


600099-AHN-I

104-141

102-151

SECTION 'G-G'

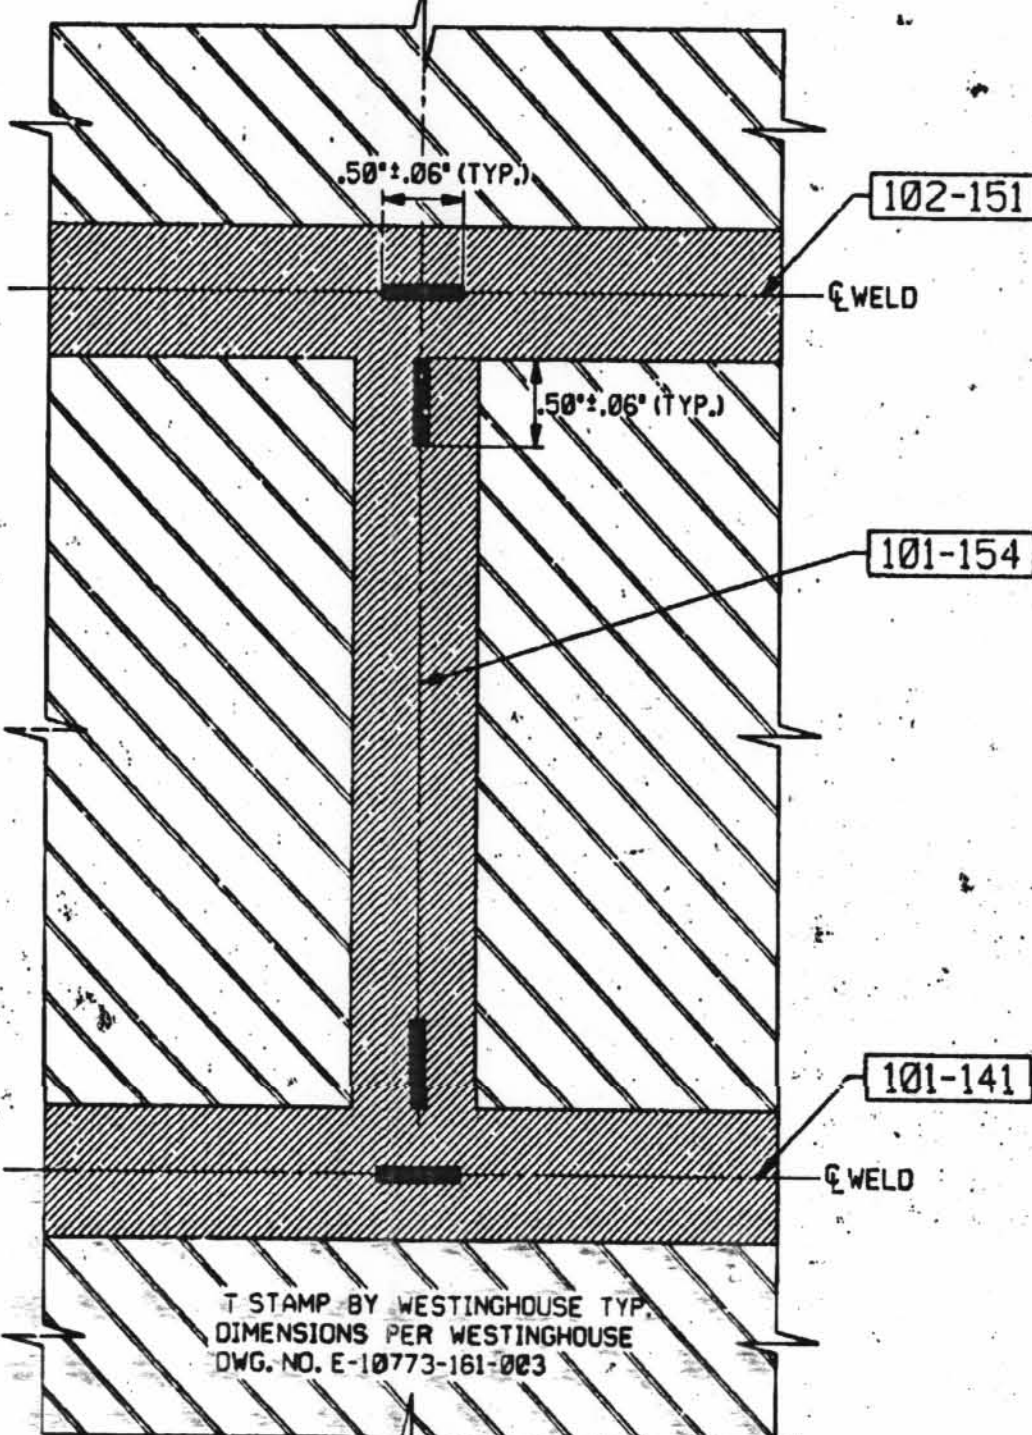

DETAIL 'B'

101-154-0°

101-154-90°

101-154-180°

102-151

104-141

SEE DETAIL 'B'

101-154-270°

BOTTOM ASSEMBLY  
BOTTOM VIEW

FOR INFORMATION ONLY

- NOTES:
1. WELD IDENTIFICATION NOS. HAVE THE PREFIX 1-SB-RV-.
  2. DRAWING NOT TO SCALE.
  3. WORK THIS DRAWING WITH 650007, 650008 AND 650010.
  4. WESTINGHOUSE SHOP ORDER NSS-105

REV		DATE	DSGN	DRWN	CHKD	CE	LDE	DESCRIPTION
1		3/27/70	MPV	JM	WMA	WMA	WMA	ORIGINAL ISSUE
New Hampshire Yankee								
REACTOR VESSEL RC-E-1 ISI EQUIPMENT WELDS								
1-NHY-650009								

FP-92668	BI	AS-BUILT LOCATION OF WELD BEAMS
-REF. DRAWING NDL	REV	TITLE

SEABROOK STATION

D-10