


PAVED ROAD
DIRT ROAD
TRAIL
FENCE
POLE
BUILDING
TREES
DRAINAGE
MINE LEASE
CULVERT

LEGEND

INDEX CONTOUR
INTERMEDIATE CONTOUR
DEPRESSION INDEX CONTOUR
DEPRESSION INTERMEDIATE
GRID TICK
GRID NUMBER
SPOT ELEVATION
SURVEYED CONTROL
BUSINESS LEASE
APPROXIMATE LIMITS OF PLACED ROCK

WELL

BOUNDARY MONUMENT SET
RESTRICTED AREA BOUNDARY

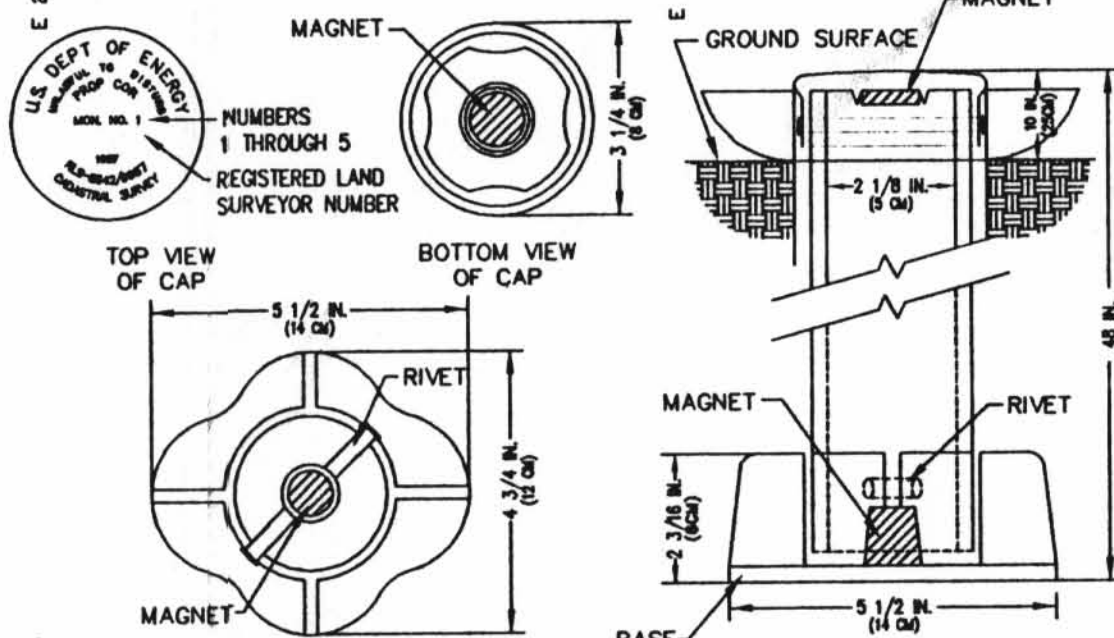

TOP VIEW OF BASE
NOT TO SCALE
BERTNSEN FEDERAL ALUMINUM BOUNDARY MONUMENT, MODEL A-1, STANDARD LOGO CAP

STATE PLANE COORDINATES FOR ESTABLISHED MONUMENTS

Monument #1 - 334688.5764 - 2671566.1577
Monument #2 - 329014.0533 - 2671745.1627
Monument #3 - 330195.2154 - 2667781.9116
Monument #3A - 330972.1938 - 2667975.5461
Monument #4 - 331502.9781 - 2667547.3874
Monument #5 - 334633.3467 - 2669802.0952

NOTE: Simpson Engineers Inc. set property corner monuments and added property lines to topography map furnished by Western Nuclear Inc.

DATE	BY	REVISIONS
07/11/99	WCP	Added Prop. to Topog. Map, B. 11.19.99
11/19/99	WCP	Added Prop. to Topog. Map, B. 11.19.99

SHERWOOD PROJECT
STATE WASHINGTON COUNTY STEVENS
SECTION TWP. 36S. R. 12E. SEC. 10
TITLE:
AS-BUILT FINAL TOPOGRAPHY



Plate 2
GRAPHIC SCALE (IN FEET)
0 150 300 600
SCALE: 1"=300'
CONTOUR INTERVAL: 2'
DATE OF PHOTOGRAPHY: 6-27-97

D-2