

 5+00 N CROSS SECTION
HORIZONTAL SCALE: 1" = 100'
VERTICAL SCALE: 1" = 10'

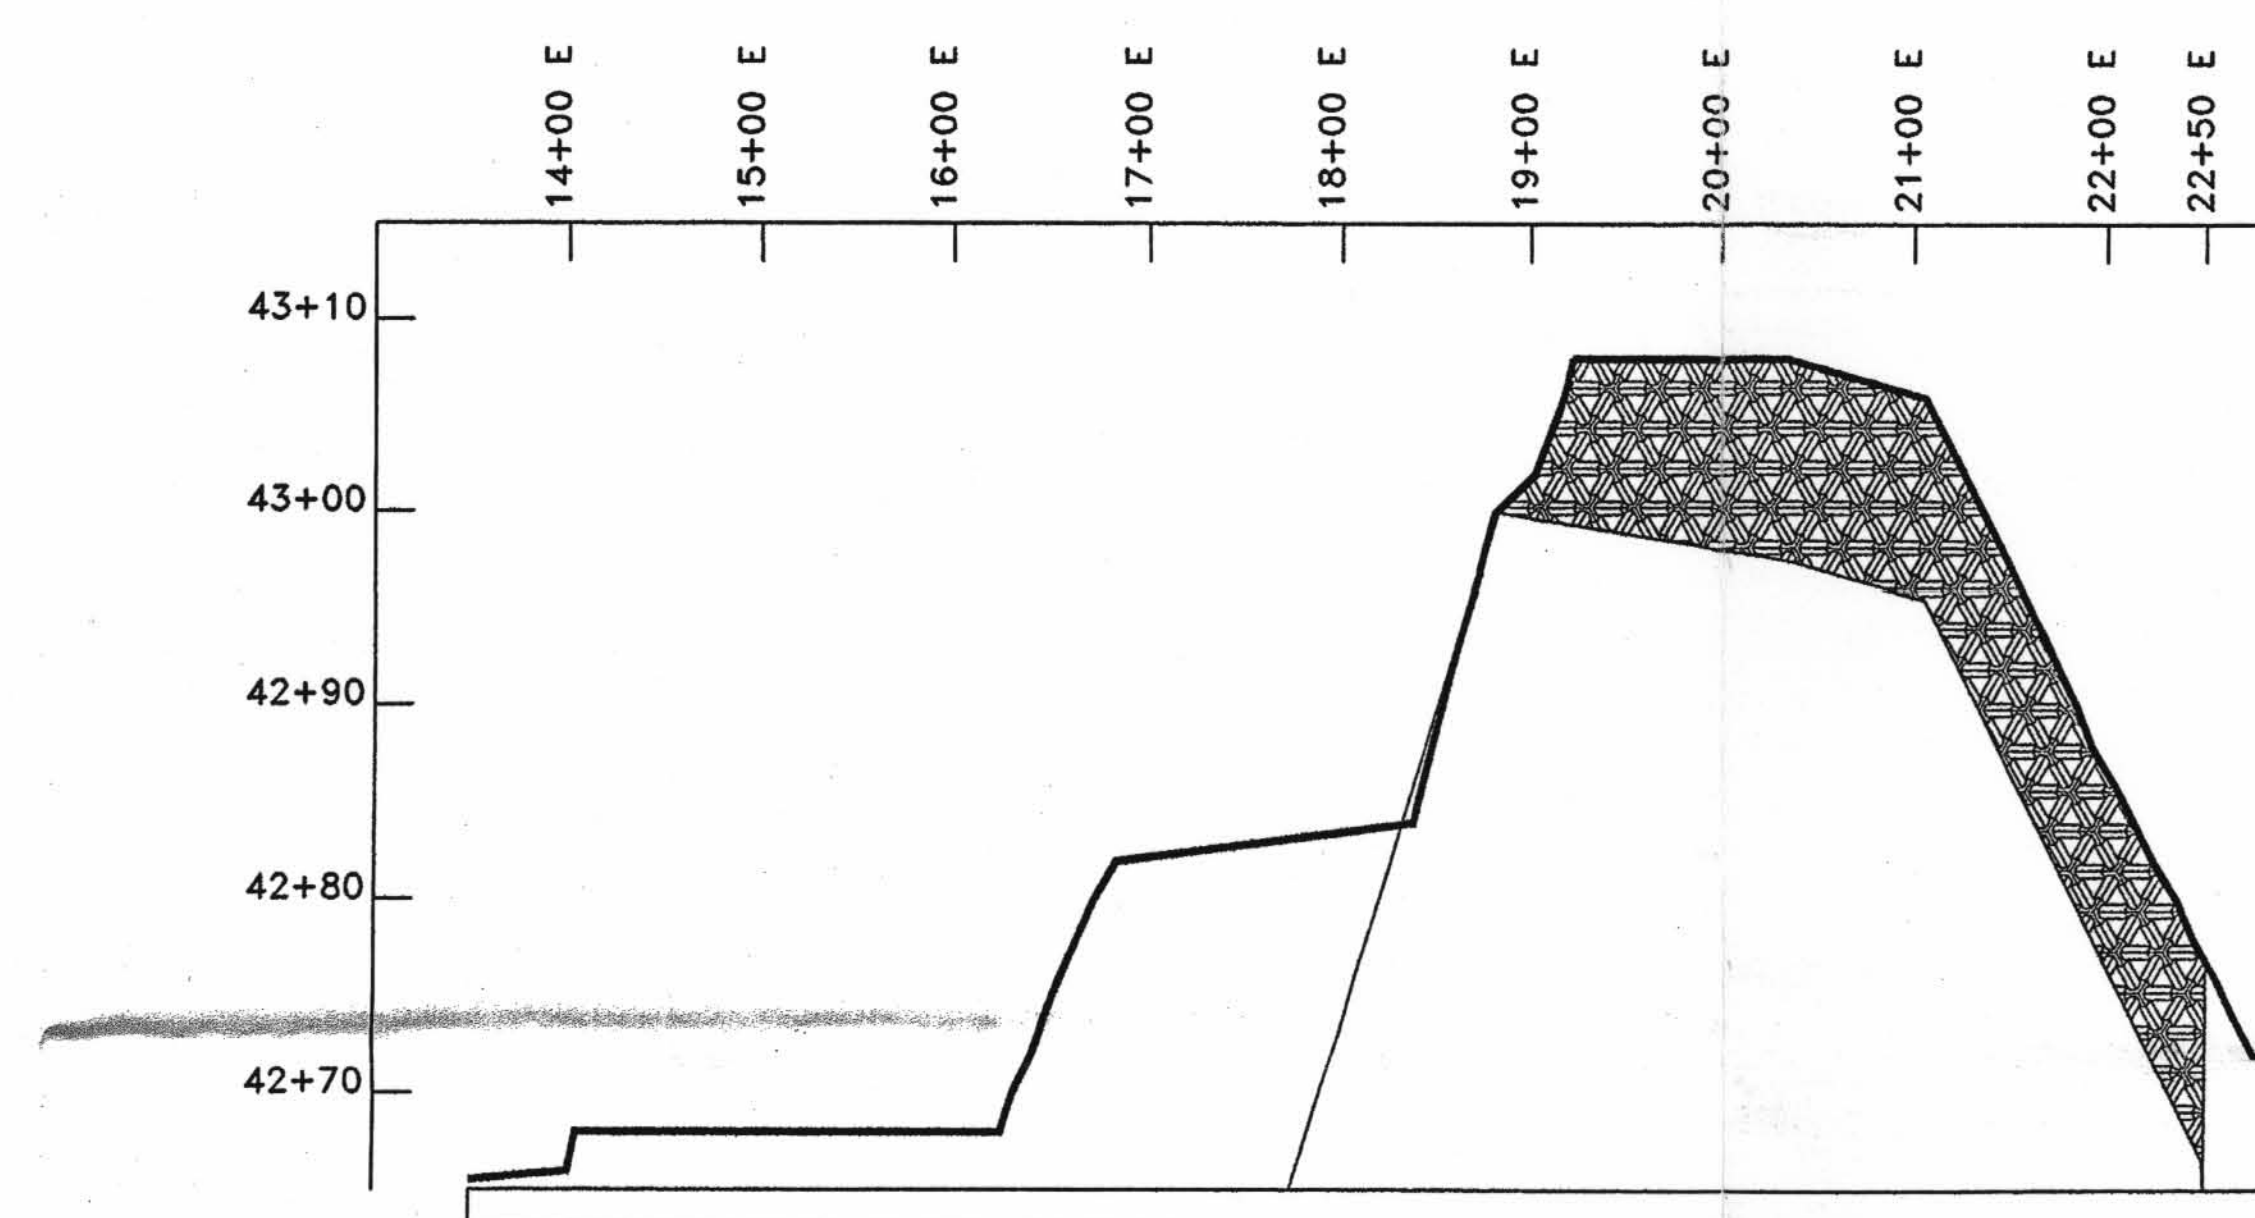


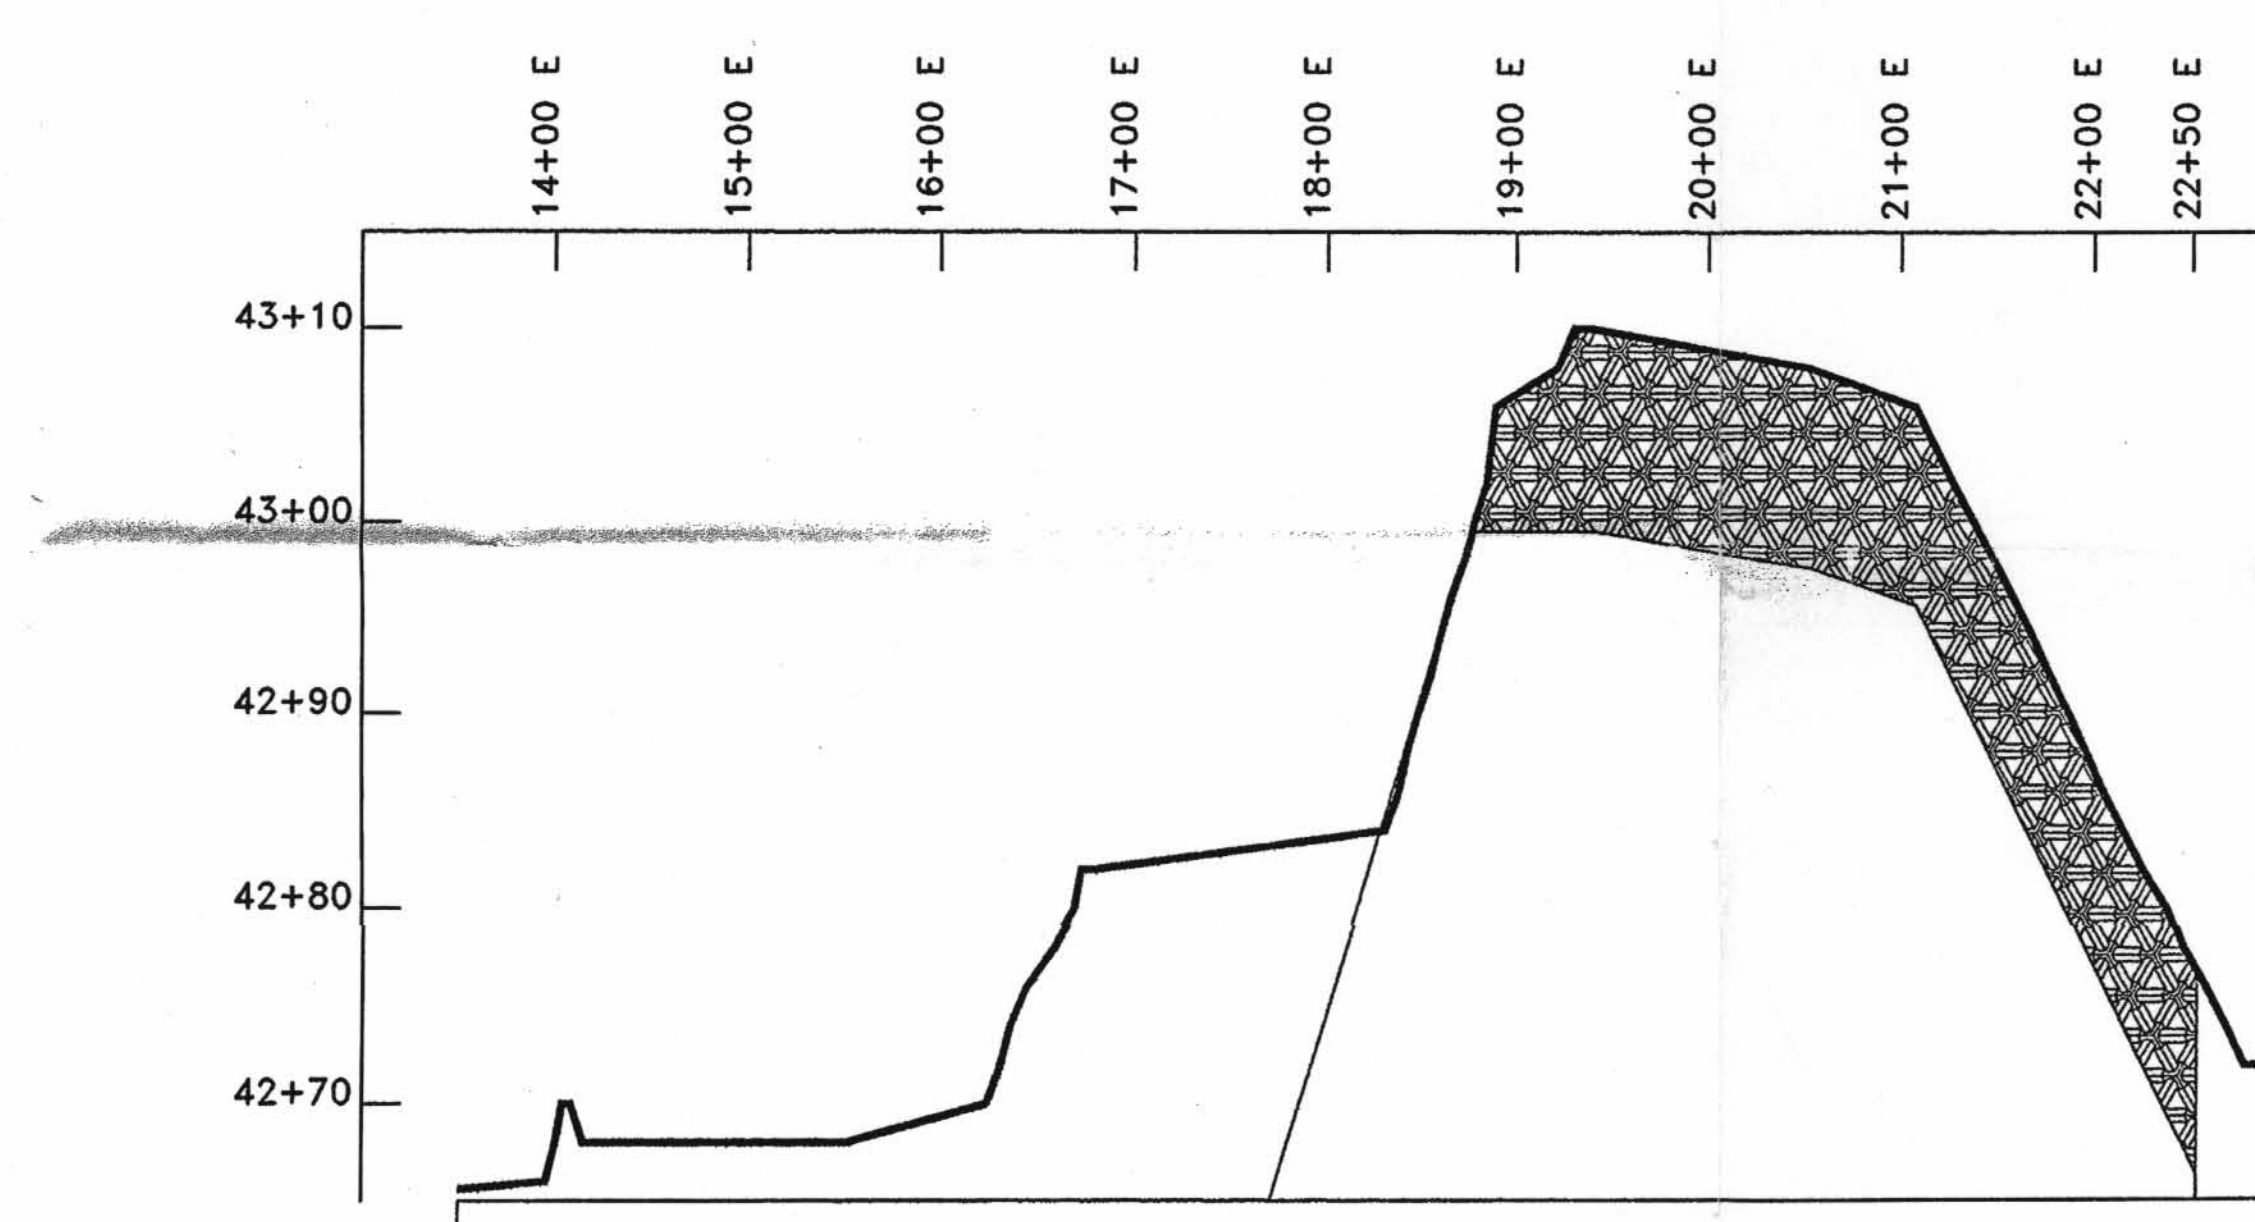
H
03

7+00 N CROSS SECTION

HORIZONTAL SCALE: 1" = 100'
VERTICAL SCALE: 1" = 10'

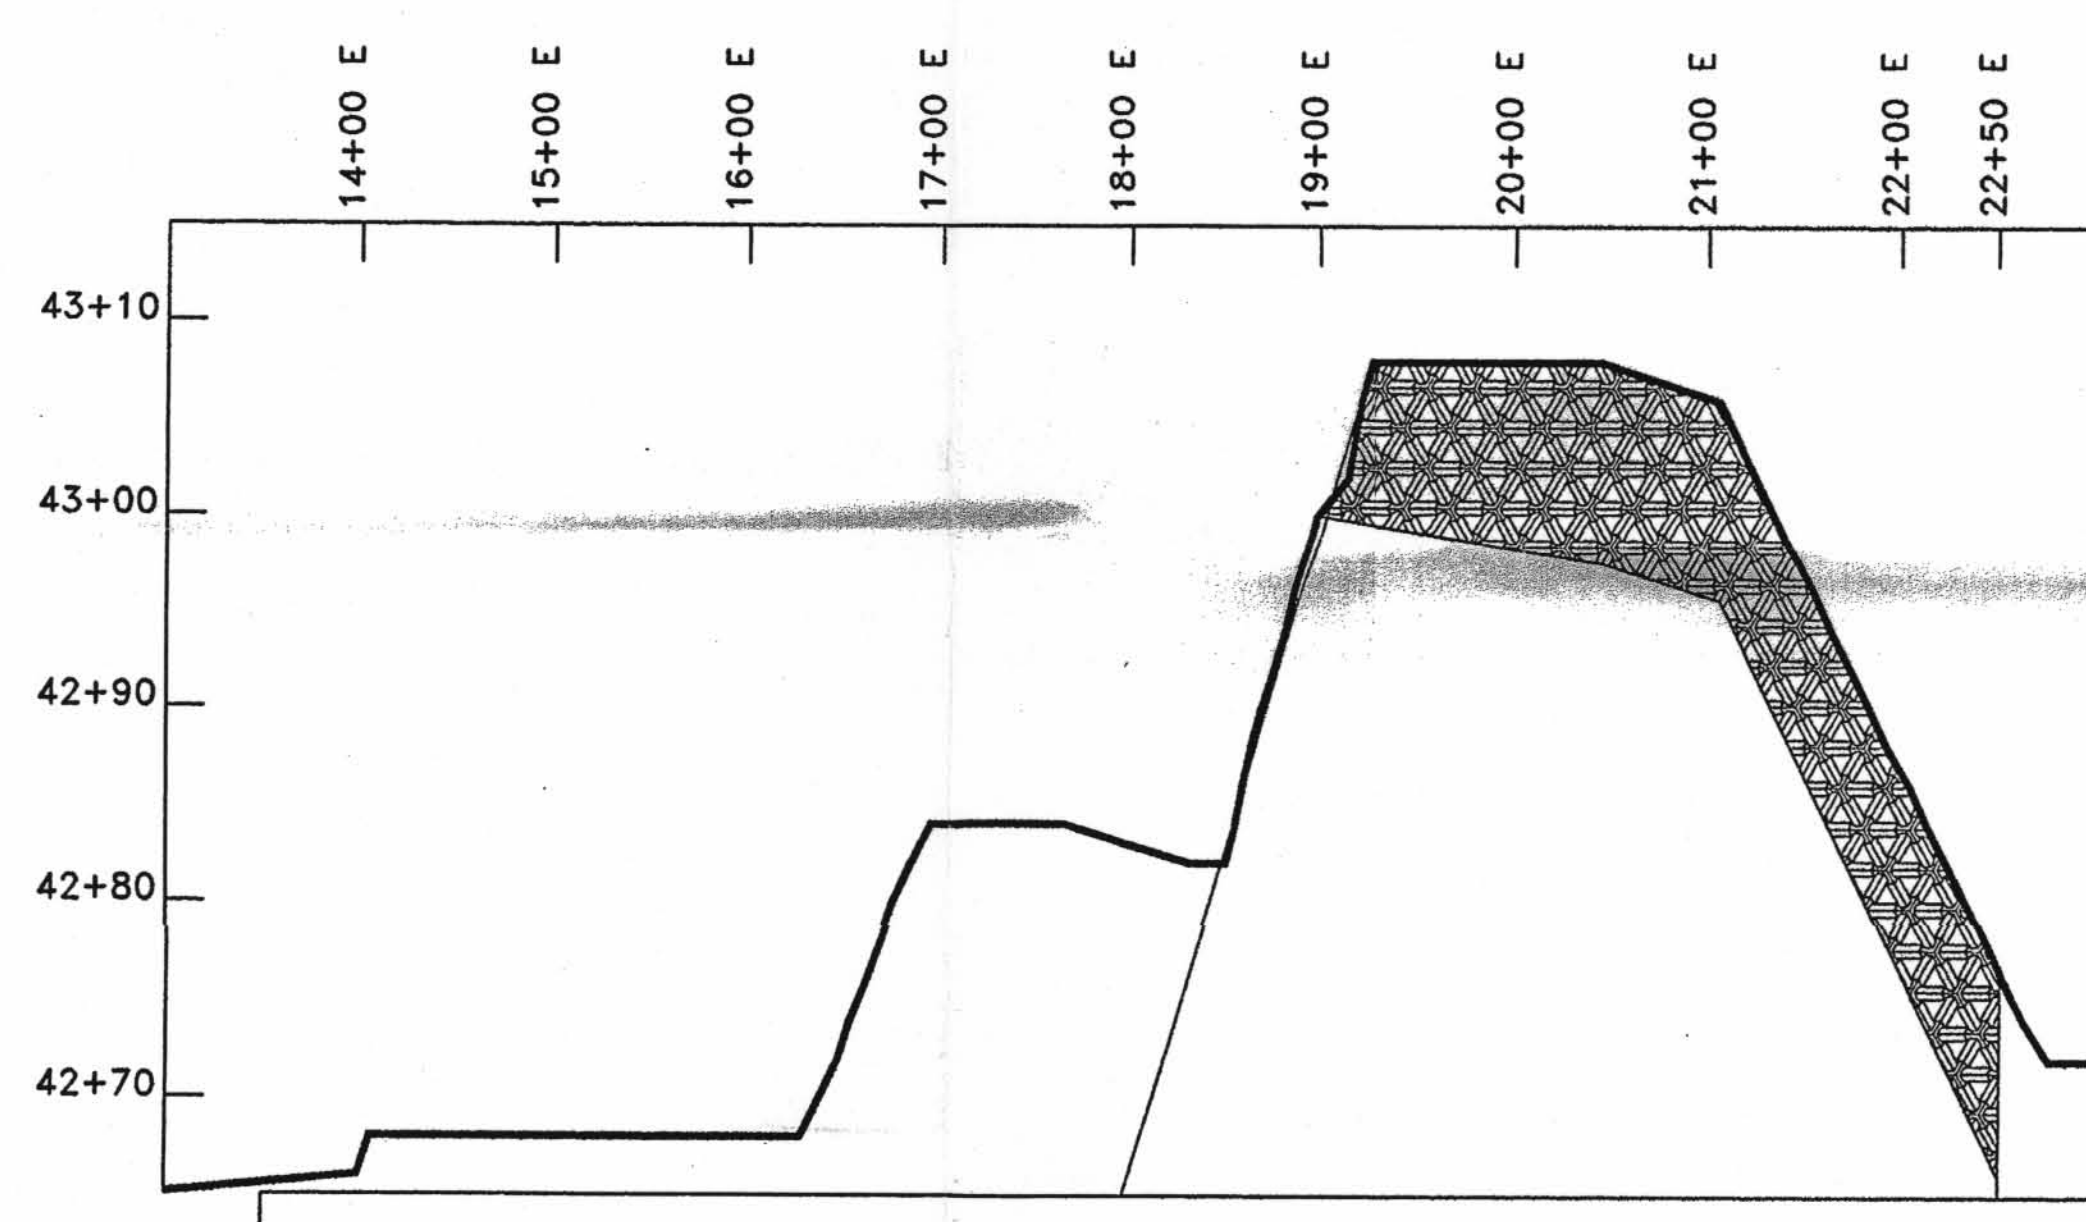


 6+00 N CROSS SECTION
 HORIZONTAL SCALE: 1" = 100'
 VERTICAL SCALE: 1" = 10'



1
03 8+00' N CROSS SECTION
HORIZONTAL SCALE: 1" = 100'
VERTICAL SCALE: 1" = 10'

KEY:


AREAS OF THE EMBANKMENT IN WHICH THE FINAL COVER HAS BEEN CONSTRUCTED. WASTE IN THESE AREAS HAVE BEEN DISPOSED OF IN ACCORDANCE WITH THE FINISHED DESIGN REQUIREMENTS.

AREAS OF THE EMBANKMENT IN WHICH TEMPORARY COVER HAS BEEN CONSTRUCTED. WASTE IN THESE AREAS HAVE BEEN DISPOSED OF IN ACCORDANCE WITH THE FINISHED DESIGN REQUIREMENTS.

NOTE:

CONTOUR MAPS ARE BASED ON A SITE SURVEY PERFORMED BY AERO-GRAPHICS, INC. ON DECEMBER 18, 2000.



				 ENVIROCARE OF UTAH, INC. THE SAFE ALTERNATIVE	DRAWN BY K. LUTZ	11e(2) DISPOSAL CELL	DATE 02/15/01
					CHECKED BY 	ANNUAL AS-BUILT DRAWING	AS NOTED
					DESIGNED BY D. WINTERS	CROSS SECTIONS	0104-03
DATE UNIT DESCRIPTION OF CHANGE						CLIVE, UTAH	