



C:\ENGINEERING\DWG FILES\2001\0104-11(2) AS-BUILT\0104-02.dwg Last edited: 02/21/01 @ 10:31 a.m. by Kutz, Stefan

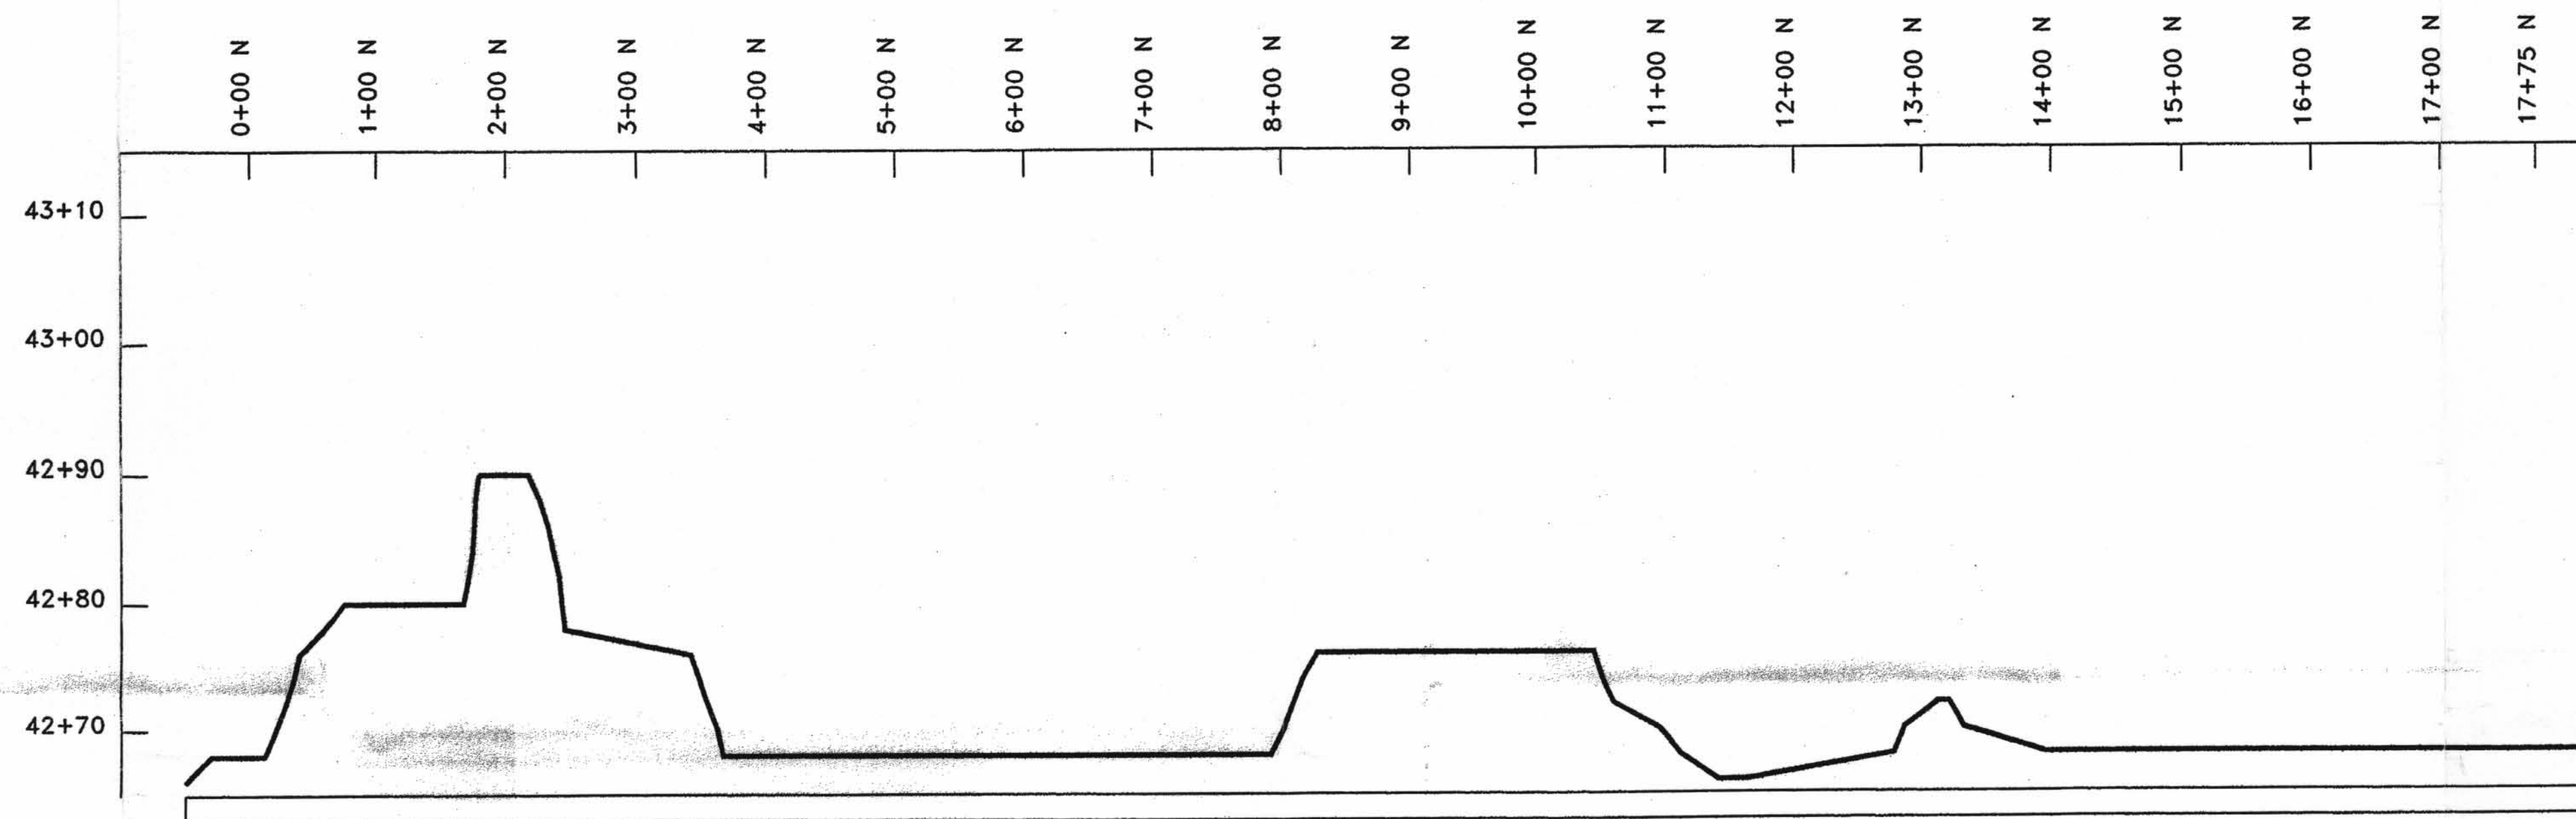

**C-C 16+00 E CROSS SECTION**  
HORIZONTAL SCALE: 1" = 100'  
VERTICAL SCALE: 1" = 10'

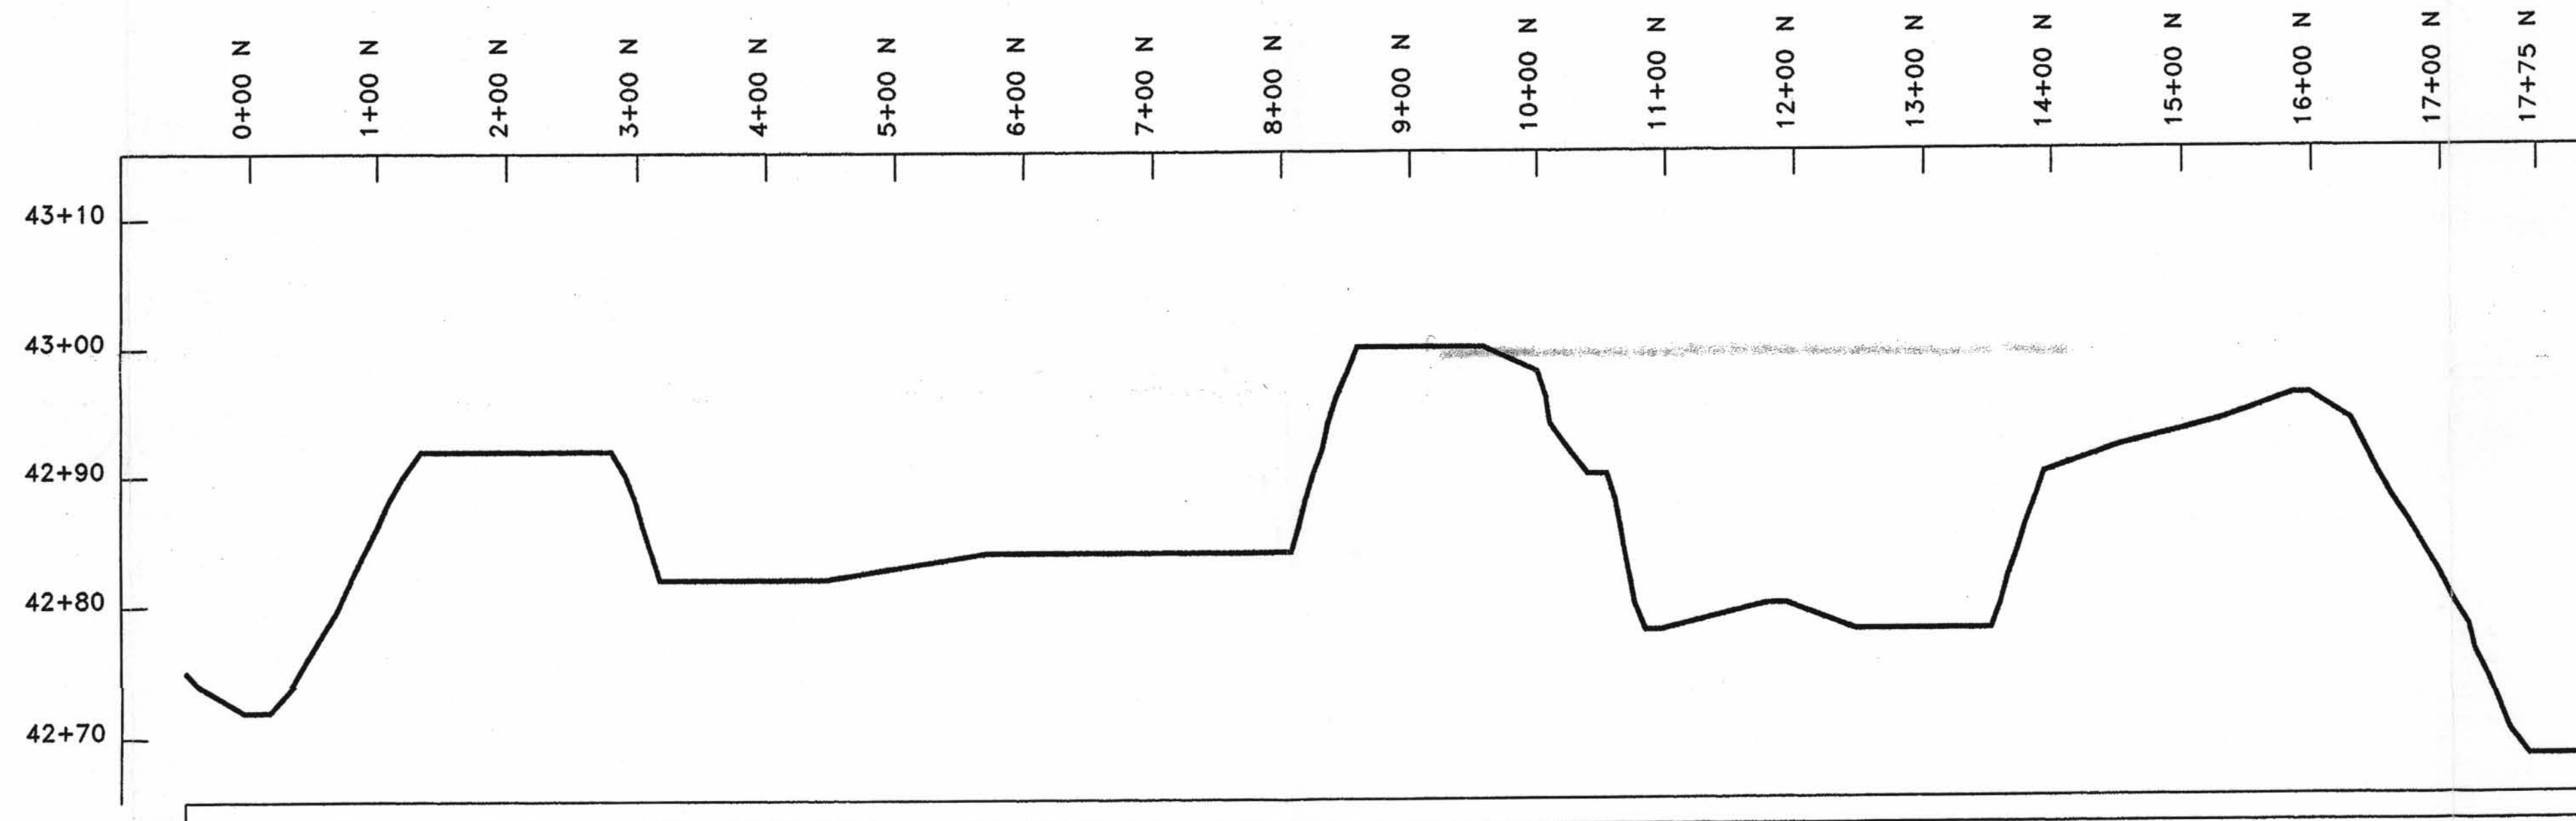

**D-D 17+00 E CROSS SECTION**  
HORIZONTAL SCALE: 1" = 100'  
VERTICAL SCALE: 1" = 10'

**KEY:**  
[Pattern] AREAS OF THE EMBANKMENT IN WHICH THE FINAL COVER HAS BEEN CONSTRUCTED. WASTE IN THESE AREAS HAVE BEEN DISPOSED OF IN ACCORDANCE WITH THE FINISHED DESIGN REQUIREMENTS.  
[Pattern] AREAS OF THE EMBANKMENT IN WHICH TEMPORARY COVER HAS BEEN CONSTRUCTED. WASTE IN THESE AREAS HAVE BEEN DISPOSED OF IN ACCORDANCE WITH THE FINISHED DESIGN REQUIREMENTS.

**NOTE:**  
CONTOUR MAPS ARE BASED ON A SITE SURVEY PERFORMED BY AERO-GRAPHICS, INC. ON DECEMBER 18, 2000.



*David Russell Winters*  
2/21/01

D-7

<b>ENVIROCARE</b> OF UTAH, INC. THE SAFE ALTERNATIVE		DRAWN BY: K. LUTZ CHECKED BY: D. WINTERS DATE: _____	11e(2) DISPOSAL CELL ANNUAL AS-BUILT DRAWING CROSS SECTIONS CLIVE, UTAH	DATE AS NOTED: 02/15/01 DRAWING NO.: 0104-07
--	--	--	--	---