



D:\CADD\ENVIRO\DWG\0104-08\0104-08.dwg User: lutz Edited: 02/15/01 9:10:35 a.m. by: lutz

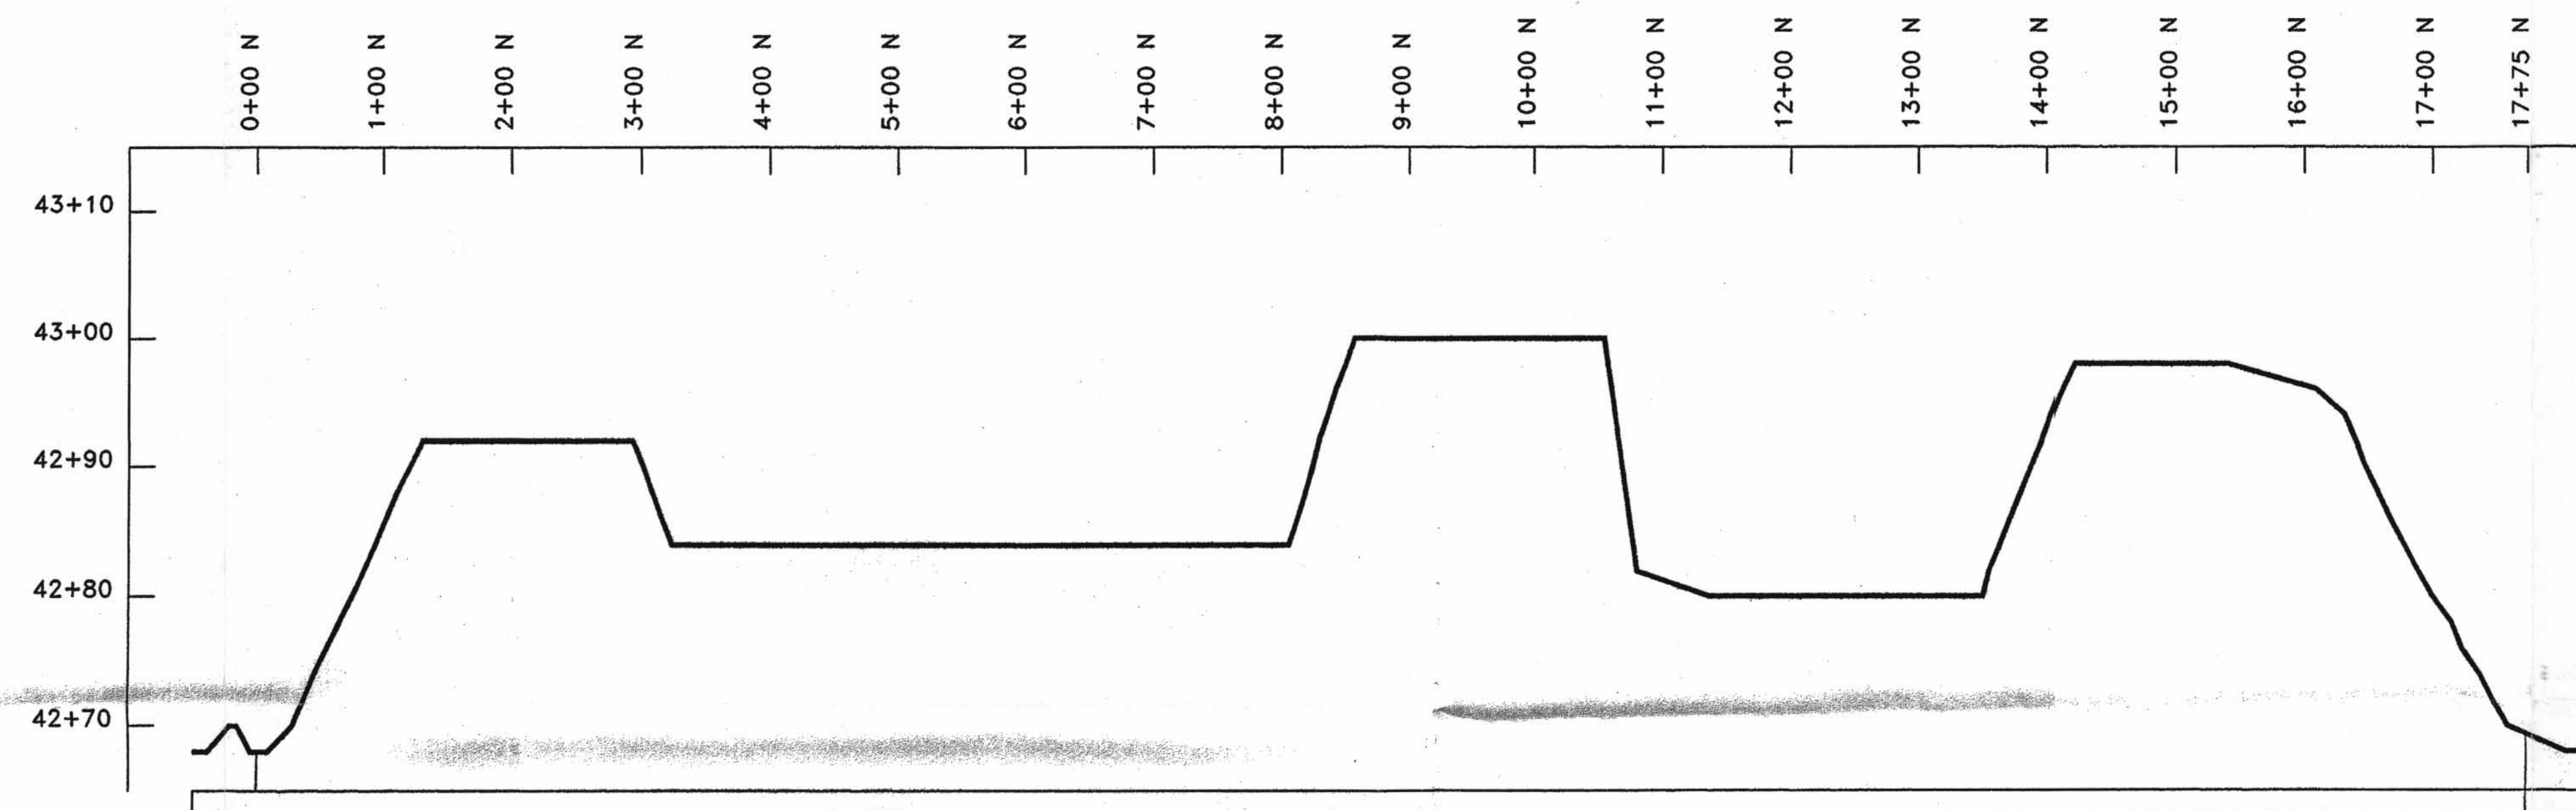

E-E 18+00 E CROSS SECTION
HORIZONTAL SCALE: 1" = 100'
VERTICAL SCALE: 1" = 10'

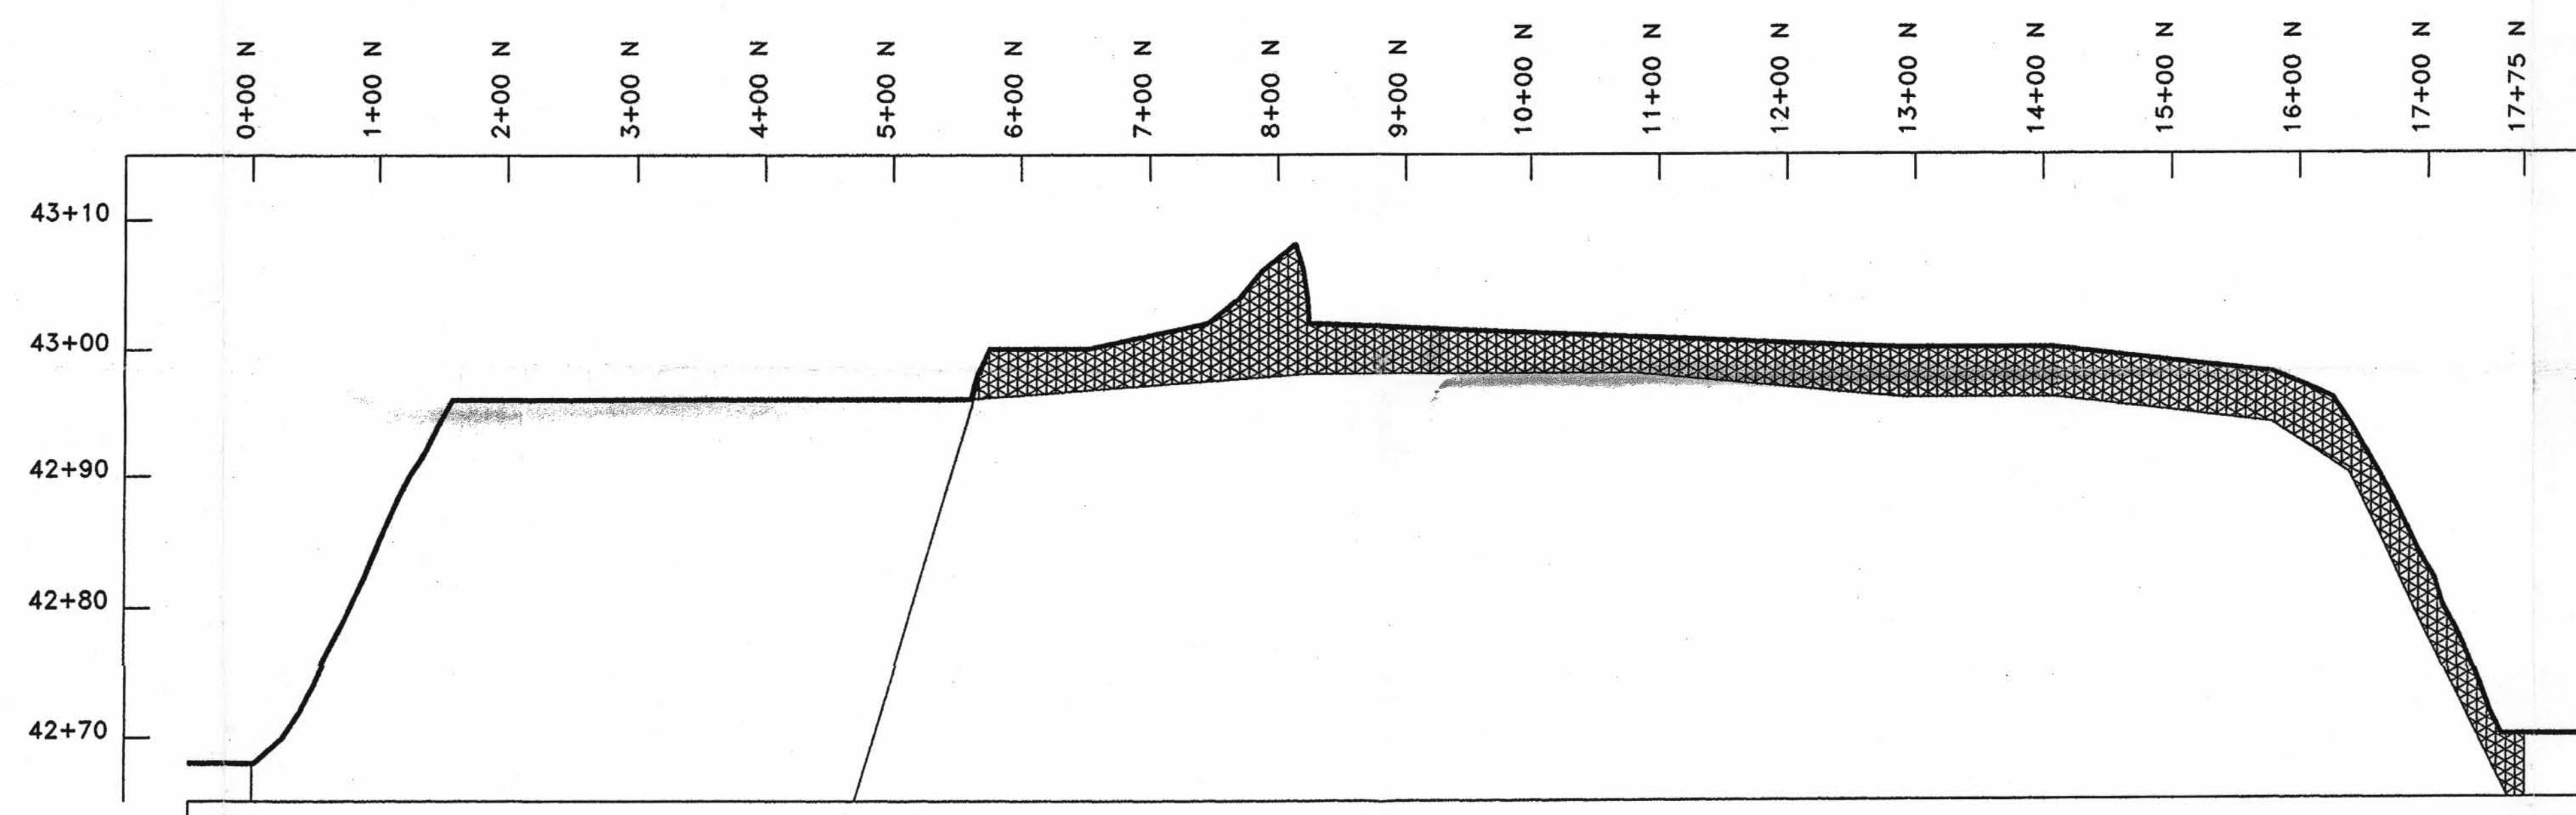

F-F 19+00 E CROSS SECTION
HORIZONTAL SCALE: 1" = 100'
VERTICAL SCALE: 1" = 10'

KEY:
AREAS OF THE EMBANKMENT IN WHICH THE FINAL COVER HAS BEEN CONSTRUCTED. WASTE IN THESE AREAS HAVE BEEN DISPOSED OF IN ACCORDANCE WITH THE FINISHED DESIGN REQUIREMENTS.
AREAS OF THE EMBANKMENT IN WHICH TEMPORARY COVER HAS BEEN CONSTRUCTED. WASTE IN THESE AREAS HAVE BEEN DISPOSED OF IN ACCORDANCE WITH THE FINISHED DESIGN REQUIREMENTS.

NOTE:
CONTOUR MAPS ARE BASED ON A SITE SURVEY PERFORMED BY AERO-GRAPHICS, INC. ON DECEMBER 18, 2000.



2/15/01

D.8

DATE	INITIALS	DESCRIPTION OF CHANGE

ENVIROCARE
OF UTAH, INC.
THE SAFE ALTERNATIVE

DESIGNED BY
K. LUTZ
CHECKED BY
D. WINTERS

11e(2) DISPOSAL CELL
ANNUAL AS-BUILT DRAWING
CROSS SECTIONS
CLIVE, UTAH

DATE AS NOTED 02/15/01
PROJECT NO. 0104-08