


Date 12-25-91  
 I, John J. [illegible]  
 certify that the above contained on this form was made in the normal and regular course of business,  
 and the date stated below and that it is a true and correct reproduction of the document submitted to Microfilm  
 Microfilming Witness

its having not been induced by ANP and is the property of the participants in the Arizona Nuclear Power Project. Use of the drawing and the specific design depicted thereon for any purpose other than that related to the Arizona Nuclear Power Project is not authorized by the Owners.

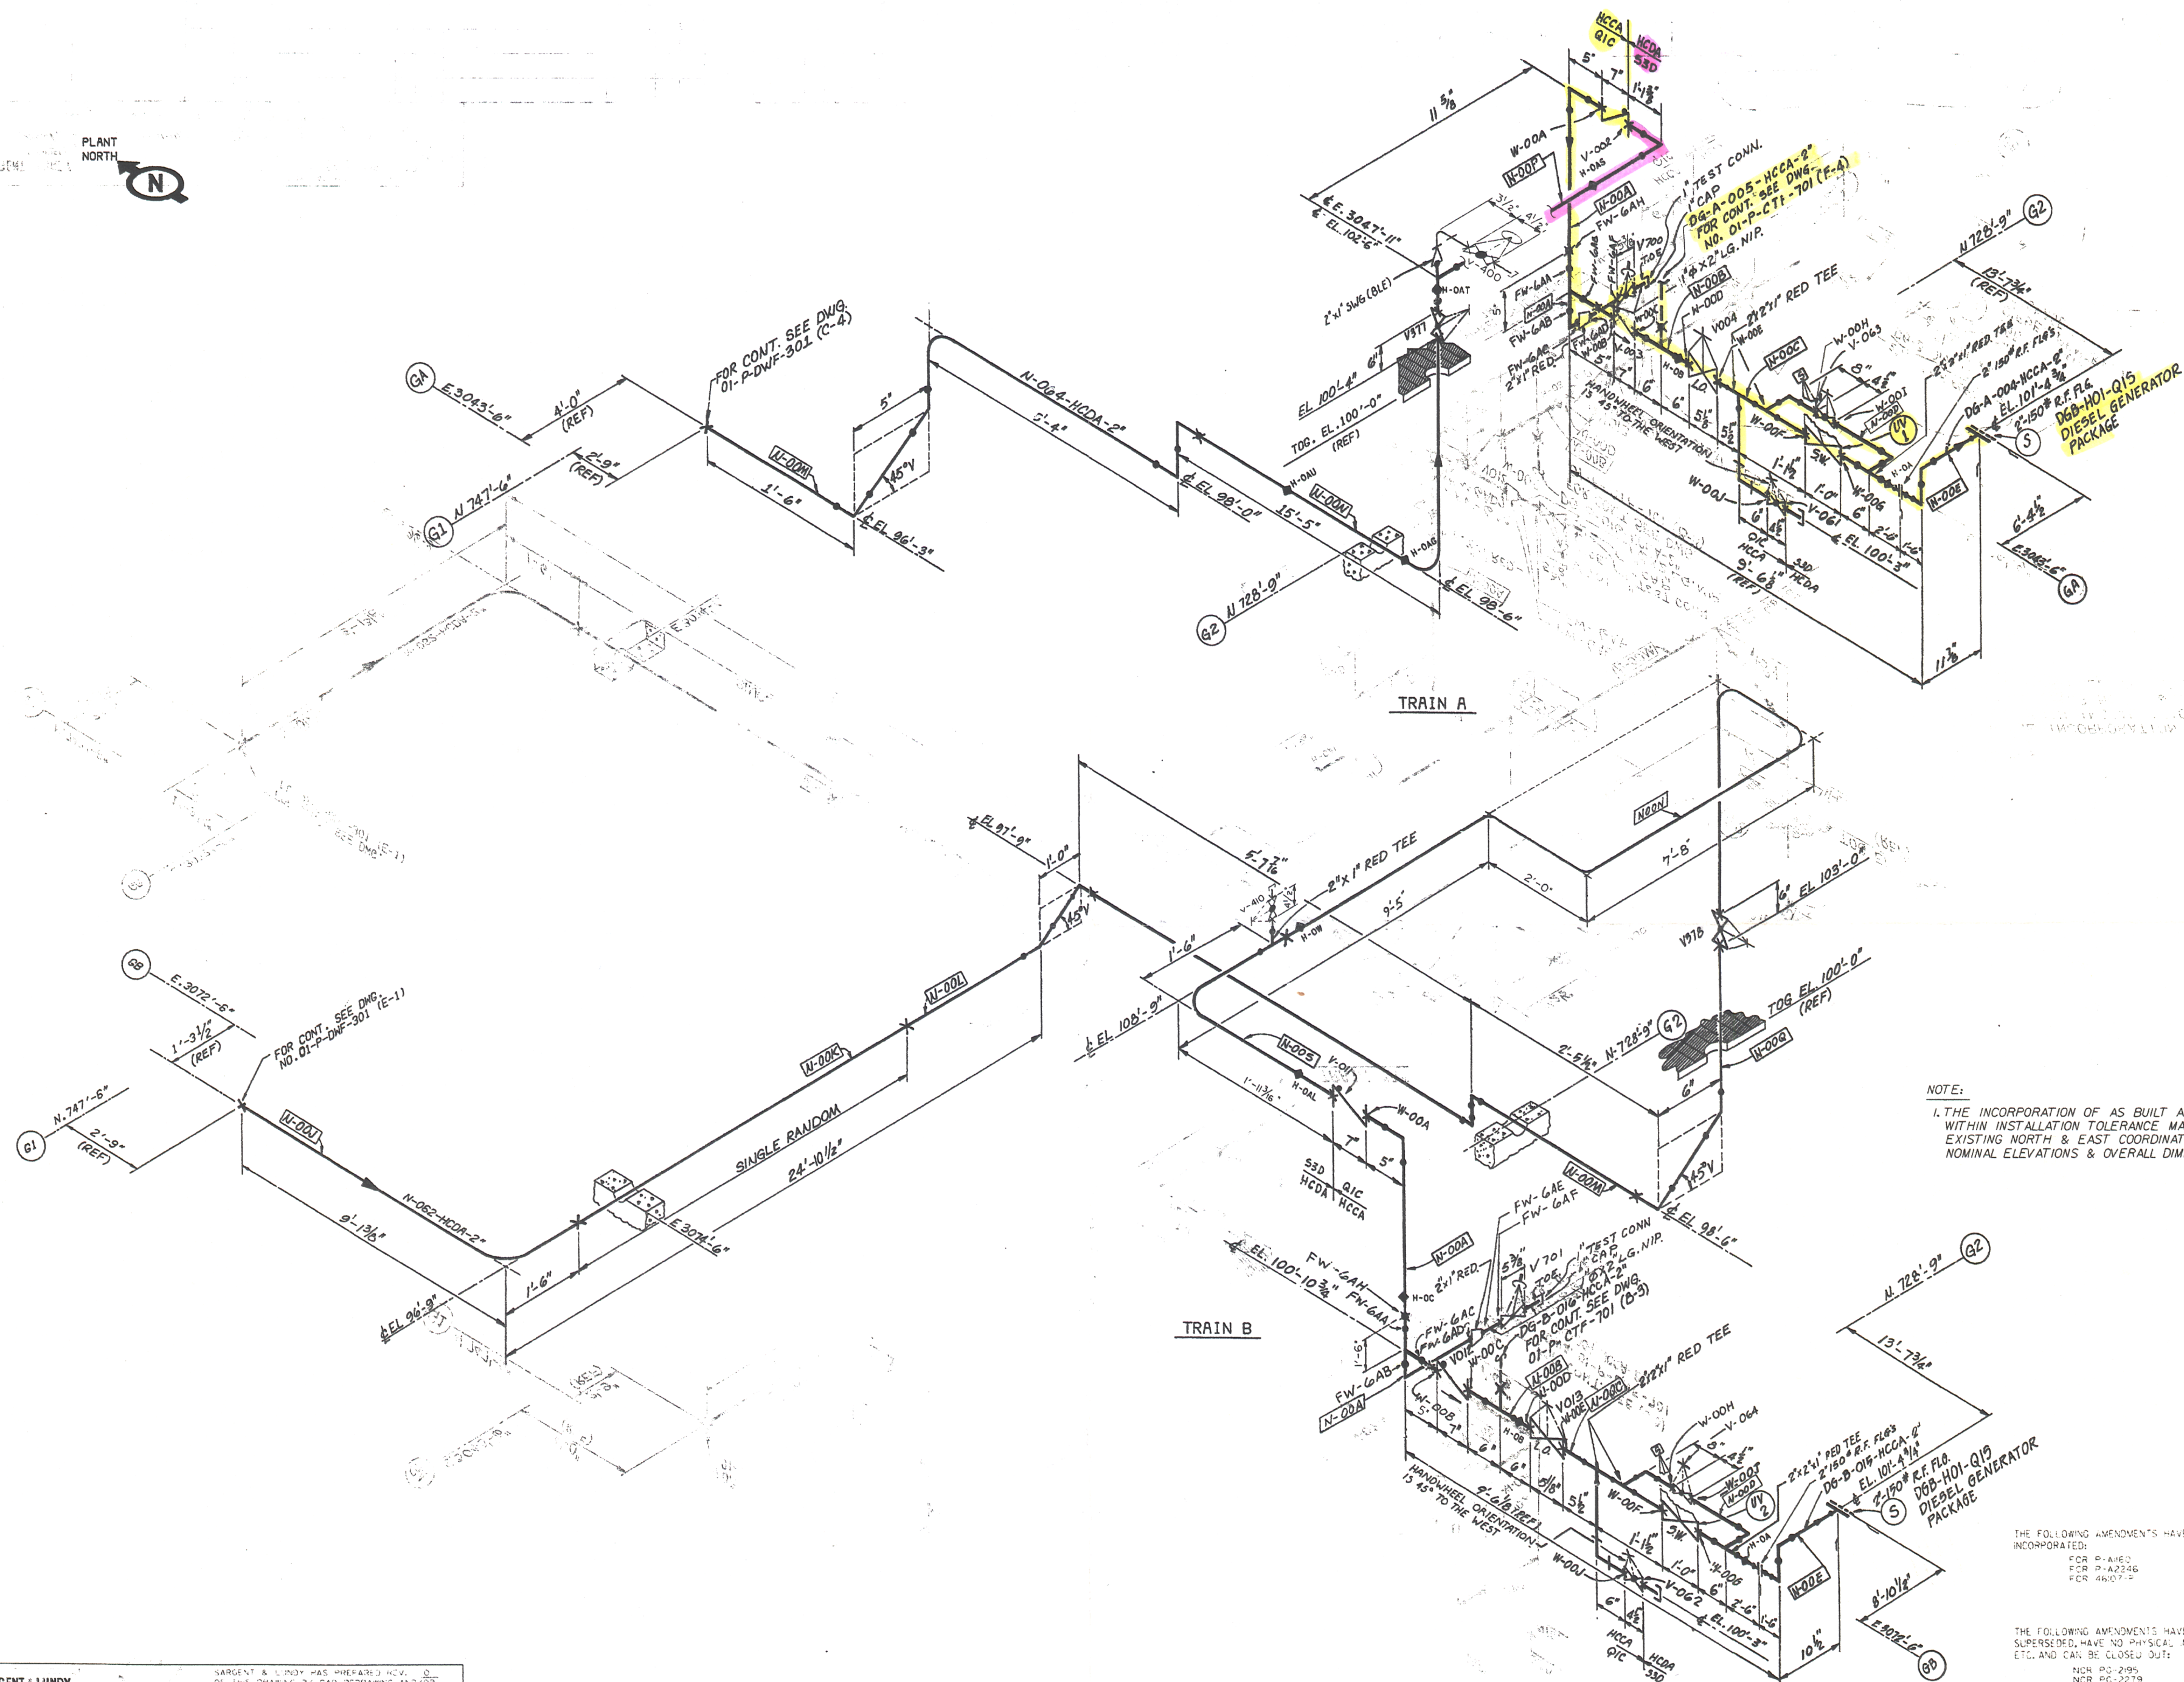

NOTE:

1. THE INCORPORATION OF AS BUILT AMENDMENTS WITHIN INSTALLATION TOLERANCE MAY AFFECT EXISTING NORTH & EAST COORDINATES, NOMINAL ELEVATIONS & OVERALL DIMENSIONS.

THE FOLLOWING AMENDMENTS HAVE BEEN  
INCORPORATED:

FCR P-A1160  
FCR P-A2246  
FCR 46107-F

THE FOLLOWING AMENDMENTS HAVE BEEN  
SUPERSEDED, HAVE NO PHYSICAL IMPACT OR  
ETC. AND CAN BE CLOSED OUT:

NCR PG-2195  
NCR PG-2279  
NCR Px 9460  
SFR IDW-003

ALL DCNS INCORPORATED ON THIS DRAWING ARE  
THOSE ISSUED AGAINST THE CORRESPONDING IS  
DRAWING.

TRAIN "A" & "B"

SEE MICROFILM FOR ACTUAL SIGNATURES



**Arizona Nuclear Power Project**

DIESEL GENERATOR BLDG. ISO  
DEMINERALIZED WATER SYSTEM

SCALE	JOB NO.	DRAWING NO.	REV.
NONE		01-P-DWF-701	0

[illegible]

10-05

34X44 'E' SIZE