


LEGEND

- 7000 2006 FINISHED GRADE TOPOGRAPHY
- DRAINAGE PATH/PONDED WATER
- == UN-PAVED ROADS
- N 794,000 + UMETCO 1000' SITE GRID
- 6-INCHES OF RIPRAP TYPE "A" $D_{50} = 0.5$ INCH
- 6-INCHES OF RIPRAP TYPE "B" $D_{50} = 3.0$ INCH
- 6-INCHES OF RIPRAP TYPE "B" $D_{50} = 3.0$ INCH
WITH 6-INCHES OF FILTER TYPE "A" $D_{50} = 0.5$ INCH
- 6-INCHES OF RIPRAP TYPE "B" $D_{50} = 3.0$ INCH
WITH 3-INCHES OF FILTER TYPE "A" $D_{50} = 0.5$ INCH
- 12-INCHES OF RIPRAP TYPE "C" $D_{50} = 6.0$ INCH
- 12-INCHES OF RIPRAP TYPE "C" $D_{50} = 6.0$ INCH
WITH 6-INCHES OF FILTER TYPE "A" $D_{50} = 0.5$ INCH
- 10-INCHES OF RIPRAP TYPE "C" $D_{50} = 6.0$ INCH
WITH 3-INCHES OF FILTER TYPE "A" $D_{50} = 0.5$ INCH
- 24-INCHES OF RIPRAP TYPE "D" $D_{50} = 16.0$ INCH
WITH 6-INCHES OF FILTER TYPE "A" $D_{50} = 0.5$ INCH
- LAUNCHED STONE EMBANKMENT TYPE "E" $D_{50} = 30.0$ INCH
- BELOW-GRADE APRON

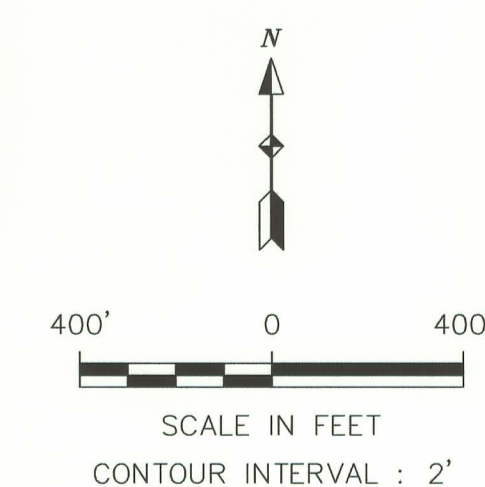

Umetco Minerals Corporation
2754 COMPASS DRIVE, SUITE 280, GRAND JUNCTION, CO 81506

AS BUILT

FINAL SITE PLAN
REFLECTING
CONSTRUCTION COMPLETION

GAS HILLS, WYOMING

JUNE 2007

PLATE 1

D-01