


LEGEND:

- EXISTING 1997 AERIAL TOPOGRAPHY
- DRAINAGE PATH/PONDED WATER
- UN-PAVED ROADS
- UMETCO 1000' SITE GRID
- FINISH GRADE TOPOGRAPHY
- CONTAMINATED FILL AREA
- LIMIT OF A-9 REPOSITORY CONTAMINATED SOILS
- CONTAMINATED FILL COMPACTION TEST LOCATIONS. 1999 FILL MATERIAL FROM THE ABOVE-GRADE TAILINGS IMPOUNDMENT ENHANCEMENT 1999 CONSTRUCTION. FILL MATERIAL PLACED, COMPACTED AND TESTED IN 1 FOOT LIFTS - 5 LIFTS TOTAL
- LIMITS OF 1999 CONTAMINATED MATERIAL FILL AREA.
- CONTAMINATED FILL COMPACTION TEST LOCATIONS. 2000 FILL MATERIAL FROM THE EXCAVATION OF THE CLAY LINER AND PRESCRIPTIVE DIG OF THE NORTH & SOUTH EVAPORATION PONDS. FILL MATERIAL PLACED, COMPACTED AND TESTED IN 1 FOOT LIFTS - 42 LIFTS TOTAL
- LIMITS OF 2000 CONTAMINATED MATERIAL FILL AREA.

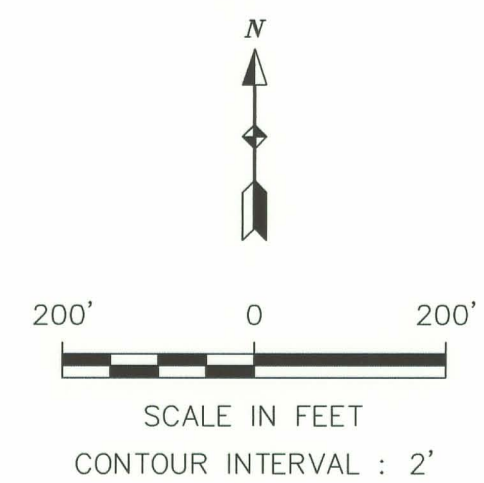

Umetco Minerals Corporation
2754 COMPASS DRIVE, SUITE 280, GRAND JUNCTION, CO 81506

AS BUILT

A-9 REPOSITORY
1999 AND 2000
COMPACTION TEST LOCATIONS
CONTAMINATED FILL AREA

GAS HILLS, WYOMING