



LEGEND:

- EXISTING 1997 AERIAL TOPOGRAPHY
- DRAINAGE PATH/PONDED WATER
- UN-PAVED ROADS
- UMETCO 1000' SITE GRID
- FINISH GRADE TOPOGRAPHY
- CONTAMINATED FILL AREA
- LIMIT OF A-9 REPOSITORY CONTAMINATED SOILS
- CONTAMINATED FILL COMPACTION TEST LOCATIONS. 2001 FILL MATERIAL FROM THE RESHAPING OF THE EXISTING A-9 REPOSITORY CONTAMINATED FILL, THE STOCKPILED FILL FROM THE GHP-1 LINER REMOVAL, AND THE WINDBLOWN CLEANUP MATERIAL. FILL MATERIAL PLACED, COMPACTED AND TESTED IN 1 FOOT LIFTS - APPROX. 8 LIFTS
- CONTAMINATED FILL COMPACTION TEST LOCATIONS. 2002 FILL MATERIAL FROM THE RESHAPING OF THE EXISTING A-9 REPOSITORY CONTAMINATED FILL, CONTAMINATED FILL FROM THE CONSTRUCTION WATER PIPELINE TRENCH CLEANUP, THE GHP-1 CLEANUP AREA AND THE WINDBLOWN CLEANUP MATERIAL. FILL MATERIAL PLACED, COMPACTED AND TESTED IN 1 FOOT LIFTS - APPROX. 22 LIFTS
- CONTAMINATED FILL COMPACTION TEST LOCATIONS. 2003 FILL MATERIAL FROM THE RESHAPING OF THE EXISTING A-9 REPOSITORY CONTAMINATED FILL. FILL MATERIAL PLACED, COMPACTED AND TESTED IN 1 FOOT LIFTS - APPROX. 8 LIFTS

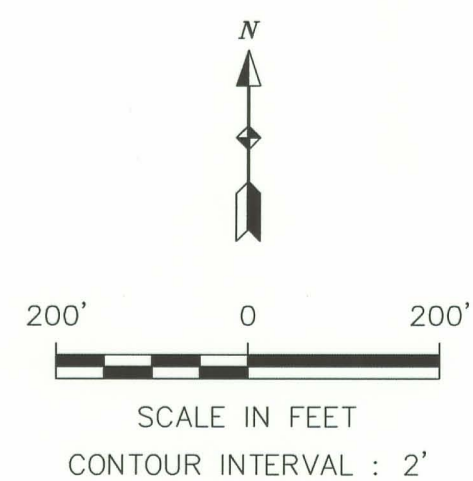

**Umetco Minerals Corporation**  
2754 COMPASS DRIVE, SUITE 280, GRAND JUNCTION, CO 81506

AS BUILT

A-9 REPOSITORY  
2001, 2002 AND 2003  
COMPACTION TEST LOCATIONS  
CONTAMINATED FILL AREA

GAS HILLS, WYOMING

DATE: JUNE 2007    DWG: GH-A9-04-AB    SHEET 4 OF 12

D-04