
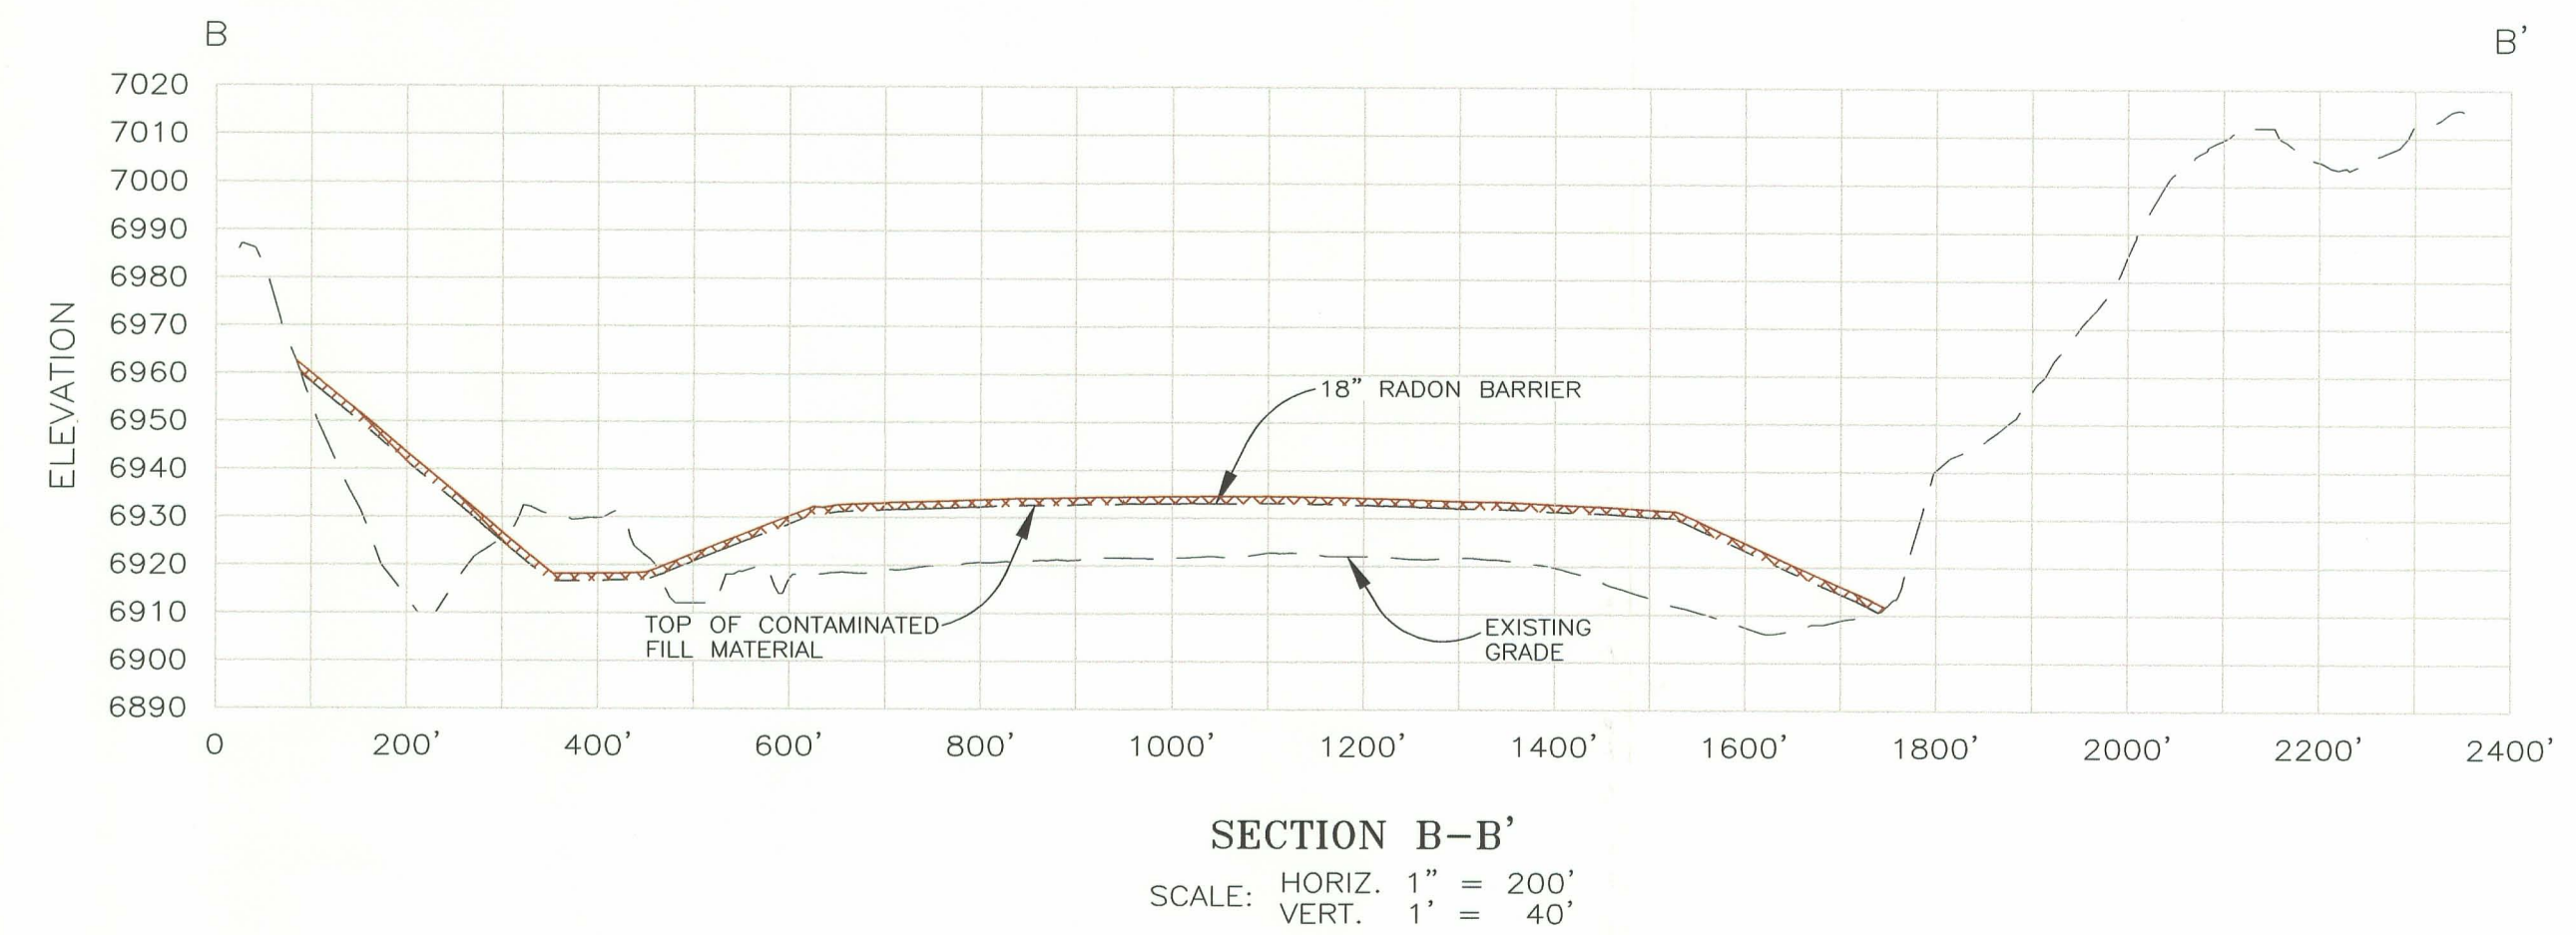


- LEGEND:**
- EXISTING 1997 AERIAL TOPOGRAPHY
  - DRAINAGE PATH/PONDED WATER
  - UN-PAVED ROADS
  - UMETCO 1000' SITE GRID
  - FINISH GRADE TOPOGRAPHY
  - RADON BARRIER FILL AREA
  - RADON BARRIER FILL SURVEY VERIFICATION POINT
  - LIMIT OF RADON BARRIER SOILS

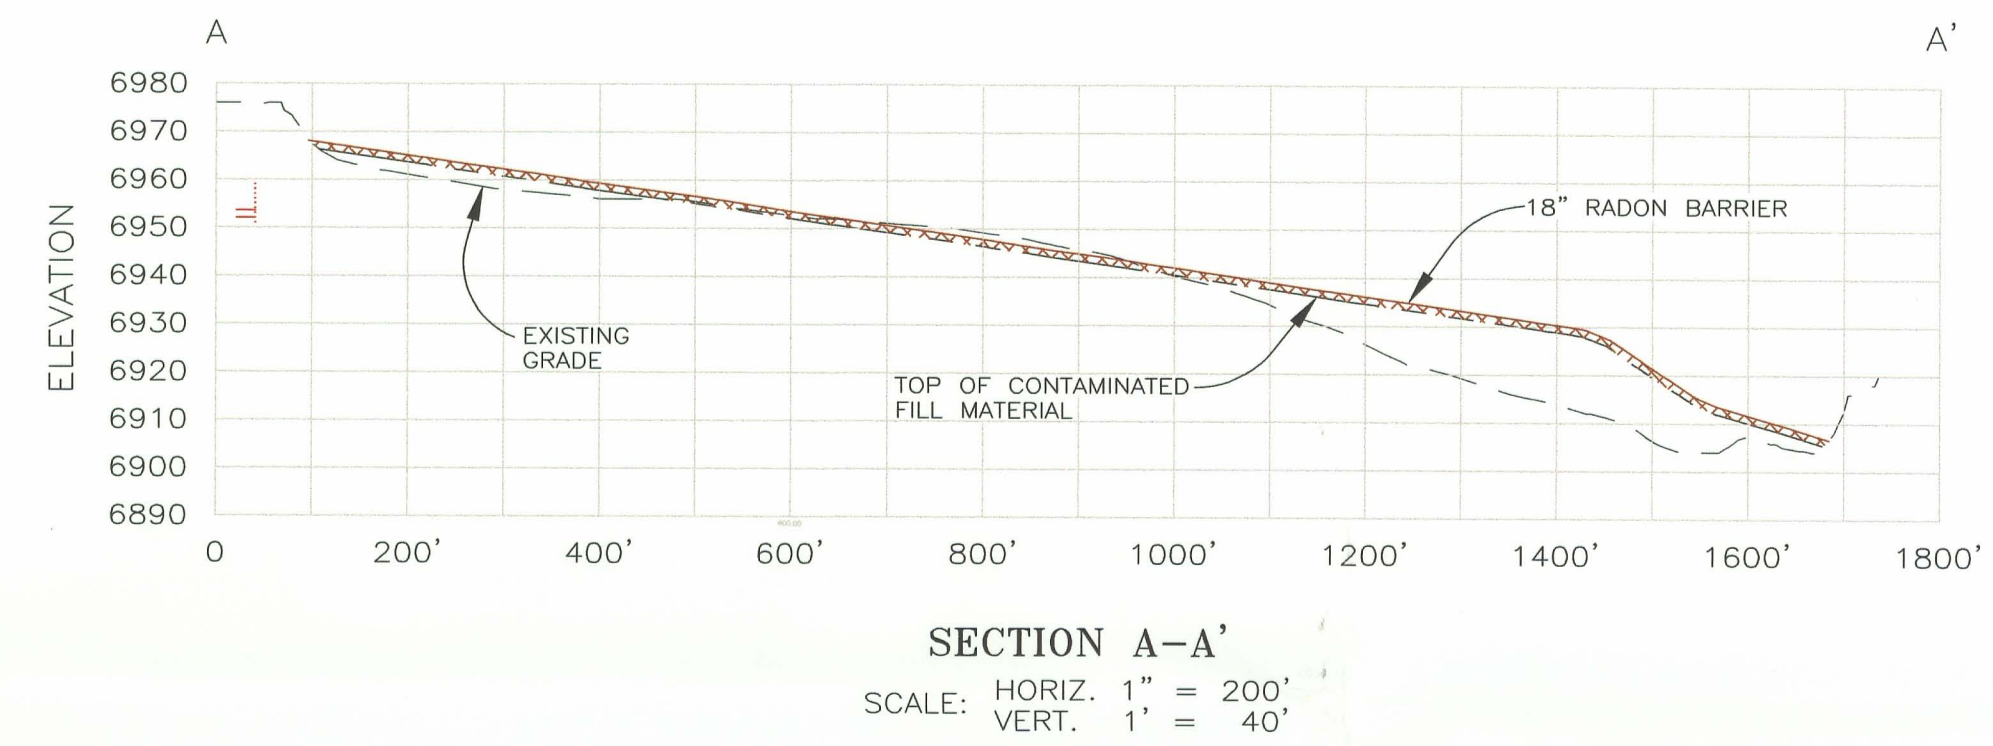

- PROFILE LEGEND:**
- EXISTING GRADE 1997 AERIAL TOPOGRAPHY
  - TOP OF THE CONTAMINATED FILL
  - 18" RADON BARRIER

**Umetco Minerals Corporation**  
2754 COMPASS DRIVE, SUITE 280, GRAND JUNCTION, CO 81506  
**AS BUILT**

**A-9 REPOSITORY  
FINAL CONTOURS AND  
SURVEY VERIFICATION POINTS  
RADON BARRIER**

**GAS HILLS, WYOMING**

D-05