



- LEGEND:
- EXISTING 1997 AERIAL TOPOGRAPHY
 - DRAINAGE PATH/PONDED WATER
 - UN-PAVED ROADS
 - UMETCO 1000' SITE GRID
 - FINISH GRADE TOPOGRAPHY
 - RADON BARRIER FILL AREA
 - LIMIT OF RADON BARRIER SOILS
 - RADON BARRIER FILL VISUAL DEPTH VERIFICATION TEST LOCATION
A9-18 INDICATES THE VISUAL DEPTH CHECK I.D.
1.57 INDICATES DEPTH MEASURED IN FEET

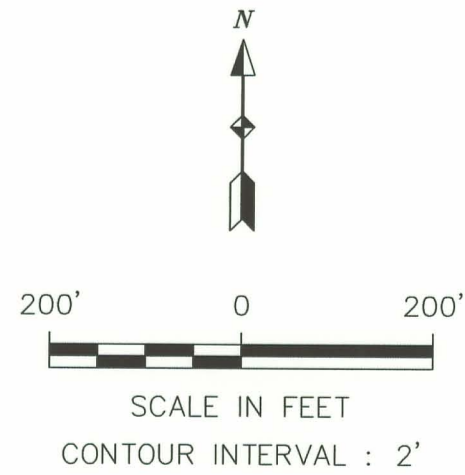

**Umetco Minerals Corporation**
2754 COMPASS DRIVE, SUITE 280, GRAND JUNCTION, CO 81506

AS BUILT

A-9 REPOSITORY
VISUAL DEPTH CHECK VERIFICATION
TEST LOCATIONS
RADON BARRIER

GAS HILLS, WYOMING

DATE: JUNE 2007 DWG: GH-A9-07-AB SHEET 7 OF 12