


LEGEND:

- 7000 2000 AERIAL TOPOGRAPHY  
UPDATED WITH 2006 SURVEYS
- DRAINAGE PATH/PONDED WATER
- UN-PAVED ROADS
- N 794,000 UMETCO 1000' SITE GRID
- 6960 FINISH GRADE TOPOGRAPHY  
OF THE A-9 REPOSITORY FROST  
PROTECTION LAYER
- LIMIT OF RADON BARRIER SOILS
- 6910 FINISH GRADE TOPOGRAPHY  
OF THE A-9 REPOSITORY TOE APRON  
EXCAVATION
- F-103 FROST PROTECTION FILL COMPACTION  
TEST LOCATION - FIRST LIFT
- F-260 FROST PROTECTION FILL COMPACTION  
TEST LOCATION - SECOND LIFT
- F-517 FROST PROTECTION FILL COMPACTION  
TEST LOCATION - THIRD LIFT
- F-725 FROST PROTECTION FILL COMPACTION  
TEST LOCATION - FOURTH LIFT
- F-983 FROST PROTECTION FILL COMPACTION  
TEST LOCATION - FIFTH LIFT  
FINISHED GRADE
- AP1-1 TOE APRON EXCAVATION SUBGRADE  
AND BACKFILL COMPACTION TEST  
LOCATIONS - FILL IN ONE FOOT LIFTS
- WC-1 WEST DIVERSION CHANNEL EXCAVATION  
SUBGRADE AND BACKFILL COMPACTION  
TEST LOCATIONS - FILL IN ONE FOOT  
LIFTS
- SUBGRADE COMPACTION TEST LOCATIONS

NOTE:

THE SUBGRADE AND THE BACKFILL COMPACTION TESTING  
FOR THE EAST DIVERSION CHANNEL TOE APRON WAS  
COMPLETED AND TESTED AS PART OF THE FILL FOR THE  
C-18 PIT BACKFILL

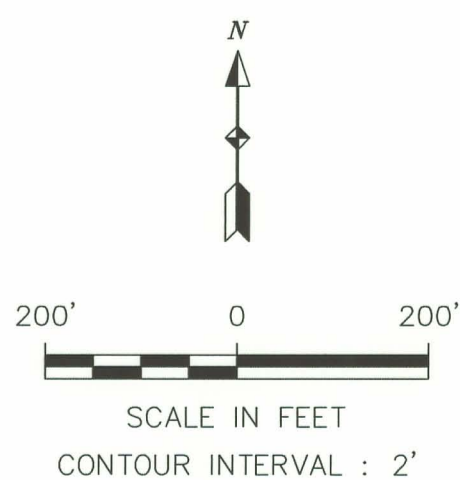

Umetco Minerals Corporation  
2754 COMPASS DRIVE, SUITE 280, GRAND JUNCTION, CO 81506

AS BUILT

A-9 REPOSITORY  
COMPACTION TEST LOCATIONS  
FROST PROTECTION LAYER  
TOE PROTECTION SUBGRADE  
AND WEST DIVERSION CHANNEL

GAS HILLS, WYOMING

DATE: JUNE 2007 DWG: GH-A9-09-AB

SHEET 9 OF 12

D-09