

#### PROFILE LEGEND:


- EXISTING GRADE 1997 AERIAL TOPOGRAPHY
- TOP OF THE CONTAMINATED FILL
- 18" RADON BARRIER
- 54" FROST PROTECTION FILL
- FINISHED GRADING OUTSIDE REPOSITORY
- 6" EROSION PROTECTION TYPE A BEDDING

#### LEGEND:

- 2000 AERIAL TOPOGRAPHY UPDATED WITH 2006 SURVEYS
- DRAINAGE PATH/PONDED WATER
- UN-PAVED ROADS
- N 794,000 UMETCO 1000' SITE GRID
- 6960 FINISH GRADE TOPOGRAPHY OF THE A-9 REPOSITORY FROST PROTECTION LAYER
- 6910 FINISH GRADE TOPOGRAPHY OF THE A-9 REPOSITORY TOE APRON EXCAVATION
- 53407 TYPE "A" RIPRAP BEDDING SURVEY VERIFICATION POINT
- LIMIT OF RADON BARRIER SOILS

#### EROSION PROTECTION

- 6-INCHES OF TYPE "A" BEDDING  
D<sub>50</sub> = 0.5 INCH

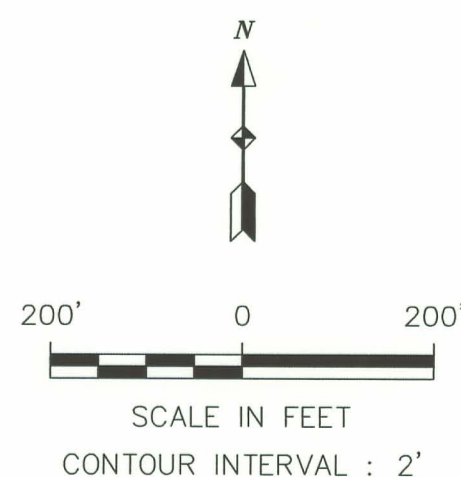

**Umetco Minerals Corporation**  
2754 COMPASS DRIVE, SUITE 280, GRAND JUNCTION, CO 81506

**AS BUILT**

**A-9 REPOSITORY  
SURVEY VERIFICATION POINTS  
TYPE "A" BEDDING  
EROSION PROTECTION PLACEMENT**

**GAS HILLS, WYOMING**

DATE: JUNE 2007 DWG: GH-A9-10-AB

SHEET 10 OF 12

D-10