



SHEET NO.	TITLE
1 OF 4	FINAL C-18 PIT RECLAMATION SITE PLAN REFLECTING POST-RECLAMATION CONSTRUCTION FINAL GRADES
2 OF 4	RECLAMATION OF THE C-18 PIT COMPACTION TEST LOCATIONS BACKFILL MATERIAL ELEVATION 6844 TO ELEVATION 6863
3 OF 4	RECLAMATION OF THE C-18 PIT COMPACTION TEST LOCATIONS BACKFILL MATERIAL ELEVATION 6864 TO ELEVATION 6883
4 OF 4	RECLAMATION OF THE C-18 PIT FINAL CONTOURS AND COMPACTION TEST LOCATIONS BACKFILL MATERIAL ELEVATION 6884 TO ELEVATION 6902

LEGEND	
	2006 FINISHED GRADE TOPOGRAPHY
	DRAINAGE PATH/PONDED WATER
	UN-PAVED ROADS
	UMETCO 1000' SITE GRID
	C-18 BOUNDARY

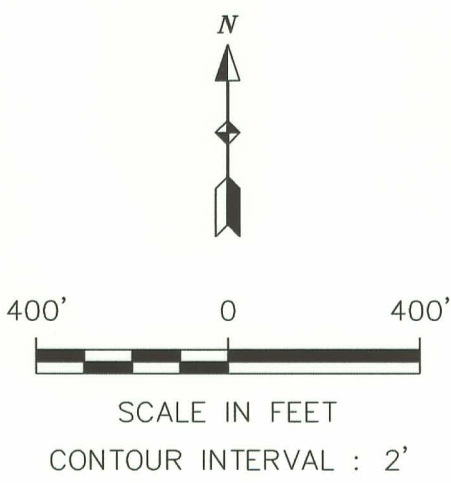

 **Umetco Minerals Corporation**
2754 COMPASS DRIVE, SUITE 280, GRAND JUNCTION, CO 81506

AS BUILT

FINAL C-18 PIT RECLAMATION
SITE PLAN
REFLECTING POST-RECLAMATION
CONSTRUCTION FINAL GRADES

GAS HILLS, WYOMING

DATE: JUNE 2007 DWS: GH-C18-01-AB SHEET 1 OF 4

D-13