




2001 COMPACTION TEST LOCATIONS
ELEVATION 6844 TO 6848

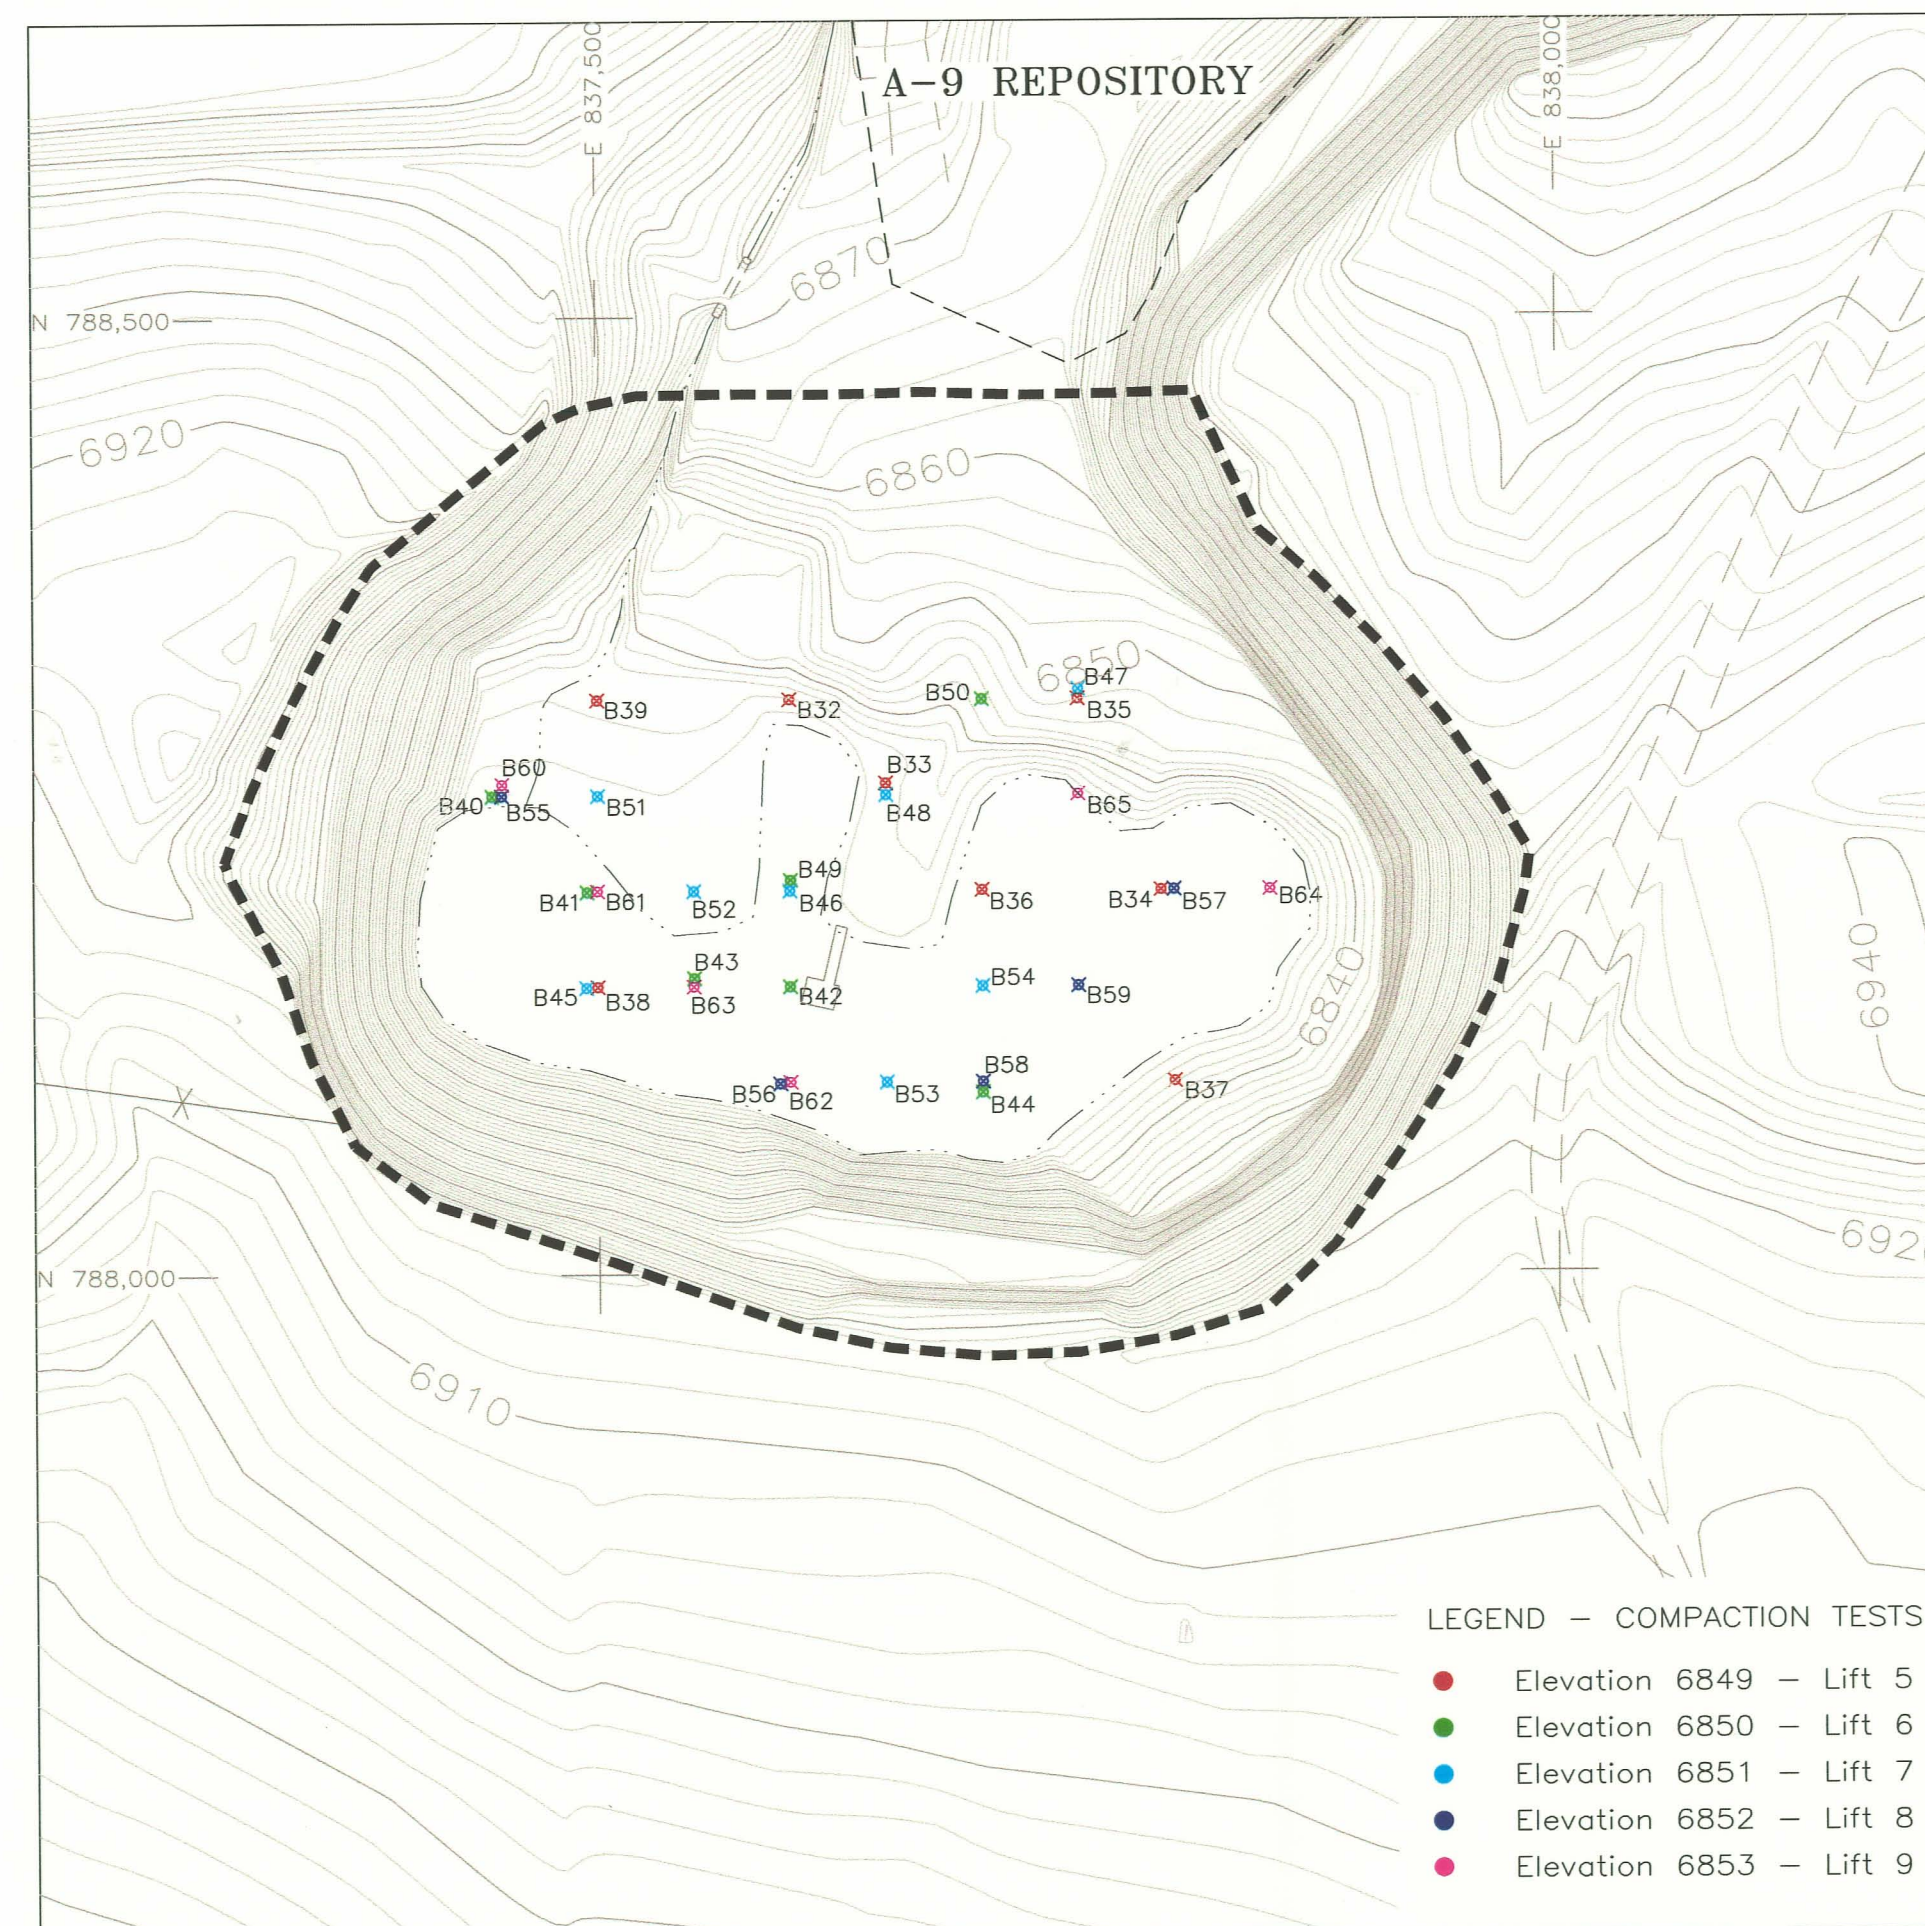


2001 COMPACTION TEST LOCATIONS
ELEVATION 6849 TO 6853

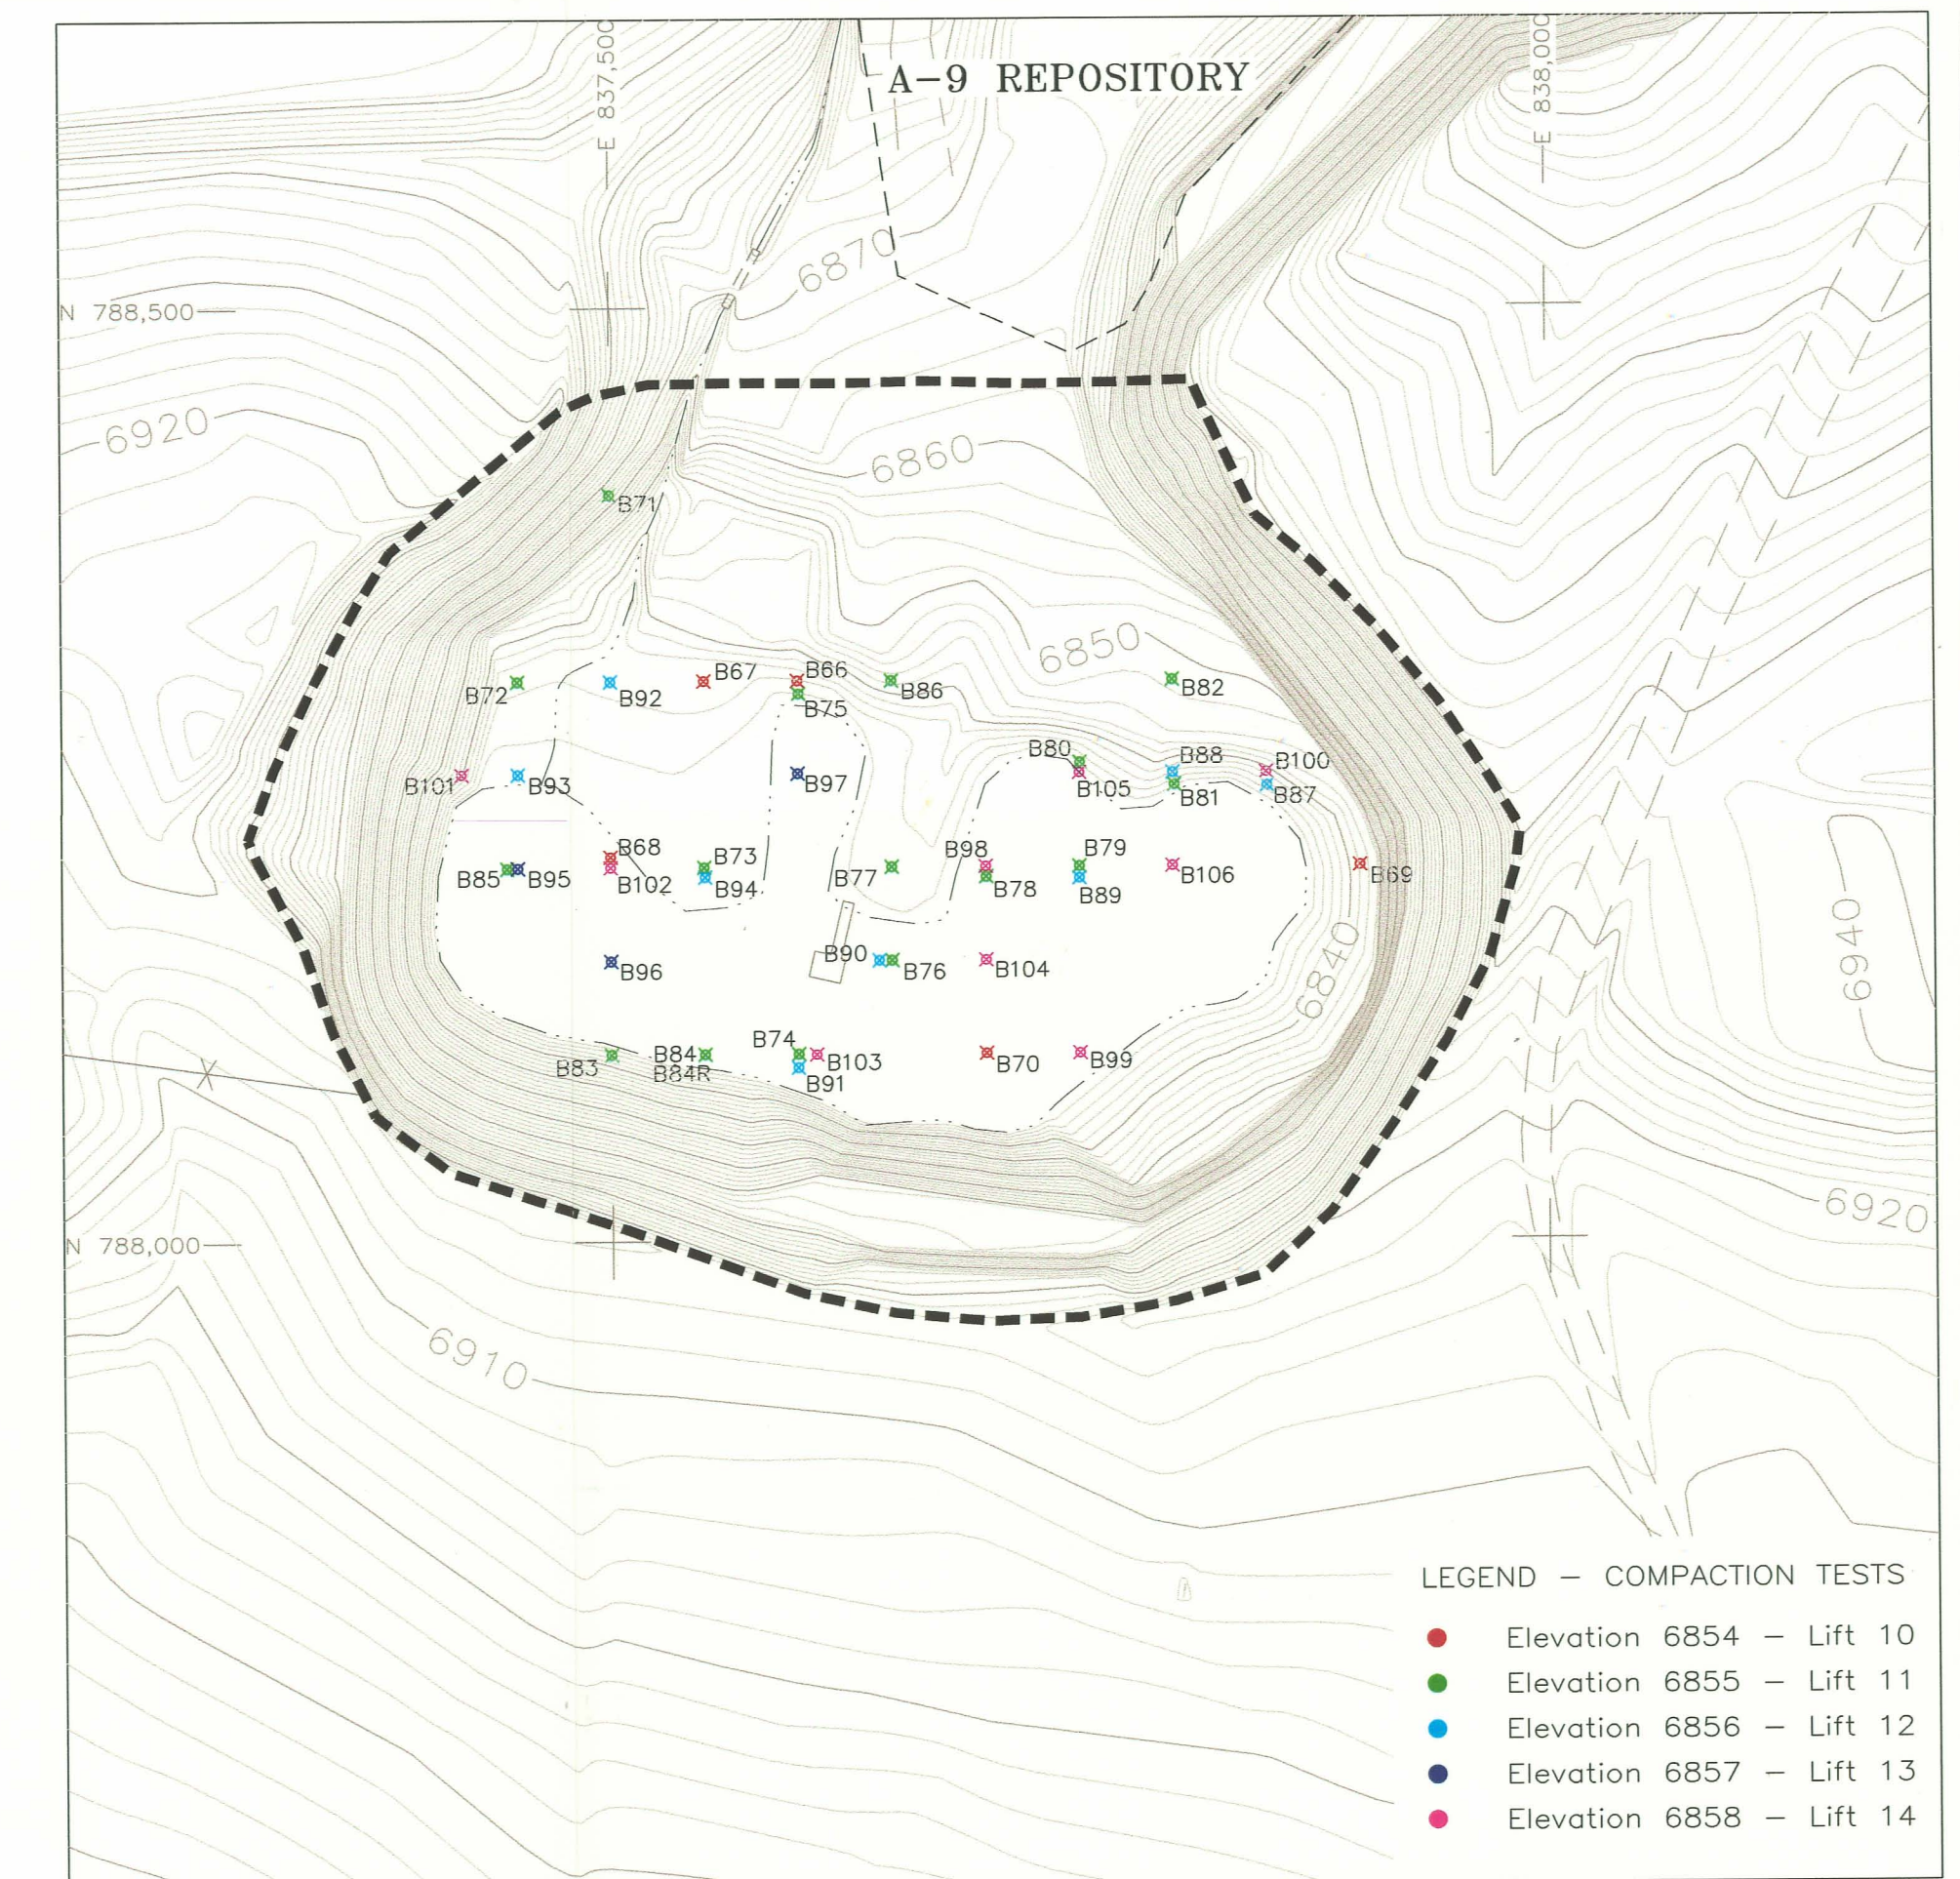



2001 COMPACTION TEST LOCATIONS
ELEVATION 6854 TO 6858

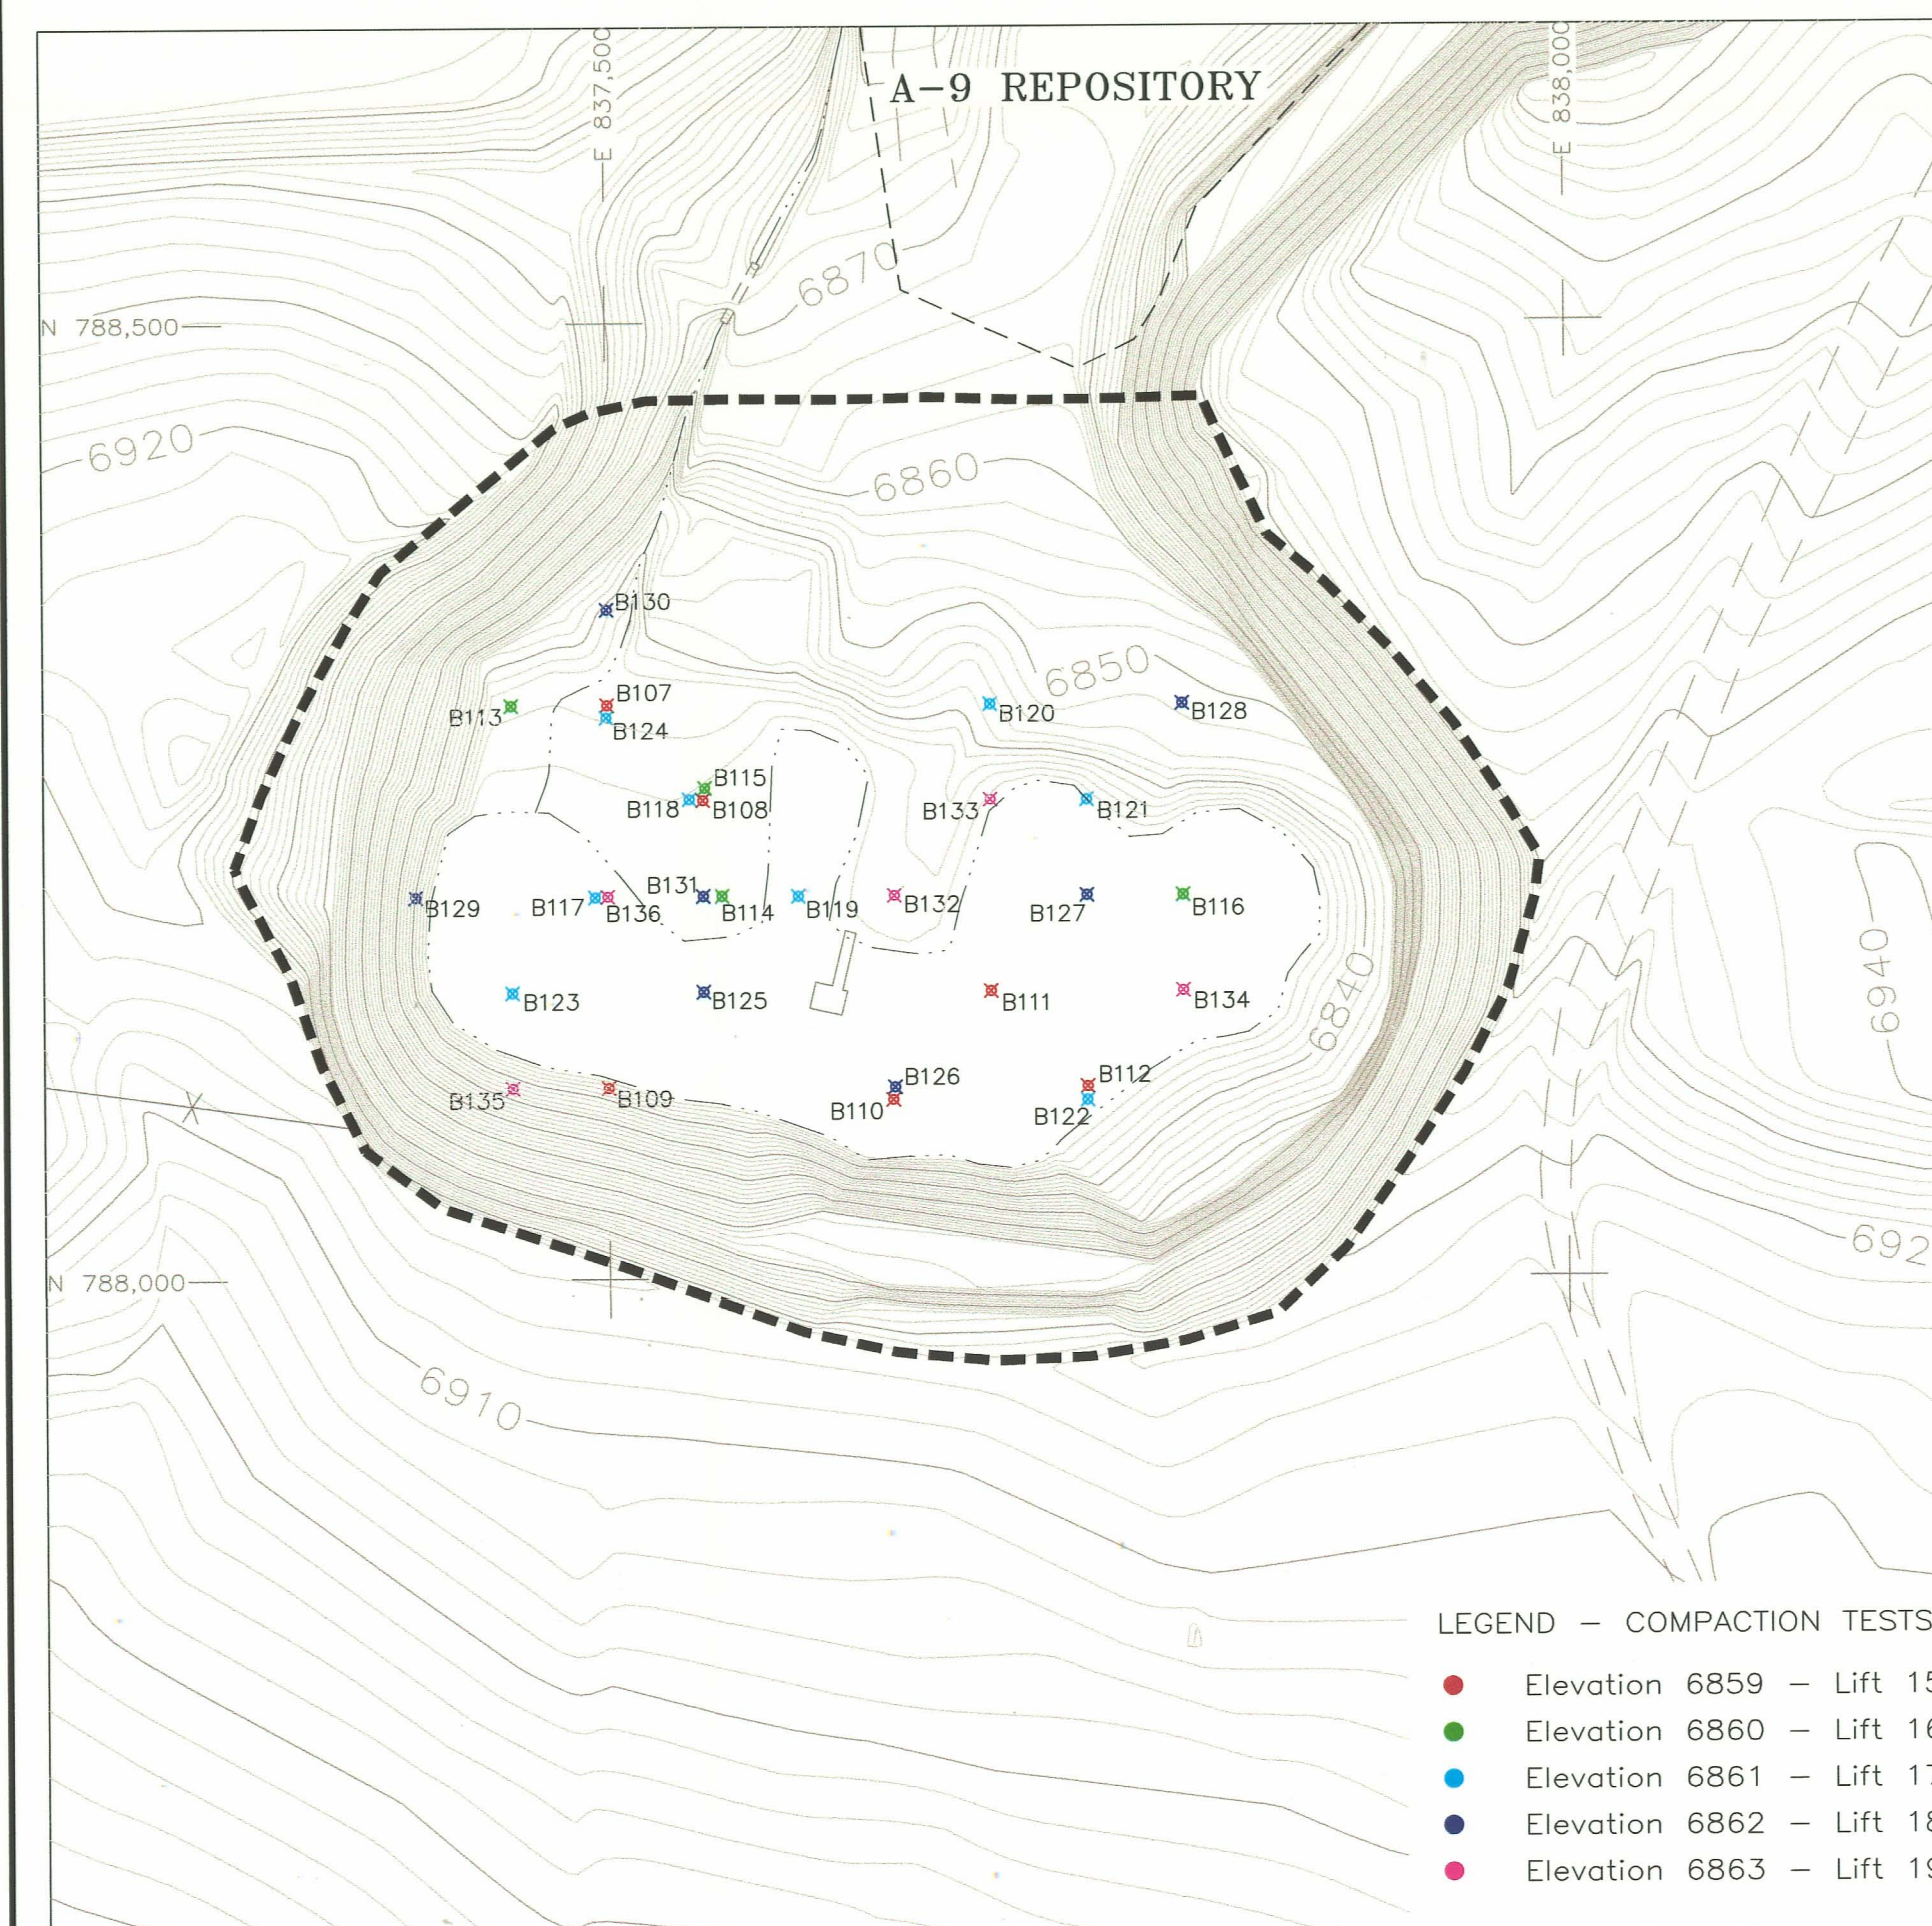


2001 COMPACTION TEST LOCATIONS
ELEVATION 6859 TO 6863

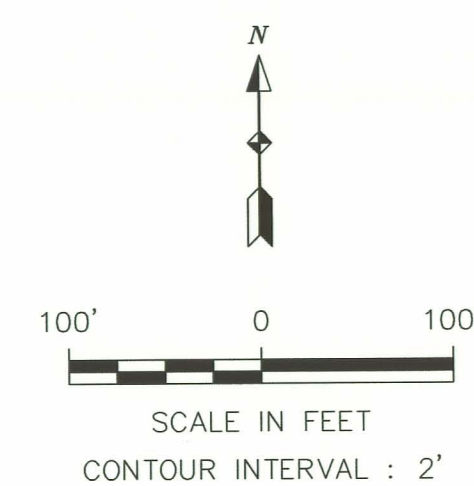

LEGEND:

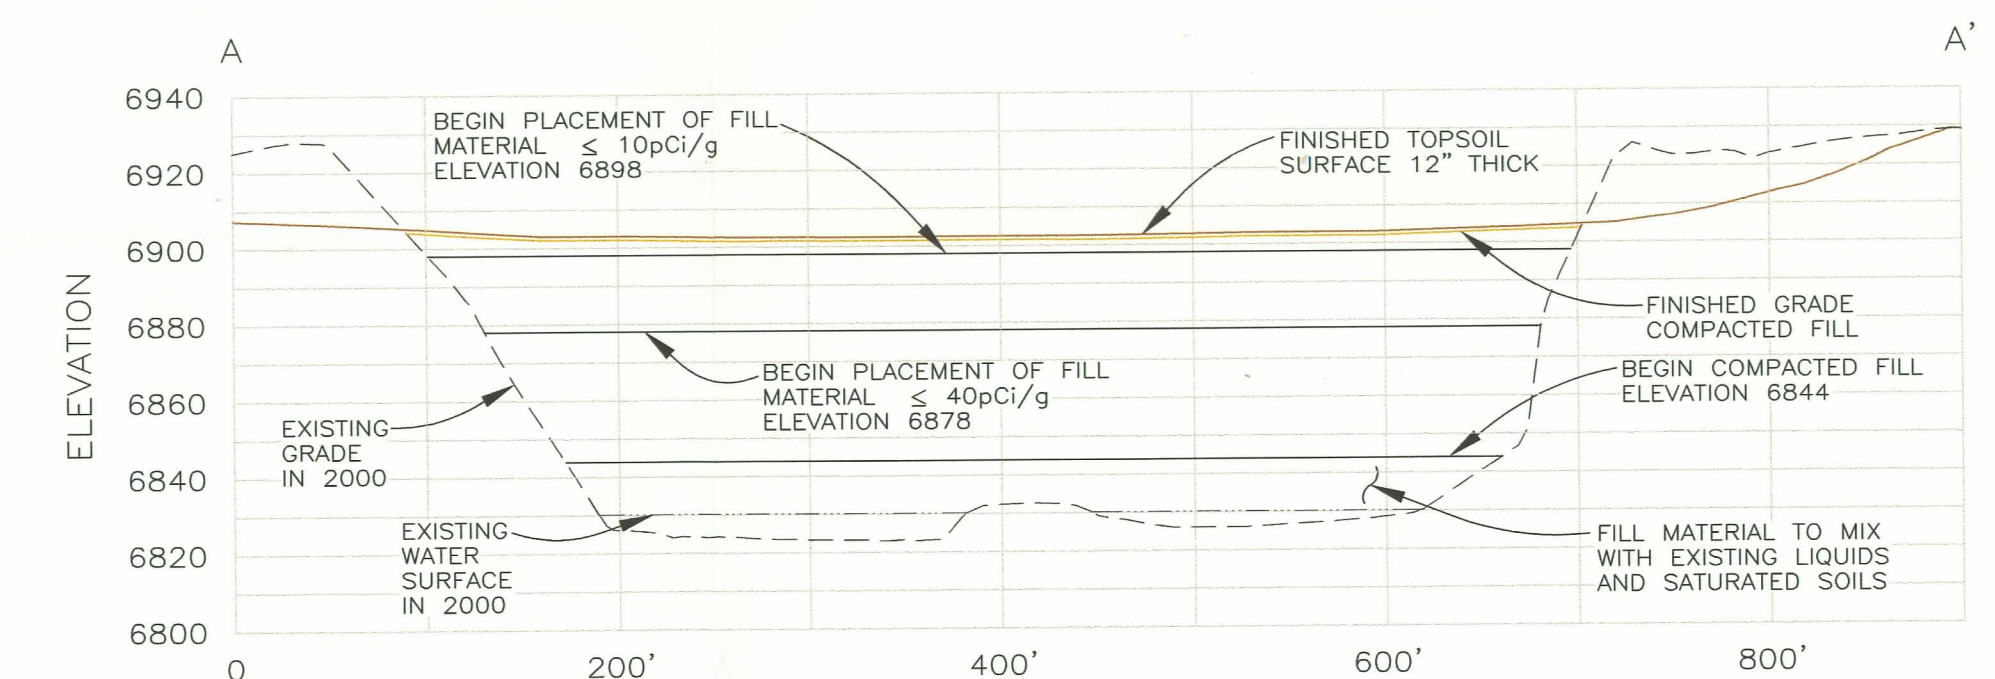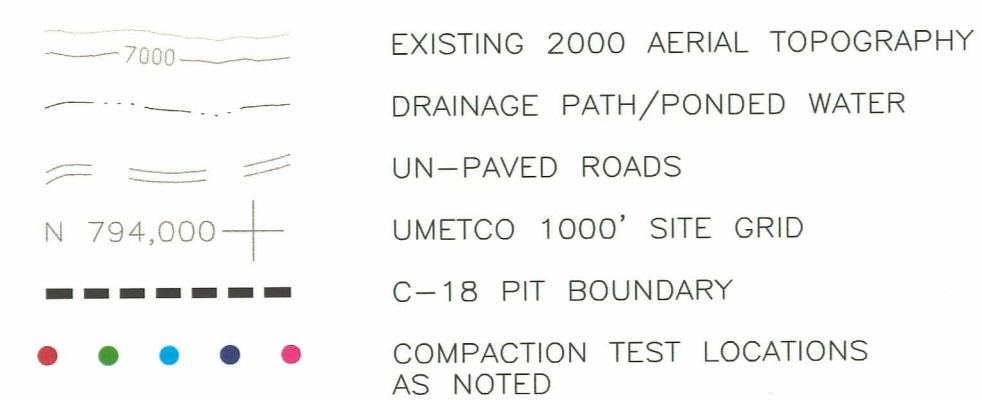

PROFILE LEGEND:

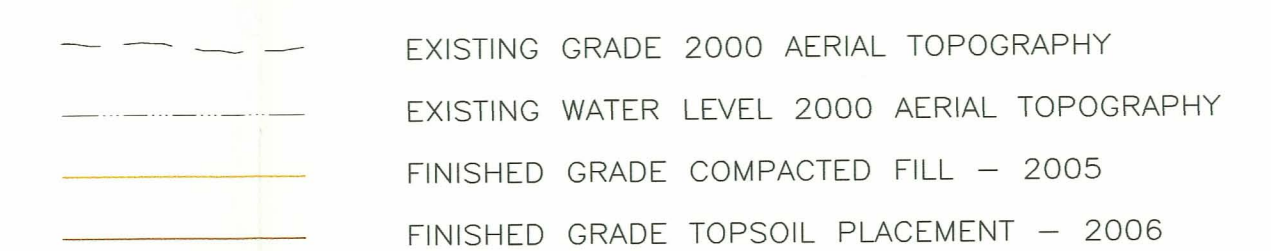

Umetco Minerals Corporation
2754 COMPASS DRIVE, SUITE 280, GRAND JUNCTION, CO 81506

AS BUILT

**RECLAMATION OF THE C-18 PIT
COMPACTION TEST LOCATIONS
BACKFILL MATERIAL
ELEVATION 6844 TO ELEVATION 6863**

GAS HILLS, WYOMING

DATE: JUNE 2007 DWG: GH-C18-02-AB

SHEET 2 OF 4

D-14