


LEGEND:

- EXISTING 1997 AERIAL TOPOGRAPHY
- DRAINAGE PATH/PONDED WATER
- UN-PAVED ROADS
- UMETCO 1000' SITE GRID
- FINISH GRADE TOPOGRAPHY
- CONTAMINATED FILL AREA
- 1997 CONTAMINATED FILL COMPACTION TEST LOCATION - FINISHED GRADE
- 1997 CONTAMINATED FILL COMPACTION TEST LOCATION - FILL AREAS TESTED IN 1-FOOT LIFTS
- 1998 CONTAMINATED FILL COMPACTION TEST LOCATION - FIRST LIFT
- 1998 CONTAMINATED FILL COMPACTION TEST LOCATION - SECOND LIFT
- 1998 CONTAMINATED FILL COMPACTION TEST LOCATION - THIRD LIFT
- 1998 CONTAMINATED FILL COMPACTION TEST LOCATION - FOURTH LIFT
- 1998 CONTAMINATED FILL COMPACTION TEST LOCATION - FIFTH LIFT
- 1998 CONTAMINATED FILL COMPACTION TEST LOCATION - LIFTS 6 THRU 8 AND FINISHED GRADE

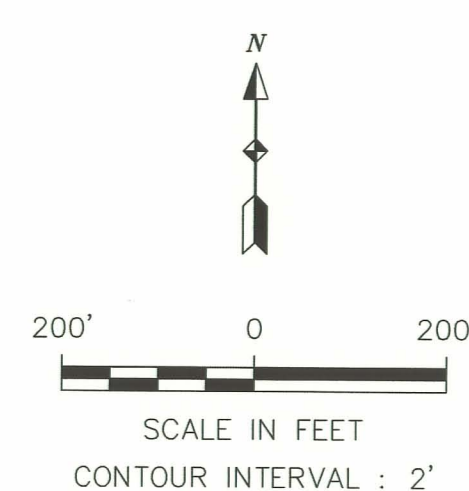

Umetco Minerals Corporation
2754 COMPASS DRIVE, SUITE 280, GRAND JUNCTION, CO 81506

AS BUILT

HEAP LEACH/GAP RECLAMATION
COMPACTION TEST LOCATIONS
CONTAMINATED FILL AREA

GAS HILLS, WYOMING