


LEGEND:

- EXISTING 1997 AERIAL TOPOGRAPHY
- DRAINAGE PATH/PONDED WATER
- UN-PAVED ROADS
- UMETCO 1000' SITE GRID
- FINISH GRADE TOPOGRAPHY
- RADON BARRIER FILL AREA
- RADON BARRIER FILL COMPACTION TEST LOCATION - FIRST LIFT
- RADON BARRIER FILL COMPACTION TEST LOCATION - SECOND LIFT
- RADON BARRIER FILL COMPACTION TEST LOCATION - THIRD LIFT

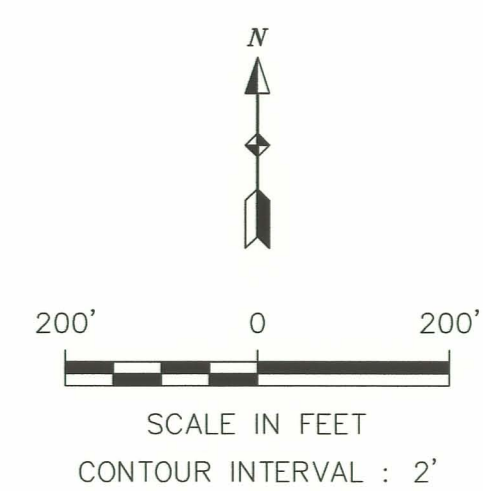

Umetco Minerals Corporation
2754 COMPASS DRIVE, SUITE 280, GRAND JUNCTION, CO 81506

AS BUILT

HEAP LEACH/GAP RECLAMATION
COMPACTION TEST LOCATIONS
RADON BARRIER FILL AREA

GAS HILLS, WYOMING