


LEGEND:

- EXISTING 1997 AERIAL TOPOGRAPHY
- DRAINAGE PATH/PONDED WATER
- UN-PAVED ROADS
- UMETCO 1000' SITE GRID
- FINISH GRADE TOPOGRAPHY
- RADON BARRIER FILL AREA
- RADON BARRIER FILL COMPACTION VISUAL DEPTH CHECK
20 = TEST LOCATION NUMBER
1.62 = MEASURED THICKNESS

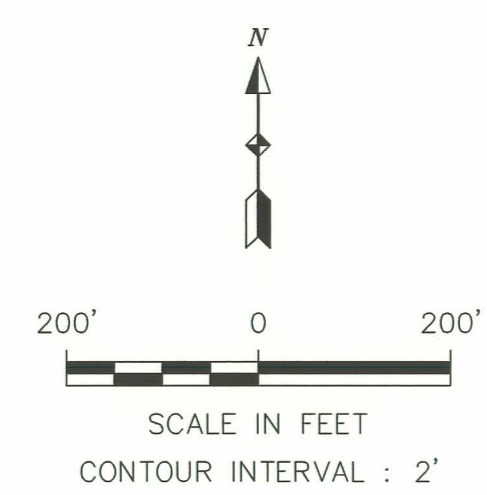

Umetco Minerals Corporation
2754 COMPASS DRIVE, SUITE 280, GRAND JUNCTION, CO 81506

AS BUILT

HEAP LEACH/GAP RECLAMATION
VISUAL DEPTH CHECK LOCATIONS
RADON BARRIER FILL AREA

GAS HILLS, WYOMING

DATE: JUNE 2007

DWG: GH-HL-07-AB

SHEET 7 OF 13

D-07