


LEGEND:

- 7000
- DRAINAGE PATH/PONDED WATER
- UN-PAVED ROADS
- UMETCO 1000' SITE GRID
- FINISH GRADE TOPOGRAPHY
- FROST PROTECTION FILL AREA
- FP001
- FP002
- FP003
- FP1000

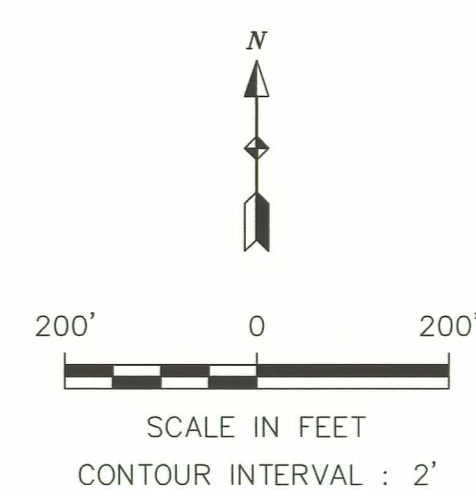

Umetco Minerals Corporation
2754 COMPASS DRIVE, SUITE 280, GRAND JUNCTION, CO 81508

AS BUILT

HEAP LEACH/GAP RECLAMATION
COMPACTION TEST LOCATIONS
FROST PROTECTION FILL AREA

GAS HILLS, WYOMING

DATE: JUNE 2007 DWS: GH-HL-09-AB

SHEET 9 OF 13

D-09