


LEGEND:

- 7000 2000 AERIAL TOPOGRAPHY
UPDATED WITH 2002 SURVEYS
- DRAINAGE PATH/PONDED WATER
- UN-PAVED ROADS
- UMETCO 1000' SITE GRID
- 6960 FINISH GRADE TOPOGRAPHY
HEAP LEACH/GAP RECLAMATION
EROSION PROTECTION PLACEMENT
- A-15
0.55 IN-PLACE VISUAL DEPTH CHECK
AND IN-PLACE GRADATION SAMPLE
C-6 = FIELD IDENTIFICATION NUMBER
1.40 = DEPTH MEASURED IN FEET
- A-45
0.52 IN-PLACE VISUAL DEPTH CHECK
A-64 = FIELD IDENTIFICATION NUMBER
0.78 = DEPTH MEASURED IN FEET
- 6-INCHES OF TYPE "A" RIPRAP
D₅₀ = 0.5 INCH
- 6-INCHES OF TYPE "B" RIPRAP D₅₀ = 3.0 INCH
WITH 6-INCHES OF TYPE "A" BEDDING D₅₀ = 0.5 INCH
- 12-INCHES OF TYPE "C" RIPRAP D₅₀ = 6.0 INCH
WITH 6-INCHES OF TYPE "A" BEDDING D₅₀ = 0.5 INCH
- BELOW GRADE APRON

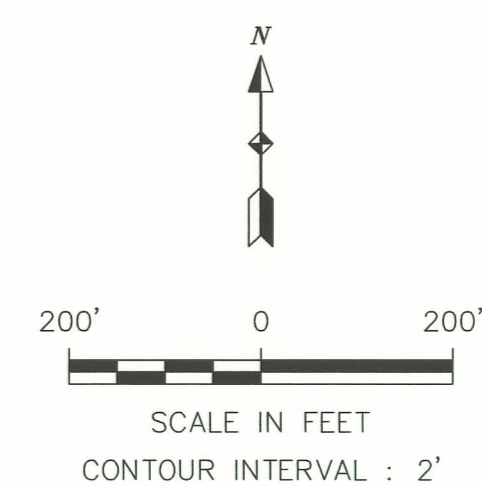

Umetco Minerals Corporation
2754 COMPASS DRIVE, SUITE 280, GRAND JUNCTION, CO 81506

AS BUILT

HEAP LEACH/GAP RECLAMATION
IN-PLACE GRADATIONS
AND VISUAL DEPTH CHECK TEST LOCATIONS
EROSION PROTECTION PLACEMENT

GAS HILLS, WYOMING

DATE: JUNE 2007

DWG: GH-HL-13-AB

SHEET 13 OF 13

D-13