




LEGEND:

- EXISTING 1997 AERIAL TOPOGRAPHY
- DRAINAGE PATH/PONDED WATER
- UN-PAVED ROADS
- UMETCO 1000' SITE GRID
- FINISH GRADE TOPOGRAPHY
- CONTAMINATED FILL AREA
- CONTAMINATED FILL COMPACTION TEST LOCATION - FINISHED GRADE
- CONTAMINATED FILL COMPACTION TEST LOCATION - FILL AREAS TESTED IN 1-FOOT LIFTS

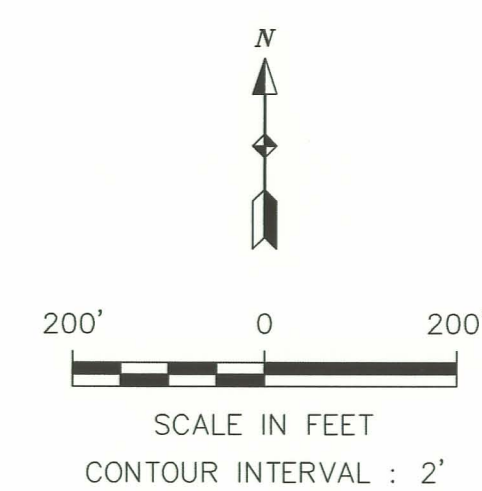

**Umetco Minerals Corporation**  
2754 COMPASS DRIVE, SUITE 280, GRAND JUNCTION, CO 81506

AS BUILT

ABOVE-GRADE TAILINGS IMPOUNDMENT  
DESIGN ENHANCEMENT  
COMPACTION TEST LOCATION  
CONTAMINATED FILL AREA

GAS HILLS, WYOMING

D-04