



- LEGEND:**
- EXISTING 1997 AERIAL TOPOGRAPHY
 - DRAINAGE PATH/PONDED WATER
 - UN-PAVED ROADS
 - UMETCO 1000' SITE GRID
 - FINISH GRADE TOPOGRAPHY
 - RADON BARRIER FILL AREA
 - RADON BARRIER FILL SURVEY VERIFICATION POINT

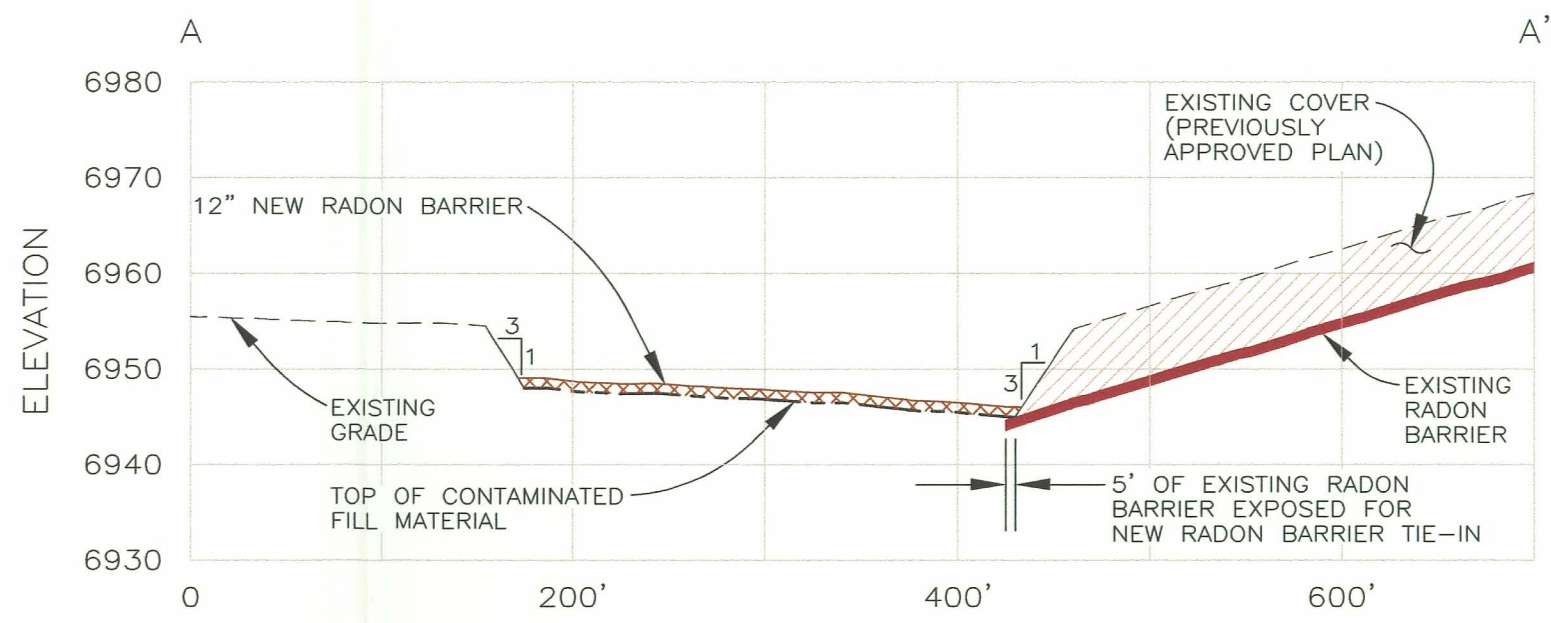


SECTION A-A'
SCALE: HORIZ. 1" = 100'
VERT. 1" = 20'

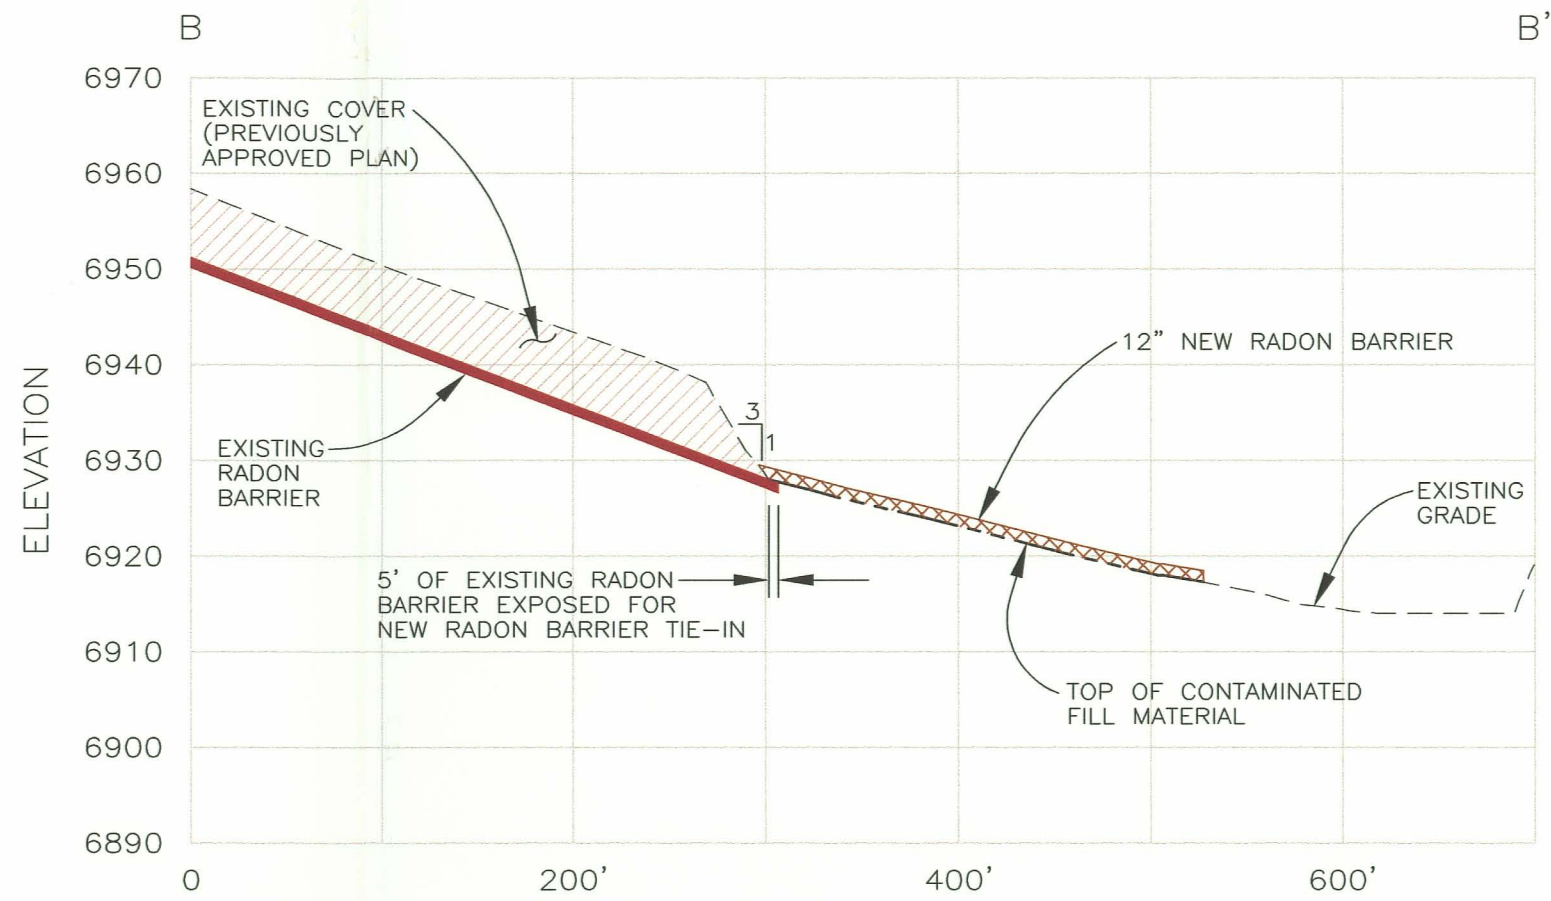

SECTION B-B'
SCALE: HORIZ. 1" = 100'
VERT. 1" = 20'

- PROFILE LEGEND:**
- EXISTING GRADE 1997 AERIAL TOPOGRAPHY
 - EXISTING RADON BARRIER
 - TOP OF THE CONTAMINATED FILL
 - 12" NEW RADON BARRIER

**Umetco Minerals Corporation**
2754 COMPASS DRIVE, SUITE 280, GRAND JUNCTION, CO 81506

AS BUILT

ABOVE-GRADE TAILINGS IMPOUNDMENT
DESIGN ENHANCEMENT
FINAL CONTOURS AND
SURVEY VERIFICATION POINTS
RADON BARRIER

GAS HILLS, WYOMING

DATE: JUNE 2007 DWG: GH-AG-05-AB SHEET 5 OF 15

D-05