




LEGEND:

- EXISTING 1997 AERIAL TOPOGRAPHY
- DRAINAGE PATH/PONDED WATER
- UN-PAVED ROADS
- UMETCO 1000' SITE GRID
- FINISH GRADE TOPOGRAPHY
- RADON BARRIER FILL AREA
- RADON BARRIER FILL COMPACTION TEST LOCATION - FIRST LIFT
- RADON BARRIER FILL COMPACTION TEST LOCATION - SECOND LIFT
- RADON BARRIER FILL VISUAL DEPTH VERIFICATION TEST LOCATION
- #46 INDICATES VISUAL DEPTH CHECK I.D.
- 1.10 INDICATES DEPTH MEASURED IN FEET

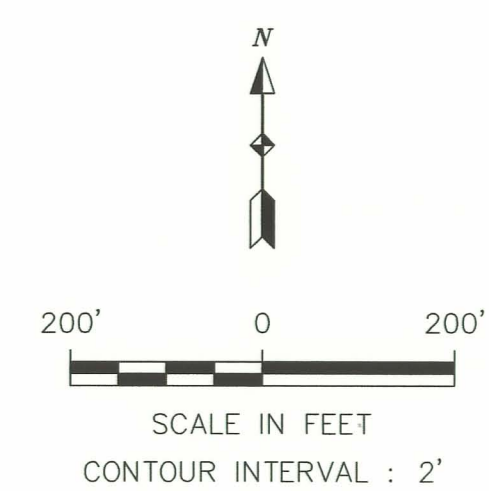

Umetco Minerals Corporation
2754 COMPASS DRIVE, SUITE 200, GRAND JUNCTION, CO 81506

AS BUILT

ABOVE-GRADE TAILINGS IMPOUNDMENT
DESIGN ENHANCEMENT
COMPACTION TEST AND
VISUAL DEPTH CHECK LOCATIONS
RADON BARRIER

GAS HILLS, WYOMING

DATE: JUNE 2007 DWR: GH-AG-06-AB

SHEET 6 OF 15

D-00