




LEGEND:

- 2000 AERIAL TOPOGRAPHY  
UPDATED WITH 2002 SURVEYS
- DRAINAGE PATH/PONDED WATER
- UN-PAVED ROADS
- UMETCO 1000' SITE GRID
- FINISH GRADE TOPOGRAPHY  
ABOVE GRADE REGRADE AND  
TOE APRON BACKFILL
- F-191 FROST PROTECTION FILL COMPACTION  
TEST LOCATION - FIRST LIFT
- F-219 FROST PROTECTION FILL COMPACTION  
TEST LOCATION - SECOND LIFT
- F-231 FROST PROTECTION FILL COMPACTION  
TEST LOCATION - THIRD LIFT
- F-421 FROST PROTECTION FILL COMPACTION  
TEST LOCATION - FOURTH LIFT
- F-523 FROST PROTECTION FILL COMPACTION  
TEST LOCATION - FIFTH LIFT

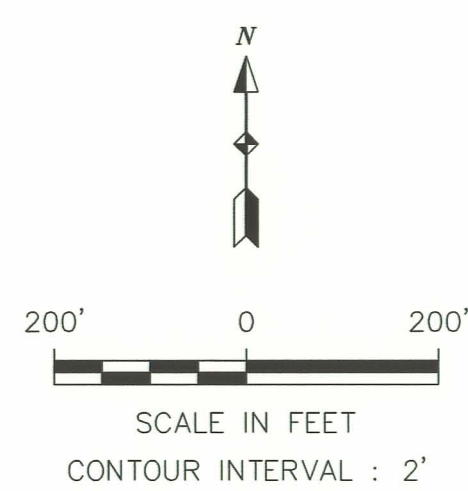

Umetco Minerals Corporation  
2754 COMPASS DRIVE, SUITE 280, GRAND JUNCTION, CO 81506

AS BUILT

ABOVE-GRADE TAILINGS IMPOUNDMENT  
DESIGN ENHANCEMENT  
1999 COMPACTION TEST LOCATIONS  
FROST PROTECTION LAYER

GAS HILLS, WYOMING