


LEGEND:

- 2000 AERIAL TOPOGRAPHY  
UPDATED WITH 2002 SURVEYS
- DRAINAGE PATH/PONDED WATER
- UN-PAVED ROADS
- UMETCO 1000' SITE GRID
- FINISH GRADE TOPOGRAPHY  
ABOVE GRADE REGRADE AND  
TOE APRON BACKFILL
- F-761 FROST PROTECTION FILL COMPACTION  
TEST LOCATION - FIRST LIFT
- F-772 FROST PROTECTION FILL COMPACTION  
TEST LOCATION - SECOND LIFT
- F-784 FROST PROTECTION FILL COMPACTION  
TEST LOCATION - THIRD LIFT
- F-835 FROST PROTECTION FILL COMPACTION  
TEST LOCATION - FOURTH LIFT
- F-873 FROST PROTECTION FILL COMPACTION  
TEST LOCATION - FIFTH LIFT
- F-884 FROST PROTECTION FILL COMPACTION  
TEST LOCATION - LIFTS 6 THRU 9

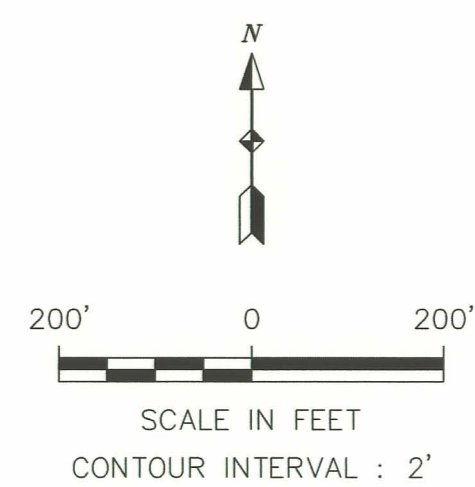

Umetco Minerals Corporation  
2754 COMPASS DRIVE, SUITE 280, GRAND JUNCTION, CO 81506

AS BUILT

ABOVE-GRADE TAILINGS IMPOUNDMENT  
DESIGN ENHANCEMENT  
2000 COMPACTION TEST LOCATIONS  
FROST PROTECTION LAYER

GAS HILLS, WYOMING

DATE: JUNE 2007

DWG: GH-AG-09-AB

SHEET 9 OF 15

D-09