


LEGEND:

- 2000 AERIAL TOPOGRAPHY  
UPDATED WITH 2002 SURVEYS
- DRAINAGE PATH/PONDED WATER
- UN-PAVED ROADS
- UMETCO 1000' SITE GRID
- FINISH GRADE TOPOGRAPHY  
ABOVE GRADE REGRADE AND  
TOE APRON BACKFILL
- COMPACTION TEST LOCATIONS  
REGRADE OF THE PREVIOUSLY  
RECLAIMED IMPOUNDMENT
- COMPACTION TEST LOCATIONS  
TOE APRON BACKFILL
- COMPACTION TEST LOCATIONS  
EAST CANYON CREEK REALIGNMENT  
FILL AREA
- FIRST LIFT - COMPACTION TEST LOCATIONS
- SECOND LIFT - COMPACTION TEST LOCATIONS
- THIRD LIFT - COMPACTION TEST LOCATIONS
- FOURTH LIFT - COMPACTION TEST LOCATIONS
- FIFTH LIFT - COMPACTION TEST LOCATIONS
- SIXTH LIFT - COMPACTION TEST LOCATIONS
- SEVENTH LIFT - COMPACTION TEST LOCATIONS
- FINISHED GRADE - COMPACTION TEST LOCATIONS

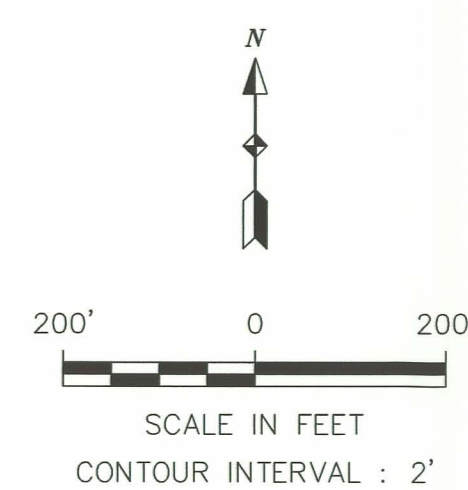

Umetco Minerals Corporation  
2754 COMPASS DRIVE, SUITE 280, GRAND JUNCTION, CO 81506

AS BUILT

ABOVE-GRADE TAILINGS IMPOUNDMENT  
DESIGN ENHANCEMENT  
COMPACTION TEST LOCATIONS TOE APRON BACKFILL  
REGRADE OF PREVIOUSLY RECLAIMED IMPOUNDMENT  
AND EAST CANYON CREEK REALIGNMENT FILL AREA

GAS HILLS, WYOMING

DATE: JUNE 2007 DWG: GH-AG-13-AB

SHEET 13 OF 15

D-13