

1. FOR LOCATION OF LOUVERS AND FAN OPENINGS SEE ARCHITECTURAL DWG'S.
2. FOR PLATFORM DETAILS SEE STRUCTURAL DWG'S.
3. DUCTWORK FABRICATION AND HANGER DETAILS SHALL BE IN ACCORDANCE WITH SMACNA RECOMMENDATIONS FOR LOW PRESSURE DUCTWORK. 90° ELBOWS TO BE EQUIPPED WITH TURNING VANES.
4. CONTR. TO INSTALL STIFFENERS AROUND DUCT OPENING AS REQUIRED.

REFERENCE DRAWINGS:

- M-112 HEATING AND VENTILATION TURBINE BUILDING PLAN EL. 607'-6"
- M-114 HEATING AND VENTILATION TURBINE BUILDING SECTIONS
- M-113 HEATING AND VENTILATION TURBINE AUXILIARY AND CONTAINMENT PLAN EL. 607'-6" AND 611'-0"
- A-211 HEATING AND VENTILATION TURBINE BUILDING MISCELLANEOUS DETAILS
- M-213 PIPING AND INSTRUMENT DIAGRAM CONTROL ROOM HEATING, VENTILATION & AIR CONDITIONING.
- M-121 SH. 3 VENTILATION FOR POST ACCIDENT MONITORING G.E.M. ENCLOSURE.
- M-1047 HEATING & VENTILATION TURBINE BLDG.

REVISIONS

NO.	DATE	REVISIONS	BY	CHKD.	APPD.	PROJ. CHIEF
1	10/16/85	CHG'D TEMP. SWITCH LOC. PER ENG. WALKDOWN	R	J		
2	4/21/85	ADDED DUCT NOTE 4 AND REF. DWG. M-121 GND. TMS. VERIFIED AS INSTALLED & INCORP. FDCR NO. N-1015 CHANGES	C	J		
3	4/21/85	ADDED NOTE 3 PER FCN NO. M-221 SEC. A FLOWERS DUCT WORK PLAN T-397, GND. TMS. FCN M-68, FCN 214.3	C	J		
4	4/18/85	ISSUED FOR RECORD - REVISED TO INCORPORATE SUBS. JOB 12447-057/GND. 9052	B	J		
5	9/28/86	CHANGED DIMENSION AT COORDINATES E-8	L	ERL		
6	2-20/86	ADDED FIRST AID COUNTING RM PER FC 286 FOR RECORD.	L	ERL		
7	6-21/86	ADDED WARNING PER 0-194-33-2506				
8	8-30/88	REVISED TS-1825, 1856 & 1887 TO TS-1890, 1891 & 1892 PER 950 88 518 (22)	J	R		
9	6-10-86	ADDED REFERENCE TO M-1047	C	R		



BECHTEL COMPANY

PALISADES PLANT  
CONSUMERS POWER COMPANY

HEATING & VENTILATION  
TURBINE BUILDING  
PLAN OF ELEV. 625'-0"

JOB No.	DRAWING No.	REV.
5935	M-113	11

WARNING  
ENERGIZED WIRING PRESENT IN DUCTWORK  
ELECTRIC SHOCK POTENTIAL

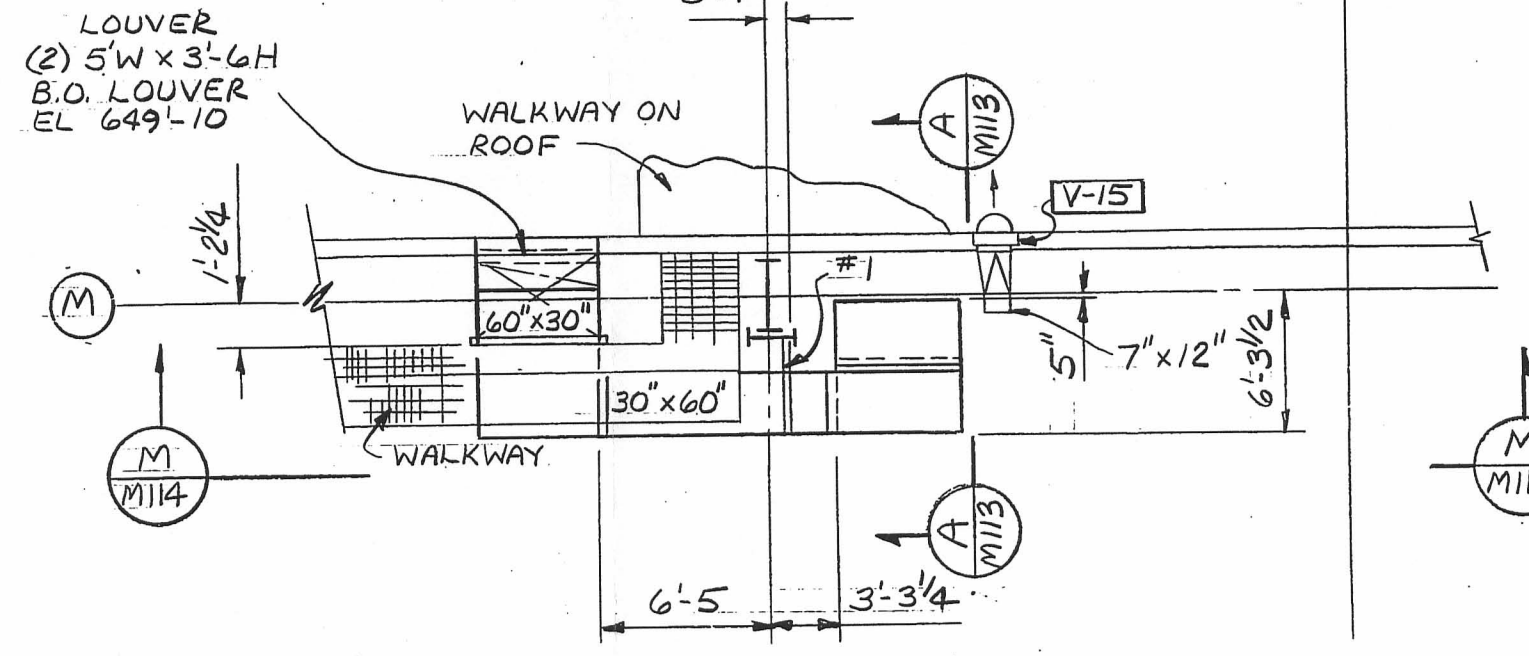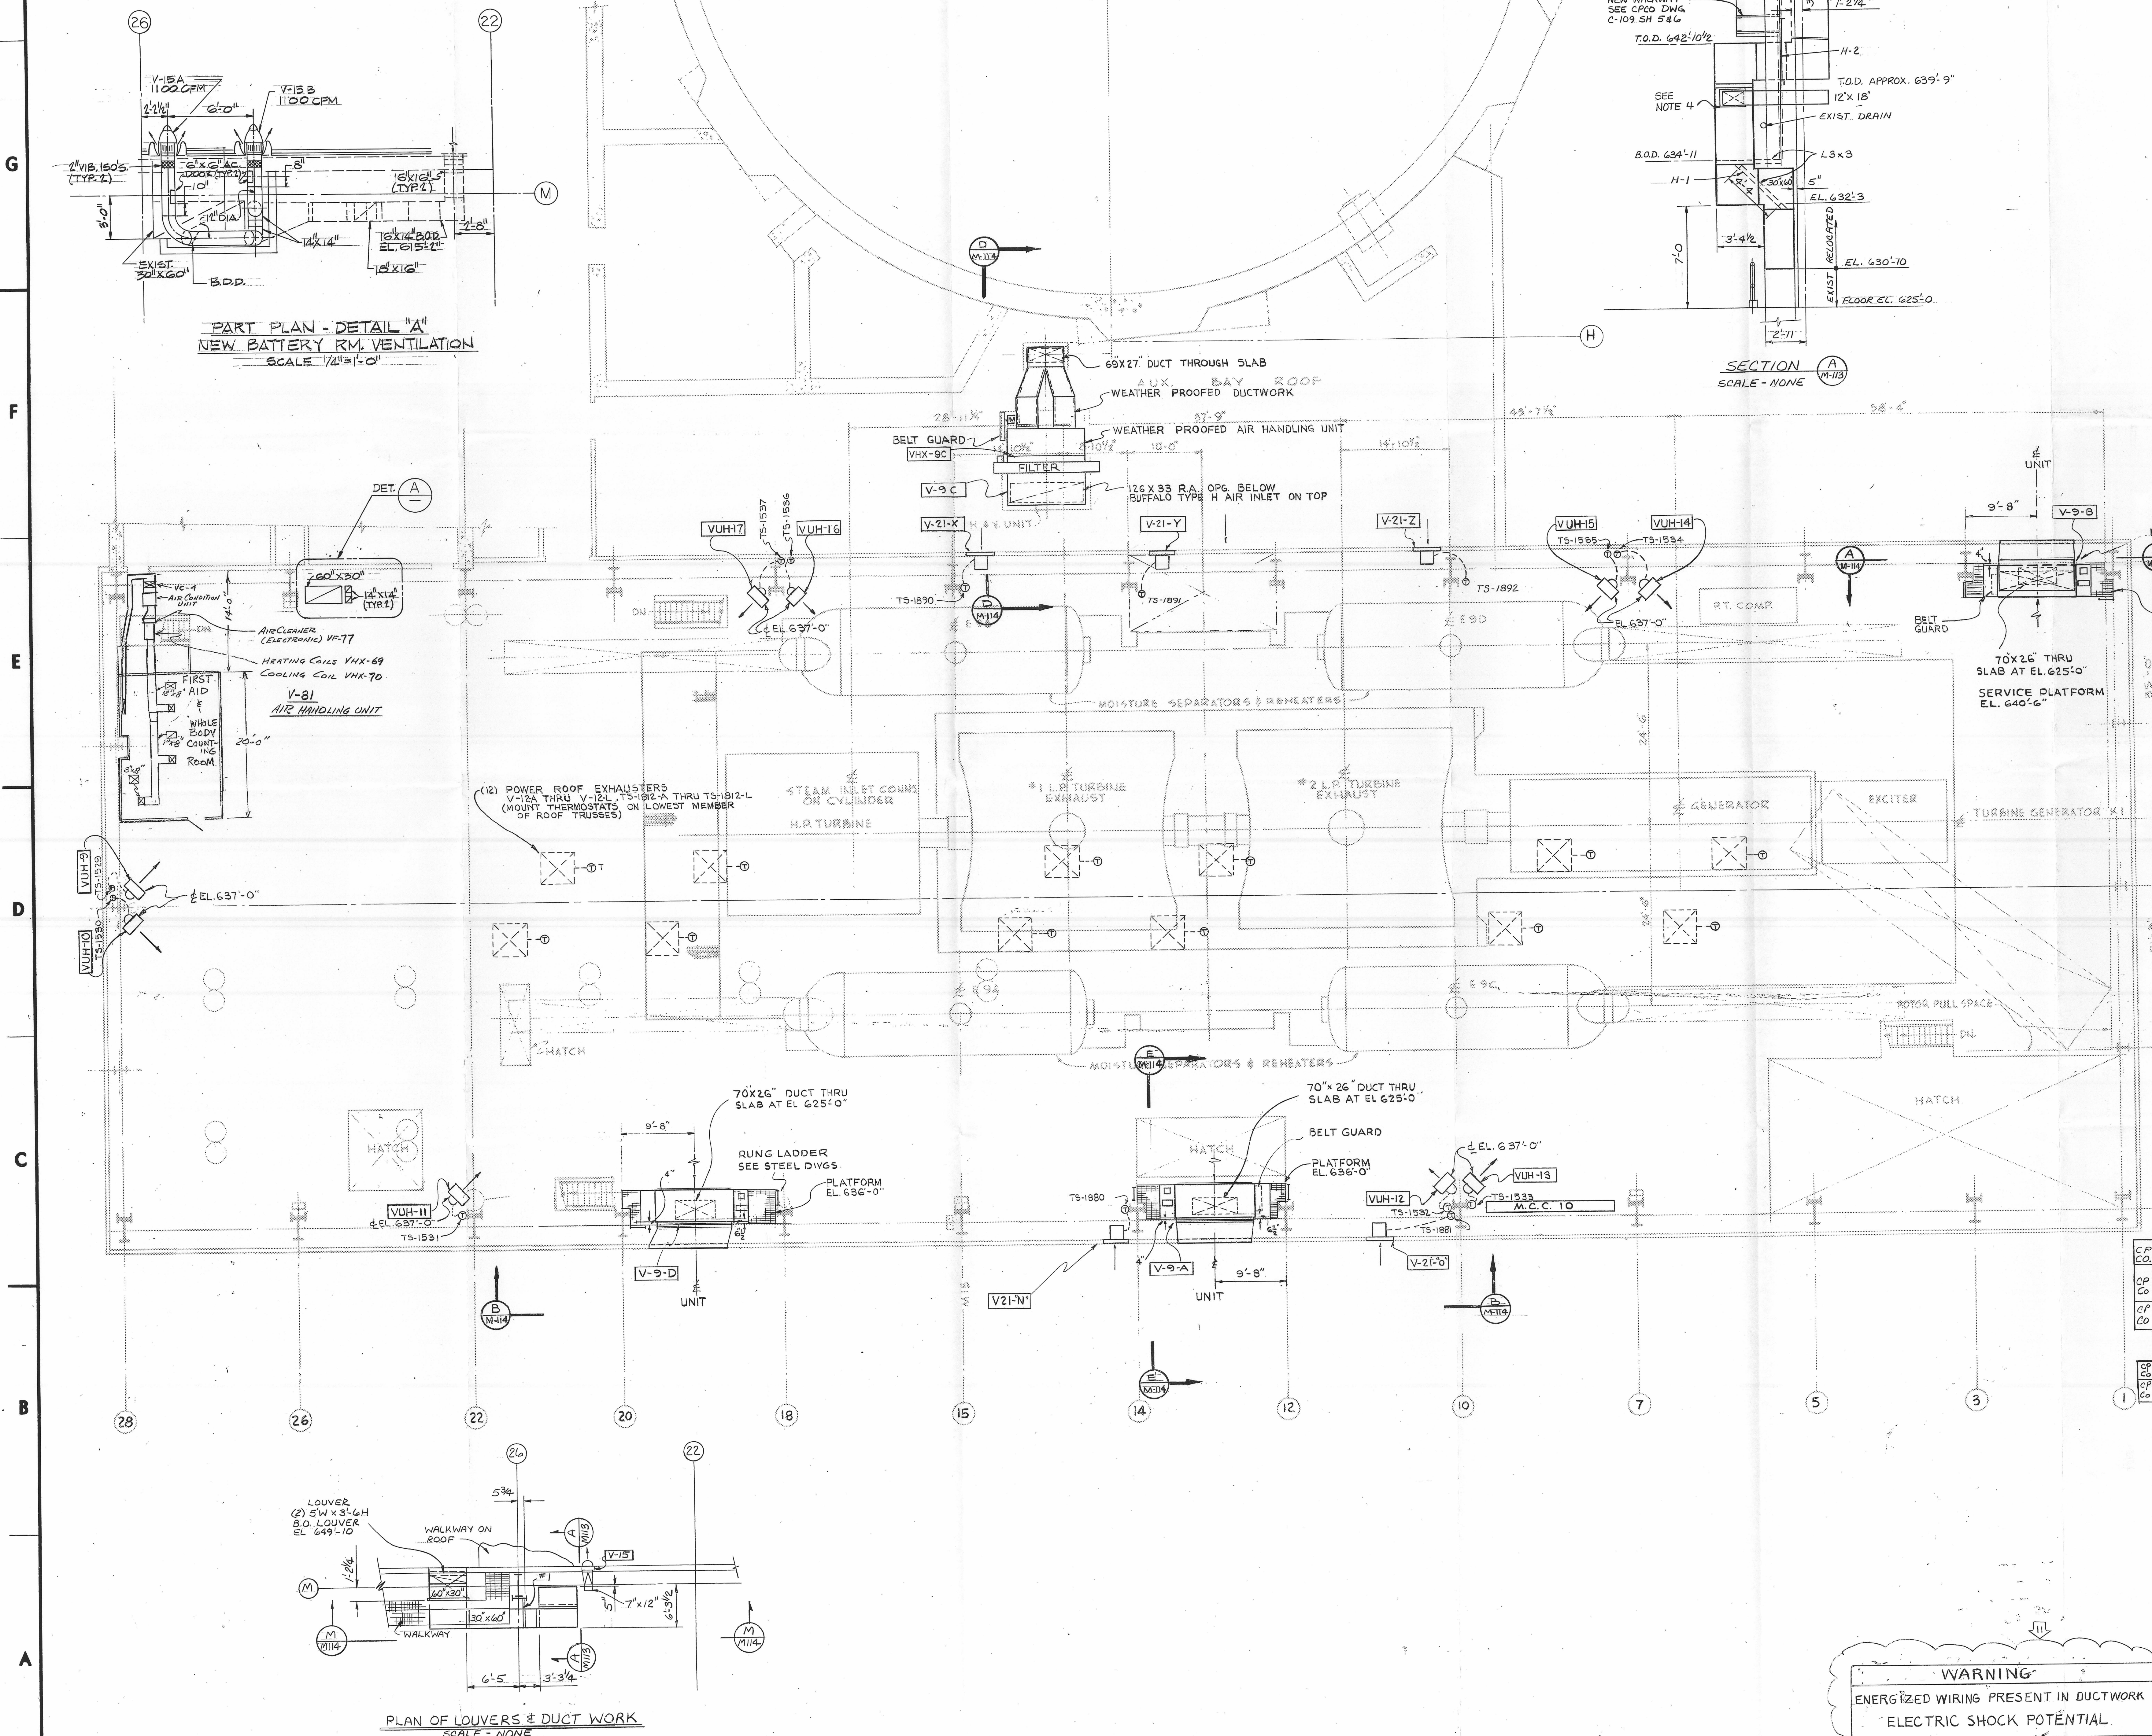

PLAN OF LOUVERS & DUCT WORK  
SCALE - NONE

PART PLAN - DETAIL "A"  
NEW BATTERY RM. VENTILATION  
SCALE 1/4"=1'-0"

SECTION  
SCALE - NONE