
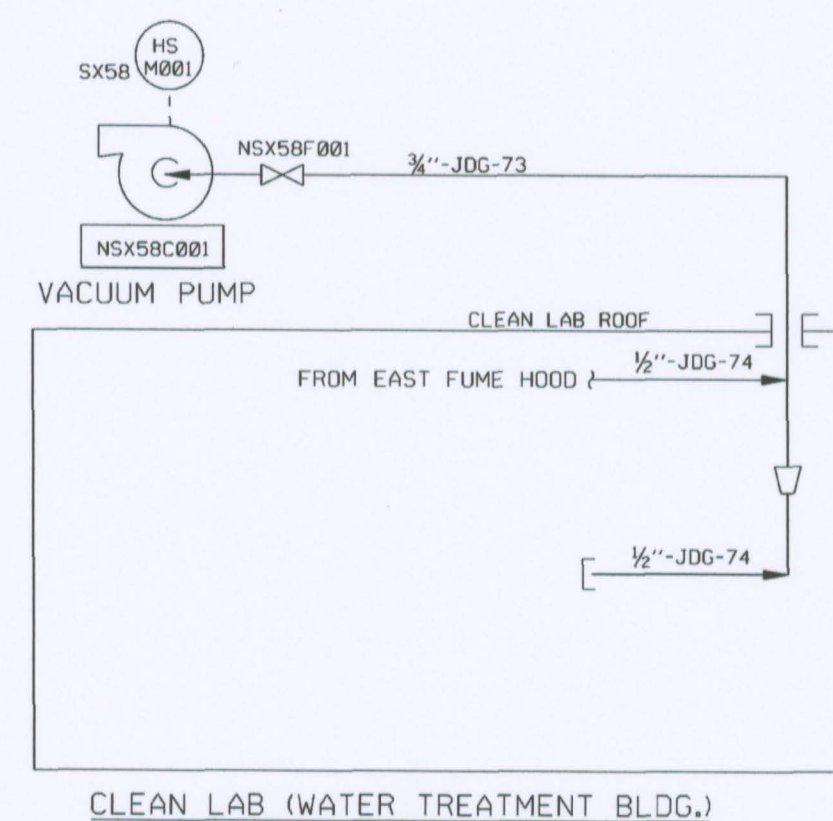


PLANT SERVICE WATER RADIAL WELL WEATHERPROOF ENCLOSURE						
RADIAL WELL	EQUIPMENT NUMBER	EQUIPMENT	INSTRUMENTATION			
			HS N002 *	TSL N002 *		
1	NSY56B001A-N	UNIT HEATER	SY56	SY56		
	NSY56B001B-N		A	A		
	NSY56B001C-N		B	B		
	NSY56B001D-N		C	C		
3	NSY56B001E-N		D	D		
	NSY56B001F-N		E	E		
	NSY56B001G-N		F	F		
	NSY56B001H-N		G	G		
5	NSY56B001I-N	H	H			
	NSY56B001J-N	J	J			
RADIAL WELL	EQUIPMENT NUMBER	EQUIPMENT	HS N001 *	TSH N003 *	TS N001	N001
			SY56	SY56	SY56	SY56
1	NSY56C001A-N	PLANT RADIAL WELL POWER WALL VENTILATORS	A	A	A	A
3	NSY56C001B-N		B	B	B	B
5	NSY56C001C-N		C	C	C	C

RADIAL WELL	EQUIPMENT NUMBER	EQUIPMENT
1	NSY56Y701A-N	INTAKE LOUVERS
3	NSY56Y701B-N	
5	NSY56Y701C-N	
1	NSY56Y702A-N	EXHAUST LOUVERS
3	NSY56Y702B-N	
5	NSY56Y702C-N	

RADIAL WELL	EXHAUST FAN	EXHAUST LOUVER	INTAKE LOUVERS	INSTRUMENTATION			CEILING HEATER
				HS	TSH (FIRESTAT)	TSL	
1	NSY56C003A-N	NSY56Y703A-N	NSY56Y704A-N NSY56Y705A-N NSY56Y706A-N	NSY56B004A NSY56B005A NSY56B006A	NSY56N007A	NSY56N008A	NSY56B002L-N
3	NSY56C003B-N	NSY56Y703B-N	NSY56Y704B-N NSY56Y705B-N NSY56Y706B-N	NSY56B004B NSY56B005B NSY56B006B	NSY56N007B	NSY56N008B	NSY56B002M-N
5	NSY56C003C-N	NSY56Y703C-N	NSY56Y704C-N NSY56Y705C-N NSY56Y706C-N	NSY56B004C NSY56B005C NSY56B006C	NSY56N007C	NSY56N008C	NSY56B002P-N

FIRE WATER PUMPHOUSE UNIT HEATERS INSTRUMENTATION	
EQUIPMENT NUMBER	TSL
B001-N	N001A
B002-N	N001B
B003-N	N002A
B004-N	N002B
B005-N	N003A
B006-N	N003B

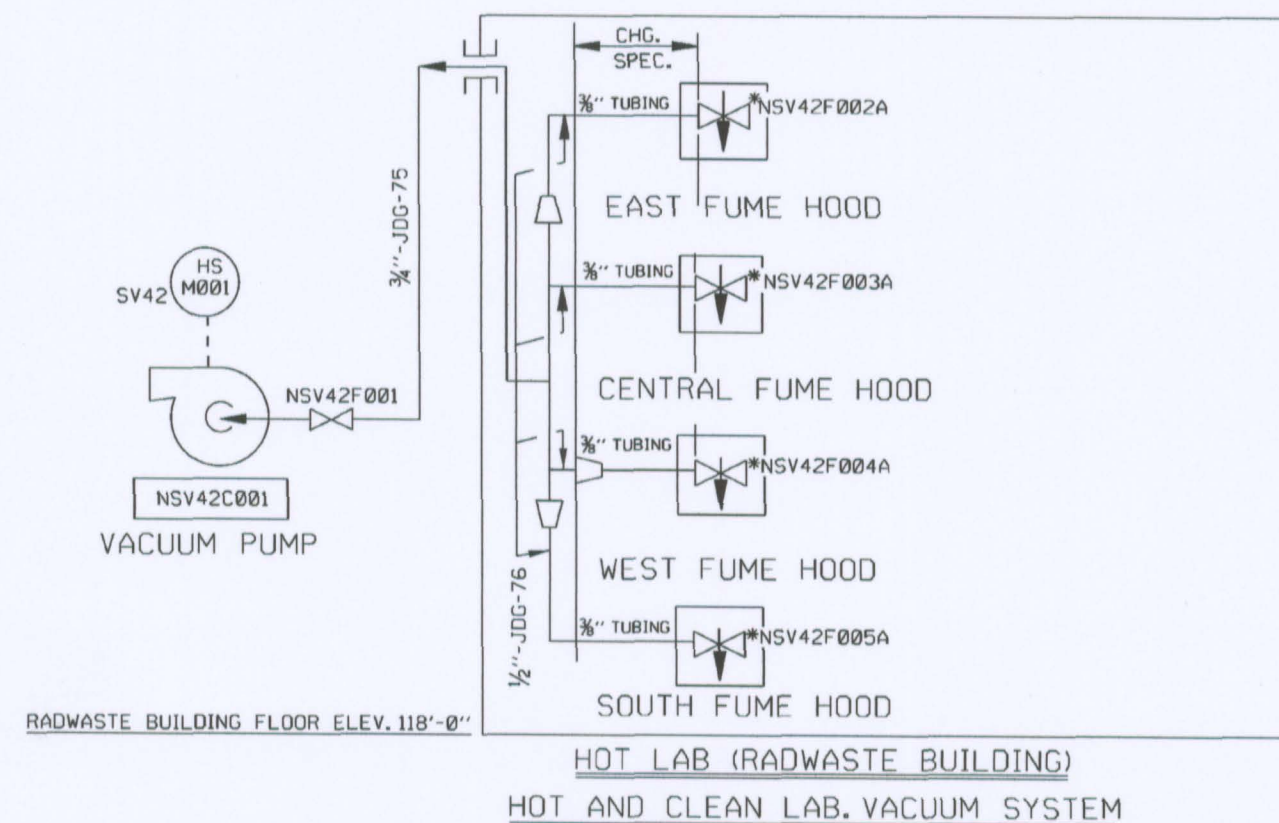

- NOTES:
- FOR HVAC LEGEND SEE M-0047A.
  - ALL PIPING 2" AND SMALLER IS CLASSIFIED AS III-1/2" RADIATION LEVEL.
  - ALL EQUIPMENT NUMBERS ON THIS DRAWING ARE PREFIXED BY NSY67 UNLESS OTHERWISE NOTED.
  - ALL INSTRUMENT NUMBERS ON DWG. M-0051A ARE PREFIXED BY SY67 UNLESS OTHERWISE NOTED. ALL INSTRUMENT NUMBERS ON DWG. M-0051B ARE PREFIXED BY SX57 UNLESS OTHERWISE NOTED.

018	AS-BUILT PER DRN 05-1077	SP	N/A	N/A	WE	11-23-2005
017	AS-BUILT PER DRN 05-42	WE	N/A	N/A	BA	10-15-2003
<b>GRAND GULF NUCLEAR STATION</b> UNIT 1 NUCLEAR PLANT ENGINEERING <b>UPDATED FINAL SAFETY ANALYSIS REPORT</b> FIGURE NUMBER - 9.4-014 P & I DIAGRAM MISC. BLDGS. VENT SYSTEM UNIT 1 SCALE: NONE DRAWING No. M-0051A REV. 018						

COMPONENTS SUBJECT TO AMR

HEATING, VENTILATION AND AIR CONDITIONING SYSTEMS AMM17

0	9-29-2011					
NO.	DATE	DESCRIPTION	BY	ENG	CHK	APP
REVISIONS						
LRA-M-0051A						
CAD FILE m0051a.DGN						
PLOT FILE						