
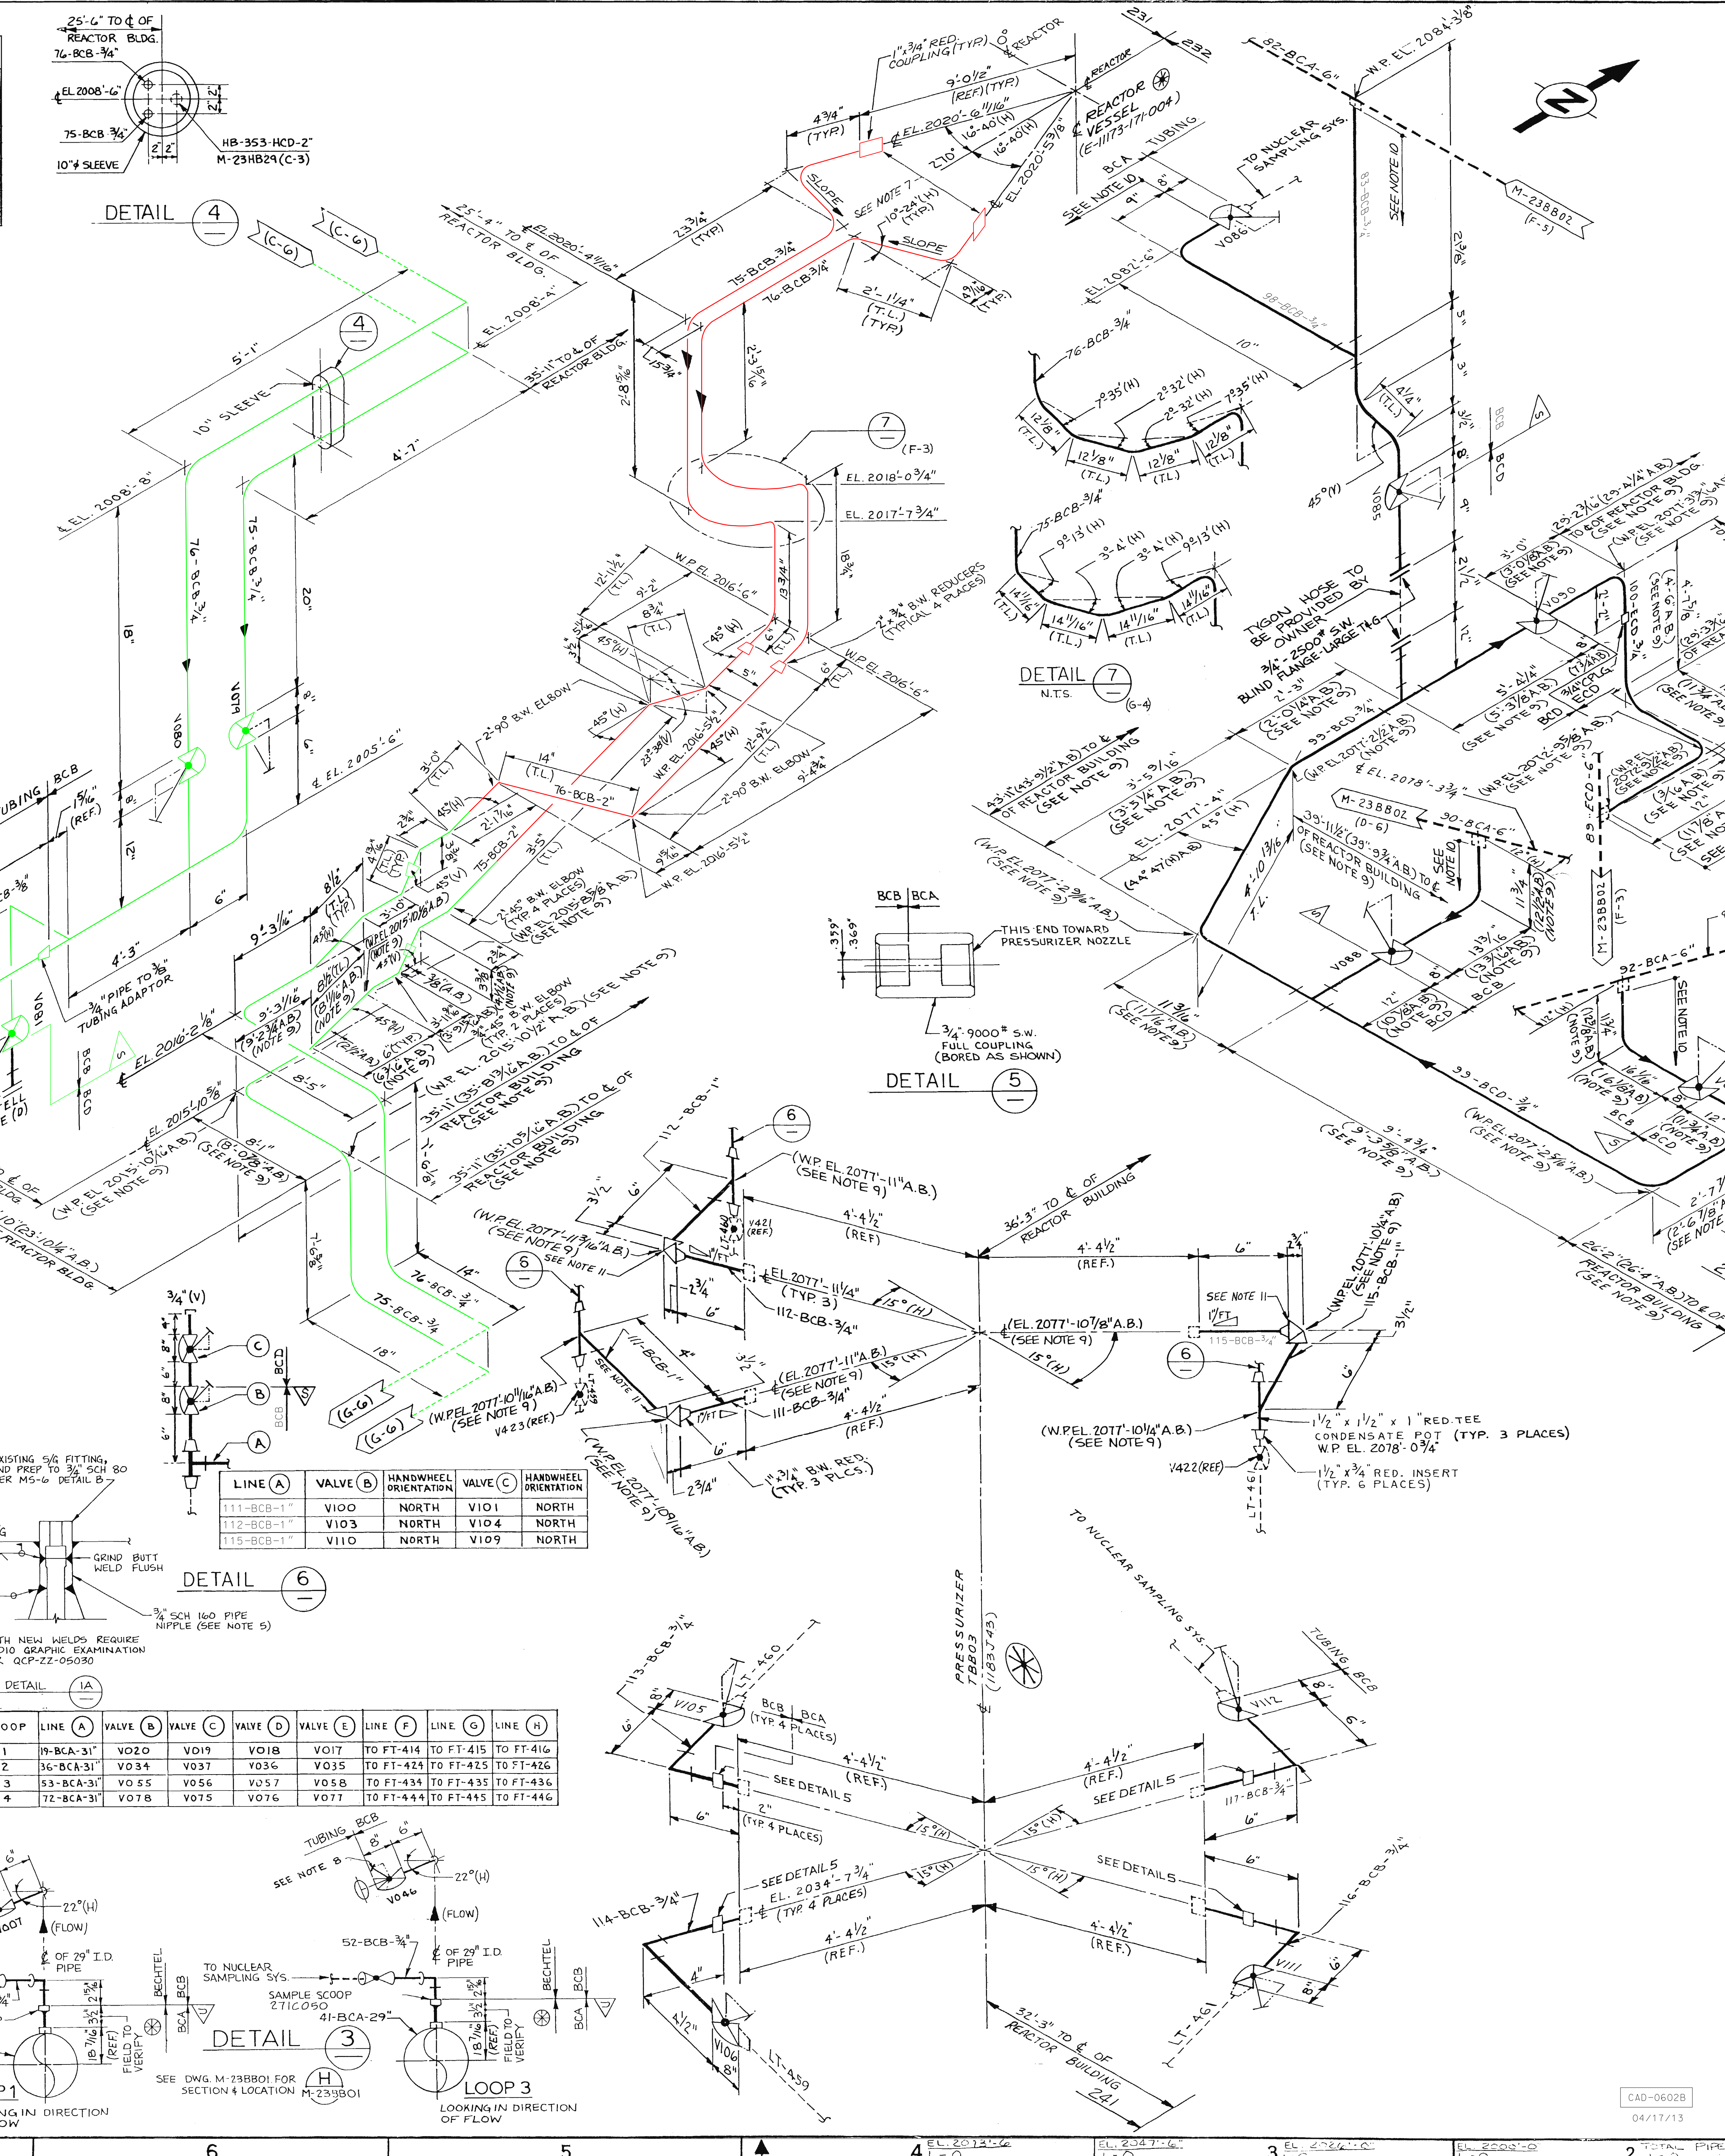


VALVE INFORMATION TABLE							
VALVE NO.	VENDOR PRINT NO.	VALVE IDENT.	P.O. ITEM NO.	VALVE NO.	VENDOR PRINT NO.	VALVE IDENT.	P.O. ITEM NO.
V007	M-240-0009	BECHTEL	2.12	V100	M-240-0009	BECHTEL	2.12
V017				V101			
V018				V103			
V019				V104			
V020				V109			
V034				V110			
V035							
V036							
V037							
V046							
V055							
V056							
V057							
V058							
V075							
V076							
V077							
V078							
V079							
V080							
V081							
V085							
V086							
V087							
V088							
V089							
V090	M-240-0009	BECHTEL	2.18				
NOTE II							
NOTE II							
V105	M-240-0009	BECHTEL	2.12				
V106	M-240-0009	BECHTEL	2.12				
NOTE II							
VIII	M-240-0009	BECHTEL	2.12				
VIII							
HV-8032	49-Z	WESTINGHOUSE	N/A				
V409	M-240-095	BECHTEL	6.08				

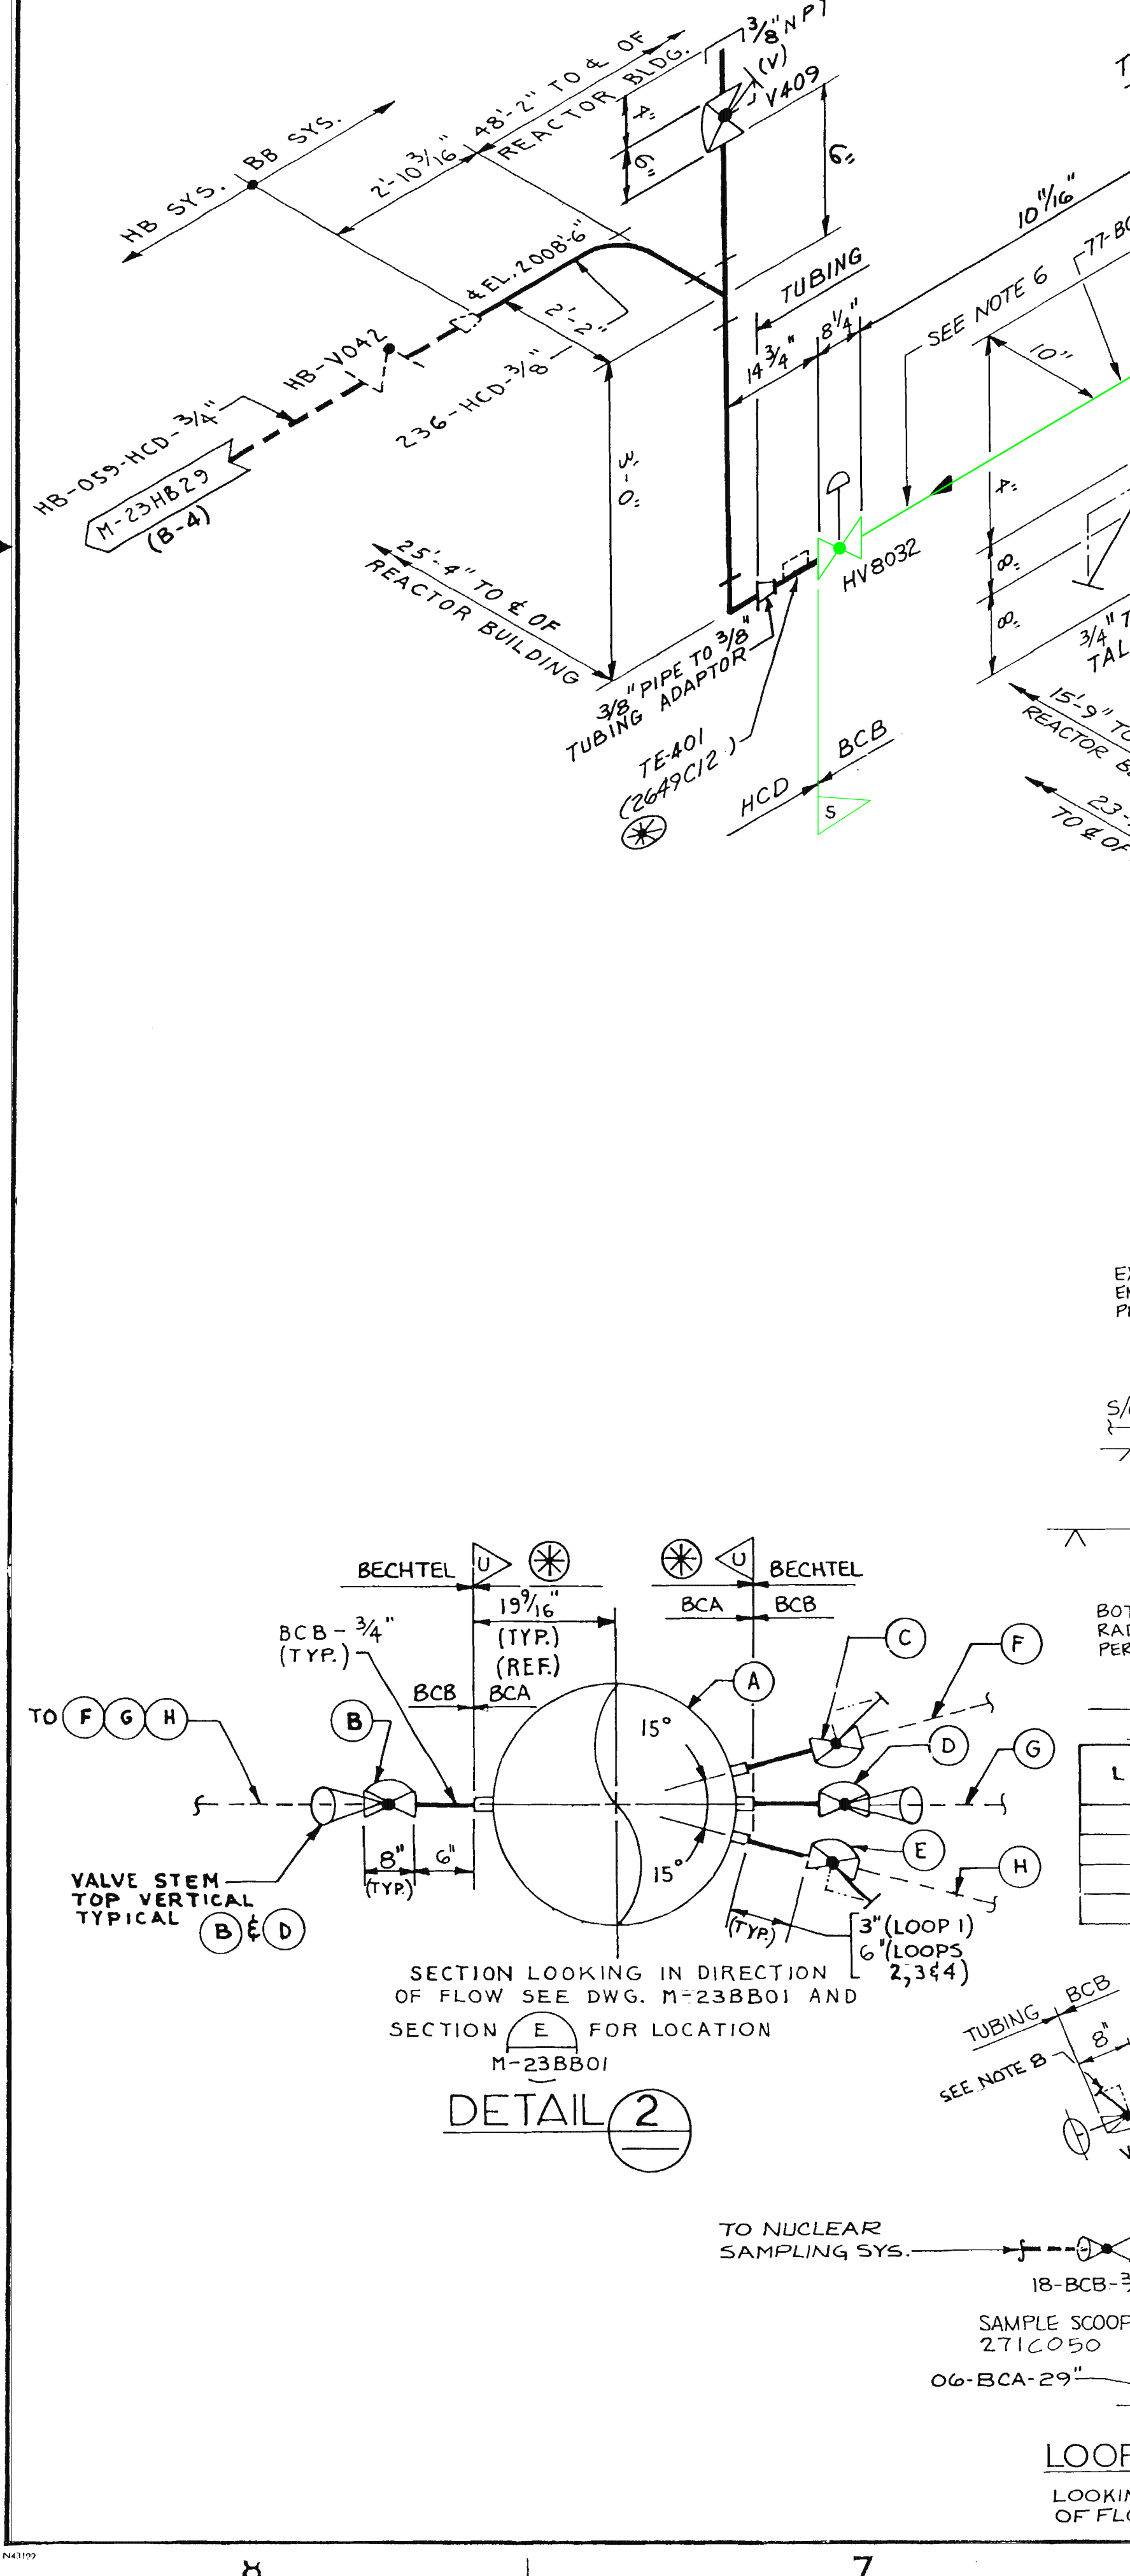

9. ELEVATIONS, DIMENSIONS, & LOCATING DIMENSIONS REFERENCED TO THIS NOTE REFLECT THE "AS BUILT" (A/B) CONDITION. ASSOCIATED DIMENSIONS THAT ARE WITHIN ALLOWABLE TOLERANCES HAVE NOT BEEN ADJUSTED.

10. LINES 83-BCB-3/4", 98-BCB-3/4", 99-BCD-3/4", 100-BCD-3/4" ARE EXTENSIONS OF CLASS I PIPING STRESS BOUNDARIES AND SHALL NOT HAVE ANY ADDITIONAL SOCKET WELD FITTINGS WITHOUT PRIOR ENGINEERING APPROVAL.

11. THE INTERNALS OF THIS VALVE HAVE BEEN REMOVED AND REPLACED WITH A STAINLESS STEEL PLUG. THE VALVE HAS BEEN TRANSFORMED TO A 90° ELBOW.

NOTES:

1. FOR GENERAL NOTES AND REFERENCES SEE DRAWING M-23BB01.

2. 2" & SMALLER BUTT WELD END VALVES ARE MARKED WITH AN ASTERISK (*) IN THE VALVE TABLE. THE CONNECTING PIPE AND/OR FITTING SHALL BE BEVELED IN THE FIELD IN ACCORDANCE WITH MS-6.

3. FIELD TO VERIFY LOCATION OF ALL NOZZLES SHOWN PRIOR TO FABRICATION AND INSTALLATION.

4. (DELETED)

5. PIPE NIPPLE IS TO BE 3/4" SCH. 160, THE STEAM GENERATOR END IS TO BE COUNTERBORED AND END PREPPED TO SCHEDULE 80 LENGTH OF 1" MAY NOT BE ALTERED WITHOUT PRIOR ENGINEERING APPROVAL. USE OF SEA SIDE CLASS ENRICH-3 FILLER METAL IS ACCEPTABLE FOR PIPE NIPPLE TO 3/4" COUPLING WELD.

6. TUBING MATERIALS SHALL BE AS IDENTIFIED ON DWG. 1-21010. SUPPORTS & HANGERS SHALL BE DESIGNATED AS SEISMIC CLASS I. THEY SHALL BE FABRICATED & INSTALLED AS SPECIFIED IN NOTES 5, 6, & 11 ON DWG. M-2001. VALVE HV-8032 IS SUPPORTED AS DESIGNATED ON DWG. M-2001B(30).

7. FIELD SHALL TRIM FOAMGLASS INSULATION IN AREA OF CONNECTIONS TO REACTOR VESSEL TO ALLOW INSTALLATION OF LINES 75-BCB-3/4".

8. VALVE HANDLES FOR V007 & V046 TO BE CUT & FINISHED AS REQUIRED TO A LENGTH OF 6" MIN., 7" MAX.

(NOTES CONTINUED ABOVE)

NO.	DATE	REVISIONS	BY	CHK	DES	ENGR	PROJ
1	06/06/06	INCORPORATE MP 03-1011	RLW	EWM			TWS
2	01/02/07	INCORP. RFR-221054	RLW	EWM			TWS
3	04/11/07	INCORP. EMP 94-1010 FCN-01	RLW	EWM			TWS
4	01/11/07	ISSUE PER EDP-22-04024	SER	RLW			TWS
5	01/23/07	INCORP. RFR-09651	MAL	RLW			TWS
6	01/26/07	INCORP. CHA-87-1120	MAL	RLW			TWS
7	01/26/07	EMP-87-1120 (PARTIAL)	J	RLW			TWS
8	01/26/07	ISSUED PER EDP-22-04024	J	RLW			TWS
9	01/26/07	INCORP. RFR-03771	J	RLW			TWS
10	01/26/07	REFLECTS TURNOVER TO U.E. INCORP. CHA-86-1015	J	RLW			TWS
11	01/26/07	INCORP. CHA-86-1015	J	RLW			TWS
12	01/26/07	INCORP. CHA-86-1015	J	RLW			TWS
BECHTEL
GAINESBURG, MARYLAND

SNUPPS
SMALL PIPING ISOMETRIC
REACTOR COOLANT SYSTEM
REACTOR BUILDING

AS-BUILT

UTILITY DRAWING NO.	REV
10466	M-23BB13(Q) 13

DRAWING APPLICABLE TO UNITS: 1 2 3 100