

# REGULATORY INFORMATION DISTRIBUTION SYSTEM (RIDS)

ACCESSION NBR: 8010100338 DOC. DATE: 80/10/07 NOTARIZED: NO DOCKET #  
 FACIL: 50-261 H. B. Robinson Plant, Unit 2, Carolina Power and Light 05000261  
 AUTH. NAME: UTLEY, E.E. AUTHOR AFFILIATION: Carolina Power & Light Co.  
 RECIP. NAME: VARGA, S.A. RECIPIENT AFFILIATION: Operating Reactors Branch 1

SUBJECT: Forwards addl info requested by NRC 800321 ltr for bypass & reset of engineered safety features. Fourteen oversize drawings encl, available in Central Files only.


SEE Repts.

DISTRIBUTION CODE: A001S COPIES RECEIVED: LTR 1 ENCL 1 SIZE: 123 + 14  
 TITLE: General Distribution for after Issuance of Operating License

NOTES: DRNGS TO: TERA (RETURN TO FILES)

ACTION:	RECIPIENT ID CODE/NAME		COPIES		RECIPIENT ID CODE/NAME		COPIES	
			LITR	ENCL			LITR	ENCL
ACTION:	VARGA, S.	04	13	17				
INTERNAL:	D/DIR, HUM FAC08		1	1	I&E	06	2	1
	NRC PDR	02	1	1	OE&D	11	1	0
	OR ASSESS BR 10		1	0	REG FILE	01	1	1
EXTERNAL:	ACRS	09	16	16	LPDR	03	1	1
	NSIC	05	1	1				

OCT 14 1980

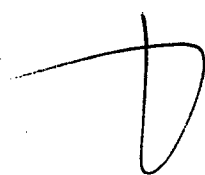

TOTAL NUMBER OF COPIES REQUIRED: LITR 38 ENCL 36



Carolina Power & Light Company

October 7, 1980

File: NG-3514(R)

Serial No.: NO-80-1498

Office of Nuclear Reactor Regulation  
Attention: Mr. Steven A. Varga, Chief  
Operating Reactors Branch No. 1  
United States Nuclear Regulatory Commission  
Washington, D. C. 20555

H. B. ROBINSON STEAM ELECTRIC PLANT UNIT NO. 2

DOCKET NO. 50-261

LICENSE NO. DPR-23

ADDITIONAL INFORMATION FOR BYPASS AND RESET OF ENGINEERED SAFETY FEATURES

Dear Mr. Varga:

In Mr. Schwencer's letter of March 21, 1980, the NRC requested additional information to continue its long-term review of the Bypass and Reset Features of Engineered Safety Features. Item 2 of that letter requested a tabulation of all Engineered Safety Features, their descriptions and drawings. These items are furnished in the attached enclosures. Enclosure 1 contains a tabulation of all Engineered Safety Features in the form as indicated by our original response of April 29, 1980. Each column heading references the specific information requested in Item 2. Enclosure 2 contains the descriptions and drawings of these Engineered Safety Features.

We trust this information satisfies your concerns and is suitable for your use. If you have any questions on this subject, please contact our staff.

Yours very truly,

E. E. Utley  
Executive Vice President  
Power Supply and  
Engineering & Construction

JHE/RSM/dk  
Enclosures

cc: Mr. J. D. Neighbors (NRC) w/enclosure 1 only

Acc  
1/1  
DRUGS TO:  
TERA (RETURN TO  
FILES)

8010100338

ENCLOSURE 1

Tabulation of all Engineered Safety Features

**REGULATORY DOCKET FILE COPY**

[illegible]

I. CONTAINMENT VENTILATION ISOLATION EQUIPMENT (DWG. 5379-3235)

[illegible]

## II. STEAM LINE ISOLATION (SLI)

[illegible]

## II. TEAM LINE ISOLATION EQUIPMENT (DWG. 5379-3233)

[illegible]

### III. GROUNDWATER ISOLATION (FWI)

[illegible]



### III.

[illegible]

## IV. ENTAINMENT ISOLATION PHASE "A" (CIA)

[illegible]

## IV. CONTAINMENT ISOLATION PHASE "A" EQUIPMENT (DWG. 537-235)

Component (1a)	System (1b)	Safety Function (1c)	Actuation Signal (1d)	Blockable (1f-2)	Conditions (2)	How Reset (2)	Reset Signal (3)	Drawing (1e-3)	Qualifying Response (4)
PCV-1716	Inst.	CV	CIA	Yes	Man. SW.	Man. Sw.	NA	CWD-590	79-01B
	Air	Isolation							
EV-1922A	Seal	CV	CIA	No	NA	NA	NA	CWD-594	79-01B
	Water	Isolation							
EV-1922B	Seal	CV	CIA	No	NA	NA	NA	CWD-594	79-01B
	Water	Isolation							
V12-18	H2 Vent.	CV	CIA	No	NA	NA	NA	CWD-598	79-01B
		Isolation							
V12-19	H2 Vent.	CV	CIA	No	NA	NA	NA	CWD-598	79-01B
		Isolation							
RMS-1	CV Air	CV	CIA	No	NA	NA	NA	CWD-599	79-01B
	Samp.	Isolation							
RMS-2	CV Air	CV	CIA	No	NA	NA	NA	CWD-599	79-01B
	Samp.	Isolation							
RMS-3	CV Air	CV	CIA	No	NA	NA	NA	CWD-599	79-01B
	Samp.	Isolation							
RMS-4	CV Air	CV	CIA	No	NA	NA	NA	CWD-599	79-01B
	Samp.	Isolation							
FCV-1930A	SG Blow-	CV	CIA	No	NA	NA	NA	CWD-627/	79-01B
	down	Isolation						630	
FCV-1930B	SG Blow-	CV	CIA	No	NA	NA	NA	CWD-627/	79-01B
	down	Isolation						630	
FCV-1931A	SG Blow-	CV	CIA	No	NA	NA	NA	CWD-627/	79-01B
	down	Isolation						630	

## IV. MAINTENANCE ISOLATION PHASE "A" EQUIPMENT (DWG. 537-35)

Component (1a)	System (1b)	Safety Function (1c)	Actuation Signal (1d)	Blockable (1f-2)	Conditions (2)	How Reset (2)	Reset Signal (3)	Drawing (1e-3)	Qualifying Response (4)
FCV-1931B	SG Blow-	CV	CIA	No	NA	NA	NA	CWD-627/	79-01B
	down	Isolation						630	
FCV-1932A	SG Blow-	CV	CIA	No	NA	NA	NA	CWD-627/	79-01B
	down	Isolation						630	
FCV-1932B	SG Blow-	CV	CIA	No	NA	NA	NA	CWD-627/	79-01B
	down	Isolation						630	
FCV-1933A	Blowdown	CV	CIA	No	NA	NA	NA	CWD-628	79-01B
	Samp.	Isolation							
FCV-1933B	Blowdown	CV	CIA	No	NA	NA	NA	CWD-628	79-01B
	Samp.	Isolation							
FCV-1934A	Blowdown	CV	CIA	No	NA	NA	NA	CWD-628	79-01B
	Samp.	Isolation							
FCV-1934B	Blowdown	CV	CIA	No	NA	NA	NA	CWD-628	79-01B
	Samp.	Isolation							
FCV-1935A	Blowdown	CV	CIA	No	NA	NA	NA	CWD-628	79-01B
	Samp.	Isolation							
FCV-1935B	Blowdown	CV	CIA	No	NA	NA	NA	CWD-628	79-01B
	Samp.	Isolation							
V-956A	Sampling	CV	CIA	No	NA	NA	NA	CWD-89	79-01B
		Isolation							
V-956B	Sampling	CV	CIA	No	NA	NA	NA	CWD-89	79-01B
		Isolation							
V-956C	Sampling	CV	CIA	No	NA	NA	NA	CWD-91	79-01B
		Isolation							

## IV. TAINMENT ISOLATION PHASE "A" EQUIPMENT (DWG. 5 235)

Component (1a)	System (1b)	Safety Function (1c)	Actuation Signal (1d)	Blockable (1f-2)	Conditions (2)	How Reset (2)	Reset Signal (3)	Drawing (1e-3)	Qualifying Response (4)
V-956D	Sampling	CV	CIA	No	NA	NA	NA	CWD-91	79-01B
		Isolation							
V-956E	Sampling	CV	CIA	No	NA	NA	NA	CWD-94	79-01B
		Isolation							
V-956F	Sampling	CV	CIA	No	NA	NA	NA	CWD-94	79-01B
		Isolation							
V-956G	Sampling	CV	CIA	No	NA	NA	NA	CWD-98	79-01B
		Isolation							
V-956H	Sampling	CV	CIA	No	NA	NA	NA	CWD-98	79-01B
		Isolation							
V-516	Gas	CV	CIA	No	NA	NA	NA	CWD-125	79-01B
	Analyzer	Isolation							
V-553	Gas	CV	CIA	No	NA	NA	NA	CWD-126	79-01B
	Analyzer	Isolation							
V-519A	RCS	CV	CIA	No	NA	NA	NA	CWD-127	79-01B
		Isolation							
V-519B	RCS	CV	CIA	No	NA	NA	NA	CWD-127	79-01B
		Isolation							
V-200A	CVCS	CV	CIA	No	NA	NA	NA	CWD-151	79-01B
		Isolation							
V-200B	CVCS	CV	CIA	No	NA	NA	NA	CWD-152	79-01B
		Isolation							
V-200C	CVCS	CV	CIA	No	NA	NA	NA	CWD-153	79-01B
		Isolation							

## V. SAFETY INJECTION (SI)

Component (1a)	System (1b)	Safety Function (1c)	Actuation Signal (1d)	Blockable (1f-2)	Conditions (2)	How Reset (2)	Reset Signal (3)	Drawing (1e-3)	Qualifying Response (4)
SI	Safe-	Protection	Steam Line	Yes	Low Tavg	Auto	Norm. Tavg	5379-3232	79-01B
	guards		Isolation		Temperature		Temperature		
					<543°		>543°		
SI	Safe-	Protection	CV Press.	No	NA	NA	NA	5379-3232	79-01B
	guards		4 psi						
SI	Safe-	Protection	High Steam	Yes	Low Prez.	Auto	Norm. Prez.	5379-3232	79-01B
	guards		Line Delta		Pressure		Pressure		
			Press.		<2000 psi		>2000 psi		
			Loop 1						
			100 psi						
SI	Safe-	Protection	High Steam	Yes	Low Prez.	Auto	Norm. Prez.	5379-3232	79-01B
	guards		Line Delta		Pressure		Pressure		
			Press.		<2000 psi		>2000 psi		
			Loop 2						
			100 psi						
SI	Safe-	Protection	High Steam	Yes	Low Prez.	Auto	Norm. Prez.	5379-3232	79-01B
	guards		Line Delta		Pressure		Pressure		
			Press.		<2000 psi		>2000 psi		
			Loop 3						
			100 psi						
SI	Safe-	Protection	Low Prez.	Yes	Low Prez.	Auto	Norm. Prez.	5379-3232	79-01B
	guards		Pressure		Pressure		Pressure		
			1715 psi		<2000 psi		>2000 psi		
SI	Safe-	Protection	Manual	No	NA	NA	NA	5379-3232	79-01B

guards

## IV. CONTAINMENT ISOLATION PHASE "A" EQUIPMENT (DWG. 53 235)

Component (1a)	System (1b)	Safety Function (1c)	Actuation Signal (1d)	Blockable (1f-2)	Conditions (2)	How Reset (2)	Reset Signal (3)	Drawing (1e-3)	Qualifying Response (4)
V-956D	Sampling	CV	CIA	No	NA	NA	NA	CWD-91	79-01B
		Isolation							
V-956E	Sampling	CV	CIA	No	NA	NA	NA	CWD-94	79-01B
		Isolation							
V-956F	Sampling	CV	CIA	No	NA	NA	NA	CWD-94	79-01B
		Isolation							
V-956G	Sampling	CV	CIA	No	NA	NA	NA	CWD-98	79-01B
		Isolation							
V-956H	Sampling	CV	CIA	No	NA	NA	NA	CWD-98	79-01B
		Isolation							
V-516	Gas	CV	CIA	No	NA	NA	NA	CWD-125	79-01B
	Analyzer	Isolation							
V-553	Gas	CV	CIA	No	NA	NA	NA	CWD-126	79-01B
	Analyzer	Isolation							
V-519A	RCS	CV	CIA	No	NA	NA	NA	CWD-127	79-01B
		Isolation							
V-519B	RCS	CV	CIA	No	NA	NA	NA	CWD-127	79-01B
		Isolation							
V-200A	CVCS	CV	CIA	No	NA	NA	NA	CWD-151	79-01B
		Isolation							
V-200B	CVCS	CV	CIA	No	NA	NA	NA	CWD-152	79-01B
		Isolation							
V-200C	CVCS	CV	CIA	No	NA	NA	NA	CWD-153	79-01B
		Isolation							

IV. CONTAINMENT ISOLATION PHASE "A" EQUIPMENT (DWG. 537-1085)

[illegible]



## V. SAFETY INJECTION (INSTANTANEOUS EQUIPMENT) DWG. 5379-232

Component (1a)	System (1b)	Safety Function (1c)	Actuation Signal (1d)	Blockable (1f-2)	Conditions (2)	How Reset (2)	Reset Signal (3)	Drawing (1e-3)	Qualifying Response (4)
V-744A	RHR	Open Valve	SI	No	NA	NA	NA	CWD-220	79-01B
V-744B	RHR	Open Valve	SI	No	NA	NA	NA	CWD-221	79-01B
V-867A	SI	Open Valve	SI	No	NA	NA	NA	CWD-243	79-01B
V-867B	SI	Open Valve	SI	No	NA	NA	NA	CWD-244	79-01B
V-870B	SI	Open Valve	SI	No	NA	NA	NA	CWD-245	79-01B
V-870A	SI	Open Valve	SI	No	NA	NA	NA	CWD-247	79-01B
V-841A	SI	Close Valve	SI	No	NA	NA	NA	CWD-250	79-01B
V-841B	SI	Close Valve	SI	No	NA	NA	NA	CWD-250	79-01B
V-865A	SI	Open Valve	SI	No	NA	NA	NA	CWD-282	79-01B
V-865B	SI	Open Valve	SI	No	NA	NA	NA	CWD-283	79-01B
V-865C	SI	Open Valve	SI	No	NA	NA	NA	CWD-284	79-01B
V-845A	SI	Open Valve	SI	No	NA	NA	NA	CWD-295	79-01B
V-845B	SI	Open Valve	SI	No	NA	NA	NA	CWD-296	79-01B
HVH-1 Damp.	HVAC	Emerg Flow	SI	No	NA	NA	NA	CWD-511	79-01B
HVH-2 Damp.	HVAC	Emerg Flow	SI	No	NA	NA	NA	CWD-512	79-01B
HVH-3 Damp.	HVAC	Emerg Flow	SI	No	NA	NA	NA	CWD-513	79-01B
HVH-4 Damp.	HVAC	Emerg Flow	SI	No	NA	NA	NA	CWD-514	79-01B
Con Rm Vent	HVAC	Isolate CR	SI	No	NA	NA	NA	CWD-566	79-01B
FW Pump "A"	FW Sys	Stop Pump	SI	No	NA	NA	NA	CWD-615	79-01B
FW Pump "B"	FW Sys	Stop Pump	SI	No	NA	NA	NA	CWD-620	79-01B
V2-6A	FW Sys	Close Valve	SI	No	NA	NA	NA	CWD-638	79-01B
V2-6B	FW Sys	Close Valve	SI	No	NA	NA	NA	CWD-639	79-01B
V2-6C	FW Sys	Close Valve	SI	No	NA	NA	NA	CWD-640	79-01B
52/2B	480V Sys	Open Breaker	SI	No	NA	NA	NA	CWD-893	79-01B

V. HYDRAULIC INJECTION (INSTANTANEOUS EQUIPMENT) DWG. 5379-1-32

[illegible]

## V. SAFETY INJECTION (SEQUENCING EQUIPMENT) DWG. 5379-3227

Component (1a)	System (1b)	Safety Function (1c)	Actuation Signal (1d)	Blockable (1f-2)	Conditions (2)	How Reset (2)	Reset Signal (3)	Drawing (1e-3)	Qualifying Response (4)
52-21B	CVCS	Stop CHPB	SI	No	NA	NA	NA	CWD-162	79-01B
52-23A	CVCS	Stop CHPC	SI	No	NA	NA	NA	CWD-163	79-01B
52-22C	CCS	Start CCPB	SI	No	NA	NA	NA	CWD-205	79-01B
52-26C	CCS	Start CCPC	SI	No	NA	NA	NA	CWD-209	79-01B
52-22A	RHR	Start RHRPA	SI	No	NA	NA	NA	CWD-214	79-01B
52-26B	RHR	Start RHRPB	SI	No	NA	NA	NA	CWD-216	79-01B
52-21C	SIS	Start SIPA	SI	No	NA	NA	NA	CWD-237	79-01B
52-29C	SIS	Start SIPB	SI	No	NA	NA	NA	CWD-238	79-01B
52-23B	SIS	Start SIPC	SI	No	NA	NA	NA	CWD-239	79-01B
52-19B	HVAC	Start HVH-1	SI	No	NA	NA	NA	CWD-511	79-01B
52-20C	HVAC	Start HVH-2	SI	No	NA	NA	NA	CWD-512	79-01B
52-25A	HVAC	Start HVH-3	SI	No	NA	NA	NA	CWD-513	79-01B
52-24B	HVAC	Start HVH-4	SI	No	NA	NA	NA	CWD-514	79-01B
52-20A	Aux FW	Start AFWA	SI	No	NA	NA	NA	CWD-651	79-01B
52-24C	Aux FW	Start AFWB	SI	No	NA	NA	NA	CWD-655	79-01B
52-20B	Ser Wtr	Start SWPA	SI	No	NA	NA	NA	CWD-831	79-01B
52-19C	Ser Wtr	Start SWPB	SI	No	NA	NA	NA	CWD-832	79-01B
52-24A	Ser Wtr	Start SWPC	SI	No	NA	NA	NA	CWD-833	79-01B
52-25B	Ser Wtr	Start SWPD	SI	No	NA	NA	NA	CWD-834	79-01B
52-17B	Emerg.	Close	SI	No	NA	NA	NA	CWD-890	79-01B
	Gen A	Breaker							
52-27B	Emerg.	Close	SI	No	NA	NA	NA	CWD-895	79-01B
	Gen B	Breaker							
52-29B	Emerg.	Bus Tie	SI	No	NA	NA	NA	CWD-896	79-01B

Power

[illegible]

## VI. CONFINEMENT ISOLATION PHASE "B" (CIB)

[illegible]

## VI. CONFINEMENT ISOLATION PHASE "B" EQUIPMENT (DWG. 5379-5)

[illegible]

## VII. CONTAINMENT SPRAY (CS)

[illegible]


VII.

[illegible]



ENCLOSURE 2


Descriptions and Drawings of  
All Engineered Safety Features

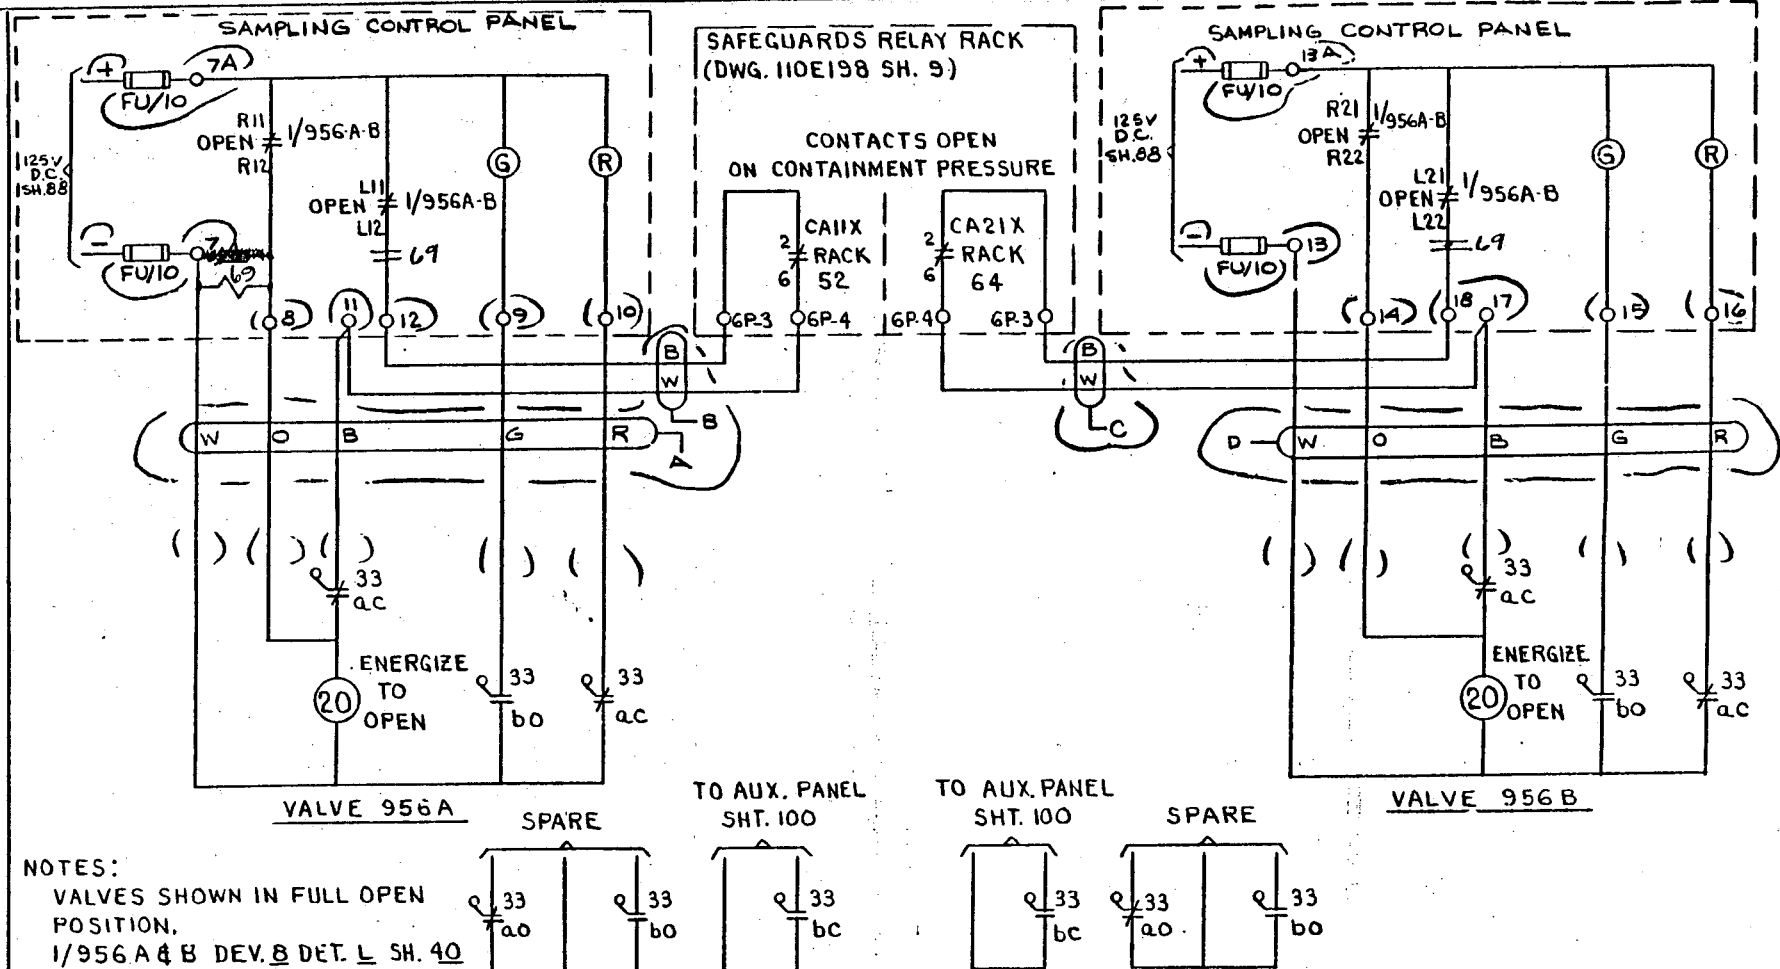

## NOTES:

VALVES SHOWN IN FULL OPEN POSITION.  
1/956A & B DEV. B DET. L SH. 40


6-13-80 2422 6-13-80 254 6-15-80 JWC			ECN 7601 4-14-71 ECN 5333 4-23-71 ECN 5333 		
--	--	--	--	--	--

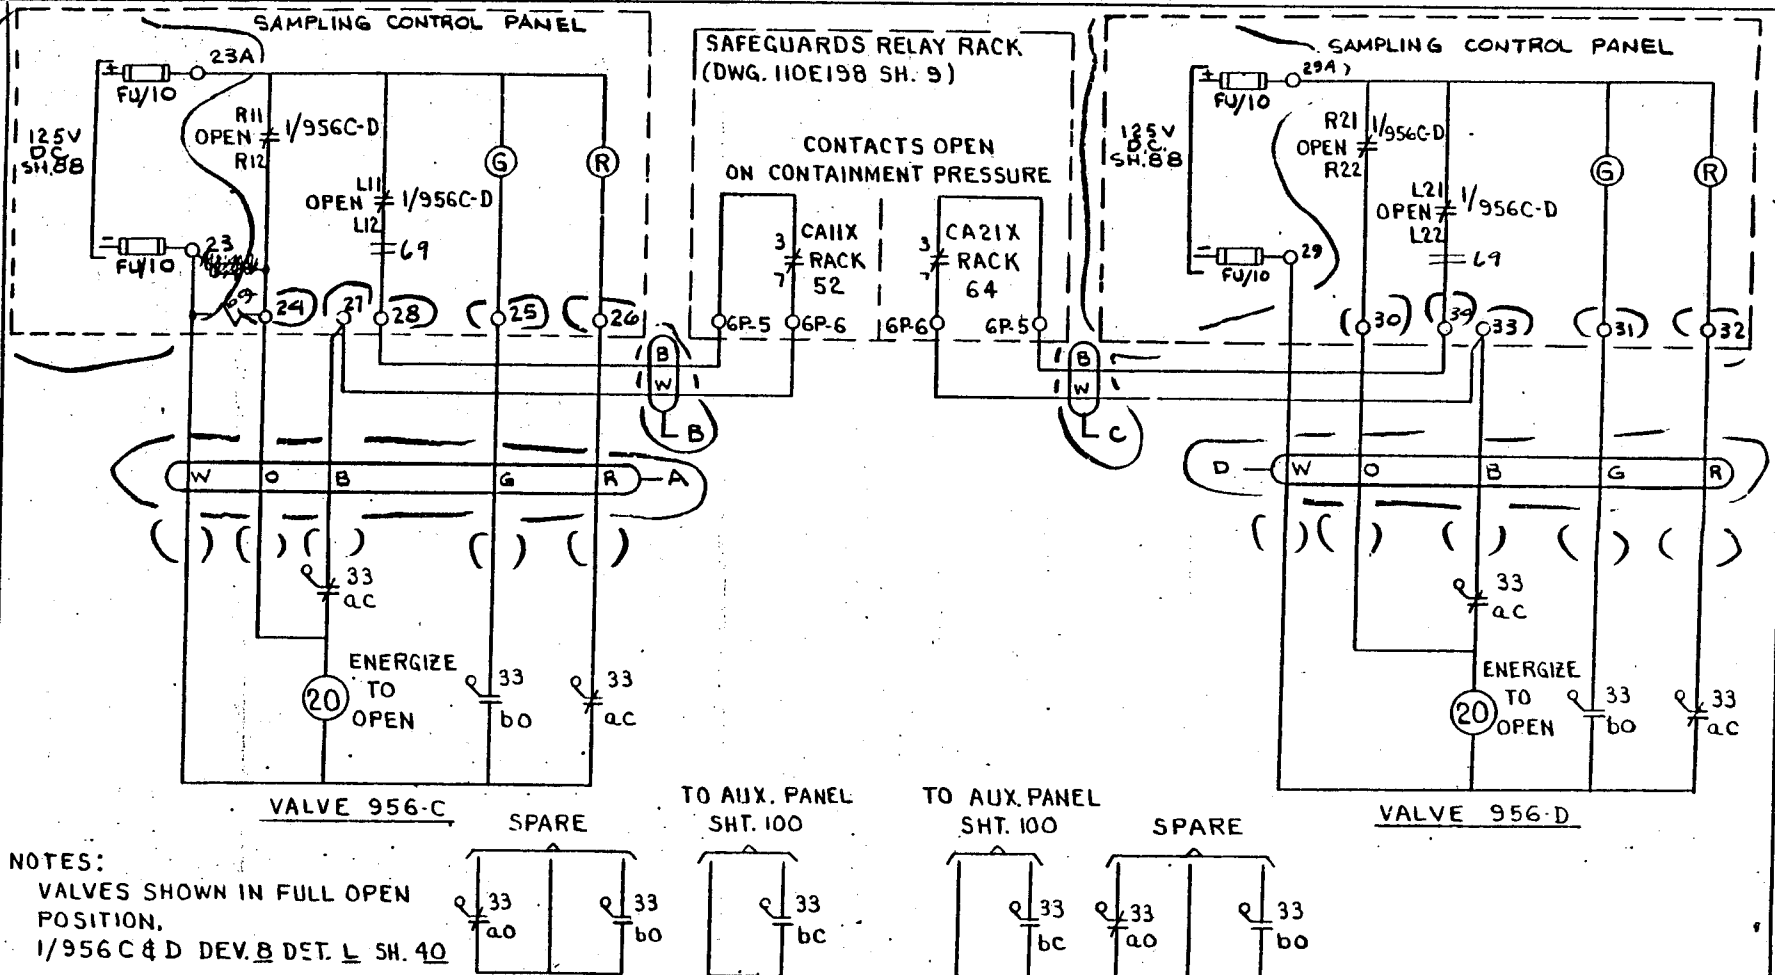


NOTES:

VALVES SHOWN IN FULL OPEN  
POSITION.  
1/956 C & D DEV. 8 DET. L SH. 40

[illegible]

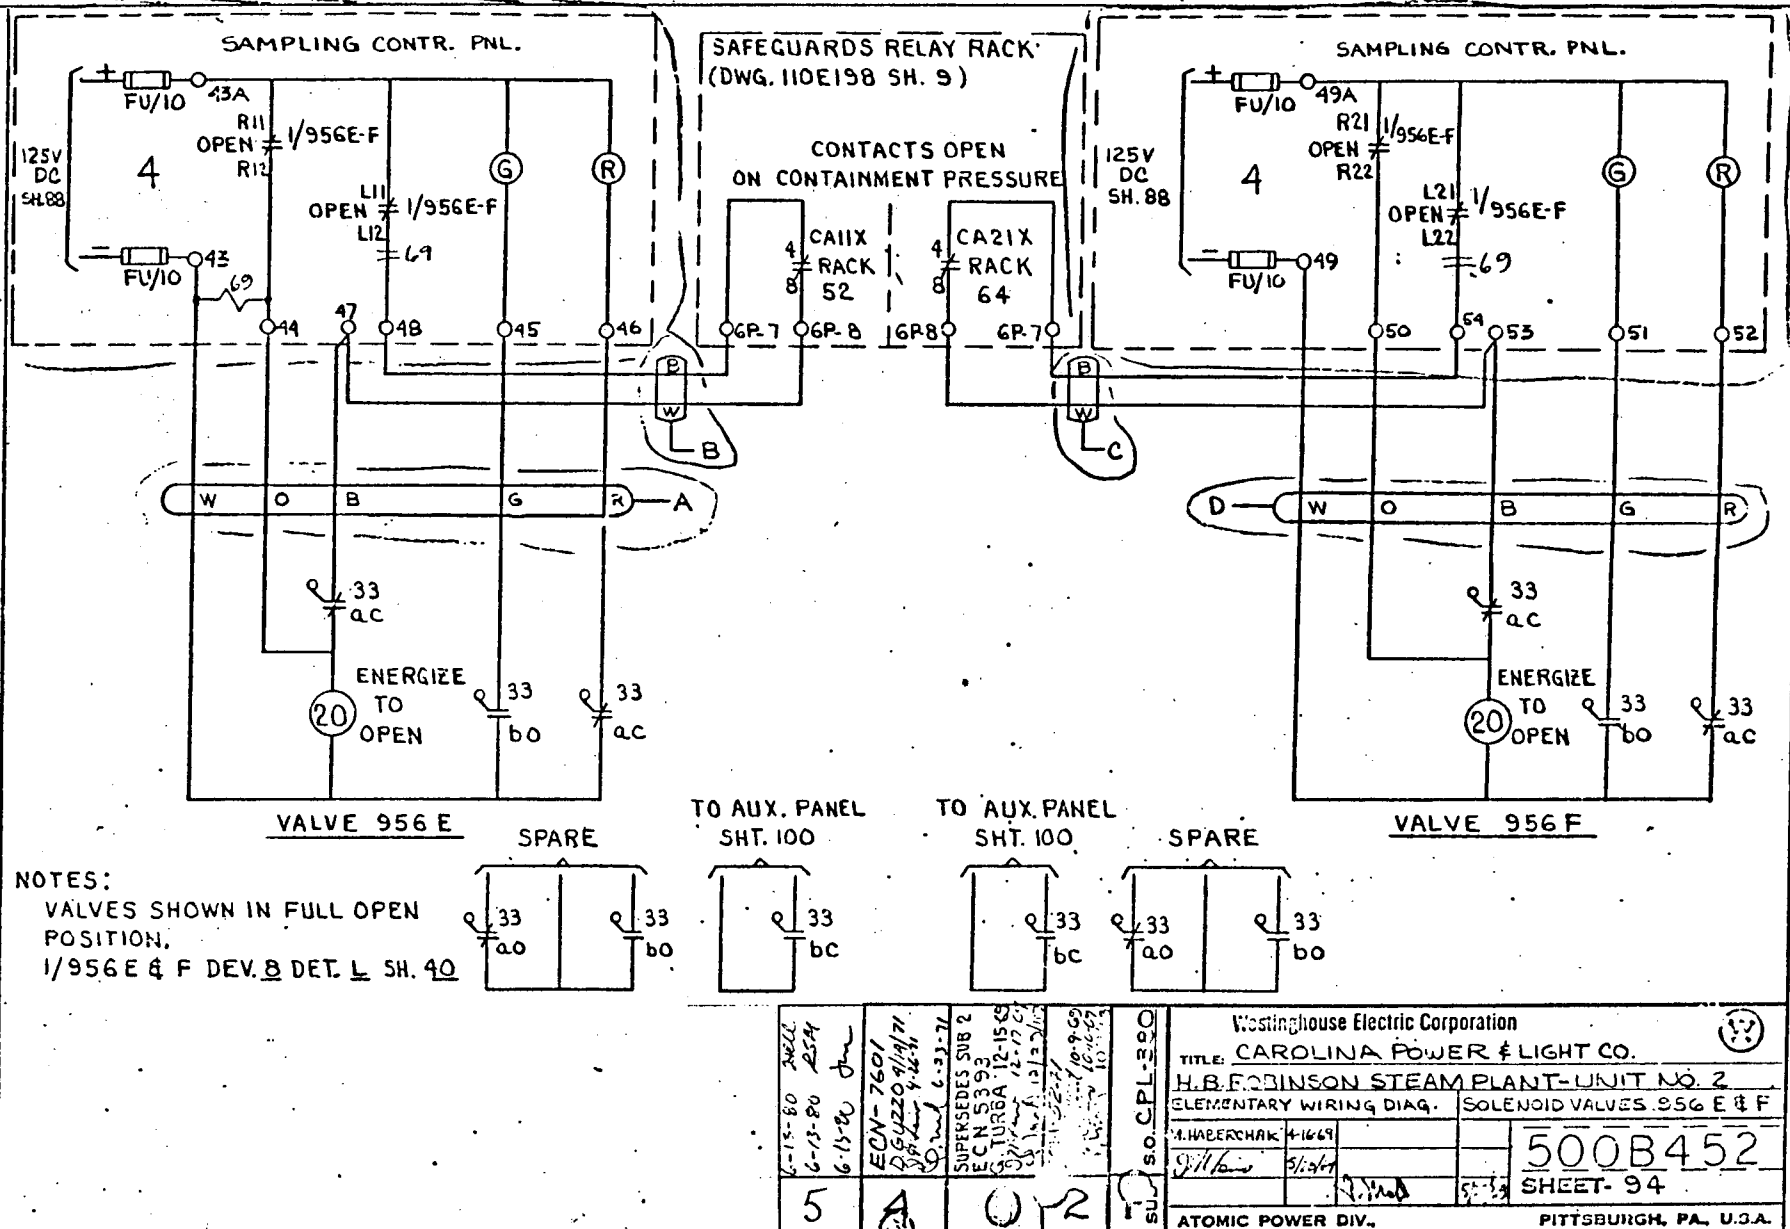


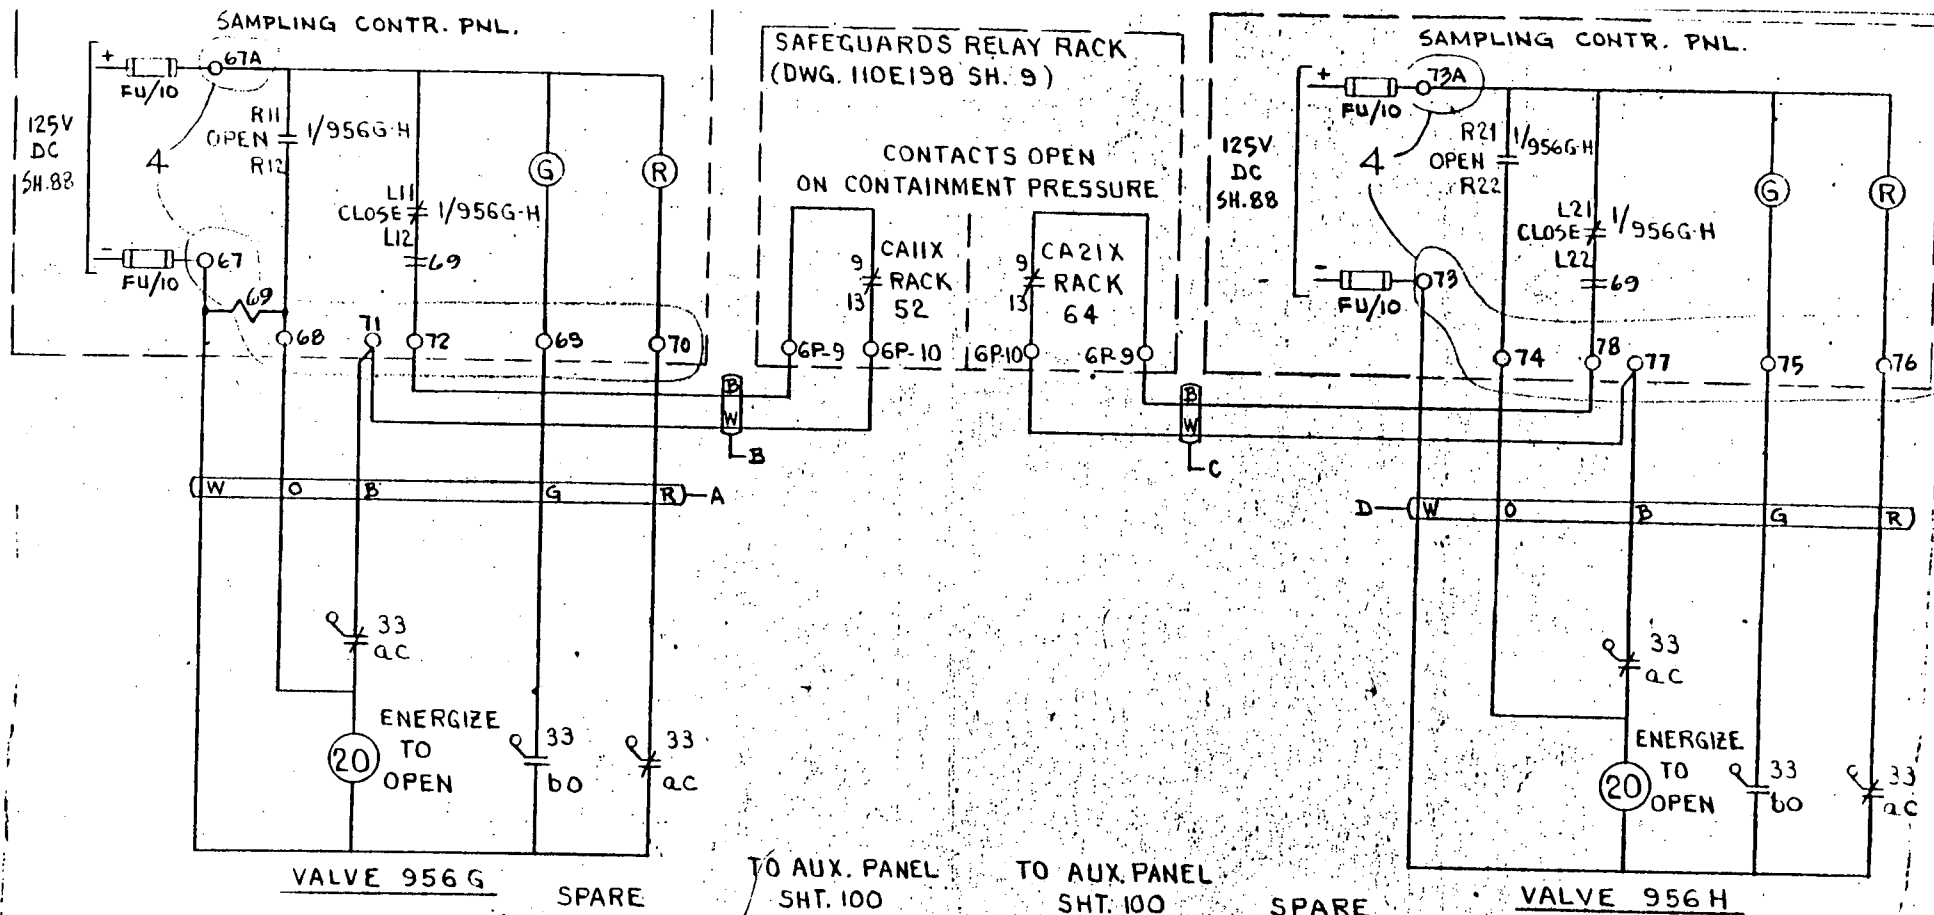


## NOTES:

VALVES SHOWN IN FULL OPEN  
POSITION.  
1/956G & H DEV. 8 DET. L SH. 40

6-13-80 Jell	6-13-80 RSM	6-13-80 JVC	FLD 4-29-76 GSC E.J.	SUPERSEDES SUB2 ECN 5393 G TURBA 12-15-79 12-17-79 12-24-79 12-24-79	ECN 5241 10-9-80 10-10-80 10-10-80 10-10-80	s.o. CPL-380	Westinghouse Electric Corporation TITLE: CAROLINA POWER & LIGHT CO. H.B.ROBINSON STEAM PLANT-UNIT NO 2 ELEMENTARY WIRING DIAG. SOLENOID VALVES 95G G & H M.HABERCHAK 4-16-69 W/H L... 5/26/69 P.M.D. SHEET. 98 ATOMIC POWER DIV., PITTSBURGH, PA., U.S.A.	(W)
5	4	1	3	2	P	SUB		

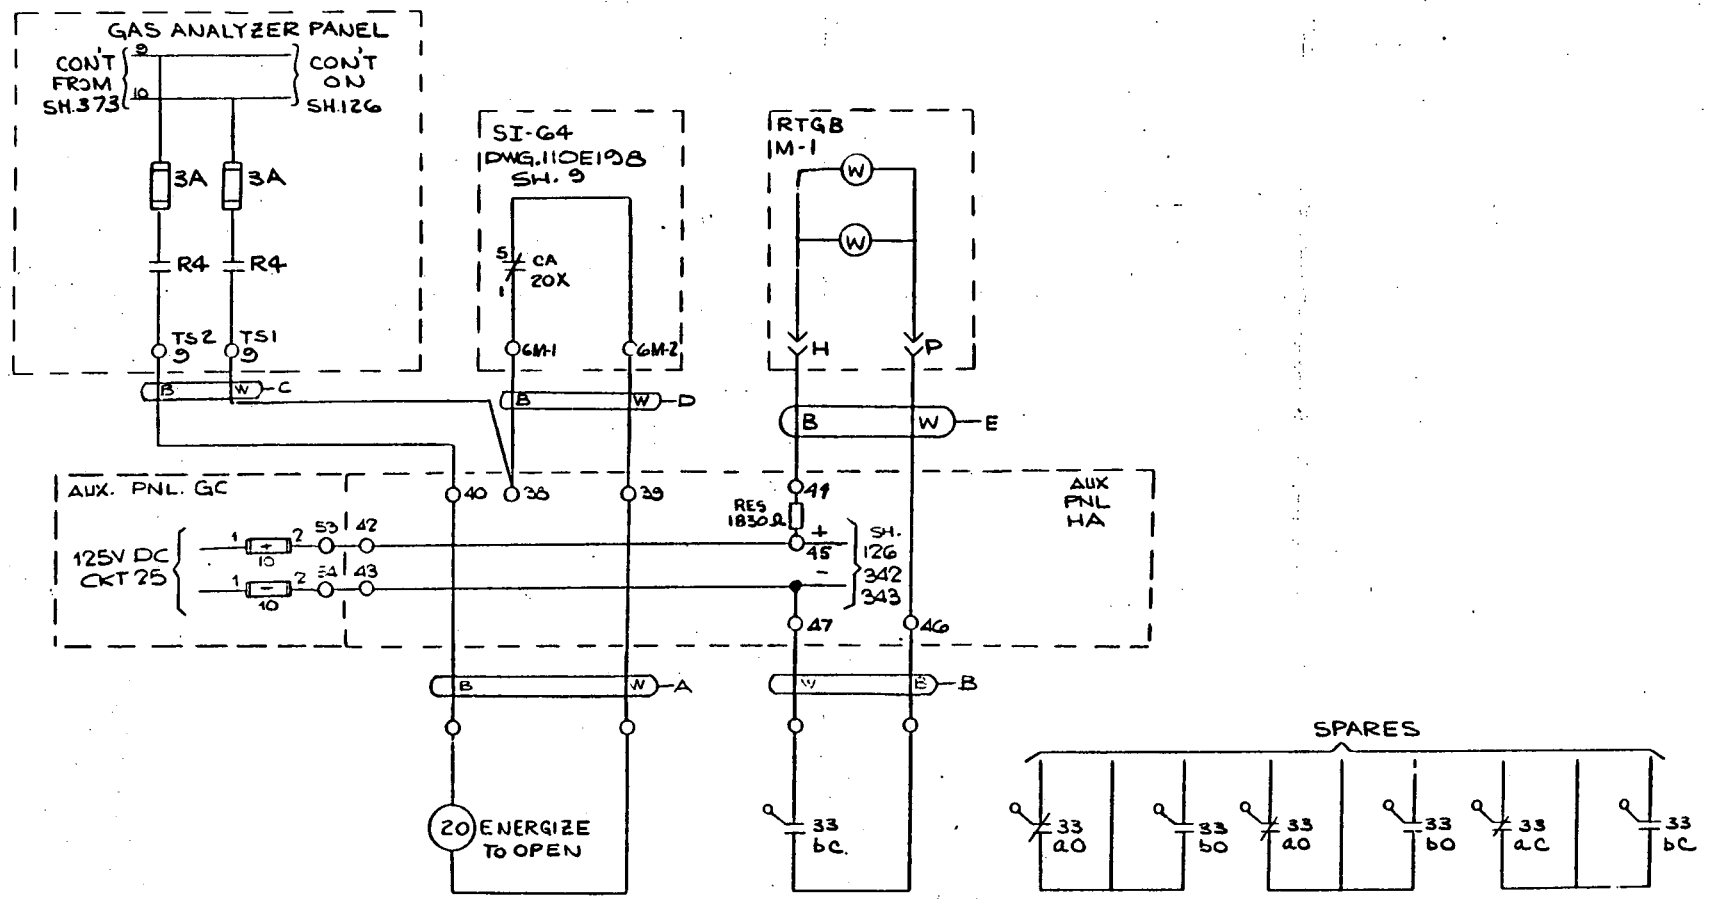


6-16-80 2400		6-17-80 2500		6-18-80 2600		6-19-80 2700		6-20-80 2800		6-21-80 2900		6-22-80 3000		6-23-80 3100		6-24-80 3200		6-25-80 3300		6-26-80 3400		6-27-80 3500		6-28-80 3600		6-29-80 3700		6-30-80 3800		6-31-80 3900		6-32-80 4000		6-33-80 4100		6-34-80 4200		6-35-80 4300		6-36-80 4400		6-37-80 4500		6-38-80 4600		6-39-80 4700		6-40-80 4800		6-41-80 4900		6-42-80 5000		6-43-80 5100		6-44-80 5200		6-45-80 5300		6-46-80 5400		6-47-80 5500		6-48-80 5600		6-49-80 5700		6-50-80 5800		6-51-80 5900		6-52-80 6000		6-53-80 6100		6-54-80 6200		6-55-80 6300		6-56-80 6400		6-57-80 6500		6-58-80 6600		6-59-80 6700		6-60-80 6800		6-61-80 6900		6-62-80 7000		6-63-80 7100		6-64-80 7200		6-65-80 7300		6-66-80 7400		6-67-80 7500		6-68-80 7600		6-69-80 7700		6-70-80 7800		6-71-80 7900		6-72-80 8000		6-73-80 8100		6-74-80 8200		6-75-80 8300		6-76-80 8400		6-77-80 8500		6-78-80 8600		6-79-80 8700		6-80-80 8800		6-81-80 8900		6-82-80 9000		6-83-80 9100		6-84-80 9200		6-85-80 9300		6-86-80 9400		6-87-80 9500		6-88-80 9600		6-89-80 9700		6-90-80 9800		6-91-80 9900		6-92-80 10000		6-93-80 10100		6-94-80 10200		6-95-80 10300		6-96-80 10400		6-97-80 10500		6-98-80 10600		6-99-80 10700		6-100-80 10800		6-101-80 10900		6-102-80 11000		6-103-80 11100		6-104-80 11200		6-105-80 11300		6-106-80 11400		6-107-80 11500		6-108-80 11600		6-109-80 11700		6-110-80 11800		6-111-80 11900		6-112-80 12000		6-113-80 12100		6-114-80 12200		6-115-80 12300		6-116-80 12400		6-117-80 12500		6-118-80 12600		6-119-80 12700		6-120-80 12800		6-121-80 12900		6-122-80 13000		6-123-80 13100		6-124-80 13200		6-125-80 13300		6-126-80 13400		6-127-80 13500		6-128-80 13600		6-129-80 13700		6-130-80 13800		6-131-80 13900		6-132-80 14000		6-133-80 14100		6-134-80 14200		6-135-80 14300		6-136-80 14400		6-137-80 14500		6-138-80 14600		6-139-80 14700		6-140-80 14800		6-141-80 14900		6-142-80 15000		6-143-80 15100		6-144-80 15200		6-145-80 15300		6-146-80 15400		6-147-80 15500		6-148-80 15600		6-149-80 15700		6-150-80 15800		6-151-80 15900		6-152-80 16000		6-153-80 16100		6-154-80 16200		6-155-80 16300		6-156-80 16400		6-157-80 16500		6-158-80 16600		6-159-80 16700		6-160-80 16800		6-161-80 16900		6-162-80 17000		6-163-80 17100		6-164-80 17200		6-165-80 17300		6-166-80 17400		6-167-80 17500		6-168-80 17600		6-169-80 17700		6-170-80 17800		6-171-80 17900		6-172-80 18000		6-173-80 18100		6-174-80 18200		6-175-80 18300		6-176-80 18400		6-177-80 18500		6-178-80 18600		6-179-80 18700		6-180-80 18800		6-181-80 18900		6-182-80 19000		6-183-80 19100		6-184-80 19200		6-185-80 19300		6-186-80 19400		6-187-80 19500		6-188-80 19600		6-189-80 19700		6-190-80 19800		6-191-80 19900		6-192-80 20000		6-193-80 20100		6-194-80 20200		6-195-80 20300		6-196-80 20400		6-197-80 20500		6-198-80 20600		6-199-80 20700		6-200-80 20800		6-201-80 20900		6-202-80 21000		6-203-80 21100		6-204-80 21200		6-205-80 21300		6-206-80 21400		6-207-80 21500		6-208-80 21600		6-209-80 21700		6-210-80 21800		6-211-80 21900		6-212-80 22000		6-213-80 22100		6-214-80 22200		6-215-80 22300		6-216-80 22400		6-217-80 22500		6-218-80 22600		6-219-80 22700		6-220-80 22800		6-221-80 22900		6-222-80 23000		6-223-80 23100		6-224-80 23200		6-225-80 23300		6-226-80 23400		6-227-80 23500		6-228-80 23600		6-229-80 23700		6-230-80 23800		6-231-80 23900		6-232-80 24000		6-233-80 24100		6-234-80 24200		6-235-80 24300		6-236-80 24400		6-237-80 24500		6-238-80 24600		6-239-80 24700		6-240-80 24800		6-241-80 24900		6-242-80 25000		6-243-80 25100		6-244-80 25200		6-245-80 25300		6-246-80 25400		6-247-80 25500		6-248-80 25600		6-249-80 25700		6-250-80 25800		6-251-80 25900		6-252-80 26000		6-253-80 26100		6-254-80 26200		6-255-80 26300		6-256-80 26400		6-257-80 26500		6-258-80 26600		6-259-80 26700		6-260-80 26800		6-261-80 26900		6-262-80 27000		6-263-80 27100		6-264-80 27200		6-265-80 27300		6-266-80 27400		6-267-80 27500		6-268-80 27600		6-269-80 27700		6-270-80 27800		6-271-80 27900		6-272-80 28000		6-273-80 28100		6-274-80 28200		6-275-80 28300		6-276-80 28400		6-277-80 28500		6-278-80 28600		6-279-80 28700		6-280-80 28800		6-281-80 28900		6-282-80 29000		6-283-80 29100		6-284-80 29200		6-285-80 29300		6-286-80 29400		6-287-80 29500		6-288-80 29600		6-289-80 29700		6-290-80 29800		6-291-80 29900		6-292-80 30000		6-293-80 30100		6-294-80 30200		6-295-80 30300		6-296-80 30400		6-297-80 30500		6-298-80 30600		6-299-80 30700		6-300-80 30800		6-301-80 30900		6-302-80 31000		6-303-80 31100		6-304-80 31200		6-305-80 31300		6-306-80 31400		6-307-80 31500		6-308-80 31600		6-309-80 31700		6-310-80 31800		6-311-80 31900		6-312-80 32000		6-313-80 32100		6-314-80 32200		6-315-80 32300		6-316-80 32400		6-317-80 32500		6-318-80 32600		6-319-80 32700		6-320-80 32800		6-321-80 32900		6-322-80 33000		6-323-80 33100		6-324-80 33200		6-325-80 33300		6-326-80 33400		6-327-80 33500		6-328-80 33600		6-329-80 33700		6-330-80 33800		6-331-80 33900		6-332-80 34000		6-333-80 34100		6-334-80 34200		6-335-80 34300		6-336-80 34400		6-337-80 34500		6-338-80 34600		6-339-80 34700		6-340-80 34800		6-341-80 34900		6-342-80 35000		6-343-80 35100		6-344-80 35200		6-345-80 35300		6-346-80 35400		6-347-80 35500		6-348-80 35600		6-349-80 35700		6-350-80 35800		6-351-80 35900		6-352-80 36000		6-353-80 36100		6-354-80 36200		6-355-80 36300		6-356-80 36400		6-357-80 36500		6-358-80 36600		6-359-80 36700		6-360-80 36800		6-361-80 36900		6-362-80 37000		6-363-80 37100		6-364-80 37200		6-365-80 37300		6-366-80 37400		6-367-80 37500		6-368-80 37600		6-369-80 37700		6-370-80 37800		6-371-80 37900		6-372-80 38000		6-373-80 38100		6-374-80 38200		6-375-80 38300		6-376-80 38400		6-377-80 38500		6-378-80 38600		6-379-80 38700		6-380-80 38800		6-381-80 38900		6-382-80 39000		6-383-80 39100		6-384-80 39200		6-385-80 39300		6-386-80 39400		6-387-80 39500		6-388-80 39600		6-389-80 39700		6-390-80 39800		6-391-80 39900		6-392-80 40000		6-393-80 40100		6-394-80 40200		6-395-80 40300		6-396-80 40400		6-397-80 40500		6-398-80 40600		6-399-80 40700		6-400-80 40800		6-401-80 40900		6-402-80 41000		6-403-80 41100		6-404-80 41200		6-405-80 41300		6-406-80 41400		6-407-80 41500		6-408-80 41600		6-409-80 41700		6-410-80 41800		6-411-80 41900		6-412-80 42000		6-413-80 42100		6-414-80 42200		6-415-80 42300		6-416-80 42400		6-417-80 42500		6-418-80 42600		6-419-80 42700		6-420-80 42800		6-421-80 42900		6-422-80 43000		6-423-80 43100		6-424-80 43200		6-425-80 43300		6-426-80 43400		6-427-80 43500		6-428-80 43600		6-429-80 43700		6-430-80 43800		6-431-80 43900		6-432-80 44000		6-433-80 44100		6-434-80 44200		6-435-80 44300		6-436-80 44400		6-437-80 44500		6-438-80 44600		6-439-80 44700		6-440-80 44800		6-441-80 44900		6-442-80 45000		6-443-80 45100		6-444-80 45200		6-445-80 45300		6-446-80 45400		6-447-80 45500		6-448-80 45600		6-449-80 45700		6-450-80 45800		6-451-80 45900		6-452-80 46000		6-453-80 46100		6-454-80 46200		6-455-80 46300		6-456-80 46400		6-457-80 46500		6-458-80 46600		6-459-80 46700		6-460-80 46800		6-461-80 46900		6-462-80 47000		6-463-80 47100		6-464-80 47200		6-465-80 47300		6-466-80 47400		6-467-80 47500		6-468-80 47600		6-469-80 47700		6-470-80 47800		6-471-80 47900		6-472-80 48000		6-473-80 48100		6-474-80 48200		6-475-80 48300		6-476-80 48400		6-477-80 48500		6-478-80 48600		6-479-80 48700		6-480-80 48800		6-481-80 48900		6-482-80 49000		6-483-80 49100		6-484-80 49200		6-485-80 49300		6-486-80 49400		6-487-80 49500		6-488-80 49600		6-489-80 49700		6-490-80 49800		6-491-80 49900		6-492-80 50000		6-493-80 50100		6-494-80 50200		6-495-80 50300		6-496-80 50400		6-497-80 50500		6-498-80 50600		6-499-80 50700		6-500-80 50800		6-501-80 50900		6-502-80 51000		6-503-80 51100		6-504-80 51200		6-505-80 51300		6-506-80 51400		6-507-80 51500		6-508-80 51600		6-509-80 51700		6-510-80 51800		6-511-80 51900		6-512-80 52000		6-513-80 52100		6-514-80 52200		6-515-80 52300		6-516-80 52400		6-517-80 52500		6-518-80 52600		6-519-80 52700		6-520-80 52800		6-521-80 52900		6-522-80 53000		6-523-80 53100		6-524-80 53200		6-525-80 53300		6-526-80 53400		6-527-80 53500		6-528-80 53600		6-529-80 53700		6-530-80 53800		6-531-80 53900		6-532-80 54000		6-533-80 54100		6-534-80 54200		6-535-80 54300		6-536-80 54400		6-537-80 54500		6-538-80 54600		6-539-80 54700		6-540-80 54800		6-541-80 54900		6-542-80 55000		6-543-80 55100		6-544-80 55200		6-545-80 55300		6-546-80 55400		6-547-80 55500		6-548-80 55600		6-549-80 55700		6-550-80 55800		6-551-80 55900		6-552-80 56000		6-553-80 56100		6-554-80 56200		6-555-80 56300		6-556-80 56400		6-557-80 56500		6-558-80 5	
--------------	--	--------------	--	---------------	--	---------------	--	---------------	--	---------------	--	---------------	--	---------------	--	---------------	--	---------------	--	----------------	--	----------------	--	------------	--

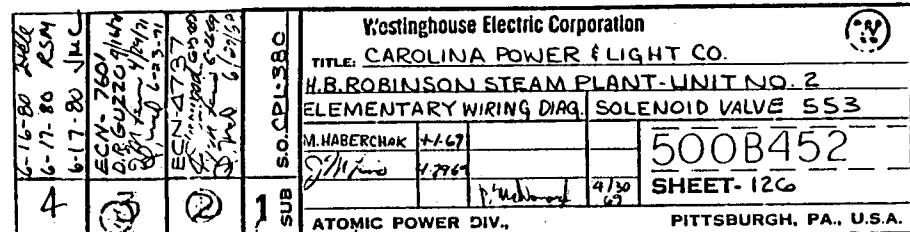

[illegible]



OK

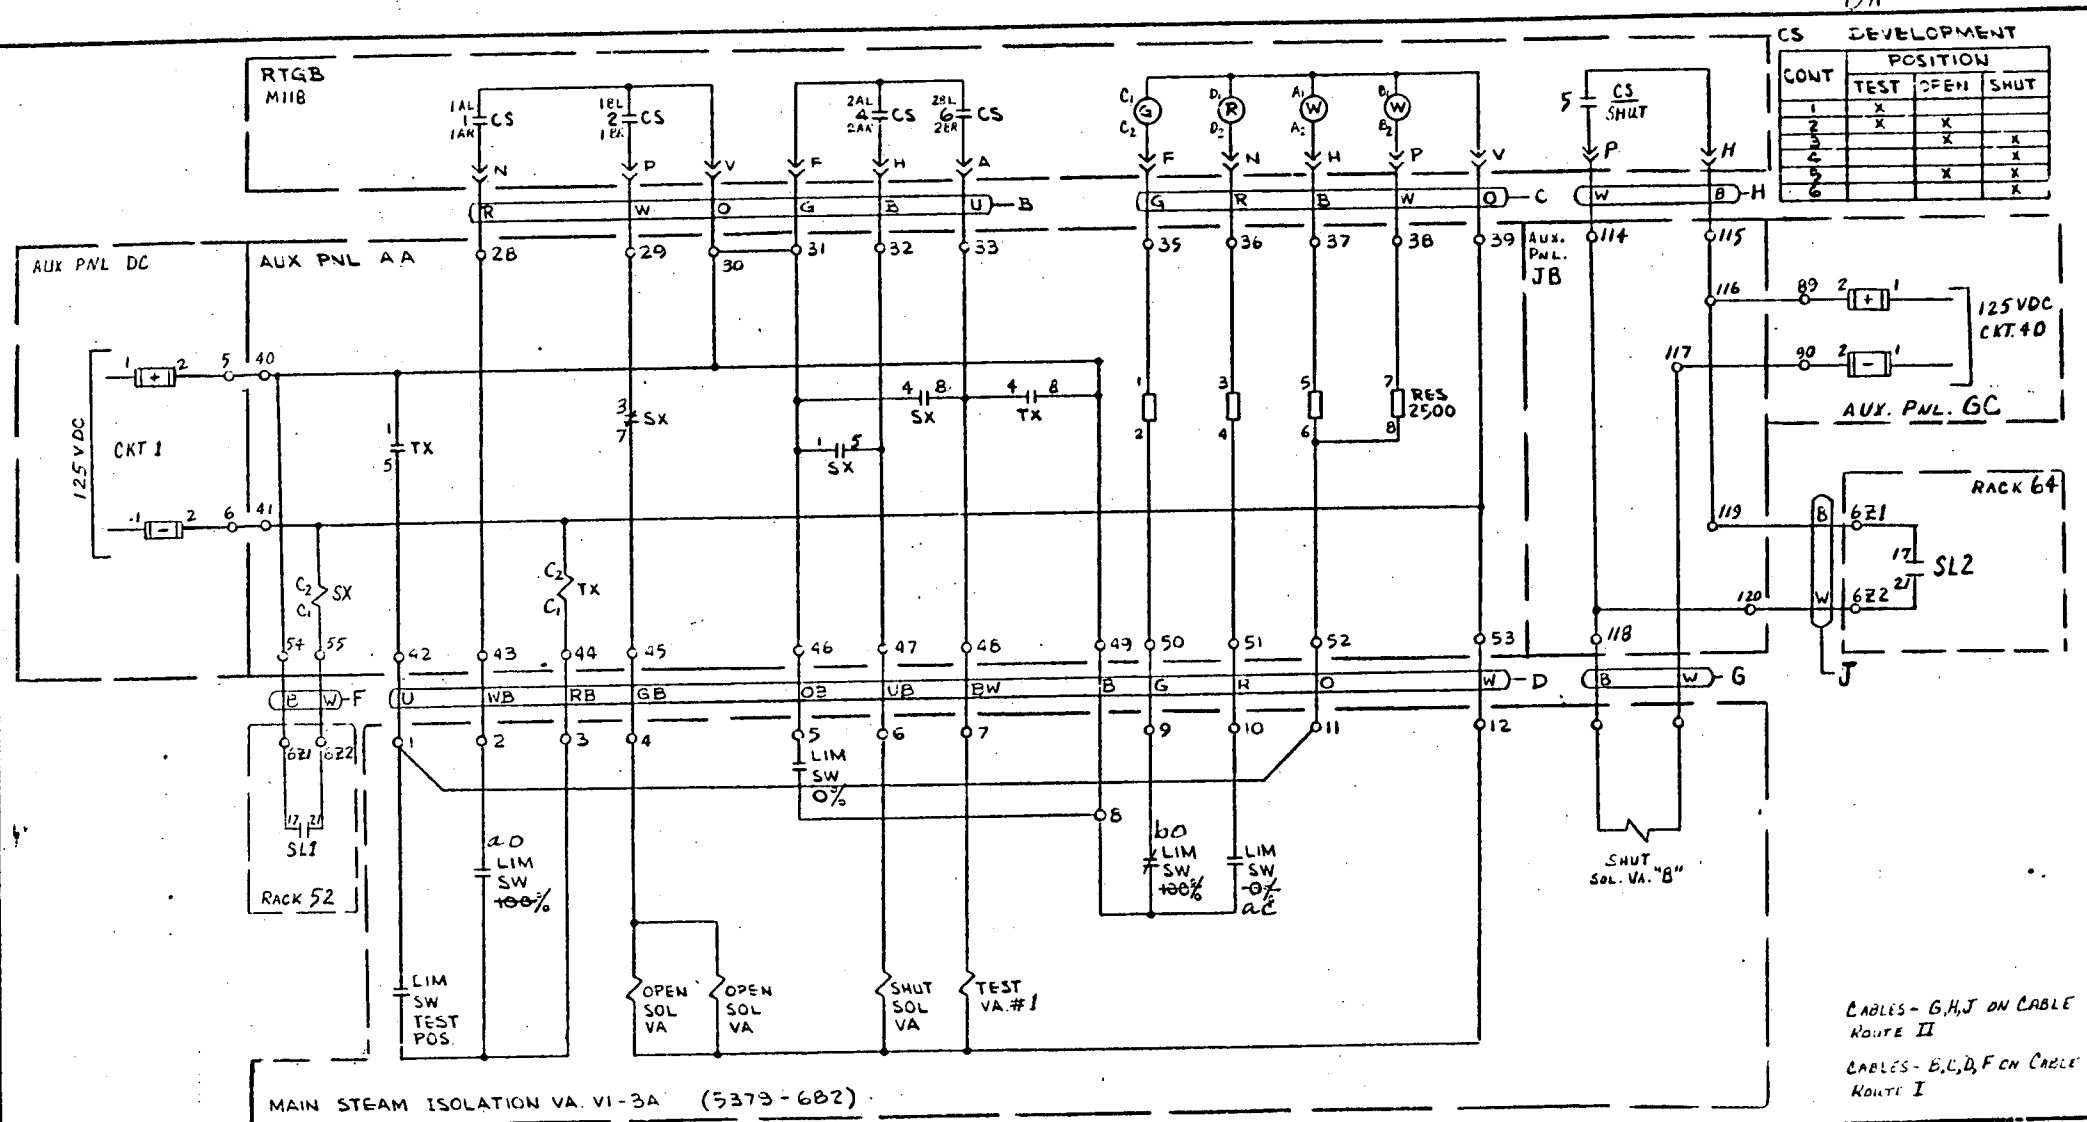

CS DEVELOPMENT

CONT	POSITION		
	TEST	OPEN	SHUT
1	X	X	
2	X	X	X
3		X	X
4		X	X
5		X	X
6		X	X

CABLES - G, H, J ON CABLE ROUTE II  
CABLES - B, C, D, F ON CABLE ROUTE I


REV	DATE	BY	APPROVED
1	12-27-74	SS	TS
2	2-12-75	SS	TS
3	6-14-75	SS	TS

EBASCO DWG B-190628  
EBASCO SERVICES INCORPORATED  
NEW YORK  
DIV. ELEC. DR. GSC  
SCALE: CM. VE  
DATE: MAR 17, 1969  
APPROVED: K. Brokaw  
SS

MAIN STEAM ISOLATION VA. VI-3A

1	SUB	S.O. CPL-350		Westinghouse Electric Corporation	
		TITLE: CAROLINA POWER & LIGHT COMPANY		H. B. ROBINSON STEAM ELECTRIC PLANT	
		CONTROL WIRING DIAGRAM		500B452	
		SHEET 141		PITTSBURGH, PA., U.S.A.	
		ATOMIC POWER DIV.			

OK

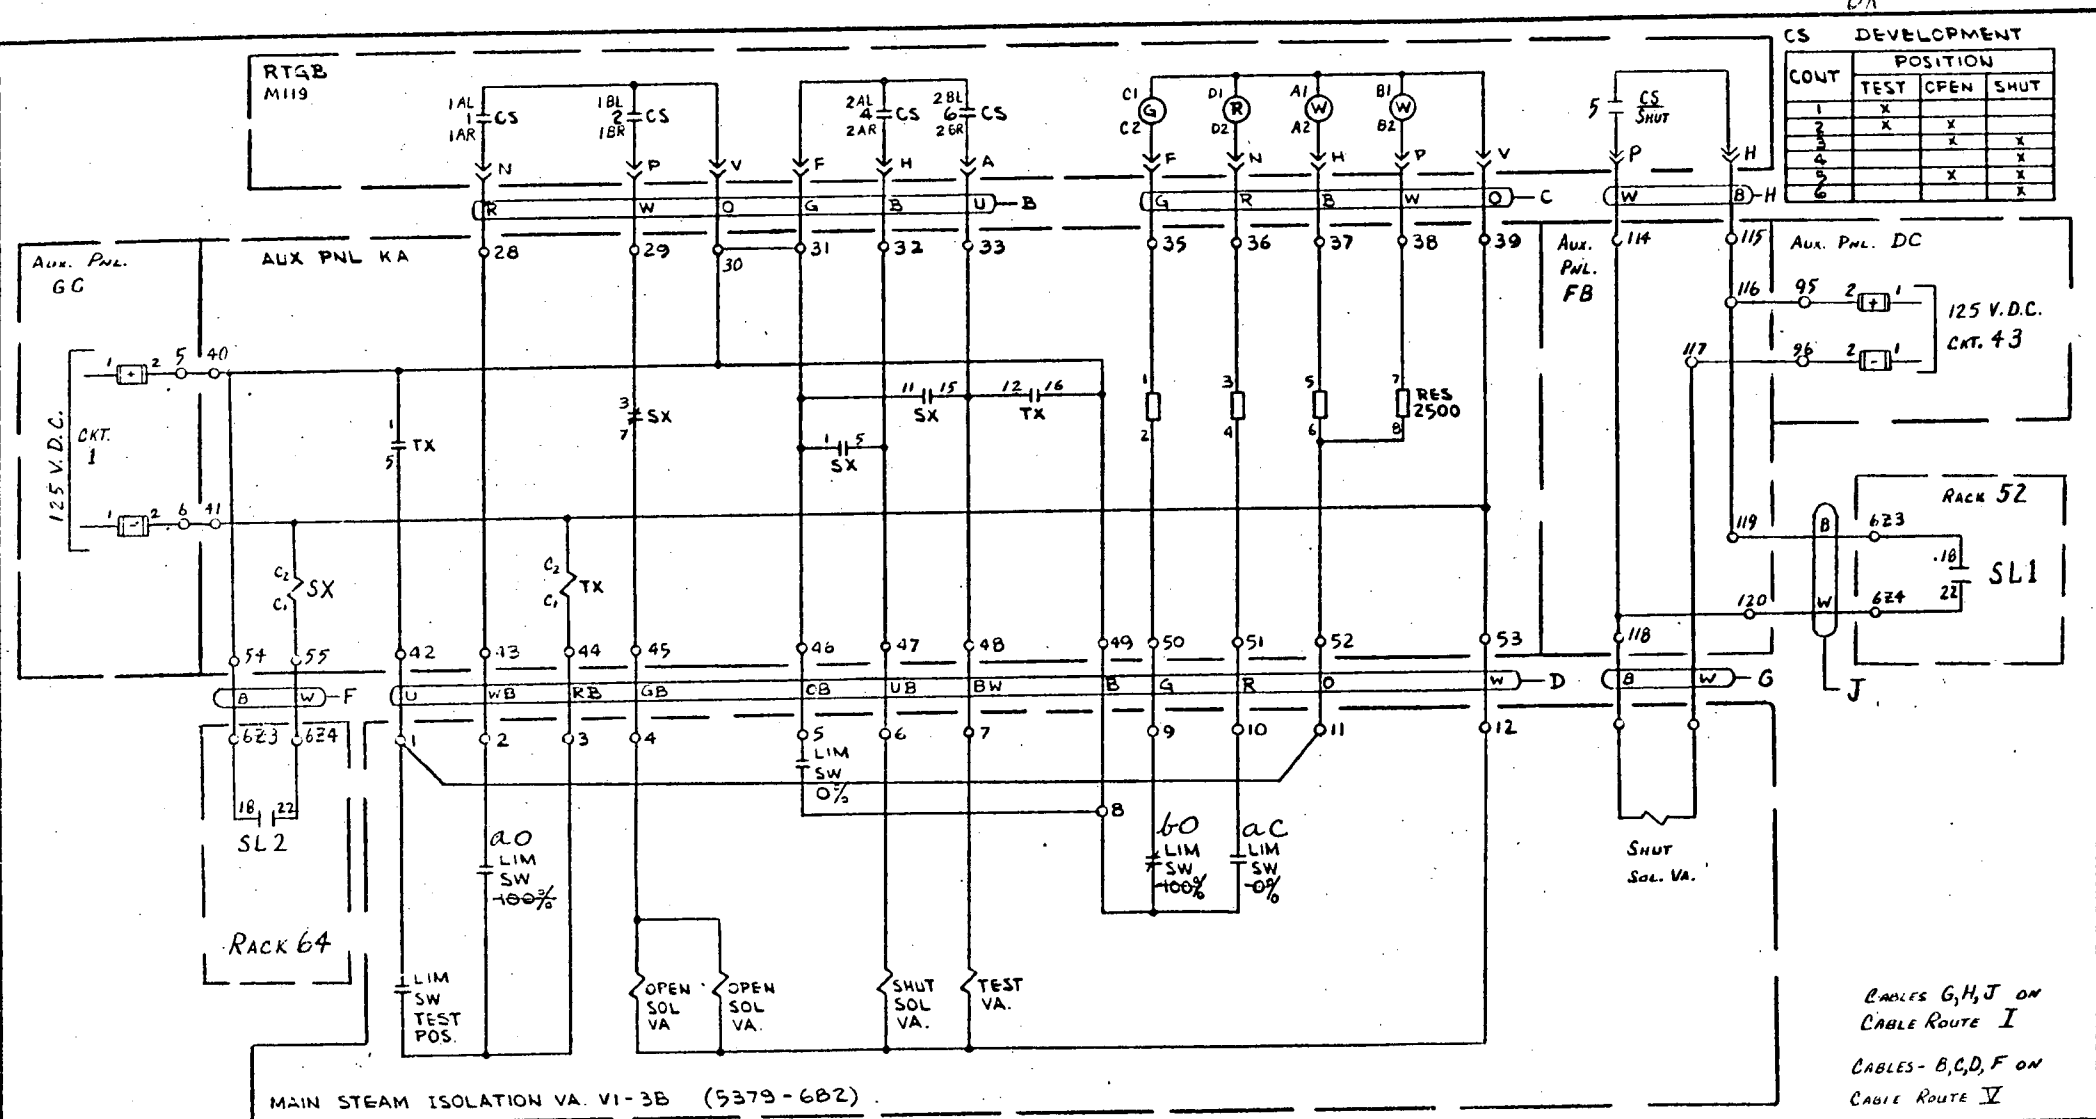

CS DEVELOPMENT

CONT	POSITION		
	TEST	CPEN	SHUT
1	X		
2	X	X	
3		X	X
4		X	X
5		X	X
6		X	X

CABLES G, H, J ON  
CABLE ROUTE I

CABLES - B, C, D, F ON  
CABLE ROUTE V

REV	DATE	BY	APPROVED	REV	DATE	BY	APPROVED
1	1-11-56	RSM	1/1/56	1	1-11-56	RSM	1/1/56
2	2-12-56	SSC	1/1/56	2	2-12-56	SSC	1/1/56
3	3-22-56	SSC	1/1/56	3	3-22-56	SSC	1/1/56
4	10-27-56	SSC	1/1/56	4	10-27-56	SSC	1/1/56

EBASCO DWG B-190628

EBASCO SERVICES INCORPORATED  
NEW YORK

DIV. ELEC. DR. G. S. S.  
SCALE - CH. V. 2  
DATE MAR 17, 1969

APPROVED  
K. Brockwell  
V. 16 55

MAIN STEAM  
ISOLATION VA VI-3B

Westinghouse Electric Corporation

TITLE: CAROLINA POWER & LIGHT COMPANY  
H. B. ROBINSON STEAM ELECTRIC PLANT

CONTROL WIRING DIAGRAM

500B452  
SHEET 144


ATOMIC POWER DIV., PITTSBURGH, PA., U.S.A.

1 SUB

S.O. CPL-380

4/1/59

OK

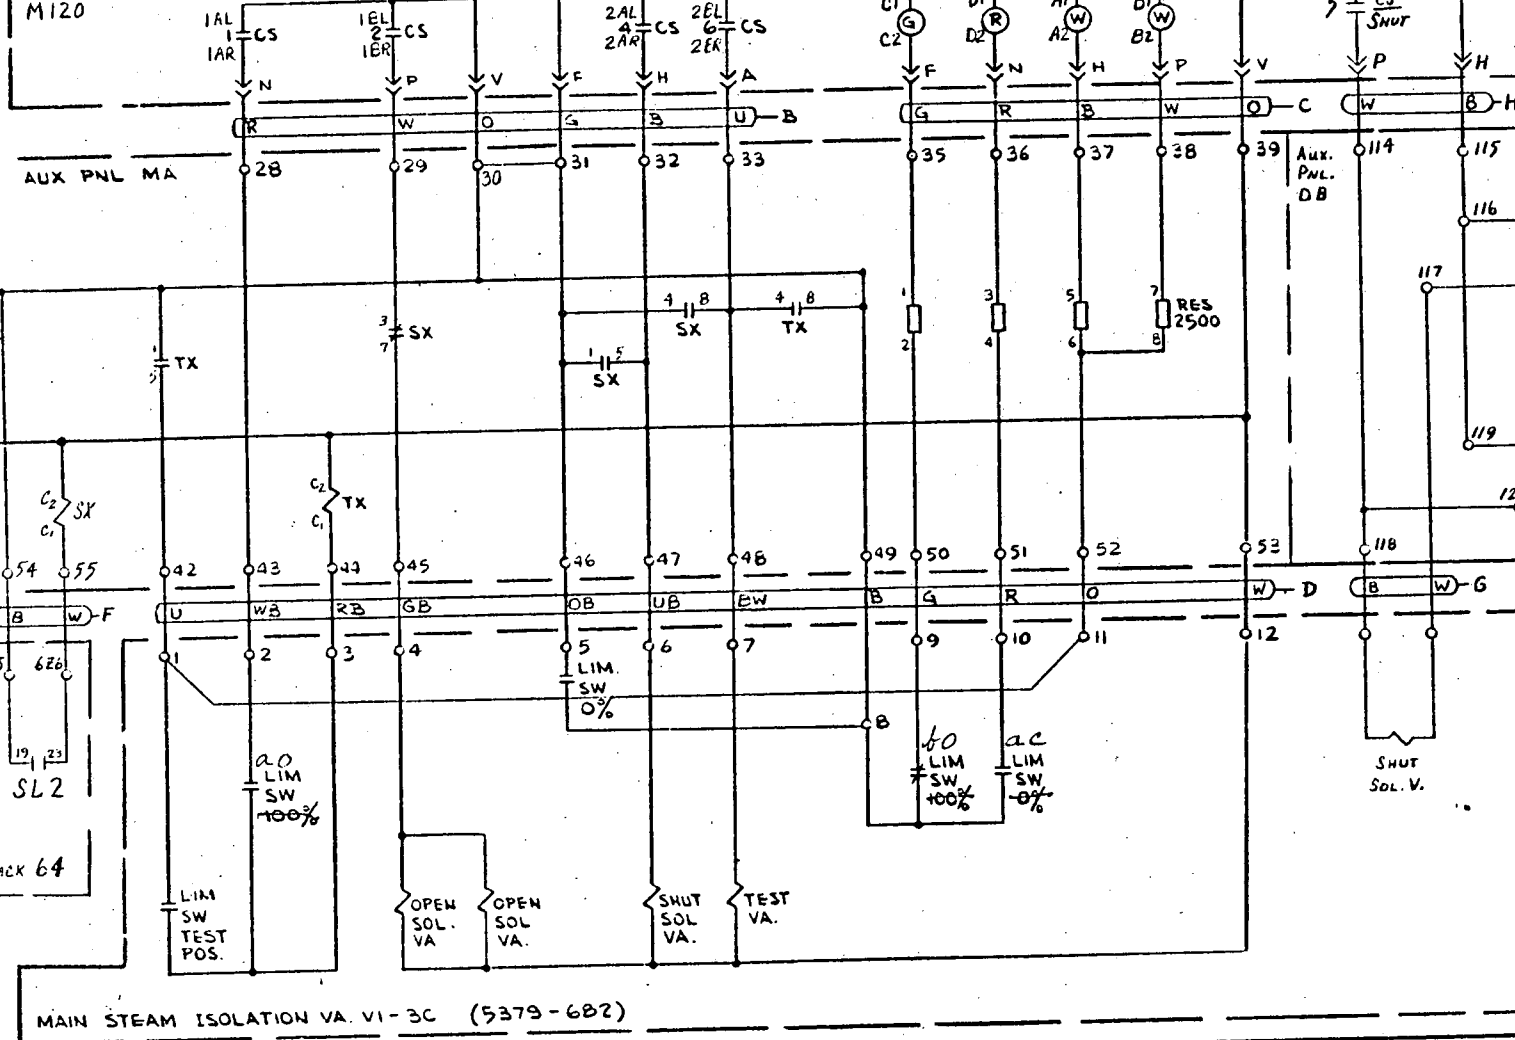RTGB  
M120

CONT	POSITION		
	TEST	OPEN	SHUT
1	X	X	
2	X	X	X
3		X	X
4		X	X
5		X	X
6		X	X


CABLES - G, H, J ON  
CABLE ROUTE IVCABLES - B, C, D, F ON  
CABLE ROUTE III


REV	DATE	BY	APPROVED	REV	DATE	BY	APPROVED
1	10-17-66	WJC		2	11-17-66	WJC	
2	11-17-66	WJC		3	11-17-66	WJC	
3	11-17-66	WJC		4	11-17-66	WJC	

EBASCO DWG B-190628  
EBASCO SERVICES INCORPORATED  
NEW YORK  
DIV. ELEC. DR. GSC  
SCALE - CH. VB  
DATE MAR 17, 1969  
APPROVED  
K. Brockwell

MAIN STEAM  
ISOLATION VA VI-3C

S.O. CPL-380 1 SUB	Westinghouse Electric Corporation		500B452 SHEET 147 PITTSBURGH, PA. U.S.A.
	TITLE: CAROLINA POWER & LIGHT COMPANY H. B. ROBINSON STEAM ELECTRIC PLANT		
	CONTROL WIRING DIAGRAM		
	<div style="display: flex; justify-content: space-between;"> <div> <p>11/3</p> <p>11/17/66</p> </div> <div> <p>11/17/66</p> <p>11/17/66</p> </div> </div>		

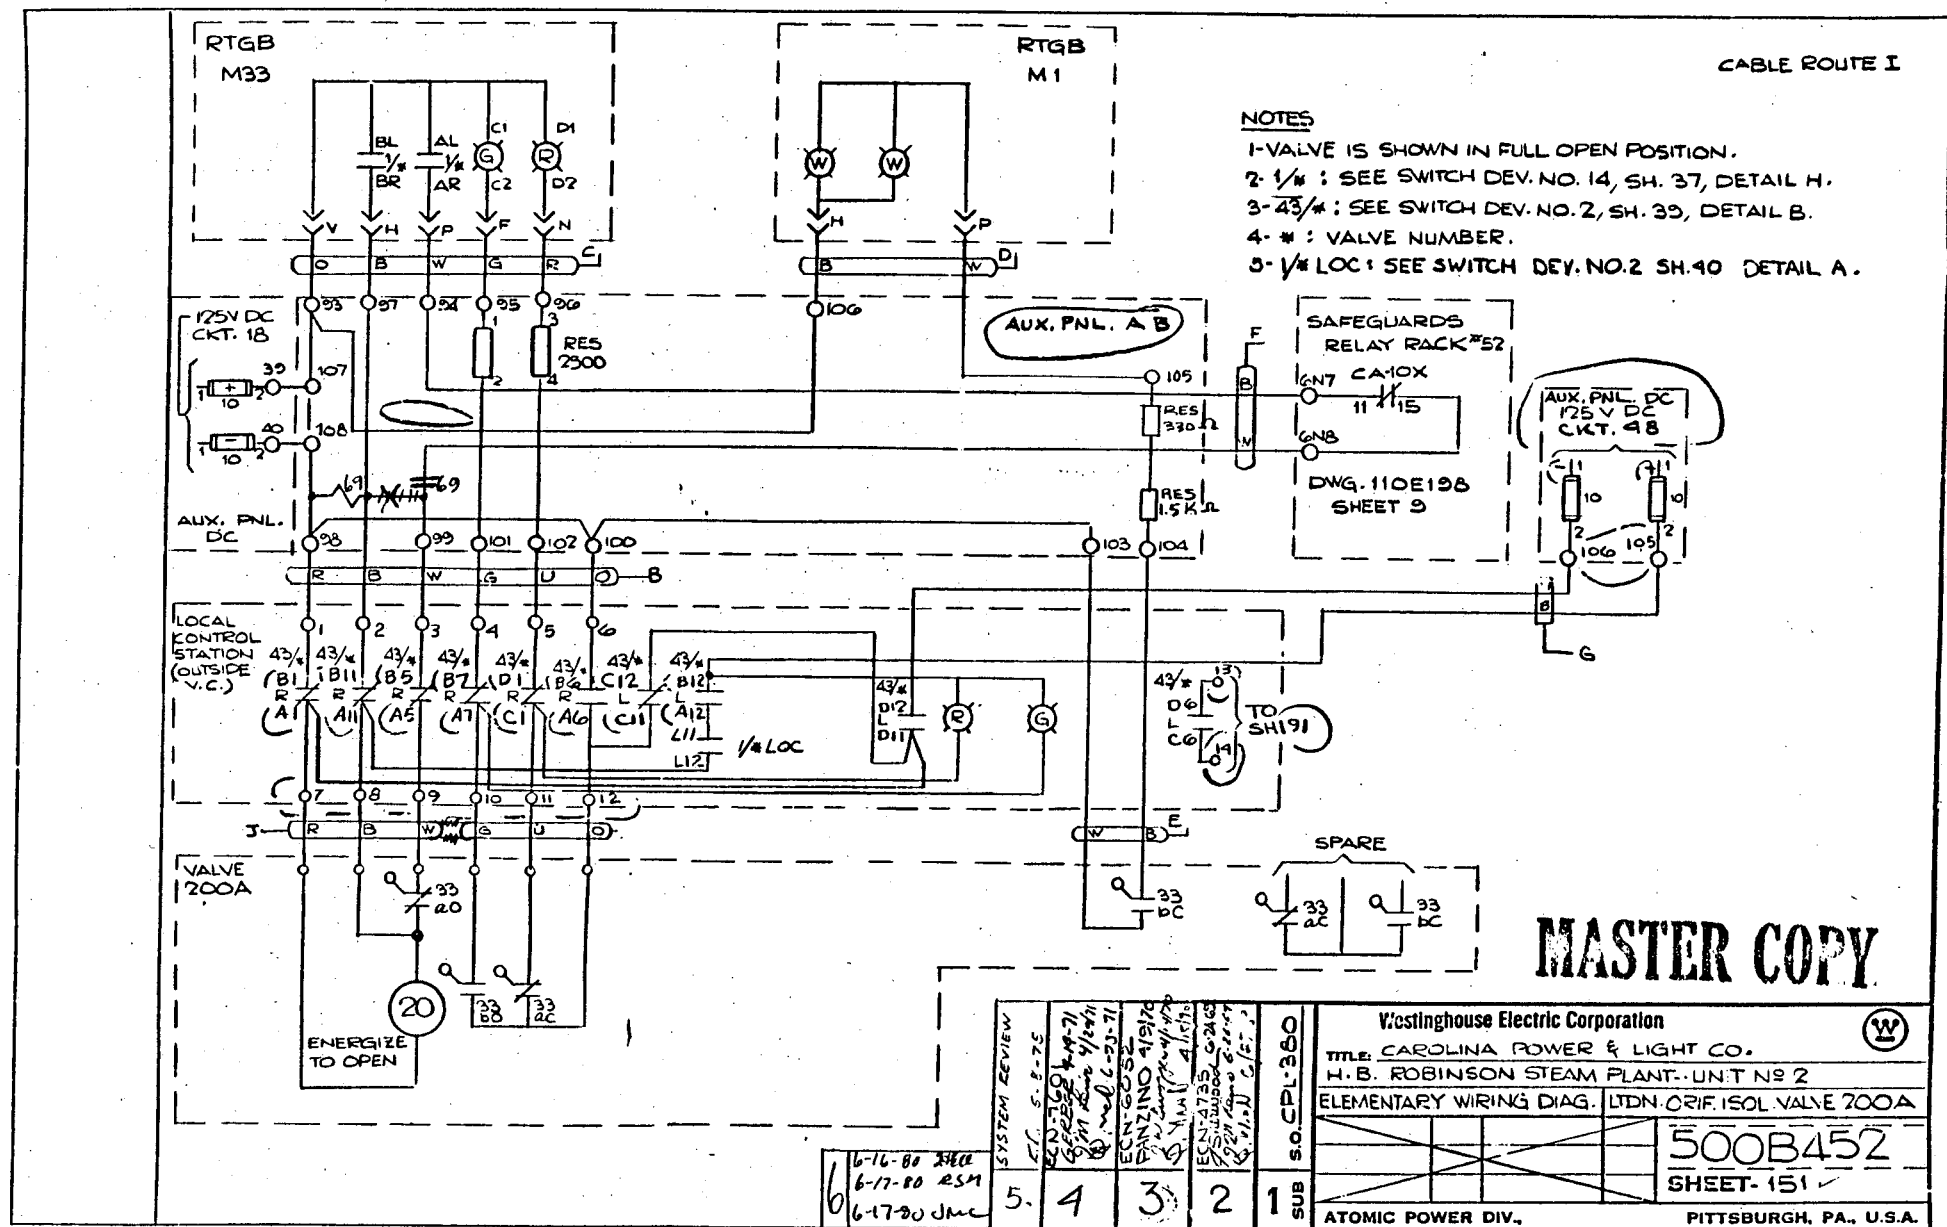

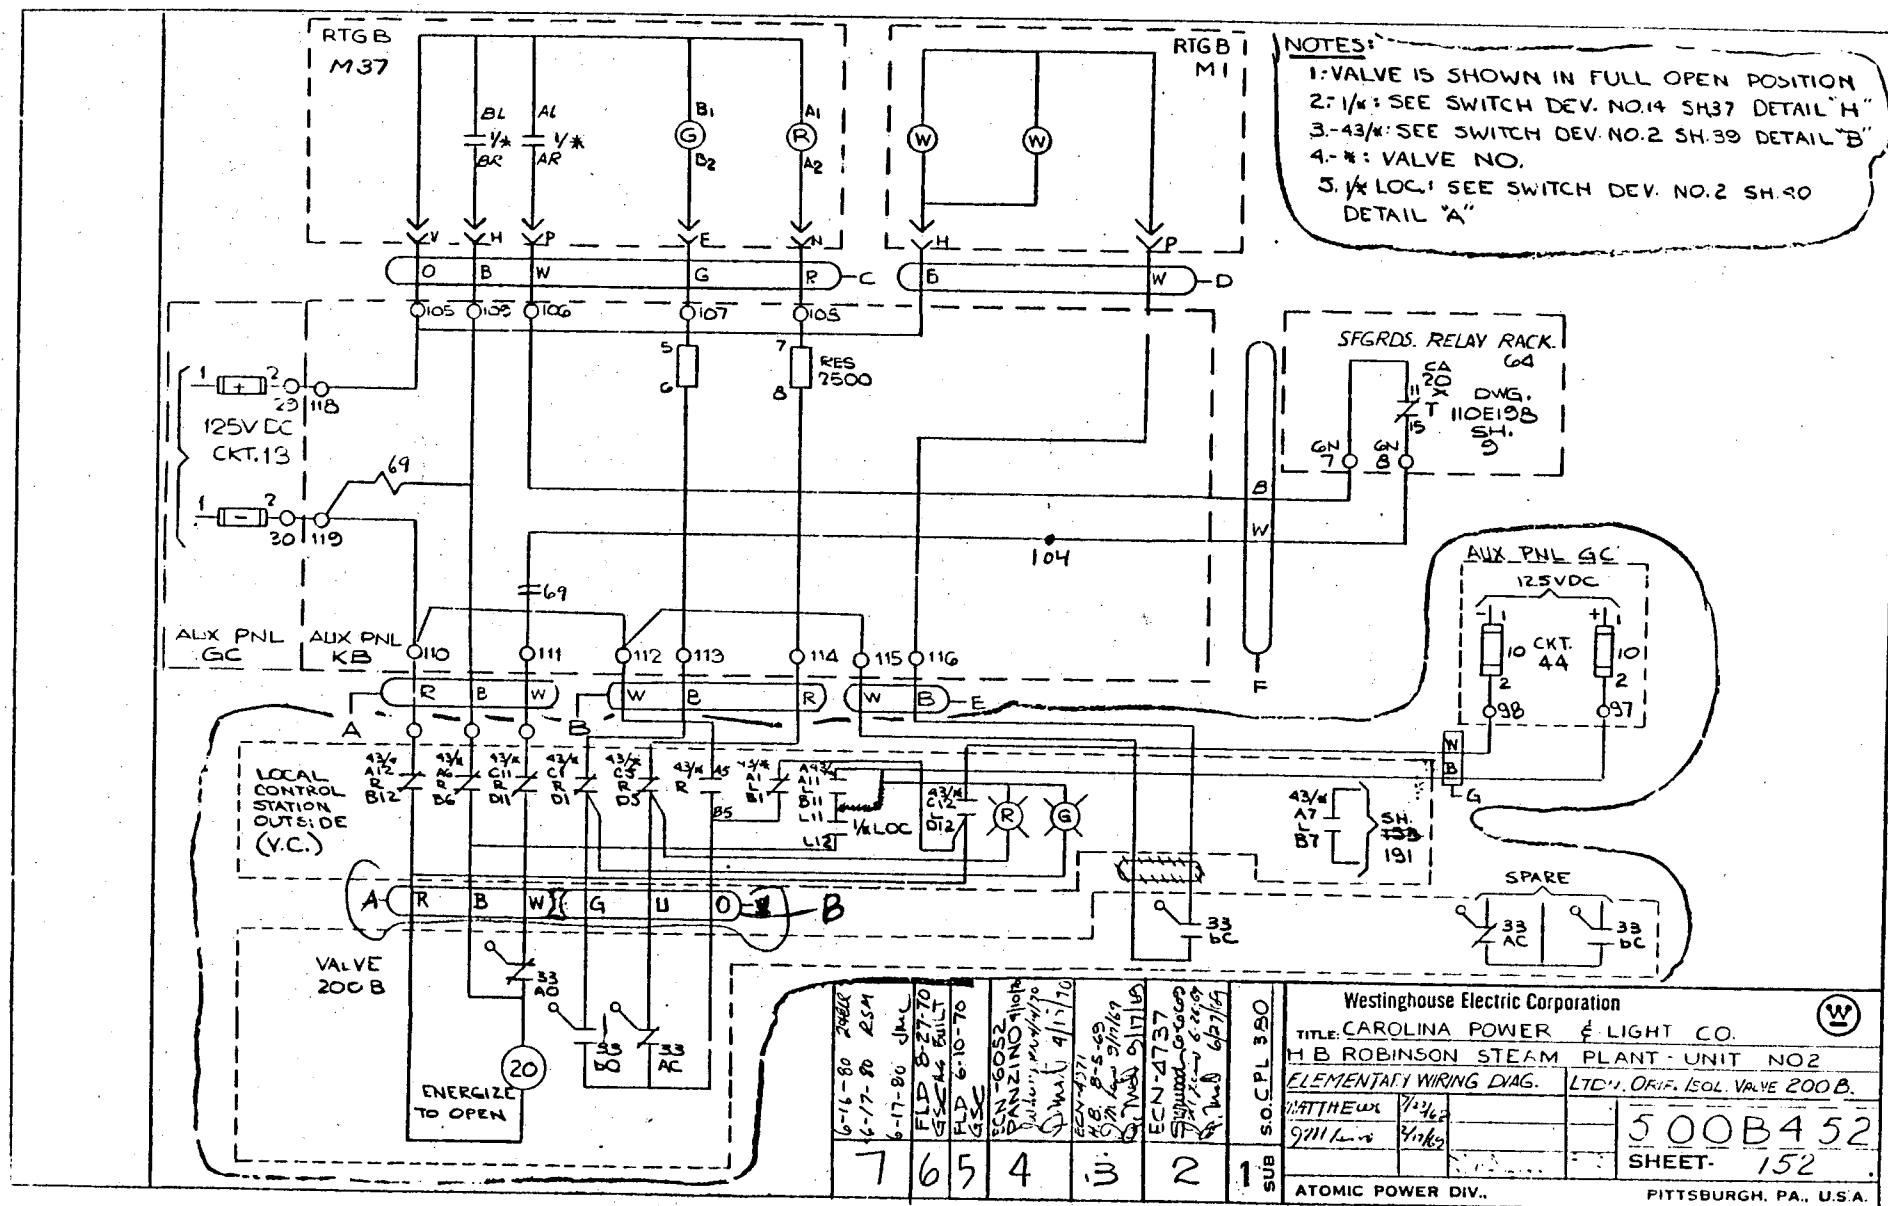


RTGB  
M37.RTGB.  
M.I.

CABLE ROUTE IV

## NOTES:

- 1.- VALVE IS SHOWN IN FULL OPEN POSITION
- 2.- 1/4" SEE SWITCH DEV. NO.14 SH.57 DETAIL "H"
- 3.- 45/4 SEE SWITCH DEV. NO.2 SH.39 DETAIL "B"
- 4.- VALVE NO.
- 5 1/4 LOC. - SEE SWITCH DEV. NO.2 SH.40 DETAIL "A"

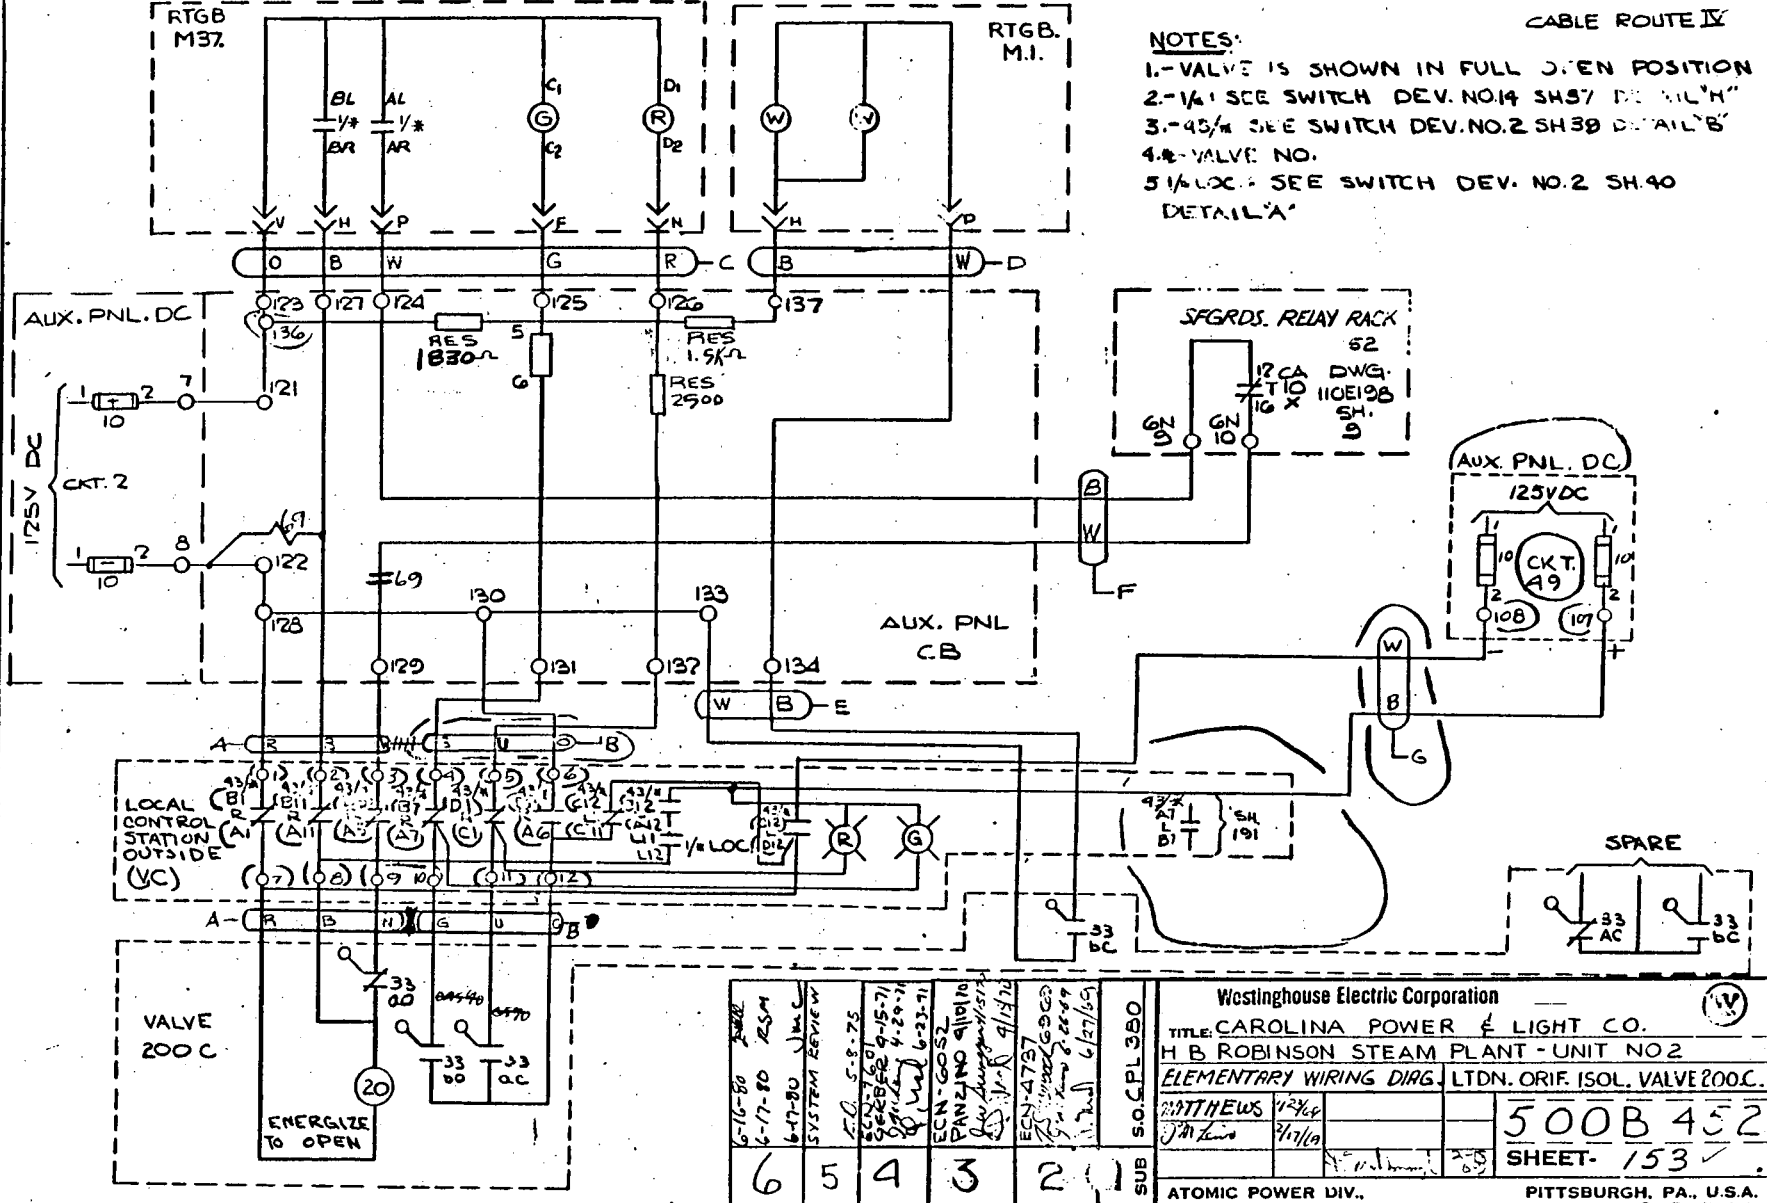

Westinghouse Electric Corporation

TITLE: CAROLINA POWER &amp; LIGHT CO.

H B ROBINSON STEAM PLANT - UNIT NO 2

ELEMENTARY WIRING DIAG. LTDN. ORIG. ISOL. VALVE 200C.

MATTHEWS

12/24

1/17/69

500B 452

SHEET- 153

ATOMIC POWER DIV.,



PITTSBURGH, PA., U.S.A.

MASTER COPY






5	6-17-80 2468
4	6-17-80 254
3	6-18-80 246
2	6-18-80 246
1	6-18-80 246

TITLE: CAROLINA POWER & LIGHT CO.			
H B ROBINSON STEAM PLANT - UNIT NO 2			
ELEMENTARY WIRING DIAG.		LTDN. LINE 150L. VA 204.B	
MATTHEWS / 12/4			


SHEET  
#155 ✓

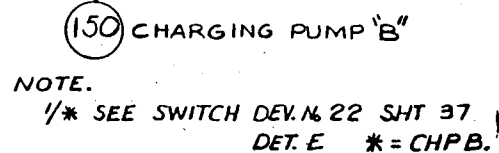

[illegible]





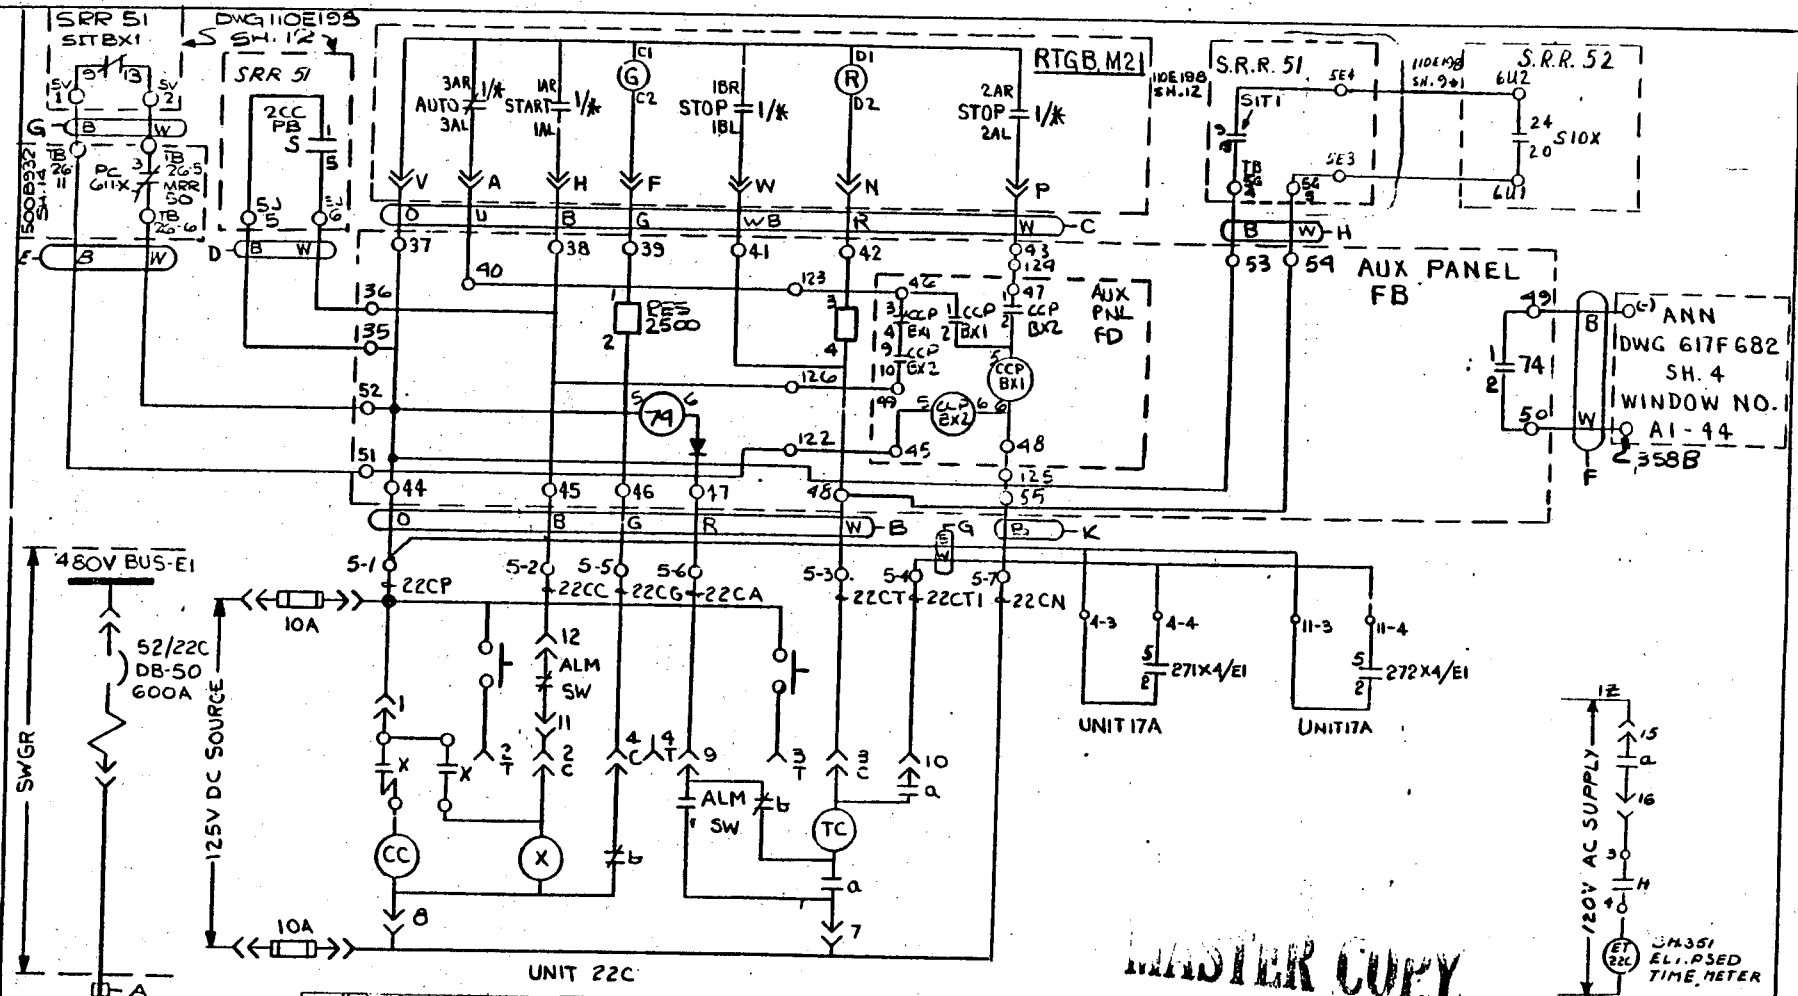

NOTE.  
 V\* SEE SWITCH DEV 13 SHT 38.  
 DET. H \* = CCPB

10	9	8	7	6	5	4	3	2	1
ECN 8063 10/18/77 10/22/77 10/23/77 10/23/77 10/23/77 10/23/77 10/23/77 10/23/77 10/23/77 10/23/77	ECN 8063 10/18/77 10/22/77 10/23/77 10/23/77 10/23/77 10/23/77 10/23/77 10/23/77 10/23/77	ECN 8063 10/18/77 10/22/77 10/23/77 10/23/77 10/23/77 10/23/77 10/23/77 10/23/77 10/23/77	ECN 8063 10/18/77 10/22/77 10/23/77 10/23/77 10/23/77 10/23/77 10/23/77 10/23/77 10/23/77	ECN 8063 10/18/77 10/22/77 10/23/77 10/23/77 10/23/77 10/23/77 10/23/77 10/23/77 10/23/77	ECN 8063 10/18/77 10/22/77 10/23/77 10/23/77 10/23/77 10/23/77 10/23/77 10/23/77 10/23/77	ECN 8063 10/18/77 10/22/77 10/23/77 10/23/77 10/23/77 10/23/77 10/23/77 10/23/77 10/23/77	ECN 8063 10/18/77 10/22/77 10/23/77 10/23/77 10/23/77 10/23/77 10/23/77 10/23/77 10/23/77	ECN 8063 10/18/77 10/22/77 10/23/77 10/23/77 10/23/77 10/23/77 10/23/77 10/23/77 10/23/77	ECN 8063 10/18/77 10/22/77 10/23/77 10/23/77 10/23/77 10/23/77 10/23/77 10/23/77 10/23/77

MASTER COPY

Westinghouse Electric Corporation

TITLE: CAROLINA POWER & LIGHT CO.

H.B. ROBINSON STEAM PLANT - UNIT NO. 2

ELEMENTARY WIRING DIAG COMPONENT COOLING PUMP B


500B452

SHEET-205

ATOMIC POWER DIV., PITTSBURGH, PA., U.S.A.




10	9	8	7	6	5	4	3	2	1
PLANT MOD. # 34	ECN 5503 G TURBA 101477 31/12/70 11:23:27	ECN 5504 G TURBA 101477 31/12/70 11:23:27	ECN 5505 G TURBA 101477 31/12/70 11:23:27	ECN 5506 G TURBA 101477 31/12/70 11:23:27	ECN 5507 G TURBA 101477 31/12/70 11:23:27	ECN 5508 G TURBA 101477 31/12/70 11:23:27	ECN 5509 G TURBA 101477 31/12/70 11:23:27	ECN 5510 G TURBA 101477 31/12/70 11:23:27	ECN 5511 G TURBA 101477 31/12/70 11:23:27

Westinghouse Electric Corporation					
TITLE: CAROLINA POWER & LIGHT CO.					
H.B. ROBINSON STEAM PLANT - UNIT NO. 2					
ELEMENTARY WIRING DIAG			COMPONENT COOLING PUMP "C"		
Shearer	7/16/48			500B 452	
J.M. Jones	11/16/48			SHEET - 209	
ATOMIC POWER DIV.			PITTSBURGH, PA., U.S.A.		



1 RTGB.M.27

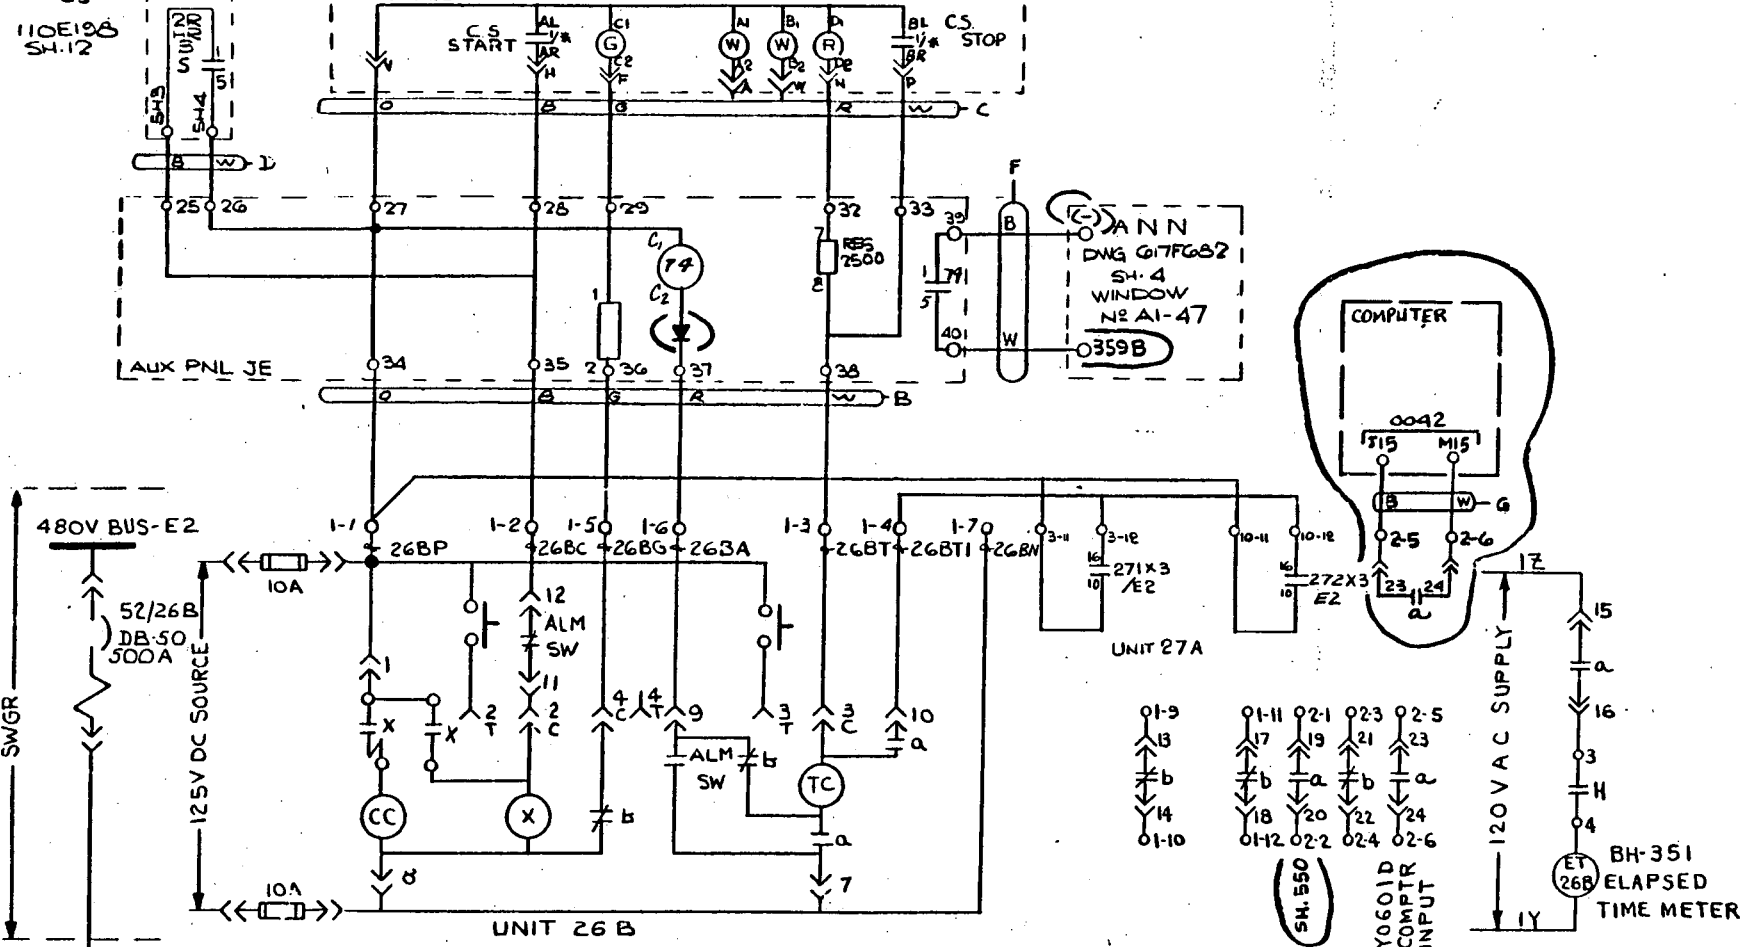


**NOTE.**

1/\* SEE SWITCH DEV No. 22. SHT 37  
DET. E \* = RHRP-B.

7	6	5	4	3	2	1	SUB	G.O.	CPL-380	Westinghouse Electric Corporation TITLE: CAROLINA POWER & LIGHT CO. H.B. ROBINSON STEAM PLANT - UNIT NO. 2 ELEMENTARY WIRING DIAG. RESIDUAL HEAT REMOVAL PUMP 'B' J.M.A.T.H.E.W.S. 4-4-46 J.M. King 1/4/48 Pittsburgh, Pa. SHEET- 216 ATOMIC POWER DIV., PITTSBURGH, PA., U.S.A.		(W)
SYSTEM REVIEW M.C.M. 3-26-75 ECN-5597 TURBA 2-11-70 TURBA 2-12-70 TURBA 3-11-70 ECN-4737 TURBA 2-10-69 TURBA 2-10-69 TURBA 3-10-69 TUR												






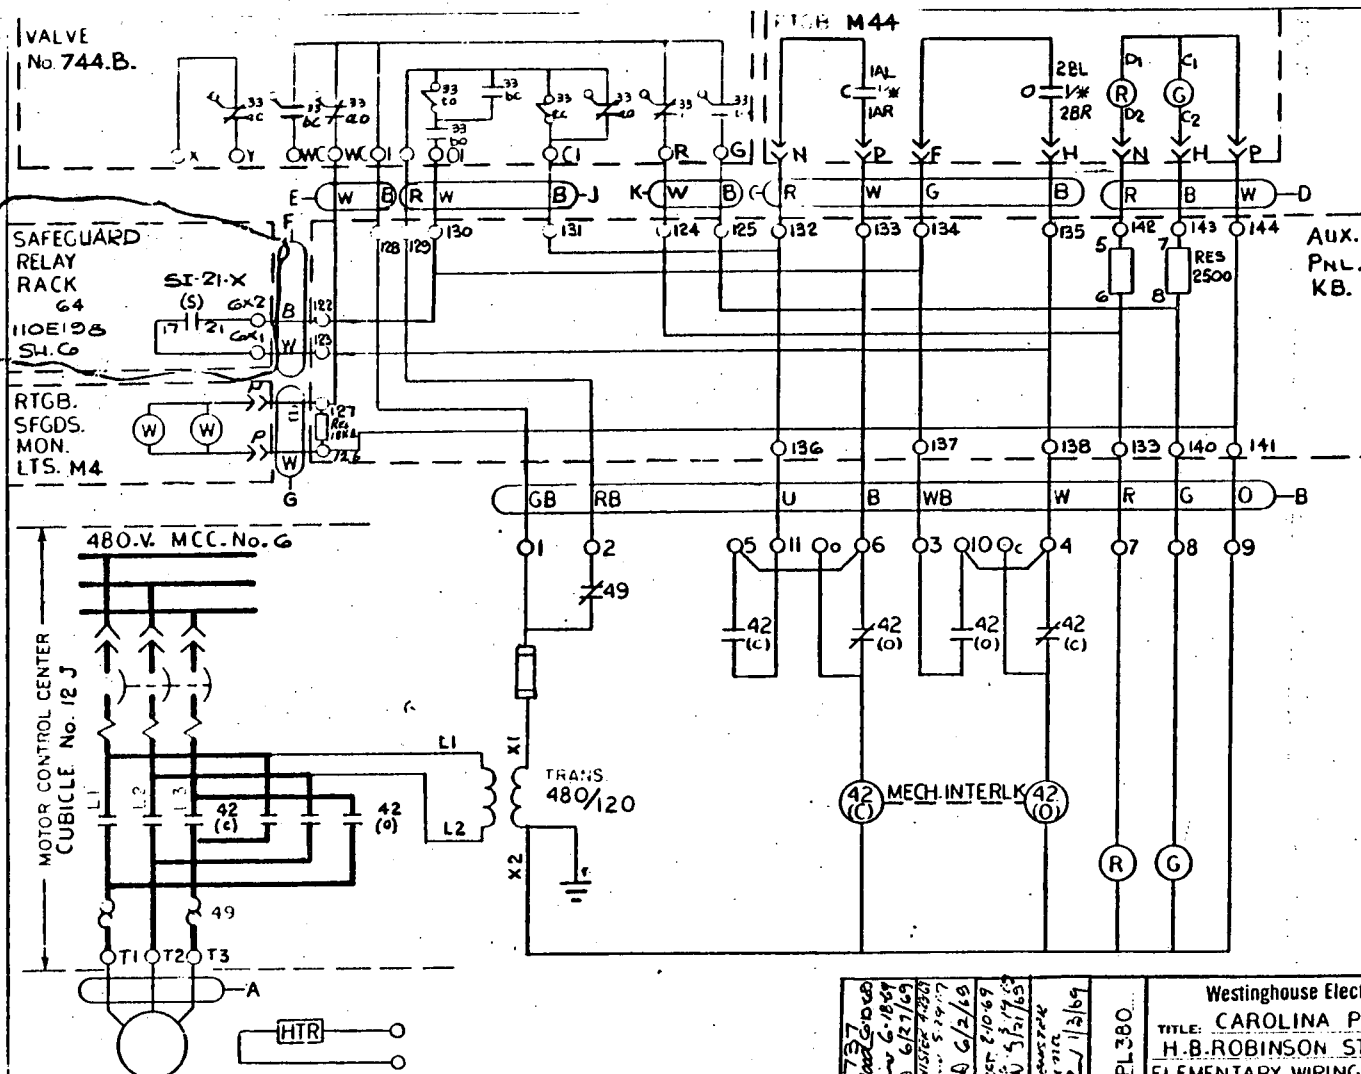

NOTE  
VALVE SHOWN IN FULL OPEN POSITION.  
1/\* SEE SWITCH DEV. No. 16 SHT. 37  
DET. 4    \* = VALVE No

ESEN-4787 S. Hines Dm Lw 6-10-69	W. R. Adams Rd Wad 6/12/69	G. S. GLENISTER Glenister 6/26/69	S. J. MORGAN Morgan 6/26/69	T. E. CLARK Clark 6/26/69
5	4	3	2	1
so. CPL 380.				
Westinghouse Electric Corporation				
TITLE: CAROLINA POWER & LIGHT Co.				
H.B. ROBINSON STEAM PLANT - UNIT No. 2.				
ELEMENTARY WIRING DIAG. RHR Loop To RES COND LEG VALVE 744B				
GLENISTER <i>Strina</i>		<i>RFA</i>		500 B 452
		<i>"6/8"</i>		SHEET- 221 .
ATOMIC POWER DIV.,			PITTSBURGH, PA., U.S.A.	

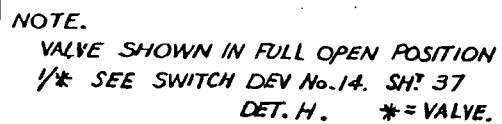

ELN-1600 I.G. 4-5-71 JALC 5-3-71 C. W. 6-23-71	ELN-4737 I.G. 8-6-69 JALC 9-17-69 C. W. 9-17-69	ELN-4737 I.G. 8-6-69 JALC 9-17-69 C. W. 9-17-69	30 CPL 380	Westinghouse Electric Corporation TITLE: <u>CAROLINA POWER &amp; LIGHT Co.</u> <u>H.B. ROBINSON STEAM PLANT- UNIT No.2</u> <u>ELEMENTARY WIRING DIAG.</u> EXCESS LETDOWN HX. OUTLET ISOL VA 735 J.H.B. 4/1/73 John Fano 4/1/73	500 B 452 SHEET- 229
4	2	3	ATOMIC POWER DIV.,	PITTSBURGH, PA., U.S.A.	









OK TW 8-14-78

CABLE ROUTE II

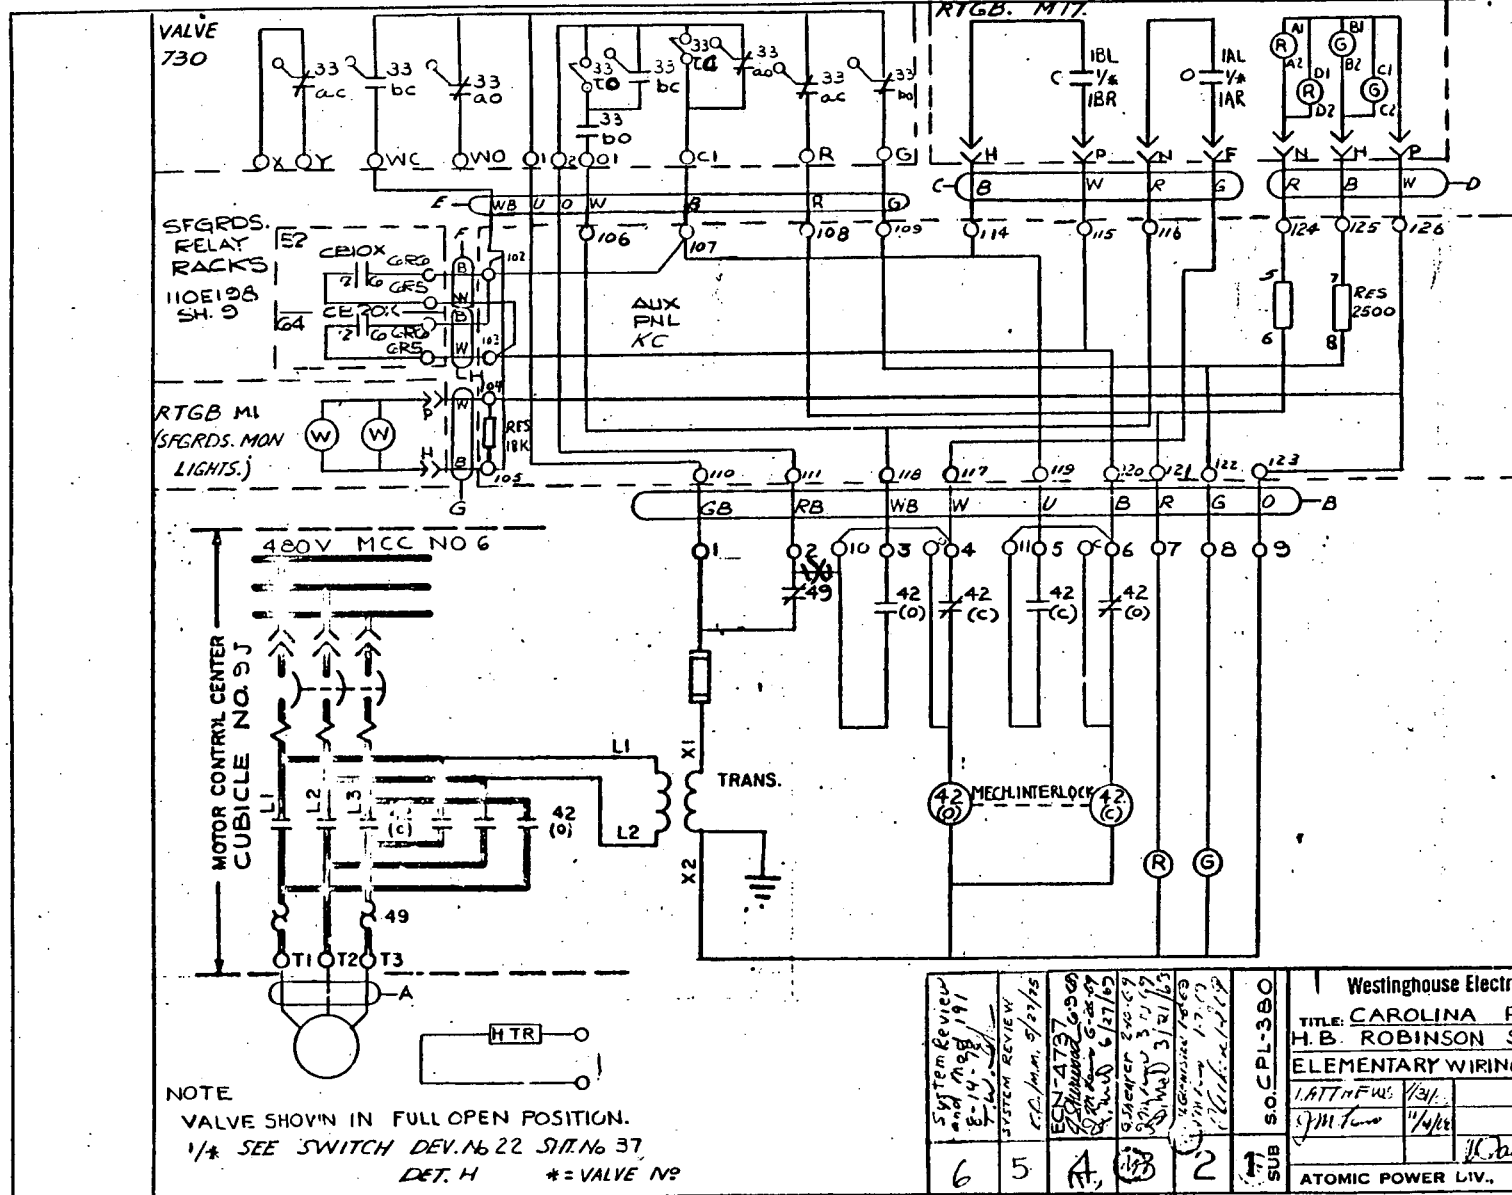

System Review and 11/28/78 6-14-78 W. W.						SYSTEM REVIEW 10/11/78 10/11/78 10/11/78 10/11/78 10/11/78 10/11/78						6 5 4 3 2 1 SUB																	
Westinghouse Electric Corporation																													
TITLE: CAROLINA POWER & LIGHT CO																													
H.B. ROBINSON STEAM PLANT UNIT NO. 2																													
ELEMENTARY WIRING DIAG. RCP. B'NG. Cool WTR. OUT. SET Vlt 730																													
1/11/78 1/11/78 1/11/78 1/11/78 1/11/78 1/11/78																													
500B 452																													
SHEET- 233																													
ATOMIC POWER DIV., PITTSBURGH, PA., U.S.A.																													

B-190628

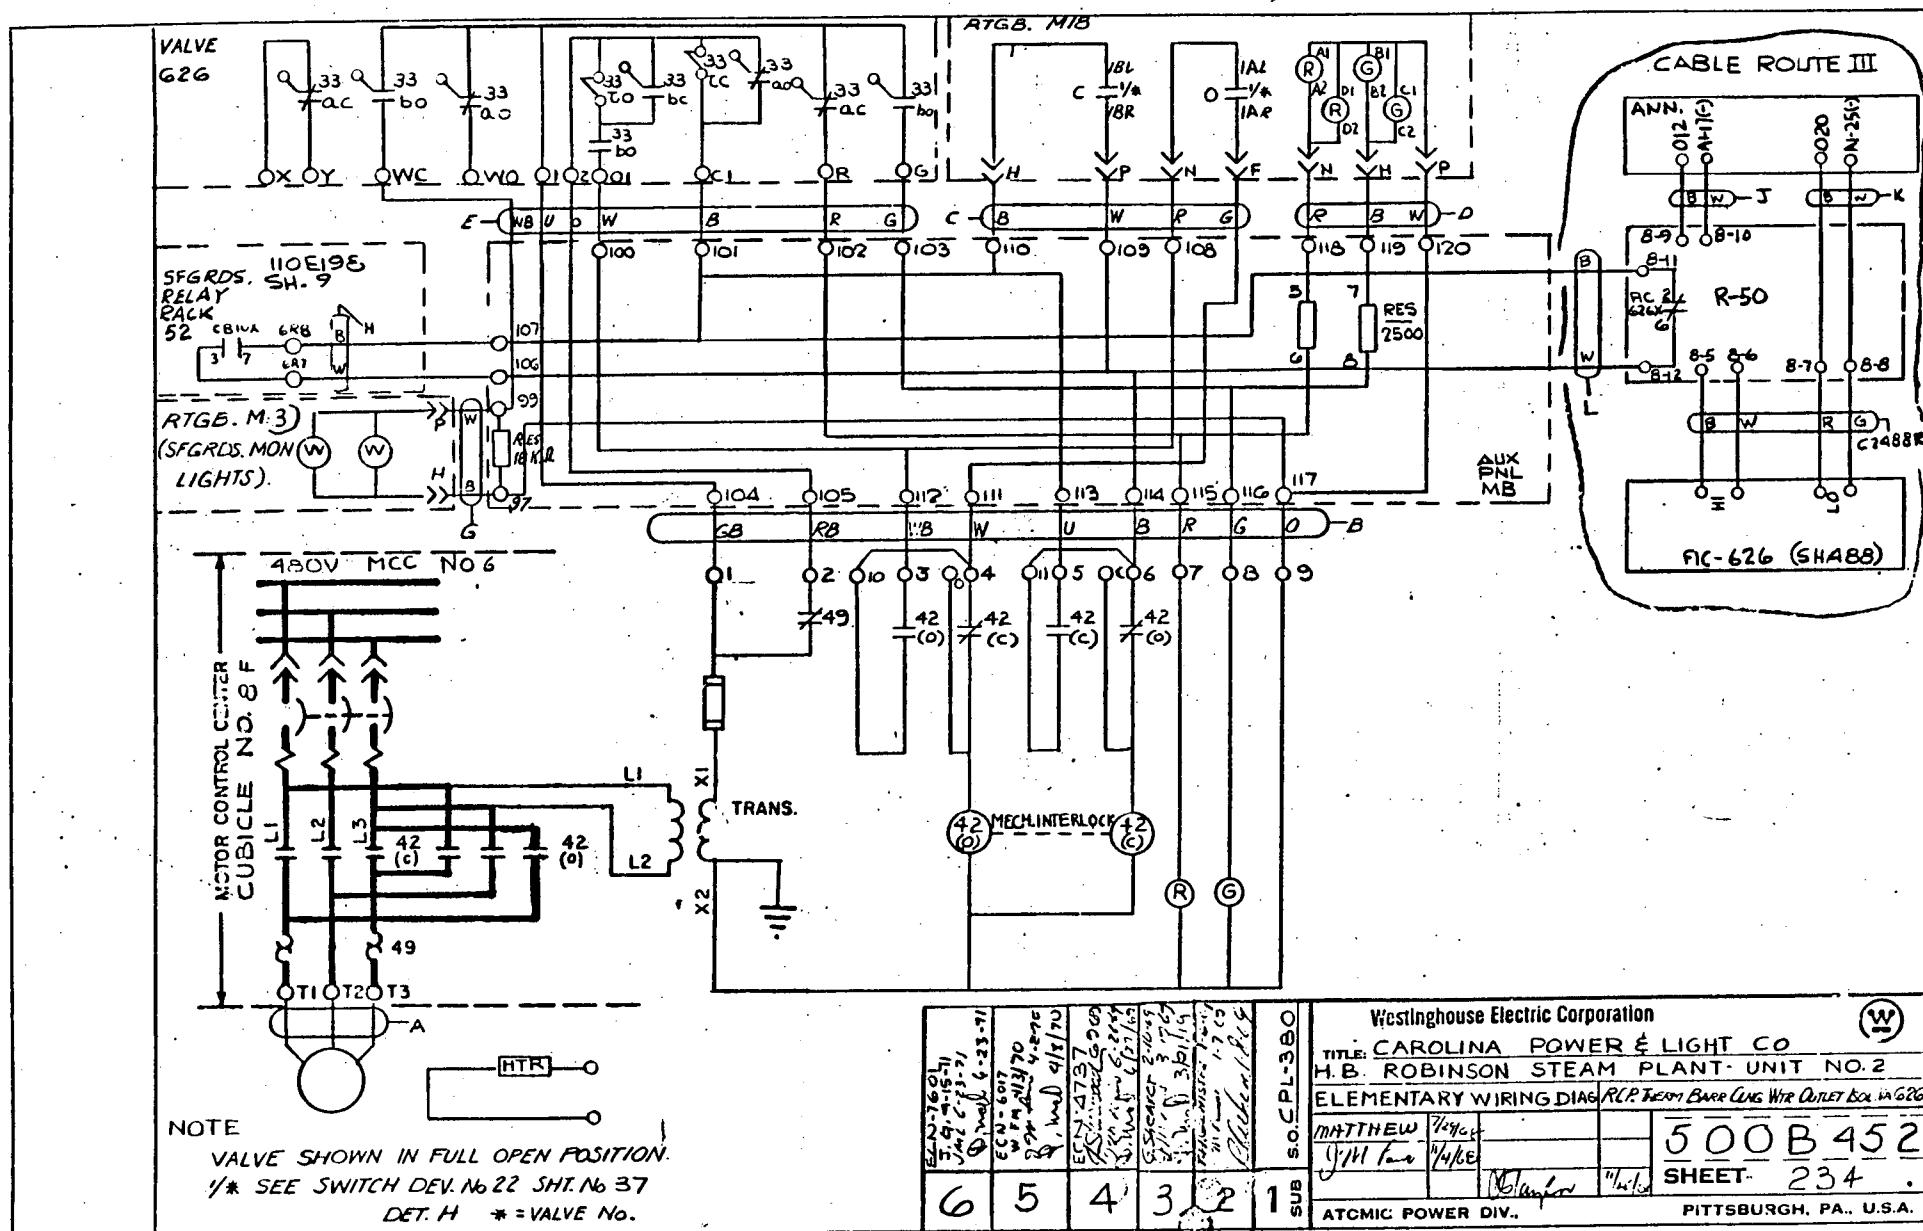


OK

CABLE ROUTE I

SFGRDS. RELAY RACK 51

110E198  
SH. 12

RTGB. M34

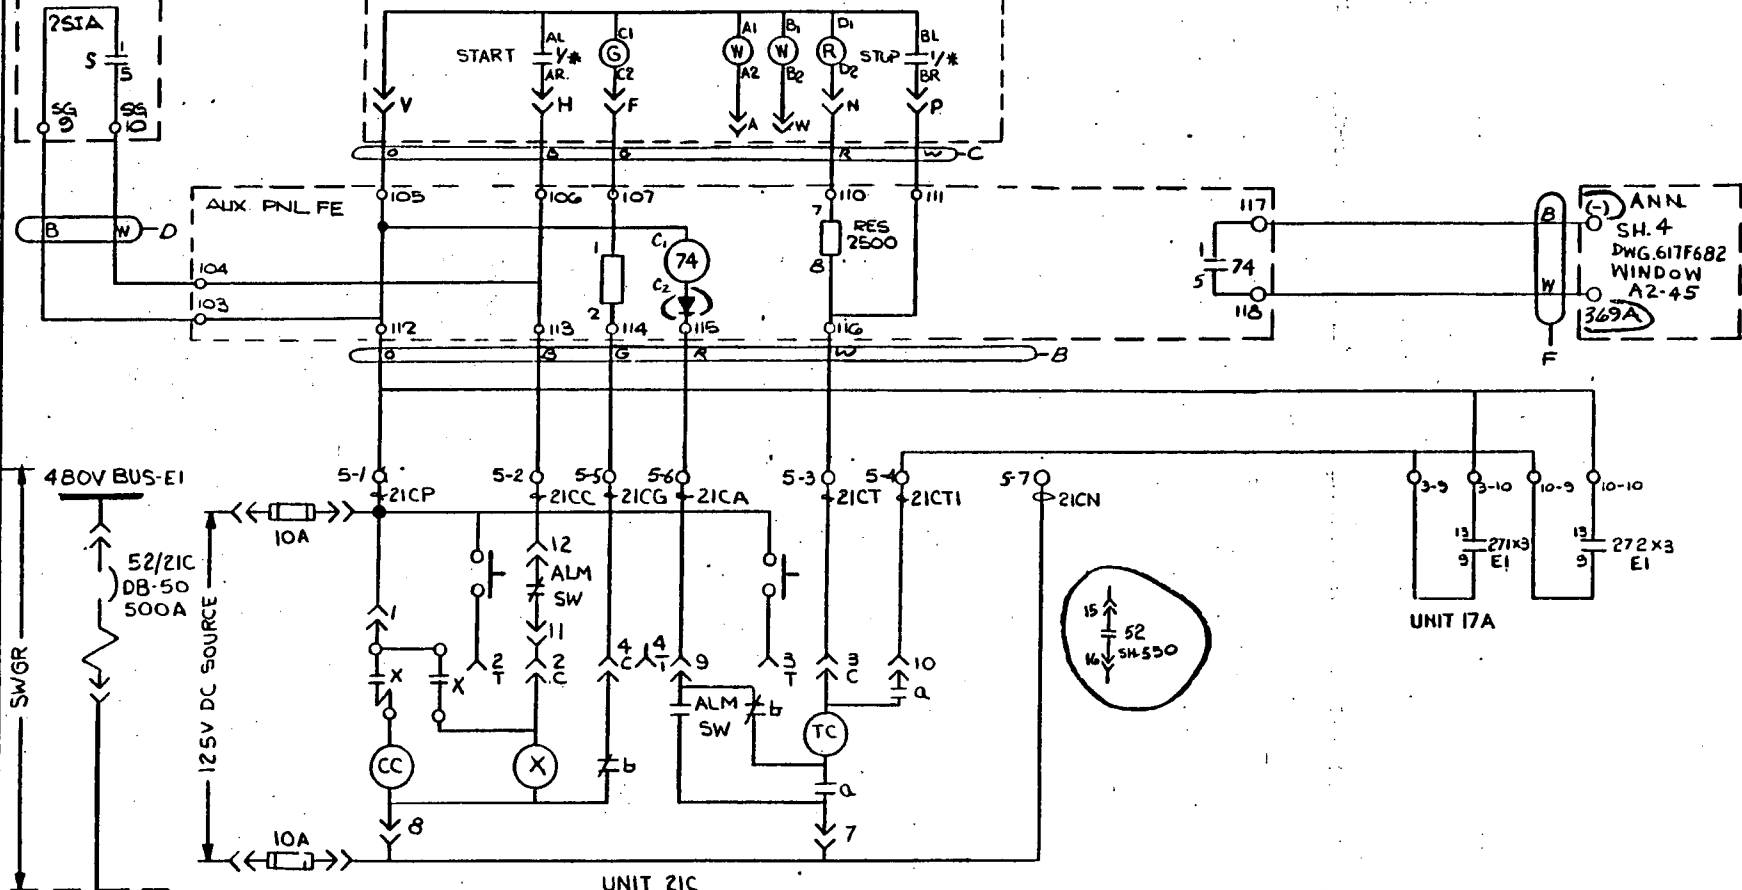

NOTE.

1/\* SEE SWITCH DEV. No. 22 SHT. No. 37  
DET. E \* = SIPA.


SYSTEM REVIEW						Westinghouse Electric Corporation			W	
6	5	4	3	2	1	TITLE: CAROLINA POWER & LIGHT CO.				
H.B. ROBINSON STEAM PLANT - UNIT NO. 2						ELEMNTARY WIRING DIAG				
SAFETY INJECTION PUMP A						Shearer	1/16/67			
						J.M. King	1/14/68			
						500B452				
						SHEET- 237				
						ATOMIC POWER DIV.,				
						PITTSBURGH, PA., U.S.A.				



8/8/69

VIB

CABLE ROUTE II

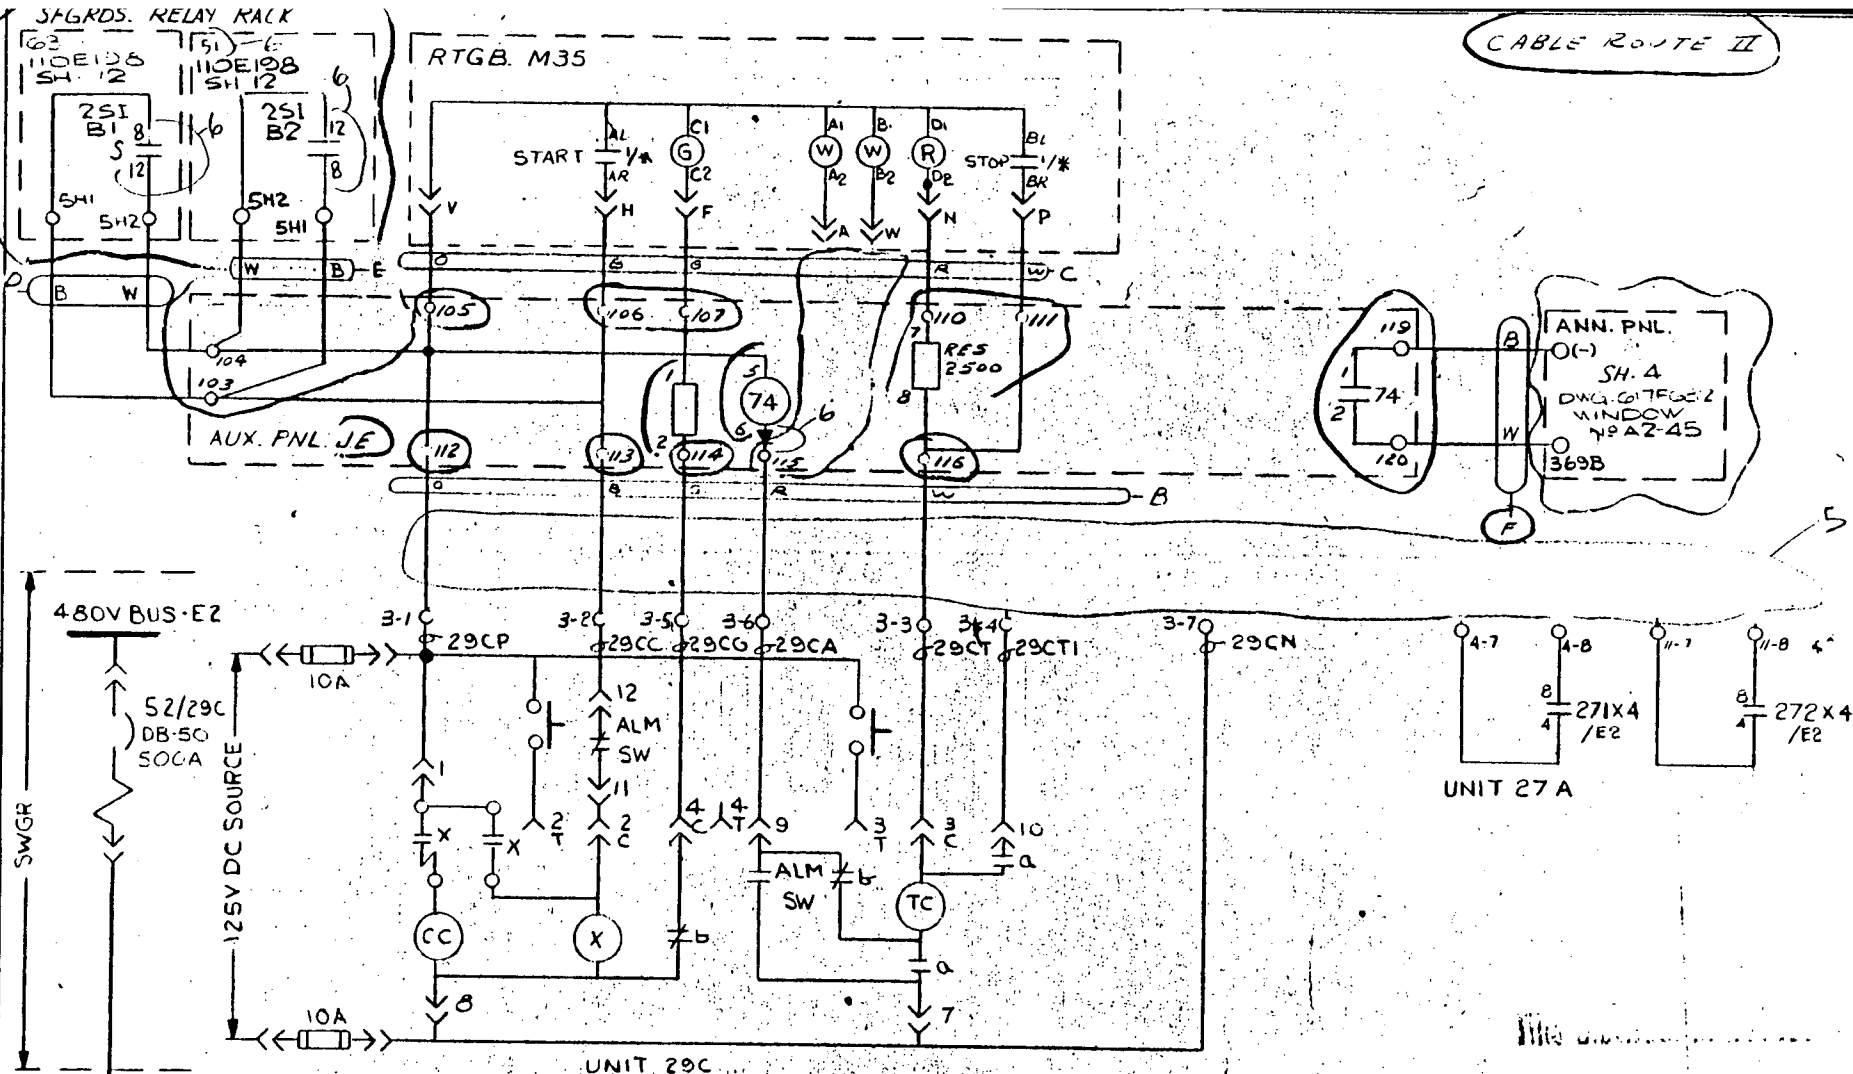

NOTE.

1/\* SEE SWITCH DEV. NO. 22 SHT. NO. 37  
DET. E. \* = SIPB.

FLD 5-26-70 GSC AS BUILT						Westinghouse Electric Corporation		W
FLD 5-26-70 GSC AS BUILT						TITLE: CAROLINA POWER & LIGHT CO.		
ECN-4737						H.B. ROBINSON STEAM PLANT - UNIT NO. 2		
GSC 3-10-69						ELEMENTARY WIRING DIAG. SAFETY INJECTION PUMP B		
GSC 3-10-69						Shearer	9/1/68	
GSC 3-10-69						W. H. H. H.	1/1/68	
GSC 3-10-69						500B 452		
GSC 3-10-69						SHEET- 238		
GSC 3-10-69						ATOMIC POWER DIV.		
GSC 3-10-69						PITTSBURGH, PA., U.S.A.		




CABLE ROUTE I




Systm Review	MC# 6-2-75	EEN-4737 Sullivan 5-9-69 Tompson 2-26-67 Ward 6-10-62 Shadler 8-11-59 Kilham 3-19-67 Ward 2-11-69 T.H. GLENNON STL 11/11/68 CSTaylor 11/13/69	SO. CPL 380
5	(4)	(2)	1 SUB
Westinghouse Electric Corporation			
TITLE: CAROLINA POWER & LIGHT Co.			
H.B.ROBINSON STEAM PLANT-UNIT No.2.			
ELEMENTARY WIRING DIAG. BORON INJ.TANK INLET VALVE 867A			
GLENISTER 8/1/60 STLund		500 B 452	
		SHEET-	243
ATOMIC POWER DIV.,			PITTSBURGH, PA., U.S.A.


OK TW 8-14-78

CABLE ROUTE II

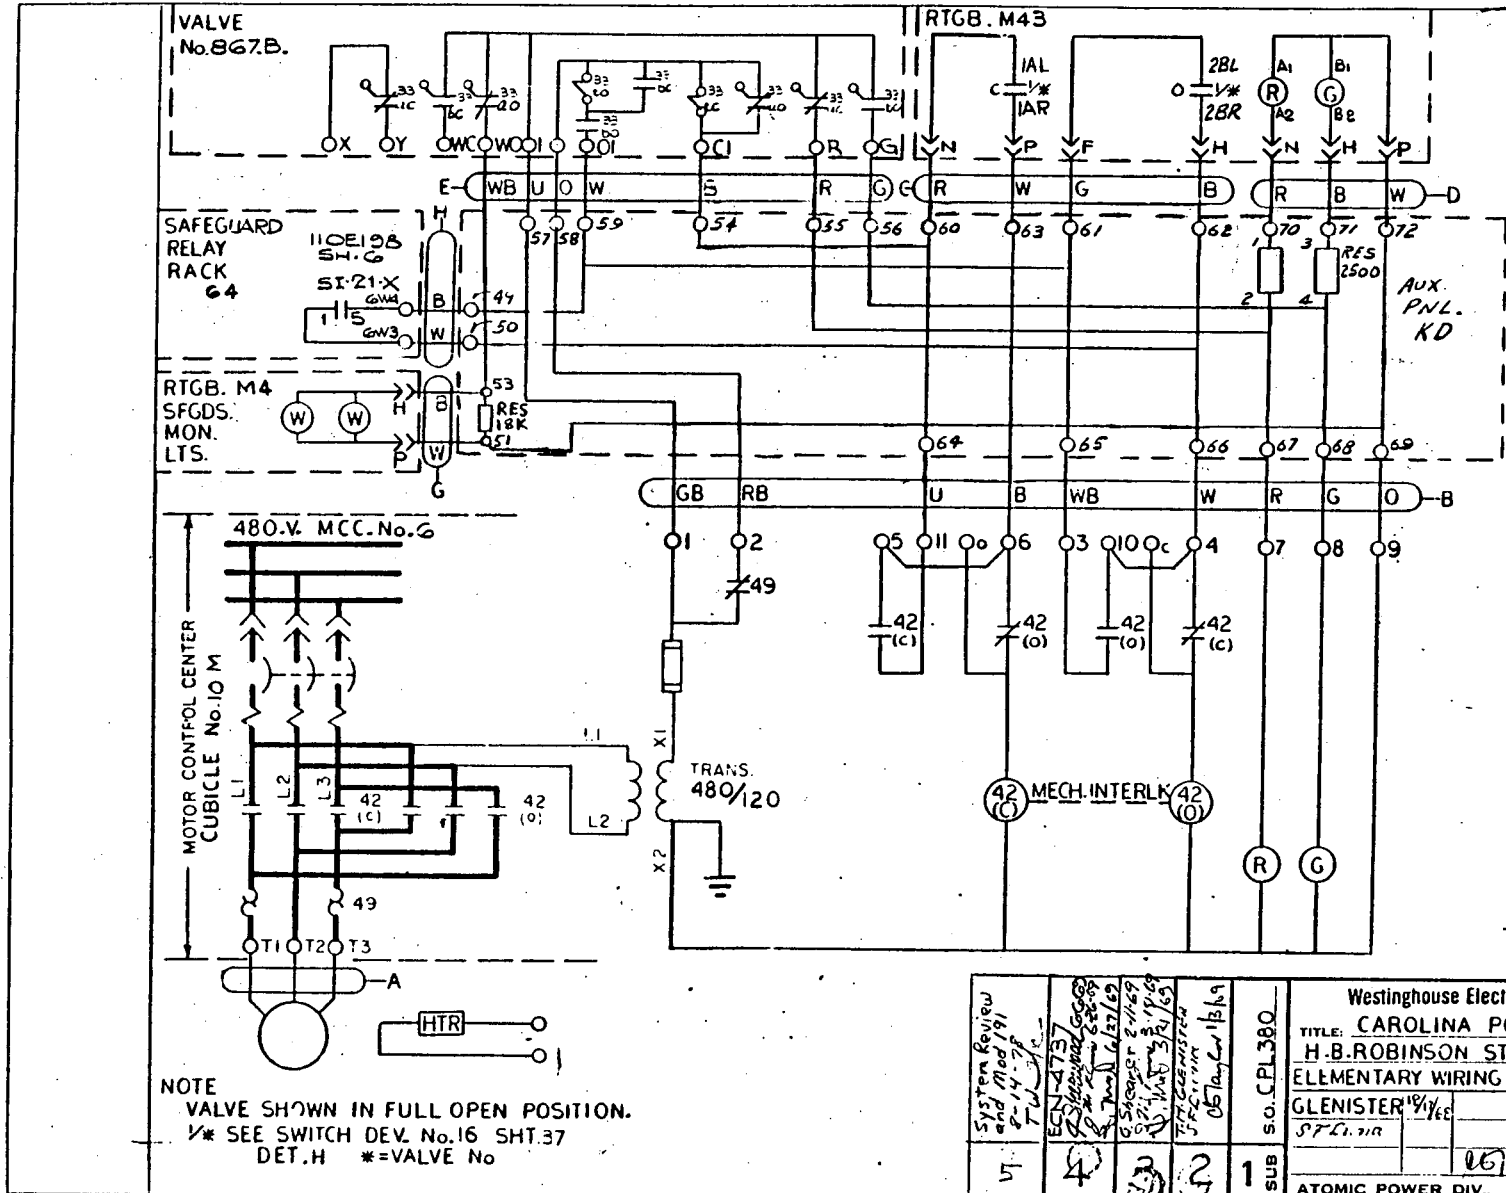

System Review and Mod 191 8-14-78 TW 5/1					Westinghouse Electric Corporation				
ECN-4737					TITLE: CAROLINA POWER & LIGHT Co.				
8/14/78					H.B. ROBINSON STEAM PLANT-UNIT No. 2.				
8/14/78					ELEMENTARY WIRING DIAG. BORON INJ. TANK INLET VALVE 867.				
8/14/78					GLENISTER 1/1/78				
8/14/78					500 B 452				
8/14/78					SHEET 244				
8/14/78					ATOMIC POWER DIV., PITTSBURGH, PA., U.S.A.				

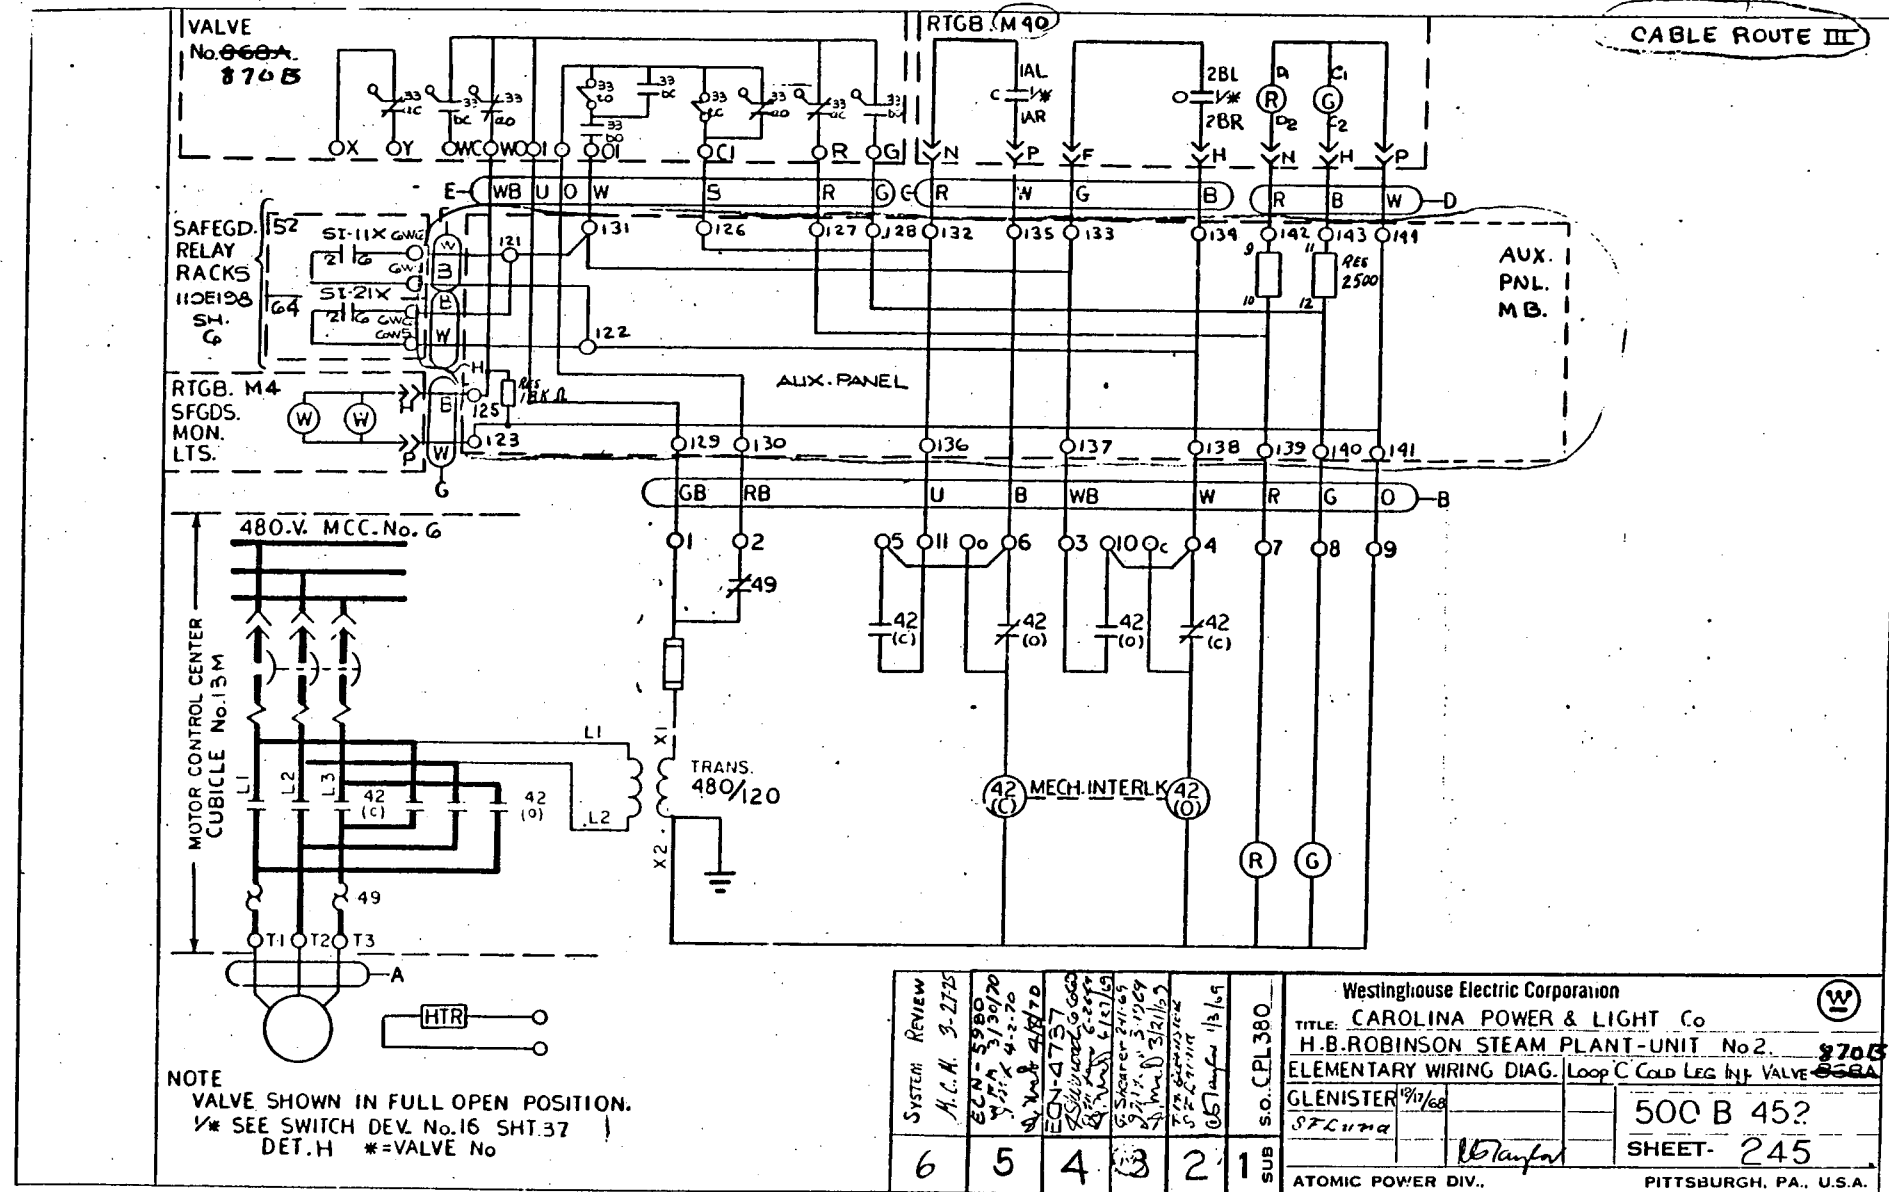

SYSTEM REVIEW				Westinghouse Electric Corporation				
M.C.N. 3-2725				TITLE: CAROLINA POWER & LIGHT Co				
E.C.N. 5980				H.B.ROBINSON STEAM PLANT-UNIT No.2				8705
Y.P.A. 3/30/70				ELEMENTARY WIRING DIAG. Loop C Cold Leg Int. Valve				868A
Y.P.A. 4-2-70				GLENISTER 12/68				
Y.P.A. 4/18/70				500 B 452				
E.C.N. 4757				SHEET- 245				
Y.P.A. 3/30/70				ATOMIC POWER DIV.,				PITTSBURGH, PA., U.S.A.
Y.P.A. 4-2-70				SUB				
Y.P.A. 4/18/70				SO. CPL. 380				
Y.P.A. 3/30/70				1				
Y.P.A. 4-2-70				6				

VALVE  
No. ~~868C~~  
870A

RTGB. M 38

CABLE ROUTE I


SAFE GD.  
RELAY  
RACKS  
110E19B  
SH. G

RTGB. M4  
SFGDS.  
MON.  
LTS.


480-V. MCC. No. 5

MOTOR CONTROL CENTER  
CUBICLE No. 8M

NOTE  
VALVE SHOWN IN FULL OPEN POSITION.  
1/\* SEE SWITCH DEV. No. 16 SHT. 37  
DET. H \* = VALVE No.

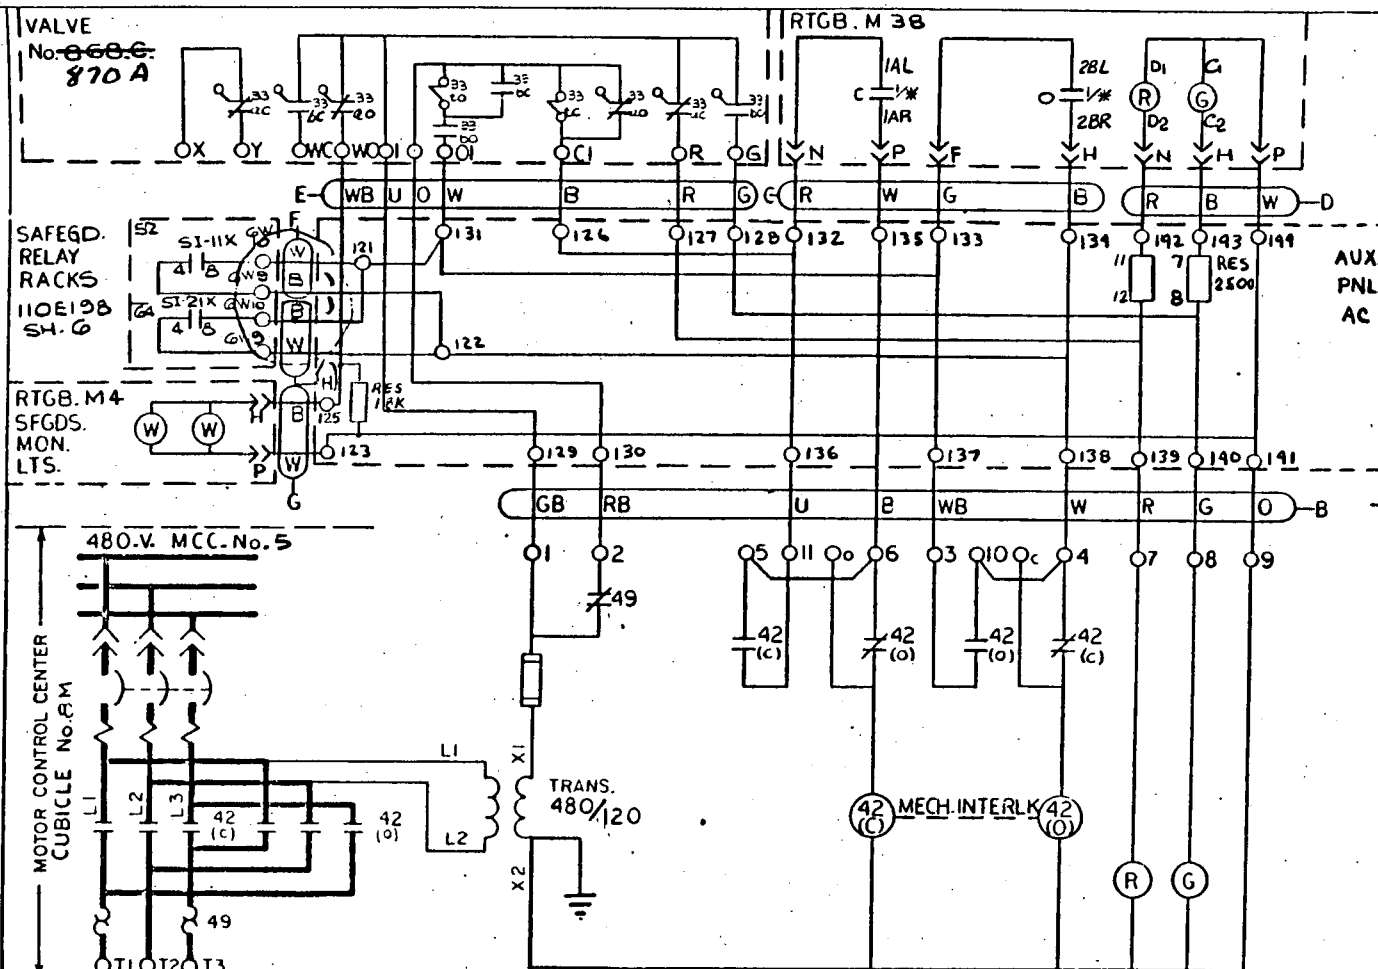

SYSTEM REVIEW						Westinghouse Electric Corporation					
MCM 6-6-75						TITLE: CAROLINA POWER & LIGHT Co					
ECN-7601						H.B.ROBINSON STEAM PLANT-UNIT No.2.					
DATE 2/20/14/77						ELEMENTARY WIRING DIAG. Loop A Cold Leg Inj. VALVE 870A					
J.M. 6-23-71						GLENISTER 18/60					
ECN-5580						500 B 452					
DATE 3/30/70						SHEET- 247					
J.M. 4-2-70						ATOMIC POWER DIV.,					
DATE 4/2/70						PITTSBURGH, PA., U.S.A.					
ECN-4737											
DATE 5/15/60											
J.M. 6-17/60											
DATE 6/17/60											
J.M. 6-17/60											
DATE 6/17/60											
J.M. 6-17/60											

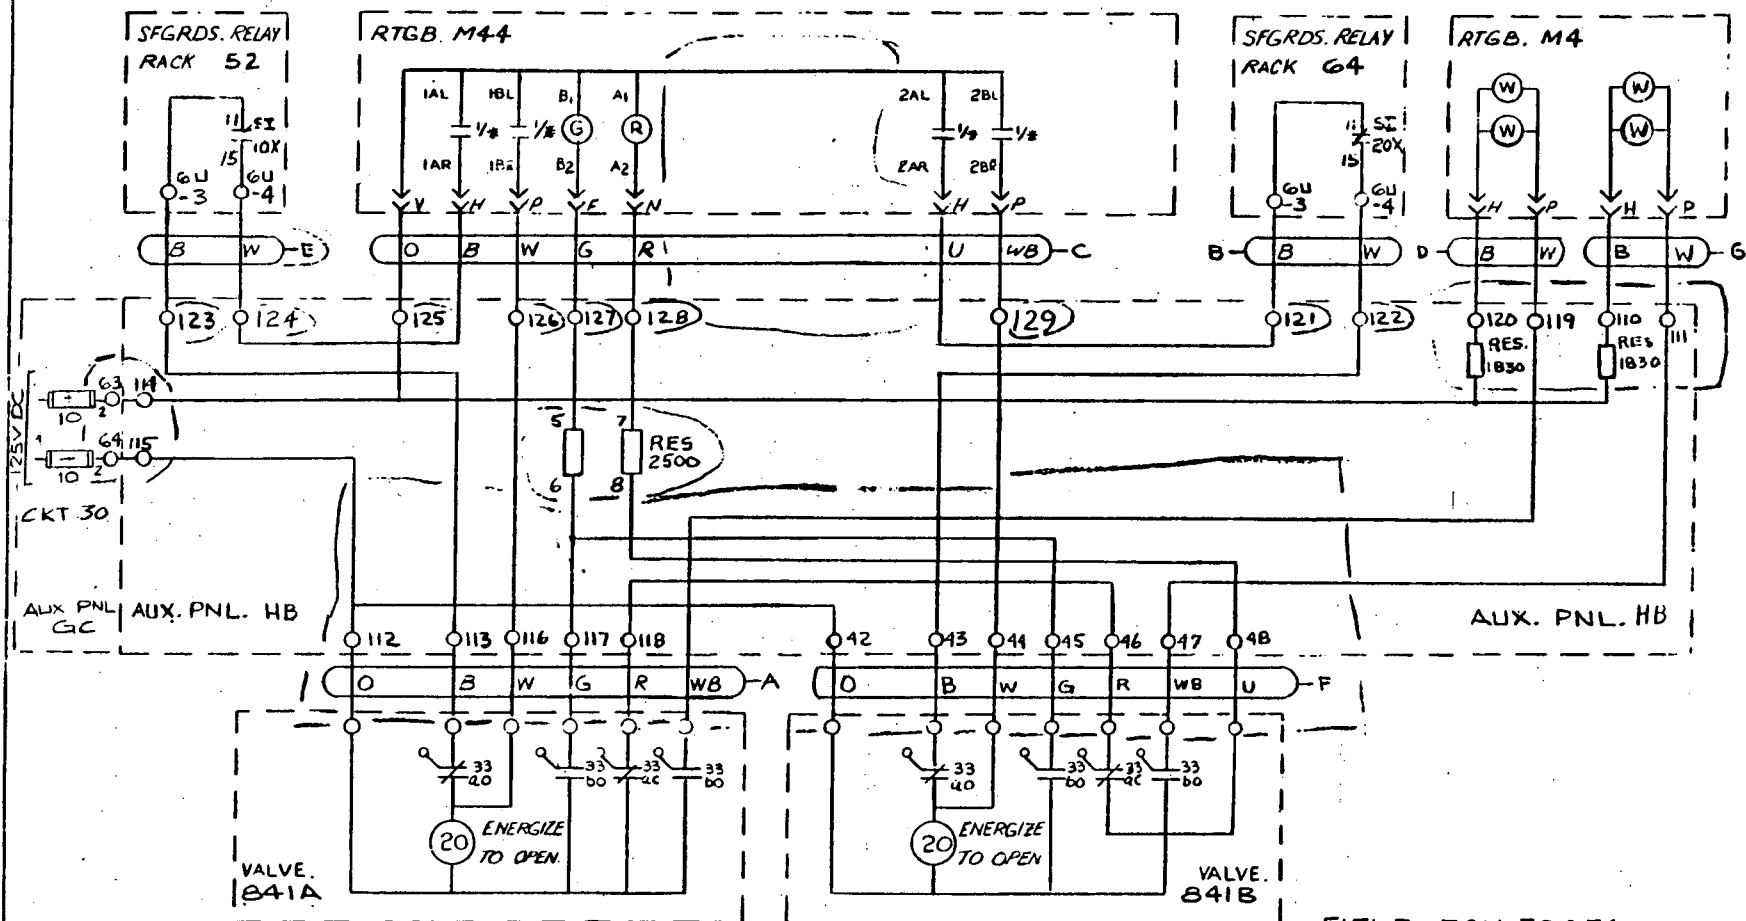

**NOTE.**

VALVE SHOWN IN FULL OPEN POSITION.

1/\* SEE SWITCH DEV. NO 24 DET. "H", (SHT. 37)


SI10X AND SI20X DWG, 110E198, SHEET 6.

\* = VALVE NO.

SUPERCEDES SUB 2  
500B452, SH. 250

SYSTEM REVIEW Rev. 8-20-75						Westinghouse Electric Corporation		(W)
6	5	4	3	1	SUB	TITLE: CAROLINA POWER FLIGHT Co.		
						H.B. ROBINSON STEAM PLANT UNIT No 2		
						ELEMENTARY WIRING DIAG BORN INJ. TK OUT RECIR. VA 841A		
						500B452.		
						SHEET- 250		
						ATOMIC POWER DIV., PITTSBURGH, PA., U.S.A.		

110E198 SH. 6

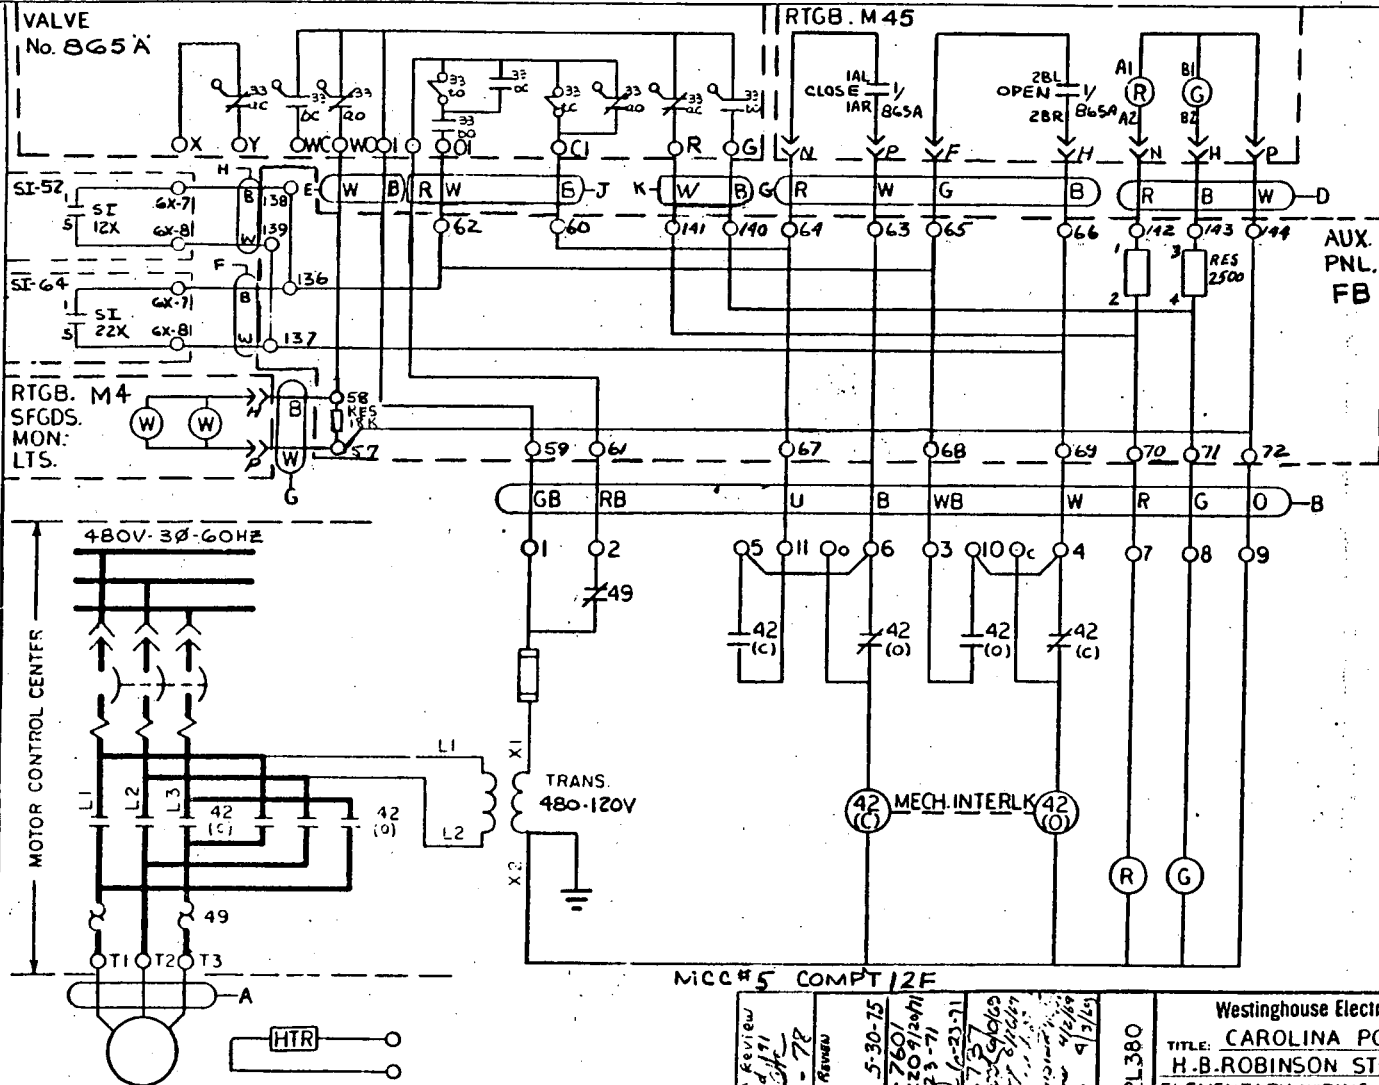

NOTE  
VALVE SHOWN IN FULL OPEN POSITION. |  
1/8G5A DEV. 16, DET. H, SHEET 37  
SI12X & SI22X DWG. 110E198 SHEET 6.


MCC#5 COMPT 12F

System Review and Mod. TW 8-14-72		System Review		MCM 5-30-75 ECN-7601 DRG 220-72471 JUL 6 1973 ECN 4737 JUL 11 1973 JUL 11	
---	--	---------------	--	--	--







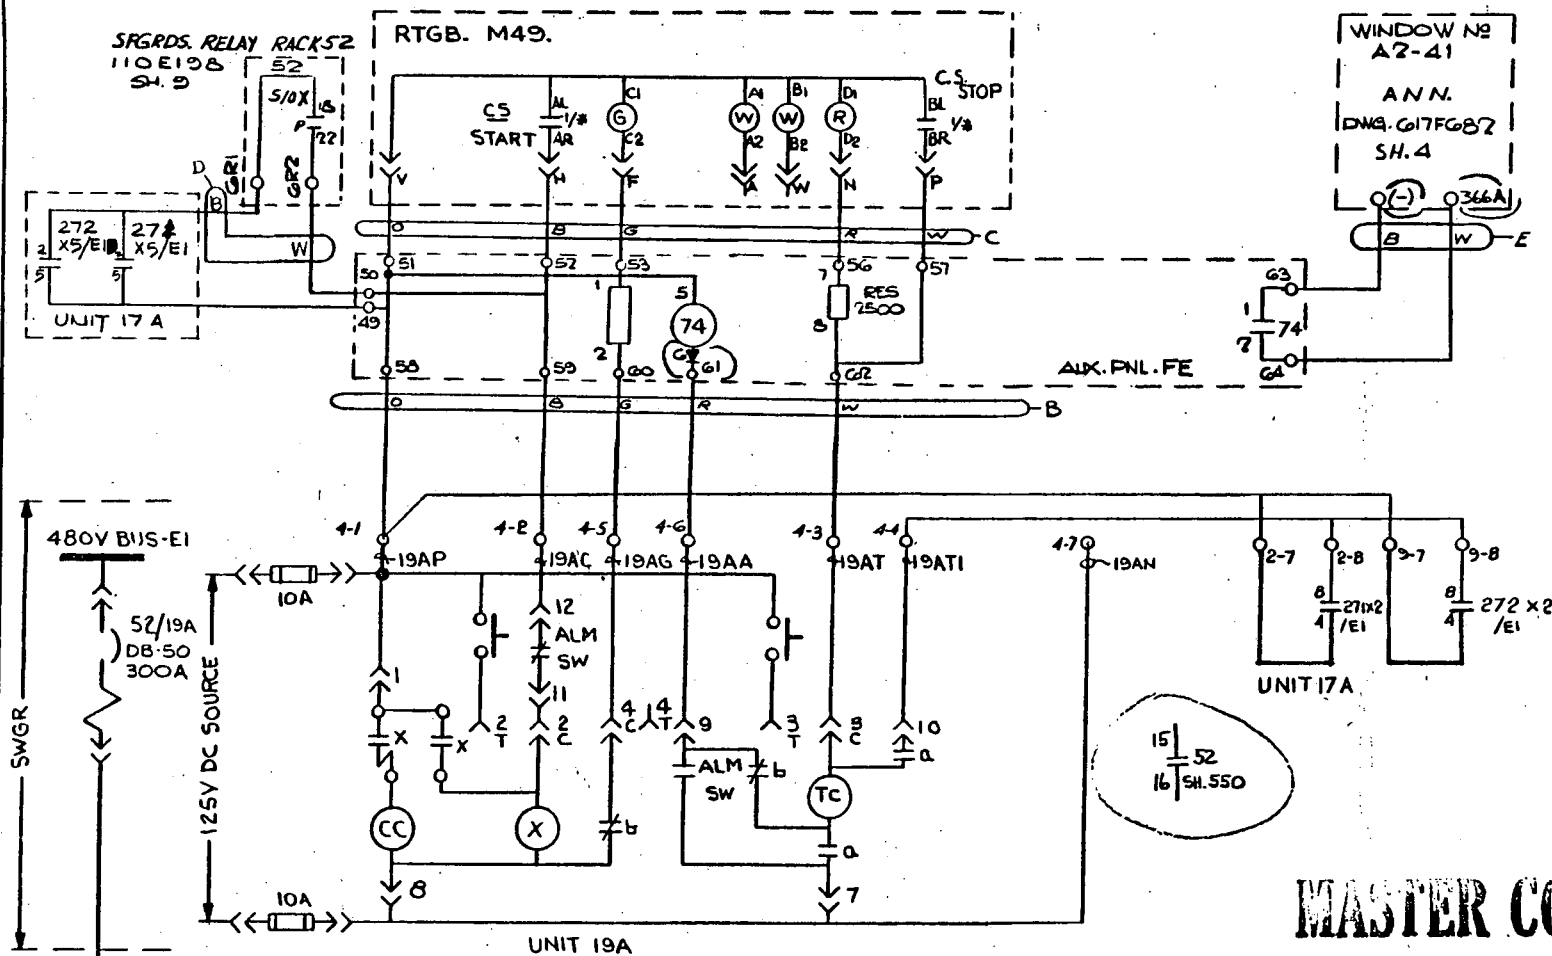

MASTER COPY

CPL. DIT. Mod # 94 7 March 78 98388				ECR-013 G. R. STOTT 6-12-78 248-128 26-2-12				ECN-2601 6-22-78 248-128 26-2-12				ECN-4737 6-22-78 248-128 26-2-12				SO. CPL-380			
5.				4.				2.				1.				SUB			
Westinghouse Electric Corporation				TITLE: CAROLINA POWER & LIGHT CO.				H.B. ROBINSON STEAM PLANT - UNIT NO. 2				ELEMENTARY WIRING DIAG. CONTAINMENT SPRAY PUMP A				3/4/68			
3/4/68				3/4/68				3/4/68				3/4/68				3/4/68			
500B 452				SHEET- 287				ATOMIC POWER DIV.,				PITTSBURGH, PA., U.S.A.							

OK

CABLE ROUTE I

VALVE  
No. 880 A

RTGB. M 4 2


SAFEGUARD  
RELAY  
RACK  
52  
HDE198  
S4. 2

RTGB. M3.  
SFGDS.  
MON.  
LTS.


480-V. MCC. No. 5


MOTOR CONTROL CENTER  
CUBICLE No. 12 J

NOTE  
VALVE SHOWN IN FULL OPEN POSITION.  
V\* SEE SWITCH DEV. No. 16 SHT. 37  
DET. H \* = VALVE No

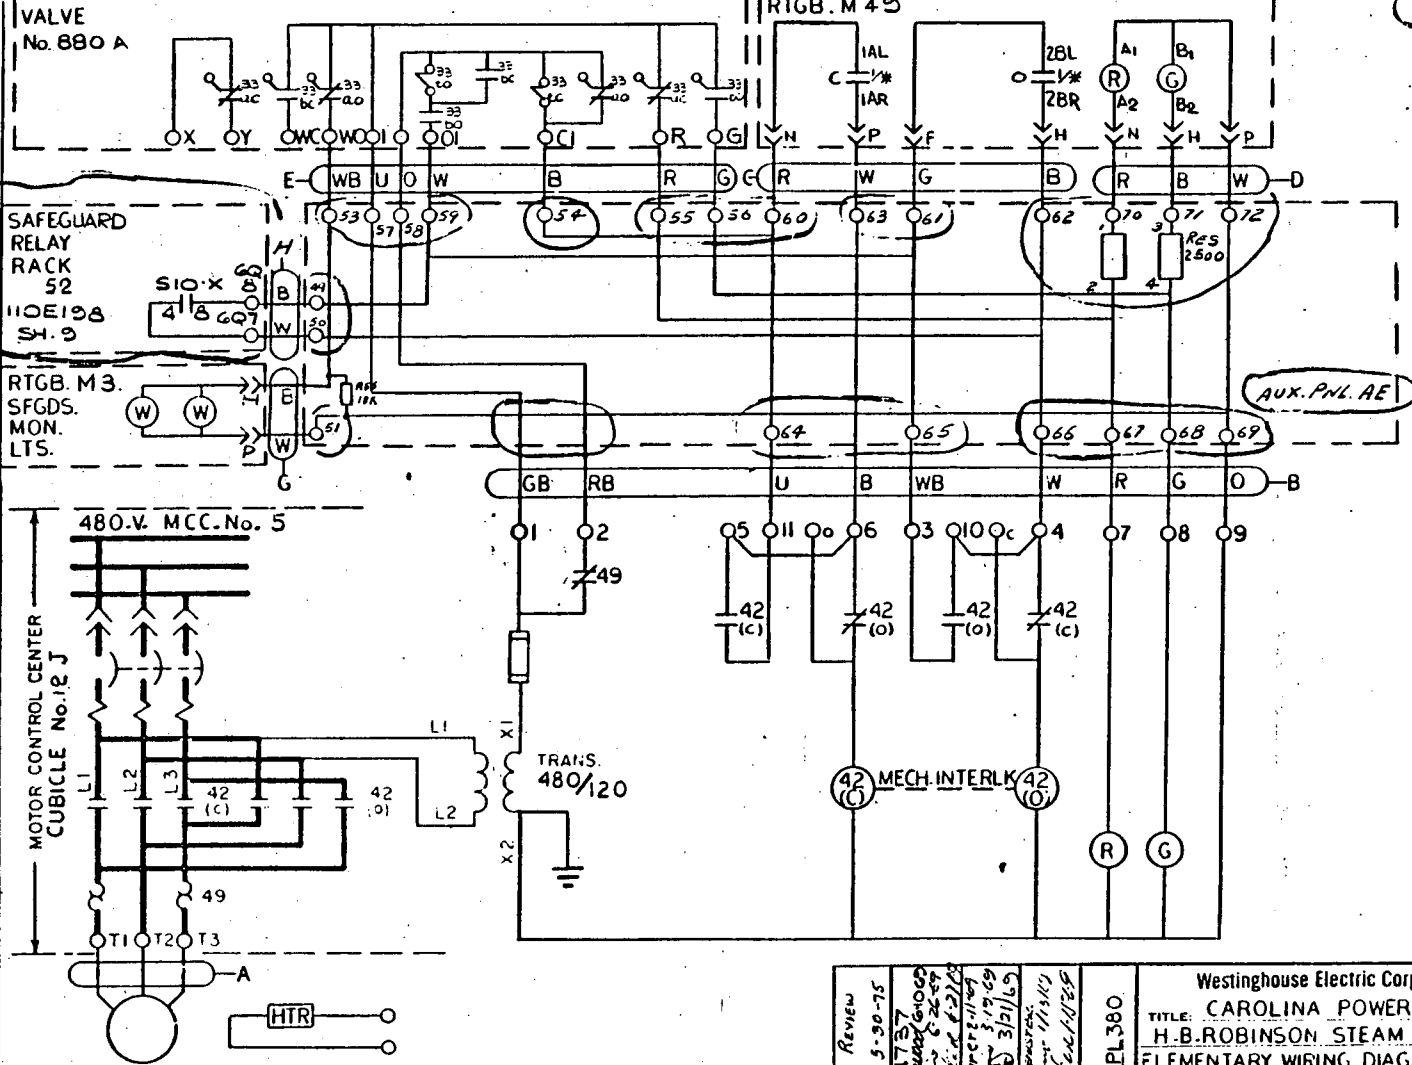

SYSTEM REVIEW				Westinghouse Electric Corporation			
MCM 5-30-75				TITLE: CAROLINA POWER & LIGHT Co			
ECS-4737				H.B. ROBINSON STEAM PLANT-UNIT No. 2.			
5/1/75				ELEMENTARY WIRING DIAG. CONT. SPRAY PUMP A DISCHG VAL 880A			
5/1/75				GLENSTER			
5/1/75				500 B 452			
5/1/75				SHEET- 288			
5				ATOMIC POWER DIV..			
4				PITTSBURGH, PA., U.S.A.			
3							
2							
1							
SUB							

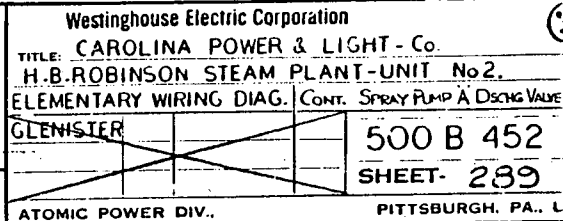

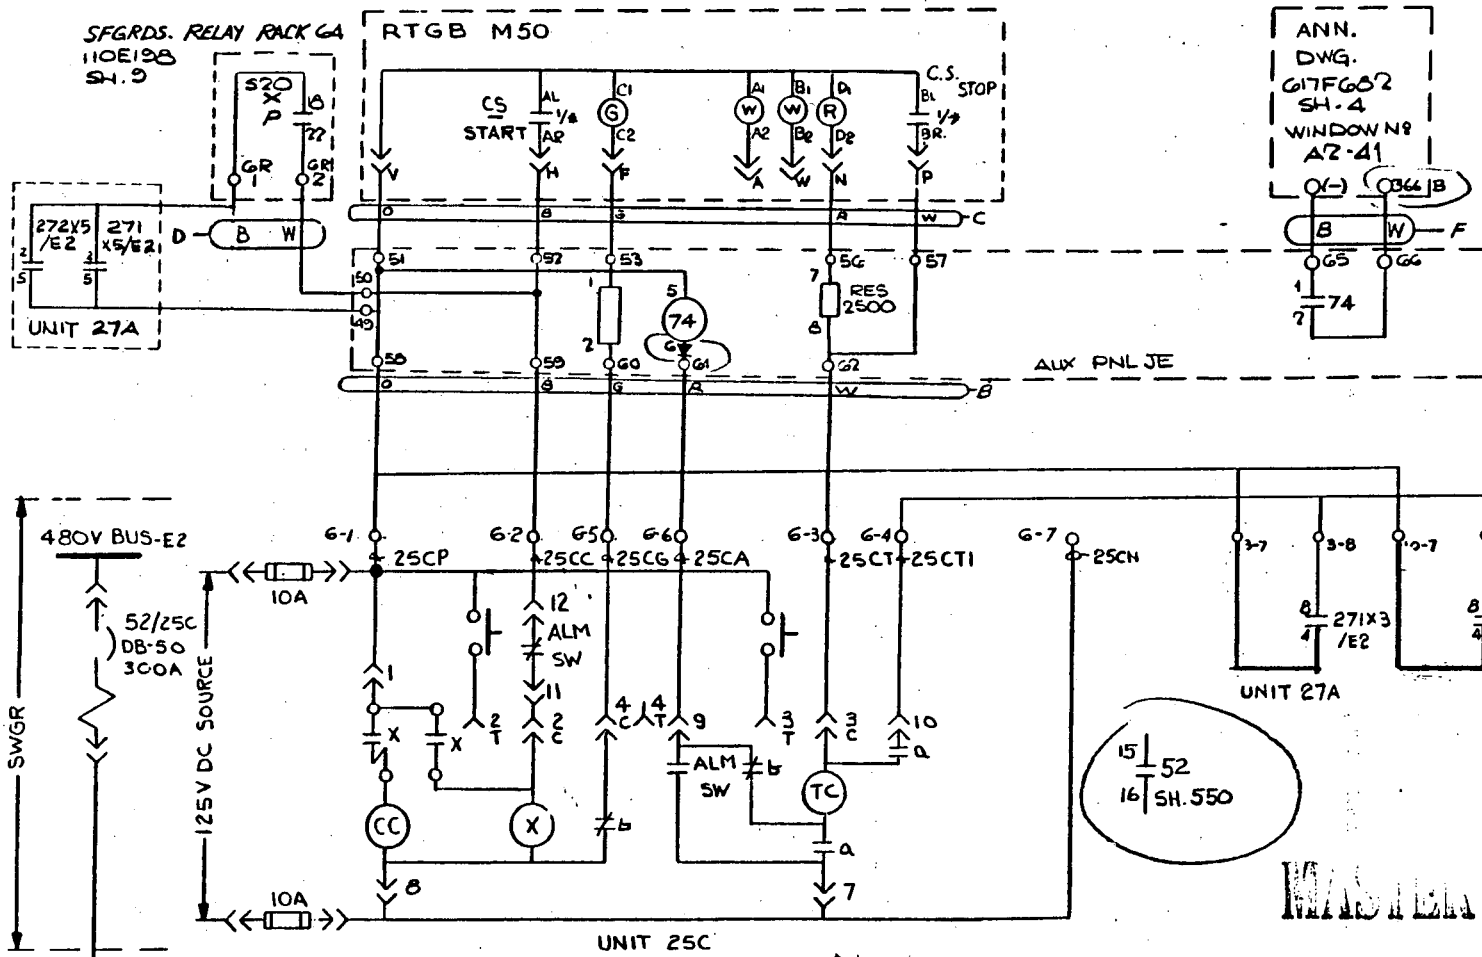


NOTE.  
1/\* SEE SWITCH DEV. No 22. SHT 27  
DCT.E \* = CSP-B.

<p>CPL-DIT. MOD-84 7 MAR 75. G. R. Stott ECR-013 GR-STOTT REQ. @ LTR. CONTAINMENT SPRAY PUMP 24 Feb 75</p>						<p>Westinghouse Electric Corporation TITLE: CAROLINA POWER &amp; LIGHT CO. H.B. ROBINSON STEAM PLANT- UNIT NO. 2 ELEMENTARY WIRING DIAG. CONTAINMENT SPRAY PUMP 'B'</p>	
6	5	4	3	2	1	<p>Shearer 2/11/75 Dill Lane 11/4/75</p>	<p>500B452 SHEET- 290</p>
<p>6 5 4 3 2 1</p>						<p>ATOMIC POWER DIV., PITTSBURGH, PA., U.S.A.</p>	

CABLE ROUTE II

ANN.  
DWG.  
617FG02  
SH-4  
WINDOW N9  
A2-41

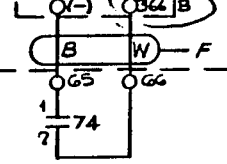


UNIT 27A

MASTER COPY

VALVE  
No. 880.C.

RTGB. M.50.

*CABLE ROUTE I*

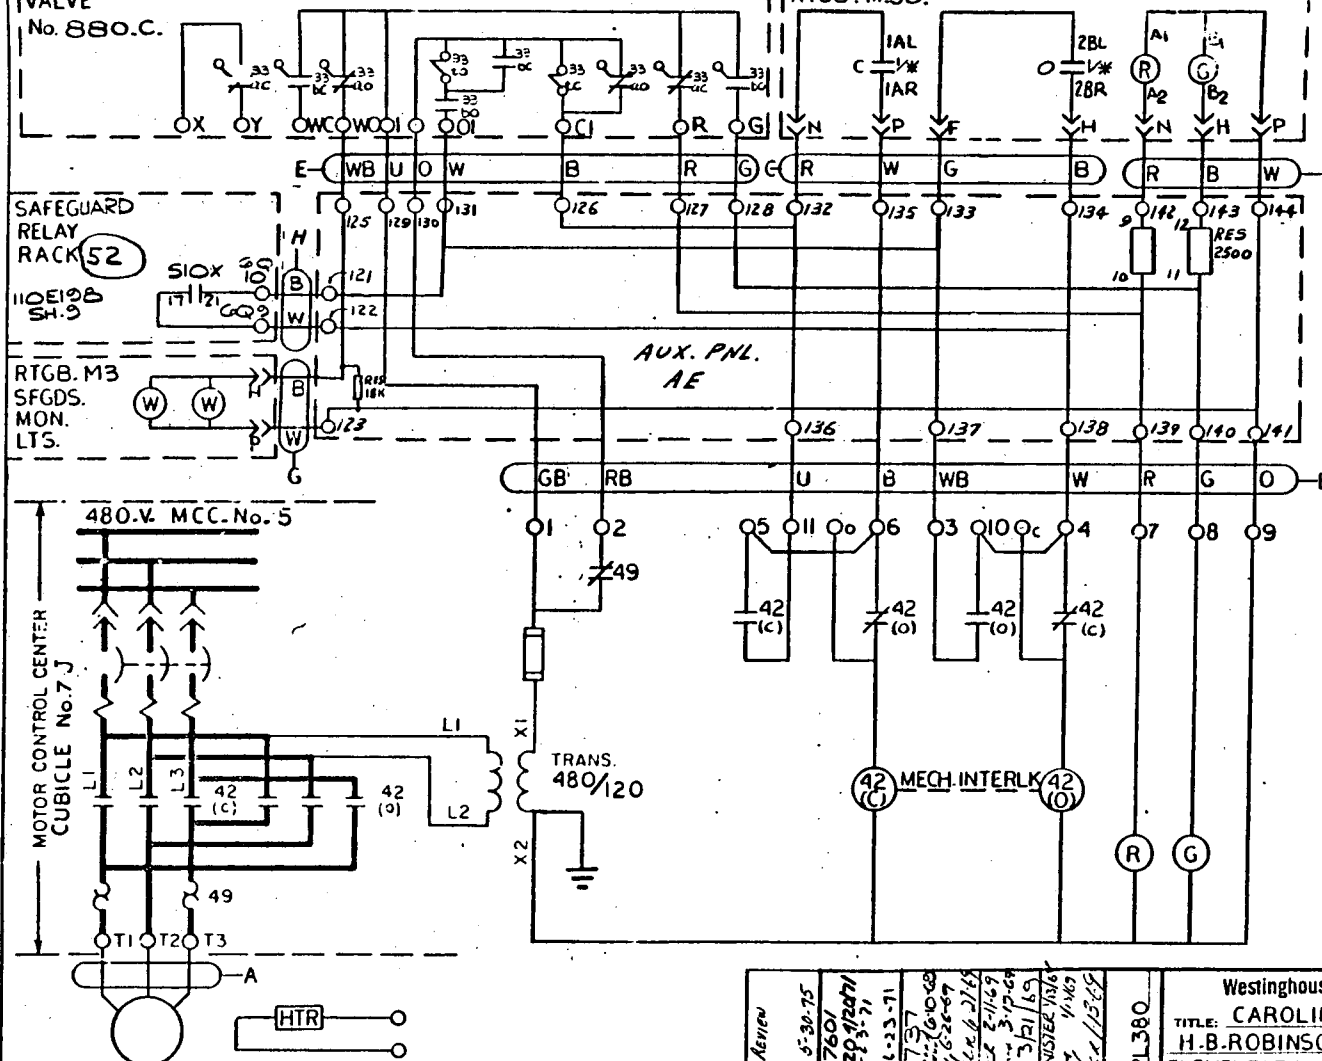


NOTE  
VALVE SHOWN IN FULL OPEN POSITION.  
1/\* SEE SWITCH DEV. No.16 SHT.37  
DET.H /\*=VALVE No


[illegible]

### CABLE ROUTE II



System Revised	MCN 5-30-75	ECN 4737	Standard 10-65	9th Rev 6-20-69	2nd Rev 2-10-65	TH. GLENISTER	W. J. WILSON	Checked H. F. F.	so. CPL 380	Westinghouse Electric Corporation		
TITLE: CAROLINA POWER & LIGHT Co. H.B. ROBINSON STEAM PLANT-UNIT No. 2, ELEMENTARY WIRING DIAG. CONT Spray Pump B. DOUG. VA. 880 D.										500 B 452		
5	4	3	2	1	SUB	<div style="border: 1px solid black; width: 100%; height: 100%; position: relative;"><div style="position: absolute; top: 0; right: 0; width: 100%; height: 100%; background: linear-gradient(to top right, transparent 49%, black 49%, black 51%, transparent 51%); background-size: 4px 4px;"></div></div>				SHEET- 292		
ATOMIC POWER DIV.,										PITTSBURGH, PA., U.S.A.		



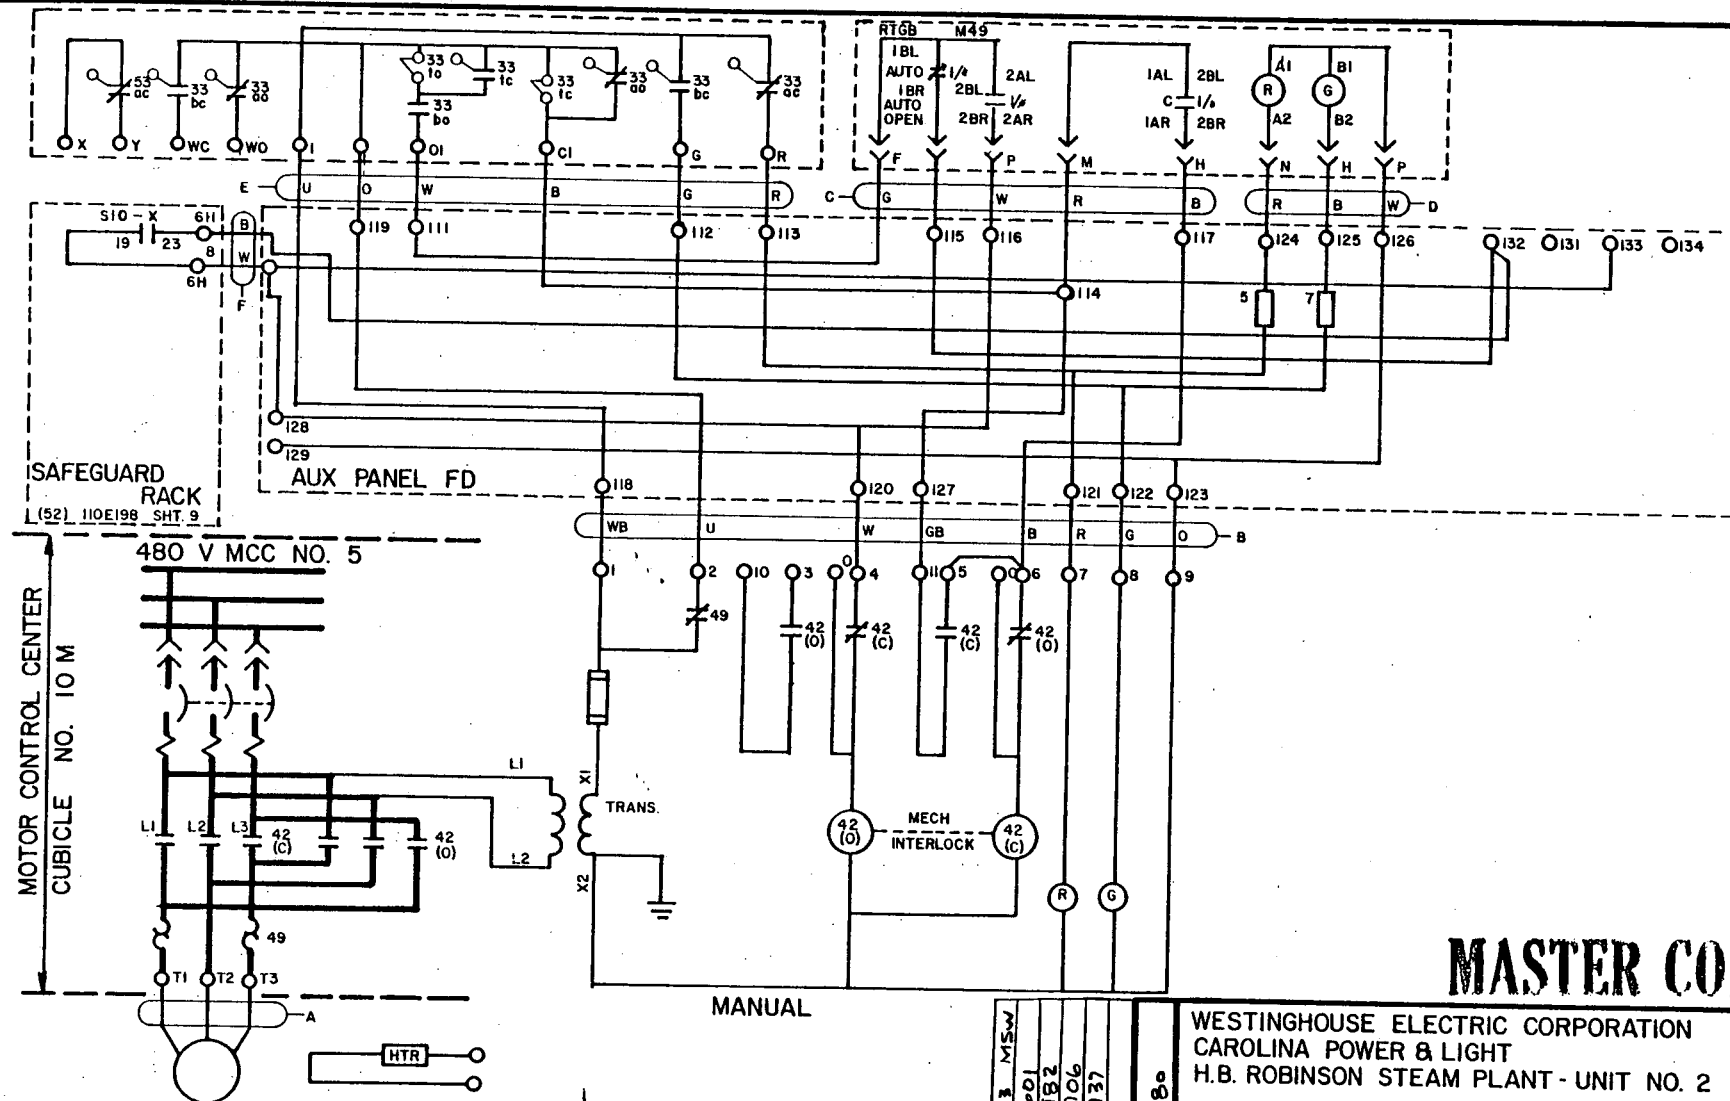

NOTE  
VALVE SHOWN IN FULL OPEN POSITION  
I/\* SEE SWITCH DEV. NO. 37 (SHT. 37). DET. D \* = VALVE NO.

**MASTER COPY**

WESTINGHOUSE ELECTRIC CORPORATION  
CAROLINA POWER & LIGHT  
H.B. ROBINSON STEAM PLANT - UNIT NO. 2  
ELEMENTARY WIRING DIAG. CONT. SPRAY ADDTV.  
TANK SUC. VA. 845 A

**500B452**  
SHEET - 295

7	MOD-213	MSW
6	ECN-7601	
5	ECN-5182	
4	ECN-5706	
3	ECN-4737	
2		
1	CPL-380	



VALVE SHOWN IN FULL OPEN POSITION  
1/\* SEE SWITCH DEV. No. 30 (SHT. 37)  
DET. D. \* = VALVE No.


7	MOD # 253 USN 3-7-75	8	ECN - 7601 DR 51220-9107 JML 23-71 8-10-75 6-13-71	5	ECN 5582 SPUR 451-70 JML 4-11-70 ECN 5100 JML 4-11-70	4	ECN 5100 JML 4-11-70 JML 2-9-70 JML 2-10-70	3	ECN 4737 JML 6-14-69 JML 5-26-71 JML 6-22-71	2	ECN 2114 JML 3-15-67 JML 3-15-67	1	SO. CPL-380	Westinghouse Electric Corporation TITLE: CAROLINA POWER & LIGHT CO H.B. ROBINSON STEAM PLANT-UNIT NO.2 ELEMENTARY WIRING DIAG. CONT. SPRAY ADDTY. TANK SEC. 1A 845B MATTHEWS 1-360 JML 1-460 500B 452 SHEET- 296 ATOMIC POWER DIV., PITTSBURGH, PA., U.S.A.	
---	-------------------------	---	---	---	---	---	--	---	---	---	--	---	-------------	---	--










**GAS ANALYZER PANEL**

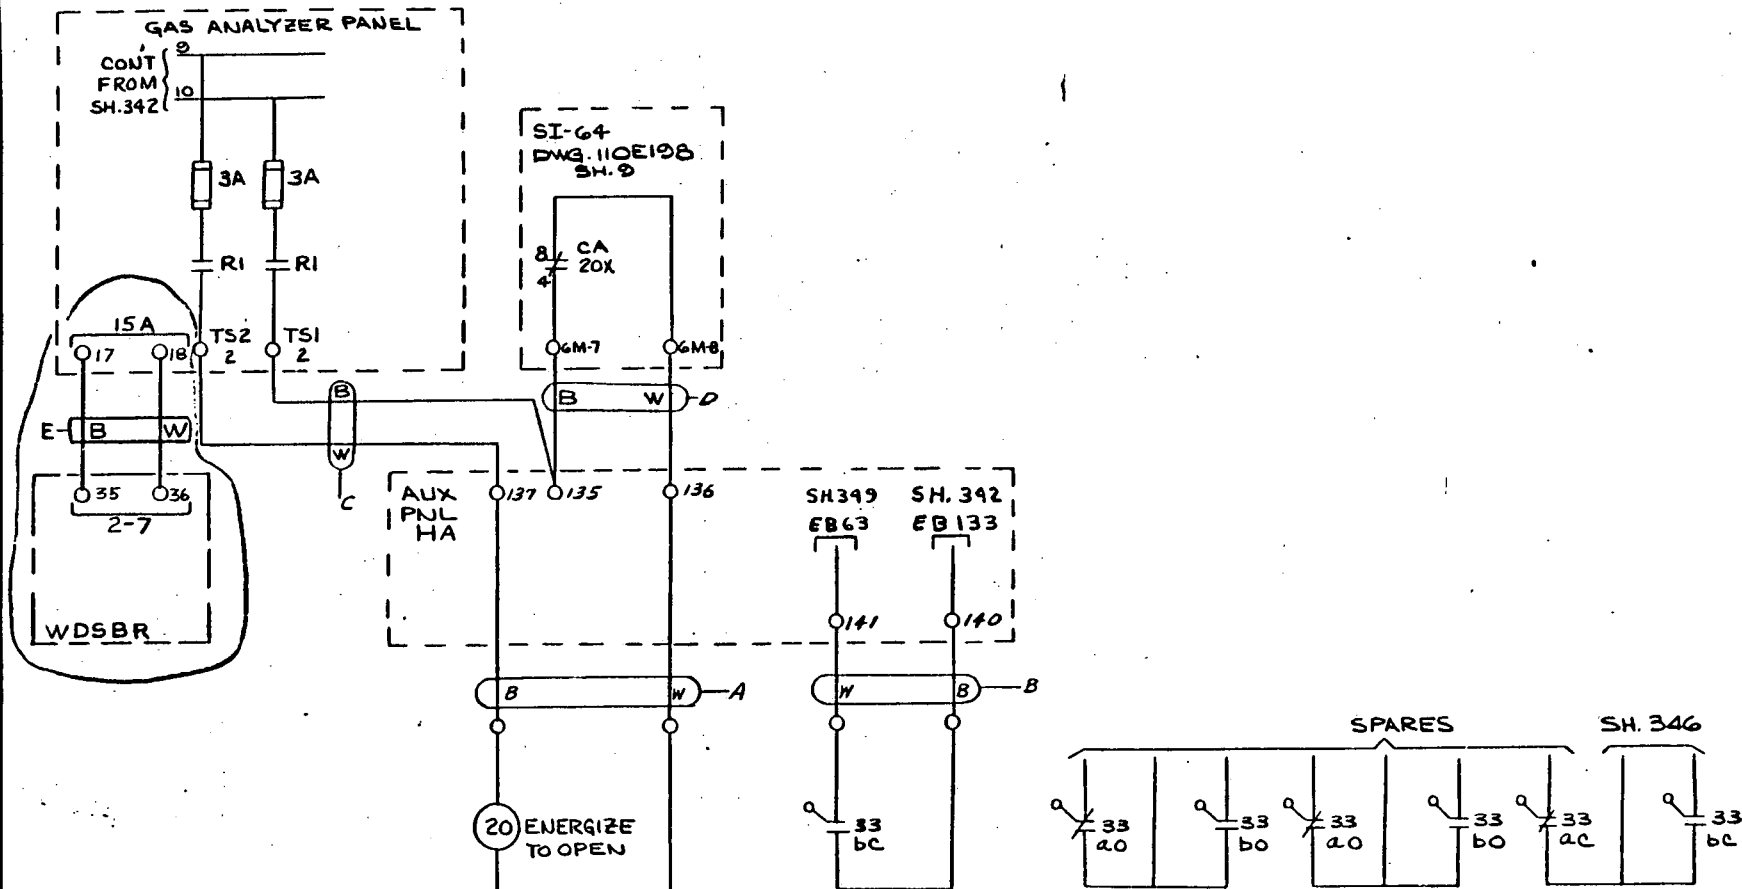
[illegible]

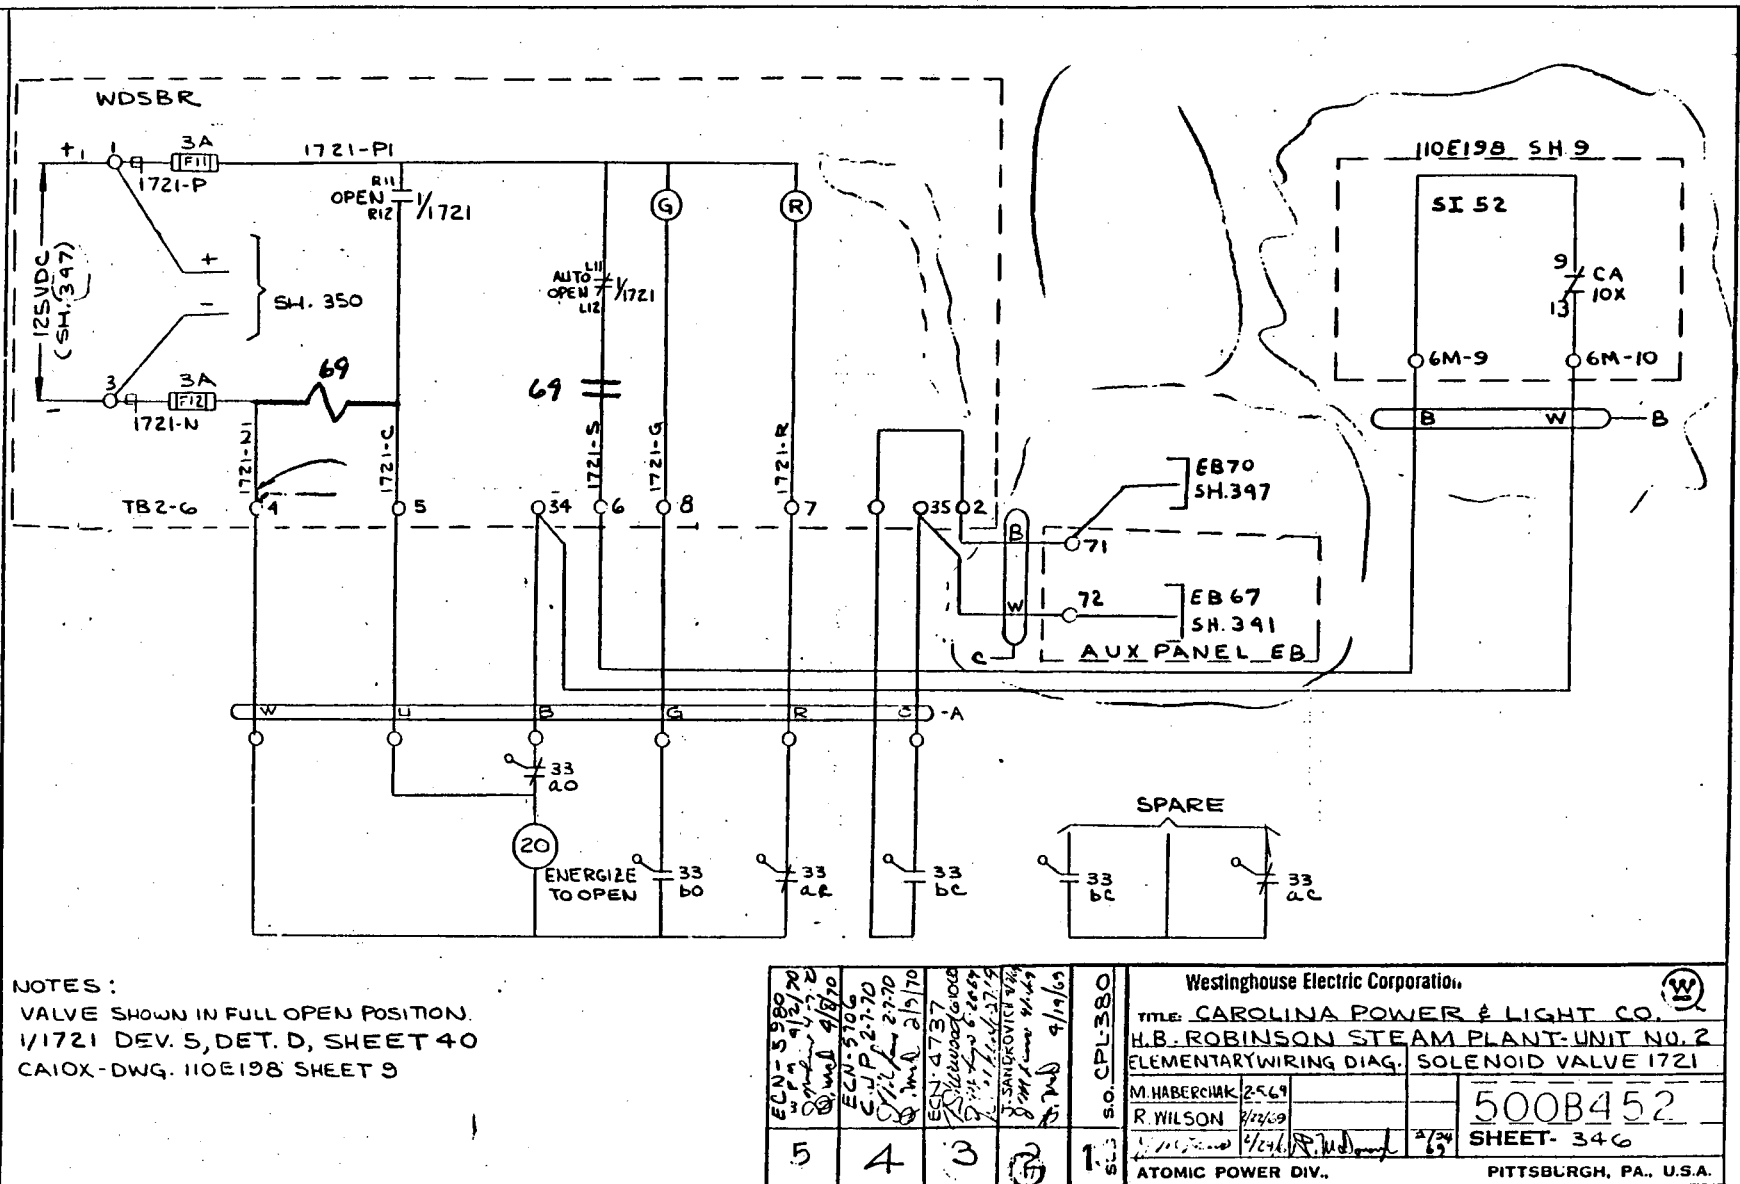

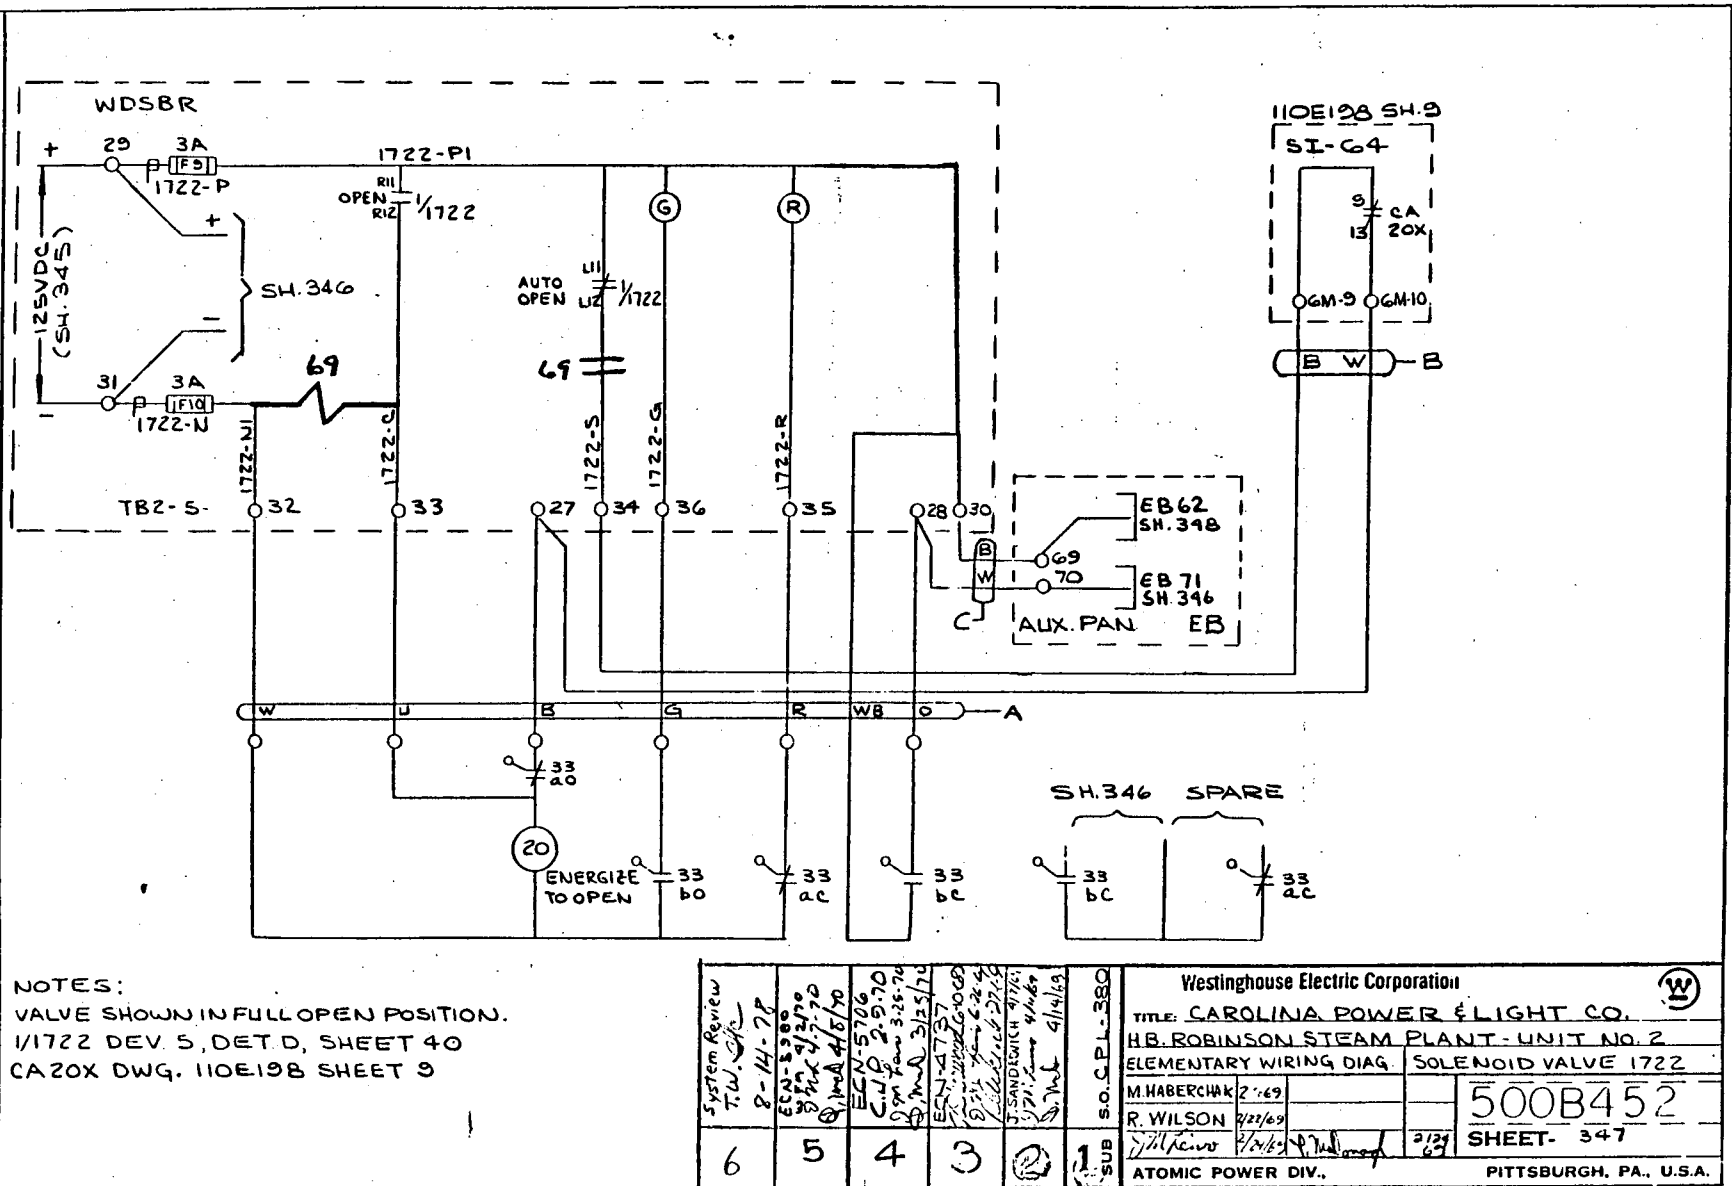



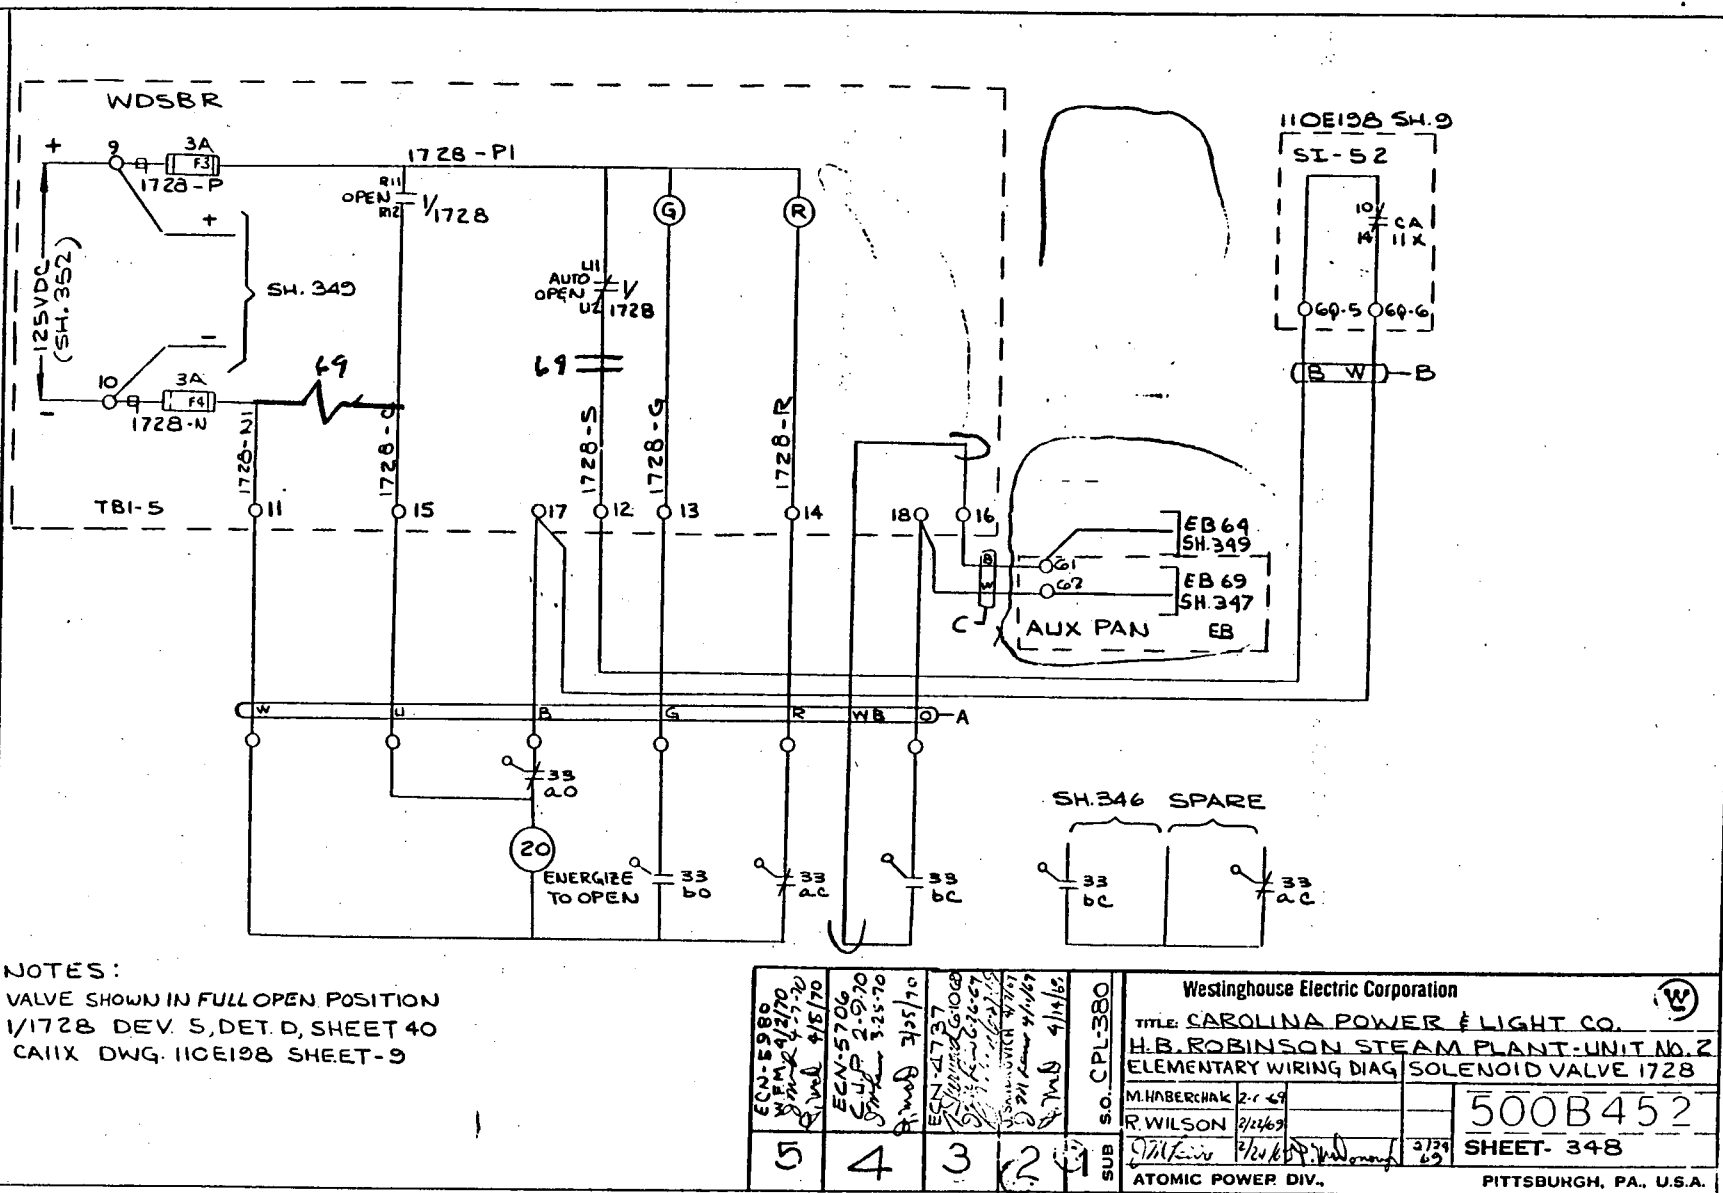

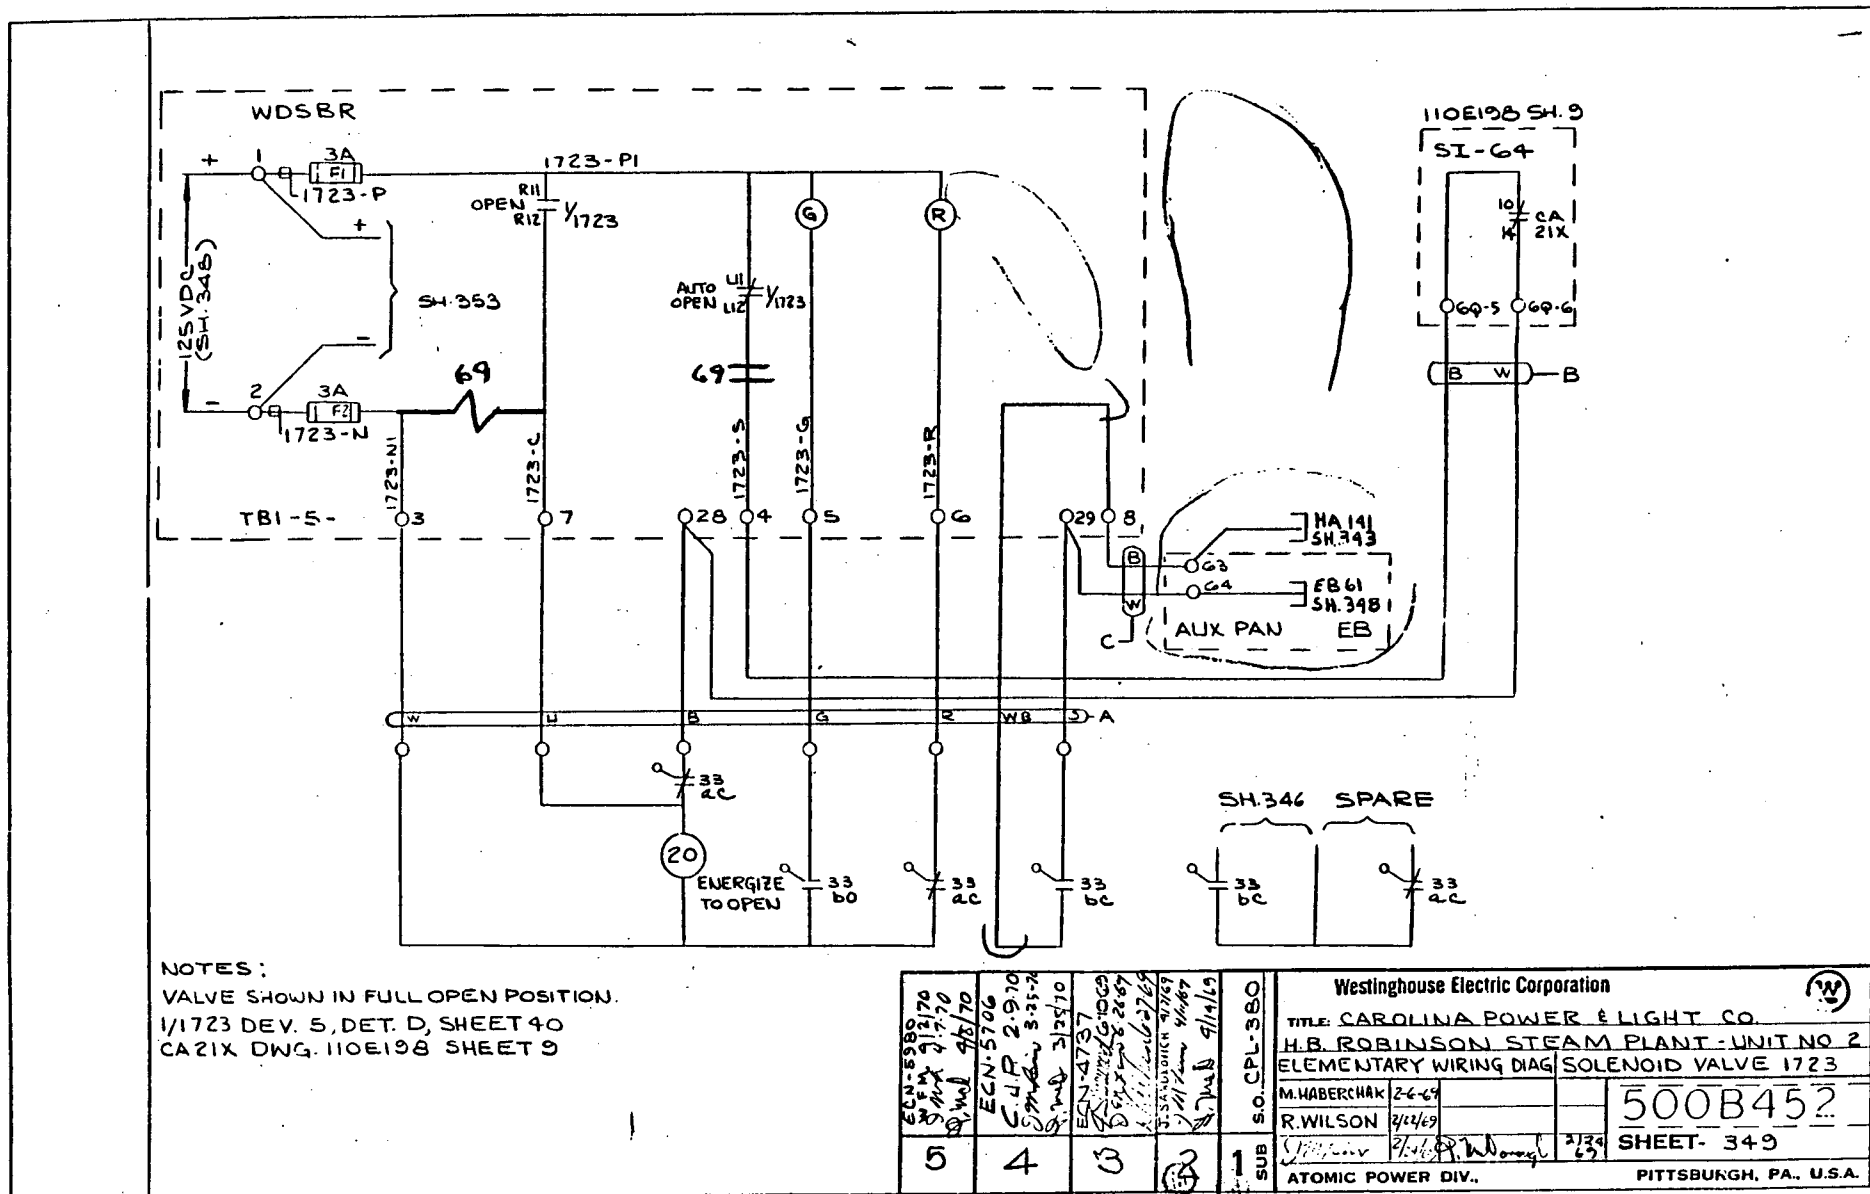

CS- DEVELOPMENT  
DEV. 23, JETH, SH 37

CABLE ROUTE III

ANN PNL  
(5373-3259)

V6-5-C  
LIM. SW.

DPS-1692C  
HVM-3  
OUTLET  
COOL WTR

SET FOR  
PROPER FLOW

LIMIT SWITCH DEVELOPMENT			
CONTACT	VALVE OPENING	CWD	SH
11-12			
3-4			
5-6			
7-8			
99-100			

CONTACT CLOSED  
\* THIS SHEET

Westinghouse Electric Corporation  
TITLE: CAROLINA POWER & LIGHT COMPANY  
H. B. ROBINSON STEAM ELECTRIC PLANT


CONTROL WIRING DIAGRAM

5008452

SH 106

ATOMIC POWER DIV.

PITTSBURGH, PA., U.S.A.

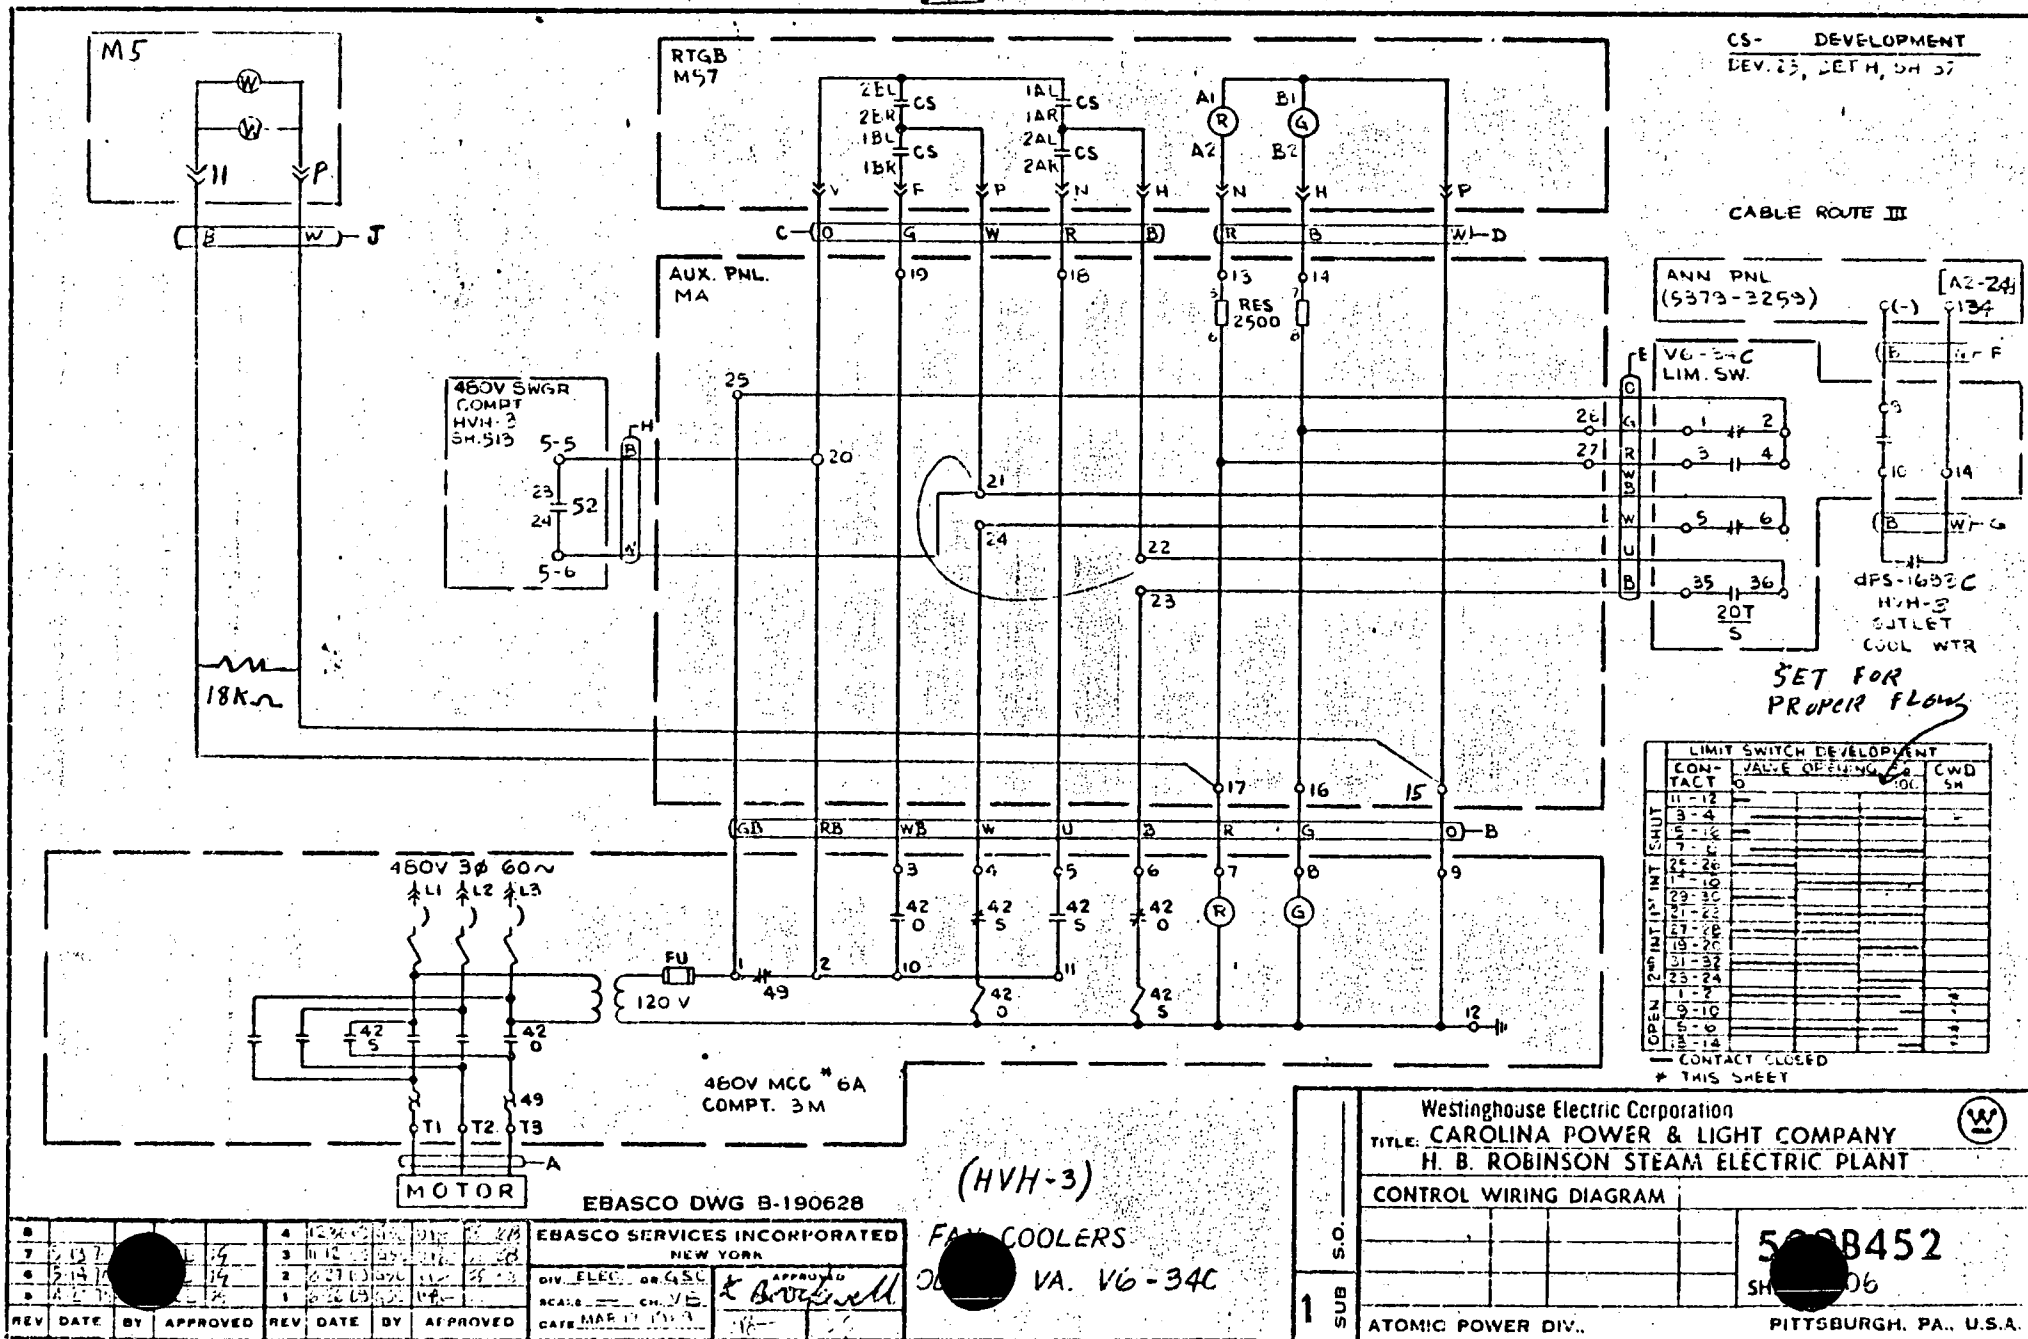

EBASCO DWG B-190628

(HVM-3)

FAN COOLERS


VA. V6-34C

EBASCO SERVICES INCORPORATED  
NEW YORK  
DIV. ELEC. OR. GSC  
SCALE: CH. 2/5  
DATE: MAR 11 1959  
APPROVED: [Signature]

REV	DATE	BY	APPROVED	REV	DATE	BY	APPROVED
1	12-17-58	...	...	2	1-12-59	...	...
3	2-14-59	...	...	4	3-10-59	...	...
5	4-15-59	...	...	6	5-12-59	...	...
7	6-10-59	...	...	8	7-8-59	...	...
9	8-5-59	...	...	10	9-2-59	...	...
11	10-1-59	...	...	12	11-1-59	...	...
13	12-1-59	...	...	14	1-1-60	...	...
15	2-1-60	...	...	16	3-1-60	...	...
17	4-1-60	...	...	18	5-1-60	...	...
19	6-1-60	...	...	20	7-1-60	...	...
21	8-1-60	...	...	22	9-1-60	...	...
23	10-1-60	...	...	24	11-1-60	...	...
25	12-1-60	...	...	26	1-1-61	...	...
27	2-1-61	...	...	28	3-1-61	...	...
29	4-1-61	...	...	30	5-1-61	...	...
31	6-1-61	...	...	32	7-1-61	...	...
33	8-1-61	...	...	34	9-1-61	...	...
35	10-1-61	...	...	36	11-1-61	...	...
37	12-1-61	...	...	38	1-1-62	...	...
39	2-1-62	...	...	40	3-1-62	...	...
41	4-1-62	...	...	42	5-1-62	...	...
43	6-1-62	...	...	44	7-1-62	...	...
45	8-1-62	...	...	46	9-1-62	...	...
47	10-1-62	...	...	48	11-1-62	...	...
49	12-1-62	...	...	50	1-1-63	...	...
51	2-1-63	...	...	52	3-1-63	...	...
53	4-1-63	...	...	54	5-1-63	...	...
55	6-1-63	...	...	56	7-1-63	...	...
57	8-1-63	...	...	58	9-1-63	...	...
59	10-1-63	...	...	60	11-1-63	...	...
61	12-1-63	...	...	62	1-1-64	...	...
63	2-1-64	...	...	64	3-1-64	...	...
65	4-1-64	...	...	66	5-1-64	...	...
67	6-1-64	...	...	68	7-1-64	...	...
69	8-1-64	...	...	70	9-1-64	...	...
71	10-1-64	...	...	72	11-1-64	...	...
73	12-1-64	...	...	74	1-1-65	...	...
75	2-1-65	...	...	76	3-1-65	...	...
77	4-1-65	...	...	78	5-1-65	...	...
79	6-1-65	...	...	80	7-1-65	...	...
81	8-1-65	...	...	82	9-1-65	...	...
83	10-1-65	...	...	84	11-1-65	...	...
85	12-1-65	...	...	86	1-1-66	...	...
87	2-1-66	...	...	88	3-1-66	...	...
89	4-1-66	...	...	90	5-1-66	...	...
91	6-1-66	...	...	92	7-1-66	...	...
93	8-1-66	...	...	94	9-1-66	...	...
95	10-1-66	...	...	96	11-1-66	...	...
97	12-1-66	...	...	98	1-1-67	...	...
99	2-1-67	...	...	100	3-1-67	...	...


CS- DEVELOPMENT  
DEV. 25, DET. H. SH. 37

CABLE ROUTE II

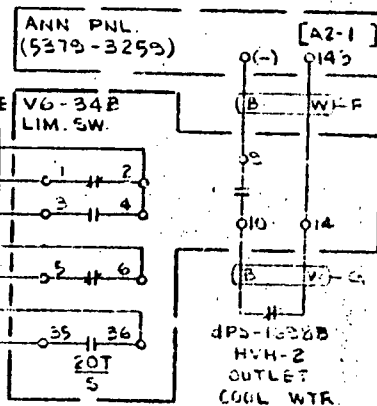

LIMIT SWITCH REF. ELEMENT			
CON- TACT	VALVE OPENING	SE NO.	CWD SH
1-2			
2-3			
3-4			
99-100			

CONTACT CLOSED  
\* THIS SHEET

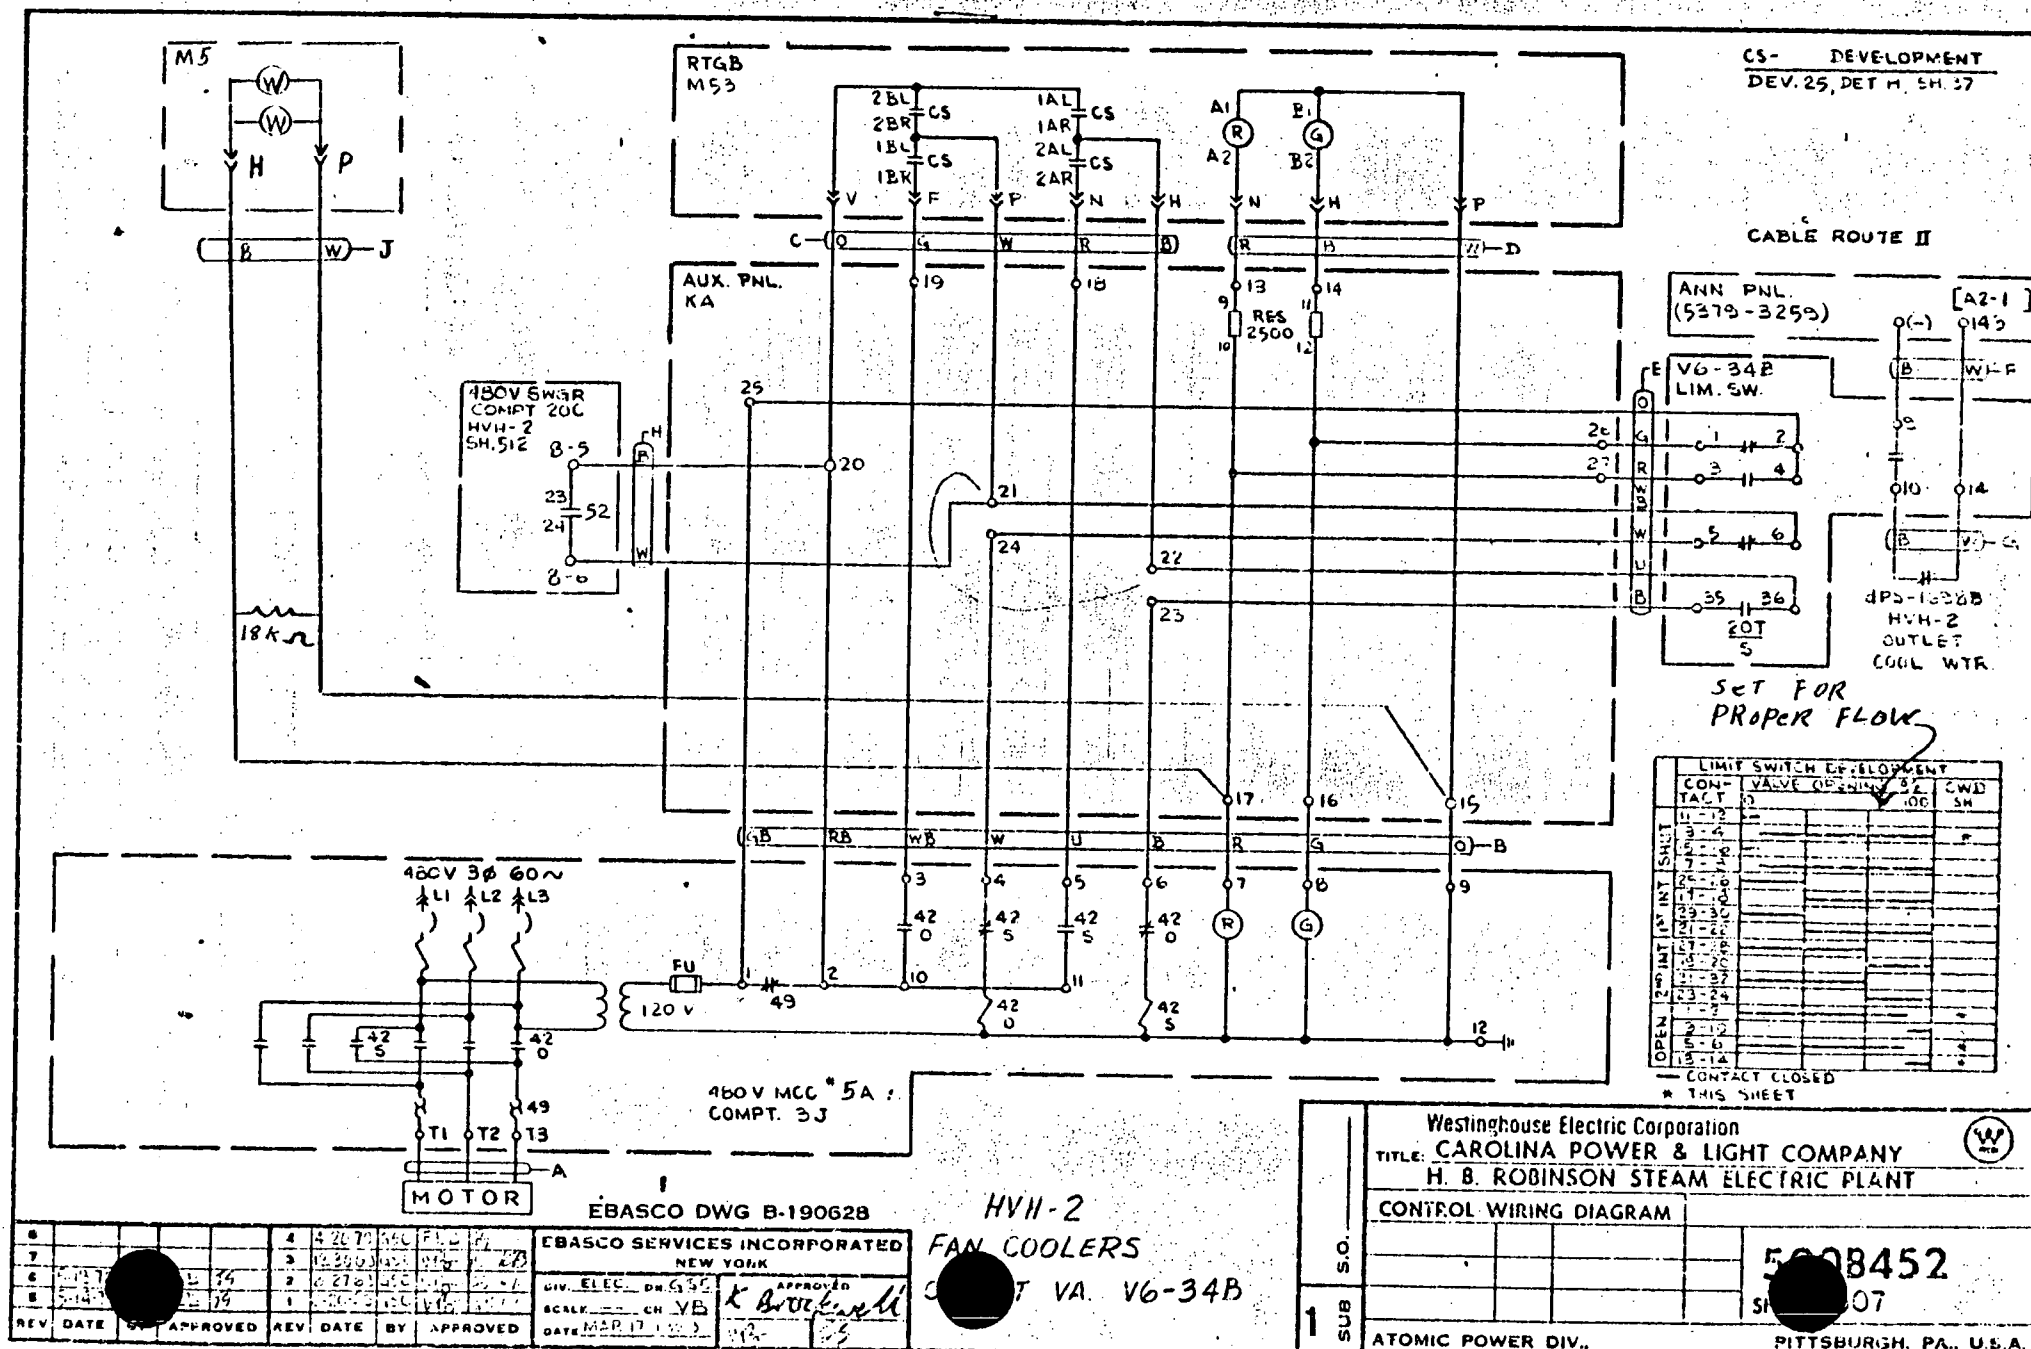


REV	DATE	APPROVED	REV	DATE	BY	APPROVED
1	10-17-53		2	10-27-53		
3	11-23-53		4	12-17-53		
5	1-14-54		6	2-17-54		
7	3-17-54		8	4-17-54		
9	5-17-54		10	6-17-54		
11	7-17-54		12	8-17-54		
13	9-17-54		14	10-17-54		
15	11-17-54		16	12-17-54		
17	1-17-55		18	2-17-55		
19	3-17-55		20	4-17-55		
21	5-17-55		22	6-17-55		
23	7-17-55		24	8-17-55		
25	9-17-55		26	10-17-55		
27	11-17-55		28	12-17-55		
29	1-17-56		30	2-17-56		
31	3-17-56		32	4-17-56		
33	5-17-56		34	6-17-56		
35	7-17-56		36	8-17-56		
37	9-17-56		38	10-17-56		
39	11-17-56		40	12-17-56		
41	1-17-57		42	2-17-57		
43	3-17-57		44	4-17-57		
45	5-17-57		46	6-17-57		
47	7-17-57		48	8-17-57		
49	9-17-57		50	10-17-57		
51	11-17-57		52	12-17-57		
53	1-17-58		54	2-17-58		
55	3-17-58		56	4-17-58		
57	5-17-58		58	6-17-58		
59	7-17-58		60	8-17-58		
61	9-17-58		62	10-17-58		
63	11-17-58		64	12-17-58		
65	1-17-59		66	2-17-59		
67	3-17-59		68	4-17-59		
69	5-17-59		70	6-17-59		
71	7-17-59		72	8-17-59		
73	9-17-59		74	10-17-59		
75	11-17-59		76	12-17-59		
77	1-17-60		78	2-17-60		
79	3-17-60		80	4-17-60		
81	5-17-60		82	6-17-60		
83	7-17-60		84	8-17-60		
85	9-17-60		86	10-17-60		
87	11-17-60		88	12-17-60		
89	1-17-61		90	2-17-61		
91	3-17-61		92	4-17-61		
93	5-17-61		94	6-17-61		
95	7-17-61		96	8-17-61		
97	9-17-61		98	10-17-61		
99	11-17-61		100	12-17-61		

EBASCO DWG B-190628  
HVH-2  
FAN COOLERS  
V6-34B

Westinghouse Electric Corporation  
TITLE: CAROLINA POWER & LIGHT COMPANY  
H. B. ROBINSON STEAM ELECTRIC PLANT  
CONTROL WIRING DIAGRAM

5008452  
SH 107

ATOMIC POWER DIV.,  
PITTSBURGH, PA., U.S.A.

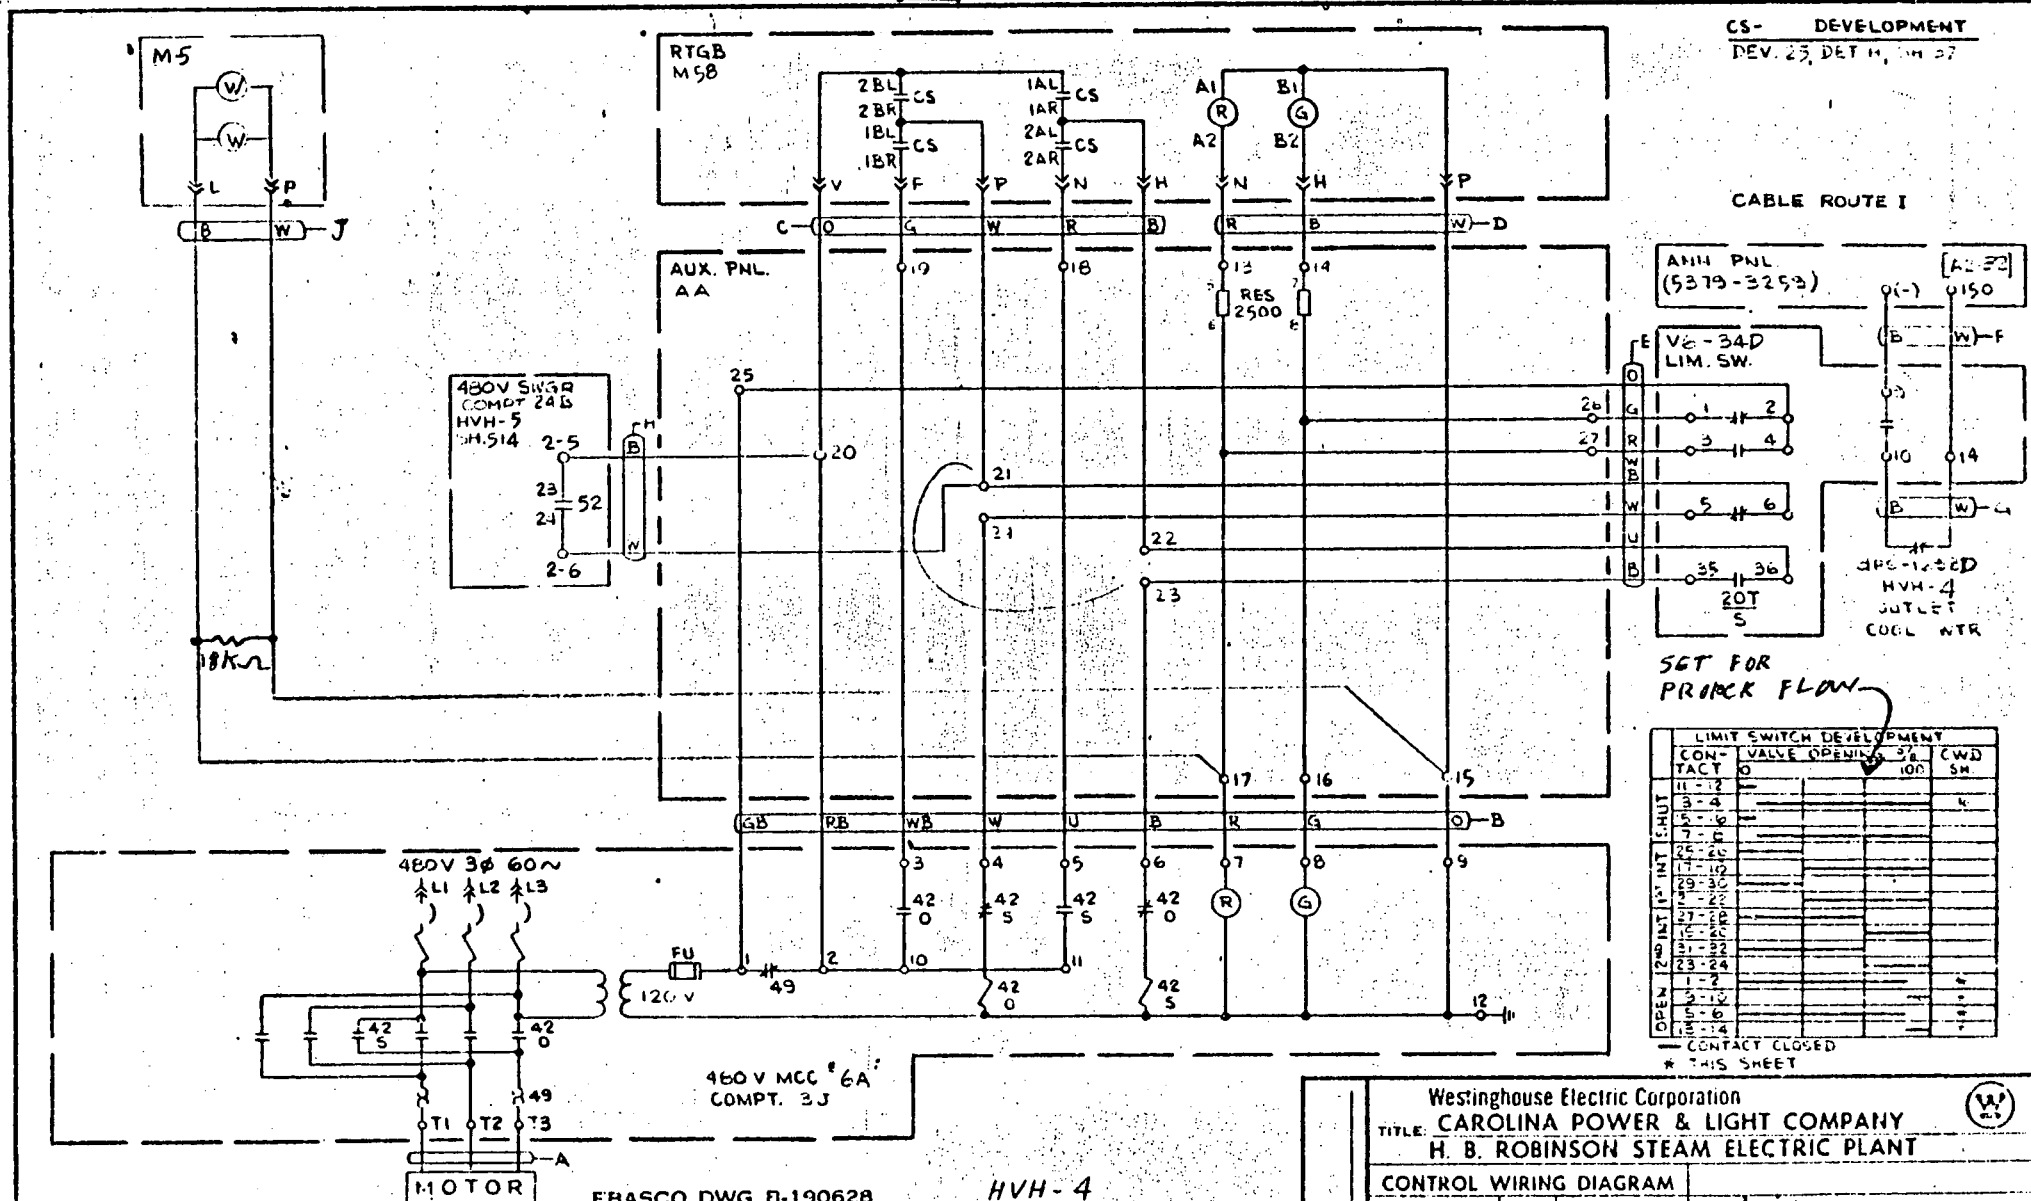


REV	DATE	BY	APPROVED	REV	DATE	BY	APPROVED
1	4-20-77	3		2	12-31-77	3	
2	5-15-77	3		3	11-12-77	3	
3	7-15-77	3		4	6-26-78	3	

EBASCO SERVICES INCORPORATED	NEW YORK
DIV. F.E.D. OR G.S.C.	APPROVED
SCALE: CH. V.B.	DATE: MAR 17 1978

Westinghouse Electric Corporation	
TITLE: CAROLINA POWER & LIGHT COMPANY	
H. B. ROBINSON STEAM ELECTRIC PLANT	
CONTROL WIRING DIAGRAM	
S.O.	
SUB	
ATOMIC POWER DIV., PITTSBURGH, PA. U.S.A.	

**5008452**

**500**

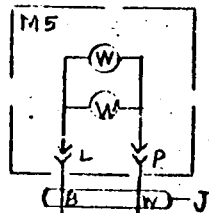

RTGB  
M4B

AUX. PNL.  
CA

480V SWGR.  
COMPT. 19B  
HVH-1  
54.511

18A

480V 3Ø 60~

480V MCC 5A.  
COMPT. 3M

MOTOR

EBASCO DWG B-190628

HVH-1

FAN COOLERS

ET VA V6-34A

CS- DEVELOPMENT  
DEV. 25, DET H, 54.37

CABLE ROUTE IV

ANN PNL.  
(5378-3250)

V6-34A  
LIM. SW.

SET FOR  
PROPER FLOW

LIMIT SWITCH DEVELOPMENT			
CONTACT	VALVE OFFLINE	VALVE ONLINE	CWD
1-2			
3-4			
5-6			
99-100			

CONTACT CLOSED  
\* THIS SHEET

Westinghouse Electric Corporation  
TITLE: CAROLINA POWER & LIGHT COMPANY  
H. B. ROBINSON STEAM ELECTRIC PLANT

CONTROL WIRING DIAGRAM

500B452

509

ATOMIC POWER DIV.

PITTSBURGH, PA., U.S.A.


REV	DATE	APPROVED	REV	DATE	BY	APPROVED
1	12-20-54	656	2	1-12-55	656	656
3	1-12-55	656	4	1-12-55	656	656
5	1-12-55	656	6	1-12-55	656	656
7	1-12-55	656	8	1-12-55	656	656
99	1-12-55	656	100	1-12-55	656	656

EBASCO SERVICES INCORPORATED  
NEW YORK

DIV. ELEC. DE. 556  
SCALE: 1" = 100'  
DATE: MAR 17 1955

APPROVED  
H. B. ROBINSON

ANN FNL (5373-3253)

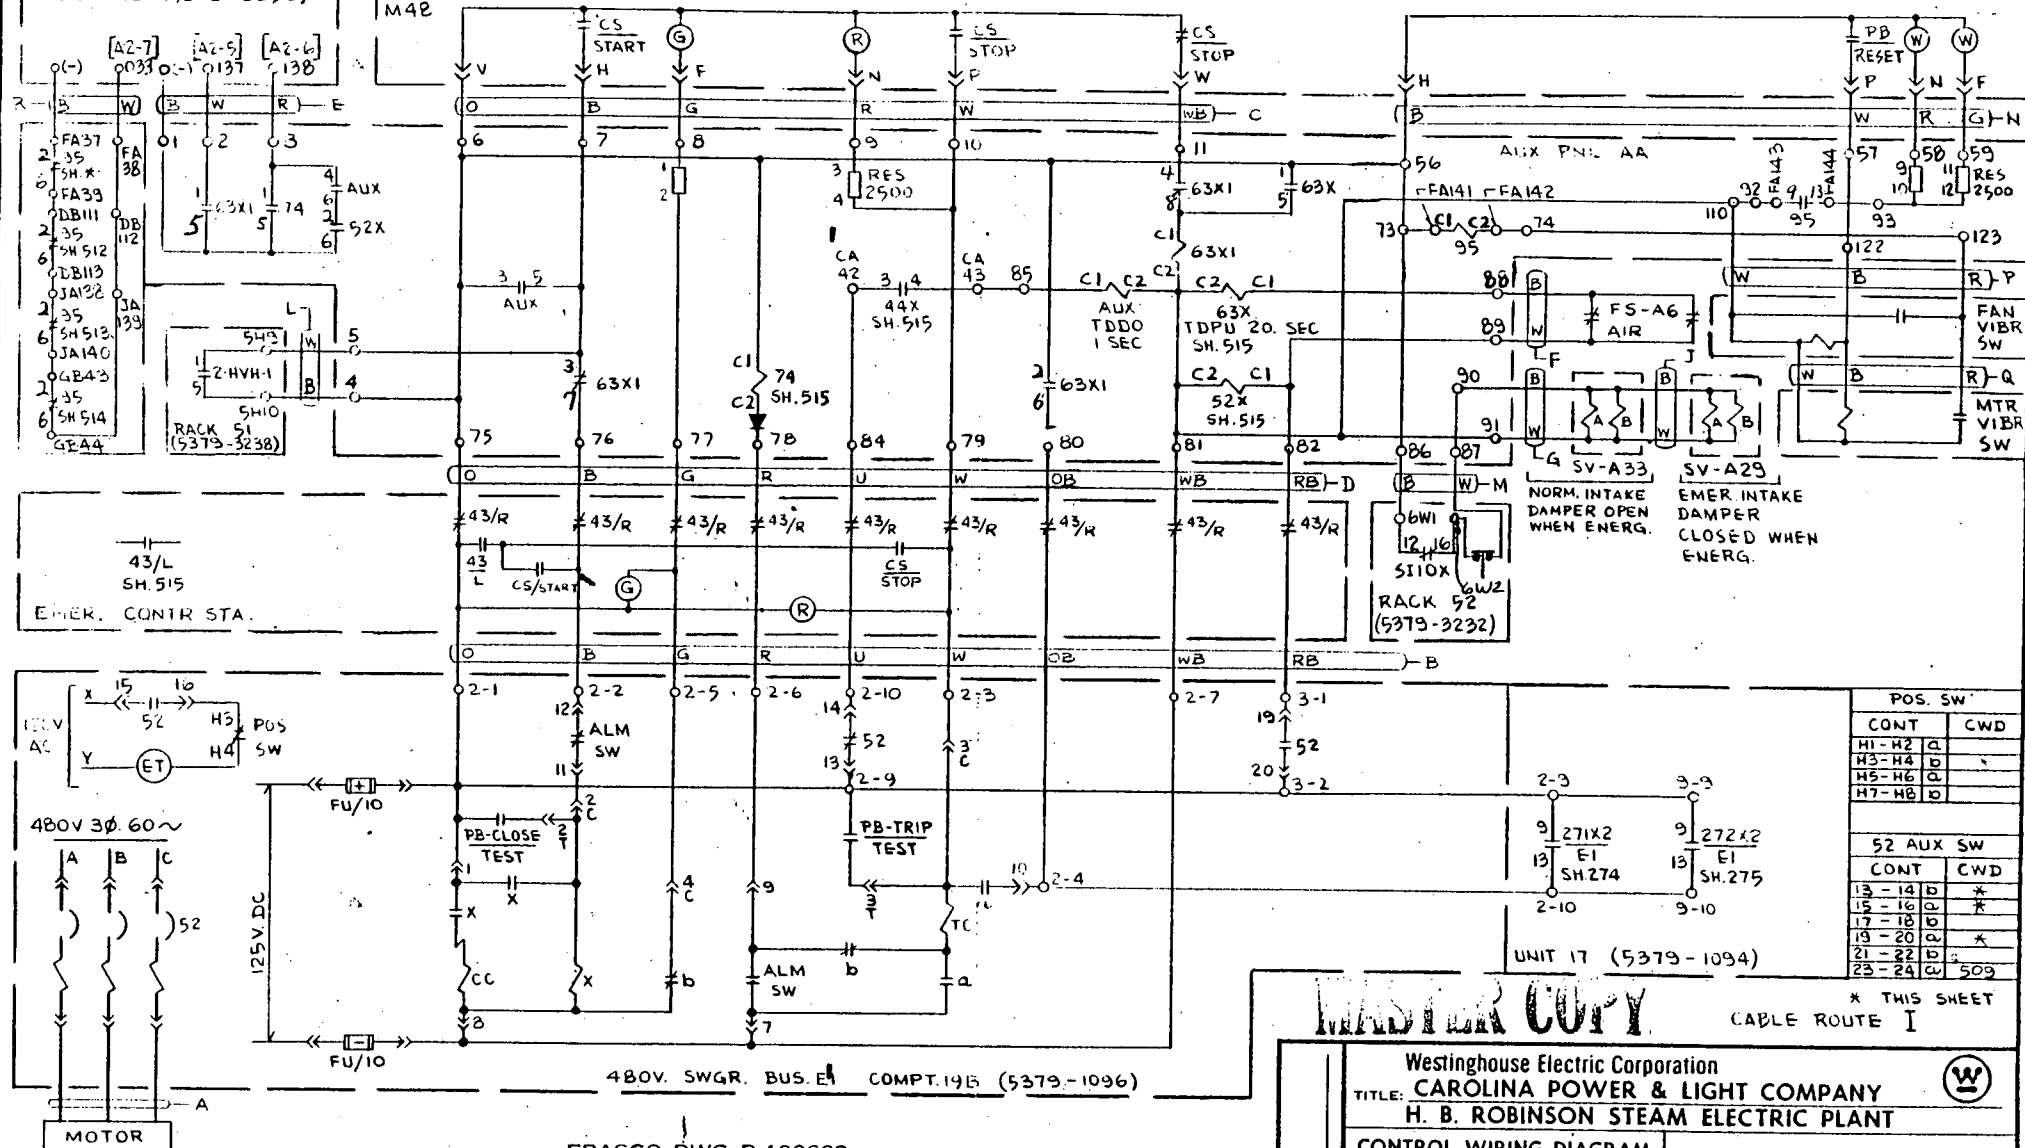RTGB  
M42

EBASCO DWG B-190628

EBASCO SERVICES INCORPORATED  
NEW YORKDIV. ELEC. DR. GSC  
SCALE: CH. VB  
DATE: MAY 23, 1963  
APPROVED: K. B. [Signature]  
VB [Signature]

REV	DATE	BY	APPROVED	REV	DATE	BY	APPROVED
1	2-26-58	JLR		1	6-26-63	VB	
2	12-30-63	GSC		2	12-30-63	GSC	
3	2-19-70	GSC		3	2-19-70	GSC	
4	8-3-70	GSC		4	8-3-70	GSC	

REACTOR CONTAINMENT  
RECIRC. COOL. UNIT  
HVH-1

MASTER COPY

\* THIS SHEET  
CABLE ROUTE IWestinghouse Electric Corporation  
TITLE: CAROLINA POWER & LIGHT COMPANY  
H. B. ROBINSON STEAM ELECTRIC PLANT


CONTROL WIRING DIAGRAM

500B452  
SHEET 511

ATOMIC POWER DIV.,

PITTSBURGH, PA., U.S.A.

ANN FNL (5373-3253)

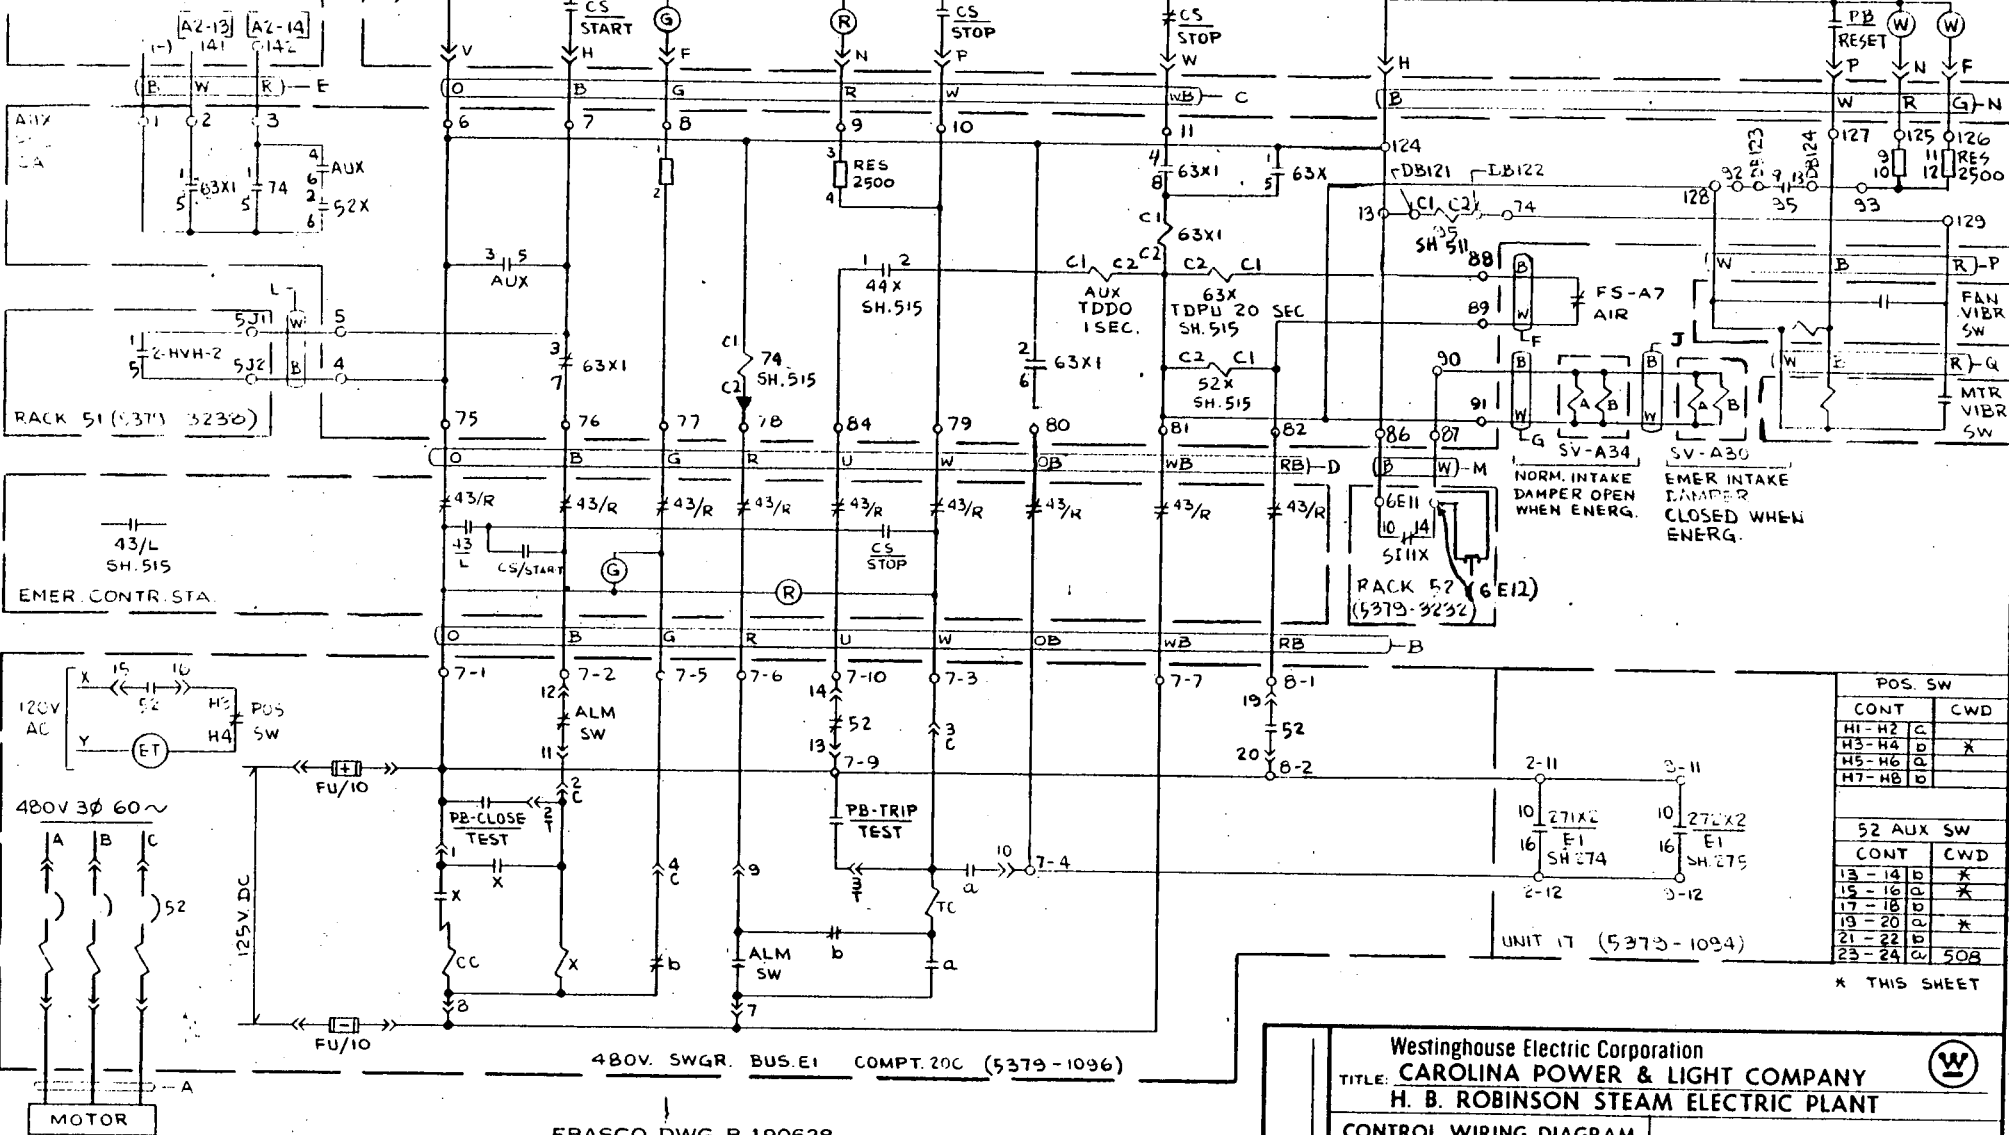RTGB  
M53

REV	DATE	BY	APPROVED	REV	DATE	BY	APPROVED
8				4	2-3-70	GSC	FLD 39
7				3	2-19-70	GSC	FLD 39
6	3/1/75	Mal 241	20824	2	2-2-69	GSC	YR 1 KB
5	2/26/75	JLR	20824	1	6-10-67	GSC	YR 1 KB

EBASCO SERVICES INCORPORATED NEW YORK			
DIV. ELEC. DR. GSC	SCALE = CH. VB	DATE MAY 23 1963	APPROVED K. Brokaw
			VI 38


REACTOR CONTAINMENT  
RECIRC. COOL. UNIT  
HVH-2

S.O.		SUB	
1			

POS. SW	
CONT	CWD
H1-H2 C	
H3-H4 D	X
H5-H6 D	
H7-H8 D	
52 AUX SW	
CONT	CWD
13-14 D	X
15-16 D	X
17-18 D	X
19-20 D	X
21-22 D	X
23-24 D	50B

\* THIS SHEET



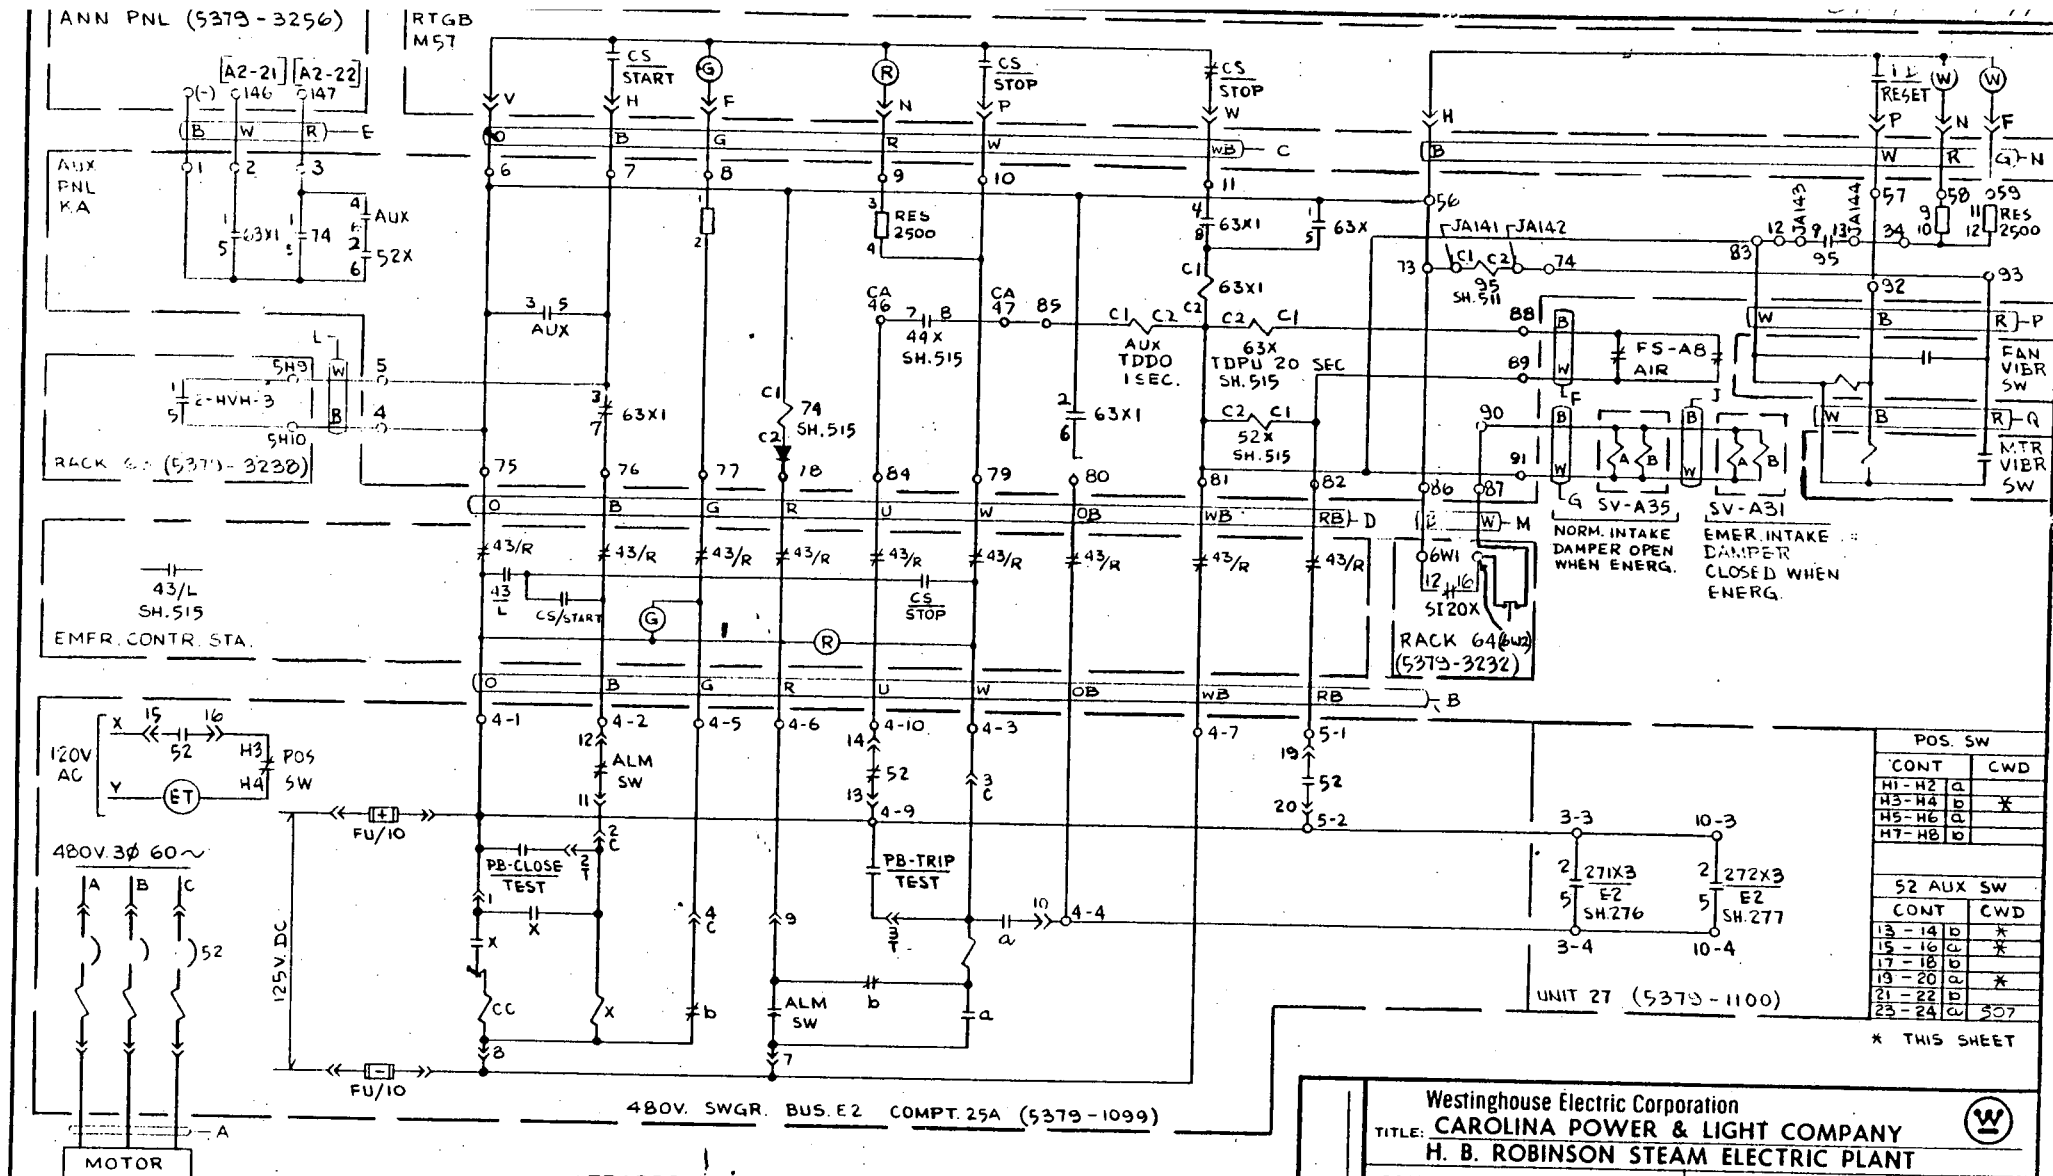


REV	DATE	BY	APPROVED	REV	DATE	BY	APPROVED
1	7-14-78	T.C.	MC	2	2-19-70	GSC	FLD
2	3-27-75	mod	263	3	2-19-70	GSC	FLD
3	2-26-75	FLD	263	4	2-19-70	GSC	FLD
				5	2-19-70	GSC	FLD

EBASCO SERVICES INCORPORATED  
NEW YORK  
DIV. ELEC. DR. GSC  
SCALE = CH. V.D.  
DATE MAY 23, 1969  
K. Brokaw  
APPROVED


Westinghouse Electric Corporation		500B452
TITLE: CAROLINA POWER & LIGHT COMPANY H. B. ROBINSON STEAM ELECTRIC PLANT		
CONTROL WIRING DIAGRAM		SHEET 513
ATOMIC POWER DIV.,		PITTSBURGH, PA., U.S.A.

POS. SW	
CONT	CWD
H1-H2	a
H3-H4	b
H5-H6	c
H7-H8	d
52 AUX SW	
CONT	CWD
13-14	b
15-16	c
17-18	d
19-20	a
21-22	b
23-24	c

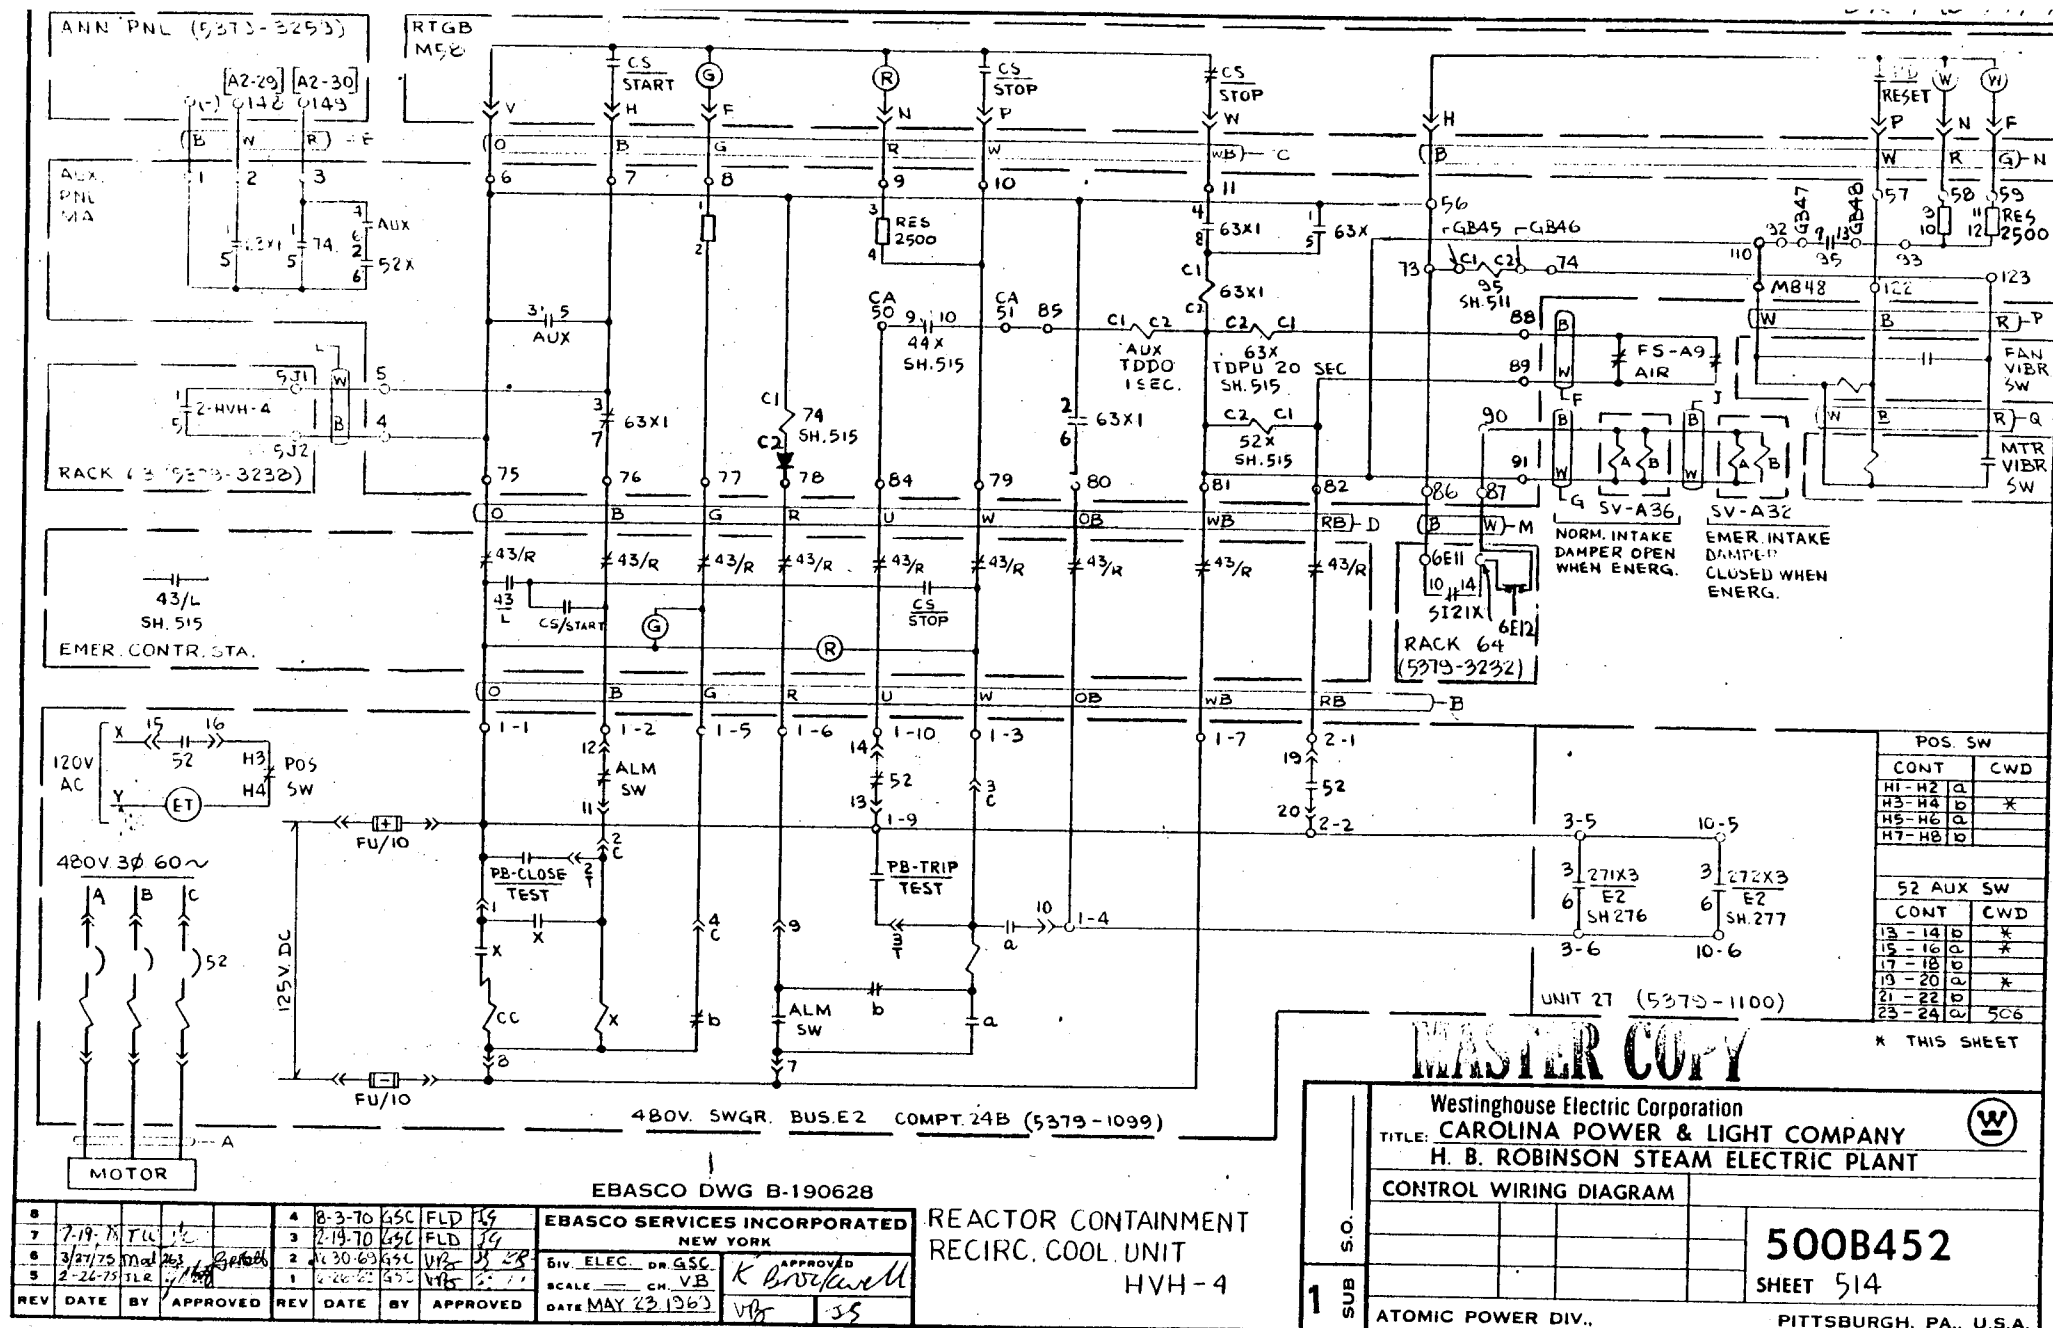



Mod 27-R1

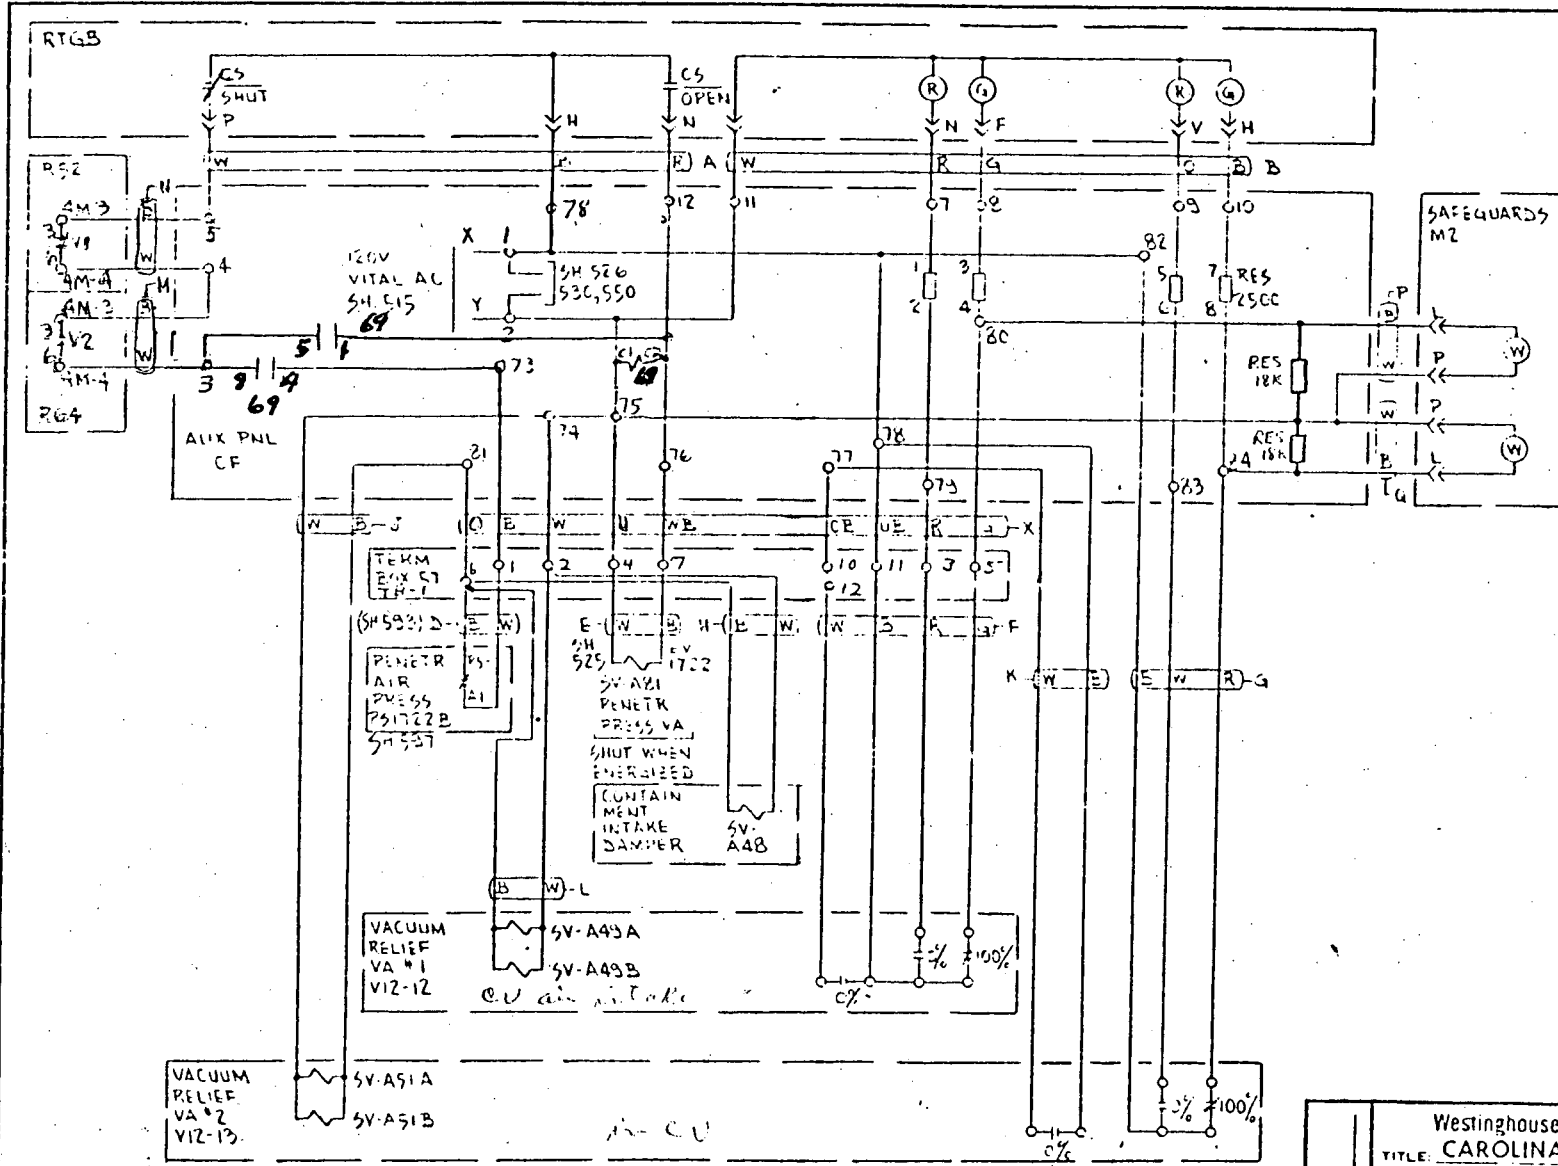

EBASCO DWG B-190028


1	10-20-70-050	FLD	34
2	5-10-70-050	FLD	34
3	5-7-70-050	FLD	34
4	5-3-70-050	FLD	34
5	5-1-70-050	FLD	34
6	5-1-70-050	FLD	34
7	5-1-70-050	FLD	34
8	5-1-70-050	FLD	34
9	5-1-70-050	FLD	34
10	5-1-70-050	FLD	34

CONTAINMENT VACUUM VALVES  
VIZ-12 VIZ-13

Westinghouse Electric Corporation		
TITLE: CAROLINA POWER & LIGHT COMPANY H. B. ROBINSON STEAM ELECTRIC PLANT		
CONTROL WIRING DIAGRAM		
1	0	528452
NUCLEAR POWER DIV.		PLTSD: G. H. PA. 115

OK TW 7-21-78

Sheet 247 121

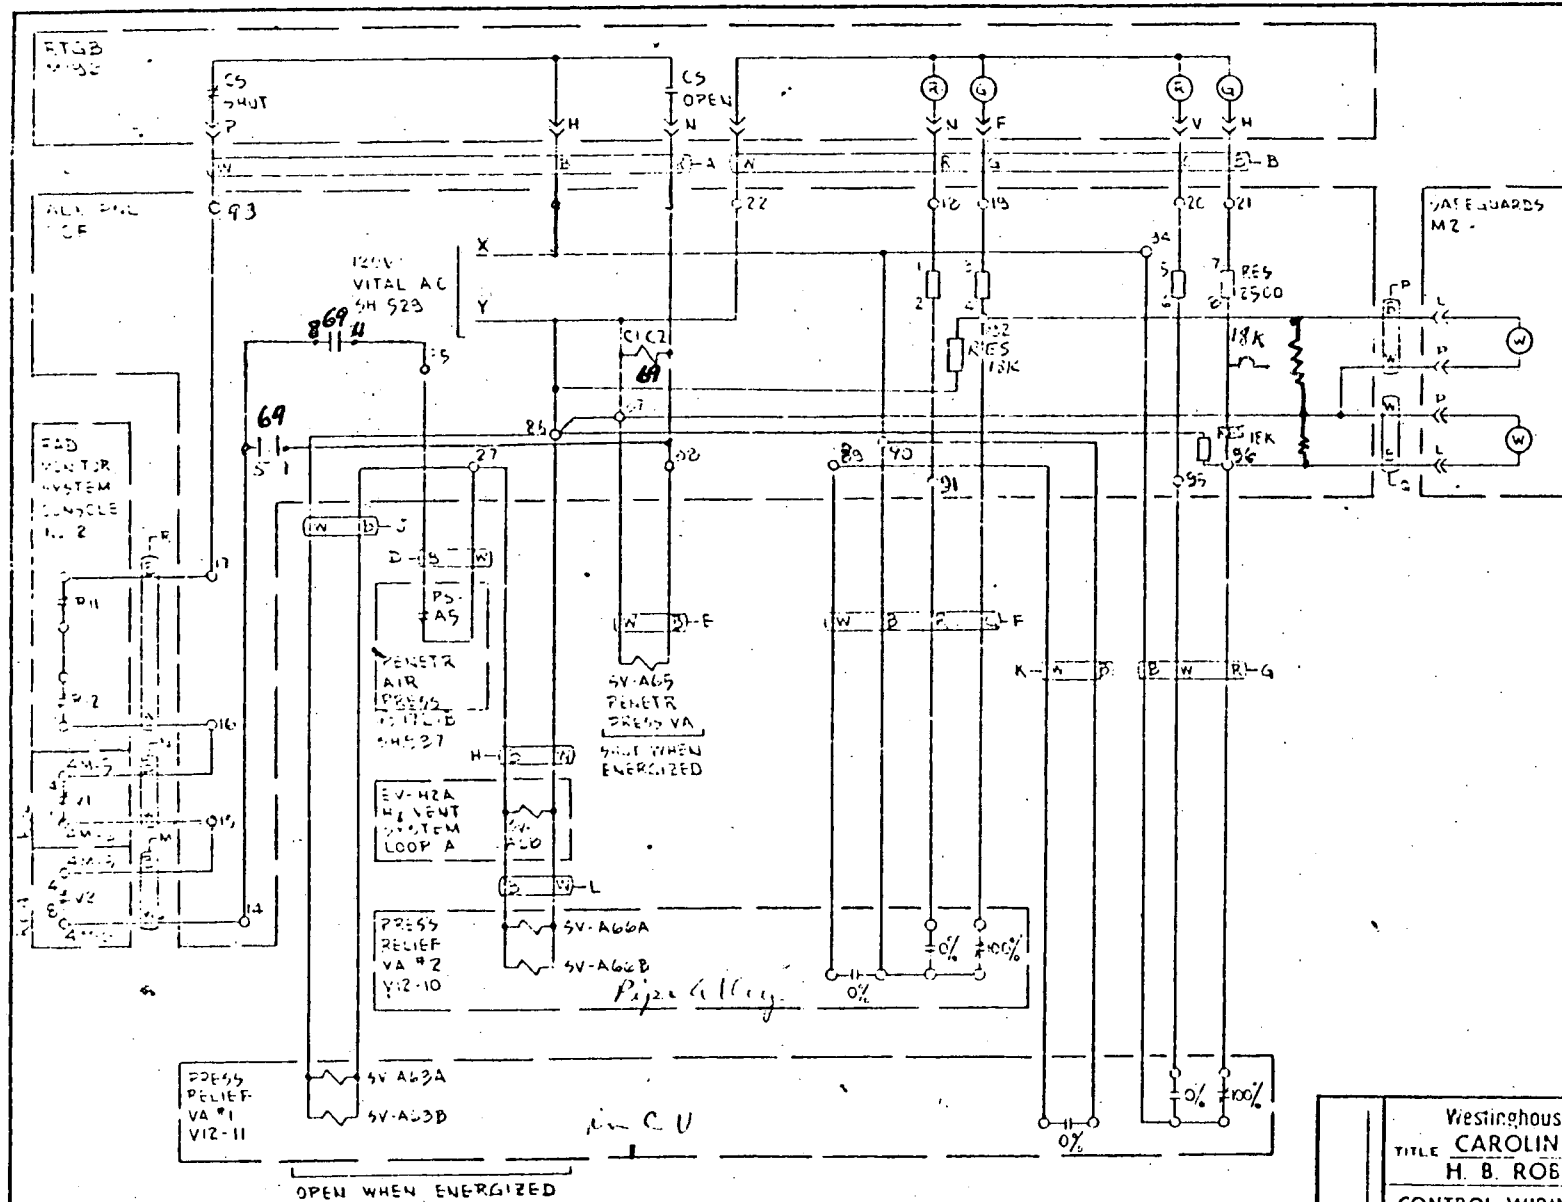


1	2	3	100
---	---	---	---	---	---	---	---	---	----	----	-----

EBASCO DWG B-190628  
EBASCO SERVICES INCORPORATED  
NEW YORK  
DIV. ELECT. OR MECH.  
SCALE 1" = 2'

Westinghouse Electric Corporation		
TITLE CAROLINA POWER & LIGHT COMPANY H. B. ROBINSON STEAM ELECTRIC PLANT		
CONTROL WIRING DIAGRAM		
SO		
1		

5452  
SHEET 1/50

OK TW 7-21-78

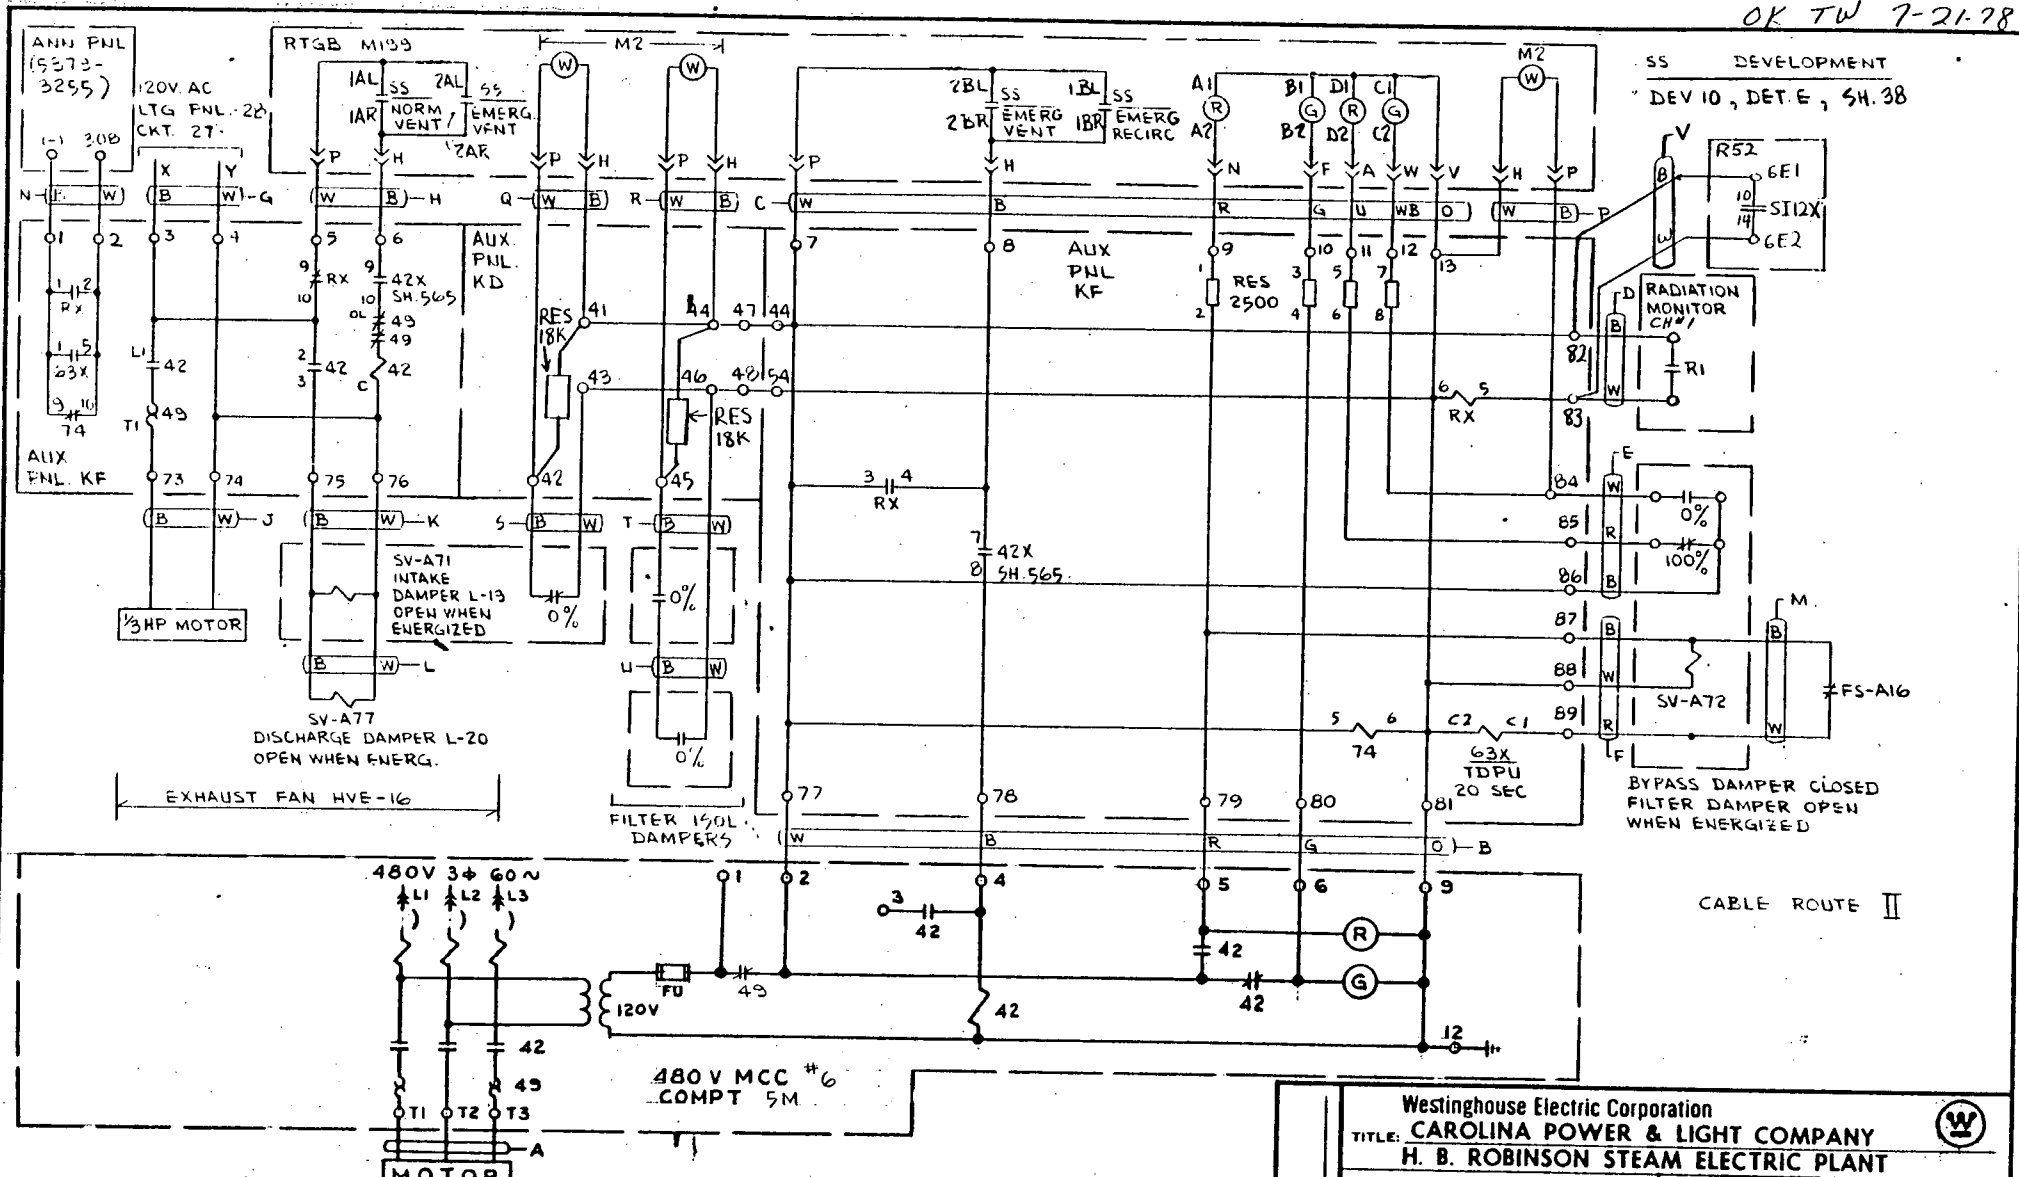



EBASCO DWG B-190628

REV	DATE	BY	APPROVED	REV	DATE	BY	APPROVED
1	7-21-78	WJC		4	5-3-70	GSC	FJ
2	10-21-70	GSC	FLD	5	5-19-70	GSC	FLD
3	10-21-70	GSC	FLD	6	10-2-70	WJC	RP
				7	1-13-67	WJC	CR

EBASCO SERVICES INCORPORATED NEW YORK	
DIV. ELEC. DR. GSC	APPROVED K. Brooker
SCALE: CH. VB	
DATE: APR 14 1963	

CONTR. RM. FILTER FAN HVE-19  
& EXHAUST FAN HVE-16

Westinghouse Electric Corporation	
TITLE: CAROLINA POWER & LIGHT COMPANY	
H. B. ROBINSON STEAM ELECTRIC PLANT	
CONTROL WIRING DIAGRAM	
500B452	
SHEET 566	
ATOMIC POWER DIV.,	
PITTSBURGH, PA., U.S.A.	

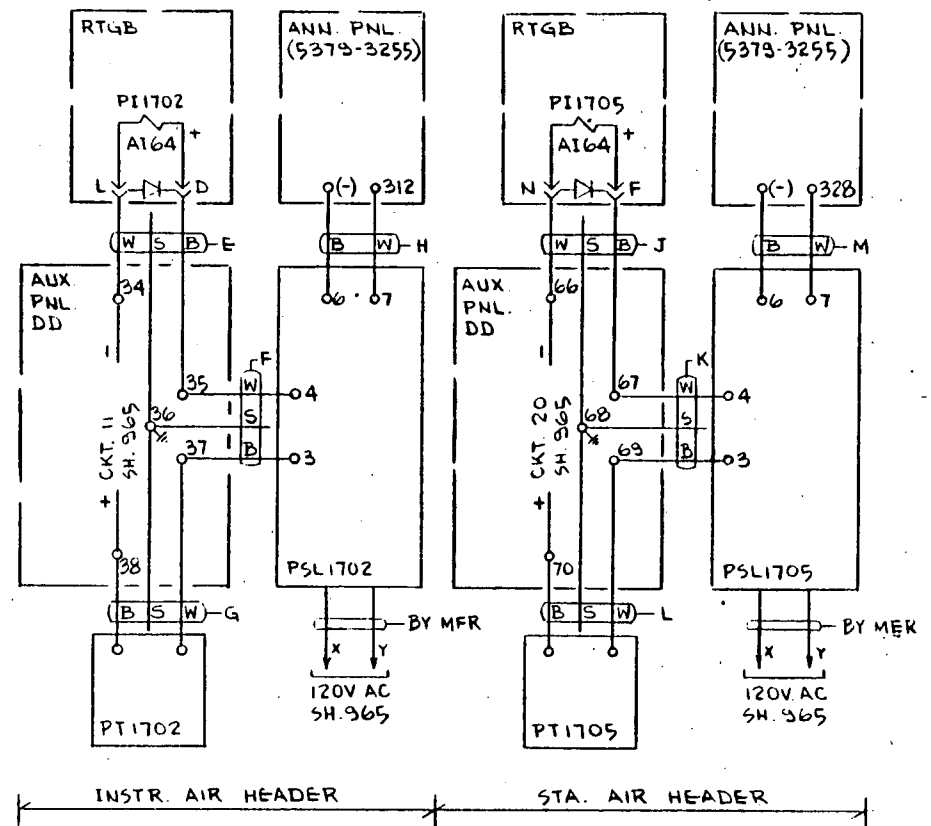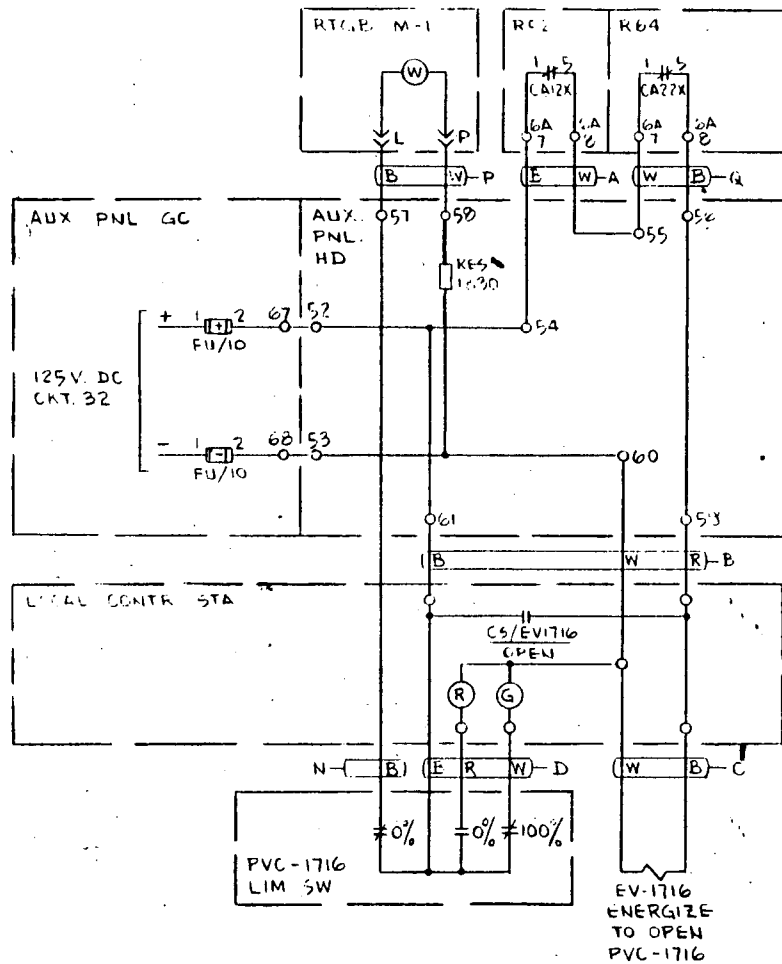


EBASCO DWG B-190628

REV	DATE	BY	APPROVED	REV	DATE	BY	APPROVED
1	6-18-70	GSC	FLD 39	1	1-15-70	GSC	VB 14
2	5-15-70	GSC	FLD 39				
3	4-27-70	GSC	VB 39				
4	1-15-70	GSC	VB 14				
5	8-18-70	GSC	FLD 39				

EBASCO SERVICES INCORPORATED NEW YORK			
DIV. ELEC.	DR. GSC	CH. VB	APPROVED
SCALE	CH. VB	DATE	AUG. 12, 1969
			VB 39

INSTRUMENT AIR TO  
CONTAINMENT  
ISOLATION VA.

Westinghouse Electric Corporation			
TITLE: CAROLINA POWER & LIGHT COMPANY			
H. B. ROBINSON STEAM ELECTRIC PLANT			
CONTROL WIRING DIAGRAM			
500B452			
SHEET 590			
ATOMIC POWER DIV., PITTSBURGH, PA., U.S.A.			

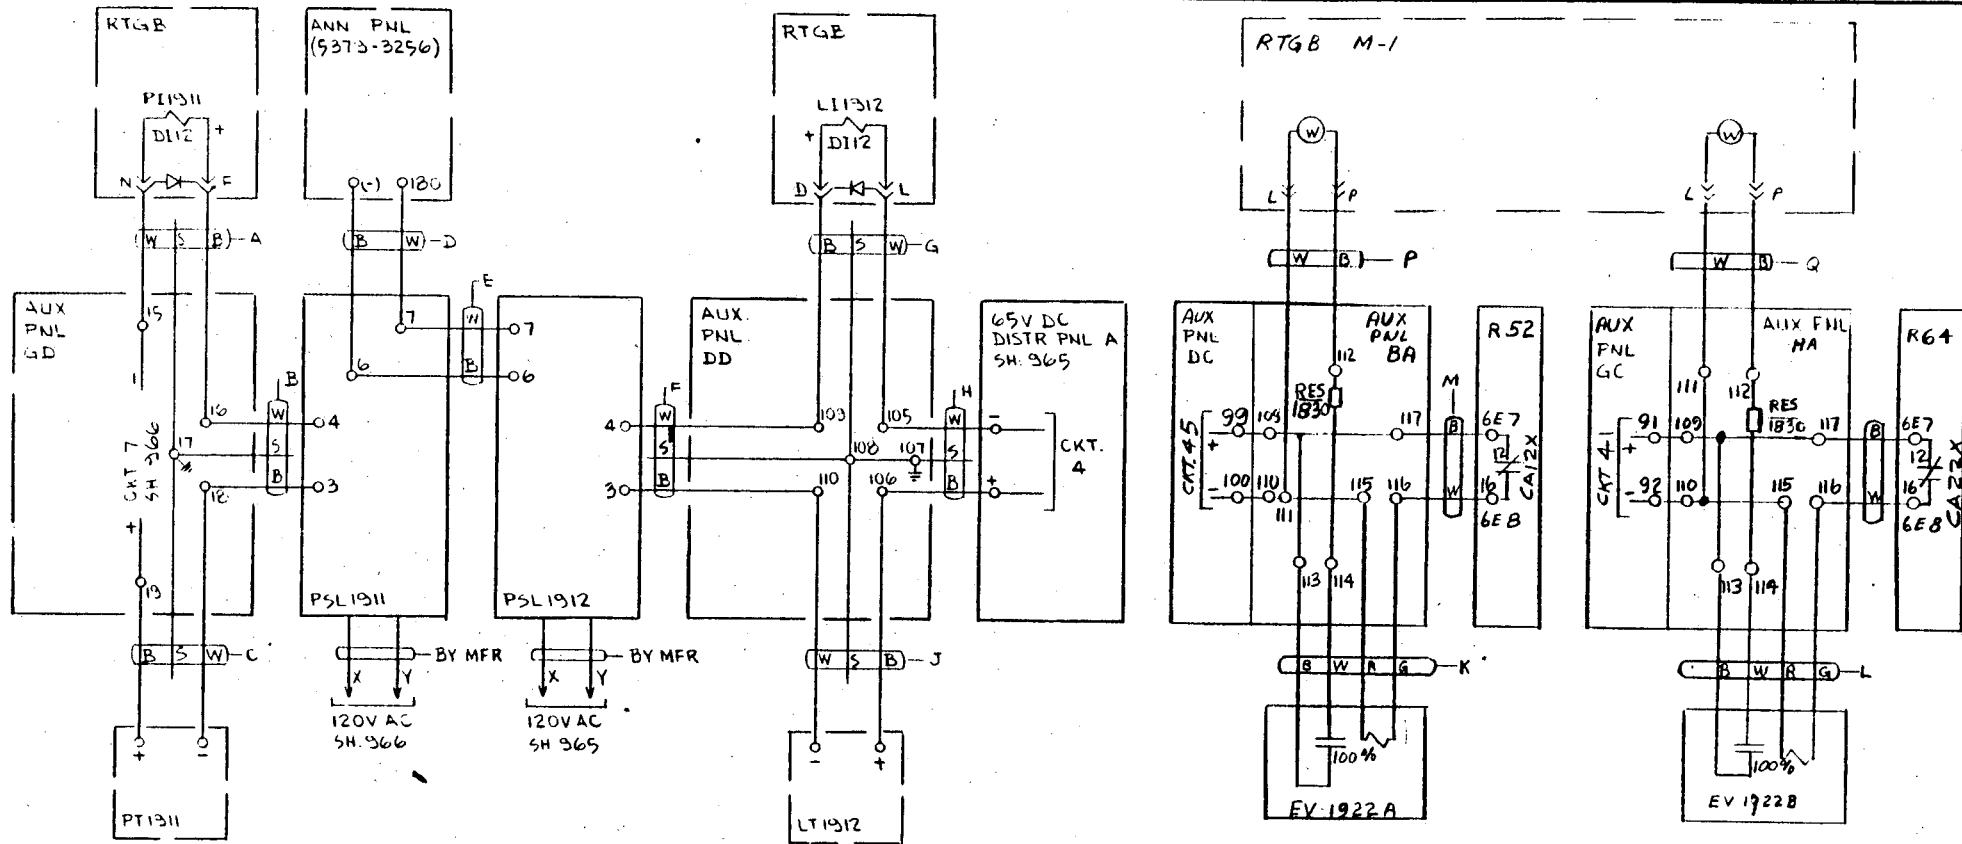

CONTAINMENT SEAL WATER INJECTION TANK

EBASCO DWG B-190628


REV	DATE	BY	APPROVED	REV	DATE	BY	APPROVED
8				4	8-26-70	GSL	FLD 1
7				3	8-15-70	GSL	FLD 1S
6	7-12-70	WAL		2	8-18-70	GSL	FLD 1S
5	2-12-70	WAL		1	2-12-70	GSL	FLD 1S

EBASCO SERVICES INCORPORATED	
NEW YORK	
DIV. ELEC. DR. G.S.L.	APPROVED
SCALE — CH. VB	<i>K. Proctor</i>
DATE JAN. 21, 1970	<i>W.B.</i>

CONTAINMENT ISOLATION  
SEAL WATER

Westinghouse Electric Corporation TITLE: CAROLINA POWER & LIGHT COMPANY H. B. ROBINSON STEAM ELECTRIC PLANT		
CONTROL WIRING DIAGRAM		500B452 SHEET 594
1 SUB		
ATOMIC POWER DIV.,		PITTSBURGH, PA., U.S.A.



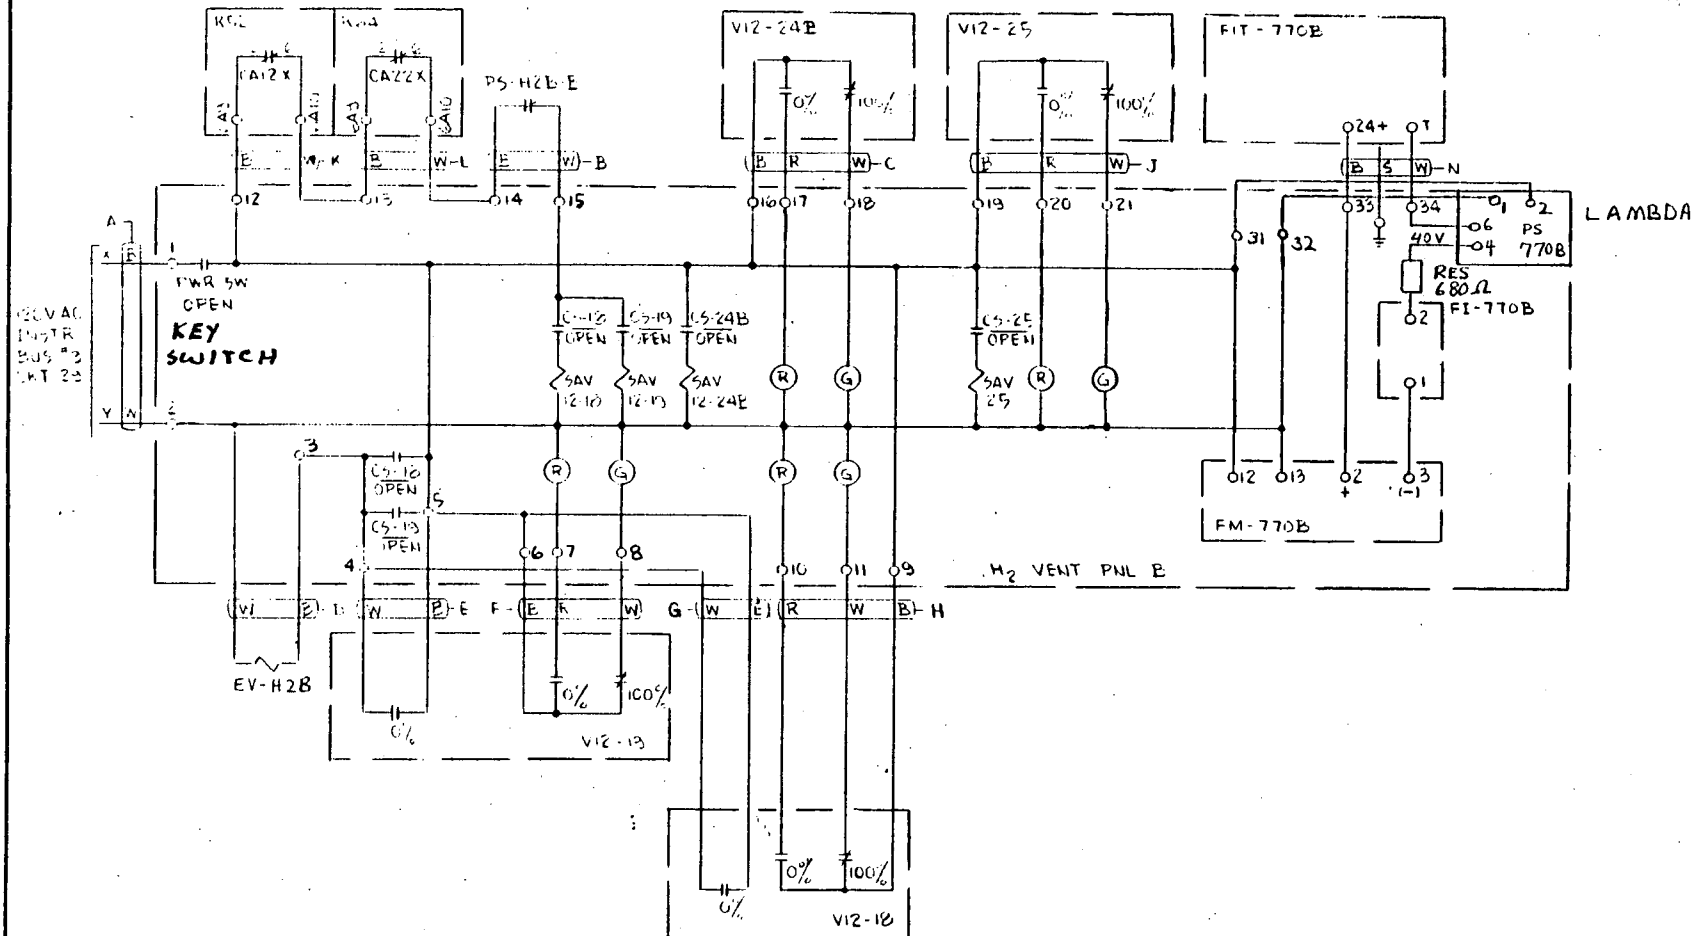


EV-H2B ——— ENER. TO CLOSE  
 SAV-12-10  
 SAV-12-13 ——— ENER. TO OPEN  
 SAV-12-24B  
 SAV-12-25

EBASCO DWG B-190628

REV	DATE	BY	APPROVED	REV	DATE	BY	APPROVED
8				4	2-24-75	SSC	FLD
7				3	2-24-75	SSC	FLD
6				2	5-13-75	SSC	FLD
5	2-15-73	TD		1	5-7-75	SSC	FLD
EBASCO SERVICES INCORPORATED NEW YORK				DIV. ELEC. DR. 456			
				SCALE CH. V2			
				DATE APR 22 1970			

H<sub>2</sub> VENT SYSTEM  
 LOOP B

S.O.		Westinghouse Electric Corporation		
		TITLE: CAROLINA POWER & LIGHT COMPANY H. B. ROBINSON STEAM ELECTRIC PLANT		
SUB		CONTROL WIRING DIAGRAM		500B452 SHEET 598
1		ATOMIC POWER DIV.,		PITTSBURGH, PA., U.S.A.

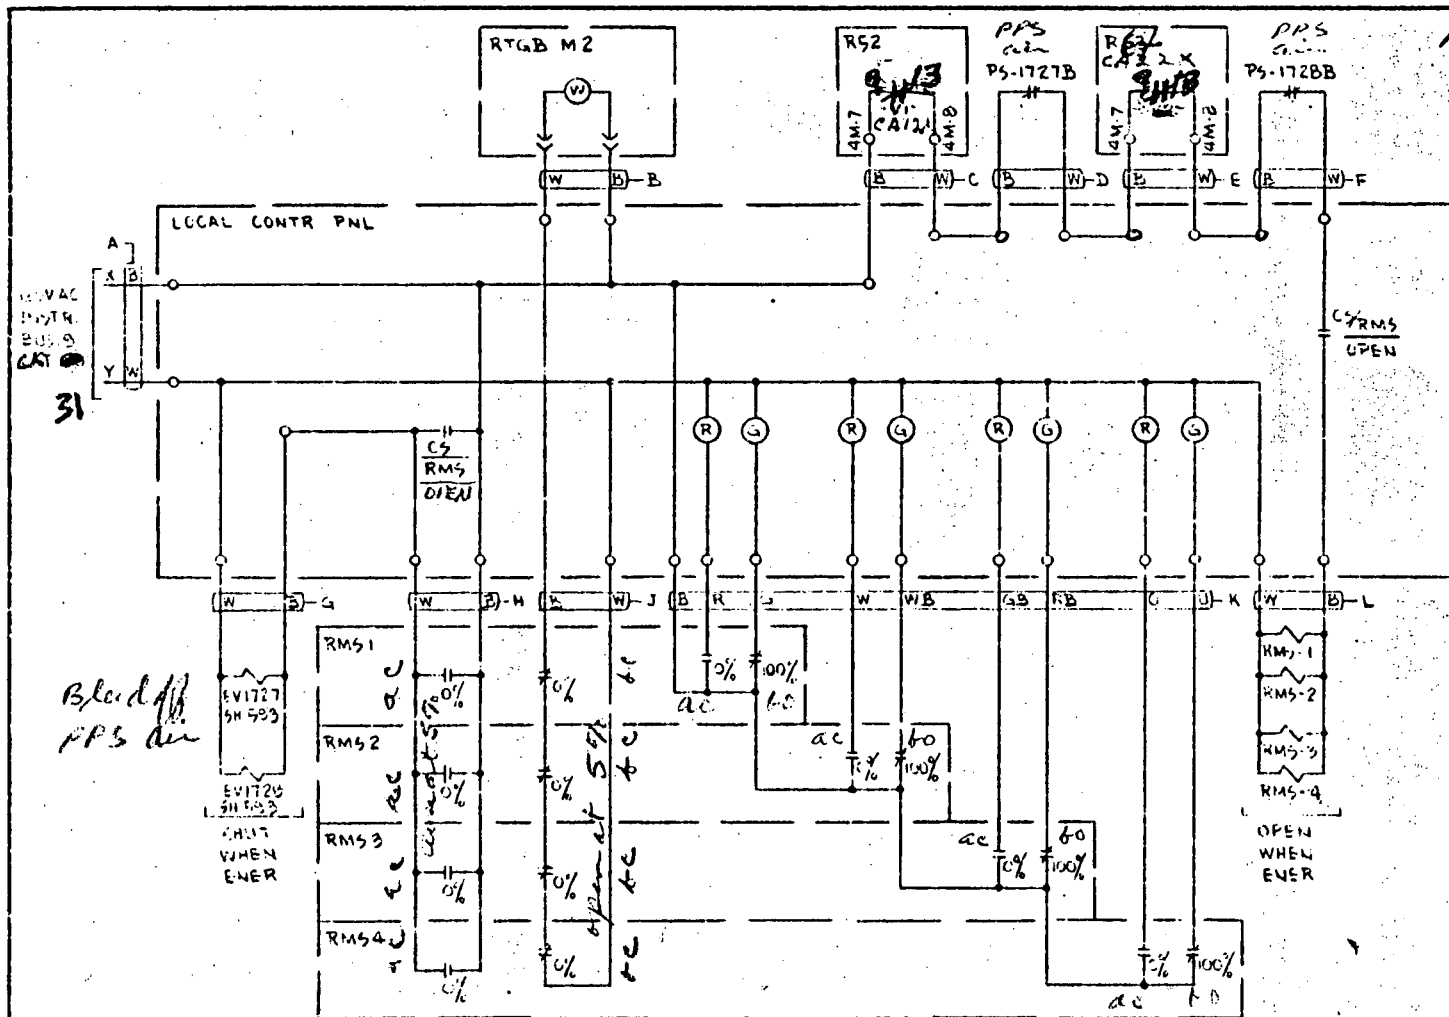

Med #35

Bleed off  
FPS Air

C. P. L.

8				4				EBASCO SERVICES INCORPORATED	
7				3				NEW YORK	
6				2				DIV. ELEC. OR G9L	APPROVED
5				1				SCALE _____ CH.	
REV.	DATE	BY	APPROVED	REV.	DATE	BY	APPROVED	DATE MAY 7 1973	

CONTAINMENT AIR  
SAMPLING VA'S  
RM 2,3,4

	SUB	SO.	Westinghouse Electric Corporation TITLE: CAROLINA POWER & LIGHT COMPANY H. B. ROBINSON STEAM ELECTRIC PLANT CONTROL WIRING DIAGRAM	5008452 SH-99	(W)
1			ATOMIC POWER DIV., PITTSBURGH, PA., U.S.A.		

ANN. PNL (5379-3256)

RTGB  
M101

AL CS

AR START

BI

AI

BL CS

BR STOP

RACK 52

(5379-3232)

SI12X

SI12X

RACK 54

(5379-3232)

SI12X

SI12X

DEV 22, DET 6, SH 37

DEV 22, DET 6, SH 37

AUX. PNL  
ECANN. PNL  
(5379-3256)AM SW  
PS 57 C6 C5 A5

MOTOR

REV	DATE	BY	APPROVED	REV	DATE	BY	APPROVED
1	6-2-71	WJH		1	6-2-71	WJH	
2	7-29-71	VZ		2	7-29-71	VZ	


REV	DATE	BY	APPROVED
1	6-2-71	WJH	
2	7-29-71	VZ	

REV	DATE	BY	APPROVED
1	6-2-71	WJH	
2	7-29-71	VZ	


REV	DATE	BY	APPROVED
1	6-2-71	WJH	
2	7-29-71	VZ	

REV	DATE	BY	APPROVED
1	6-2-71	WJH	
2	7-29-71	VZ	

EBASCO DWG B-190628  
FEDWATER PUMP A  
500B452  
SHEET 615  
ATOMIC POWER DIV., PITTSBURGH, PA., U.S.A.

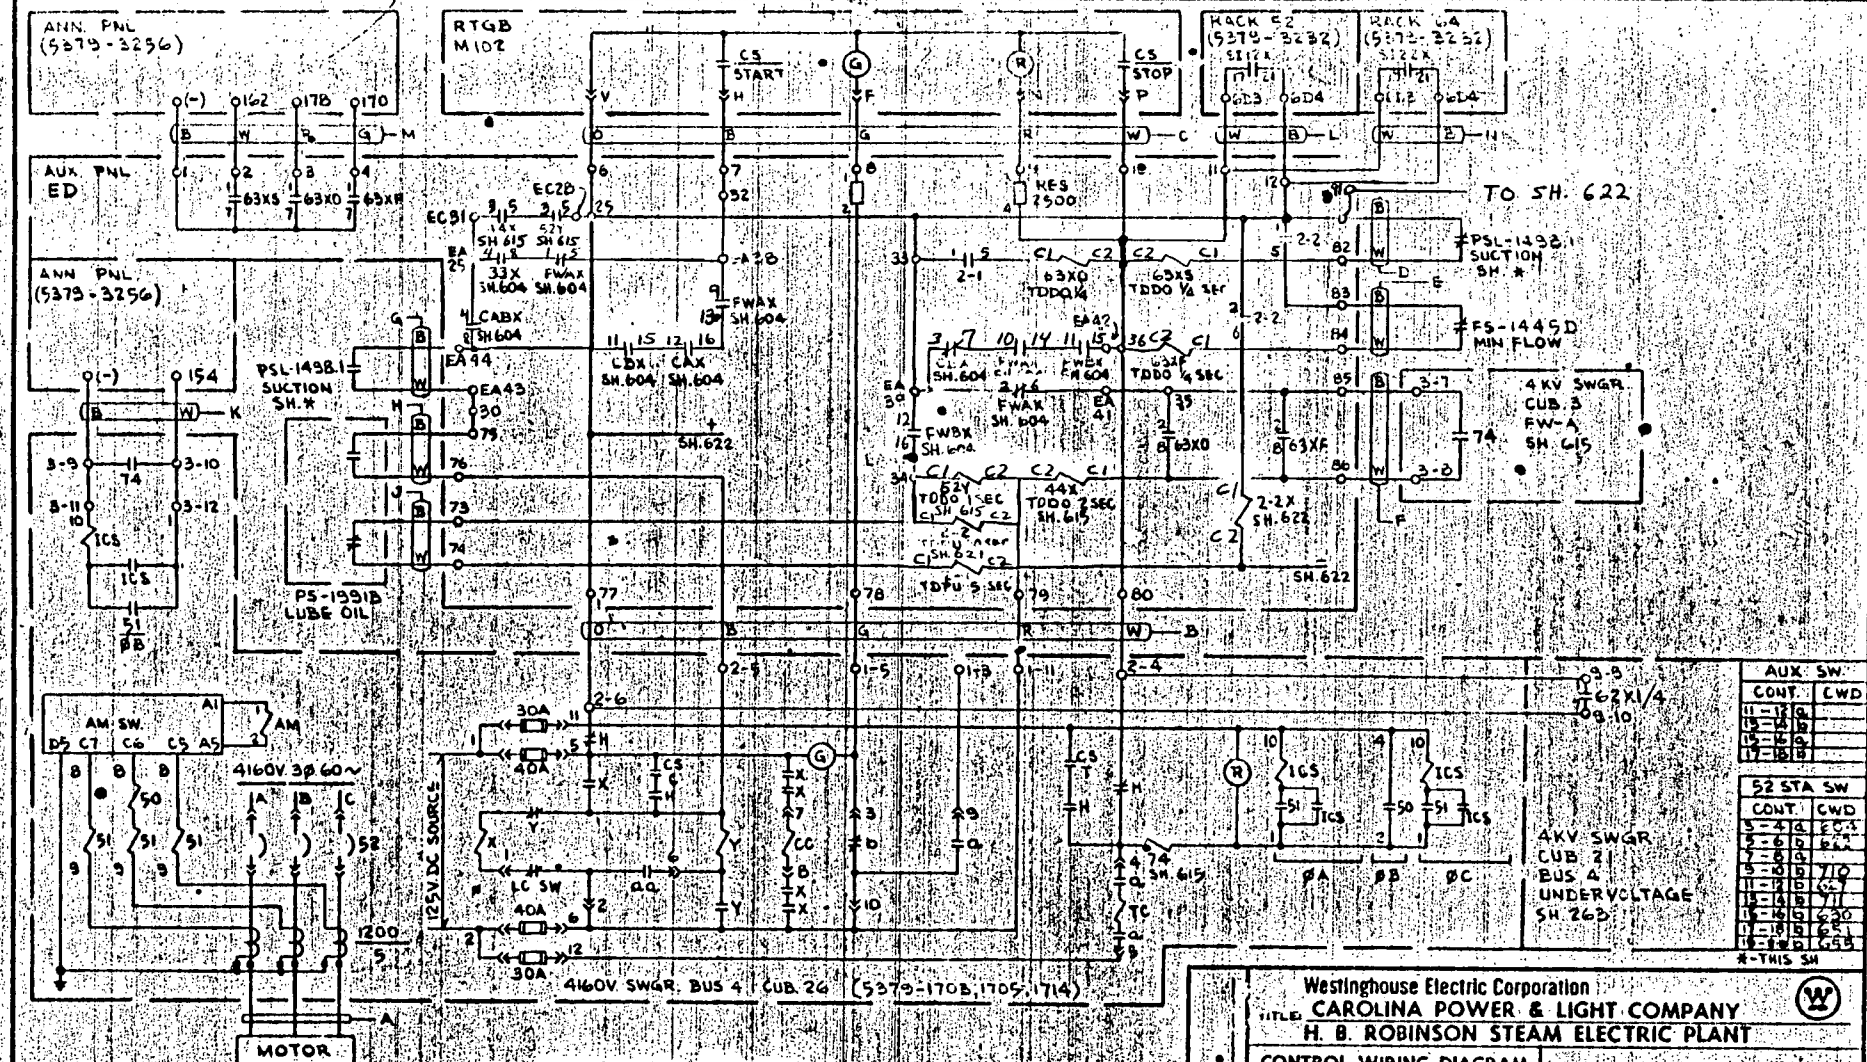

ANN PNL (5375-3256) AUX PNL ED ANN PNL (5375-3256) PSL-1438 SUCTION SH. 6 PS-1551D LUBE OIL AM SW. 4160V SWGR, BUS 4 CUB. 26 (5375-170B, 1705, 1714) MOTOR				RTGB M102 EC2D EC21 EC22 EC23 EC100				RACK E2 (5375-3232) RACK G4 (5375-3232) PSL-1438 SUCTION SH. 6 PS-1551D LUBE OIL AM SW. 4160V SWGR, BUS 4 CUB. 26 (5375-170B, 1705, 1714) MOTOR			
EBASCO DWG B-190628 EBASCO SERVICES INCORPORATED NEW YORK DATE APR 14, 1962 APPROVED BY K. BROOKMAN SCALE 1:1				FEEDWATER PUMP B CONTROL WIRING DIAGRAM 500B452 SHEET 620 ATOMIC POWER DIV. PITTSBURGH, PA. U.S.A.							

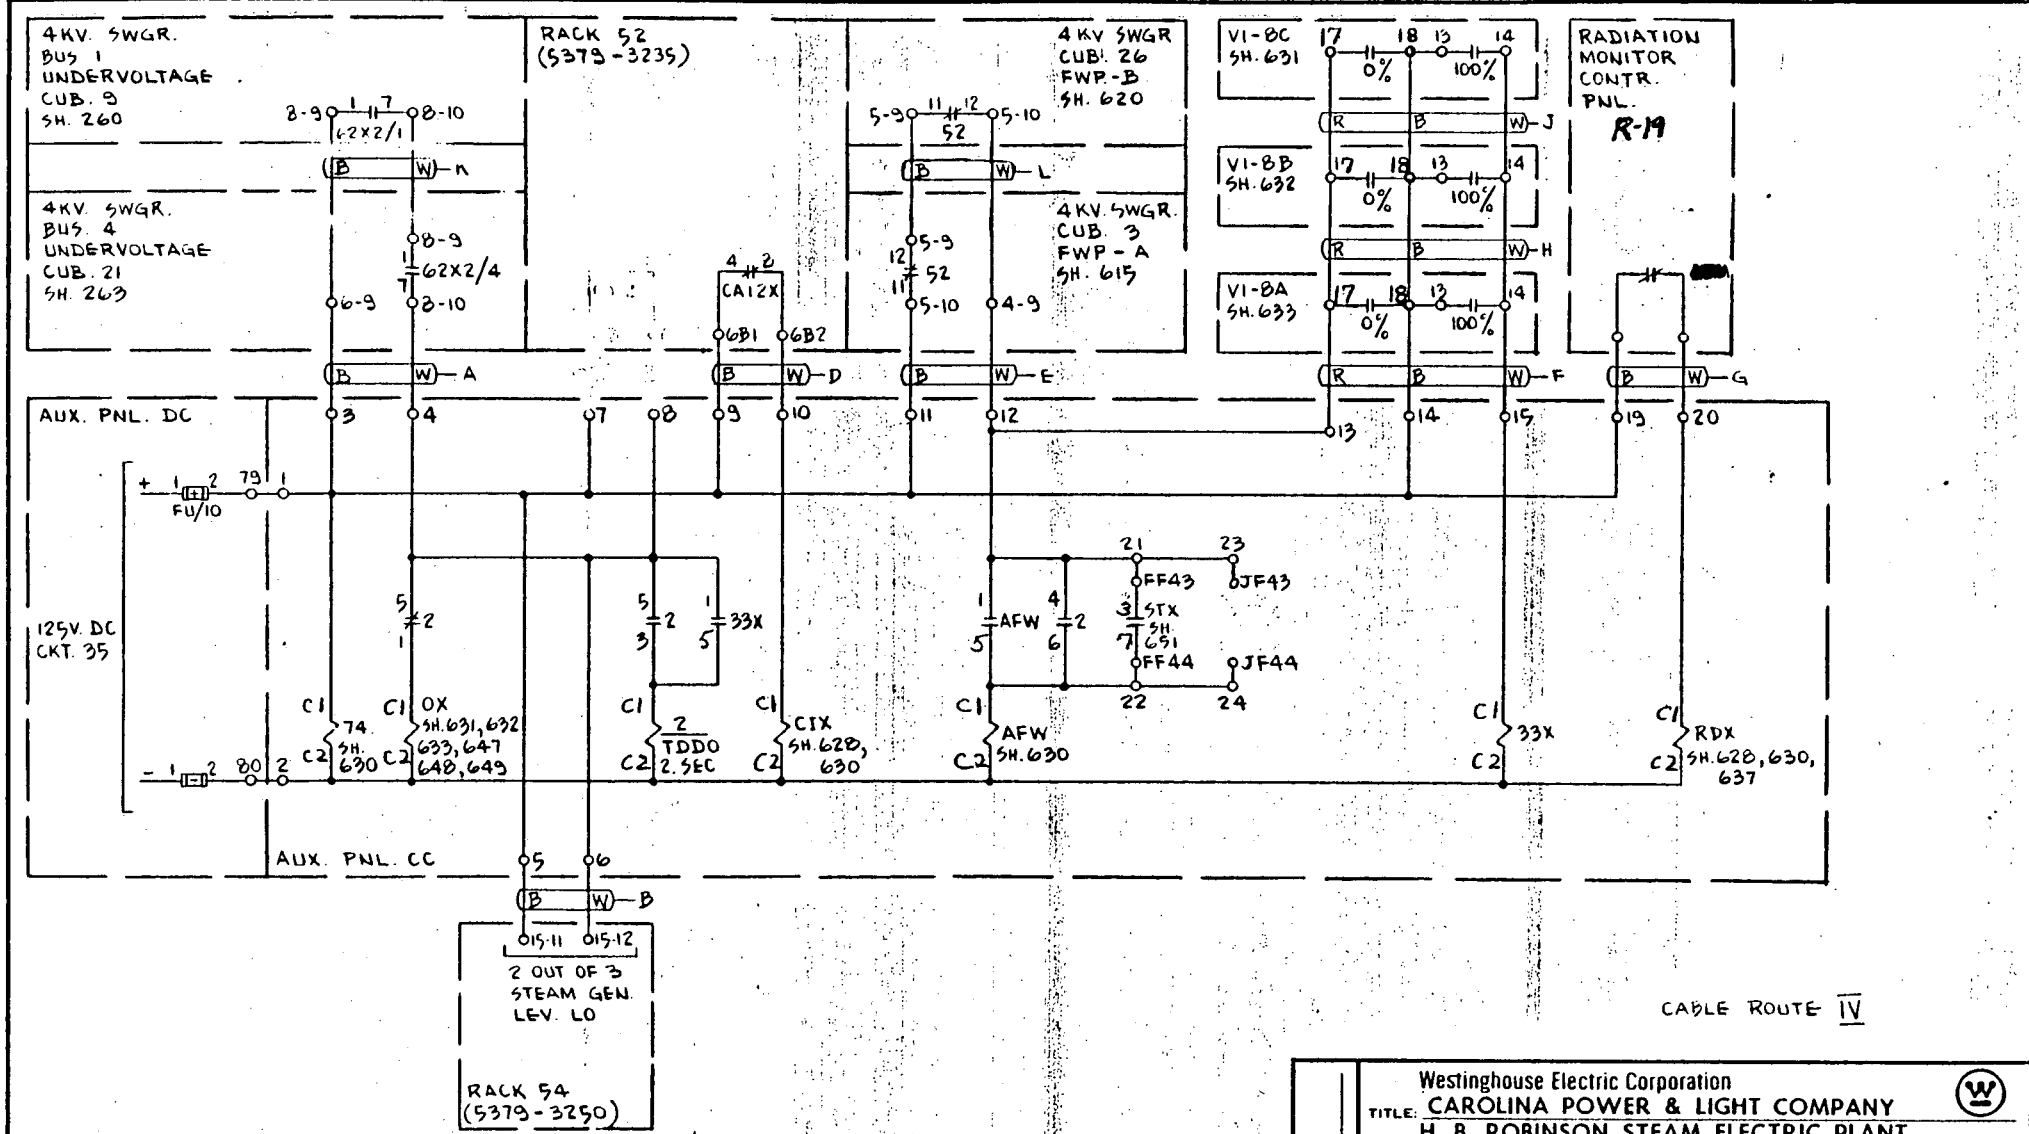



REV	DATE	BY	APPROVED	REV	DATE	BY	APPROVED
6				4			
7				3	6-26-70	TW	CH
8				2	10-5-70	FLD	FLD
5				1	8-24-70	FLD	FLD

EBASCO SERVICES INCORPORATED			
NEW YORK			
DIV. ELEC.	DR. GSC	APPROVED	
SCALE	CH. VB	K. Brockwell	
DATE	JAN 16 1970	VB	

STEAM DRIVEN FWP  
BACK-UP

SUB 1		Westinghouse Electric Corporation		
		TITLE: CAROLINA POWER & LIGHT COMPANY H. B. ROBINSON STEAM ELECTRIC PLANT		
		CONTROL WIRING DIAGRAM		
				500B452
				SHEET 627
		ATOMIC POWER DIV.		PITTSBURGH, PA., U.S.A.

AL CONTR STA

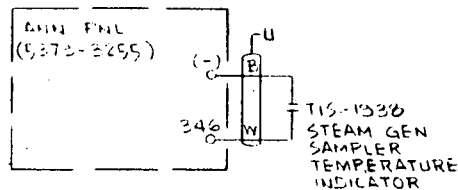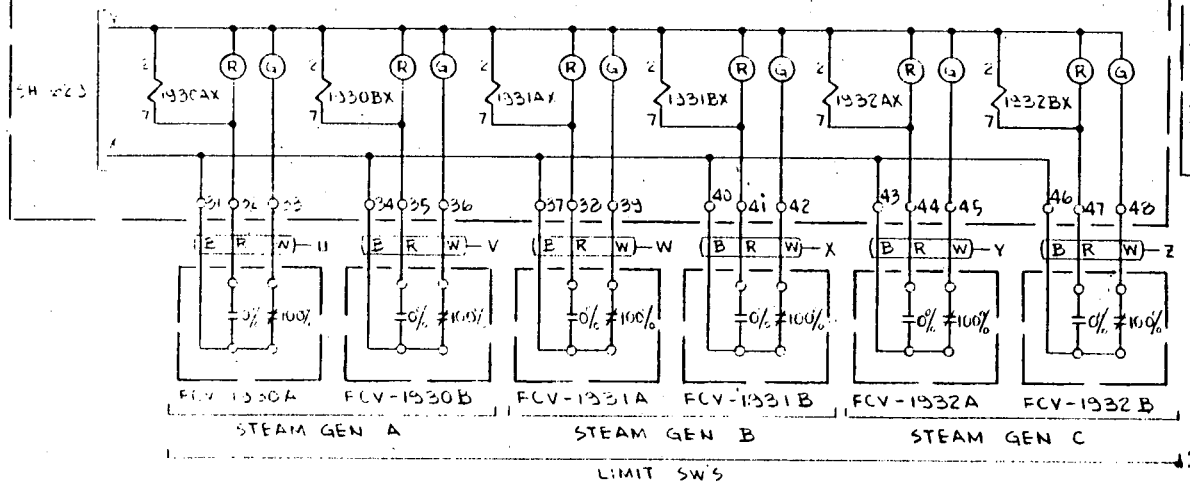


EBASCO DWG B-190628

REV	DATE	BY	APPROVED	REV	DATE	BY	APPROVED
8				4	10-70	FLD	39
7				3	2-24-70	FLD	35
6				2	1-6-70	FLD	18
5	7-2-69	TW		1	2-27-69	FLD	15
EBASCO SERVICES INCORPORATED NEW YORK				DIV. ELEC. DR. 432			
				SCALE: CH. Y.B.			
				DATE: JUL 11 1969			

STEAM GENERATOR  
BLOWDOWN SAMPLING  
VALVES

"SHUT - OPEN"  
SPRING RETURN  
TO SHUT

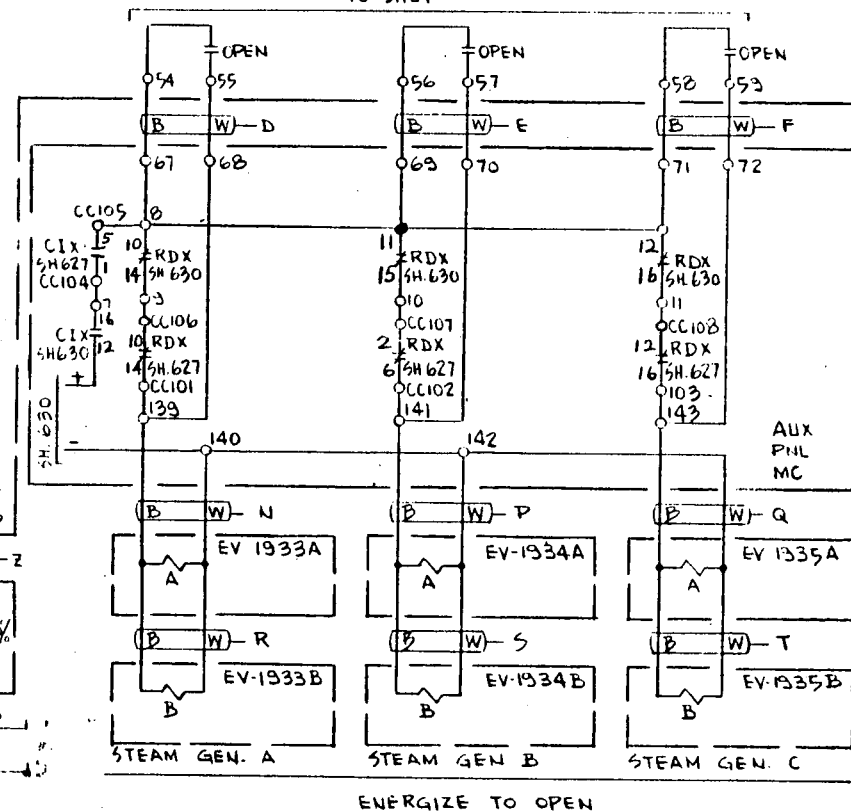

Westinghouse Electric Corporation

TITLE: CAROLINA POWER & LIGHT COMPANY  
H. B. ROBINSON STEAM ELECTRIC PLANT

CONTROL WIRING DIAGRAM

500B452


SHEET 628

ATOMIC POWER DIV.,

PITTSBURGH, PA., U.S.A.



125V. DC  
PNL. B  
CKT 23

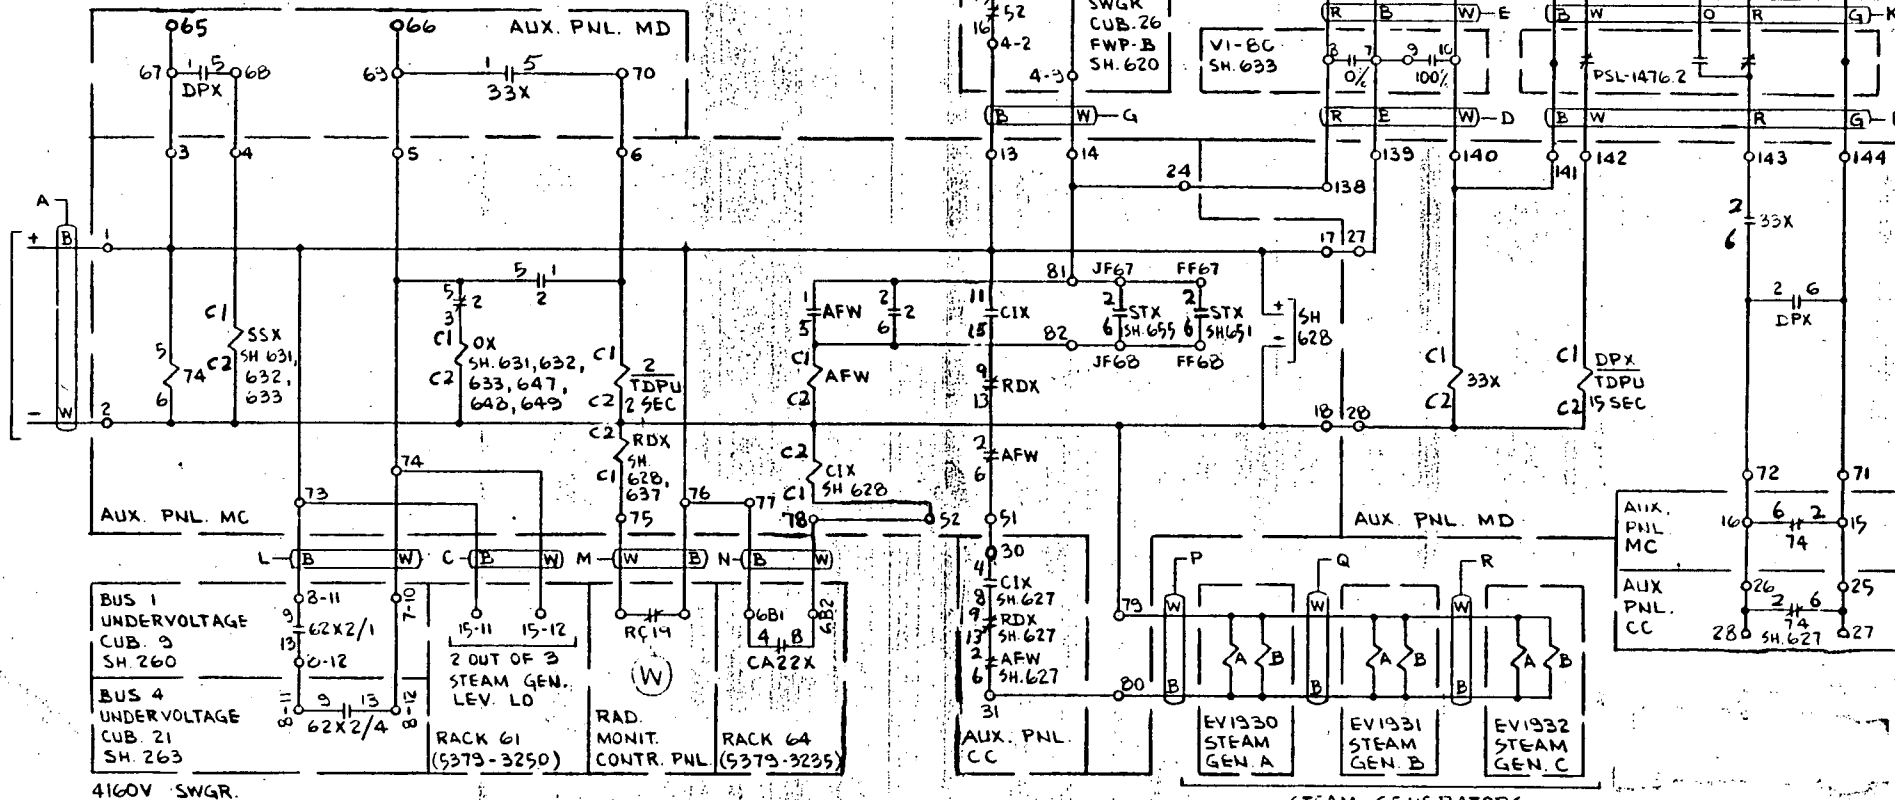

4160V SWGR.


STEAM GENERATORS  
CONTINUOUS BLOWDOWN VALVES  
OPEN WHEN ENERGIZED

EBASCO DWG B-190628


REV	DATE	BY	APPROVED	REV	DATE	BY	APPROVED
8				4	5-19-70	35C	FLD 64
7				3	2-23-70	35C	FLD 54
6	6-26-70	TW	OK	2	1-6-70	35C	WBS
5	8-26-70	45C	FLD T4	1	8-15-69	35C	WBS
EBASCO SERVICES INCORPORATED NEW YORK				DIV. ELEC. OR GSC SCALE — CH. YB DATE JUL. 11 1969			


STEAM DRIVEN  
FEEDWATER PUMP





Westinghouse Electric Corporation		
TITLE: CAROLINA POWER & LIGHT COMPANY H. B. ROBINSON STEAM ELECTRIC PLANT		
CONTROL WIRING DIAGRAM		500B452 SHEET 630
S.O.		
1	SUB	ATOMIC POWER DIV., PITTSBURGH, PA., U.S.A.

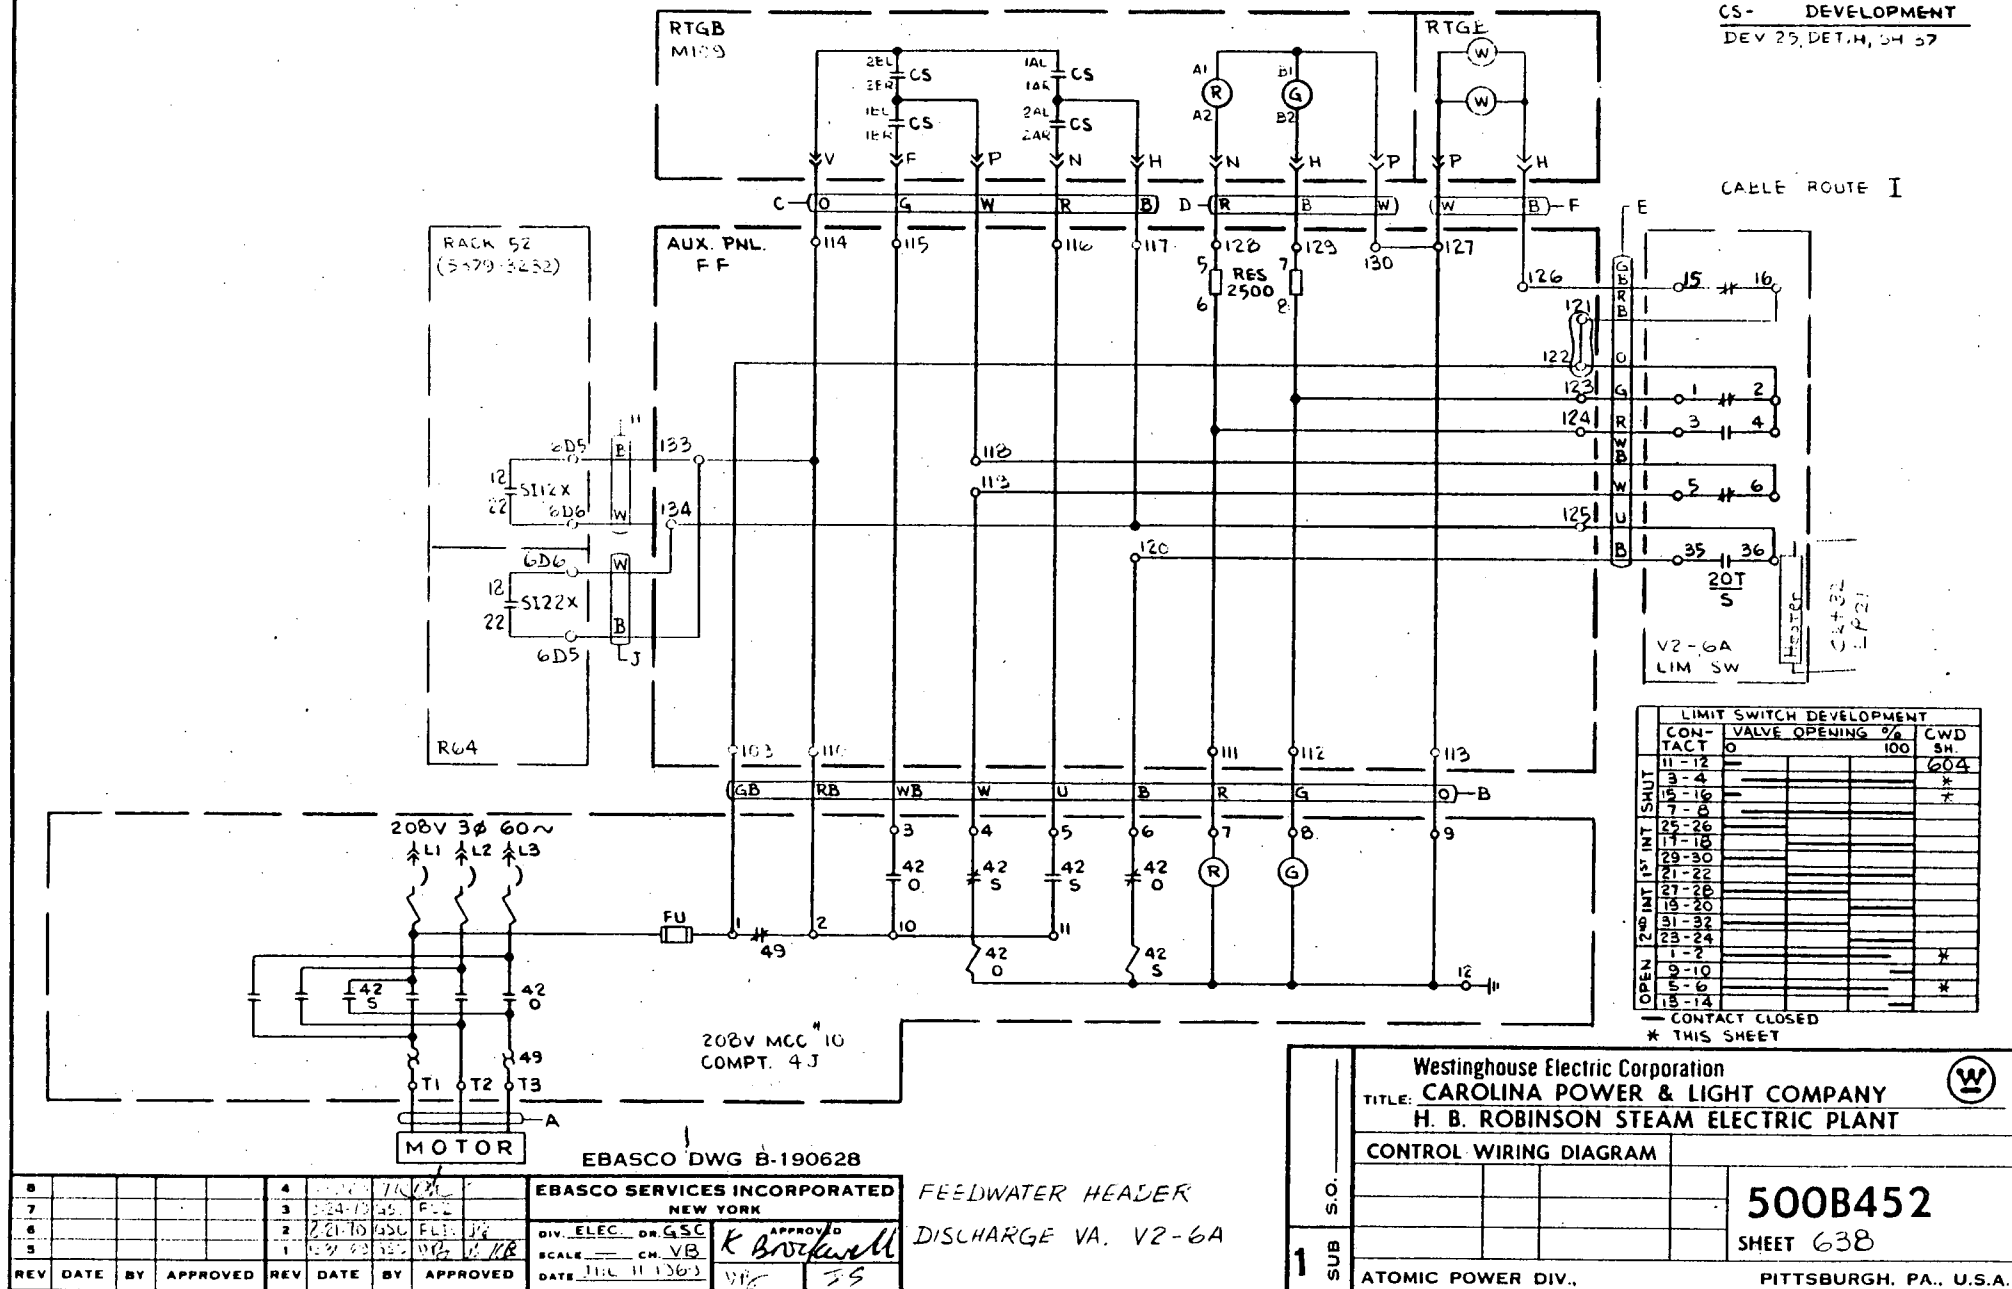




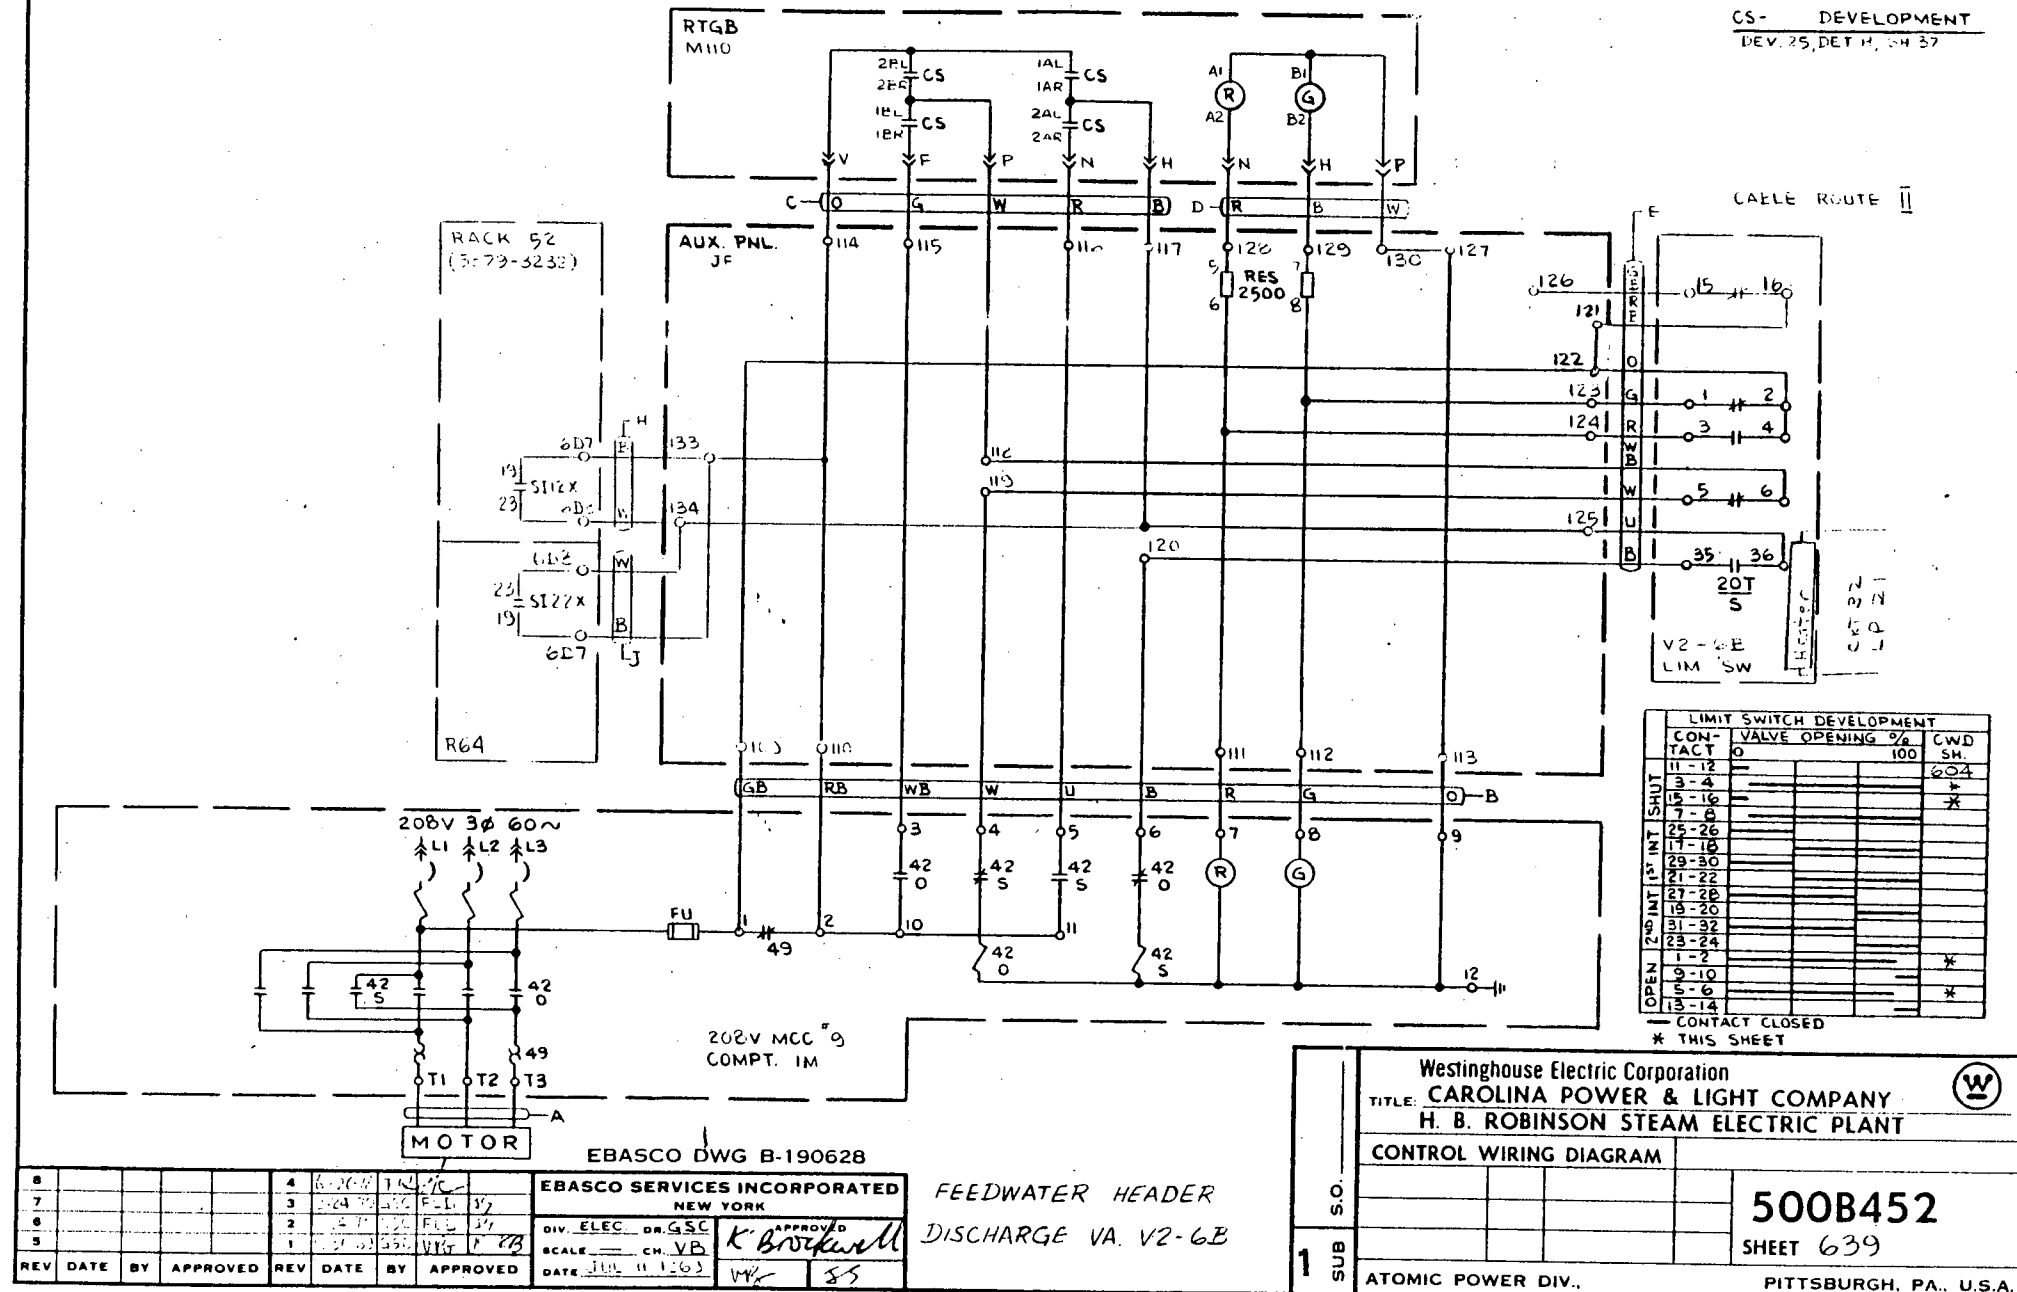


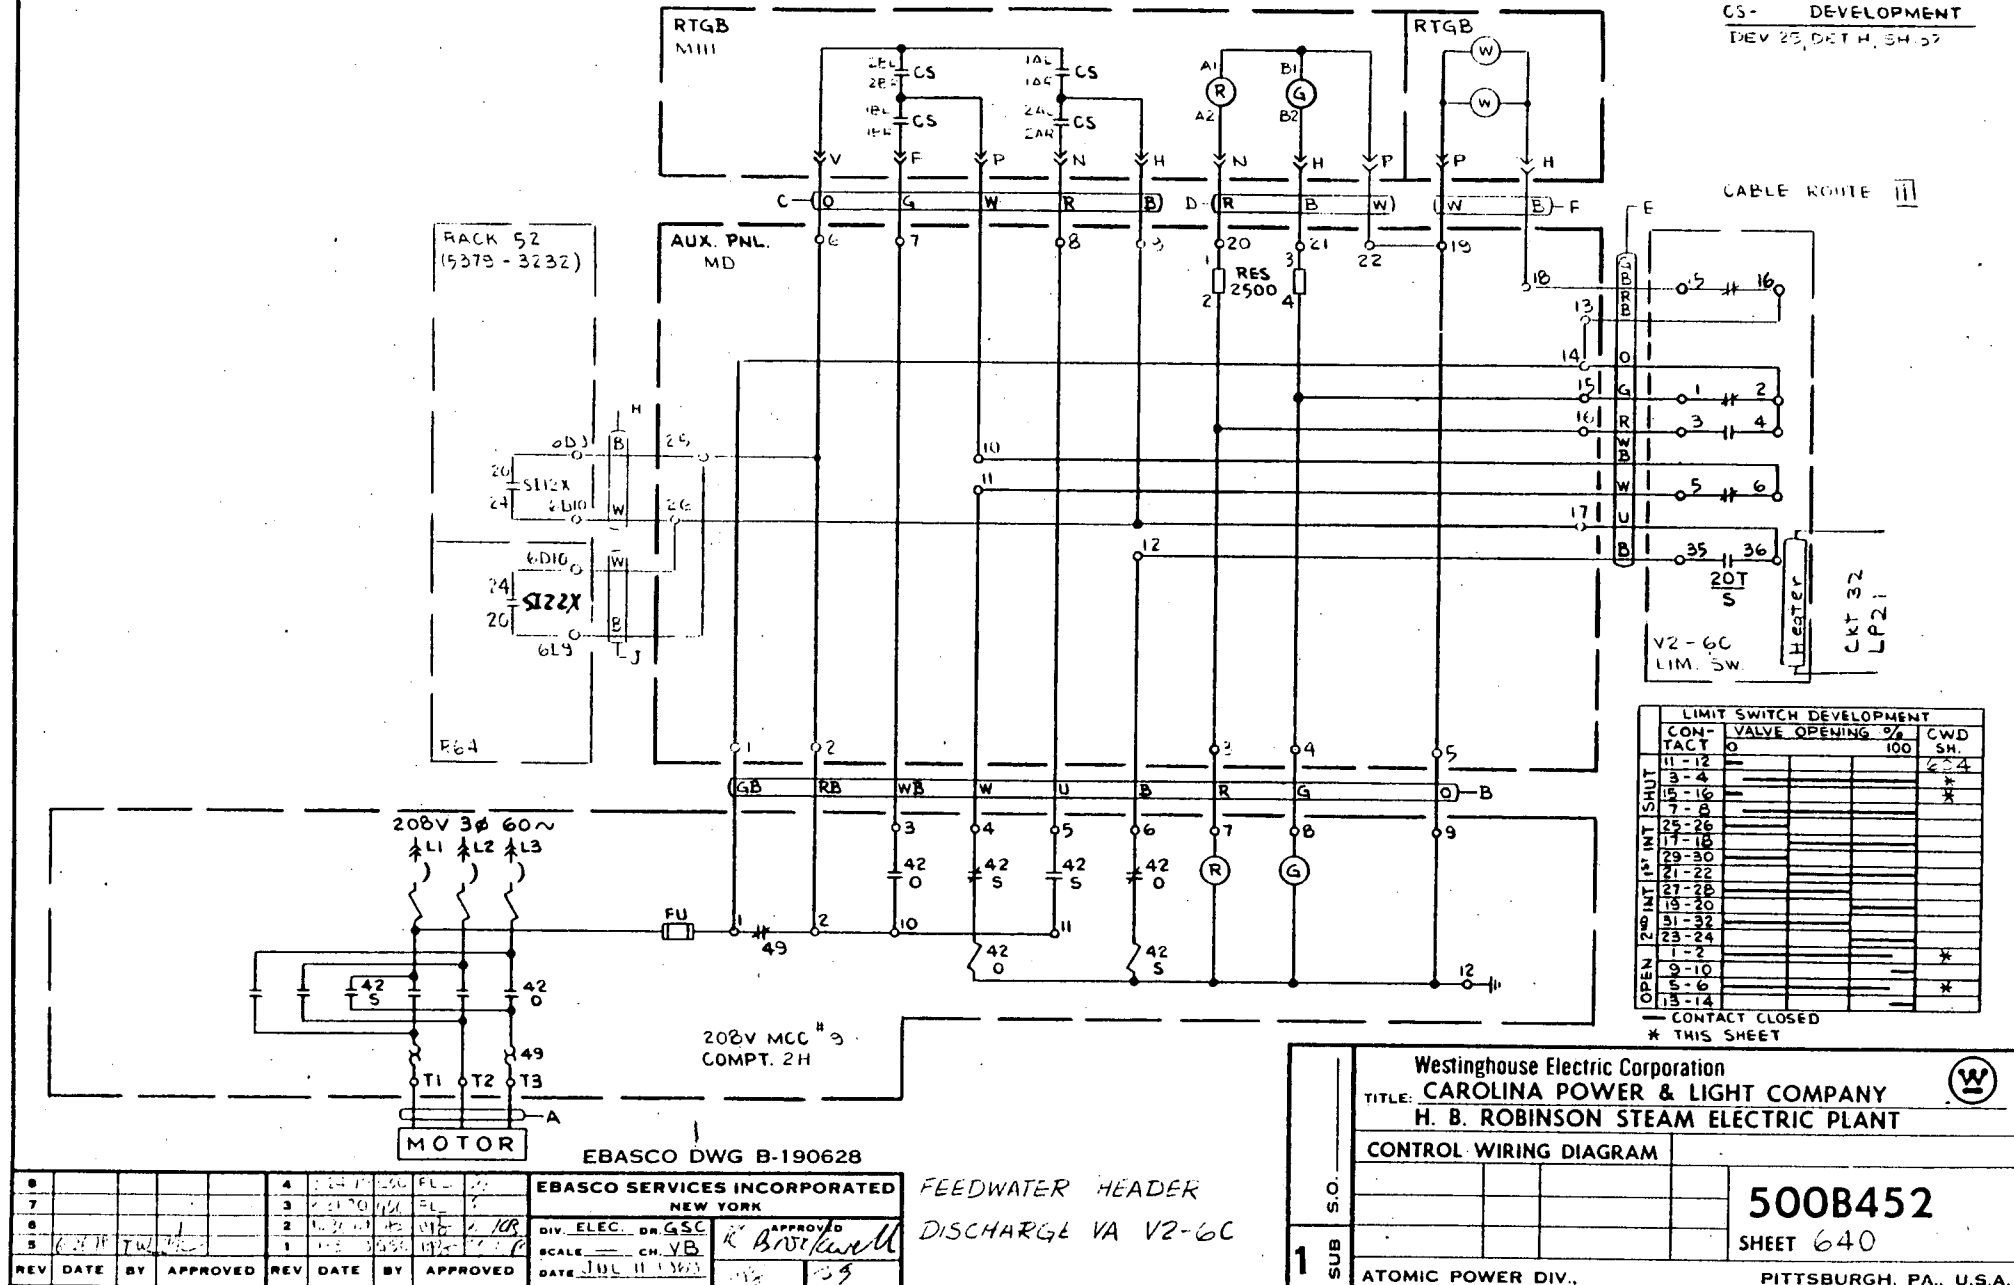

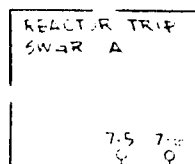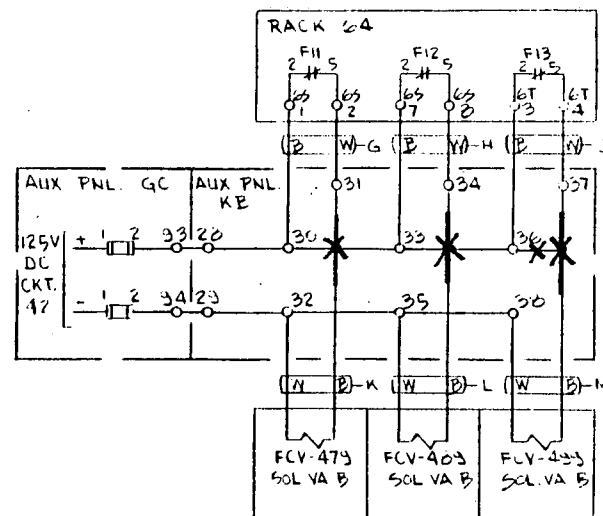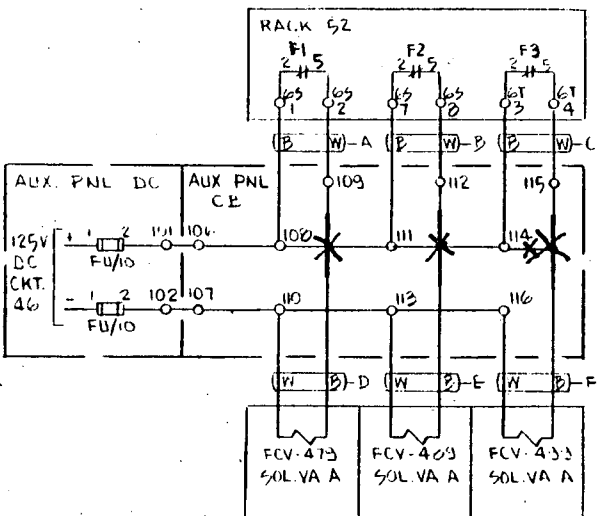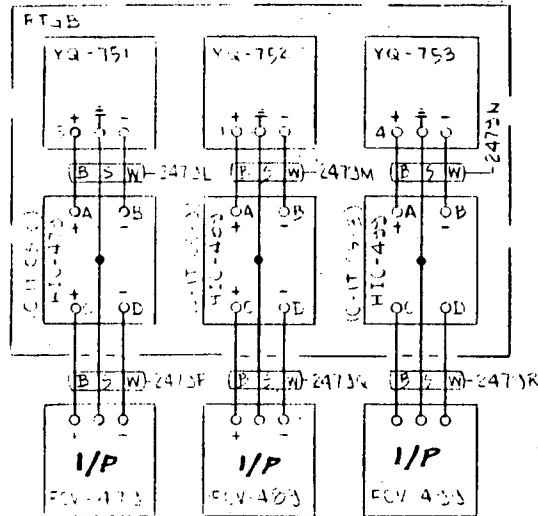


FEEDWATER BYPASS VALVES

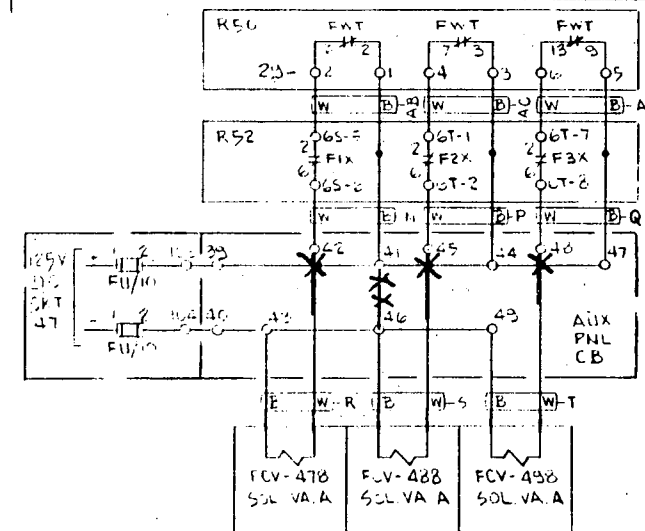

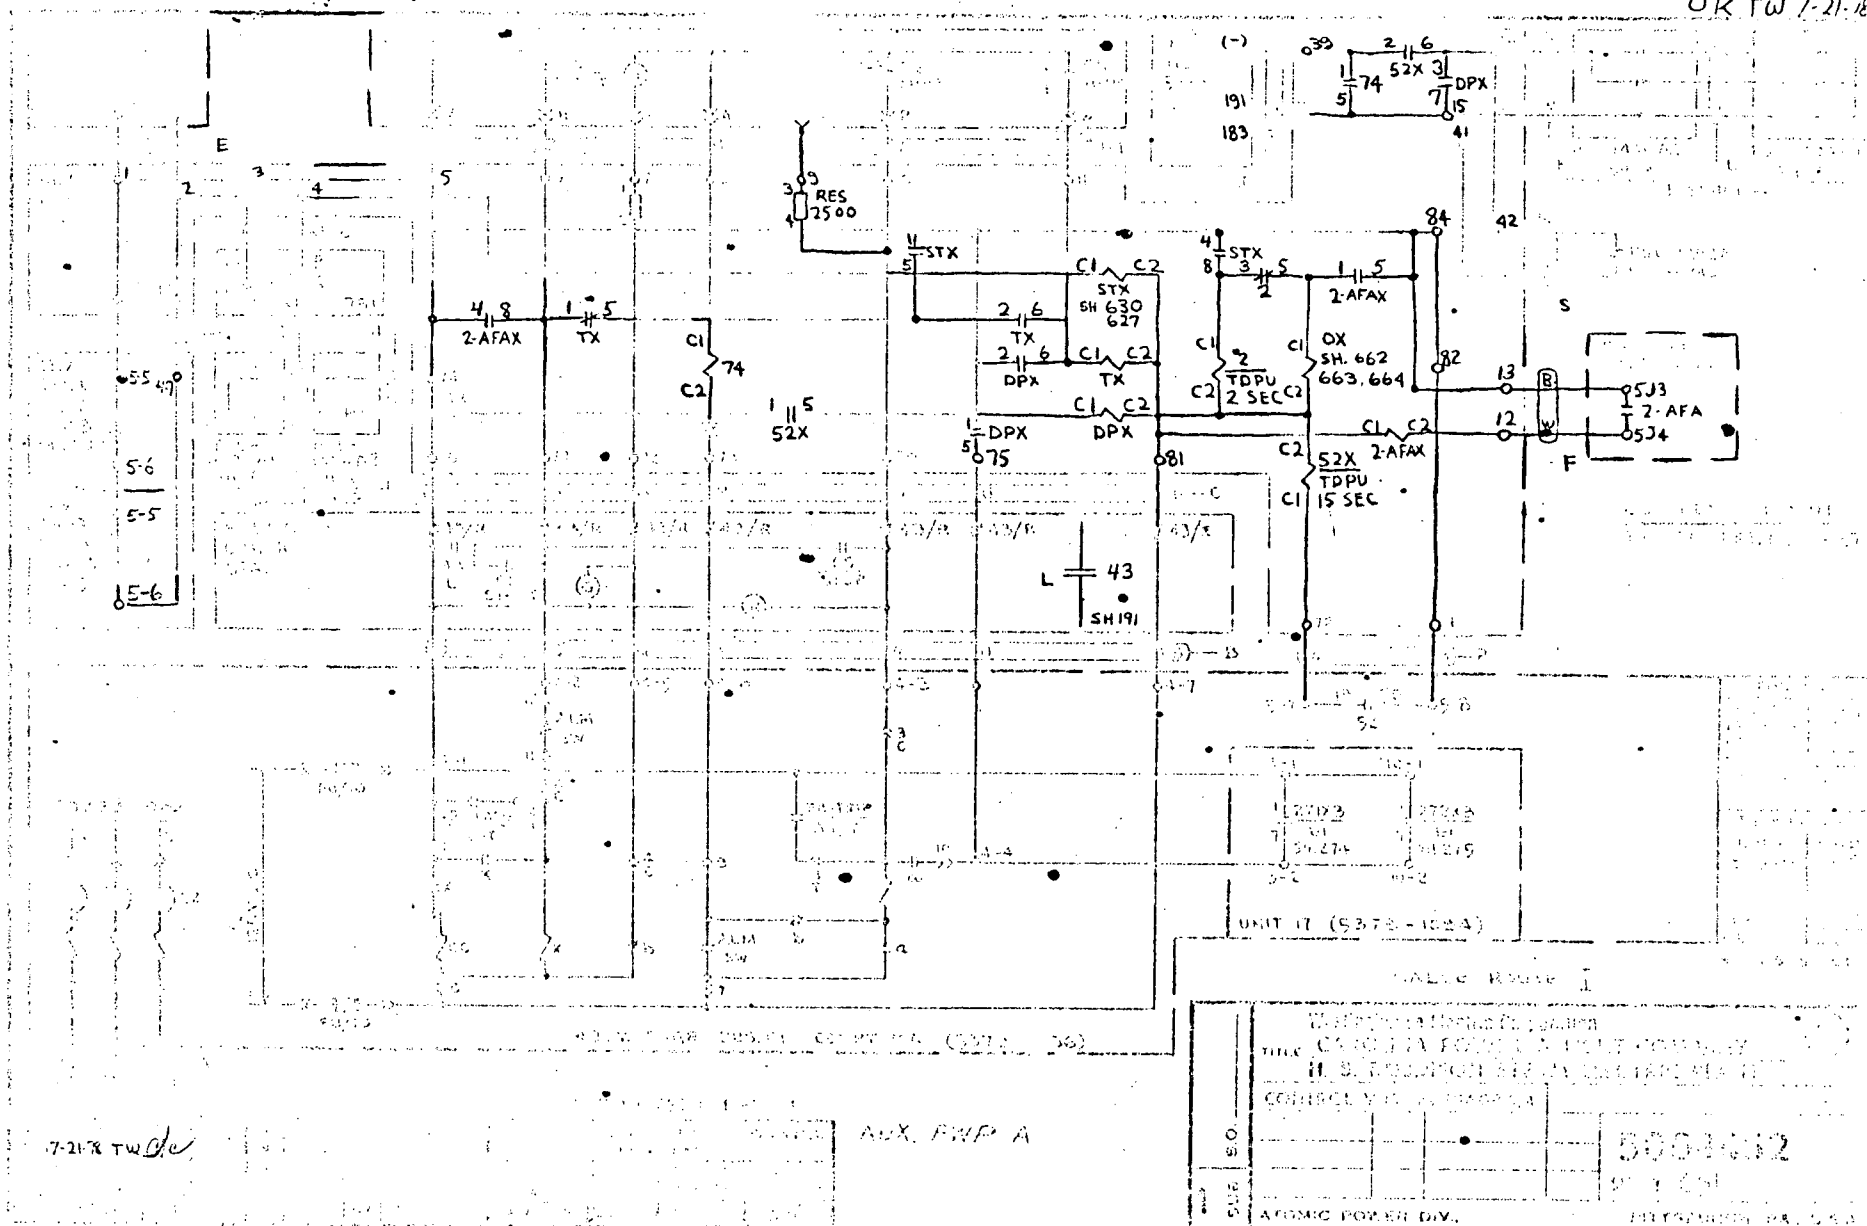

$$E_{\text{eff}} = \frac{1}{2} \left( \frac{1}{E_1} + \frac{1}{E_2} \right) \quad \text{for } E_1 \neq E_2 \quad \text{and} \quad E_{\text{eff}} = E_1 = E_2 \quad \text{for } E_1 = E_2$$

U. S. DEPARTMENT OF COMMERCE  
BUREAU OF ECONOMIC ANALYSIS  
WASHINGTON, D. C. 20540  
OFFICE OF THE ASSISTANT SECRETARY FOR  
COMMERCE AND ECONOMIC RESEARCH  
U. S. DEPARTMENT OF COMMERCE  
BUREAU OF ECONOMIC ANALYSIS  
WASHINGTON, D. C. 20540  
OFFICE OF THE ASSISTANT SECRETARY FOR  
COMMERCE AND ECONOMIC RESEARCH

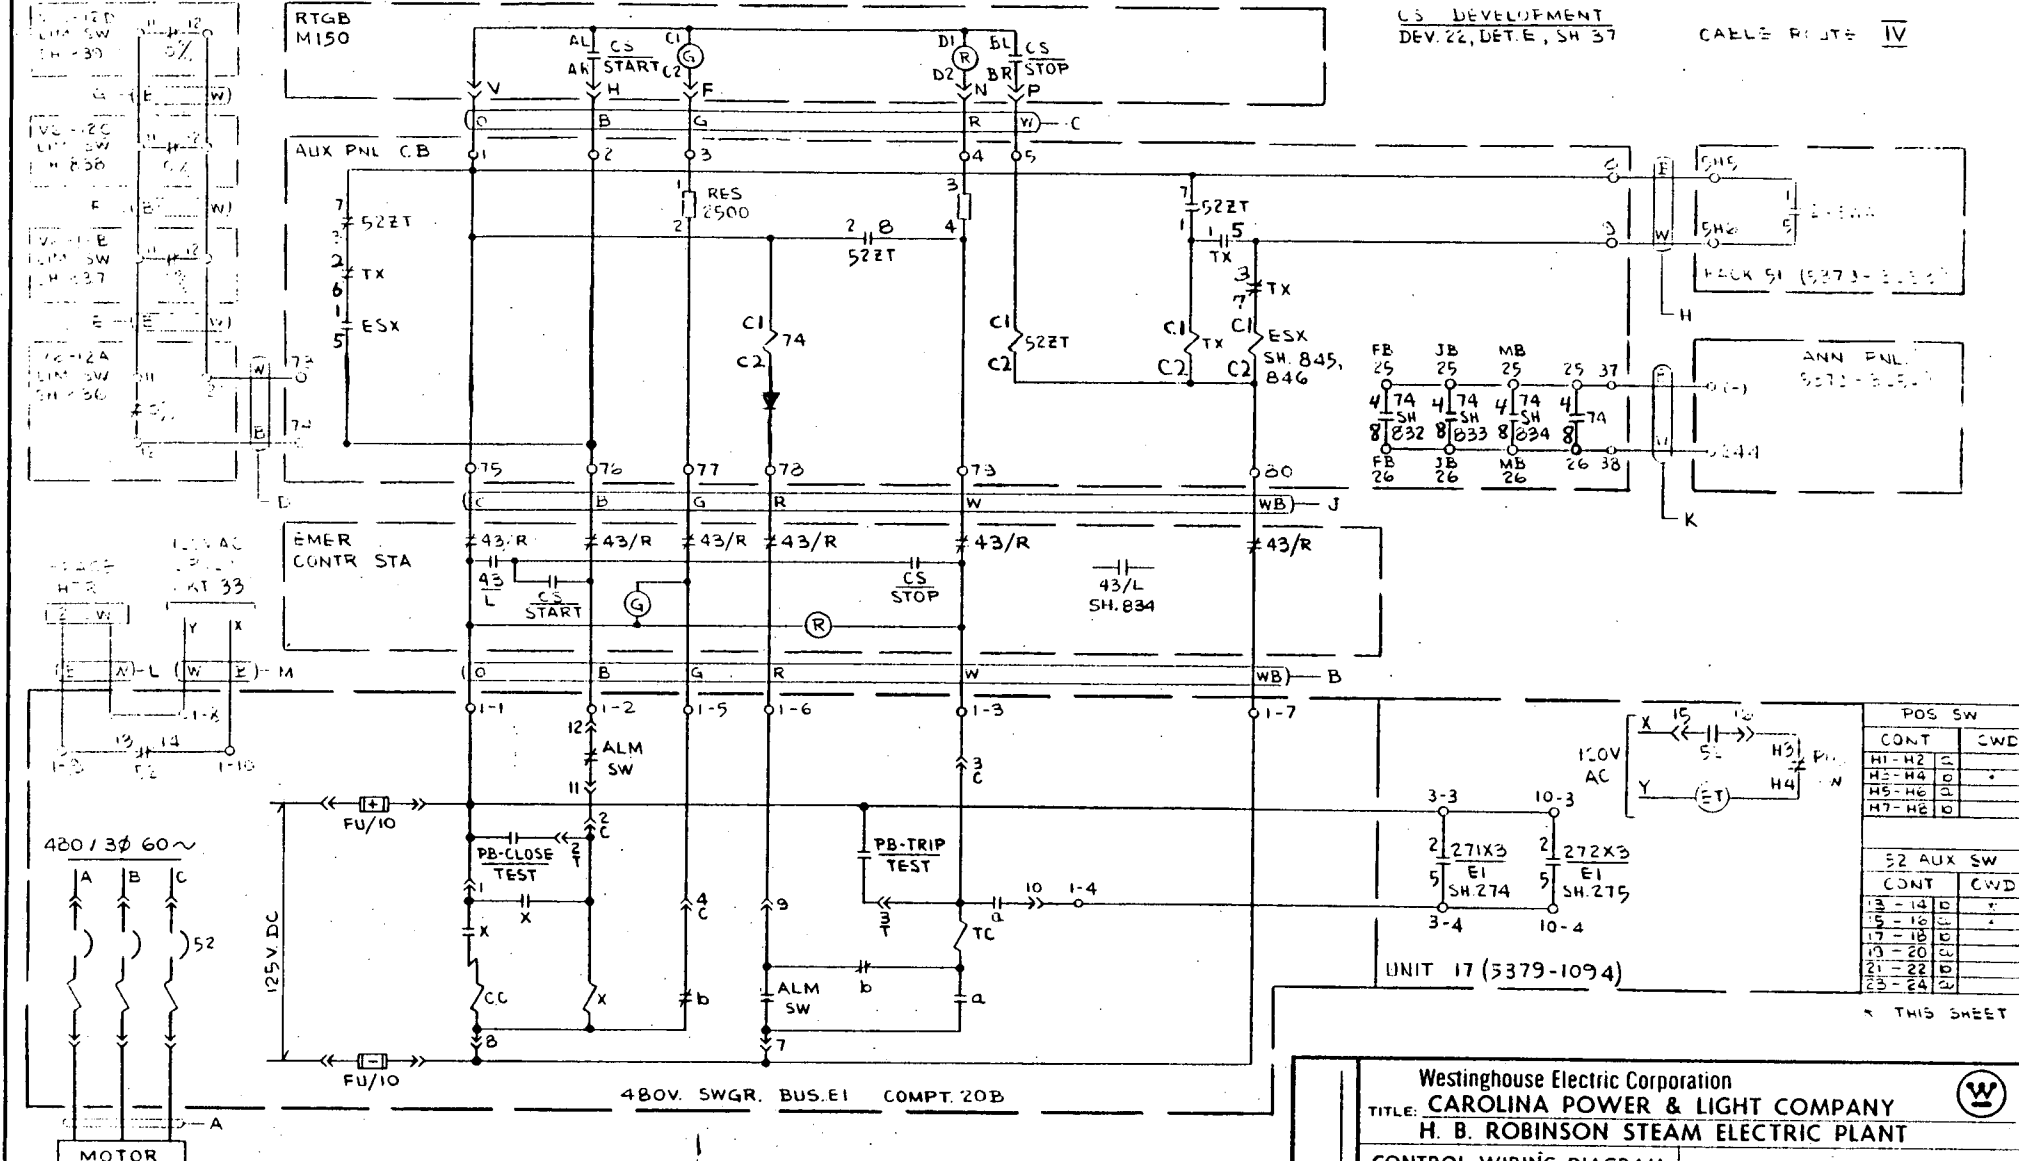

REV	DATE	BY	APPROVED	REV	DATE	BY	APPROVED
8				4	7-10-67	W.R.	
7				3	6-20-67	W.R.	
6				2	6-17-67	W.R.	
5				1	6-22-67	W.R.	

EBASCO SERVICES INCORPORATED  
NEW YORK

DIV. ELEC. DR. GSC  
SCALE CH. V.B.  
DATE 7-17-67

APPROVED  
K. Brockwell

Westinghouse Electric Corporation


TITLE: CAROLINA POWER & LIGHT COMPANY  
H. B. ROBINSON STEAM ELECTRIC PLANT


CONTROL WIRING DIAGRAM

500B452

SHEET 231

ATOMIC POWER DIV., PITTSBURGH, PA., U.S.A.

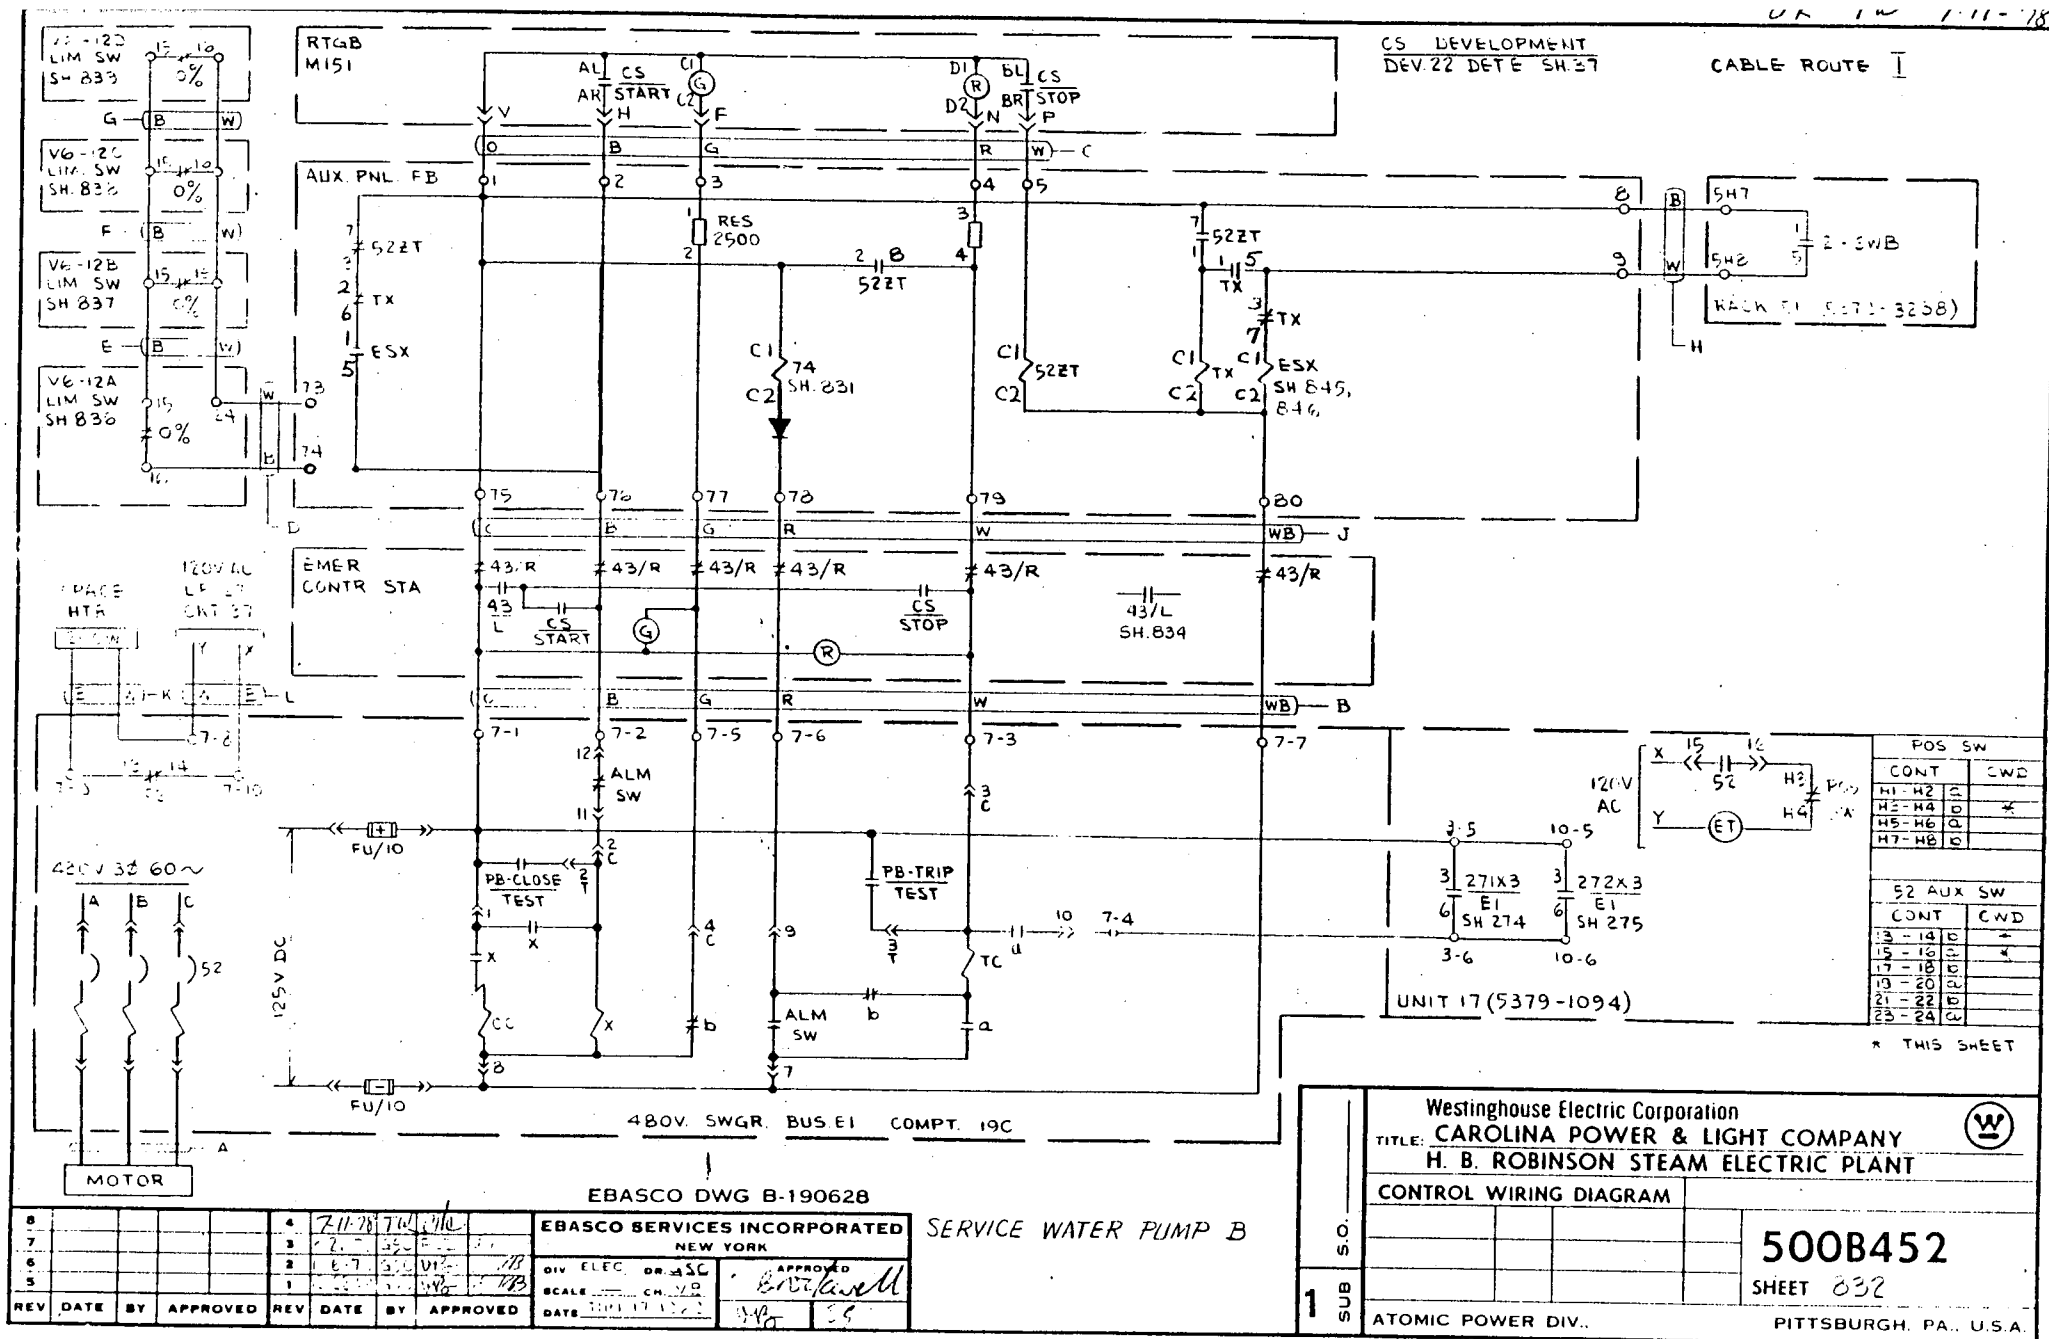

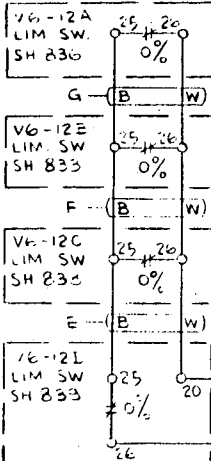

RTGB  
M152

CS DEVELOPMENT  
DEV.22 DET.E SH.37

CABLE ROUTE II



AUX. PNL. JB

52ZT  
TX  
ESX

EMER. CONTR. STA

120VAC  
LP 27  
CKT 3-3

STAGE  
HTR  
200W

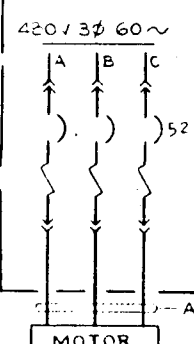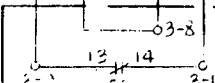

125V. DC

480V. SWGR. BUS. E2 COMPT. 24A

EBASCO DWG B-190628

SERVICE WATER PUMP C

REV	DATE	BY	APPROVED	REV	DATE	BY	APPROVED
8				4	7-11-78	TLC	
7				3	2-26-78	GSC	ELL 34
6				2	1-6-70	SSC	VB
5				1	12-2-63	GSC	VB

EBASCO SERVICES INCORPORATED  
NEW YORK  
DIV. ELEC. DR. GSC  
SCALE — CH. VB  
DATE JUN 17 1963

Westinghouse Electric Corporation  
TITLE: CAROLINA POWER & LIGHT COMPANY  
H. B. ROBINSON STEAM ELECTRIC PLANT

CONTROL WIRING DIAGRAM

500B452  
SHEET 833

ATOMIC POWER DIV.

PITTSBURGH, PA., U.S.A.

POS SW	
CONT	CWD
H1-H2	Q
H3-H4	D
H5-H6	Q
H7-H8	D


52 AUX SW	
CONT	CWD
13-14	D
15-16	Q
17-18	D
19-20	Q
21-22	D
23-24	Q

\* THIS SHEET



144



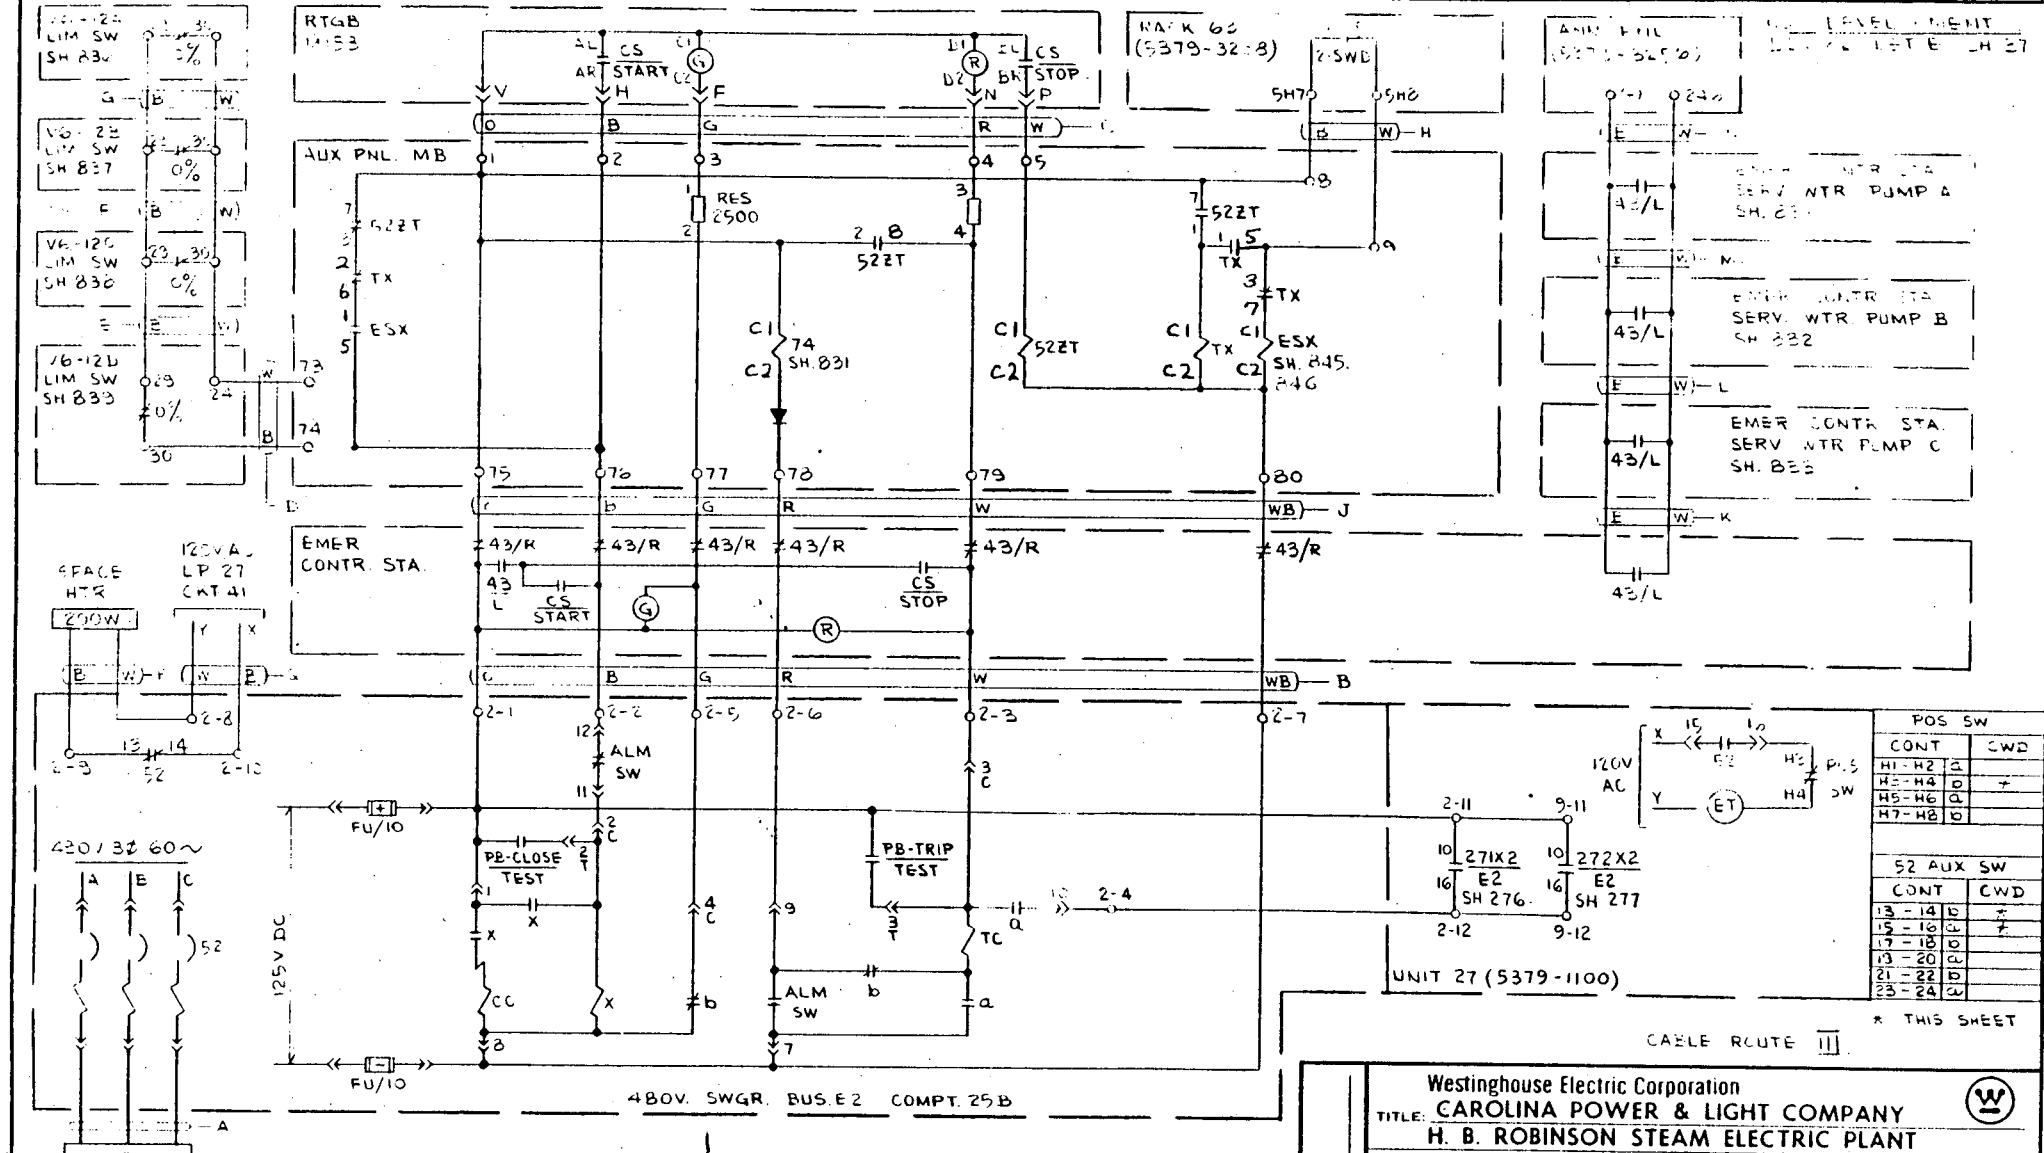

EBASCO DWG B-190628

SERVICE WATER PUMP D

Westinghouse Electric Corporation

TITLE: CAROLINA POWER & LIGHT COMPANY

H. B. ROBINSON STEAM ELECTRIC PLANT

CONTROL WIRING DIAGRAM

500B452

SHEET 334

ATOMIC POWER DIV., PITTSBURGH, PA., U.S.A.

REV	DATE	BY	APPROVED
1	7-11-78	TW	MC
2	7-11-78	MC	MC
3	7-11-78	MC	MC
4	7-11-78	MC	MC
5	7-11-78	MC	MC

EBASCO SERVICES INCORPORATED

NEW YORK


DIV. ELEC. OR. GSC

SCALE: CH. VB


DATE: JUN 17 1978


APPROVED

35

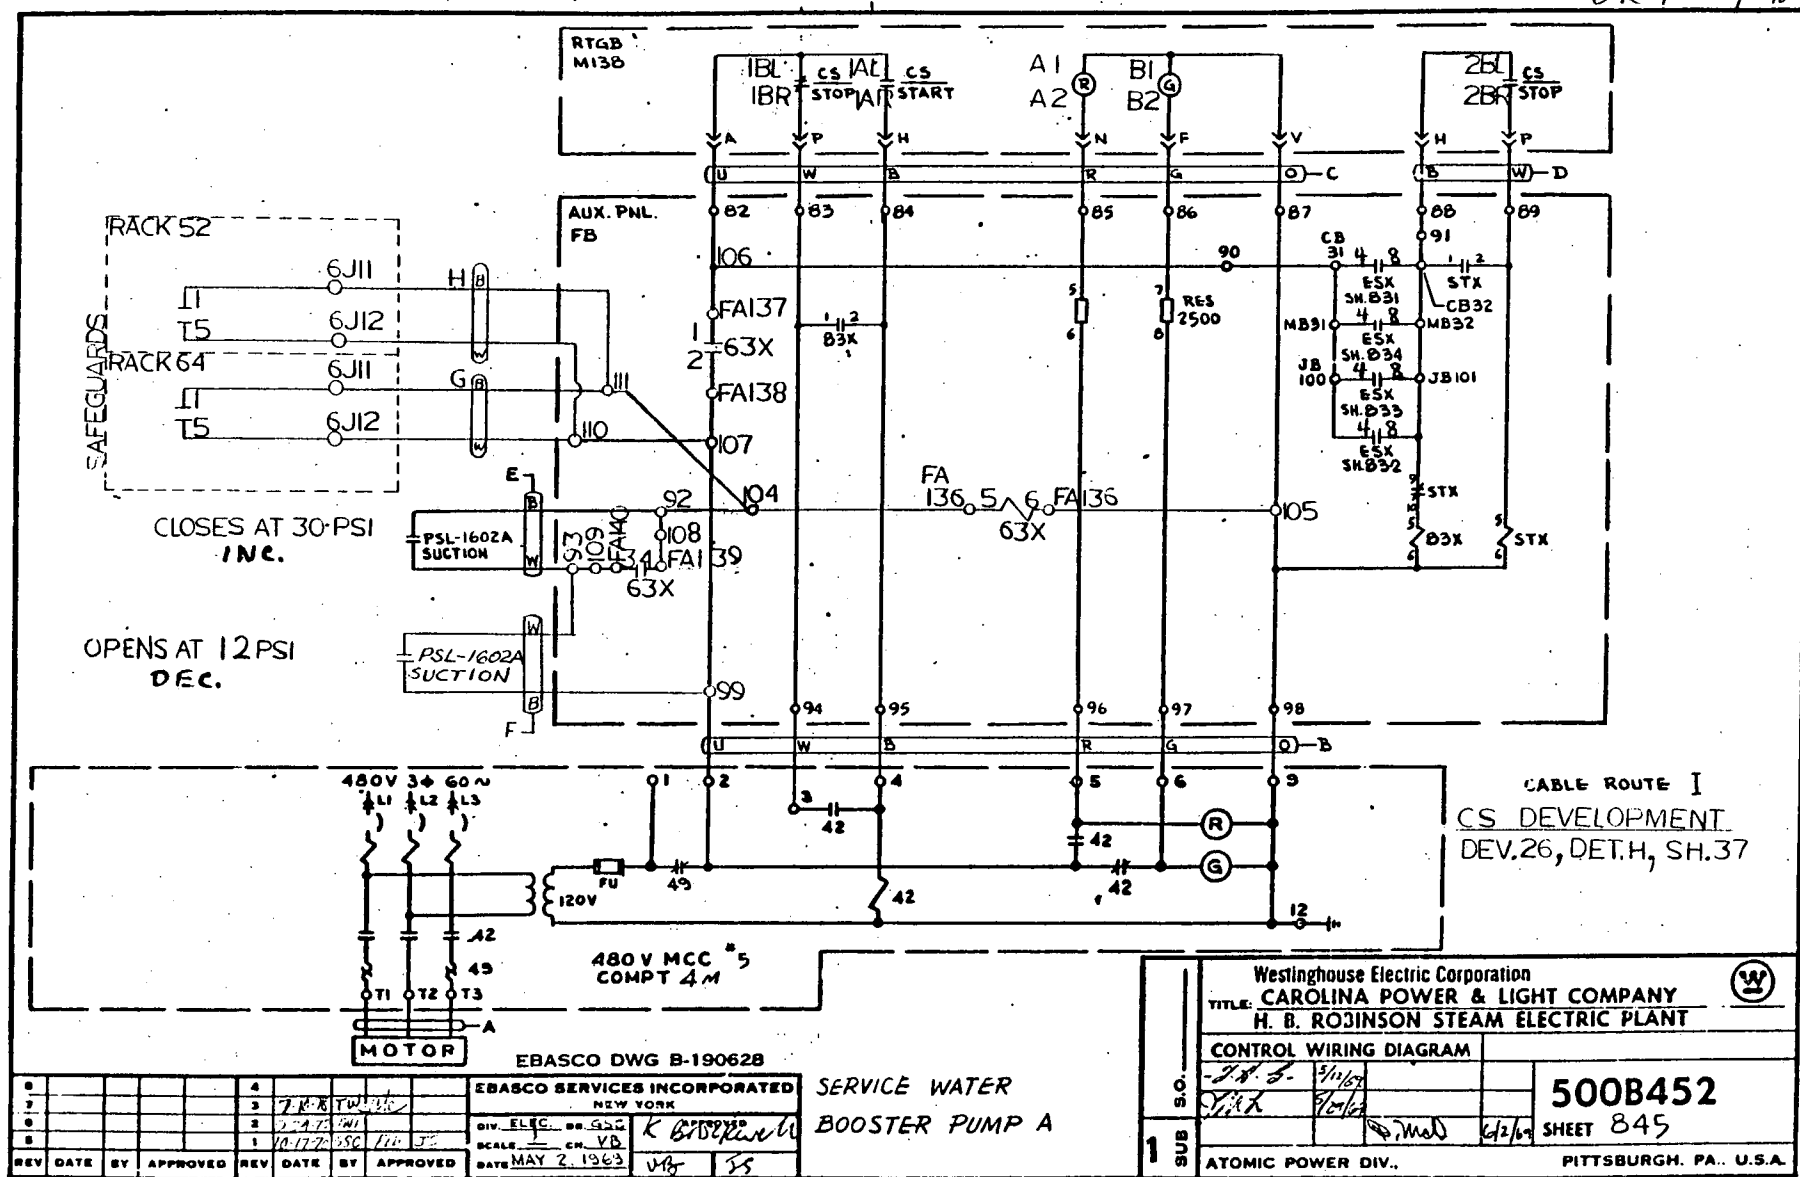


B A A O A A

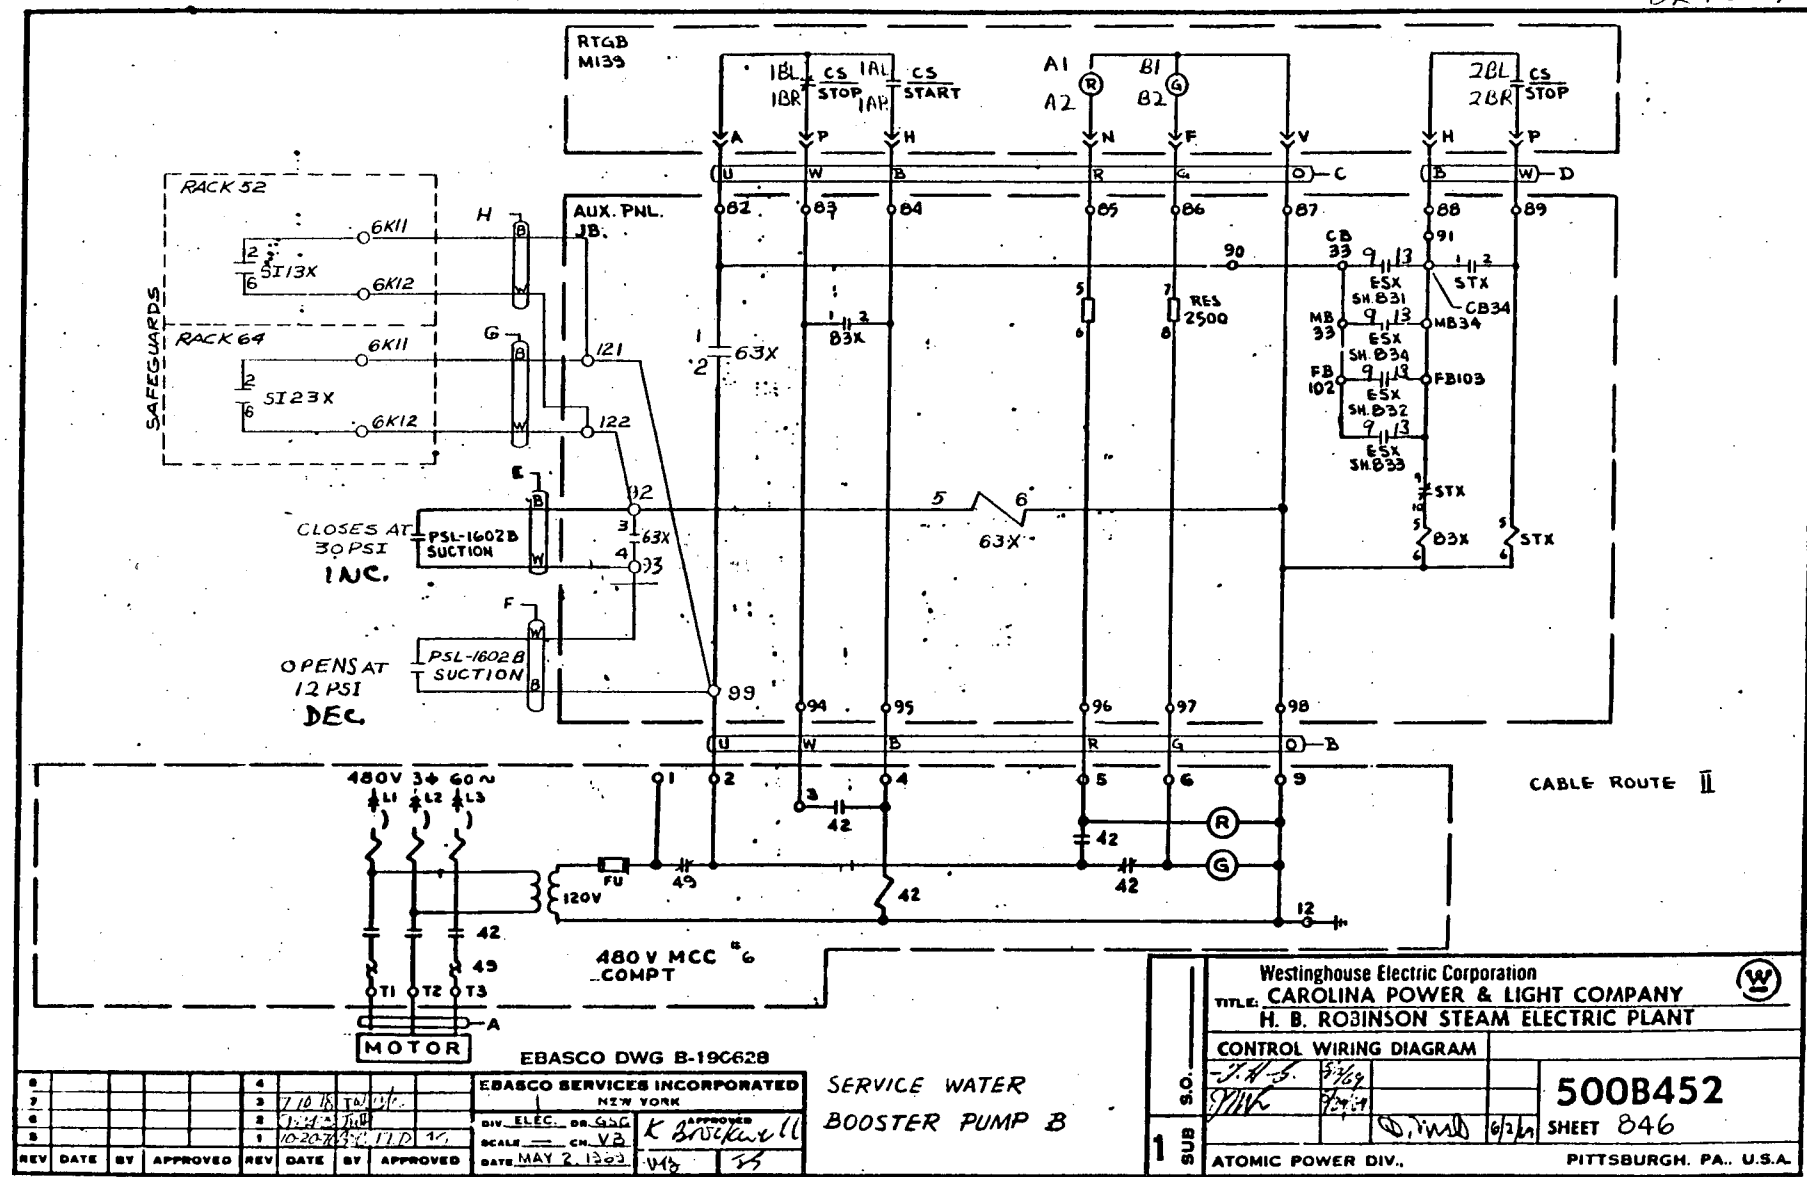

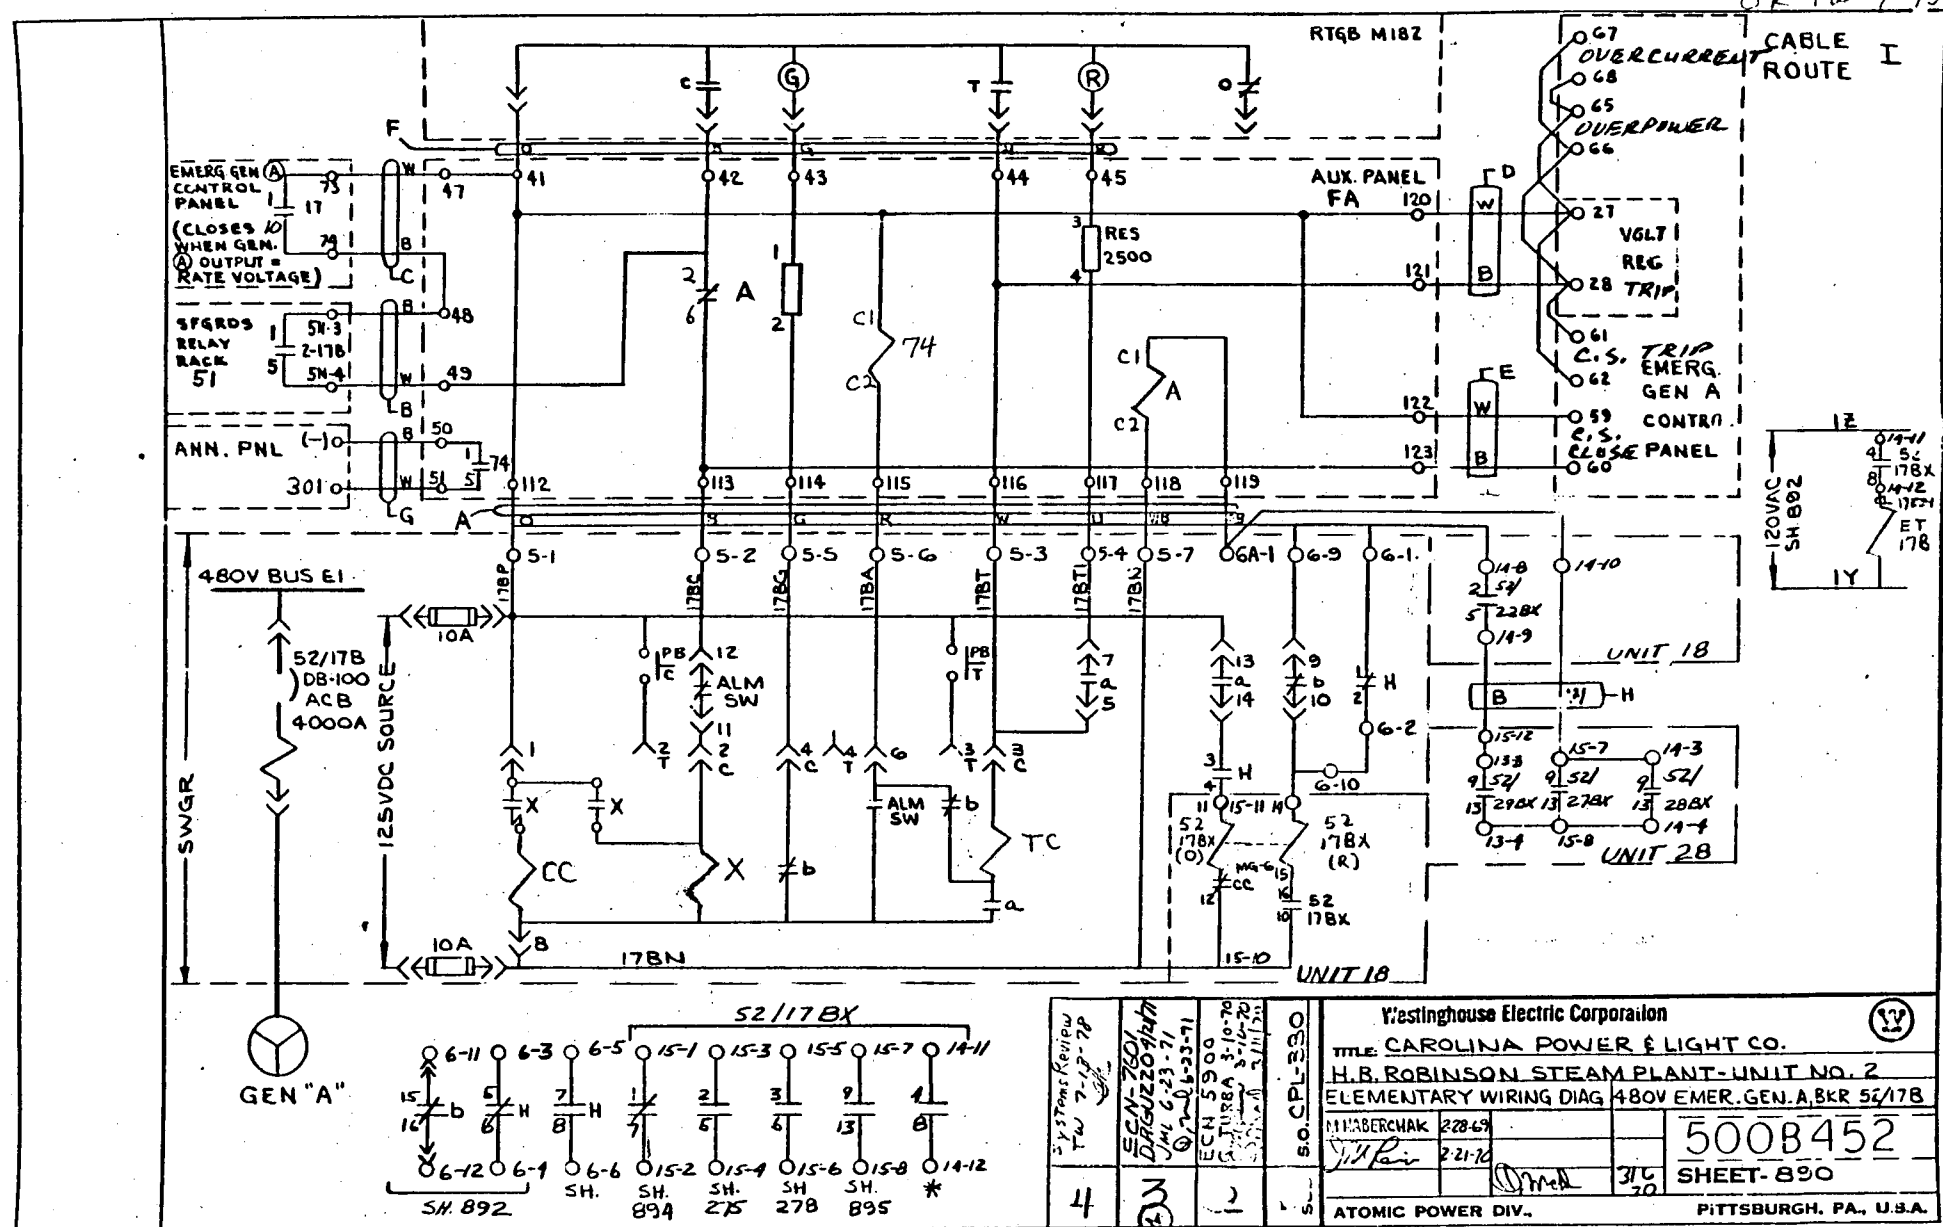


Westinghouse Electric Corporation		(17)	
TITLE: CAROLINA POWER & LIGHT CO.			
H.B. ROBINSON STEAM PLANT-UNIT NO. 2			
ELEMENTARY WIRING DIAG 480V EMER. GEN. A, BKR 52/17B			
MYABERCHAK	228-69		
221-70			
5008452		SHEET-890	
ATOMIC POWER DIV.		PITTSBURGH, PA., U.S.A.	

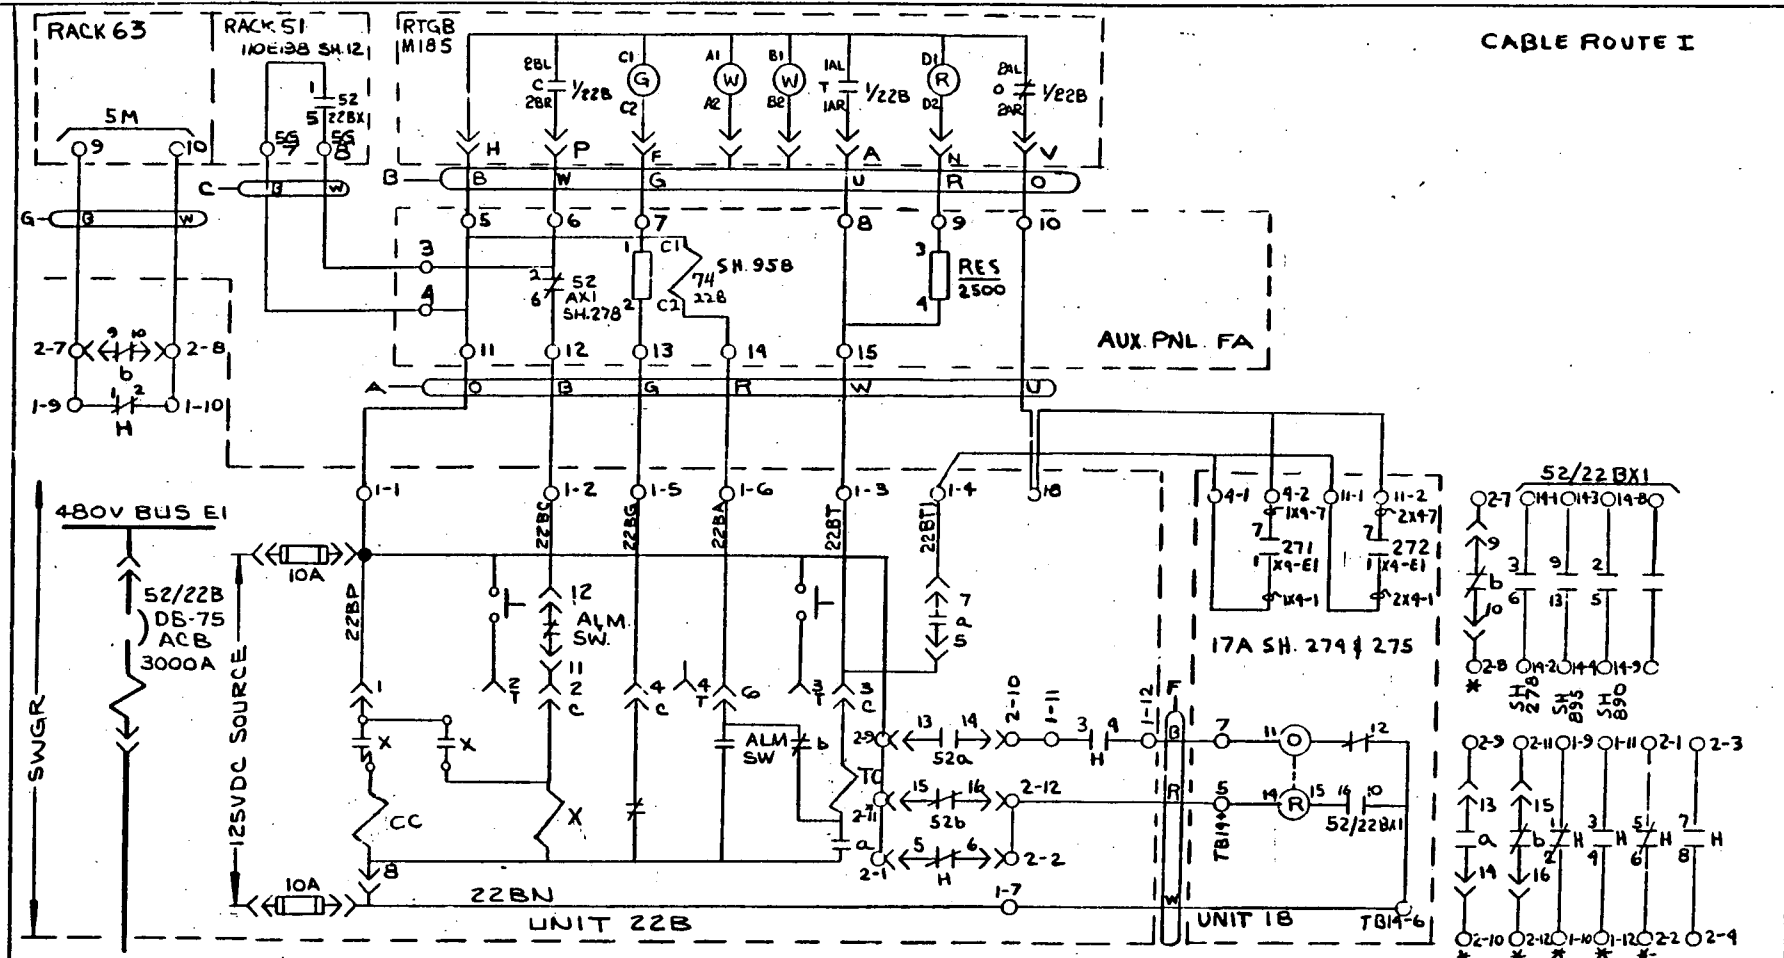

NOTE:  
 1/22B DEV. 16, DET. G, SHEET 37  
 52/22BX DWG. 110E198 SH. 12

Systems Review T-1 7-13-78		ECN-7601 DRG 209/171 VLC 6-29-71 7-13-78		ECN-5980 VLC 4-7-70 7-13-78		ECN-5900 VLC 3-10-70 7-13-78		ECN-4757 VLC 4-7-70 7-13-78		S.O. CPL-380		Westinghouse Electric Corporation					
6		5		4		3		2		1		SUB		TITLE: CAROLINA POWER & LIGHT CO. H.B. ROBINSON STEAM PLANT-UNIT NO. 2 ELEMENTARY WIRING DIAG. 480V BREAKER 52/22B			
												M. HABERCHAK 3-10-67				500B452	
												J. P. [Signature] 4-12-67				SHEET-891	
												P. [Signature] 7/73				ATOMIC POWER DIV., PITTSBURGH, PA., U.S.A.	


\* THIS SHEET

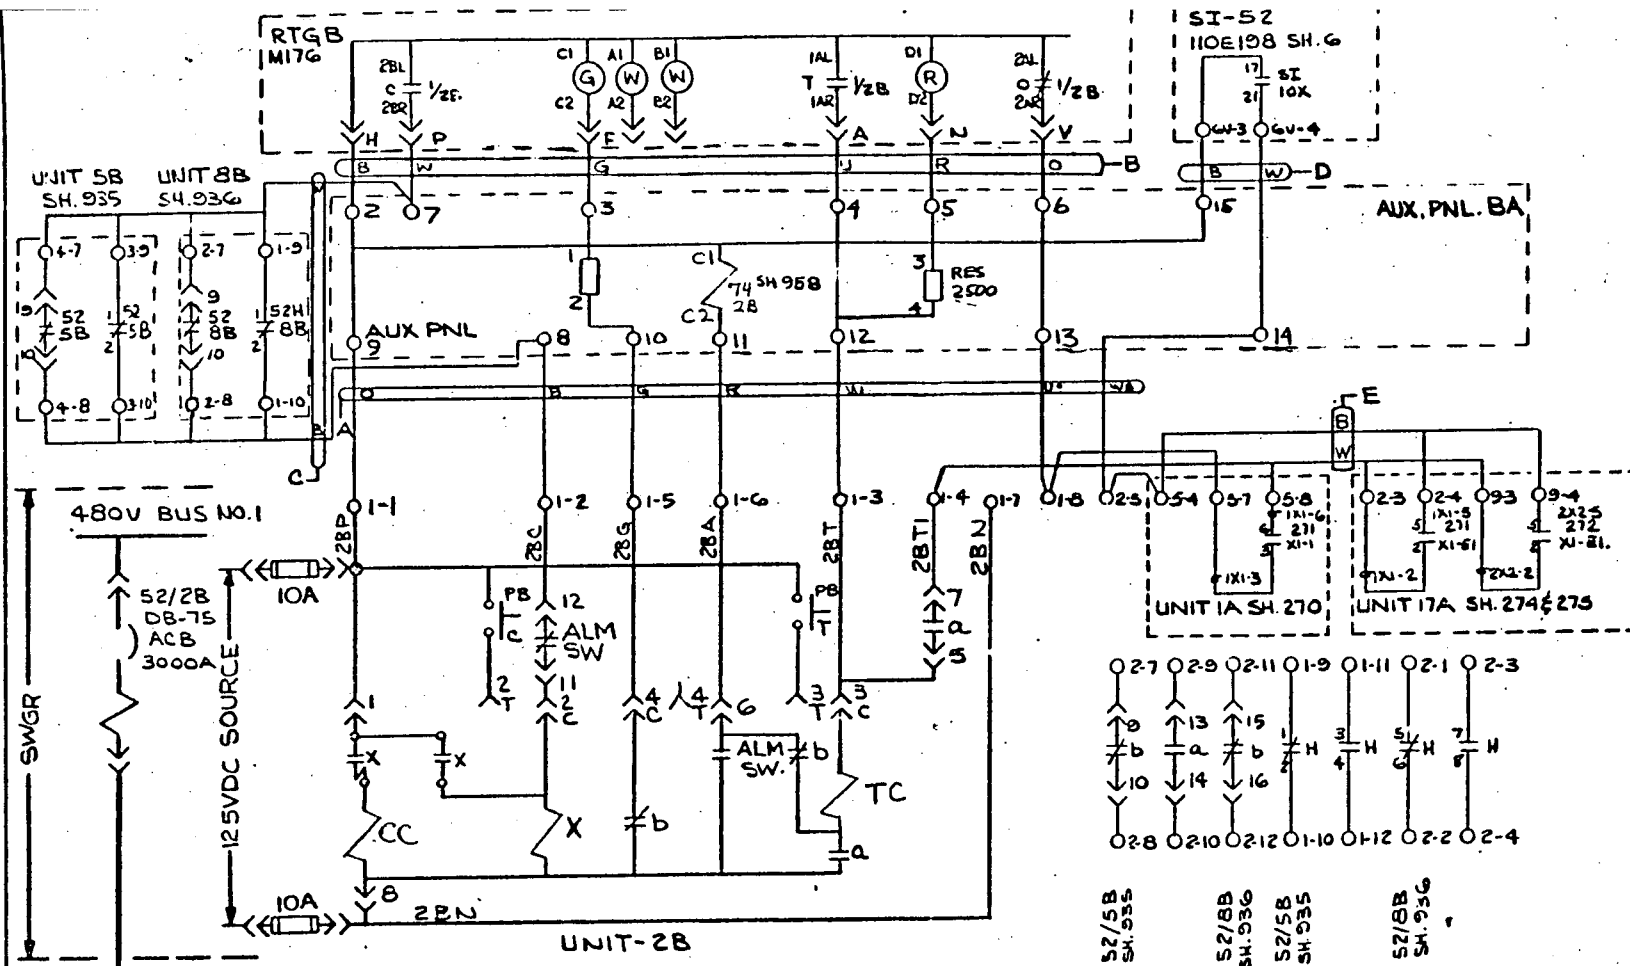


TO UNIT 1B  
SH 694

NOTE:  
1/2B DEV. IG, DET. G, SHEET 37

Systems Review T.W. 7-14-72				Westinghouse Electric Corporation			
ECN-7601 ORGANIZED 7/21/71 JUL 23 71				TITLE: CAROLINA POWER & LIGHT CO			
CN-4737 JUL 23 71				H.B. ROBINSON STEAM PLANT - UNIT NO. 2			
S.O. CPL-380				ELEMENTARY WIRING DIAG 480V BREAKER 52/2B			
4				Shearer			
SUB				500B452			
				SHEET- 893			
				ATOMIC POWER DIV.			
				PITTSBURGH, PA. U.S.A.			

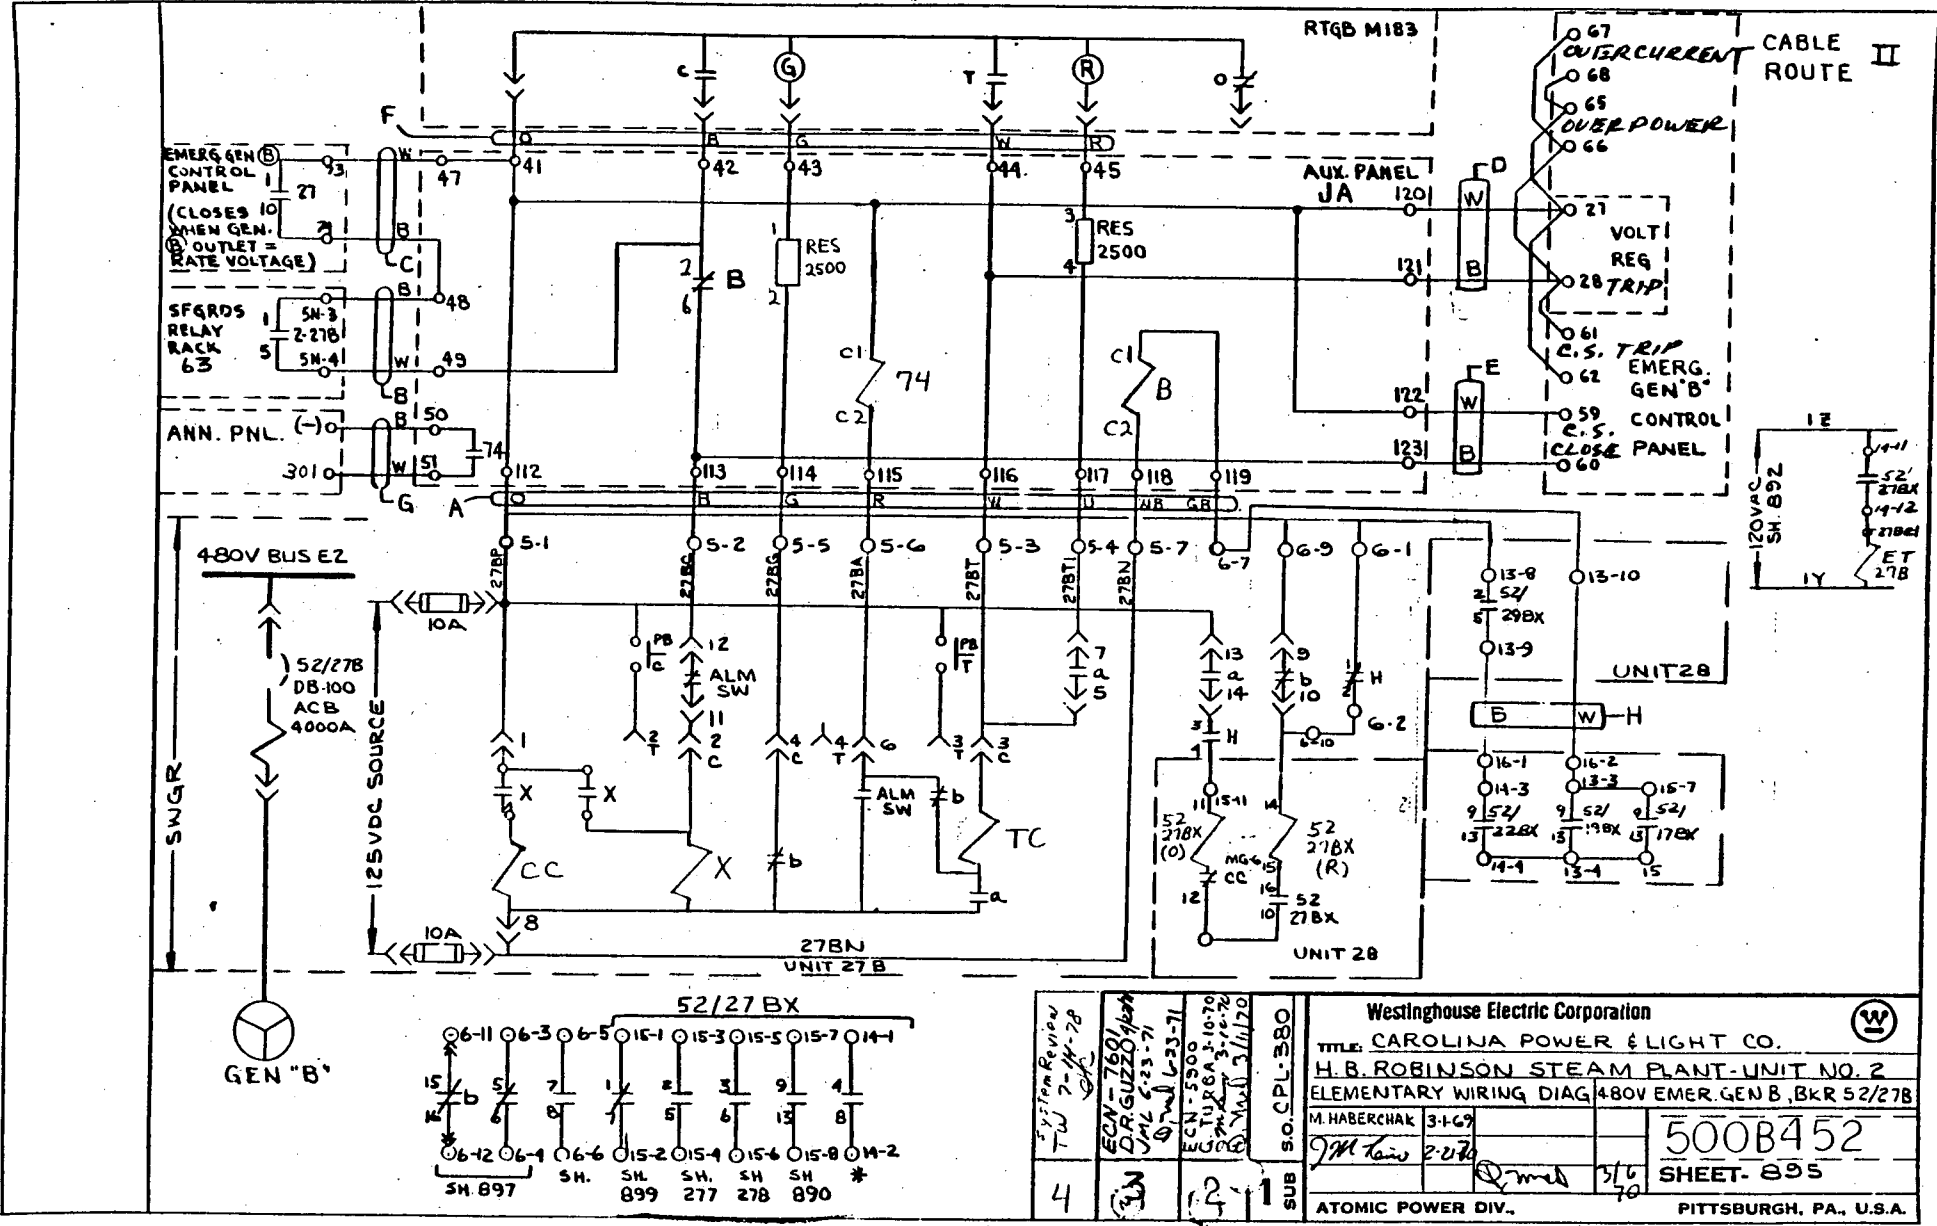


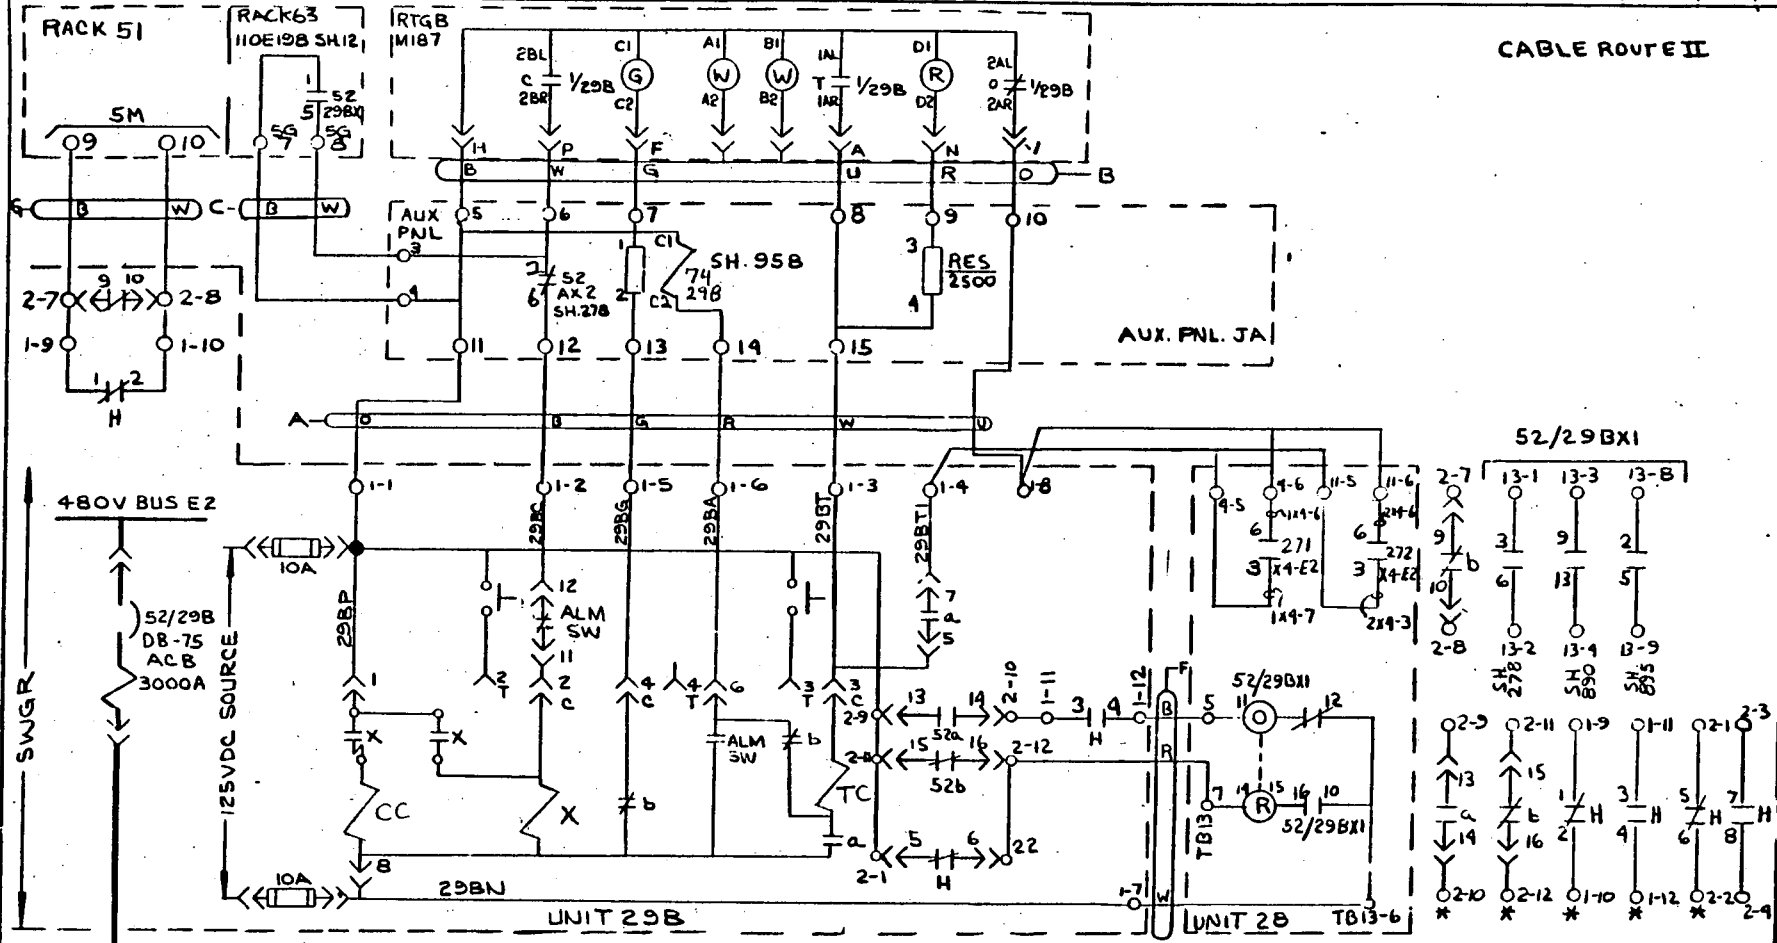





NOTE:  
1/29B DEV. IG, DET. G, SHEET 37.  
52/29BX DWG. 110E19B SH. 12


<p>Systems Review T.W. 7-14-78</p>						<p>Westinghouse Electric Corporation</p>		
<p>ECN-760 20020-12/78 110E19B SH. 12</p>						<p>TITLE: CAROLINA POWER &amp; LIGHT CO</p>		
<p>ECN-5980 20020-12/78 110E19B SH. 12</p>						<p>H.B. ROBINSON STEAM PLANT - UNIT NO. 2</p>		
<p>ECN-5980 20020-12/78 110E19B SH. 12</p>						<p>ELEMENTARY WIRING DIAG. 480V BREAKER 52/29B</p>		
<p>ECN-5980 20020-12/78 110E19B SH. 12</p>						<p>M. HABERCHAK 3-12-78</p>		
<p>ECN-5980 20020-12/78 110E19B SH. 12</p>						<p>500B452</p>		
<p>ECN-5980 20020-12/78 110E19B SH. 12</p>						<p>SHEET- 896</p>		
<p>ECN-5980 20020-12/78 110E19B SH. 12</p>						<p>ATOMIC POWER DIV., PITTSBURGH, PA., U.S.A.</p>		

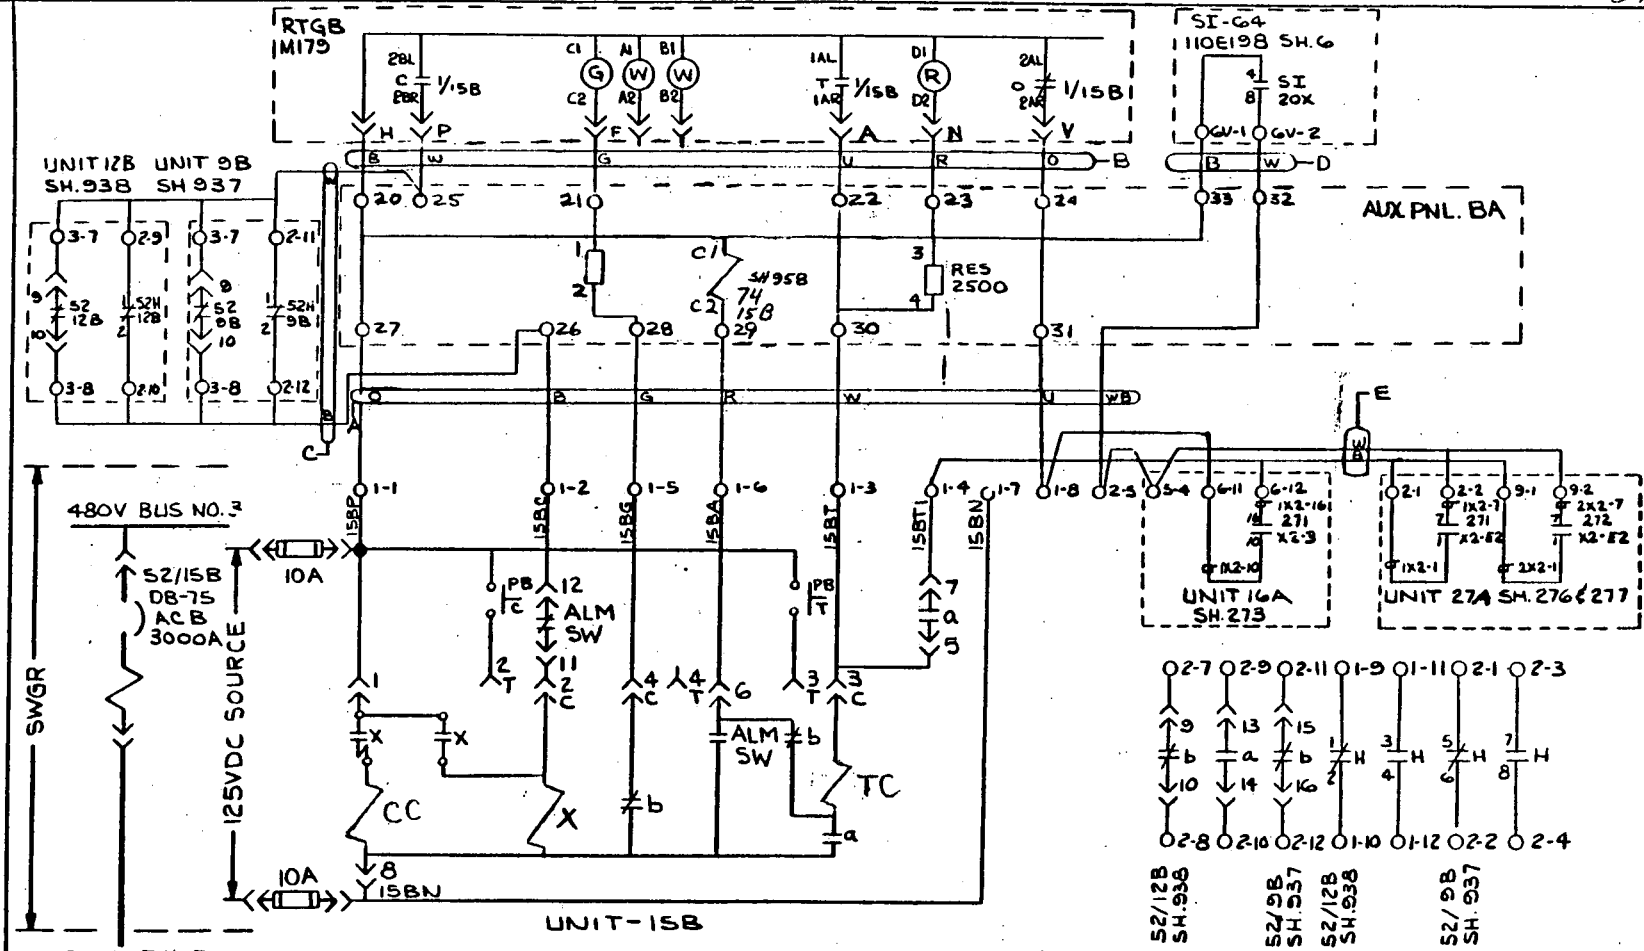



 
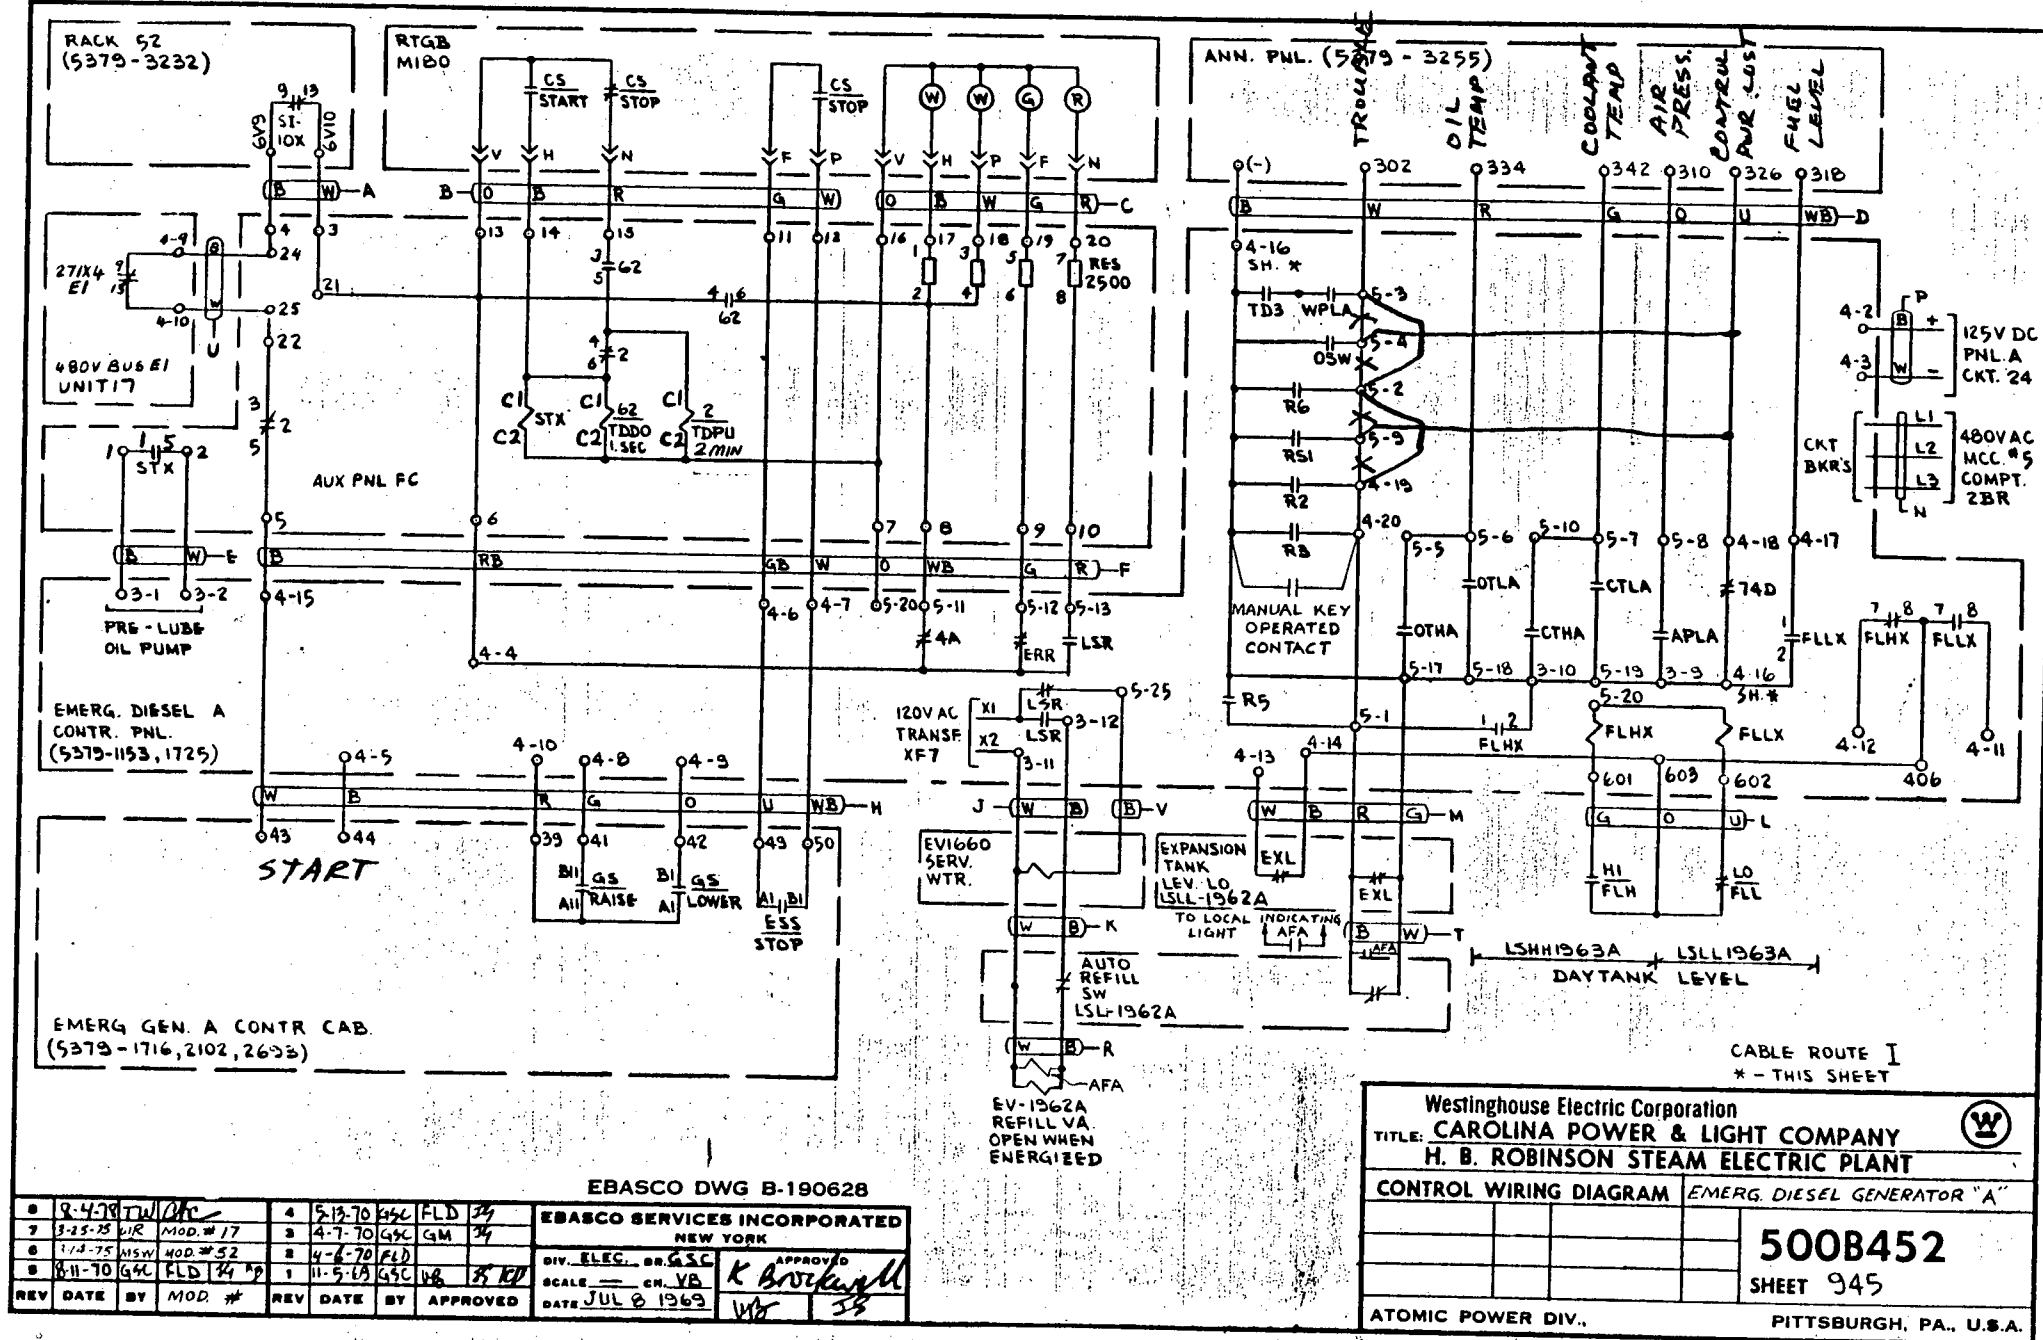
NOTE:  
1/15B DEV. 16, DET. G, SHEET 37

SYSTEM REVIEW TW 7-14-62 E.H.	ECN-7601 460220 4/22/71 JMC 6-23-71 G.M. 6-23-71	ECN-4757 460220 4/22/71 JMC 6-23-71 G.M. 6-23-71	S.O. CPL-380	Westinghouse Electric Corporation				
				TITLE: CAROLINA POWER & LIGHT CO.				
				H.B. ROBINSON STEAM PLANT - UNIT NO. 2				
				ELEMENTARY WIRING DIAG 480V BREAKER 52/15 B				
4				SUB	Shearer			500B452
					<i>J. McKie</i>	4-19-61		
						<i>R. McDonald</i>	7/23/69	
ATOMIC POWER DIV.,					PITTSBURGH, PA., U.S.A.			

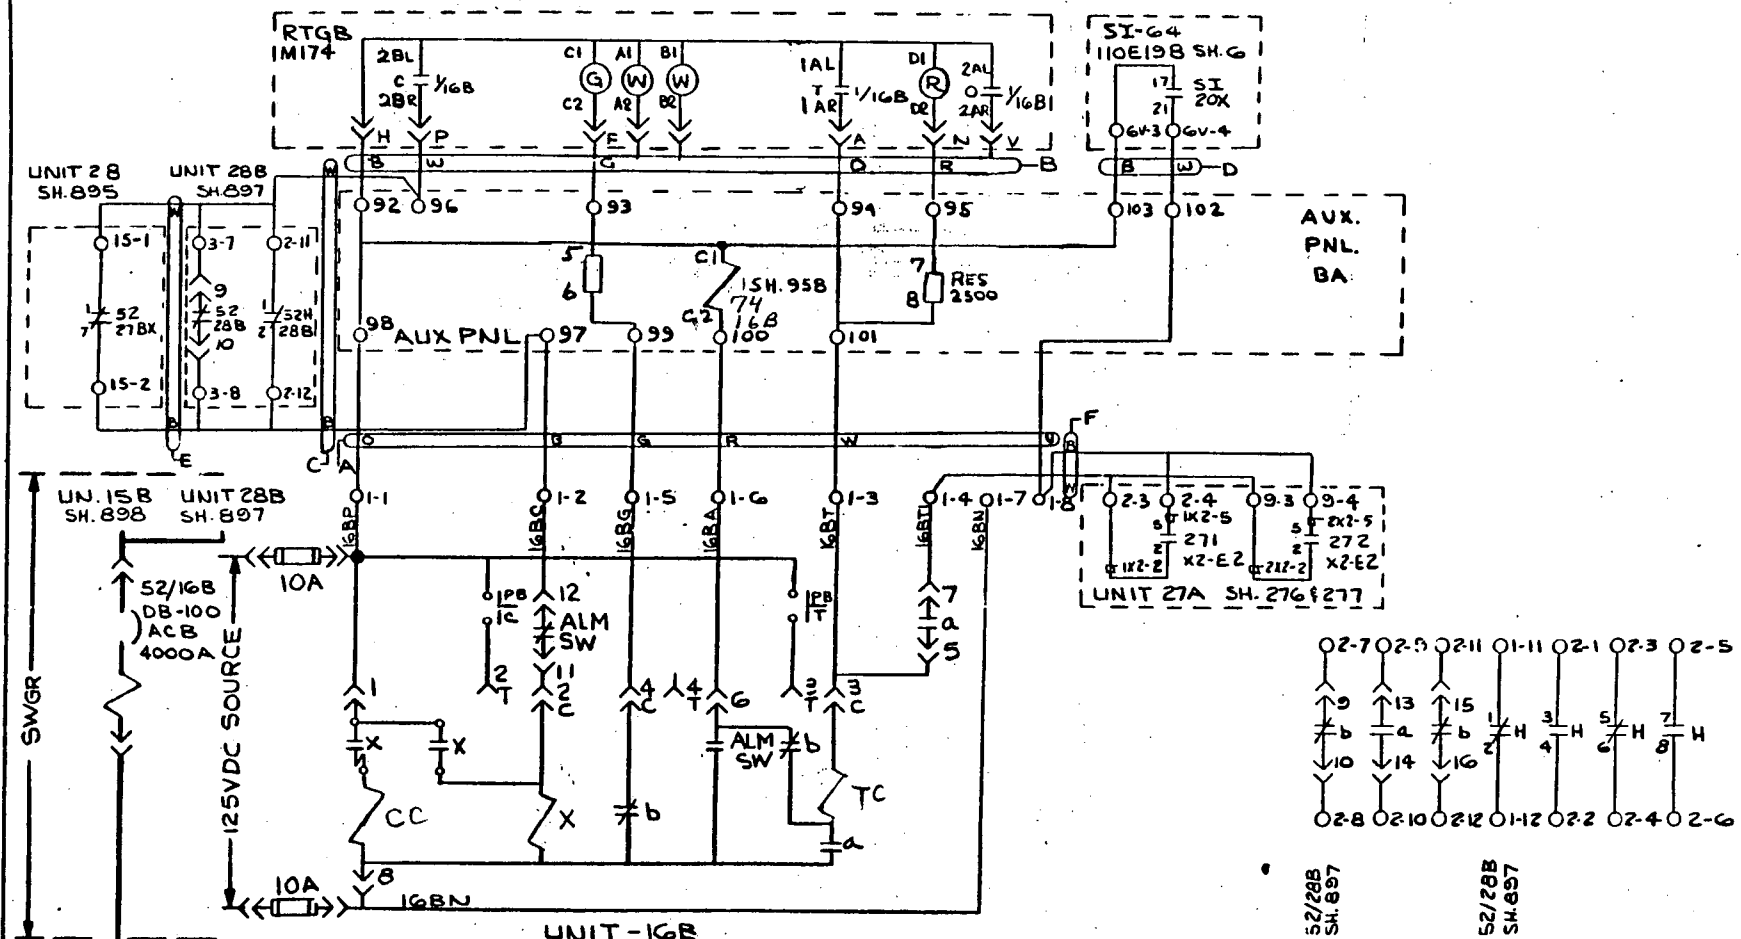


NOTE:  
STA. SERVICE  
TRANS. NO. C  
1/16B DEV. 16 DET. 3, SHEET 37

Systems Review w T-W 7-14-78 SK		ECN-7601 20020 1/2/71 JUL 2-25-71 Q 6-23-71		ECN-5980 3-1-70 2-1-70 4-1-70		ECN-4737 1-1-70 2-1-70 3-1-70		SO. CPL-380				
5	4	3	2	1	SUB	Westinghouse Electric Corporation TITLE: CAROLINA POWER & LIGHT CO. H.B. ROBINSON STEAM PLANT - UNIT NO. 2 ELEMNTARY WIRING DIAG 480V BREAKER 52/16B				500B452 SHEET- 899		
ATOMIC POWER DIV.,						PITTSBURGH, PA. U.S.A.						



11X17

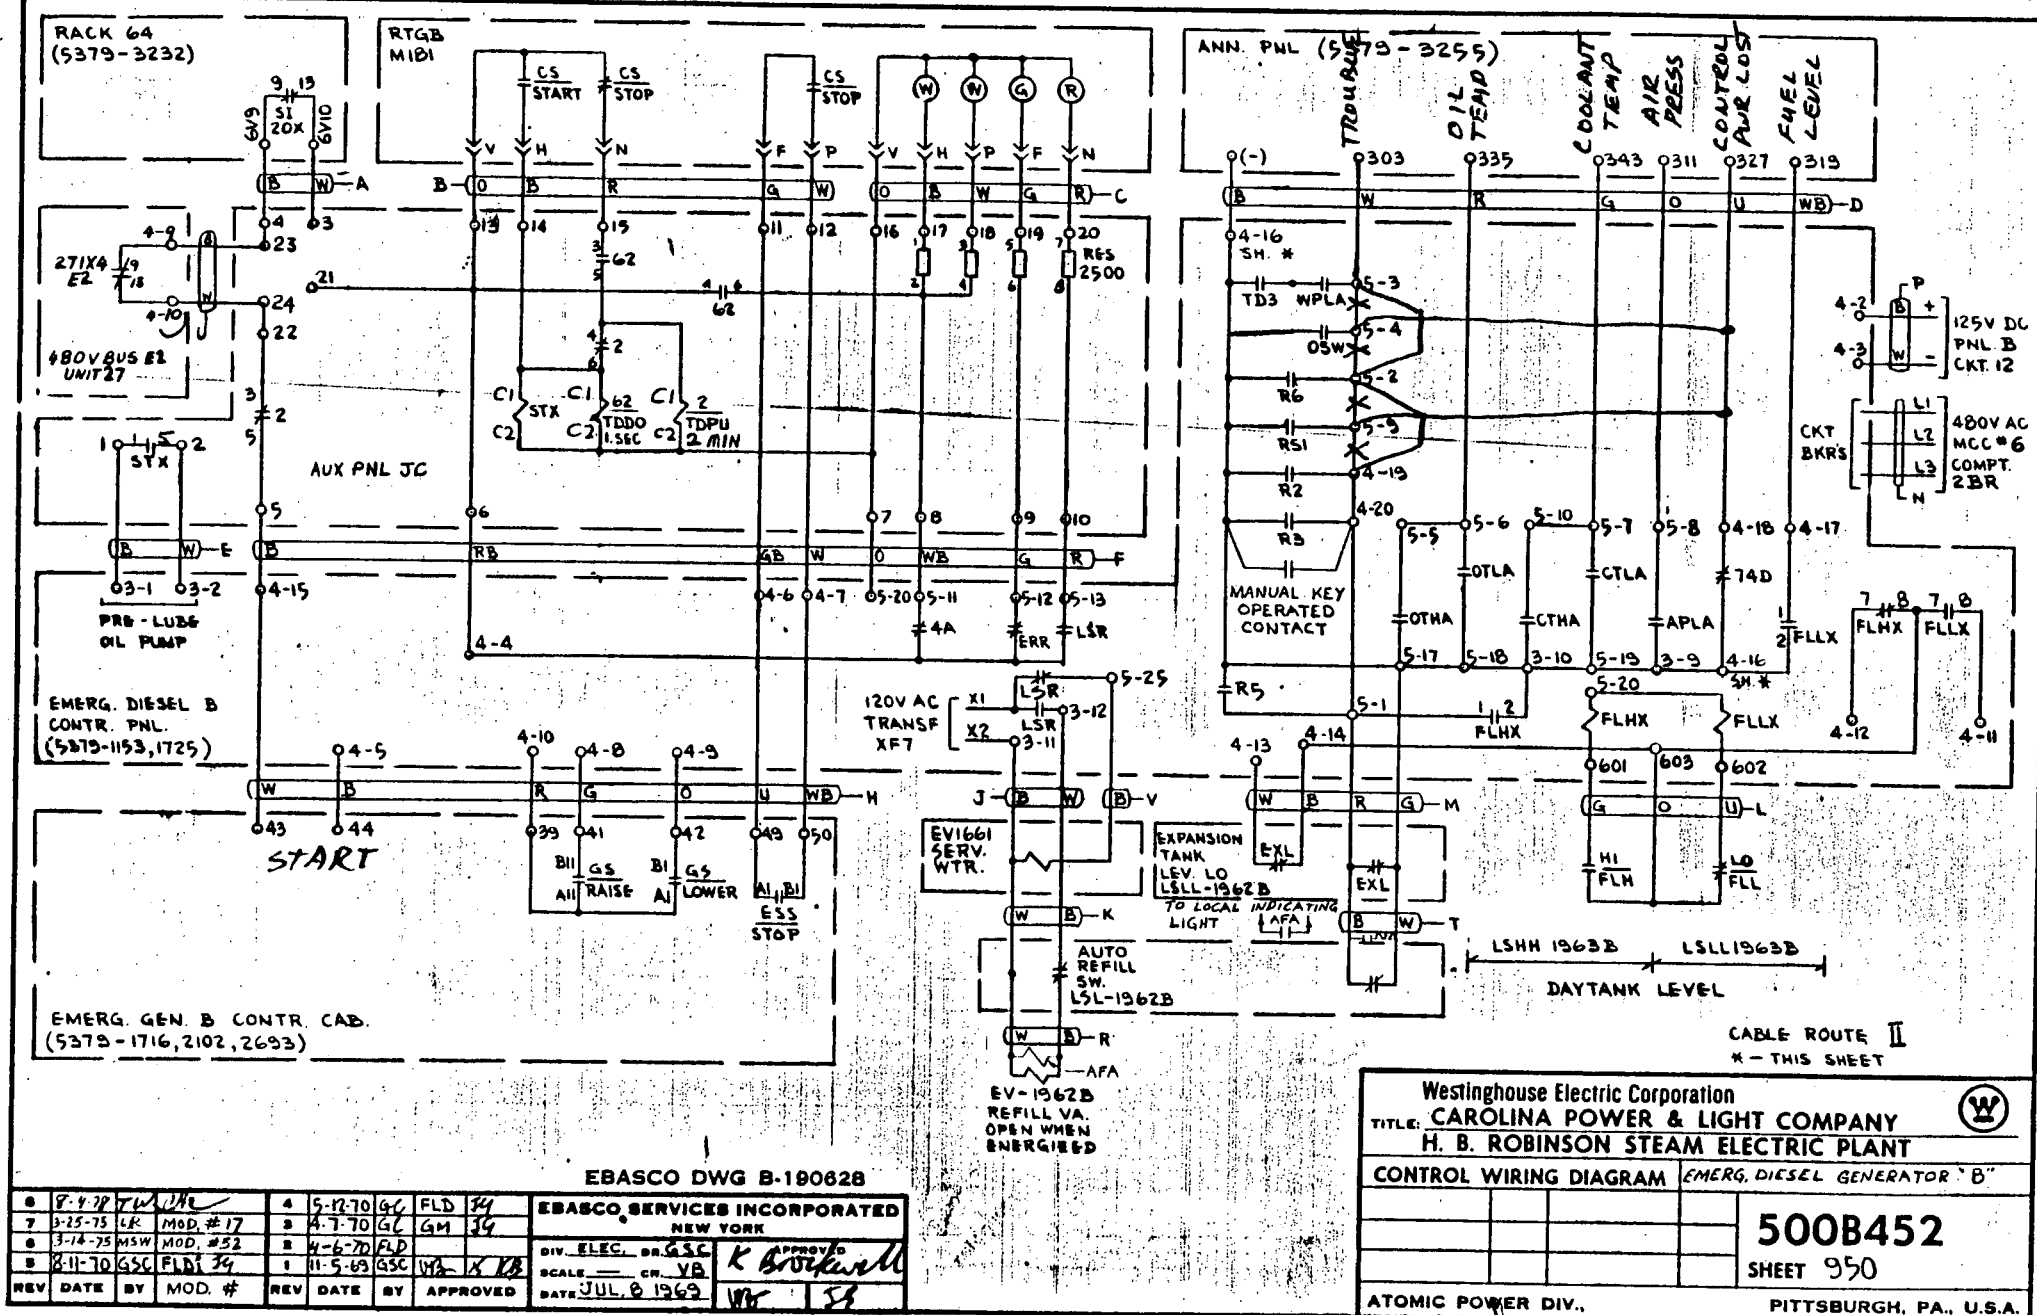

11x17