

ACCELERATED DISTRIBUTION DEMONSTRATION SYSTEM

REGULATORY INFORMATION DISTRIBUTION SYSTEM (RIDS)

ACCESSION NBR:9010300400 DOC.DATE: 90/10/18 NOTARIZED: NO DOCKET #
 FACIL:50-261 H.B. Robinson Plant, Unit 2, Carolina Power & Light C 05000261
 50-324 Brunswick Steam Electric Plant, Unit 2, Carolina Powe 05000324
 50-325 Brunswick Steam Electric Plant, Unit 1, Carolina Powe 05000325
 50-400 Shearon Harris Nuclear Power Plant, Unit 1, Carolina 05000400

AUTH.NAME AUTHOR AFFILIATION
 LOFLIN,L.I. Carolina Power & Light Co.
 RECIP.NAME RECIPIENT AFFILIATION
 Document Control Branch (Document Control Desk)

SUBJECT: Responds to NRC request for addl info re emergency preparedness facilities.

DISTRIBUTION CODE: A045D COPIES RECEIVED:LTR 1 ENCL 1 SIZE: 6
 TITLE: OR Submittal: Emergency Preparedness Plans, Implement'g Procedures, c /

NOTES:Application for permit renewal filed. 05000400 A

	RECIPIENT		COPIES			RECIPIENT		COPIES		
	ID CODE/NAME		LTTR	ENCL		ID CODE/NAME		LTTR	ENCL	
	PD2-1 PD		1	1		LO,R		1	1	
	LE,N.		1	1		BECKER,D		1	1	
INTERNAL:	AEOD/DOA/IRB		1	1		NRR/DREP/PEPB9D		1	1	
	NUDOCS-ABSTRACT		1	1		REG FILE 01		1	1	
EXTERNAL:	NRC PDR		1	1		NSIC		1	1	

NOTE TO ALL "RIDS" RECIPIENTS:

PLEASE HELP US TO REDUCE WASTE! CONTACT THE DOCUMENT CONTROL DESK,
 ROOM P1-37 (EXT. 20079) TO ELIMINATE YOUR NAME FROM DISTRIBUTION
 LISTS FOR DOCUMENTS YOU DON'T NEED!

TOTAL NUMBER OF COPIES REQUIRED: LTTR 10 ENCL 10

*may
with*



Carolina Power & Light Company

Serial: NLS-90-215

OCT 18 1990

United States Nuclear Regulatory Commission
ATTENTION: Document Control Desk
Washington, DC 20555

H. B. ROBINSON STEAM ELECTRIC PLANT, UNIT NO. 2
DOCKET NO. 50-261/LICENSE NO. DPR-23

SHEARON HARRIS NUCLEAR POWER PLANT
DOCKET NO. 50-400/LICENSE NO. NPF-63

BRUNSWICK STEAM ELECTRIC PLANT, UNIT NOS. 1 AND 2
DOCKET NOS. 50-325 & 50-324/LICENSE NOS. DPR-71 & DPR-62

RESPONSE TO REQUEST FOR INFORMATION REGARDING EMERGENCY PREPAREDNESS
FACILITIES

Gentlemen:

Enclosed is the package of information which Mrs. Anne Boland, NRC Region II, requested during her visit in August to Carolina Power and Light Company's Joint Information Centers (JICs).

The package consists of:

- 1) Sutton Plant site plan with facilities boldly marked; this is the Brunswick JIC location;
- 2) Florence County map highlighting locations of Robinson's present Alternate JIC and future Alternate JIC, and
- 3) Copy of memorandum requesting new telephone lines for the Harris JIC.

Mrs. Boland also asked about the independence of the NRC automatic ringdown lines from the JICs to the Emergency Operations Facilities (EOFs). In response to her question, the NRC automatic ringdowns to the EOFs at all three plants are on separate lines from the automatic ringdown lines which are used by CP&L personnel in the JICs.

130003

9010300400 901018
PDR ADOCK 05000261
F PDC

If you need further information, contact Tami Dunn at 919-546-6175.

Yours very truly,



L. J. Loflin
Manager


Nuclear Licensing Section

WCL/cwh (842SNP)

Enclosures

cc: Mrs. Anne Boland (NRC Region II)
Mr. R. A. Becker (w/o enclosures)
Mr. S. D. Ebnetter (w/o enclosures)
Mr. L. Garner (NRC - HBR) (w/o enclosures)
Mr. N. B. Le (w/o enclosures)
Mr. R. Lo (w/o enclosures)
Mr. R. L. Prevatte (w/o enclosures)
Mr. J. E. Tedrow (w/o enclosures)

UNIT #2 UNIT #1

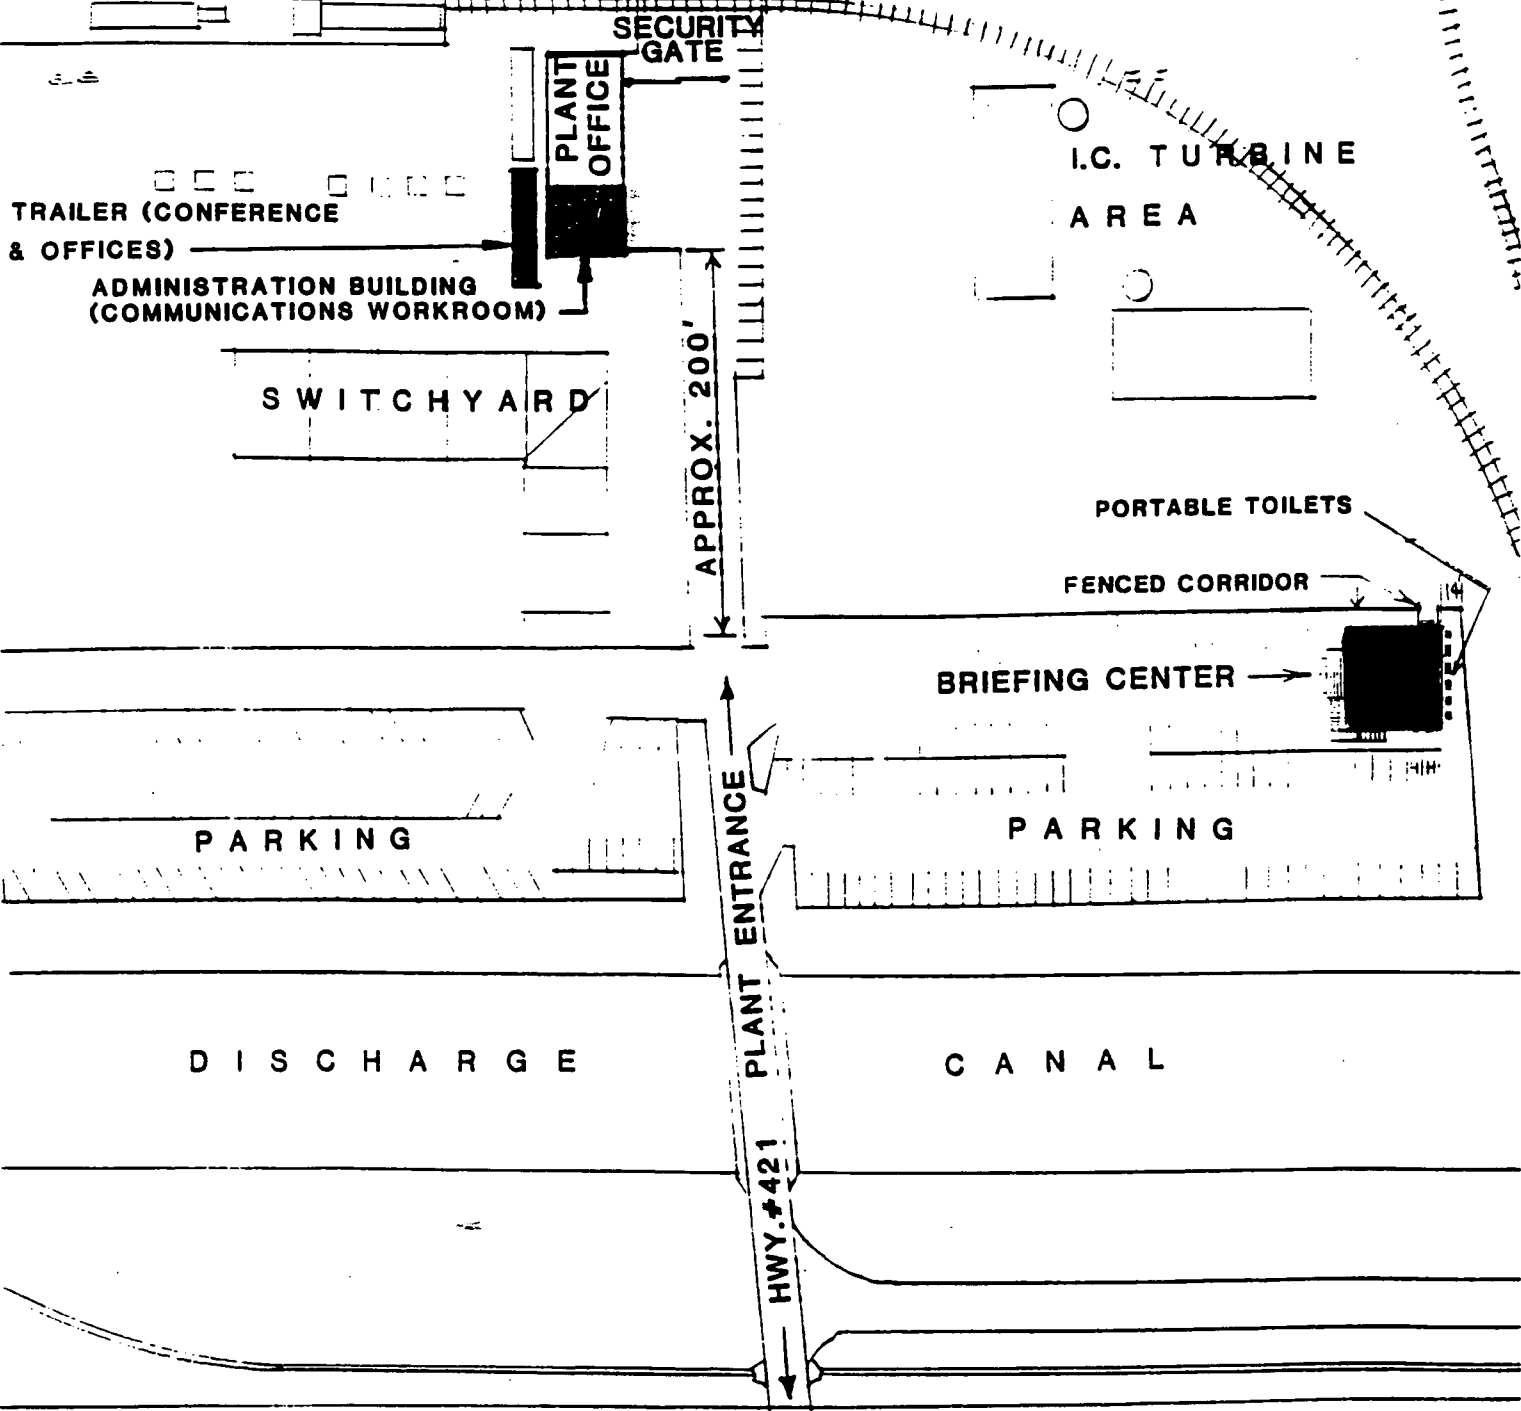

SITE PLAN

1"=20'

NOTE: SEE DRAWING D-8319 FOR LIST OF REFERENCE DWGS.



CAROLINA POWER & LIGHT COMPANY
FOSSIL PLANT BETTERMENT DEPARTMENT

L.V. SUTTON STEAM ELECTRIC PLANT JOINT INFORMATION CENTER

SITE PLAN

2	5/2/90	AS-BUILT	VGR/JXR	CO
1	1-26-90	DCN-001	JAR/JXR	CO
0	12-5-89	APPROVED FOR CONST.	JXR/JXR	DB BELL
A	11-6-89	ISSUED FOR COMMENTS	VGR/JXR	BELL
NO.	DATE	REVISION	BY	CHK

SCALE 1"=100'

UNIT/SECTION CIVIL/ES

DR. L. FILLER

CH. J. R. Rabon

[Signature]

DATE


DES. NO.

D-8316

Alternate Briefing Area presently
in place

New JIC - Complete April 1991
4 briefing area

(Alternate JIC presently located here
also)

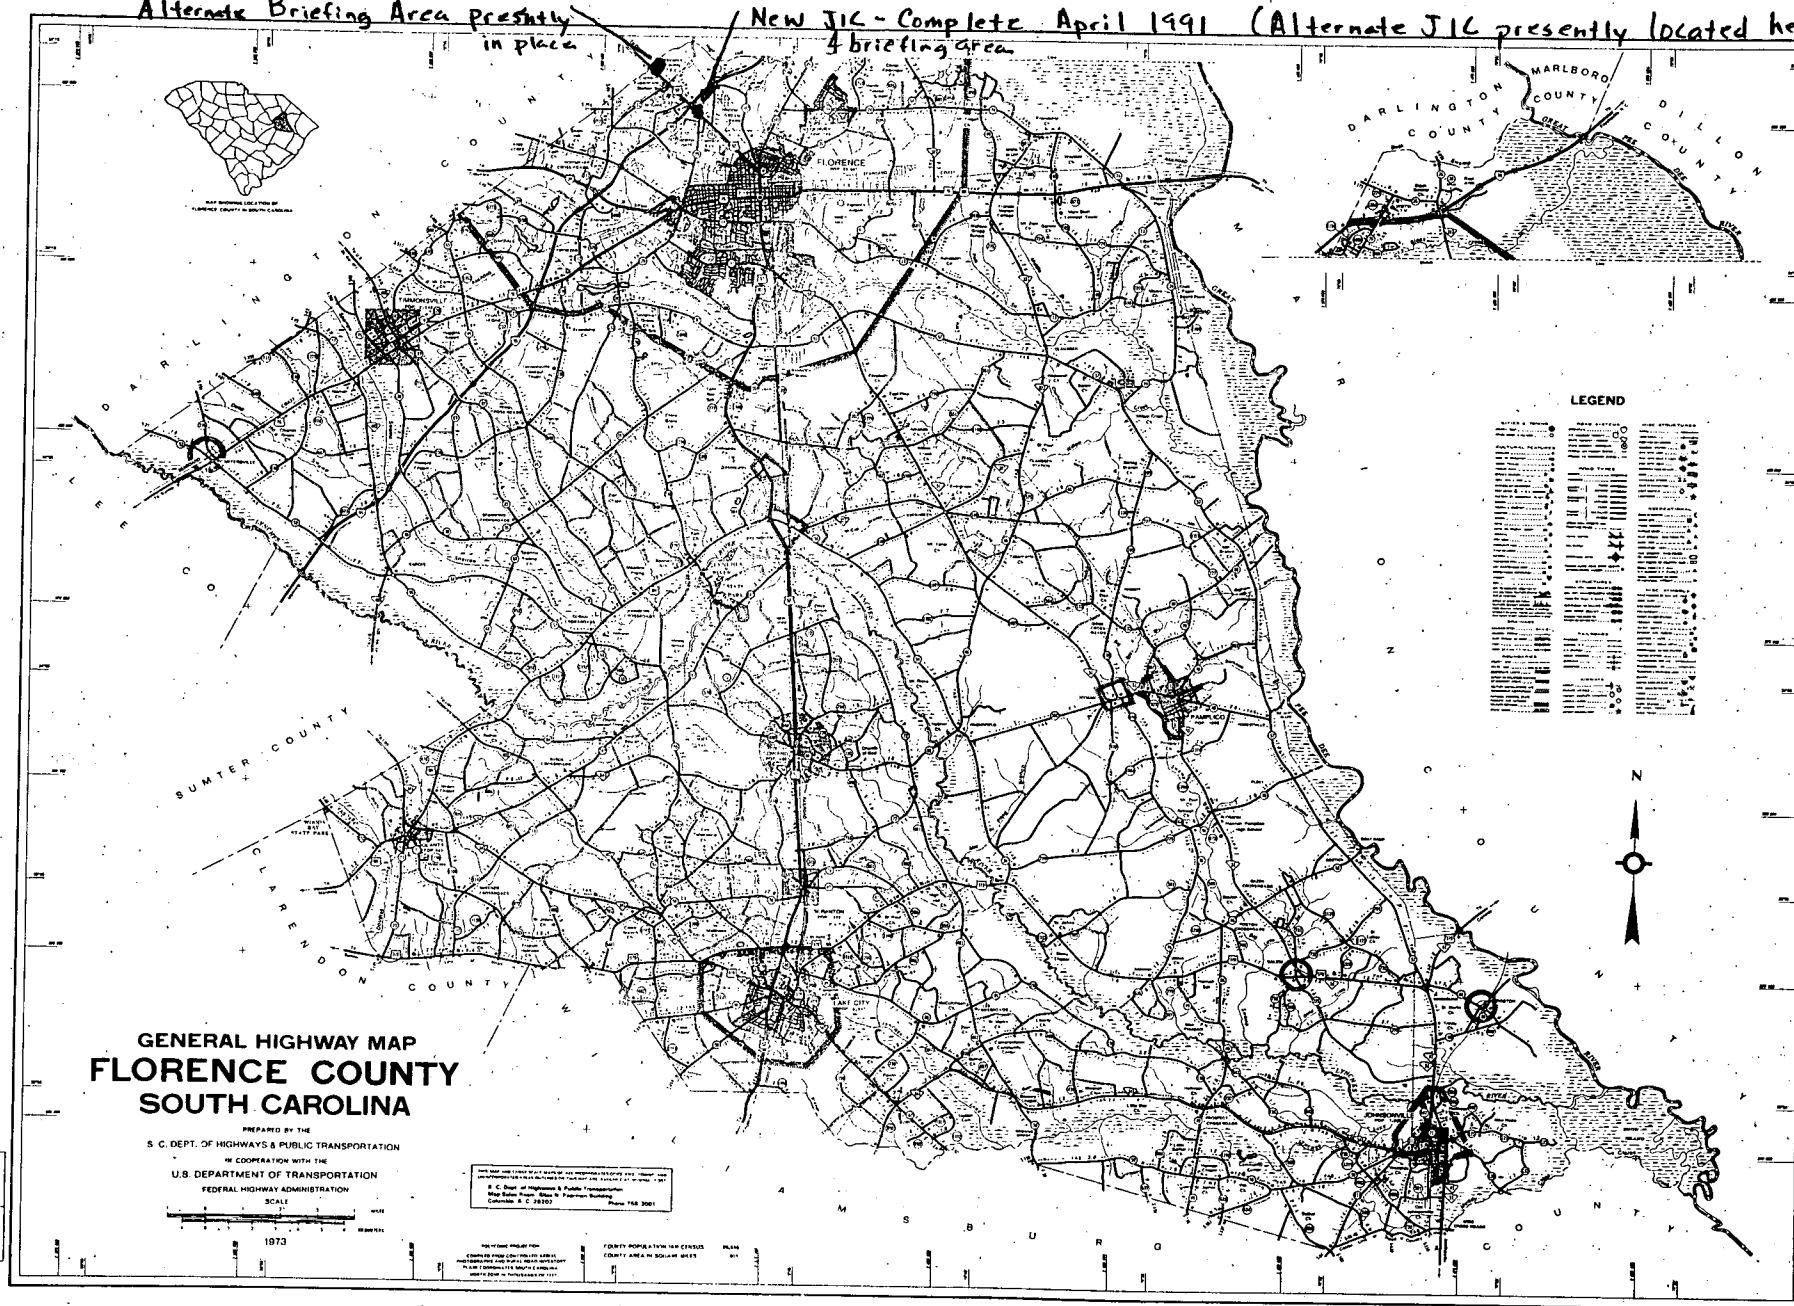



Carolina Power & Light Company

September 27, 1990

Company Correspondence

MEMORANDUM**TO:** Dwight Mims**FROM:** Max F. Thompson, Jr.**RE:** Harris Joint Information Center (JIC) Telephone Modifications

I would like to request two additional bell telephone lines be added at the Harris JIC located in Room A of the Raleigh Civic & Convention Center. See the attached drawing for the exact locations.

These telephone lines are for use by the Nuclear Regulatory Commission (NRC) and one of the lines will be used for a computer.

Expenses incurred for installation and monthly costs of these additional lines should be charged to billing number 919-362-0904, Department Identifier Code JICRCC, earning number 919-832-5333. Completion of this project is necessary by December 31, 1990.

If you have any questions regarding these modifications, contact Tami Dunn at extension 6175. Thank you for your continued support.

cc: Anne Boland (USNRC) ✓
Rick White
Wayne Ennis
Bob Indelicato
Albert Garrou
Bryan Allen
Tami Dunn

