

THE FOLLOWING DRAWINGS
TO BE WITHHELD FROM
PUBLIC PER 10 CFR 2.390 AND SECY-04-0191.

57730
102023-6
102023-8
102023-9
102023-11
102023-12
102023-16
102023-17
102023-18
108023-6
108023-8
108023-9
108023-11
108023-12
108023-18
438431
438432
438445
438449
439533
498992
498993
500852
500853
500976
663082-2

RASTER=19404.dgn
 DGN=19404.dgn
 CAD User:RHS1 Date: 05-25-2007

E

D

C

B

A

1

2

3

4

5


6

7

8

9

10

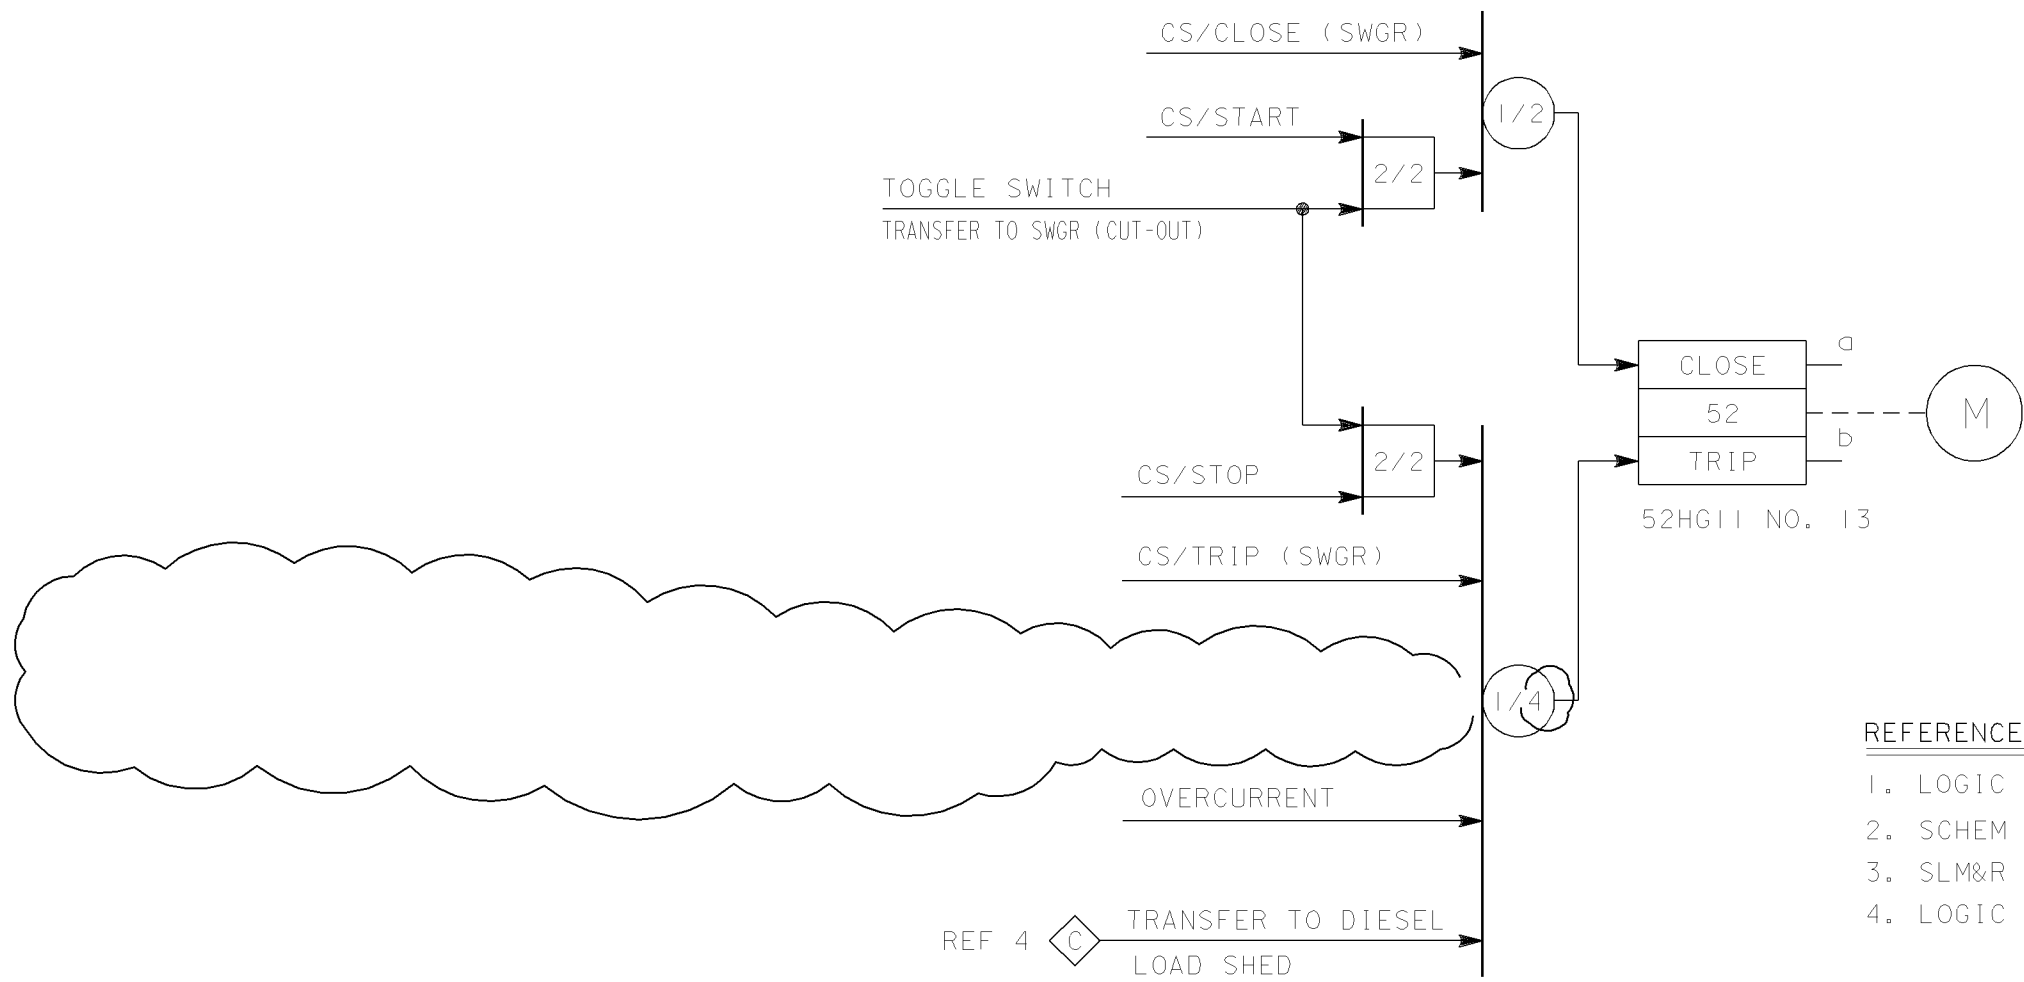


REFERENCES:

	DWG NO.
1. LOGIC DIAGRAM SYMBOLS	19425
2. SCHEM DIAG CHARGING PUMP #13	4008756
3. SLM&R DIAG 4KV BUS F,G&H	437533
4. LOGIC DIAG 4KV BUS SECT "G" AUTO XFER	458864

KEY DWG. SECTION 3


NUCLEAR SAFETY RELATED

UNIT 1

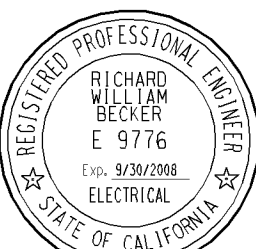DATE 05-25-2007			REVISION DESCRIPTION		<div>ELECTRICAL LOGIC DIAGRAM CENTRIFUGAL CHARGING PUMP 1-3</div> <div>DIABLO CANYON POWER PLANT PACIFIC GAS AND ELECTRIC COMPANY SAN FRANCISCO, CALIFORNIA</div>		DWG SCALE:			
D.D.	RHS1		REVISED PER DCI-SE-49704-01				BILL OF MATL:			
R.E.	FxC2						SUPSDS:			
I.V.							SUPSD BY:			
P.E.	RWB7						DRAWING 19404	SHEET 1	PAGE 0	REV 6

INPG
I Size

U# 2 - 102788

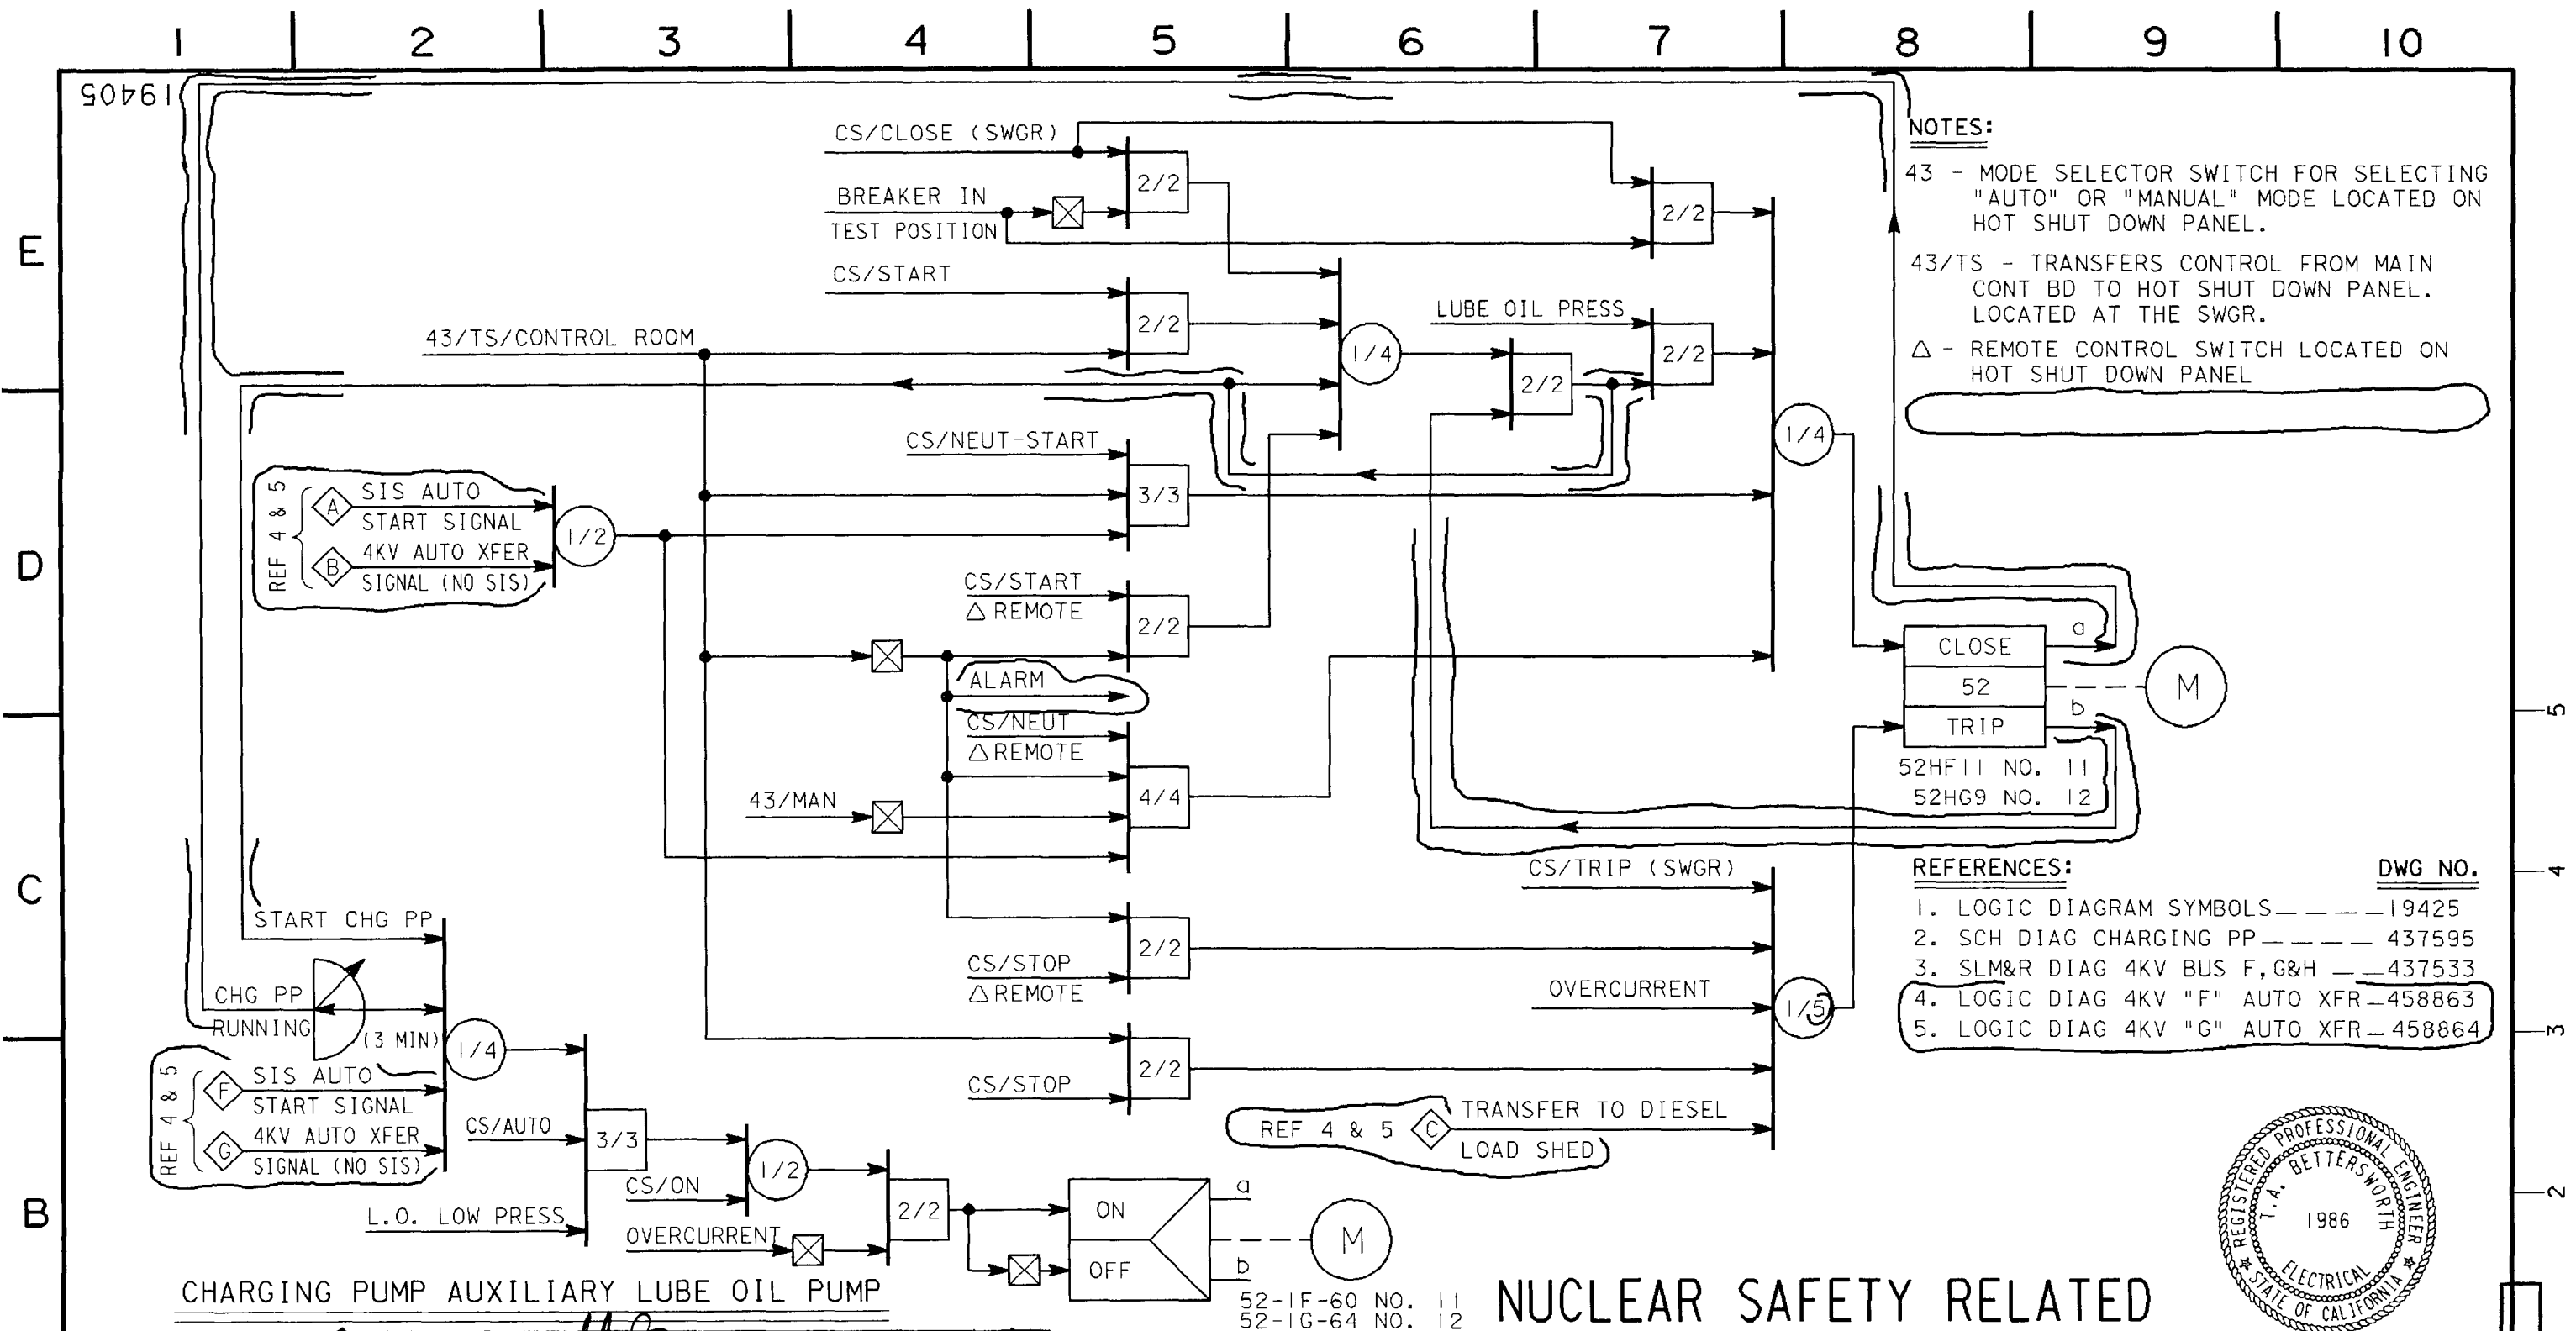

7	M. Basu	U. Basu	C12314	12/31/94
REV	REGISTERED ENGINEER	SIGNATURE	CA REG NO.	EXP DATE

KEY ELEC SECT 3 RM INDEXED REV 6 UNIT 1

LOGIC DIAGRAM
CENTRIFUGAL CHARGING PUMPS

DIABLO CANYON

DEPARTMENT OF ENGINEERING
PACIFIC GAS AND ELECTRIC COMPANY
SAN FRANCISCO, CALIFORNIA

COAST VALLEYS DIVISION

MICROFILM 7

BILL OF MATL

DWG LIST

SUPSDS

SUPSD BY

SHEET NO. 19405

SHEETS 7

REV. 7

U#2-102789

REVISIONS

NO.	DATE	DESCRIPTION	GM	DWN.	CHKD.	SUPV.	APVD.
7	1-18-94	REDRAWN; REV LOGIC; DEL ASTERISK NOTE; ADD REF'S 4 & 5 (FCT-16395)	WAA	WAA	PS	MMH	UP
6	12-1-92	REV AS PER LOGIC DIAGRAM (FCT-14621, DCI-EE-47591 & 47593)	MS	VAL	DSW	NH	MB

APPROVED BY: GM 167027

LRW: SUPV. H. HERTING

DN: DSGN. E. ZEITER

JWC: DWN. O. CASTELLANOS

TAB: CHKD. EZ/J. CUENCO

DATE: 11-25-69

SCALES: NONE

PROJECT LOCATION: DIABLO

INSTALLATION TYPE: L

DIVISION NAME: B


MISC: 53

DD CODE: GD

MAN HOURS: 57

CADD: C

DRAWING SOURCE: A

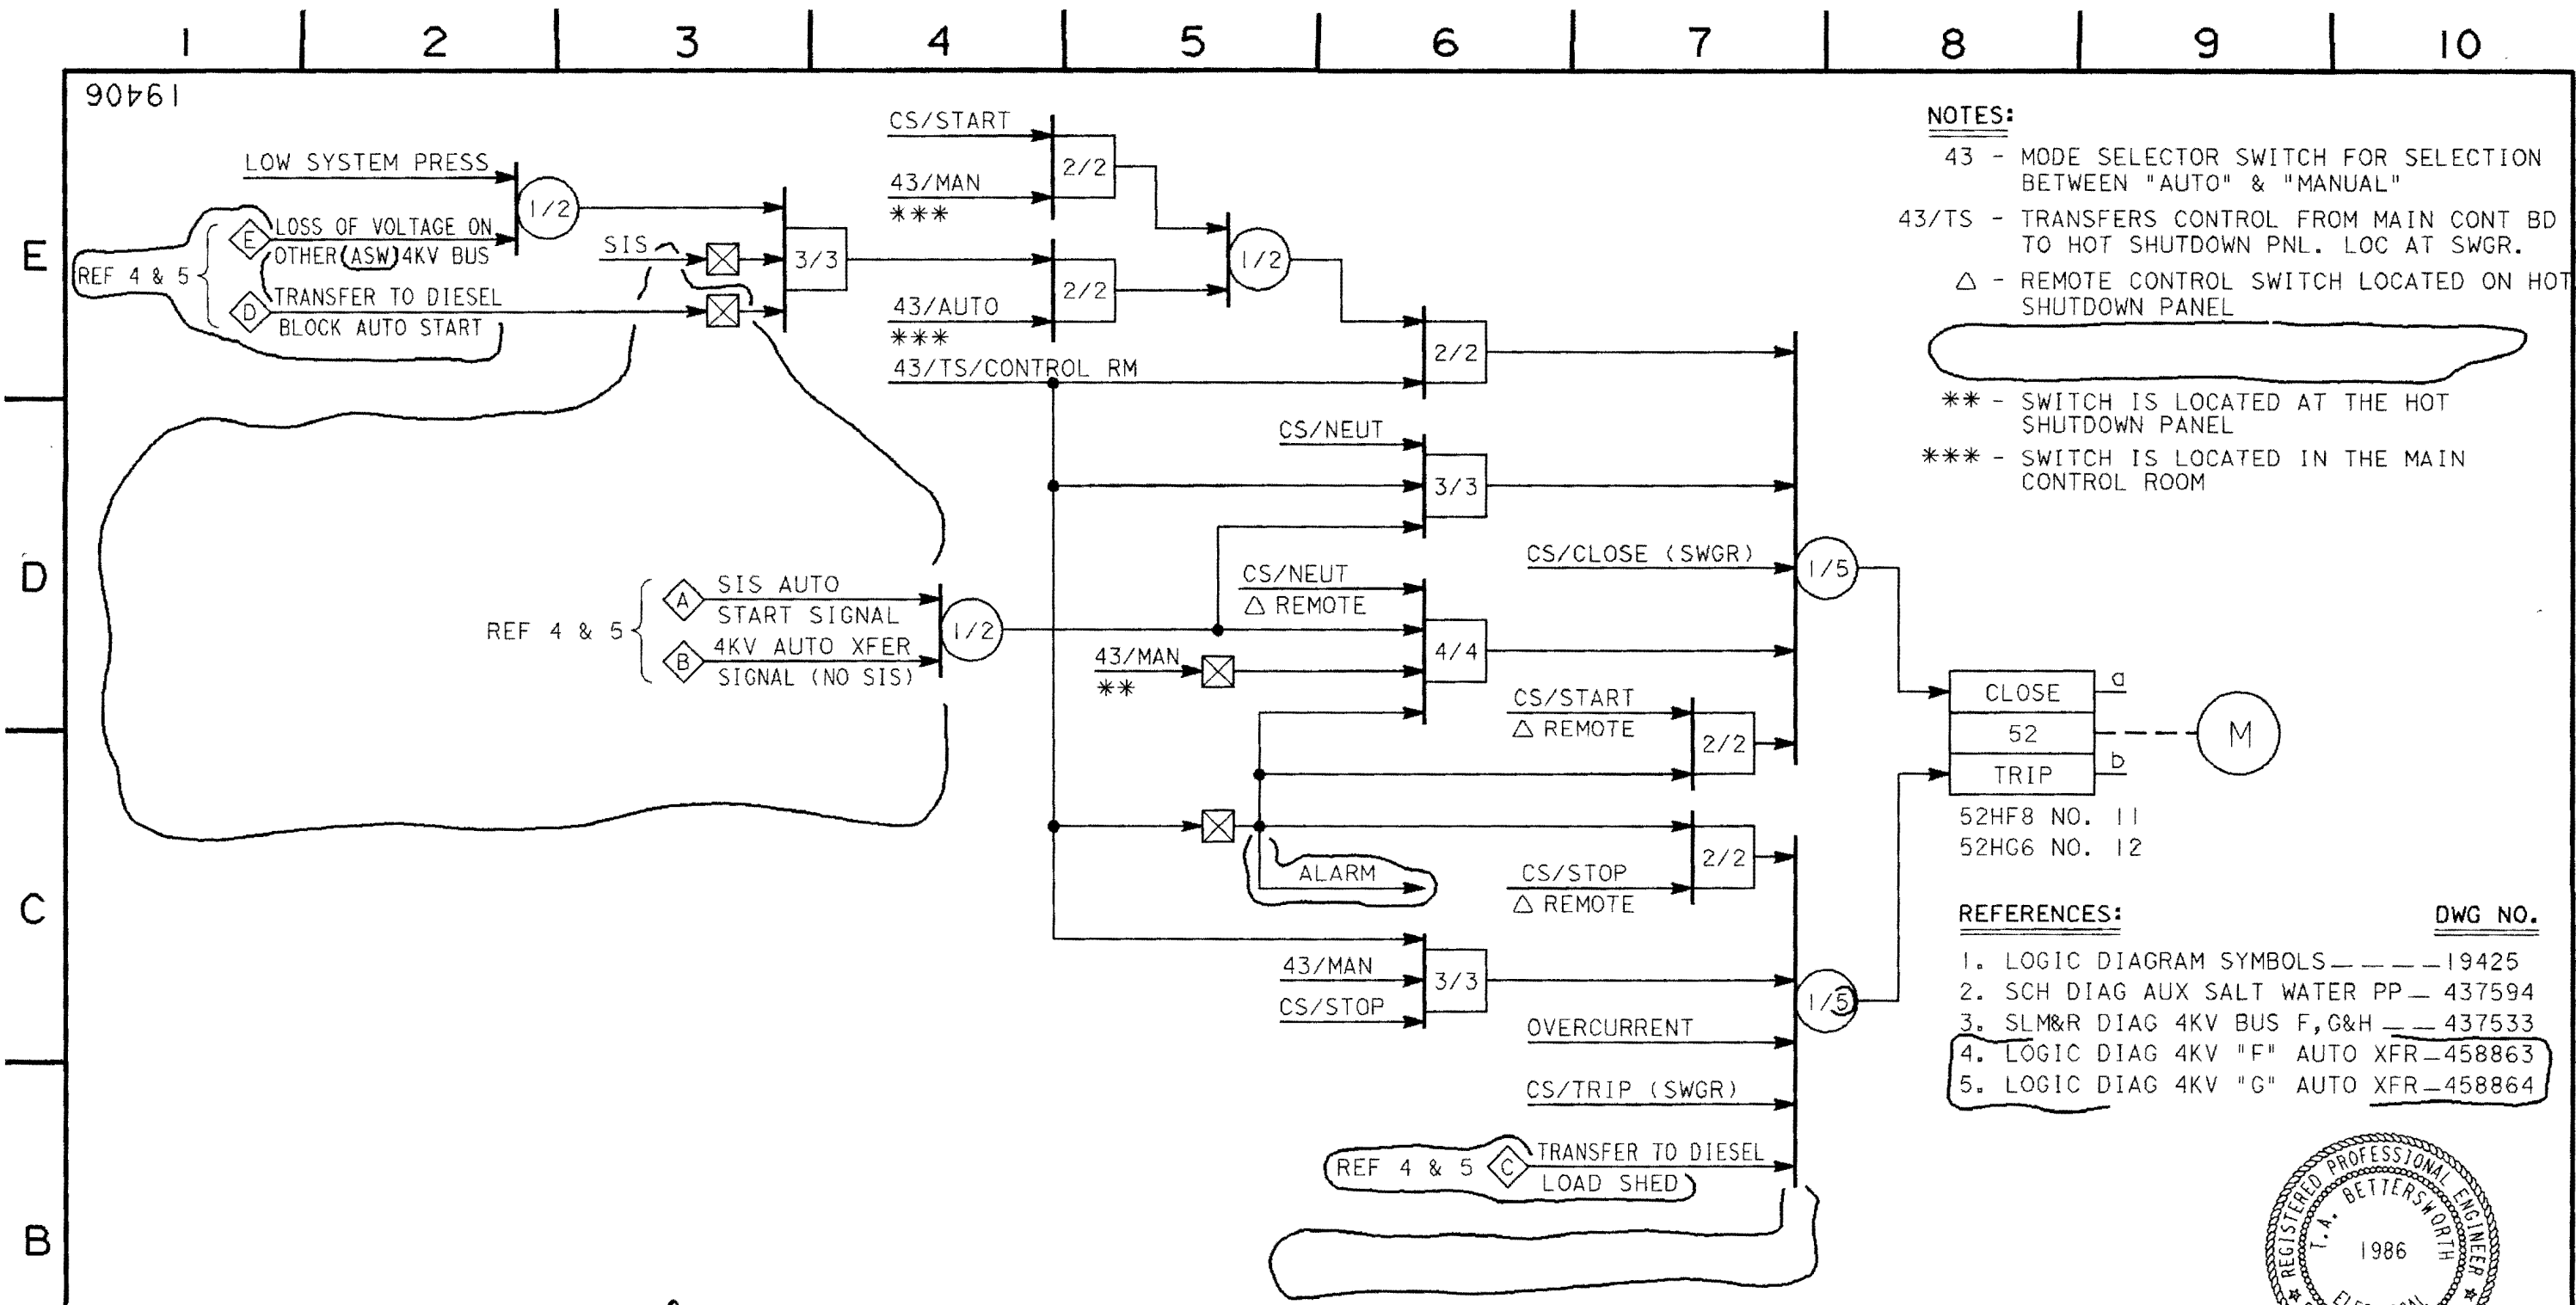

4	M. Brown	<i>[Signature]</i>	C12314	12/31/94
REV	REGISTERED ENGINEER	SIGNATURE	CA REG NO	EXP DATE

KEY ELEC SECT 3
RM INDEXED REV 3

NUCLEAR SAFETY RELATED UNIT 1



COAST VALLEYS DIVISION

NO.	DATE	DESCRIPTION	GM	DWN.	CHKD.	SUPV.	APVD.
4	1-19-94	REDRAWN; REV LOGIC & NOTES; ADD REF 4 & 5 (FCT-16395)	WAA	WJ	WJ	WJ	WJ
3	12-1-92	REV AS PER LOGIC DIAGRAM (FCT-14621, DCI-EE-47591 & -47593)	MS	VAL	DSW		MB
1	2-16-73	MISC CHGS APPROVED FOR CONSTRUCTION(M)	167027	EZ		LRW	DN

REVISIONS

APPROVED BY	GM 167027
LRW	SUPV. H. HERTING
JBG/DN	DSGN. E. ZEITER
JWC	DWN. E. Z.
TAB	CHKD. GVZ/HH
	O.K. EZ HH
	DATE 11-25-69
	SCALES NONE

LOGIC DIAGRAM
AUXILIARY SALT WATER PUMPS
DIABLO CANYON
DEPARTMENT OF ENGINEERING
PACIFIC GAS AND ELECTRIC COMPANY
SAN FRANCISCO, CALIFORNIA

MICROFILM	4
BILL OF MATL	
DWG LIST	
SUPSDS	
SUPSD BY	
SHEET NO.	19406
SHEETS	4

RASTER=002g1091.dgn
DGN=002g1091.dgn
CAD User: MNRU Date: 10-08-2012

E


D

C

B

A

1 2 3 4 5 6 7 8 9 10

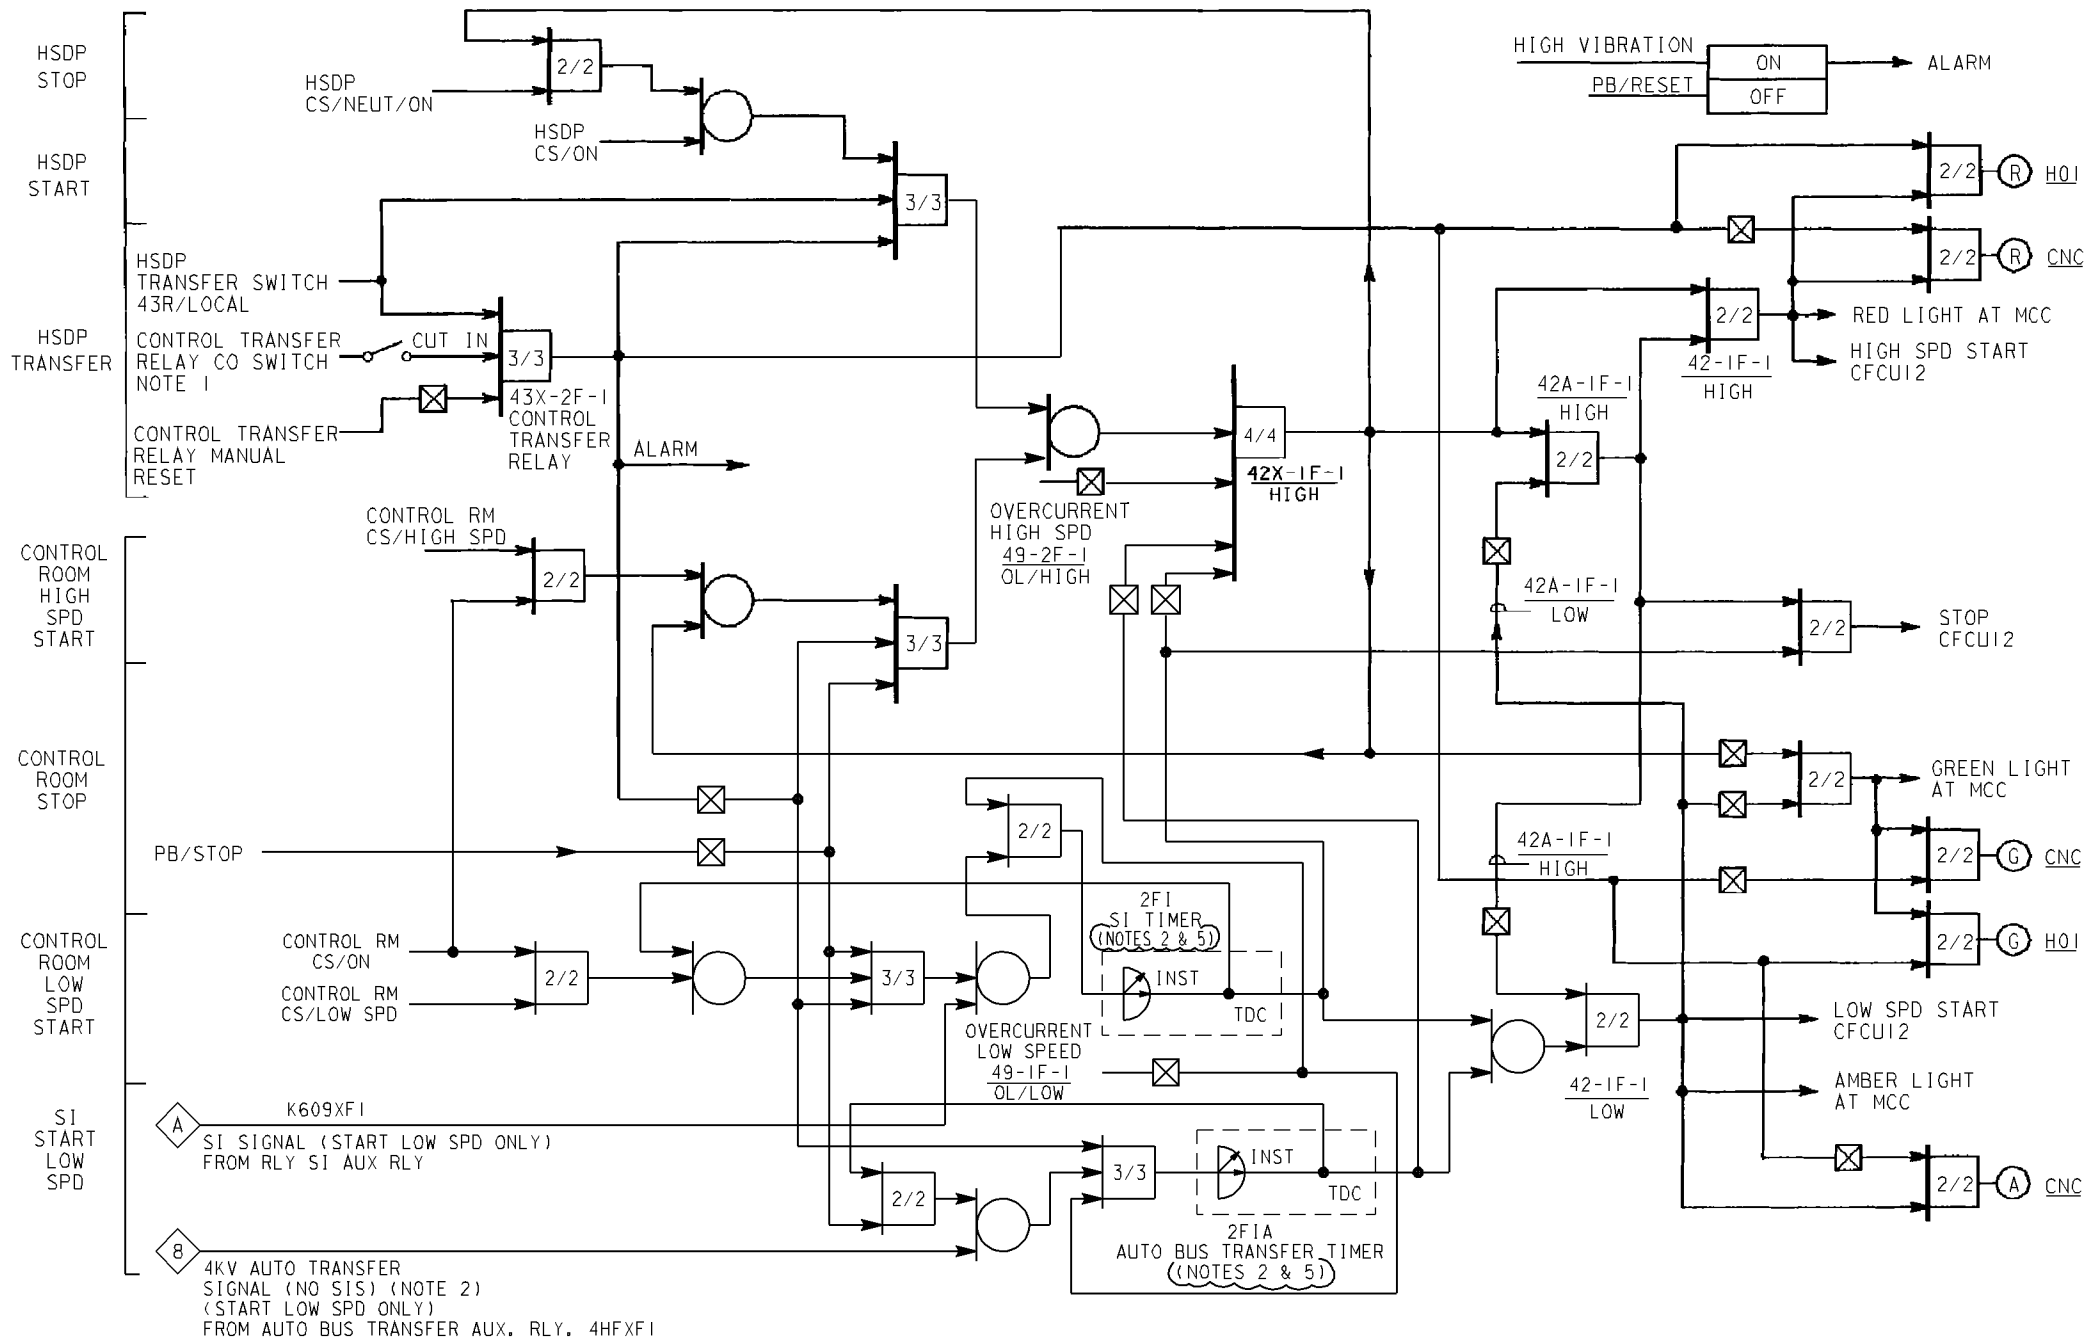

KEY DWG. SECTION 3

NUCLEAR SAFETY RELATED

UNIT 1

DATE 10-08-2012		REVISION DESCRIPTION REVISED PER DDN-2*931		ELECTRICAL LOGIC DIAGRAM CONTAINMENT FAN COOLERS		DWG SCALE:			
D.D.	MNRU					BILL OF MATL:			
R.E.	SMB5					SUPSDS:			
I.V.						SUPSD BY:			
P.E.	AGB2					DRAWING 19407	SHEET 1	PAGE 0	REV 16



INPG
I Size

TABLE A

CFCU DEVICE	DESCRIPTION	SETTING
12 2F1	SI TIMER	REF 2
12 2F1A	AUTO XFR TIMER	REF 2
11 2F2	SI TIMER	REF 2
11 2F2A	AUTO XFR TIMER	REF 2
13 2G1	SI TIMER	REF 3
13 2G1A	AUTO XFR TIMER	REF 3
14 2H1	SI TIMER	REF 4
14 2H1A	AUTO XFR TIMER	REF 4
15 2G2	SI TIMER	REF 3
15 2G2A	AUTO XFR TIMER	REF 3

REFERENCES: DWG NO.
1. LOGIC DIAGRAM SYMBOLS — — — 19425
2. LOGIC DIAG 4KV "F" AUTO XFR — 458863
3. LOGIC DIAG 4KV "G" AUTO XFR — 458864
4. LOGIC DIAG 4KV "H" AUTO XFR — 458865
5. LIST OF ELEC DEVICES FOR PROT & CONTROL — — — — — SAP
6. SCH DIAG FAN COOLERS — — — — — 437600

NOTES:
1. CONTROL TRANSFER RELAY C.O. SWITCH FANS 11, 13 & 14 - NORMALLY CUT IN FANS 12, 15 - NORMALLY CUT OUT ALARM WHEN NOT IN NORMAL POSITION
2. THE PREFIX 2 REFERS TO IEEE DEVICE #2 WHICH IS A TIME DELAY STARTING OR CLOSING RELAY. IT'S NOT REFERING TO UNIT 2
3. DELETED
4. 480V AC IS REQUIRED FOR 120V CONTROL POWER.
5. SINGLE RELAYS HAVE BEEN REPLACED WITH TWO (2) RELAYS. ONE (1) RELAY HAS INSTANTANEOUS CONTACTS AND ONE (1) RELAY HAS THE TIME DELAY CONTACTS. THE LOGIC IS THE SAME.

LEGEND:
43R - TRANSFERS CONTROL FROM CONTROL BOARD TO HOT SHUTDOWN PANEL (HSDP)
◇ - DENOTES INTERCONNECTION TO OTHER LOGIC DIAG. REF 2, 3 & 4

80761


E

D

C

B


A

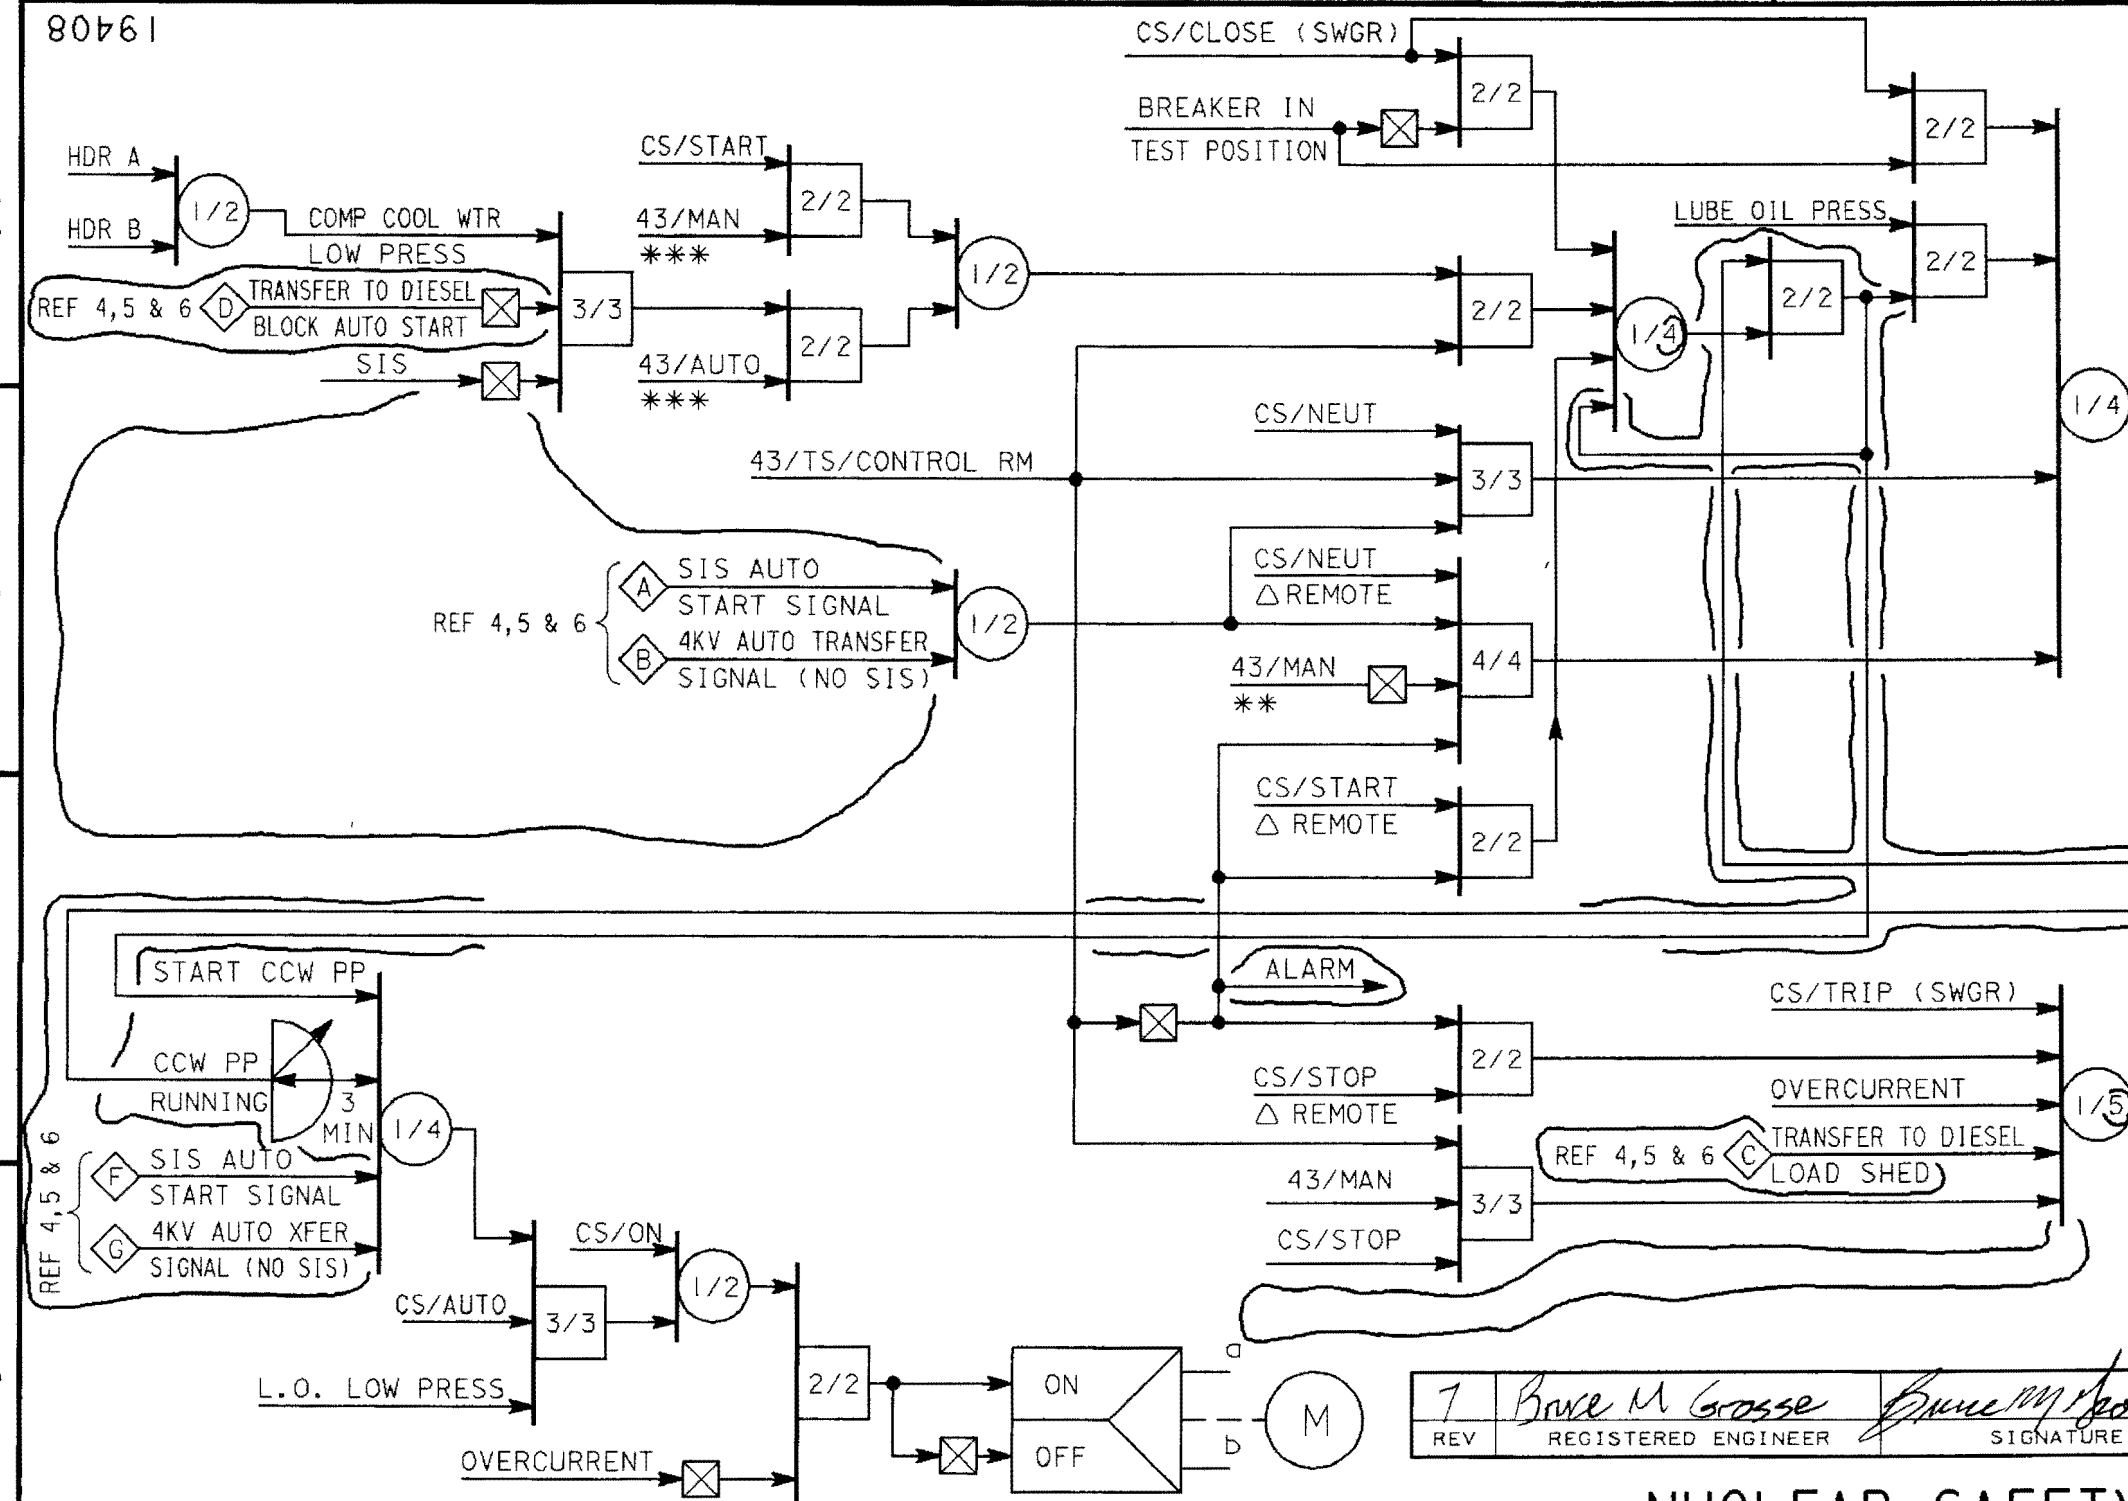

NOTES:

- 43 - MODE SELECTOR SWITCH
 43/TS - TRANSFERS CONTROL FROM MAIN CONT BD TO HOT SHUTDOWN PANEL (LOC AT SWGR)
 Δ - REMOTE CONTROL SWITCH LOCATED ON HOT SHUT DOWN PANEL

- **- MODE SELECTOR SWITCH LOC ON HOT SHUTDOWN PANEL
 *** - SWITCH IS LOCATED IN THE MAIN CONT RM

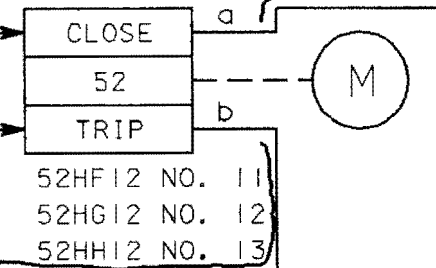

REFERENCES:

- LOGIC DIAGRAM SYMBOLS - 19425
- SCH DIAG COMP CLG WTR - 437593
- SLM&R DIAG 4KV BUS F, G&H - 437533
- LOGIC DIAG 4KV "F" AUTO XFR - 458863
- LOGIC DIAG 4KV "G" AUTO XFR - 458864
- LOGIC DIAG 4KV "H" AUTO XFR - 458865

DWG NO.

7	Brave M Grosse	Signature	19988	9/30/95
REV	REGISTERED ENGINEER	SIGNATURE	CA REG NO.	EXP DATE



COMPONENT COOLING PUMP AUXILIARY LUBE OIL PUMP

52-IF-44 NO. 11
 52-IG-41 NO. 12
 52-IH-35 NO. 13

NUCLEAR SAFETY RELATED

KEY DWG--SECTION 3

UNIT 1

COAST VALLEYS DIVISION

MICROFILM 7

NO.	DATE	DESCRIPTION	GM	DWN.	CHKD.	SUPV.	APVD.
7	2-24-94	REDRAWN; REV LOGIC; ADD REF'S 4, 5 & 6 (FCT-16395)	WAA	VAL	RS	22B	BMF
6	12-1-92	REV AS PER LOGIC DIAGRAM (FCT-14621, DCI-EE-47591, -47593 & -47594)	MS	VAL	DSW		MB

REVISIONS

APPROVED BY	GM 167027
LRW	SUPV. H. HERTING
DN	DSGN. E. ZEITER
JWC	DWN. R. S/F. MOY
TAB	CHKD. E. ZEITER
	O.K. EZ HH
	DATE 11-25-69
	SCALES NONE

LOGIC DIAGRAM
COMPONENT COOLING WATER PUMPS

DIABLO CANYON

DEPARTMENT OF ENGINEERING
 PACIFIC GAS AND ELECTRIC COMPANY
 SAN FRANCISCO, CALIFORNIA

BILL OF MATL	
DWG LIST	
SUPSDS	
SUPSD BY	
SHEET NO.	19408
REV.	7

19408D.E62 02-24-94 WAA

DWG TYPE 7
 DWG SUBJECT 15

DRAWING TITLE LOGIC DIAG CMPNT CLG WTR PPS
 UNIT NO. 1

PROJECT LOCATION DIABLO
 INSTALLATION TYPE L
 DIVISION NAME B
 MISC 53
 DD CODE 55 56
 MAN HOURS 57 59
 CADD 60
 DRAWING SOURCE A
 70

PROJECT LOCATION DIABLO
 INSTALLATION TYPE L
 DIVISION NAME B
 MISC 53
 DD CODE 55 56
 MAN HOURS 57 59
 CADD 60
 DRAWING SOURCE A
 70

60761

AMSAC SYSTEM

LO-LO LEVEL
STEAM GEN NO. 1
LO-LO LEVEL
STEAM GEN NO. 2
LO-LO LEVEL
STEAM GEN NO. 3
LO-LO LEVEL
STEAM GEN NO. 4

FCO
CUT OUT

MAIN TURB
FWP TRIPPED

NO. 11
NO. 12

REF 5 & 6

TRANS TO DSL
BLOCK AUTO START

SIS

REF 5 & 6 A SIS AUTO
START SIGNAL
REF 5 & 6 B 4KV AUTO TRANSFER
SIGNAL (NO SIS)

REFERENCES:

1. LOGIC DIAGRAM SYMBOLS — 19425
2. SCH DIAG AUX FW PP — 437583
3. S/D AUX FW MTR OP VVS — 437507
4. S/D STM GEN BLOWDN SOL VVS — 437685
5. LOGIC DIAG 4KV "F" AUTO TRANS — 458863
6. LOGIC DIAG 4KV "H" AUTO TRANS — 458865

DWG NO.

NOTES:

- 43 - MODE SELECTOR SWITCH FOR SELECTION
BETWEEN "AUTO" & "MANUAL" LOCATED ON
HOT SHUTDOWN PANEL
- 43/TS - TRANSFERS CONTROL FROM MAIN CONT BD
TO SHUTDOWN PANEL LOCATED ON THE SWGR
- Δ - REMOTE CONTROL SWITCH LOCATED ON HOT
SHUTDOWN PANEL

43/TS (CONT RM)

CS/NEUT

43/MAN
Δ REMOTE
CS/NEUT
Δ REMOTE

CS/START
CS/START
Δ REMOTE

CS/STOP
Δ REMOTE
OVERCURRENT

REF 5 & 6 C TRANSFER TO DIESEL
LOAD SHED
CS/TRIP (SWGR)


CS/STOP

3HH8/3HF9 - STEAM GEN
BLOWDOWN VVS

REF 4

CUT-IN, CUT-OUT
SW (CB)

AUX FDW
SUP VLVS
LCV 110
LCV 111
LCV 113
LCV 115
(REF 3)

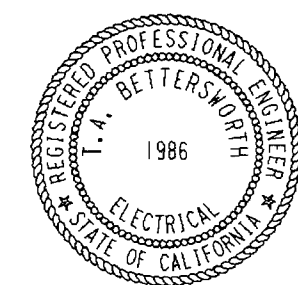

COAST VALLEYS DIVISION

MICROFILM 9

BILL OF MATL

DWG LIST

SUPSDS

SUPSD BY

SHEET NO. SHEETS

19409 9

NUCLEAR SAFETY RELATED

UNIT I

LOGIC DIAGRAM
AUXILIARY FEEDWATER PUMPS

DIABLO CANYON

DEPARTMENT OF ENGINEERING
PACIFIC GAS AND ELECTRIC COMPANY
SAN FRANCISCO, CALIFORNIA

9	M. Basu	11/21/94	C12314	12/31/94
REV	REGISTERED ENGINEER	SIGNATURE	CA REG NO.	EXP DATE

KEY DWG--SECT 3

NO.	DATE	DESCRIPTION	GM	DWN.	CHKD.	SUPV.	APVD.
9	5-5-94	REV 3HH8 TO 3HH8/3HF9 (FCT-17116)	WAA	WY	JAN	MB	WAA
8	1-20-94	REDRAWN; DEL STAR NOTE; ADD REF'S 5 & 6; REV LOGIC (FCT-16395)	WAA	WG	KS	MH/RNT	MB
7	12-1-92	REV AS PER LOGIC DIAGRAM (FCT- 14621) (DCI-EE-47591, -47594)	WAA	MS	VAL	DSW	MB

REVISIONS

APPROVED BY	GM 167027
LRW	SUPV. H. HERTING
DN	DSGN. E. ZEITER
JWC	DWN. R. D. SMITH
TAB	CHKD. EZ
	O.K. GVZ HH
	DATE 11-25-69
	SCALES NONE

19409D.E62 04-27-94 WAA

DWG TYPE 4
SUBJECT 15

DRAWING TITLE
AUXILIARY FEEDWATER PUMPS
UNIT NO. 1

PROJECT LOCATION
DIABLO

INSTALLATION TYPE
L

DIVISION NAME
B

MISC
GD

DD CODE
55 56

MAN HOURS
57 59

CADD
C

DRAWING SOURCE
A

SCAN 9 102800

CAD User:RHS1 Date: 3-02-2001
DGN=19410.DGN

E

D

C

B

A

1

2

3

4

5


6

7

8

9

10

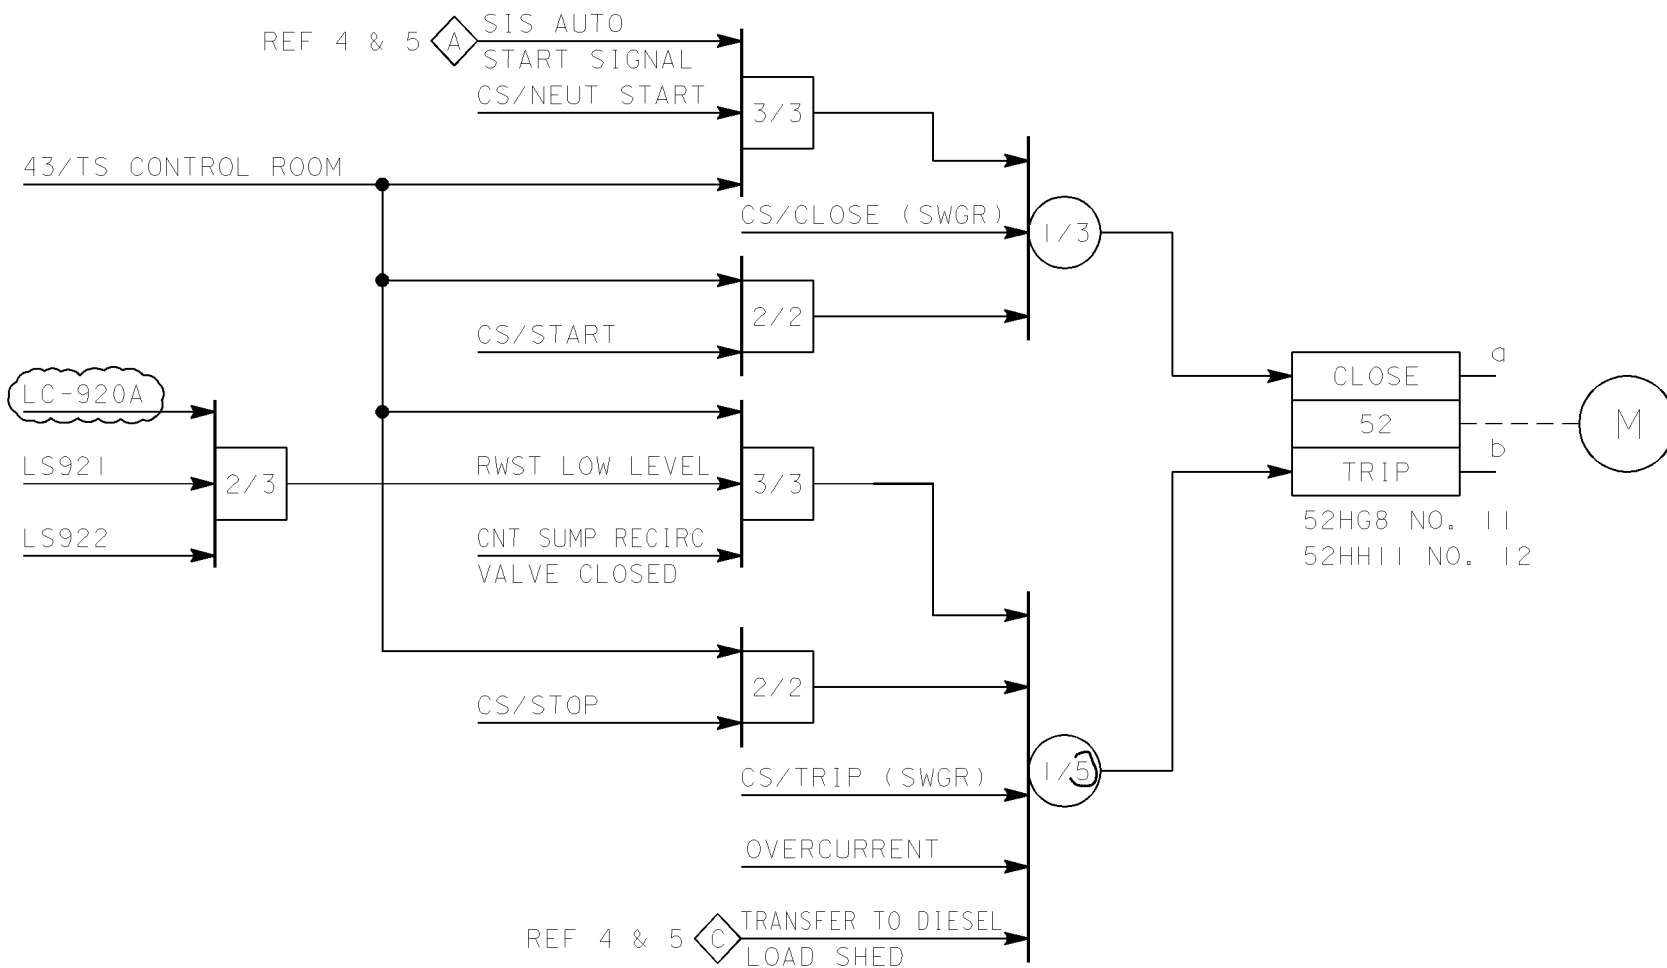

NOTES:

- 43/TS - TRANSFERS CONTROL FROM LOCAL TO CONTROL ROOM. SWITCH IS LOCATED AT THE SWITCHGEAR.

REFERENCES:

- SCH DIAG RES HEAT REM-----437591
- LOGIC DIAGRAM SYMBOLS-----19425
- SLM&R DIAG 4K F,G & H-----437533
- LOGIC DIAG 4KV "G" AUTO TRANS--458864
- LOGIC DIAG 4KV "H" AUTO TRANS--458865

DWG NO.

KEY DWG--SECTION 3


NUCLEAR SAFETY RELATED

UNIT 1

DATE		3/2/01		DESCRIPTION		COORDINATION	
DWN.		RHS1		Revised per FCT 025512		NUCL.	-
R.E.		KJD3				MECH.	-
INDEP. VERIFIER		-				ELEC.	-
						CIVIL	-
P.E.		LAL3				PIPING	-
						I&C	-
REVISION INFORMATION							

LOGIC DIAGRAM
RESIDUAL HEAT REMOVAL PUMPS

DIABLO CANYON POWER PLANT
PACIFIC GAS AND ELECTRIC COMPANY
SAN FRANCISCO, CALIFORNIA

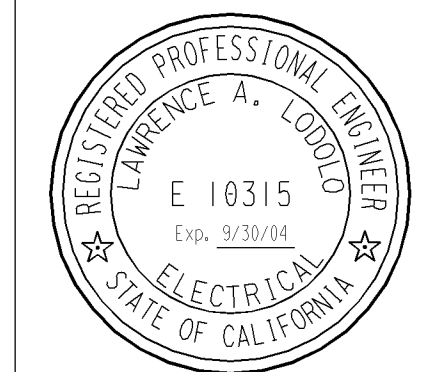

DWG SCALE	
BILL OF MATL	
SUPSDS	
SUPSD BY	
SHEET NO.	OF
19410	8

U#2-102793

1161


E

D


C

B

A

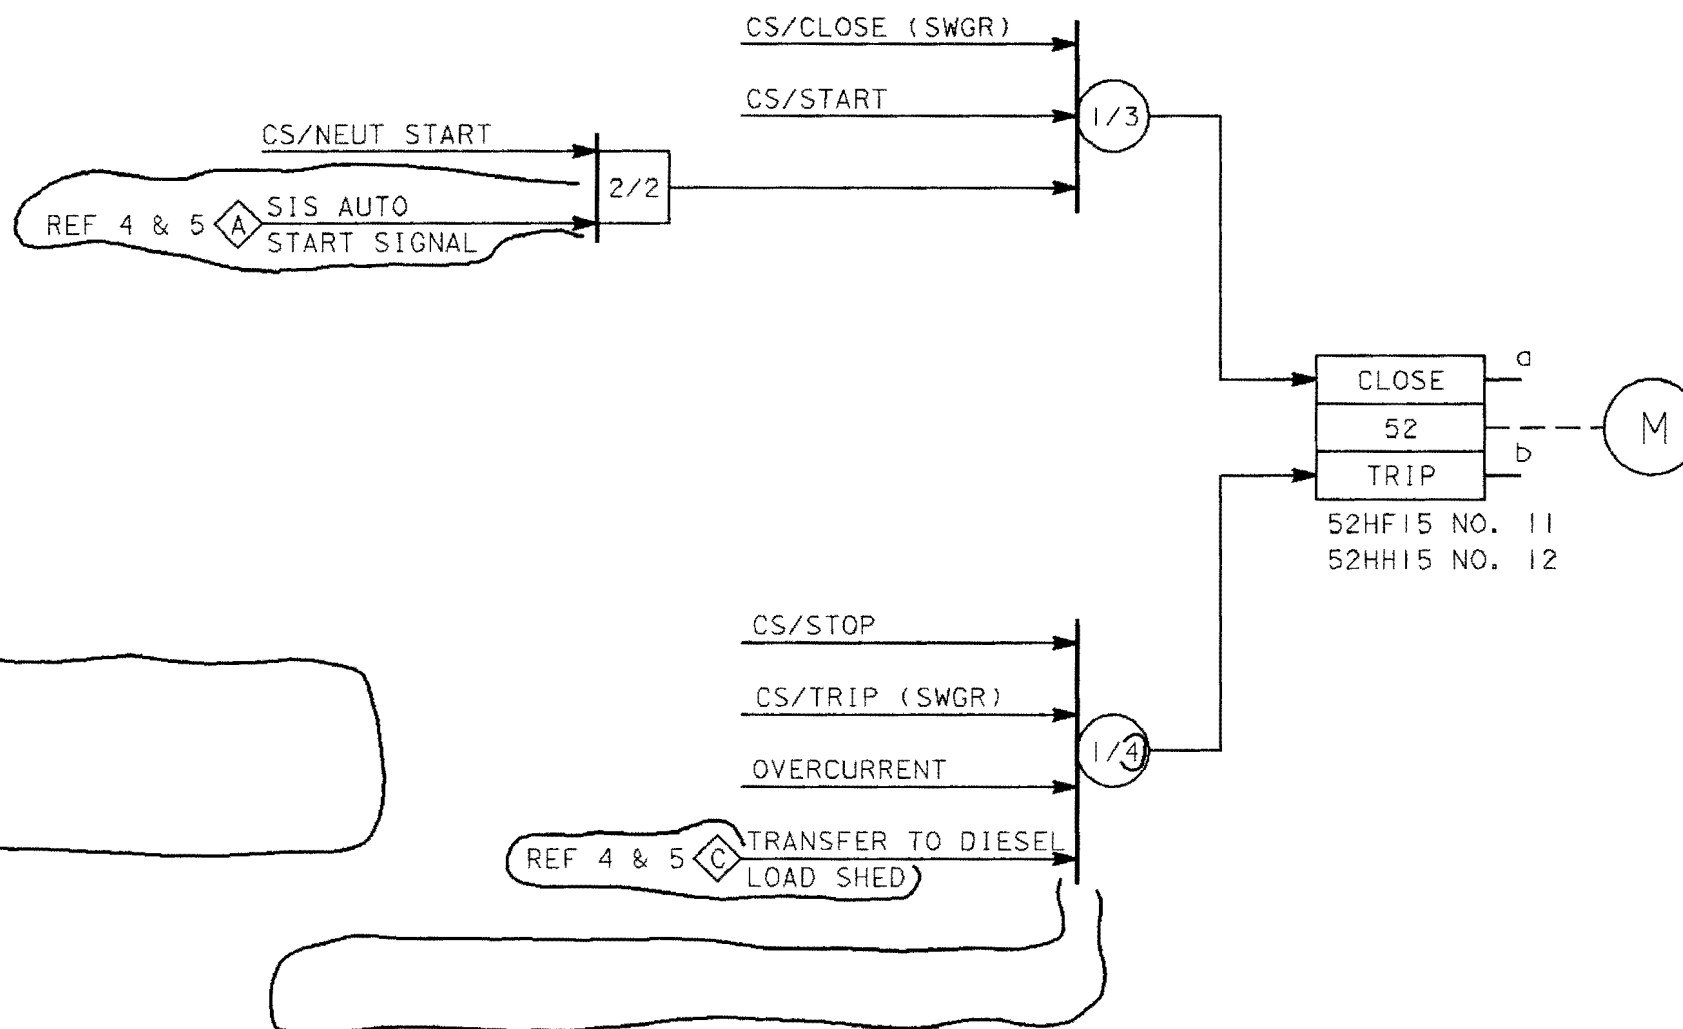

- REFERENCES:**
- | | DWG NO. |
|----------------------------------|---------|
| 1. SCH DIAG SAFETY INJ PP | 437589 |
| 2. SLM&R DIAG 4KV F, G & H | 437533 |
| 3. LOGIC DIAGRAM SYMBOLS | 19425 |
| 4. LOGIC DIAG 4KV "F" AUTO TRANS | 458863 |
| 5. LOGIC DIAG 4KV "H" AUTO TRANS | 458865 |

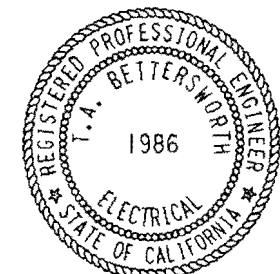

NUCLEAR SAFETY RELATED

4	M. Bann	<i>[Signature]</i>	C12314	12/31/94
REV	REGISTERED ENGINEER	SIGNATURE	CA REG NO.	EXP DATE

KEY DWG--SECT 3
RM INDEXED REV

NO.	DATE	DESCRIPTION	GM	DWN.	CHKD.	SUPV.	APVD.
4	1-14-94	REDRAWN; REV LOGIC; DEL NOTE; ADD REF 4 & 5 (FCT-16395)	WAA	WJ	VL	MA	UP
3	2-16-90	REV NOTE & TIMER SETTING (FCT-10345)	TE	VL	JC	KAW	SLW
2	3-13-73	CHGD TIME SETTING ON TIMERS (E)	167027	EZ		LRW	DN
1	1-12-73	APPROVED FOR CONSTRUCTION	167027	EZ		LRW	DN

REVISIONS

APPROVED BY	GM 167027
LRW	SUPV. H. HERTING
DN	DSGN. E. ZEITER
JWC	DWN. K. P. SCHOLZ
TAB	CHKD. EZ
	O.K. GVZ HH
	DATE 12-4-69
	SCALES NONE

LOGIC DIAGRAM
SAFETY INJECTION PUMPS

DIABLO CANYON
DEPARTMENT OF ENGINEERING
PACIFIC GAS AND ELECTRIC COMPANY
SAN FRANCISCO, CALIFORNIA

SCAN 4 IC
COAST VALLEYS DIVISION
MICROFILM 4


BILL OF MATL	
DWG LIST	
SUPSDS	
SUPSD BY	
SHEET NO.	19411
SHEETS	4
REV.	

19411D.E62 01-11-94 DWL

DWG TYPE	DWG SUBJECT	DRAWING TITLE	UNIT NO.	PROJECT LOCATION	INSTALLATION TYPE	DIVISION NAME	MISC	DD CODE	MAN HOURS	CADD	DRAWING SOURCE
4	15	SAFETY INJECTION PUMPS	1	DIABLO	L	B		GD		C	A

U#2-102794

DWG TYPE 4
SUBJECT CONTAINMENT SPRAY PUMPS
UNIT NO. 2
PROJECT LOCATION DIABLO
INSTALLATION DIVISION TYPE L
MISC CODE B
DD CODE G
MAN HOURS 57
CADD 60
DRAWING SOURCE A 70

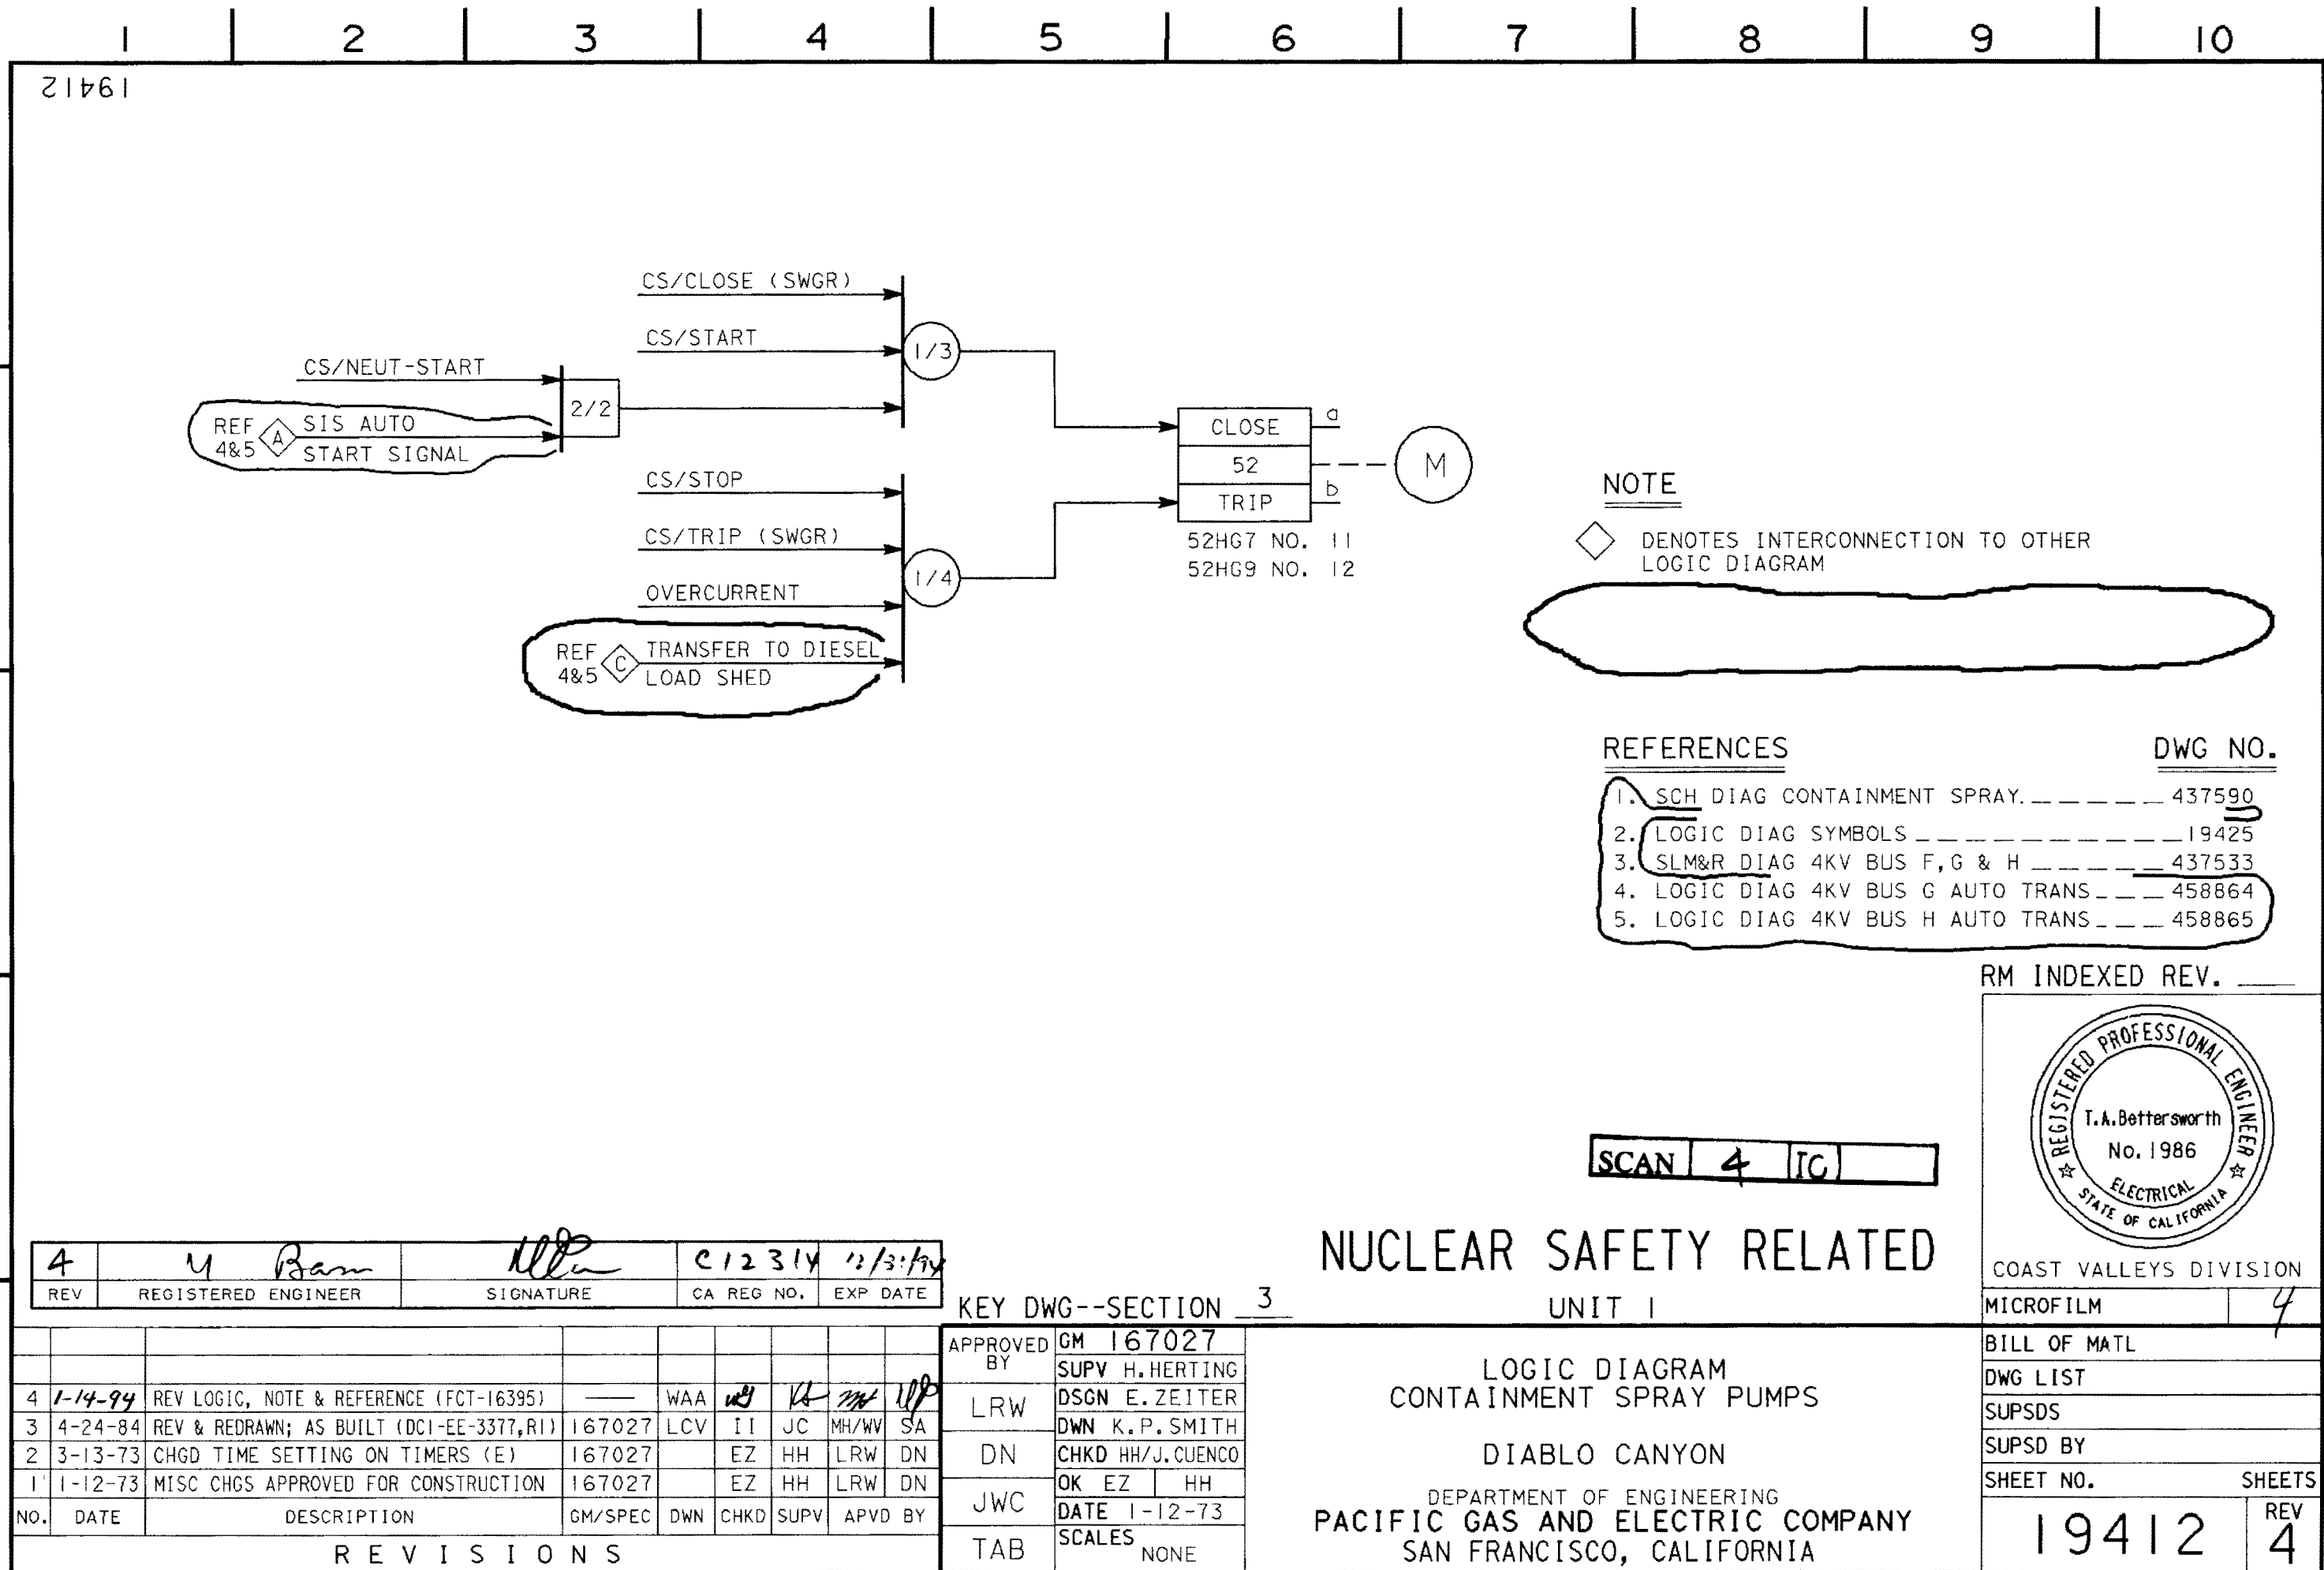

RASTER=19413.dgn
DGN=19413.dgn
CAD User:RXG2 Date:06-11-2007

E

D

C

B

A

1

2

3

4

5


6

7

8

9

10

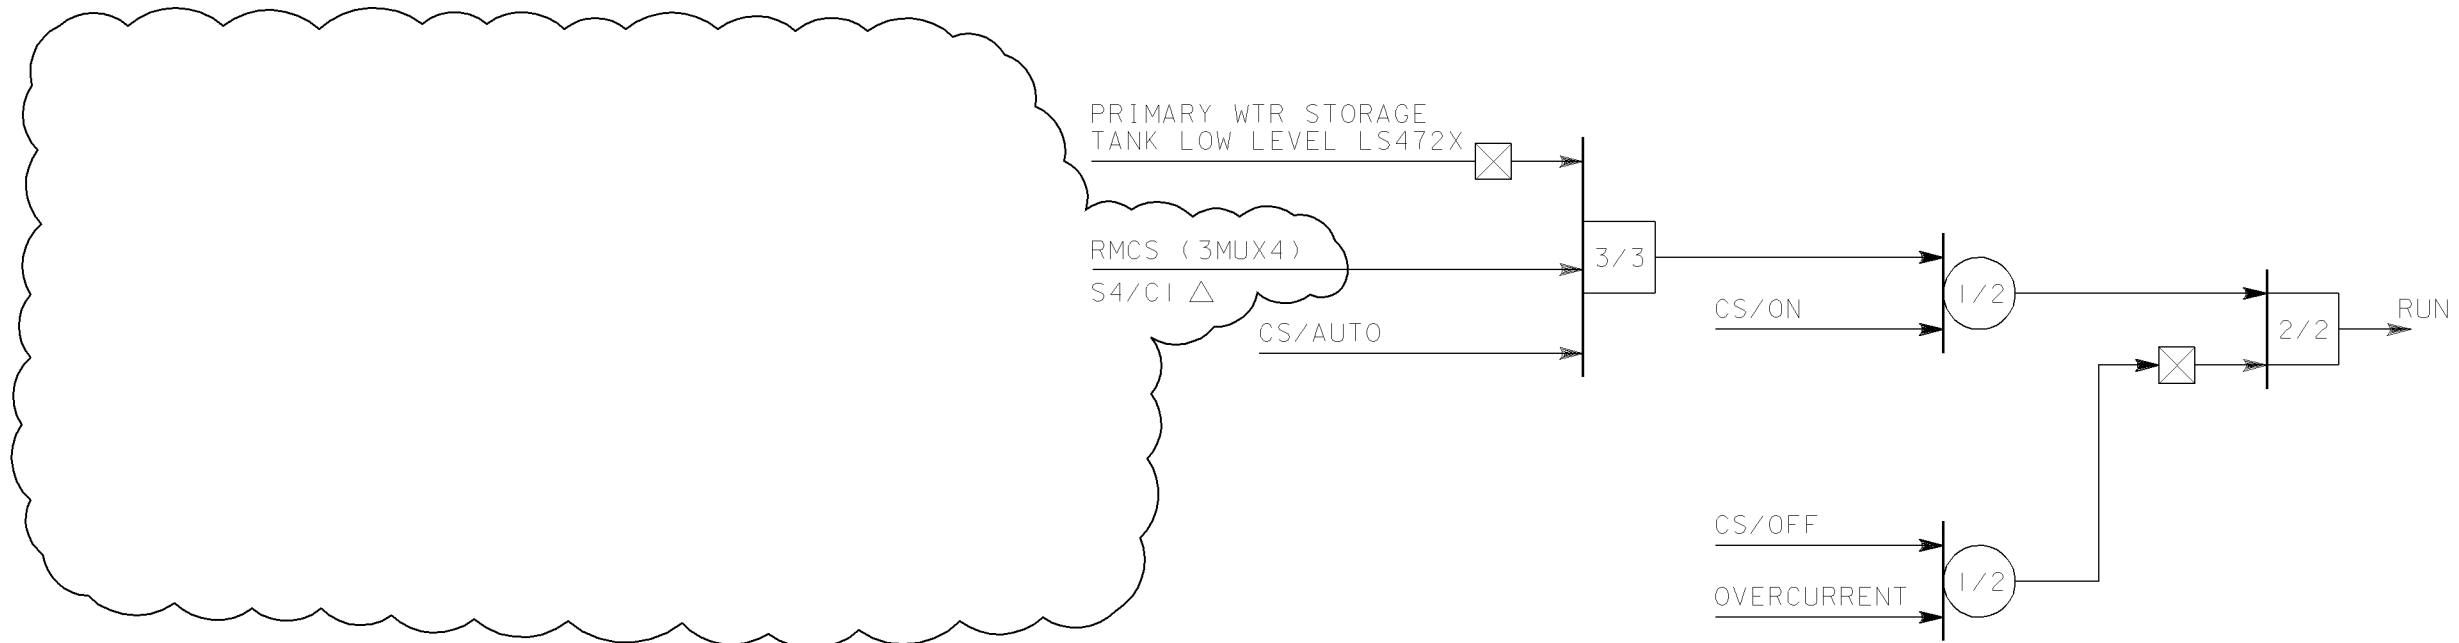

REFERENCE

DWG NO.

1. SCHEM DIAG CHEMICAL & VOLUME CONTROL SYS ----- 437597
2. SCHEM DIAG RC M-U SYS ----- 437596

NOTE

Δ - SIGNAL FROM RMCS-RNARB PLC OUTPUT S4/CI.

KEY DWG. SECTION 3


UNIT 1

NUCLEAR SAFETY RELATED

DATE 06-11-2007			REVISION DESCRIPTION		ELECTRICAL LOGIC DIAGRAM PRIMARY MAKE-UP WATER PUMPS		DWG SCALE:			
			REVISED PER DCI-SE-049779-00				BILL OF MATL:			
D.D.	RxG2						SUPSDS:			
R.E.	FxC2						SUPSD BY:			
I.V.							DRAWING	SHEET	PAGE	REV
P.E.	RWB7					19413		1	0	3
						DIABLO CANYON POWER PLANT PACIFIC GAS AND ELECTRIC COMPANY SAN FRANCISCO, CALIFORNIA				

RASTER=19414.dgn
DGN=19414.dgn
CAD User:RXG2 Date:06-11-2007

E
D
C
B
A

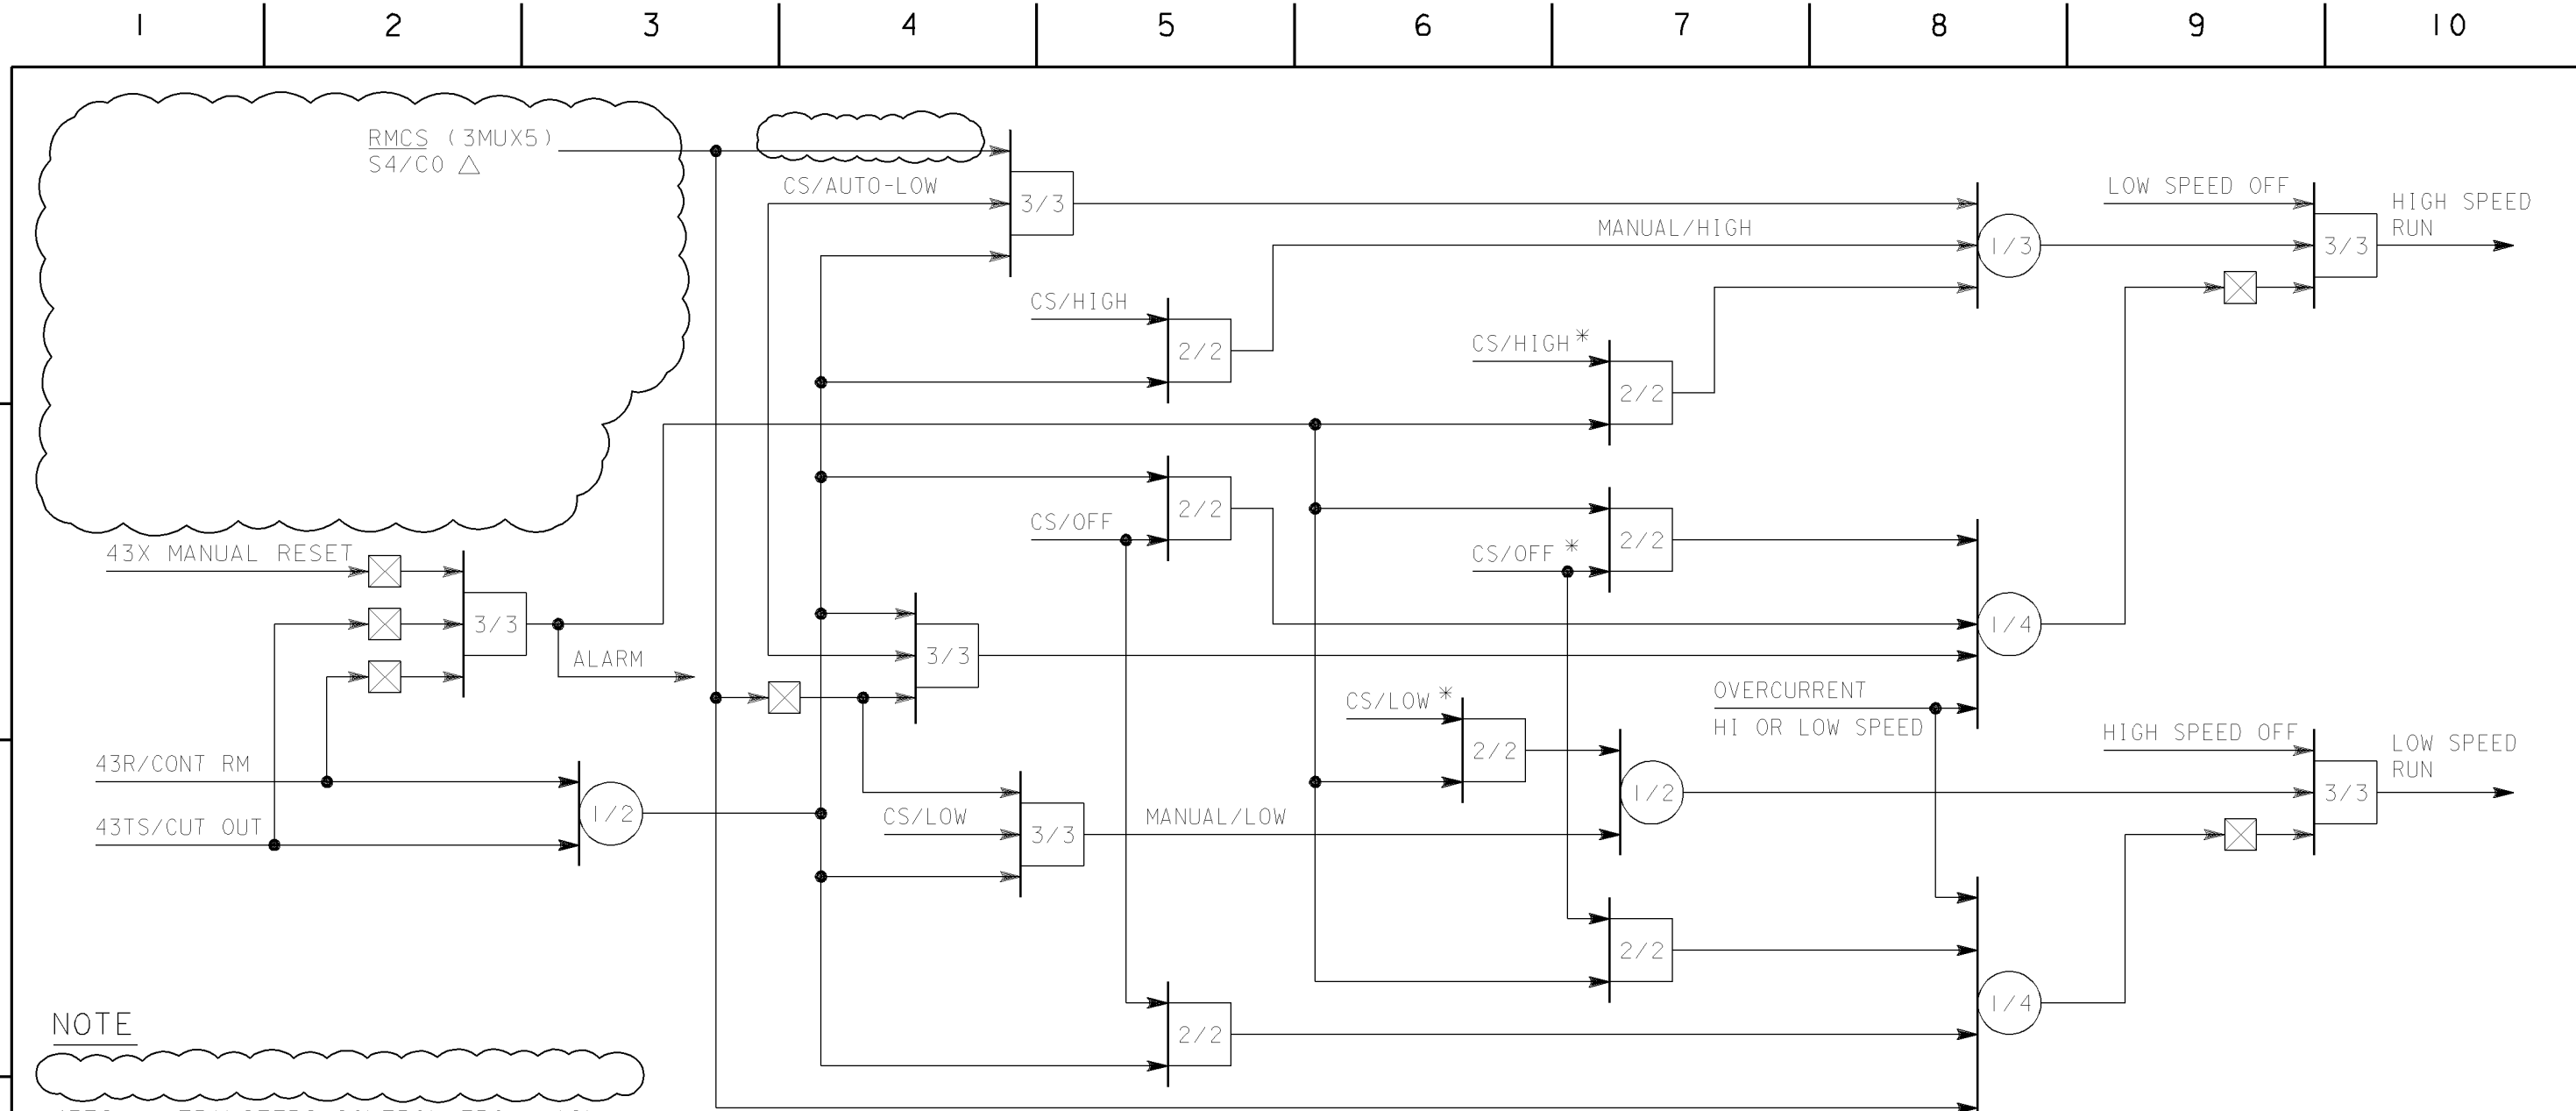

NOTE

43TS - TRANSFERS CONTROL FROM MAIN
OR CONTROL BOARD TO HOT SHUT-
DOWN PANEL (HSP) 43R LOCATED
AT HSP, 43/TS LOCATED AT MCC

* - CS LOCATED AT HOT SHUT DOWN PANEL
△ - SIGNAL FROM RMCS-RNARB PLC OUTPUT
S4/C0.

REFERENCE


1. CHEMICAL & VOLUME CONTROL SYS ____ 437597
2. SCH DIAG RC M-U SYST _____ 437596

DWG NO.

KEY DWG. SECTION 3

NUCLEAR SAFETY RELATED
UNIT 1

DATE 06-11-2007			REVISION DESCRIPTION		ELECTRICAL LOGIC DIAGRAM BORIC ACID TRANSFER PUMPS DIABLO CANYON POWER PLANT PACIFIC GAS AND ELECTRIC COMPANY SAN FRANCISCO, CALIFORNIA	DWG SCALE:			
D.D.	RxG2		REVISED PER DCI-SE-049779-00	BILL OF MATL:					
R.E.	FxC2			SUPSDS:					
I.V.				SUPSD BY:					
P.E.	RWB7			DRAWING 19414		SHEET 1	PAGE 0	REV 3	

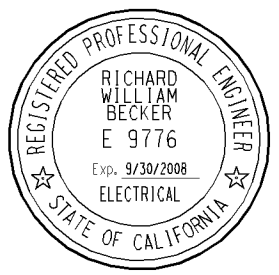

52661


LOGIC SYMBOLS

DEVICE FUNCTION NUMBERS AND LETTERS

SYMBOL	FUNCTION	DEFINITION
	AND	A CONTROL FUNCTION WHICH PRODUCES AN OUTPUT WHEN EVERY INPUT SIGNAL IS APPLIED.
	OR	A CONTROL FUNCTION WHICH PRODUCES AN OUTPUT ONLY WHEN ONE (OR MORE) INPUT SIGNAL IS APPLIED.
	NOT	A CONTROL FUNCTION WHICH PRODUCES AN OUTPUT ONLY WHEN NO INPUT SIGNAL IS APPLIED.
	OFF RETURN MEMORY	A CONTROL FUNCTION WHICH RETAINS THE CONDITION OF OUTPUT CORRESPONDING TO THE INPUT LAST APPLIED EXCEPT UPON INTERRUPTION OF POWER IT RETURNS TO THE OFF CONDITION.
	RETENTIVE MEMORY	A CONTROL FUNCTION WHICH RETAINS THE CONDITION OF OUTPUT CORRESPONDING TO THE INPUT LAST APPLIED EVEN WITH A POWER FAILURE.
		DENOTE INTERCONNECTION TO OTHER LOGIC
	ADJUSTABLE TIME DELAY ENERGIZING	A CONTROL FUNCTION WHICH PRODUCES AN OUTPUT FOLLOWING DEFINITIVE INTENTIONAL TIME DELAY AFTER ITS INPUT SIGNAL IS APPLIED. (EXAMPLE SHOWS 0 TO 30 SECONDS ADJUSTABLE TIME DELAY ENERGIZING.)
	ADJUSTABLE TIME DELAY DE-ENERGIZING	A CONTROL FUNCTION WHOSE OUTPUT IS DE-ENERGIZED FOLLOWING A DEFINITIVE INTENTIONAL TIME DELAY AFTER ITS INPUT SIGNAL IS REMOVED. (EXAMPLE SHOW 0 TO 30 SECONDS ADJUSTABLE TIME DELAY DE-ENERGIZING.)
	COINCIDENCE (2 OUT OF 3 SHOWN)	A CONTROL FUNCTION WHICH PRODUCES AN OUTPUT ONLY WHEN THE PRESCRIBED NUMBER OF INPUT SIGNALS IS APPLIED. (FOR EXAMPLE SHOWN, ANY 2 INPUT SIGNALS ARE REQUIRED FOR AN OUTPUT.)
	CIRCUIT BREAKER	A MECHANICAL SWITCHING DEVICE WHICH RETAINS THE CONDITION OF OUTPUT CORRESPONDING TO THE INPUT LAST APPLIED, AND APPLIES ELECTRICAL POWER TO AN ACTUATING DEVICE. THIS BREAKER IS ALSO TRIP FREE, AND WILL NOT "PUJP" (SEE NOTE 1).

Q	OUTPUT PRESENT WHEN CIRCUIT BREAKER IS CLOSED
D	OUTPUT PRESENT WHEN CIRCUIT BREAKER IS OPEN
CS	CONTROL SWITCH
SIS	SAFETY INJECTION SIGNAL
43	AUTOMATIC - MANUAL TRANSFER SWITCH
43MU	MAKE - UP MODE SELECTOR SWITCH
43R OR 43/TS	TRANSFER SWITCH USED TO TRANSFER CONTROL FROM THE MAIN CONTROL ROOM TO THE HOT SHUTDOWN PANEL. SWITCH IS LOCATED ON THE HOT SHUTDOWN PANEL OR SWITCHGEAR.
42-F-2	MOTOR STARTER 480V BUS SECTION F BREAKER NO.2
52-F-2	CIRCUIT BREAKER 480V BUS SECTION F BREAKER NO.2
52-G6	CIRCUIT BREAKER 4KV BUS SECTION G BREAKER NO.6
52VD6	CIRCUIT BREAKER 2KV BUS SECTION D BREAKER NO.6
(SV), (CV)	LETTERS IN PARENTHESES INDICATE THE TYPE OF ELECTRICAL RELAY
CS/OPEN OR 43/LOCAL	DESIGNATION ABOVE THE LINE DENOTES DEVICE, DESIGNATION BELOW THE LINE DESIGNATES THE SIGNAL INFORMATION OR POSITION.

RM INDEXED REV. 3

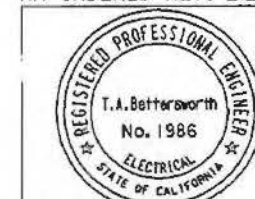

COAST VALLEYS DIVISION

MICROFILM 3

BILL OF MATL

DWG LIST 050052

SUPSDS

SUPSD BY

SHEET NO. SHEETS

19425

REV 3

KEY DWG--SECTION 3

UNITS 1 & 2

APPROVED BY	GM 167027
JEH	SUPV H. WERTING
DN	OSGN E. ZEITER
JWC	DWN E.Z.
TAB	CHKD
	OK SVZ FH
	DATE 2-17-70
	SCALES NONE

LOGIC DIAGRAM SYMBOLS

DIABLO CANYON

DEPARTMENT OF ENGINEERING

PACIFIC GAS AND ELECTRIC COMPANY

SAN FRANCISCO, CALIFORNIA

REVISIONS

19425D.E59 05-21-93 DWL

3 6-4-93 REDRAWN; APPLIED DWG TO UNITS 1 & 2

(DC2-EE-48591) (DC2-EE-48593)

(DC2-EE-48594) (FCT-15279)

1 5-29-71 APPROVED FOR CONSTR

167027

EZ

JEH

NO.

DATE

DESCRIPTION

GM/SPEC

DWN

CHKD

SUPV

APVD BY

DRAWING SYMBOLS

LOGIC SYMBOLS

DIAGRAM SYMBOLS

UNIT NO.

16 17 18 100

VALVE SYMBOLS

EQUIPMENT SYMBOLS

INSTRUMENT SYMBOLS

LINE CODING

VENT, DRAIN, TELL TALE
SYSTEM IDENTIFICATION

PGE & COMMON (NOTE 7)

TITLE

WESTINGHOUSE

PGE & COMMON (NOTE 7)

TITLE

WESTINGHOUSE

COMMON (NOTE 7)

TITLE

COMMON (NOTE 7)

TITLE

NON-CONTROLLED (MANUAL)
SEE VALVE SPEC. - DWG. 049020
ADDITIONAL VALVE DESCRIPTION
SERIES NO.
PRESSURE RATING
TYPE
SIZE (SHOWN ONLY IF DIFF. FROM LINE SIZE)
FOR TUBING VALVE IDENTIFICATION SEE DWG 053479

VALVE TYPE
VALVE SIZE
(SPECIFIED ON VALVE
REFERENCE GUIDE) DC-663219-30
ITEM NO. SEE DWG. 102039 (ALTERNATE SPEC)

MODULATING VALVE
NORMALLY CLOSED VALVE (ON-OFF)
NORMALLY OPEN VALVE (ON-OFF)
THROTTLED VALVE (MANUAL)
EXCESS FLOW CHECK VALVE

USES THE VALVE TYPE DESIGNATION SHOWN BELOW

GATE VALVE
GATE VALVE (DOUBLE DISC)
NEEDLE VALVE

GLOBE VALVE
BALL VALVE
DIAPHRAGM VALVE
BUTTERFLY VALVE
THREWAY VALVE

CHECK VALVE
CHECK VALVE WITH OPERATOR
DAMPER

SEE ABBREVIATION
AIR OPERATOR

AIR OPERATOR
(WITH POSITIONER)

INSTRUMENT ACTUATED
OPERATOR WITH VALVE
POSITIONER

PROCESS ACTUATED OPERATOR
VALVE WITH VALVE POSITIONER

PROCESS ACTUATED VALVE OPERATOR
WITH PILOT (DOWNSTREAM BLEED)

DOUBLE DISC GATE VALVE WITH
THERMAL RELIEF CONNECTION

ELECTRIC SOLENOID OPERATOR

ELECTRIC MOTOR OPERATOR

MANUAL REGULATOR OR
SELF CONTAINED REGULATOR

PRESSURE REDUCING REGULATOR
WITH EXTERNAL PRESSURE TAP

RUPTURE DISC

RELIEF VALVE

VACUUM BREAKER

STEM LEAKOFF
ANGLE VALVE

EXTENSION STEM
OPERATOR THRU WALL PENETRATION

HEAT EXCHANGER
(ANY TYPE)

HEAT EXCHANGER
(ALTERNATE)

FLOW STRAIGHTENING
VANE

PULSATION DAMPENER

POSITIVE DISPLACEMENT
PUMP
BLENDER

CENTRIFUGAL PUMP

SMALL CANNED MOTOR PUMP

FAN, BLOWER OR
COMPRESSOR

JOHNSON SCREEN

MIXER

EJECTOR, EDUCTOR

RESTRICTING
ORIFICE

FLOW PRIMARY
ELEMENT

STEAM TRAP (SEE DWG.
049063 FOR DETAILS)

FILTER

STRAINER
(NUMBER IS NOT NEEDED
FOR START-UP STRAINER)

CONICAL STRAINER
(FOR START-UP ONLY)

EXPANSION JOINT

FLEXIBLE CONNECTION

FLEXIBLE HOSE

DISCONNECT COUPLING

BLIND PIPE END (PLUG OR CAP)

BLIND FLANGE

FIRE HOSE CONNECTION

NOZZLE TERMINAL
(SIZE SHOWN ONLY IF DIFF.
FROM PIPE)

MFR. NOZZLE IDENTIFICATION
(IF AVAILABLE)

REDUCER

FLANGE CONNECTION
(PIPING OR EQUIPMENT)

HEATER
(STEAM OR ELECTRICAL)

LOOP SEAL (TRAP)

SPRAY NOZZLES

SPARGER
(INSIDE VESSEL)

SPECTACLE FLANGE

THERMAL SLEEVE

INSTRUMENT NO IDENTIFICATION BALLOON
(SEE TABLE BELOW)
INSTRUMENT SCHEMATIC REFERENCE -
USED FOR ALL MULTIPLE DEVICE
INSTRUMENT LOOPS

INSTRUMENT NO.
(W) COMPUTER INPUT NO

MECHANICAL PANEL NO.
(SEE DWG. 101904)

INST. FUNCTION - SEE LISTING BELOW
(USED FOR SINGLE DEVICE INSTRUMENT
ONLY)

DEVELOPMENT OF TAG NO. DESIGNATION (SEE ALSO SPECIAL TAGS)

INSTRUMENT FUNCTION (ATTACHED TO PIPE ONLY)

PROCESS VARIABLE	ANALYSIS	FLOW	LEVEL	NUCLEAR	PRESSURE	RADIATION	TEMPERATURE	POSITION	MISC. (VIBRATION SW. SPEED CONTROL, ETC.)
16	AN	F	L	N	P	R	TW	PD	Y
	AN	FCV	LCV	N	PCV	RCV	T	PO	YCV
	ANI	FI	LI	NI	PI	RI	TE	POI	YI
	CEL	FE	LS	NE	PS	RS	TS	POS	YS
	ANS	FIS	LIS	-	PIS	RIS	TIS	-	YIS
	ANX	FX	LX	-	PX	RX	TX	-	YX
	ANT	FT	LT	-	PT	RT	TT	-	YT
	-	FC	LC	NC	PC	RC	TC	-	YC
	-	FIC	LIC	NIC	PIC	RIC	TIC	-	YIC

PROCESS VARIABLE	ANALYSIS	FLOW	LEVEL	NUCLEAR	PRESSURE	RADIATION	TEMPERATURE	POSITION	MISC. (VIBRATION SW. SPEED CONTROL, ETC.)
16	AN	F	L	N	P	R	TW	PD	Y
	AN	FCV	LCV	N	PCV	RCV	T	PO	YCV
	ANI	FI	LI	NI	PI	RI	TE	POI	YI
	CEL	FE	LS	NE	PS	RS	TS	POS	YS
	ANS	FIS	LIS	-	PIS	RIS	TIS	-	YIS
	ANX	FX	LX	-	PX	RX	TX	-	YX
	ANT	FT	LT	-	PT	RT	TT	-	YT
	-	FC	LC	NC	PC	RC	TC	-	YC
	-	FIC	LIC	NIC	PIC	RIC	TIC	-	YIC

POSITIONER
TI - USED FOR THERMOCOUPLE ELEMENT ALSO
OTE - USED FOR RTD ELEMENT ONLY

INST. FUNCTION LEGEND

APS-AUTOMATIC PUMP START/STOP
HIA-HIGH ALARM
LOA-LOW ALARM
INT-INTERLOCK
TST-TEST
HLA-HIGH/LOW ALARM

SPECIAL TAG:

RV-RELIEF VALVE
SC-SAMPLE COOLER
SV-SOLENOID VALVE
STR-STRAINER
TRP-TRAP
HCV-HAND CONTROL
VALVE
RTD-RESISTANCE
TEMPERATURE
DETECTOR
FY-SAMPLE PUMP

GENERAL NOTES:

- FOR UNIT LINE NO. SEE LINE DESIGNATION (102040)
- SEE INDIVIDUAL SCHEMATIC FOR SPECIAL SYMBOLS NOT SHOWN ON THIS LEGEND.
- ON VENTS AND DRAINS WHERE A DOUBLE BARRIER IS REQUIRED REFER TO DWG. 049066 NOTE 4.

DC-663211-16

SHEET NUMBER
RECORD NUMBER

- ALL VALVES SHOWN TO HAVE LEAKOFF CONNECTIONS SHALL BE PERMANENTLY PIPED TO THE APPROPRIATE DRAIN POINT. ALL OTHER VALVES WITH LEAKOFF WILL HAVE LEAKOFF CONNECTIONS CAPPED.

- SUPPLIED WITH ASSOCIATED EQUIPMENT.
(SEE PIPING SCHEMATIC FOR SPECIFIC INFO.)

- INDICATES PIPE NOT SUPPLIED BY KELLOGG
(8711) OR SCOTT (8831) (SEE PIPING SCHEMATIC
FOR SPECIFIC INFORMATION)

- COMMON-INDICATES THAT SAME SYMBOL IS USED FOR (W)
OR PG&E (30-E)

INSULATION SPECIFICATION (101905)
LINE SIZE (INCHES)
LINE NO. (OMITTED FOR <2-1/2" SHORT RUN)
PIPING SPECIFICATION (049021)

ALTERNATE

INSULATING FLANGE (SEE DWG. 065645)

MAIN FLOW LINES

SECONDARY FLOW LINES

INSTRUMENT LINES (PROCESS)

MAIN HEADER (AIR)

BELLOWS SENSOR
FILLED SEALED SYSTEM
(CAPILLARY)

INDICATES CHANGE OF LINE SPEC.
SIZE OR NO. AND EQUIP. BOUNDARY

PIPE PENETRATION NO.
INSIDE CONTAINMENT
OUTSIDE CONTAINMENT

CHANGE OF PIPING SPEC.

SHIELD WALL PENETRATION

CHANGE OF PG&E CLASS

HEAT TRACING AND BOUNDARY

PG & E CODE CLASS	APPLICABLE CODES * *	DESIGN CLASS	SEISMIC CLASSIFICATION
A	DESIGN - B31.1, FABRICATION, ERECT, NDE - B31.7 CLASS I	I	I
B	DESIGN, FABRICATION, ERECTION, NDE - B31.7 CLASS II	II	II
C	DESIGN, FABRICATION, ERECTION, NDE - B31.7 CLASS III	III	III
D	DESIGN, FABRICATION, ERECTION NDE-B31.7 CLASS IIIFOR NEW WORK DESIGN, FABRICATION, ERECTION NDE, B31.7 FOR WORK PERFORMED PRIOR TO UPGRADE	I	I
E	DESIGN, FABRICATION, ERECTION NDE-B31.1	II	NON I
F	PIPING DESIGN, NDE; FABRICATION & ERECTION, ANSI 31.1 - 1967 WITH ADDENDA & SHALL BE SEISMICALLY QUALIFIED FOR DESIGN EARTHQUAKE (DE) CONDITION	II	NON I (DE)
G	NFPA AND ALSO COMPLIES WITH B31.1 *	II	I
GI	NFPA STANDARDS *	II	NON I
H	PIPING DESIGN, NDE; FABRICATION AND ERECTION, ANSI 31.1-1967 WITH ADDENDA	II	NON I
J	ORIGINAL INSTALLATION-PGE CODE CLASS I, DESIGN CLASS I (ANSI B31.7 CLASS II, 1969 EDITION PLUS 1970 ADDENDA) FOR REPAIR, REPLACEMENT OR NEW CONSTRUCTION	I	I

* 10CFR50 APPENDIX B OR ALTERNATE QUALITY ASSURANCE
PROGRAM APPLICABLE TO THESE CODE CLASSES.

* REFER TO PG&E SPECIFICATION 8707 AND 8711
TO DETERMINE THE PIPING CODES AND STANDARDS APPLICABLE
TO A PARTICULAR PG&E CODE CLASS, NOT LISTED ABOVE.

- SYMBOLS USED ON THIS SHEET EXTRACTED FROM
DC-663200-10.

EQUIPMENT NUMBERING:

0-1 - FOR UNITS 1 & 2 (COMMON)
1-1 - FOR UNIT 1 ONLY
2-1 - FOR UNIT 2 ONLY

EQUIPMENT NUMBER
UNIT NUMBER

REFERENCE BLOCK COMMON (NOTE 7)

PIPING OR INSTR.
SCHEM. "FLAG"
DWG. NO. (LAST TWO DIGITS)
NO. OMITTED FOR THE SAME DWG
DWG. COORDINATE (SIDE)
DWG. COORDINATE (TOP)

ALTERNATE

ABBREVIATION & DESCRIPTION

NFPA NATIONAL FIRE PROTECTION ASSOCIATION
RWST REFUELING WATER STORAGE TANK
SRST SPENT RESIN STORAGE TANK
PRT PRESSURIZER RELIEF TANK
PRL PRESSURE RELIEF LINE
ATM ATMOSPHERE
PW PRIMARY WATER
FAI FAIL AS IS
FC FAIL CLOSED
FO FAIL OPEN
SC SEALED CLOSED
SO SEALED OPEN
DH DRAIN HEADER
GA GAS ANALYZER

HT HOLD-UP TANK (LIQUID)
NO NORMALLY OPEN
NC NORMALLY CLOSED
ECC EMERGENCY COOLING CONNECTION
PP PUMP
VH VENT HEADER
DW DEMINERALIZED WATER
D LOCAL DRAIN
V VENT TO ATMOSPHERE
N₂ NITROGEN
H₂ HYDROGEN
T CONTAINMENT ISOLATION SIGNAL (PHASE A)
S SAFETY INJECTION SIGNAL
P CONTAINMENT SPRAY SIGNAL &
CONTAINMENT ISOLATION SIGNAL
(PHASE B)

RCOT REACTOR COOLANT DRAIN TANK
IMB INSIDE MISSILE BARRIER
OMB OUTSIDE MISSILE BARRIER
RR REACH ROD
PG INDICATE PG&E SCOPE WITH A (W) SYSTEM
WM WALL MOUNTED

(W) WESTINGHOUSE ELECTRIC CO.

* SUPPLIED WITH ASSOCIATED EQUIPMENT.

M MAIN STEAM ISOLATION SIGNAL

DR DESIGN REQUIREMENT. SEE
SYSTEM PCM (DESIGN CRITERIA
MEMORANDUM) FOR DESIGN
REQUIREMENTS/LIMITATIONS.

UNIT 1


P G & E CO.

SHEET 3 PAGE 0

102001

REV.

18

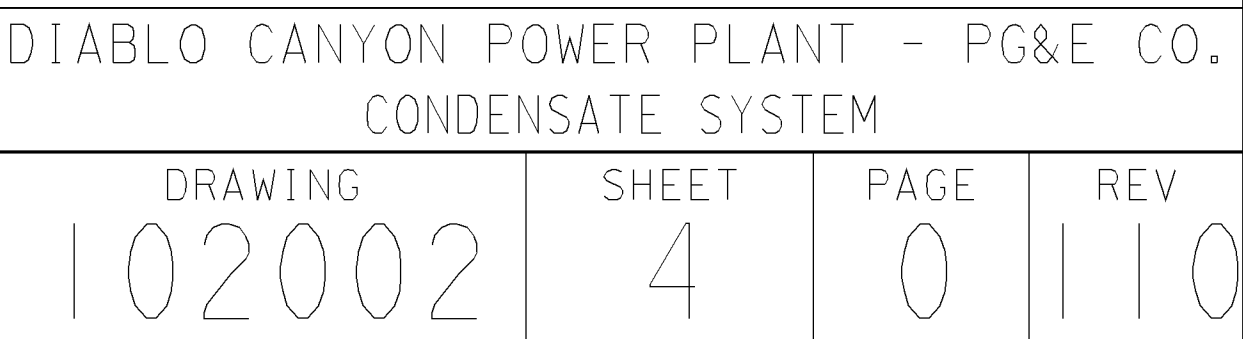

RASTER=2002sb.dgn
DCN=2002sb.dgn
CAD User: MIBF Date: 12-19-2005

NOTES

1. ALL PIPING ON THIS SHEET ARE CODE CLASS E UNLESS OTHERWISE NOTED
2. STRAINER 3 - 2½" YARWAY, MODEL NO. M821 E
3. ⅛" HOLE IN PUMP DISCHARGE PIPE (18" ABOVE PUMP CASING) AND VENT VALVE BOTH PROVIDED FOR VENTING SUMP PUMP AND PREVENTING PUMP VAPOR BINDING E

GLAND STEAM CONDENSER

DC-663283-6

CONDENSER VACUUM PUMPS

DC-663044-1

WATER TRAP SILENCER

MAIN CONDENSER

INTERCONDENSER

AFTERCONDENSER

SLUDGE POT

STEAM JET AIR EJECTOR 1-1

DC-663041-9

DIABLO CANYON POWER PLANT - PG&E CO.

DRAWING	SHEET	PAGE	REV
102002	6	0	105

12-19-2005	MIBF	KJD3		FRANCIS C. LING	MECHANICAL	M 16098	12/31/2005	REVISED PER FCT-030760
DATE	DWN	RE	1V	PROFESSIONAL ENGINEER	PE DISC.	PE#	PE EXP.	

102

70

71

72

73

74

75

76

77

78

79

A

B

C

D

E

A


B

C

D

E

FEEDWATER HEATERS

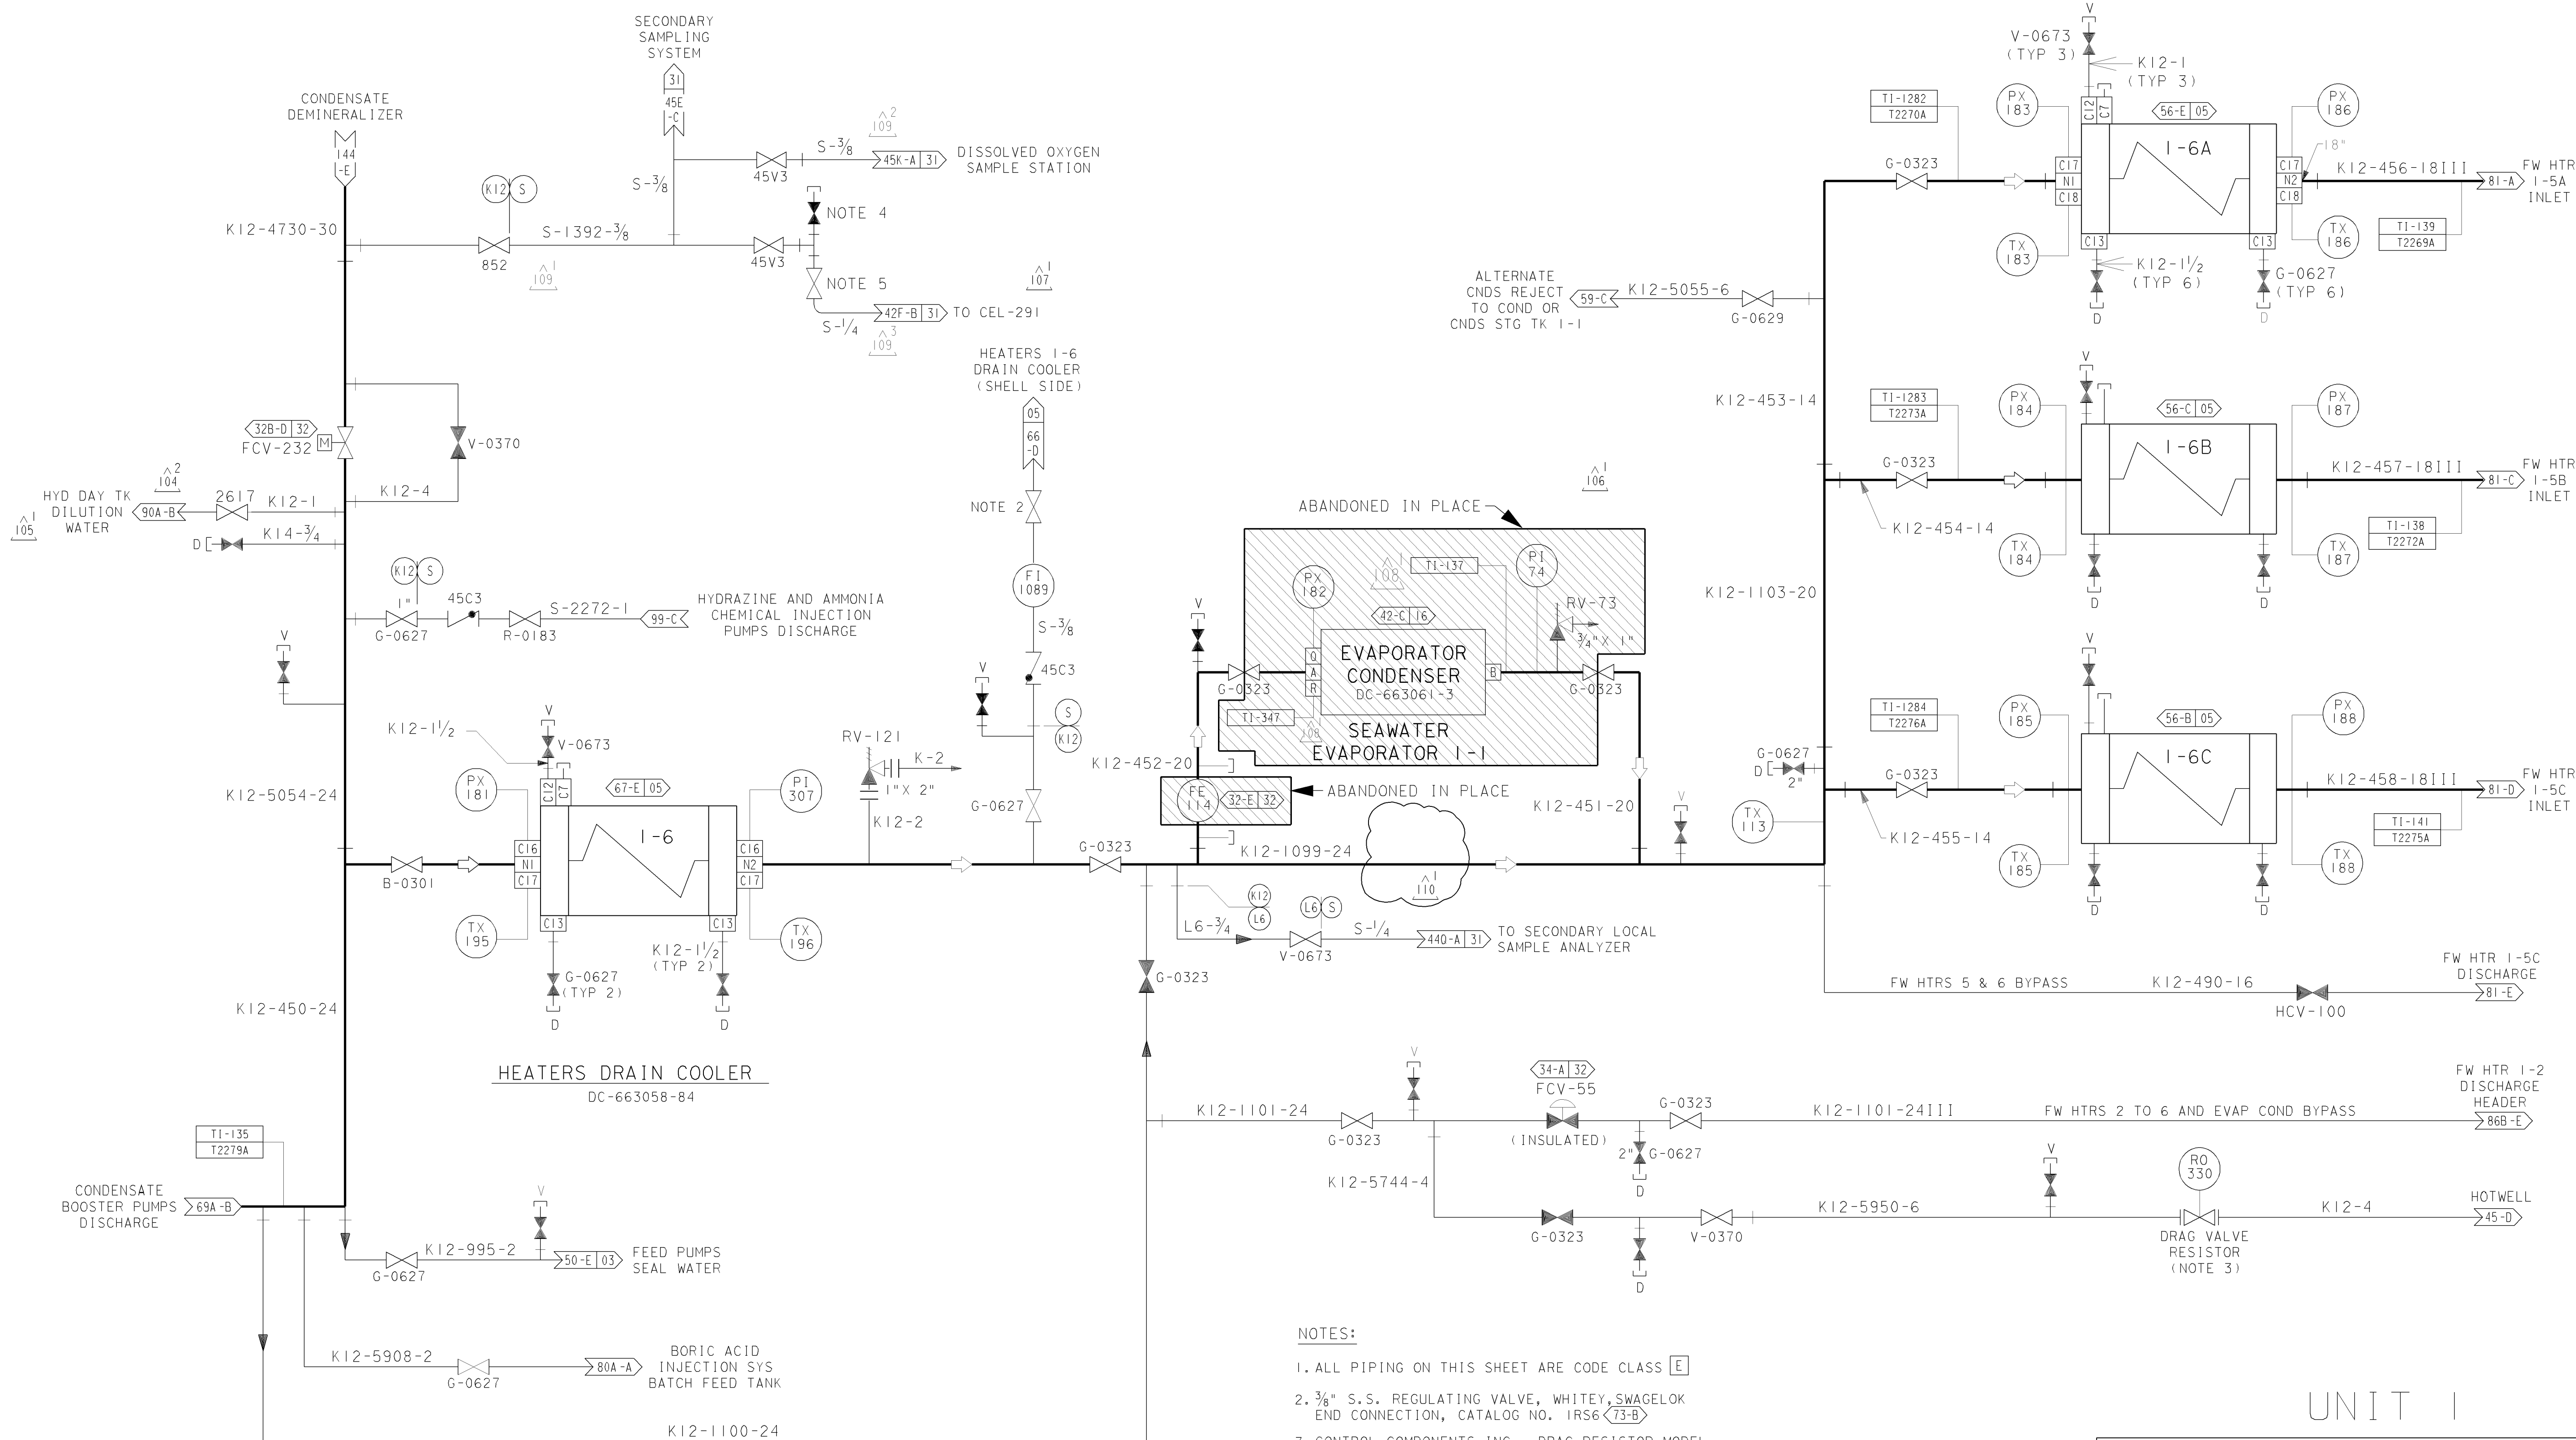DC-663058-6 (SHELL)
DC-663058-93 (CHANNEL)

UNIT I

DIABLO CANYON POWER PLANT - PG&E CO.
CONDENSATE SYSTEM


DRAWING	SHEET	PAGE	REV
102002	7	0	110

RASTER=2002s7.dgn
DGN=2002s7.dgn
CAD User: MNRU

Date: 05-17-2012

INP01C
3 Size

05-17-2012	MNRU	FxC2		KERSI J. DALAL	MECHANICAL	M 16690	3/31/2014	REVISED PER DDN-2*777-0
DATE	DWN	RE	IV	PROFESSIONAL ENGINEER	PE DISC.	PE#	PE EXP.	

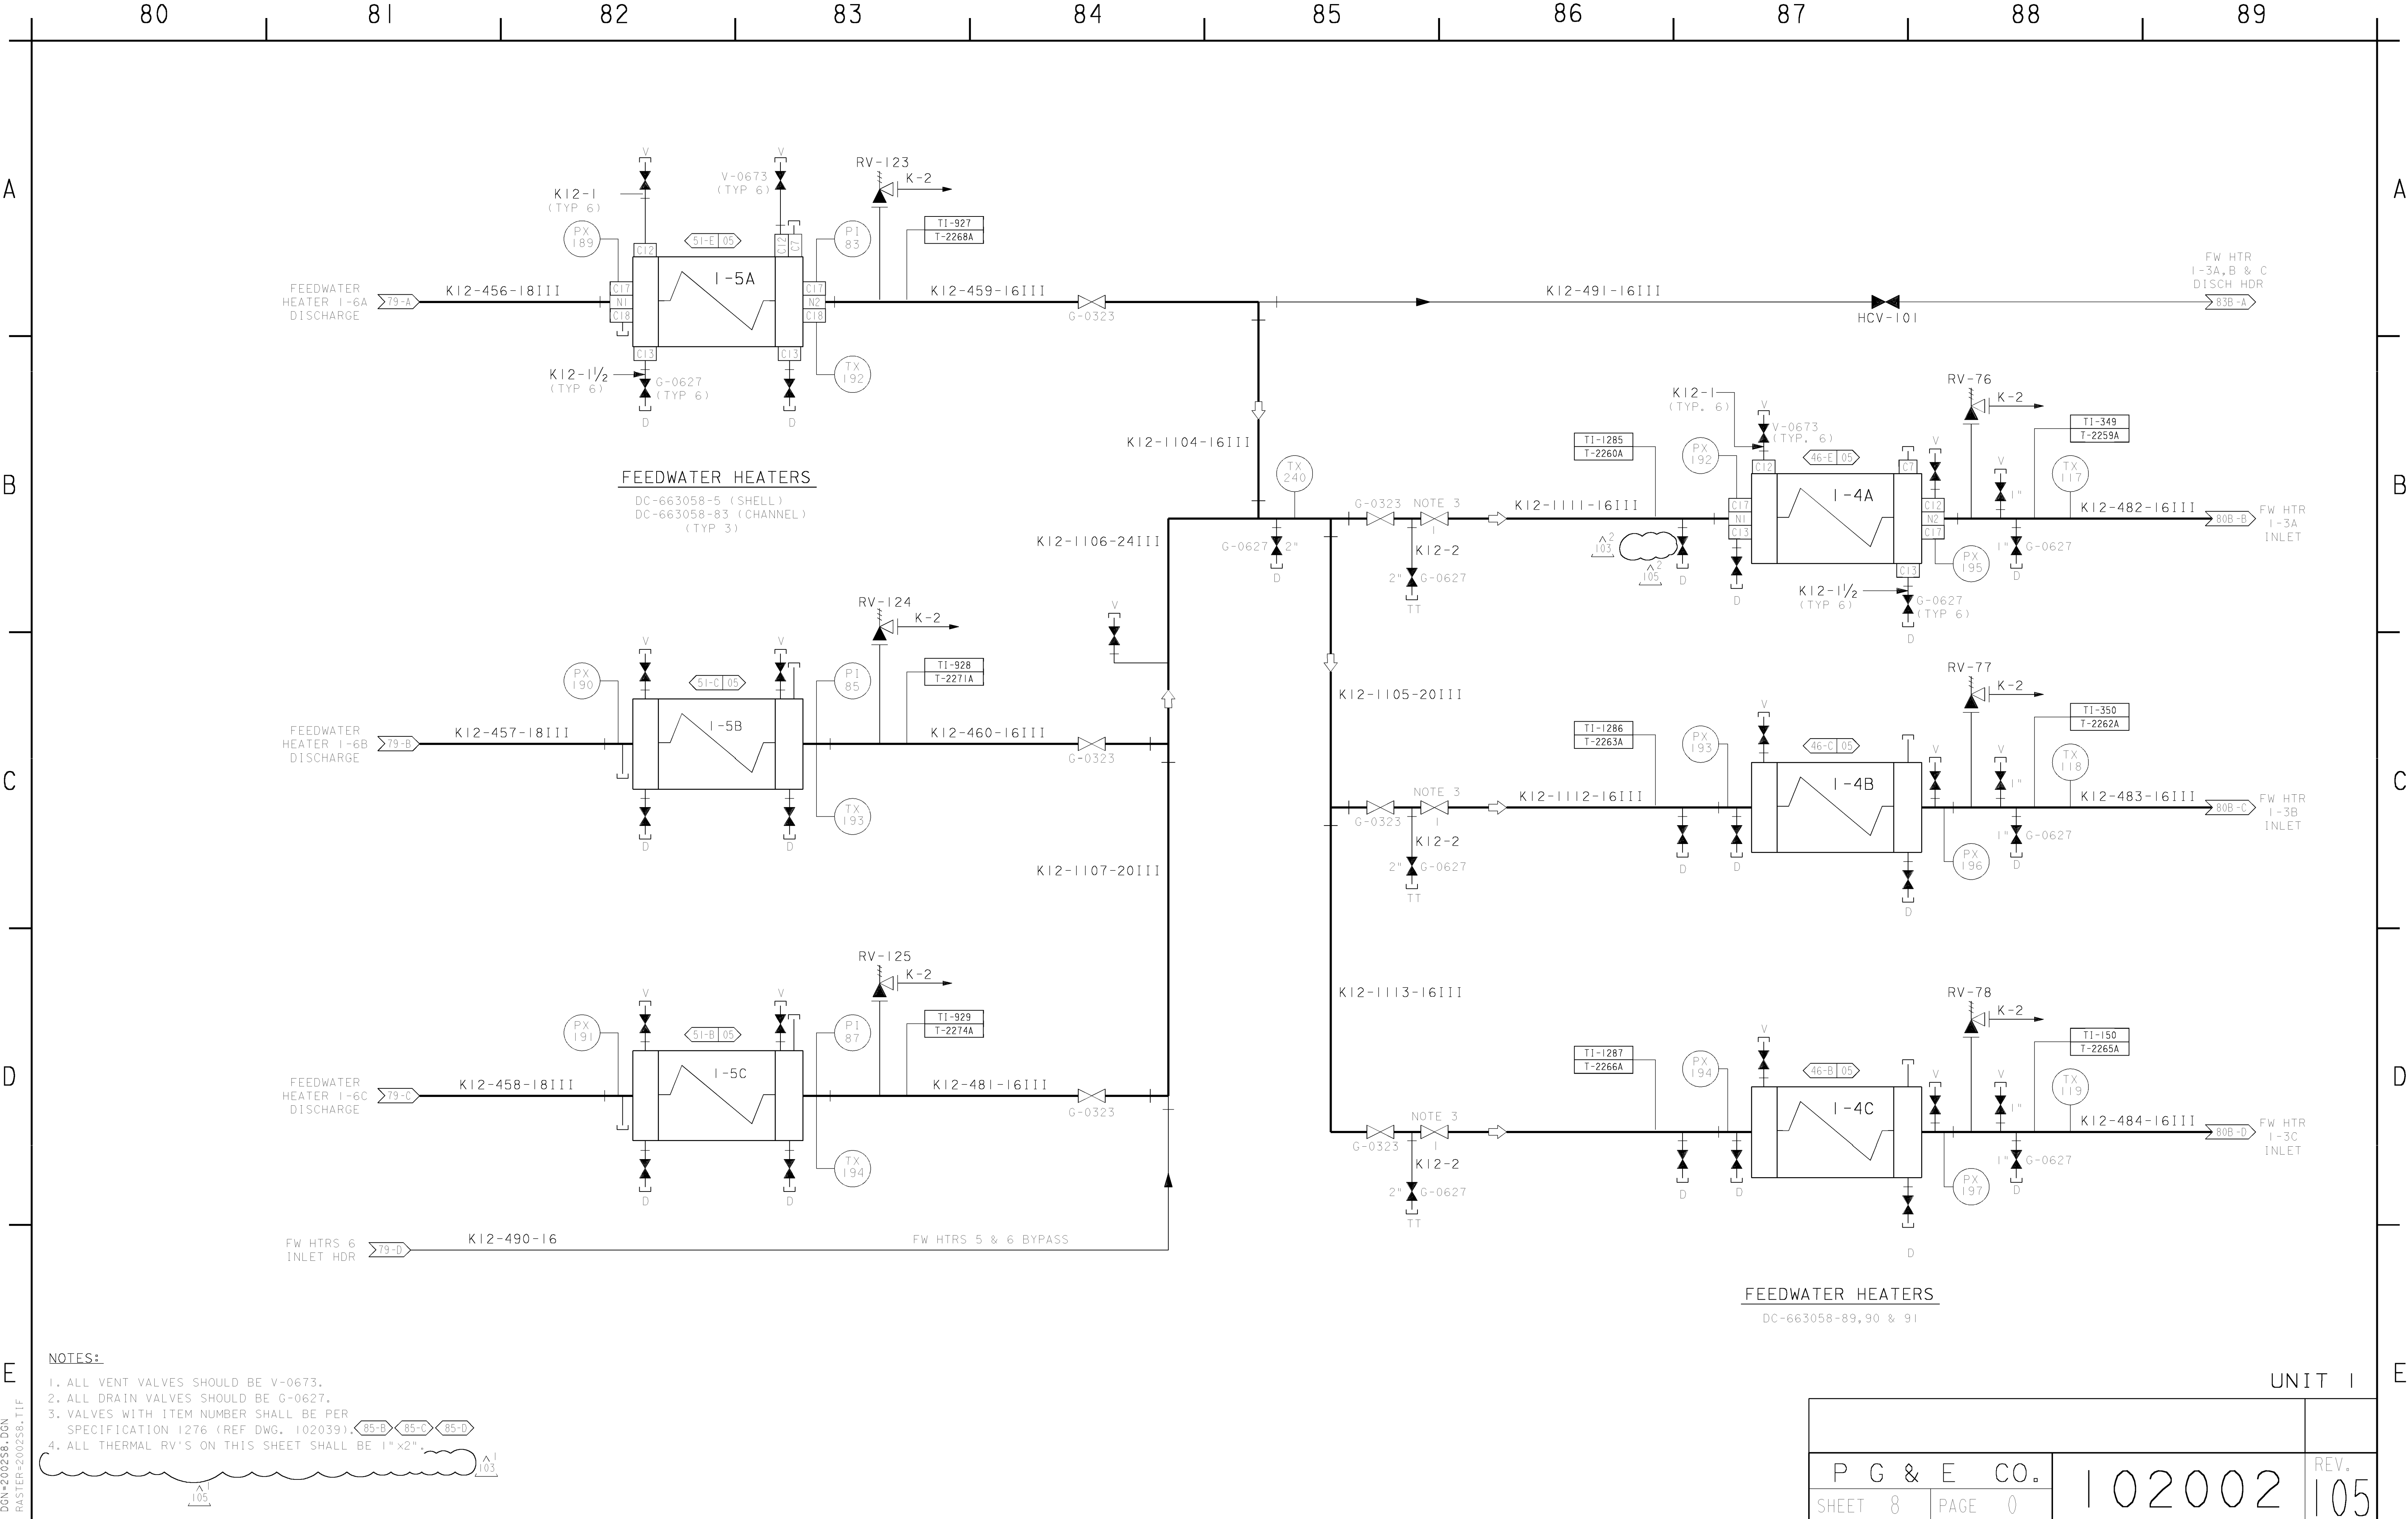

NOTES:

1. ALL VENT VALVES SHOULD BE V-0673.
2. ALL DRAIN VALVES SHOULD BE G-0627.
3. VALVES WITH ITEM NUMBER SHALL BE PER SPECIFICATION 1276 (REF DWG. 102039).
4. ALL THERMAL RV'S ON THIS SHEET SHALL BE 1" x 2".

P G & E CO.		102002	REV. 105
SHEET 8	PAGE 0		

10/21/00	NDNI	RHSI	-	KERSI J. DALAL	MECHANICAL	M 16690	3/31/2004	Revised per FCT 025229
DATE	DWN	RE	IV	PROFESSIONAL ENGINEER	PE DISC.	PE#	PE EXP.	

A

B

C

D

E


A

B

C

D

E

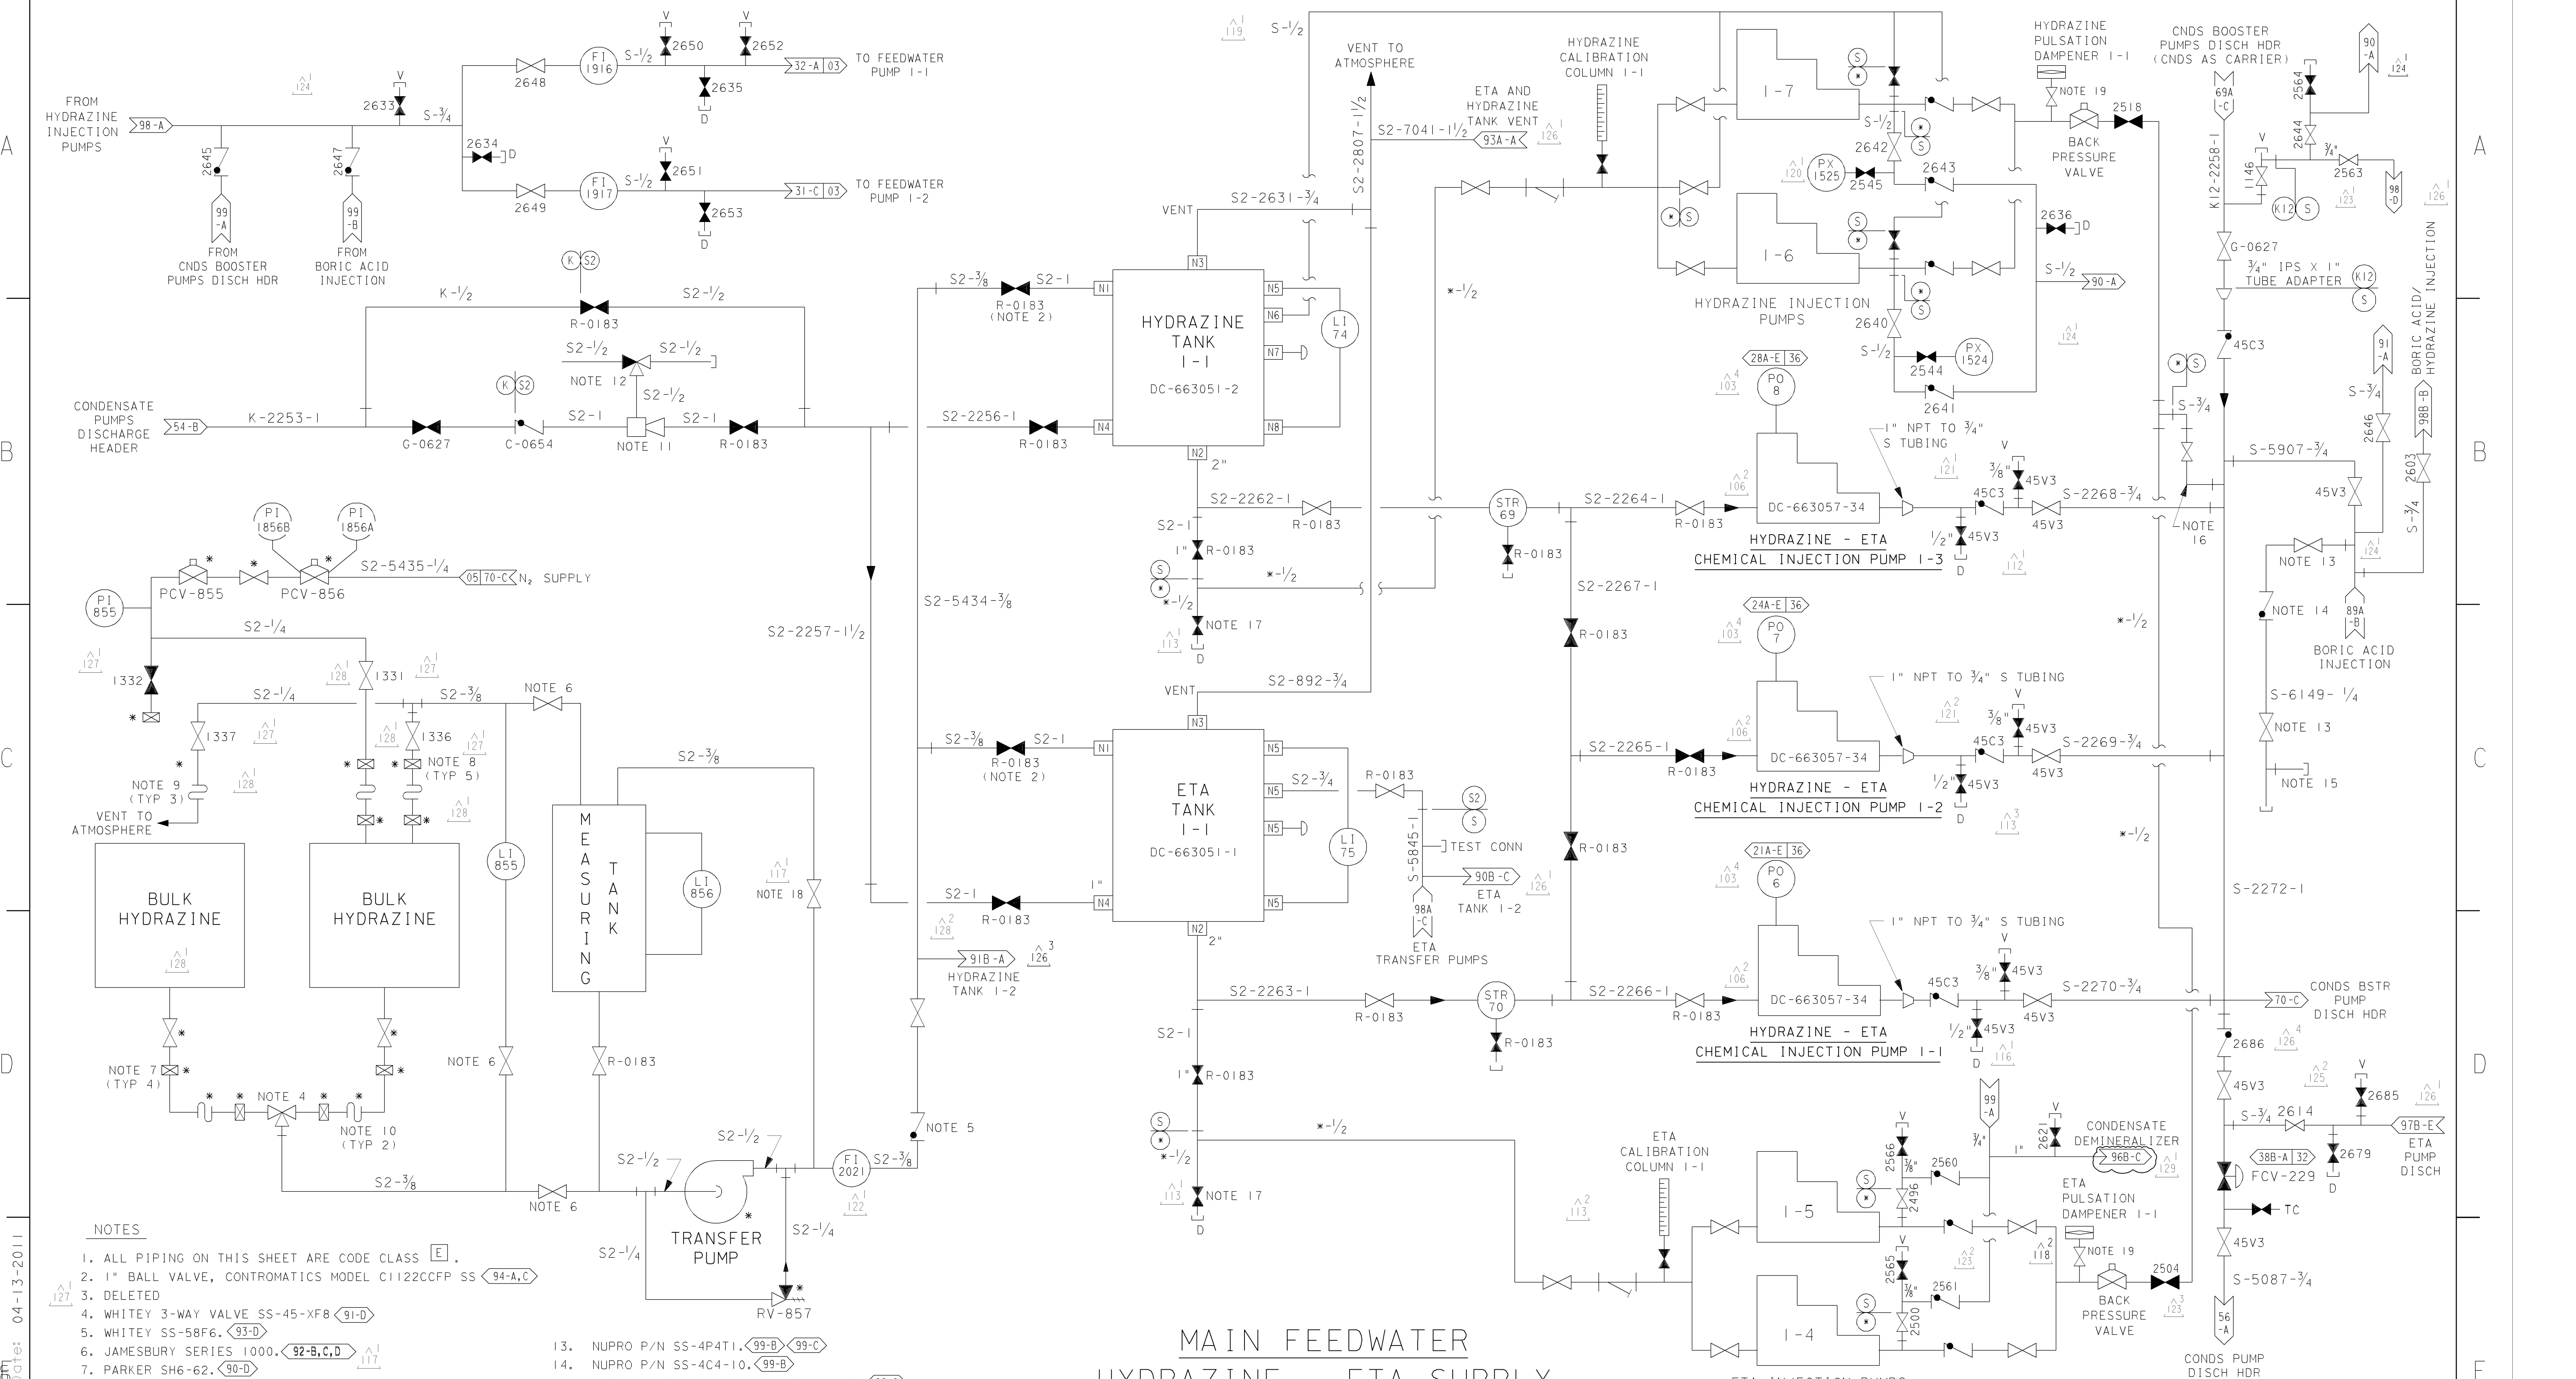

- NOTES
1. ALL PIPING ON THIS SHEET ARE CODE CLASS E.

2. 1" BALL VALVE, CONTRAMATICS MODEL C1122CCFP SS 94-A,C

3. DELETED

4. WHITEY 3-WAY VALVE SS-45-XF8 91-D

5. WHITEY SS-58F6. 93-D

6. JAMESBURY SERIES 1000. 92-B,C,D 117

7. PARKER SH6-62. 90-D

8. PARKER SH2-62. 90-C

9. 1/4" DIAMETER POLY TUBING. 90-C

10. 1/2" TEFLON HOSE WITH SS BRAIDING 91-D

11. ETA AND HYDRAZINE EDUCTOR (PENBERTHY #63A). 92-B 117

12. SS 45 F X 8 (WHITEY). 92-A

13. NUPRO P/N SS-4P4T1. 99-B 99-C

14. NUPRO P/N SS-4C4-10. 99-B

15. CONNECTION FOR CHEMICAL INJECTION. 99-C

16. WHITEY P/N SS-45S16. 99-B

17. APOLLO #76-103 94-B 94-D 117

18. PBM P/N SPH-31-SW2/F0 93-C

19. CONBRACO P/N 76-103-01 98-A
- MAIN FEEDWATER
HYDRAZINE - ETA SUPPLY
- | | | | |
|--------------------------------------|-------|------|-----|
| DIABLO CANYON POWER PLANT - PG&E CO. | | | |
| CONDENSATE SYSTEM | | | |
| DRAWING | SHEET | PAGE | REV |
| 102002 | 9 | 0 | 129 |
- PASTER=102002s9.dgn
PCN=102002s9.dgn
CAD User: JBMX Dft# 04-13-2011
- | | | | | | | | | |
|------------|------|------|----|-----------------------|------------|---------|-----------|------------------------|
| 04-13-2011 | JBMX | FxC2 | | KERSI J. DALAL | MECHANICAL | M 16690 | 3/31/2012 | REVISED PER DFT-7*1067 |
| DATE | DWN | RE | IV | PROFESSIONAL ENGINEER | PE DISC. | PE# | PE EXP. | |
- 3 5126








A

B

C

D

E

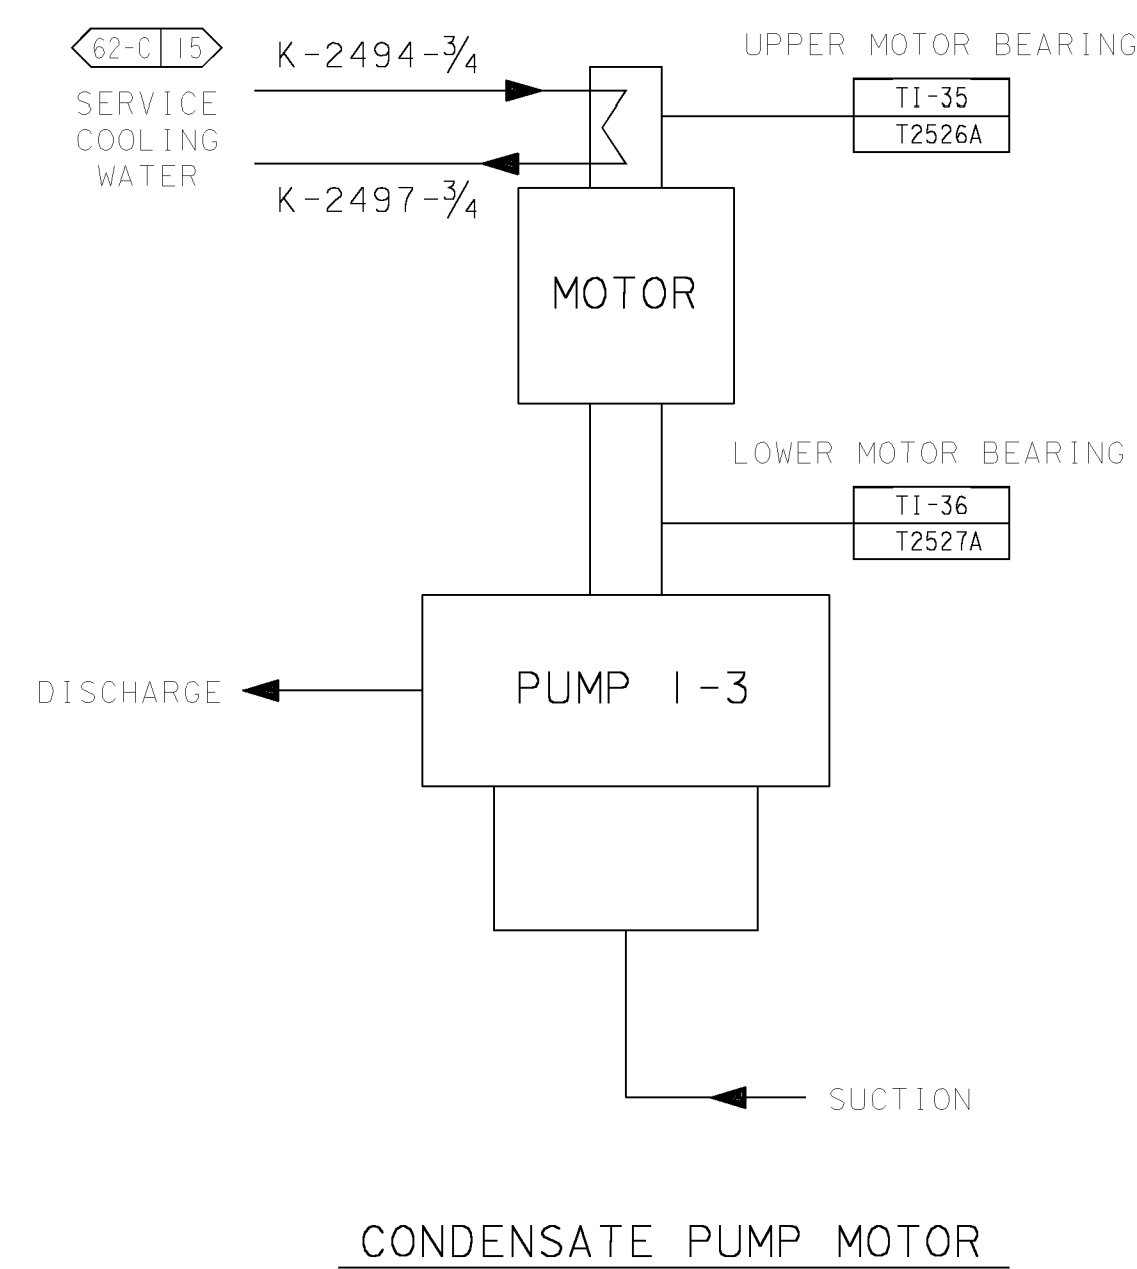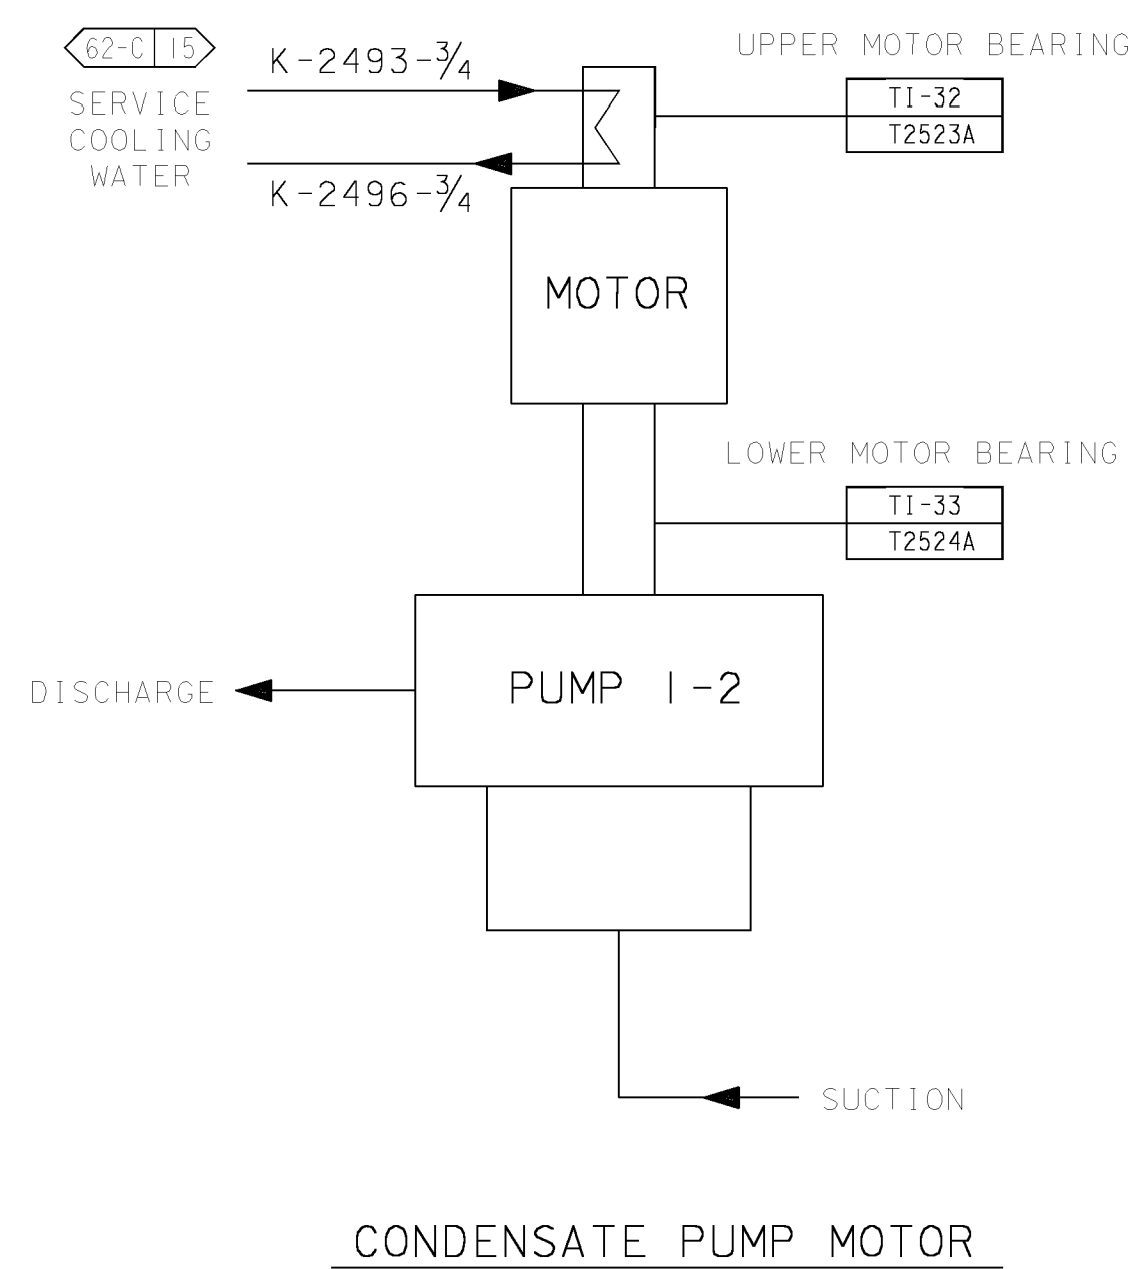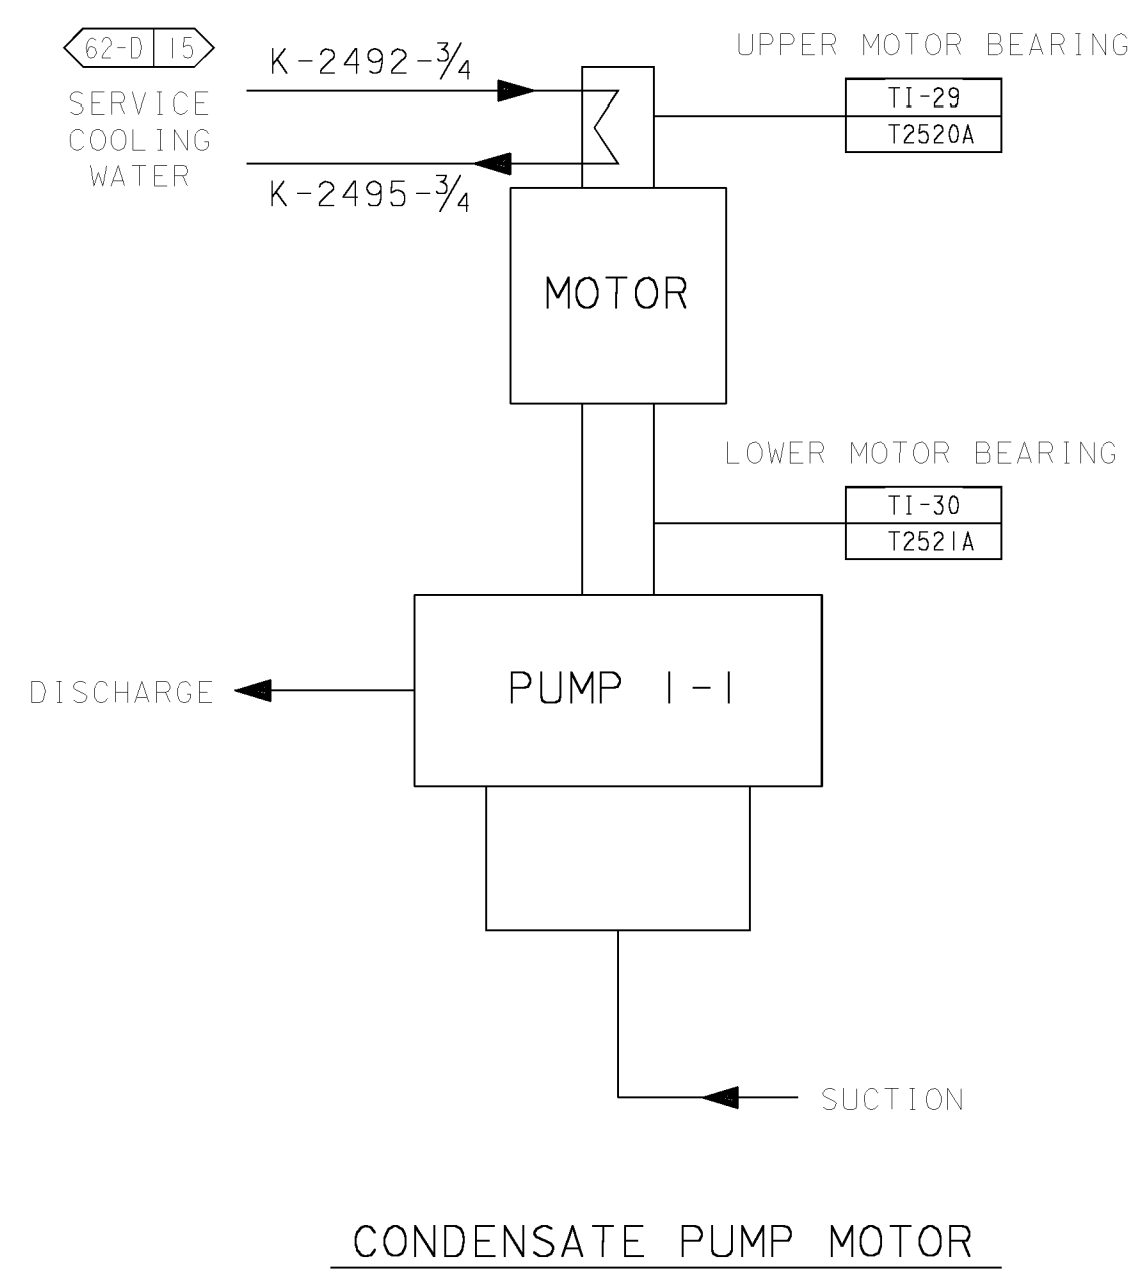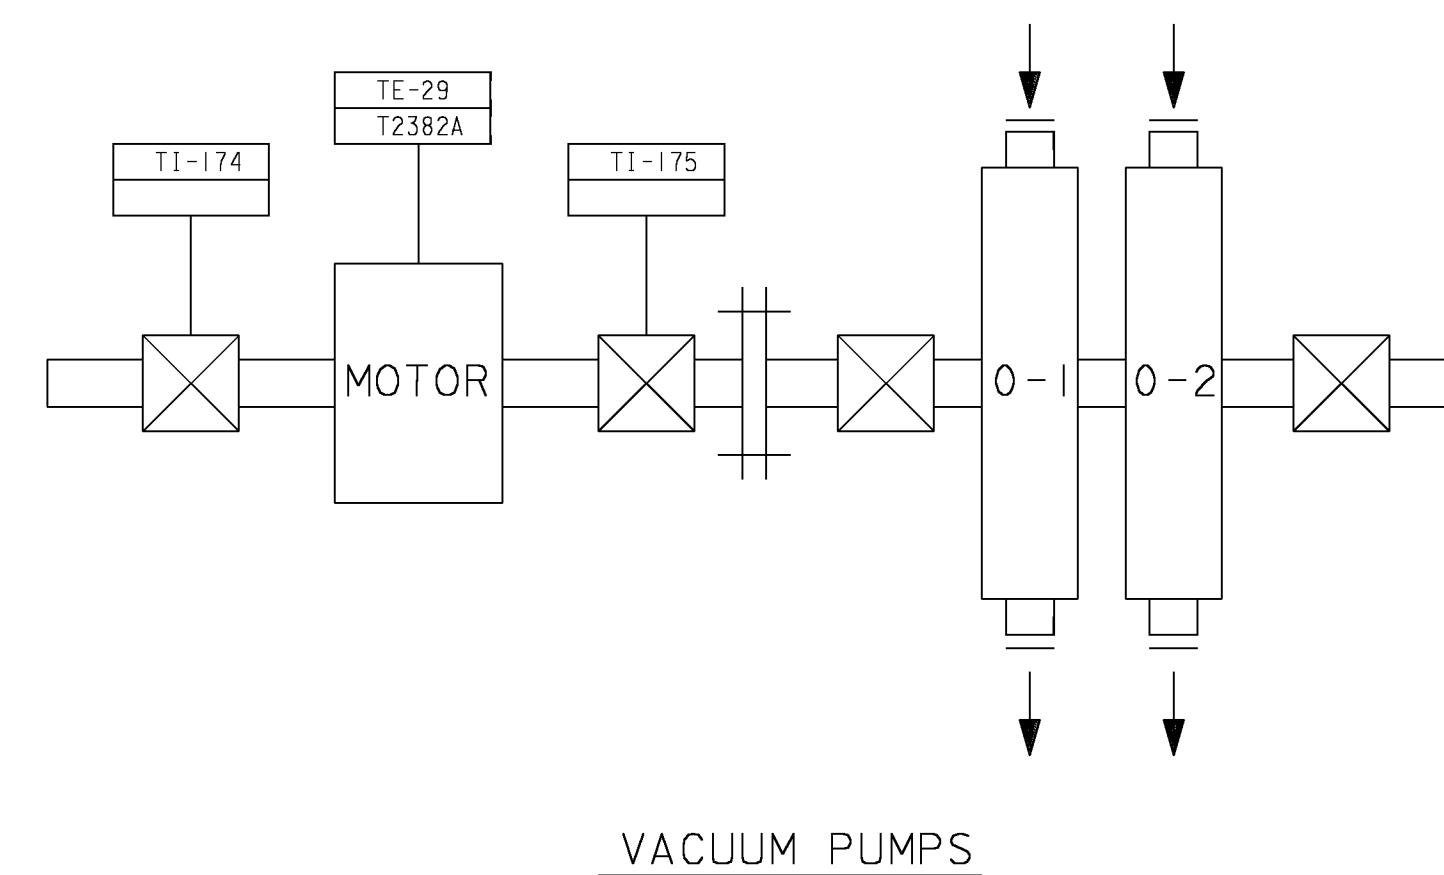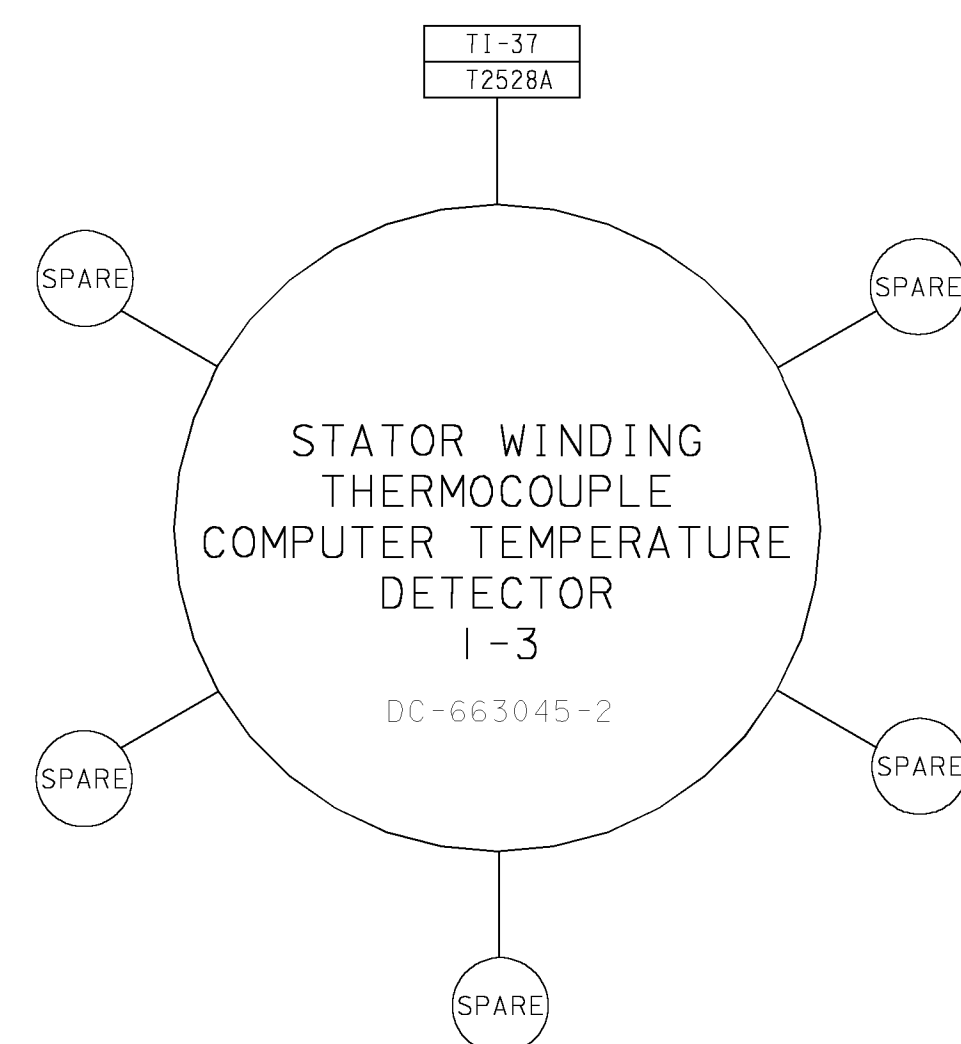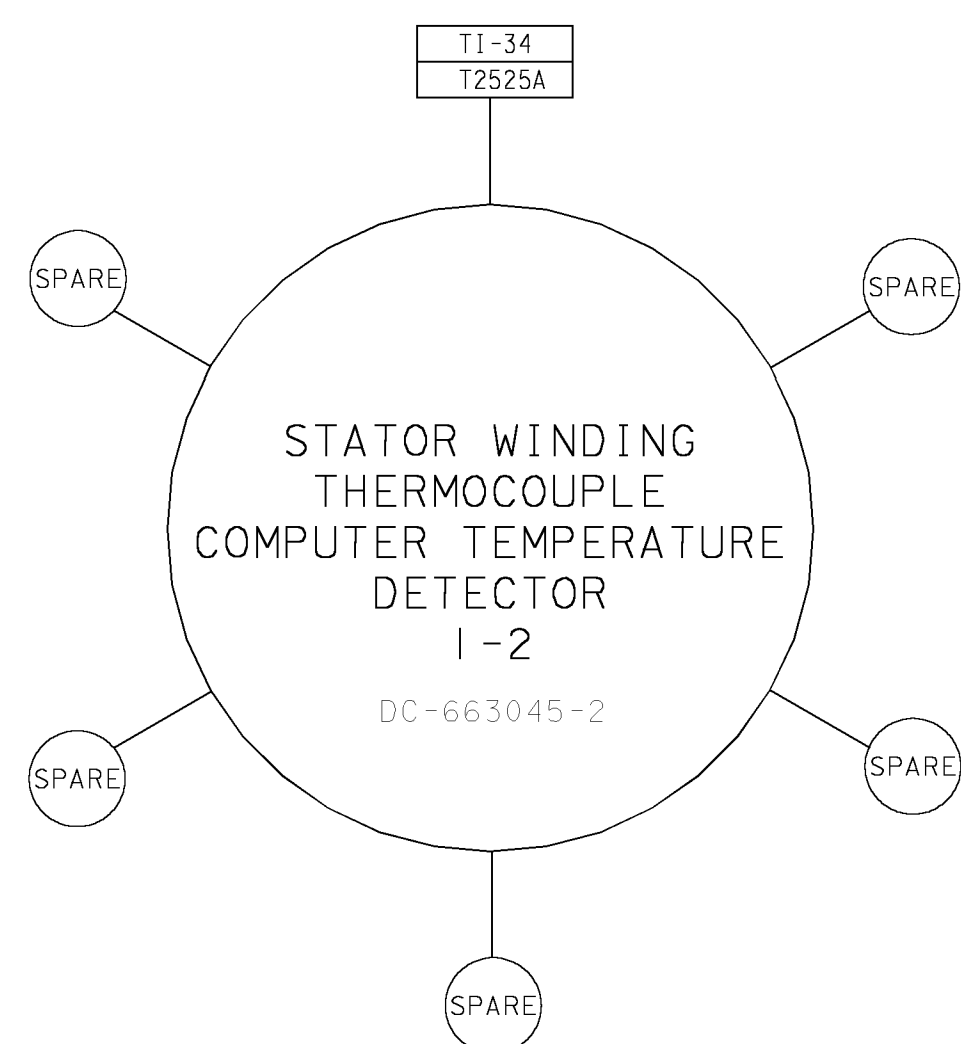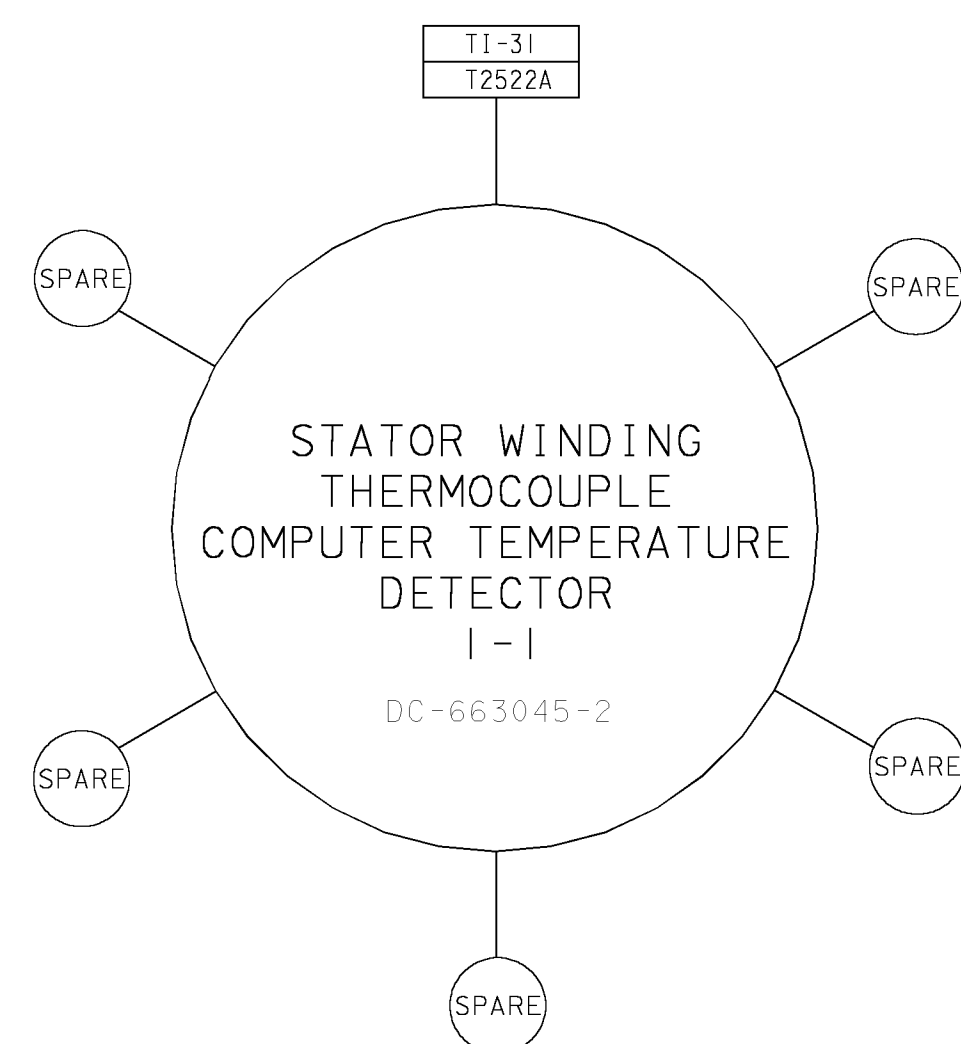

UNIT I

P G & E CO.		102002	REV.
SHEET 10	PAGE 0		103

5/4/99	CMG9	FXC2	-	KERSI J. DALAL	MECHANICAL	M 16690	3/31/2000	Enhanced per FCT 023917
DATE	DWN	RE	IV	PROFESSIONAL ENGINEER	PE DISC.	PE#	PE EXP.	

110

111

112

113

114

115

116

117


118

119

MAIN CONDENSER TUBE SHEET SALT WATER LEAK DETECTION SYSTEM

NOTES:

1. ALL PIPING SHOWN ON THIS SHEET SHALL BE PG&E CODE CLASS E
2. ALL ANALYZER SENSORS (CEL) SHALL BE INSTALLED AS CLOSE AS POSSIBLE TO INSTRUMENT SUPPLY PUMPS.
3. THE WORD "TYPICAL" AS USED ON THIS SHEET DENOTES VALVES, PIPING, ETC. WITH THE SAME SPECIFICATION AND FUNCTION.
4. FOR CONDENSER TRAY CONNECTIONS, SEE DC-663041-13. 116-D
5. 1/2" - WHITEY SS 45F8. 110,119-B,D
6. GARLOCK STYLE 204 DOUBLE ARCH EXPANSION JOINT. 115-A
7. 3/8" WHITEY SS 4456 (TYP 4). 111,118-B,D

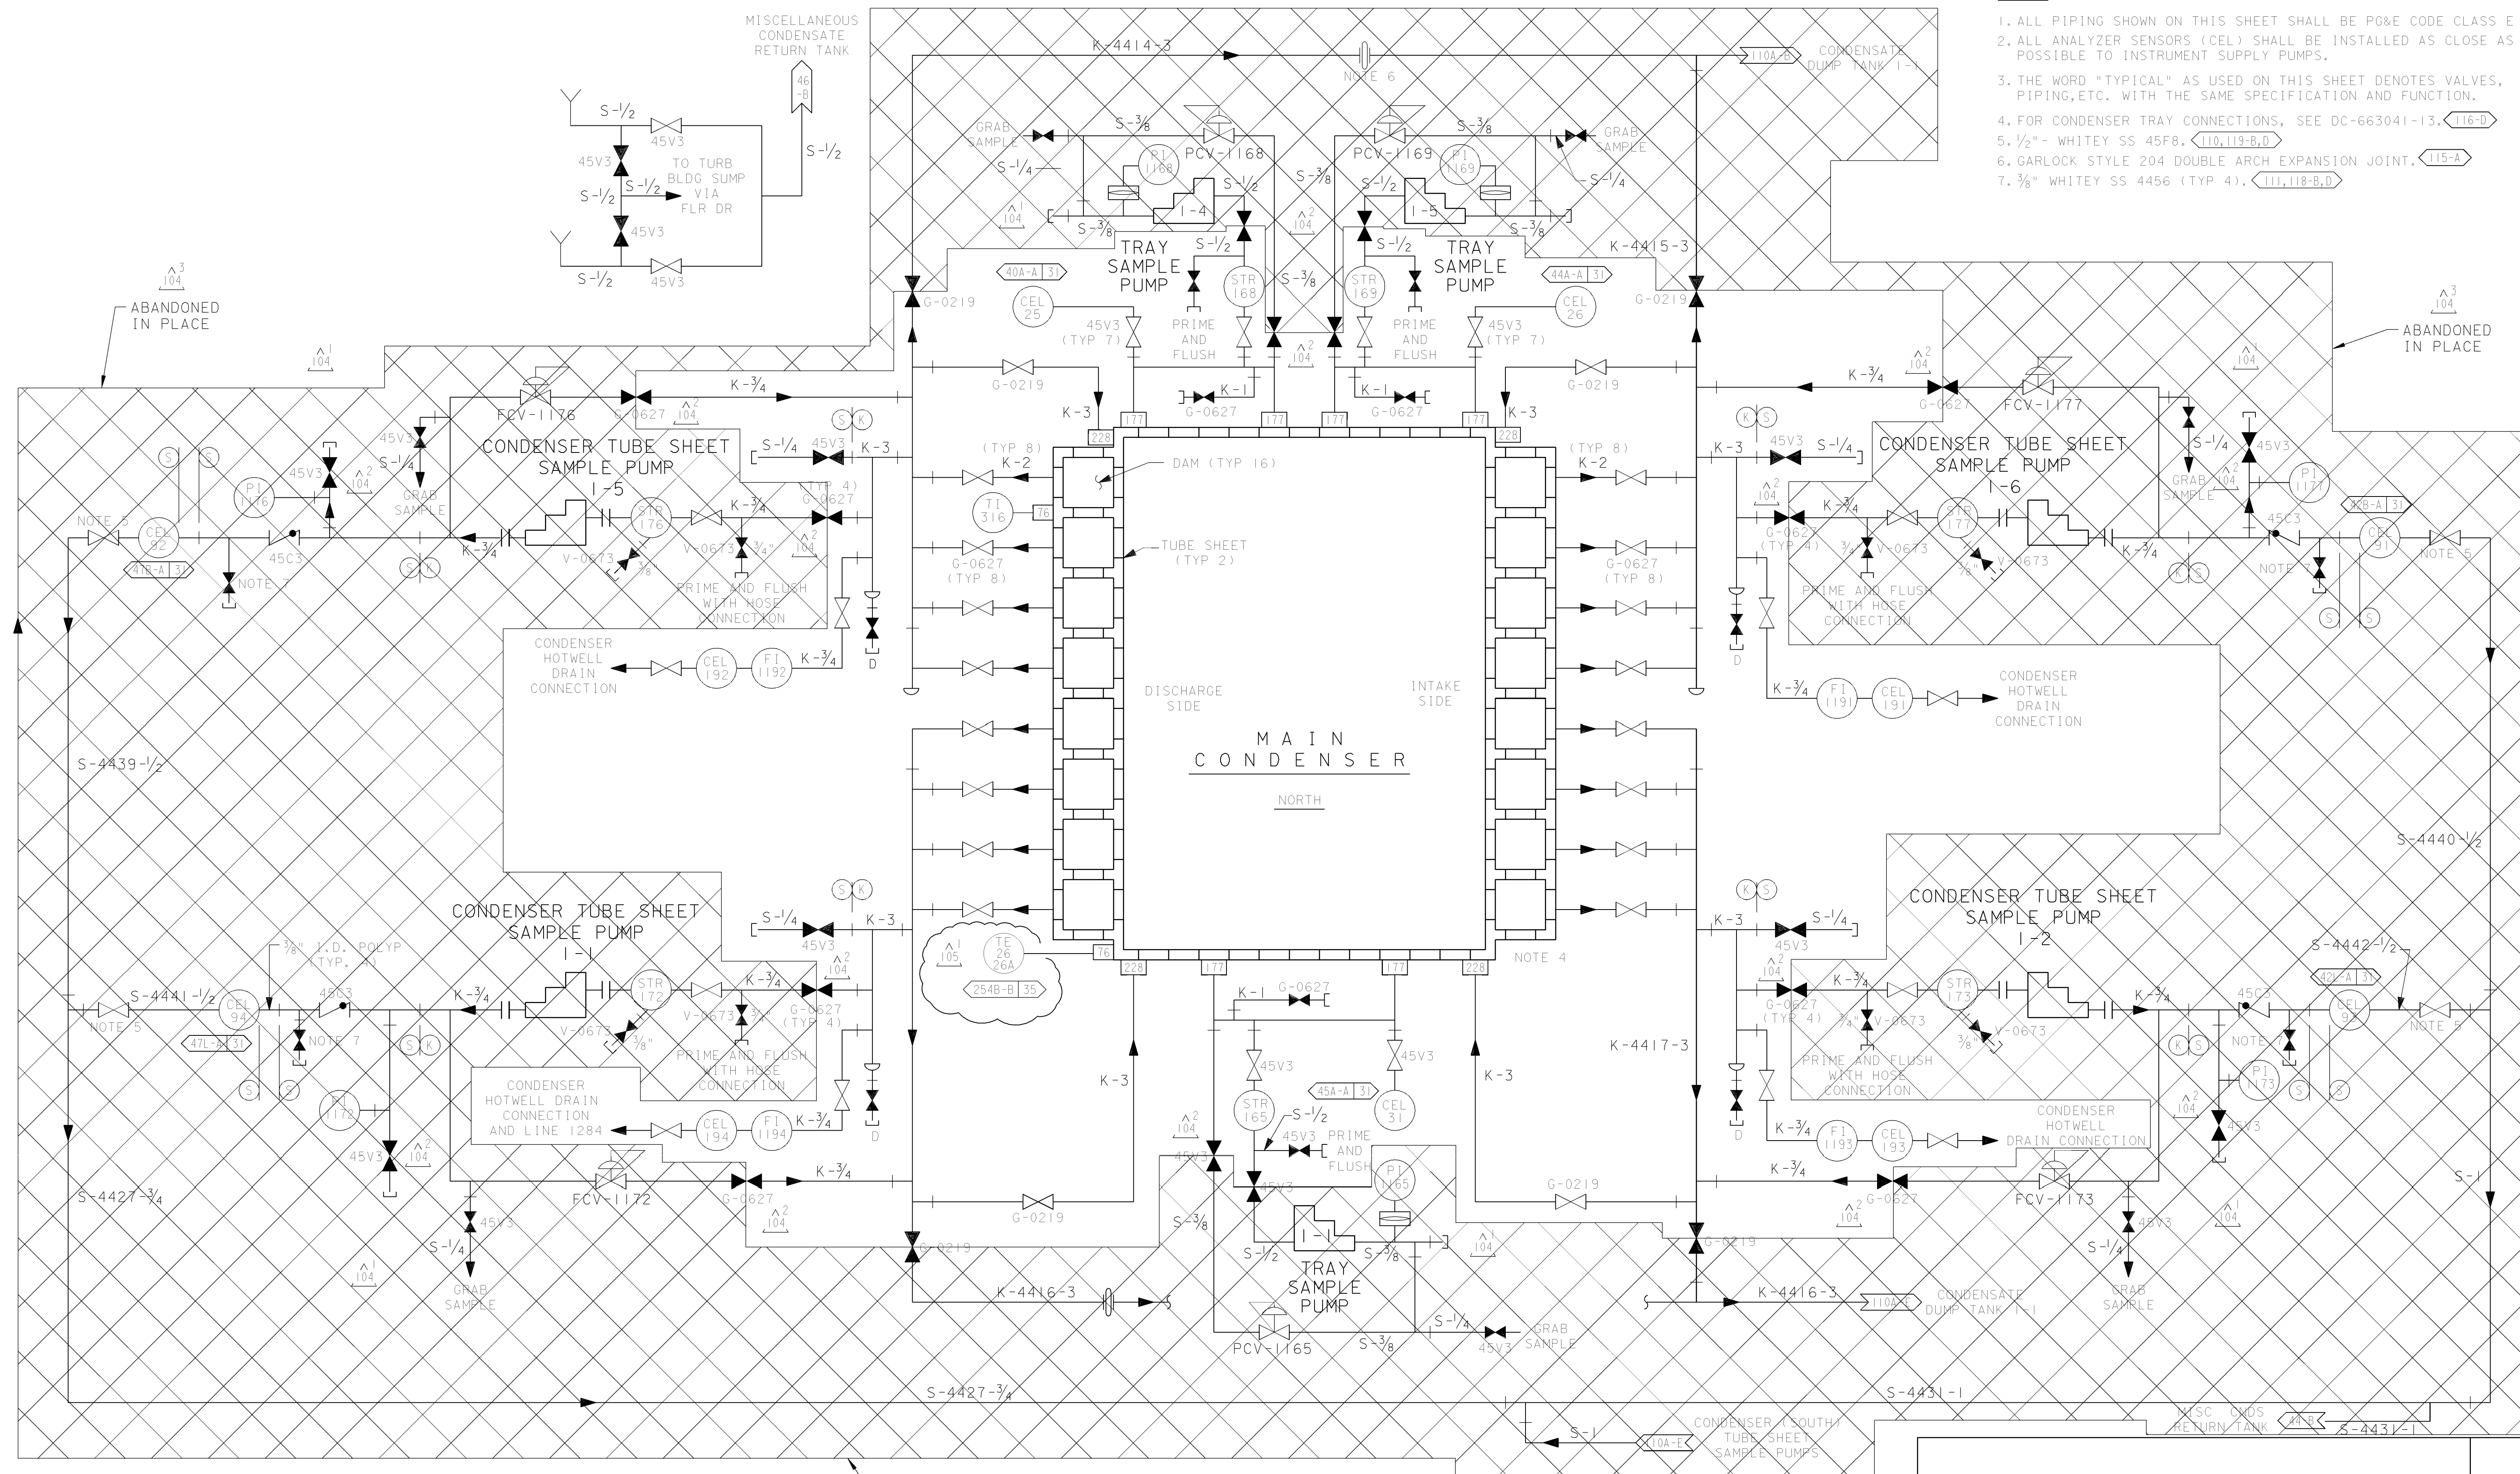

UNIT-1


P G & E CO.

SHEET 11 PAGE 0

102002

REV. 105

5/5/05	AJL2	FXC2	-	KERSI J. DALAL	MECHANICAL	M 16690	3/31/2006	Revised per FCT 030067
DATE	DWN	RE	IV	PROFESSIONAL ENGINEER	PE DISC.	PE#	PE EXP.	

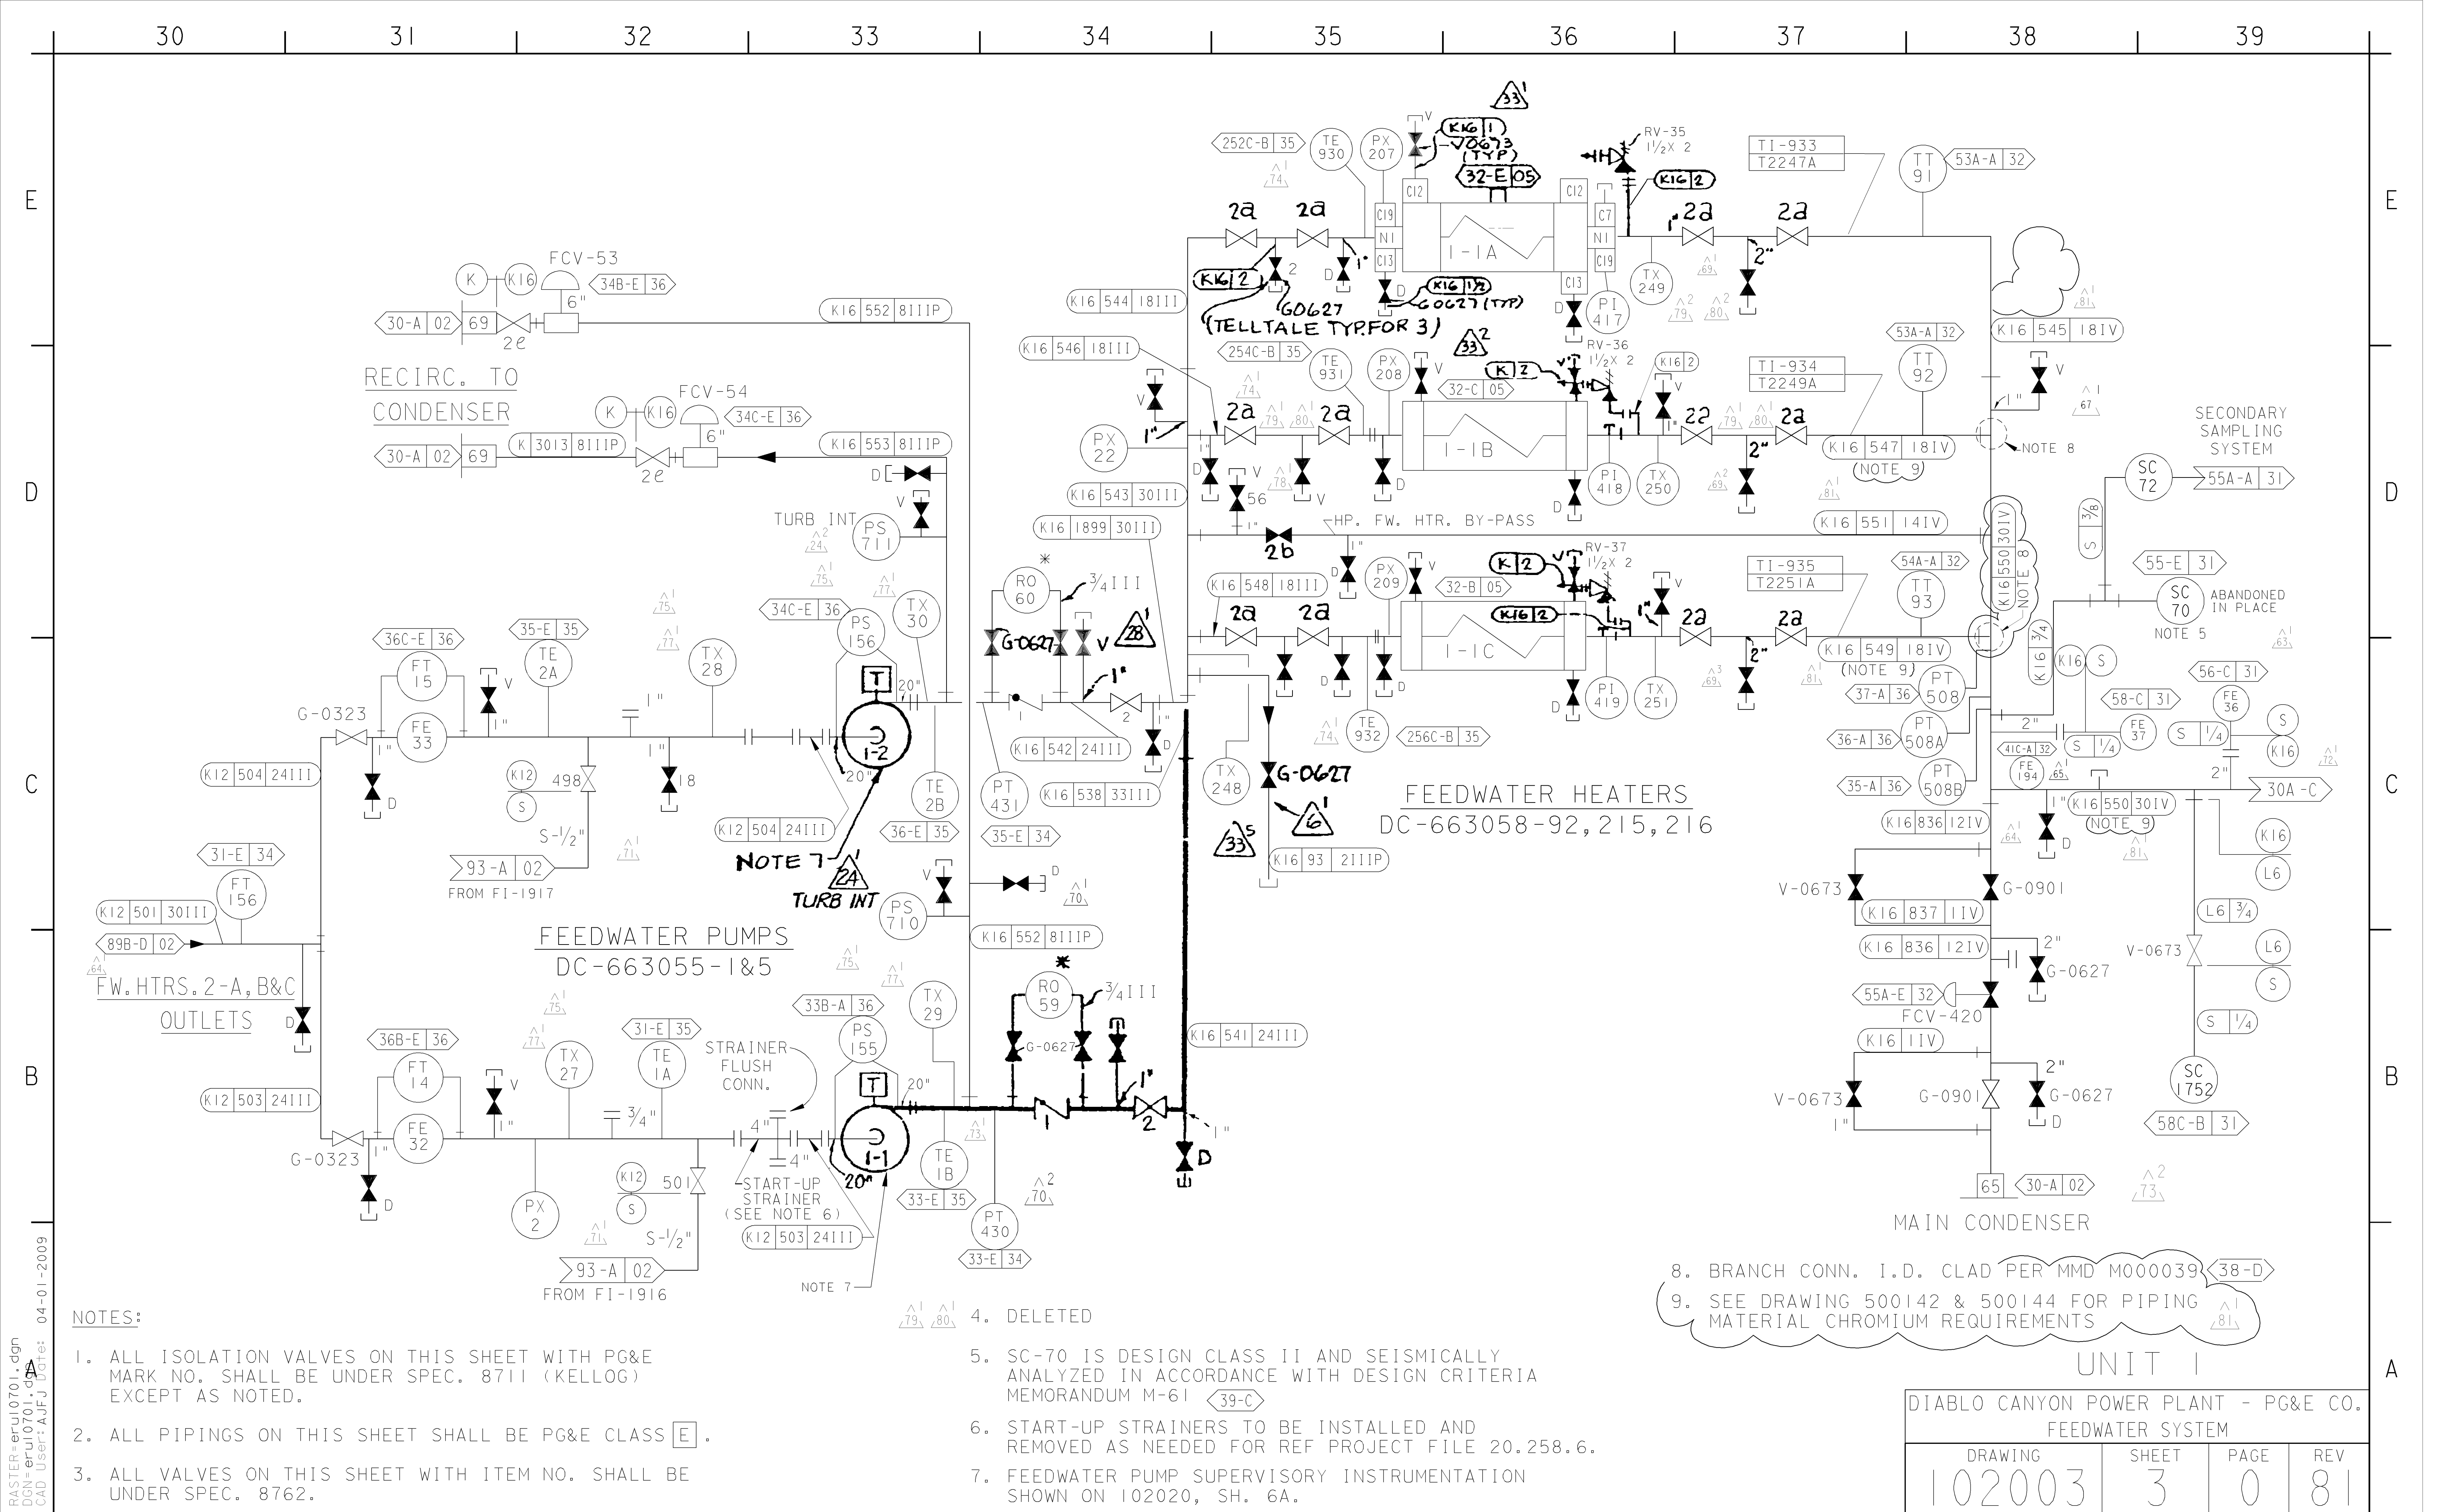

NOTES:


1. ALL ISOLATION VALVES ON THIS SHEET WITH PG&E MARK NO. SHALL BE UNDER SPEC. 8711 (KELLOG) EXCEPT AS NOTED.
2. ALL PIPINGS ON THIS SHEET SHALL BE PG&E CLASS E.
3. ALL VALVES ON THIS SHEET WITH ITEM NO. SHALL BE UNDER SPEC. 8762.
4. DELETED
5. SC-70 IS DESIGN CLASS II AND SEISMICALLY ANALYZED IN ACCORDANCE WITH DESIGN CRITERIA MEMORANDUM M-61 39-C
6. START-UP STRAINERS TO BE INSTALLED AND REMOVED AS NEEDED FOR REF PROJECT FILE 20.258.6.
7. FEEDWATER PUMP SUPERVISORY INSTRUMENTATION SHOWN ON 102020, SH. 6A.

8. BRANCH CONN. I.D. CLAD PER MMD M000039 38-D
9. SEE DRAWING 500142 & 500144 FOR PIPING MATERIAL CHROMIUM REQUIREMENTS 81

UNIT 1

DIABLO CANYON POWER PLANT - PG&E CO.
FEEDWATER SYSTEM

DRAWING	SHEET	PAGE	REV
102003	3	0	81

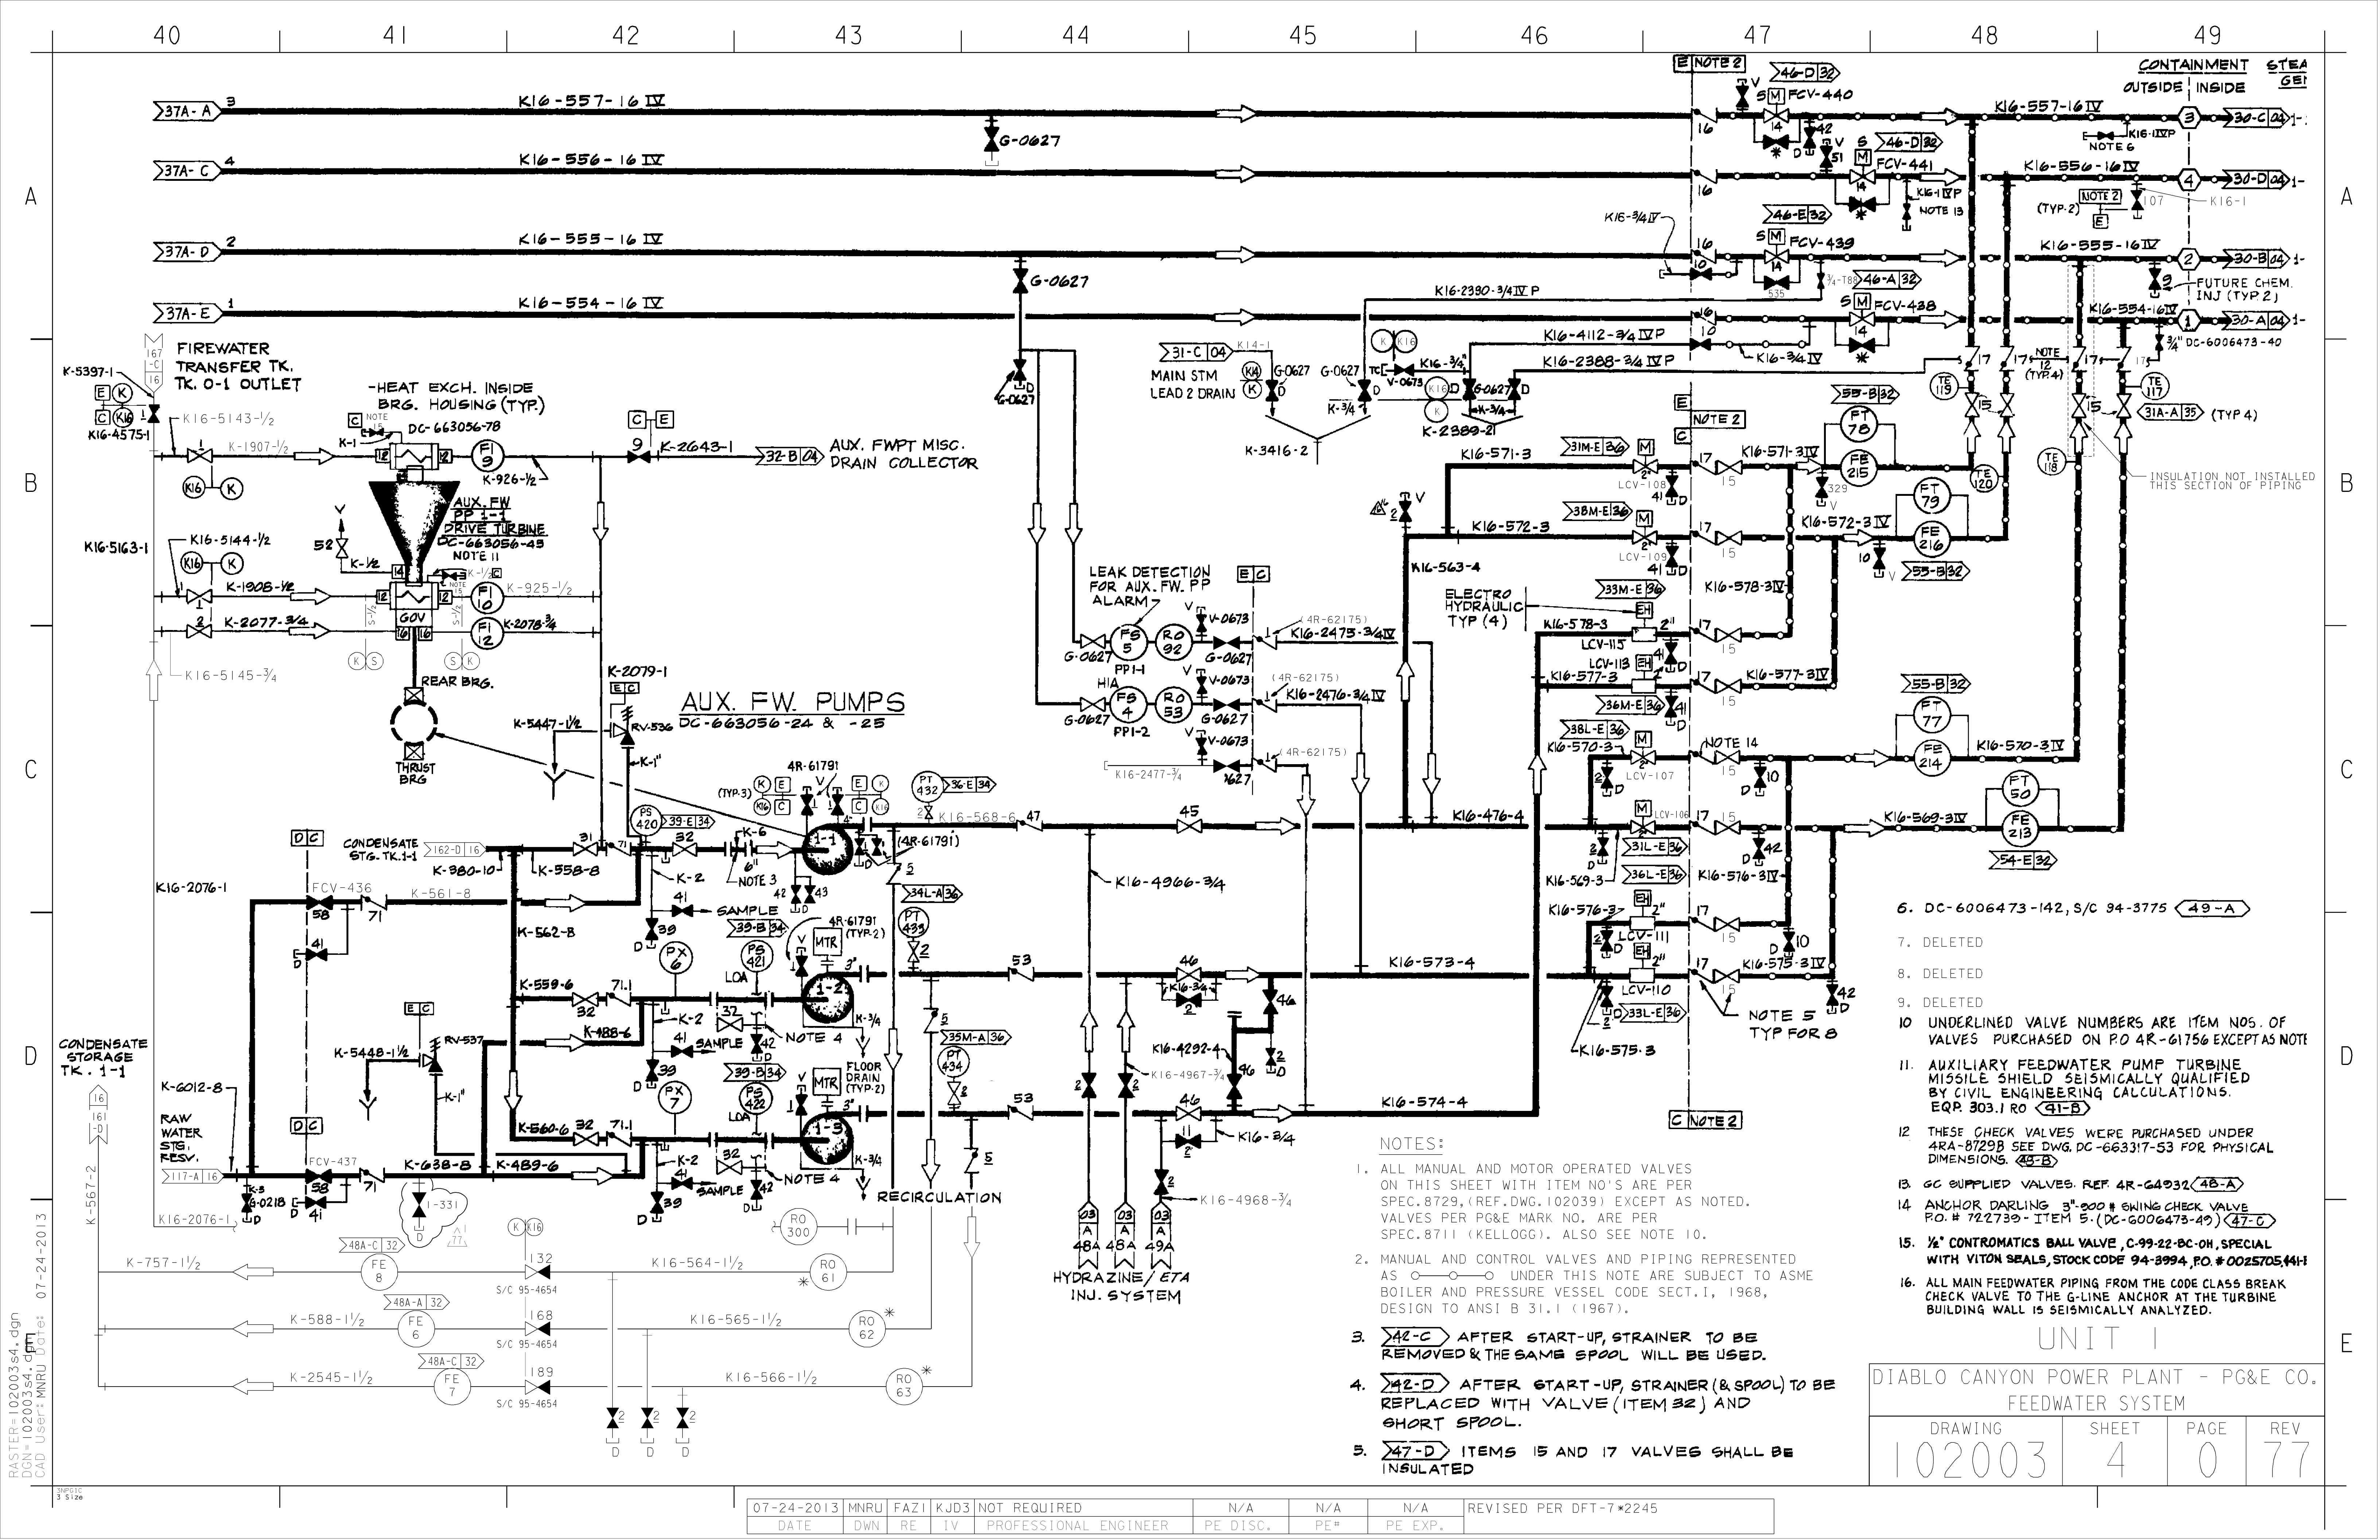

- 6. DC-6006473-142, S/C 94-3775 **49-A**
- 7. DELETED
- 8. DELETED
- 9. DELETED
- 10. UNDERLINED VALVE NUMBERS ARE ITEM NOS. OF VALVES PURCHASED ON P.O. 4R-61756 EXCEPT AS NOTE
- 11. AUXILIARY FEEDWATER PUMP TURBINE MISSILE SHIELD SEISMICALLY QUALIFIED BY CIVIL ENGINEERING CALCULATIONS. EQR. 303.1 RO **41-B**
- 12. THESE CHECK VALVES WERE PURCHASED UNDER 4RA-8729B SEE DWG. DC-663317-53 FOR PHYSICAL DIMENSIONS. **45-B**
- 13. GC SUPPLIED VALVES. REF. 4R-64932 **48-A**
- 14. ANCHOR DARLING 3"-000 # 6WING CHECK VALVE P.O. # 722733- ITEM 5. (DC-6006473-49) **47-C**
- 15. 1/2" CONTRAMATICS BALL VALVE, C-99-22-BC-0H, SPECIAL WITH VITON SEALS, STOCK CODE 94-3994, P.O. # 0025705 **44-H**
- 16. ALL MAIN FEEDWATER PIPING FROM THE CODE CLASS BREAK CHECK VALVE TO THE G-LINE ANCHOR AT THE TURBINE BUILDING WALL IS SEISMICALLY ANALYZED.

- NOTES:
- 1. ALL MANUAL AND MOTOR OPERATED VALVES ON THIS SHEET WITH ITEM NO.'S ARE PER SPEC. 8729, (REF. DWG. 102039) EXCEPT AS NOTED. VALVES PER PG&E MARK NO. ARE PER SPEC. 8711 (KELLOGG). ALSO SEE NOTE 10.
 - 2. MANUAL AND CONTROL VALVES AND PIPING REPRESENTED AS UNDER THIS NOTE ARE SUBJECT TO ASME BOILER AND PRESSURE VESSEL CODE SECT. I, 1968, DESIGN TO ANSI B 31.1 (1967).
 - 3. **42-C** AFTER START-UP, STRAINER TO BE REMOVED & THE SAME SPOOL WILL BE USED.
 - 4. **42-D** AFTER START-UP, STRAINER (B. SPOOL) TO BE REPLACED WITH VALVE (ITEM 32) AND SHORT SPOOL.
 - 5. **47-D** ITEMS 15 AND 17 VALVES SHALL BE INSULATED

DIABLO CANYON POWER PLANT - PG&E CO.			
FEEDWATER SYSTEM			
DRAWING	SHEET	PAGE	REV
102003	4	0	77

40A

41A

42A

43A

44A


45A

46A

47A

48A

49A

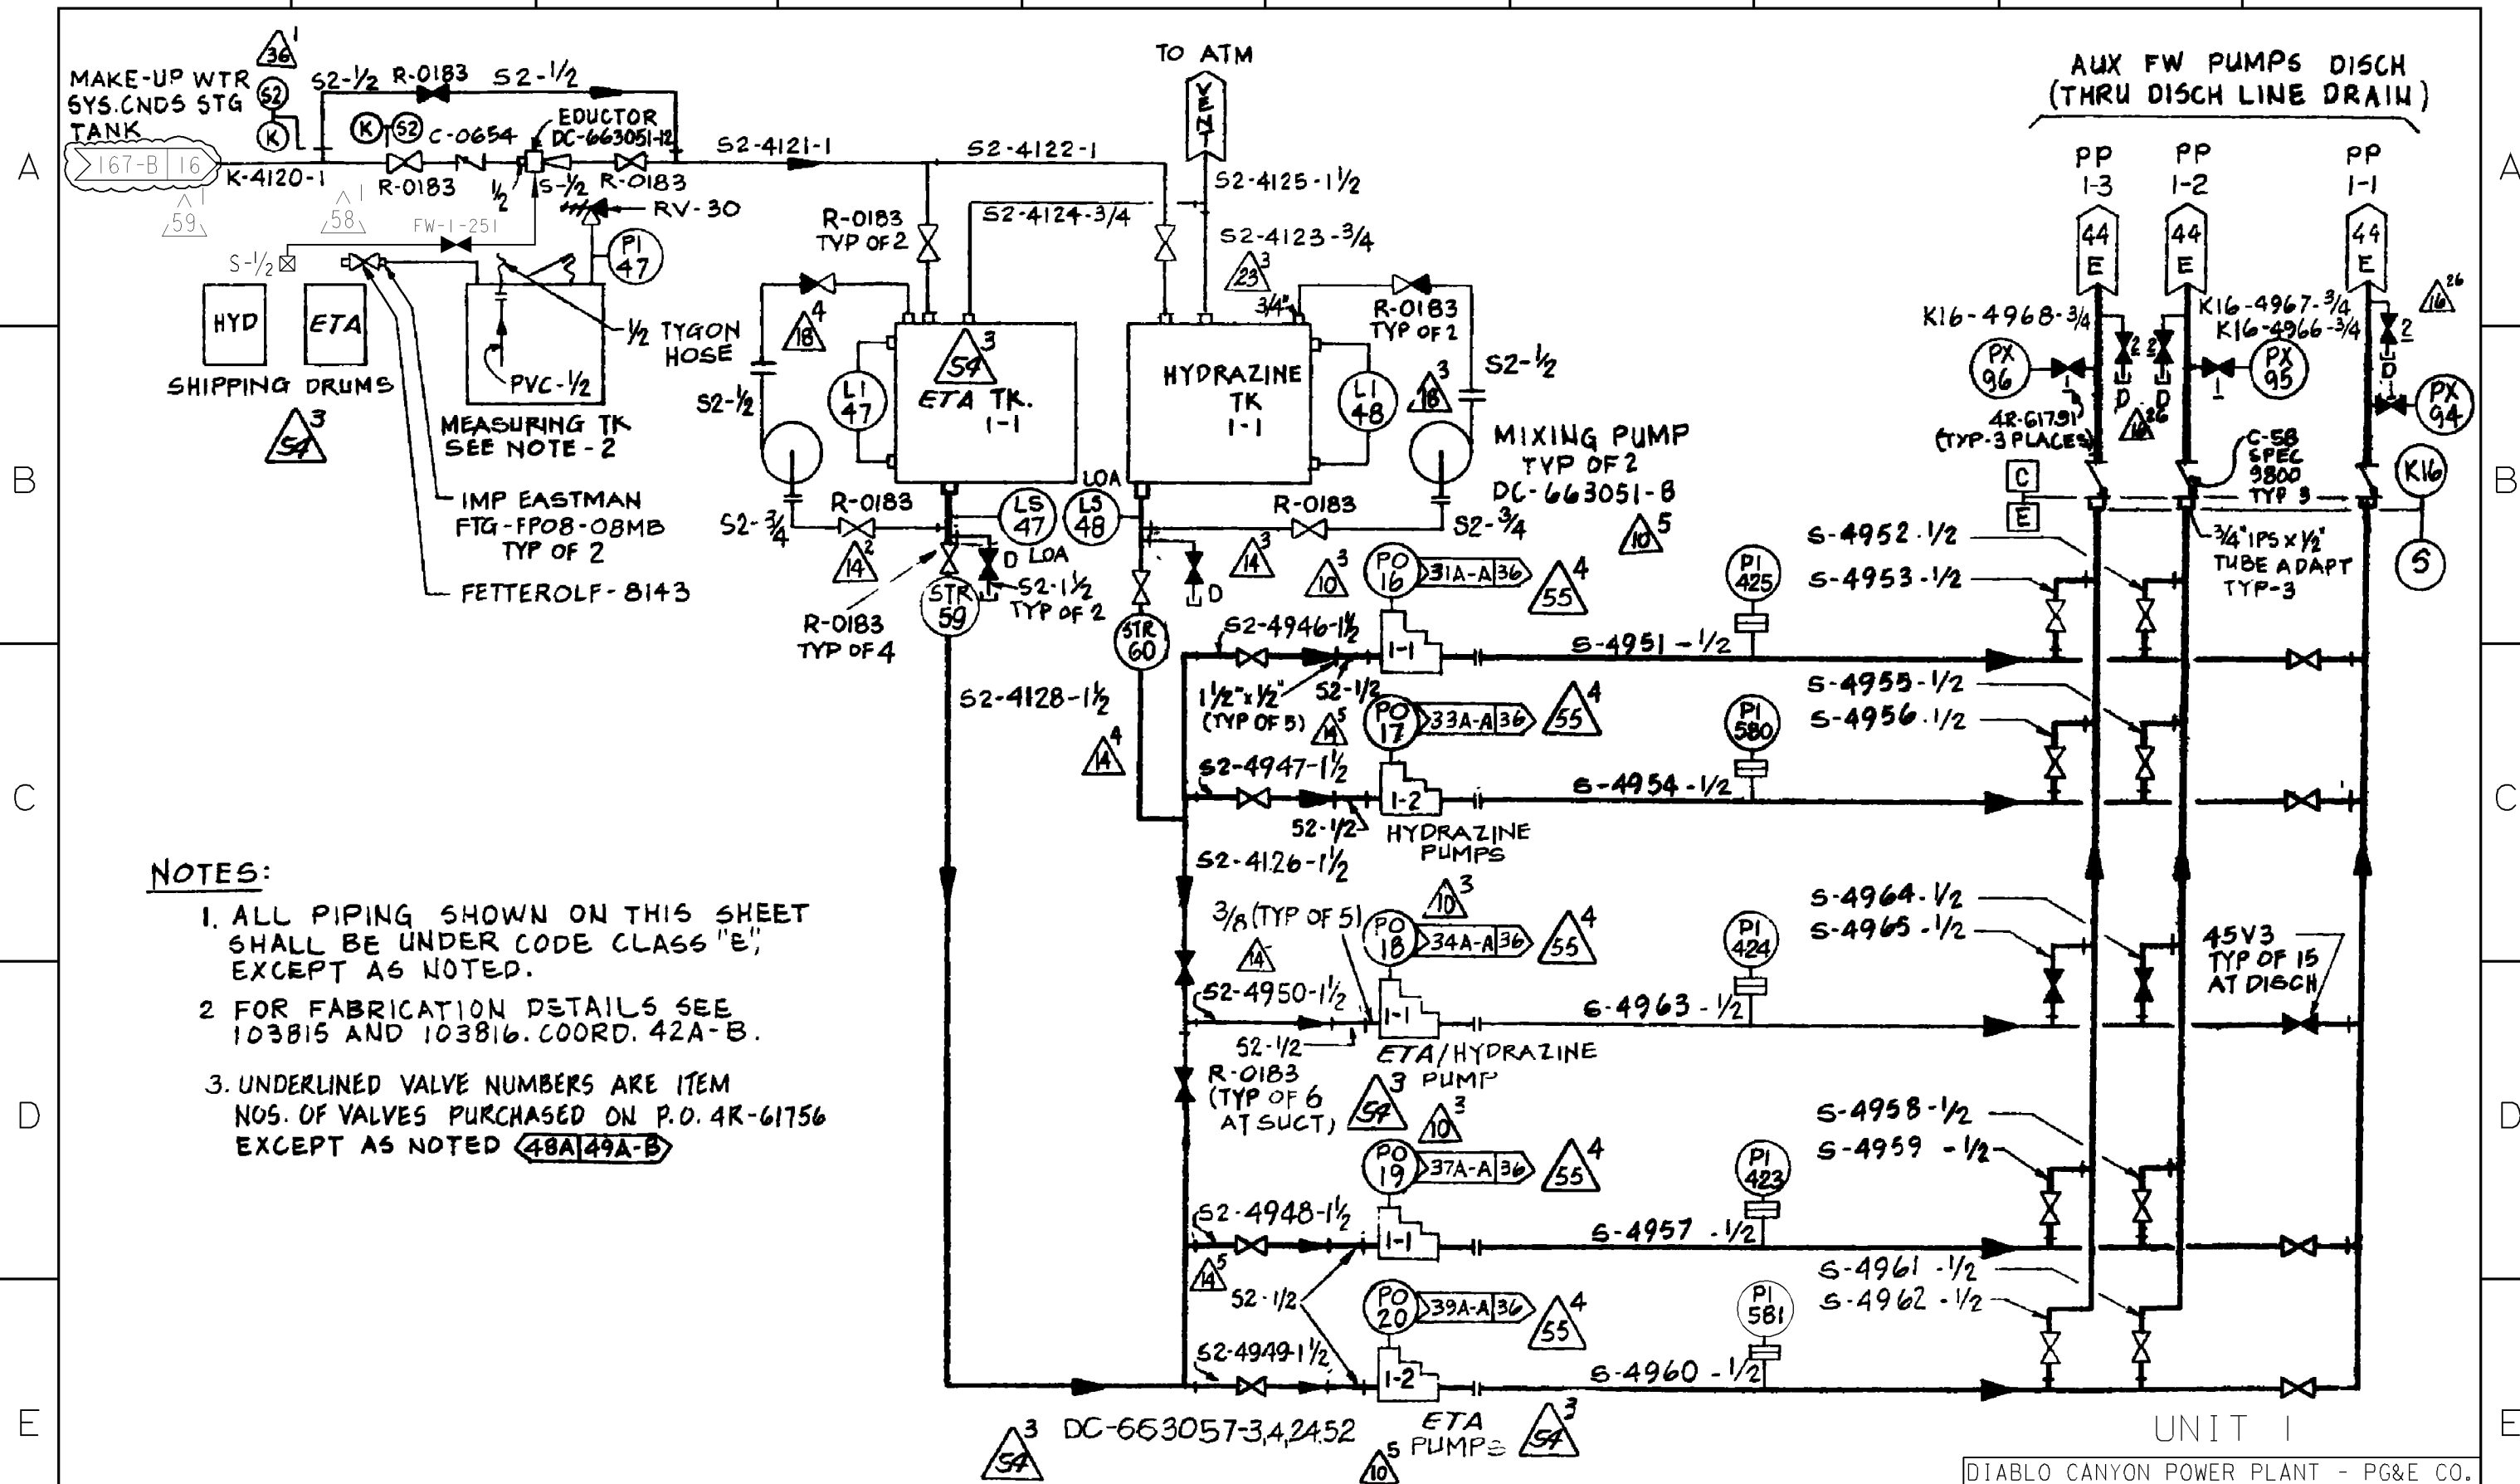

NOTES:


1. ALL PIPING SHOWN ON THIS SHEET SHALL BE UNDER CODE CLASS "E", EXCEPT AS NOTED.
2. FOR FABRICATION DETAILS SEE 103815 AND 103816. COORD. 42A-B.
3. UNDERLINED VALVE NUMBERS ARE ITEM NOS. OF VALVES PURCHASED ON P.O. 4R-61756 EXCEPT AS NOTED 48A 49A-B

AUXILIARY FEEDWATER ETA/HYDRAZINE INJECTION SYSTEM

DIABLO CANYON POWER PLANT - PG&E CO.

DRAWING	SHEET	PAGE	REV
102003	4A	0	59

01-04-2006	MIBF	KJD3		FRANCIS C. LING	MECHANICAL	M 16098	12/31/2007	REVISED PER FCT-030760
DATE	DWN	RE	IV	PROFESSIONAL ENGINEER	PE DISC.	PE#	PE EXP.	

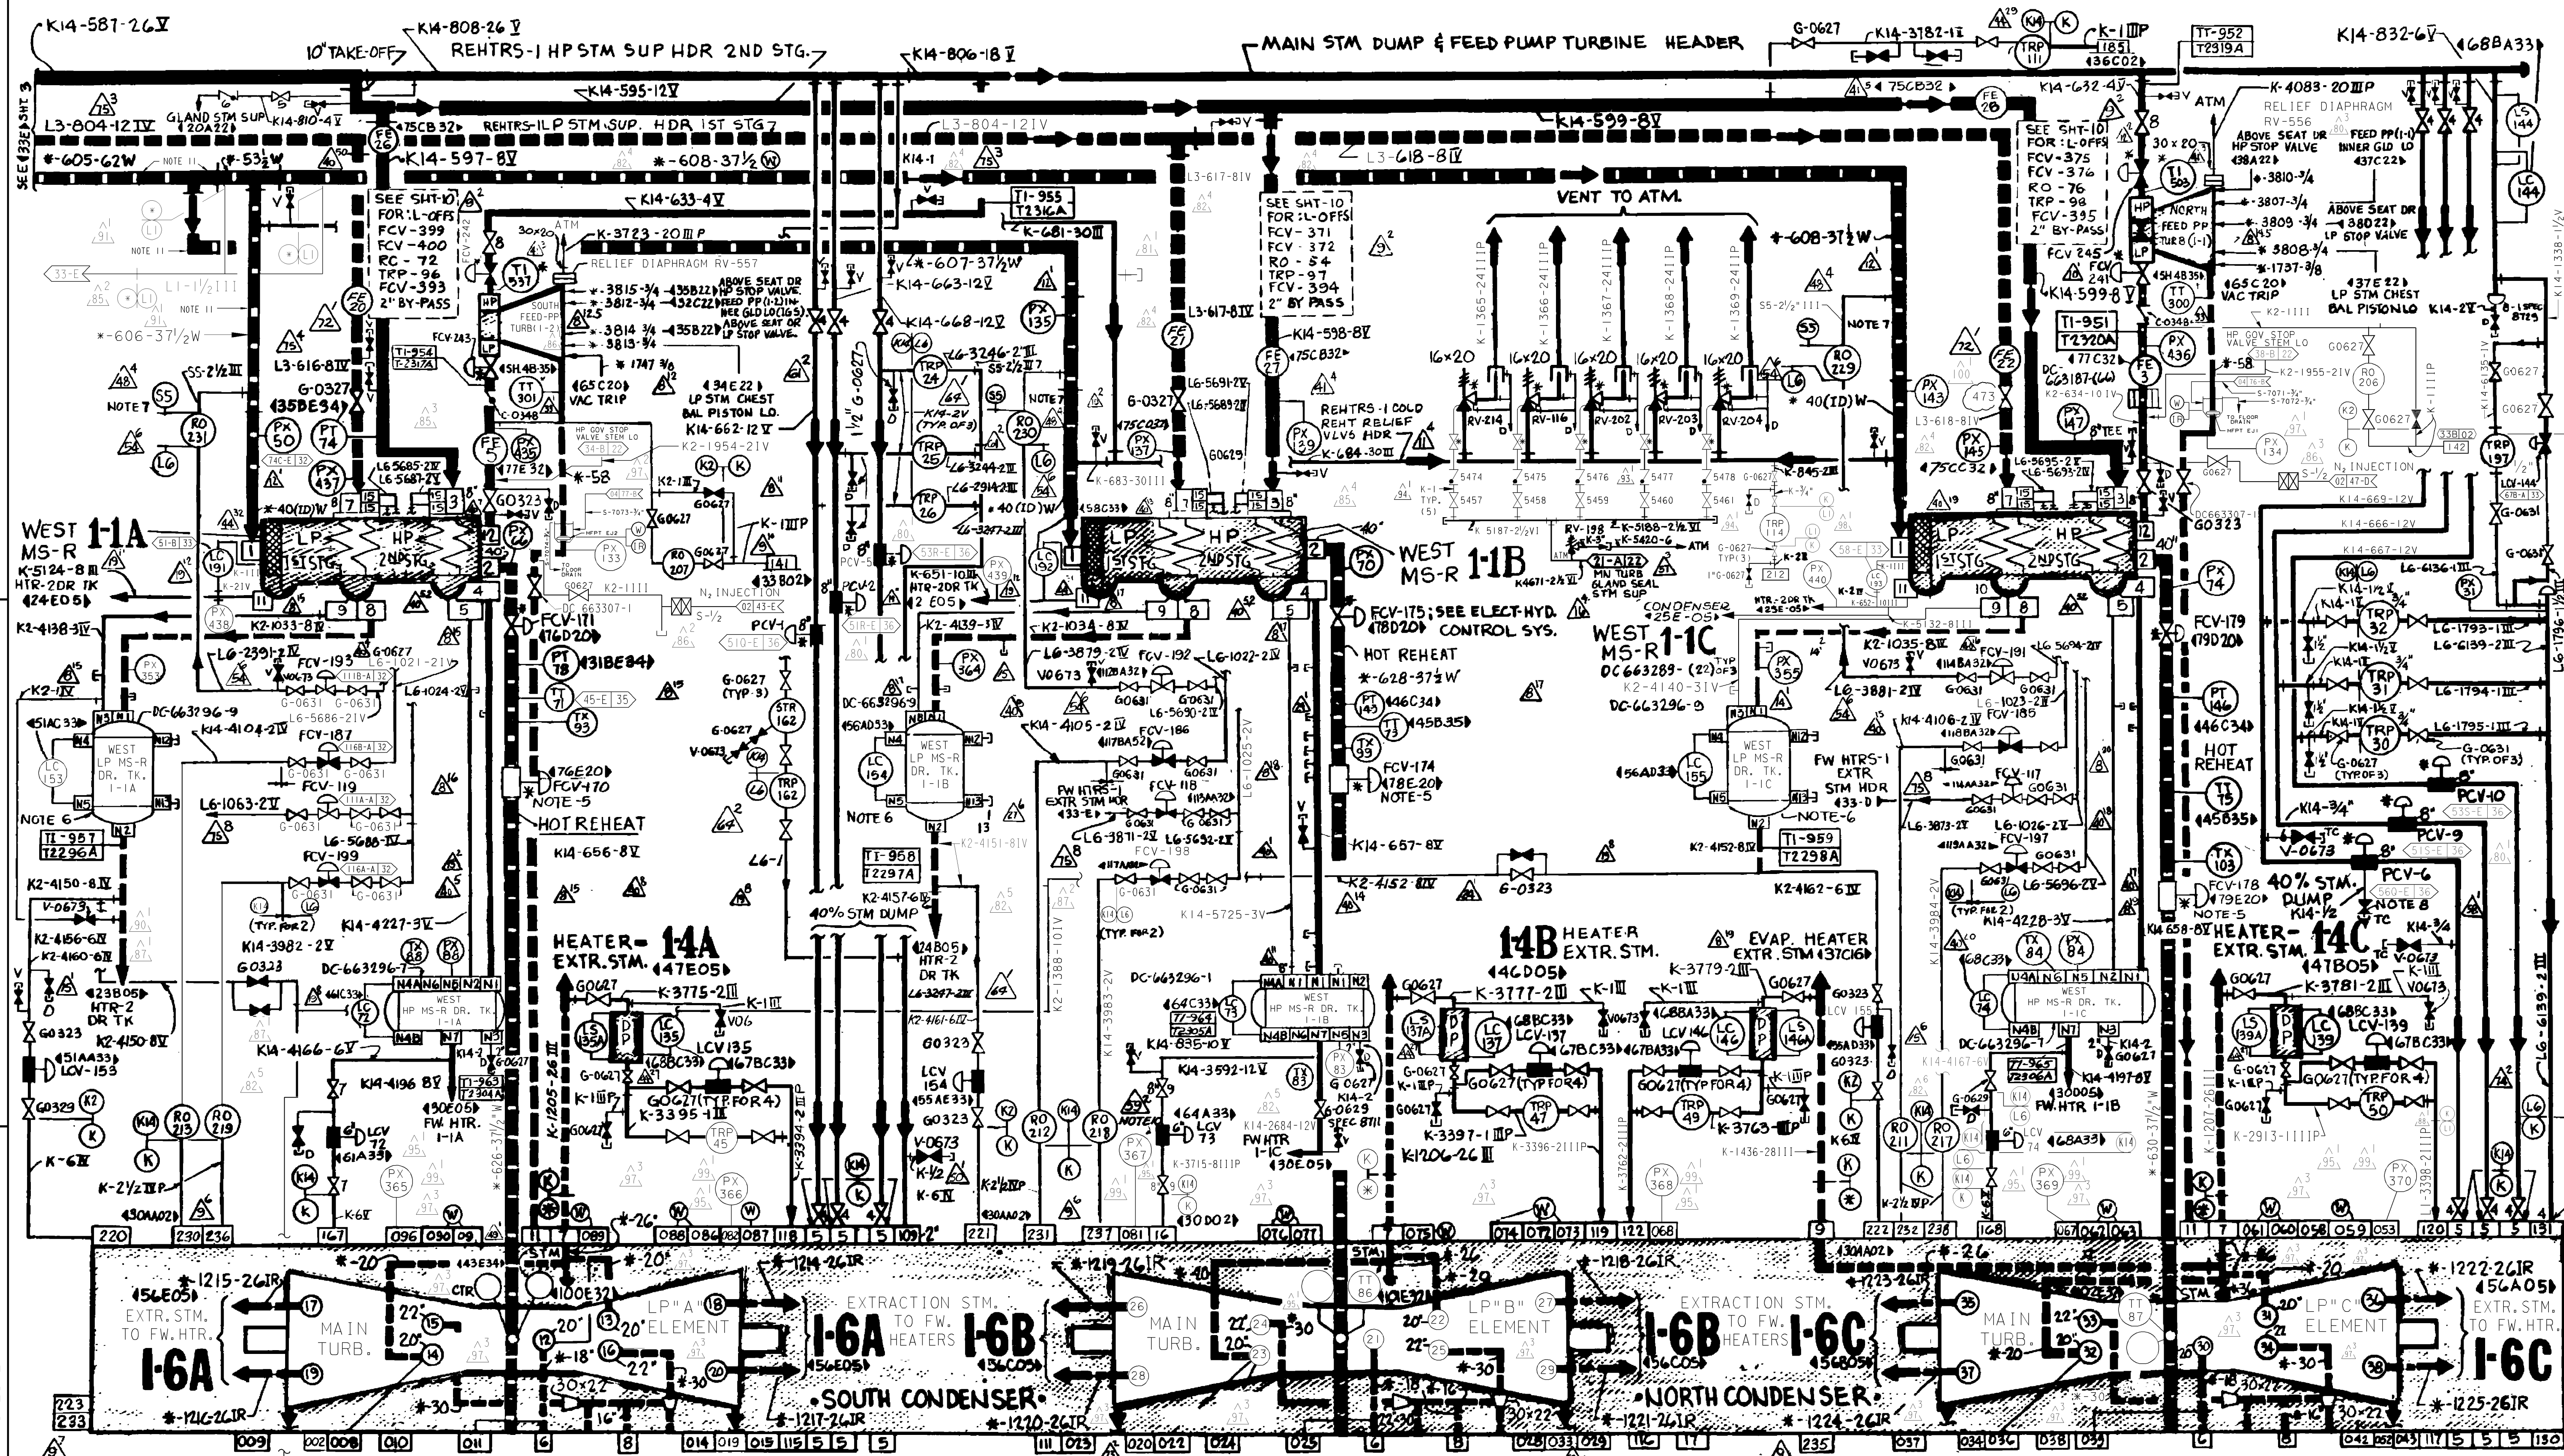

NOTES: 1. PG&E CODE CLASS [E] MANUAL VALVES WITH ITEM NOS. ARE UNDER SPEC. 8762.
2. ON ALL TRAPS AND LCV DRAINS, FULL INSULATION IS USED UPSTREAM AND PERSONNEL PROTECTION DOWNSTREAM.
3. (W) DENOTES WESTINGHOUSE NOZZLE.

4. ALL PIPING THIS SHEET: PG&E CODE CLASS [E]
5. REFER TO E-H SYS. DWG. 102004 SHTS. 3 & 3A.
6. ADDITIONAL INST. & NOZZLES FOR LPM-SR DRAIN TANK.

LP MS-R DRAIN TK.	LI	LS (LOA)	LS (LTA)
1-A	253	253A	253B
1-B	254	254A	254B
1-C	255	255A	255B


7. 2" PIPING DENOTED IS PG&E PIPING SPEC. S5, EXCEPT SOCKET WELDING ENDS ARE USED AT ELBOWS.
8. 1/2" GLOBE, DWG. 6006473-40 (39-D)
9. DELETED
10. CONDENSER NITROGEN INJECTION FOR DISSOLVED OXYGEN CONTROL IS THROUGH PX-367, FOR NITROGEN SUPPLY, SEE SYSTEM 05, (102005, COORD. 78-D), (36-C)
11. PORTIONS OF COLD REHEAT LINES I.D. CLAD W/ S.S. REF: A0401197/A0466559, (34-E)

FLOW LINE LEGEND
HIGH PRESSURE STEAM
AND CONDENSATE
LOW PRESSURE STEAM
AND CONDENSATE

UNIT I
DIABLO CANYON POWER PLANT - PG&E CO.
TURBINE STEAM SUPPLY SYSTEM

DRAWING	SHEET	PAGE	REV
102004	4	0	100


FLOW LINE LEGEND

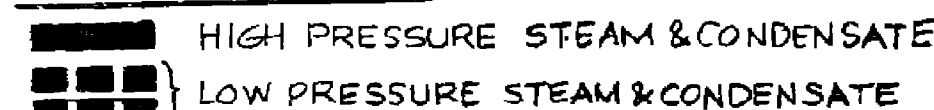

C

B

A

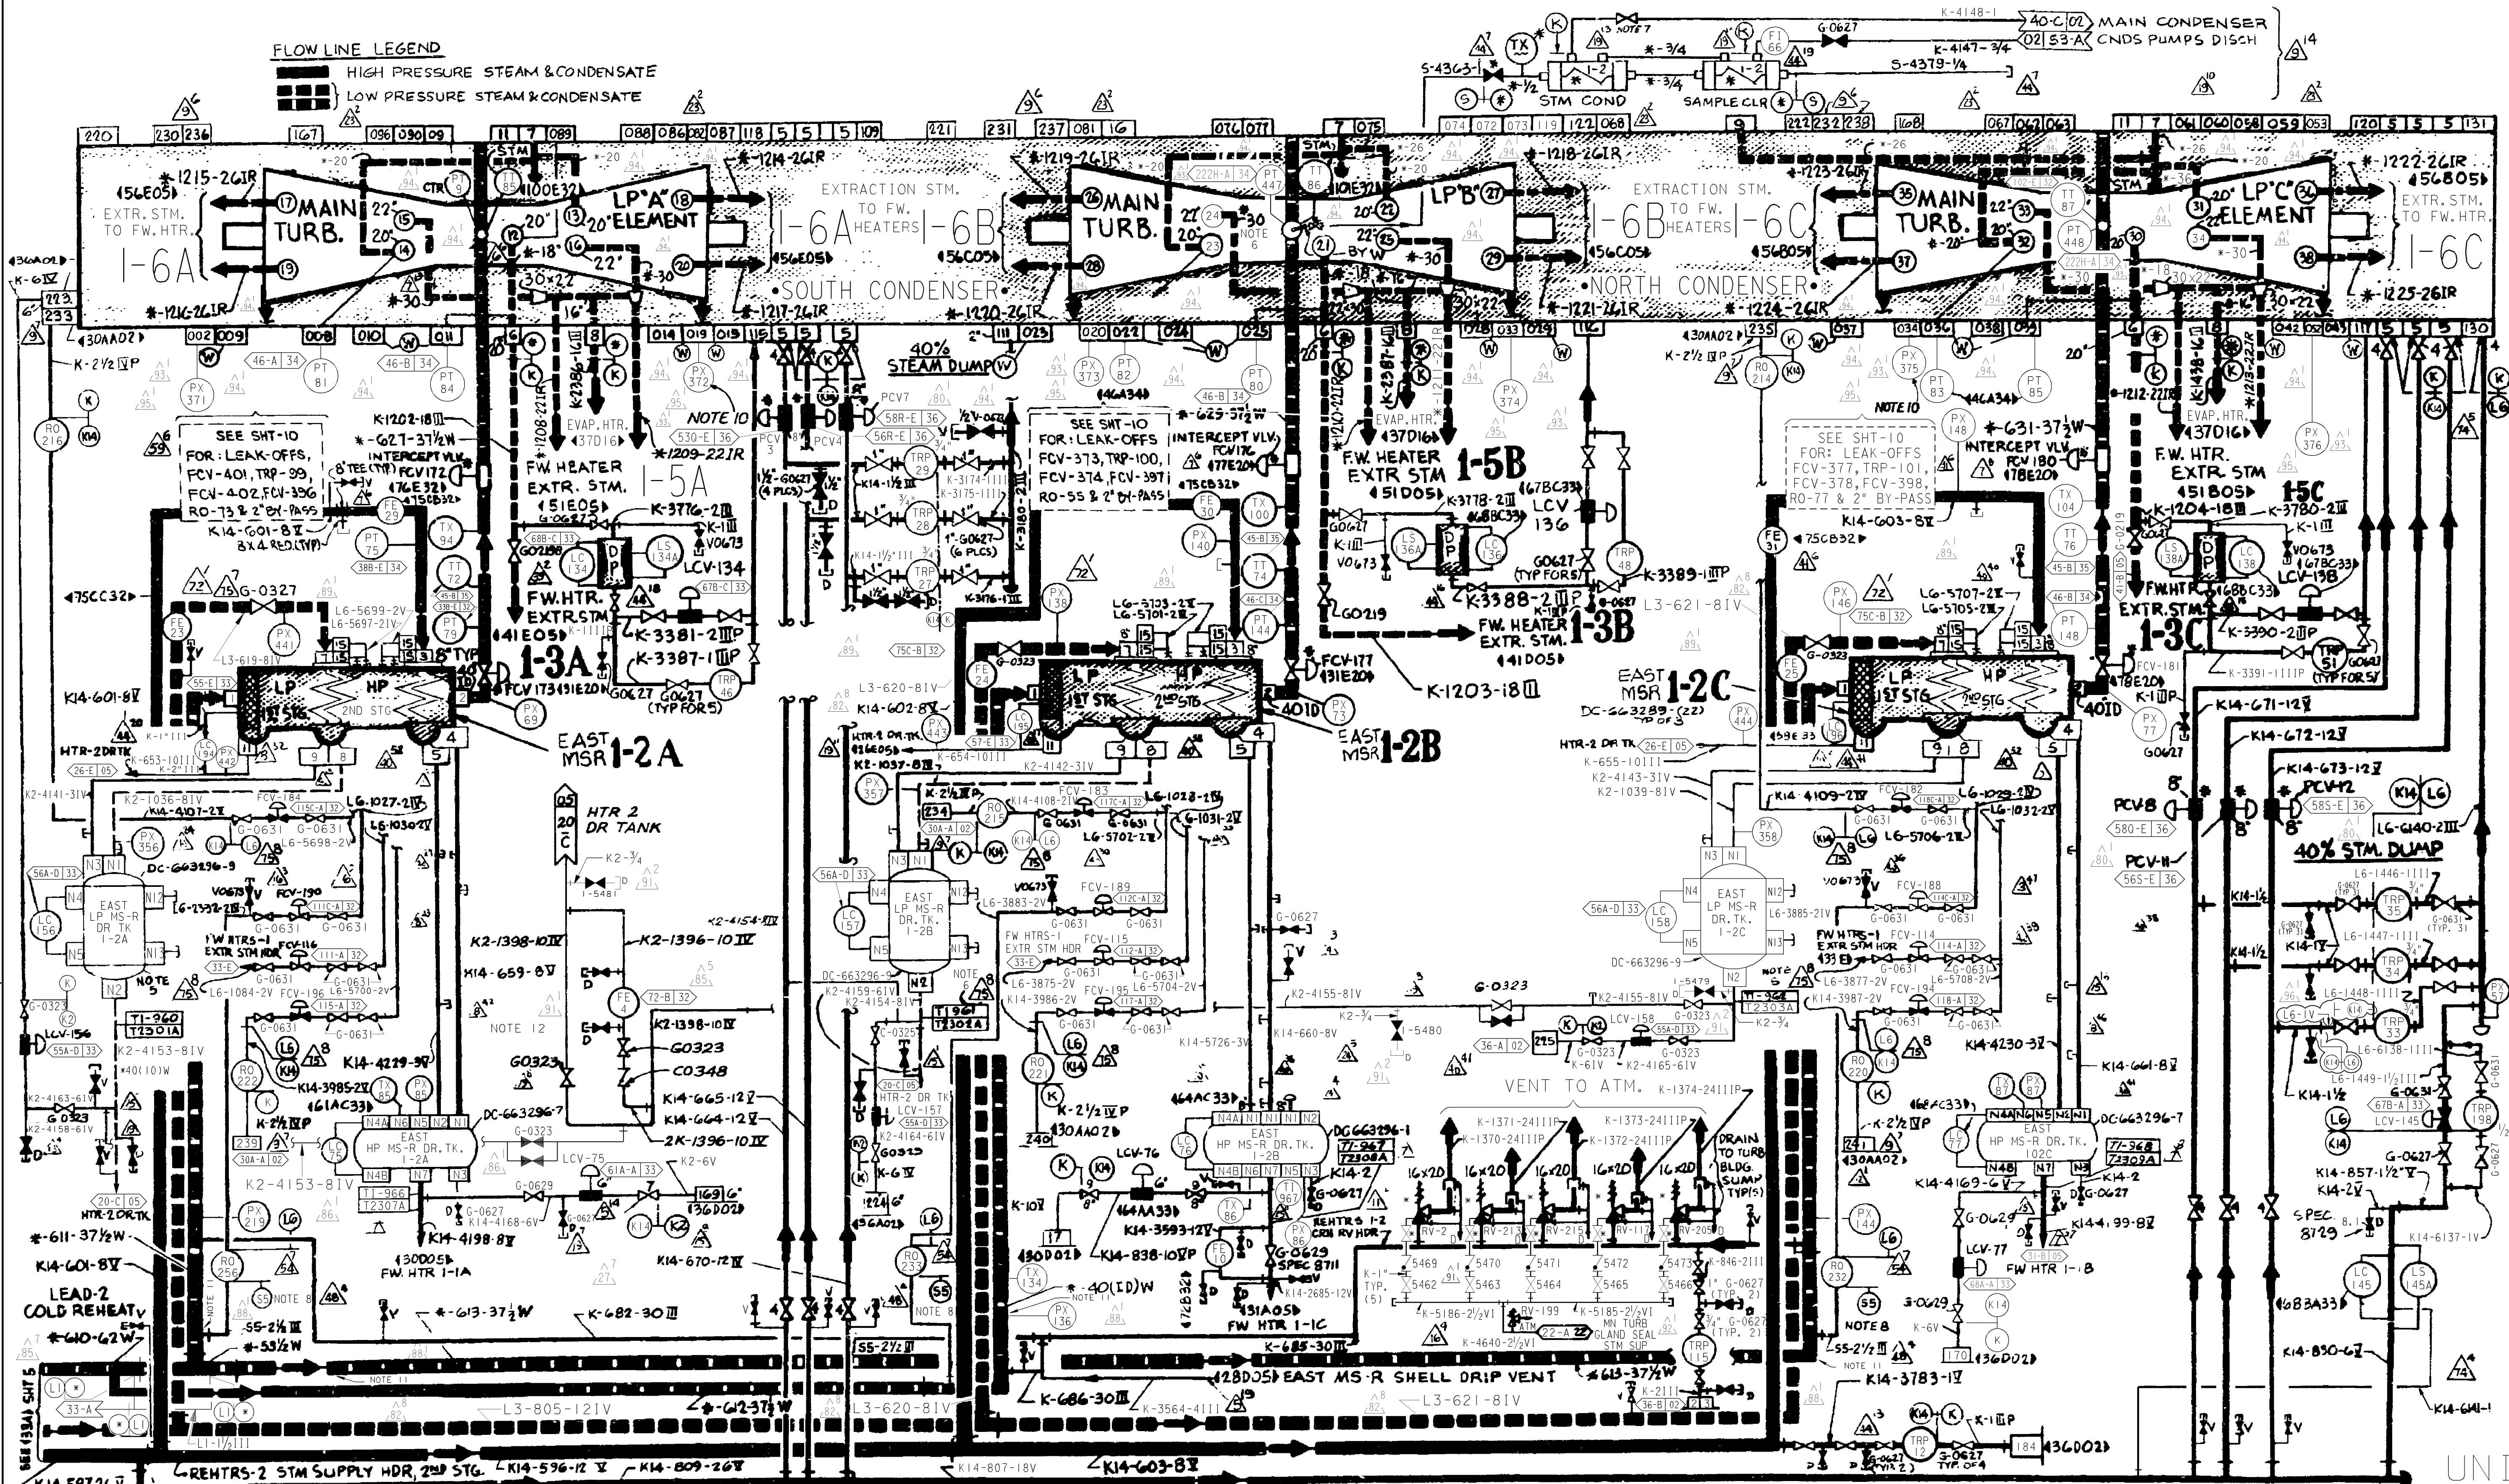

- NOTES:
1. PG&E CODE CLASS [E] MANUAL & MOTOR OPERATED VALVES WITH ITEM NO. ARE UNDER SPEC. 8762. ON ALL TRAP & LCV DRAINS FULL INSULATION IS USED UP STREAM AND PERSONNEL PROTECTION DOWNSTREAM.
 2. [W] DENOTES WESTINGHOUSE NOZZLE.
 3. ALL PIPING THIS SHEET: PG&E CODE CLASS [E].
 4. ADDITIONAL INST. & NOZZLES FOR LP MS-R DRAIN TANK.
 5. NOZZLE SAMPLE DAB BY WESTINGHOUSE (DWG. DC-663280-65) (36-C).
 6. 1" VOGT GLOBE VALVE SER 12141P HF 800 W.P. (37-C).

LP MS-R	LI	LS (LOA)	LS (MIA)
DRAIN TK	NOZ. N7/N6	NOZ. N8/N9	NOZ. N10/N11
I-2A	256	256A	256B
I-2B	257	257A	257B
I-2C	258	258A	258B


8. 2 1/2" PIPING DENOTED IS PG&E PIPING SPEC. S5 EXCEPT SOCKET WELDING ENDS ARE USED AT ELBOWS.
9. DELETED
10. COND. N₂ INJ. FOR DISSOLVED O₂ CONT. IS THRU PX-372 & PX-375. FOR N₂ SUPPLY SEE SYSTEM 05 (102005, COORD. 78-DX38-C).
11. PORTIONS OF COLD REHEAT LINE I.D. CLAD W/ S.S. REF: A0401197/A0466559. (34/36-38-A)
12. VALVE DELETED.

UNIT I

DIABLO CANYON POWER PLANT - PG&E CO.
TURBINE STEAM SUPPLY SYSTEM

DRAWING	SHEET	PAGE	REV
102004	6	0	96

STEAM GENERATORS BLOWDOWN TREATMENT DEMINERALIZER SYSTEM

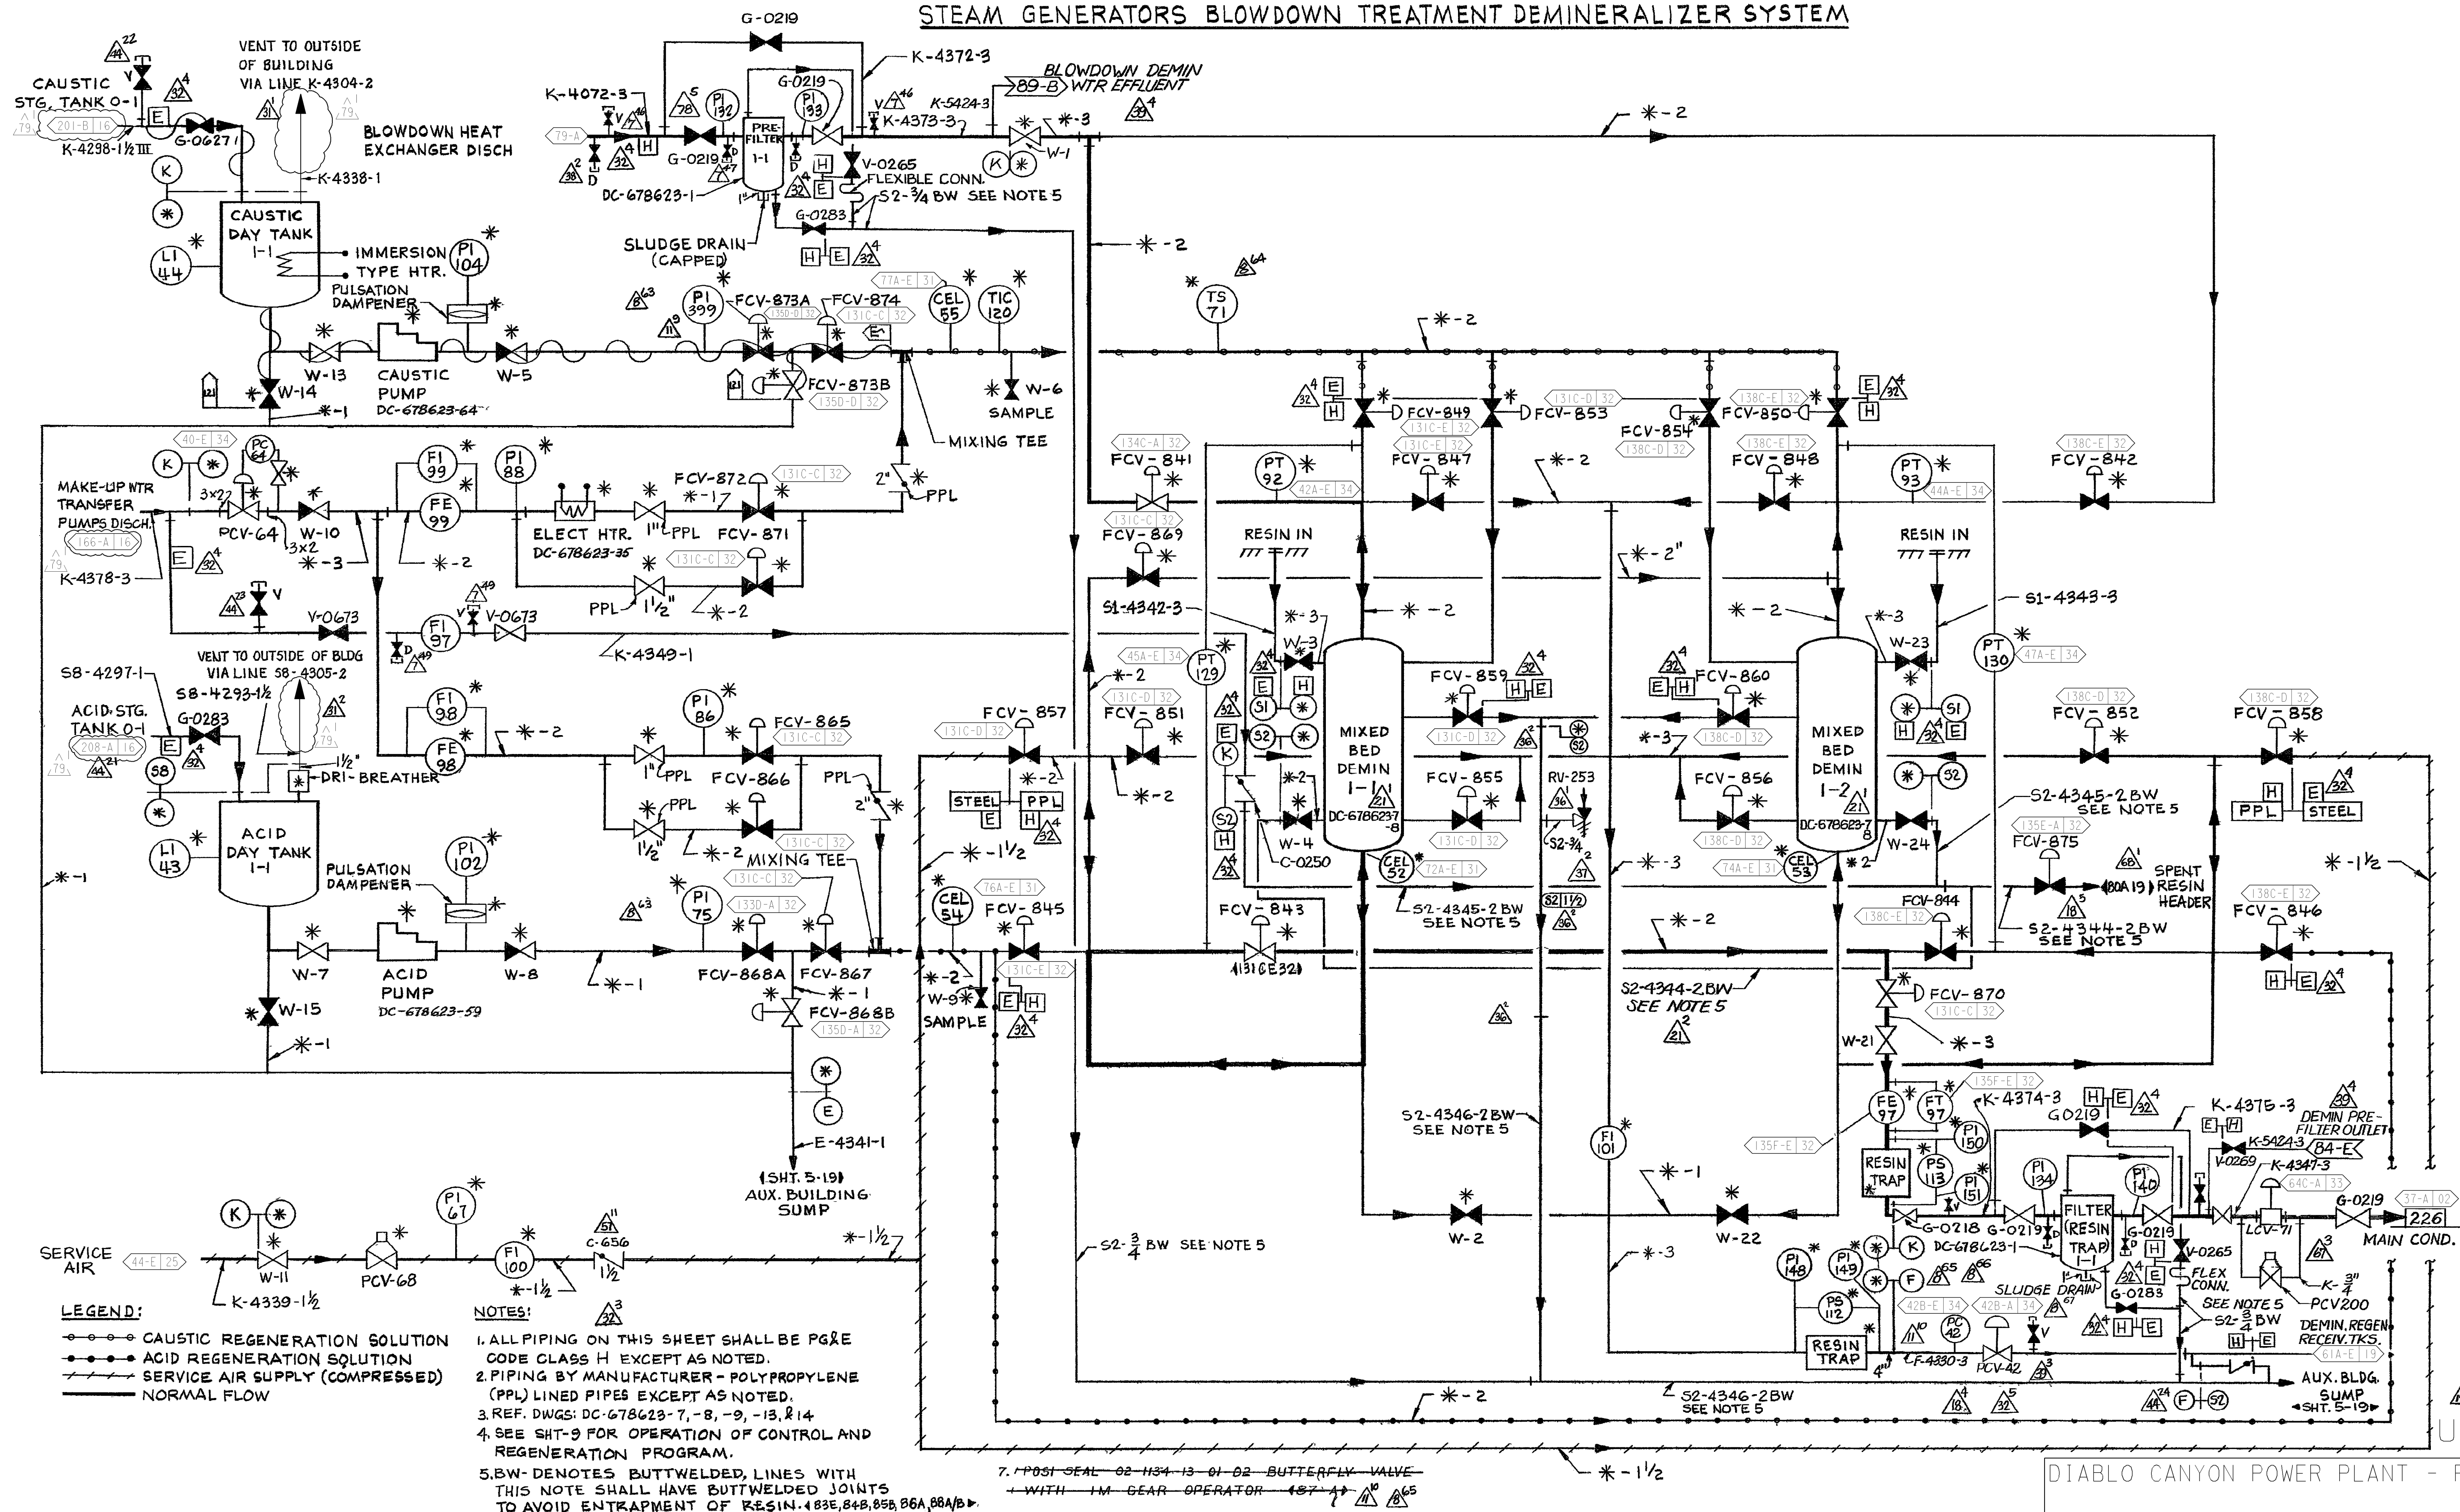


DIABLO CANYON POWER PLANT - PG&E CO.

DRAWING	SHEET	PAGE	REV
102004	8	0	79

OPERATION OF CONTROL AND REGENERATION PROGRAM FOR STEAM GENERATORS BLOWDOWN CLEAN-UP MIXED BED DEMINERALIZERS

[illegible]

LEGEND: ○ VALVE OPEN (PIN INSERTED)
● VALVE CLOSED
R PUMP RUNNING

RI GENERANT INLET WATER
SI SERVICE INLET
 PIN INSERTED

H₂SO₄ - 98% ACID
NaOH - 50% CAUSTIC

P. G. & E. CO.

SHEET 9 OF SHEETS

102004

CHANGE

19

35 M/M NEC

SCANNED:

CAD User: MIBF Date: 5-11-2004
DCN=2005S2.DGN
RASTER=2005S2.TIF

MOISTURE SEP. - REHTR & FW HTR DRAINS

WEST MS-R SHELL DRAIN

EAST MS-R SHELL DRAIN

FEEDWATER HTR. DRAINS

HEATER-2 DRAIN TANK

DC-663052-2

NOTES:

1. NOZZLE NOS. 14, 15, & 16 SHALL BE FIELD INST.
2. REDUCER MATERIAL IS B564 ALLOY 600 FORGING.

3. PIPE IS A312 TP304L, SOCKOLET AND THREADED CAP ARE A182 GR. F304L.
4. HTR-2 DRAIN PP-1-1 SHALL TRIP ON LOW HTR-2 DRAIN TANK LEVEL OR TURBINE TRIP.
5. 1"-1500# YARWAY HY-DROP THROTTLE VALVE FIG. 6013-F22.
6. START-UP STRAINER SHALL BE INSTALLED AND REMOVED AS NEEDED (REF. PROJECT FILE 20.258.6)
7. 8" SCH. 40 PIPE MATERIAL IS A312 TP304L.
8. FLANGE MATERIAL IS A182 GR. F304L.
9. REDUCER MATERIAL IS B564-600 FORGING. ALSO ACCEPTABLE IS B167 ALLOY 600 COLD DRAWN REDUCER, FROM SEAMLESS PIPE. B564 & B167 FALL UNDER ADDITIONAL REQUIREMENTS OF ASTM B366.
10. FE-122 SHALL BE CALIBRATED PER QUALIFIED PROCEDURES PRIOR TO BEING USED TO CALIBRATE REACTOR POWER LEVEL. SEE DWGS. 663187-227 THRU 234 FOR MATERIALS AND CONST. DET.
11. 1-FE-80 TO USE TAP SET NO. 1 AT 1-FE-122.

12. PIPING MATERIALS ARE A335-P11, A182-F11 & A234-WP11. PIPING MATERIAL IS A335-P22.
13. I.D. OF NOZZLE HAS BEEN CLAD WITH INCONEL.
14. NOZZLE I.D. CLAD WITH INCONEL.

P G & E CO.
SHEET 2 PAGE 0

102005

REV.
48

5/11/04

MIBF

FXC2

-

KERSI J. DALAL

MECHANICAL

M 16690

3/31/2006

Revised per FCT 028824

DATE

DWN

RE


IV

PROFESSIONAL ENGINEER

PE DISC.

PE#

PE EXP.

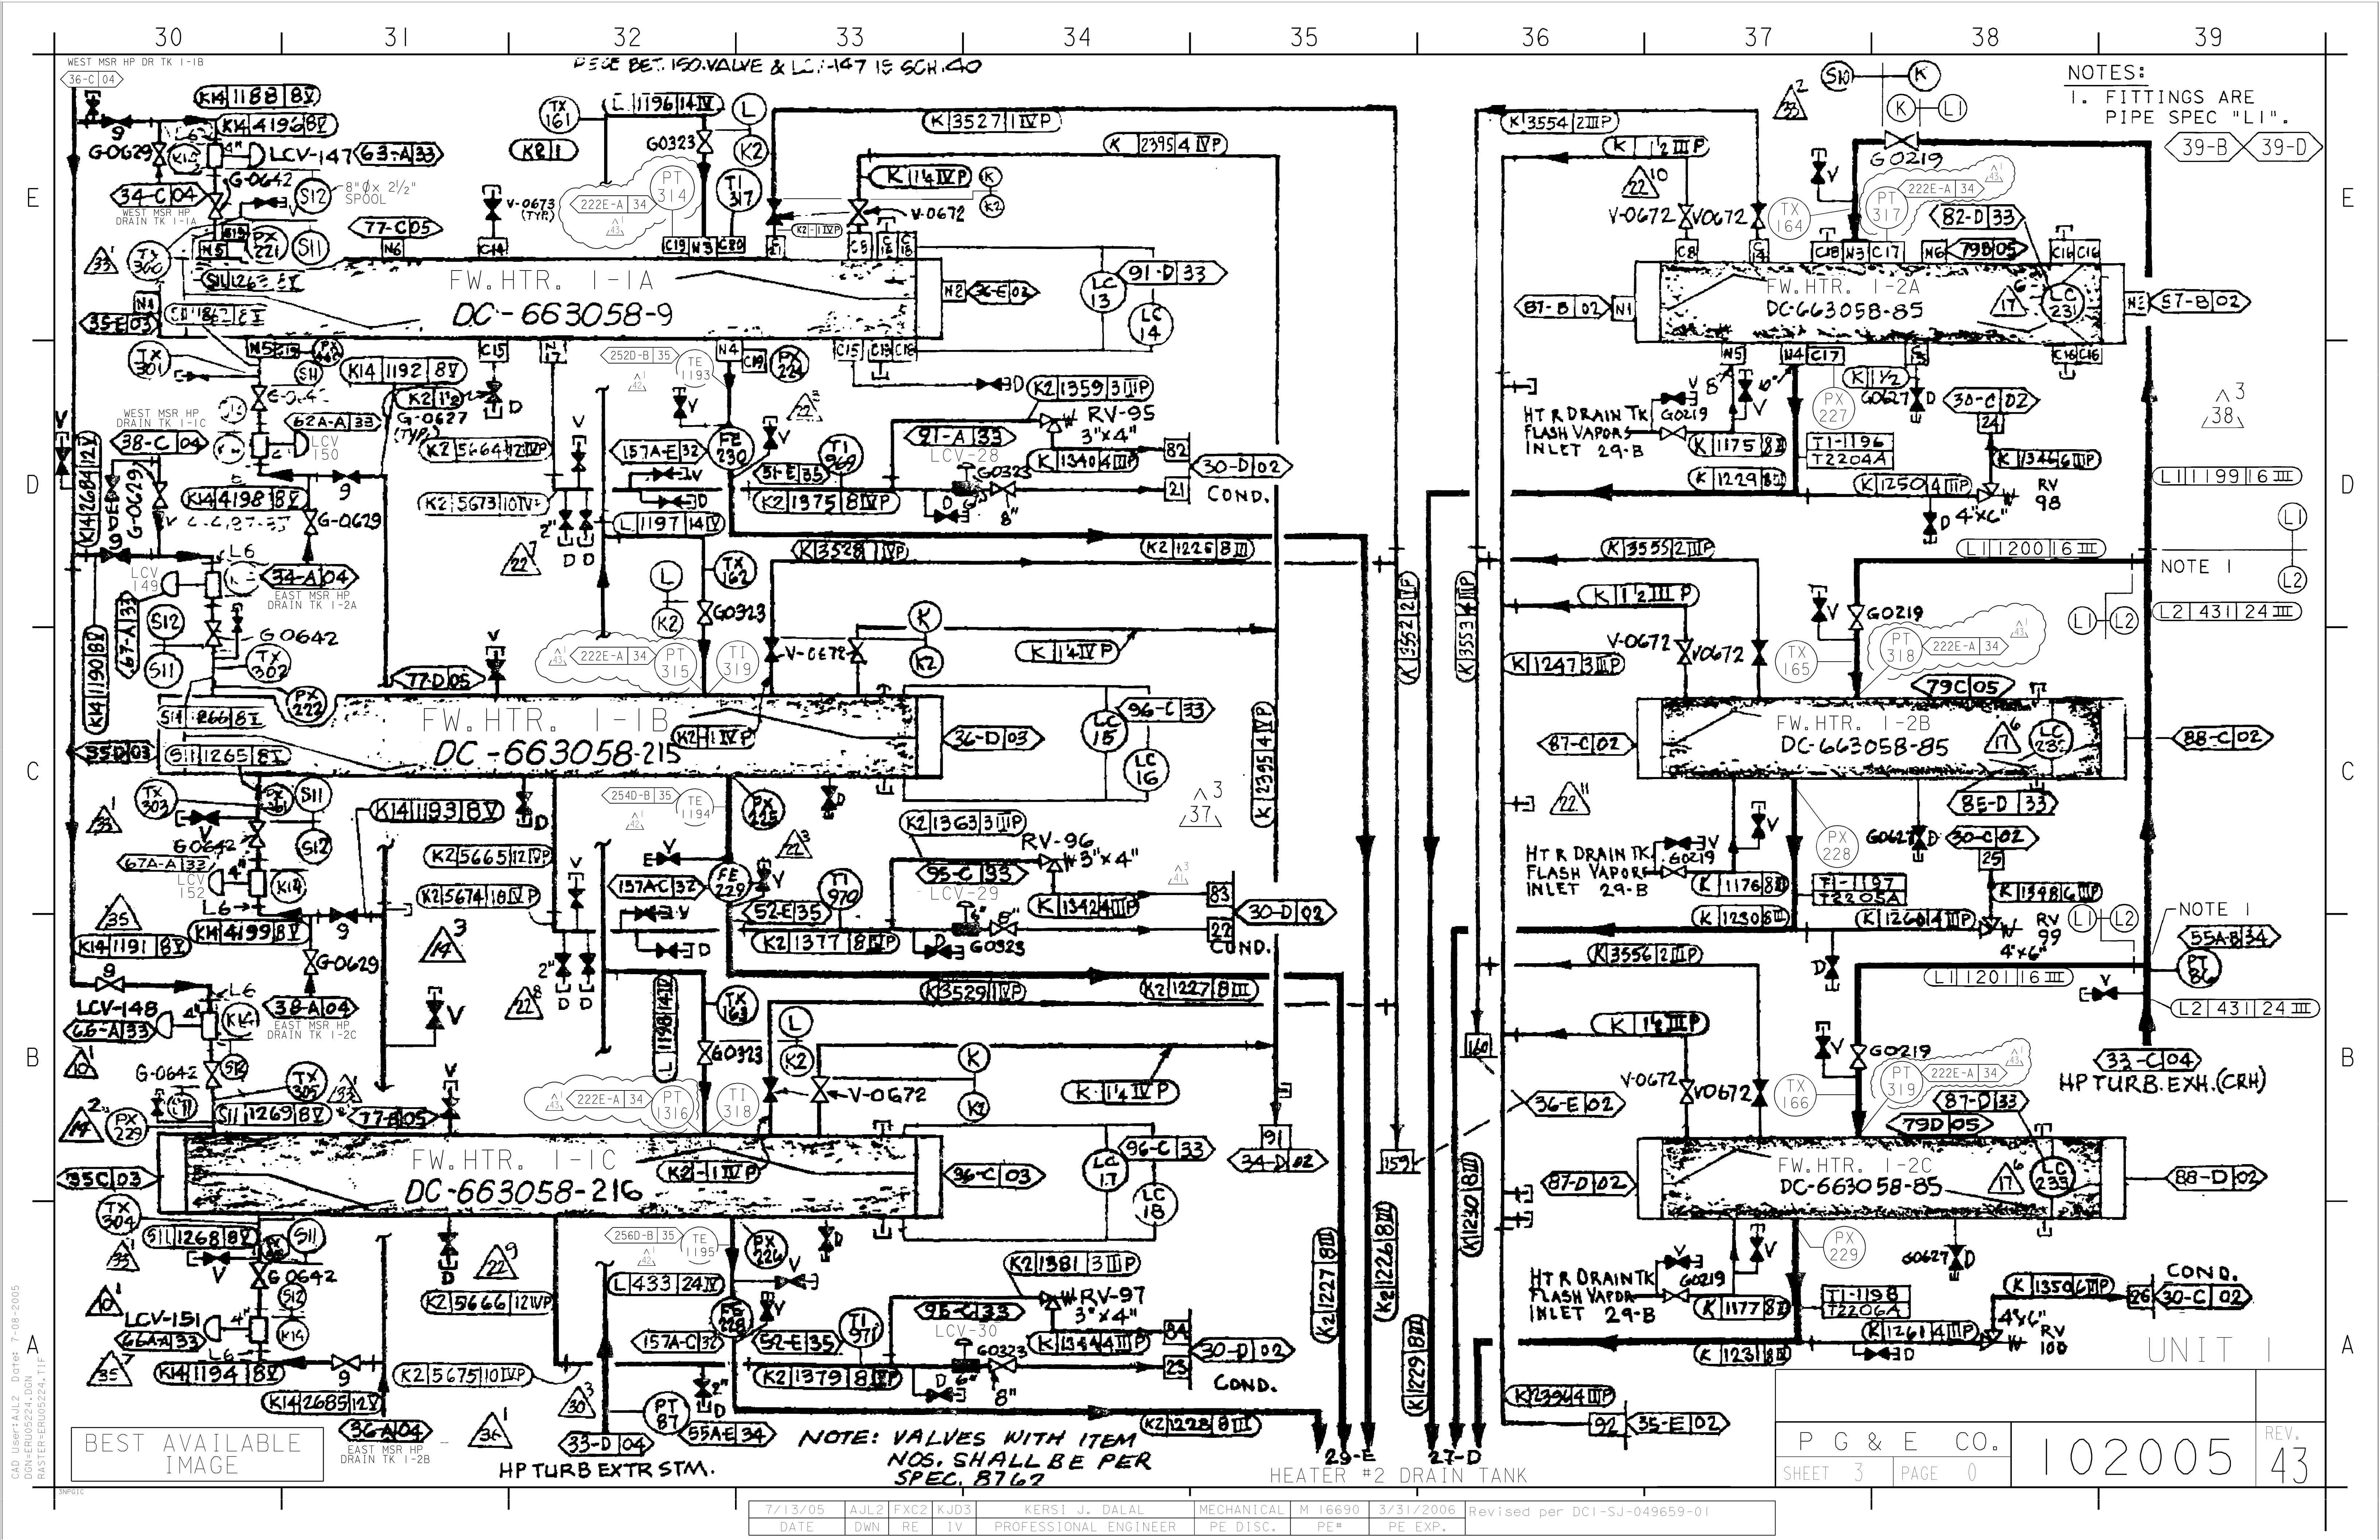

NOTES:
1. FITTINGS ARE
PIPE SPEC "LI".

39-B 39-D

38

LI 1199 6 III

NOTE I
L2 431 24 III

88-C 02

NOTE I
55A-B 34

L2 431 24 III

33-C 04

87-D 33

88-D 02

UNIT I


BEST AVAILABLE
IMAGE

EAST MSR HP
DRAIN TK I-2B

HP TURB EXTR STM.

NOTE: VALVES WITH ITEM
NOS. SHALL BE PER
SPEC. 8767

HEATER #2 DRAIN TANK

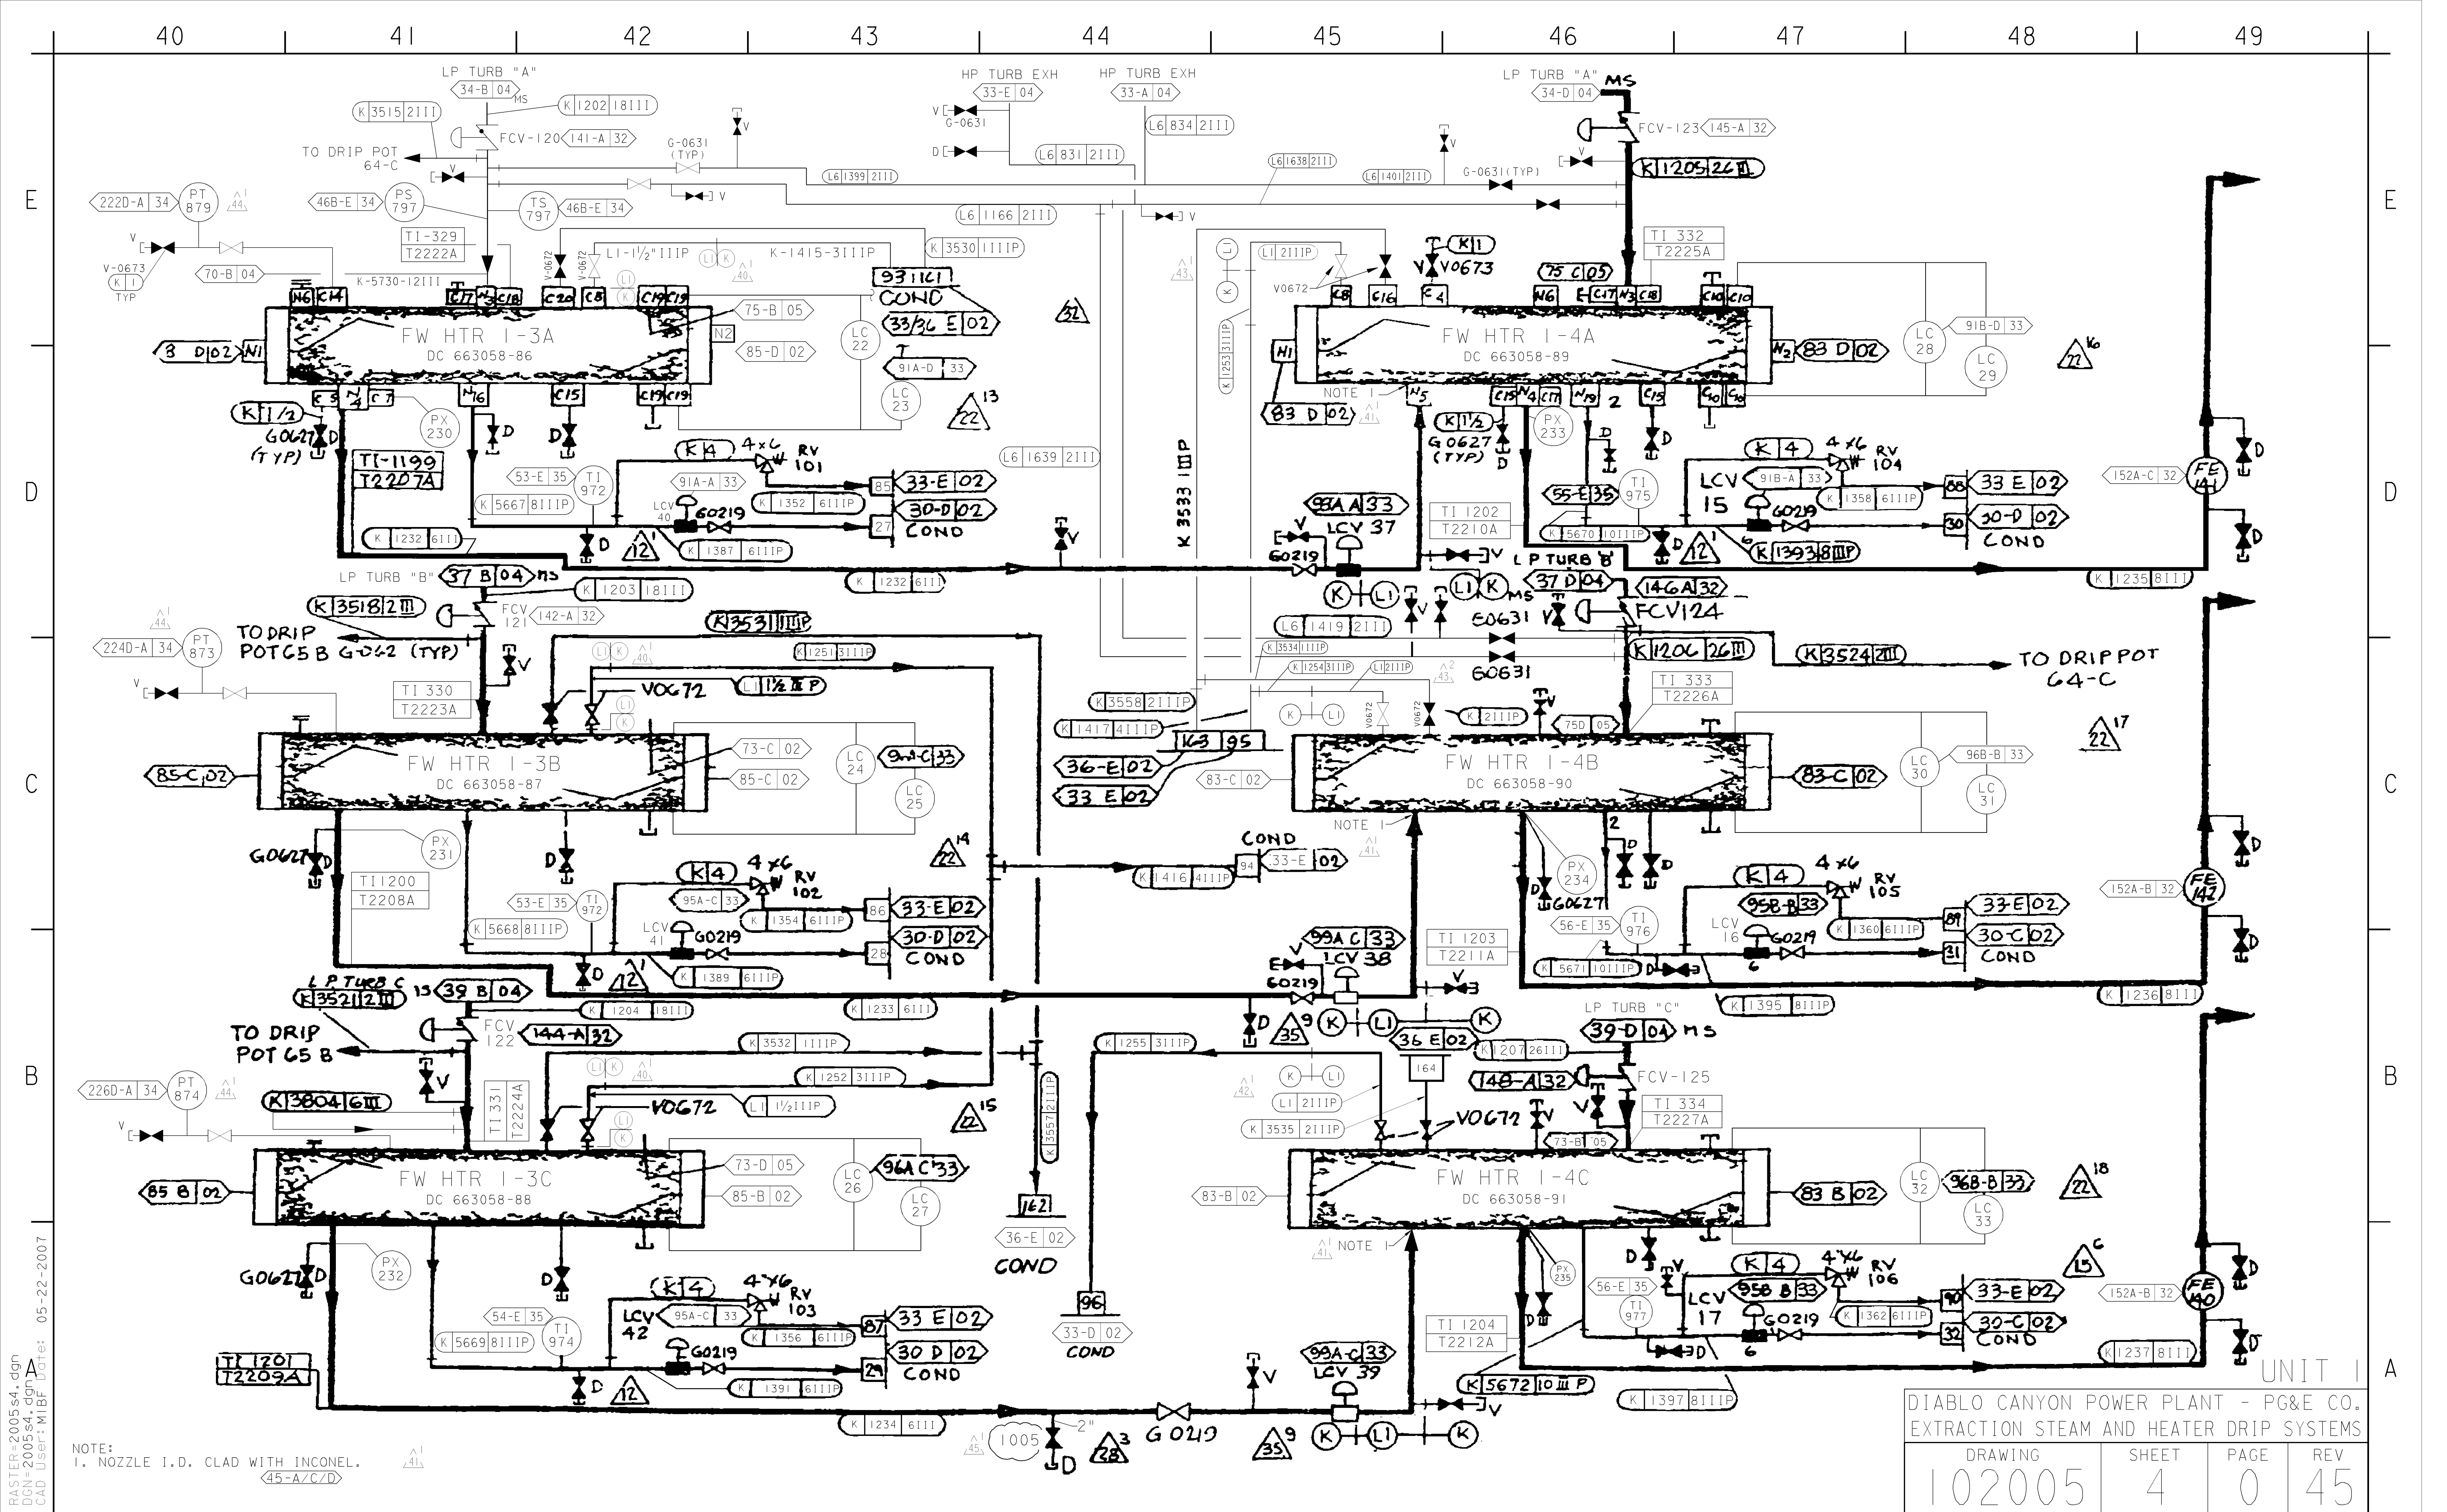

NOTE:
1. NOZZLE I.D. CLAD WITH INCONEL.
45-A/C/D


DIABLO CANYON POWER PLANT - PG&E CO.
EXTRACTION STEAM AND HEATER DRIP SYSTEMS

DRAWING	SHEET	PAGE	REV
102005	4	0	45

05-22-2007	MIBF	FXC2	KERSI J. DALAL	MECHANICAL	M 16690	3/31/2008	REVISED PER FCT-32438
DATE	DWN	RE	IV	PE DISC.	PE*	PE EXP.	

RASTER=2005s5.dgn
DGN=2005s5.dgn
CAD User: ADMI

Date: 03-06-2009

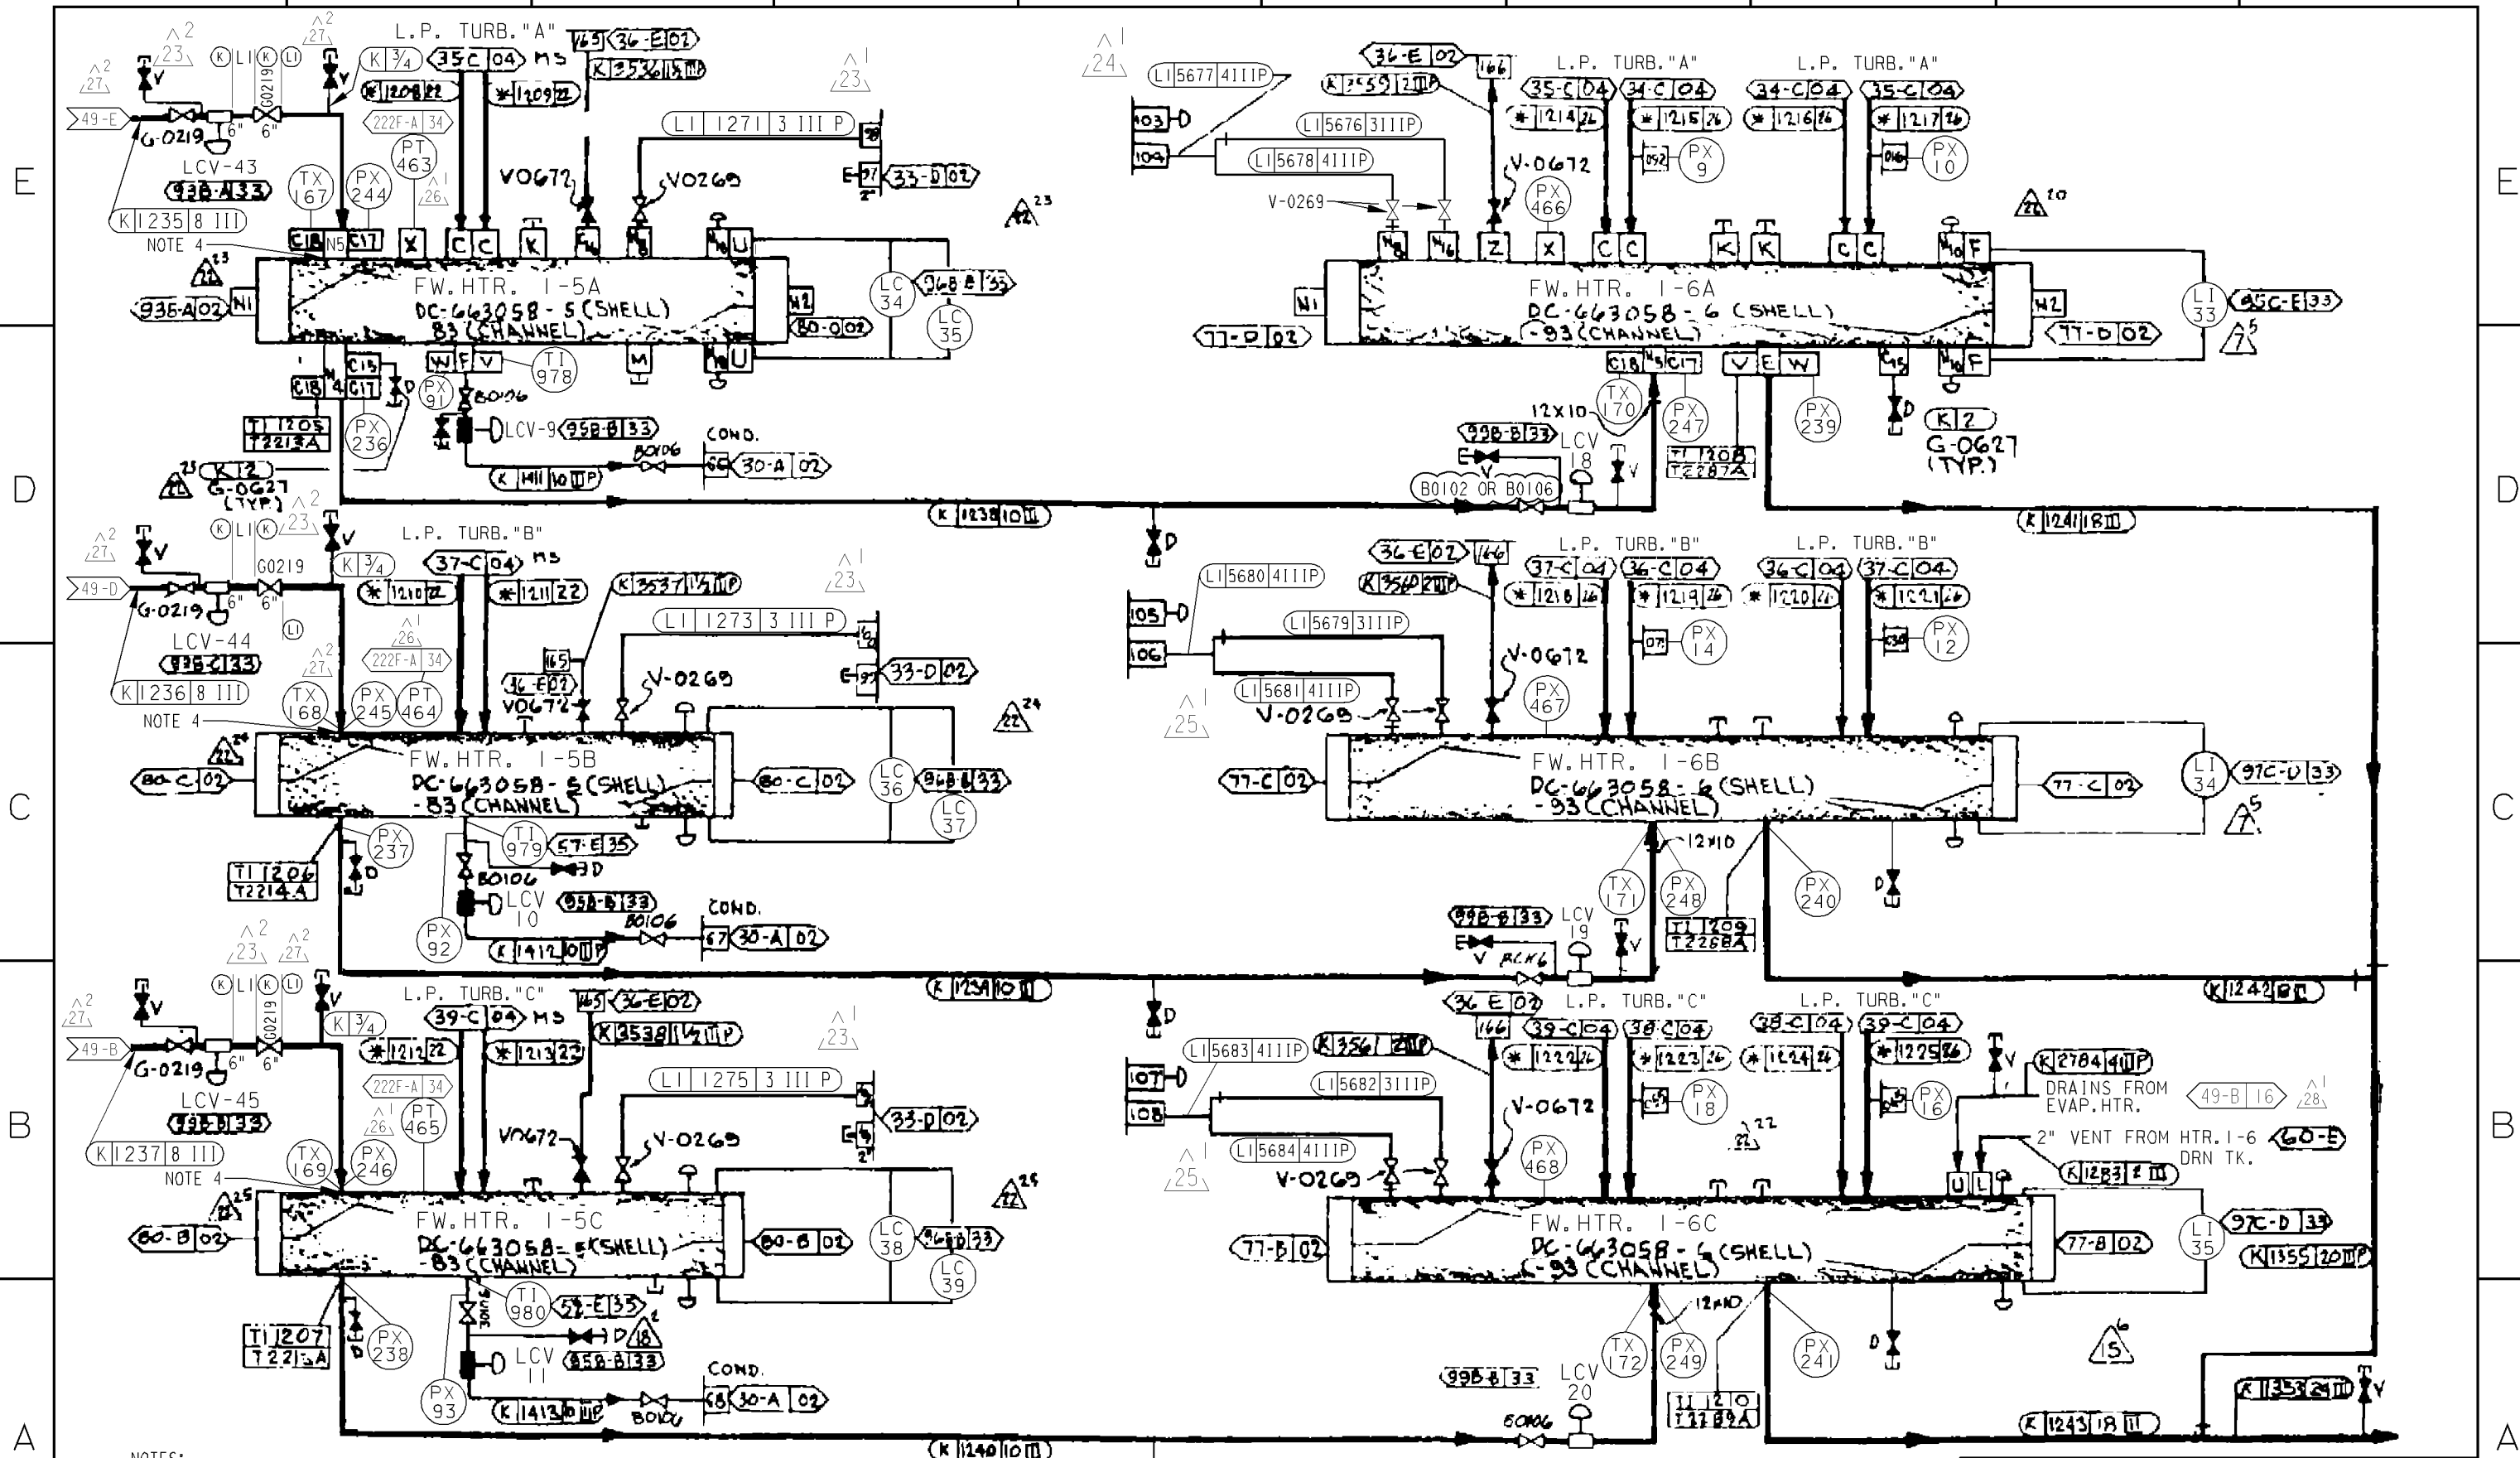

NOTES:

1. HTRS 5 & 6 ARE LOCATED IN CONDENSER NECK
2. DELETED
3. * INDICATES PIPING BY I.R. (INGERSOLL RAND) UNDER SPEC 8701
4. FAC - RESISTANT CLADDING APPLIED INSIDE NOZZLE N5 (51-B/C/E)


DIABLO CANYON POWER PLANT - PG&E CO.
EXTRACTION STEAM AND HEATER DRIP SYSTEMS


UNIT I

DRAWING	SHEET	PAGE	REV
102005	5	0	29

INPG1C
I Size

03-06-2009	ADMI	FxC2		KERSI J. DALAL	MECHANICAL	M 16690	3/31/2010	REVISED PER DDT-4*273-0
DATE	DWN	RE	IV	PROFESSIONAL ENGINEER	PE DISC.	PE#	PE EXP.	

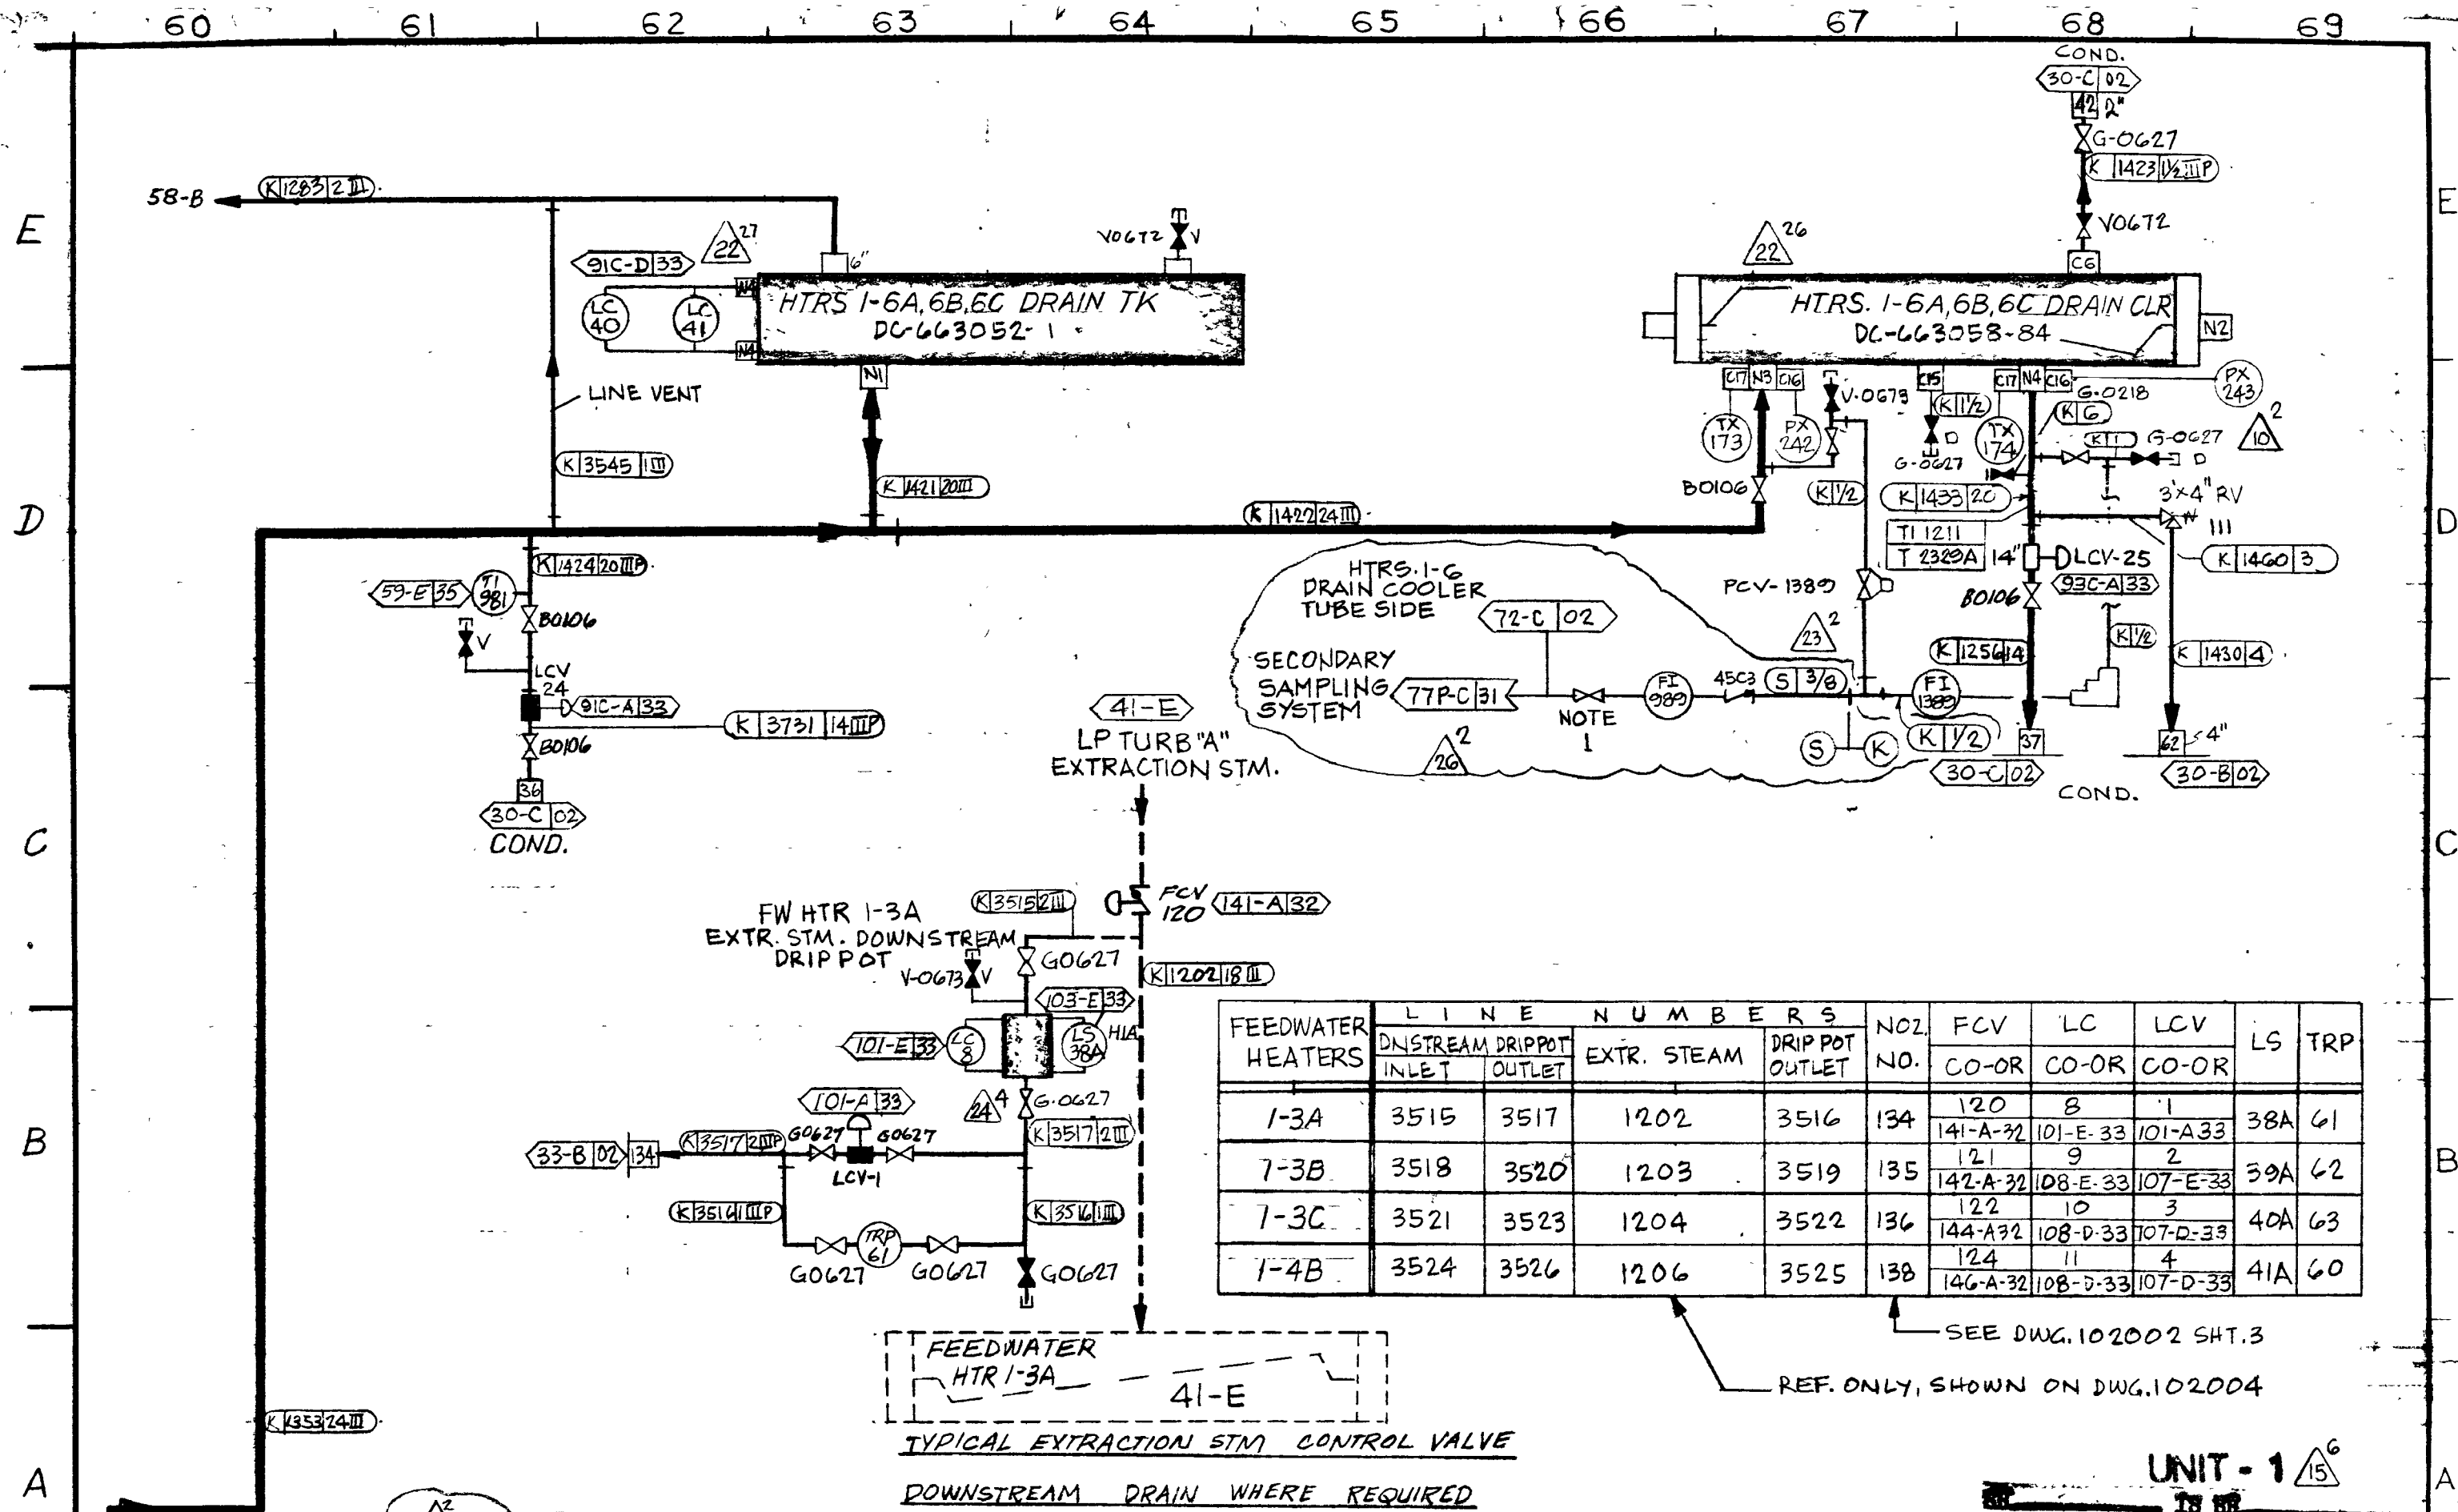

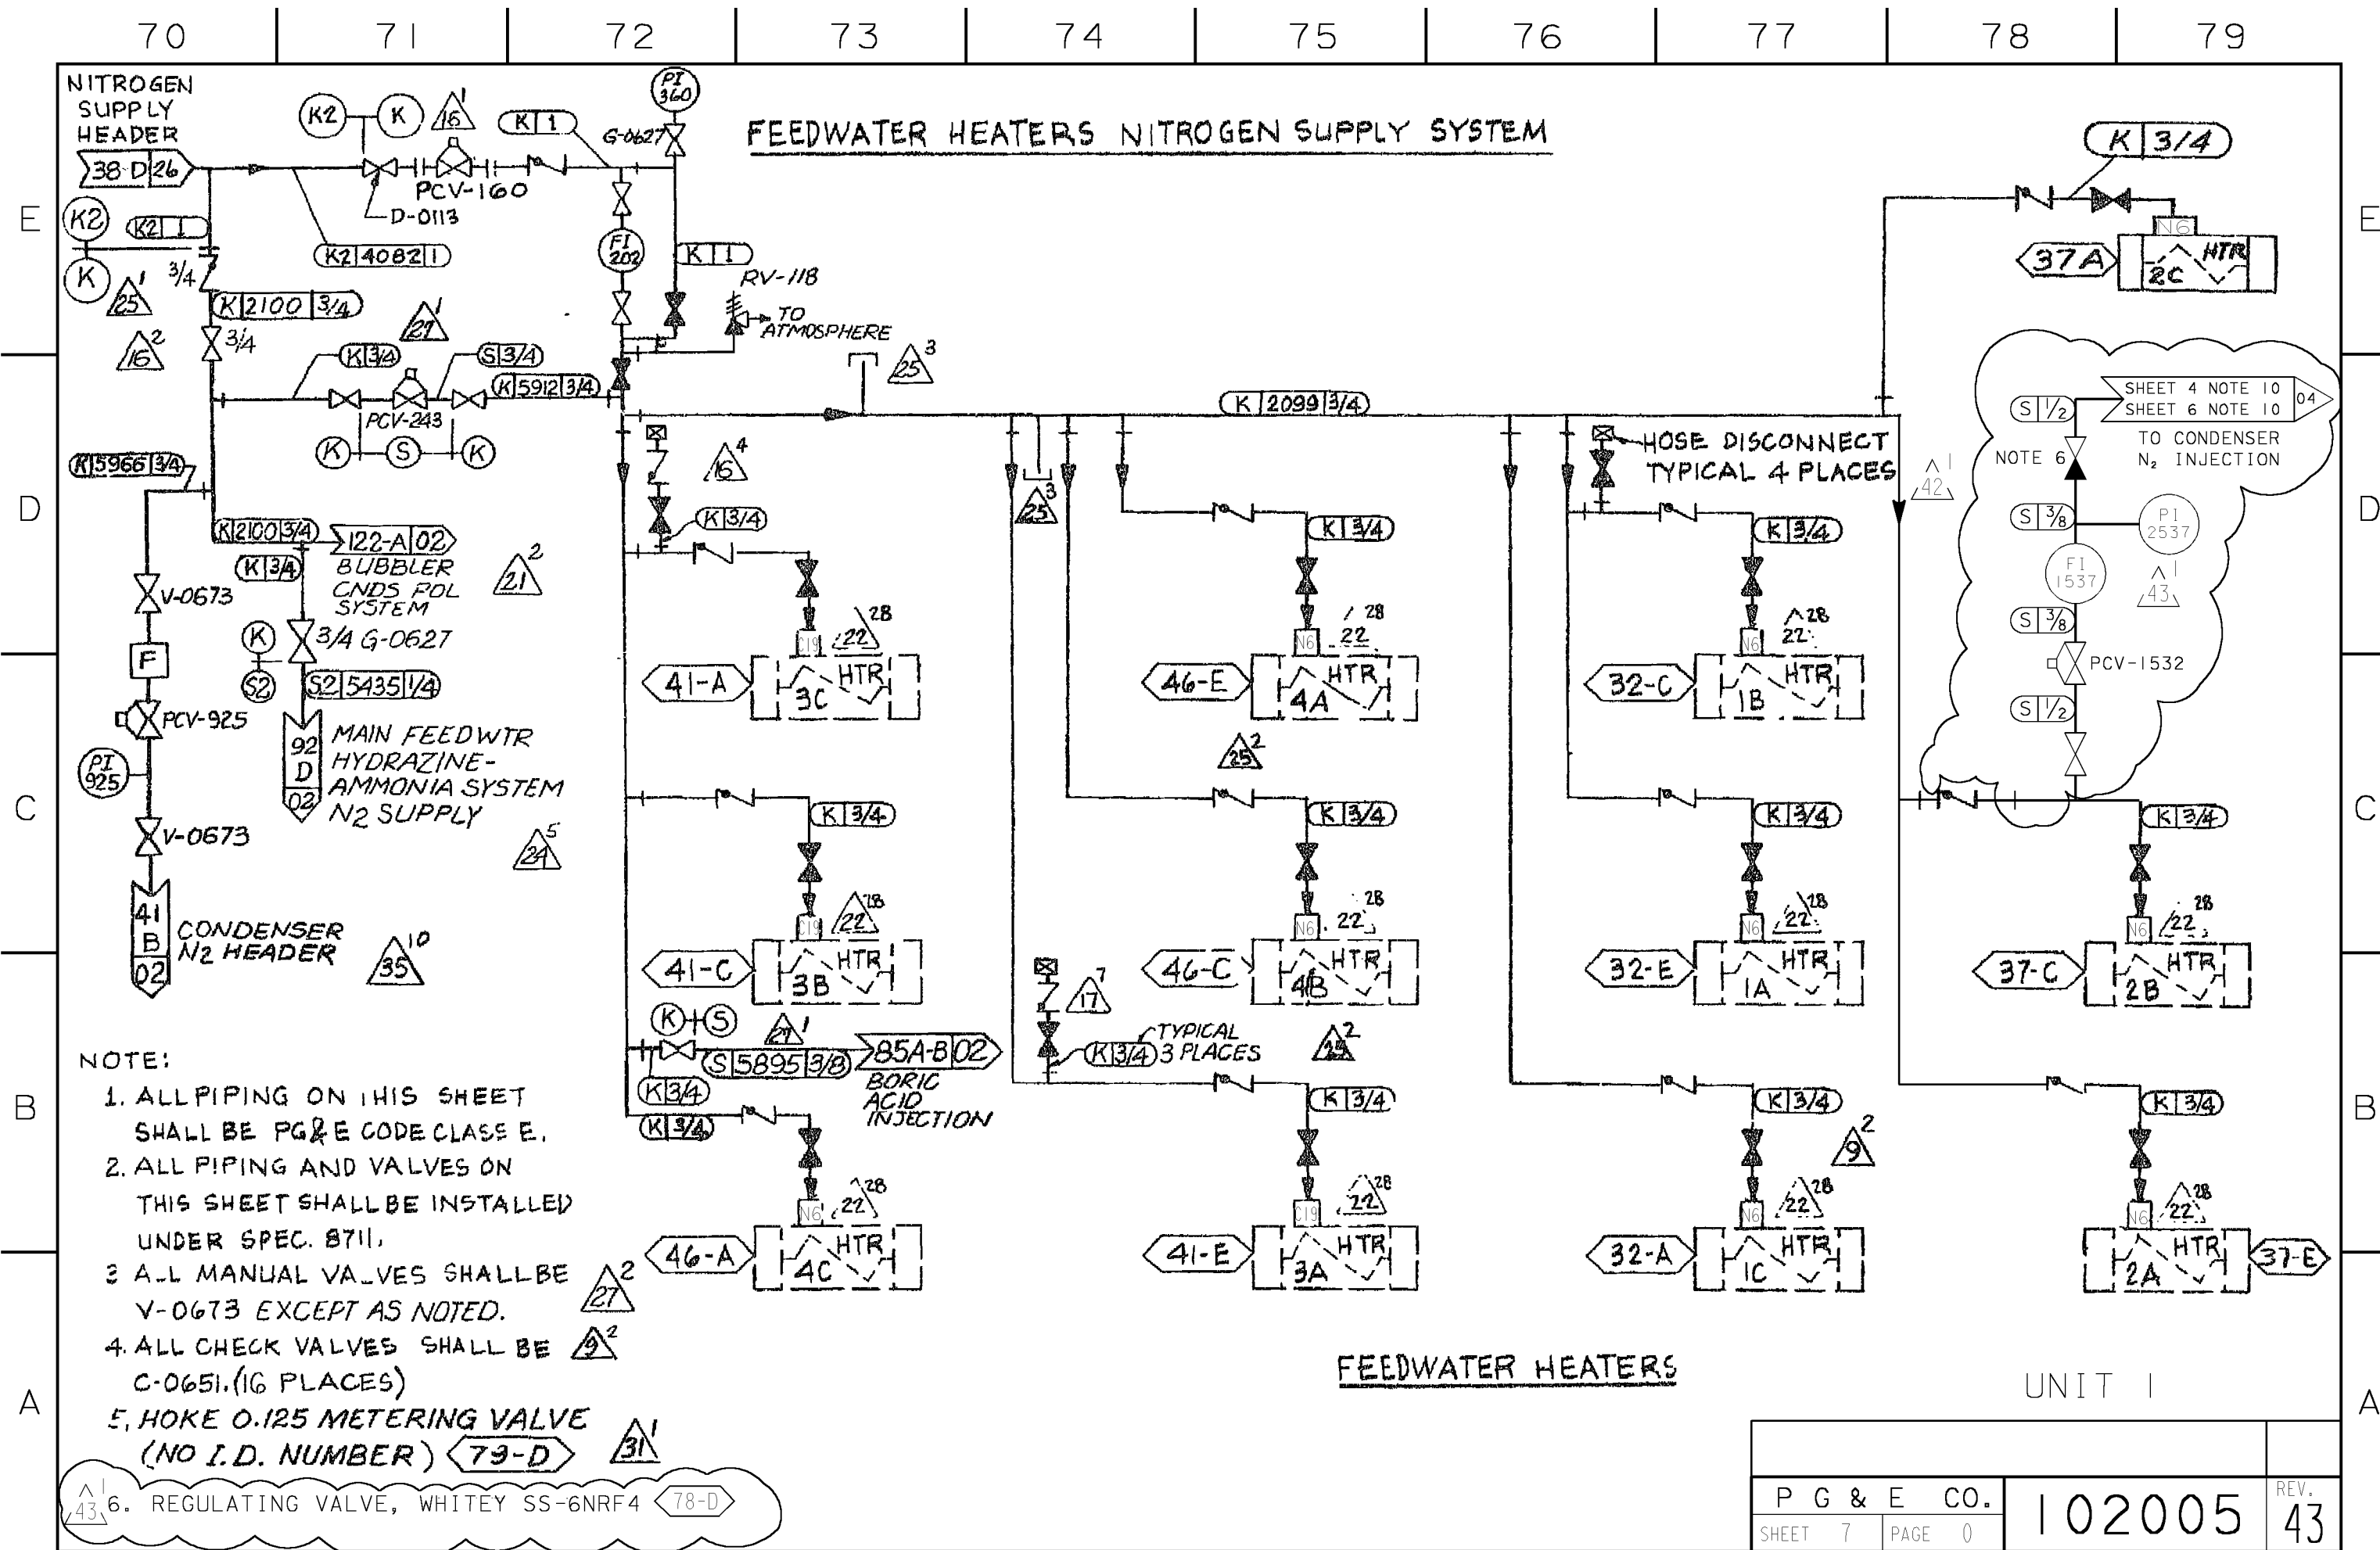

E

D

C

B

A

E


D

C

B

A

RASTER-00241543.DGN
DGN=00241543.DGN
CAD User: AJFJ Date: 04-21-2011

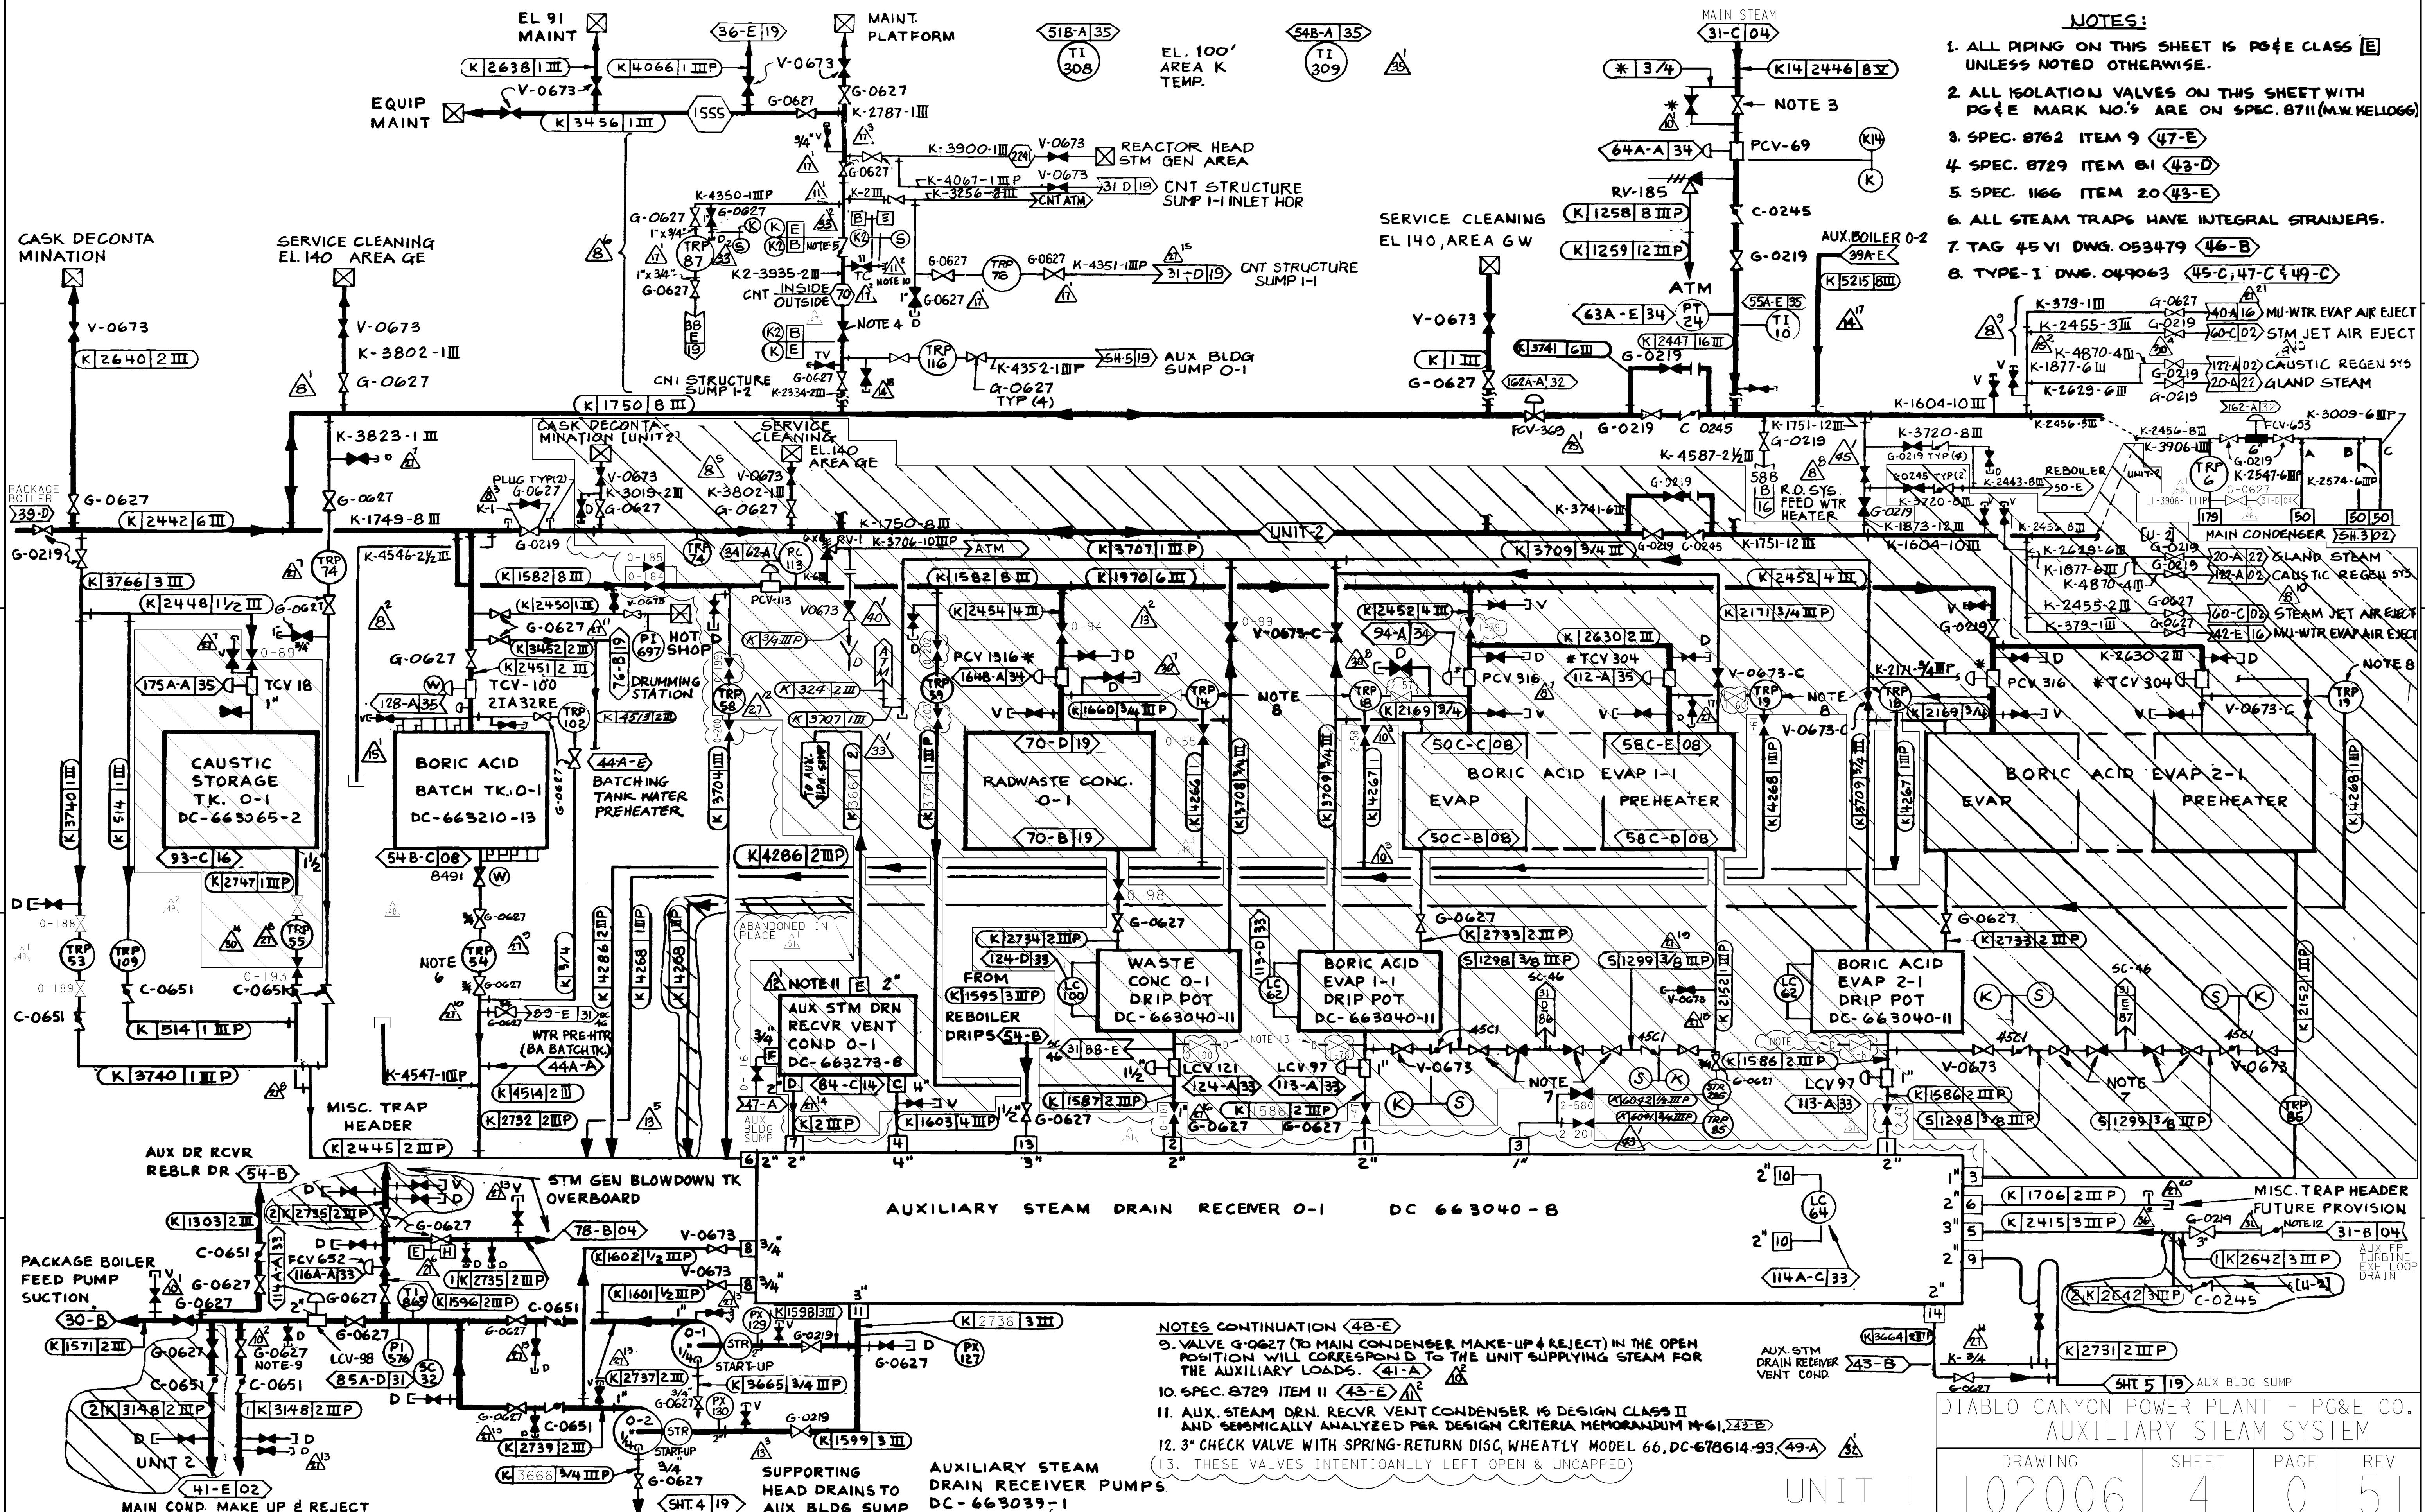

- NOTES:**
1. ALL PIPING ON THIS SHEET IS PG&E CLASS [E] UNLESS NOTED OTHERWISE.
 2. ALL ISOLATION VALVES ON THIS SHEET WITH PG&E MARK NO.'S ARE ON SPEC. 8711(M.W.KELLOGG)
 3. SPEC. 8762 ITEM 9 (47-E)
 4. SPEC. 8729 ITEM 81 (43-D)
 5. SPEC. 1166 ITEM 20 (43-E)
 6. ALL STEAM TRAPS HAVE INTEGRAL STRAINERS.
 7. TAG 45 VI DWG. 053479 (46-B)
 8. TYPE-1 DWG. 049063 (45-C, 47-C & 49-C)

- NOTES CONTINUATION (48-E)**
9. VALVE G-0627 (TO MAIN CONDENSER MAKE-UP & REJECT) IN THE OPEN POSITION WILL CORRESPOND TO THE UNIT SUPPLYING STEAM FOR THE AUXILIARY LOADS. (41-A)
 10. SPEC. 8729 ITEM 11 (43-E)
 11. AUX. STEAM DRN. RECVR VENT CONDENSER IS DESIGN CLASS II AND SEISMICALLY ANALYZED PER DESIGN CRITERIA MEMORANDUM M-61, 243-B
 12. 3" CHECK VALVE WITH SPRING-RETURN DISC, WHEATLY MODEL 66, DC-678614-93 (49-A)
 13. THESE VALVES INTENTIONALLY LEFT OPEN & UNCAPPED


DIABLO CANYON POWER PLANT - PG&E CO.
AUXILIARY STEAM SYSTEM

DRAWING	SHEET	PAGE	REV
102006	4	0	51

RASTER=102006s4a.dgn
DGN=102006s4a.dgn
CAD User: MNRU Date: 10-23-2012

NOTE
ALL PIPING ON THIS SHEET SHALL
BE PG&E CLASS E

** CVCS VALVES

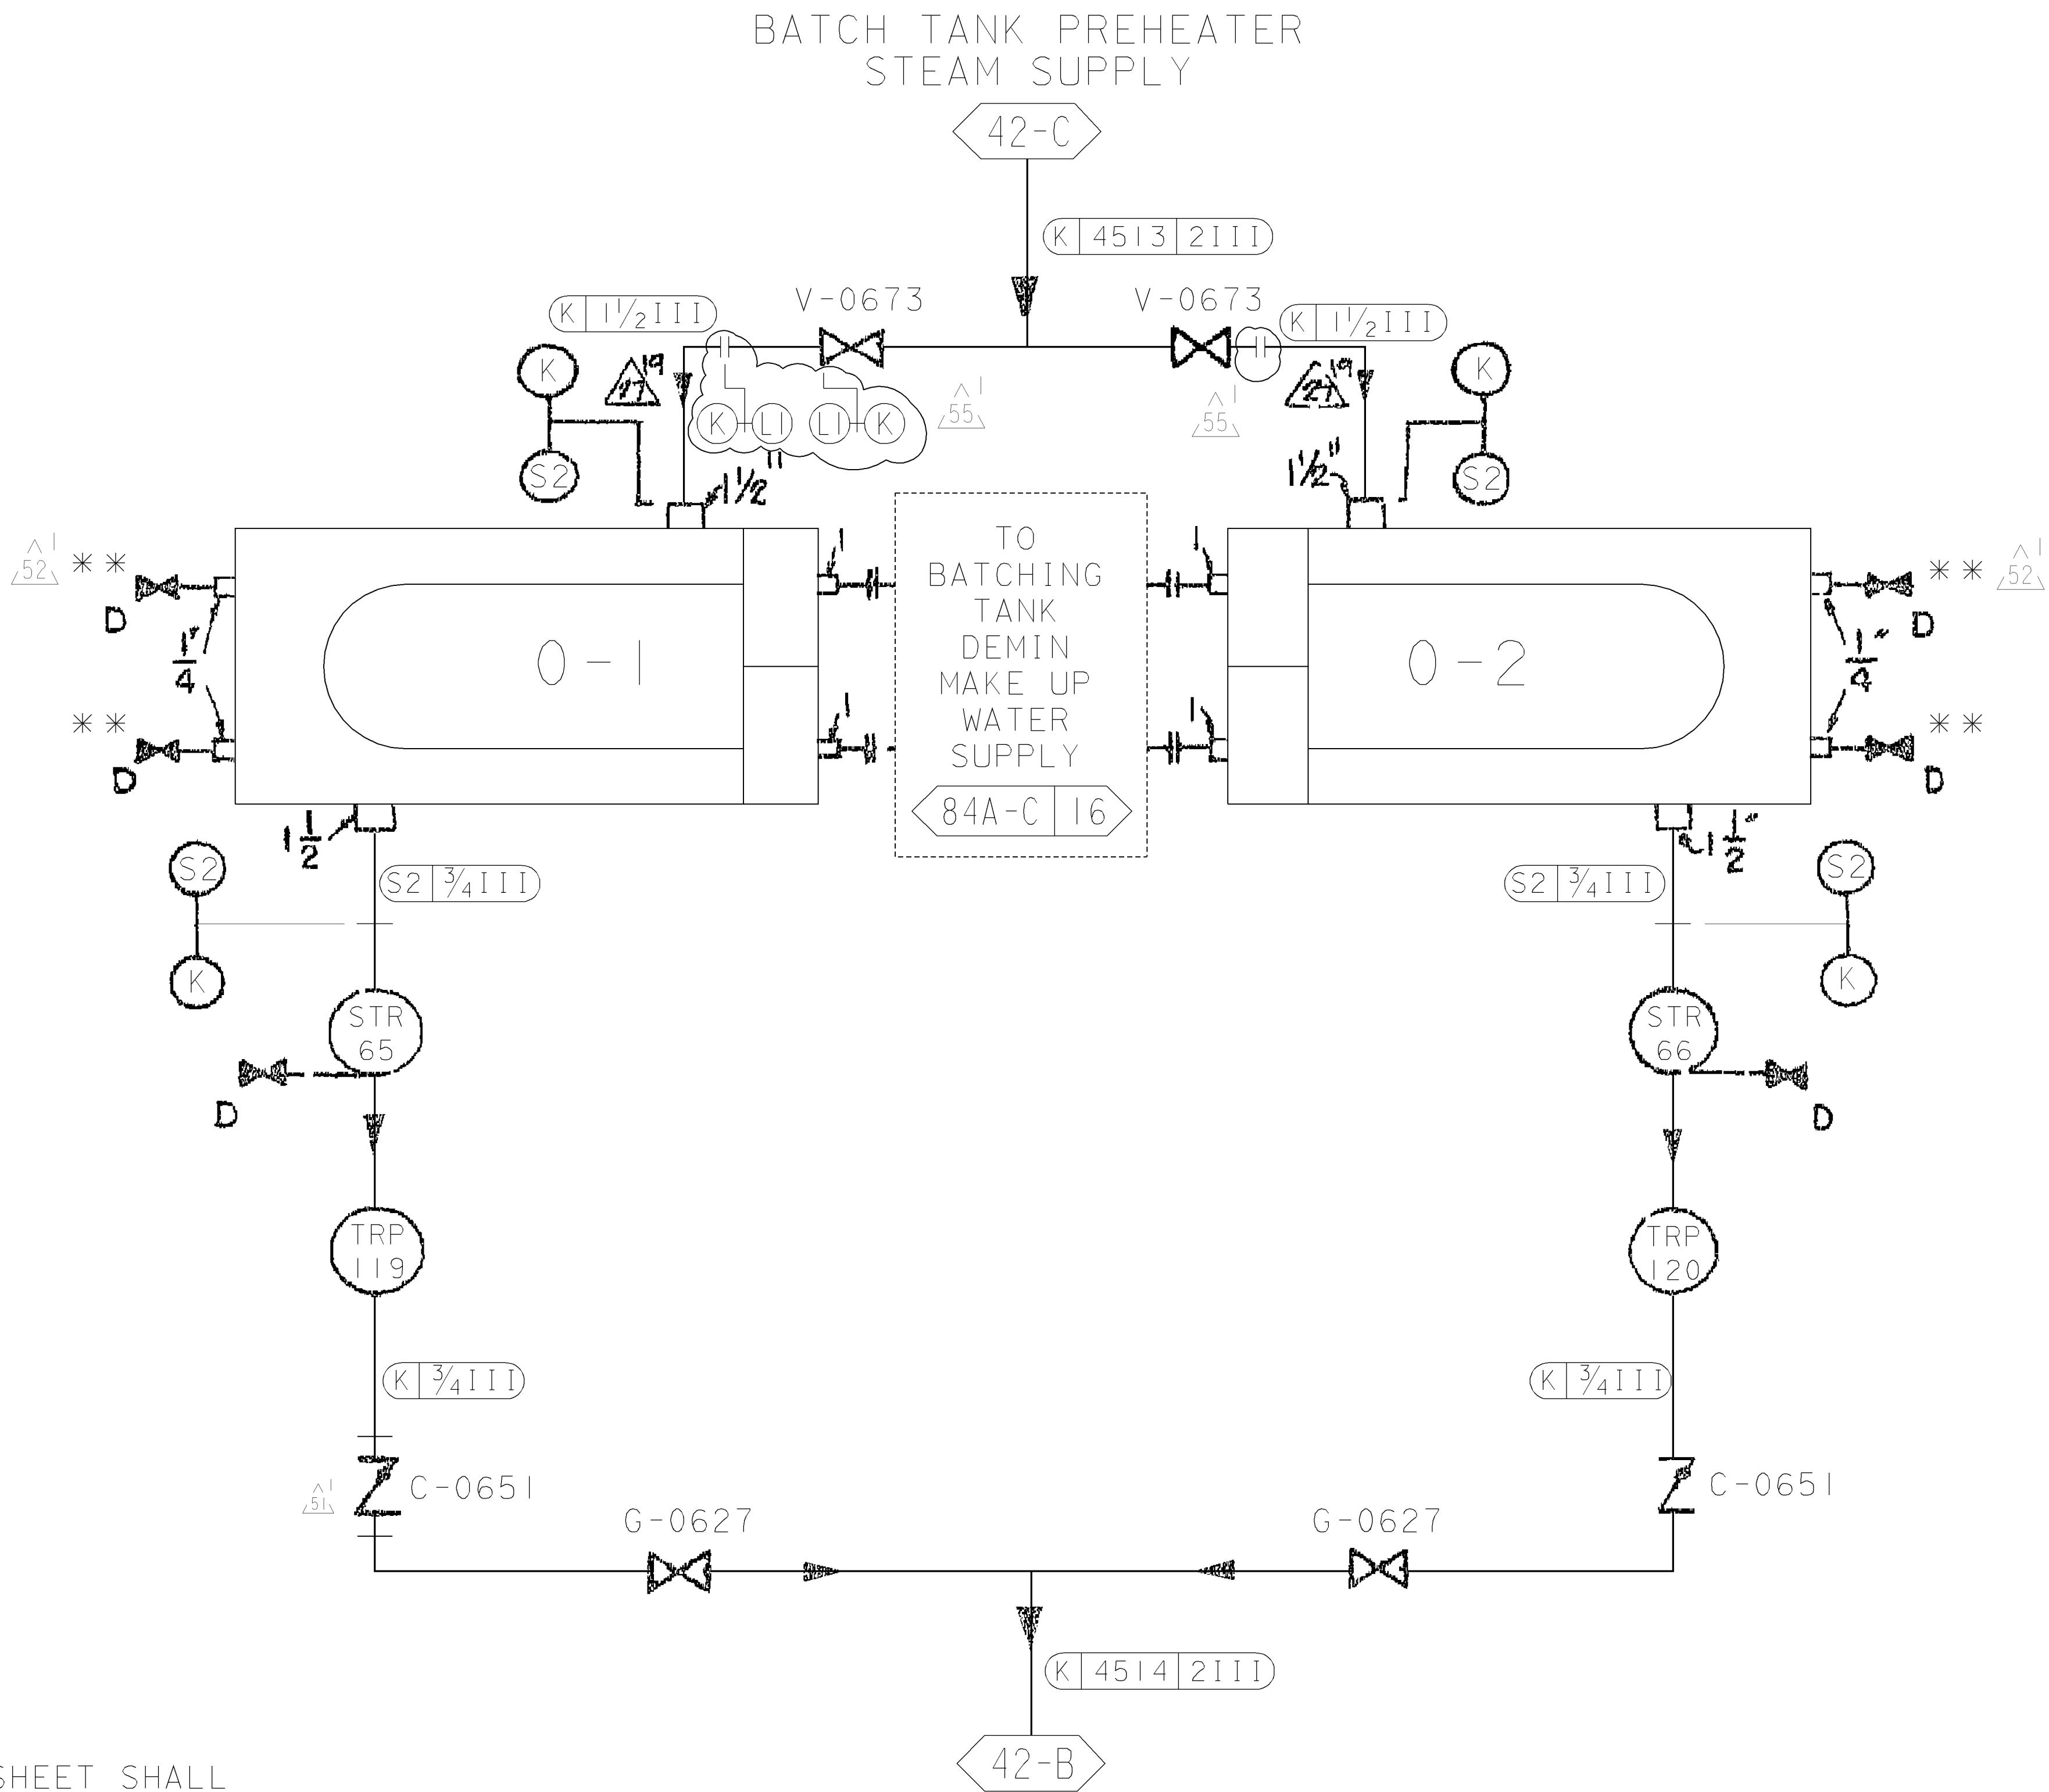

DIABLO CANYON POWER PLANT - PG&E CO. AUXILIARY STEAM SYSTEM			
DRAWING 102006	SHEET 4A	PAGE 0	REV 55

INP01C
3 Size

10-23-2012	MNRU	FxC2		KERSI J. DALAL	MECHANICAL	M 16690	3/31/2014	REVISED PER DFT-7*1851
DATE	DWN	RE	IV	PROFESSIONAL ENGINEER	PE DISC.	PE#	PE EXP.	

LEGEND:

—●— VALVE LEAK-OFF

—◇— PIPING DESIGNED TO THE 1955 EDITION OF ANSI B31.1 AND APPLICABLE NUCLEAR CODE CASES.

NOTES: (CONTINUED)

23. 3/4-X42D, ITT VALVE NO. 2471-10-M-3/4" DWG. NO. 663219-267,

STOCK CODE 42-2543, FOR TEST CONNECTION. (48-E)

24. 3"-150#, ITT BALL VALVE W/ BETTIS CB-415-SR60 ACTUATOR 1-8000B

DWG. NO. DC 6006473-236, STOCK CODE 94-6447, P.O. #038232. (48-D)

25. ANCHOR/DARLING 3/4"-1878GB, DC-6006473-97 P.O. #019183 (44-B)

NOTES: CONT'D FROM 47-A


19. LOOP SEALS ARE INSULATED FROM PRESSURIZER NOZZLES TO SAFETY VALVES NOTE 22 INSULATION PER 663320-96. (42-A-C)


20. PRIMARY WTR FOR MAINTENANCE, WASH DOWN AREA. (47-C)

21. REMOTE OPERATORS DISCONNECTED AND ABANDONED IN-PLACE (45-A)

22. SEE SHEET 7A FOR RVRLIS (41-B)

ALIGNMENT FOR OPERATION (42-B, 44-C, 46-E)

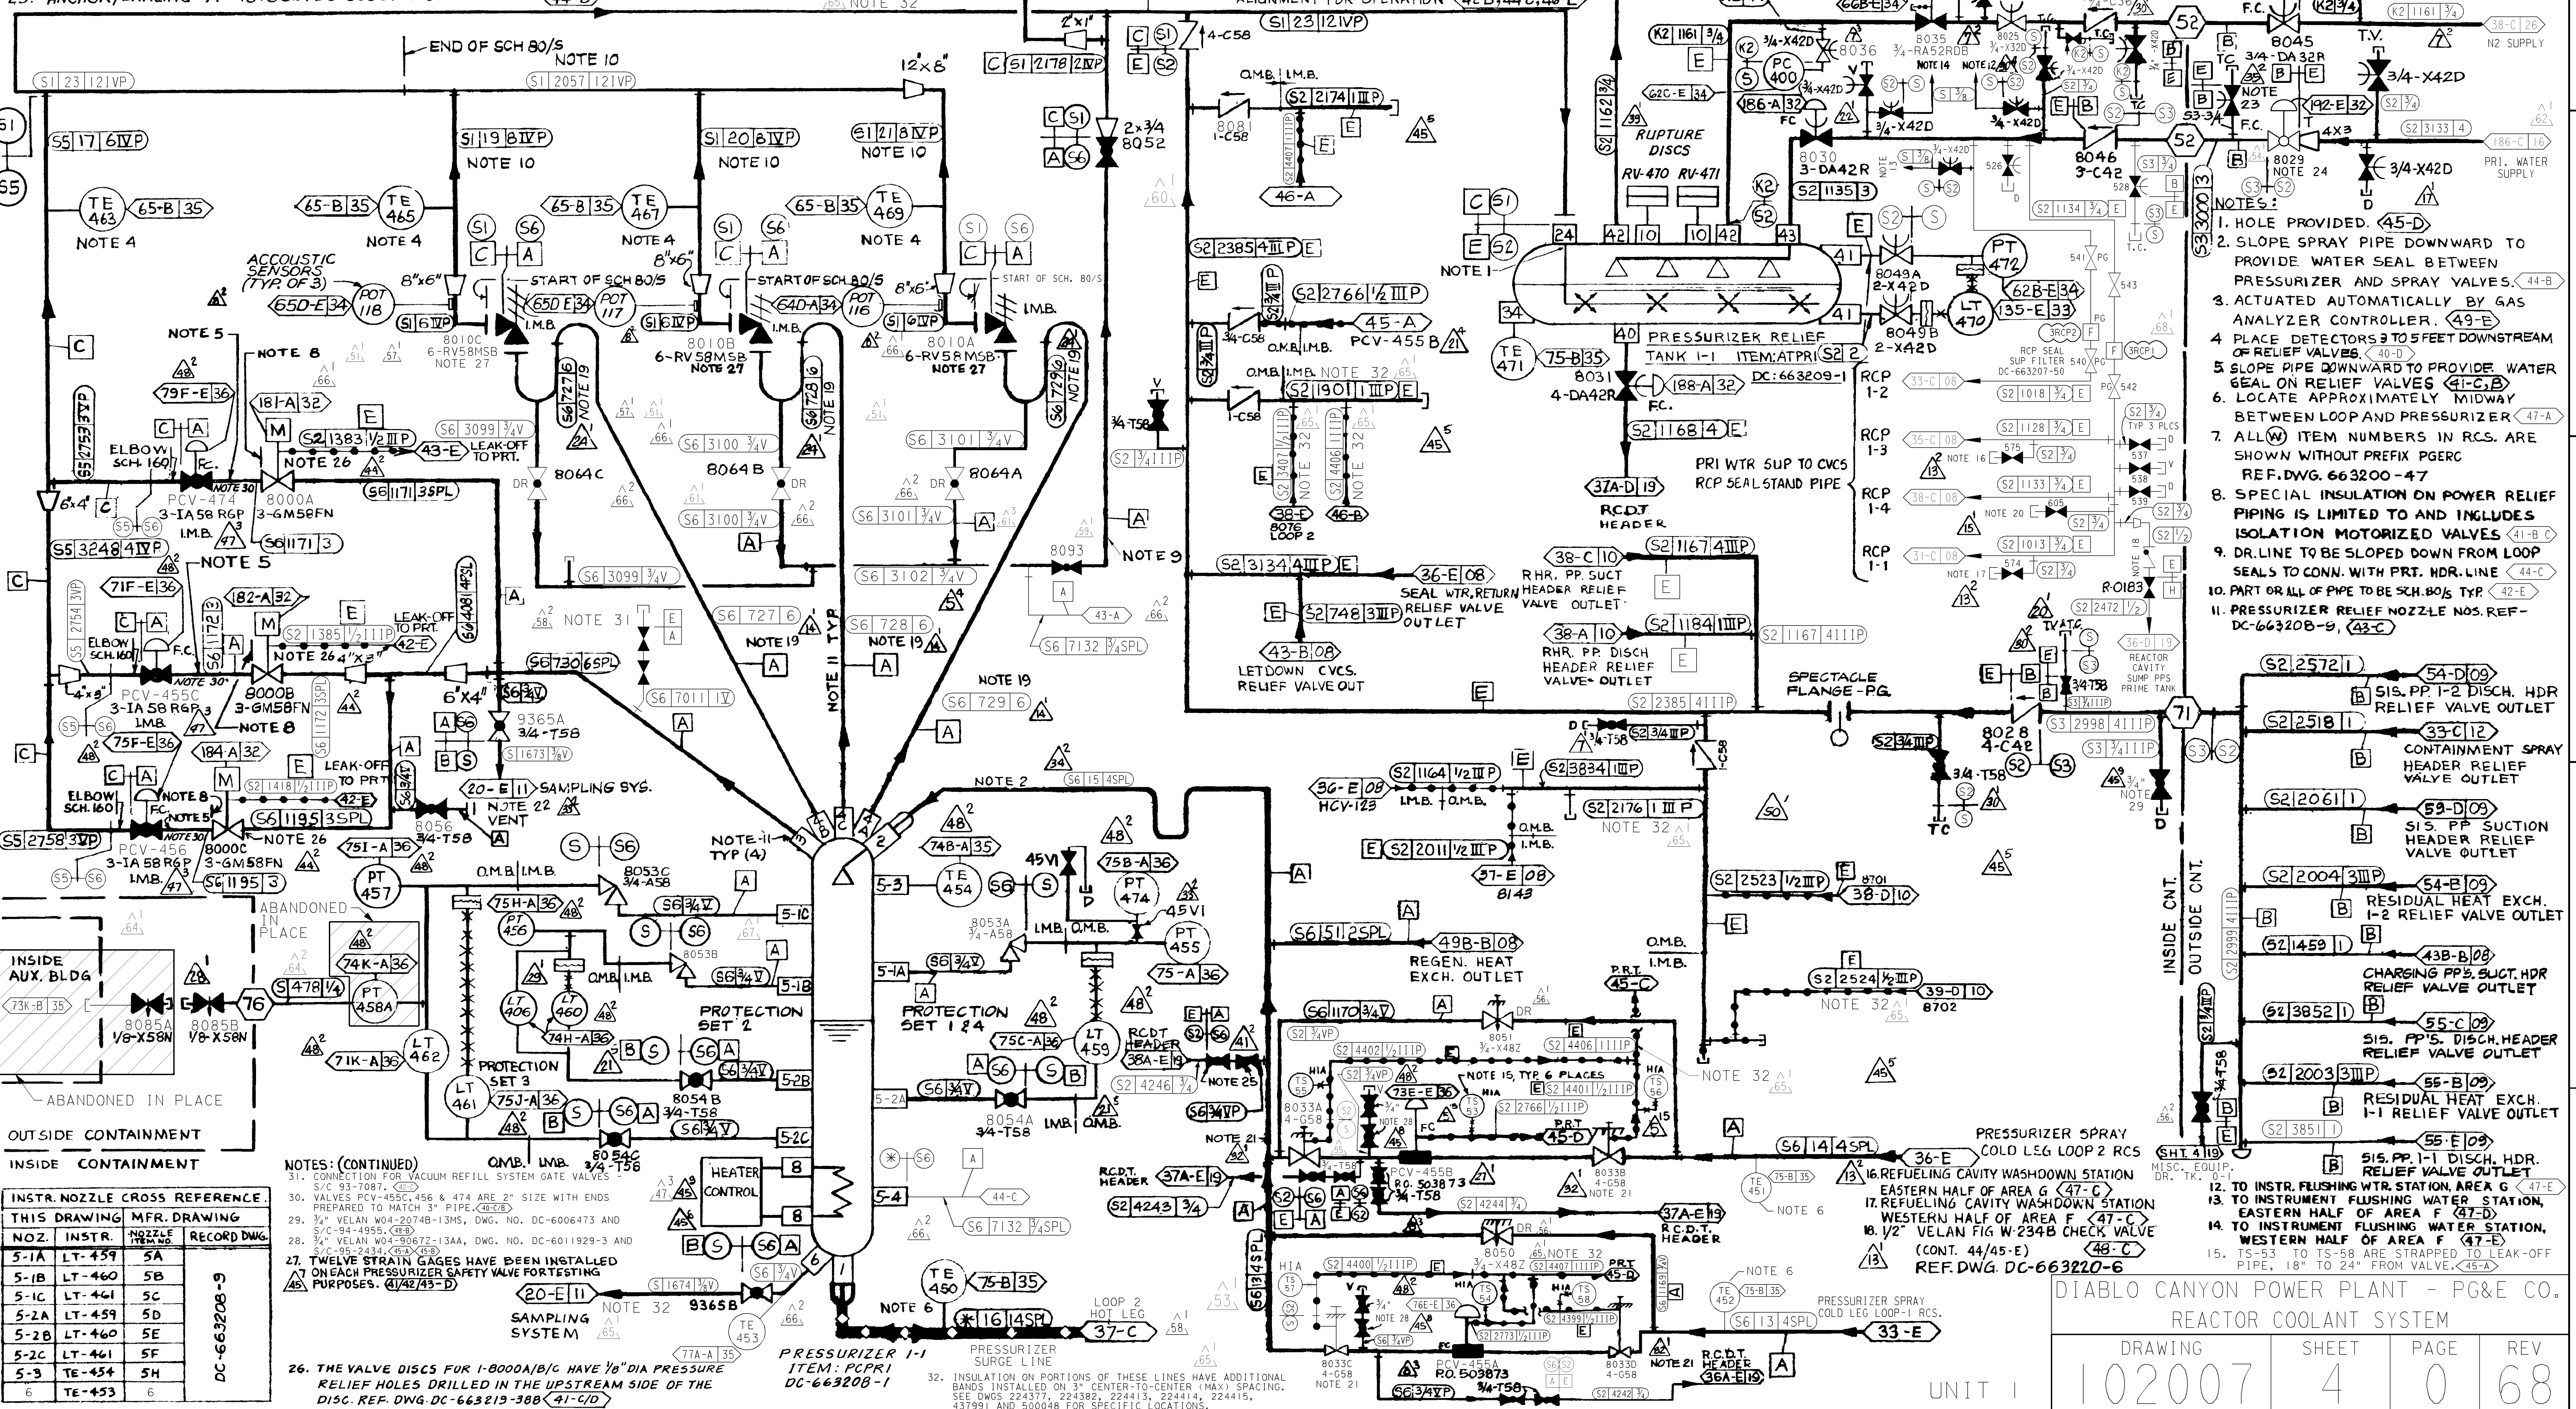

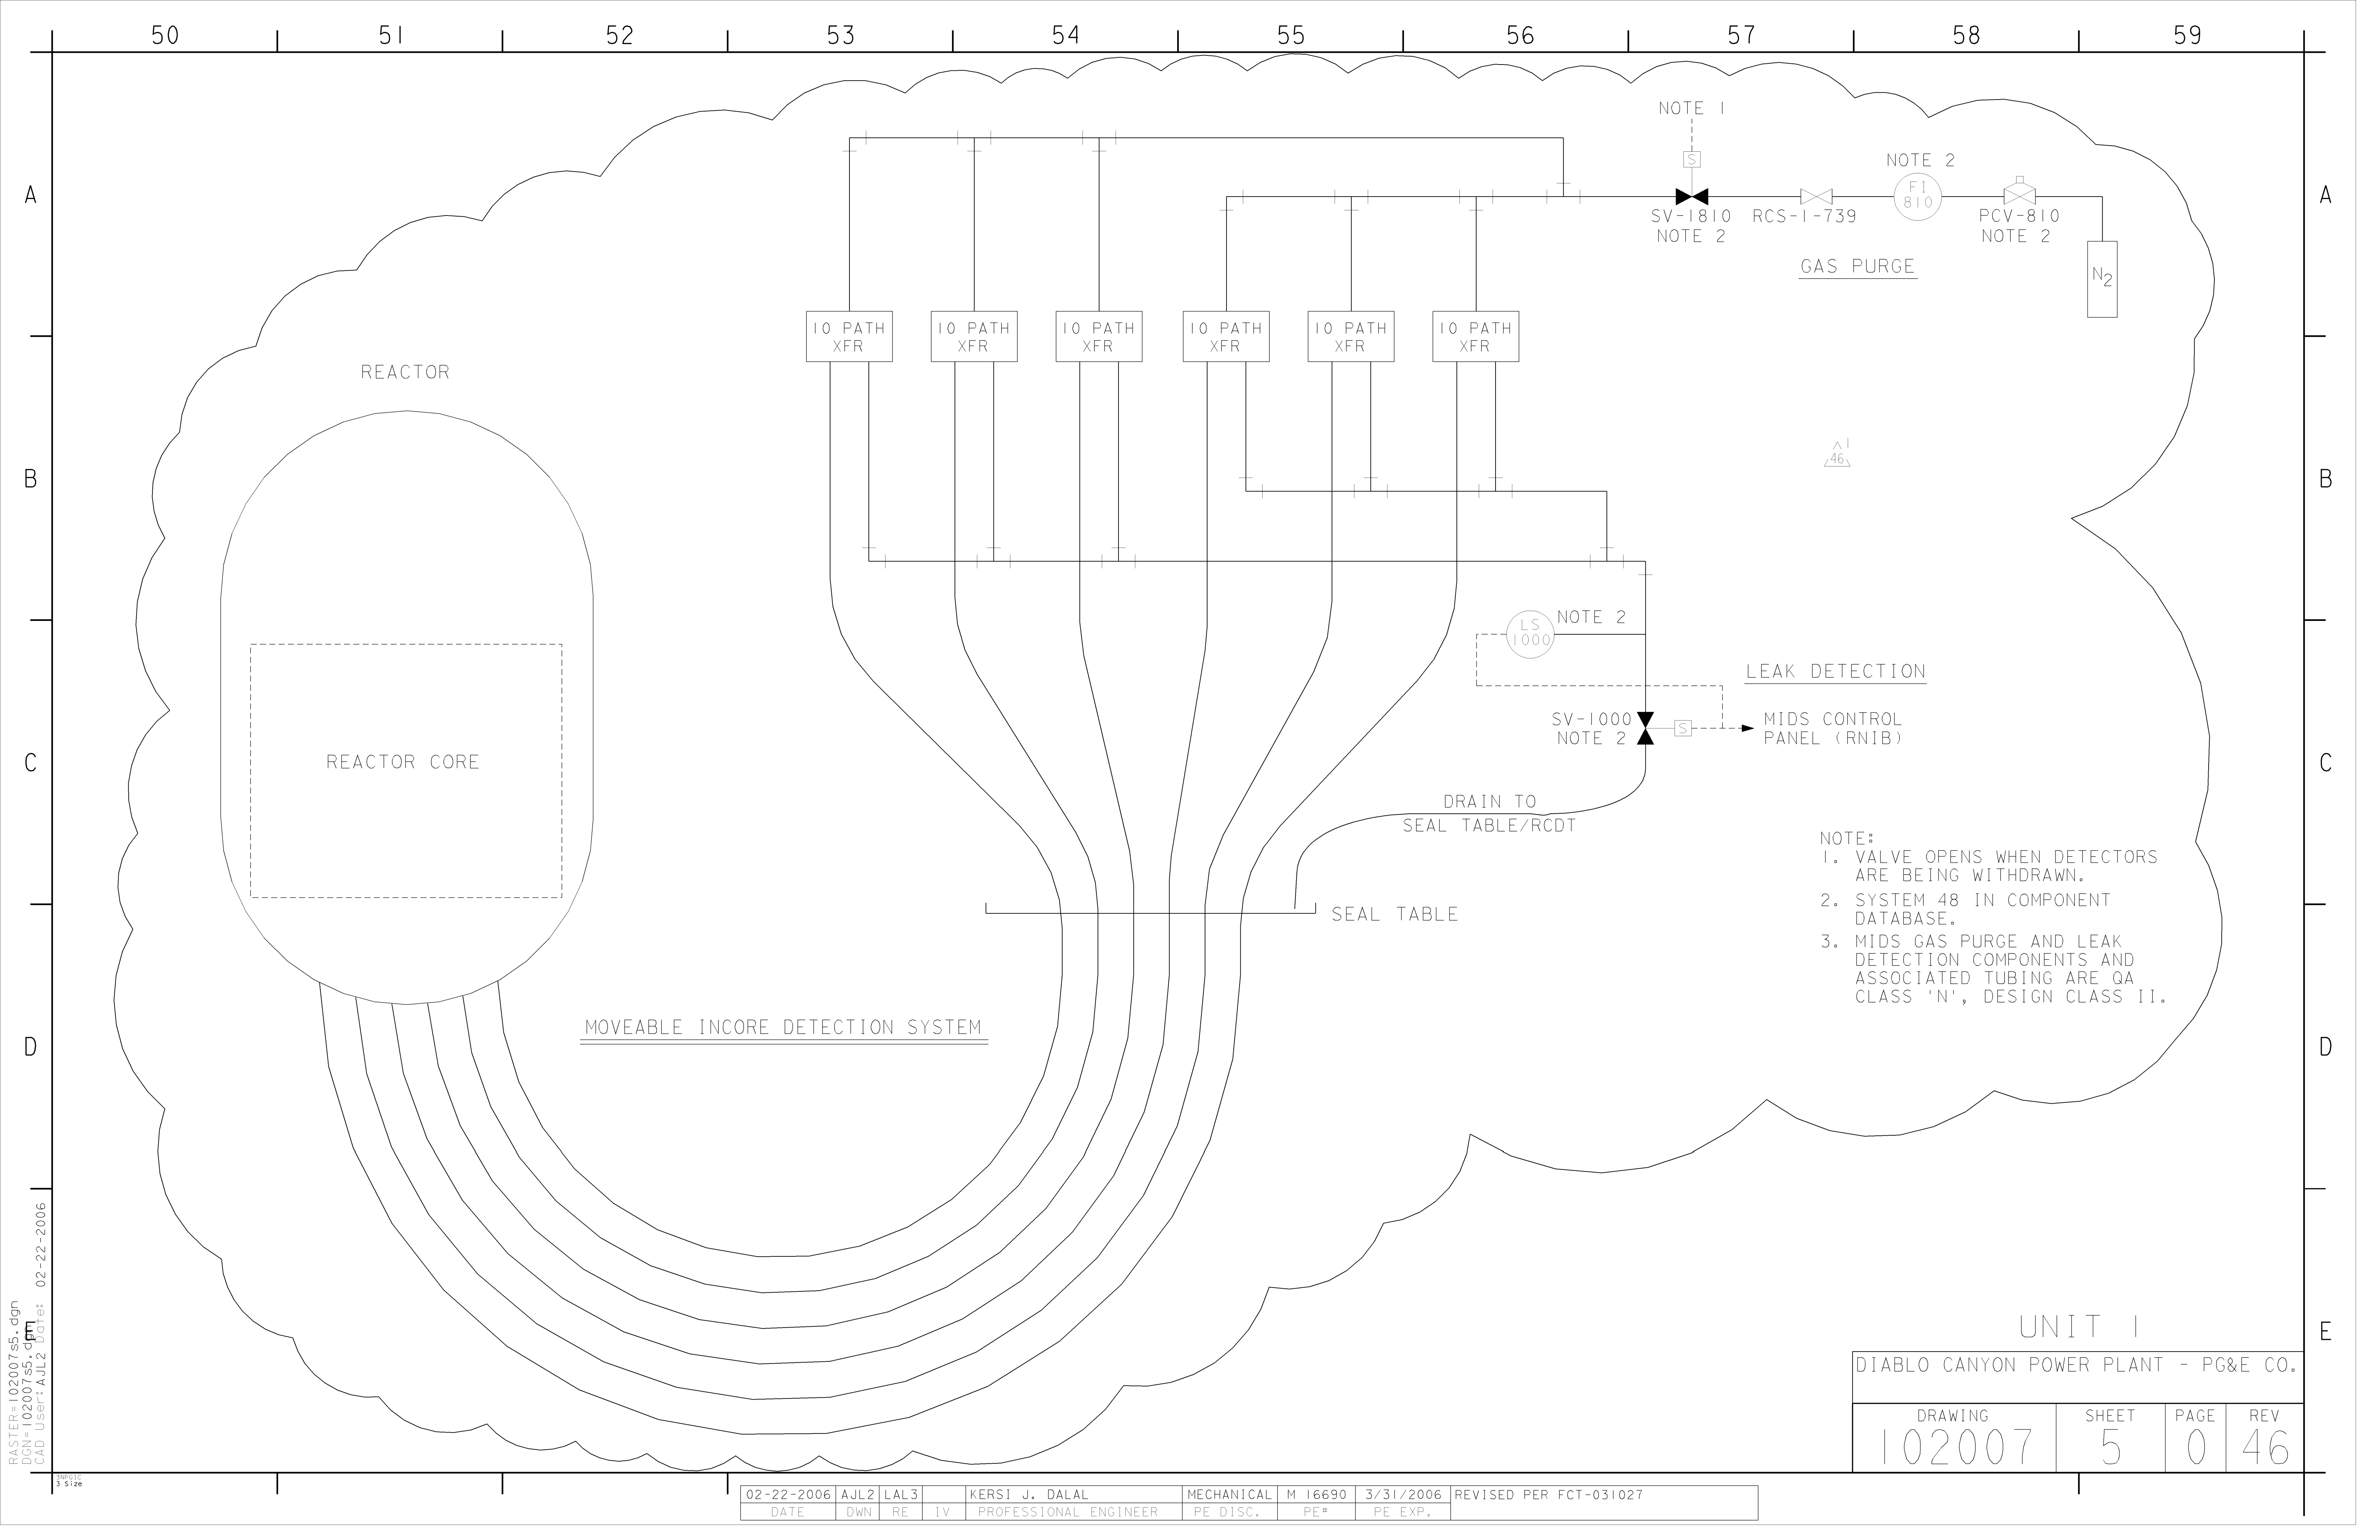

RASTER=102007s5.dgn
DGN=102007s5.dgn
CAD User: AJL2 Date: 02-22-2006

3 Size

02-22-2006	AJL2	LAL3		KERSI J. DALAL	MECHANICAL	M 16690	3/31/2006	REVISED PER FCT-031027
DATE	DWN	RE	IV	PROFESSIONAL ENGINEER	PE DISC.	PE*	PE EXP.	

UNIT 1			
DIABLO CANYON POWER PLANT - PG&E CO.			
DRAWING	SHEET	PAGE	REV
102007	5	0	46

CAD User:rxg2 Date: 5-23-2002
DGN=2007S5A.DGN

A

B

C

D

E

A

B

C

D

E

50A

51A

52A

53A

54A


55A

56A

57A

58A

59A

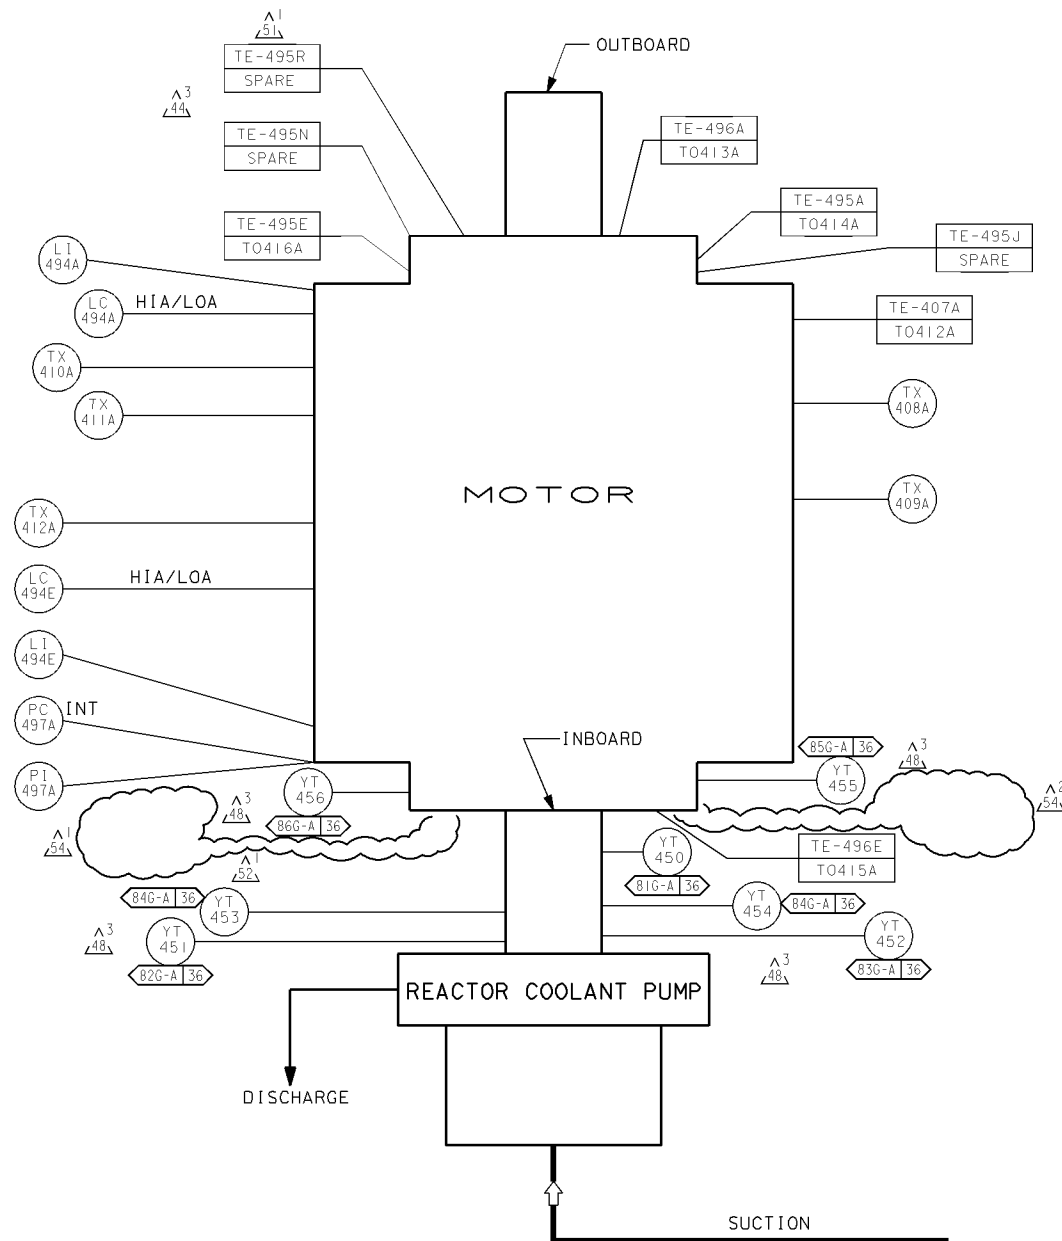

NOTES:

1. DELETED
2. DELETED
3. DELETED
4. FOR INSTRUMENT ORIENTATION SEE DWG 054174 FIG 926, SHT 29
5. INSTRUMENT SCHEMATIC COORD'S FOR PUMPS 2, 3 & 4 ARE NOT PROVIDED ON THIS SHEET; SEE SHEETS 8H, 1 & J OF DWG 102036, 53B-C.

REACTOR COOLANT PUMPS INSTRUMENTATION

INSTRUMENT		PUMP 1	PUMP 2	PUMP 3	PUMP 4
UPPER OIL RESERVOIR FOR UPPER RADIAL AND THRUST BEARING		LC-494A	LC-494B	LC-494C	LC-494D
		LI-494A	LI-494B	LI-494C	LI-494D
		LC-494E	LC-494F	LC-494G	LC-494H
LOWER OIL RESERVOIR		LI-494E	LI-494F	LI-494G	LI-494H
STATOR WINDING	STATOR WINDING COMPUTER POINT NO.	TE-407A T0412A	TE-407B T0432A	TE-407C T0452A	TE-407D T0472A
	SLOT 52				
	SLOT 64	TX-408A	TX-408B	TX-408C	TX-408D
	SLOT 76	TX-409A	TX-409B	TX-409C	TX-409D
	SLOT 106	TX-410A	TX-410B	TX-410C	TX-410D
	SLOT 10	TX-411A	TX-411B	TX-411C	TX-411D
	SLOT 22	TX-412A	TX-412B	TX-412C	TX-412D
THRUST BEARING UPPER SHOE, COMPUTER POINT NO.		TE-495A T0414A	TE-495B T0434A	TE-495C T0454A	TE-495D T0474A
THRUST BEARING UPPER SHOE		TE-495J SPARE	TE-495K SPARE	TE-495L SPARE	TE-495M SPARE
THRUST BEARING LOWER SHOE, COMPUTER POINT NO.		TE-495E T0416A	TE-495F T0436A	TE-495G T0456A	TE-495H T0476A
THRUST BEARING LOWER SHOE		TE-495N SPARE	TE-495O SPARE	TE-495P SPARE	TE-495Q SPARE
UPPER RADIAL BEARING COMPUTER POINT NO.		TE-496A T0413A	TE-496B T0433A	TE-496C T0453A	TE-496D T0473A
UPPER RADIAL BEARING		TE-495R SPARE	TE-495S SPARE	TE-495T SPARE	TE-495U SPARE
LOWER RADIAL BEARING COMPUTER POINT NO.		TE-496E T0415A	TE-496F T0435A	TE-496G T0455A	TE-496H T0475A
OIL LIFT PUMP PRESSURE		PC-497A PI-497A	PC-497B PI-497B	PC-497C PI-497C	PC-497D PI-497D
PP SHAFT RADIAL VIB X - PROBE		YT-452	YT-462	YT-472	YT-482
PP SHAFT RADIAL VIB Y - PROBE		YT-453	YT-463	YT-473	YT-483
PP SHAFT RADIAL VIB X - PROBE		YT-450	YT-460	YT-470	YT-480
PP SHAFT RADIAL VIB Y - PROBE		YT-451	YT-461	YT-471	YT-481
KEYPHASOR		YT-454	YT-464	YT-474	YT-484
VELOCITY - X		YT-455	YT-465	YT-475	YT-485
VELOCITY - Y		YT-456	YT-466	YT-476	YT-486

NOTE 5


NOTE 4

UNIT 1

P G & E CO.		102007	REV. 54
SHEET 5A	PAGE 0		

INPG2ND

12/20/02	PMH2	AGB2	-	D. J. KINOSHITA	MECHANICAL	M 19615	9/30/2003	Revised per FCT 027136
DATE	DWN	RE	IV	PROFESSIONAL ENGINEER	PE DISC.	PE #	PE EXP.	

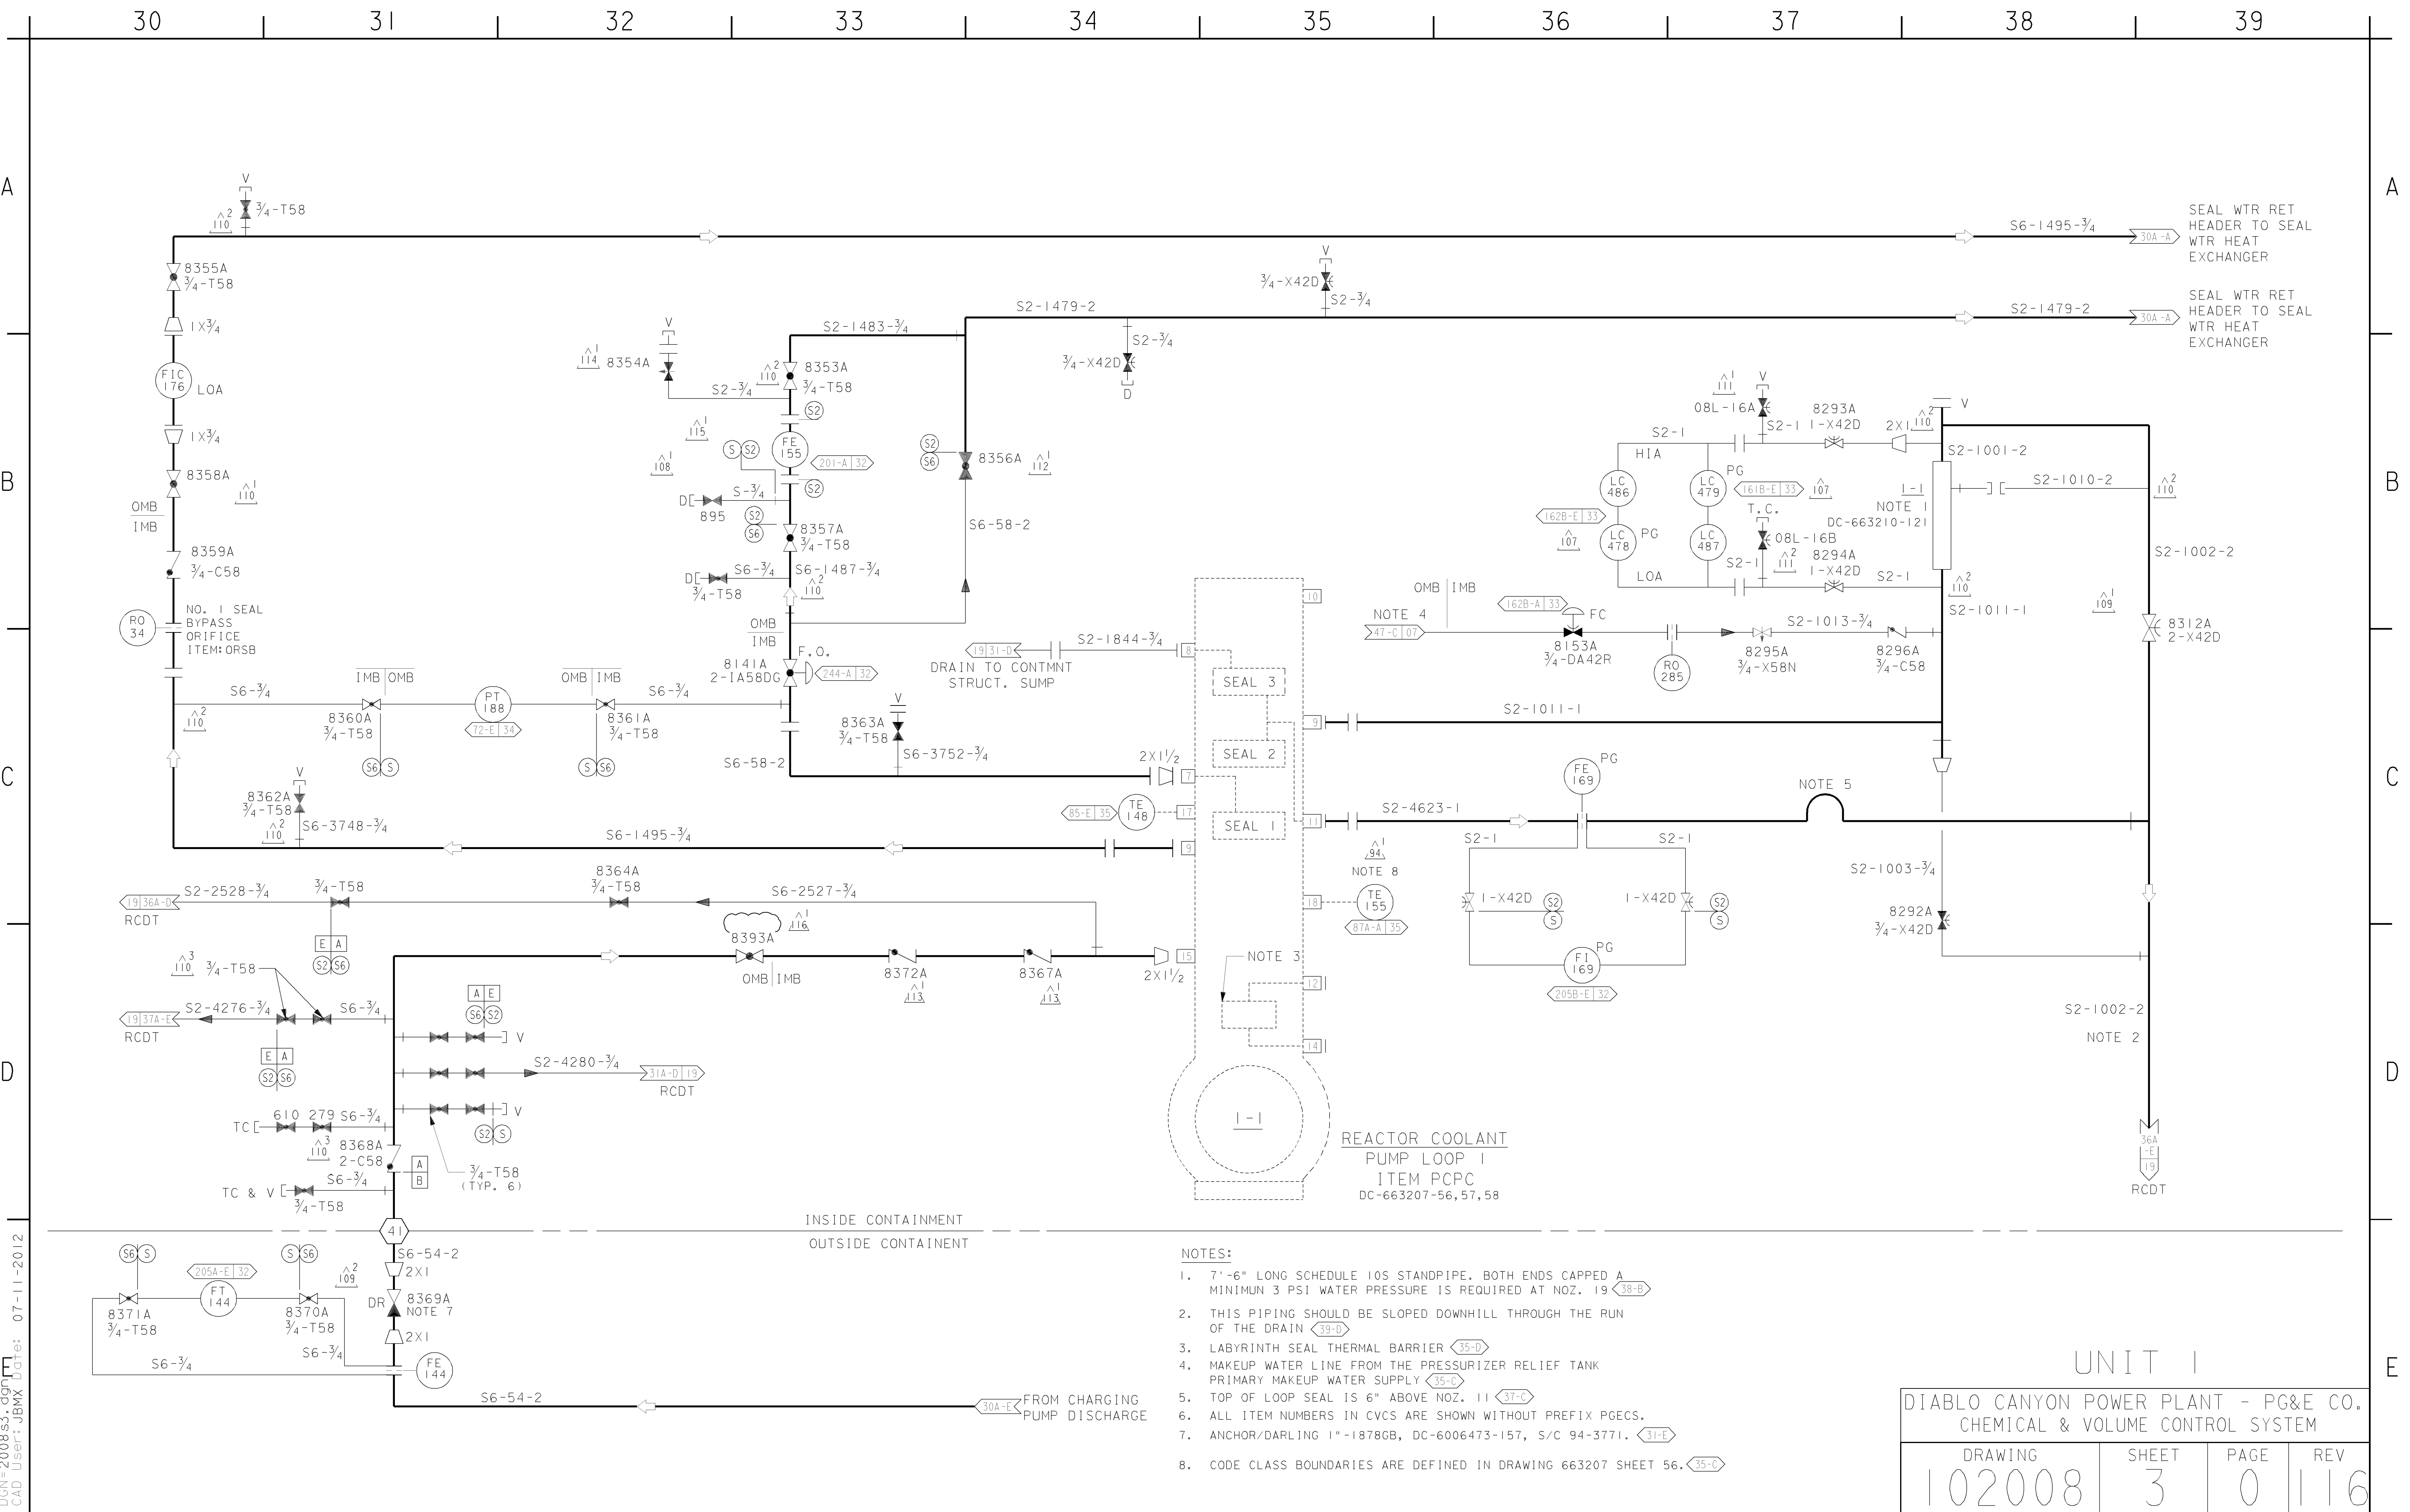


- NOTES:
- 7'-6" LONG SCHEDULE 10S STANDPIPE. BOTH ENDS CAPPED A MINIMUM 3 PSI WATER PRESSURE IS REQUIRED AT NOZ. 19 (38-B)
 - THIS PIPING SHOULD BE SLOPED DOWNHILL THROUGH THE RUN OF THE DRAIN (39-D)
 - LABYRINTH SEAL THERMAL BARRIER (35-D)
 - MAKEUP WATER LINE FROM THE PRESSURIZER RELIEF TANK PRIMARY MAKEUP WATER SUPPLY (35-C)
 - TOP OF LOOP SEAL IS 6" ABOVE NOZ. 11 (37-E)
 - ALL ITEM NUMBERS IN CVCS ARE SHOWN WITHOUT PREFIX PGCS.
 - ANCHOR/DARLING 1"-1878GB, DC-6006473-157, S/C 94-3771. (31-E)
 - CODE CLASS BOUNDARIES ARE DEFINED IN DRAWING 663207 SHEET 56. (35-D)


UNIT I			
DIABLO CANYON POWER PLANT - PG&E CO. CHEMICAL & VOLUME CONTROL SYSTEM			
DRAWING	SHEET	PAGE	REV
102008	3	0	116

07-11-2012	JBMX	FAZI		KERSI J. DALAL	MECHANICAL	M 16690	3/31/2014	REVISED PER DFT-7*1625
DATE	DWN	RE	IV	PROFESSIONAL ENGINEER	PE DISC.	PE#	PE EXP.	

RASTER: 2008s3.dgn
DGN: 2008s3.dgn
CAD User: JBMX Date: 07-11-2012

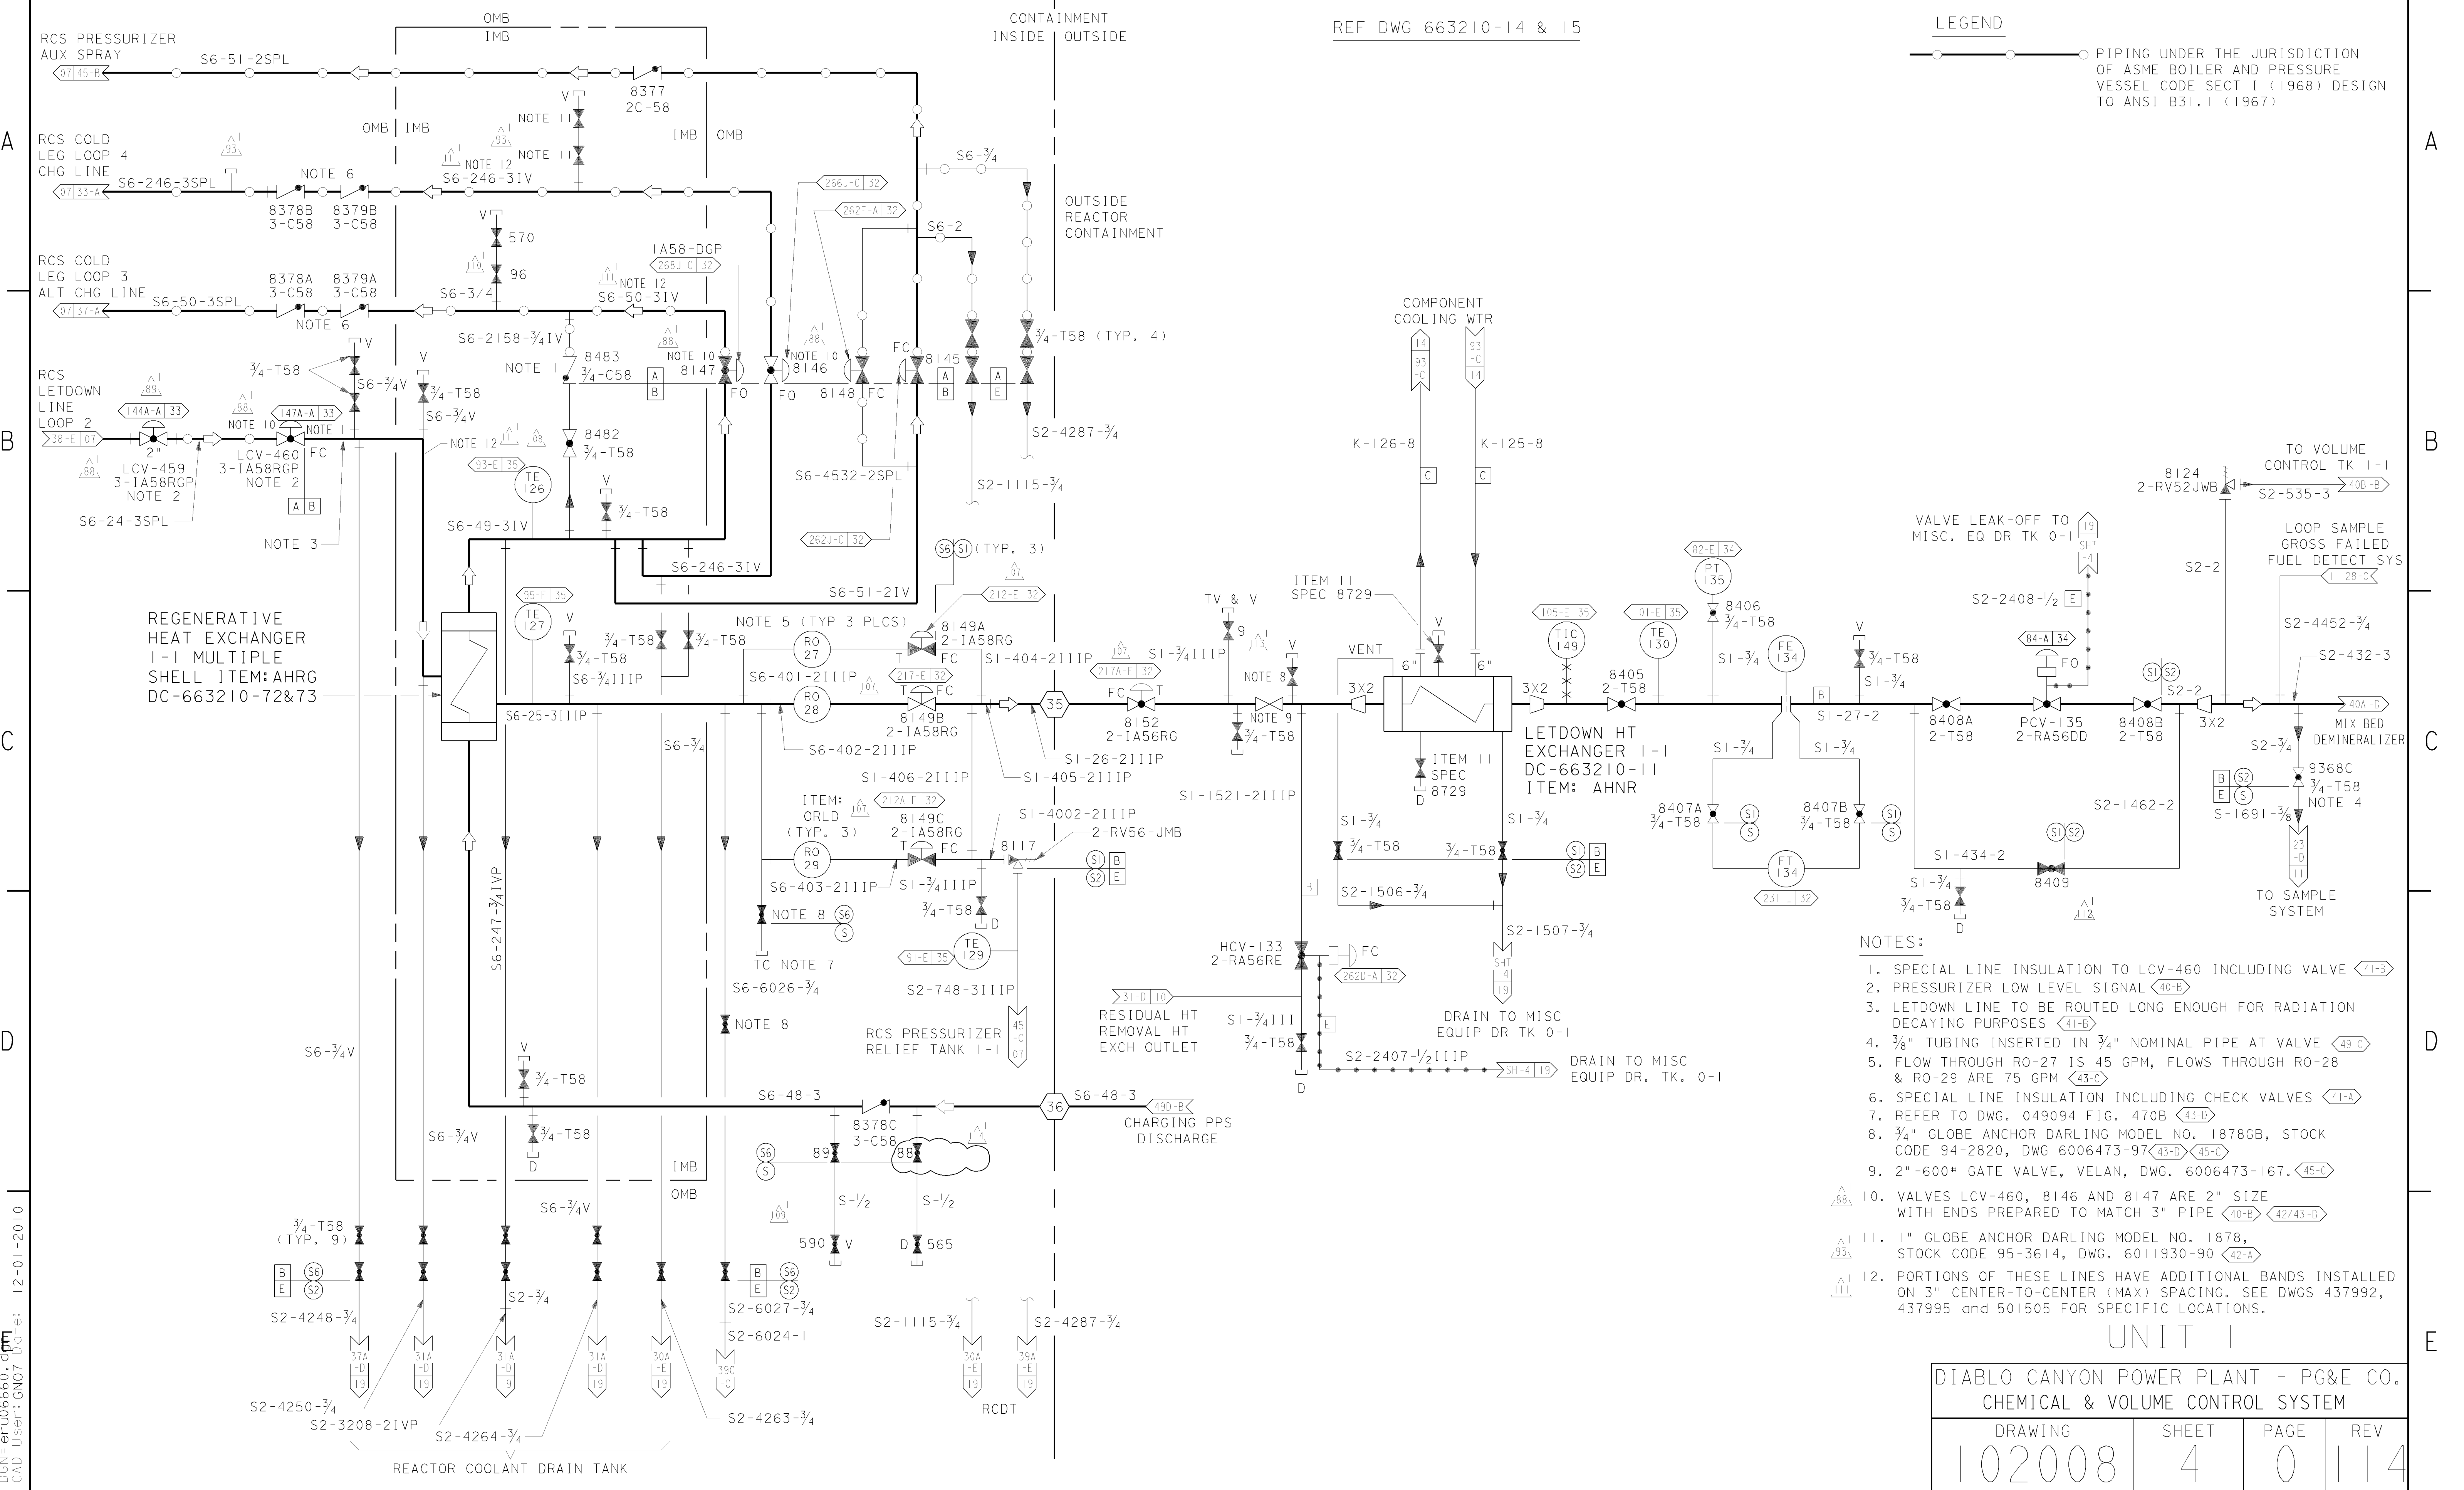


RASTER=er06660.dgn
DGN=er06660.dgn
CAD User: GNO7 Date: 12-01-2010

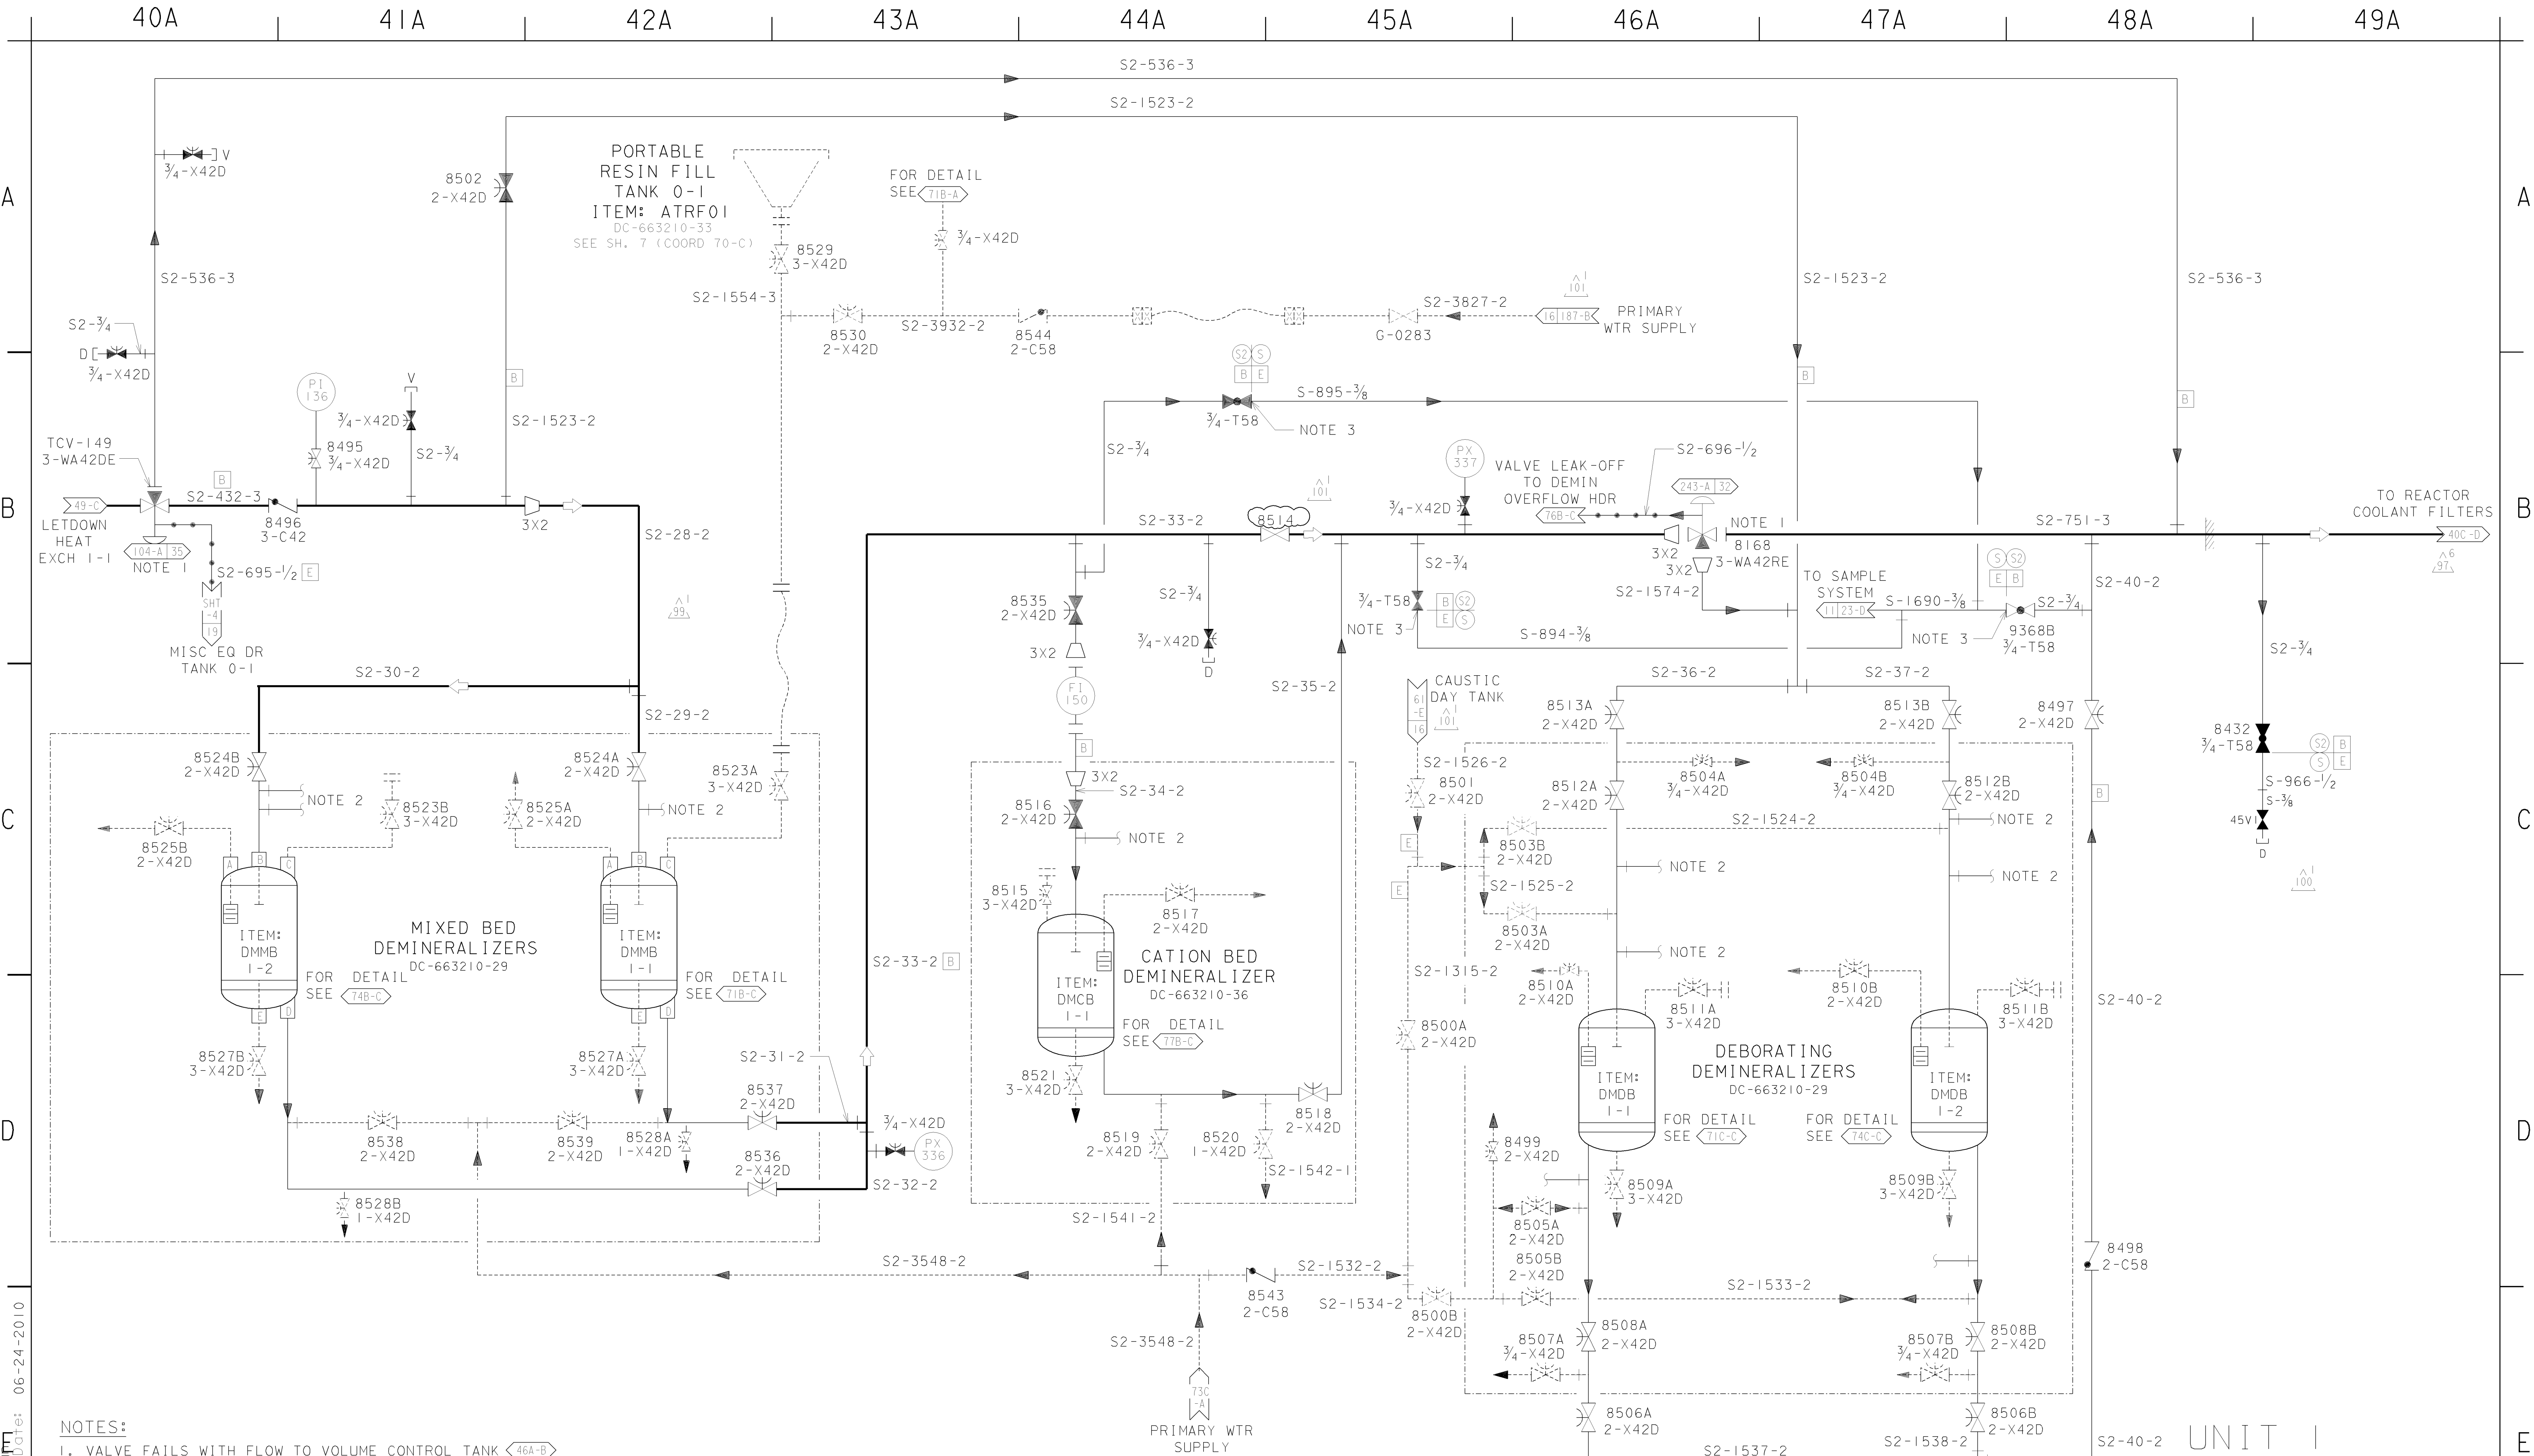


NOTES:
1. VALVE FAILS WITH FLOW TO VOLUME CONTROL TANK 46A-B
2. FOR VENTS & DRAINS OFF INLET LINES SEE SH. 7 41A-C 42A-C 44A-C 46A-C 47A-C
3. 3/8" TUBING INSERTED IN 3/4" NOMINAL PIPE AT VALVE 45A-B
REF DWG 663210-15

06-24-2010	JBMX	AGB2		KERSI J. DALAL	MECHANICAL	M 16690	3/31/2012	REVISED PER DFT-7*829
DATE	DWN	RE	IV	PROFESSIONAL ENGINEER	PE DISC.	PE#	PE EXP.	

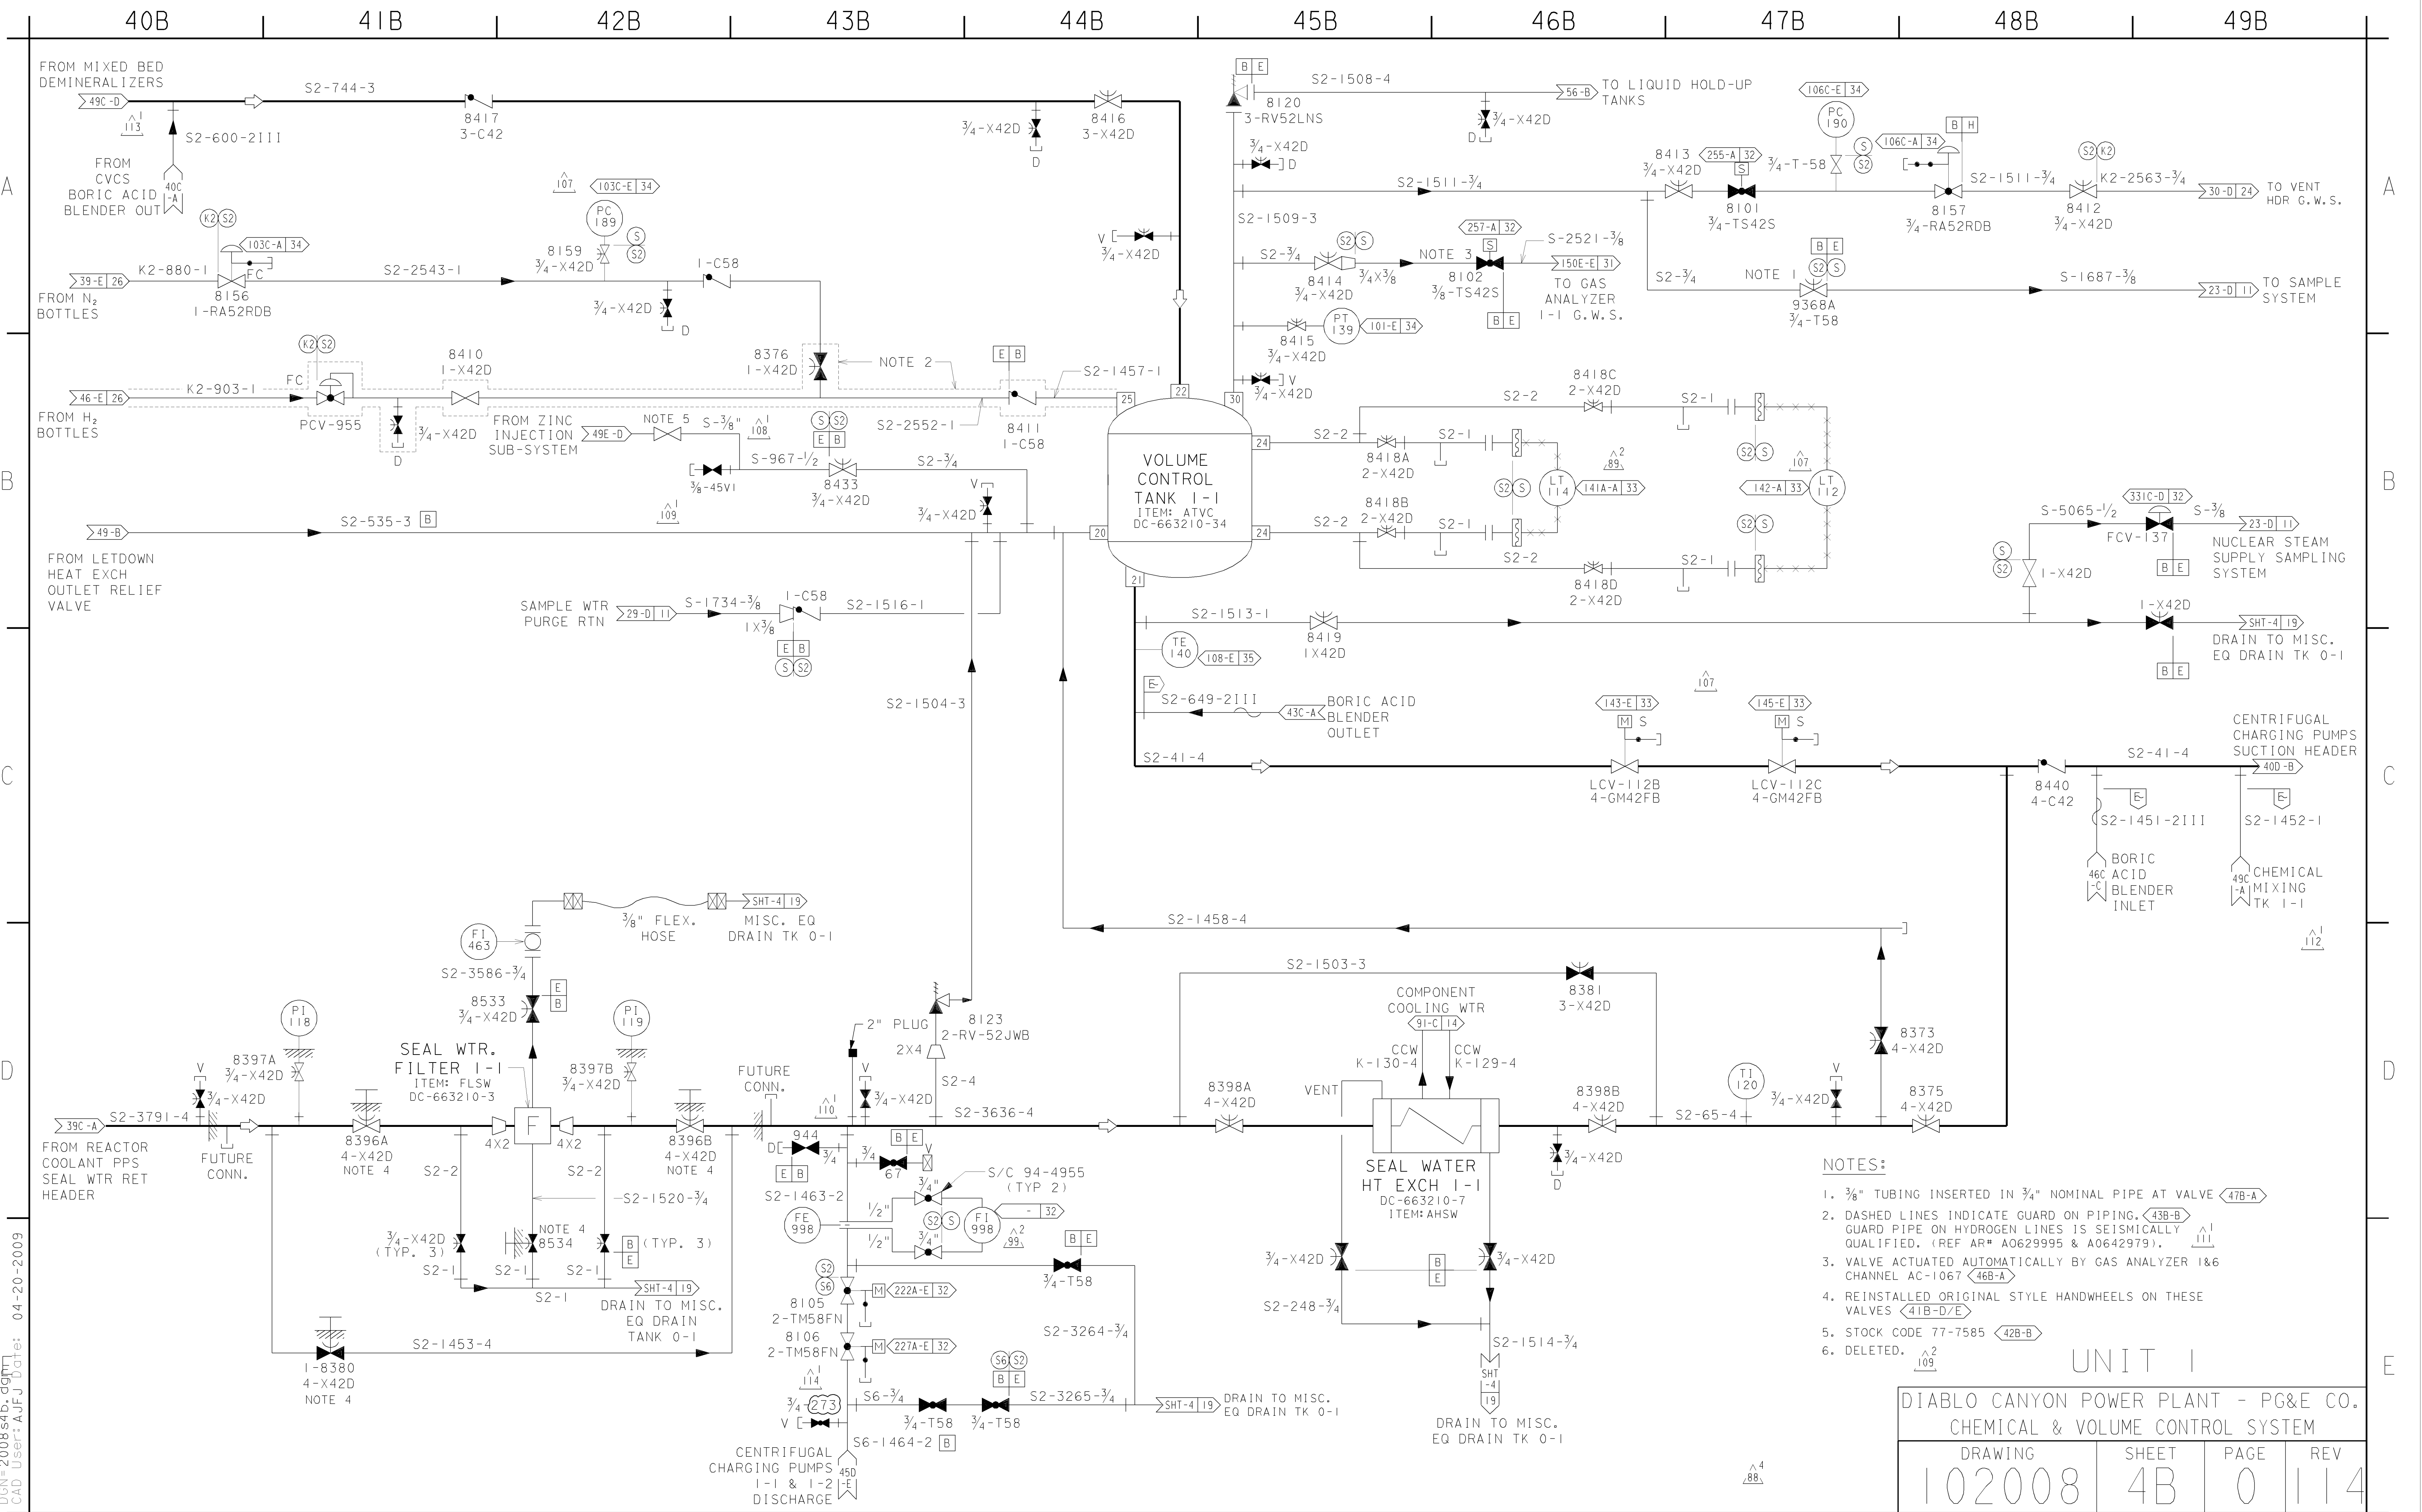

RASTER=2008s4b.dgn
DGN=2008s4b.dgn
CAD User: AJFJ Date: 04-20-2009

04-20-2009	AJFJ	Fx C2	KERSI J. DALAL	MECHANICAL	M 16690	3/31/2010	REVISED PER DFT-7*393
DATE	DWN	RE	IV	PROFESSIONAL ENGINEER	PE DISC.	PE*	PE EXP.

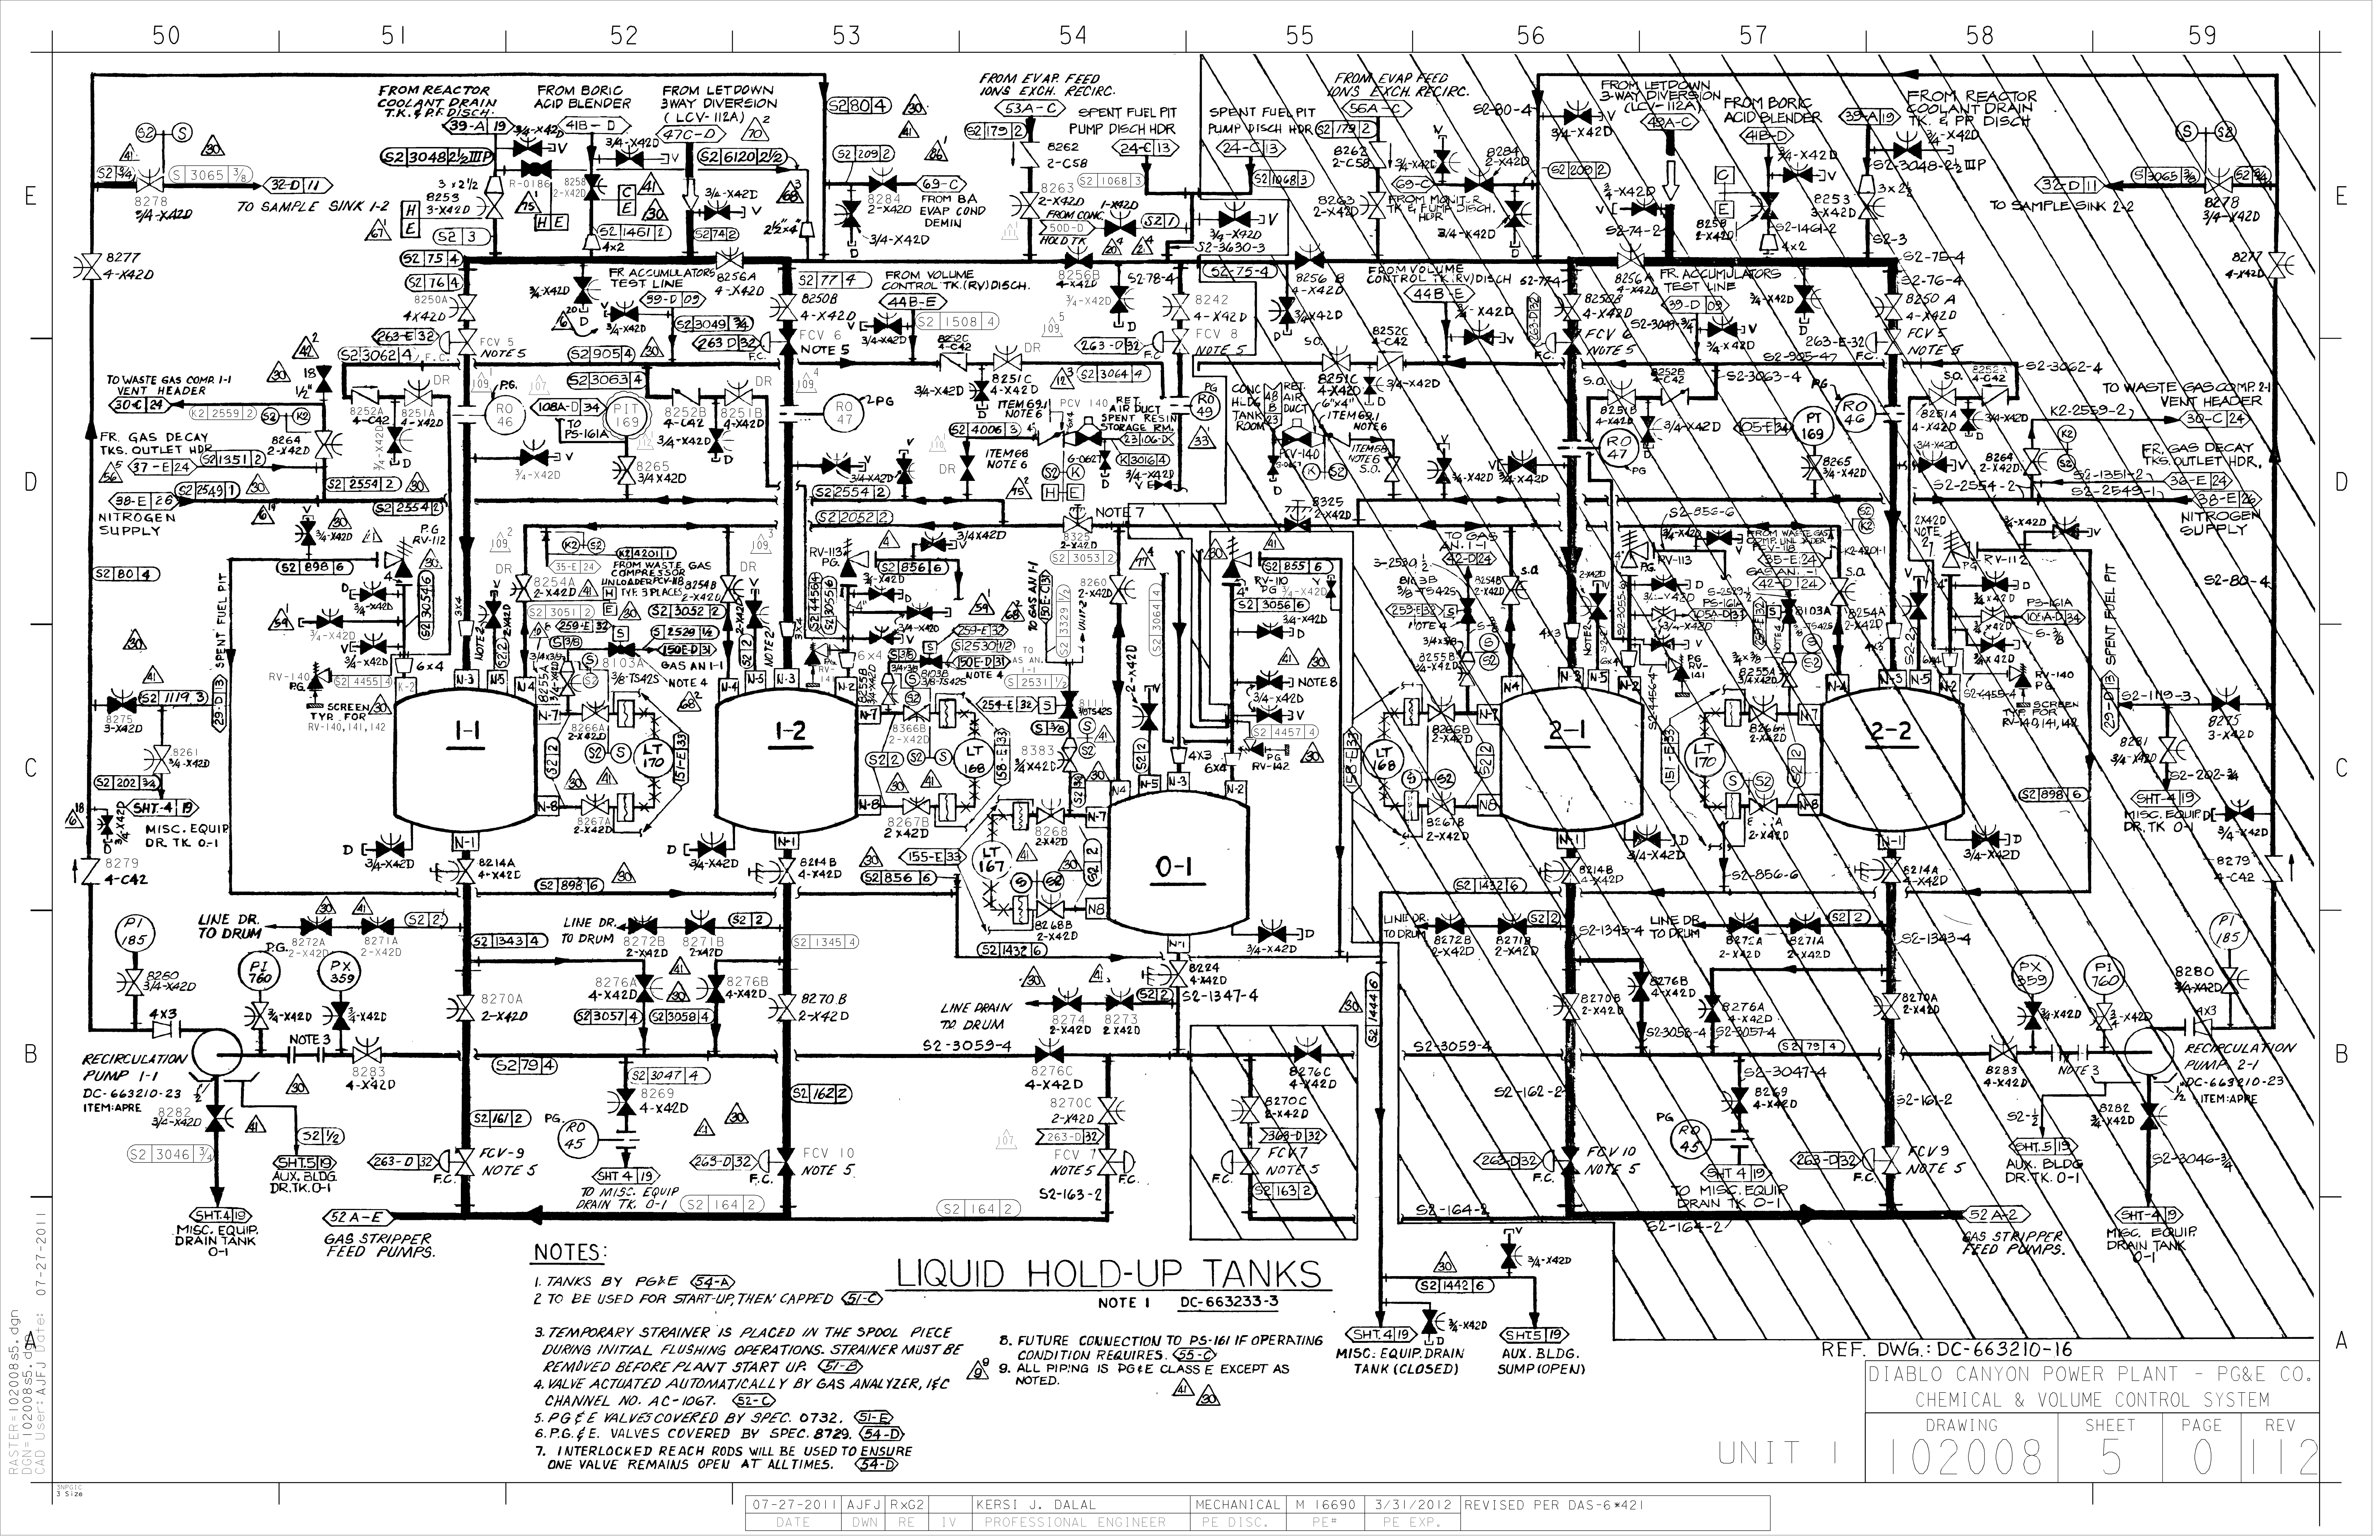

NOTES:

- 1. TANKS BY PG&E (54-A)
- 2. TO BE USED FOR START-UP, THEN CAPPED (51-C)
- 3. TEMPORARY STRAINER IS PLACED IN THE SPOOL PIECE DURING INITIAL FLUSHING OPERATIONS. STRAINER MUST BE REMOVED BEFORE PLANT START UP (51-B)
- 4. VALVE ACTUATED AUTOMATICALLY BY GAS ANALYZER, IFC CHANNEL NO. AC-1067. (52-C)
- 5. PG&E VALVES COVERED BY SPEC. 0732. (51-E)
- 6. PG&E VALVES COVERED BY SPEC. 8729. (54-D)
- 7. INTERLOCKED REACH RODS WILL BE USED TO ENSURE ONE VALVE REMAINS OPEN AT ALL TIMES. (54-D)

LIQUID HOLD-UP TANKS


NOTE 1 DC-663233-3


- 8. FUTURE CONNECTION TO PS-161 IF OPERATING CONDITION REQUIRES. (55-C)
- 9. ALL PIPING IS PG&E CLASS E EXCEPT AS NOTED.

REF. DWG.: DC-663210-16

DIABLO CANYON POWER PLANT - PG&E CO.
CHEMICAL & VOLUME CONTROL SYSTEM

DRAWING	SHEET	PAGE	REV
UNIT 1	102008	5	0112

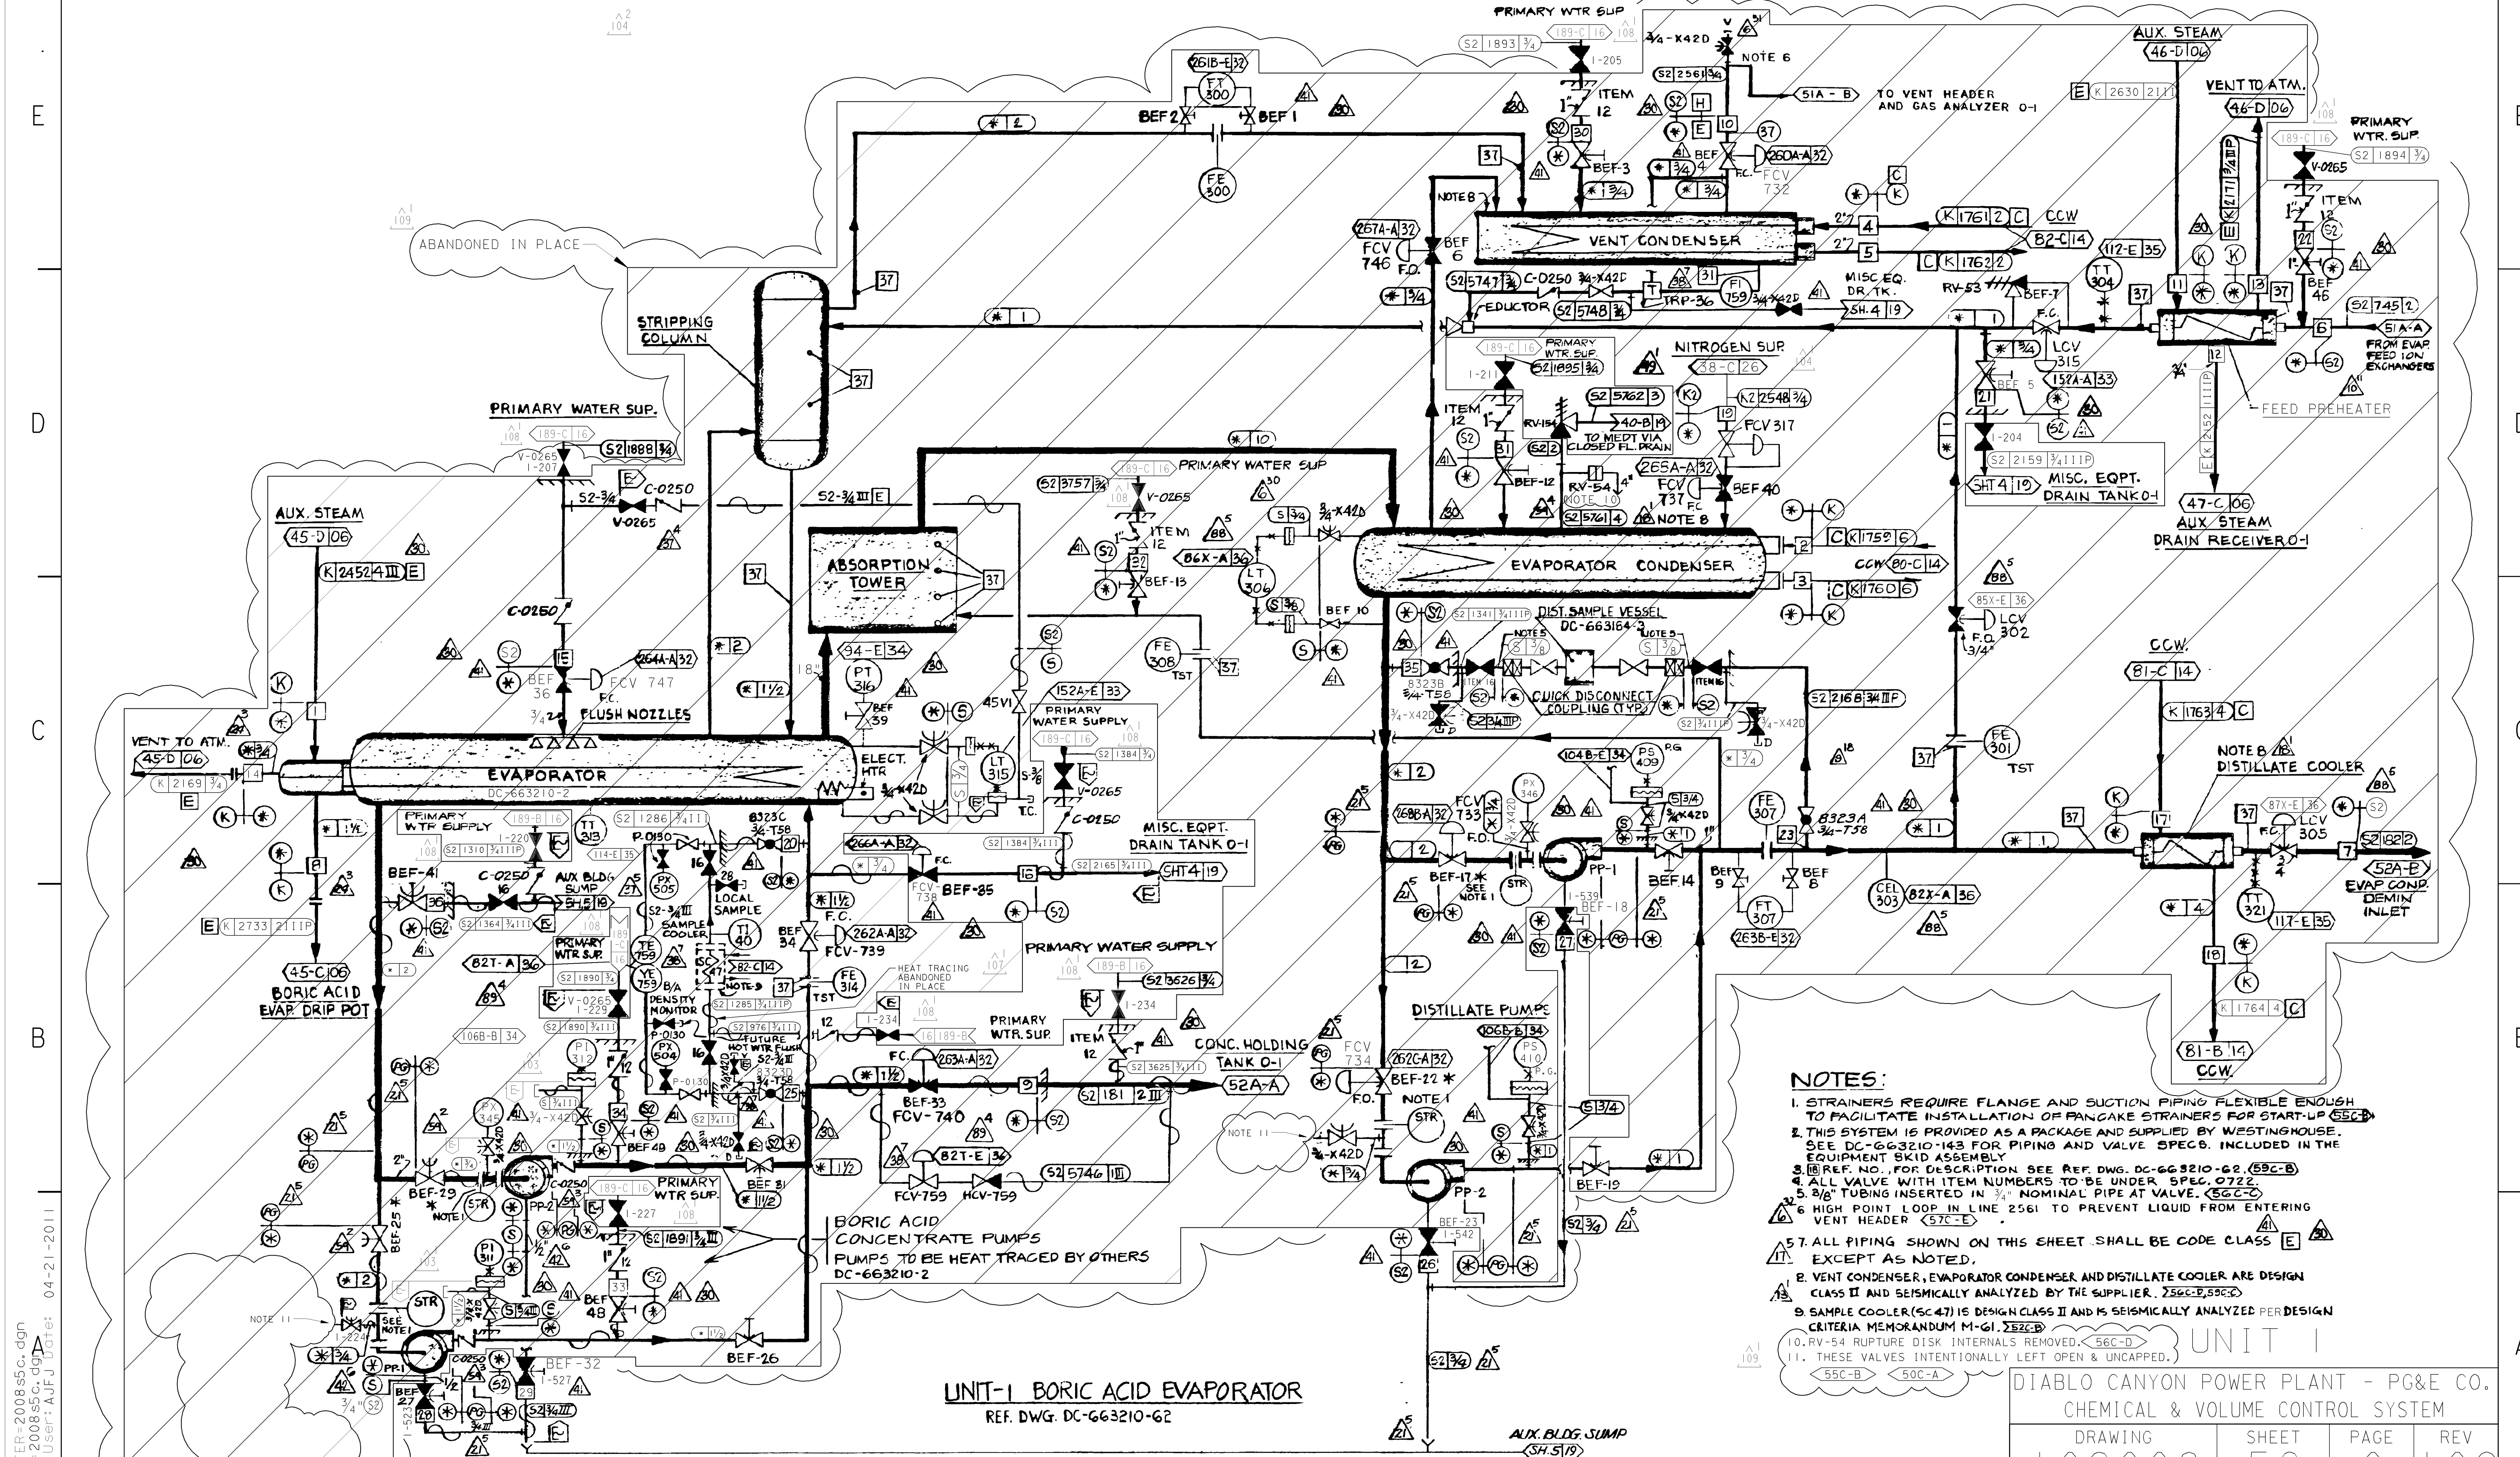

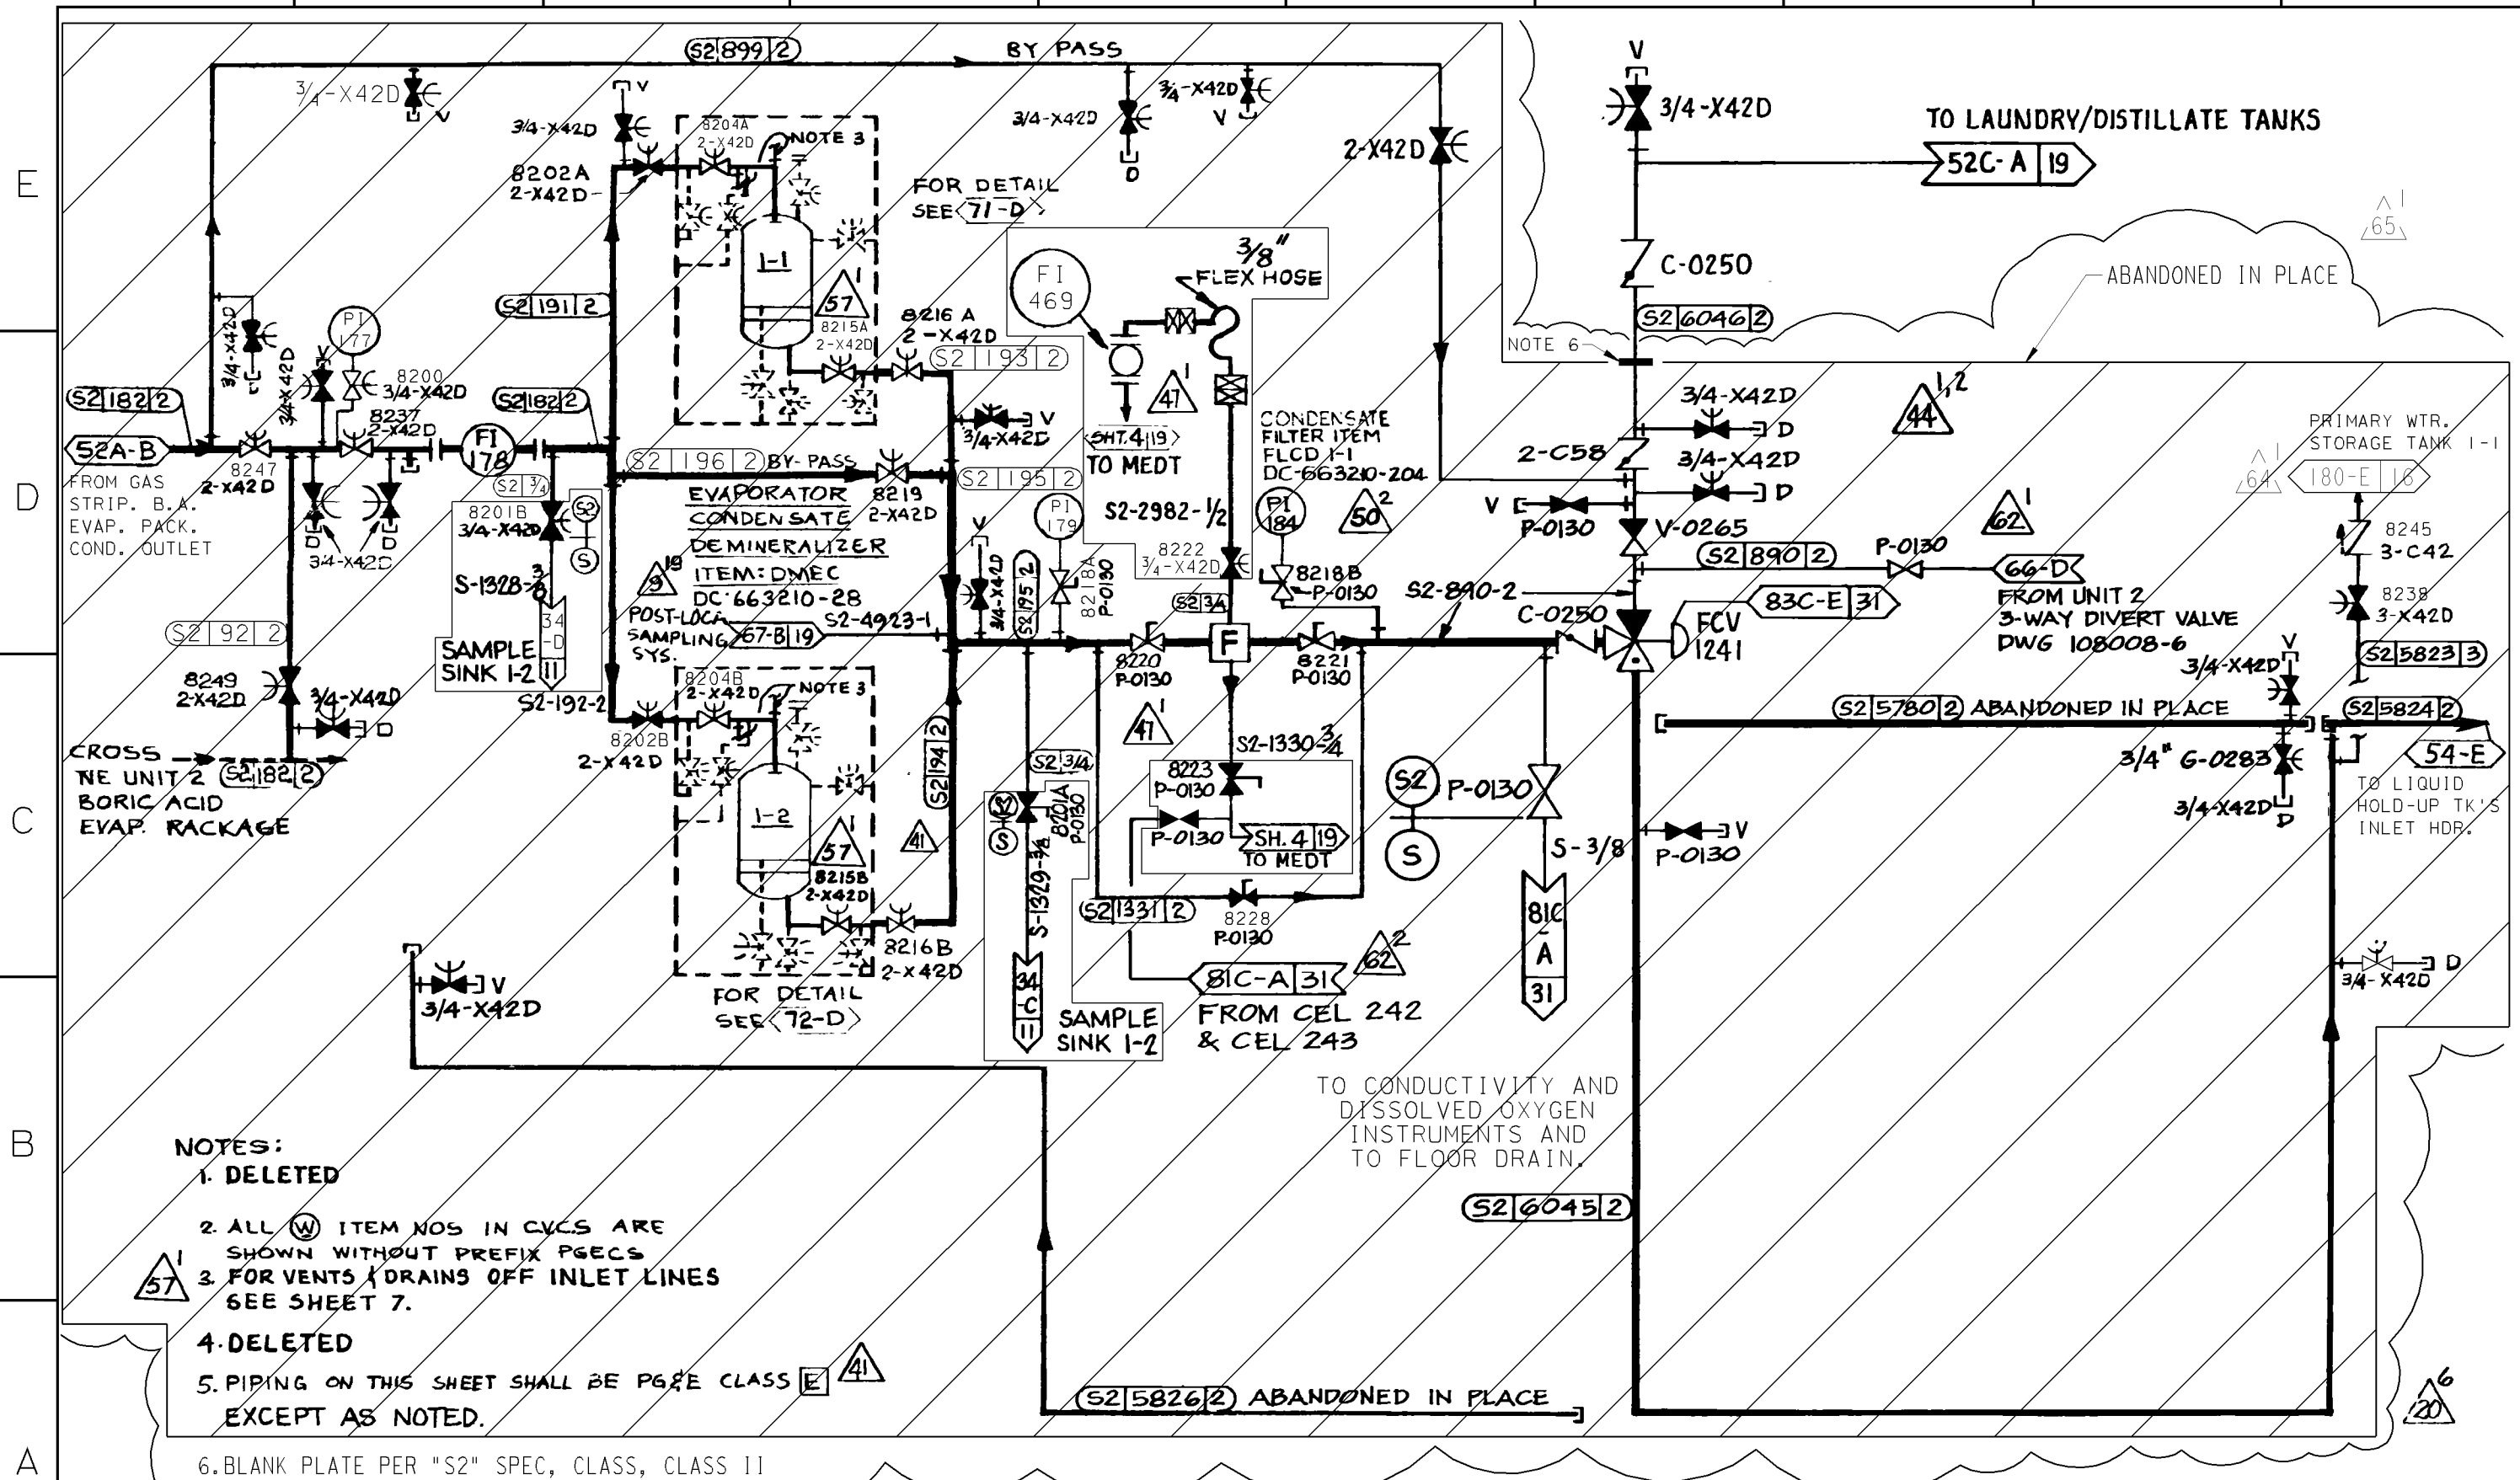

~~NOTES:~~

1. DELETED
2. ALL (W) ITEM NOS IN CYCS ARE SHOWN WITHOUT PREFIX PGCS
3. FOR VENTS & DRAINS OFF INLET LINES SEE SHEET 7.
4. DELETED
5. PIPING ON THIS SHEET SHALL BE PGCS EXCEPT AS NOTED.

6. BLANK PLATE PER "S2" SPEC, CLASS, CLASS II

TO CONDUCTIVITY AND
DISSOLVED OXYGEN
INSTRUMENTS AND
TO FLOOR DRAIN.

UNIT 1

REF. DWG. 663210-41


DIABLO CANYON POWER PLANT - PG&E CO.
CHEMICAL & VOLUME CONTROL SYSTEM

DRAWING	SHEET	PAGE	REV
102008	6	0	65


RASTER=2008s6.dgn
DGN=2008s6.dgn
CAD User: AJFJ Doc

INPGIC
I Size

04-13-2011	AJFJ	FxC2		KERSI J. DALAL	MECHANICAL	M 16690	3/31/2012	REVISED PER DDN-2*560
DATE	DWN	RE	IV	PROFESSIONAL ENGINEER	PE DISC.	PE#	PE EXP.	

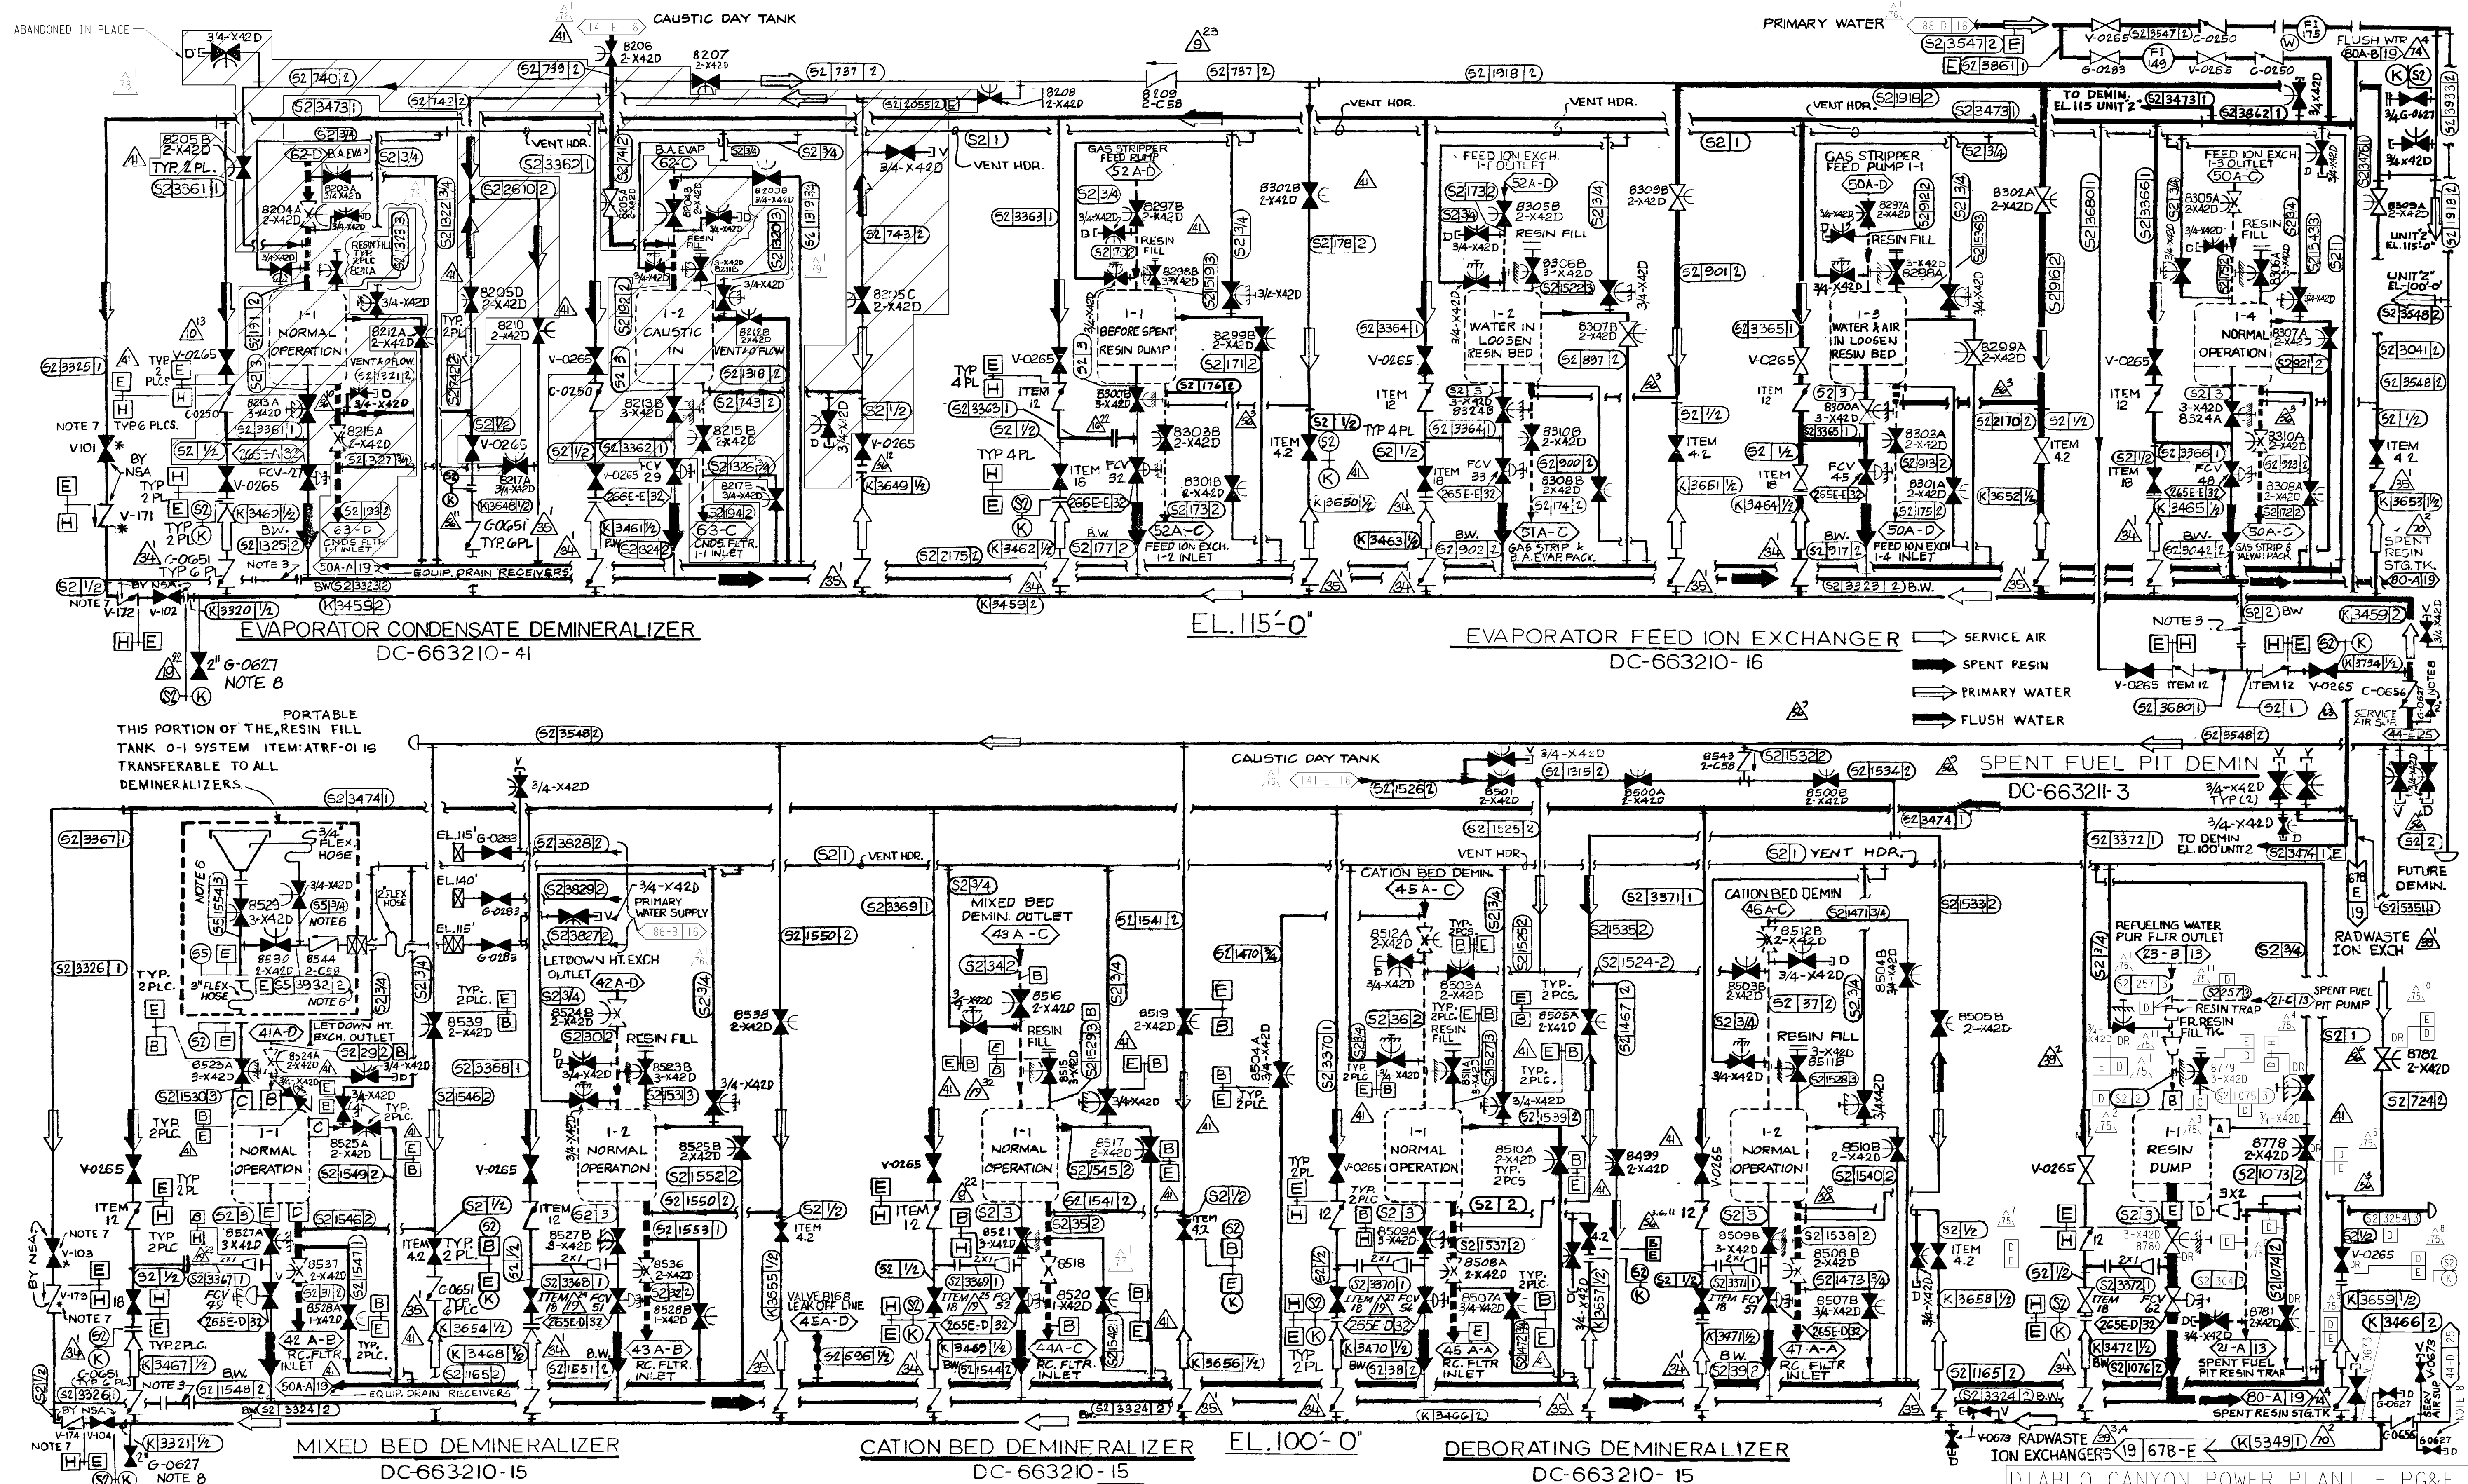

NOTES: 1. FOR PIPING SPECS, SPEC BOUNDARIES, CODE CLASSES AND CODE BOUNDARIES REFER TO EQUIPMENT 1 IN EACH DEMINERALIZER GROUP.
2. BW INDICATES BUTTWELDED 72-A

3. 1" FLANGED SPOOL FOR CLEANOUT ENTRY INTO 2" LINE. (70.79-AD)
 4. ALL VALVES WITH ITEM NOS. TO BE UNDER SPEC.0722 UNLESS NOTED.
 5. PIPING ON THIS SHEET IS P.G. & E. CODE CLASS E, 
 EXCEPT AS NOTED.
 6. SPEC. "55" APPLIES TO PIPE ONLY, EXCLUDING FLANGES AND VALVES

7. VALVES PROVIDED BY "NSA" SEE DWG. 101935
(VALVE INVENTORY) 70-D,A
B. RESIN HDR. BLOWOUT VALVES 70-C,A 79-C,A

DIABLO CANYON POWER PLANT - PG&E CO. CHEMICAL & VOLUME CONTROL SYSTEM

DRAWING	SHEET	PAGE	REV
---------	-------	------	-----

UNIT 1	102008	7	0	79
--------	--------	---	---	----

A

B

C

D

E


A

B

C

D

E

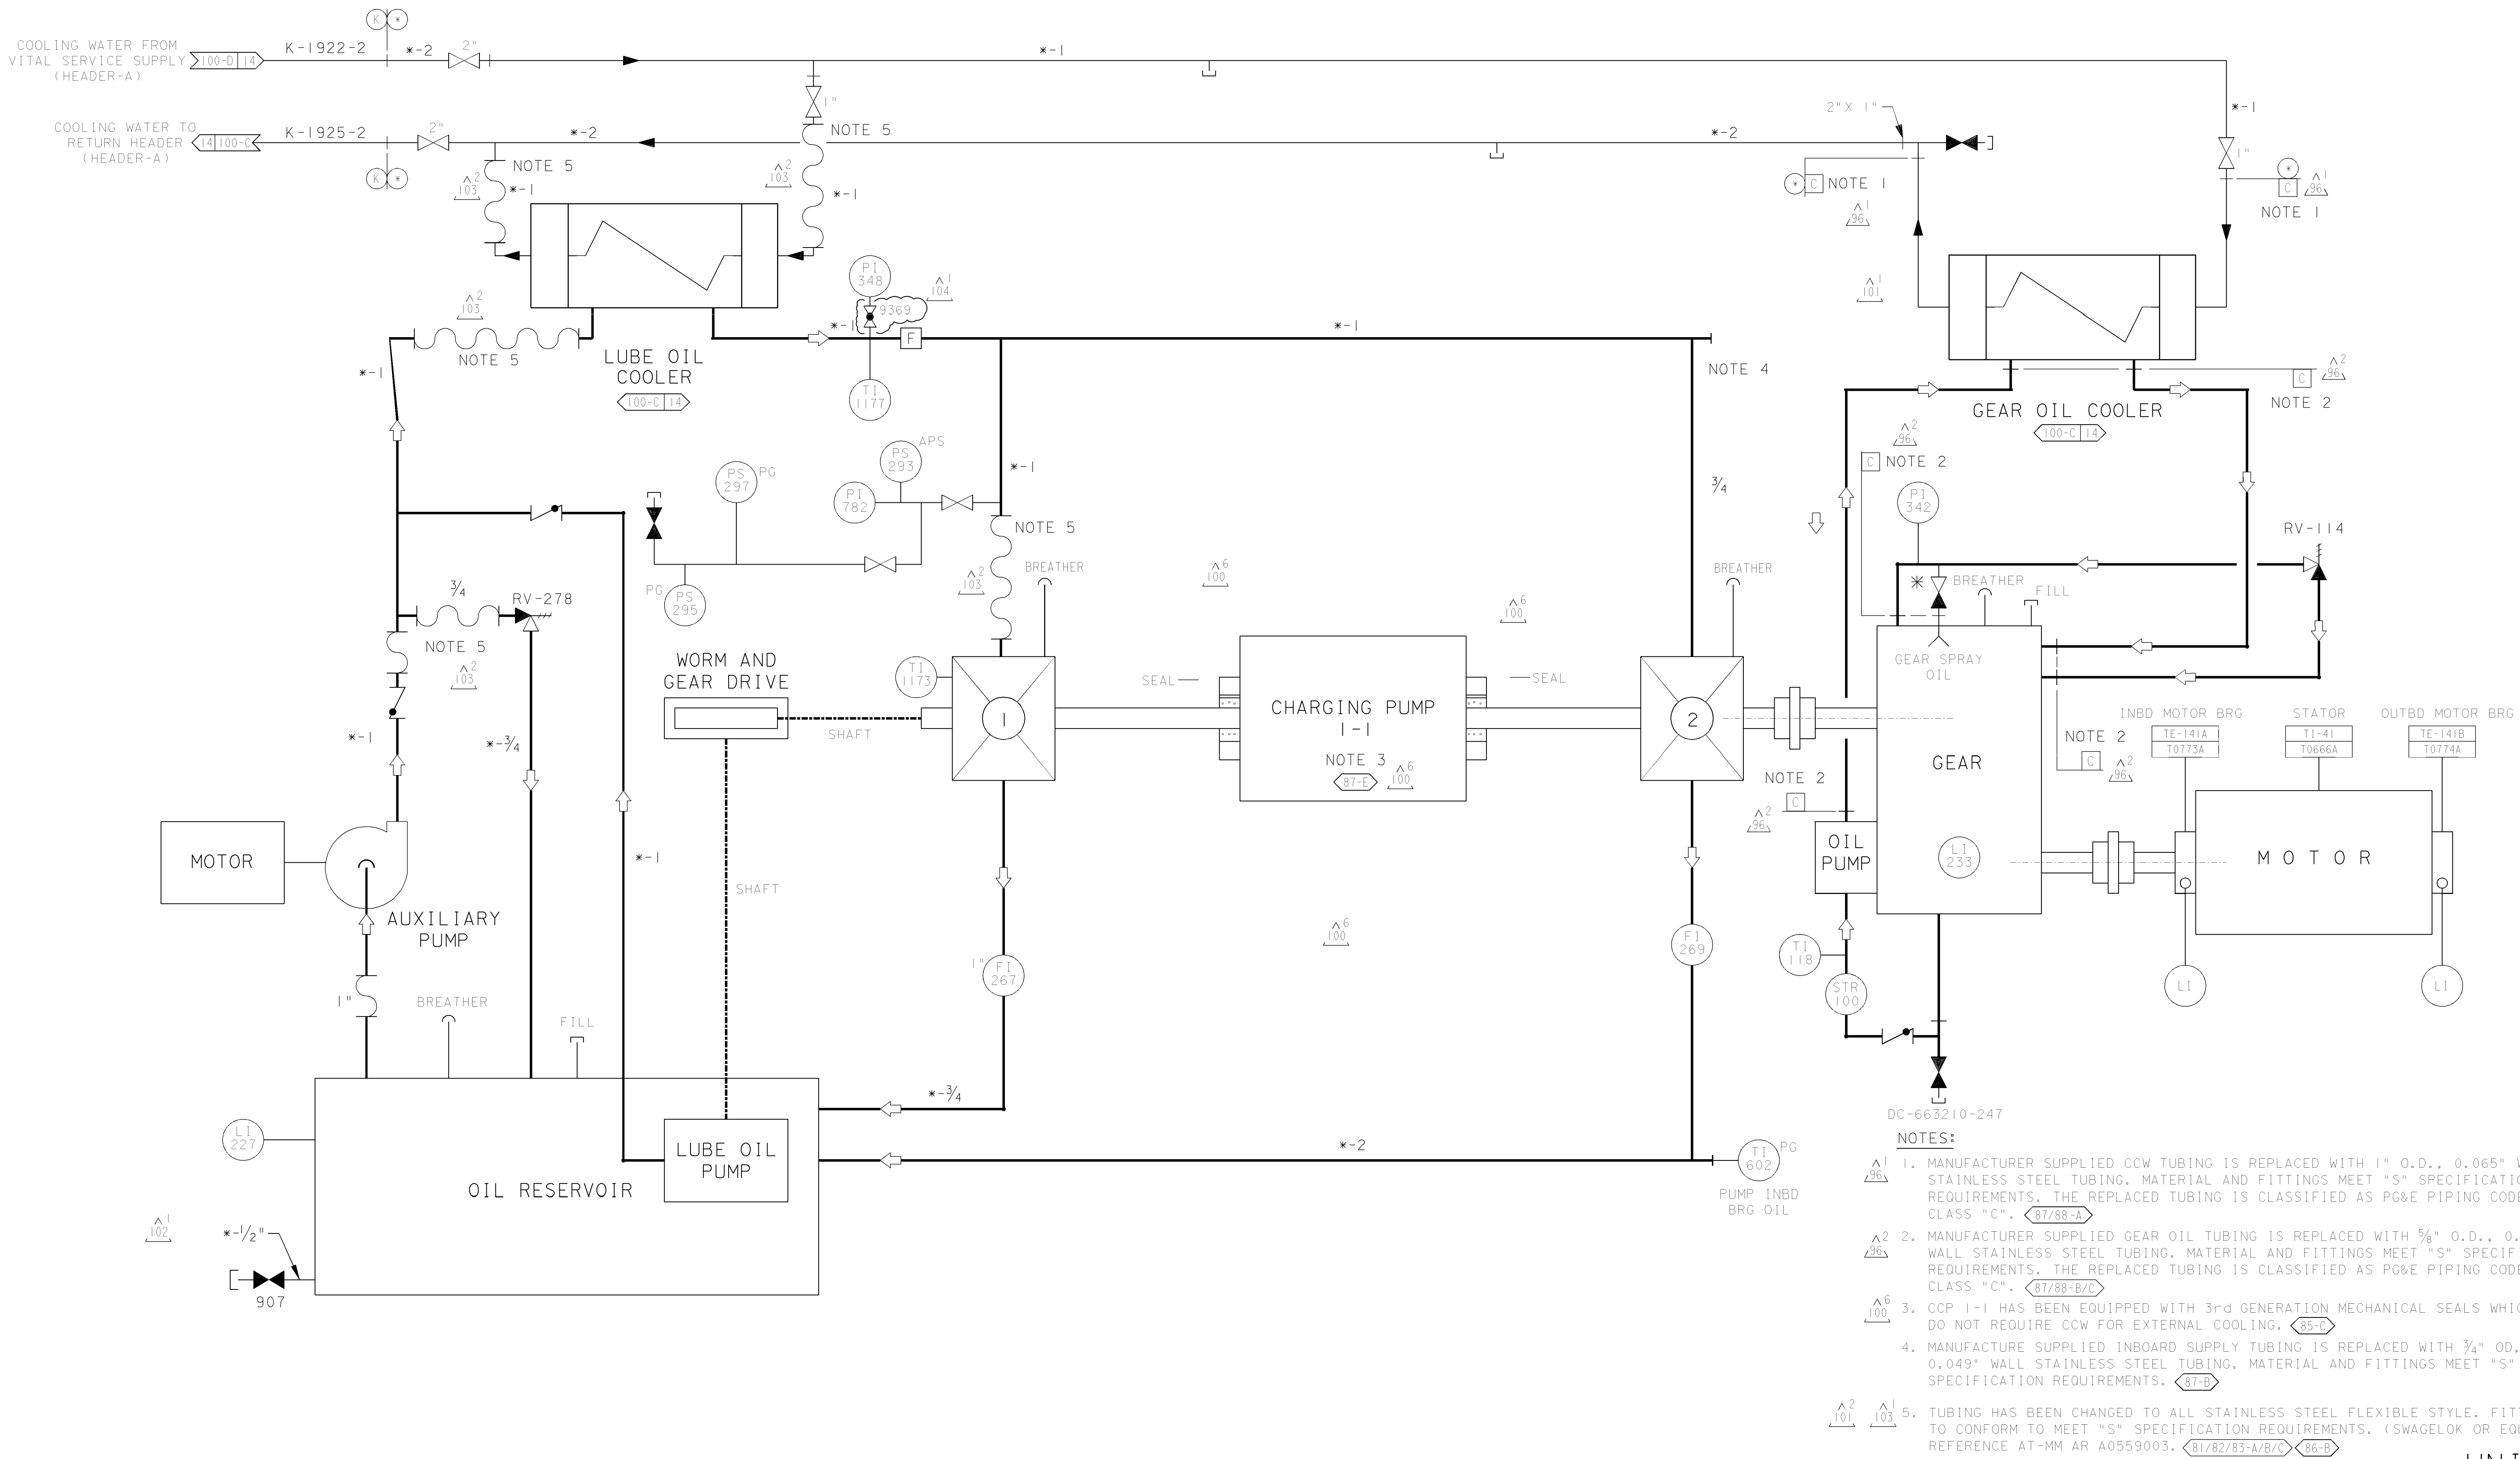

CENTRIFUGAL CHARGING PUMP 1-1
LUBE OIL, GEAR OIL, SEAL FLUSH AND COOLER PIPING
DC-663210-50

- NOTES:
- 1. MANUFACTURER SUPPLIED CCW TUBING IS REPLACED WITH 1" O.D., 0.065" WALL STAINLESS STEEL TUBING. MATERIAL AND FITTINGS MEET "S" SPECIFICATION REQUIREMENTS. THE REPLACED TUBING IS CLASSIFIED AS PG&E PIPING CODE CLASS "C". <87/88-A>
 - 2. MANUFACTURER SUPPLIED GEAR OIL TUBING IS REPLACED WITH 3/4" O.D., 0.049" WALL STAINLESS STEEL TUBING. MATERIAL AND FITTINGS MEET "S" SPECIFICATION REQUIREMENTS. THE REPLACED TUBING IS CLASSIFIED AS PG&E PIPING CODE CLASS "C". <87/88-B/C>
 - 3. CCP 1-1 HAS BEEN EQUIPPED WITH 3rd GENERATION MECHANICAL SEALS WHICH DO NOT REQUIRE CCW FOR EXTERNAL COOLING. <85-C>
 - 4. MANUFACTURE SUPPLIED INBOARD SUPPLY TUBING IS REPLACED WITH 3/4" OD, 0.049" WALL STAINLESS STEEL TUBING. MATERIAL AND FITTINGS MEET "S" SPECIFICATION REQUIREMENTS. <87-B>
 - 5. TUBING HAS BEEN CHANGED TO ALL STAINLESS STEEL FLEXIBLE STYLE. FITTINGS TO CONFORM TO MEET "S" SPECIFICATION REQUIREMENTS. (SWAGelok OR EQUAL), REFERENCE AT-MM AR A0559003. <81/82/83-A/B/C> <86-B>

P G & E CO.		102008	REV. 104
SHEET 8	PAGE 0		

12/4/02	PMH2	RMDI	-	ERBAN L. GREEN	MECHANICAL	M 20917	6/30/2005	Revised per FCT 027006
DATE	DWN	RE	IV	PROFESSIONAL ENGINEER	PE DISC.	PE#	PE EXP.	

A

B

C

D


A

B

C

D

E

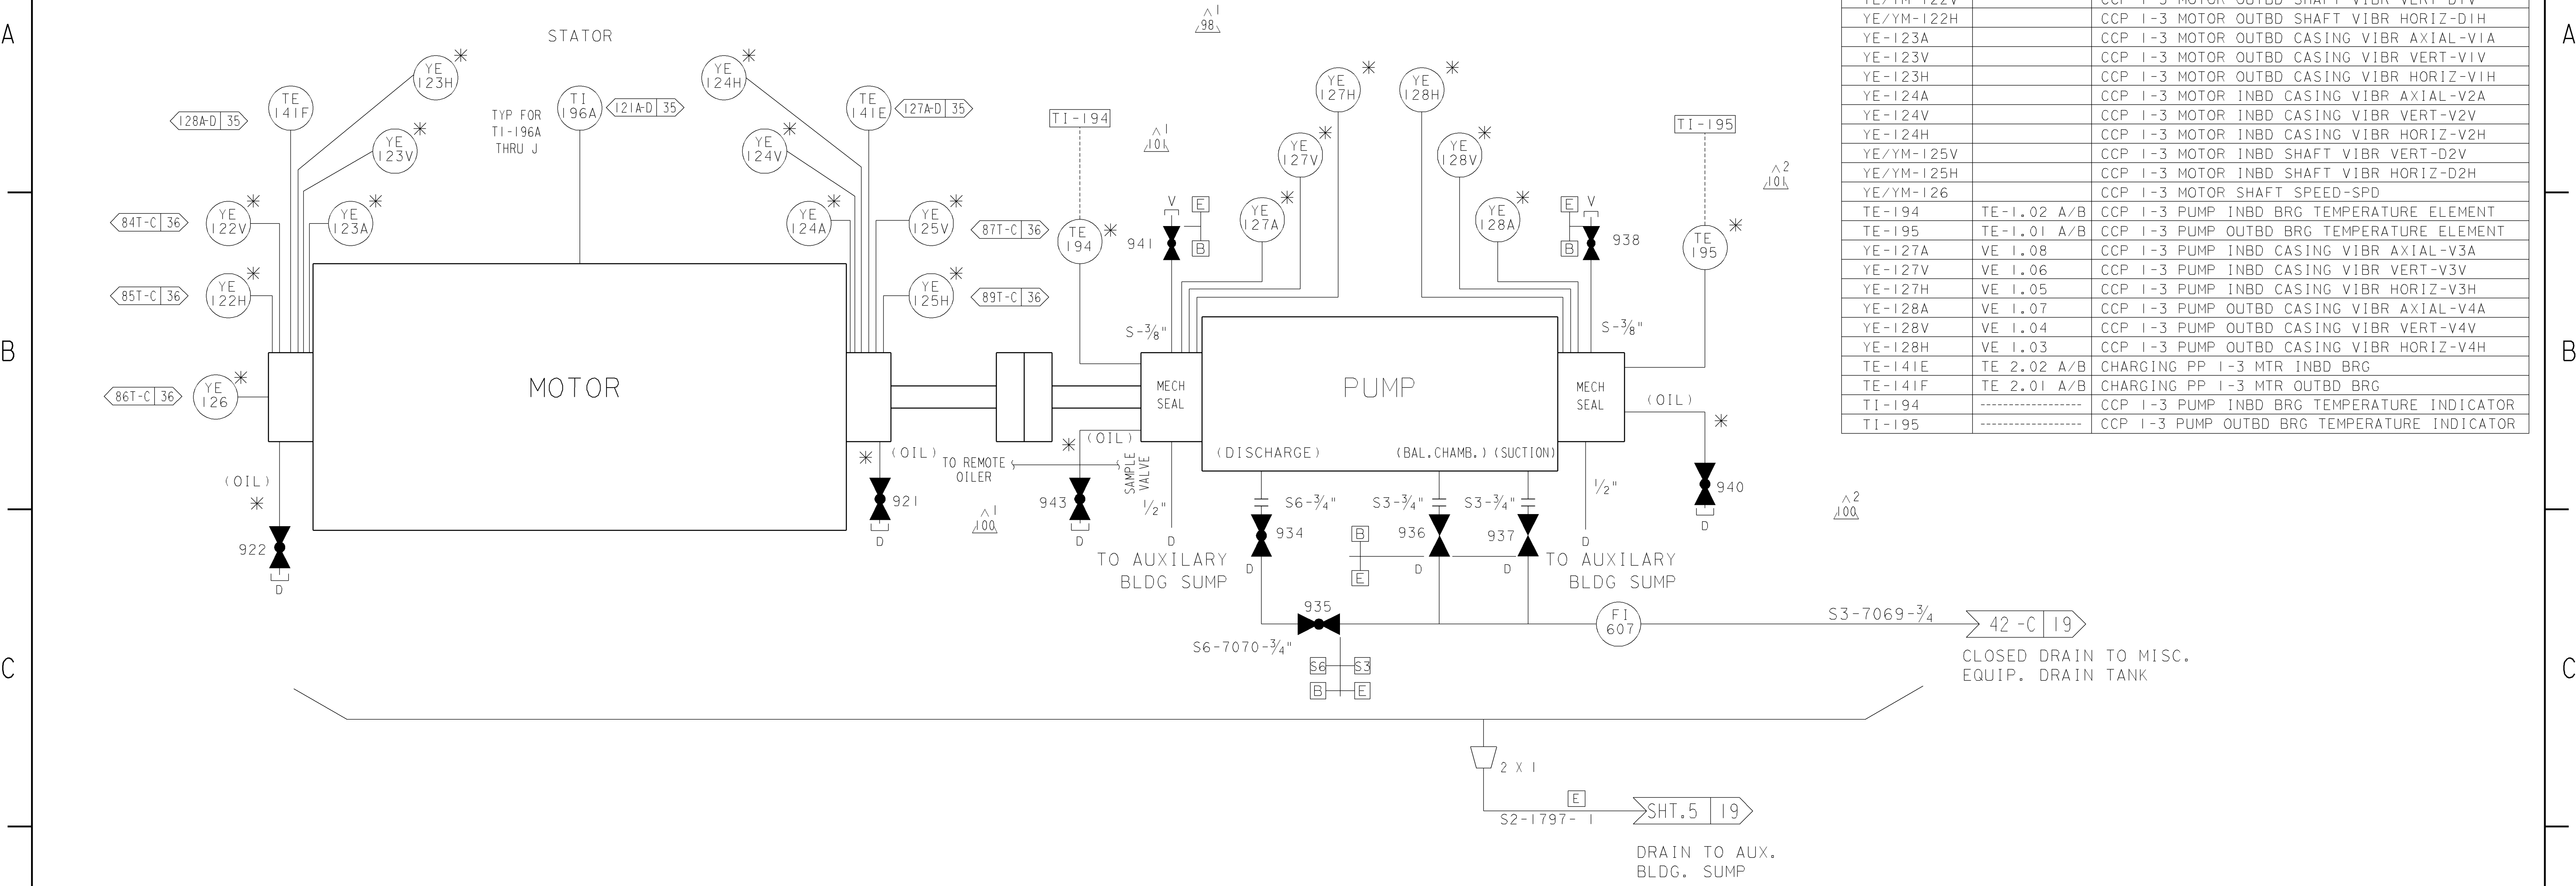

NOTES:

1. ALL PIPING AND VALVES CONNECTED TO THE PUMP BEARING OIL HOUSINGS, PUMP MECH. SEAL HOUSING DRAINS, AND MOTOR BEARING OIL HOUSINGS ARE PIPE CODE CLASS E.
2. ALL VIBRATION, SPEED, AND TEMPERATURE MONITORING INSTRUMENTATION IS INSTRUMENT CLASS II. SEE VENDOR DRAWINGS 663210-321, -334, & -339 FOR ADDITIONAL INSTRUMENTATION INFORMATION.
3. * - SUPPLIED WITH ASSOCIATED EQUIPMENT. FOR LEGEND SEE PIPING SCHEMATIC LEGEND DWG. 102001-3.

UNIT 1


DIABLO CANYON POWER PLANT - PG&E CO. CHEMICAL & VOLUME CONTROL SYSTEM			
DRAWING	SHEET	PAGE	REV
102008	9	0	102

CENTRIFUGAL CHARGING PUMP 1-3

REF DWG DC-663210-301

07-22-2009	RxG2	FxC2		KERSI J. DALAL	MECHANICAL	M 16690	3/31/2010	REVISED PER DFT-7*491
DATE	DWN	RE	1V	PROFESSIONAL ENGINEER	PE DISC.	PE#	PE EXP.	

RASTER=2008s9.dgn
DCN=2008s9.dgn
CAD User: RxG2 D07re: 07-22-2009

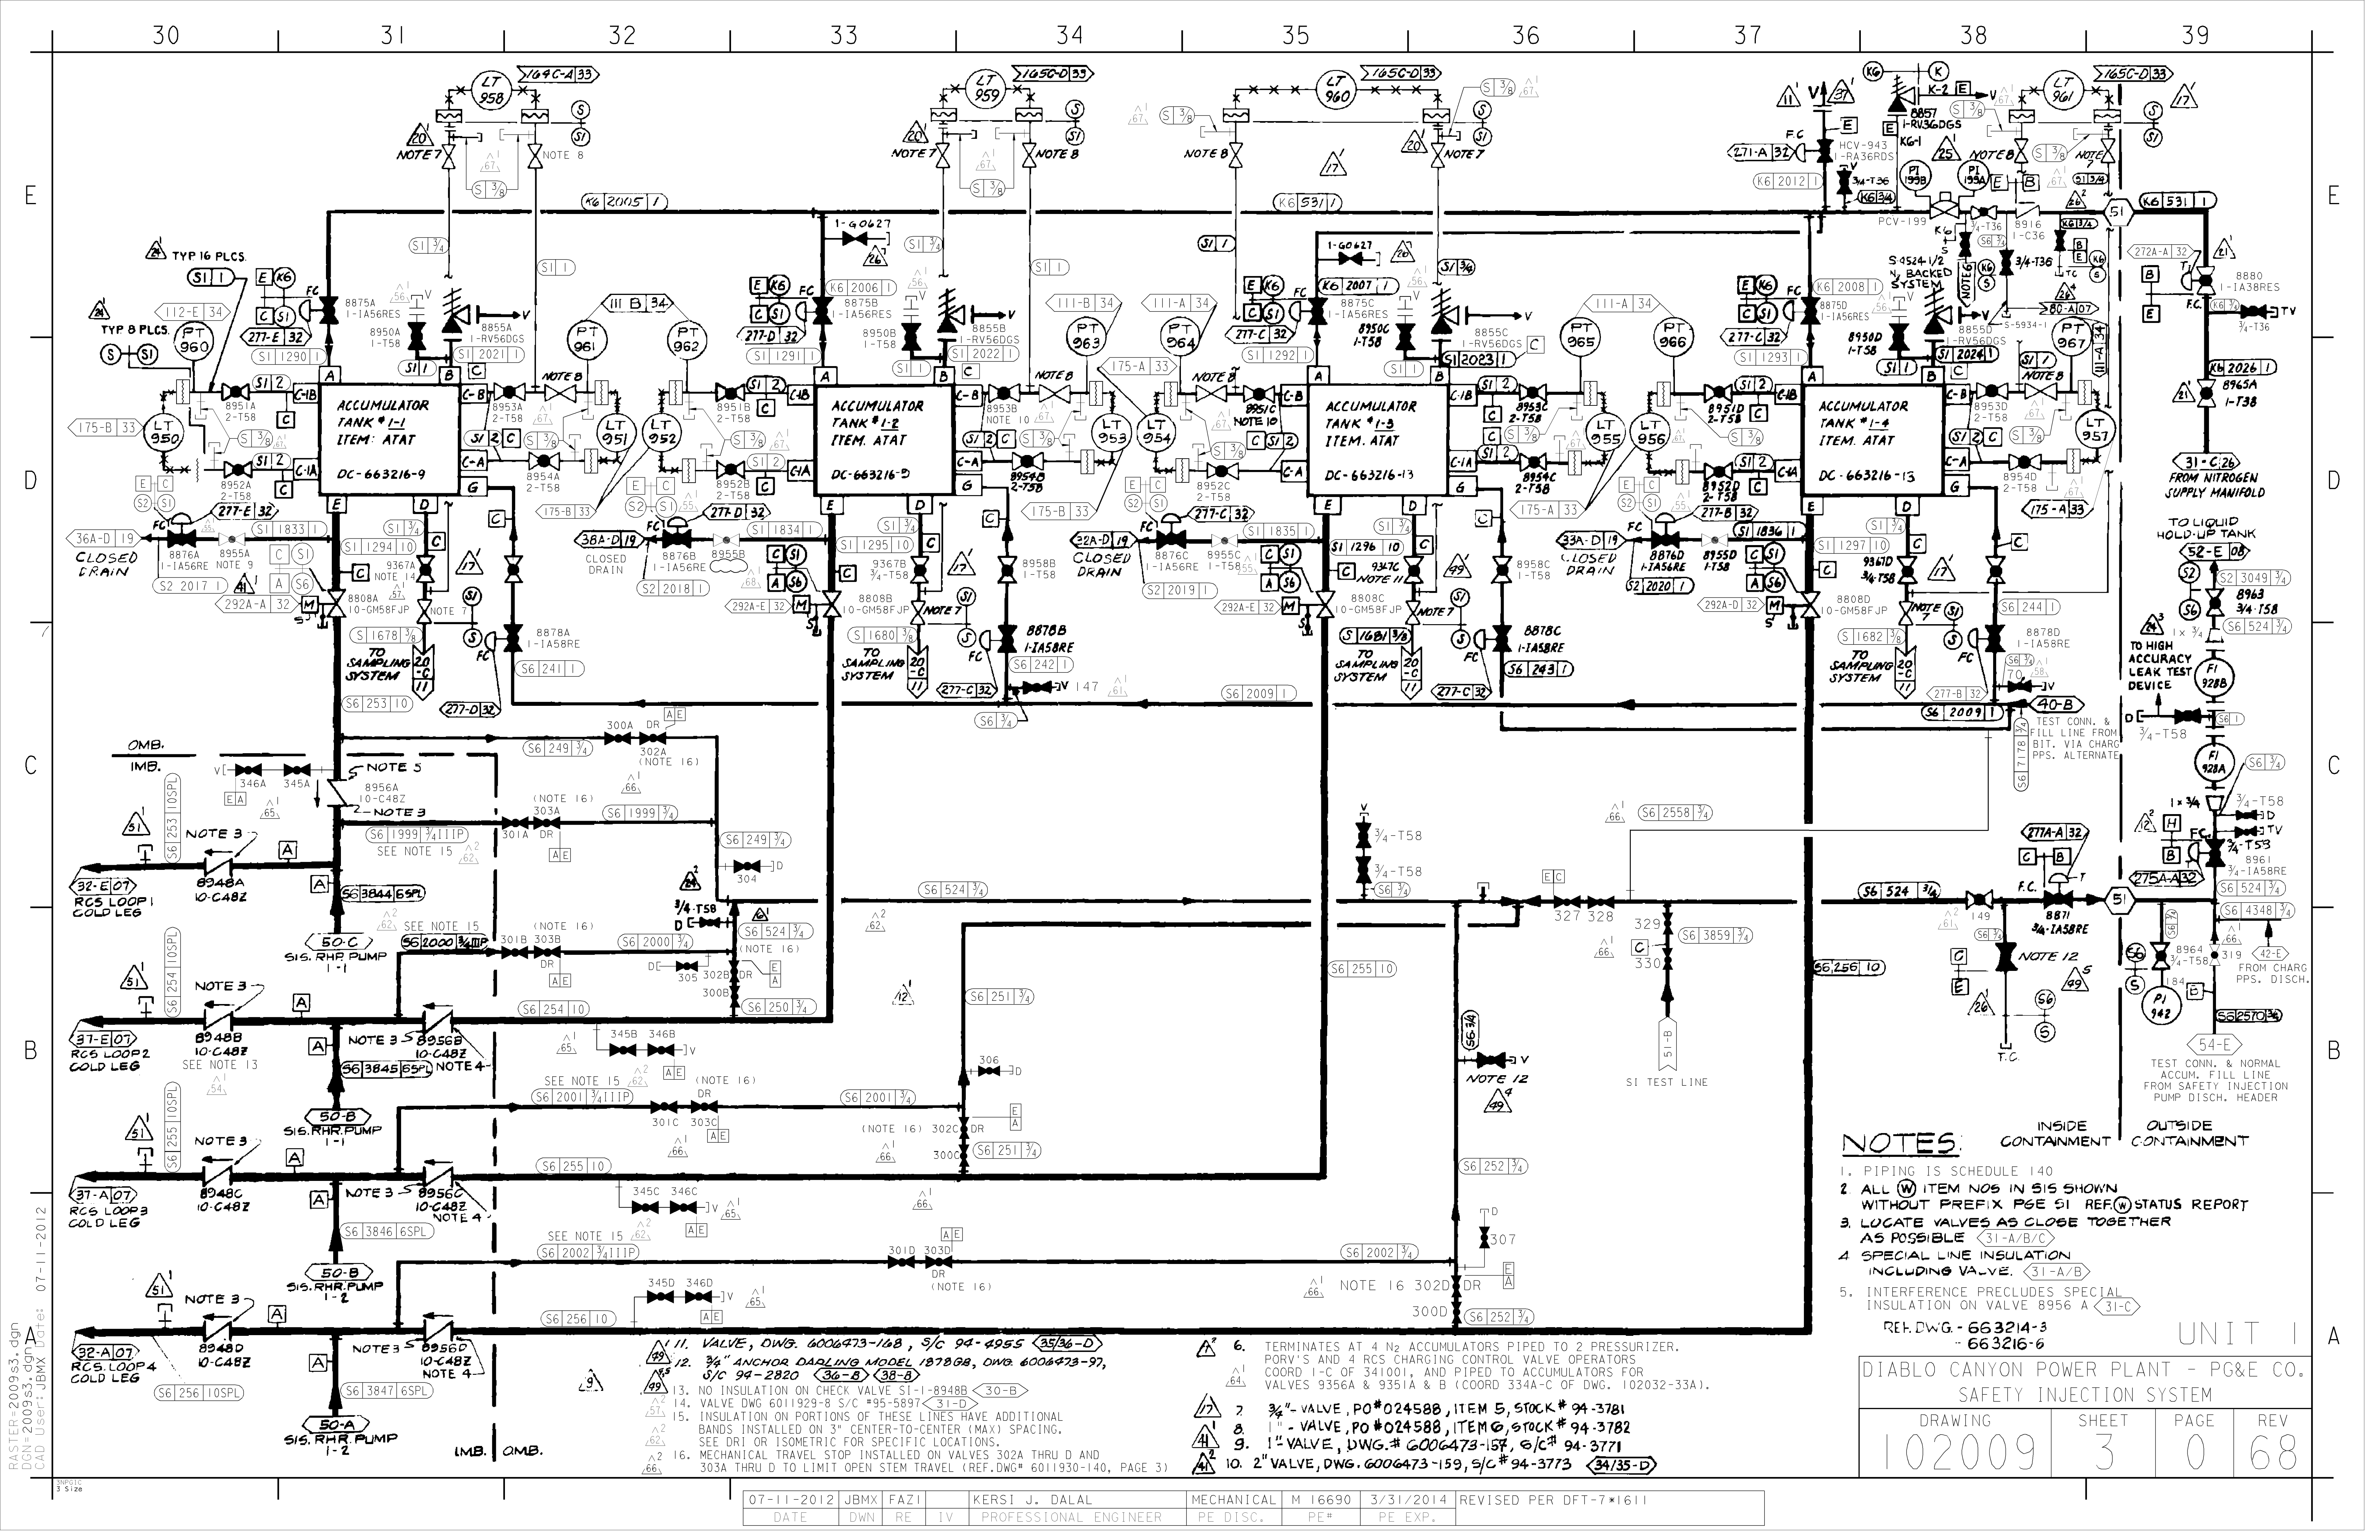

NOTES:


1. PIPING IS SCHEDULE 140
2. ALL (W) ITEM NOS IN SIS SHOWN WITHOUT PREFIX PGE SI REF (W) STATUS REPORT
3. LOCATE VALVES AS CLOSE TOGETHER AS POSSIBLE (31-A/B/C)
4. SPECIAL LINE INSULATION INCLUDING VALVE (31-A/B)
5. INTERFERENCE PRECLUDES SPECIAL INSULATION ON VALVE 8956 A (31-C)


REF. DWG. - 663214-3
- 663216-6

DIABLO CANYON POWER PLANT - PG&E CO.
SAFETY INJECTION SYSTEM


DRAWING	SHEET	PAGE	REV
102009	3	0	68

07-11-2012	JBMX/FAZI	KERSI J. DALAL	MECHANICAL	M 16690	3/31/2014	REVISED PER DFT-7*1611
DATE	DWN	RE	IV	PROFESSIONAL ENGINEER	PE DISC.	PE#

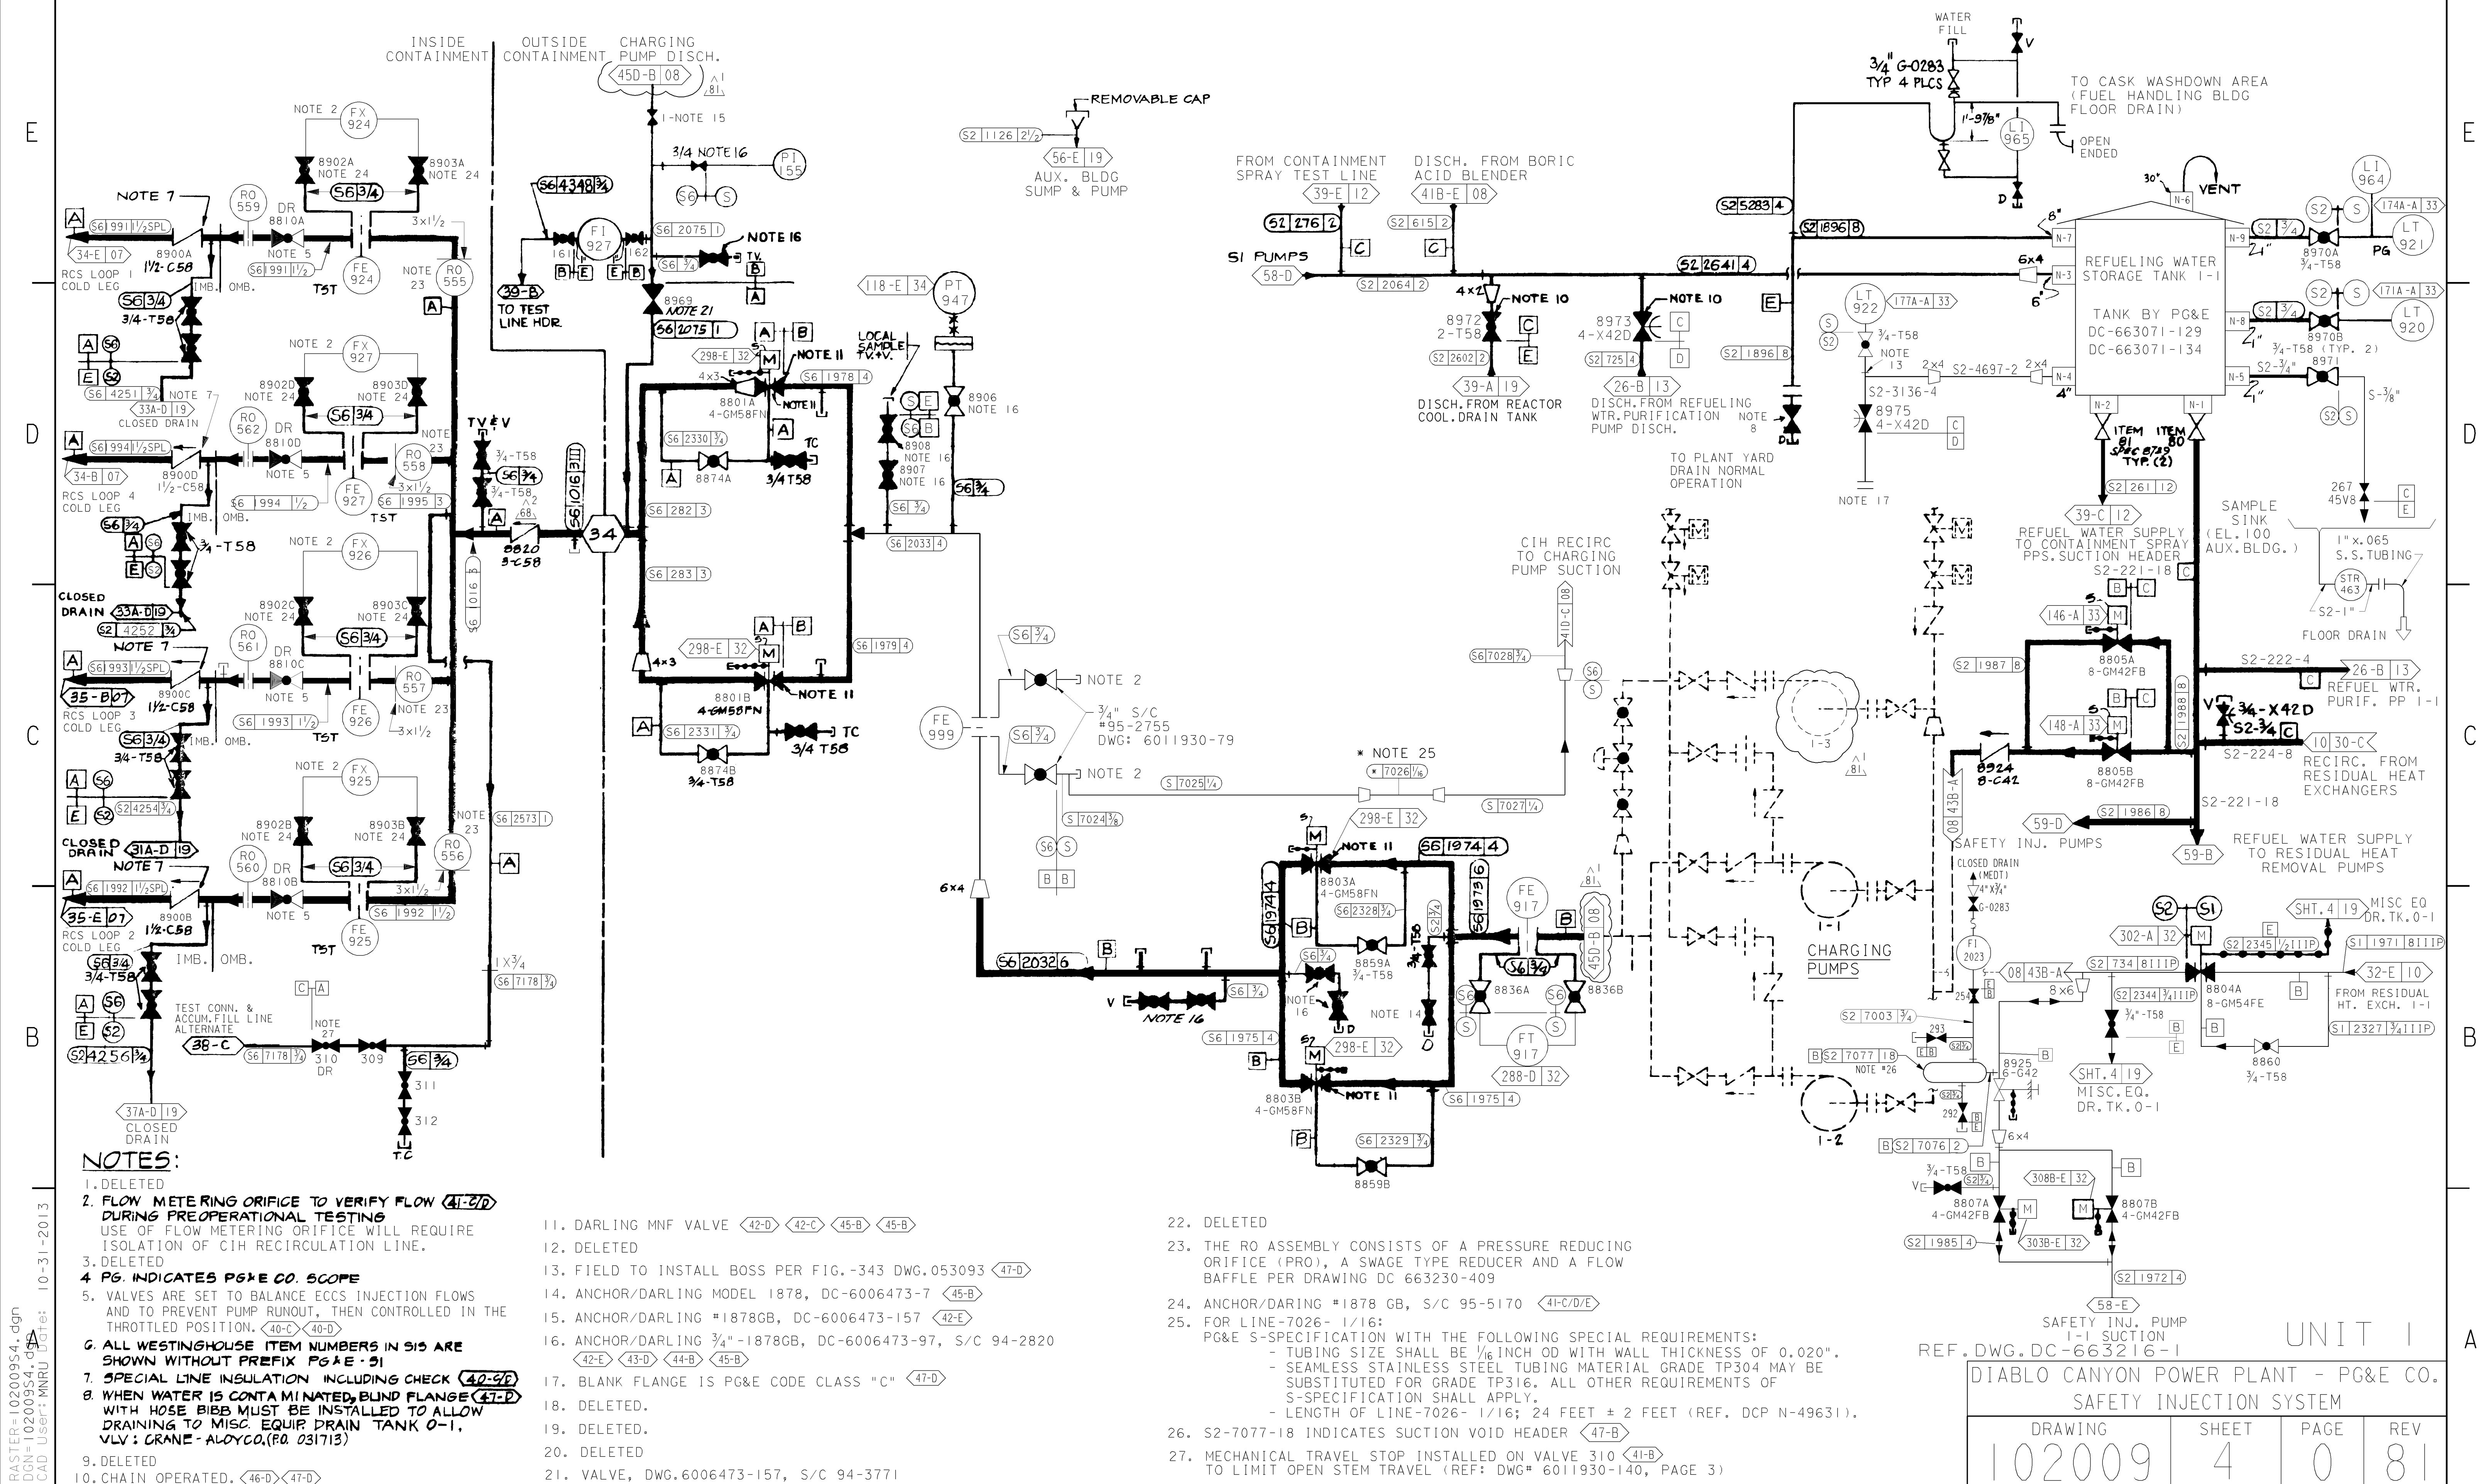

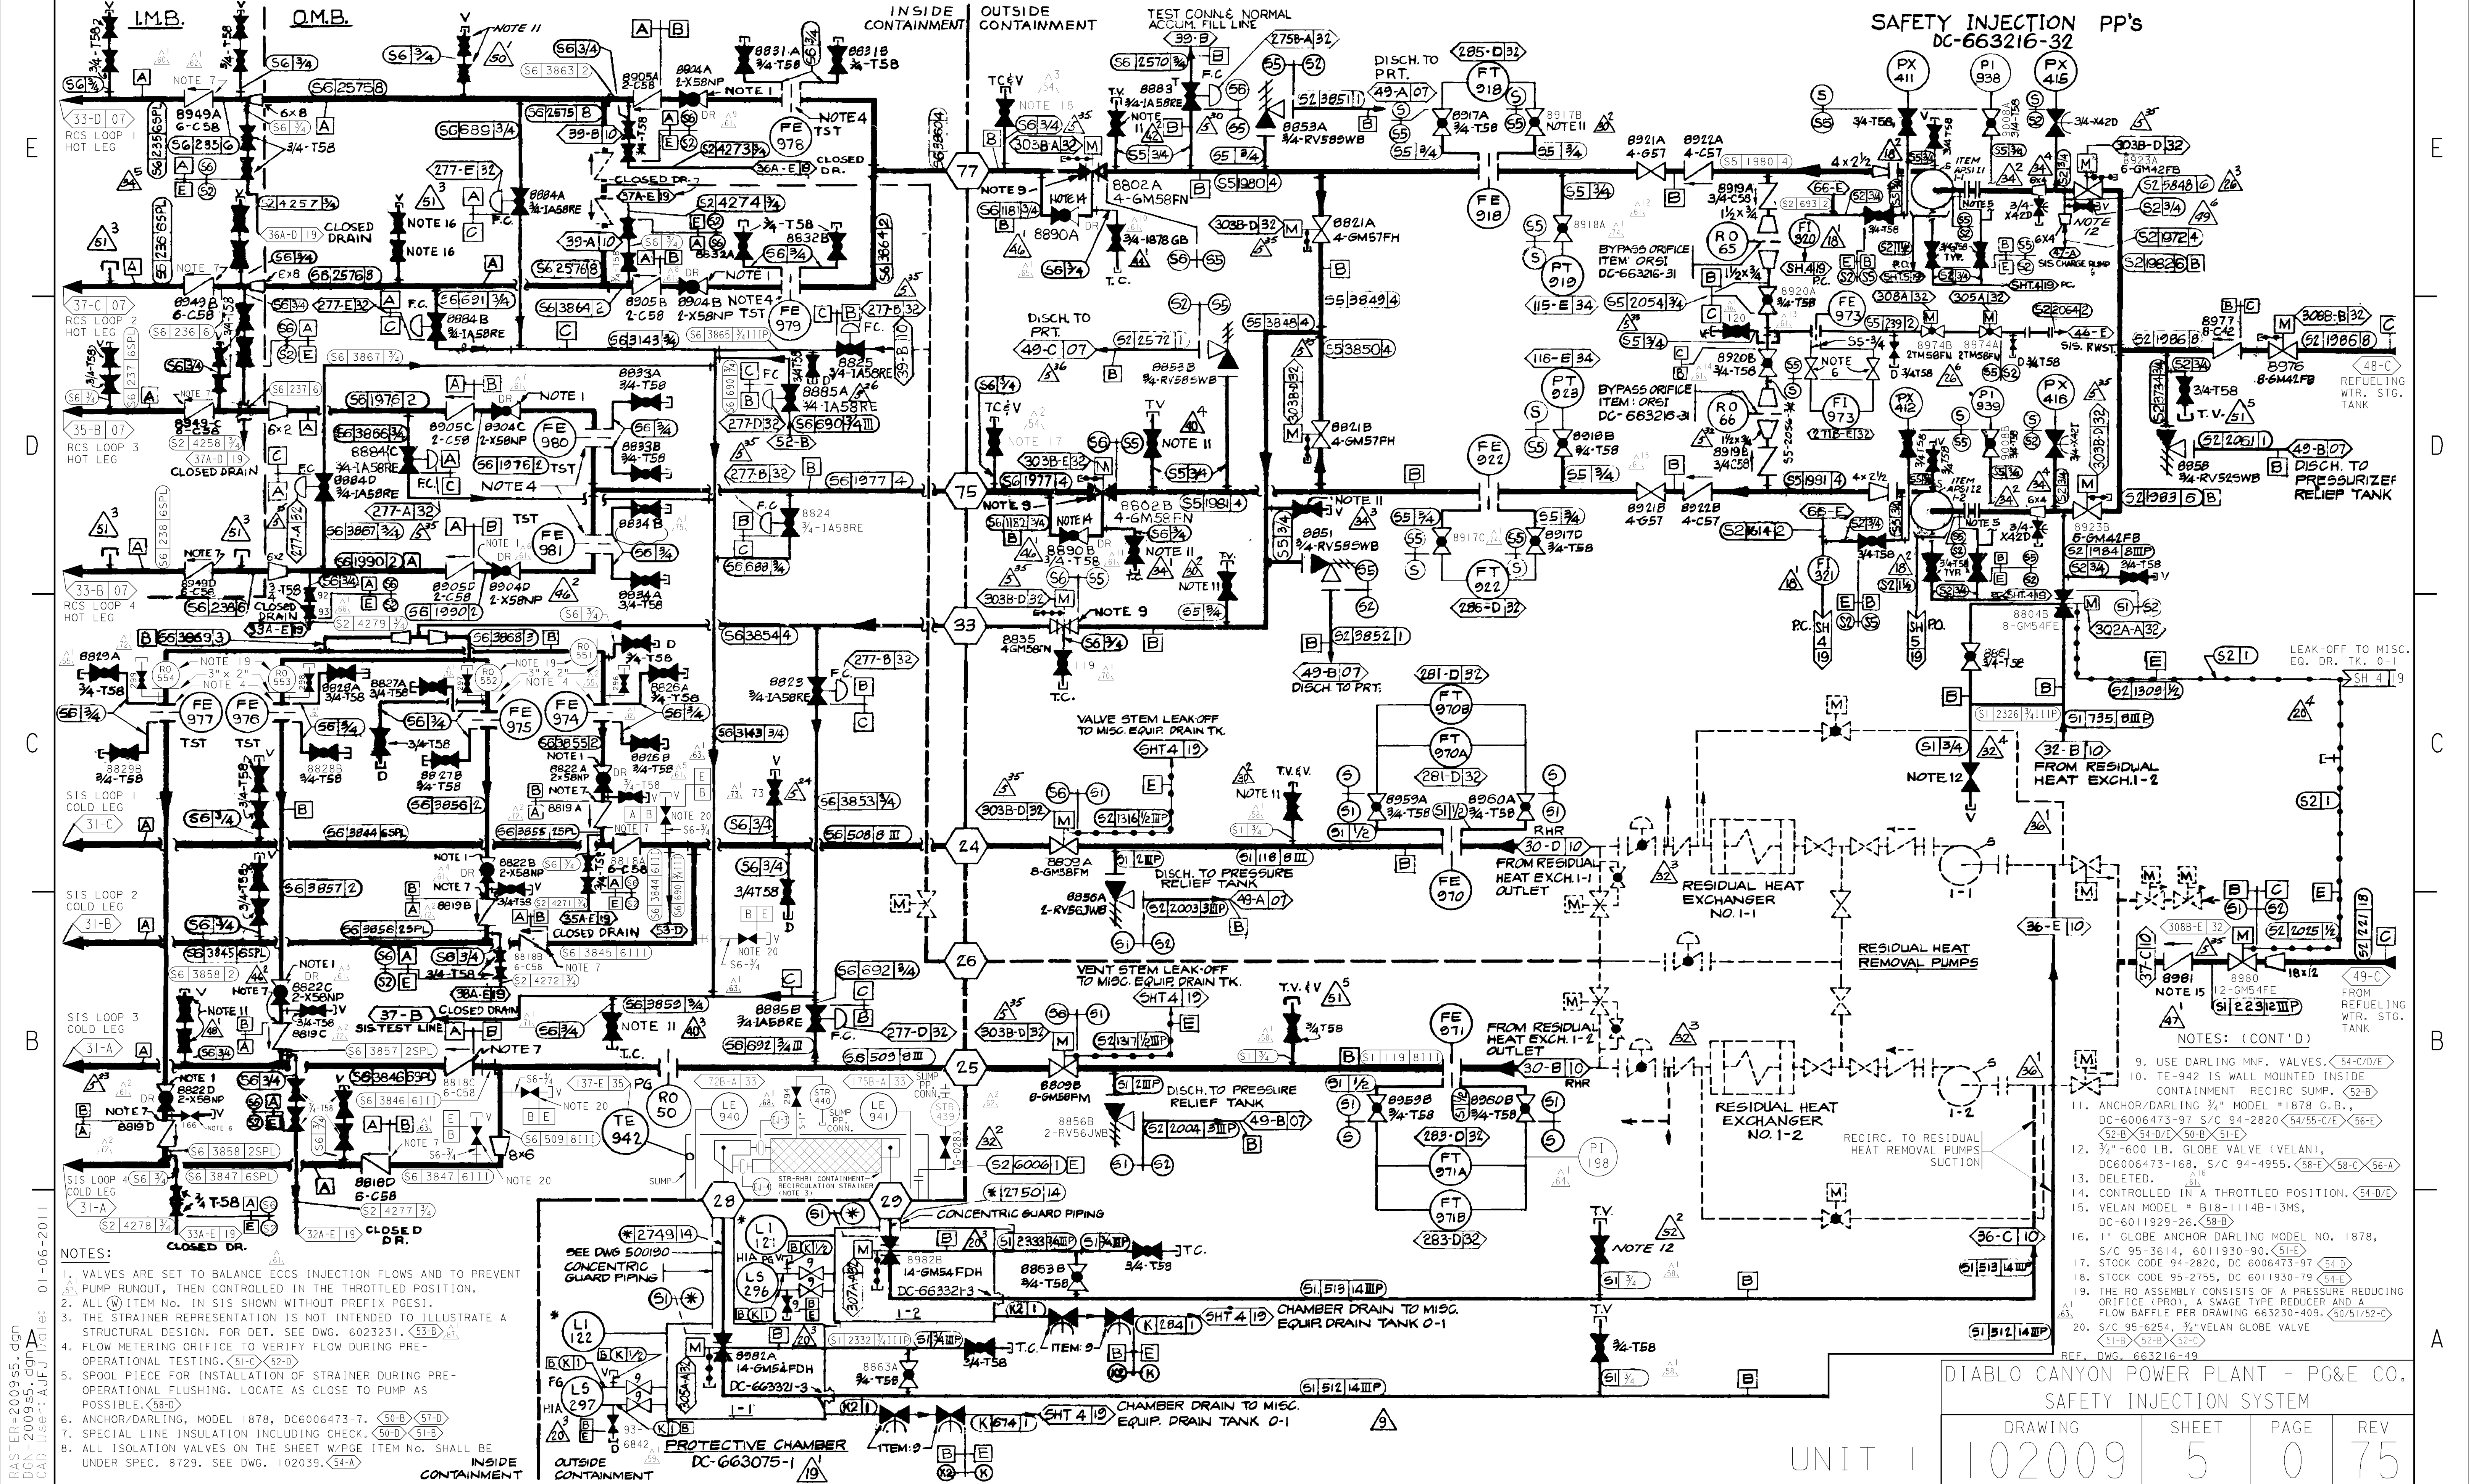


RASTER=200955.dgn
DGN=200955.dgn
CAD User=AJFU Date: 01-06-2011

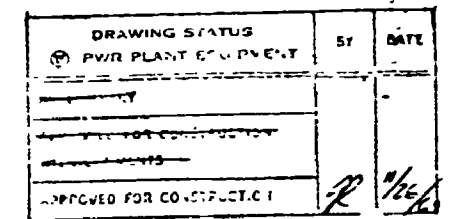INPGIC

4/27/99	CMG9	FXC2	-	KERSI J. DALAL	MECHANICAL	M 16690	3/31/2000	Enhanced per FCT 023917
DATE	DWN	RE	IV	PROFESSIONAL ENGINEER	PE DISC.	PE#	PE EXP.	

E
D
C
B
A

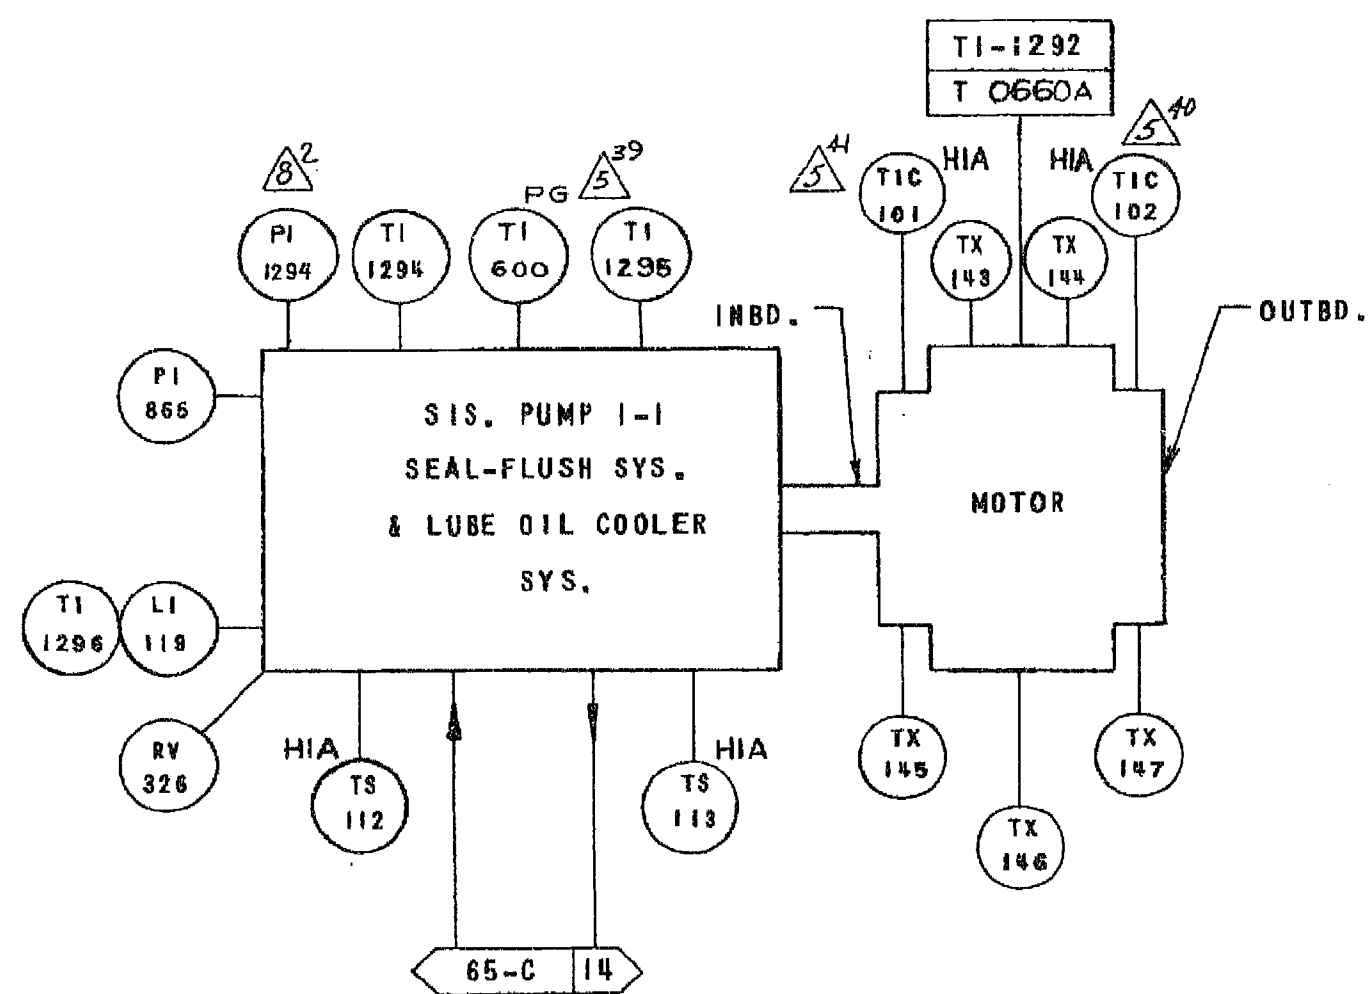

SERVICE	ITEM NO. (W)	PG&E INSTR. NO.	
		PUMP 1	PUMP 2
L.O.COOLER RELIEF VALVE	S13	RV-326	RV-327
PUMP THRUST BRG.L.O. SUPPLY	S11	PI-865	PI-866
PUMP L.O. RESERVOIR	S09	LI-119 TI-1296	LI-120 TI-1299
L.O.CLR.OUTLET L.O.TEMP.	S06	TI-1294	TI-1297
PUMP THRUST BRG.L.O. TEMP.	S03	TI-1295	TI-1298
PUMP OUTBD.SEAL-FLUSH TEMP.	G15	TS-112	TS-114
PUMP INBD.SEAL-FLUSH TEMP.	G15	TS-113	TS-115
PUMP INBD. BRG. TEMP.	—	TI-600	TI-601
L.O.CLR OUTLET L.O. PRESSURE	T41	PI-1294	PI-1297
MOTOR STATOR TEMP.	SLOT 1	TI-1292 T 0660A	TI-1293 T 0661A
MOTOR STATOR TEMP.	SLOT 7	TX-143	TX-148
MOTOR STATOR TEMP.	SLOT 13	TX-144	TX-149
MOTOR STATOR TEMP.	SLOT 19	TX-145	TX-150
MOTOR STATOR TEMP.	SLOT 25	TX-146	TX-151
MOTOR STATOR TEMP	SLOT 31	TX-147	TX-152
MOTOR INBD.BRG.TEMP.	—	TIC-101	TIC-104
MOTOR OUTBD.BRG.TEMP.	—	TIC-102	TIC-105

BY PGE

SIS. PUMP INSTR.
TYP.


REF:
DC-663216-26
DC-663216-32
DC-663216-33
DC-663216-43

UNIT I

CAD User:CMG9 Date: 4-16-1999
DGN=2009S7.DGN
RASTER=2009S7.TIF

P G & E CO.		102009	REV. 14
SHEET 7	PAGE 0		


INPGIC	4/27/99	CMG9	FXC2	-	KERSI J. DALAL	MECHANICAL	M 16690	3/31/2000	Enhanced per FCT 023917
	DATE	DWN	RE	IV	PROFESSIONAL ENGINEER	PE DISC.	PE#	PE EXP.	

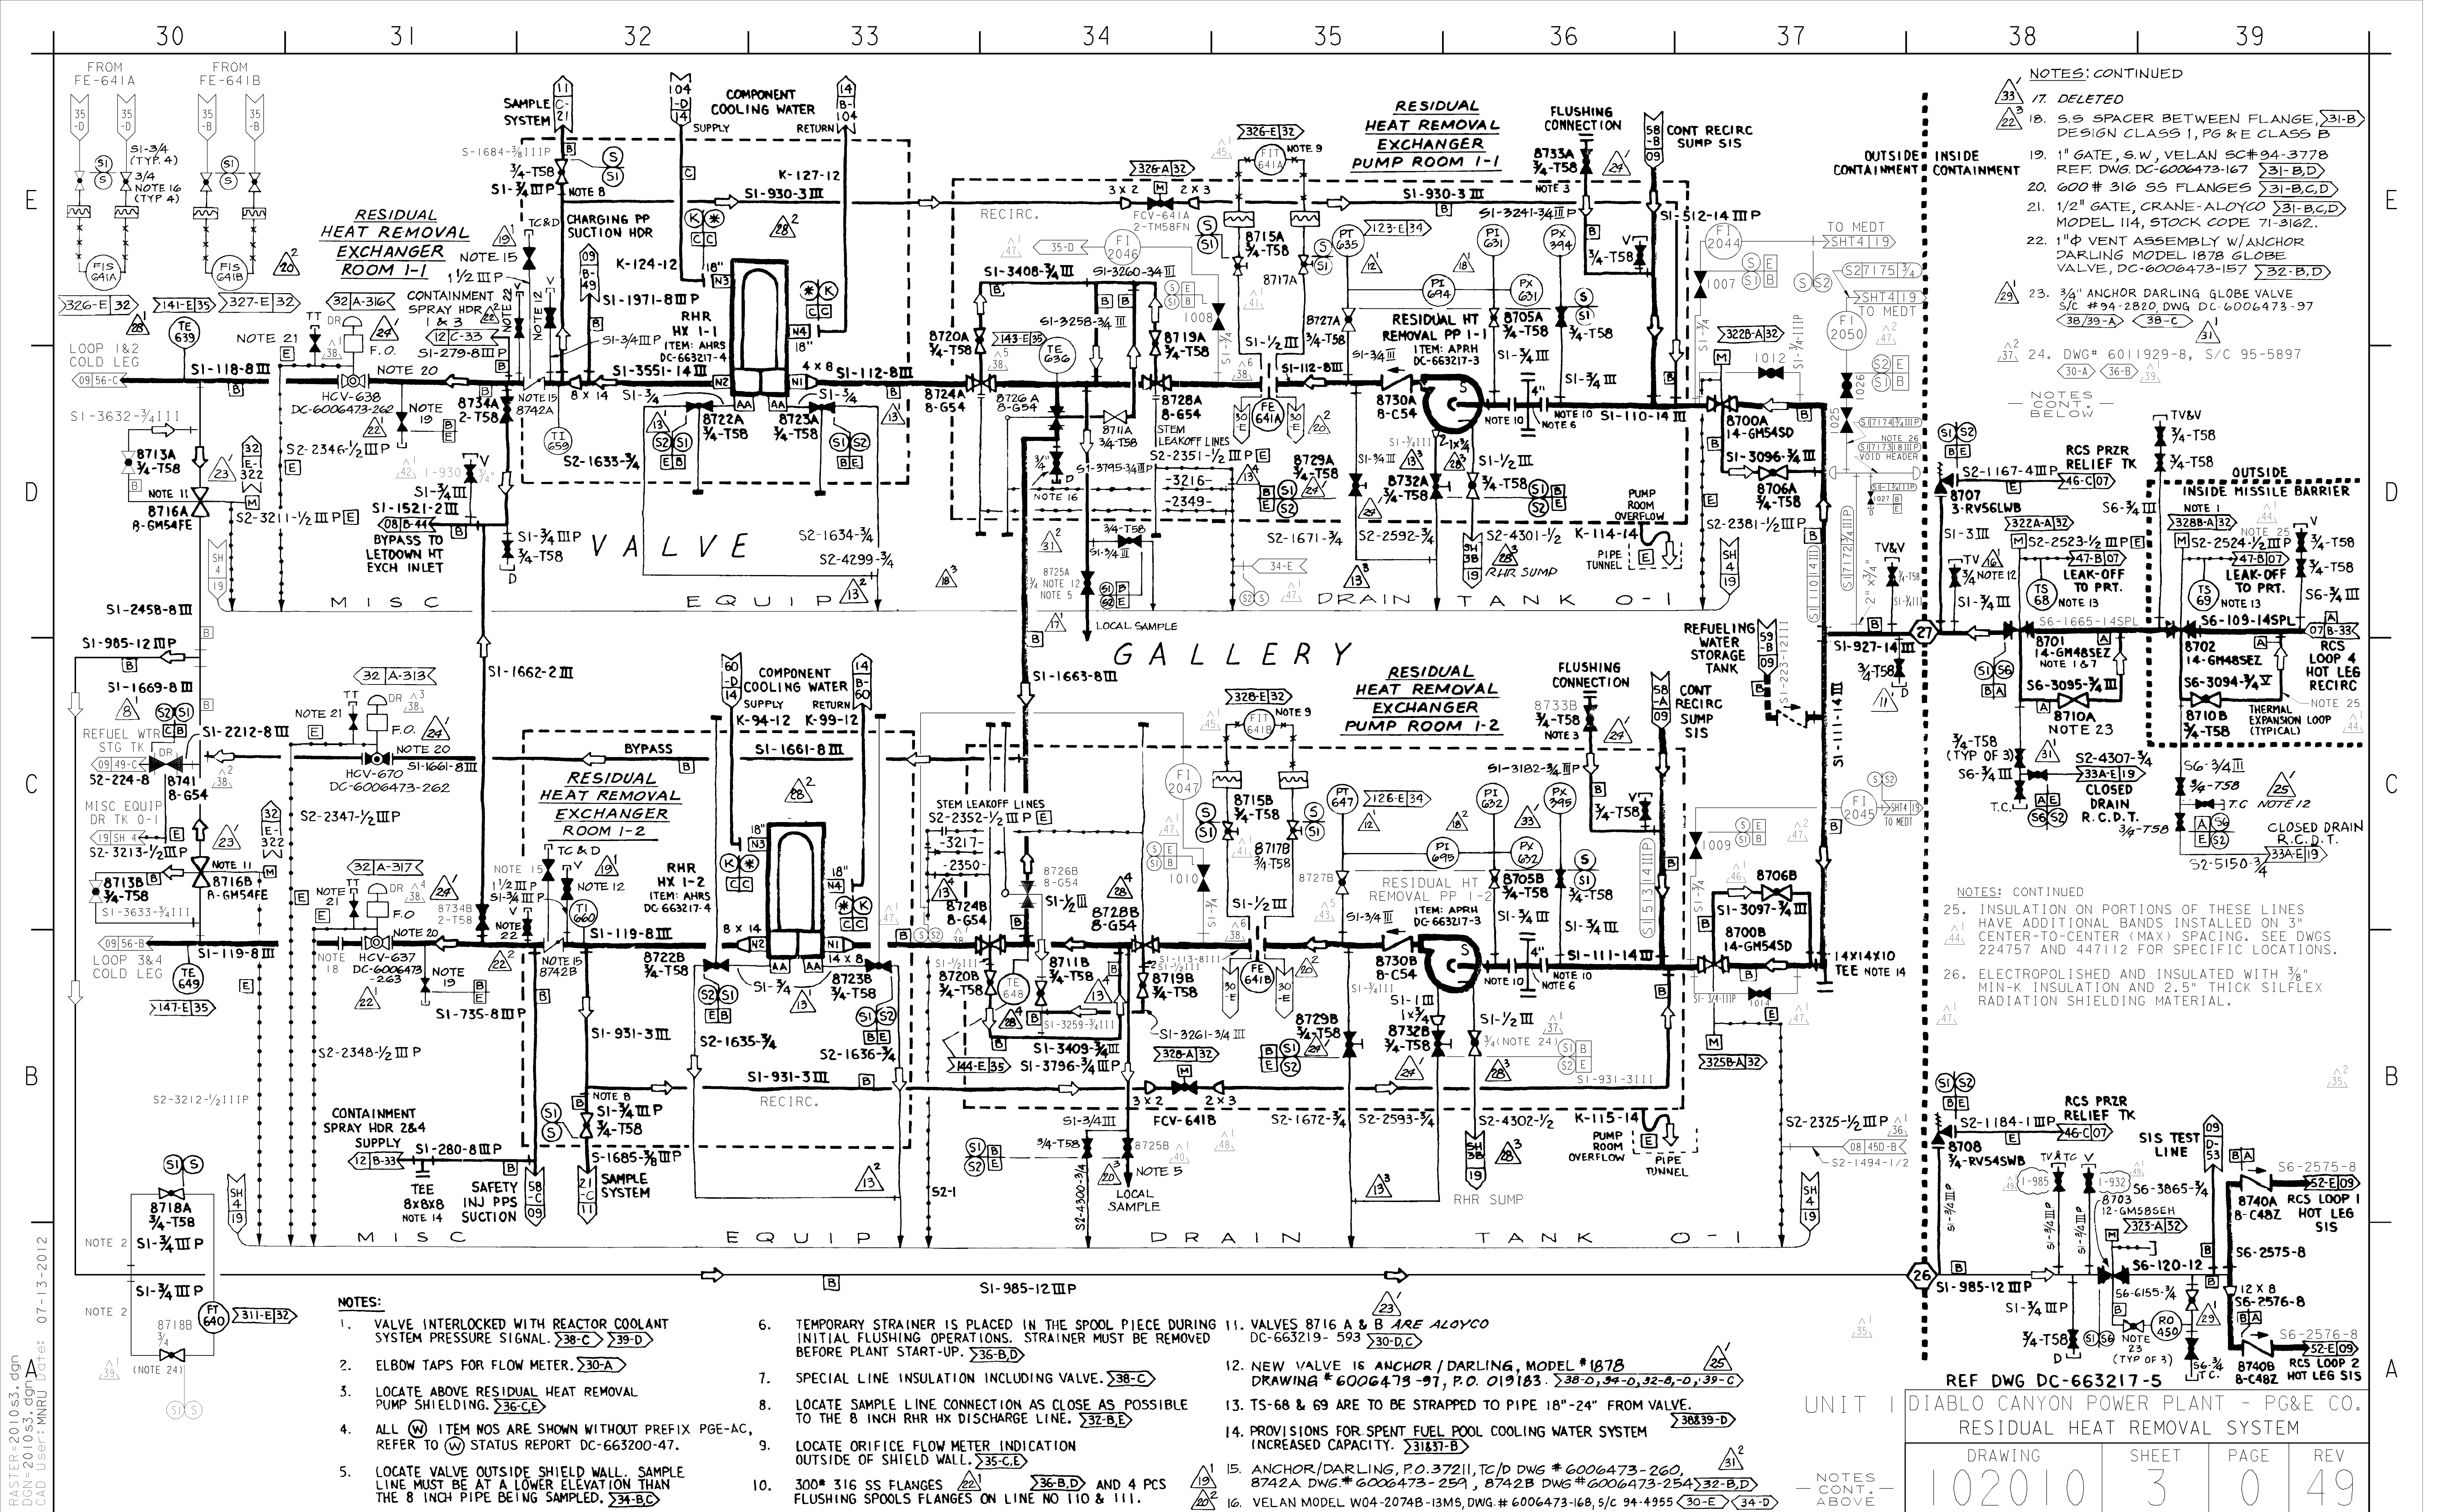

- NOTES: CONTINUED
- 17. DELETED
 - 18. S.S SPACER BETWEEN FLANGE, 31-B, DESIGN CLASS 1, PG & E CLASS B
 - 19. 1" GATE, S.W. VELAN SC# 34-3778 REF. DWG. DC-6006473-167 31-B,D
 - 20. 600# 316 SS FLANGES 31-B,C,D
 - 21. 1/2" GATE, CRANE-ALOYCO 31-B,C,D
 - 22. 1" VENT ASSEMBLY W/ANCHOR DARLING MODEL 1878 GLOBE VALVE, DC-6006473-157 32-B,D
 - 23. 3/4" ANCHOR DARLING GLOBE VALVE S/C # 94-2820, DWG DC-6006473-97 38/39-A 38-C
 - 24. DWG# 6011929-8, S/C 95-5897 30-A 36-B 31

- NOTES: CONT. BELOW
- 25. INSULATION ON PORTIONS OF THESE LINES HAVE ADDITIONAL BANDS INSTALLED ON 3" CENTER-TO-CENTER (MAX) SPACING. SEE DWGS 224757 AND 447112 FOR SPECIFIC LOCATIONS.
 - 26. ELECTROPOLISHED AND INSULATED WITH 3/4" MIN-K INSULATION AND 2.5" THICK SILFLEX RADIATION SHIELDING MATERIAL.

- NOTES:
- 1. VALVE INTERLOCKED WITH REACTOR COOLANT SYSTEM PRESSURE SIGNAL. 38-C 39-D
 - 2. ELBOW TAPS FOR FLOW METER. 30-A
 - 3. LOCATE ABOVE RESIDUAL HEAT REMOVAL PUMP SHIELDING. 36-C,E
 - 4. ALL (W) ITEM NOS ARE SHOWN WITHOUT PREFIX PGE-AC, REFER TO (W) STATUS REPORT DC-663200-47.
 - 5. LOCATE VALVE OUTSIDE SHIELD WALL. SAMPLE LINE MUST BE AT A LOWER ELEVATION THAN THE 8 INCH PIPE BEING SAMPLED. 34-B,C
 - 6. TEMPORARY STRAINER IS PLACED IN THE SPOOL PIECE DURING INITIAL FLUSHING OPERATIONS. STRAINER MUST BE REMOVED BEFORE PLANT START-UP. 36-B,D
 - 7. SPECIAL LINE INSULATION INCLUDING VALVE. 38-C
 - 8. LOCATE SAMPLE LINE CONNECTION AS CLOSE AS POSSIBLE TO THE 8 INCH RHR HX DISCHARGE LINE. 32-B,E
 - 9. LOCATE ORIFICE FLOW METER INDICATION OUTSIDE OF SHIELD WALL. 35-C,E
 - 10. 300# 316 SS FLANGES 36-B,D AND 4 PCS FLUSHING SPOOLS FLANGES ON LINE NO 110 & 111.
 - 11. VALVES 8716 A & B ARE ALOYCO DC-663219- 593 30-D,C
 - 12. NEW VALVE IS ANCHOR/DARLING, MODEL #1878 DRAWING # 6006473-97, P.O. 019183. 38-D, 34-D, 32-A-D, 39-C
 - 13. TS-68 & 69 ARE TO BE STRAPPED TO PIPE 18"-24" FROM VALVE. 38839-D
 - 14. PROVISIONS FOR SPENT FUEL POOL COOLING WATER SYSTEM INCREASED CAPACITY. 31837-B
 - 15. ANCHOR/DARLING, P.O. 37211, TC/D DWG # 6006473-260, 8742A DWG # 6006473-254, 8742B DWG # 6006473-254 32-B,D
 - 16. VELAN MODEL W04-2074B-13MS, DWG. # 6006473-168, S/C 94-4955 30-E 34-D

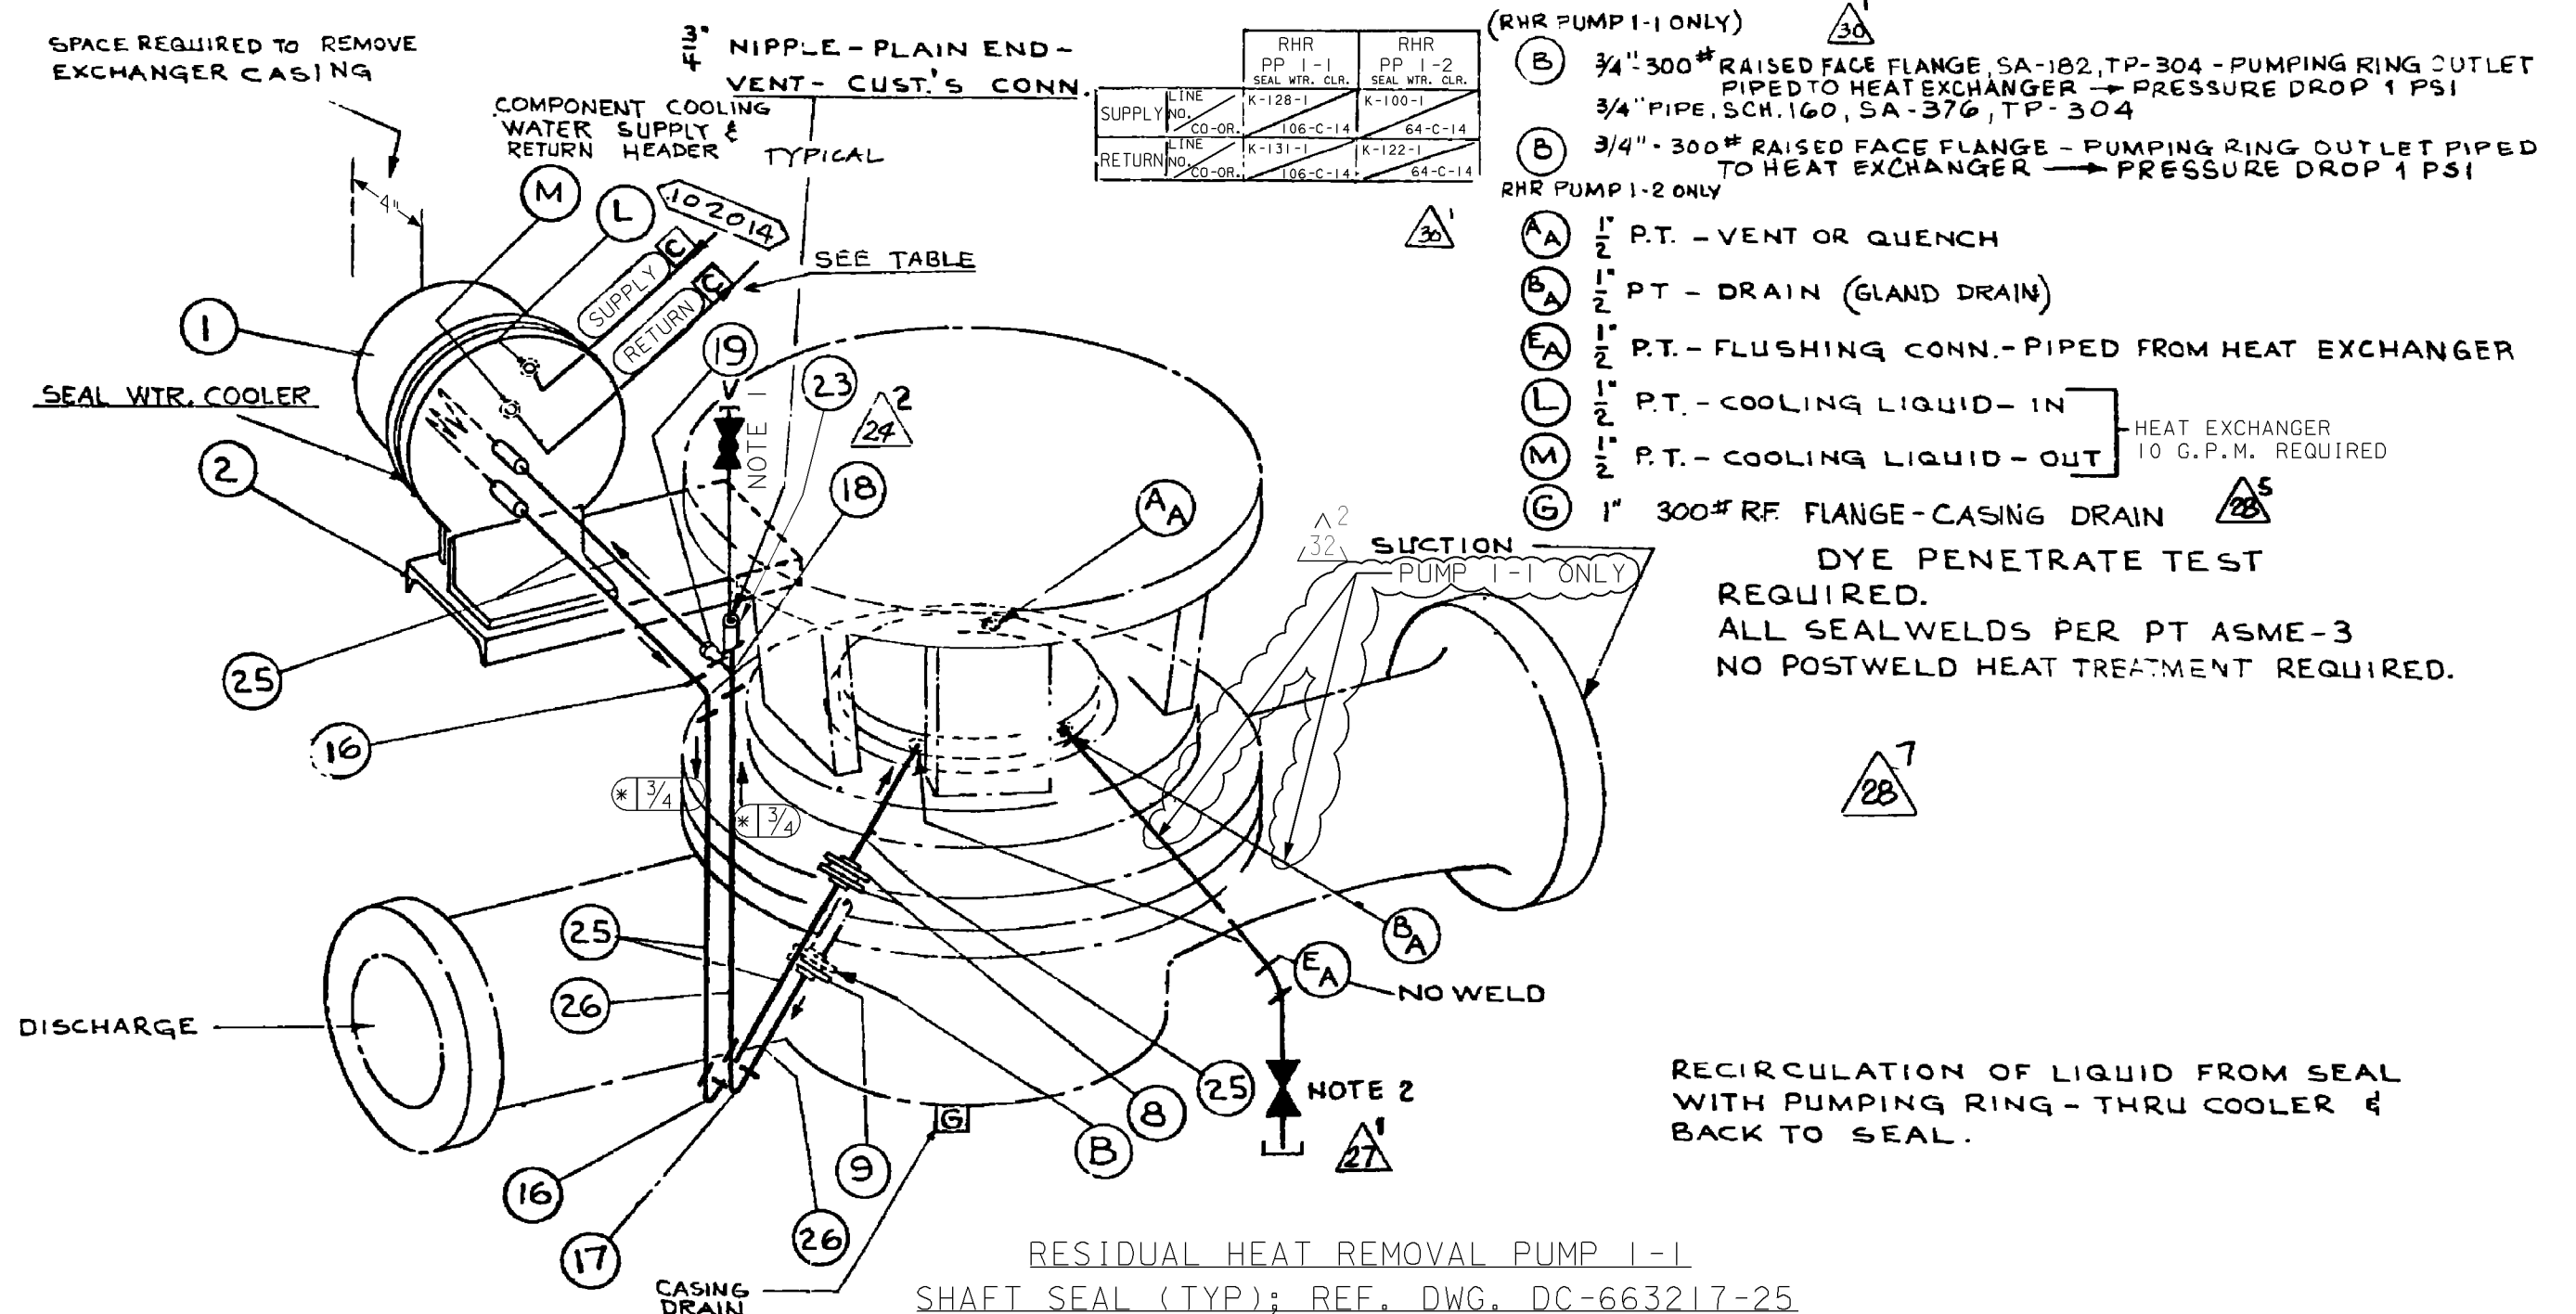

NOTE

1. PUMP I-1, 3/4" - T58
PUMP I-2, ANCHOR DARLING MODEL 1878GB,
DWG. 6006773-97, S/C. 94-2820

2. PUMP I-1 ONLY, 3/4" - T58 (45-B)


		RHR PP I-1 SEAL WTR. CLR.	RHR PP I-2 SEAL WTR. CLR.
SUPPLY	LINE NO.	K-128-1	K-100-1
RETURN	CO-OR.	106-C-14	64-C-14
	LINE NO.	K-131-1	K-122-1

- (RHR PUMP I-1 ONLY)
- (B) 3/4" - 300# RAISED FACE FLANGE, SA-182, TP-304 - PUMPING RING OUTLET PIPED TO HEAT EXCHANGER → PRESSURE DROP 1 PSI
 - (B) 3/4" - 300# RAISED FACE FLANGE - PUMPING RING OUTLET PIPED TO HEAT EXCHANGER → PRESSURE DROP 1 PSI
- RHR PUMP I-2 ONLY
- (A) 1/2" P.T. - VENT OR QUENCH
 - (B) 1/2" P.T. - DRAIN (GLAND DRAIN)
 - (E) 1/2" P.T. - FLUSHING CONN. - PIPED FROM HEAT EXCHANGER
 - (L) 1/2" P.T. - COOLING LIQUID - IN
 - (M) 1/2" P.T. - COOLING LIQUID - OUT
 - (G) 1" 300# RF. FLANGE - CASING DRAIN
- HEAT EXCHANGER
10 G.P.M. REQUIRED
- DYE PENETRATE TEST
REQUIRED.
ALL SEALWELDS PER PT ASME-3
NO POSTWELD HEAT TREATMENT REQUIRED.

CAD User: mlbf Date: 4-23-2004
DGN=2010S4.DGN
RASTER=2010S4.TIF

P G & E CO.		102010	REV. 32
SHEET 4	PAGE 0		

4/26/04	MIBF	CDP3	-	KERSI J. DALAL	MECHANICAL	M 16690	3/31/2006	Revised per FCT 028019
DATE	DWN	RE	IV	PROFESSIONAL ENGINEER	PE DISC.	PE#	PE EXP.	

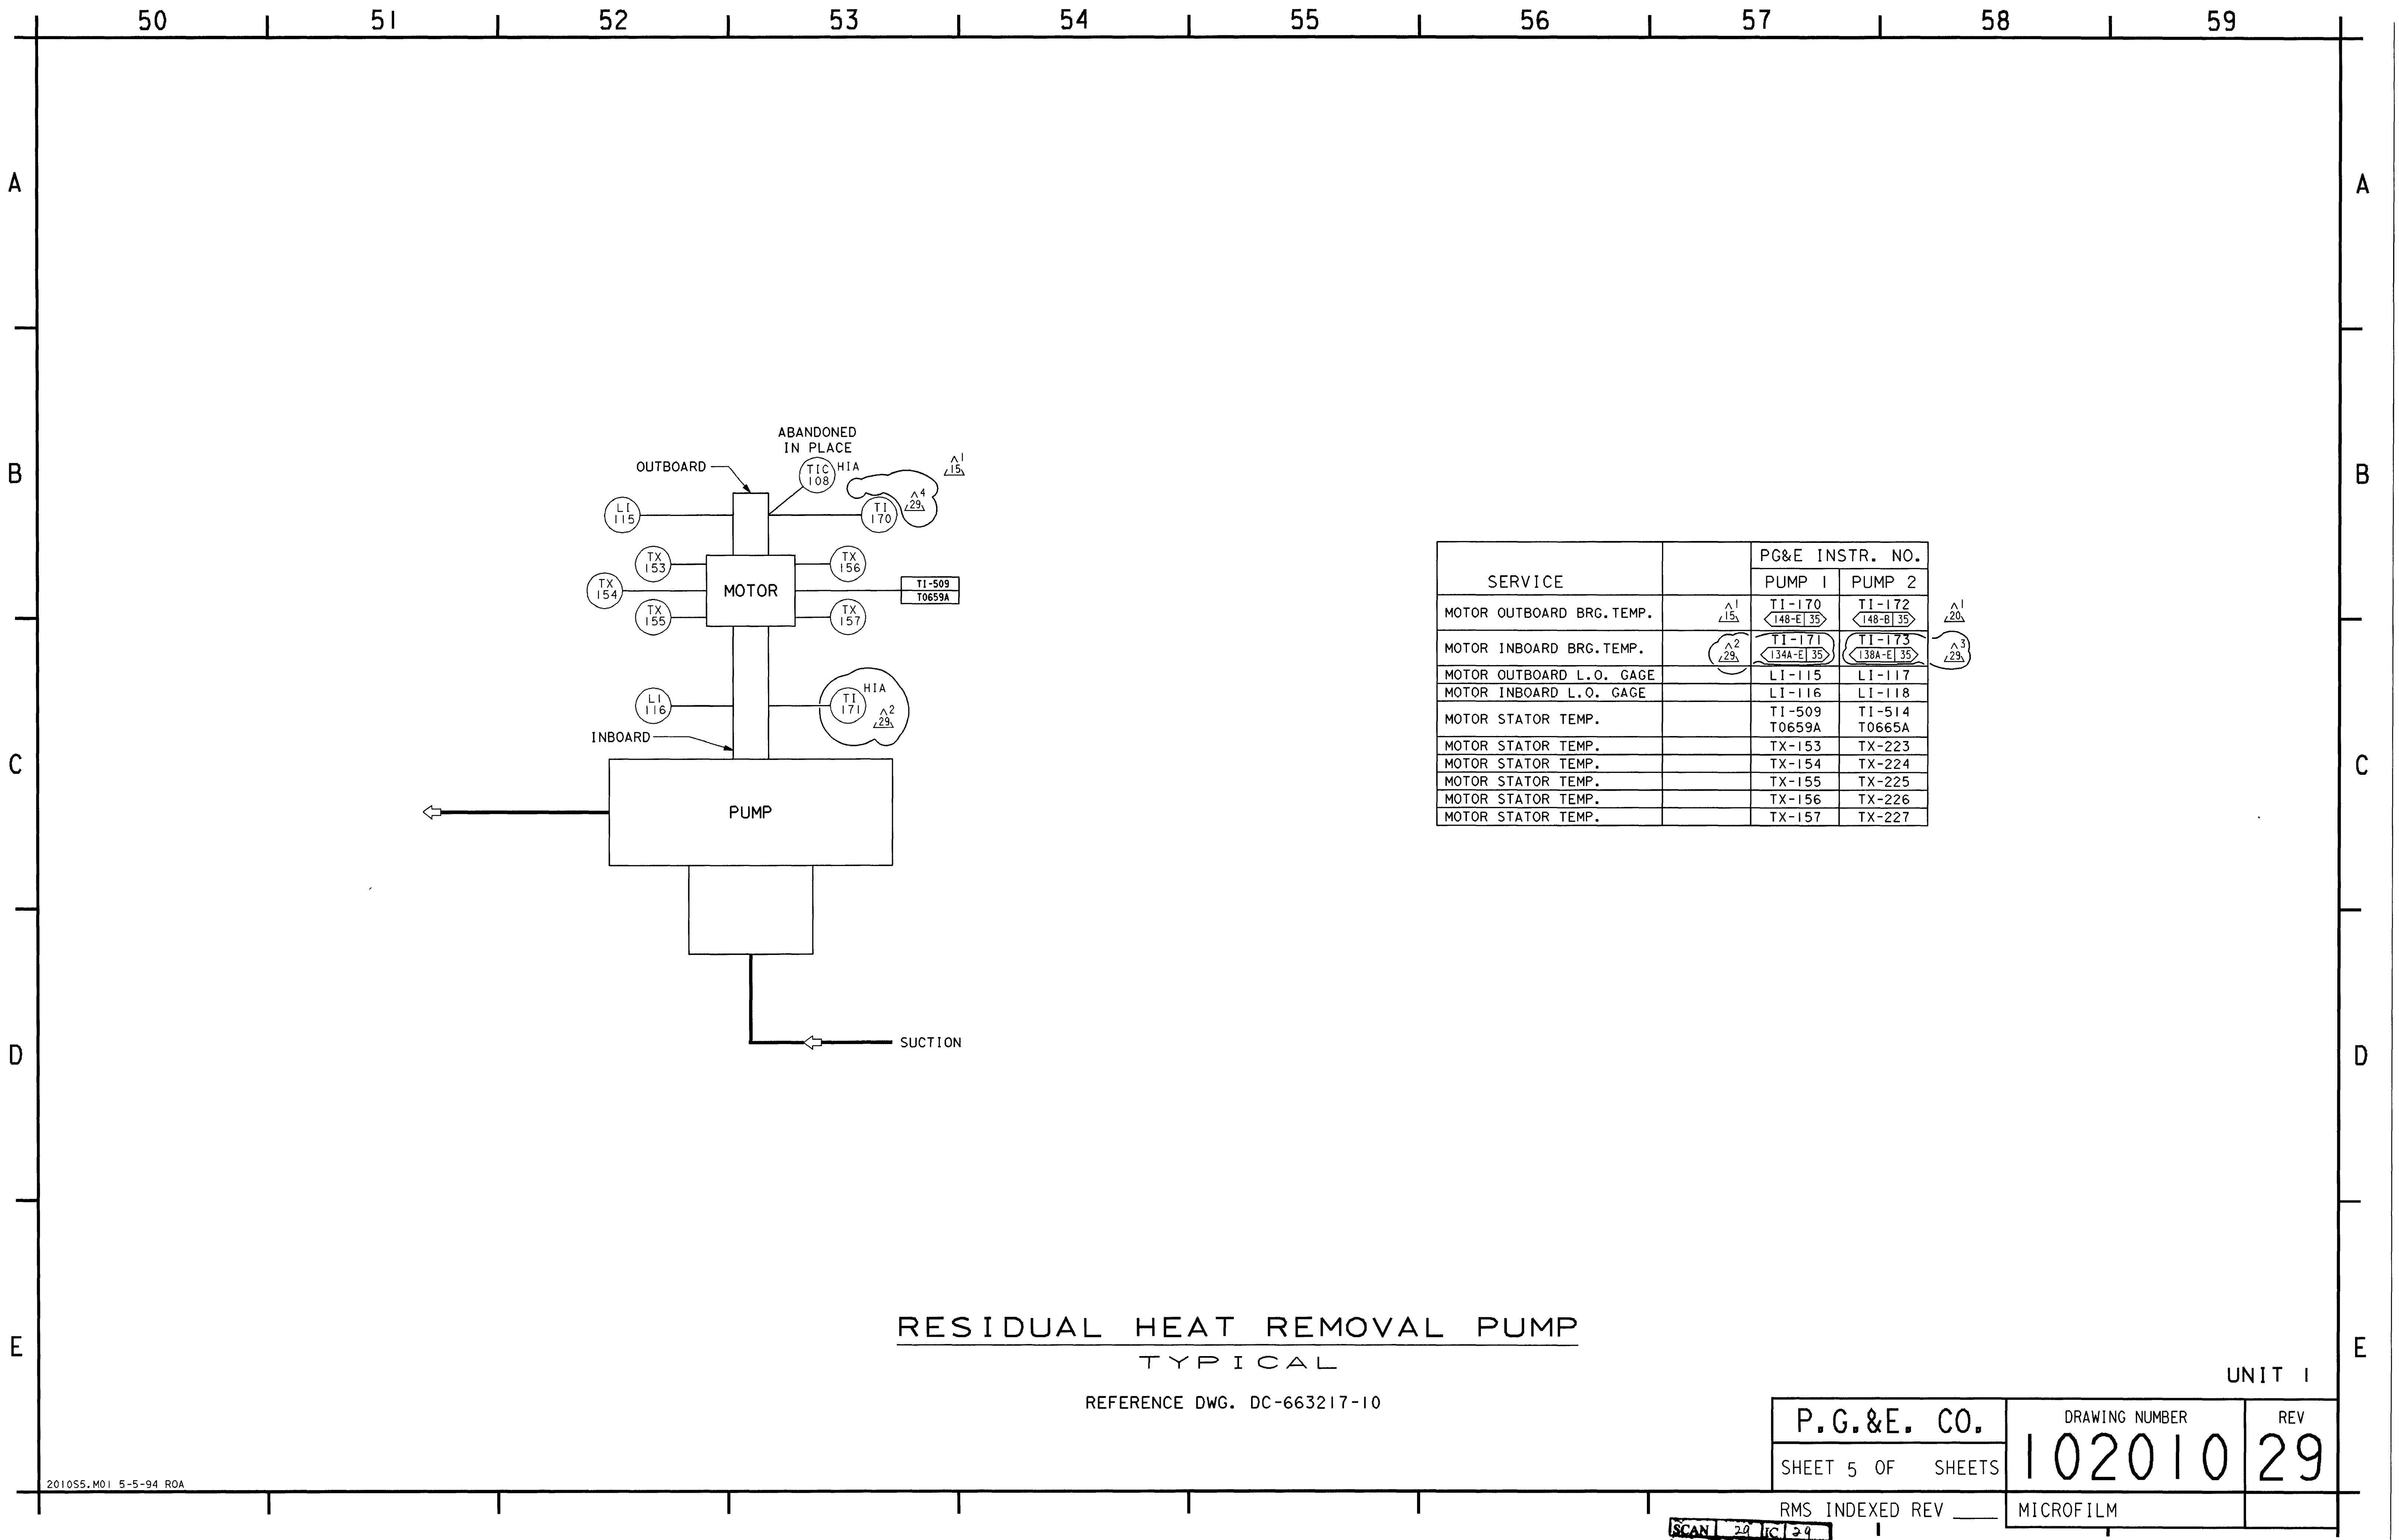

SERVICE	PG&E INSTR. NO.	
	PUMP 1	PUMP 2
MOTOR OUTBOARD BRG. TEMP.	TI-170 <148-E 35>	TI-172 <148-B 35>
MOTOR INBOARD BRG. TEMP.	TI-171 <134A-E 35>	TI-173 <138A-E 35>
MOTOR OUTBOARD L.O. GAGE	LI-115	LI-117
MOTOR INBOARD L.O. GAGE	LI-116	LI-118
MOTOR STATOR TEMP.	TI-509 T0659A	TI-514 T0665A
MOTOR STATOR TEMP.	TX-153	TX-223
MOTOR STATOR TEMP.	TX-154	TX-224
MOTOR STATOR TEMP.	TX-155	TX-225
MOTOR STATOR TEMP.	TX-156	TX-226
MOTOR STATOR TEMP.	TX-157	TX-227


RESIDUAL HEAT REMOVAL PUMP
TYPICAL

REFERENCE DWG. DC-663217-10

UNIT 1

P.G.&E. CO.	DRAWING NUMBER	REV
	102010	29
SHEET 5 OF SHEETS	MICROFILM	

NUCLEAR STEAM SUPPLY SAMPLING SYSTEM

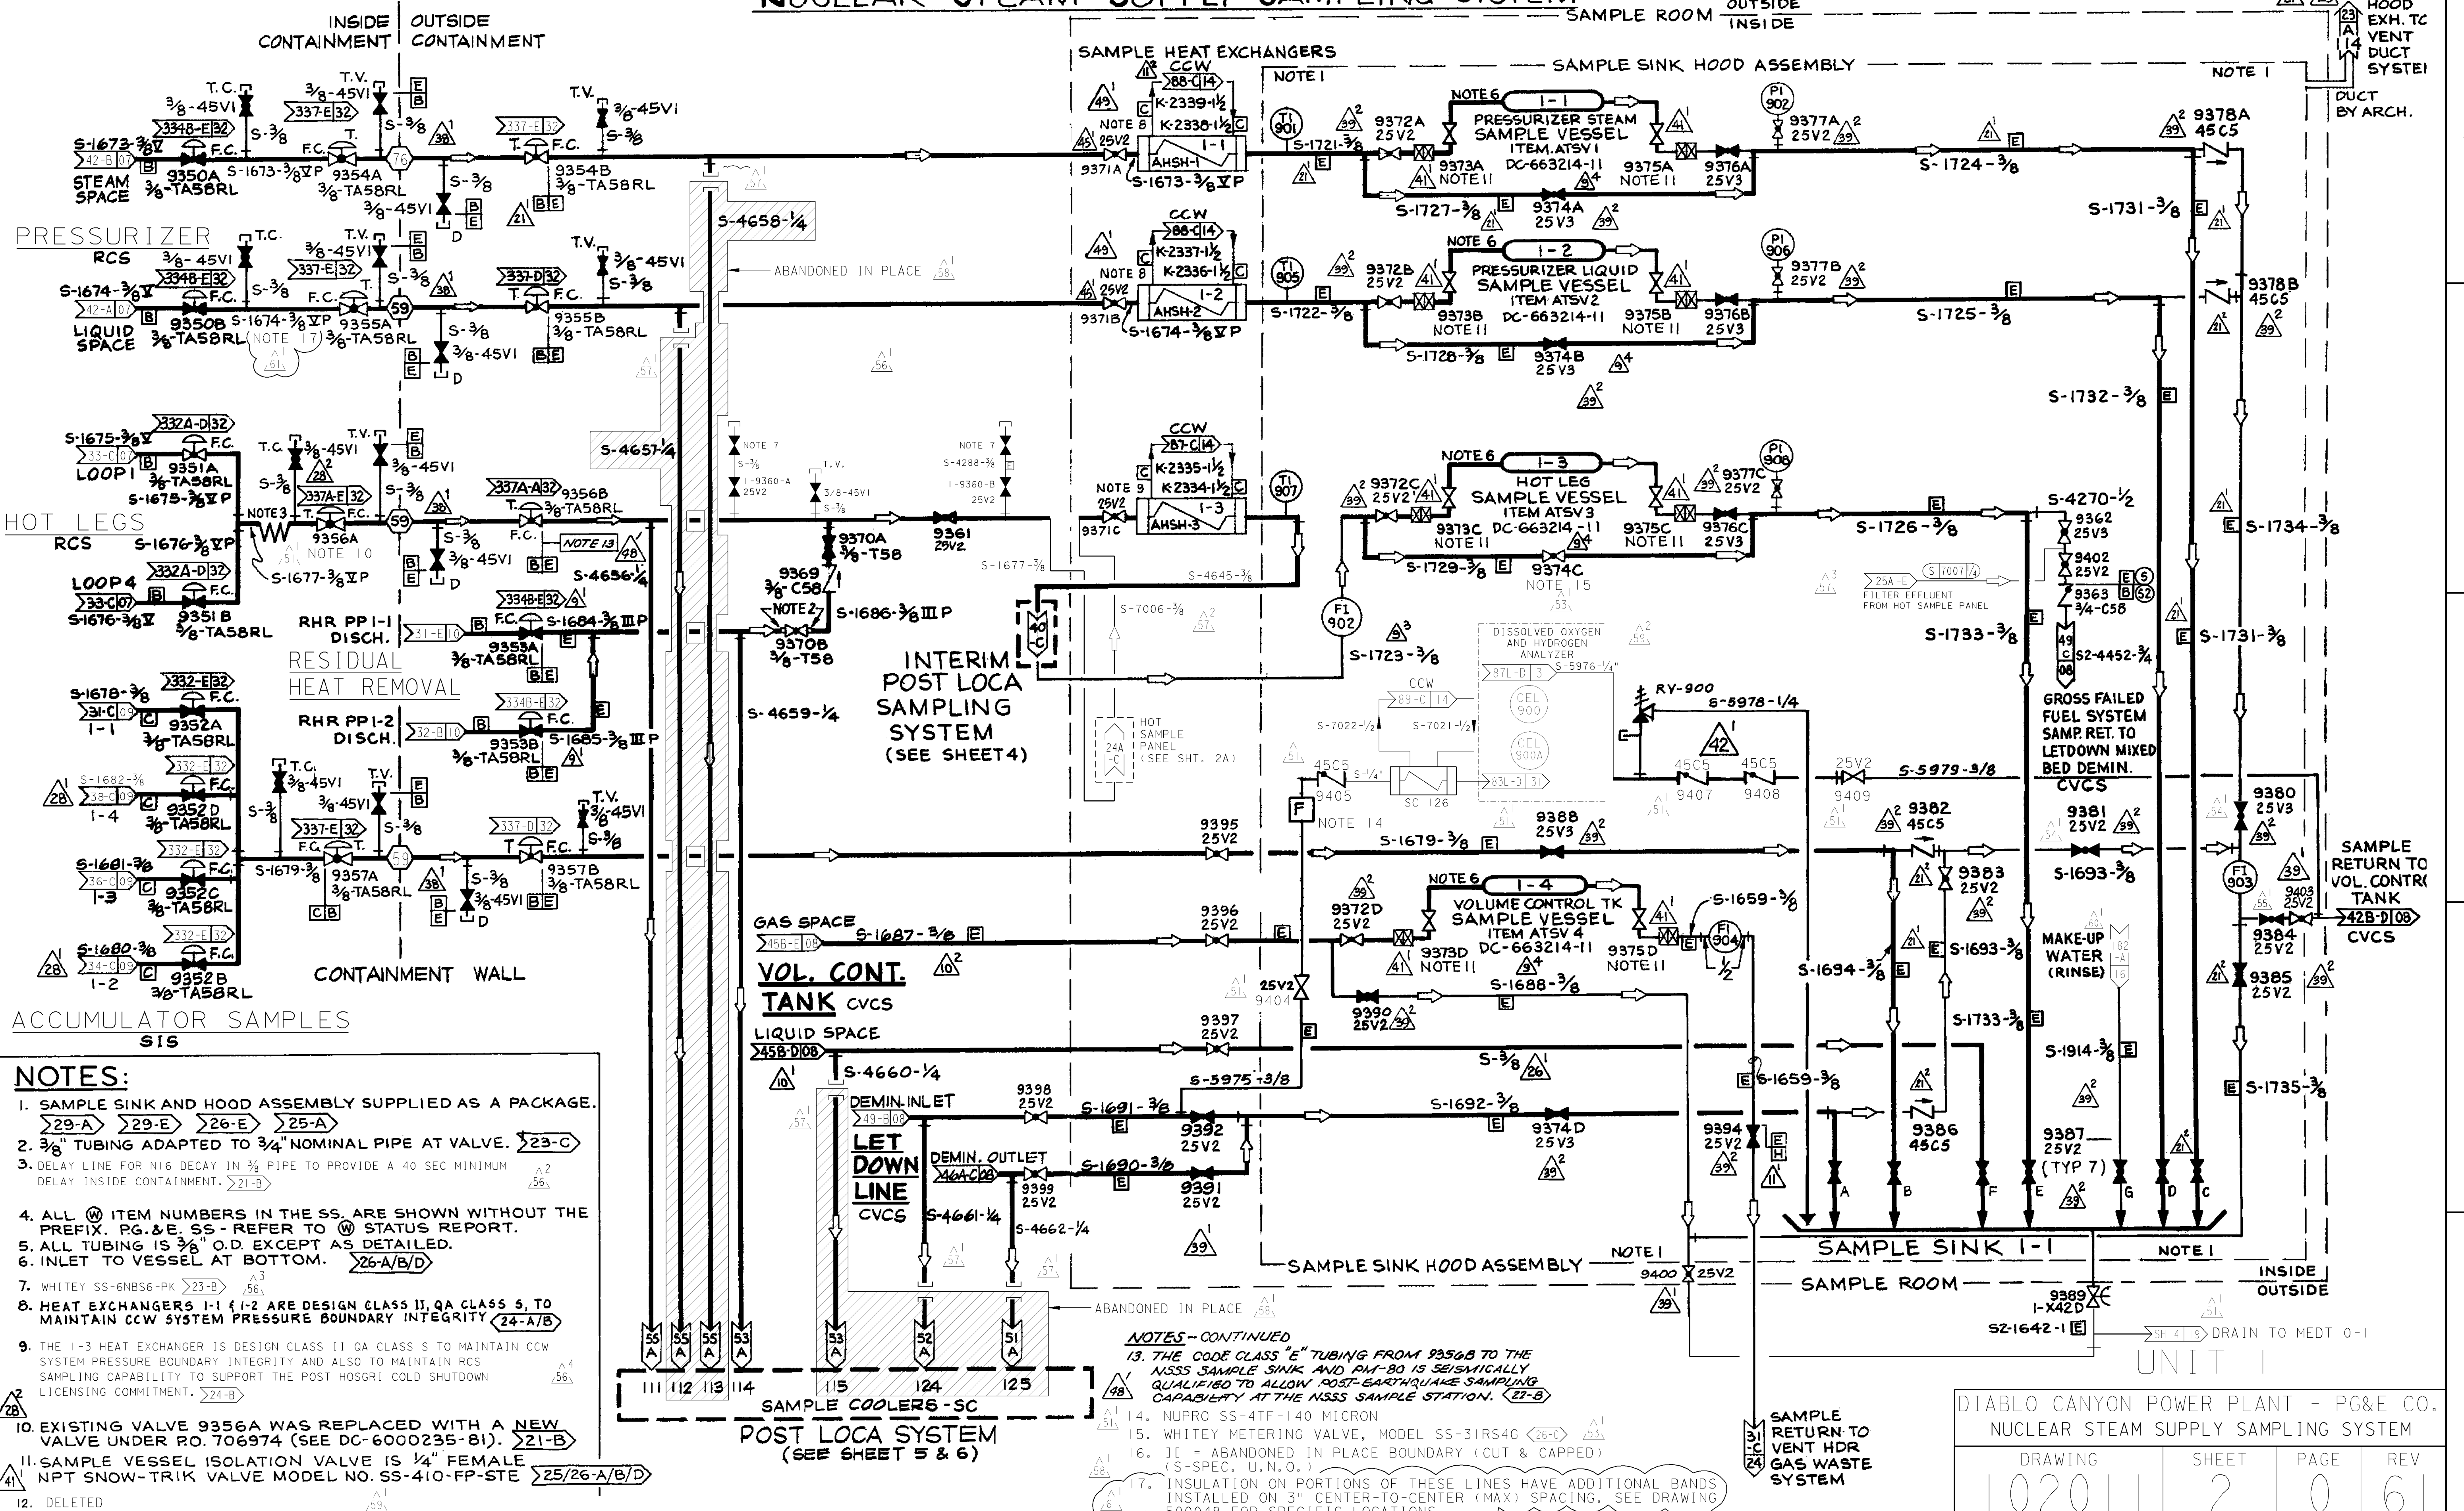

- NOTES:**
1. SAMPLE SINK AND HOOD ASSEMBLY SUPPLIED AS A PACKAGE. 29-A 29-E 26-E 25-A
 2. 3/8" TUBING ADAPTED TO 3/4" NOMINAL PIPE AT VALVE. 23-C
 3. DELAY LINE FOR N16 DECAY IN 3/8" PIPE TO PROVIDE A 40 SEC MINIMUM DELAY INSIDE CONTAINMENT. 21-B
 4. ALL (W) ITEM NUMBERS IN THE SS ARE SHOWN WITHOUT THE PREFIX. PG. & E. SS - REFER TO (W) STATUS REPORT.
 5. ALL TUBING IS 3/8" O.D. EXCEPT AS DETAILED.
 6. INLET TO VESSEL AT BOTTOM. 26-A/B/D
 7. WHITEY SS-6NBS6-PK 23-B
 8. HEAT EXCHANGERS 1-1 (1-2) ARE DESIGN CLASS II, QA CLASS S, TO MAINTAIN CCW SYSTEM PRESSURE BOUNDARY INTEGRITY 24-A/B
 9. THE 1-3 HEAT EXCHANGER IS DESIGN CLASS II, QA CLASS S TO MAINTAIN CCW SYSTEM PRESSURE BOUNDARY INTEGRITY AND ALSO TO MAINTAIN RCS SAMPLING CAPABILITY TO SUPPORT THE POST HOSGRI COLD SHUTDOWN LICENSING COMMITMENT. 24-B
 10. EXISTING VALVE 9356A WAS REPLACED WITH A NEW VALVE UNDER P.O. 706974 (SEE DC-6000235-81). 21-B
 11. SAMPLE VESSEL ISOLATION VALVE IS 1/4" FEMALE NPT SNOW-TRIK VALVE MODEL NO. SS-410-FP-STE 25/26-A/B/D
 12. DELETED

- NOTES - CONTINUED**
13. THE CODE CLASS "E" TUBING FROM 9356B TO THE NSSS SAMPLE SINK AND RM-80 IS SEISMICALLY QUALIFIED TO ALLOW POST-EARTHQUAKE SAMPLING CAPABILITY AT THE NSSS SAMPLE STATION. 27-B
 14. NUPRO SS-4TF-140 MICRON
 15. WHITEY METERING VALVE, MODEL SS-31RS4G 26-C
 16. IT = ABANDONED IN PLACE BOUNDARY (CUT & CAPPED) (S-SPEC. U.N.O.)
 17. INSULATION ON PORTIONS OF THESE LINES HAVE ADDITIONAL BANDS INSTALLED ON 3" CENTER-TO-CENTER (MAX) SPACING. SEE DRAWING 500048 FOR SPECIFIC LOCATIONS.

DIABLO CANYON POWER PLANT - PG&E CO.			
NUCLEAR STEAM SUPPLY SAMPLING SYSTEM			
DRAWING	SHEET	PAGE	REV
102011	2	0	61

06-01-2007	FAZI	FxC2	KERSI J. DALAL	MECHANICAL	M 16690	3/31/2008	REVISED PER FCT-31957
DATE	DWN	RE	IV	PROFESSIONAL ENGINEER	PE DISC.	PE*	PE EXP.

30

31

32

33

34

35

36

37

38

39


A

B

C

D

E

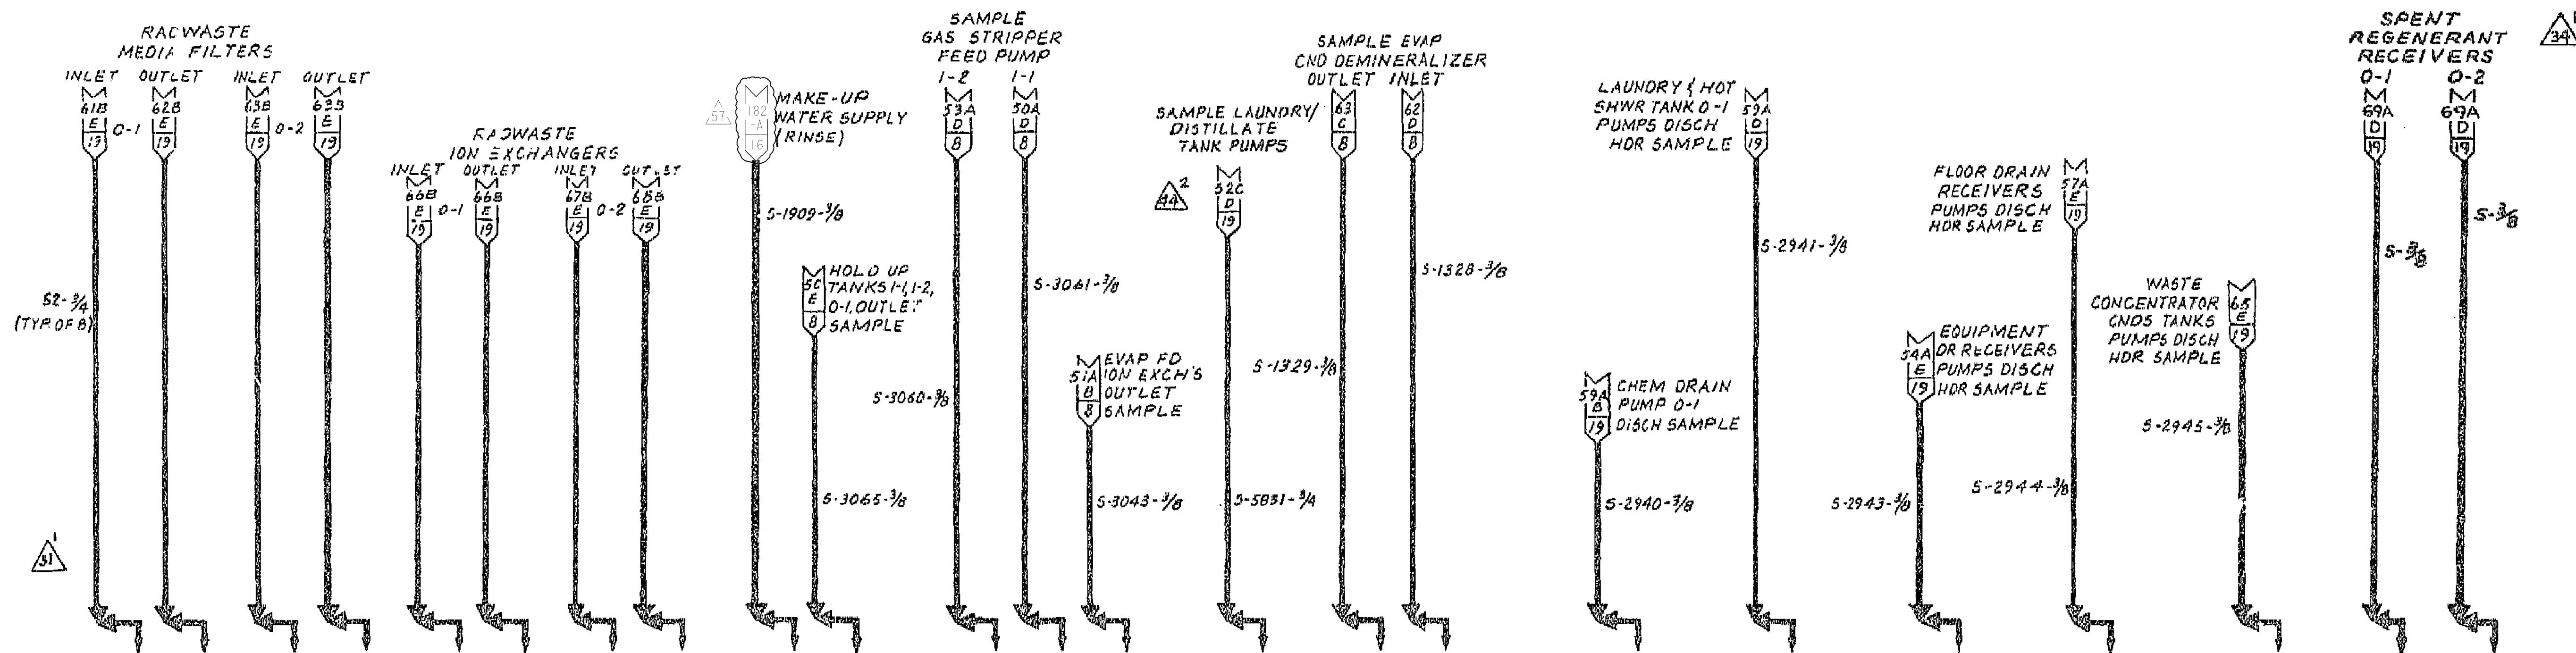

SAMPLE SINK 1-2
DC-678611-144

NOTES:

1. ALL PIPE & TUBING CONTAINED IN THIS SHEET SHALL BE PG&E CLASS "E" & INSTRUMENT CLASS II RESPECTIVELY.
2. ALL VALVES EXCEPT AS NOTED SHALL BE "WHITE" 6LR36 SPEC 88M.
3. INSULATE WITH 2 LAYERS OF LEWCO FT60 OR EQUIV. INSULATION.


SPENT FUEL SYSTEM (SFS) POOL RECIRCULATION SAMPLES (REF. 102034)

SFS PUMP 1-1 DISCHARGE (PI-652) SFS PUMP 1-2 DISCHARGE (PI-646) RWP PUMP DISCHARGE (PI-674B) SFS FILTER 1-1 DISCHARGE (PI-654)




SAMPLE SINK 1-3


MEDT 0-1

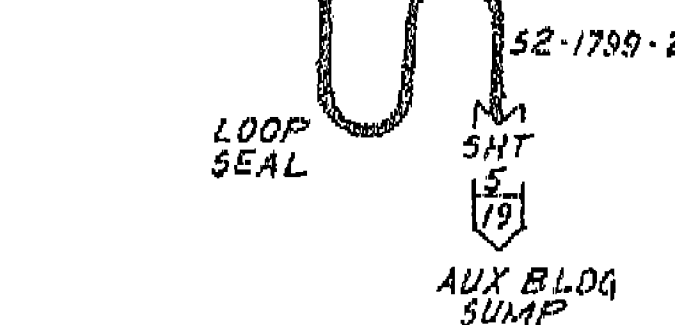

BORIC ACID STORAGE TANK 1-1, 1-2 SAMPLE

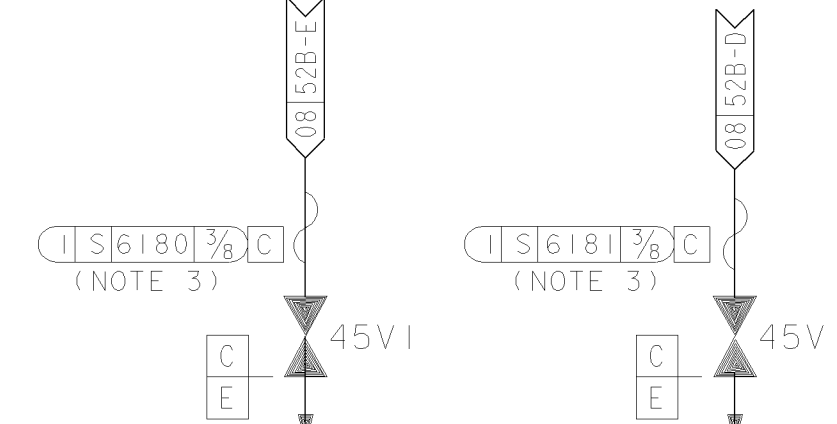

BORIC ACID STORAGE TANK 2-1, 2-2 SAMPLE

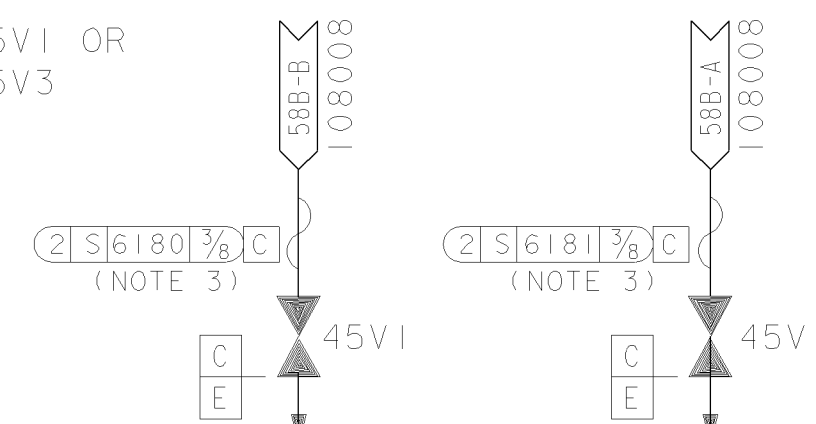

SAMPLE SINK 0-1

1" x .065 WALL SS TUBING TO BATP 2-2 DRAIN SCUPPER (NOTE 3)

UNIT 1

DIABLO CANYON POWER PLANT - PG&E CO.

DRAWING	SHEET	PAGE	REV
102011	3	0	57

DATE	DWN	RE	IV	FRANCIS C. LING	MECHANICAL	M 16098	12/31/2007	REVISED PER FCT-030760
01-26-2006	MIBF	KJD3		PROFESSIONAL ENGINEER	PE DISC.	PE#	PE EXP.	

A

B

C

D


A

B

C

D

E

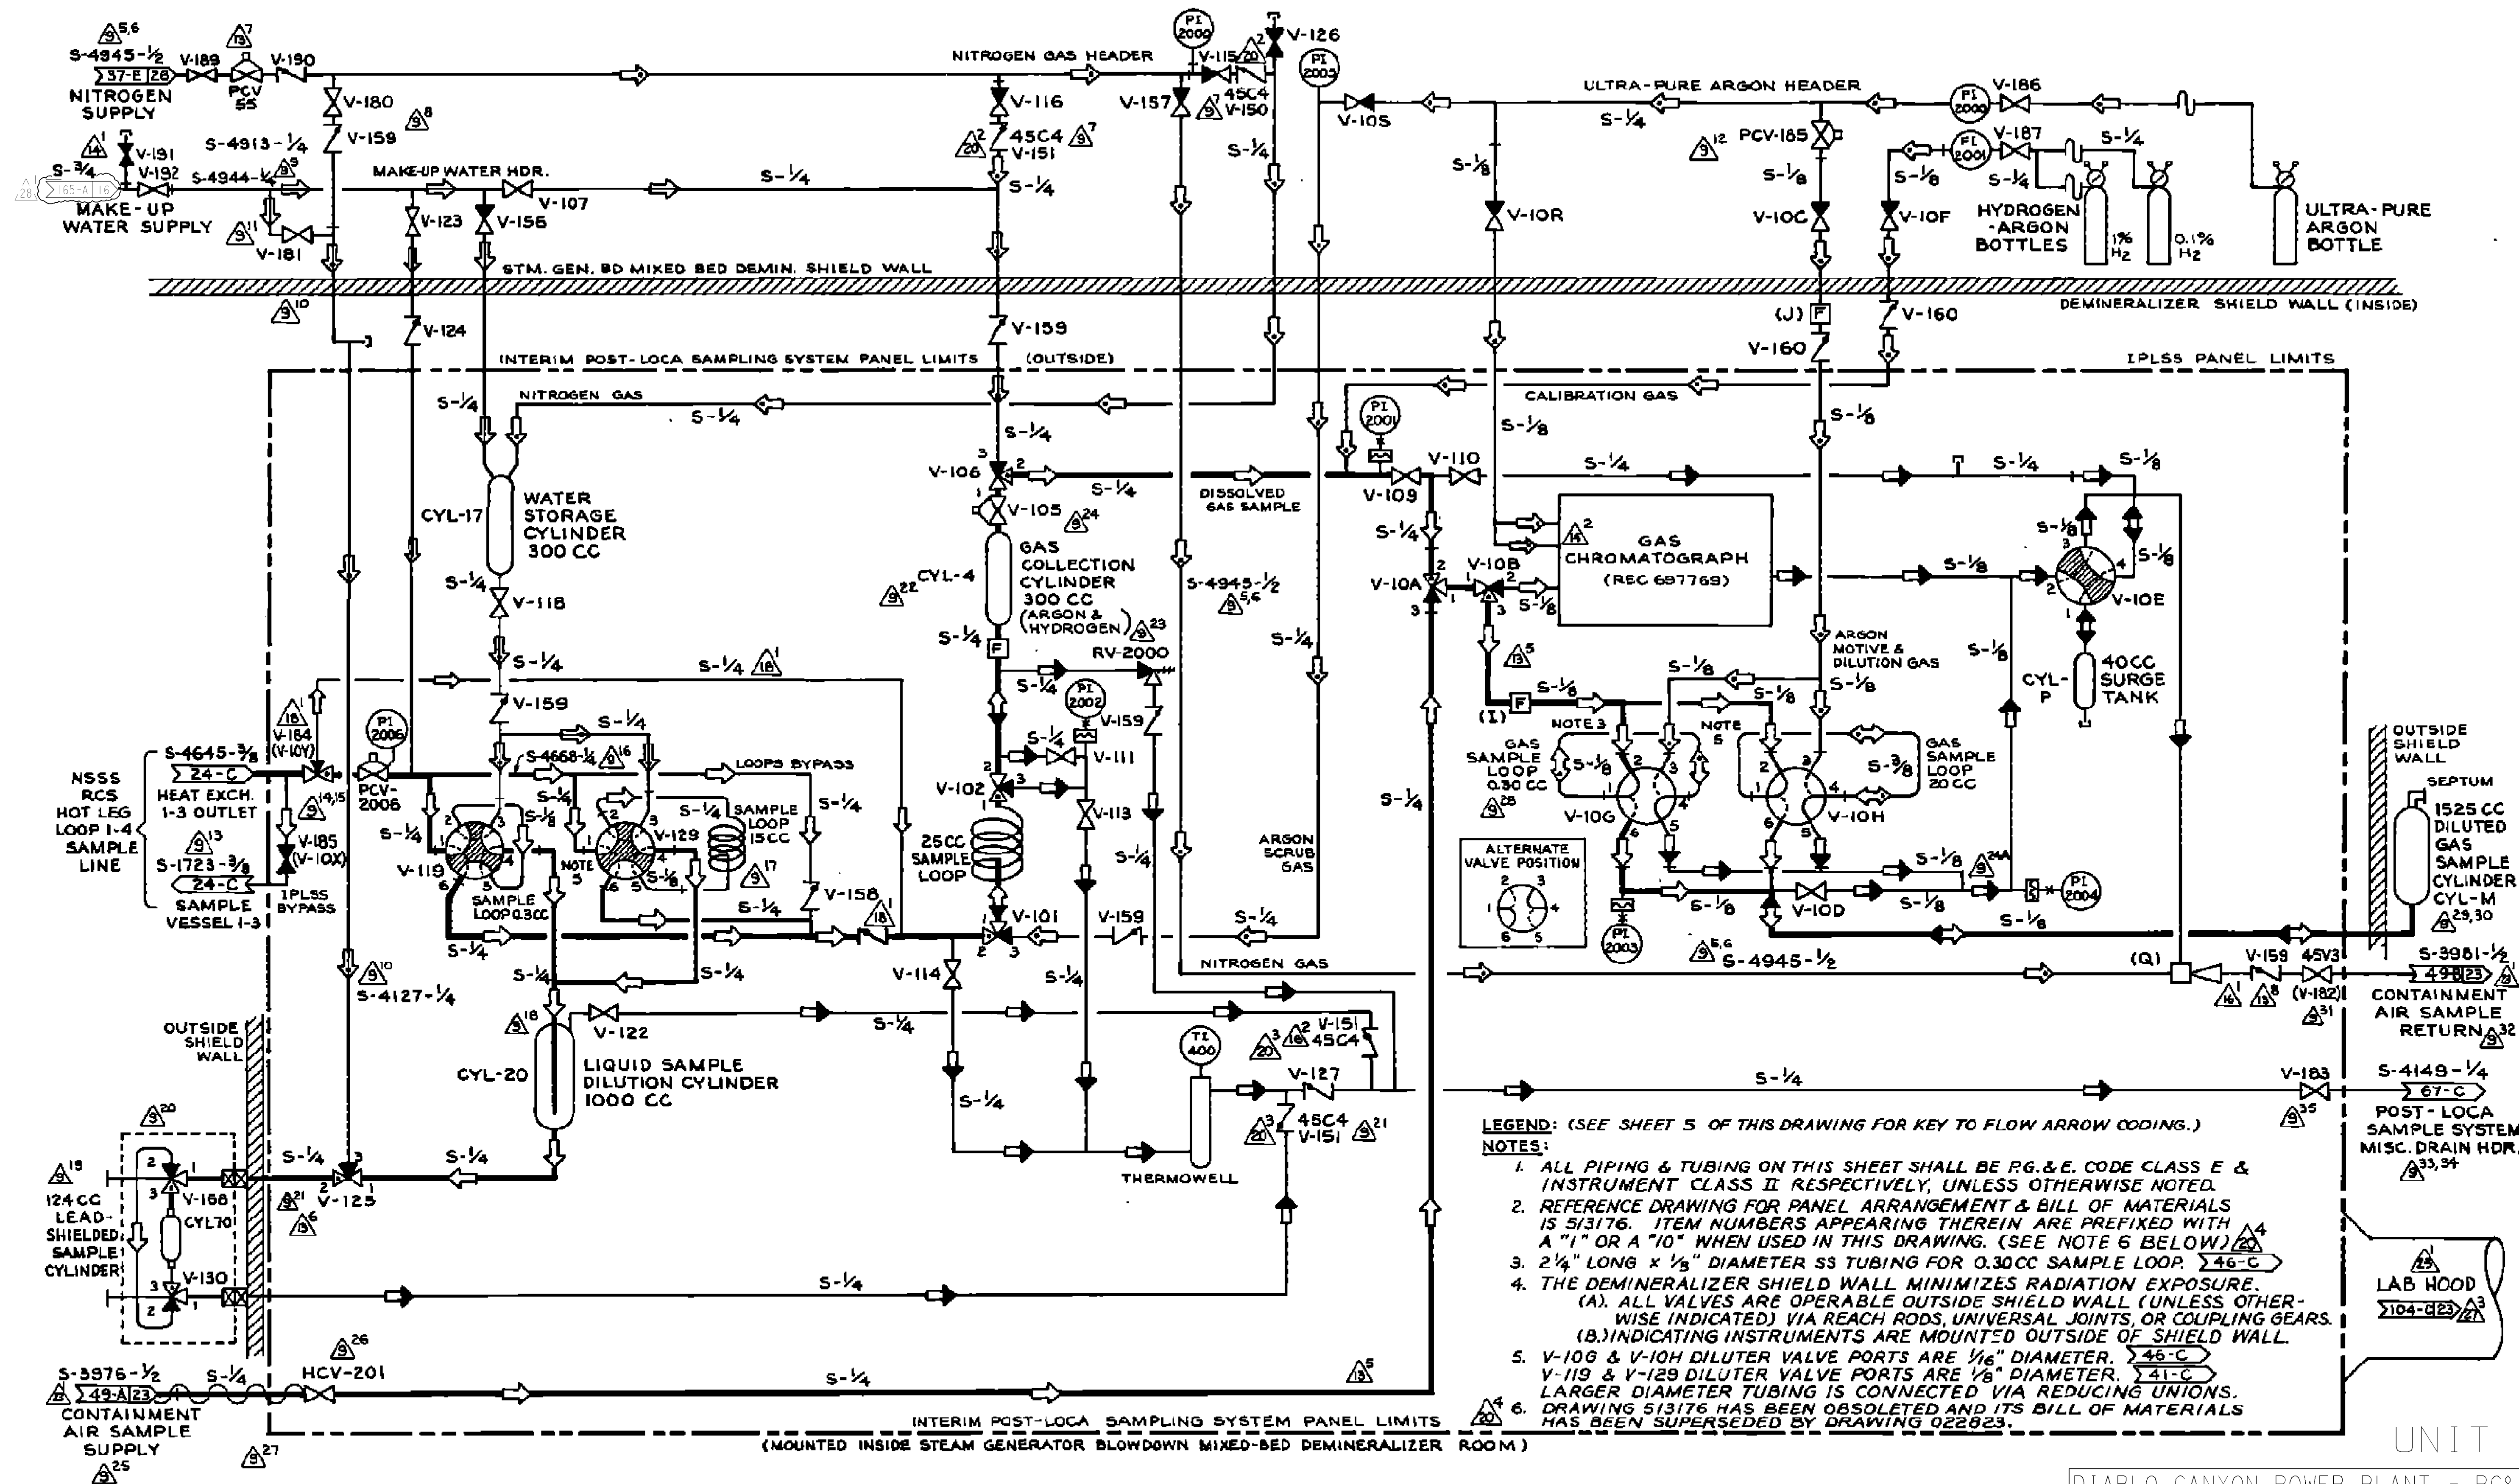


INTERIM POST-LOCA SAMPLING SYSTEM

DIABLO CANYON POWER PLANT - PG&E CO.


DRAWING	SHEET	PAGE	REV
102011	4	0	28

01-24-2006	MIBF	RHSI	FRANCIS C. LING	MECHANICAL	M 16098	12/31/2007	REVISED PER FCT-030760
DATE	DWN	RE	IV	PE DISC.	PE*	PE EXP.	

RASTER-2011.s4.dgn
DGN=2011.s4.dgn
CAD User: MIBF Date: 01-24-2006

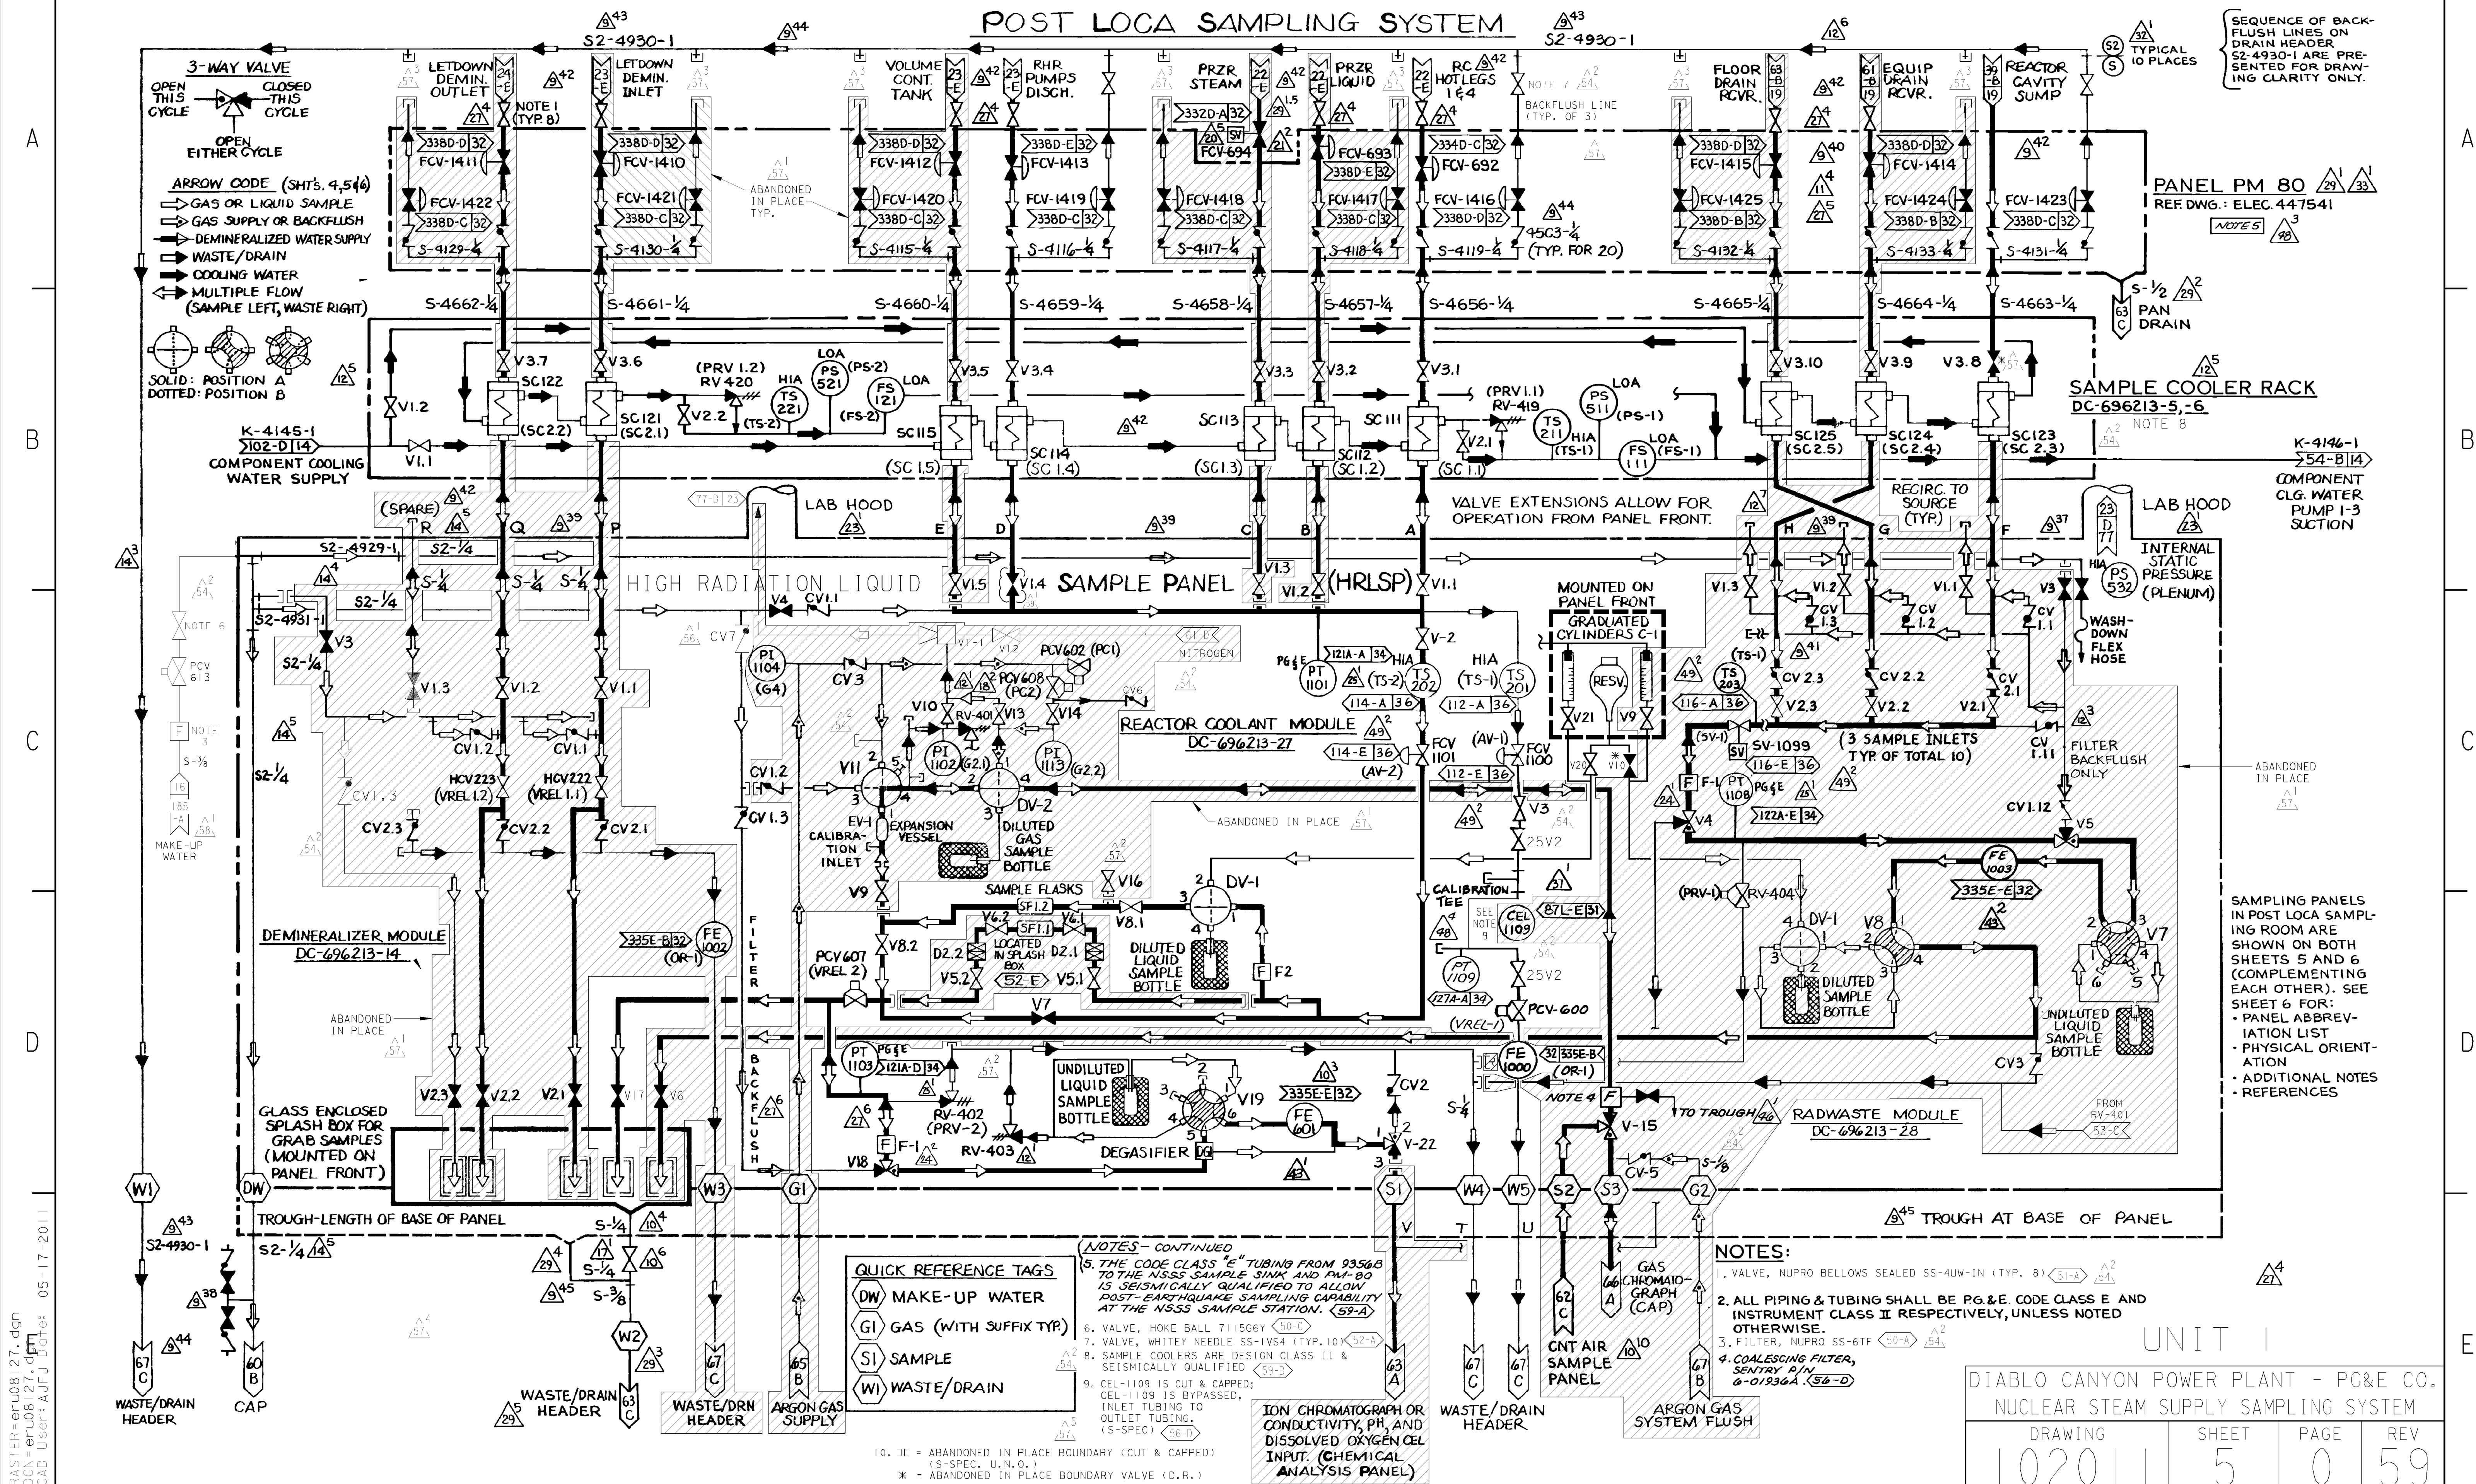


POST-LOCA SAMPLING SYSTEM

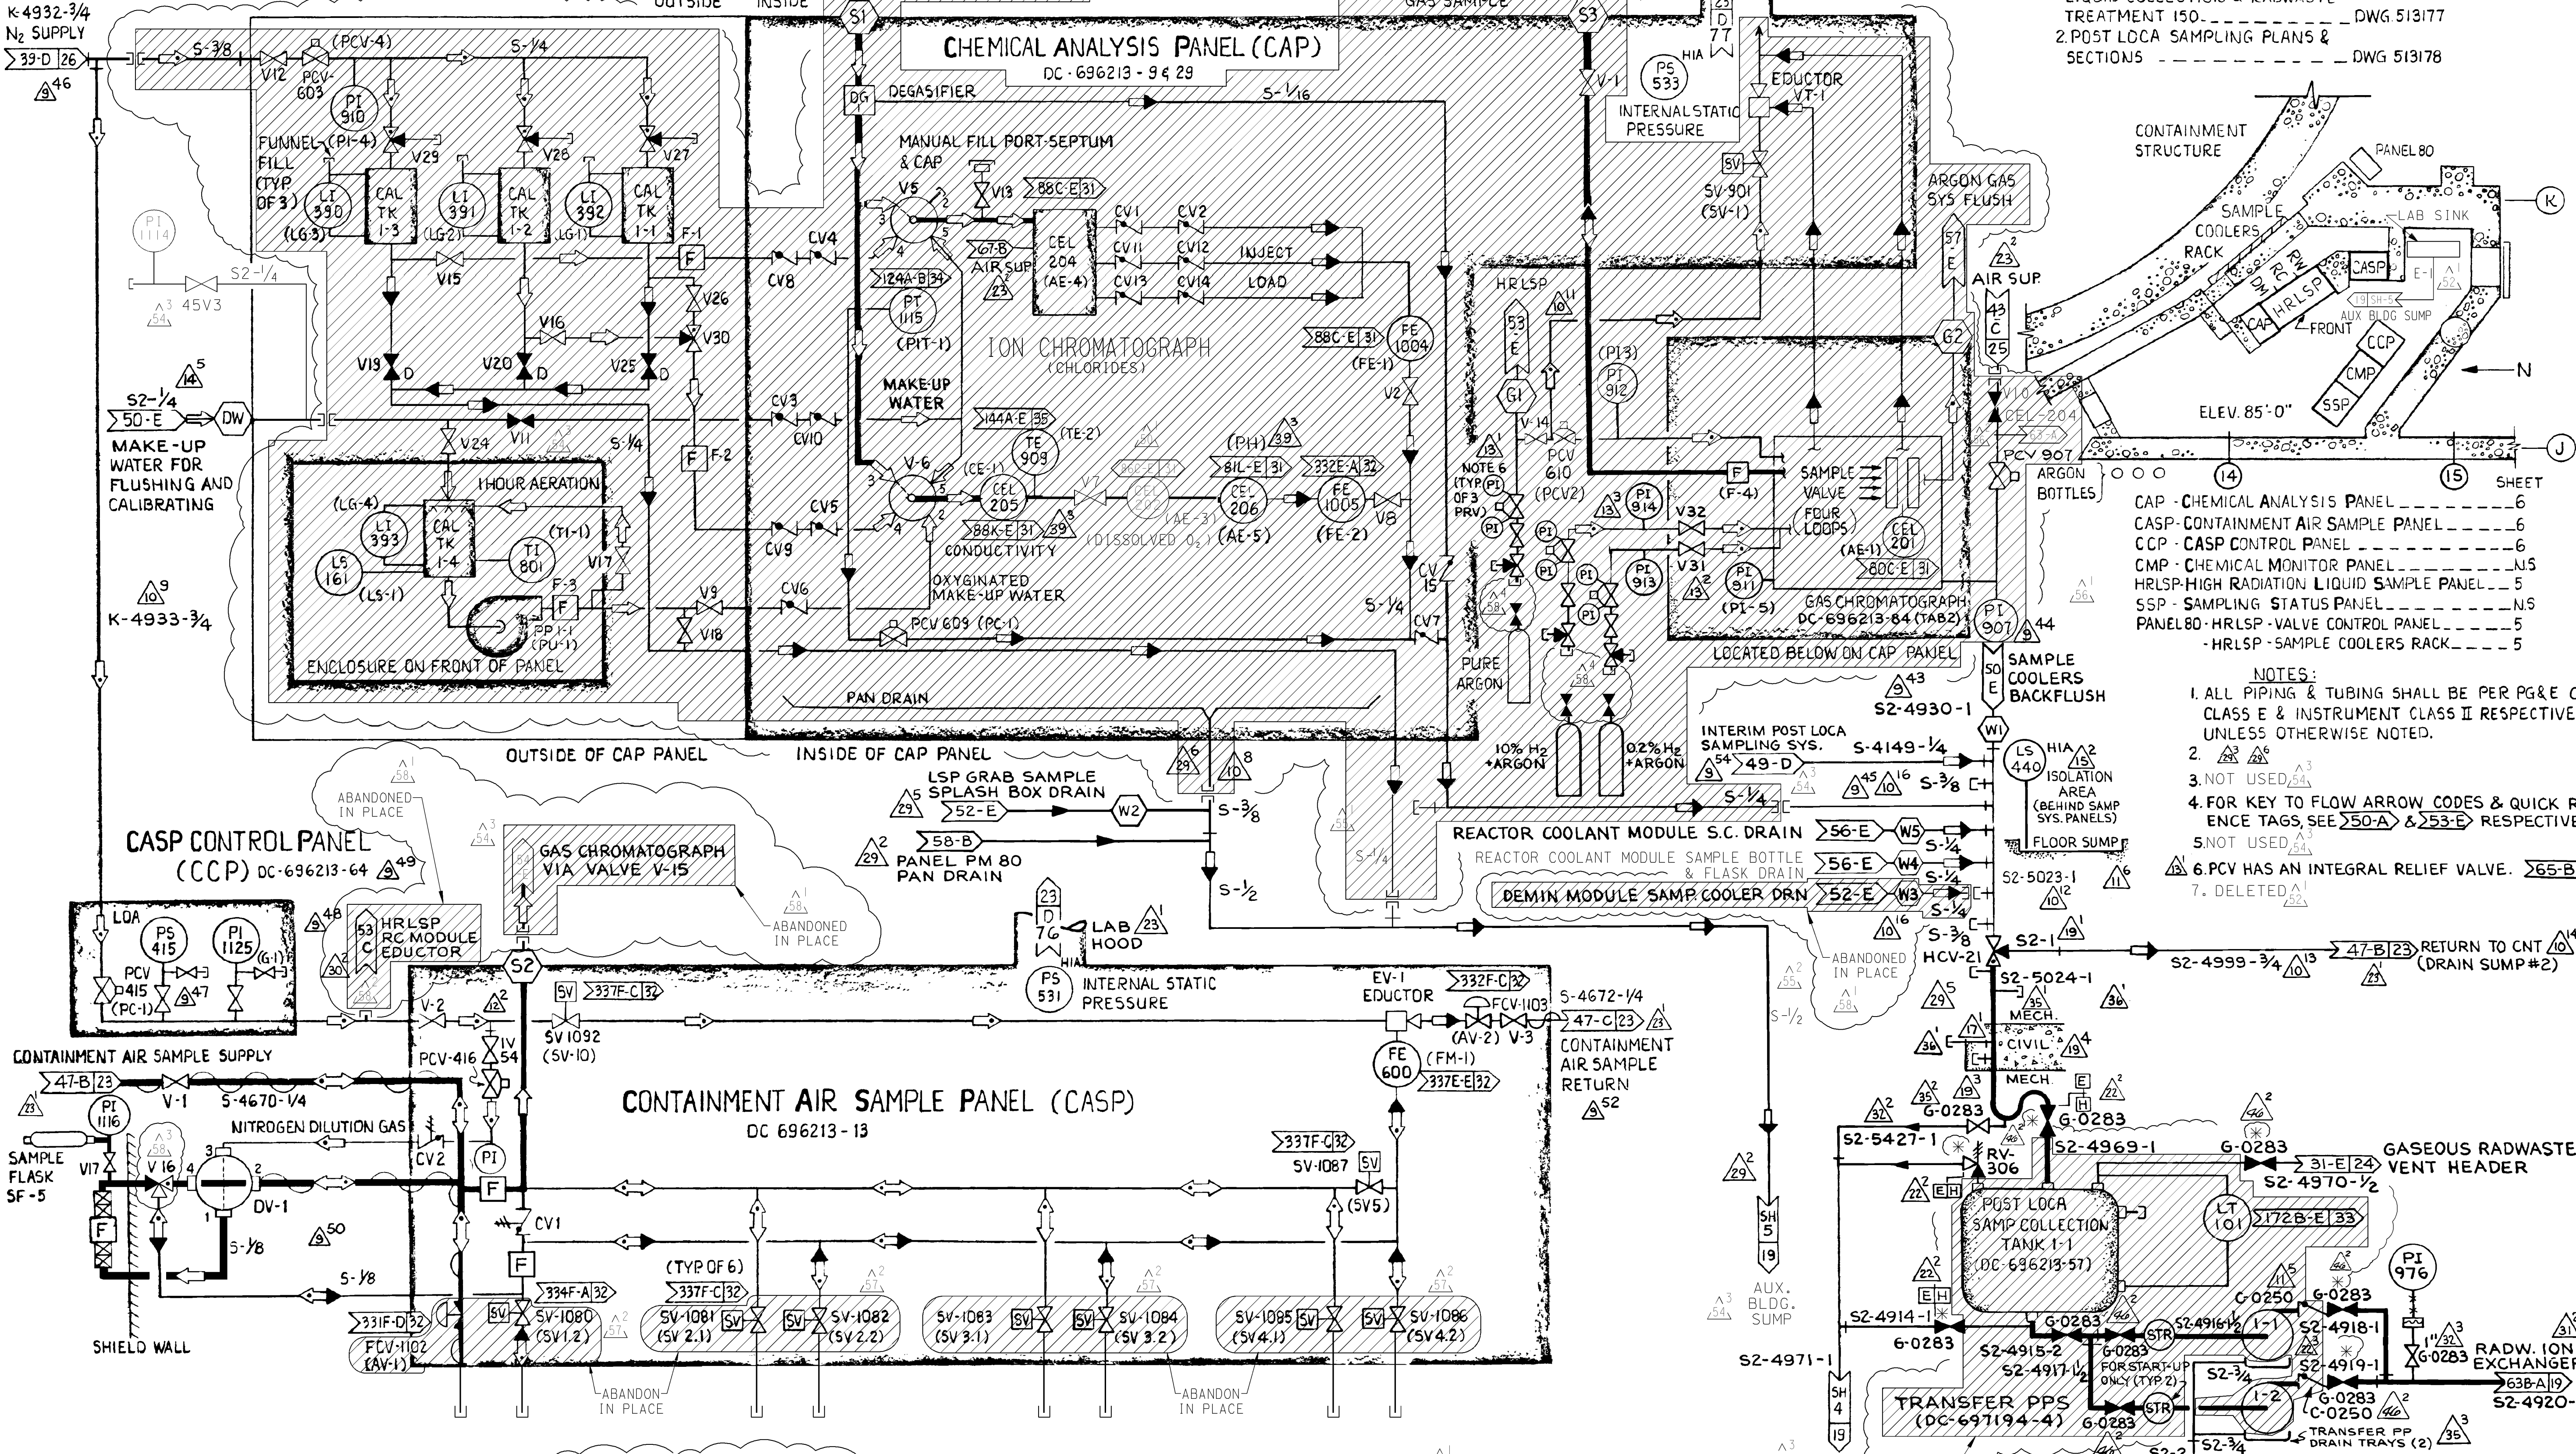

REFERENCES:
1. POST LOCA SAMPLING SYSTEM-
LIQUID COLLECTION & RADWASTE
TREATMENT ISO. DWG 513177
2. POST LOCA SAMPLING PLANS &
SECTIONS DWG 513178


- CAP - CHEMICAL ANALYSIS PANEL
CASP - CONTAINMENT AIR SAMPLE PANEL
CCP - CASP CONTROL PANEL
CMP - CHEMICAL MONITOR PANEL
HRLSP - HIGH RADIATION LIQUID SAMPLE PANEL
SSP - SAMPLING STATUS PANEL
PANEL 80 - HRLSP - VALVE CONTROL PANEL
- NOTES:
1. ALL PIPING & TUBING SHALL BE PER PG&E CODE
CLASS E & INSTRUMENT CLASS II RESPECTIVELY
UNLESS OTHERWISE NOTED.
2. NOT USED
3. NOT USED
4. FOR KEY TO FLOW ARROW CODES & QUICK REFER-
ENCE TAGS, SEE 50-A & 53-E RESPECTIVELY.
5. NOT USED
6. PCV HAS AN INTEGRAL RELIEF VALVE.
7. DELETED

NOTES: (CONTINUED)
8. * = ABANDONED-IN-PLACE BOUNDARY VALVE (D.R.)
JC = ABANDONED-IN-PLACE BOUNDARY (CUT & CAPPED)
(S-SPEC. U.N.O.)

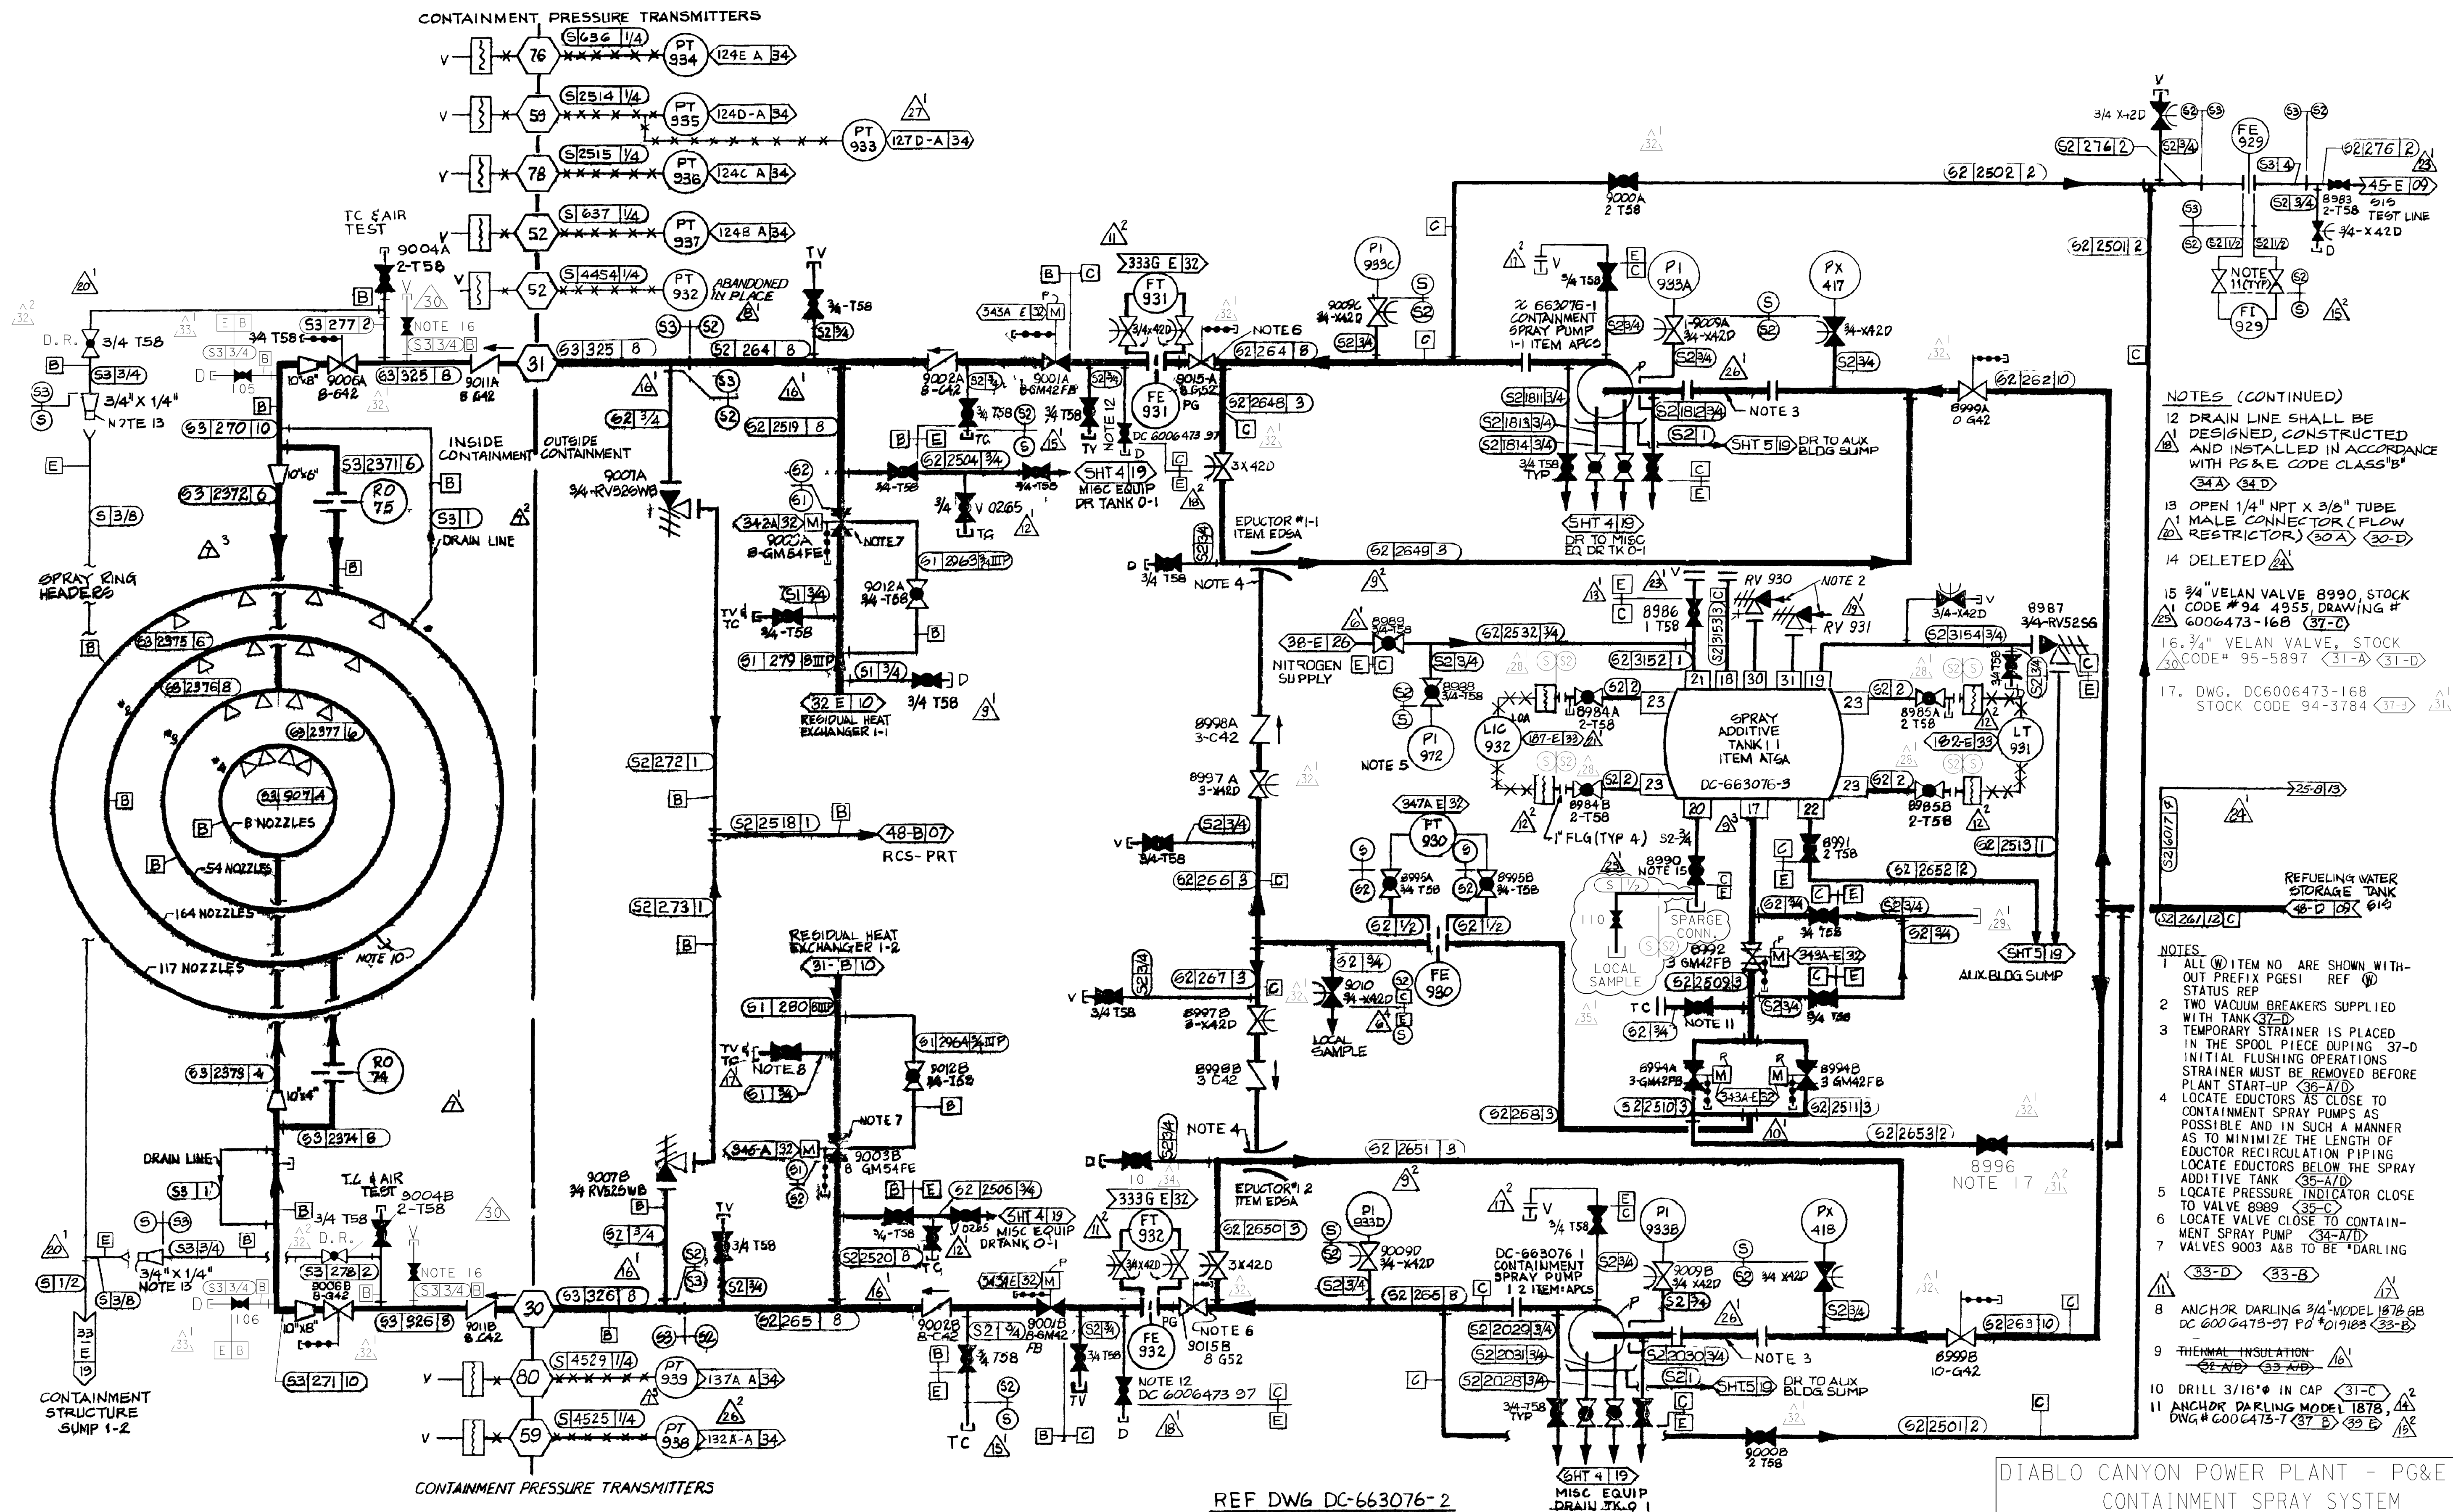

- NOTES (CONTINUED)
- 12 DRAIN LINE SHALL BE DESIGNED, CONSTRUCTED AND INSTALLED IN ACCORDANCE WITH PG&E CODE CLASS "B" (34-A) (34-D)
- 13 OPEN 1/4" NPT X 3/8" TUBE MALE CONNECTOR (FLOW RESTRICTOR) (30-A) (30-D)
- 14 DELETED (31-A)
- 15 3/4" VELAN VALVE 8990, STOCK CODE # 94 4955, DRAWING # 6006473-16B (37-C)
- 16 3/4" VELAN VALVE, STOCK CODE # 95-5897 (31-A) (31-D)
17. DWG. DC6006473-16B STOCK CODE 94-3784 (37-B) (31-A)

- NOTES
- 1 ALL (W) ITEM NO. ARE SHOWN WITHOUT PREFIX PG&E REF (D) STATUS REP
- 2 TWO VACUUM BREAKERS SUPPLIED WITH TANK (37-D)
- 3 TEMPORARY STRAINER IS PLACED IN THE SPOOL PIECE DURING INITIAL FLUSHING OPERATIONS. STRAINER MUST BE REMOVED BEFORE PLANT START-UP (36-A/D)
- 4 LOCATE EDUCATORS AS CLOSE TO CONTAINMENT SPRAY PUMPS AS POSSIBLE AND IN SUCH A MANNER AS TO MINIMIZE THE LENGTH OF EDUCATOR RECIRCULATION PIPING. LOCATE EDUCATORS BELOW THE SPRAY ADDITIVE TANK (35-A/D)
- 5 LOCATE PRESSURE INDICATOR CLOSE TO VALVE 8989 (35-C)
- 6 LOCATE VALVE CLOSE TO CONTAINMENT SPRAY PUMP (34-A/D)
- 7 VALVES 9003 A&B TO BE "DARLING" (33-D) (33-B)
- 8 ANCHOR DARLING 3/4" MODEL 1878 6B DC 6006473-97 P.O. #019183 (33-B)
- 9 THERMAL INSULATION (32-A/B) (33-A/B)
- 10 DRILL 3/16" IN CAP (31-C)
- 11 ANCHOR DARLING MODEL 1878, DWG # 6006473-7 (37-B) (32-B)



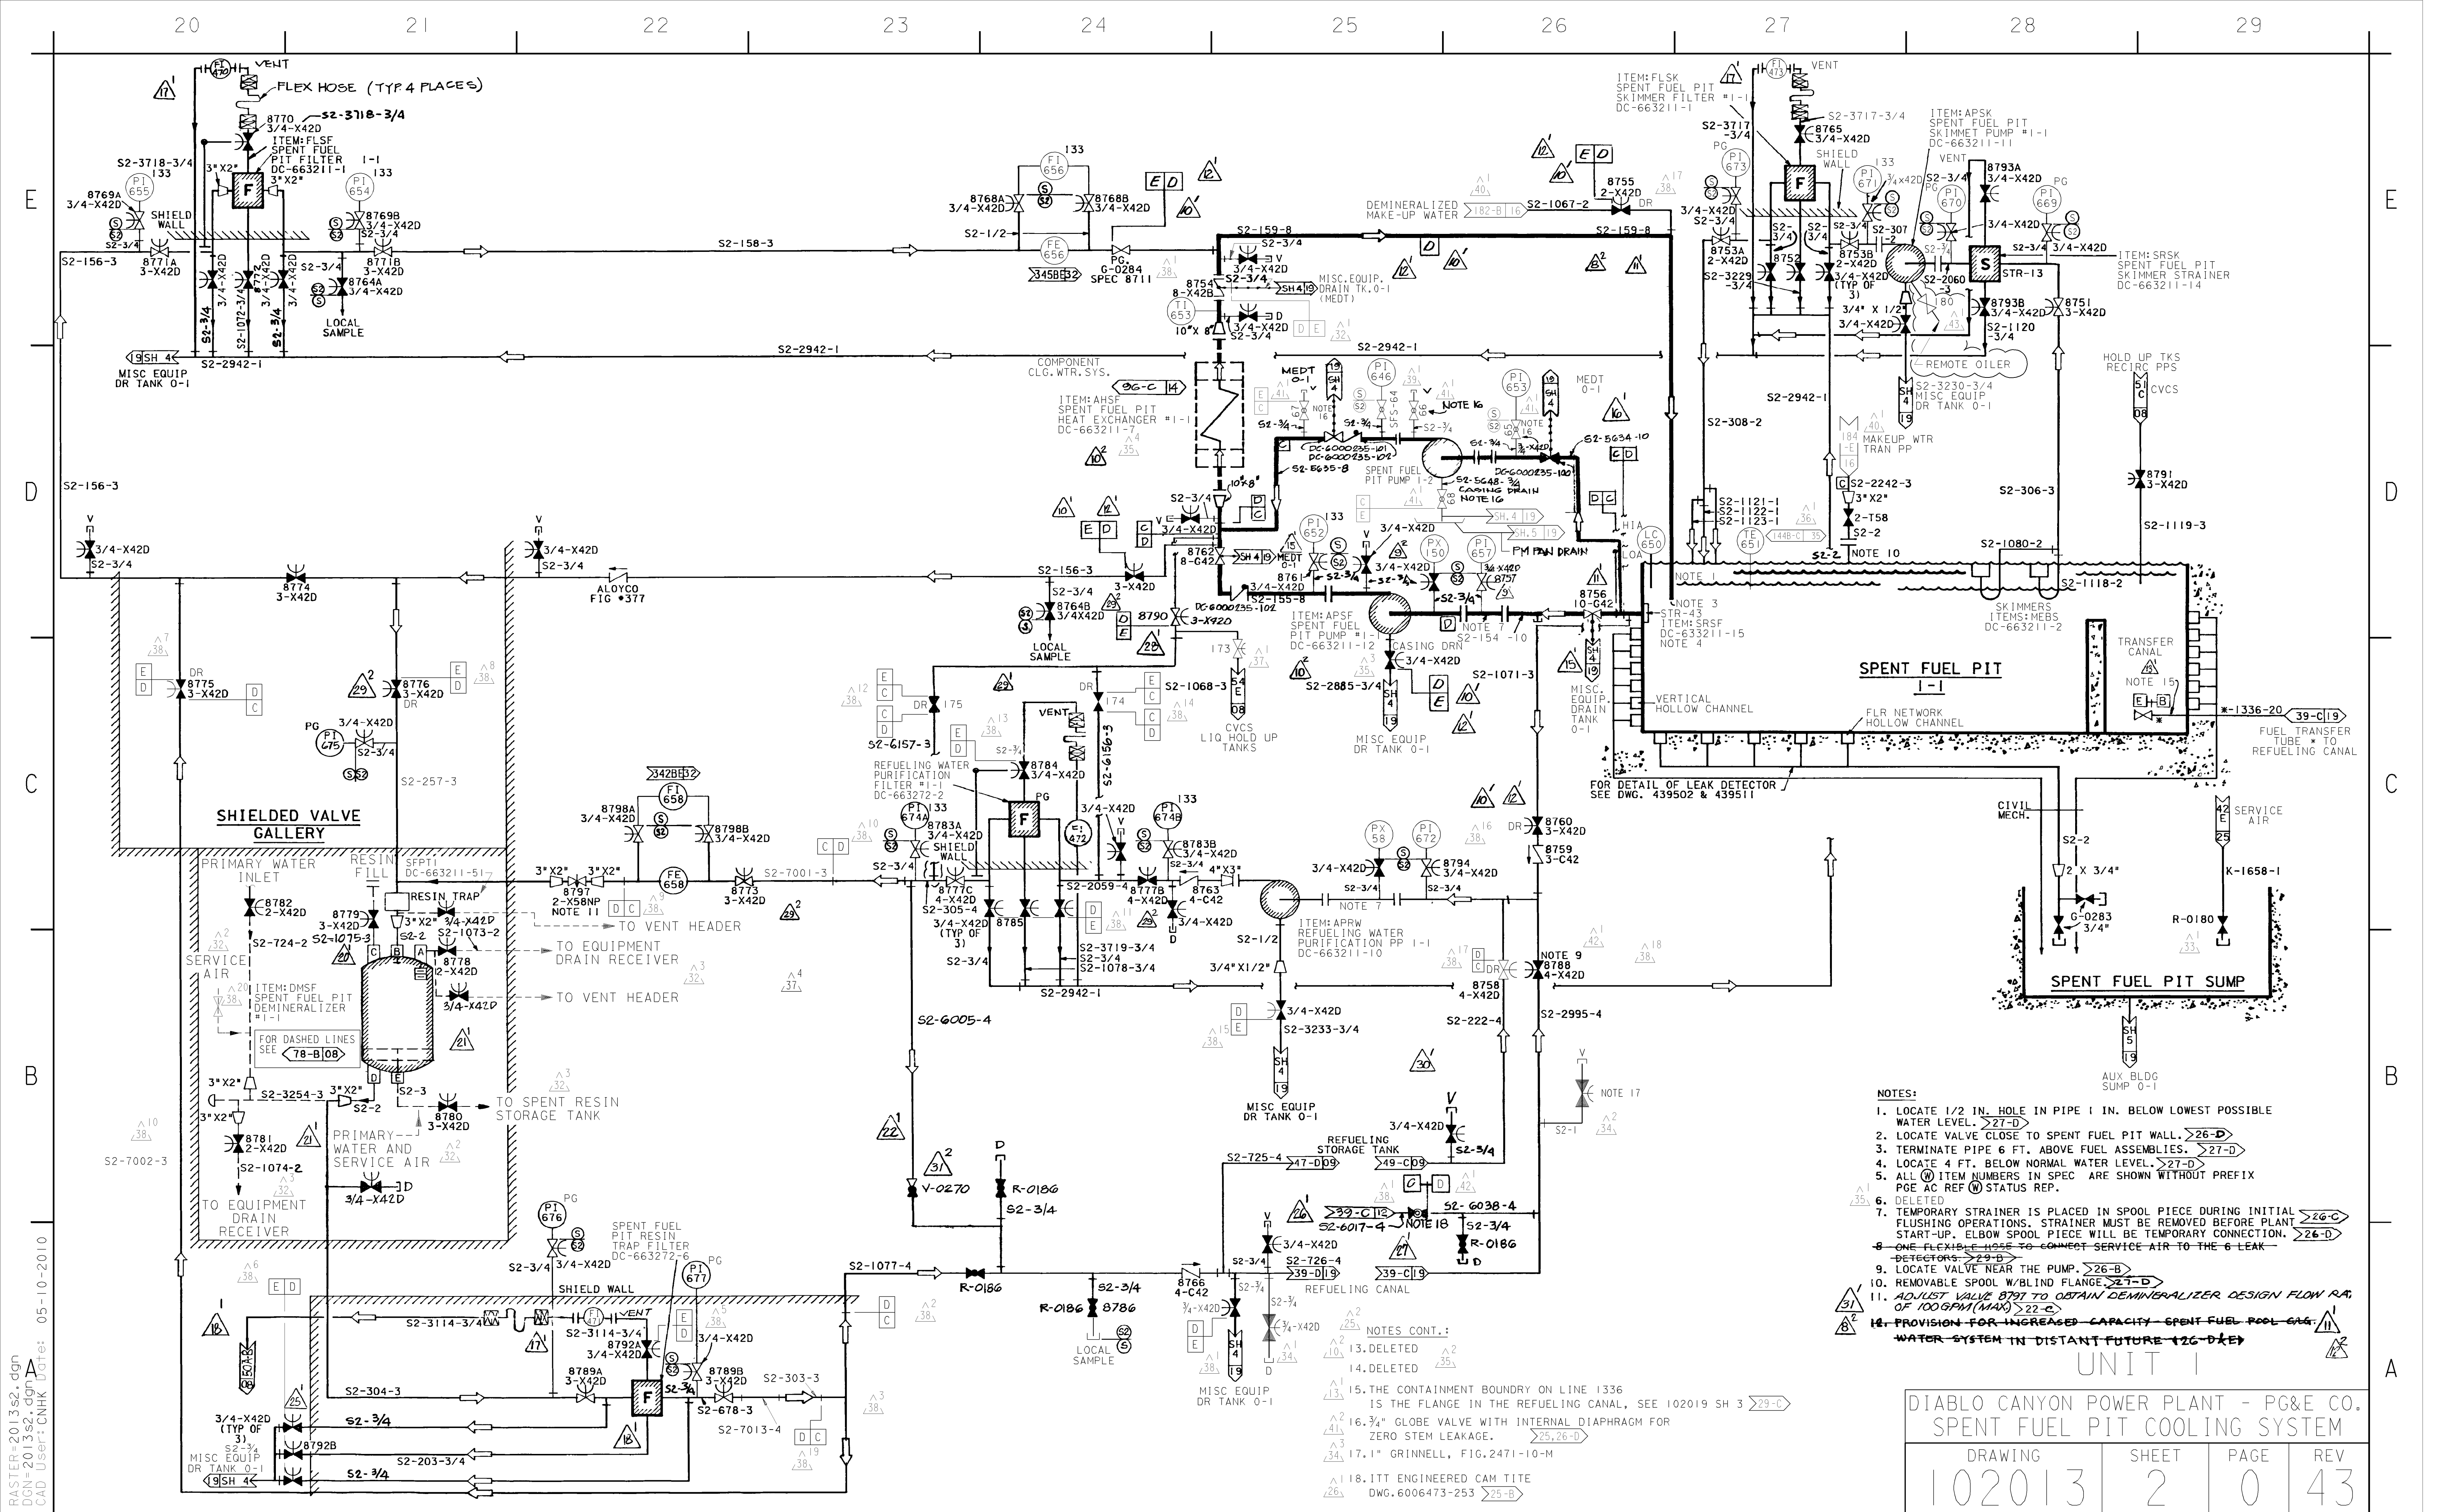


- NOTES:
1. LOCATE 1/2 IN. HOLE IN PIPE 1 IN. BELOW LOWEST POSSIBLE WATER LEVEL. >27-D
 2. LOCATE VALVE CLOSE TO SPENT FUEL PIT WALL. >26-D
 3. TERMINATE PIPE 6 FT. ABOVE FUEL ASSEMBLIES. >27-D
 4. LOCATE 4 FT. BELOW NORMAL WATER LEVEL. >27-D
 5. ALL ITEM NUMBERS IN SPEC ARE SHOWN WITHOUT PREFIX PGE AC REF (M) STATUS REP.
 6. DELETED
 7. TEMPORARY STRAINER IS PLACED IN SPOOL PIECE DURING INITIAL FLUSHING OPERATIONS. STRAINER MUST BE REMOVED BEFORE PLANT START-UP. ELBOW SPOOL PIECE WILL BE TEMPORARY CONNECTION. >26-C
 8. ~~ONE FLEXIBLE HOSE TO CONNECT SERVICE AIR TO THE 6 LEAK DETECTORS. >26-D~~
 9. LOCATE VALVE NEAR THE PUMP. >26-B
 10. REMOVABLE SPOOL W/BLIND FLANGE. >27-D
 11. ADJUST VALVE 8791 TO OBTAIN DEMINERALIZER DESIGN FLOW RATE OF 100 GPM (MAX). >22-C
 12. ~~PROVISION FOR INCREASED CAPACITY SPENT FUEL POOL S&S WATER SYSTEM IN DISTANT FUTURE. >26-D~~

DIABLO CANYON POWER PLANT - PG&E CO. SPENT FUEL PIT COOLING SYSTEM			
DRAWING	SHEET	PAGE	REV
102013	2	0	43

05-10-2010	CNKH	RxG2	KERSI J. DALAL	MECHANICAL	M 16690	3/31/2012	REVISED PER DDT-4*223-1
DATE	DWN	RE	PROFESSIONAL ENGINEER	PE DISC.	PE#	PE EXP.	

COMPONENT COOLING WATER PUMPS
DC-663213-1

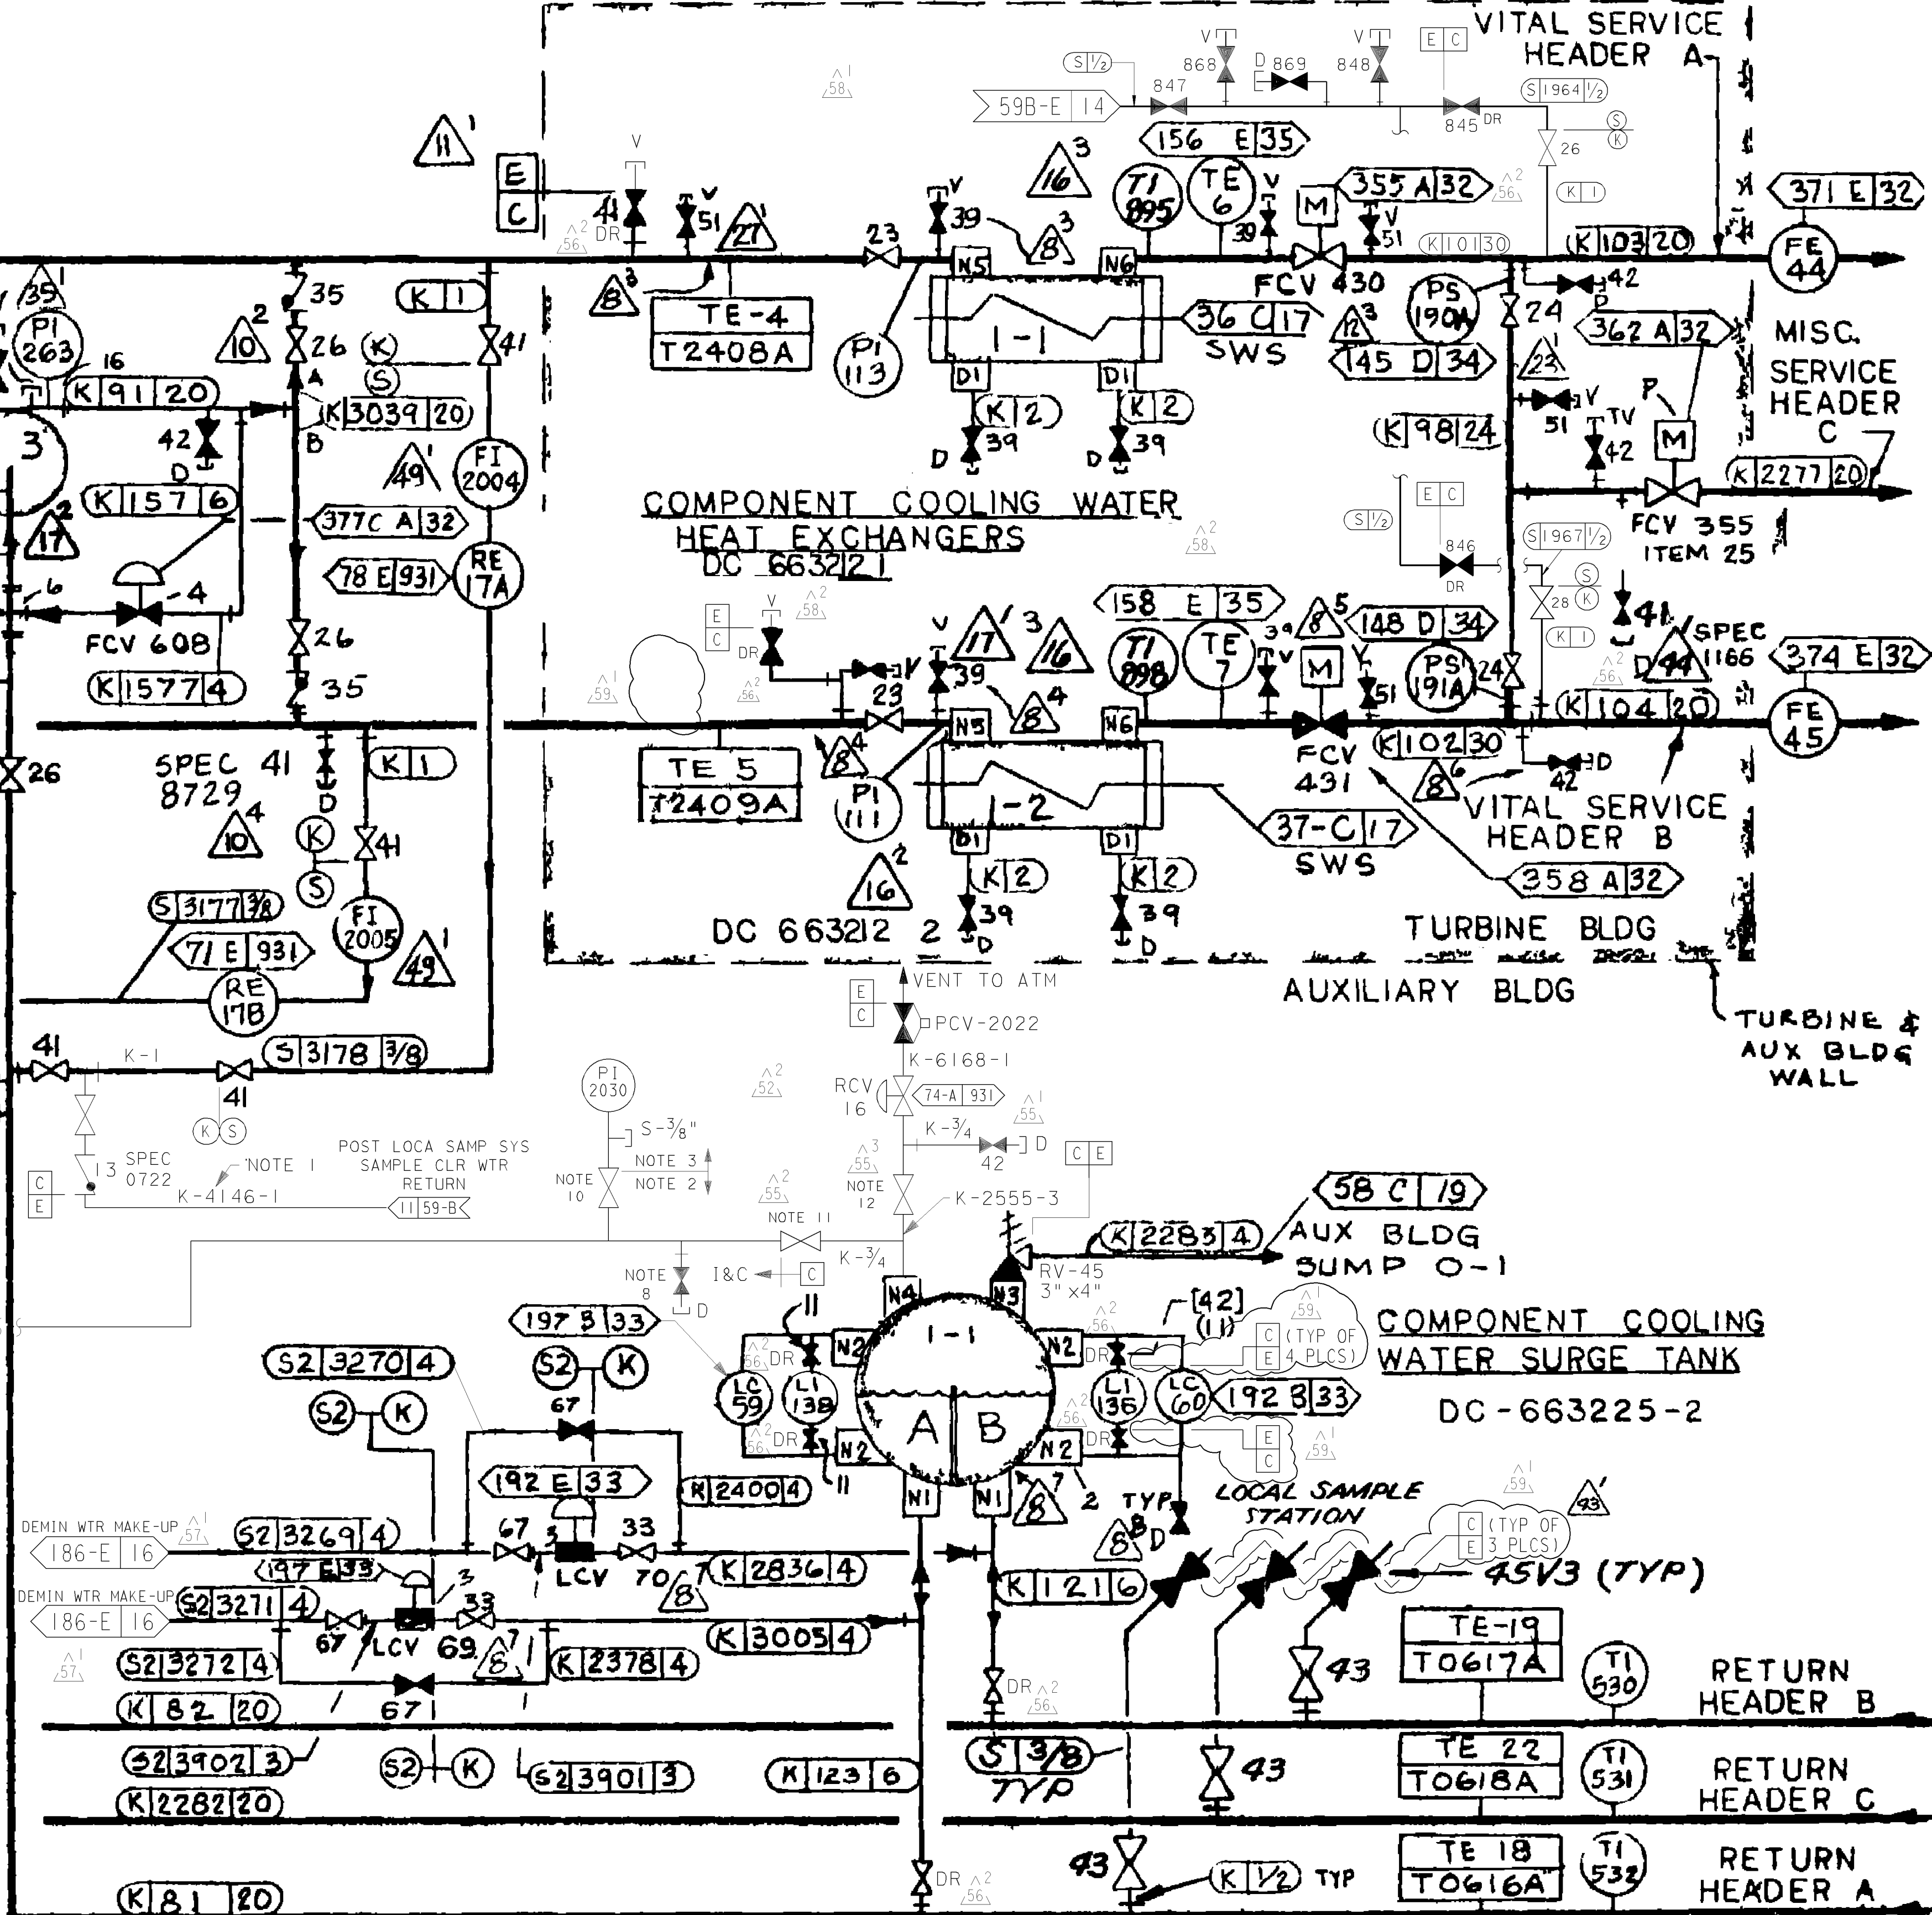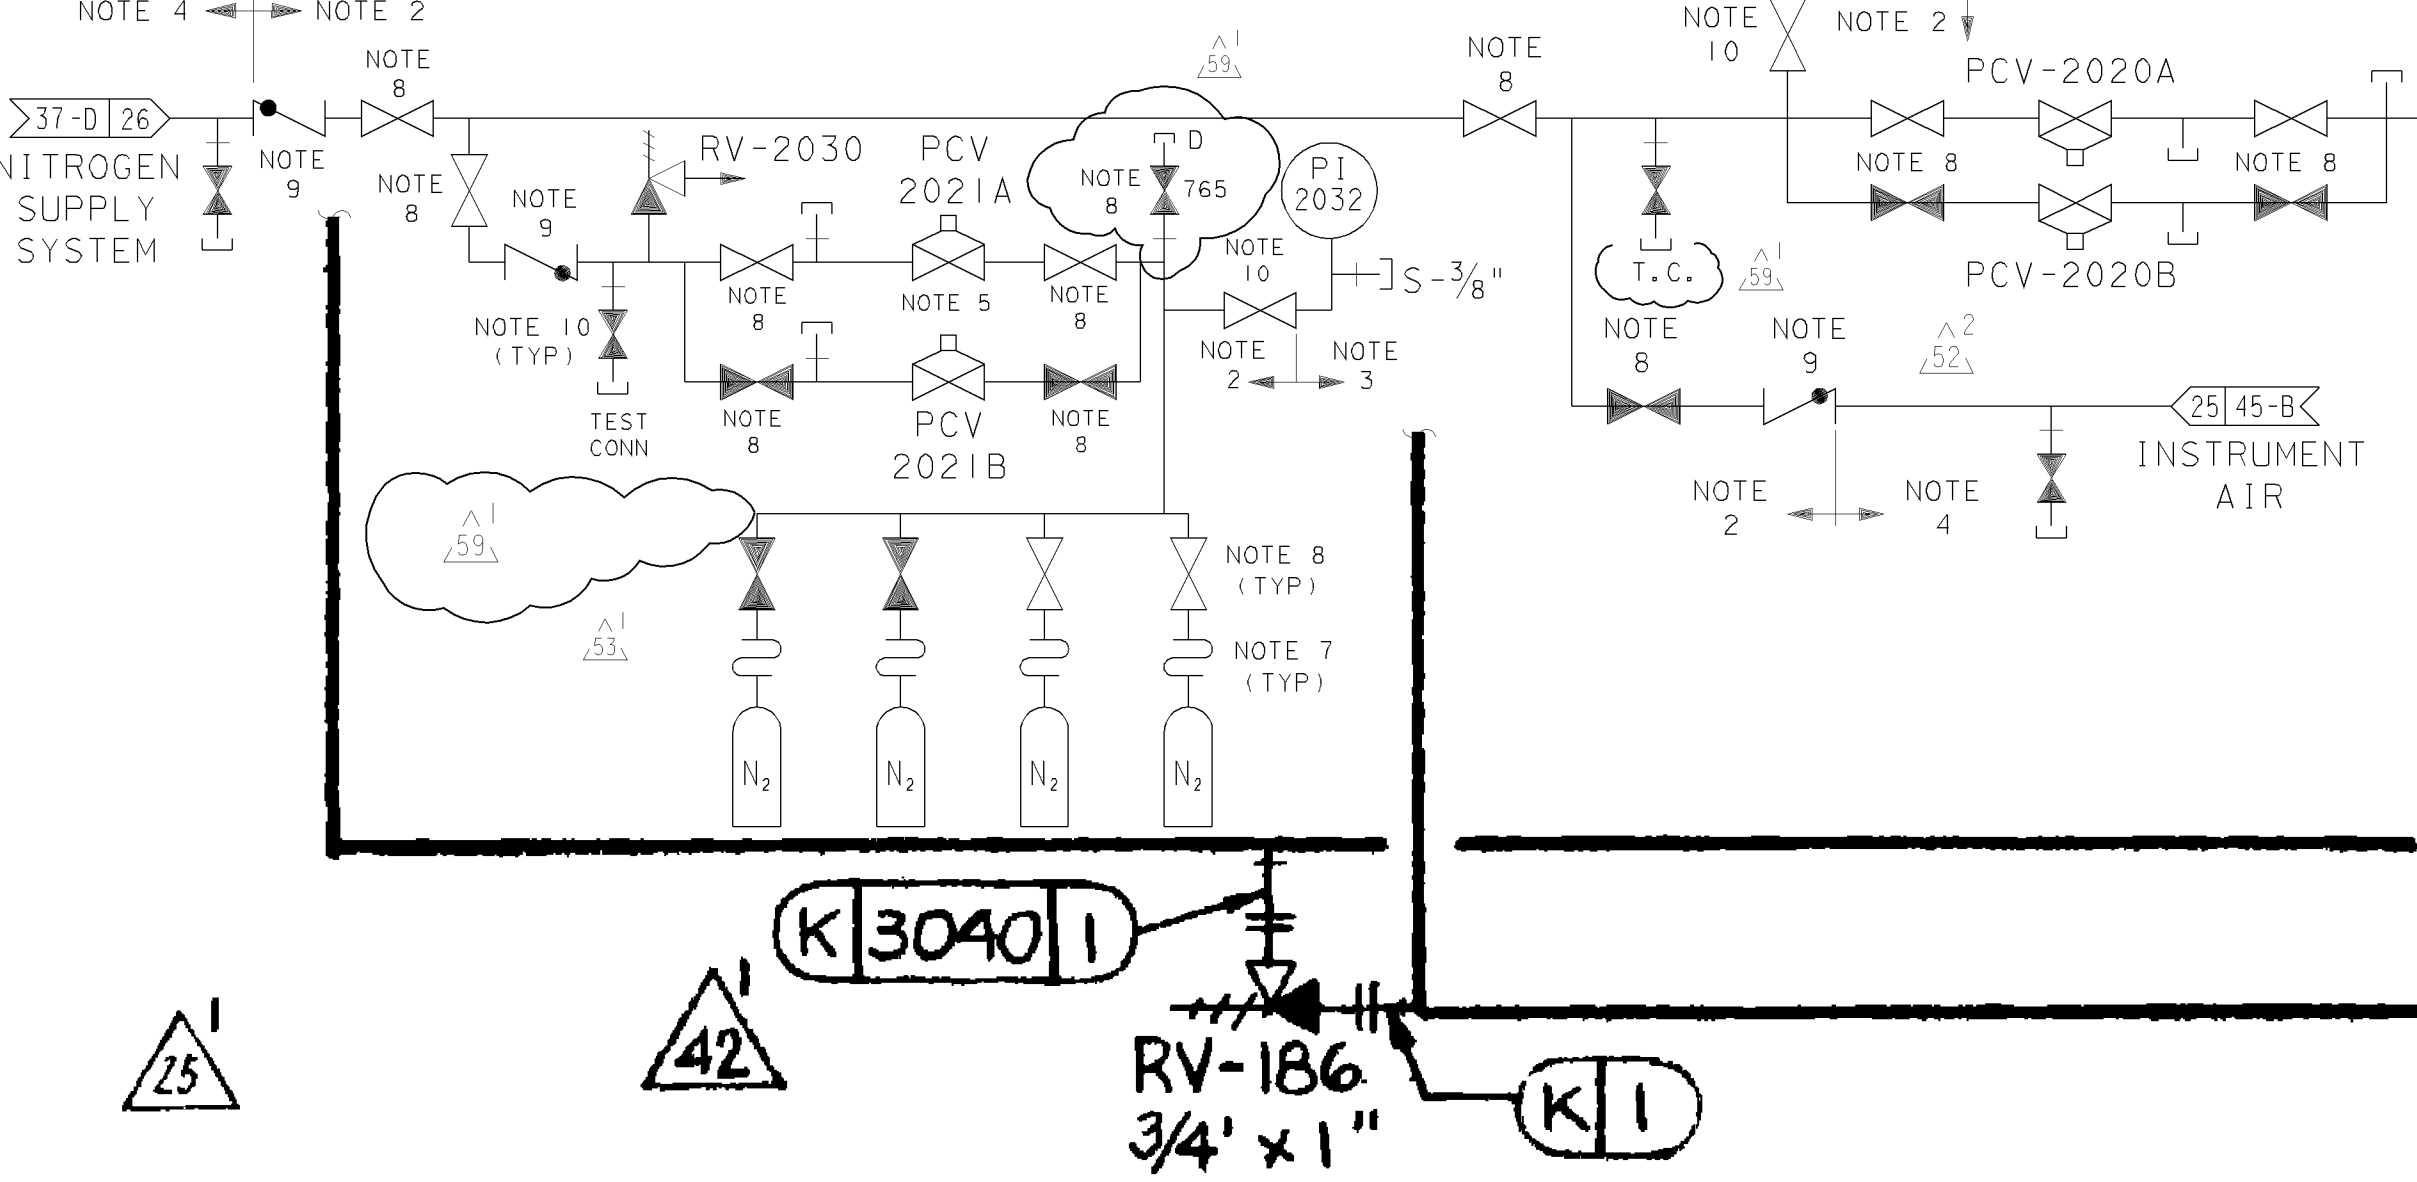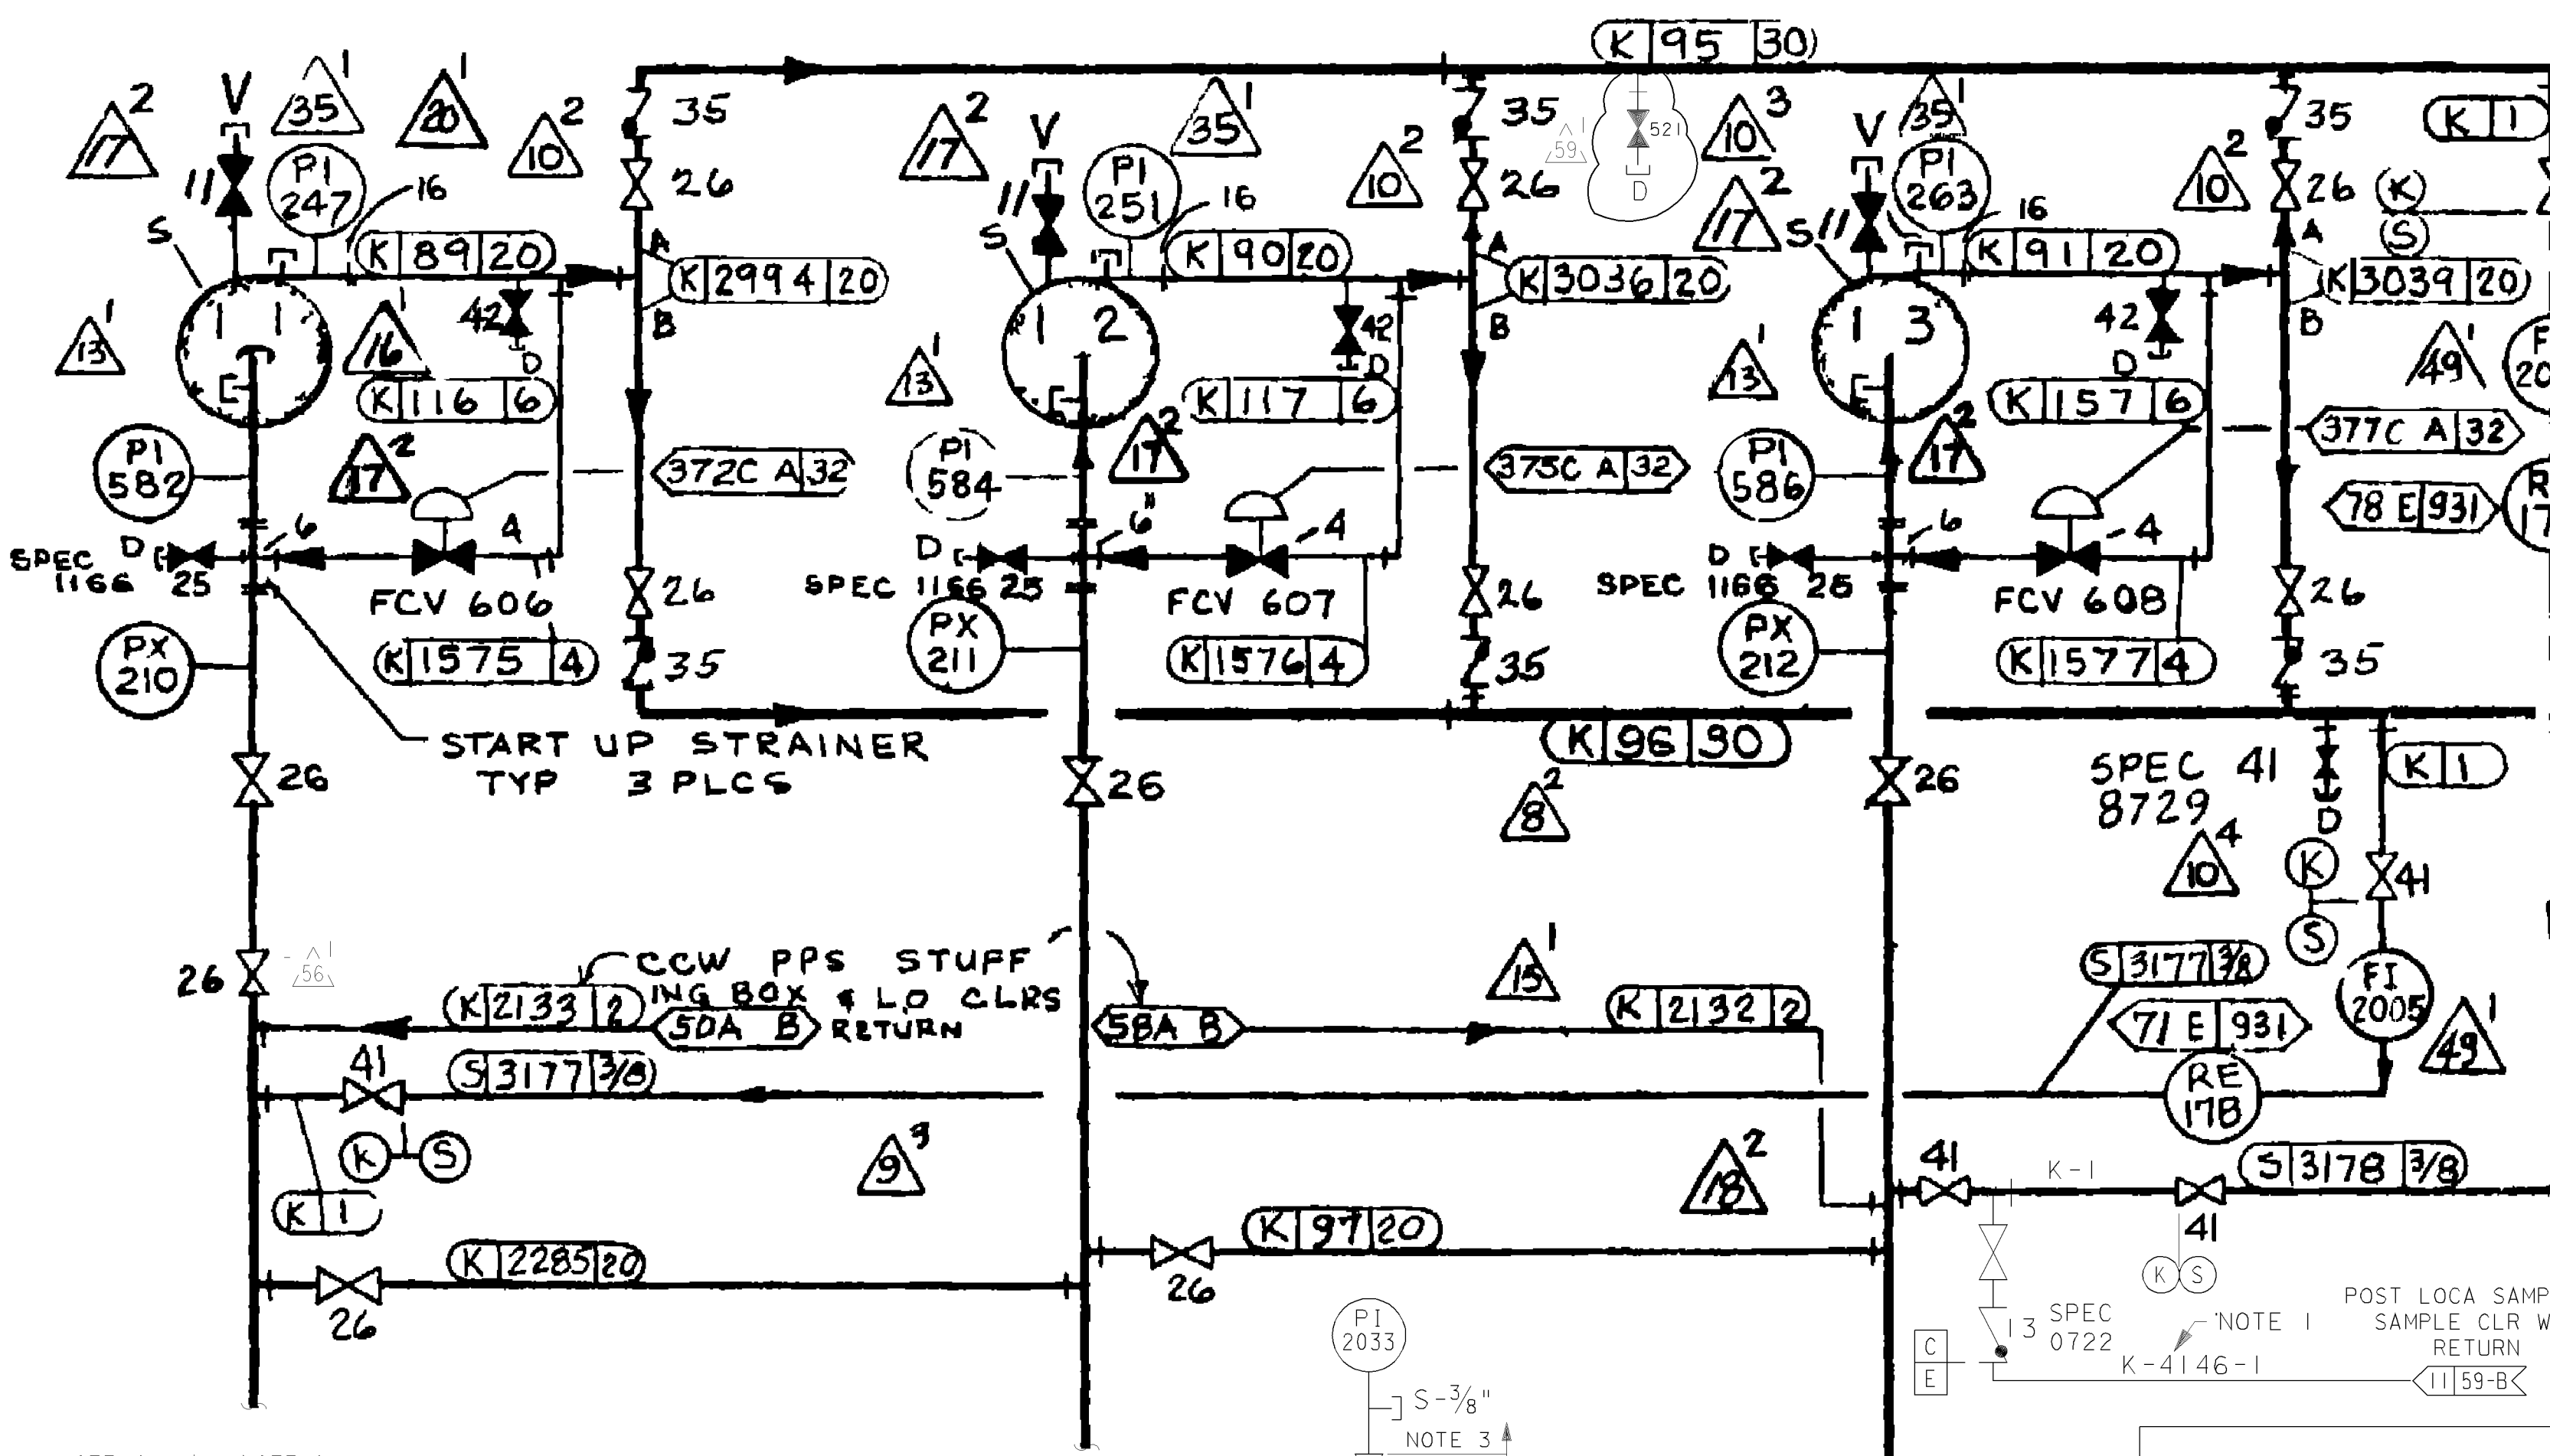


NOTES

1. CODE CLASS E PORTION OF LINE 4146 SHALL BE SEISMICALLY ANALYZED TO DESIGN CLASS 1 CRITERIA
2. INSTRUMENT DESIGN CLASSIFICATION ID
3. INSTRUMENT DESIGN CLASSIFICATION IC
4. INSTRUMENT DESIGN CLASSIFICATION II
5. PCV HAS AN INTEGRAL RELIEF VALVE
6. UNLESS SPECIFIED OTHERWISE THE SURGE TANK PRESSURIZATION LINES ARE 3/4"x 0.065" WALL SS TUBING
7. 1/2" FLEXIBLE TUBING, SWAGelok NO. 8R-8
8. WHITEY MODEL NO. SS-63ES12
9. NUPRO MODEL NO. SS-CHI6S12-1
10. 3/8" WHITEY MODEL NO. SS-43ES6-SH
11. STOCK CODE 93-6841
12. STOCK CODE 95-4119

UNIT 1

DIABLO CANYON POWER PLANT - PG&E CO. COMPONENT COOLING WATER SYSTEM			
DRAWING	SHEET	PAGE	REV
102014	5	0	59

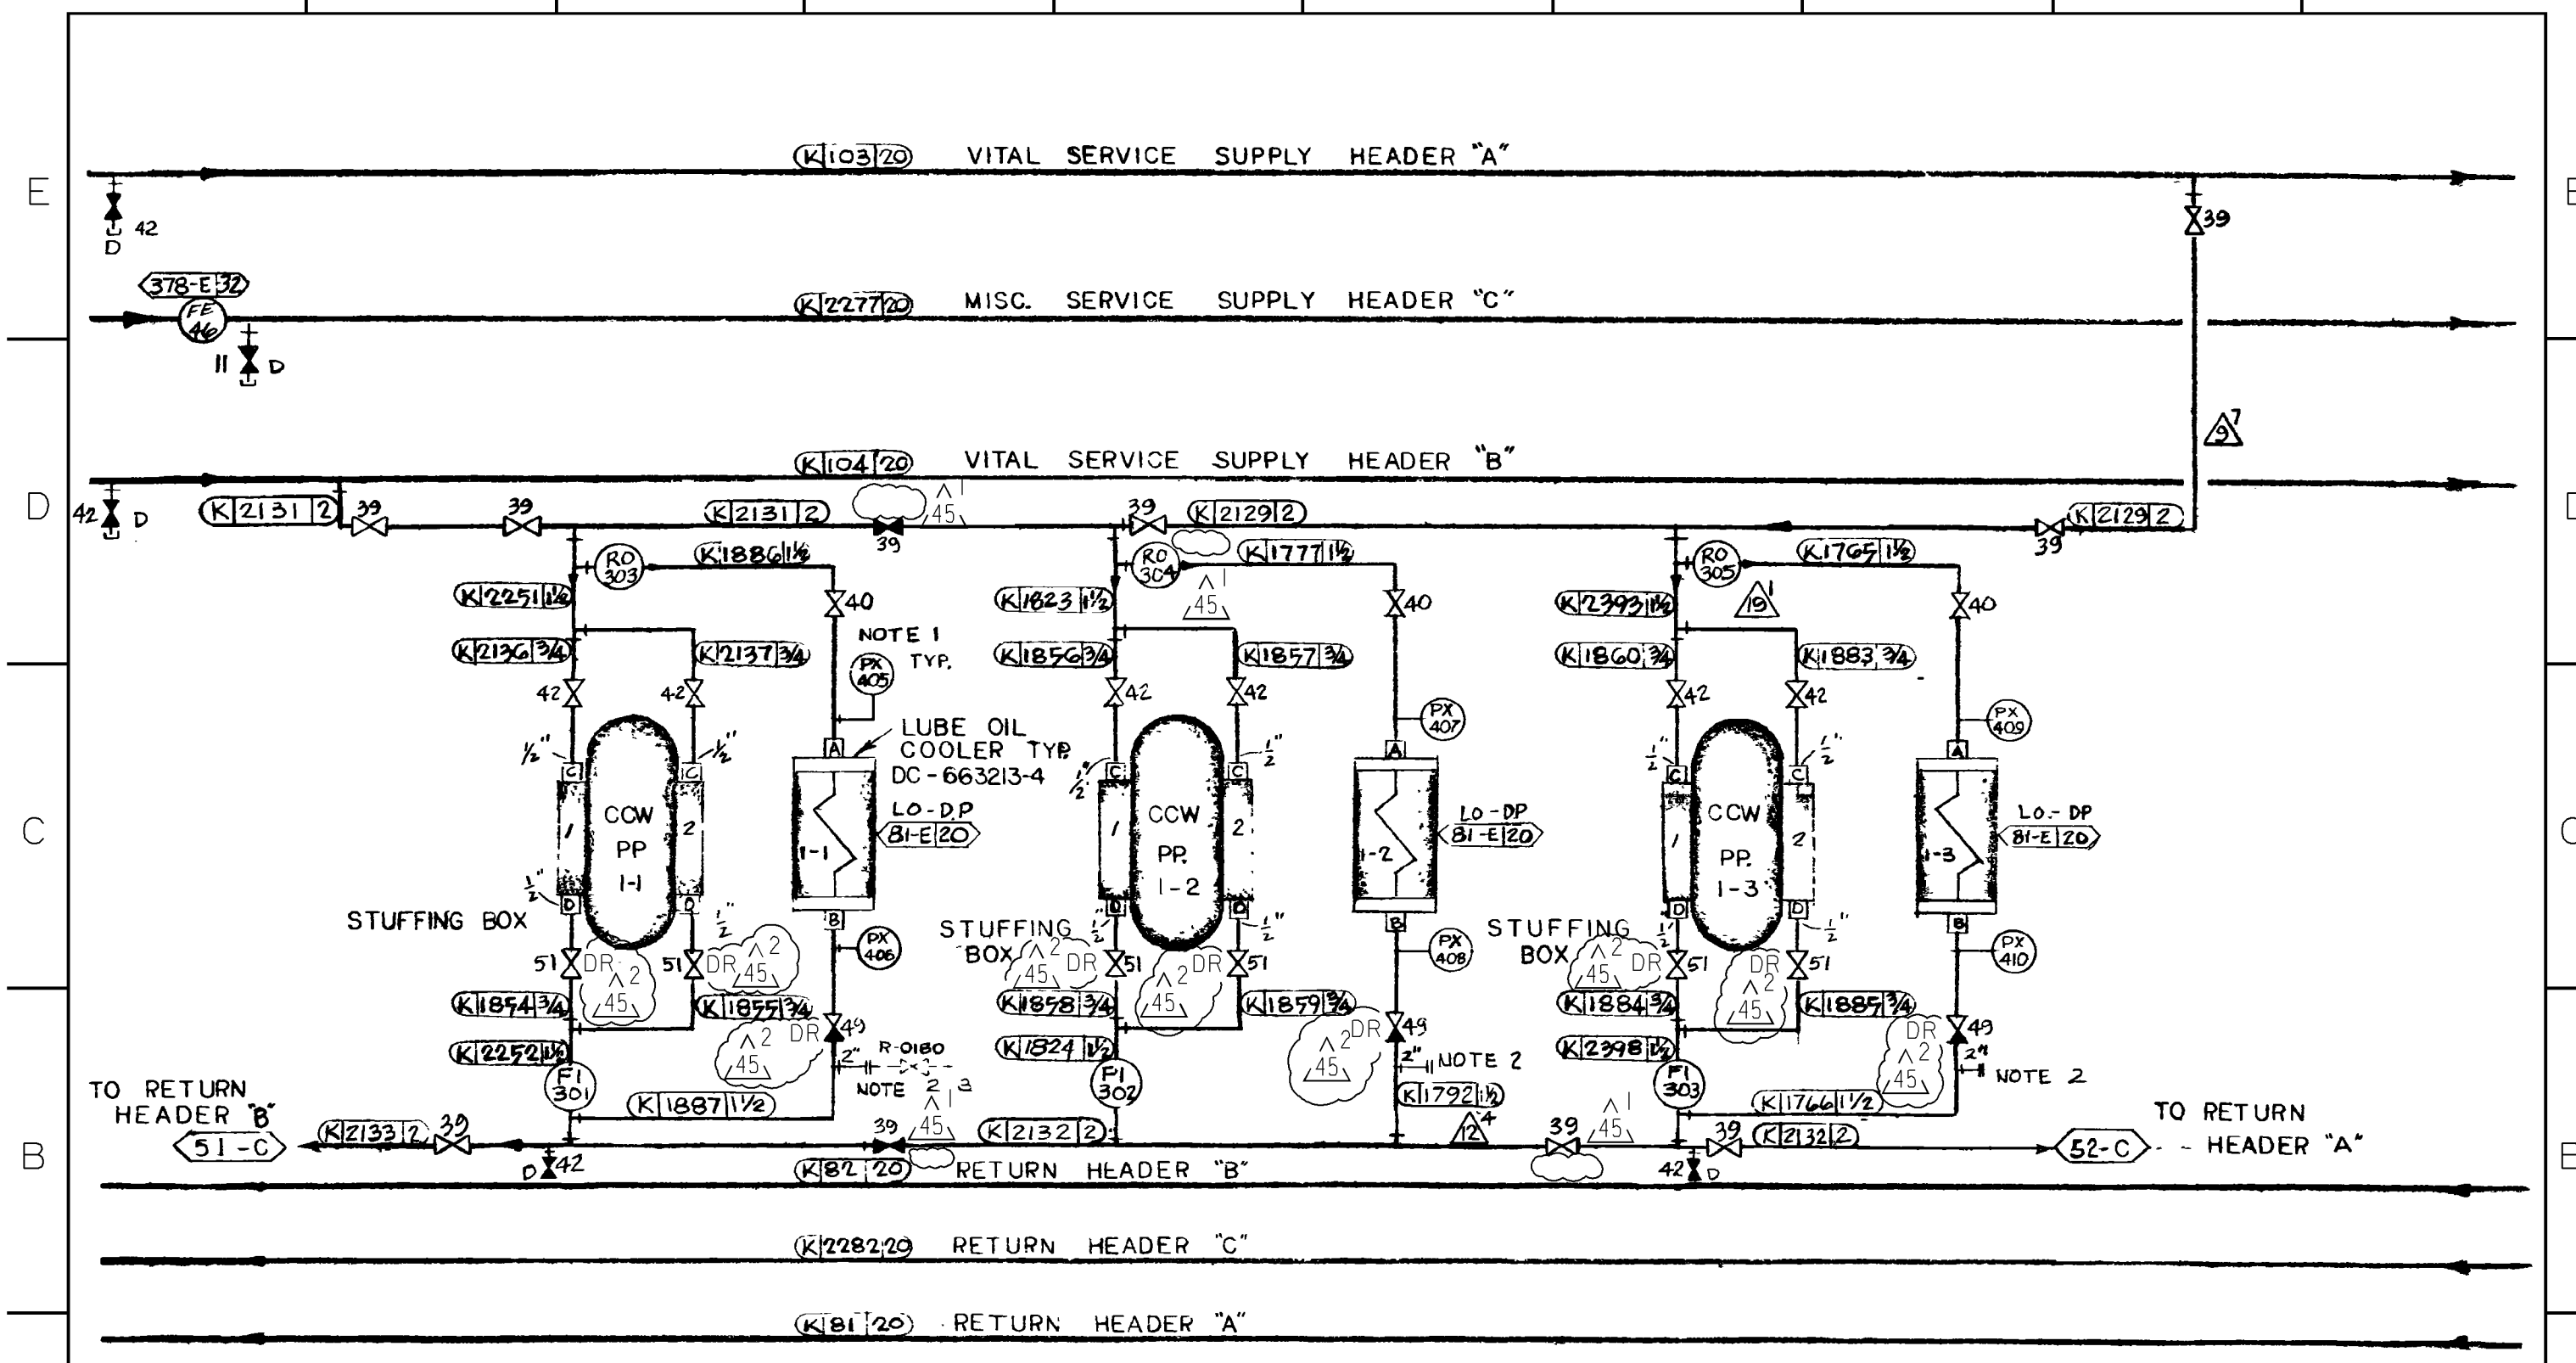

COMPONENT COOLING WATER PUMPS COOLING REQUIREMENTS DC-663213-1

NOTES:

1. PXS TO BE LOCATED WITHIN 1' OF HEAT EXCHANGER (53A-D)
 2. LOCATE FLANGE FOR EASY CONNECTION OF TEMPORARY VALVE AND PRESSURE TEST GAGE. REPLACE WITH BLIND FLANGE AFTER TEST (53A-B)
 3. VALVE IS NON-CLASS I. 2" BALL VALVE WITH 2" FLANGE AT ONE END AND 2" MALE NIPPLE AT OTHER END. ONLY ONE VALVE WILL BE USED AT SEVERAL
- 3.(CONT) TEST POINTS, REMOVE VALVE PRIOR TO OPERATION. SYS IS CLASS I (53A-B)

UNIT-1

P G & E CO.		102014	REV. 45
SHEET 5A	PAGE 0		


CAD User: PMH2 Date: 3-01-2001
 DGN=2014S5A.DGN
 RASTER=2014S5A.TIF

INPGIC

3/1/01	PMH2	FXC2	-	KERSI J. DALAL	MECHANICAL	M 16690	3/31/2004	Revised per FCT 025489
DATE	DWN	RE	IV	PROFESSIONAL ENGINEER	PE DISC.	PE#	PE EXP.	

40 7. THE INSTRUMENT AIR TO FCV-360 AND TCV-27 HAS BEEN ISOLATED, BOTH VALVES ARE FULLY OPEN. 66-B



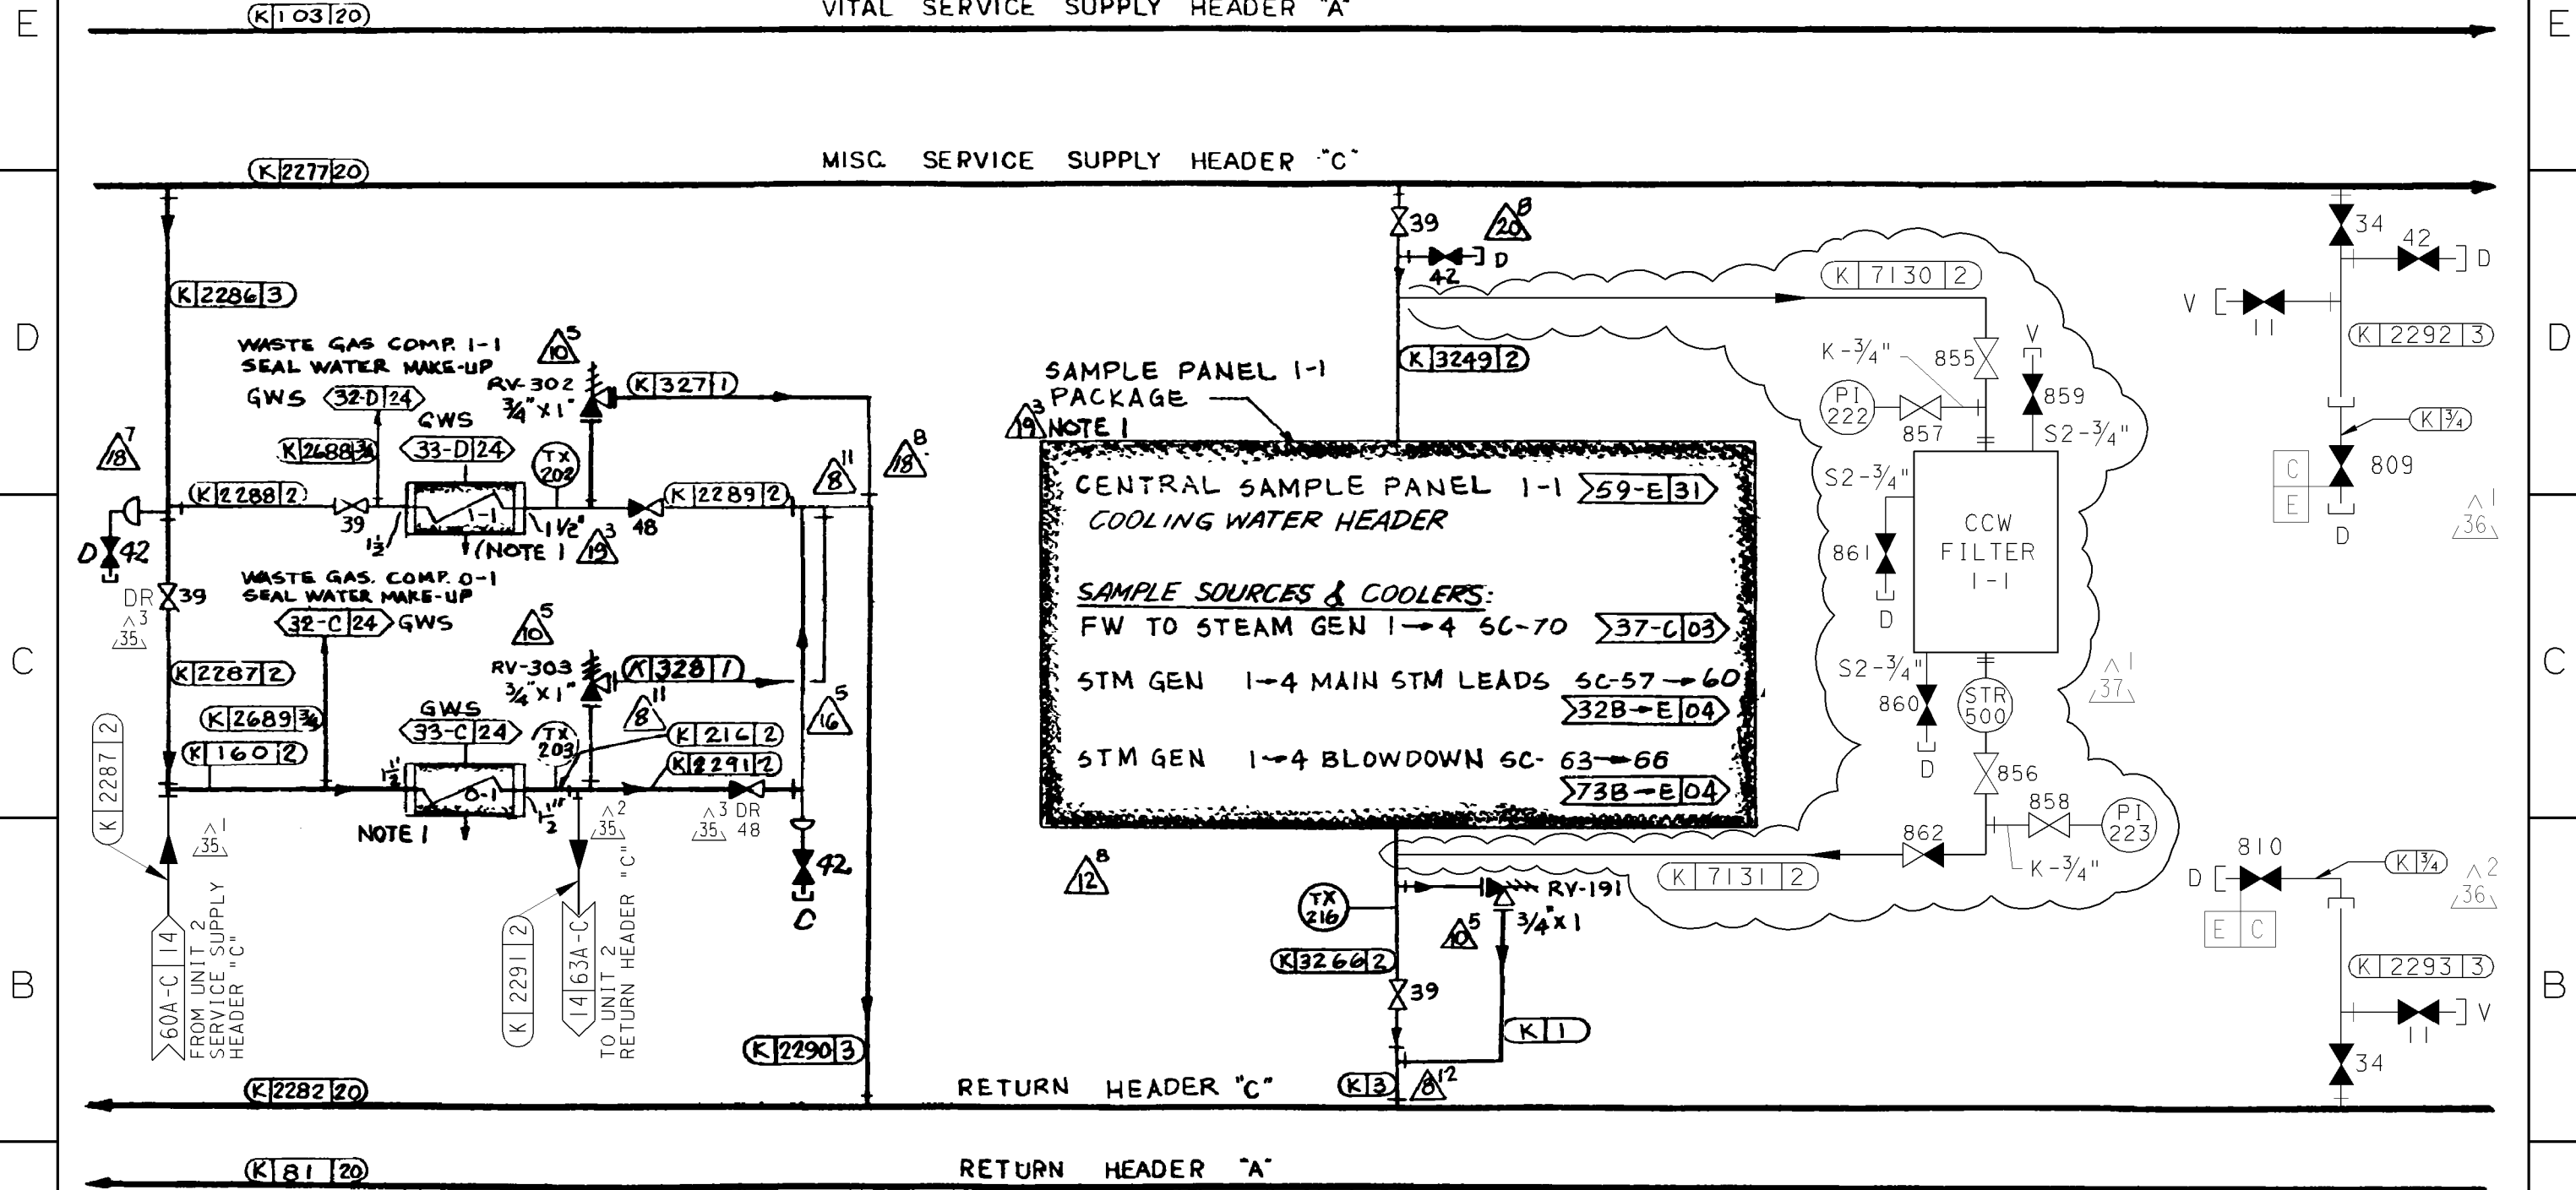

SAMPLE PANEL 1-1 PACKAGE
NOTE 1

CENTRAL SAMPLE PANEL 1-1 59-E/31
COOLING WATER HEADER

SAMPLE SOURCES & COOLERS:
 FW TO STEAM GEN 1-4 SC-70 37-C/03
 STM GEN 1-4 MAIN STM LEADS SC-57-60 32B-E/04
 STM GEN 1-4 BLOWDOWN SC-63-66 73B-E/04

WASTE GAS COMPRESSORS 1-1, 0-1
SEAL WATER COOLERS
 DC-663274-2

CENTRAL SAMPLE PANEL 1-1
COOLERS
 DC-663108-5

UNIT 1

DIABLO CANYON POWER PLANT - PG&E CO.
 COMPONENT COOLING WATER SYSTEM

DRAWING	SHEET	PAGE	REV
102014	6A	0	37

NOTE
 1. WASTE GAS COMPRESSOR SEAL WATER COOLERS & CENTRAL
 SAMPLE PANEL COOLERS ARE DESIGN CLASS II & SEISMICALLY
 ANALYZED IN ACCORDANCE WITH DESIGN CRITERIA
 MEMORANDUM T-10 (FORMERLY M-61) 61A-C/D, 64A-D

HEADER 'C' COMPONENTS

RASTER=2014s6a.dgn
 DGN=2014s6a.dgn
 CAD User: AJFJ Date: 02-25-2010

INPG1C
 1 Size



02-25-2010	AJFJ	Fxc2		KERSI J. DALAL	MECHANICAL	M 16690	3/31/2010	REVISED PER DDN-2*169
DATE	DWN	RE	IV	PROFESSIONAL ENGINEER	PE DISC.	PE#	PE EXP.	

VITAL SERVICE SUPPLY HEADER A

MISC SERVICE SUPPLY HEADER C

OUTSIDE CONTAINMENT
INSIDE CONTAINMENT

CONTAINMENT WALL

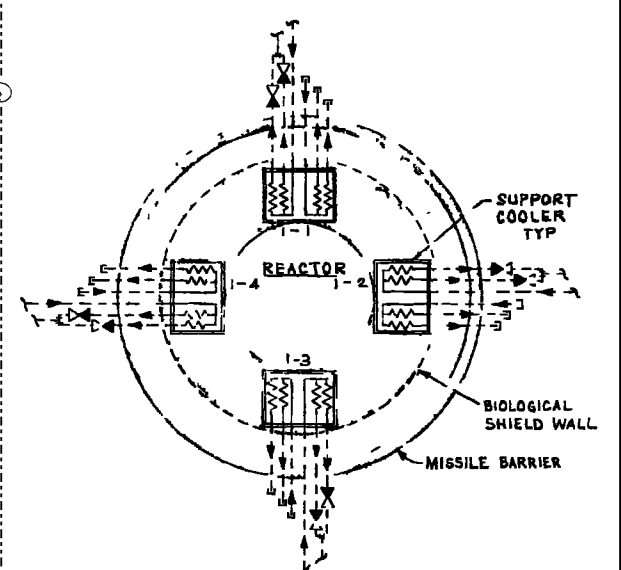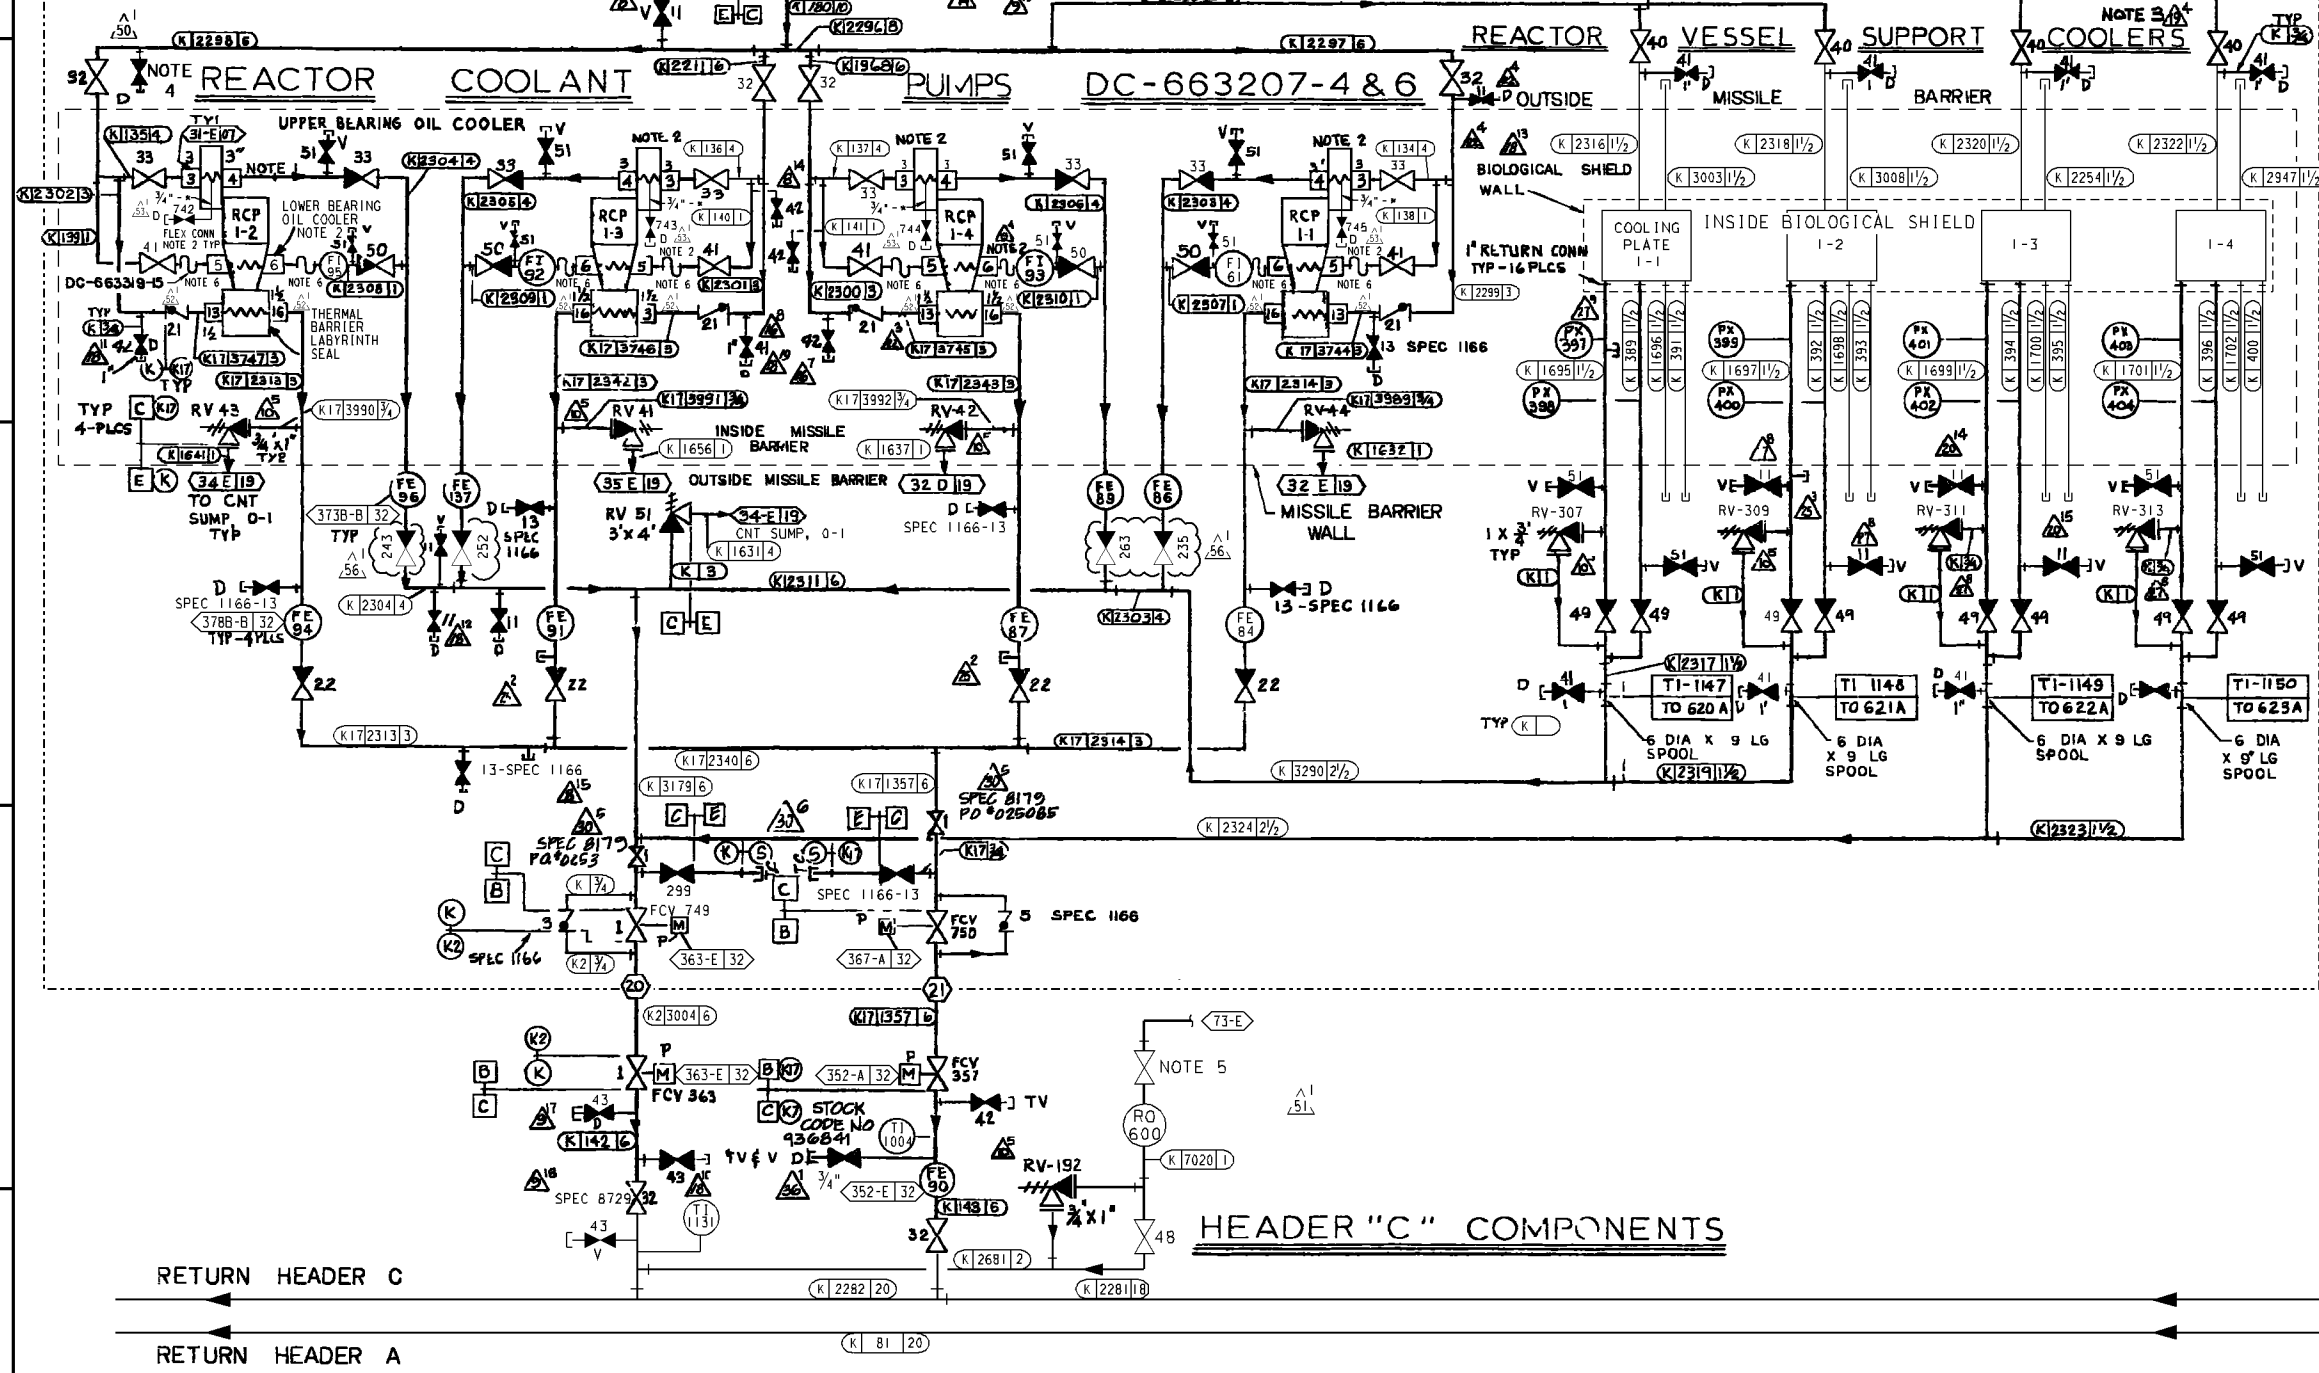

PHYSICAL ARRANGEMENT
OF REACTOR VESSEL SUP-
PORT COOLERS
CONNECT INLETS & OUTLETS
TO SCHEMATIC AT LEFT
REF DWG 500177/436273

NOTES:

1. REACTOR COOLANT PUMP 1-2 HAS SHORT PIPE (K-3) BETWEEN UPPER BEARING OIL COOLER OUTLET NOZZLE NO. 4 AND LINE NUMBER 2304, RCP 1-2 ONLY. (70-D)
2. REACTOR COOLANT PP L.O. COOLERS ARE DESIGN CLASS II & SEISMICALLY ANALYZED BY THE SUPPLIER. (71/74-D)
3. REACTOR VESSEL SUPPORT COOLERS ARE DESIGN CLASS II AND SEISMICALLY ANALYZED PER DESIGN CRITERIA MEMORANDUM T-10 (FORMERLY M-61). (77-B)
4. VALVE, DC-6006473-269, STOCK CODE 93-6846.
5. VALVE, DC-6006473-39, STOCK CODE 93-6842.
6. ISOLATION KIT INSTALLED AT ONE END OF FLEX LINE MIN.

UNIT I

DIABLO CANYON POWER PLANT - PG&E CO. COMPONENT COOLING WATER SYSTEM			
DRAWING	SHEET	PAGE	REV
102014	7	0	56

RASTER=001h1095.DGN
DGN=001h1095.DGN
CAD User: CNHK Date: 08-05-2011

INPG1C
I Size


08-05-2011	CNHK	FxC2		KERSI J. DALAL	MECHANICAL	M 16690	3/31/2012	REVISED PER DFT-7*1279-0
DATE	DWN	RE	IV	PROFESSIONAL ENGINEER	PE DISC.	PE #	PE EXP.	

NOTES CONT'D

- 4. S-D-S - INDICATES LINE COMING OFF PIPE CAP ¹22
- 5. DELETED
- 6. FOR INFO ON VALVES AND COOLER HOT SAMPLE PANEL SEE DC-6016129-1.
- 7. PIPING CODE CLASS E BOUNDARY IS CLASS II (QA CLASS S). ²42
- 8. BLANK PLATE INSTALLED PER "K" SPEC, CODE CLASS C. ⁵³3

NOTES CONT'D

- 2. BORIC ACID EVAP. PKG. COOLERS (EXCEPT SAMPLE COOLER), WASTE CONC. PKG. (EXCEPT SAMPLE COOLER) & NSSS SAMPLE HX. CCW. SIDE ARE DESIGN CLASS II & SEISMICALLY ANALYZED BY THE SUPPLIER ^{81/82-C, 85/86-C, 87/89-C}
- 3. B.A. PKG. SAMPLE COOLER (SC 47), AUX. STM. DRAIN REC. VENT COND & WASTE CONC. PKG. SAMPLE COOLER (SC 48) ARE DESIGN CLASS II & SEISMICALLY ANALYZED PER DESIGN CRITERIA MEMORANDUM T-10 (FORMERLY M-61) ^{82/84-C, 86-C}

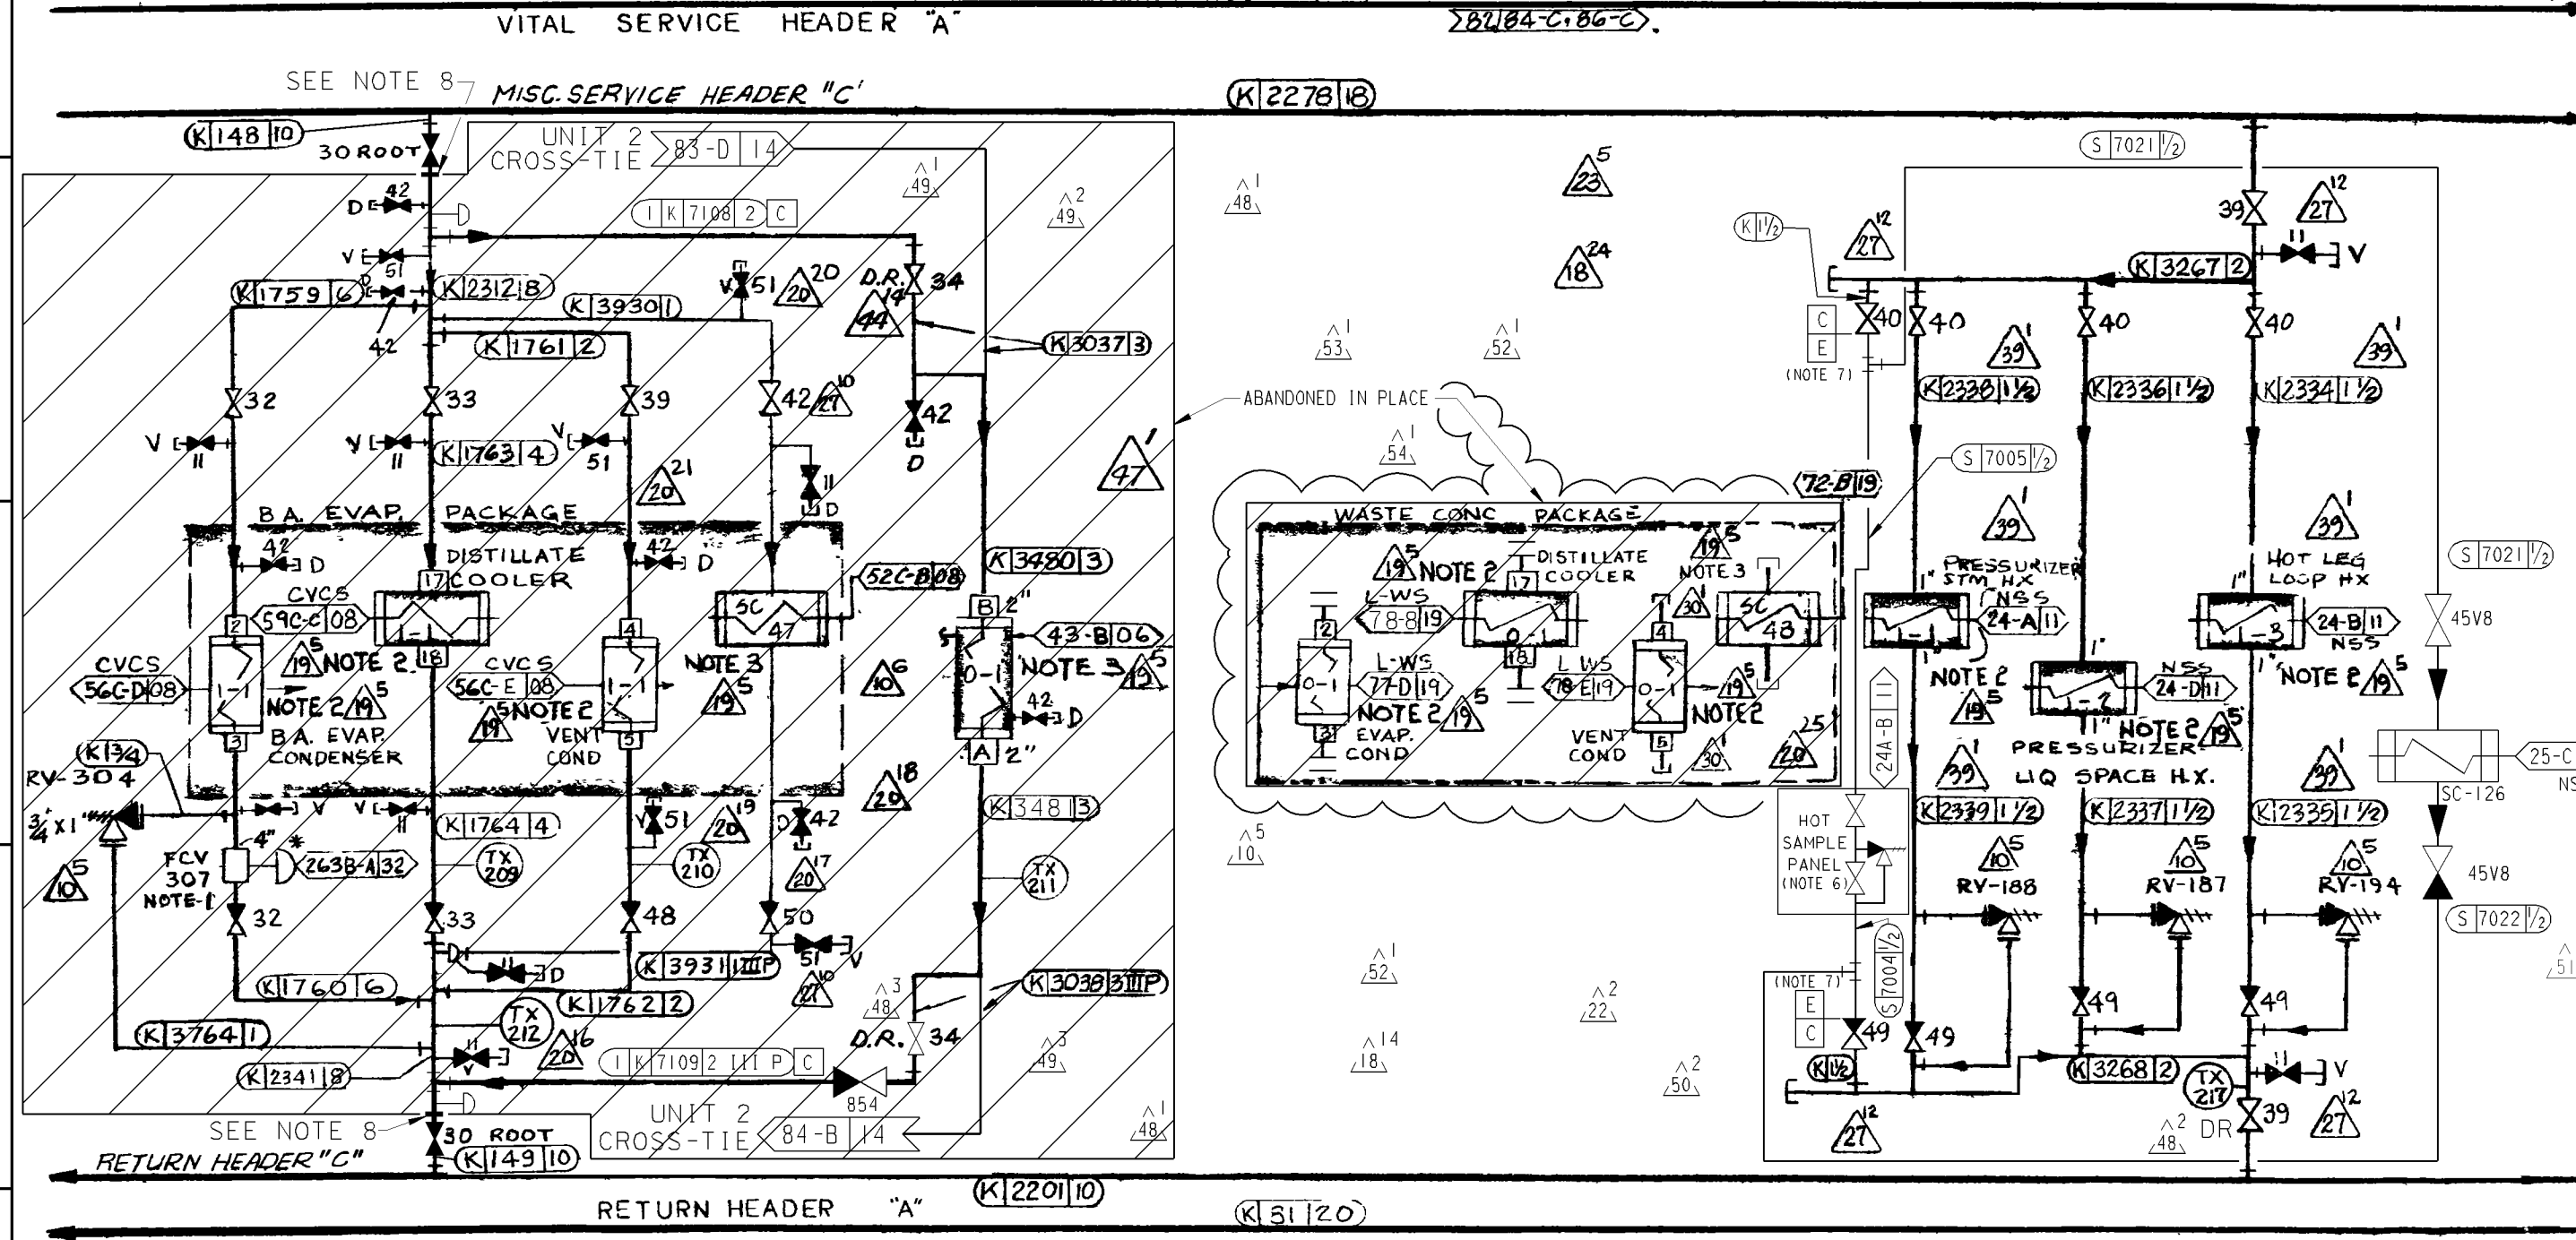

NOTES:
1. VALVE PLACES OUTSIDE EVAPORATION AREA DUE TO HIGH RADIATION LEVEL. ^{80-B}
-CONT. AT TOP RIGHT-


HEADER "C" COMPONENTS

DIABLO CANYON POWER PLANT - PG&E CO. COMPONENT COOLING WATER SYSTEM			
DRAWING	SHEET	PAGE	REV
102014	8	0	54

08-08-2011	CNHK	FxC2		KERSI J. DALAL	MECHANICAL	M 16690	3/31/2012	REVISED PER DFT-7*1279-0
DATE	DWN	RE	IV	PROFESSIONAL ENGINEER	PE DISC.	PE#	PE EXP.	

RASTER=2014s8.dgn
DGN=2014s8.dgn
CAD User: CNHK
Date: 08-08-2011

NOTES: 1. ST. GEN. BLOWDOWN SAMPLE COOLERS & COND. FOR SGBD TK VENT SAMPLE ARE DESIGN CLASS II & SEISMICALLY ANALYZED PER DESIGN CRITERIA MEMORANDUM T-10 (FORMERLY M-61) ⁴¹ 46 49 59 2. DELETED 3. CODE CLASS E PORTIONS OF LINES 4172 & 4173 SHALL BE SEISMICALLY ANALYZED TO DESIGN CLASS I CRITERIA. ^{95-B,D} 4. S/C 93-5909, DWG 6006473-8. ^{92-B} 5. S/C 94-3774, DWG 6006473-141. ^{92-B} 6. S/C 93-6841, DWG 6006473-166. ^{93-B} 7. SOLID PLATE INSTALLED BETWEEN FLANGES TO DIVERT FLOW THROUGH TCV-130. 8. VALVE WAS ORIGINALLY PURCHASED AS TCV-130 AND IS NOW REDESIGNATED AS CCW-1-786 AS A MANUAL VALVE. ⁵⁷

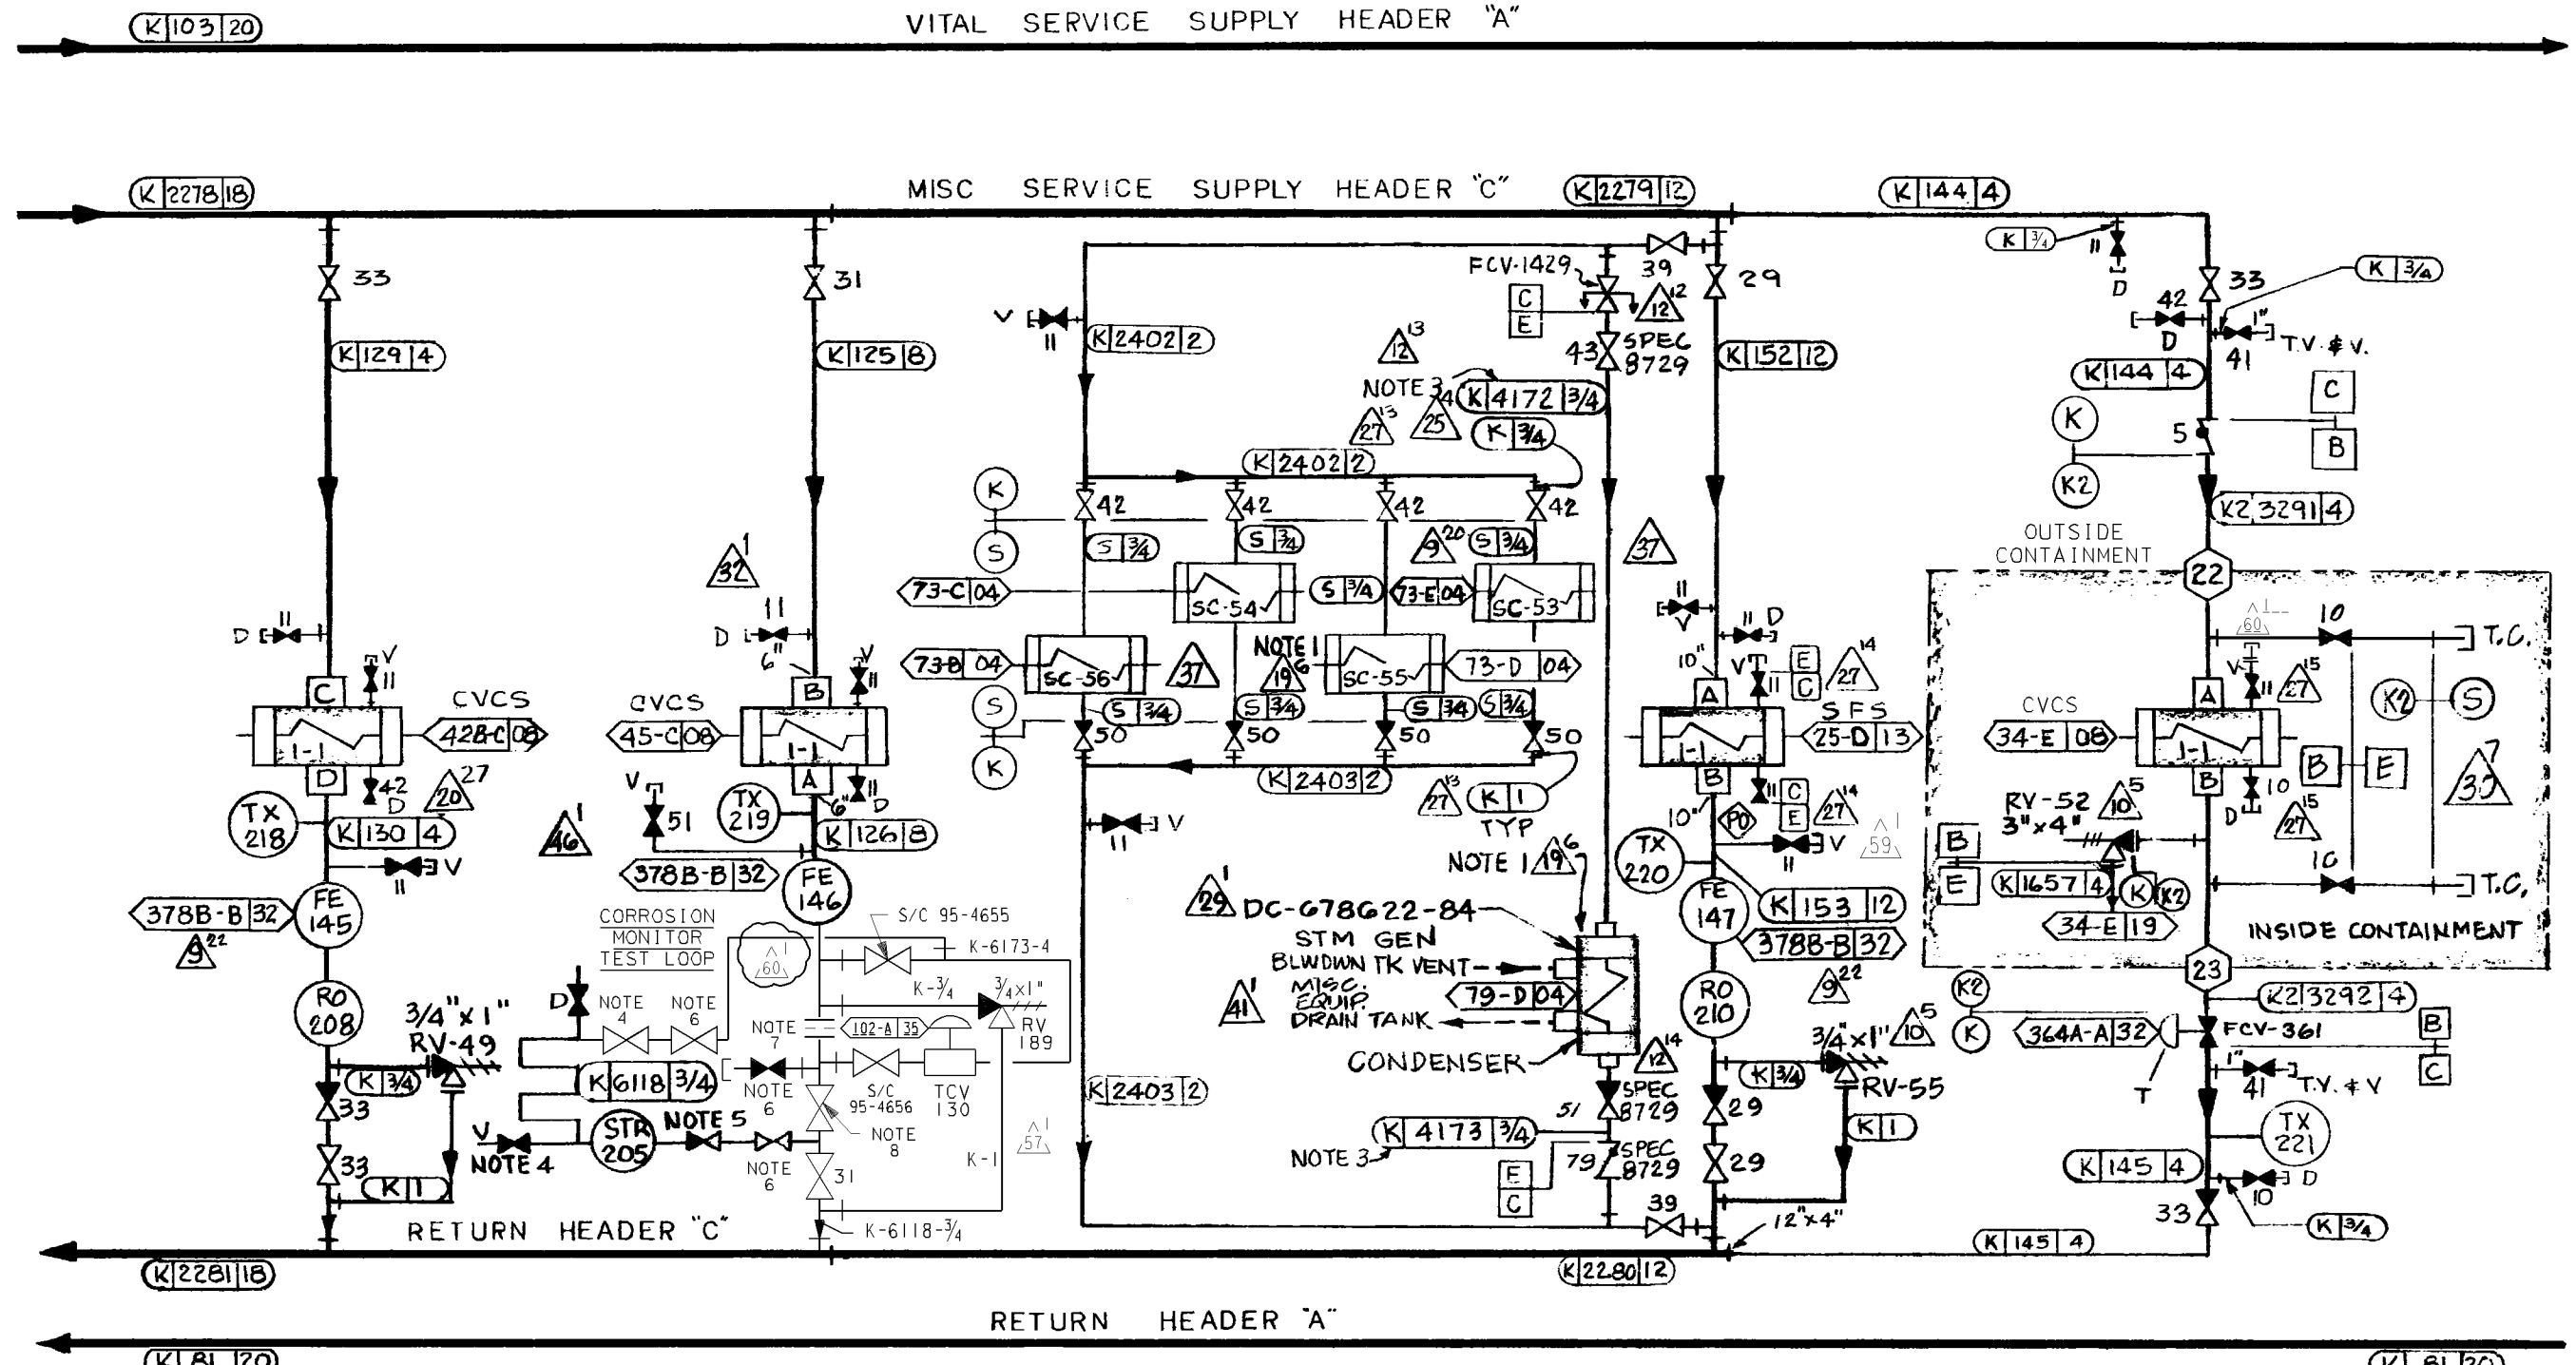

RASTER=001hl093.dgn
DGN=001hl093.dgn
CAD User: JBMX Date: 04-25-2012


NOTES CONT: 7. CODE CLASS E PORTION OF LINE 4145 SHALL BE SEISMICALLY ANALYZED TO DESIGN CLASS I CRITERIA (102-E)

8. DRAIN W/ QUICK-DISCONNECT COUPLING W/ INTEGRAL CHECK VALVE FOR EMERGENCY TIE-IN TO FIRE PROTECTION SYSTEM (102018-5A). COUPLING TO BE REMOVED WHEN DRAINING IS REQUIRED.

9. DRAIN W/ QUICK-DISCONNECT COUPLING W/ INTEGRAL CHECK VALVE. DRAIN HOSE TO BE ATTACHED FOR ROUTING FLOW TO FLOOR DRAINS WHEN FPS TIE-IN (NOTE 8) IS OPERATIONAL COUPLING TO BE REMOVED WHEN DRAINING IS REQUIRED.

10. THE INSTRUMENT AIR TO FCV-366 AND TCV-28 HAS BEEN ISOLATED BOTH VALVES ARE FULLY OPEN. (106-B)

11. VALVE - SP 99-6959 (105-C)

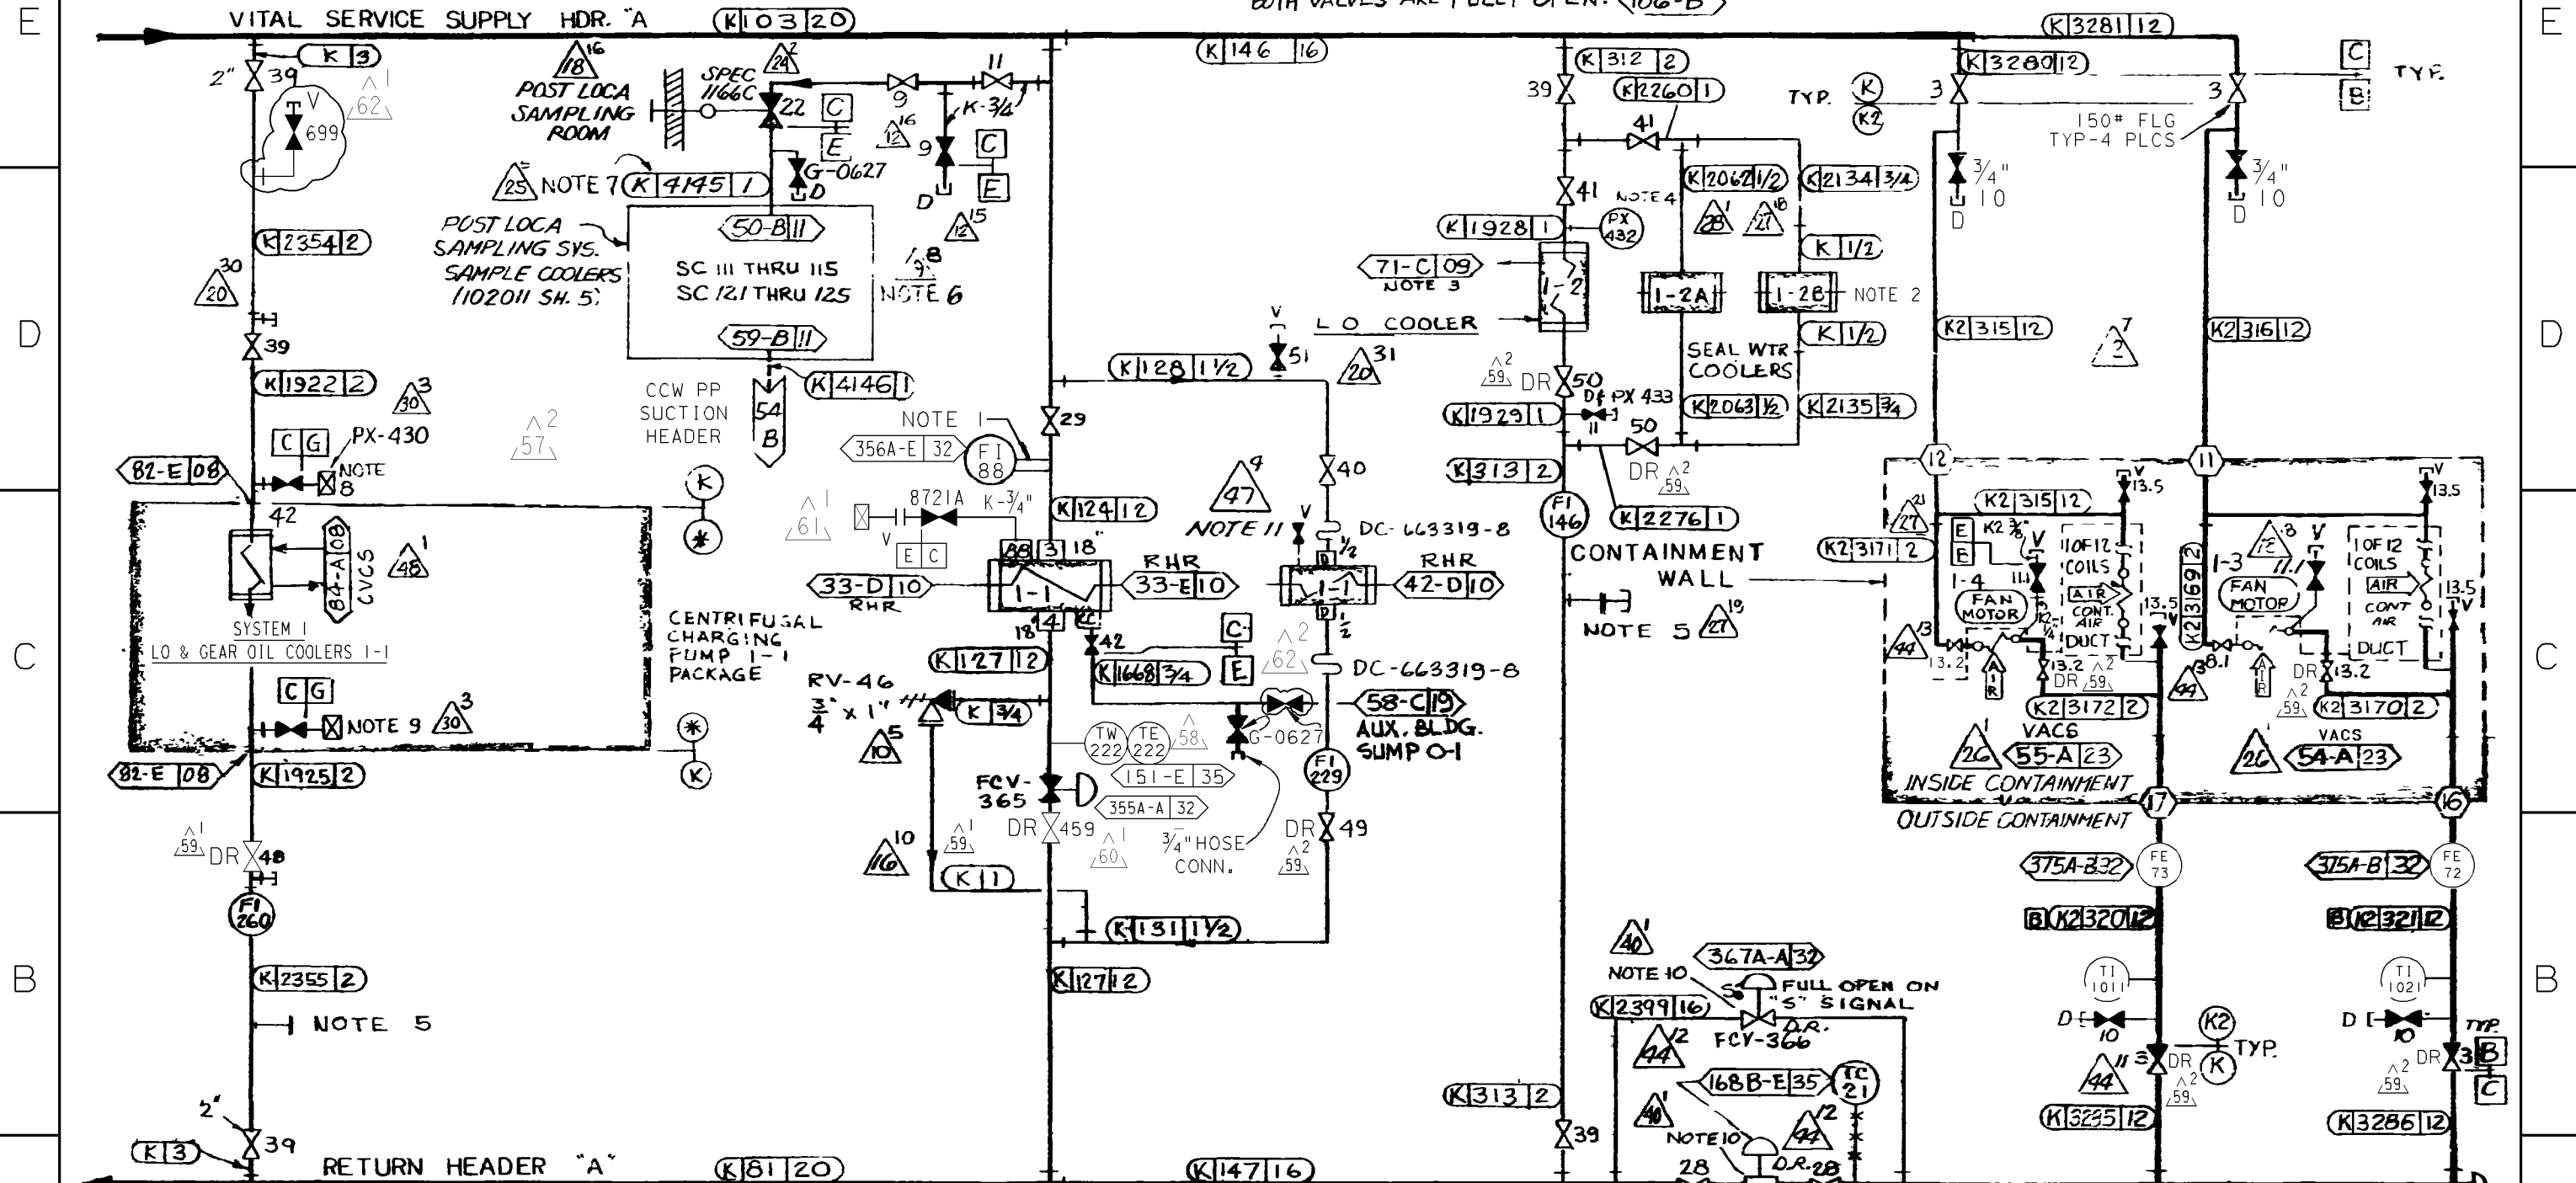

NOTES:

1. ELBOW TAPS FOR FLOW INDICATION (104-D)
2. REFER TO SIS PP SEAL FLUSH SYSTEM DIAGRAM, PG&E RECORD NO DC-663216-27 (107-D)
3. REFER TO SIS PP LUBE OIL COOLER SYSTEM MFR. DWG, PG&E RECORD NO DC-663216-26 (105-D)

4. PX'S TO BE LOCATED WITHIN 1' OF H.X. (106-E)
5. 2" BLIND FLANGE SEE NOTES 2 & 3 SH.5A (100-B)
6. POST LOCA SAMPLE COOLERS ARE DESIGN CLASS II SEISMICALLY ANALYZED PER DESIGN CRITERIA MEMORANDUM M-45 (103-D)

(SEE COORD 100-E FOR NOTES CONT.)

HEADER "A" COMPONENTS

UNIT 1

DIABLO CANYON POWER PLANT - PG&E CO.
COMPONENT COOLING WATER SYSTEM

DRAWING	SHEET	PAGE	REV
102014	10	0	62

RASTER=erul7616.dgn
DGN=erul7616.dgn
CAD User: JBMX Date: 04-25-2012

INPGIC
1 Size

04-25-2012	JBMX	Fxc2		KERSI J. DALAL	MECHANICAL	M 16690	3/31/2014	REVISED PER DFT-7*1526
DATE	DWN	RE	IV	PROFESSIONAL ENGINEER	PE DISC.	PE#	PE EXP.	

RASTER=2015s3.dgn
DGN=2015s3.dgn
CAD User: JBMX

Date: 10-06-2010

A

B

C

D

E


A

B

C

D

E

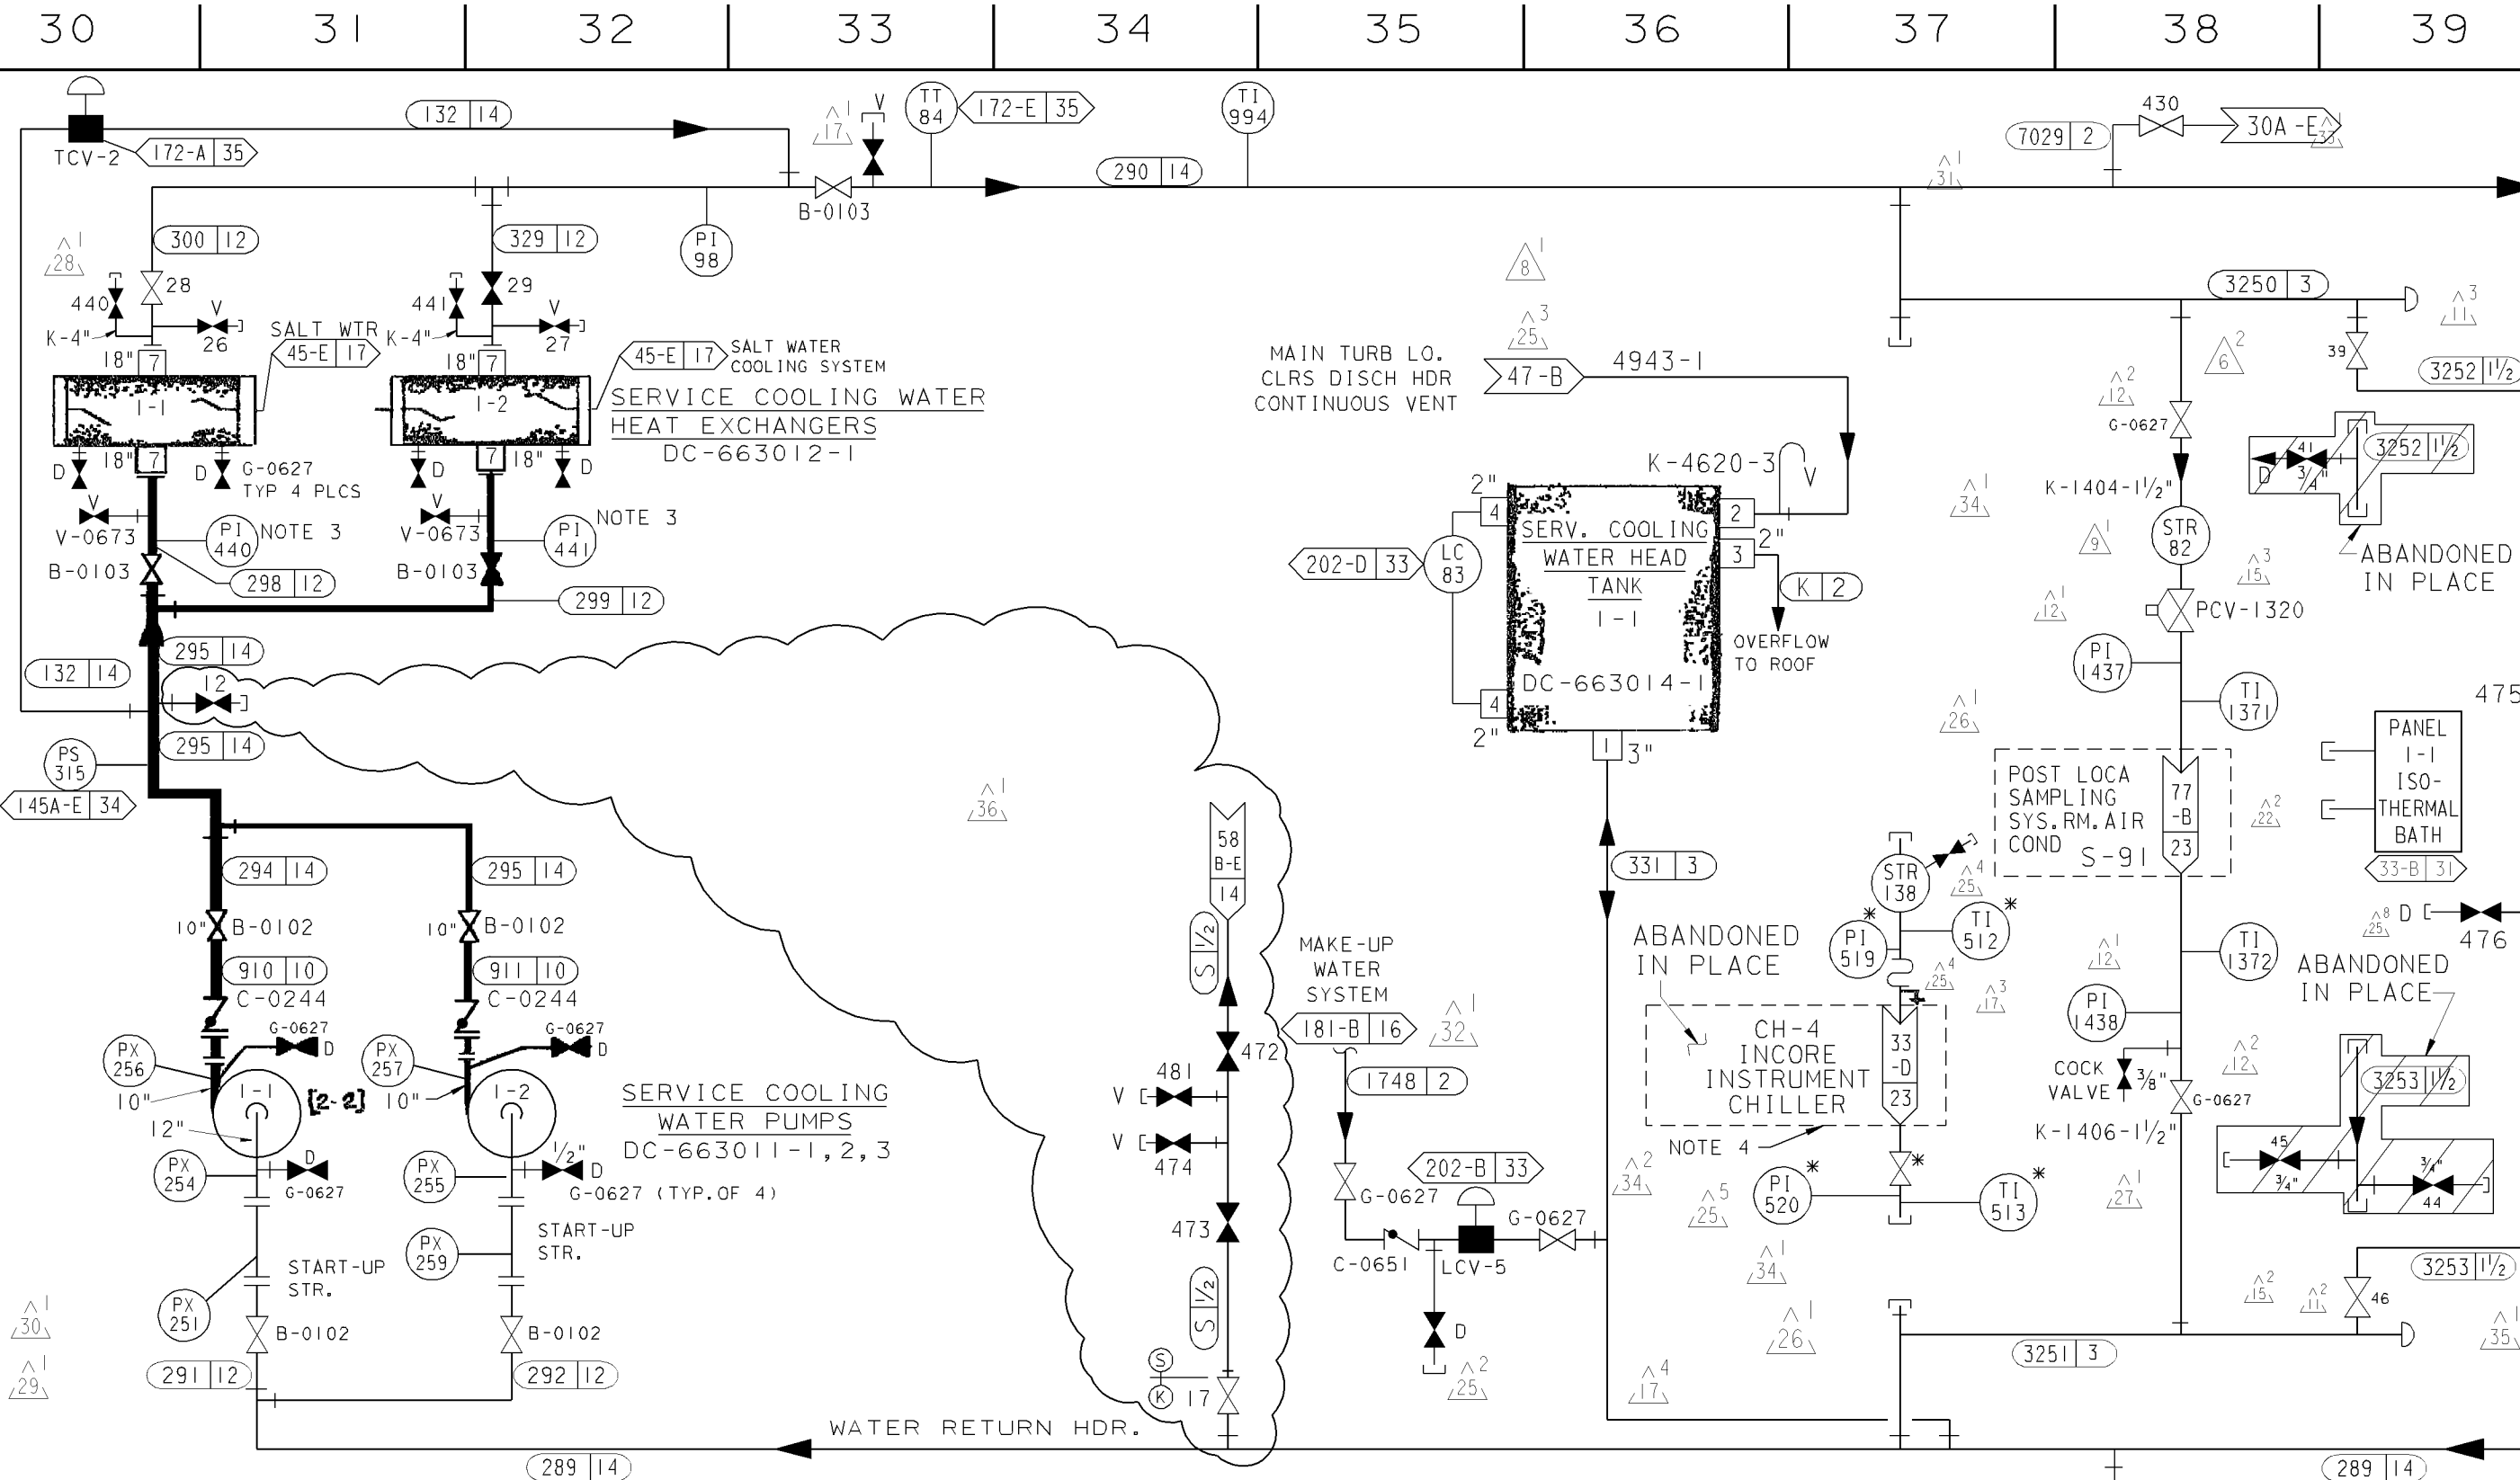

NOTES:

1. ALL PIPING ON THIS DWG SHALL BE "K" SPEC., PG&E CLASS "E"
2. ALL DRAIN AND VENT VALVES, DESIGNATED "D" & "V", ARE $\frac{3}{4}$ ".
3. INSTALL PI NEXT TO INLET VALVE IN ORDER TO MONITOR PLACING HX IN SERVICE. (31-D)
4. CH-4 INCORE INSTRUMENT CHILLER AND ASSOCIATED COMPONENTS ARE ABANDONED IN PLACE.


UNIT 1

DIABLO CANYON POWER PLANT - PG&E CO.
SERVICE COOLING WATER SYSTEM


DRAWING	SHEET	PAGE	REV
102015	3	0	36

INPG1C
1 Size

10-06-2010	JBMX	Fxc2		KERSI J. DALAL	MECHANICAL	M 16690	3/31/2012	REVISED PER DDN-2*156 AND DFC-3*983
DATE	DWN	RE	IV	PROFESSIONAL ENGINEER	PE DISC.	PE#	PE EXP.	

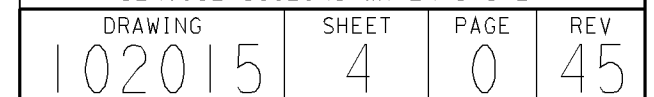


10-02-2007	FAZI	FxC2		KERSI J. DALAL	MECHANICAL	M 16690	3/31/2008	REVISED PER FCT-32897
DATE	DWN	RE	IV	PROFESSIONAL ENGINEER	PE DISC.	PE#	PE EXP.	

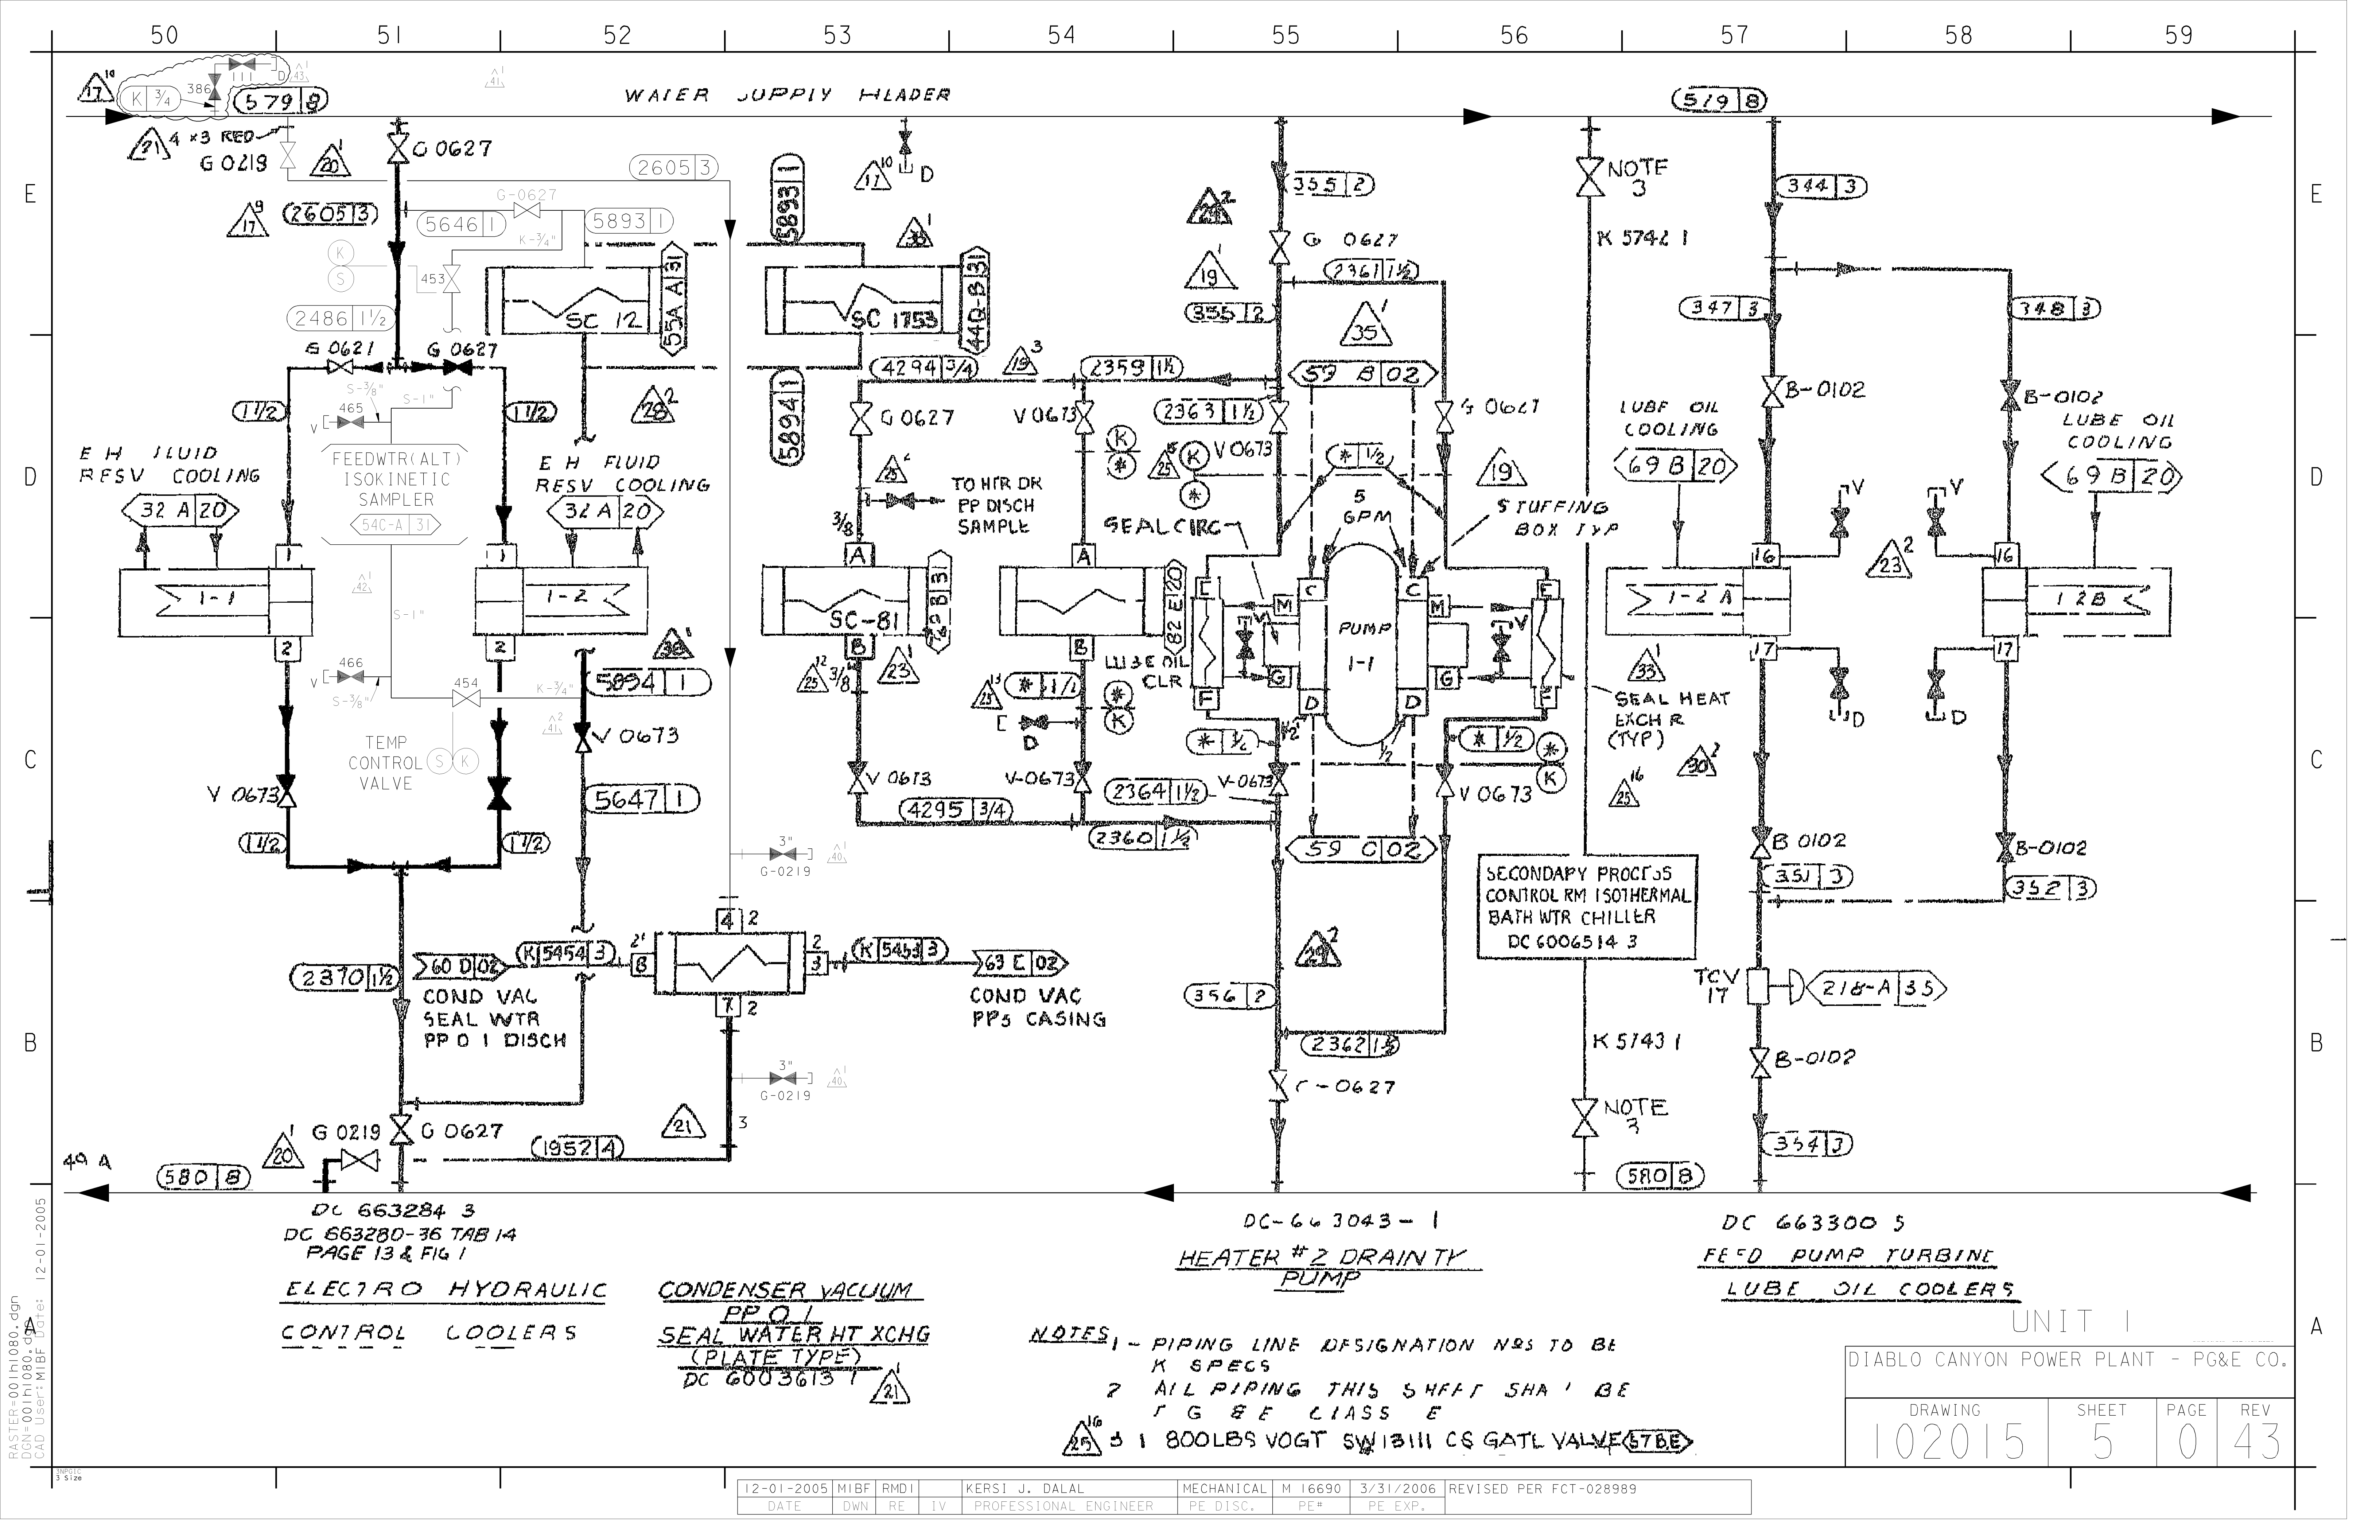

60 61 62 63 64 65 66 67 68 69

579 B WATER SUPPLY HEADER 579 B

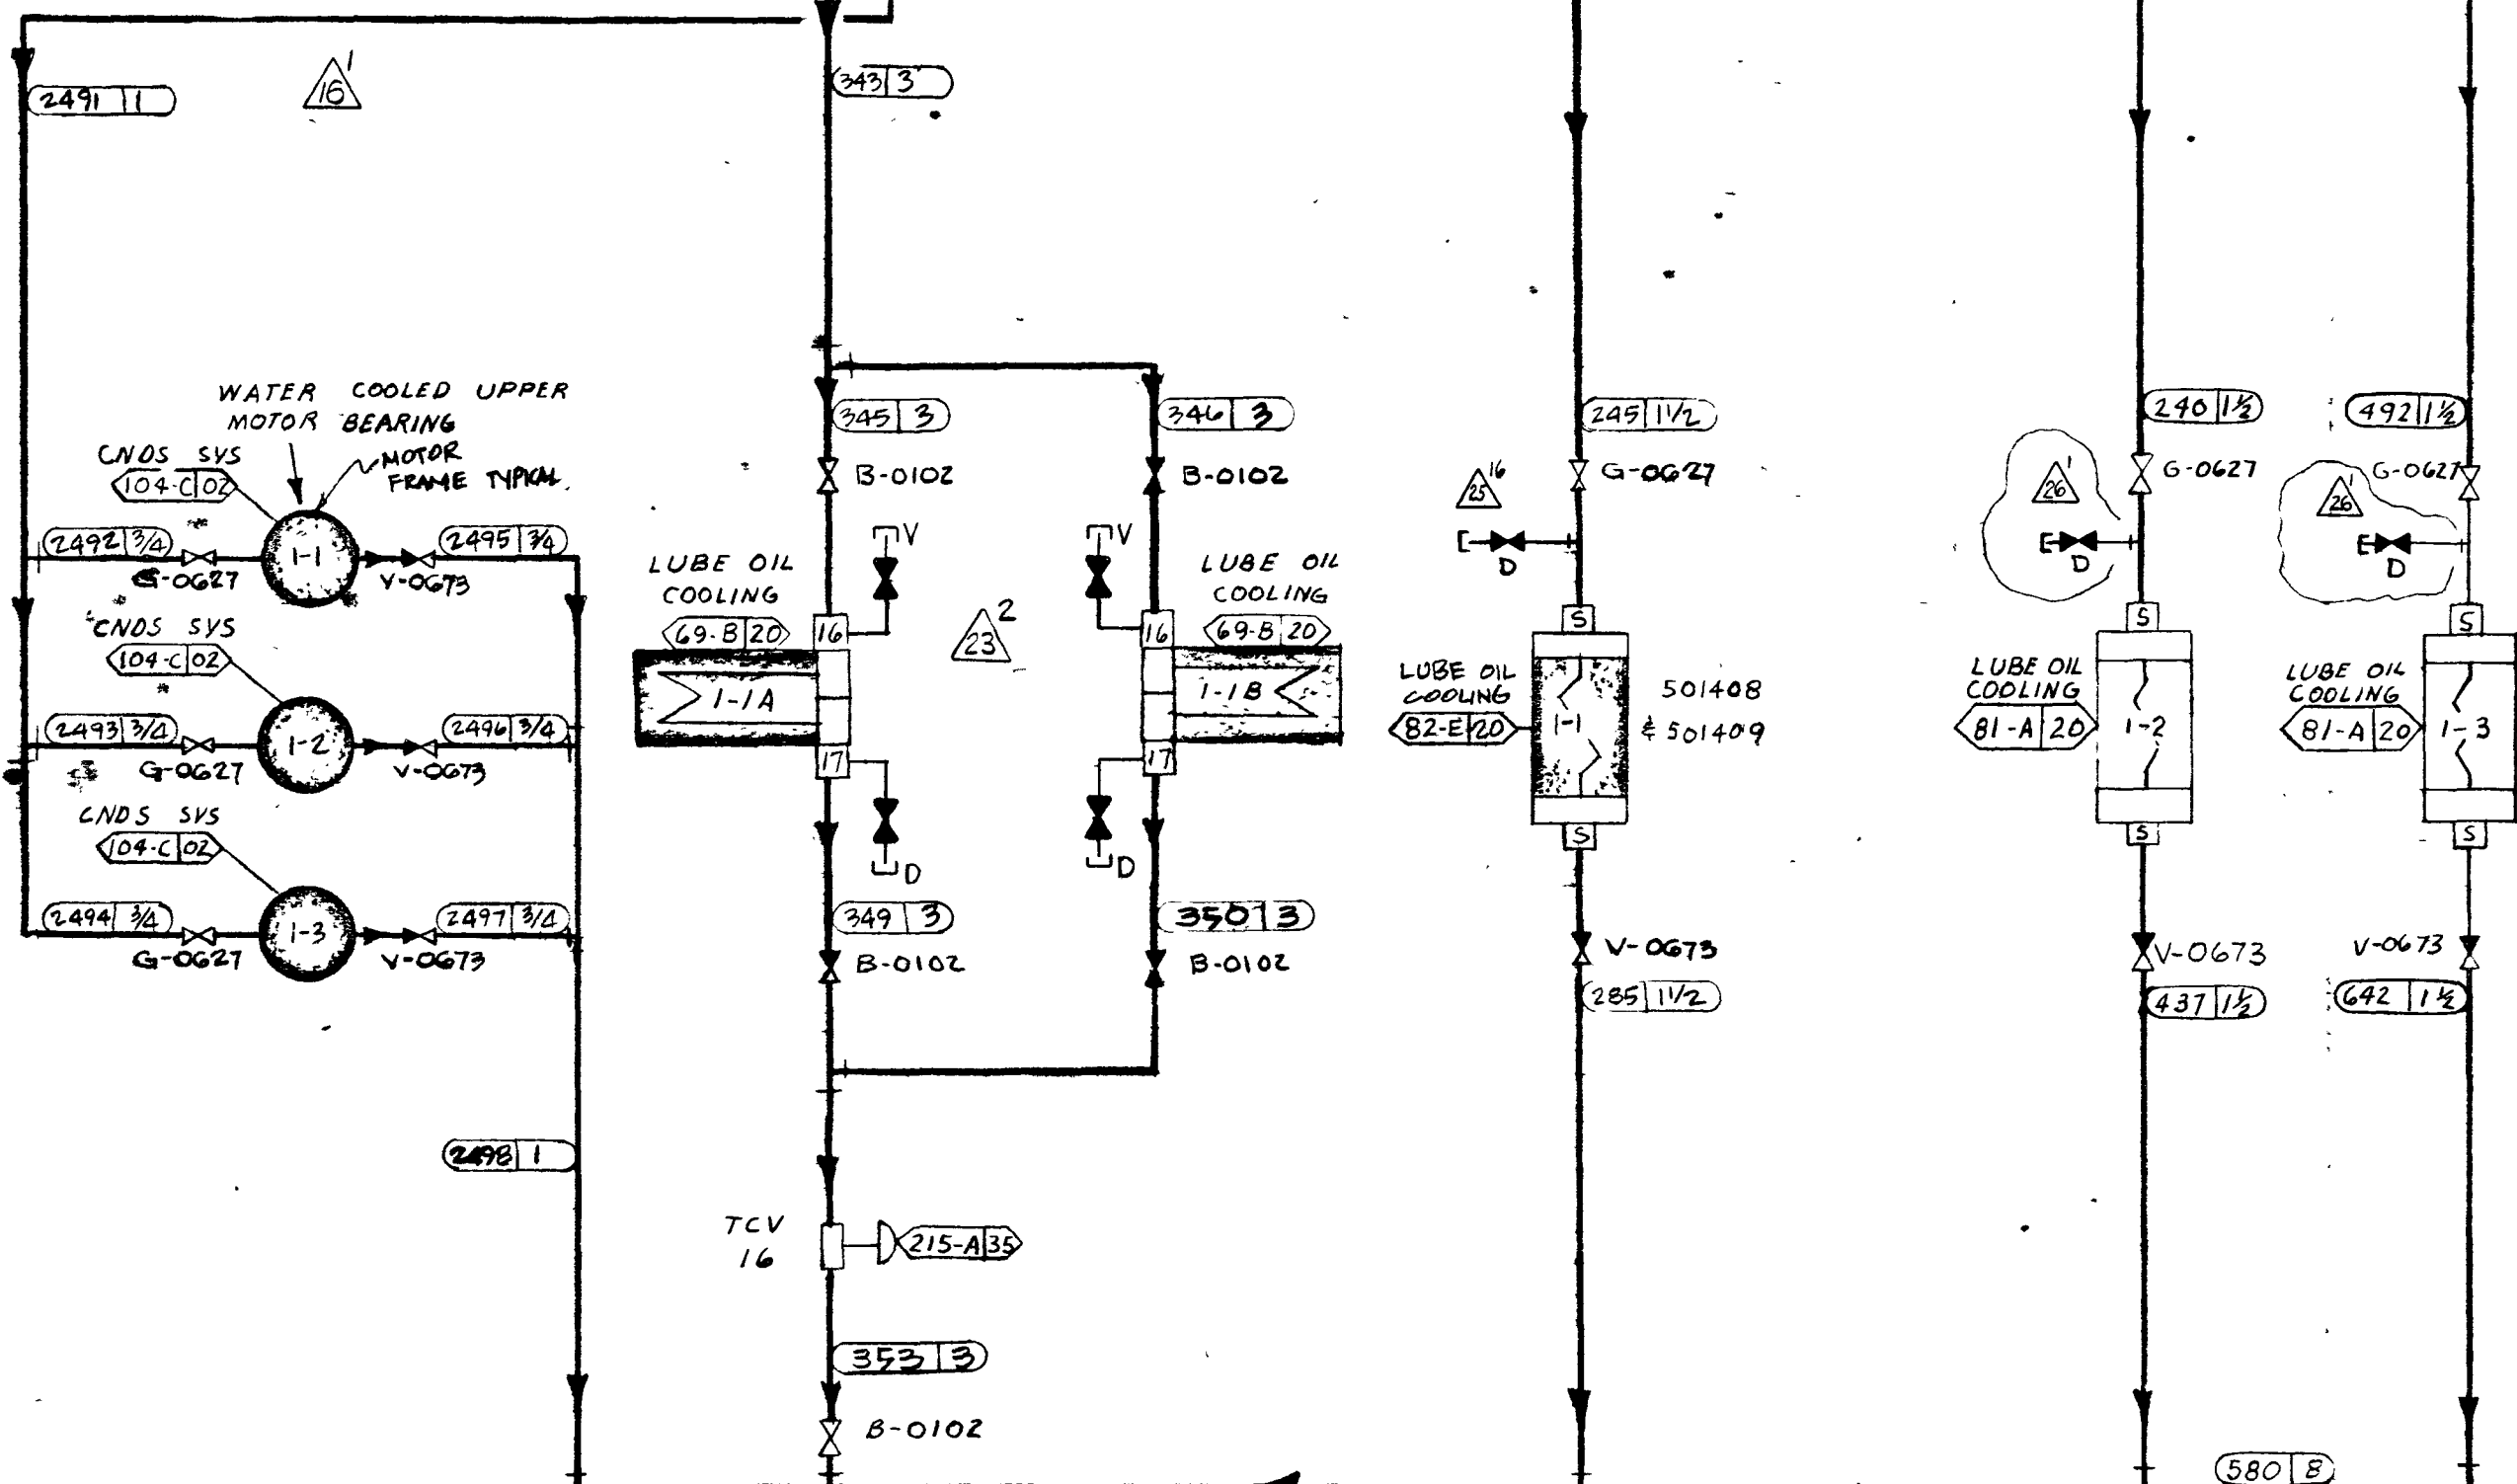

PL-663045-2
CONDENSATE PUMP MOTOR
UPPER BEARING

PL-663300-5
FEED PUMP TURBINE
LUBE OIL COOLERS

DC-663046-1,3
CONDENSATE BOOSTER PPS
LUBE OIL SUPPLY
UNIT - 1

NOTES

1. PIPING LINE DESIGNATION NEG. TO BE "K" SPECS.
2. ALL PIPING THIS SHEET SHALL BE P G & E CLASS "E".

P.G.&E.CO.	SHEET NO 6 OF	SHEETS
	DRAWING NUMBER	CHANGE
102015		26

RM INDEXED REV. 26


SCAN 26 10

35 M/M Neg.

96 65

35 M/M NEG

922

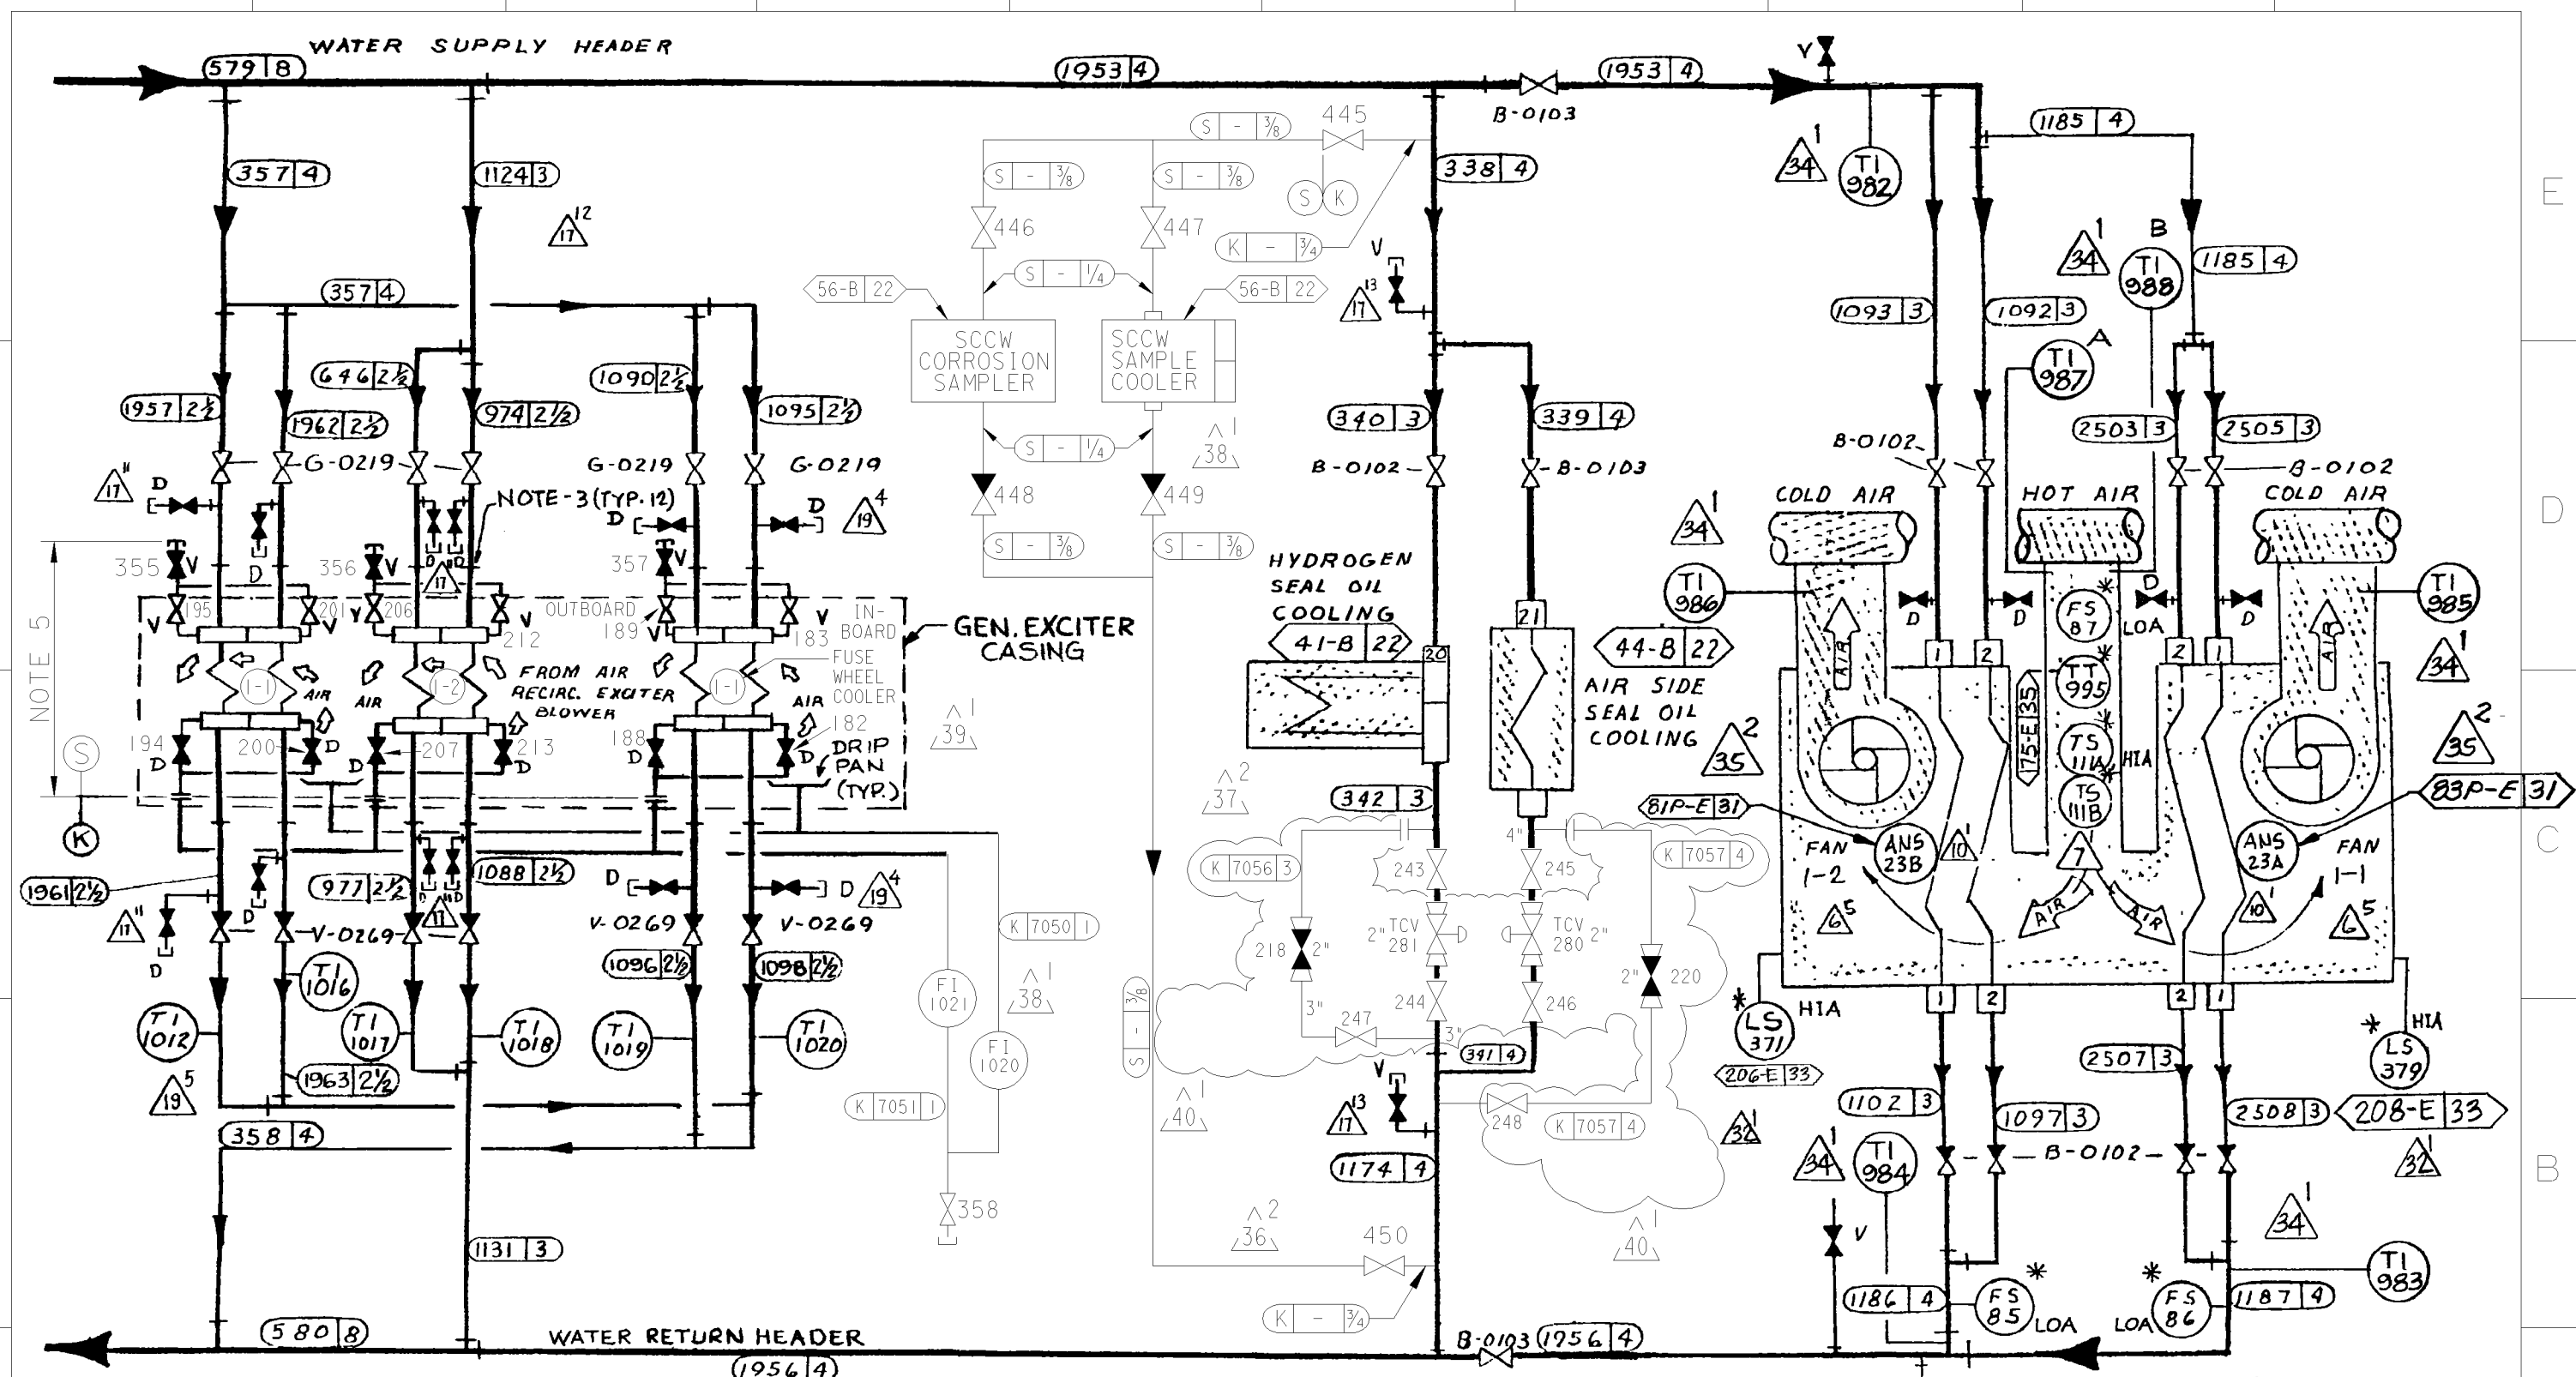

DC-663293-1
GENERATOR EXCITER
2 COILS PER COOLER

DC-663293-1
FUSE WHEEL
2 COILS PER COOLER

DC-663282-11
GENERATOR SEAL OIL
COOLERS

DC-663326-22 AND -57
ISO-PHASE BUS

COOLERS
2 COILS PER COOLER
DIABLO CANYON POWER PLANT - PG&E CO.
SERVICE COOLING WATER SYSTEM

NOTES:
1. PIPING LINE DESIGNATION NO'S TO BE "K" SPEC.
2. ALL PIPING THIS SHEET SHALL BE PG&E. CLASS "E".
3. "VICTAULIC" TYPE COUPLING. TYP OF 12. SEE DC 663293-1 (71-D)

4. CORROSION MONITOR/SAMPLER IS CHEMISTRY CONTROLLED AND MAY BE REMOVED AND REINSTALLED AS NEEDED.
5. SS TUBING FOR COOLER VENTS AND DRAINS BY PG&E. SEE N-MOD A0726979.

UNIT 1

DRAWING	SHEET	PAGE	REV
102015	7	0	40

RASTER=102015s7.dgn
DGN=102015s7.dgn
CAD User: Date:2009-03-25

2009-03-25	AJFJ	FxC2		KERSI J. DALAL	MECHANICAL	M 16690	3/31/2010	REVISED PER DDN-2*209-00
DATE	DWN	RE	IV	PROFESSIONAL ENGINEER	PE DISC.	PE#	PE EXP.	DFC-3*319-00, & DFC-3*383-01

RASTER=2016sl.dgn
DGN=2016sl.dgn
CAD User: JBMX Date: 11-01-2010

E


D

C

B

A

BASIC DIAGRAM

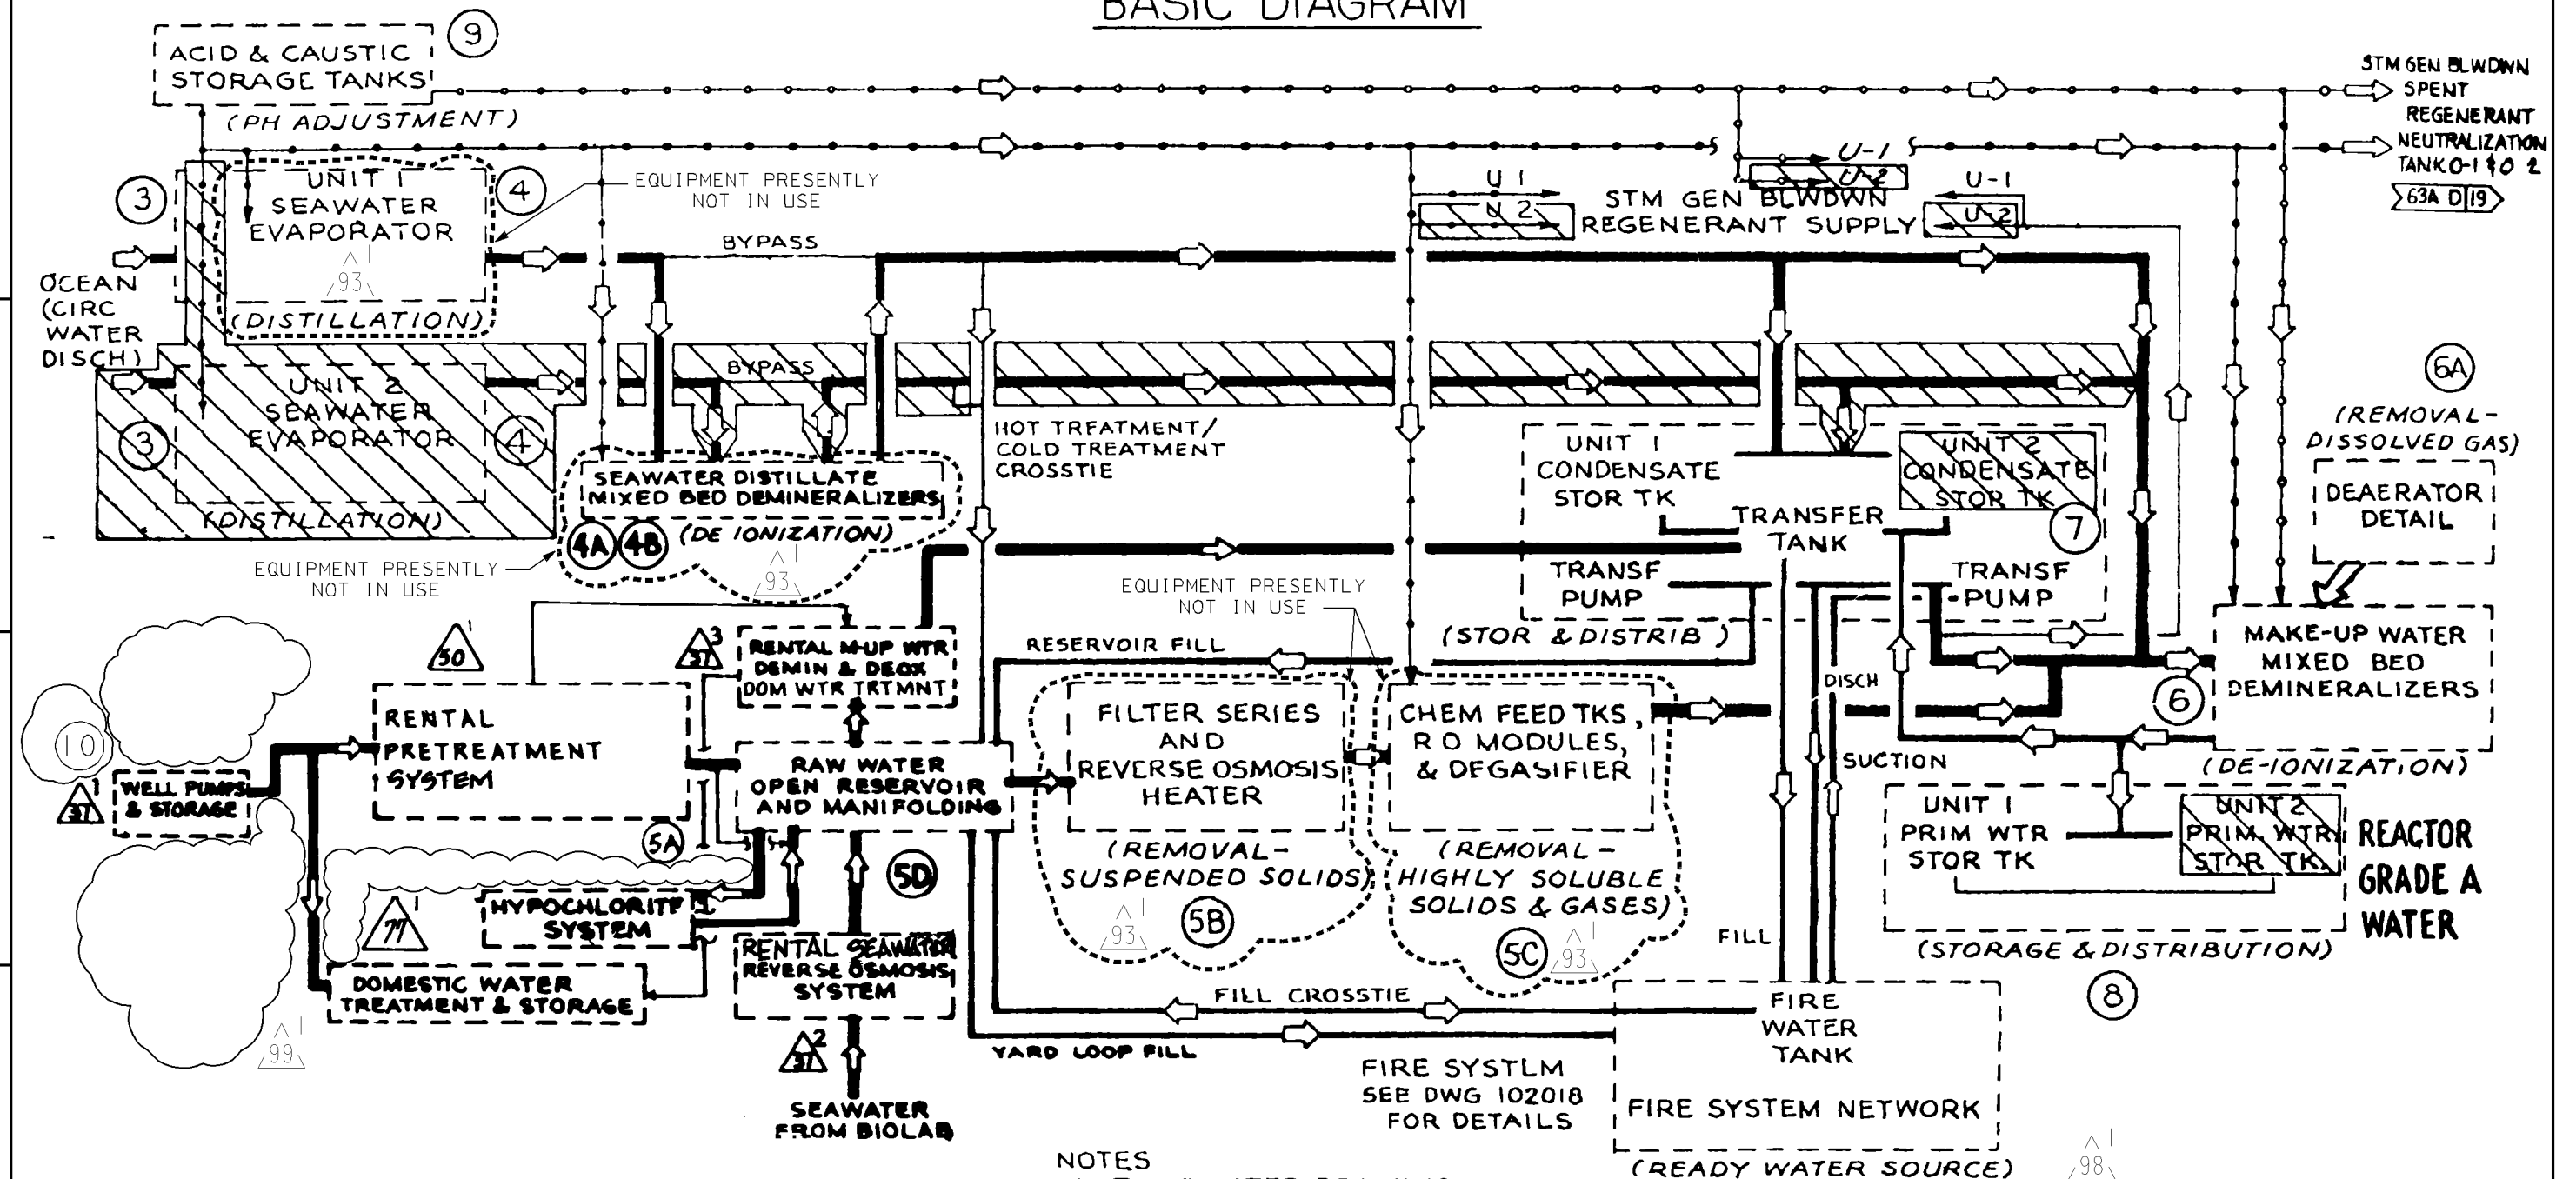

NOTES


- (N) INDICATES DRAWING SHEET NUMBER
- SEE SHEET 2 FOR EQUIPMENT, VALVING AND DETAILS OF BASIC DIAGRAM

FROM THIS REVISION FORWARD EACH SHEET WILL BE REVISED INDIVIDUALLY. SHEET 1 DOES NOT REQUIRE REVISION WITH OTHER SHEETS. REFER TO SHEET 27 FOR CHANGE INFORMATION. CHANGE INFORMATION SHEET CAN BE VIEWED IN THE WIP LIBRARY.

UNIT 1

DATE		REVISION DESCRIPTION		PIPING SCHEMATIC MAKE-UP WATER SYSTEM		DWG SCALE:			
11-01-2010		REVISED PER DDN-2*715				BILL OF MATL:			
D.D.	JBMX					SUPSDS:			
R.E.	FxC2					SUPSD BY:			
I.V.						DRAWING	SHEET	PAGE	REV
P.E.	KJD3					102016	1	0	99




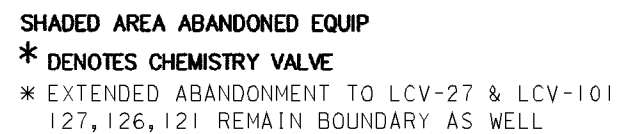

DRAWING	SHEET	PAGE	REV
102016	4	0	96

E
D
C
B
A

E
D
C
B
A

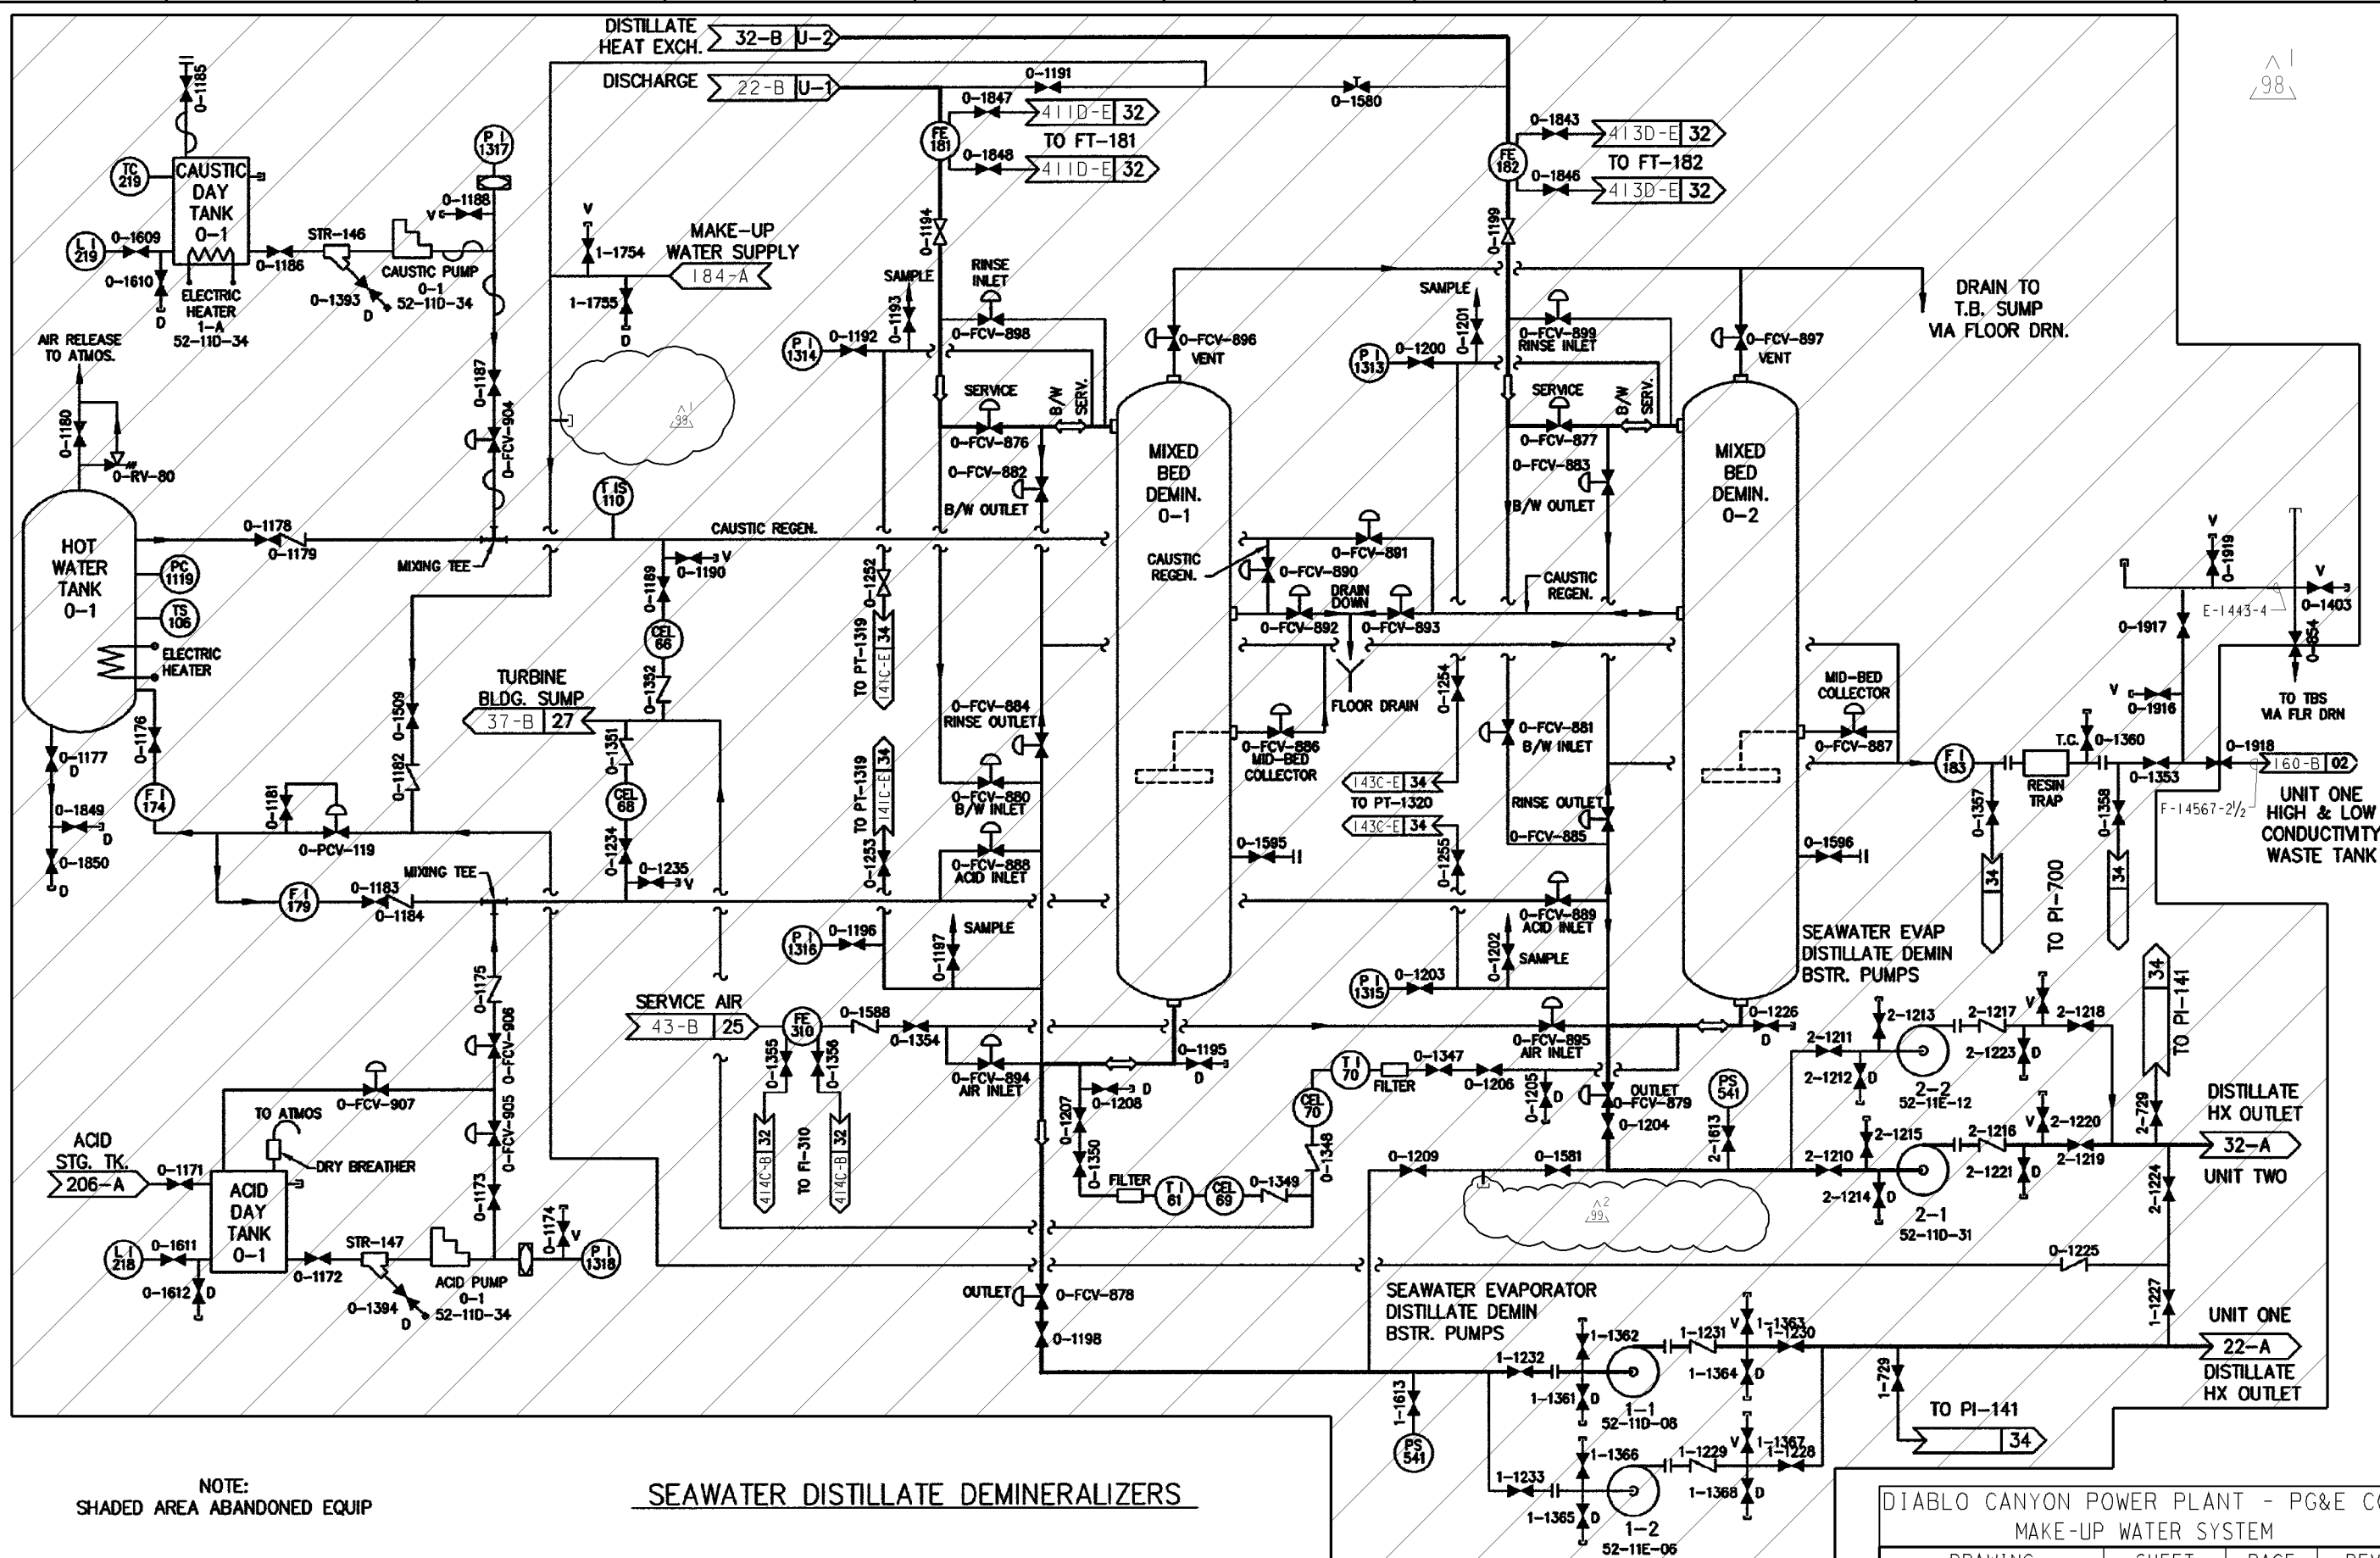

NOTE:
SHADED AREA ABANDONED EQUIP

SEAWATER DISTILLATE DEMINERALIZERS

UNIT 1 & 2

DIABLO CANYON POWER PLANT - PG&E CO. MAKE-UP WATER SYSTEM			
DRAWING	SHEET	PAGE	REV
102016	6	0	99

RASTER=2016s06.dgn
DGN=2016s06.dgn
CAD User: JBMX Date: 10-07-2010


INPG1C
I Size

10-07-2010	JBMX	Fxc2		KERSI J. DALAL	MECHANICAL	M 16690	3/31/2012	REVISED PER DDN-2*156
DATE	DWN	RE	IV	PROFESSIONAL ENGINEER	PE DISC.	PE#	PE EXP.	

E
D
C
B
A

E
D
C
B
A

RASTER=atrxx.dgn
DGN=atrxx.dgn
CAD User: MNRU Date:02-13-2013

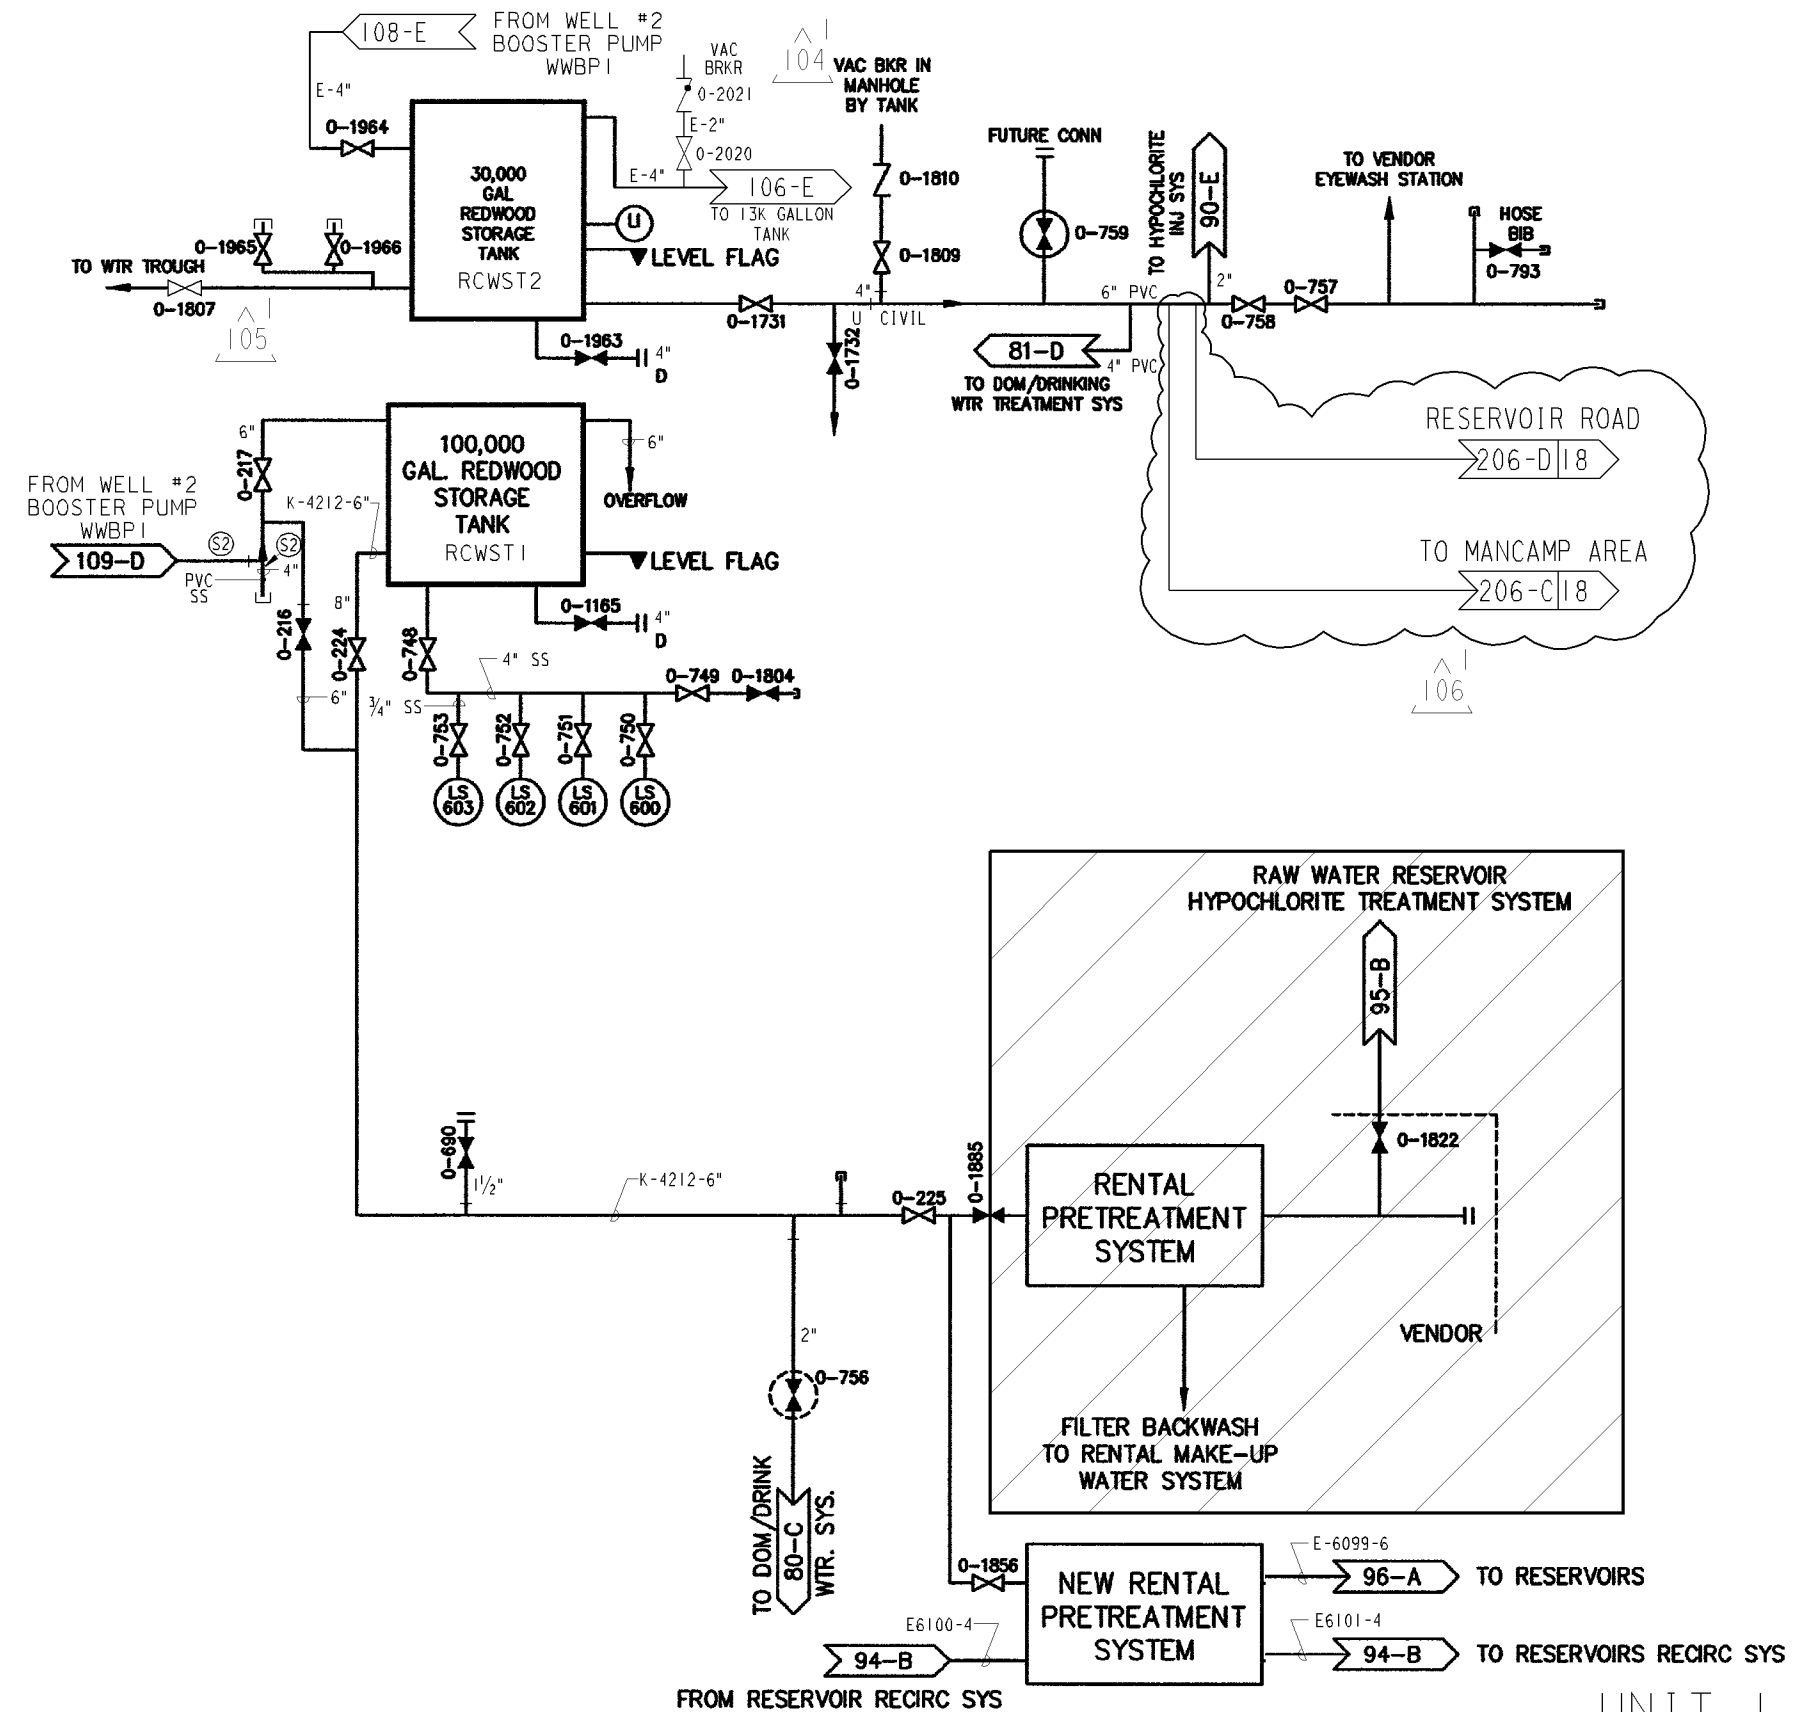


NOTE:
SHADED AREA ABANDONED EQUIP

UNIT 1			
DIABLO CANYON POWER PLANT - PG&E CO. MAKE-UP WATER SYSTEM			
DRAWING	SHEET	PAGE	REV
102016	7	0	106

02-13-2013	MNRU	FxC2	KJD3	KERSI J. DALAL	MECHANICAL	M 16690	3/31/2014	REVISED PER DFT-7*1954
DATE	DWN	RE	IV	PROFESSIONAL ENGINEER	PE DISC.	PE#	PE EXP.	

105

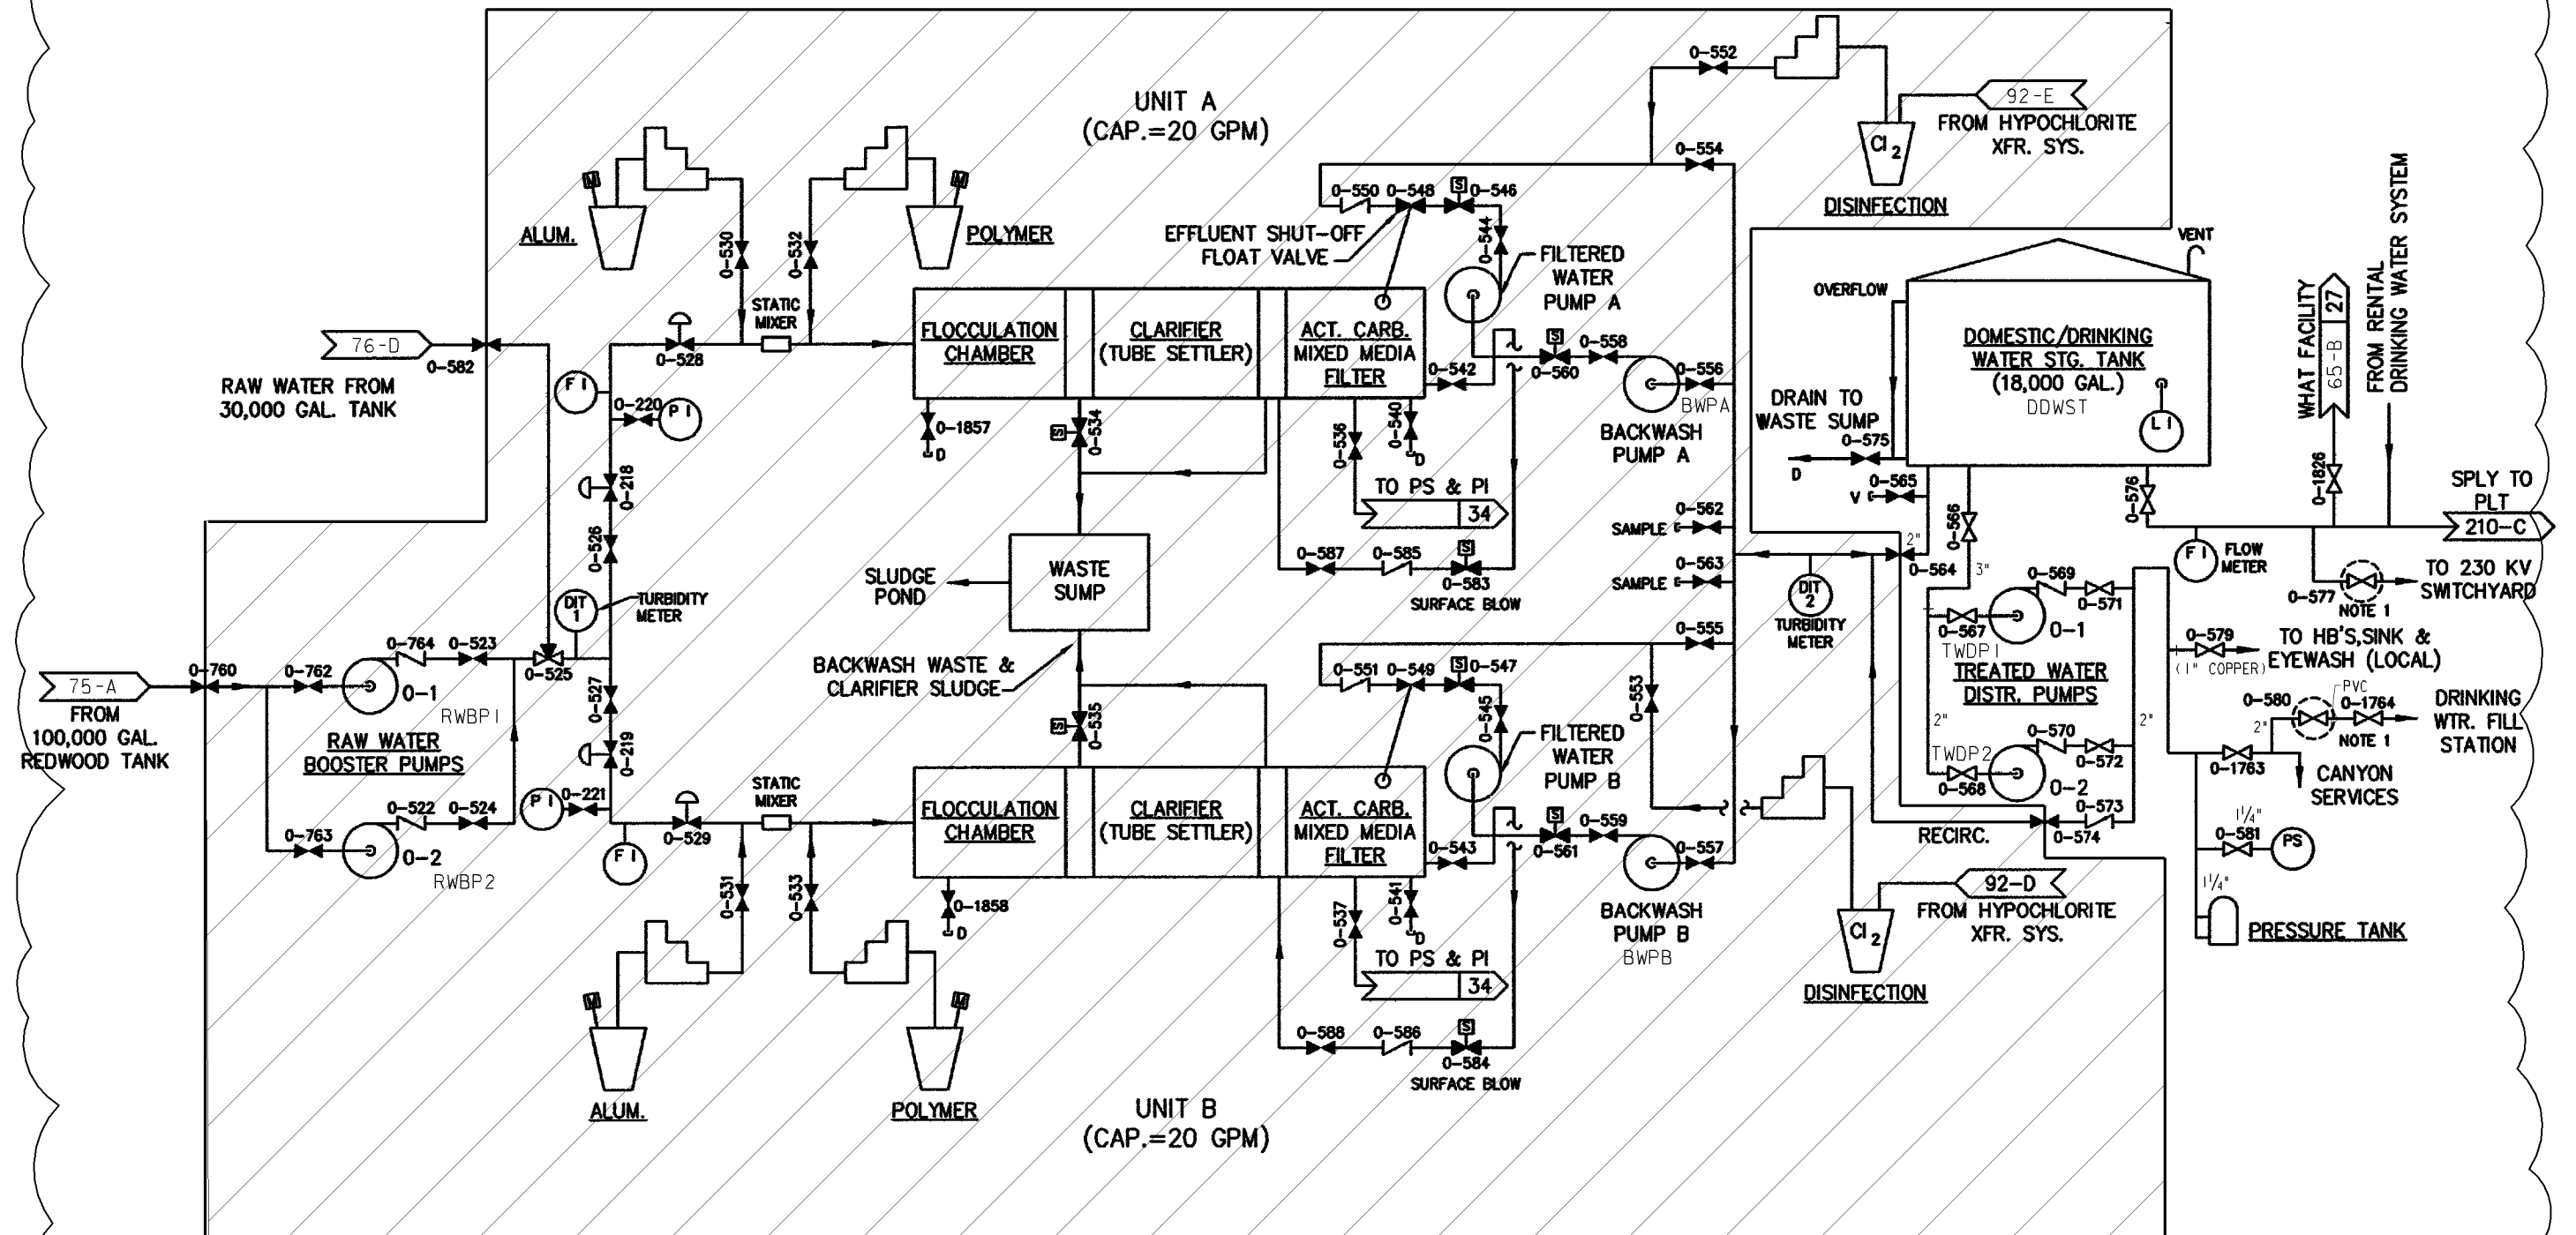

DOMESTIC/DRINKING WATER TREATMENT SYSTEM

UNIT 1

DIABLO CANYON POWER PLANT - PG&E CO.


NOTE 1) UNDERGROUND VALVE
SHADED AREA ABANDONED EQUIP

DRAWING	SHEET	PAGE	REV
102016	8	0	105

01-04-2006	MIBF	KJD3		FRANCIS C. LING	MECHANICAL	M 16098	12/31/2007	REVISED PER FCT-030760
DATE	DWN	RE	IV	PROFESSIONAL ENGINEER	PE DISC.	PE#	PE EXP.	

E
D
C
B
A

E
D
C
B
A

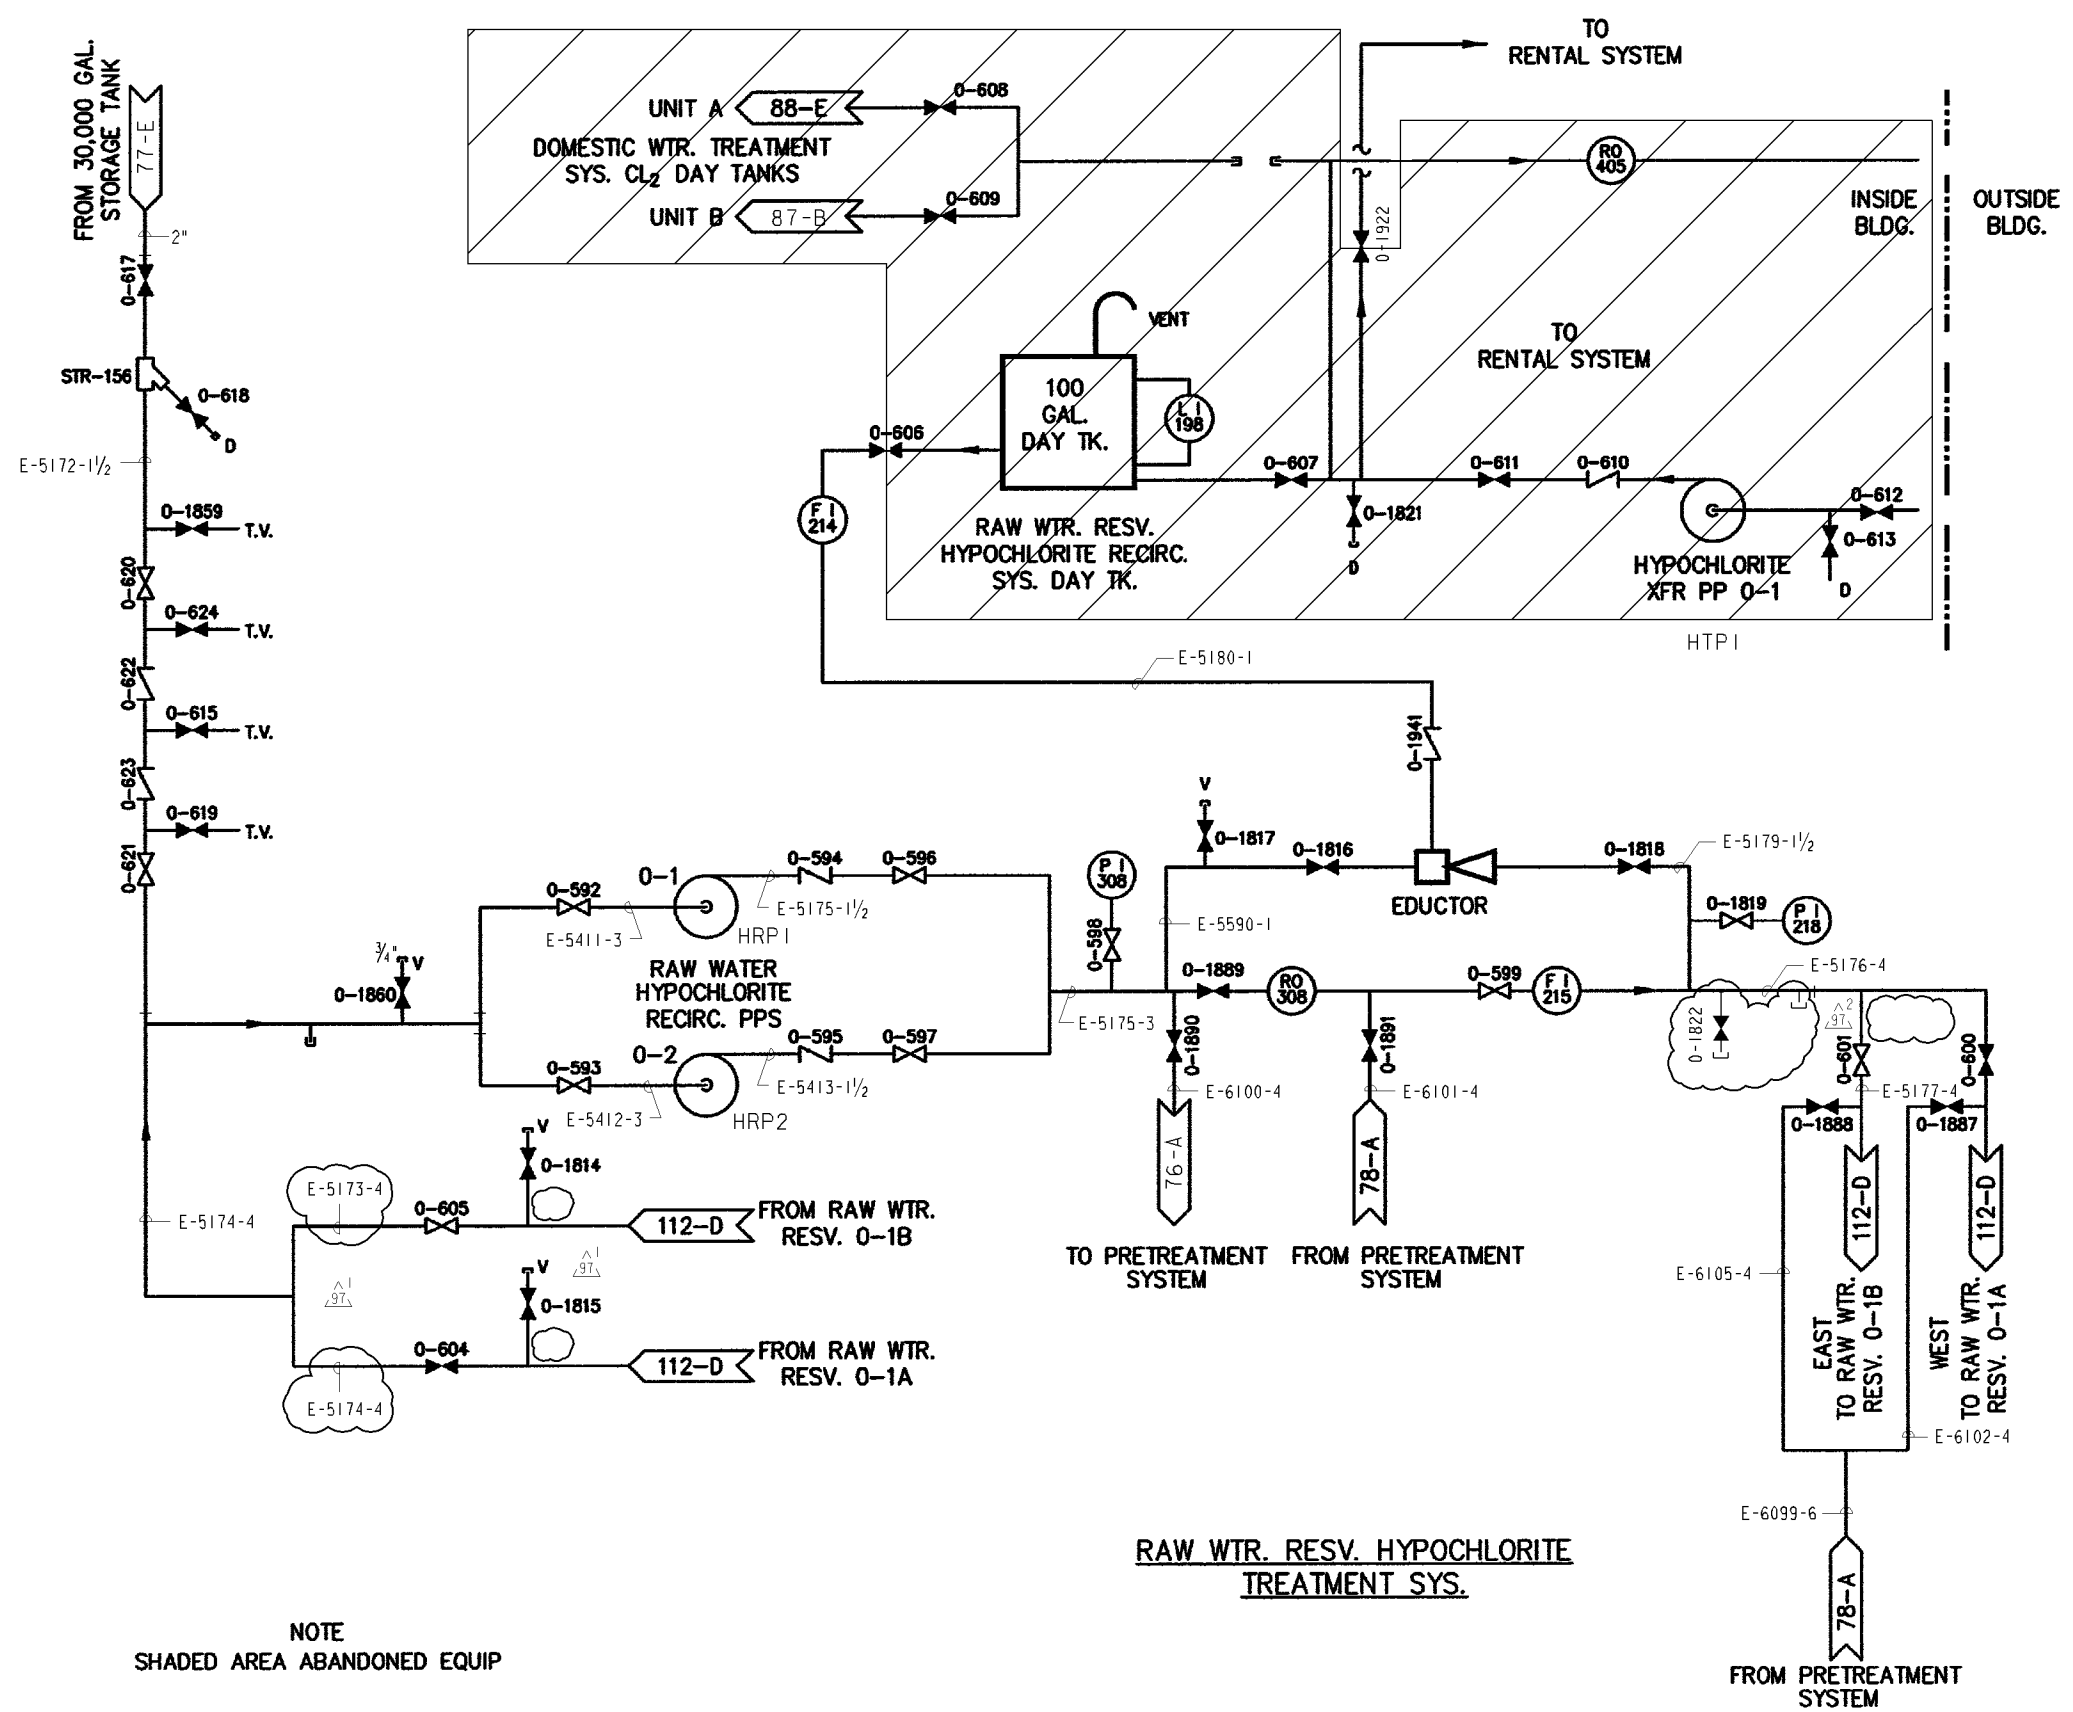

RASTER=2016s09.dgn
DGN=2016s09.dgn
CAD User: RxG2 Date: 08-07-2009

UNIT 1			
DIABLO CANYON POWER PLANT - PG&E CO.			
MAKE-UP WATER SYSTEM			
DRAWING	SHEET	PAGE	REV
102016	9	0	97

08-07-2009	RxG2	FxC2		KERSI J. DALAL	MECHANICAL	M 16690	3/31/2010	REVISED PER DDN-2*45
DATE	DWN	RE	IV	PROFESSIONAL ENGINEER	PE DISC.	PE#	PE EXP.	

A

B

C

D

E

A

B

C

D

E

500 KV CONTROL BLDG.

301



STORAGE TANK

(P)

4"

59A-D

TREATED WATER
DISTRIBUTION PPS 0-1/0-2

6"

6"

(G)

2"

59A-E

DOMESTIC/DRINKING
WATER SYSTEM
STORAGE TANK
(18,000 GALLON)

(G)

6"

303

230 KV CONTROL
RM. BLDG.

'WHAT' FACILITY

6"

MU-0-1987

6"

MU-0-1895

IONICS
DRINKING
WATER
PLANTDOMESTIC
WATER TANK
(20,000 GAL)

(G)

4"

6"

BFP-14

4"

(G)

LAUNDRY & RADWASTE BLDG.

117

117

BFP-15

BFP-16

BFP-9

101

118

AUX. BOILER

UNIT #1

UNIT #2

PRE FAB TOILET
SEE HVAC/PLUMBING
DWG 59425 FOR DET.

102

BLDG.
(FUTURE-I & C TELECOM)

103

DISCH.
STRUCTURE

BFP-12

4"

(G)

4"

104

ADM. BLDG.

BFP-13

6"

(G)

6"

105

SECURITY BLDG.

BFP-6

2"

(G)

2"

106

UNIT 2 COLD
MACHINE SHOP

BFP-5

2 1/2"

(G)

2 1/2"

109

SIMULATOR
BLDG.

BFP-4

2"

(G)

2"

108

INTAKE STRUCTURE BLDG.

BFP-3

2"

(G)

2"

120

HAZARDOUS
WASTE

BFP-8

2"

(G)

2"

121

SEAWATER
REVERSE
OSMOSIS

BFP-7

2"

(G)

2"

122

G.C. FAB. SHOP

BFP-24

1 1/4"

ISO VALVE

1 1/4"

DISCONNECT
COUPLINGEMERGENCY
EYEWASH/SHOWER

BOAT DOCK

BFP-20

1 1/2"

(G)

1 1/2"

101

UNIT #1

UNIT #2

PRE FAB TOILET
SEE HVAC/PLUMBING
DWG 59425 FOR DET.

102

BLDG.
(FUTURE-I & C TELECOM)

103

DISCH.
STRUCTURE

BFP-14

4"

(G)

4"

118

AUX. BOILER

BFP-15

BFP-16

BFP-9

101

117

117

LAUNDRY & RADWASTE BLDG.

BFP-12

4"

(G)

4"

104

ADM. BLDG.

BFP-13

6"

(G)

6"

105

SECURITY BLDG.

BFP-6

2"

(G)

2"

106

UNIT 2 COLD
MACHINE SHOP

BFP-5

2 1/2"

(G)

2 1/2"

109

SIMULATOR
BLDG.

BFP-4

2"

(G)

2"

108

INTAKE STRUCTURE BLDG.

BFP-3

2"

(G)

2"

120

HAZARDOUS
WASTE

BFP-8

2"

(G)

2"

121

SEAWATER
REVERSE
OSMOSIS

BFP-7

2"

(G)

2"

122

G.C. FAB. SHOP

BFP-24

1 1/4"

ISO VALVE

1 1/4"

DISCONNECT
COUPLINGEMERGENCY
EYEWASH/SHOWER

BOAT DOCK

BFP-20

1 1/2"

(G)

1 1/2"

101

UNIT #1

UNIT #2

PRE FAB TOILET
SEE HVAC/PLUMBING
DWG 59425 FOR DET.

102

BLDG.
(FUTURE-I & C TELECOM)

103

DISCH.
STRUCTURE

BFP-14

4"

(G)

4"

118

AUX. BOILER

BFP-15

BFP-16

BFP-9

101

117

117

LAUNDRY & RADWASTE BLDG.

BFP-12

4"

(G)

4"

104

ADM. BLDG.

BFP-13

6"

(G)

6"

105

SECURITY BLDG.

BFP-6

2"

(G)

2"

106

UNIT 2 COLD
MACHINE SHOP

BFP-5

2 1/2"

(G)

2 1/2"

109

SIMULATOR
BLDG.

BFP-4

2"

(G)

2"

108

INTAKE STRUCTURE BLDG.

BFP-3

2"

(G)

2"

120

HAZARDOUS
WASTE

BFP-8

2"

(G)

2"

121

SEAWATER
REVERSE
OSMOSIS

BFP-7

2"

(G)

2"

122

G.C. FAB. SHOP

BFP-24

1 1/4"

ISO VALVE

1 1/4"

DISCONNECT
COUPLINGEMERGENCY
EYEWASH/SHOWER

BOAT DOCK

BFP-20

1 1/2"

(G)

1 1/2"

101

UNIT #1

UNIT #2

PRE FAB TOILET
SEE HVAC/PLUMBING
DWG 59425 FOR DET.

102

BLDG.
(FUTURE-I & C TELECOM)

103

DISCH.
STRUCTURE

BFP-14

4"

(G)

4"

118

AUX. BOILER

BFP-15

BFP-16

BFP-9

101

117

117

LAUNDRY & RADWASTE BLDG.

BFP-12

4"

(G)

4"

104

ADM. BLDG.

BFP-13

6"

(G)

6"

105

SECURITY BLDG.

BFP-6

2"

(G)

2"

106

UNIT 2 COLD
MACHINE SHOP

BFP-5

2 1/2"

(G)

2 1/2"

109

SIMULATOR
BLDG.

BFP-4

2"

(G)

2"

108

INTAKE STRUCTURE BLDG.

BFP-3

2"

(G)

2"

120

HAZARDOUS
WASTE

BFP-8

2"

(G)

2"

121

SEAWATER
REVERSE
OSMOSIS

BFP-7

2"

(G)

2"

122

G.C. FAB. SHOP

BFP-24

1 1/4"

ISO VALVE

1 1/4"

DISCONNECT
COUPLINGEMERGENCY
EYEWASH/SHOWER

BOAT DOCK

BFP-20

1 1/2"

(G)

1 1/2"

101

UNIT #1

UNIT #2

PRE FAB TOILET
SEE HVAC/PLUMBING
DWG 59425 FOR DET.

102

BLDG.
(FUTURE-I & C TELECOM)



1. DELETED
2. ALL PIPING IS CODE CLASS "E"
3. SHADED AREA, ABANDONED IN PLACE


DRAWING 102016	SHEET 10	PAGE 0	REV 85
-------------------	-------------	-----------	-----------

05-25-2012	MNRU	FxC2		KERSI J. DALAL	MECHANICAL	M 16690	3/31/2014	REVISED PER DDT-4*645-0
DATE	DWN	RE	IV	PROFESSIONAL ENGINEER	PE DISC.	PE#	PE EXP.	

INPG2ND
I Size

RASTER=2016s11.dgn
DGN=2016s11.dgn
CAD User: MNRU

Date: 01-07-2014

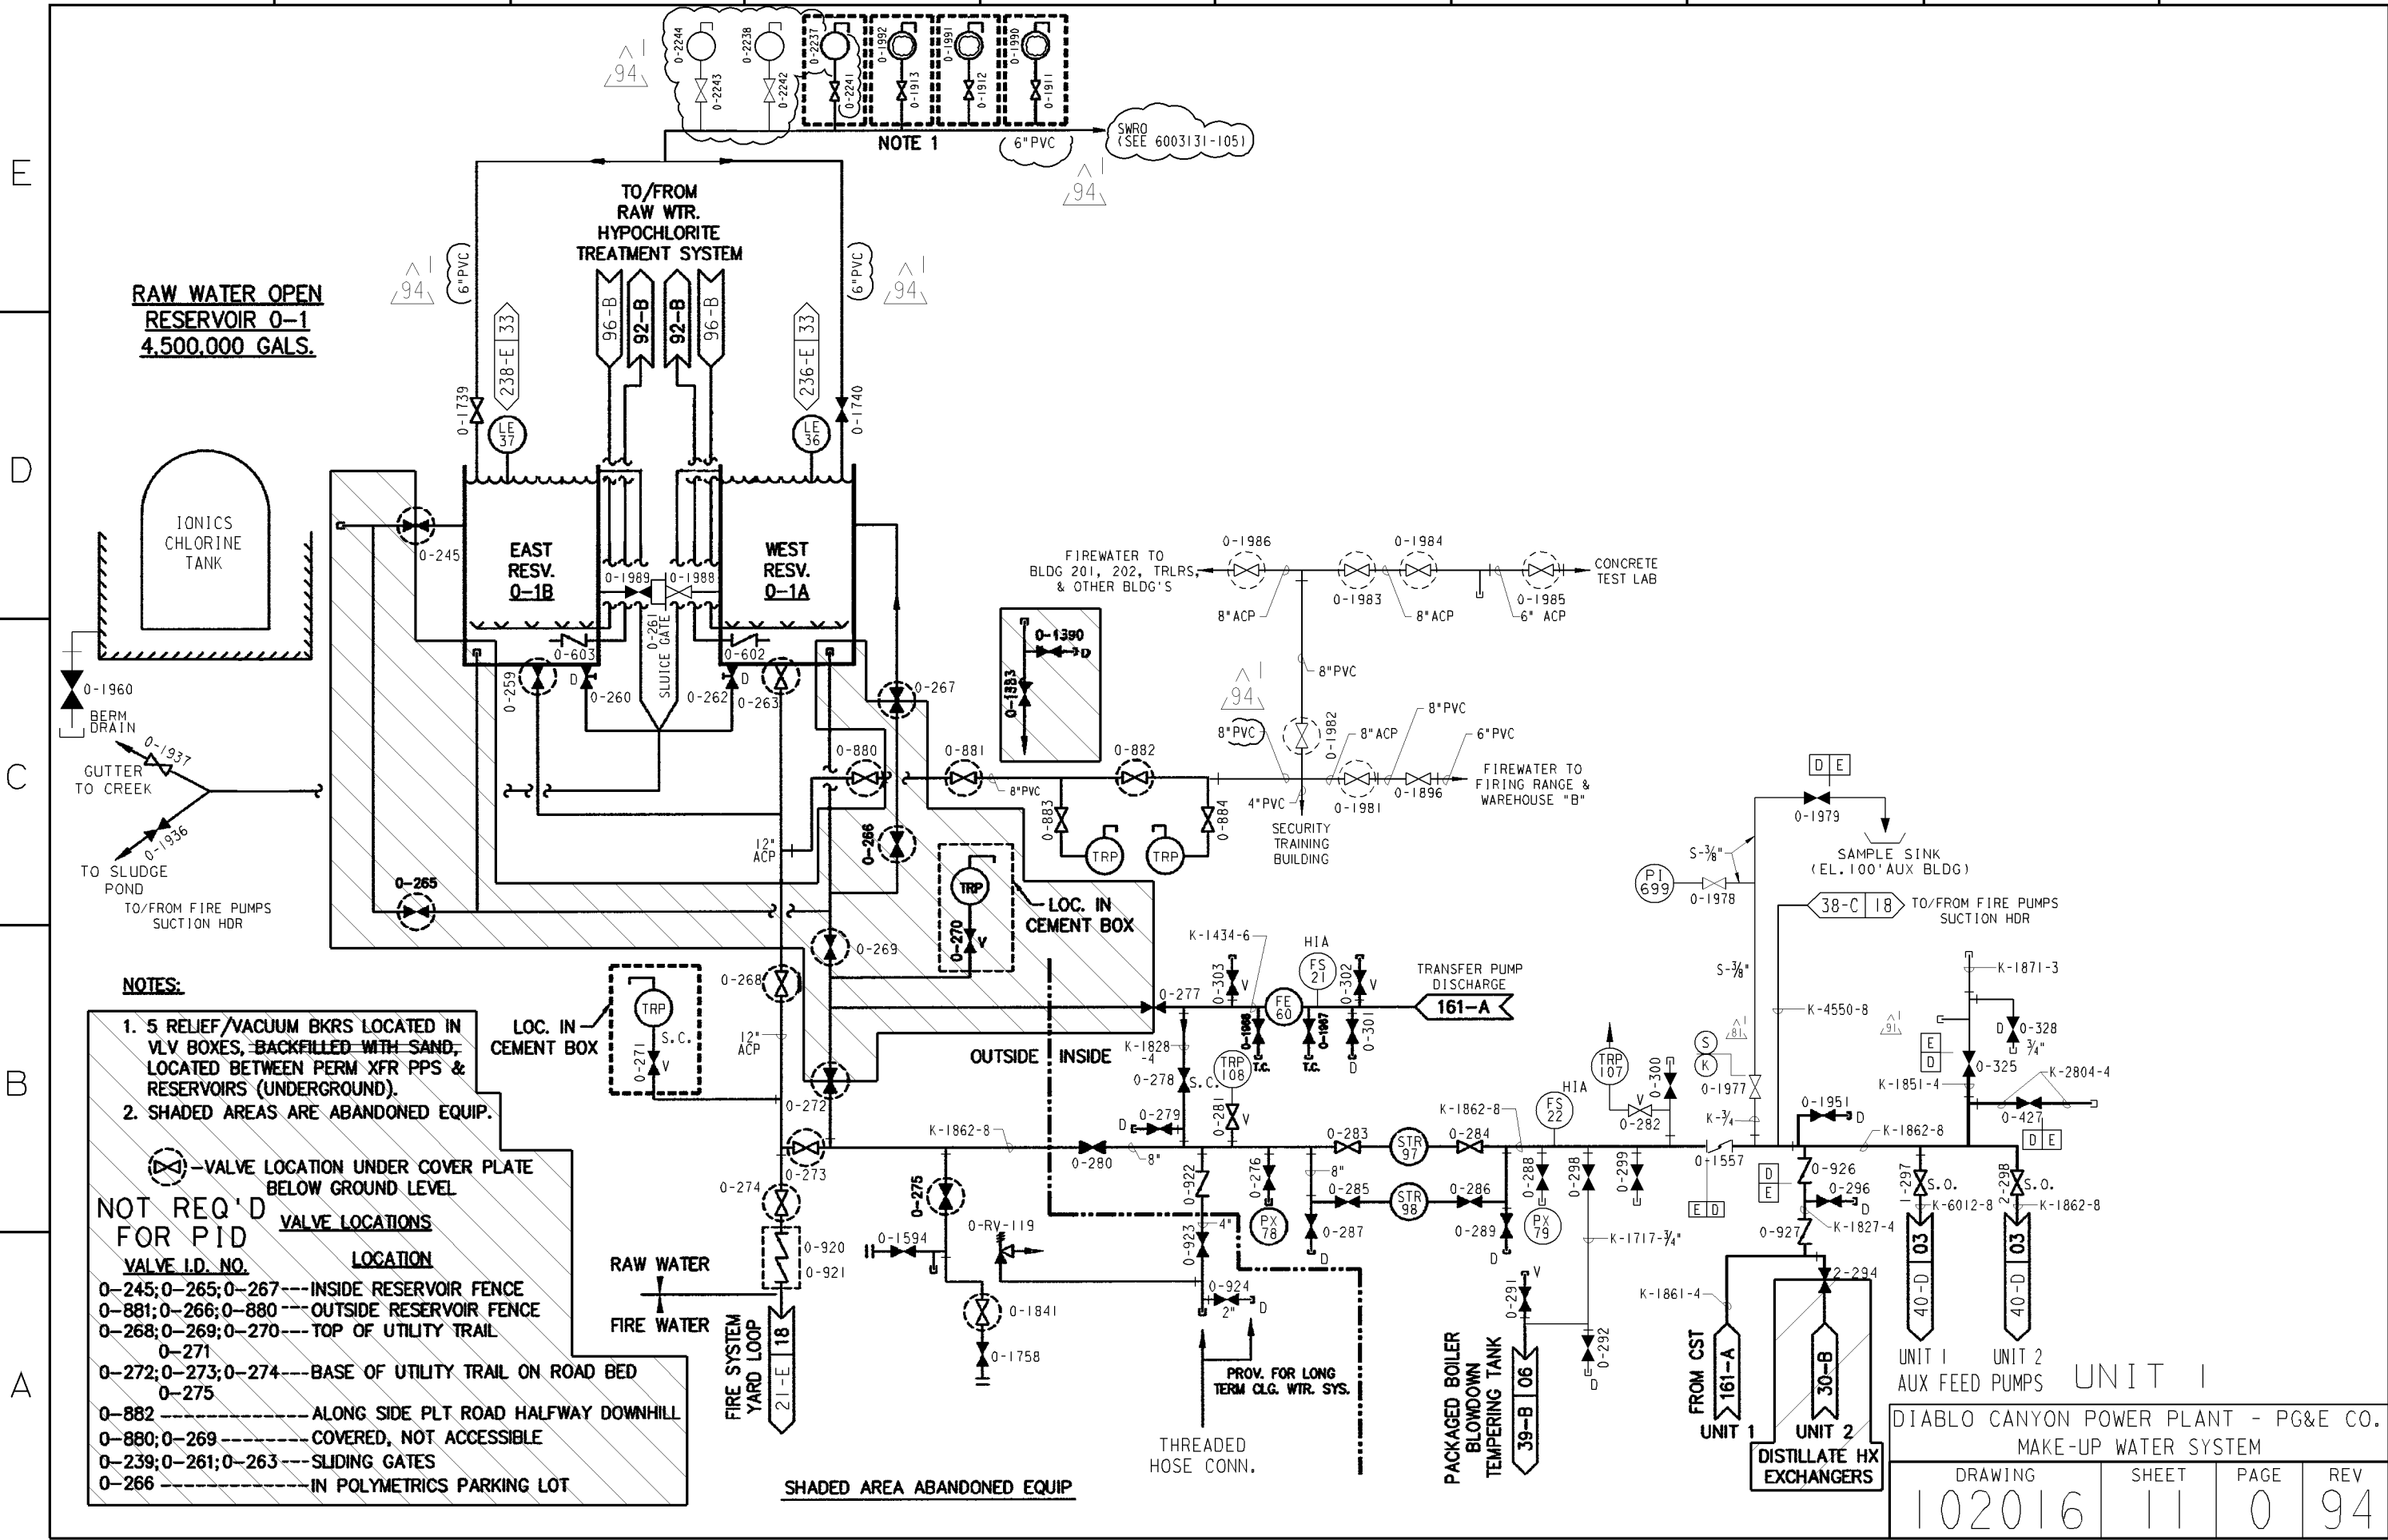


INP/CIC
1 Size


01-07-2014	MNRU	Fxc2	KJD3	NOT REQUIRED	N/A	N/A	N/A	REVISED PER DFT-7*2314
DATE	DWN	RE	IV	PROFESSIONAL ENGINEER	PE DISC.	PE #	PE EXP.	

UNIT 1 & 2

DIABLO CANYON POWER PLANT - PG&E CO. MAKE-UP WATER SYSTEM			
DRAWING	SHEET	PAGE	REV
102016	13	0	82

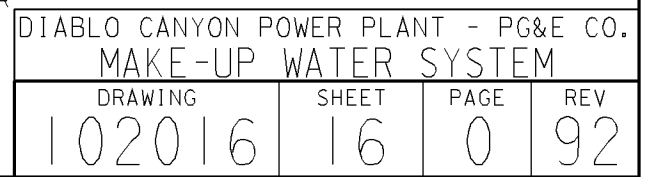

RASTER=2016s18.dgn
DGN=2016s18.dgn
CAD User: CNHK Date: 07-21-2011

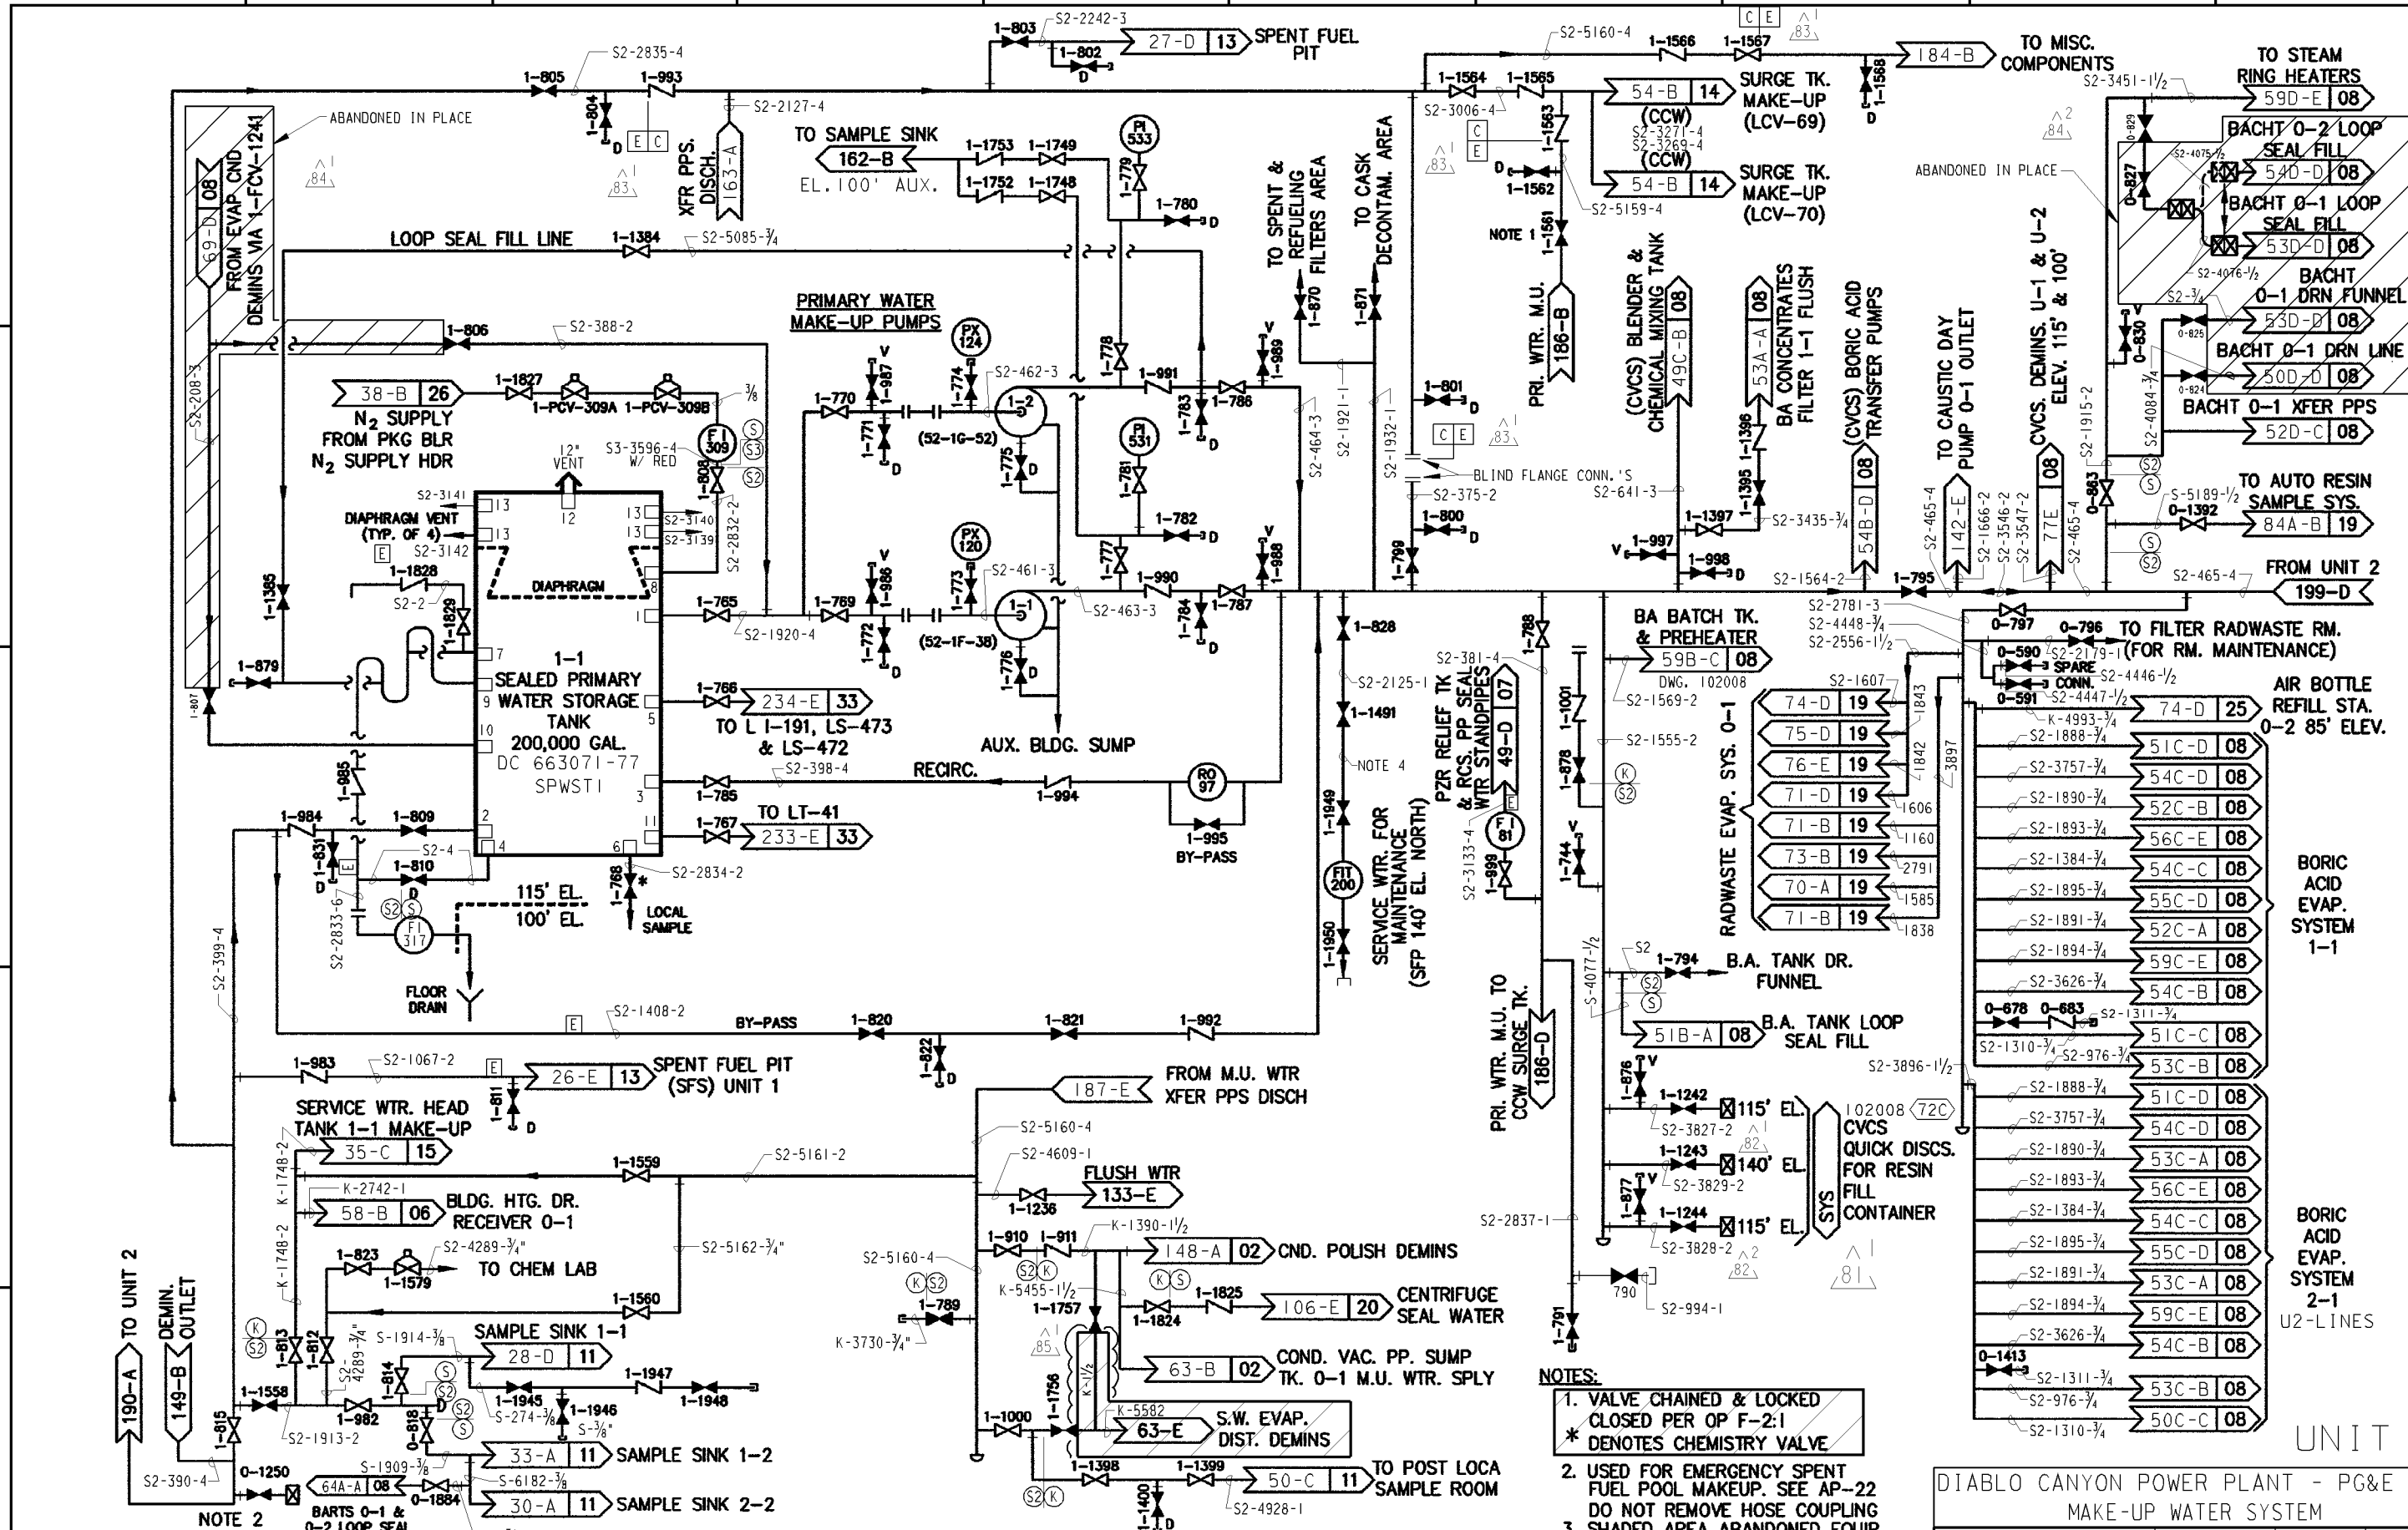

- NOTES:
1. VALVE CHAINED & LOCKED CLOSED PER OP F-2:1
 2. USED FOR EMERGENCY SPENT FUEL POOL MAKEUP. SEE AP-22 DO NOT REMOVE HOSE COUPLING
 3. SHADED AREA ABANDONED EQUIP
 4. PIPING IS SS SCH 40 THRU'D SEE DWG. 224924 FOR DETAILS.

DIABLO CANYON POWER PLANT - PG&E CO.
MAKE-UP WATER SYSTEM

DRAWING	SHEET	PAGE	REV
102016	18	0	85

07-21-2011	CNHK	RxG2		KERSI J. DALAL	MECHANICAL	M 16690	3/31/2012	REVISED PER DFT-7*1265-0
DATE	DWN	RE	IV	PROFESSIONAL ENGINEER	PE DISC.	PE#	PE EXP.	

200

201

202

203

204


205

206

207

208

209

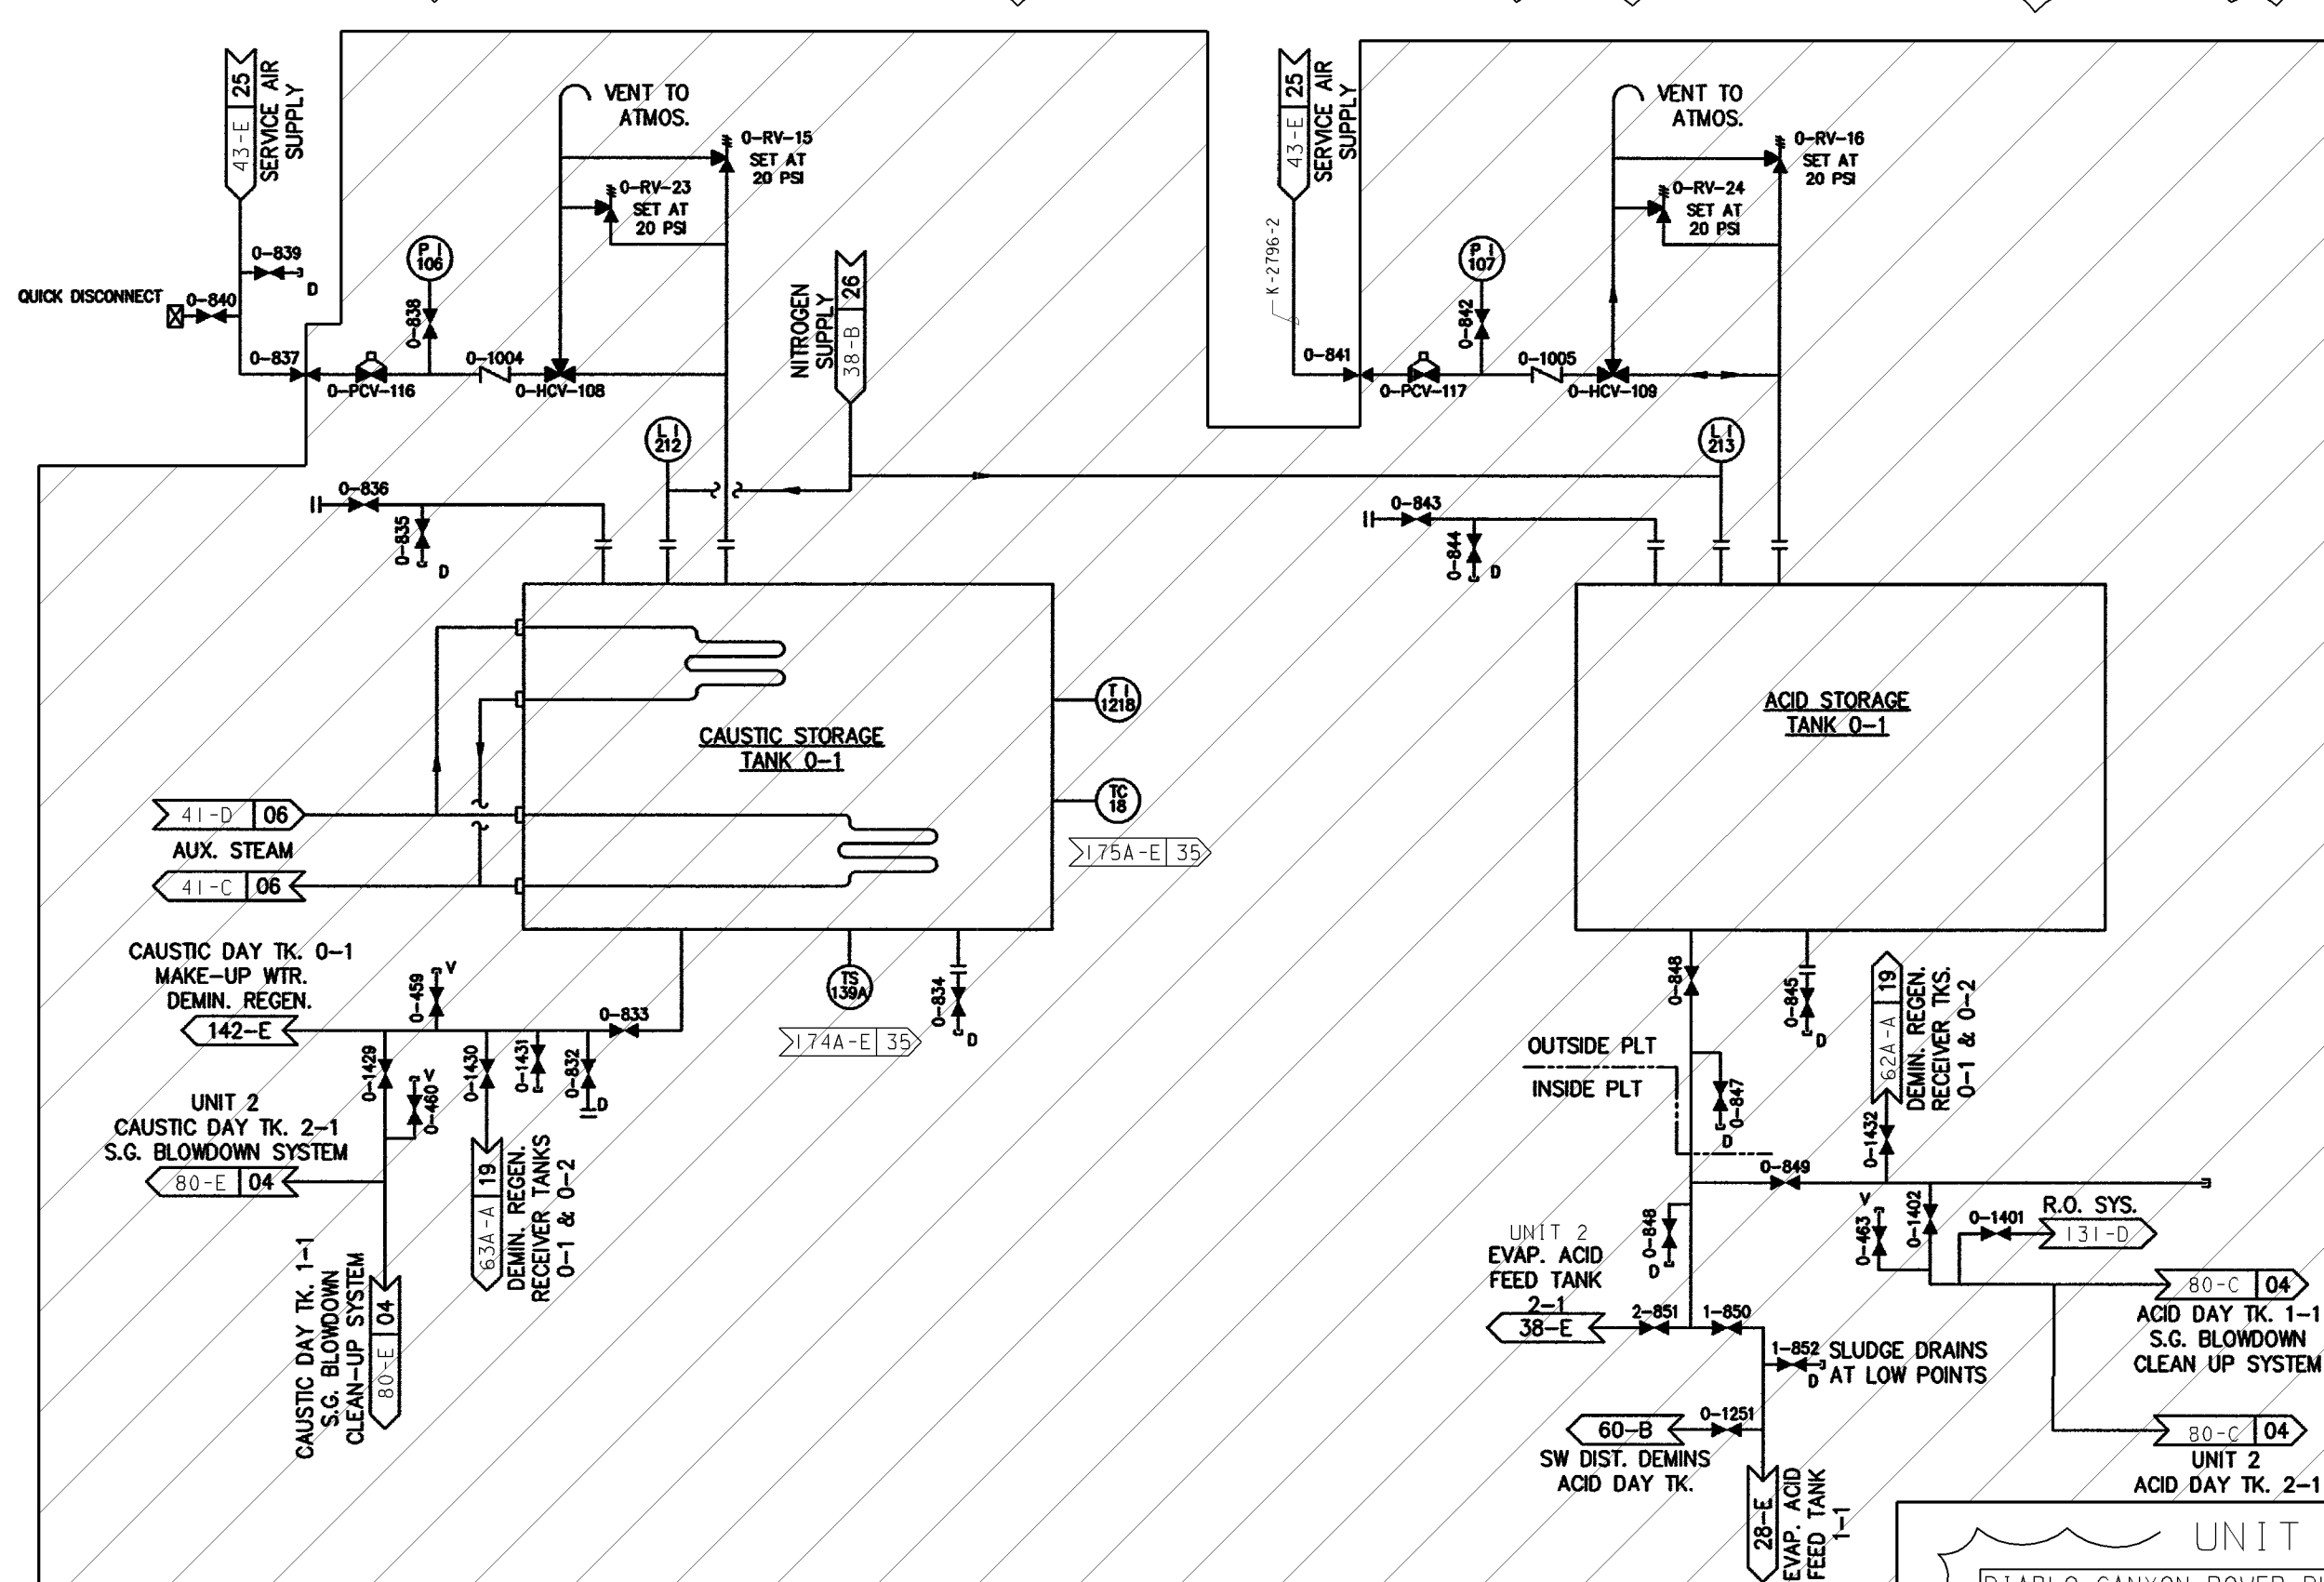

SHADED AREA ABANDONED EQUIP

UNIT 1
 DIABLO CANYON POWER PLANT - PG&E CO.


DRAWING	SHEET	PAGE	REV
102016	20	0	80

01-04-2006	MIBF	KJD3		FRANCIS C. LING	MECHANICAL	M 16098	12/31/2007	REVISED PER FCT-030760
DATE	DWN	RE	IV	PROFESSIONAL ENGINEER	PE DISC.	PE#	PE EXP.	

RASTER=2016s20.dgn
 DGN=2016s20.dgn
 CAD User: MIBF

Date: 01-04-2006

INPGIC
 I Size

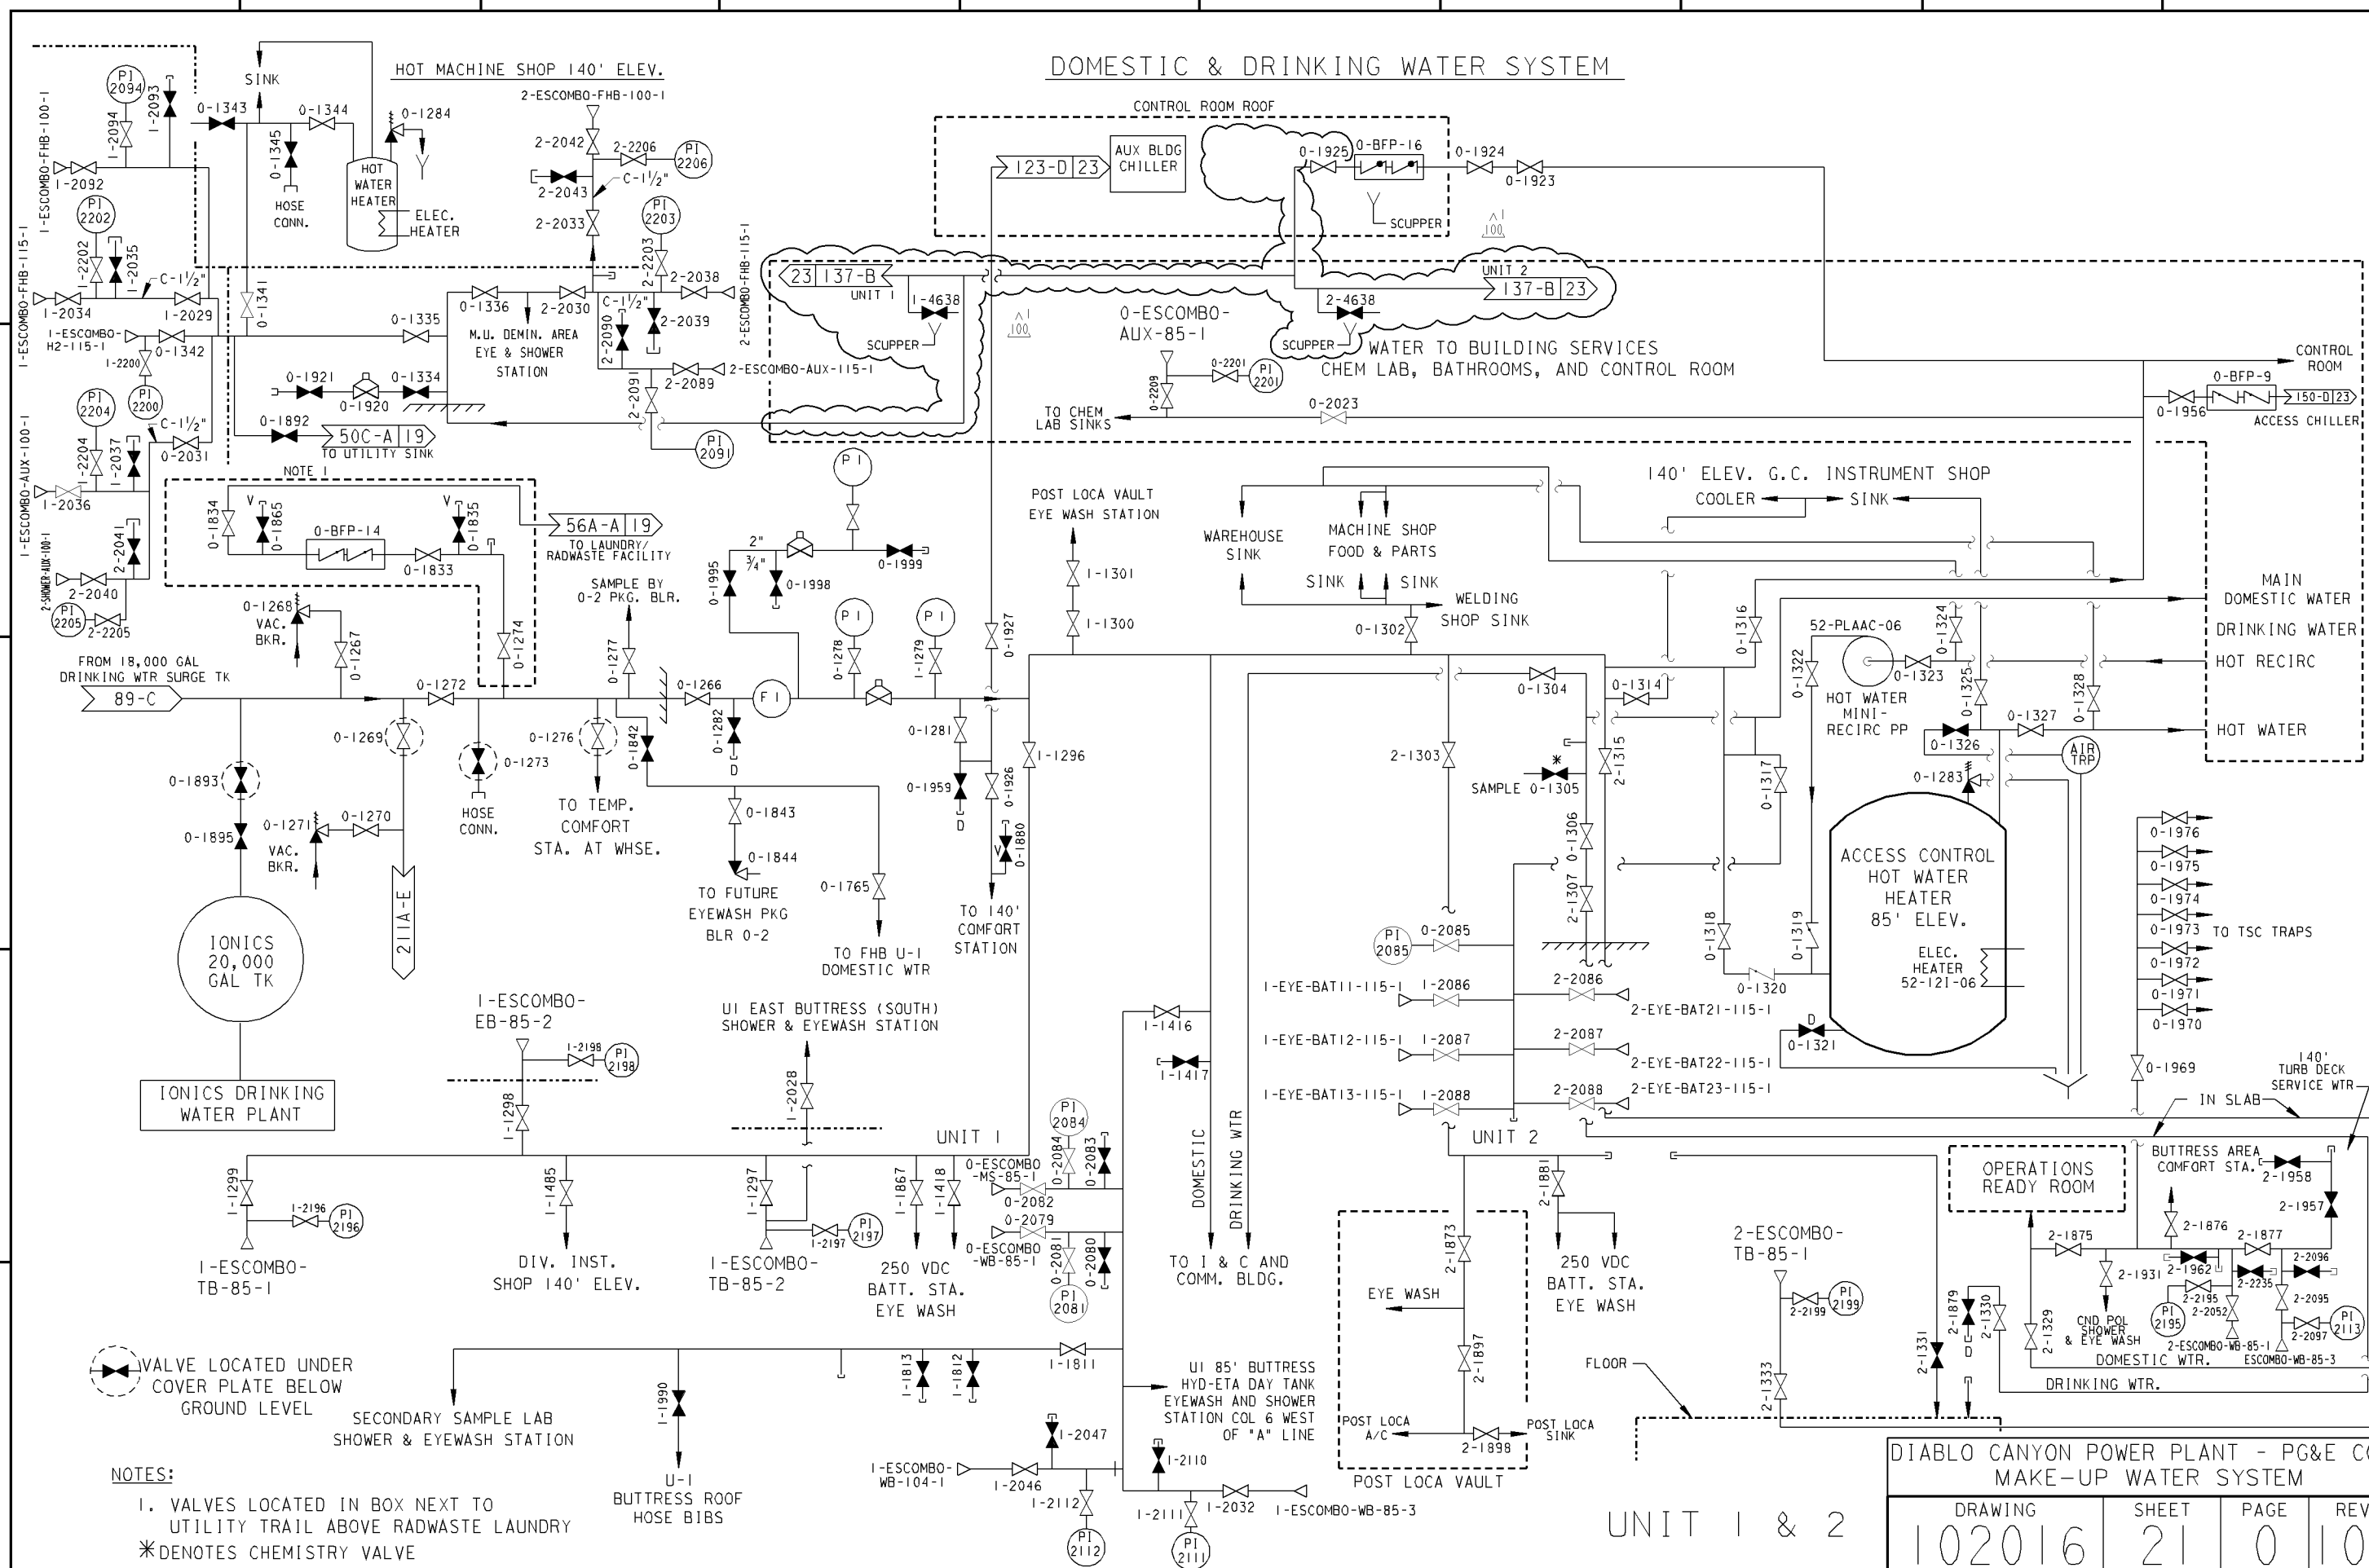


NOTES:

1. VALVES LOCATED IN BOX NEXT TO
UTILITY TRAIL ABOVE RADWASTE LAUNDRY
*DENOTES CHEMISTRY VALVE

DIABLO CANYON POWER PLANT - PG&E CO.
MAKE-UP WATER SYSTEM

DRAWING	SHEET	PAGE	REV
020 6	2	0	1 00

UNIT 1 & 2

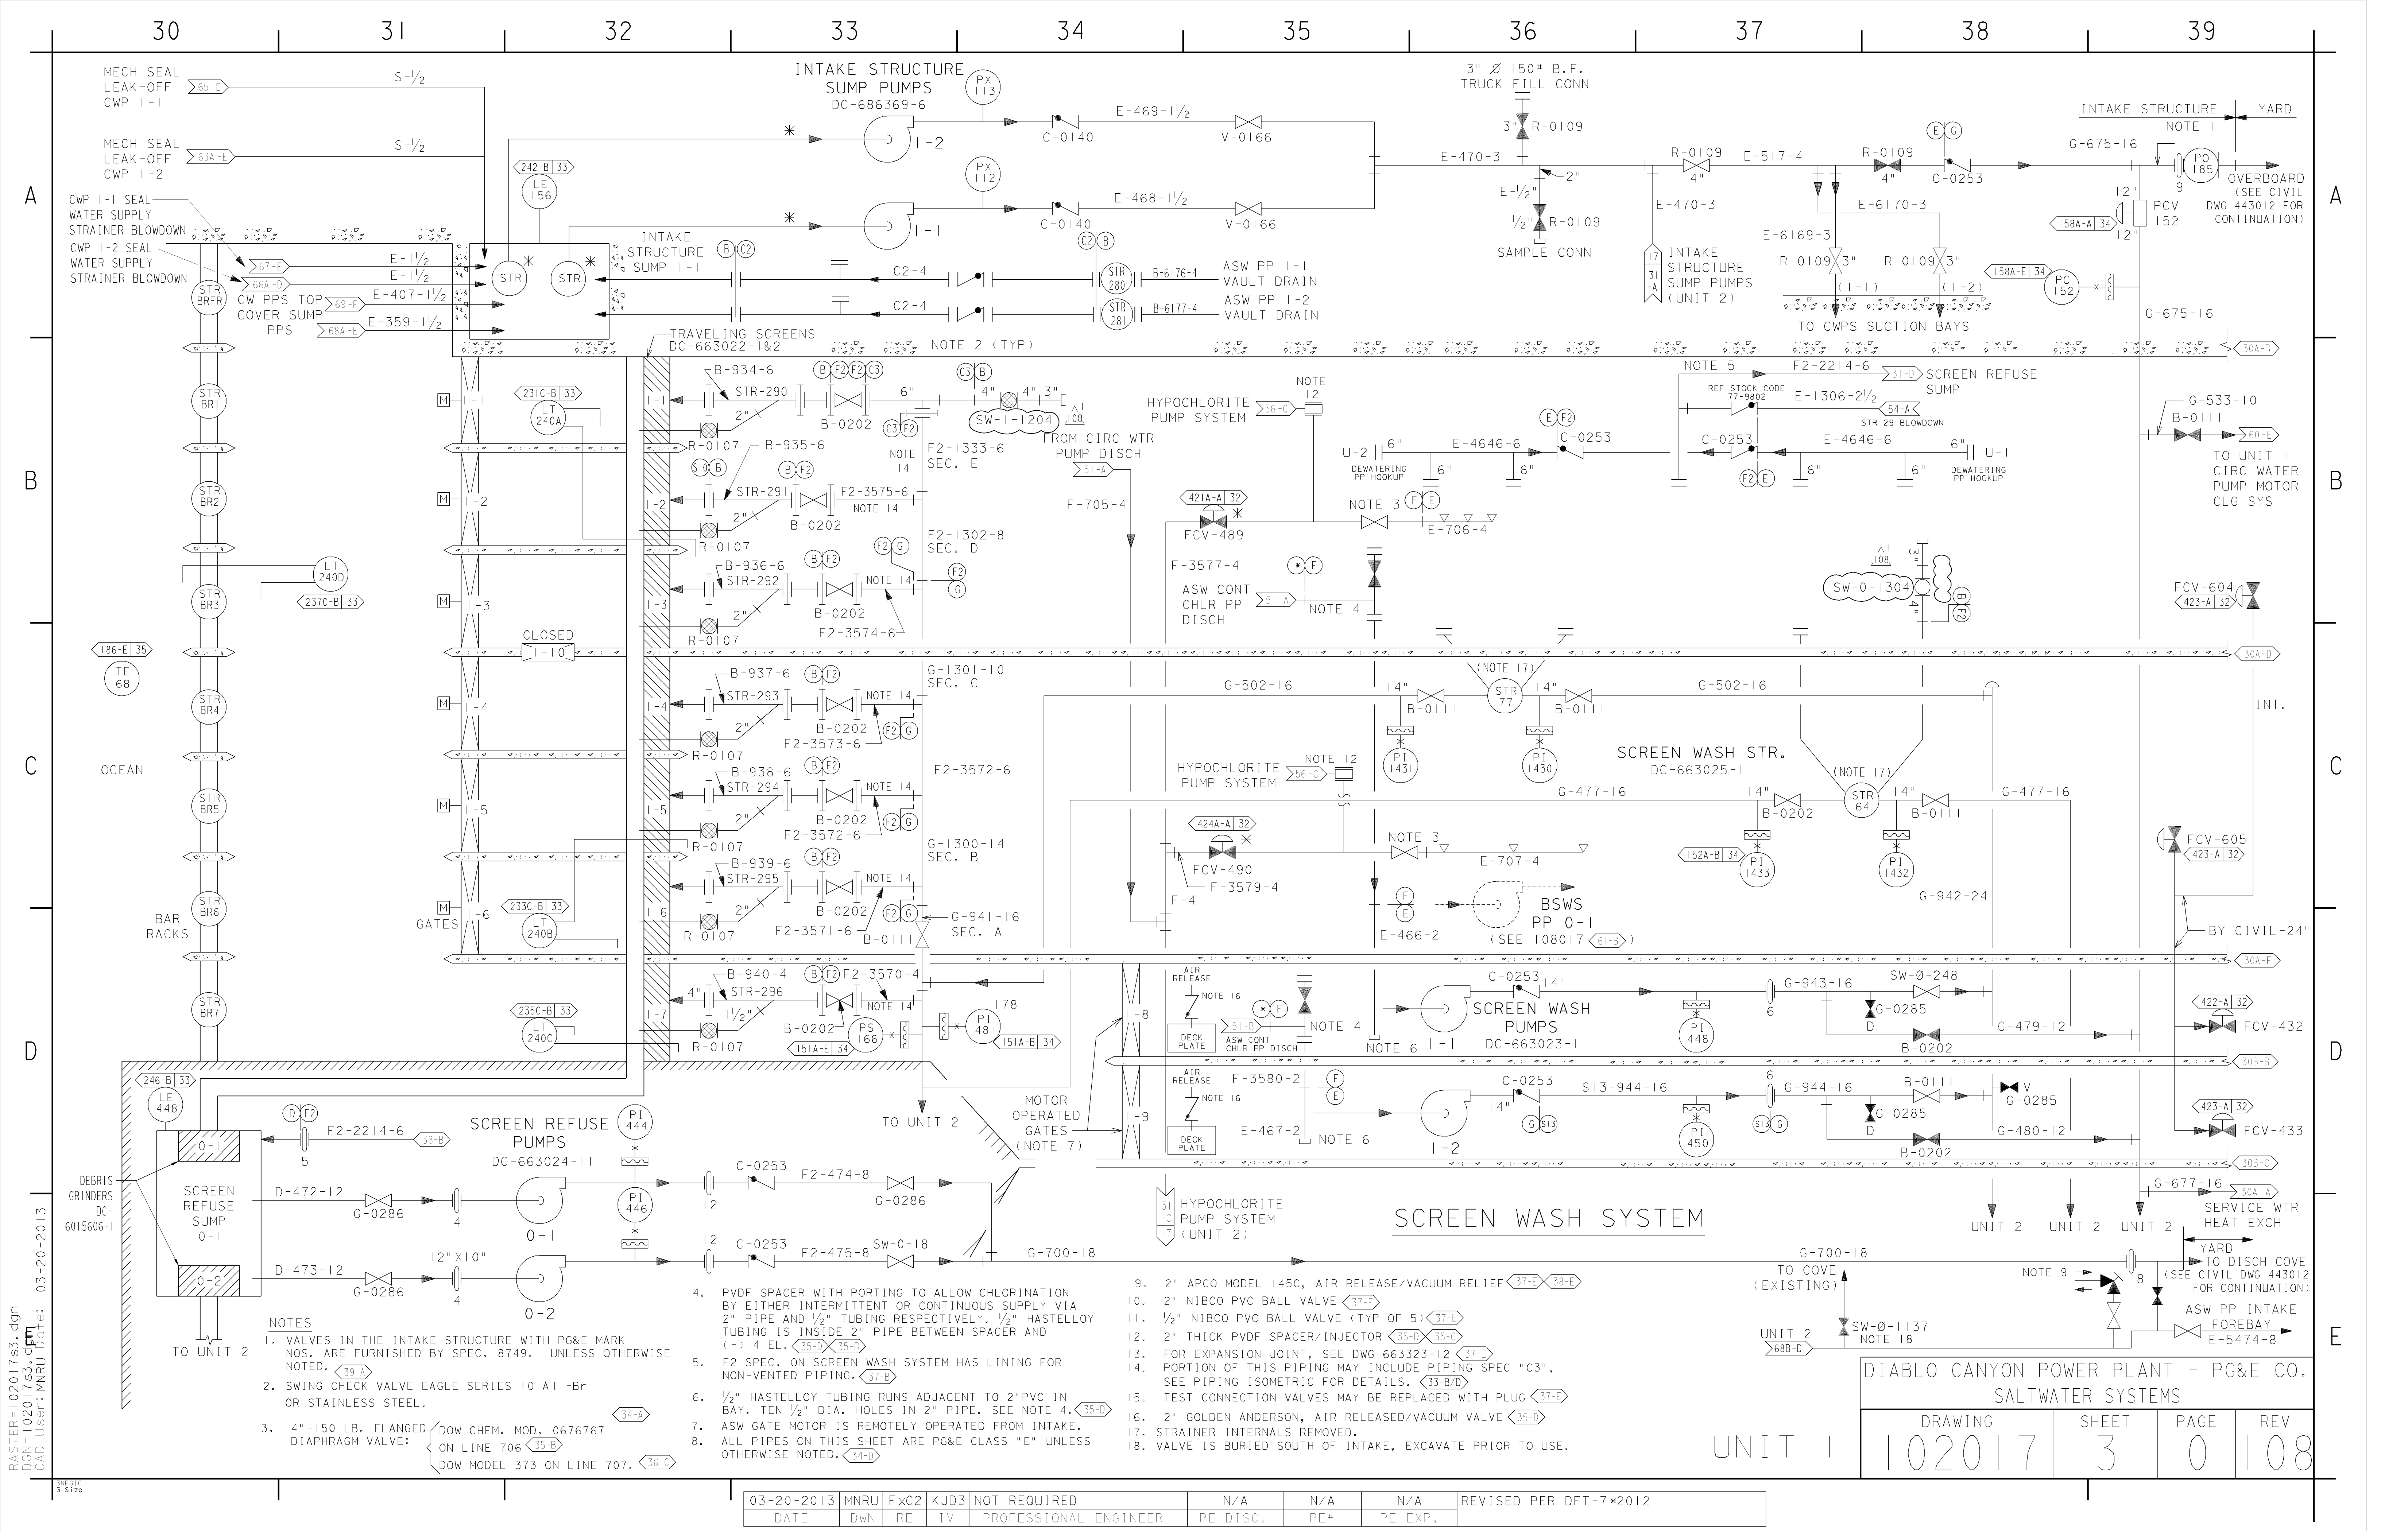

A

B

C

D

E

A

B

C

D

E

PASTER=102017.s3.dgn
DCN=102017.s3.dgn
CAD User: MNRU Date: 03-20-2013

3/12/2013

- NOTES
1. VALVES IN THE INTAKE STRUCTURE WITH PG&E MARK NOS. ARE FURNISHED BY SPEC. 8749. UNLESS OTHERWISE NOTED. (39-A)
 2. SWING CHECK VALVE EAGLE SERIES 10 A1 -Br OR STAINLESS STEEL.
 3. 4"-150 LB. FLANGED DIAPHRAGM VALVE:
 - DOW CHEM. MOD. 0676767
 - ON LINE 706 (35-B)
 - DOW MODEL 373 ON LINE 707. (36-C)

4. PVDF SPACER WITH PORTING TO ALLOW CHLORINATION BY EITHER INTERMITTENT OR CONTINUOUS SUPPLY VIA 2" PIPE AND 1/2" TUBING RESPECTIVELY. 1/2" HASTELLOY TUBING IS INSIDE 2" PIPE BETWEEN SPACER AND (-) 4 EL. (35-D) (35-B)
5. F2 SPEC. ON SCREEN WASH SYSTEM HAS LINING FOR NON-VENTED PIPING. (37-B)
6. 1/2" HASTELLOY TUBING RUNS ADJACENT TO 2"PVC IN BAY. TEN 1/2" DIA. HOLES IN 2" PIPE. SEE NOTE 4. (35-D)
7. ASW GATE MOTOR IS REMOTELY OPERATED FROM INTAKE.
8. ALL PIPES ON THIS SHEET ARE PG&E CLASS "E" UNLESS OTHERWISE NOTED. (34-D)
9. 2" APCO MODEL 145C, AIR RELEASE/VACUUM RELIEF (37-E) (38-E)
10. 2" NIBCO PVC BALL VALVE (37-E)
11. 1/2" NIBCO PVC BALL VALVE (TYP OF 5) (37-E)
12. 2" THICK PVDF SPACER/INJECTOR (35-D) (35-C)
13. FOR EXPANSION JOINT, SEE DWG 663323-12 (37-B)
14. PORTION OF THIS PIPING MAY INCLUDE PIPING SPEC "C3", SEE PIPING ISOMETRIC FOR DETAILS. (33-B/D)
15. TEST CONNECTION VALVES MAY BE REPLACED WITH PLUG (37-B)
16. 2" GOLDEN ANDERSON, AIR RELEASED/VACUUM VALVE (35-D)
17. STRAINER INTERNALS REMOVED.
18. VALVE IS BURIED SOUTH OF INTAKE, EXCAVATE PRIOR TO USE.

03-20-2013	MNRU	FxC2	KJD3	NOT REQUIRED	N/A	N/A	N/A	REVISED PER DFT-7*2012
DATE	DWN	RE	IV	PROFESSIONAL ENGINEER	PE DISC.	PE #	PE EXP.	

DIABLO CANYON POWER PLANT - PG&E CO.
SALTWATER SYSTEMS

DRAWING	SHEET	PAGE	REV
102017	3	0	108

UNIT 1

A

B

C

D

E


A

B

C

D

E

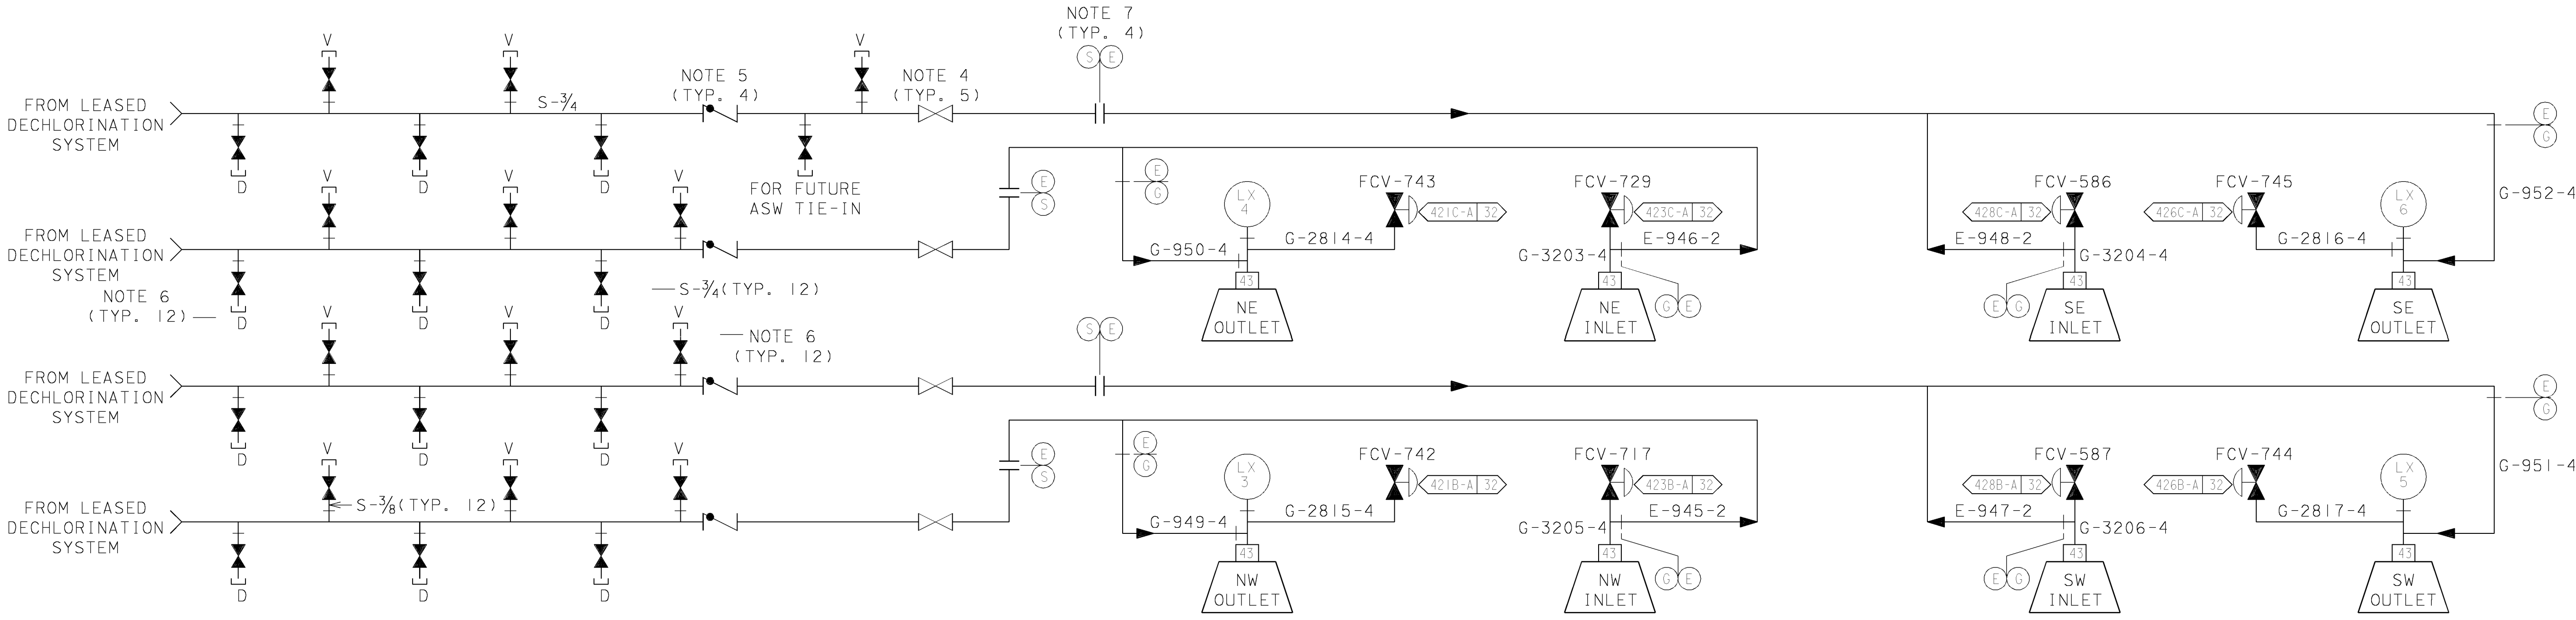

MAIN CONDENSER WATER BOX VENT SYSTEM

NOTES

1. ALL PIPING ON THIS SHEET IS PG&E CLASS E UNLESS OTHERWISE NOTED.

2. DEMUSSELING PROCEDURE STARTS AFTER THE SCREENS OF BOTH UNITS HAVE BEEN WASHED. (42-C)

3. TEMPORARY CONNECTION INSTALLED AT FX FOR FRESH WATER DEMUSSELING PROCESS, WHICH IS USED AS ALTERNATIVE TO H.T. DEMUSSELING. (47-B)
4. WHITEY SS-63TS13. (44-D)

5. NUPRO SS-CH12-10 (43-D)

6. WHITEY SS-44S6 (43-D)

7. COMPLIES WITH "S" SPEC EXCEPT 3/4" TUBING WHICH HAS .065" WALL AND FLANGES ARE 2" 150# FFSW A182 GR F304. (44-D)

UNIT 1


P G & E CO.		102017	REV.
SHEET 4	PAGE 0		68


6/22/99	CMG9	FXC2	-	KERSI J. DALAL	MECHANICAL	M 16690	3/31/2000	Enhanced per FCT 023917
DATE	DWN	RE	IV	PROFESSIONAL ENGINEER	PE DISC.	PE#	PE EXP.	

CAD User: CMG9 Date: 6-22-1999
DGN: 2017S4.DGN

SNPDTG

67

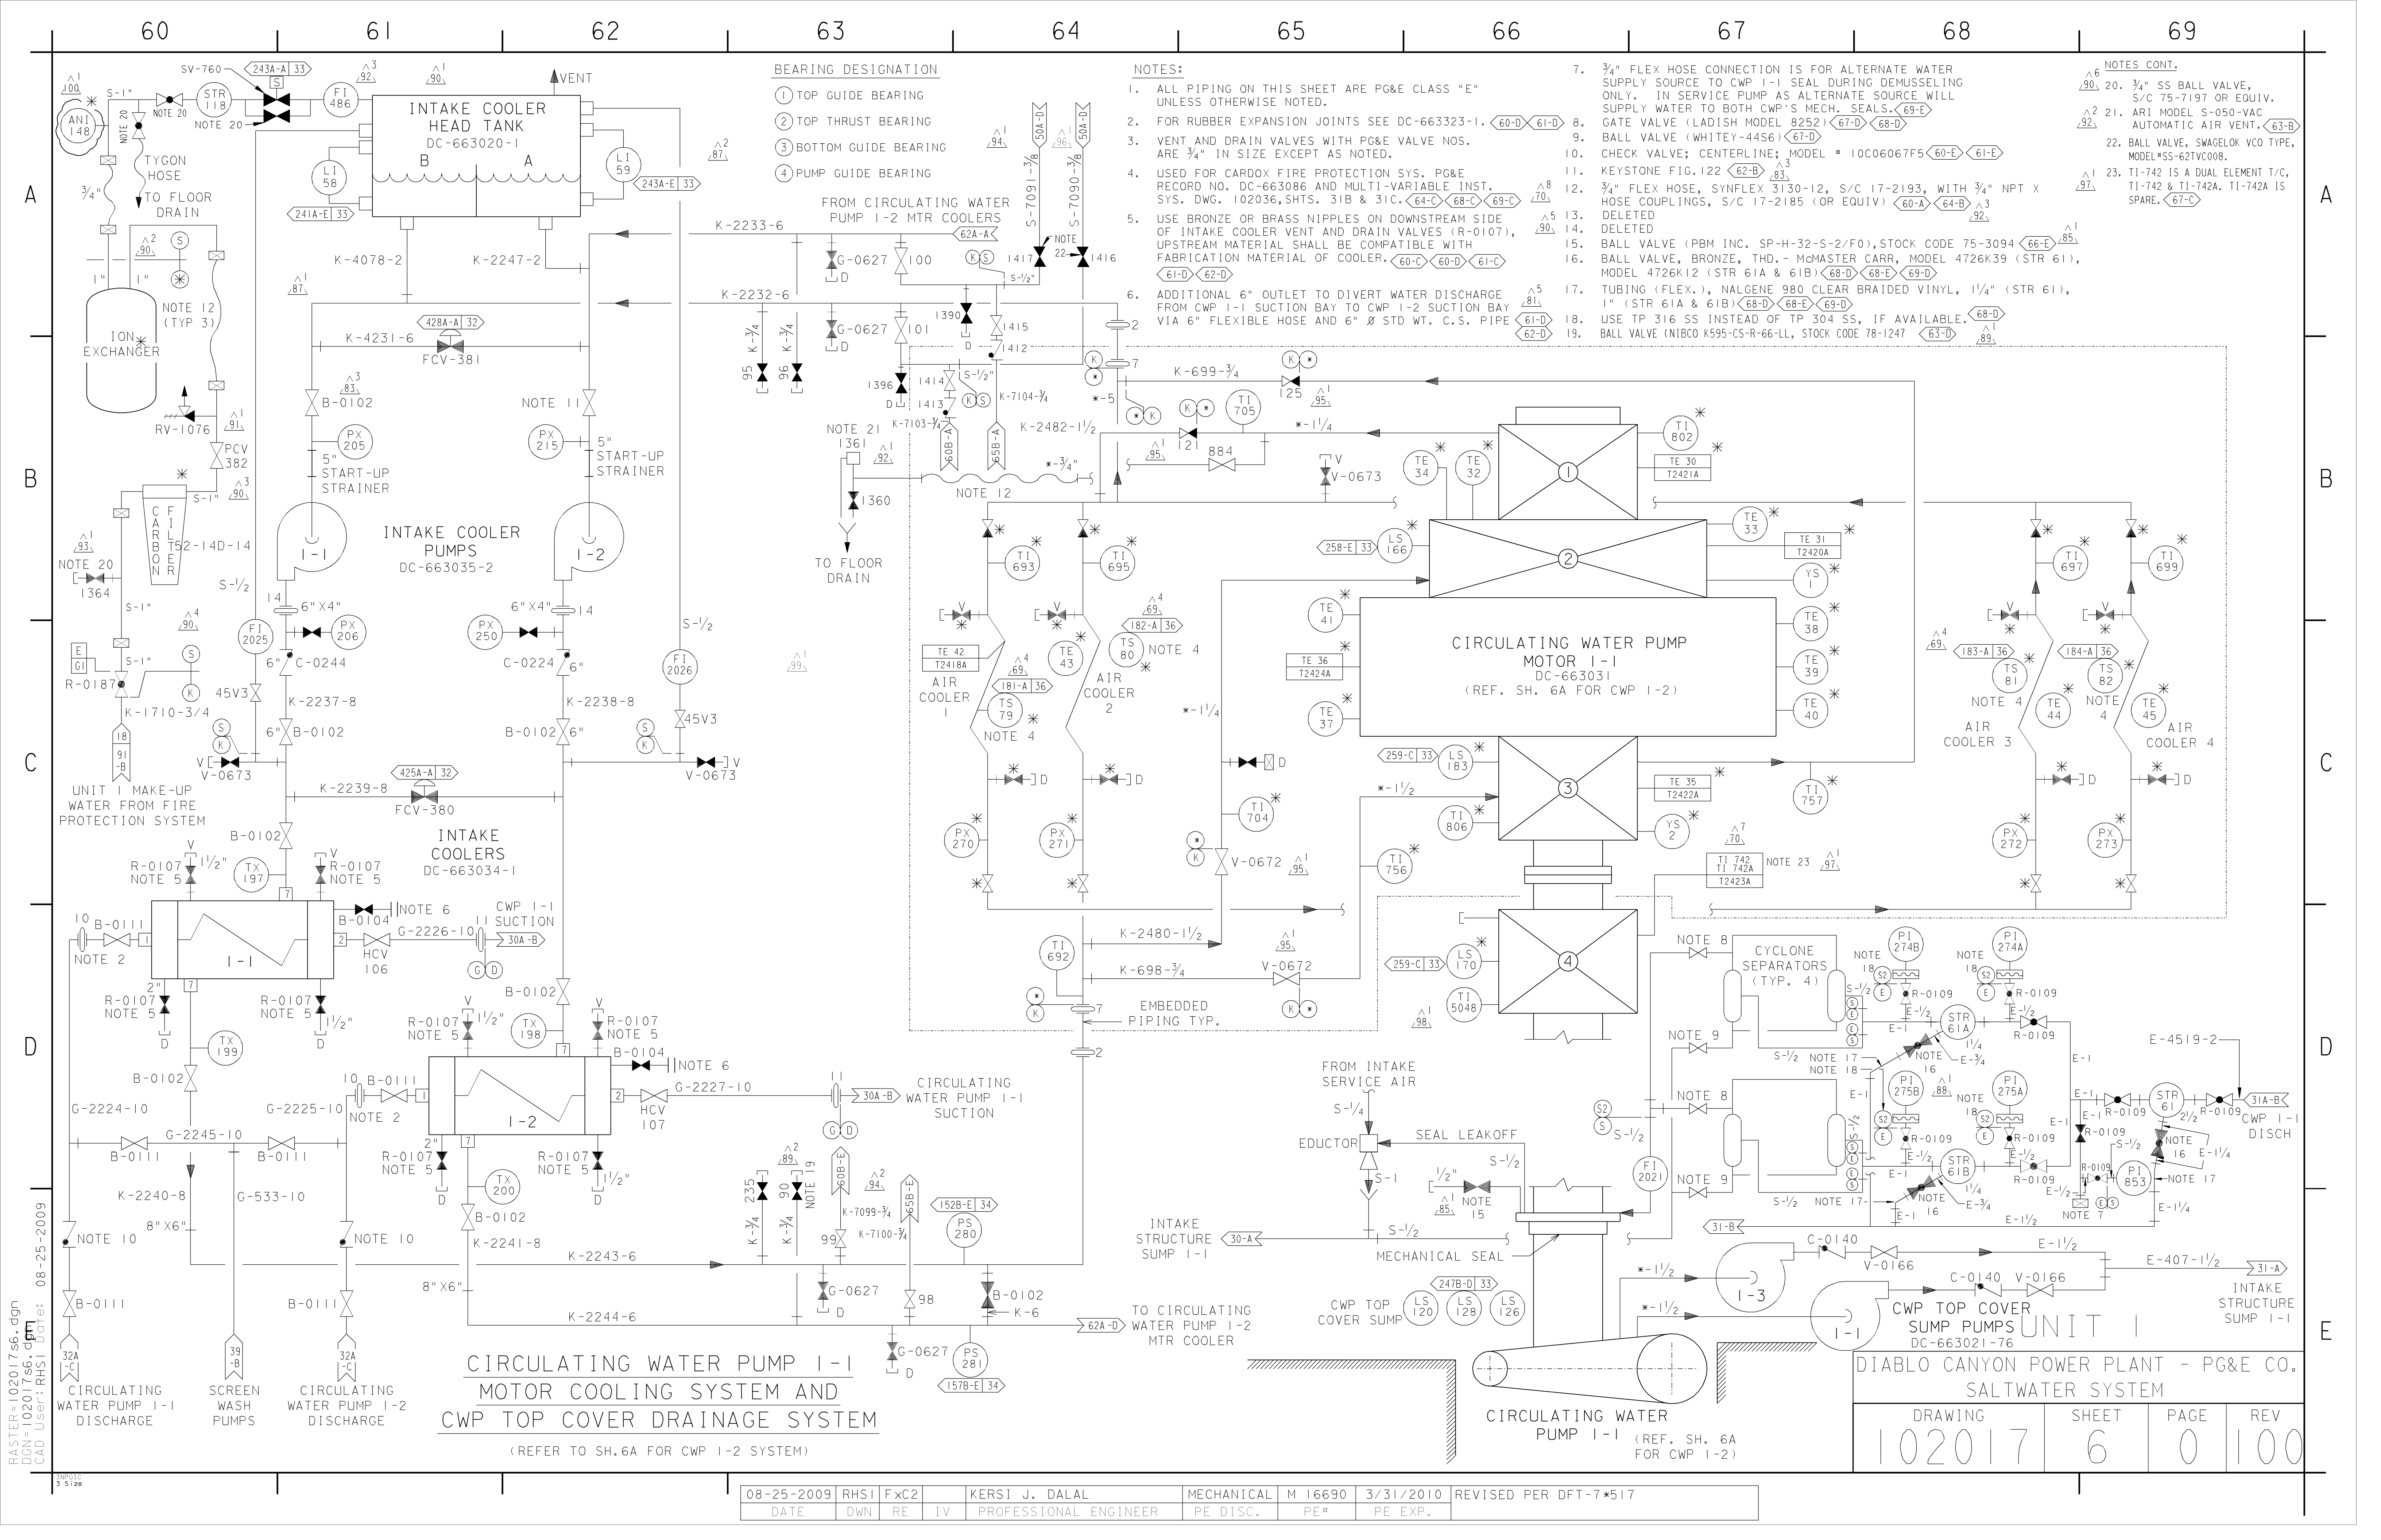

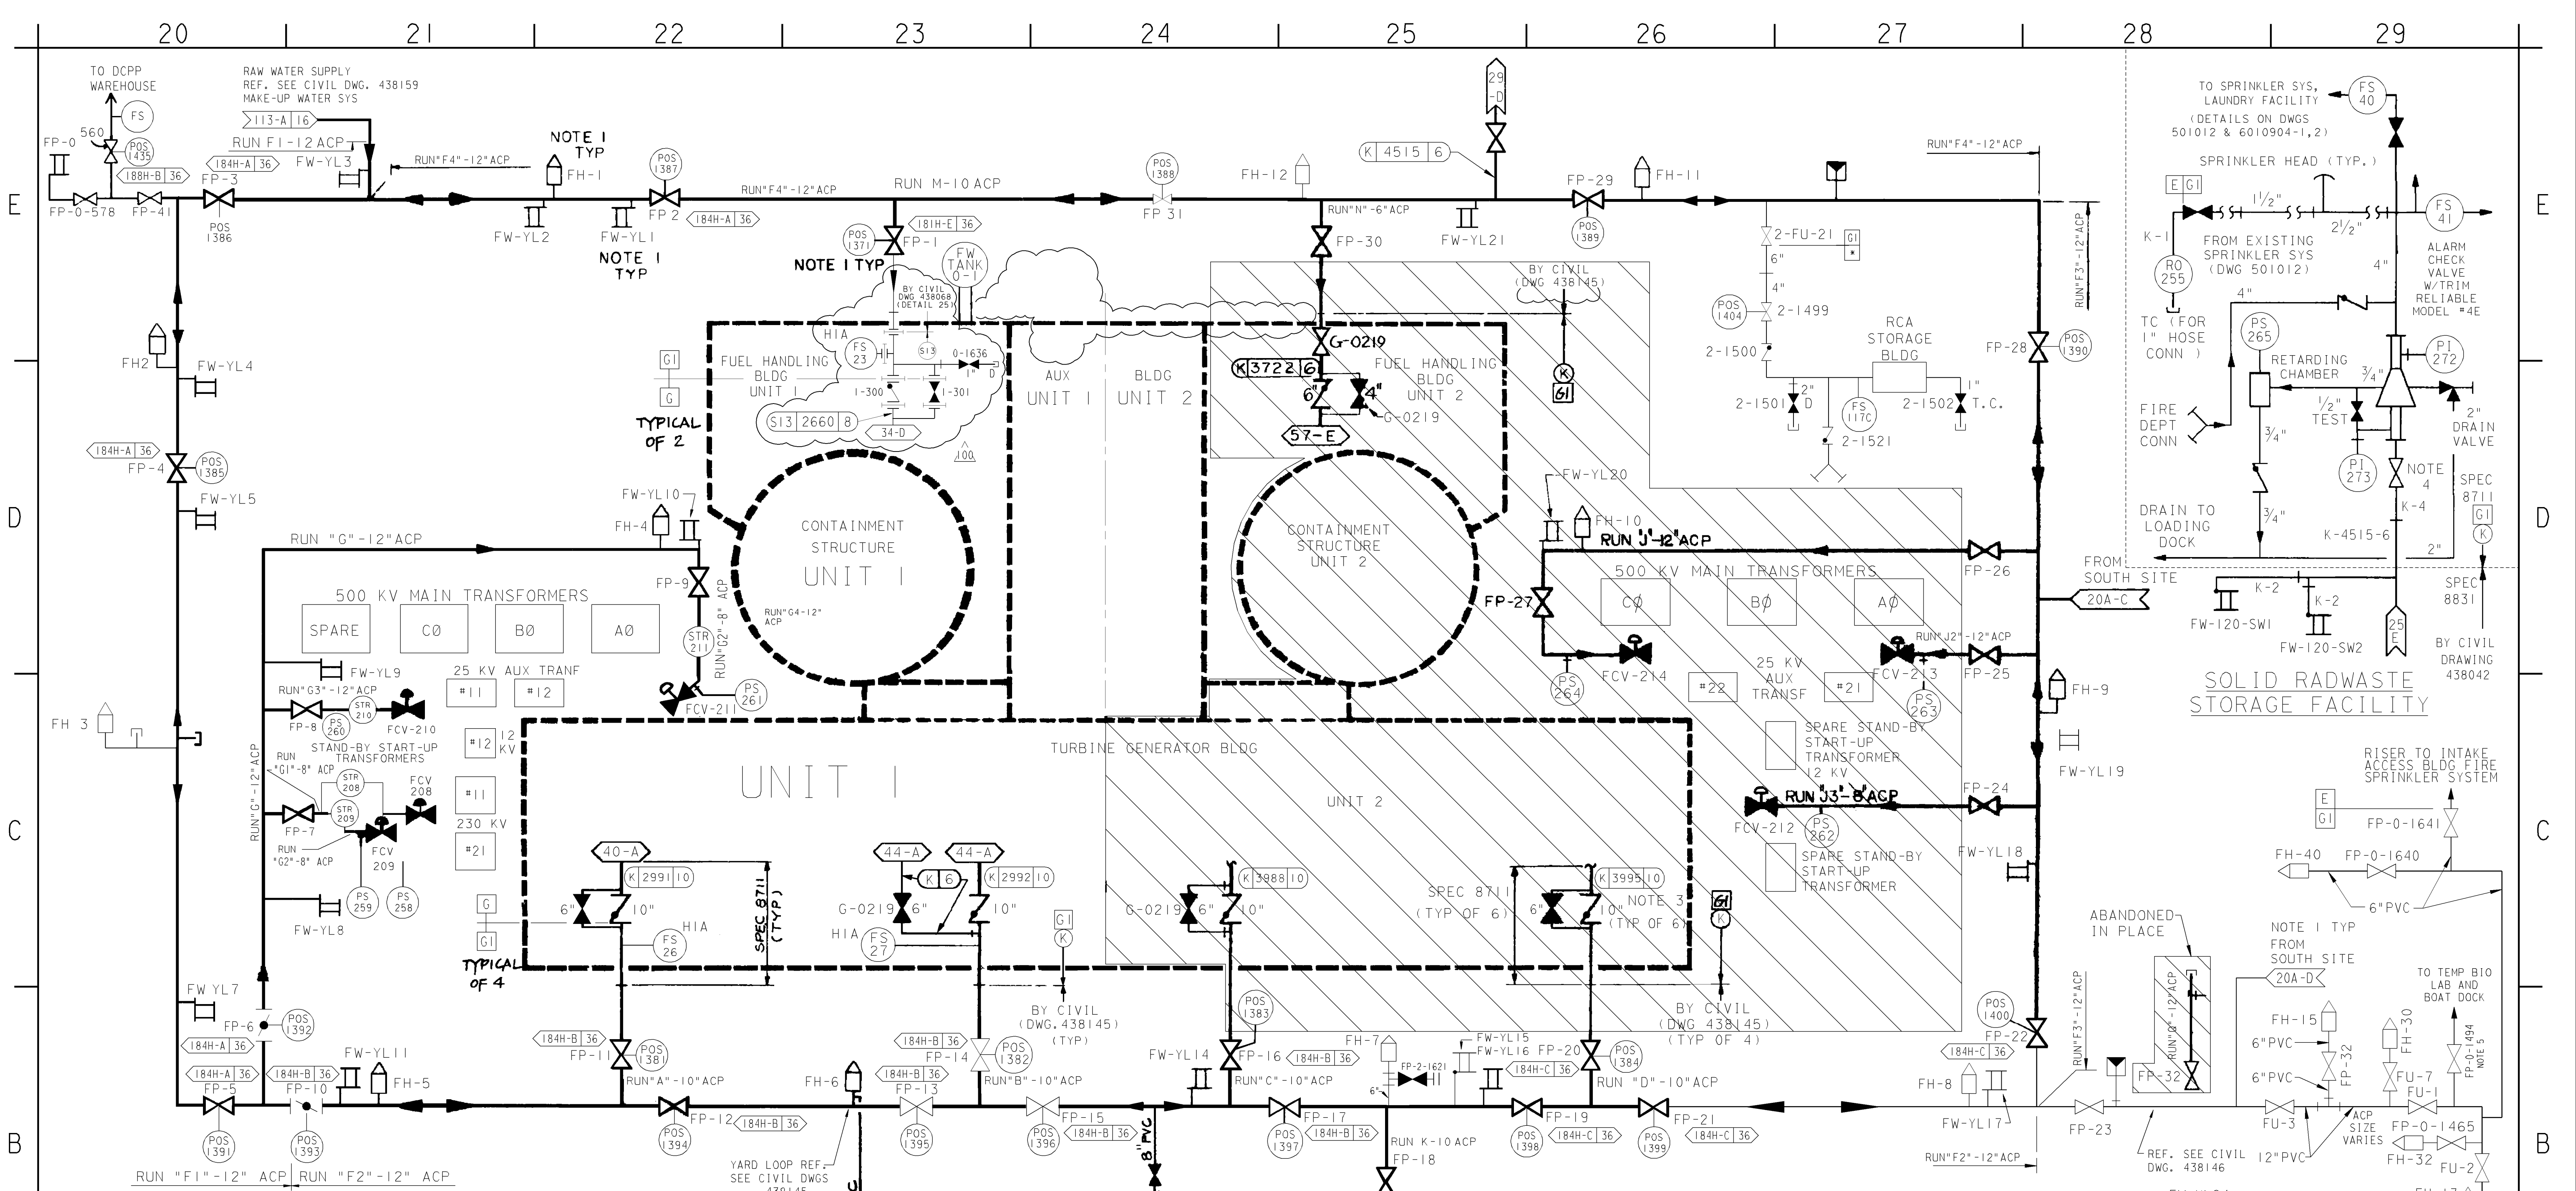


- NOTES:
- LEGEND ACP ASBESTOS CEMENT PIPE
FH FIRE HYDRANT FH (22-E)
FW FIREWATER HOSEREEL FW (22-E)
FP POST INDICATOR ISOLATION VALVE FP (23-E)
FU UNDERGROUND VALVE FU (29-B)
BV BUTTERFLY VALVE (20-B)
 - ALL OUTDOOR PIPING AND VALVES ON THIS SHEET ARE BY CIVIL UNDER SPEC 8831 EXCEPT TRANS DELUGE SYSTEMS (FCV 208, 209, 210, 211, 212, 213 & 214) WHICH ARE UNDER SPEC 8724 OR AS NOTED MECH PIPING VALVES.
 - CHECK VALVES ARE CRANE 150#, 147- 1/2 GATE VALVES ARE CRANE 150#, 147-1/2, EXCEPT AS SHOWN.
 - 4" KENNEDY 70240 175# (29-D)
 - VALVE FP-0-1494 IS BURIED AND INACCESSIBLE.

REFERENCE DRAWINGS
(TRANSFORMER DELUGE SYSTEM)
DC663086-67,69,70,71,78,203 THRU 213,220 & 221
FIRE WATER HOSEREEL STATION DETAILS 064358 AND 064359
(LAUNDRY FACILITY AND RADWASTE STORAGE SPRINKLER PIPING)
DC-6010904-1,2 (29-E)
(SOLID RADWASTE STORAGE BUILDING DRAINAGE & FIRE PROTECTION) 501012

DIABLO CANYON POWER PLANT - PG&E CO. FIRE PROTECTION SYSTEMS			
DRAWING	SHEET	PAGE	REV
102018	2	0	100

09-17-2013	MNRU	FxC2	KJD3	NOT REQUIRED	N/A	N/A	N/A	REVISED PER DDN-2*426
DATE	DWN	RE	IV	PROFESSIONAL ENGINEER	PE DISC.	PE#	PE EXP.	



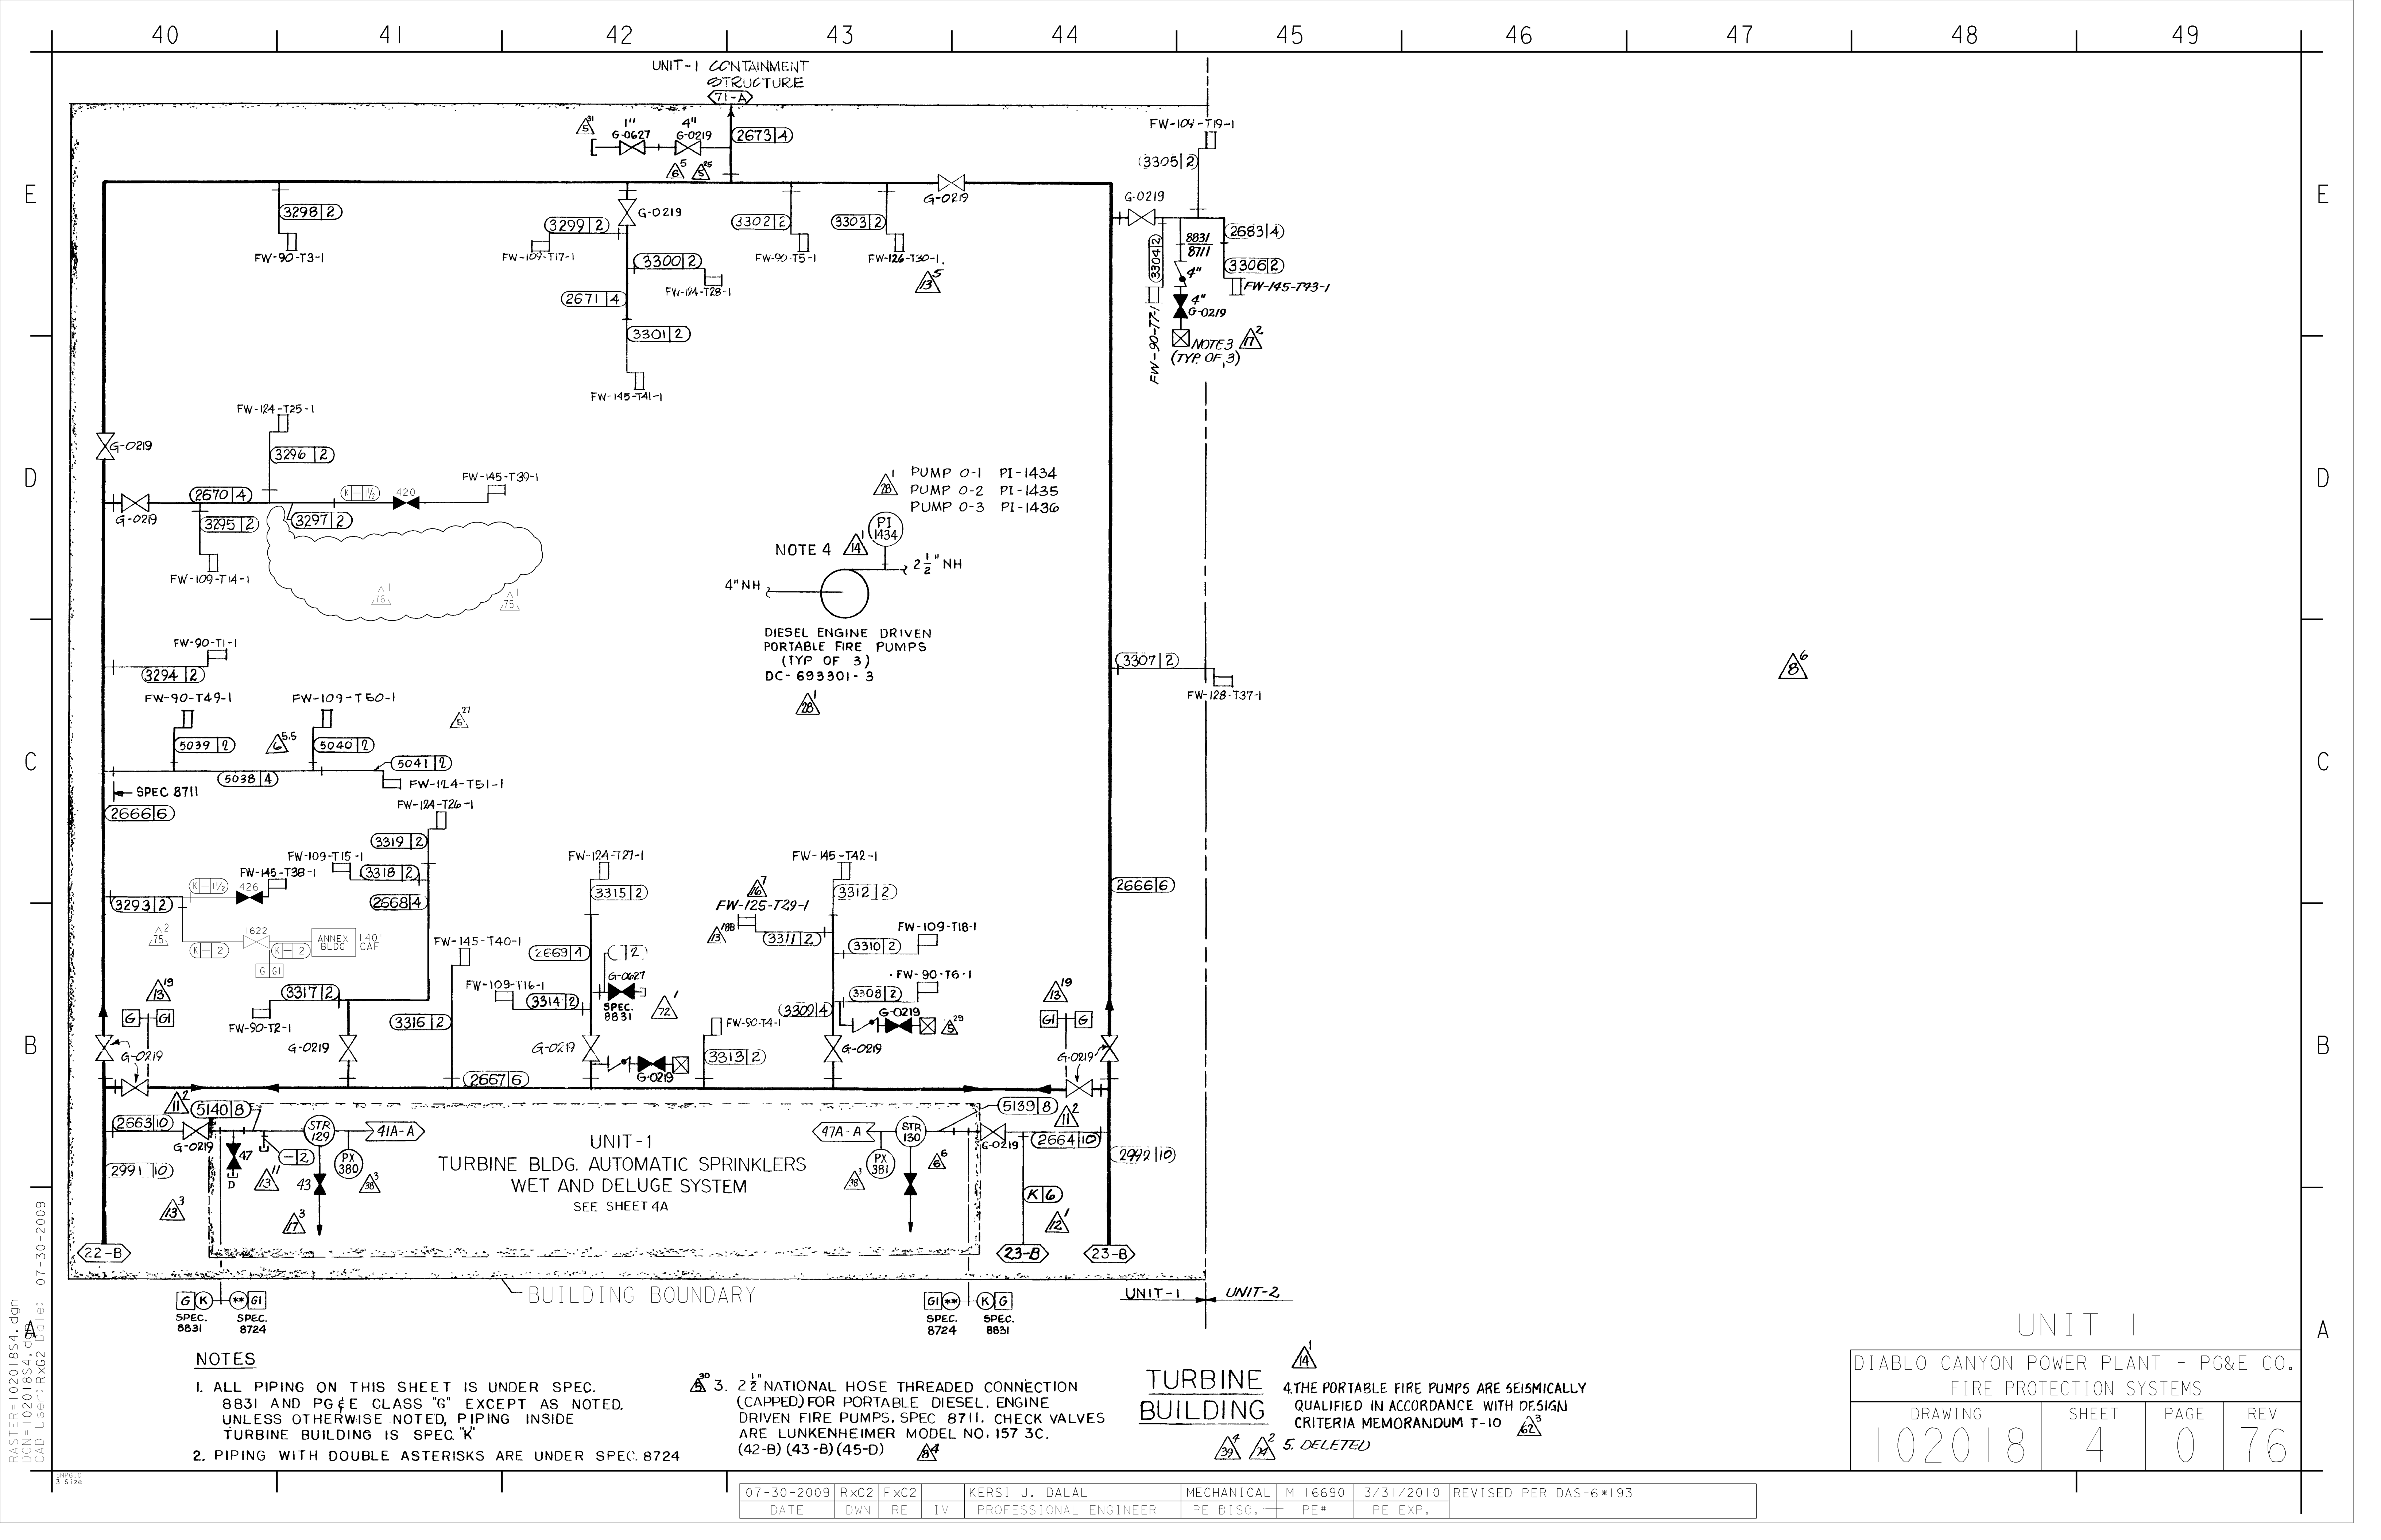

NOTES


1. ALL PIPING ON THIS SHEET IS UNDER SPEC. 8831 AND PG&E CLASS "G" EXCEPT AS NOTED. UNLESS OTHERWISE NOTED, PIPING INSIDE TURBINE BUILDING IS SPEC. "K"
2. PIPING WITH DOUBLE ASTERISKS ARE UNDER SPEC. 8724
3. 2 1/2" NATIONAL HOSE THREADED CONNECTION (CAPPED) FOR PORTABLE DIESEL ENGINE DRIVEN FIRE PUMPS. SPEC. 8711. CHECK VALVES ARE LUNKENHEIMER MODEL NO. 157 3C. (42-B) (43-B) (45-D)
4. THE PORTABLE FIRE PUMPS ARE SEISMICALLY QUALIFIED IN ACCORDANCE WITH DESIGN CRITERIA MEMORANDUM T-10
5. DELETED

TURBINE BUILDING

DIABLO CANYON POWER PLANT - PG&E CO.
FIRE PROTECTION SYSTEMS

DRAWING	SHEET	PAGE	REV
102018	4	0	76


07-30-2009	RxG2	FxC2		KERSI J. DALAL	MECHANICAL	M 16690	3/31/2010	REVISED PER DAS-6*193
DATE	DWN	RE	IV	PROFESSIONAL ENGINEER	PE DISC.	PE*	PE EXP.	

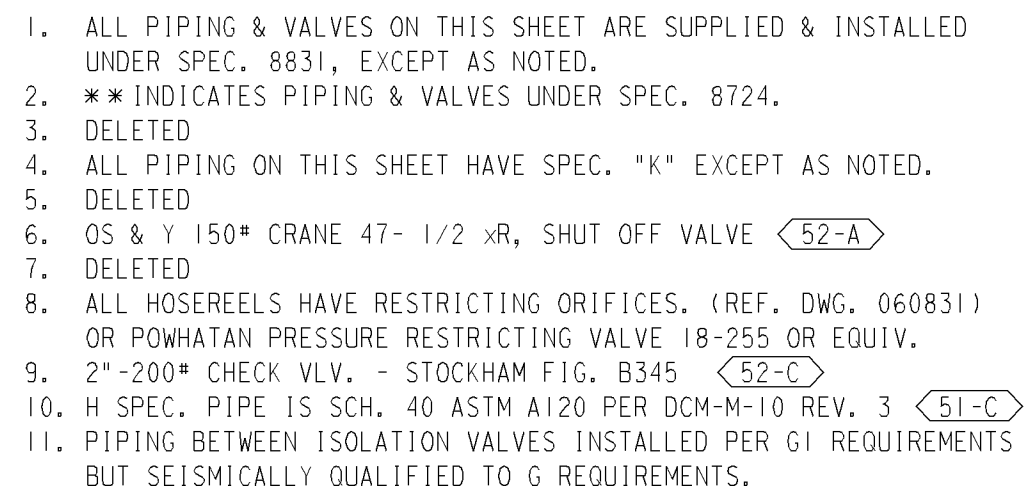

UNIT 1

DRAWING	SHEET	PAGE	REV
102018	5	0	82


A

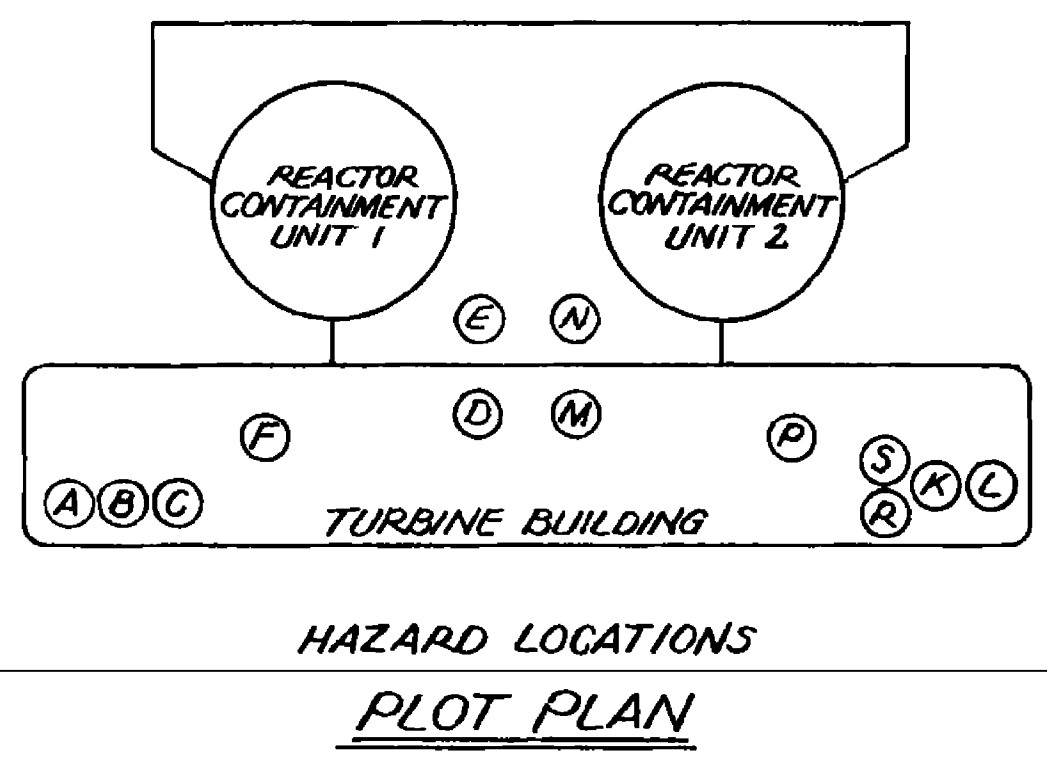

B

GENERATOR GAS MANIFOLD
TGS 22B-61
UNIT 1


PILOT SUPPLY (FCV-215)
PILOT SUPPLY (FCV-104)
PILOT SUPPLY (FCV-103)
PILOT SUPPLY (FCV-101)
PILOT SUPPLY (FCV-101)
UNIT 2

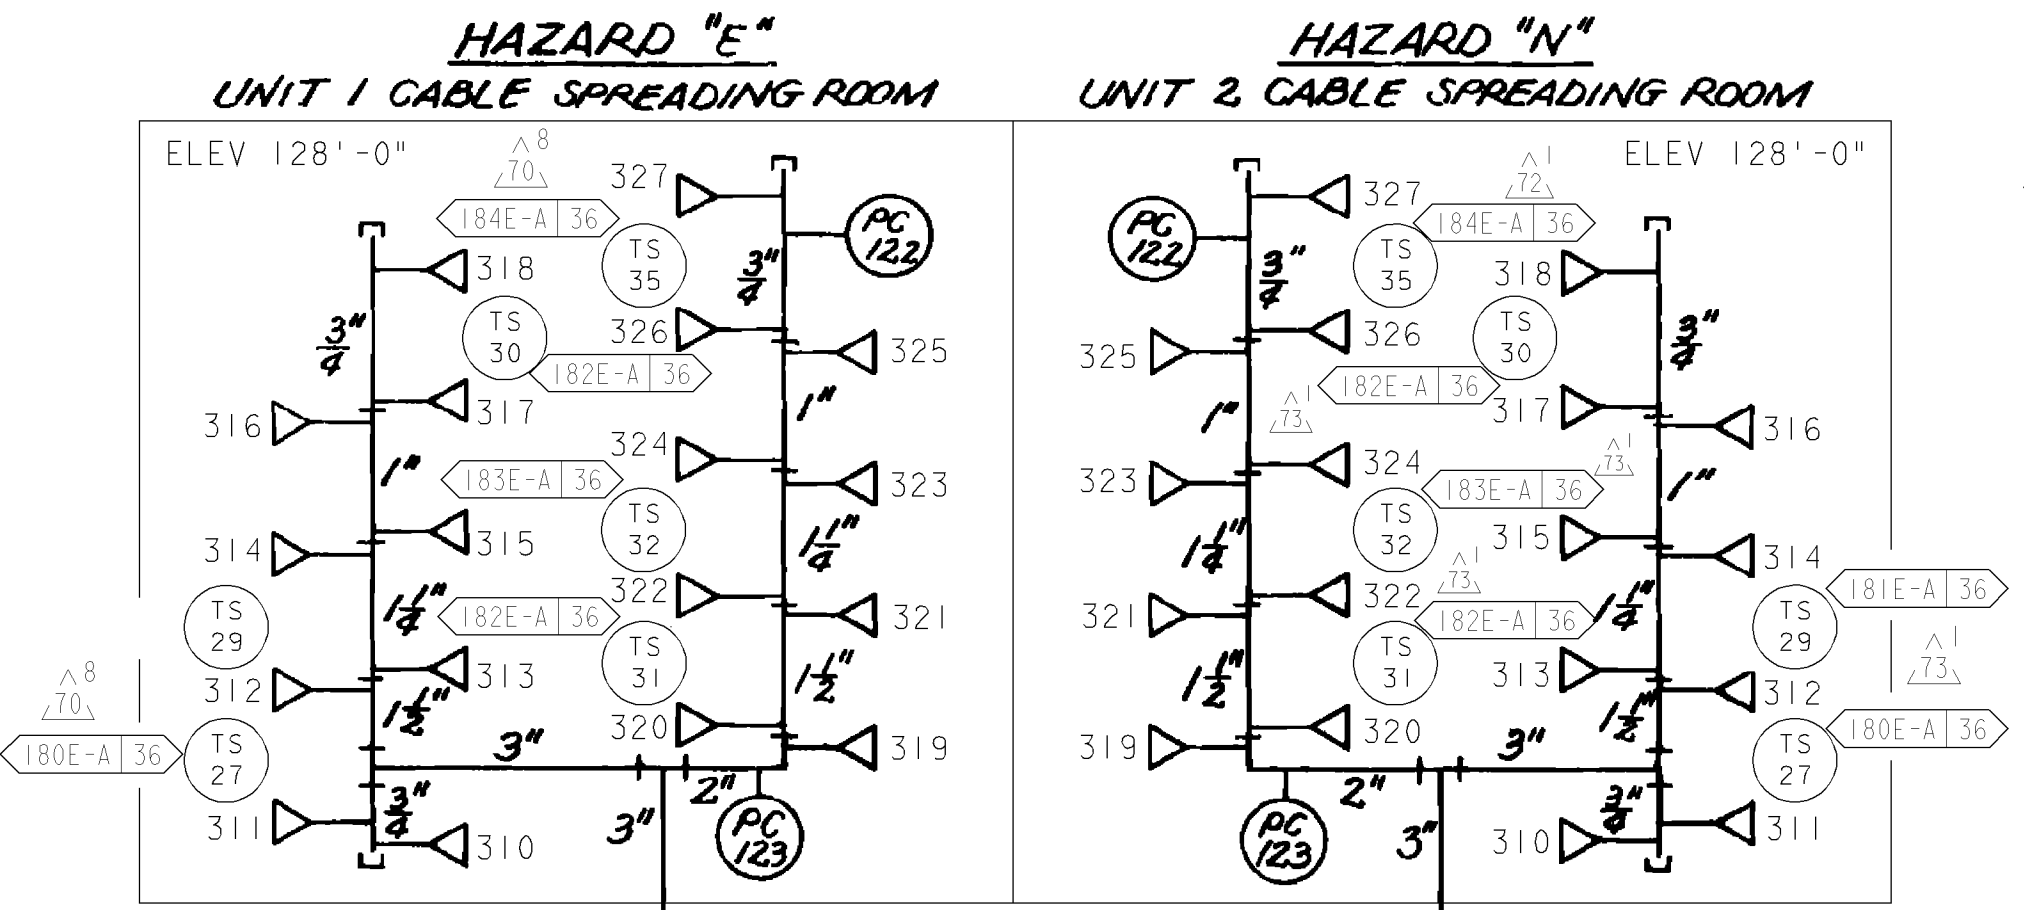


- NOTES:
- 1 FOR INSTRUMENT SCHEMATIC REFERENCE, SEE SHEETS 18B, 18C & 18E OF DWG 102036 AND SHEET 18E OF DWG 108036.
 - 2 ** INDICATES PIPING UNDER SPEC 8724 OR SATISFIES NFPA-12 PIPING REQUIREMENTS.
 - 3 ALL PIPING IS CLASS "GI" EXCEPT AS NOTED.
 - 4 ALARMS WHEN MAIN SHUTOFF VALVE IS CLOSED.
 - 5 CARDOX ODORIZER ASSEMBLY MODEL NO 24824 AND 1 1/2" BALL VALVE CHEMETRON NO 1 061-0711 WITH LOCKING DEVICE NO 5 061-0773.
 - 6 FOR ADDITIONAL INFORMATION ON CYLINDER FILLING UNIT, REF DC 663088-6.
 - 7 DELETED

C

HAZARD "D"
TURB LUBE OIL RM 1
ELEV 104'-0"

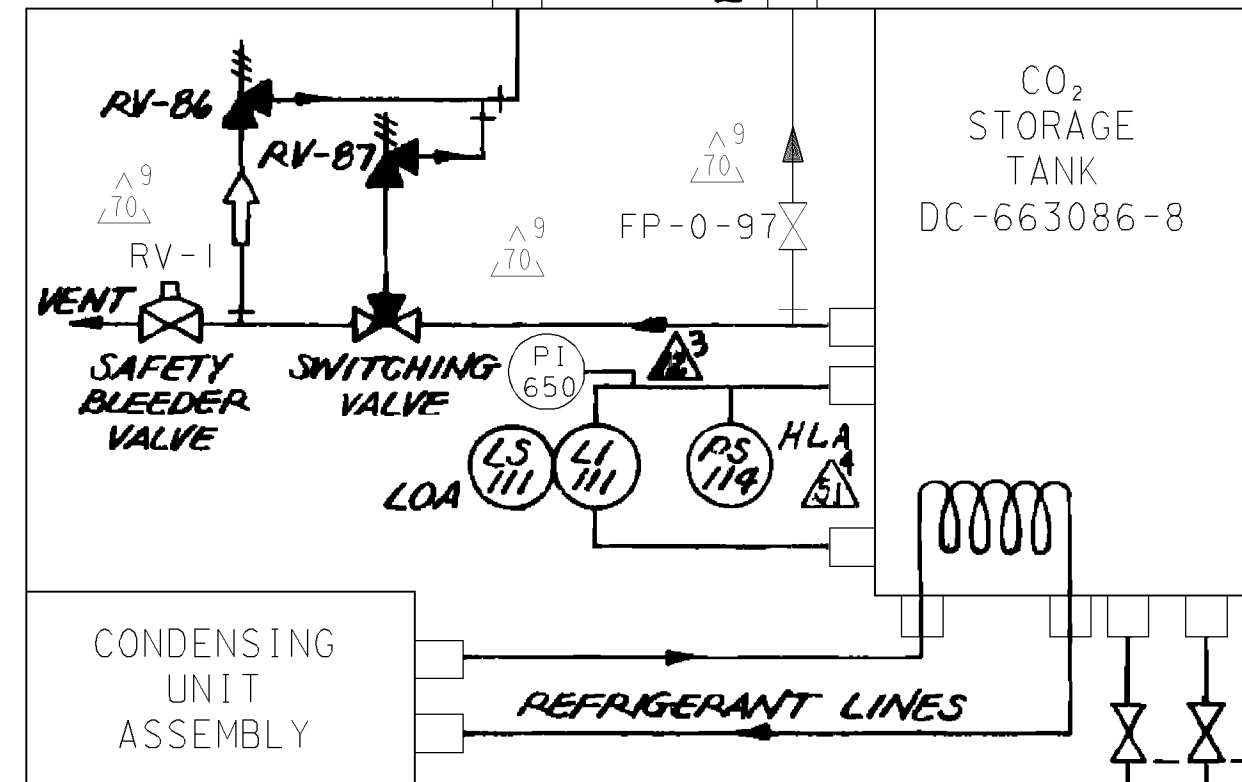


HAZARD "M"
TURB LUBE OIL RM 1
ELEV 104'-0"

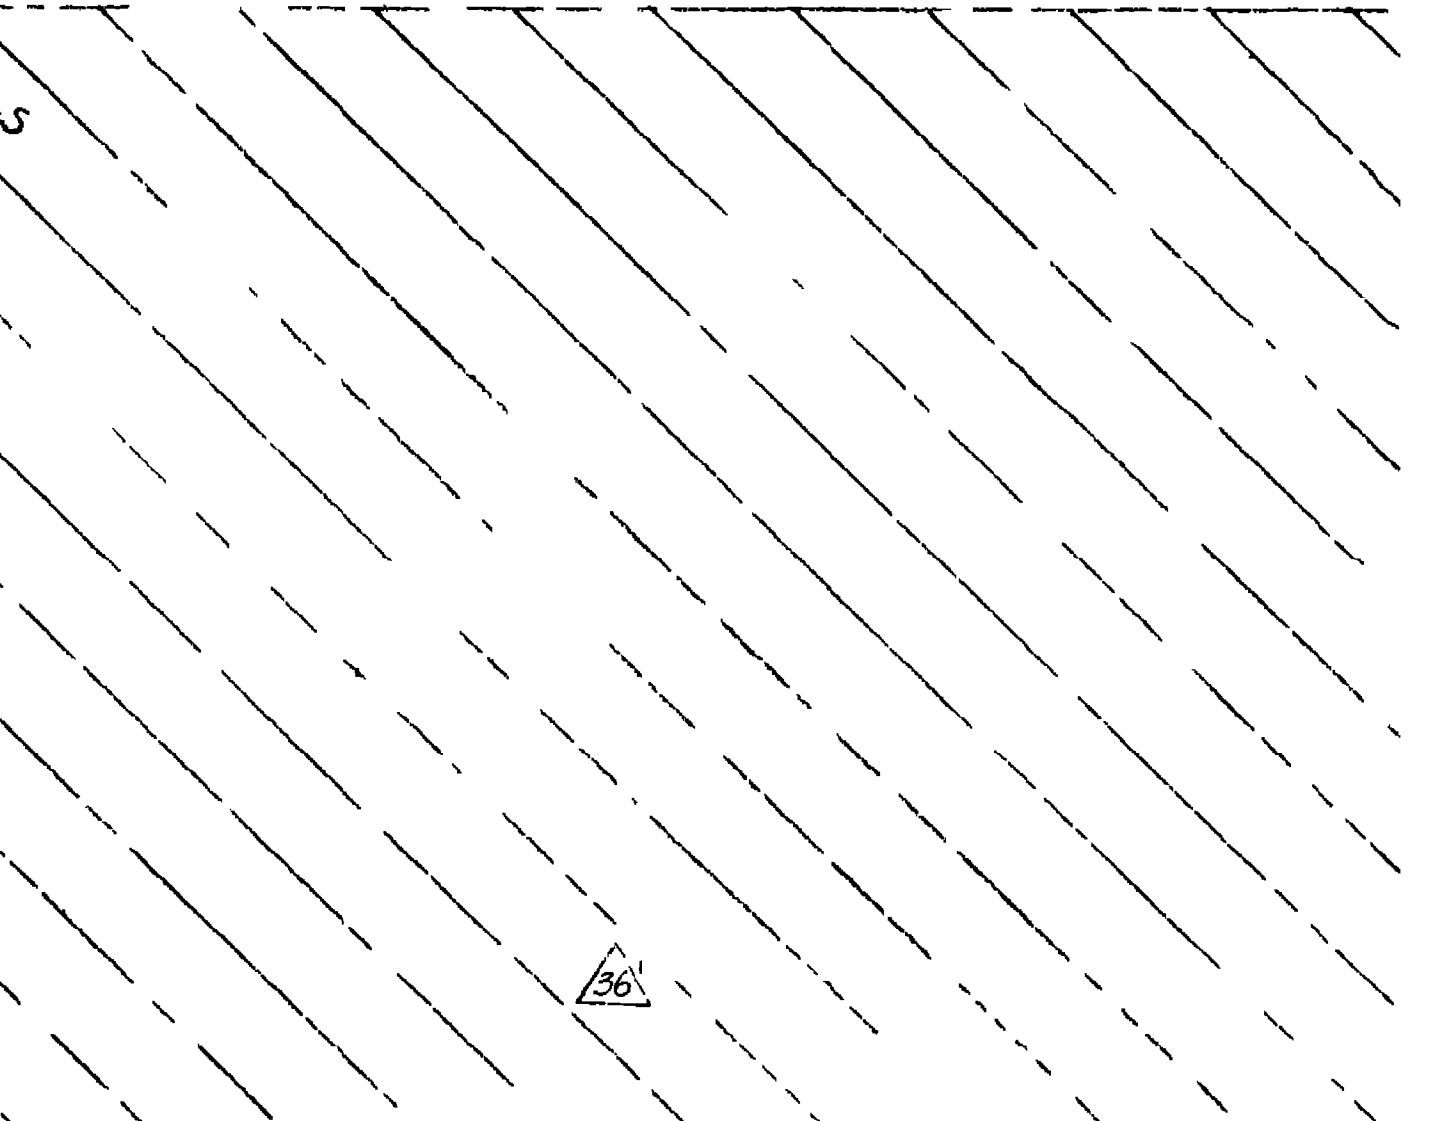


D



HAZARD "F"
TURB GEN BEARING NO. 10

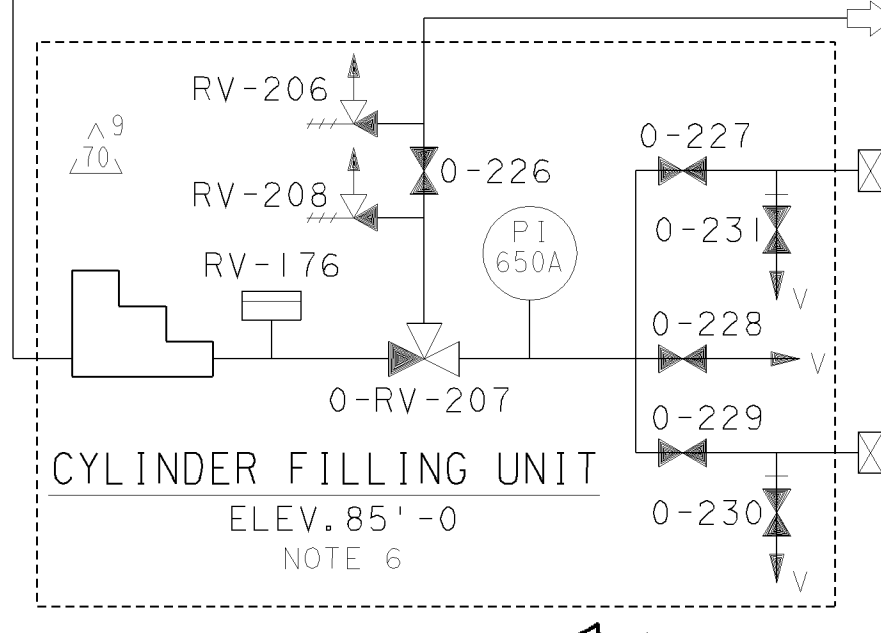

CO2 STORAGE UNIT 0-1

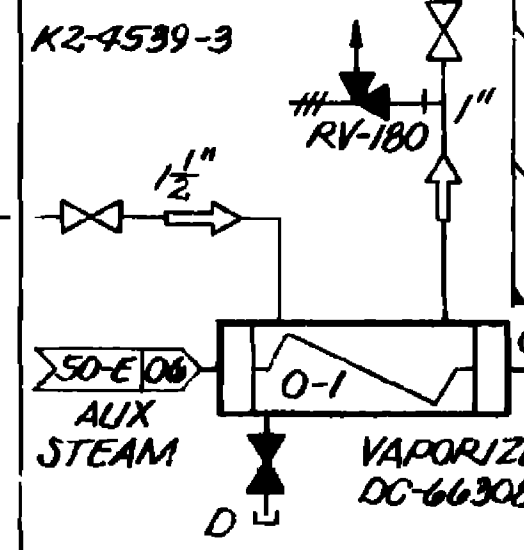

HAZARD "S"
CLASS I DOC STOR RM

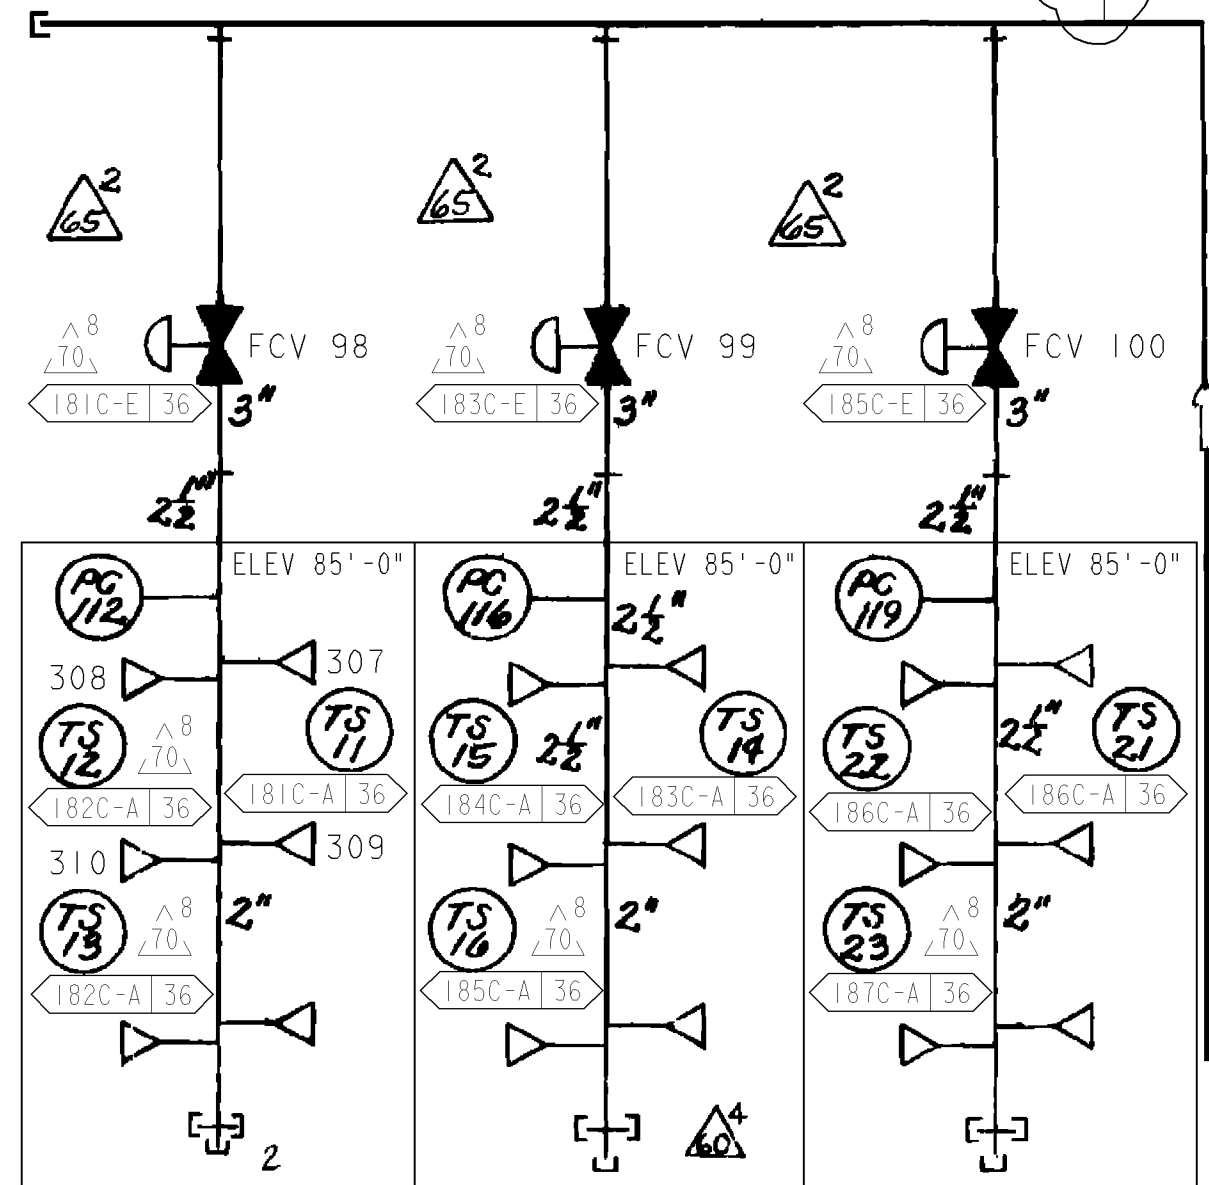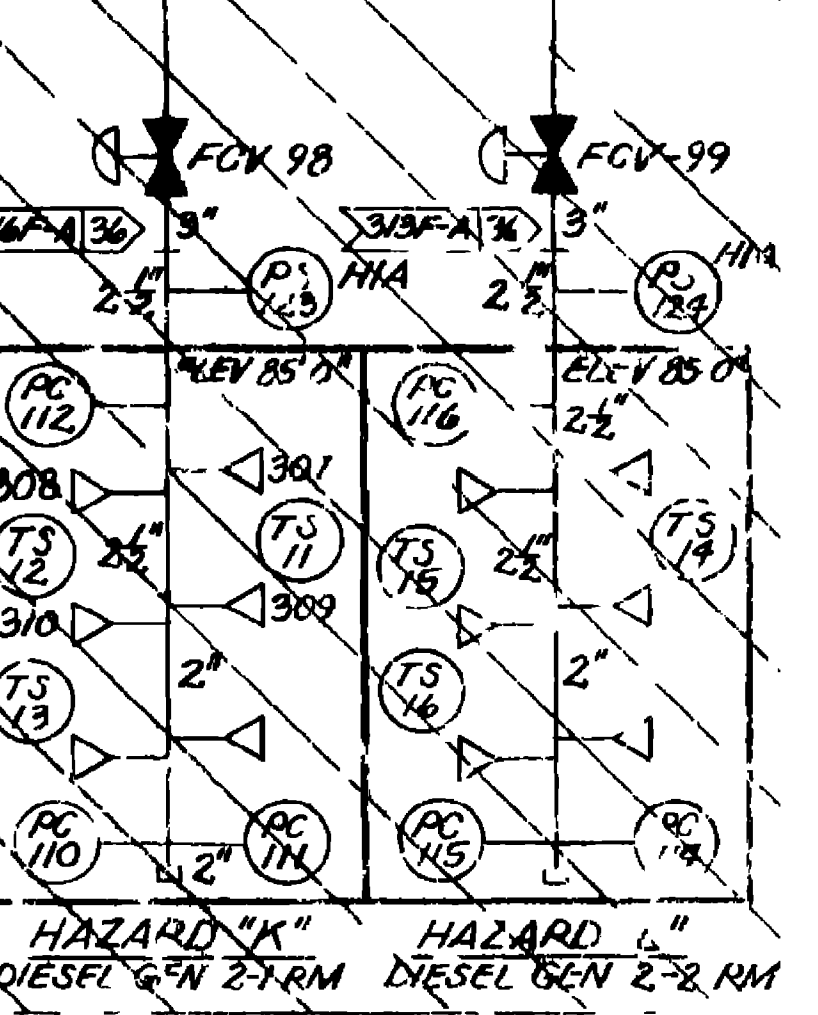

CARBON DIOXIDE FIRE PROTECTION SYSTEM
HAZARD SPRAY HEADS
REF DC-663086-1&2



UNIT 1

DIABLO CANYON POWER PLANT - PG&E CO. FIRE PROTECTION SYSTEMS			
DRAWING	SHEET	PAGE	REV
102018	6	0	74

RASTER=2018s6.dgn
DGN=2018s6.dgn
CAD User: JBMX Date: 03-31-2011

03-31-2011	JBMX	Fxc2	KERSI J. DALAL	MECHANICAL	M 16690	3/31/2012	REVISED PER DFT-7*1100
DATE	DWN	RE	IV	PE DISC.	PE*	PE EXP.	

- NOTES:
- 1. ALL PIPING WITH PG&E CLASS 'G' IS UNDER SPEC. 8831, EXCEPT AS NOTED.
 - 2. ALL PIPING WITH PG&E CLASS 'B', 'E' & 'G' IS UNDER SPEC. 8711.
 - 3. EACH RCP HAS 5 SPRINKLER HEADS FOR FIRE PROTECTION (T5-C)
 - 4. ALL HOSE REELS HAVE RESTRICTING ORIFICES (REF. DWG. 060831), OR POWHATAN PRESSURE RESTRICTING VALVE 18-255 OR EQUIV.
 - 5. 3/4" GATE VALVE, VELAN, DWG. NO 6006473-166, STOCK CODE 93-6841 (T2-C)

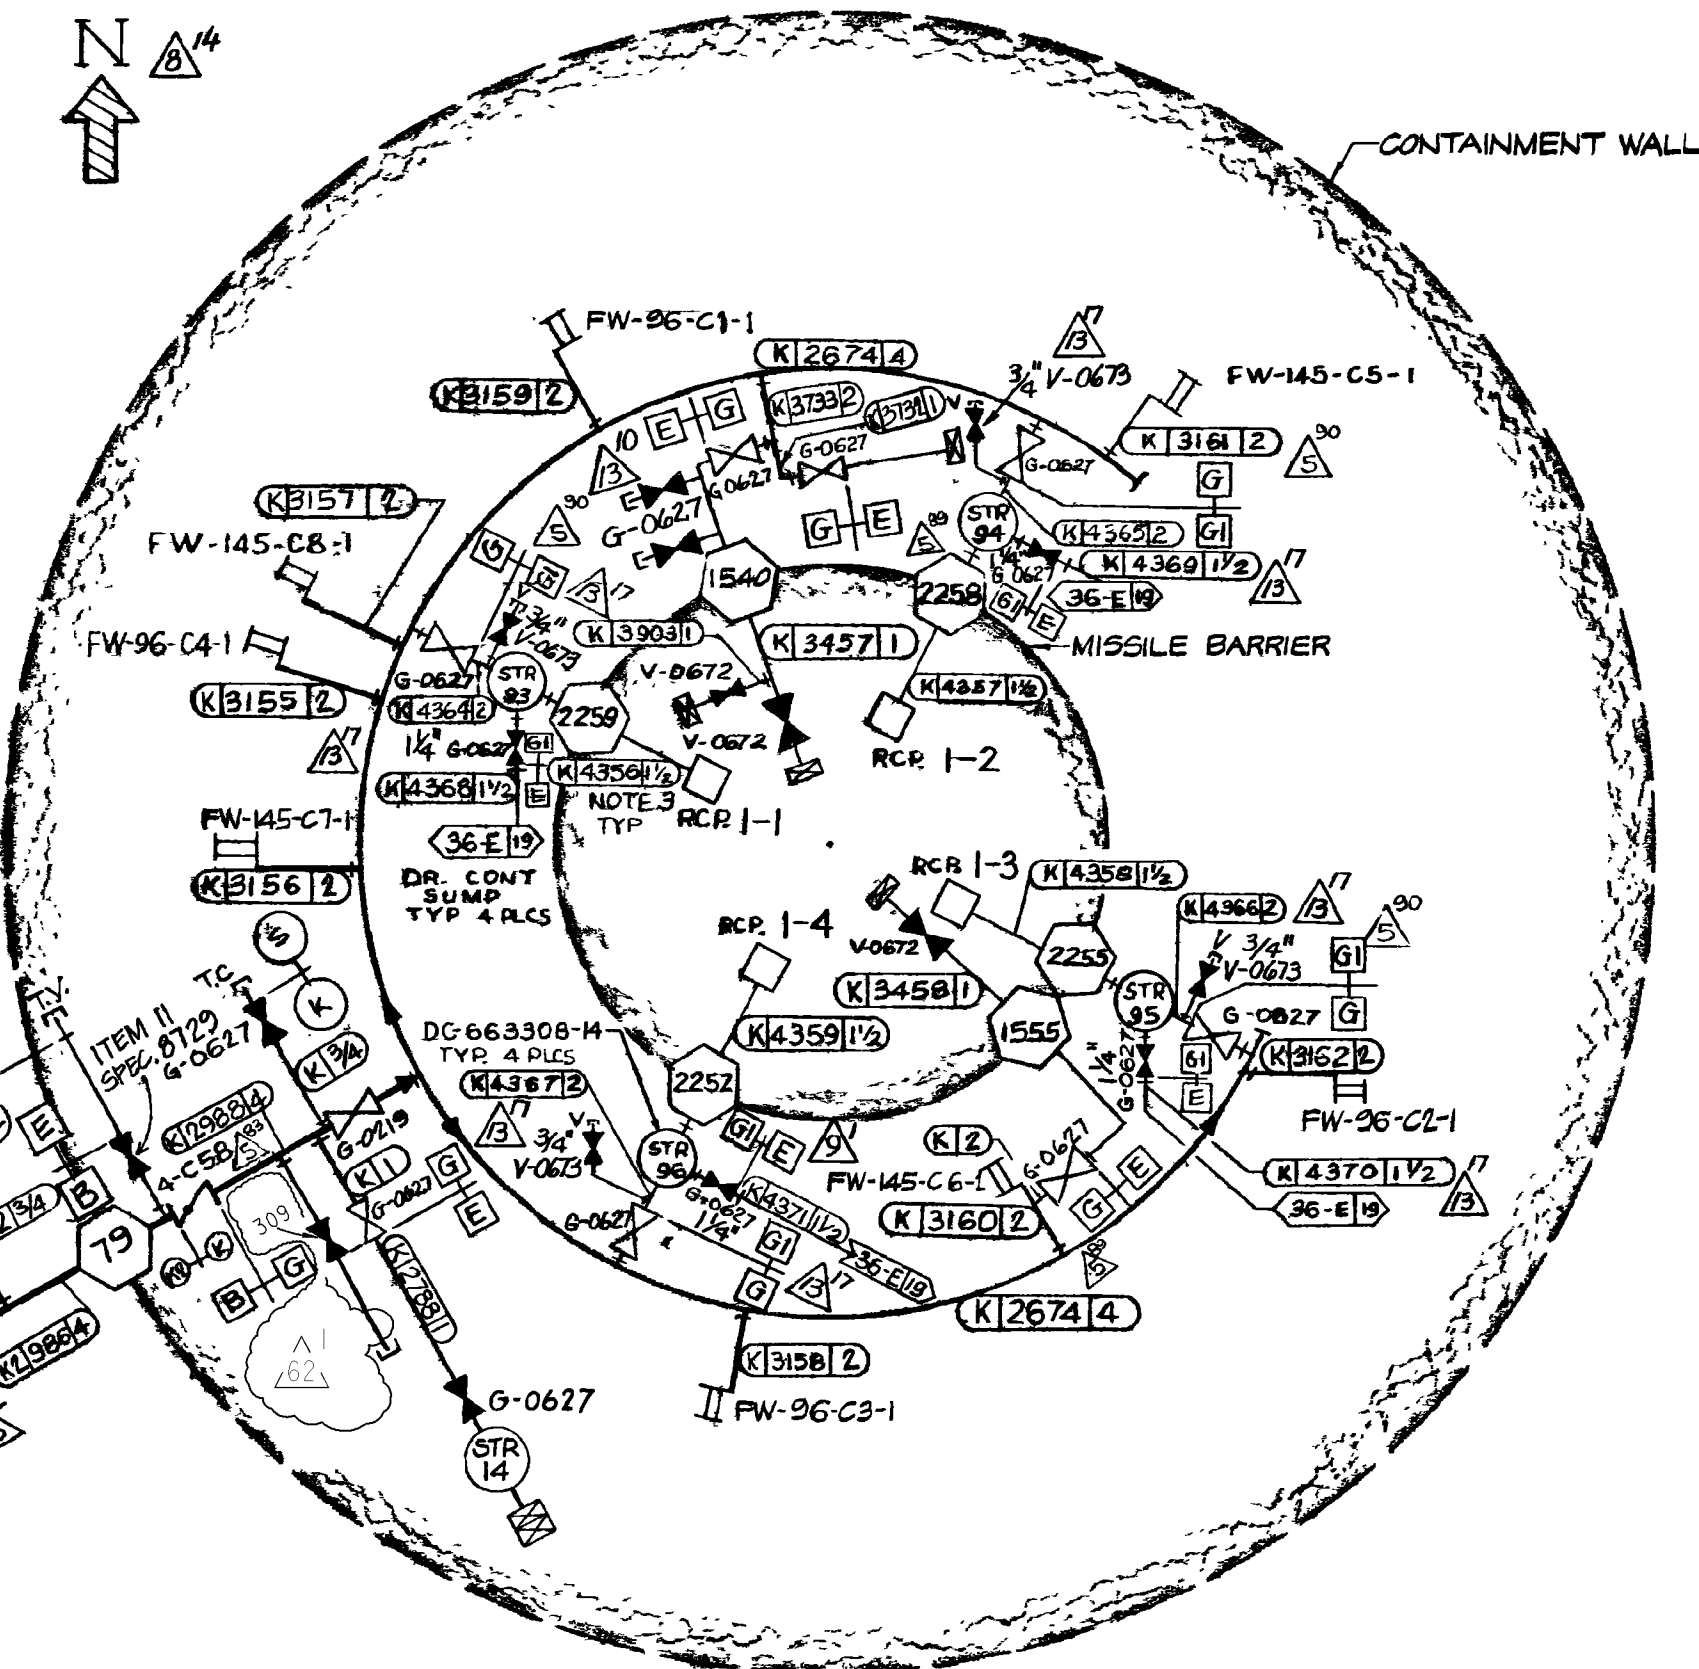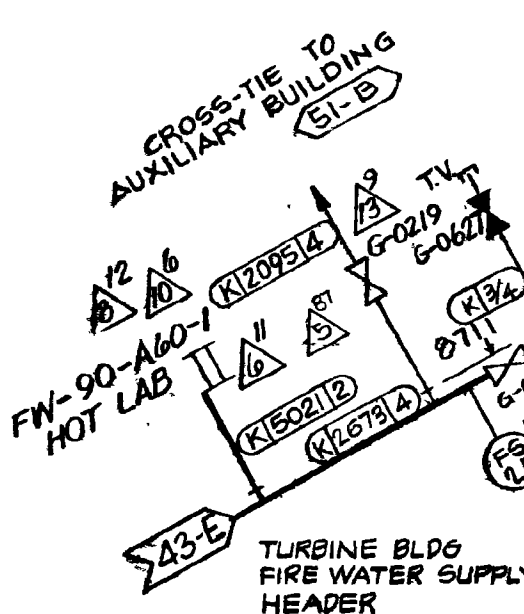

CONTAINMENT STRUCTURE

UNIT - I

P G & E CO.		102018		REV.
SHEET	7	PAGE	0	62

CAD User: AJL2 Date: 9-10-2004
DGN=ERU84471.DGN
RASTER=ERU84471.TIF


9/14/04	AJL2	CDP3	-	KERSI J. DALAL	MECHANICAL	M 16690	3/31/2006	Revised per FCT 029317
DATE	DWN	RE	IV	PROFESSIONAL ENGINEER	PE DISC.	PE#	PE EXP.	

CO₂ BOTTLES 75 LBS

INITIAL DC-663086-6 EXTENDED

NOTES:

- 1. VALVES, PIPING AND INSTRUMENTS ON THIS SHEET ARE UNDER SPEC 8724, EXCEPT AS NOTED.
- 2. ODORIZER ASSEMBLY (SPEC K6) AND 1" BALL VALVE, CHEMETRON NO.1-061-0709 WITH LOCKING DEVICE NO.5-061-0772.
- 3. FCV-112 AND FCV-113 ARE PILOT OPERATED DISCHARGE HEADS.
- 4. DISCHARGE HEADS ON MANIFOLD ARE PRESSURE OPERATED.
- 5. FOR UNIT 2 INSTRUMENT SCHEMATIC REFERENCE, SEE SHEET 18A OF DWG 108036.

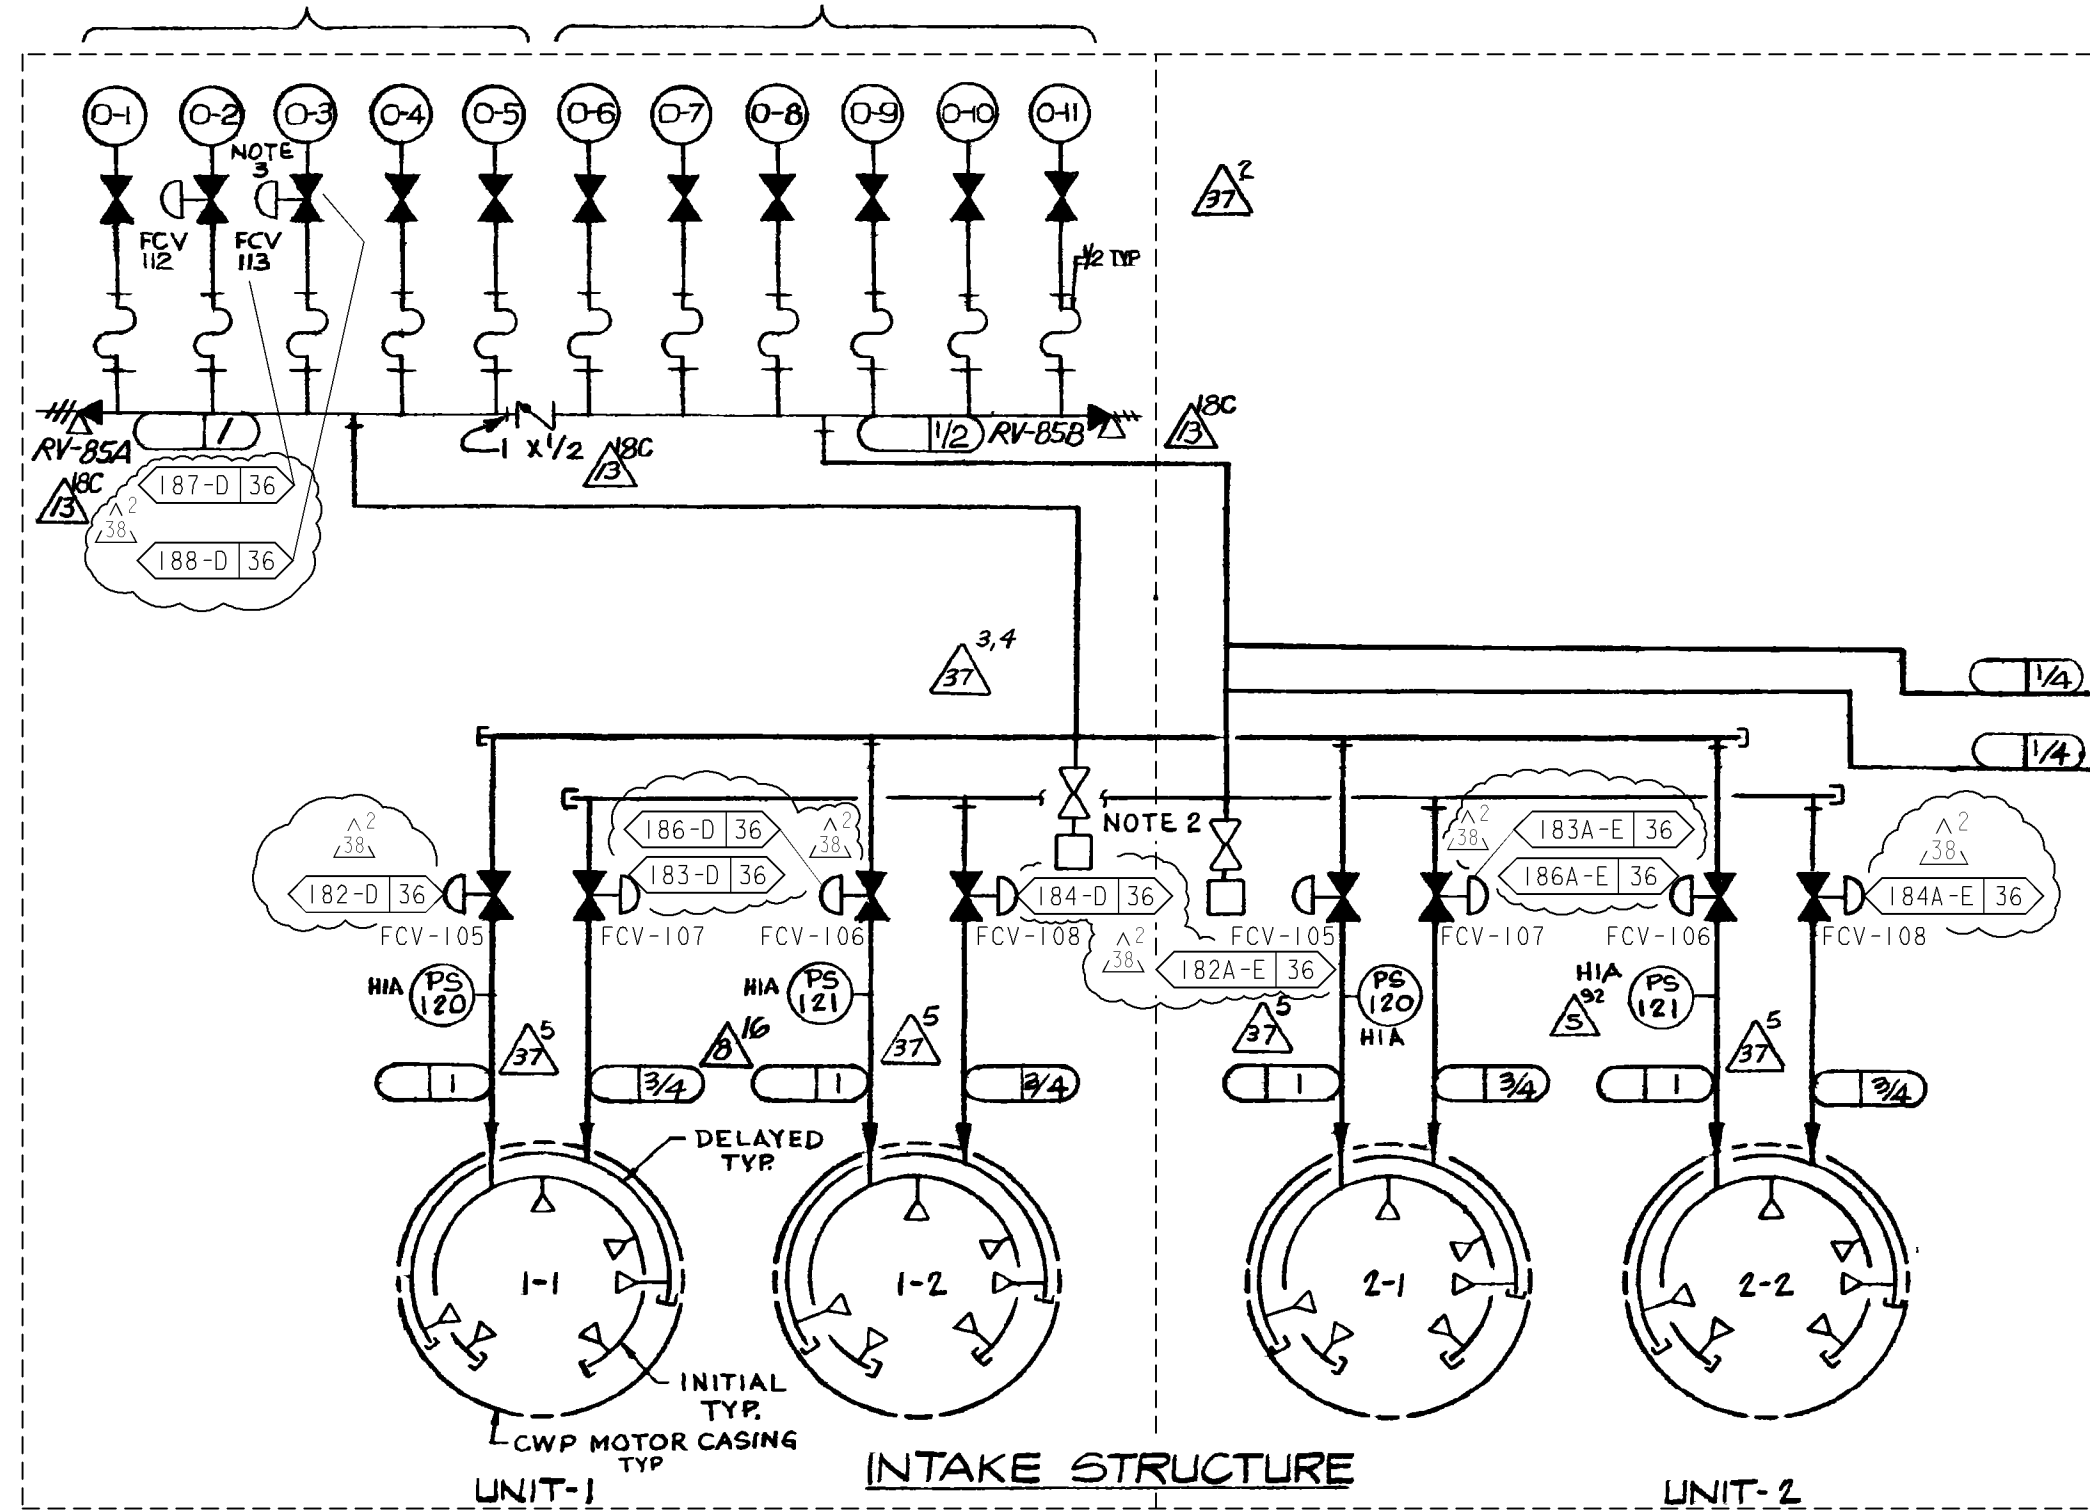

CO₂ PROTECTION SYSTEM FOR INTAKE STRUCTURE


UNIT-1

P G & E CO.		102018	REV. 38
SHEET 8	PAGE 0		

9/22/04	AJL2	FXC2	-	KERSI J. DALAL	MECHANICAL	M 16690	3/31/2006	Revised per FCT 029332
DATE	DWN	RE	IV	PROFESSIONAL ENGINEER	PE DISC.	PE#	PE EXP.	

CAD User: AJL2 Date: 9-21-2004
DGN=102018S8.DGN
RASTER=102018S8.TIF

INPG2ND

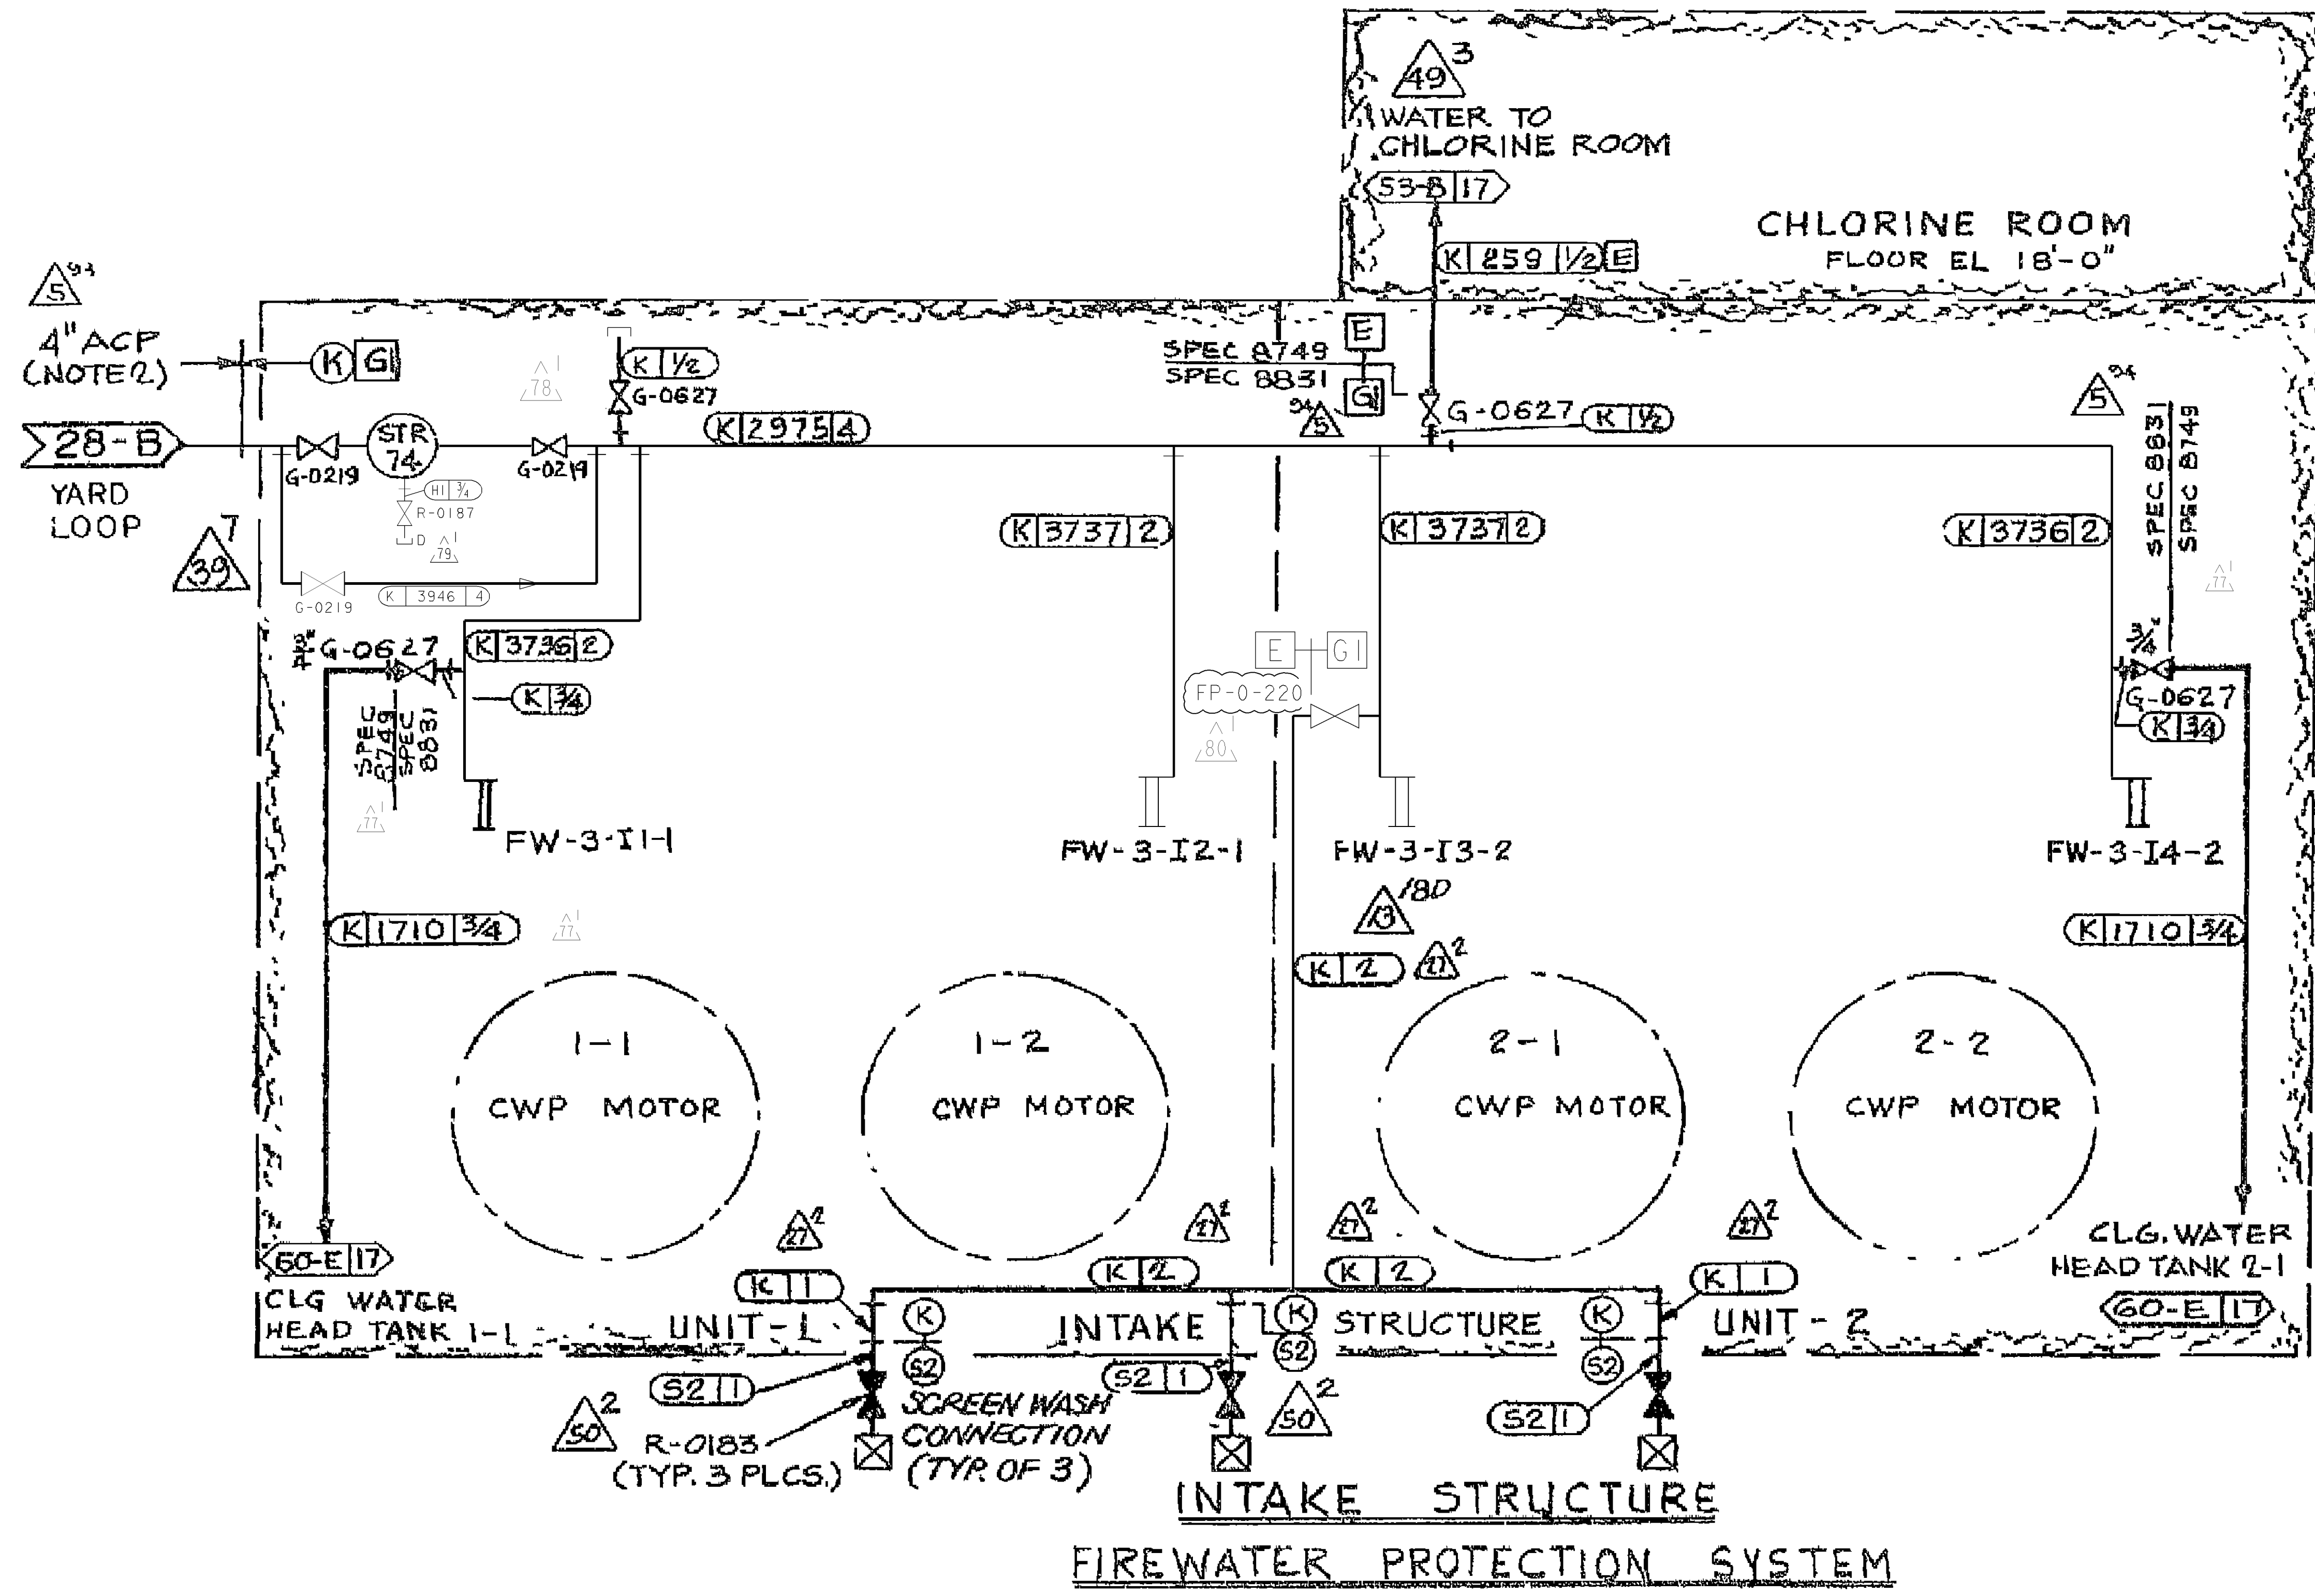


NOTES:

- 1. DELETED
- 2. ASBESTOS CEMENT PIPE BY CIVIL, REF DWG. 438146.
- 3. ALL HOSE REELS HAVE RESTRICTING ORIFICES. (REF DWG. 060831)
- 4. DELETED


UNIT 1			
DIABLO CANYON POWER PLANT - PG&E CO.			
DRAWING	SHEET	PAGE	REV
102018	9	0	80

03-09-2006	AJL2	RMDI	KERSI J. DALAL	MECHANICAL	M 16690	3/31/2006	REVISED PER FCT-031146
DATE	DWN	RE	IV	PE DISC.	PE*	PE EXP.	

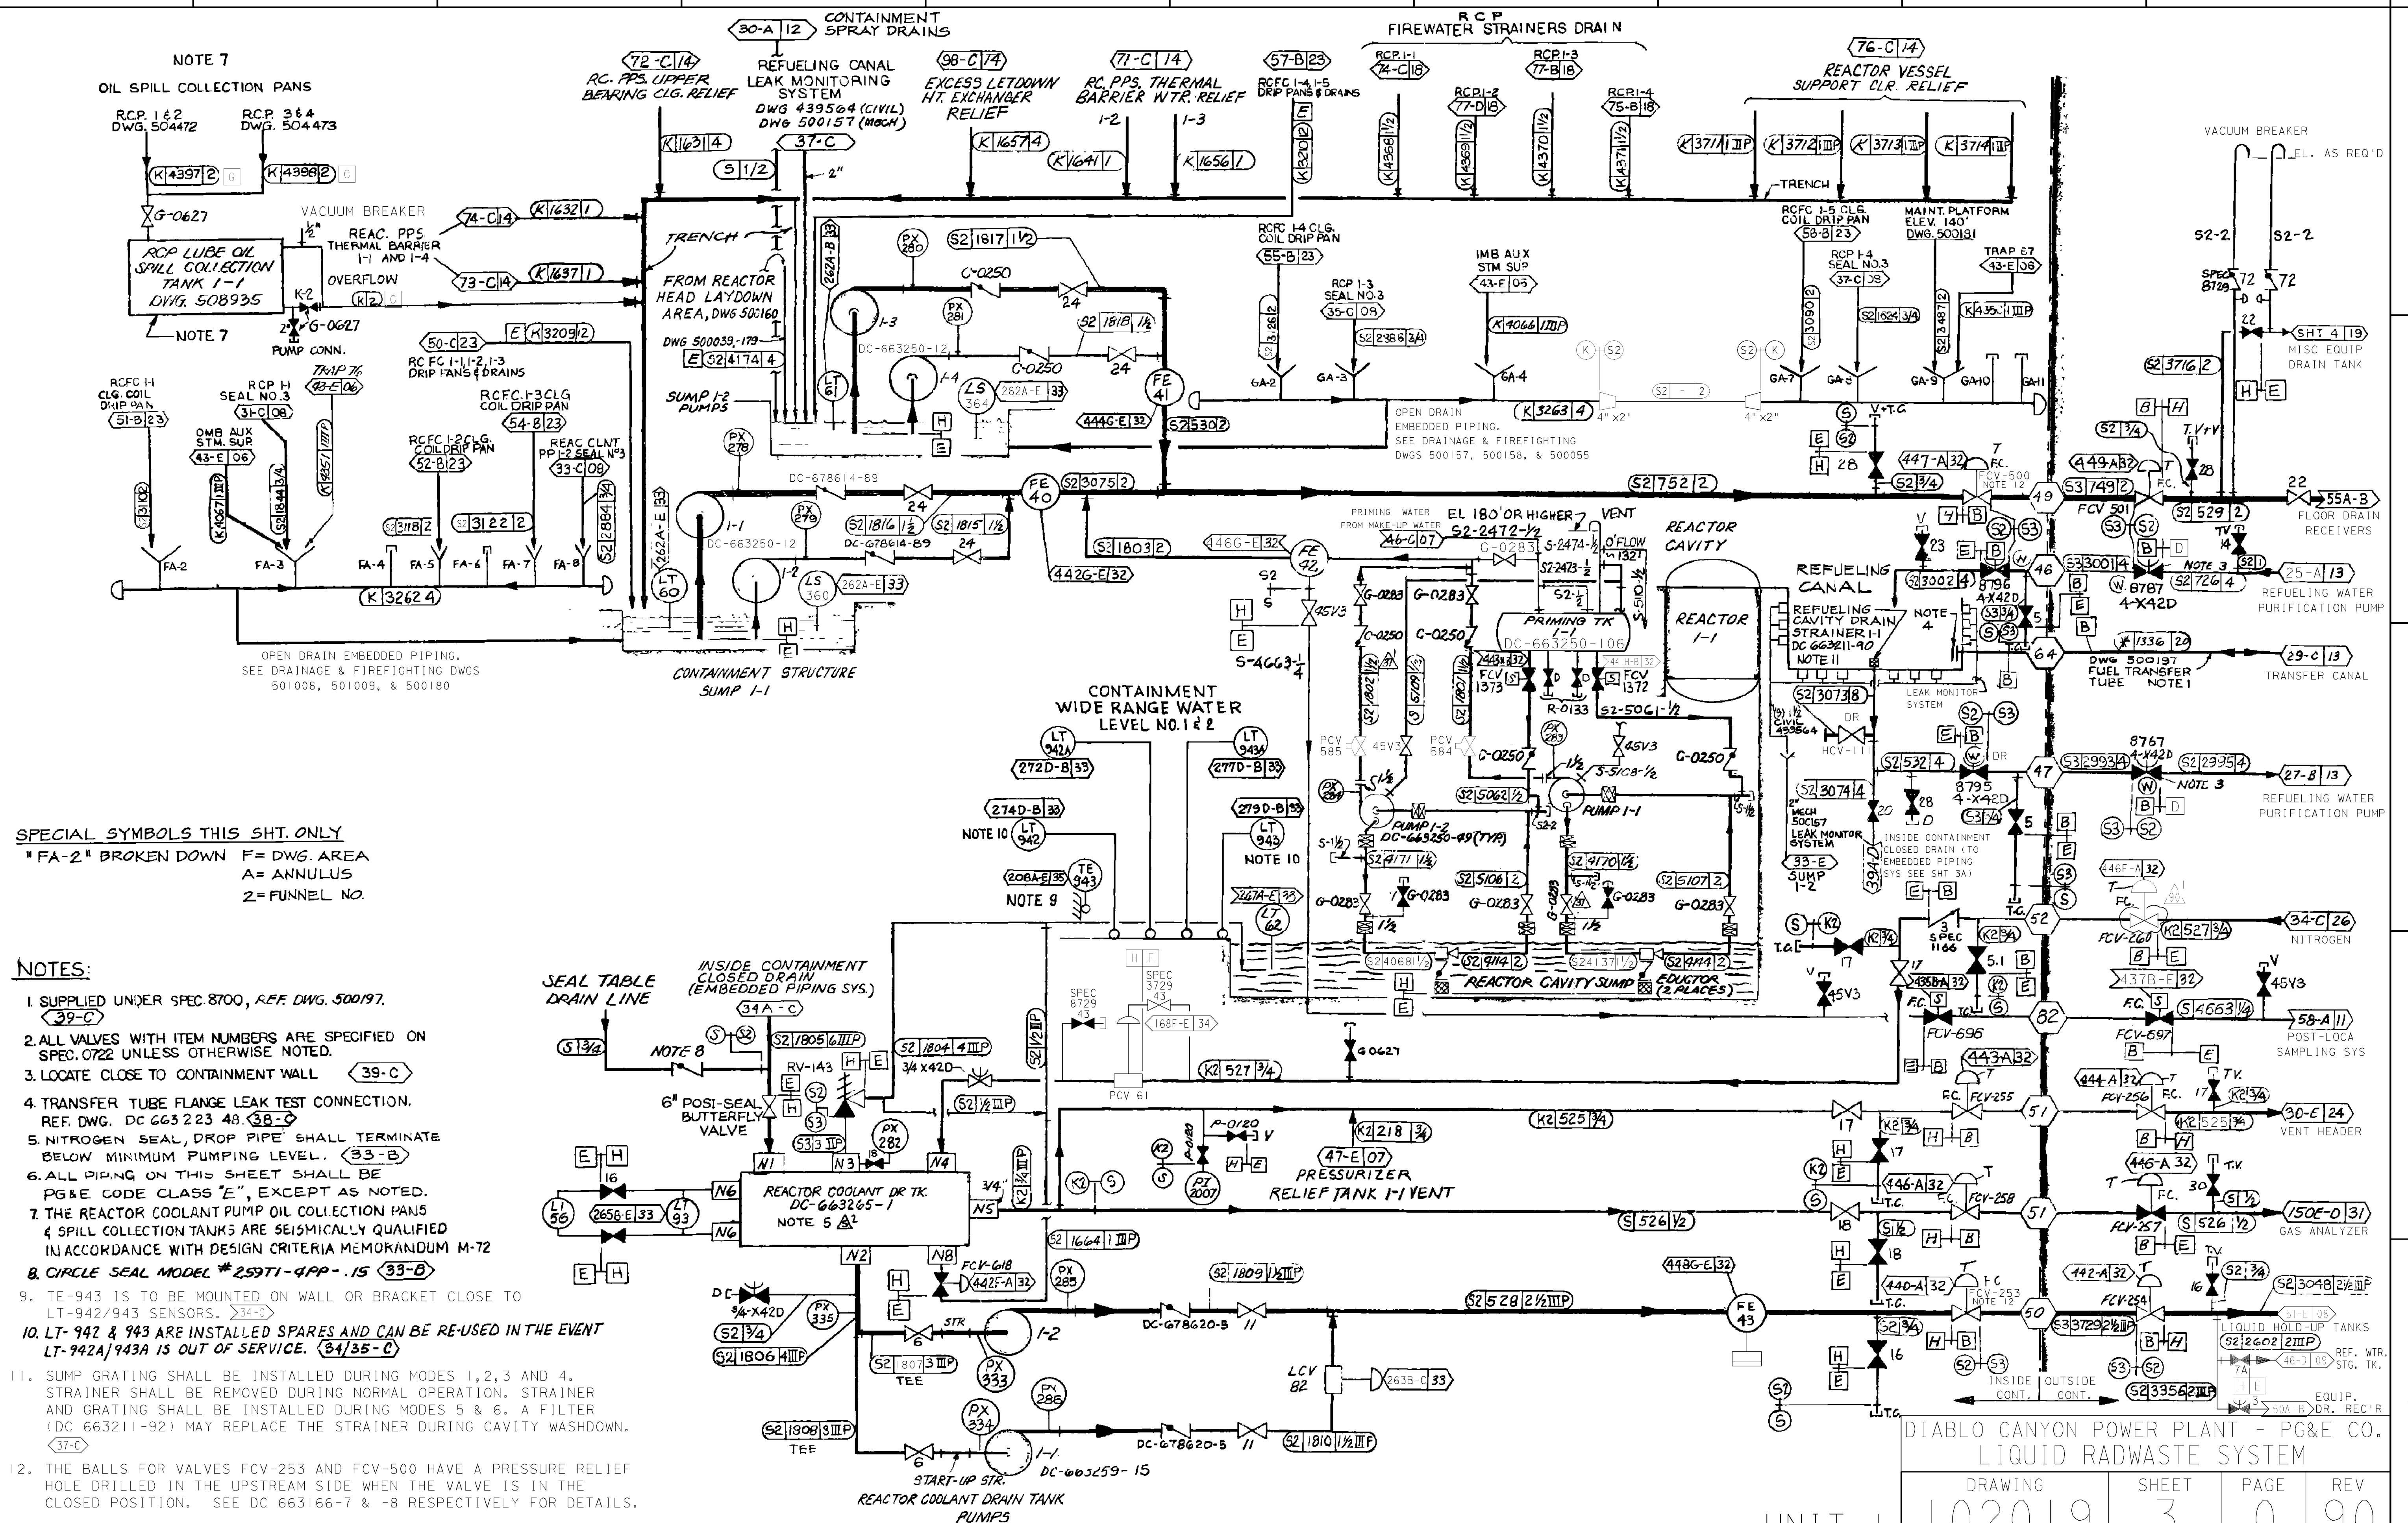

AREA "F"

AREA "G"

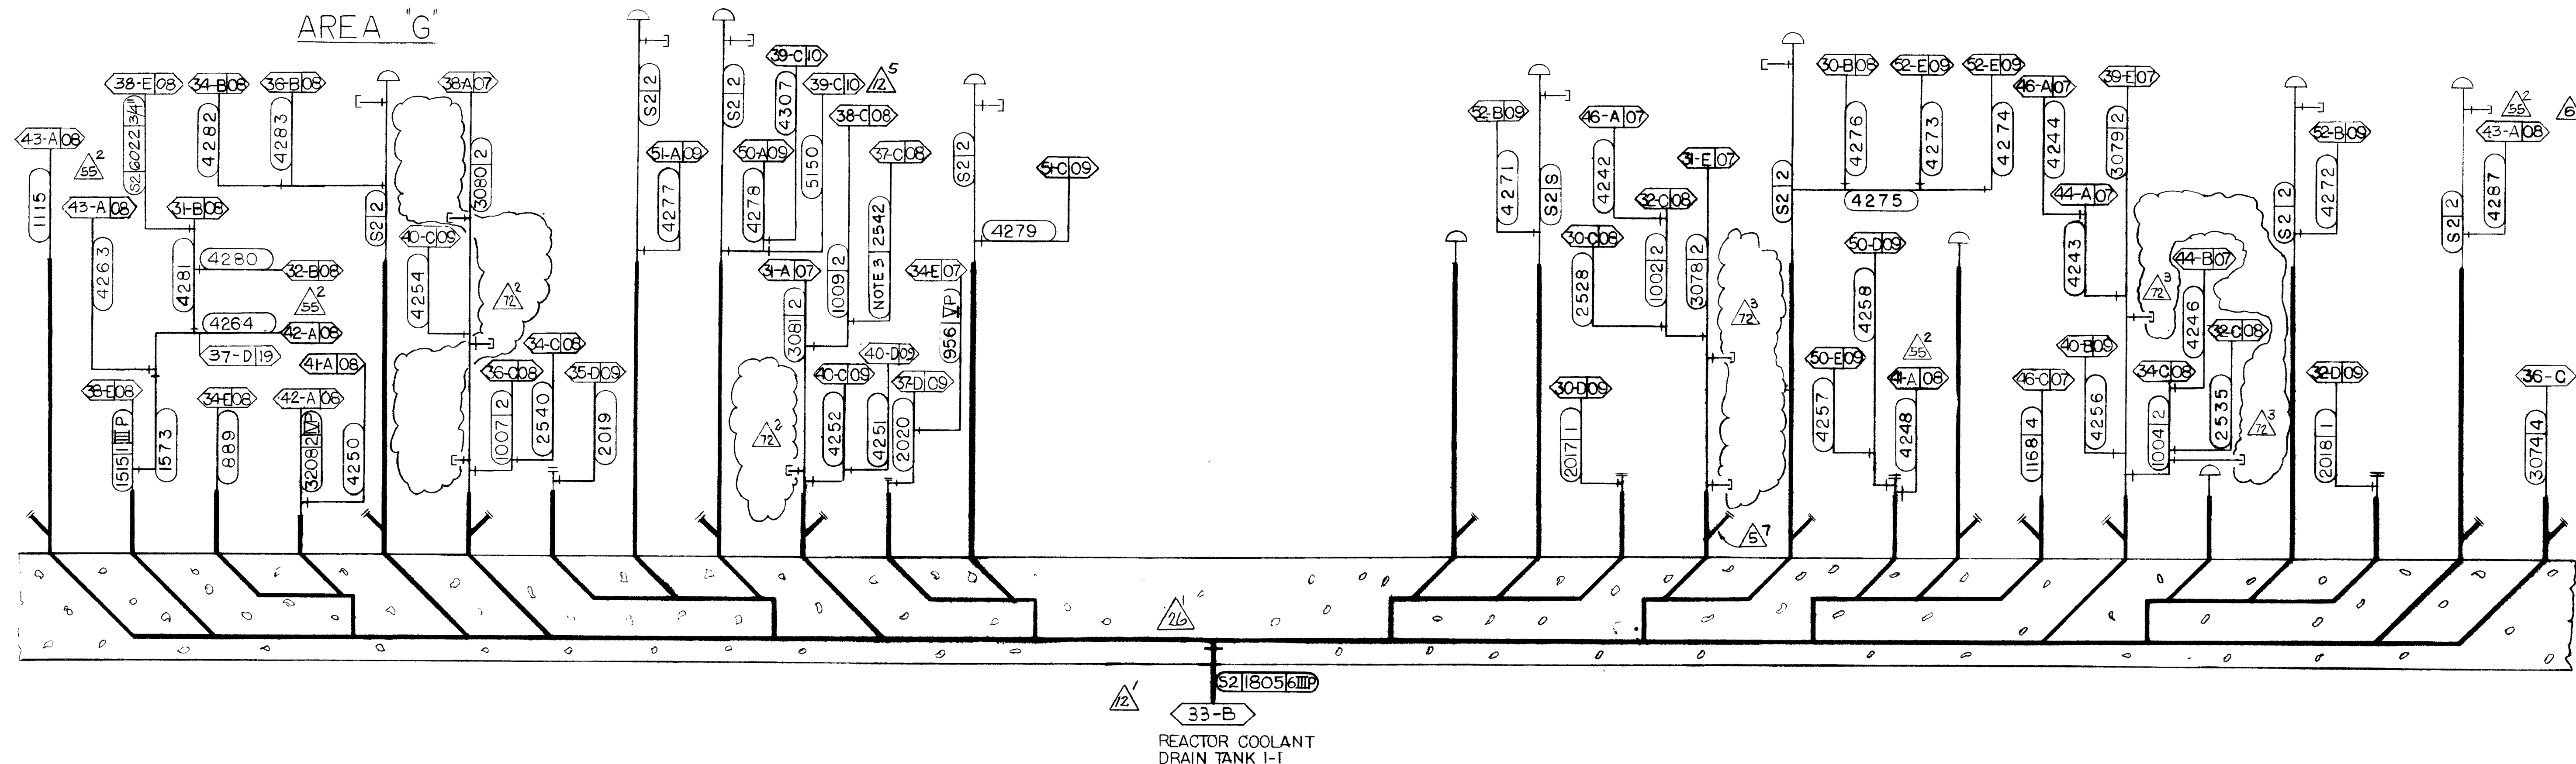

- NOTES:
1. ALL DRAIN PIPING ON THIS DRAWING SHALL BE S2-3/4, CODE CLASS "E", UNLESS NOTED.
 2. EMBEDDED PIPING IS INDICATED BY HEAVY LINES REF. DWG. No. 500157 & 500158
 3. USE SCHEDULE 160 IN LINE 2542, ON UNIT 1 ONLY.

33A-D

INSIDE CONTAINMENT
CLOSED DRAIN TO EMBEDDED
PIPING SYSTEM.

UNIT - 1 RM INDEXED REV.

P. G. & E. CO.

102019

CHANGE



SHEET 3A OF SHEETS


72

35 M/M NEG

SCAN 72 101

NOTES:

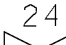1. VALVES WITH ITEM NUMBERS  ARE SPECIFIED ON SPEC.0722 UNLESS OTHERWISE NOTED
2. FOR DRAIN COLLECTION PIPING TO AND INCLUDING HEADERS A TO N REFER TO PG&E DRAINAGE AND FIRE FIGHTING DRAWINGS 500121 TO 500132; 500994 TO 500996 & 500998 TO 501005
3. ALL PIPING ON THIS SHEET IS PG&E CODE CLASS  EXCEPT AS NOTED
4. OIL ABSORBENT BOOMS (NOCHAR) HAVE BEEN INSTALLED IN THE SUMP. LANYARD FOR BOOMS IS ATTACHED TO MANWAY. REF. AT-MM AR A0540057 AND CIVIL DWGS 438426 AND 439510.

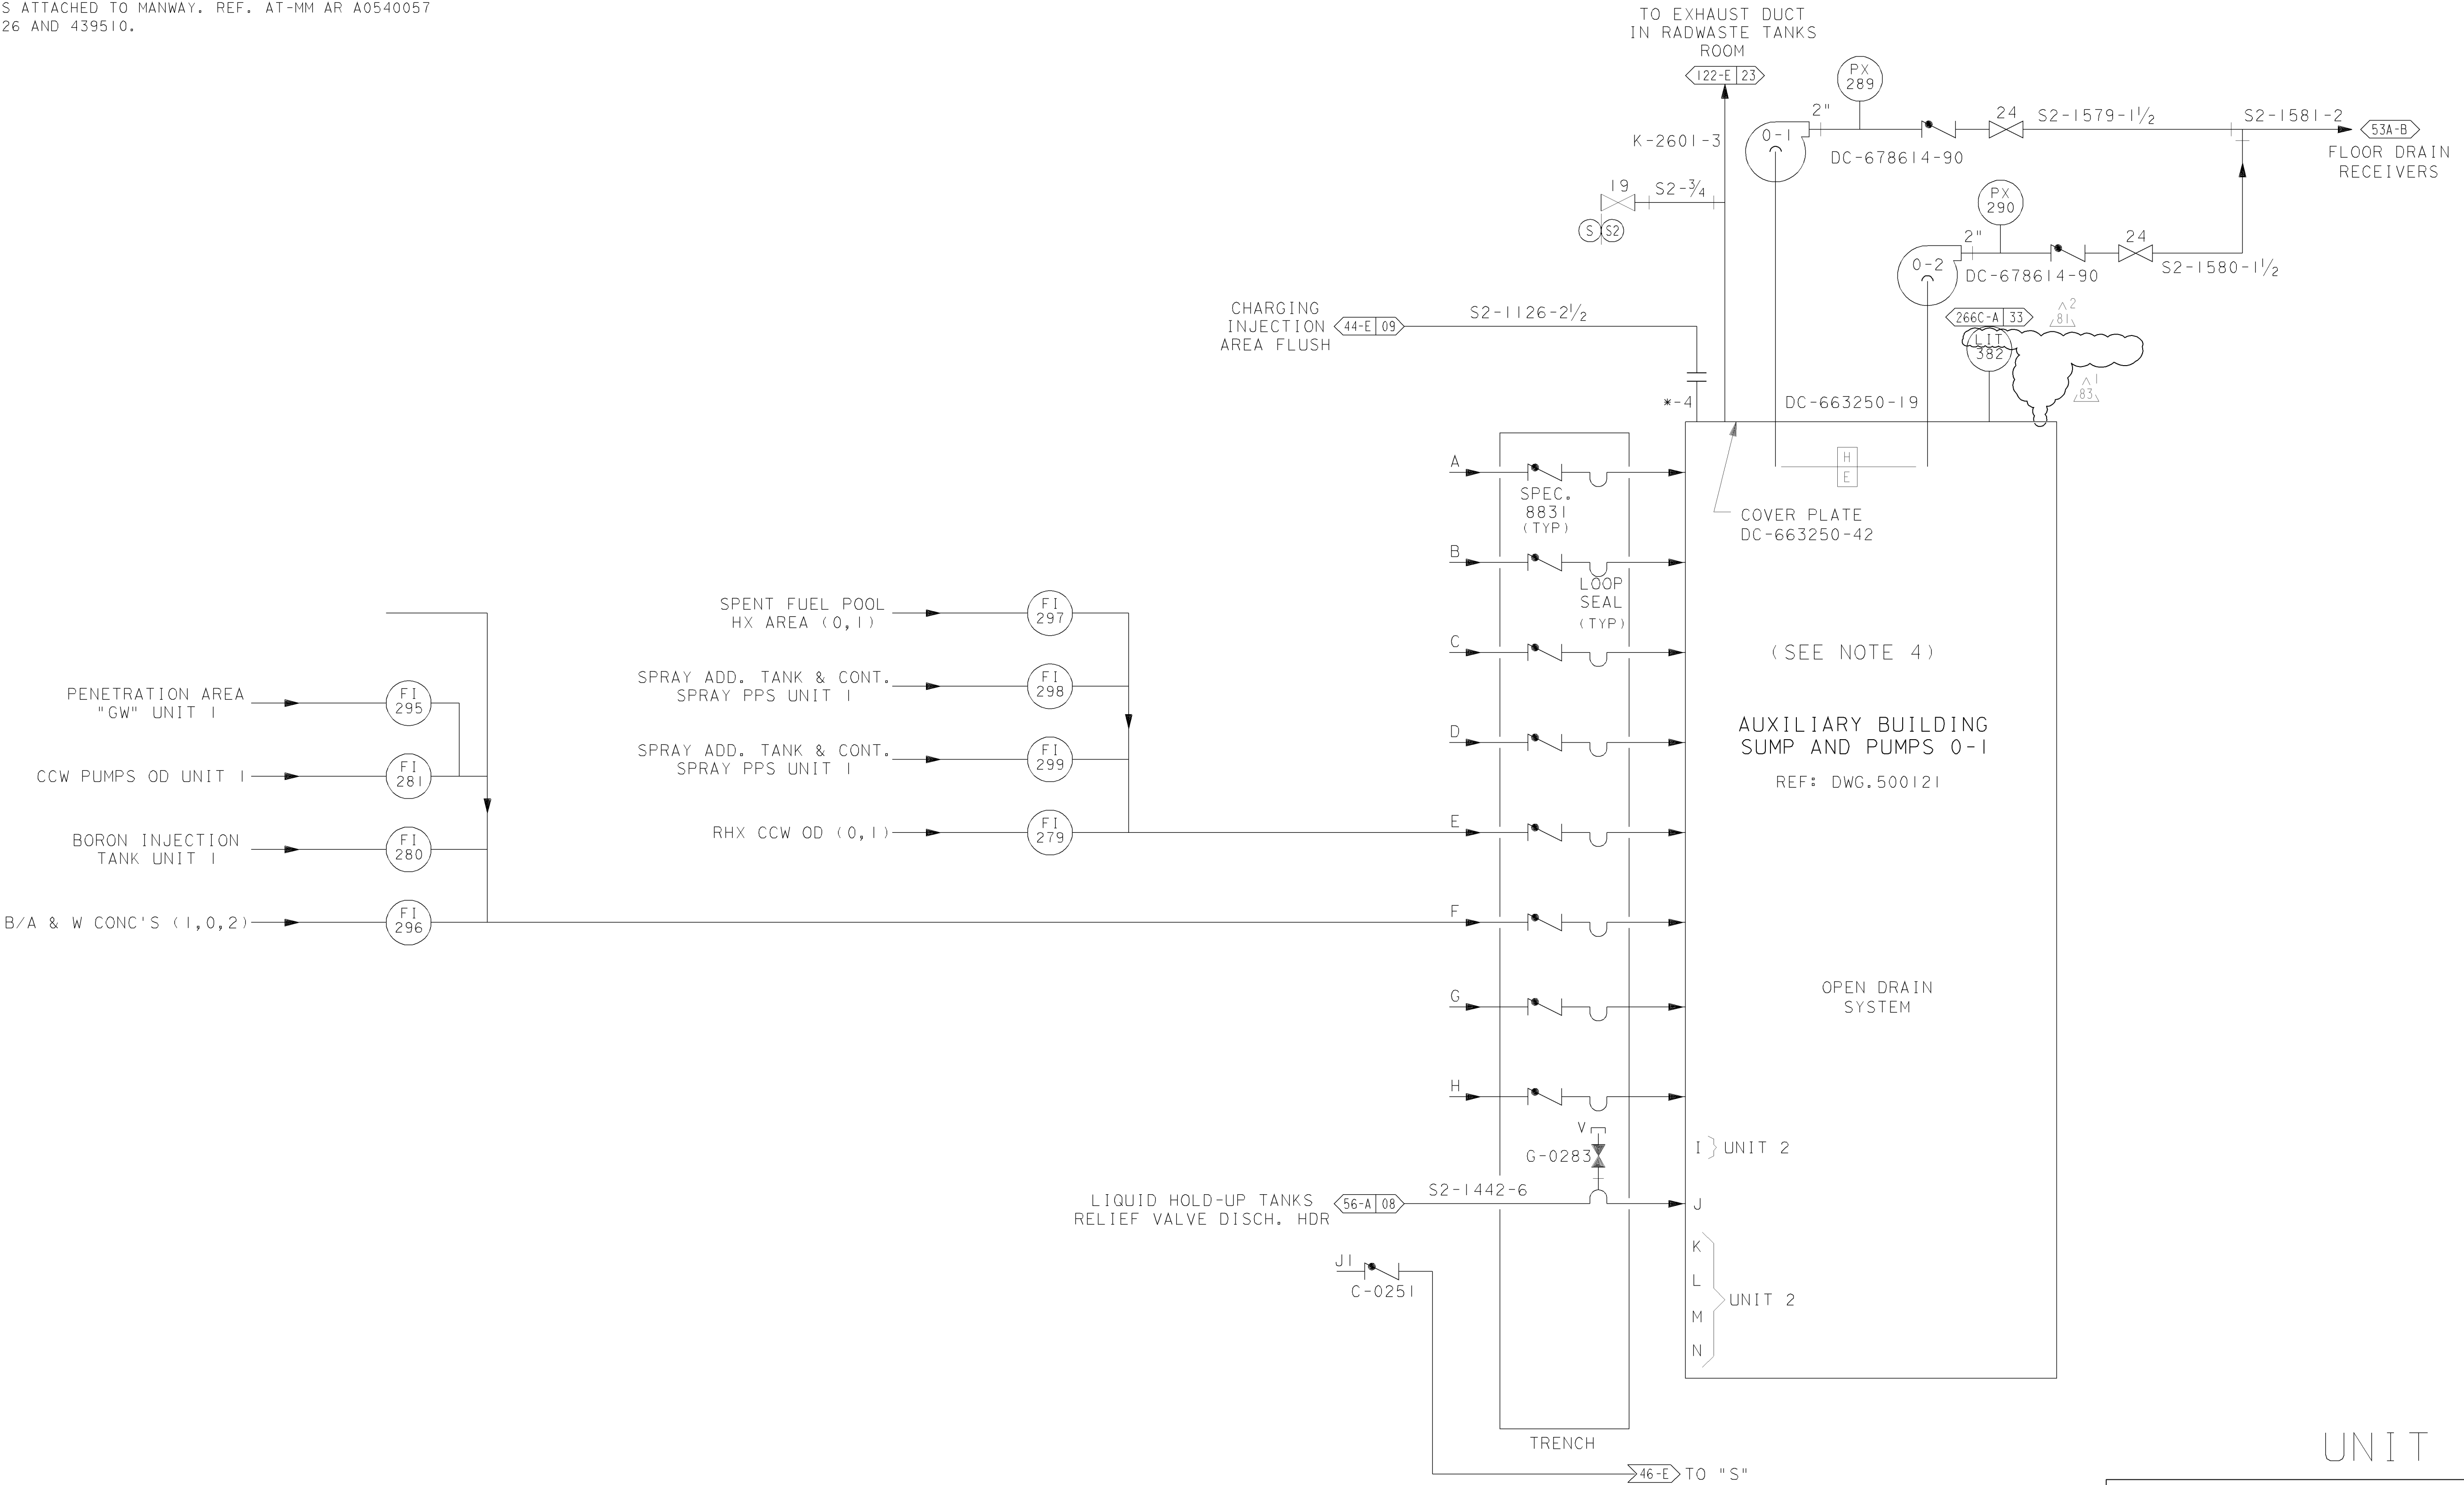



UNIT 1

DIABLO CANYON POWER PLANT - PG&E CO.			
LIQUID RADWASTE SYSTEM			
DRAWING	SHEET	PAGE	REV
102019	5	0	83

08-30-2011	AJFJ	FxC2		KERSI J. DALAL	MECHANICAL	M 16690	3/31/2012	REVISED PER DAS-6*432
DATE	DWN	RE	IV	PROFESSIONAL ENGINEER	PE DISC.	PE#	PE EXP.	

RASTER=102019s5.dgn
DGN=102019s5.dgn
CAD User: AJFJ Date: 08-30-2011

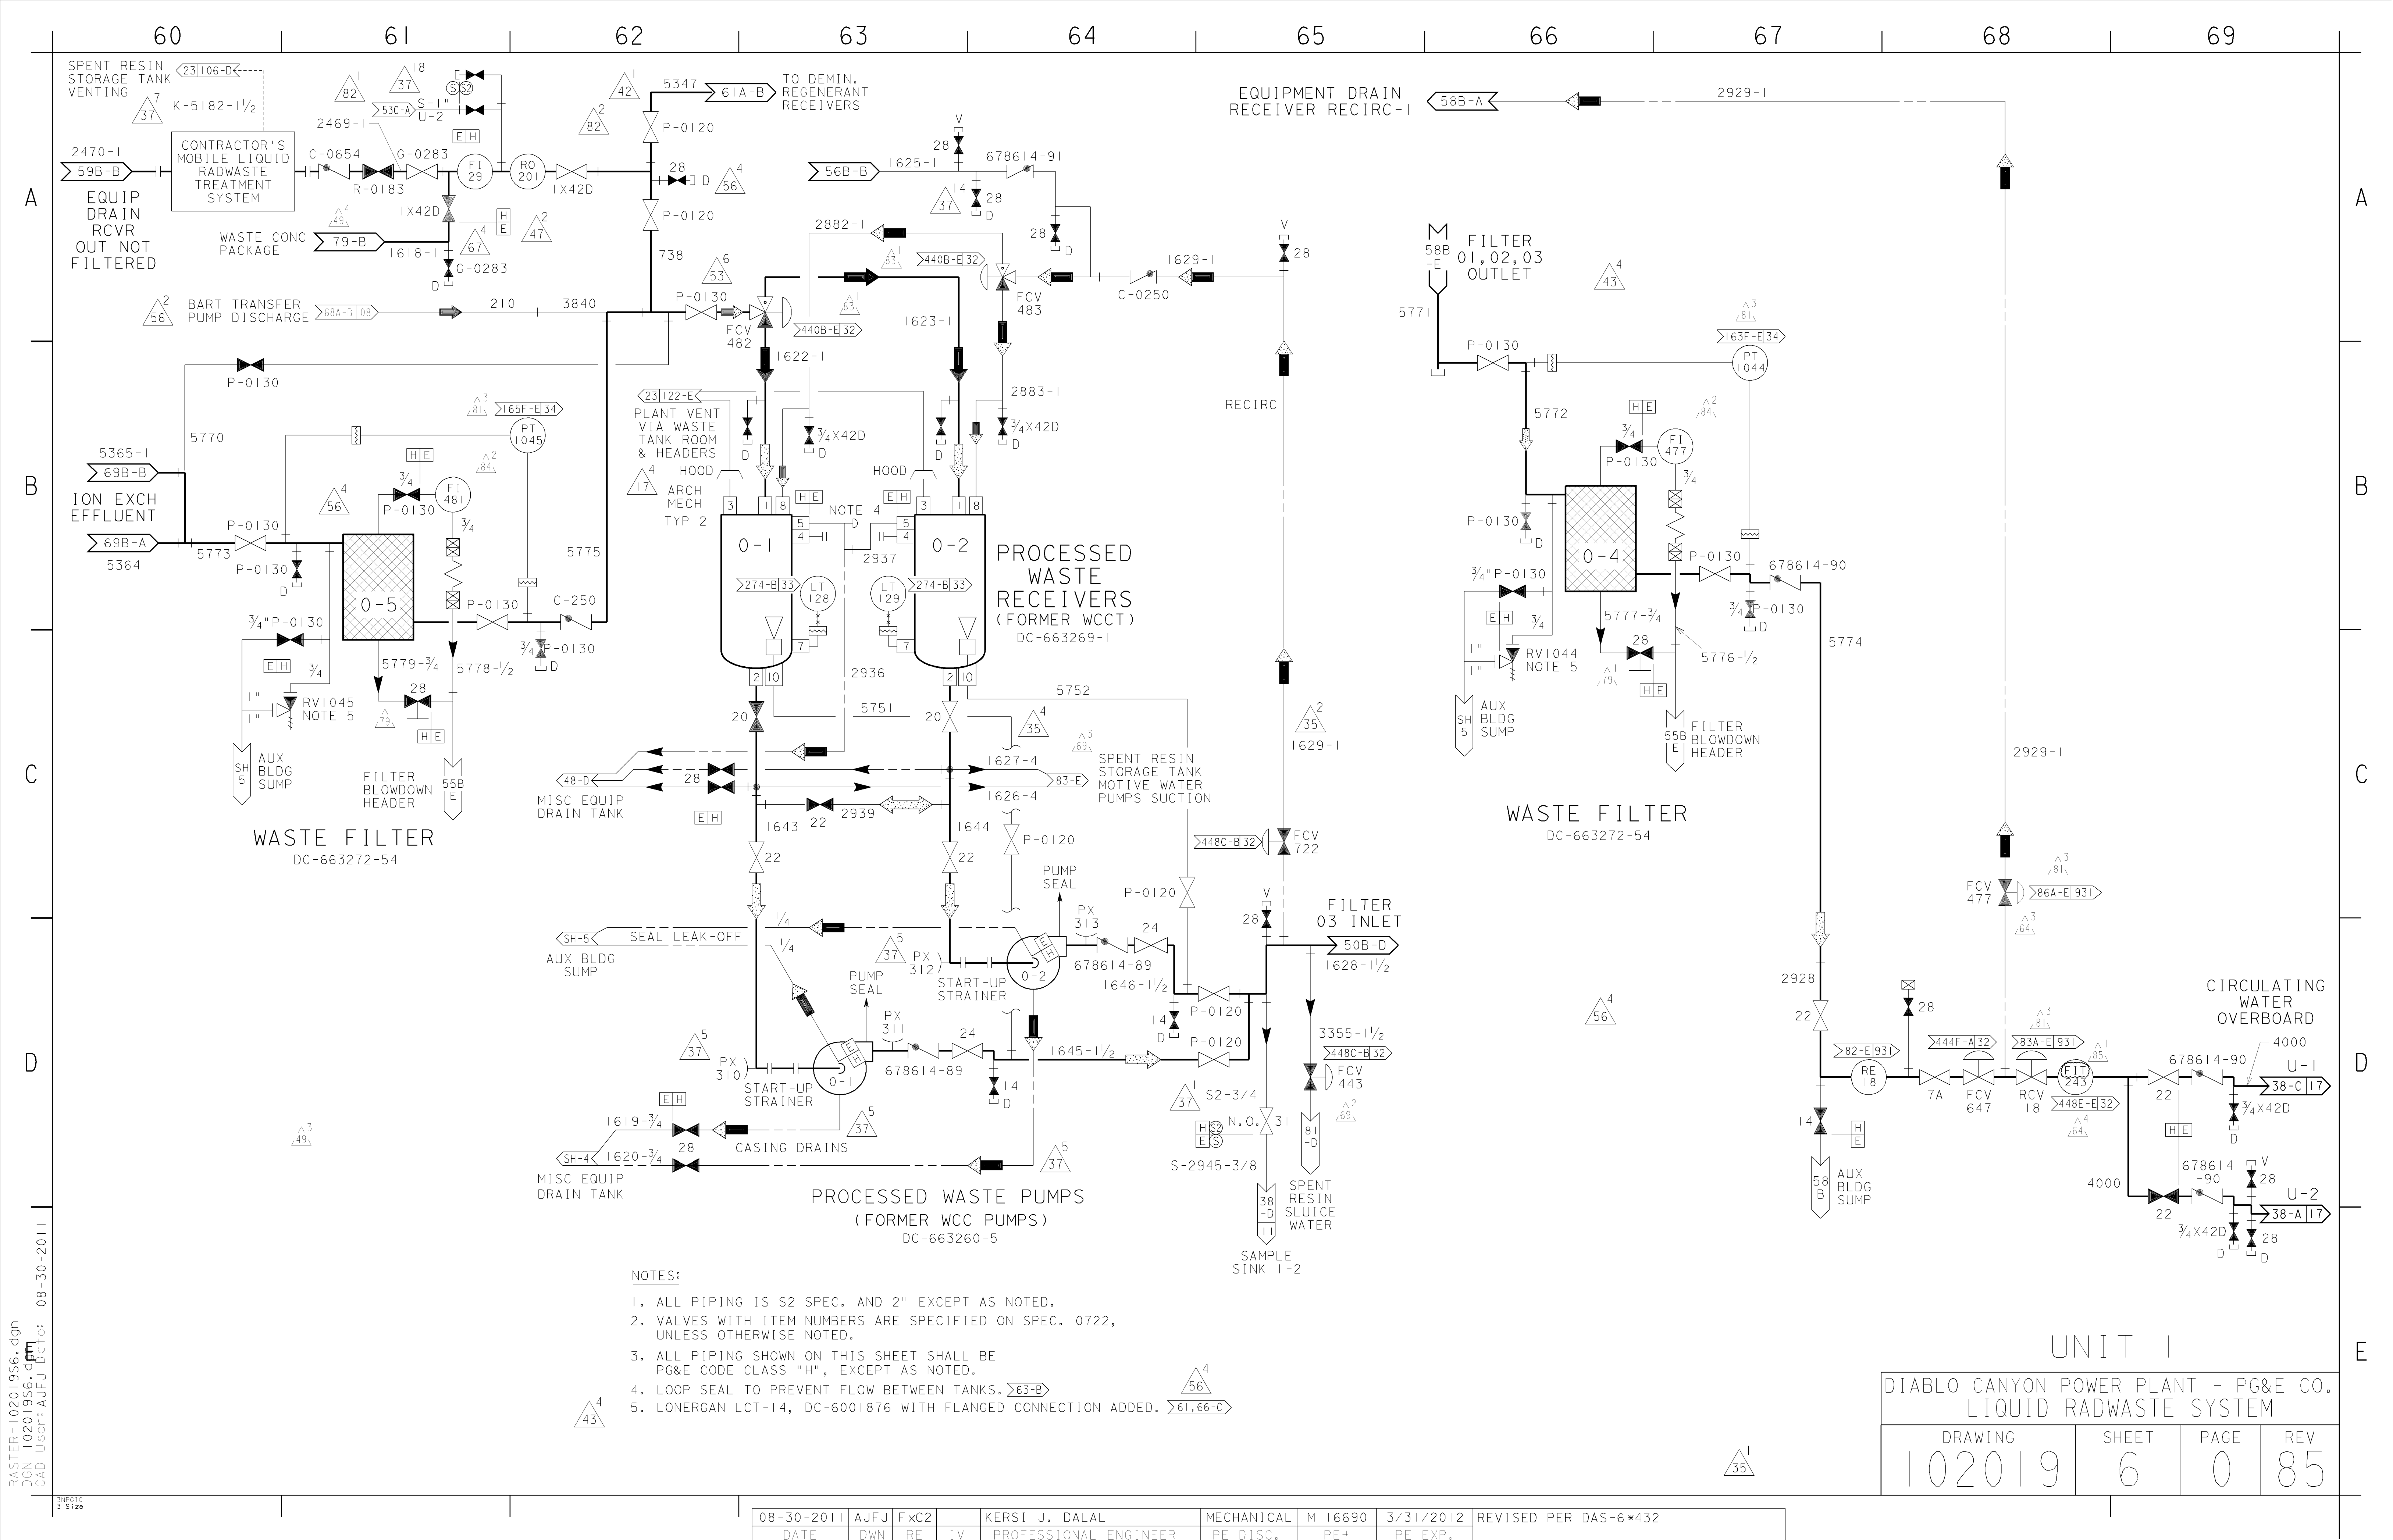

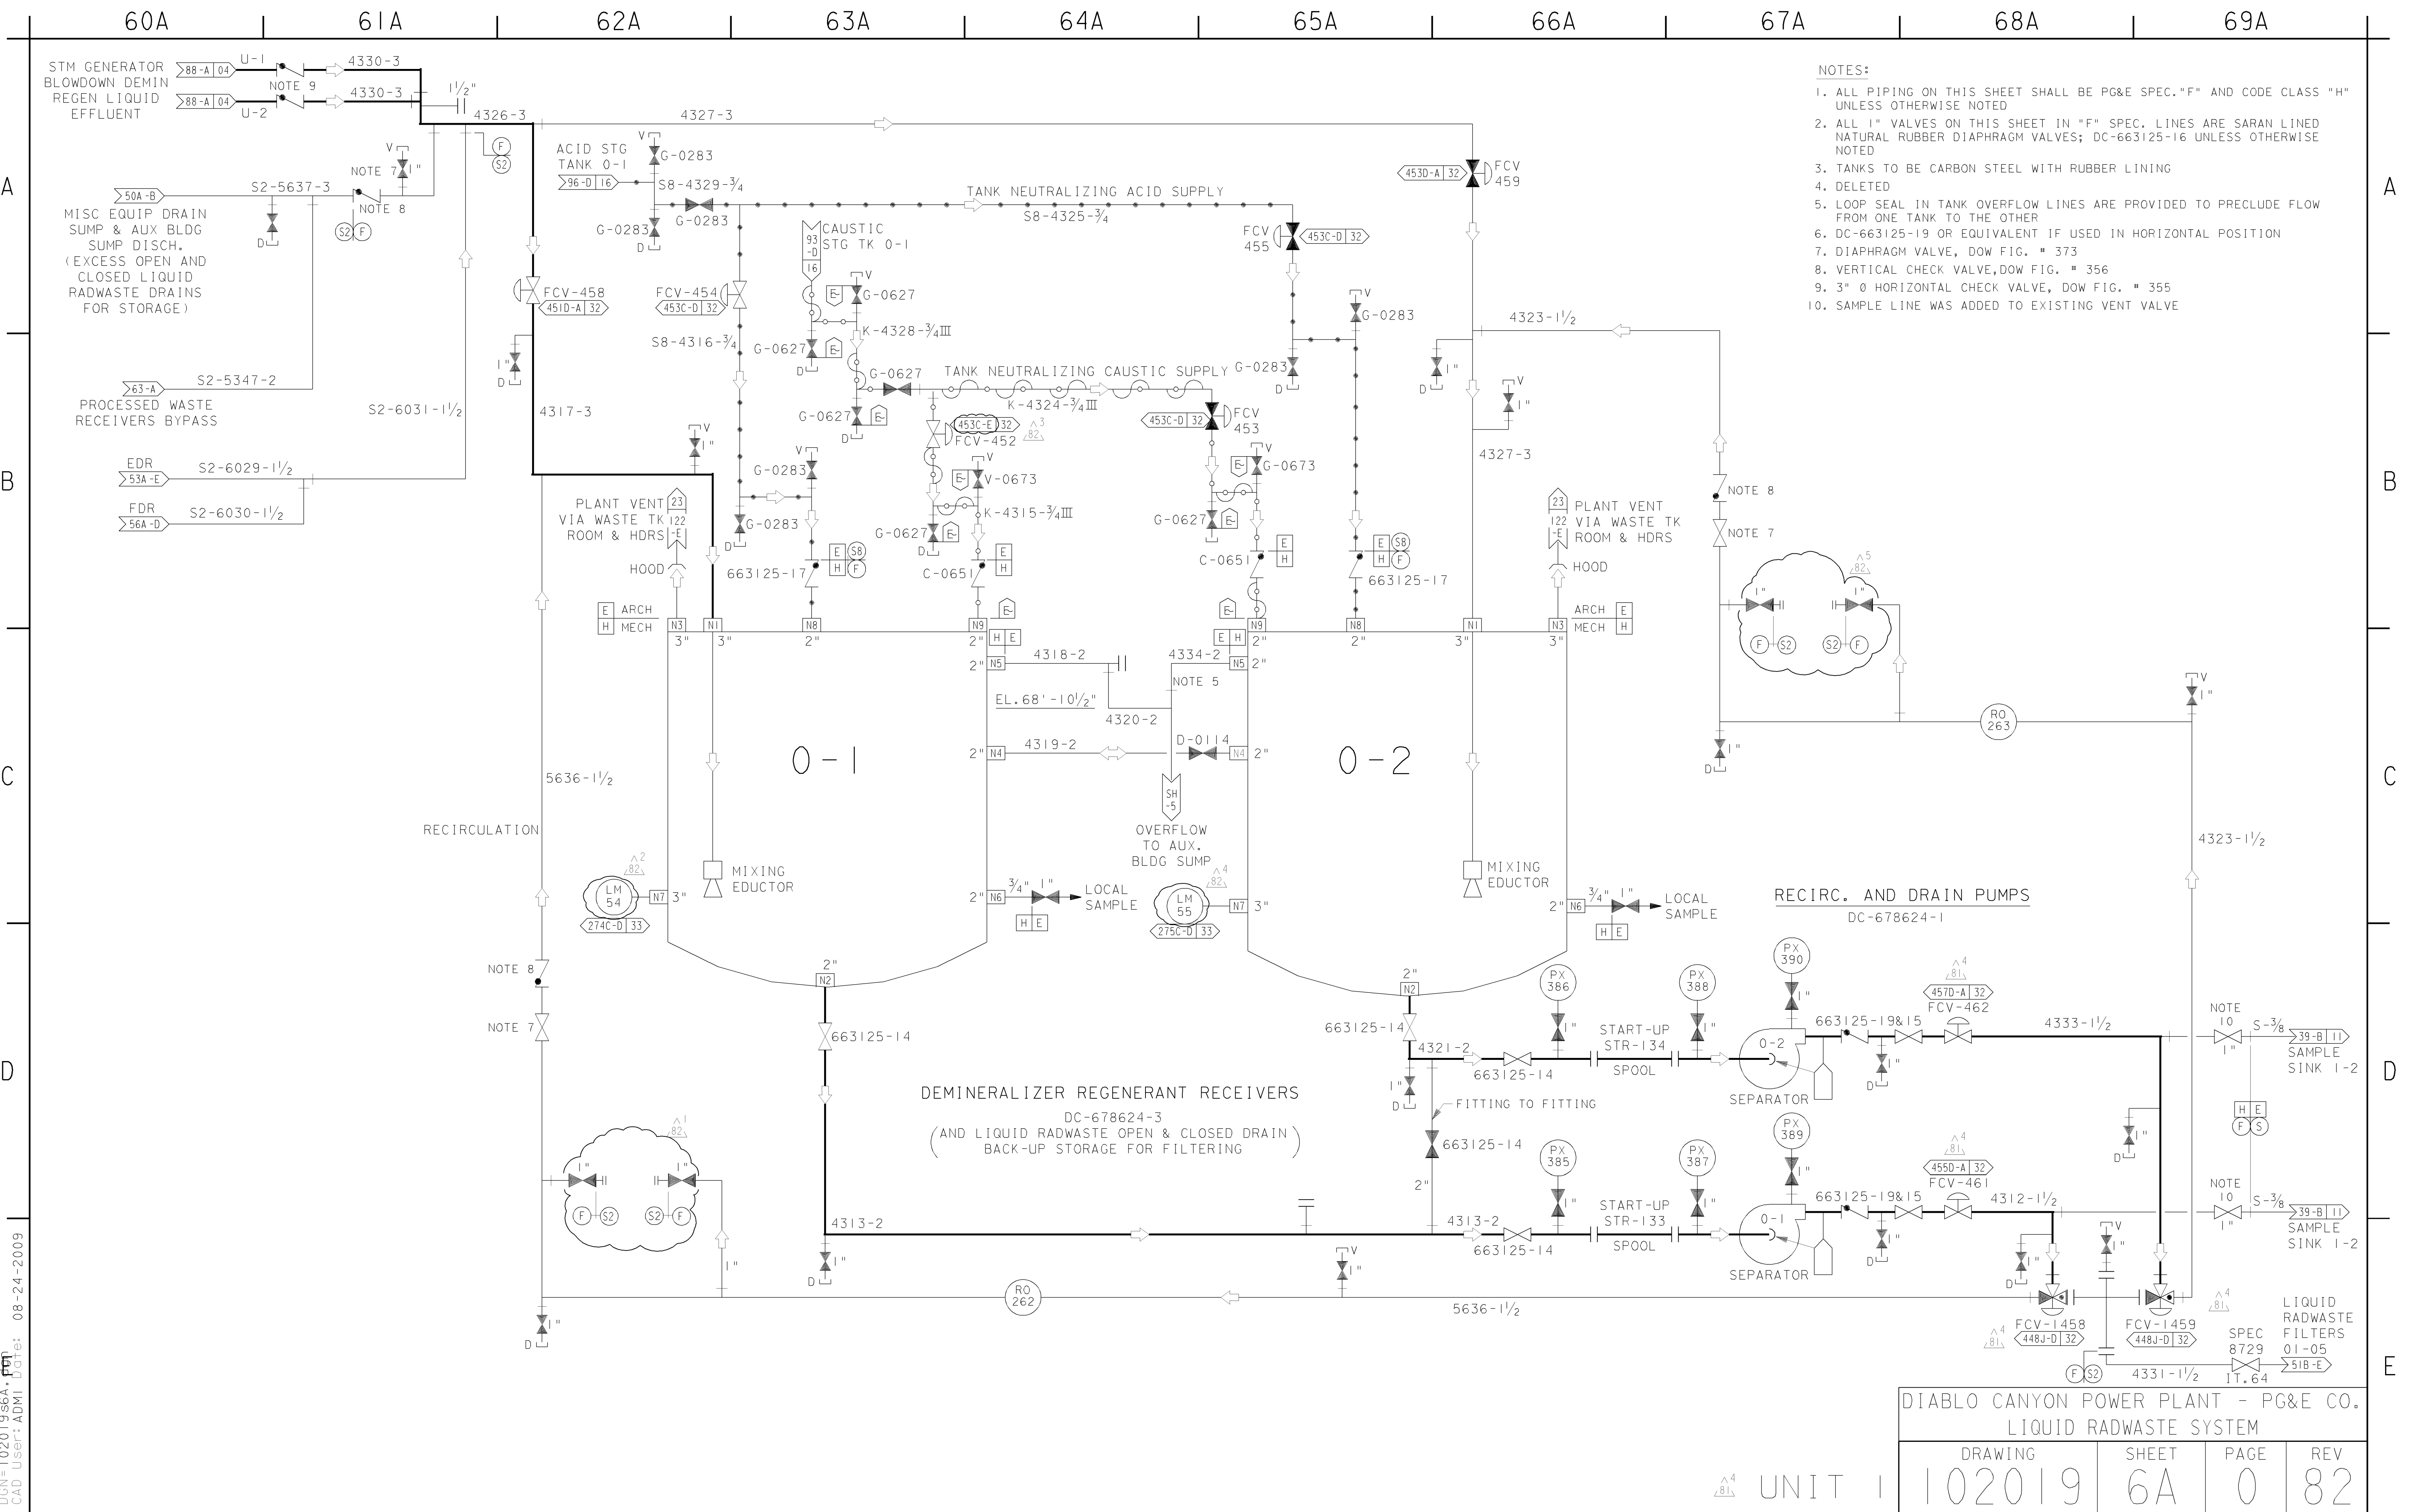


- NOTES:
- 1. ALL PIPING ON THIS SHEET SHALL BE PG&E SPEC. "F" AND CODE CLASS "H" UNLESS OTHERWISE NOTED
 - 2. ALL 1" VALVES ON THIS SHEET IN "F" SPEC. LINES ARE SARAN LINED NATURAL RUBBER DIAPHRAGM VALVES; DC-663125-16 UNLESS OTHERWISE NOTED
 - 3. TANKS TO BE CARBON STEEL WITH RUBBER LINING
 - 4. DELETED
 - 5. LOOP SEAL IN TANK OVERFLOW LINES ARE PROVIDED TO PRECLUDE FLOW FROM ONE TANK TO THE OTHER
 - 6. DC-663125-19 OR EQUIVALENT IF USED IN HORIZONTAL POSITION
 - 7. DIAPHRAGM VALVE, DOW FIG. # 373
 - 8. VERTICAL CHECK VALVE, DOW FIG. # 356
 - 9. 3" Ø HORIZONTAL CHECK VALVE, DOW FIG. # 355
 - 10. SAMPLE LINE WAS ADDED TO EXISTING VENT VALVE

DIABLO CANYON POWER PLANT - PG&E CO.
LIQUID RADWASTE SYSTEM

DRAWING	SHEET	PAGE	REV
102019	6A	0	82

08-24-2009	ADMI	FxC2		KERSI J. DALAL	MECHANICAL	M 16690	3/31/2010	REVISED PER DDN-2*150 & DAS-6*192
DATE	DWN	RE	IV	PROFESSIONAL ENGINEER	PE DISC.	PE#	PE EXP.	

RASTER=102019s6A.dgn
DCN=102019s6A.dgn
CAD User: ADMI Date: 08-24-2009

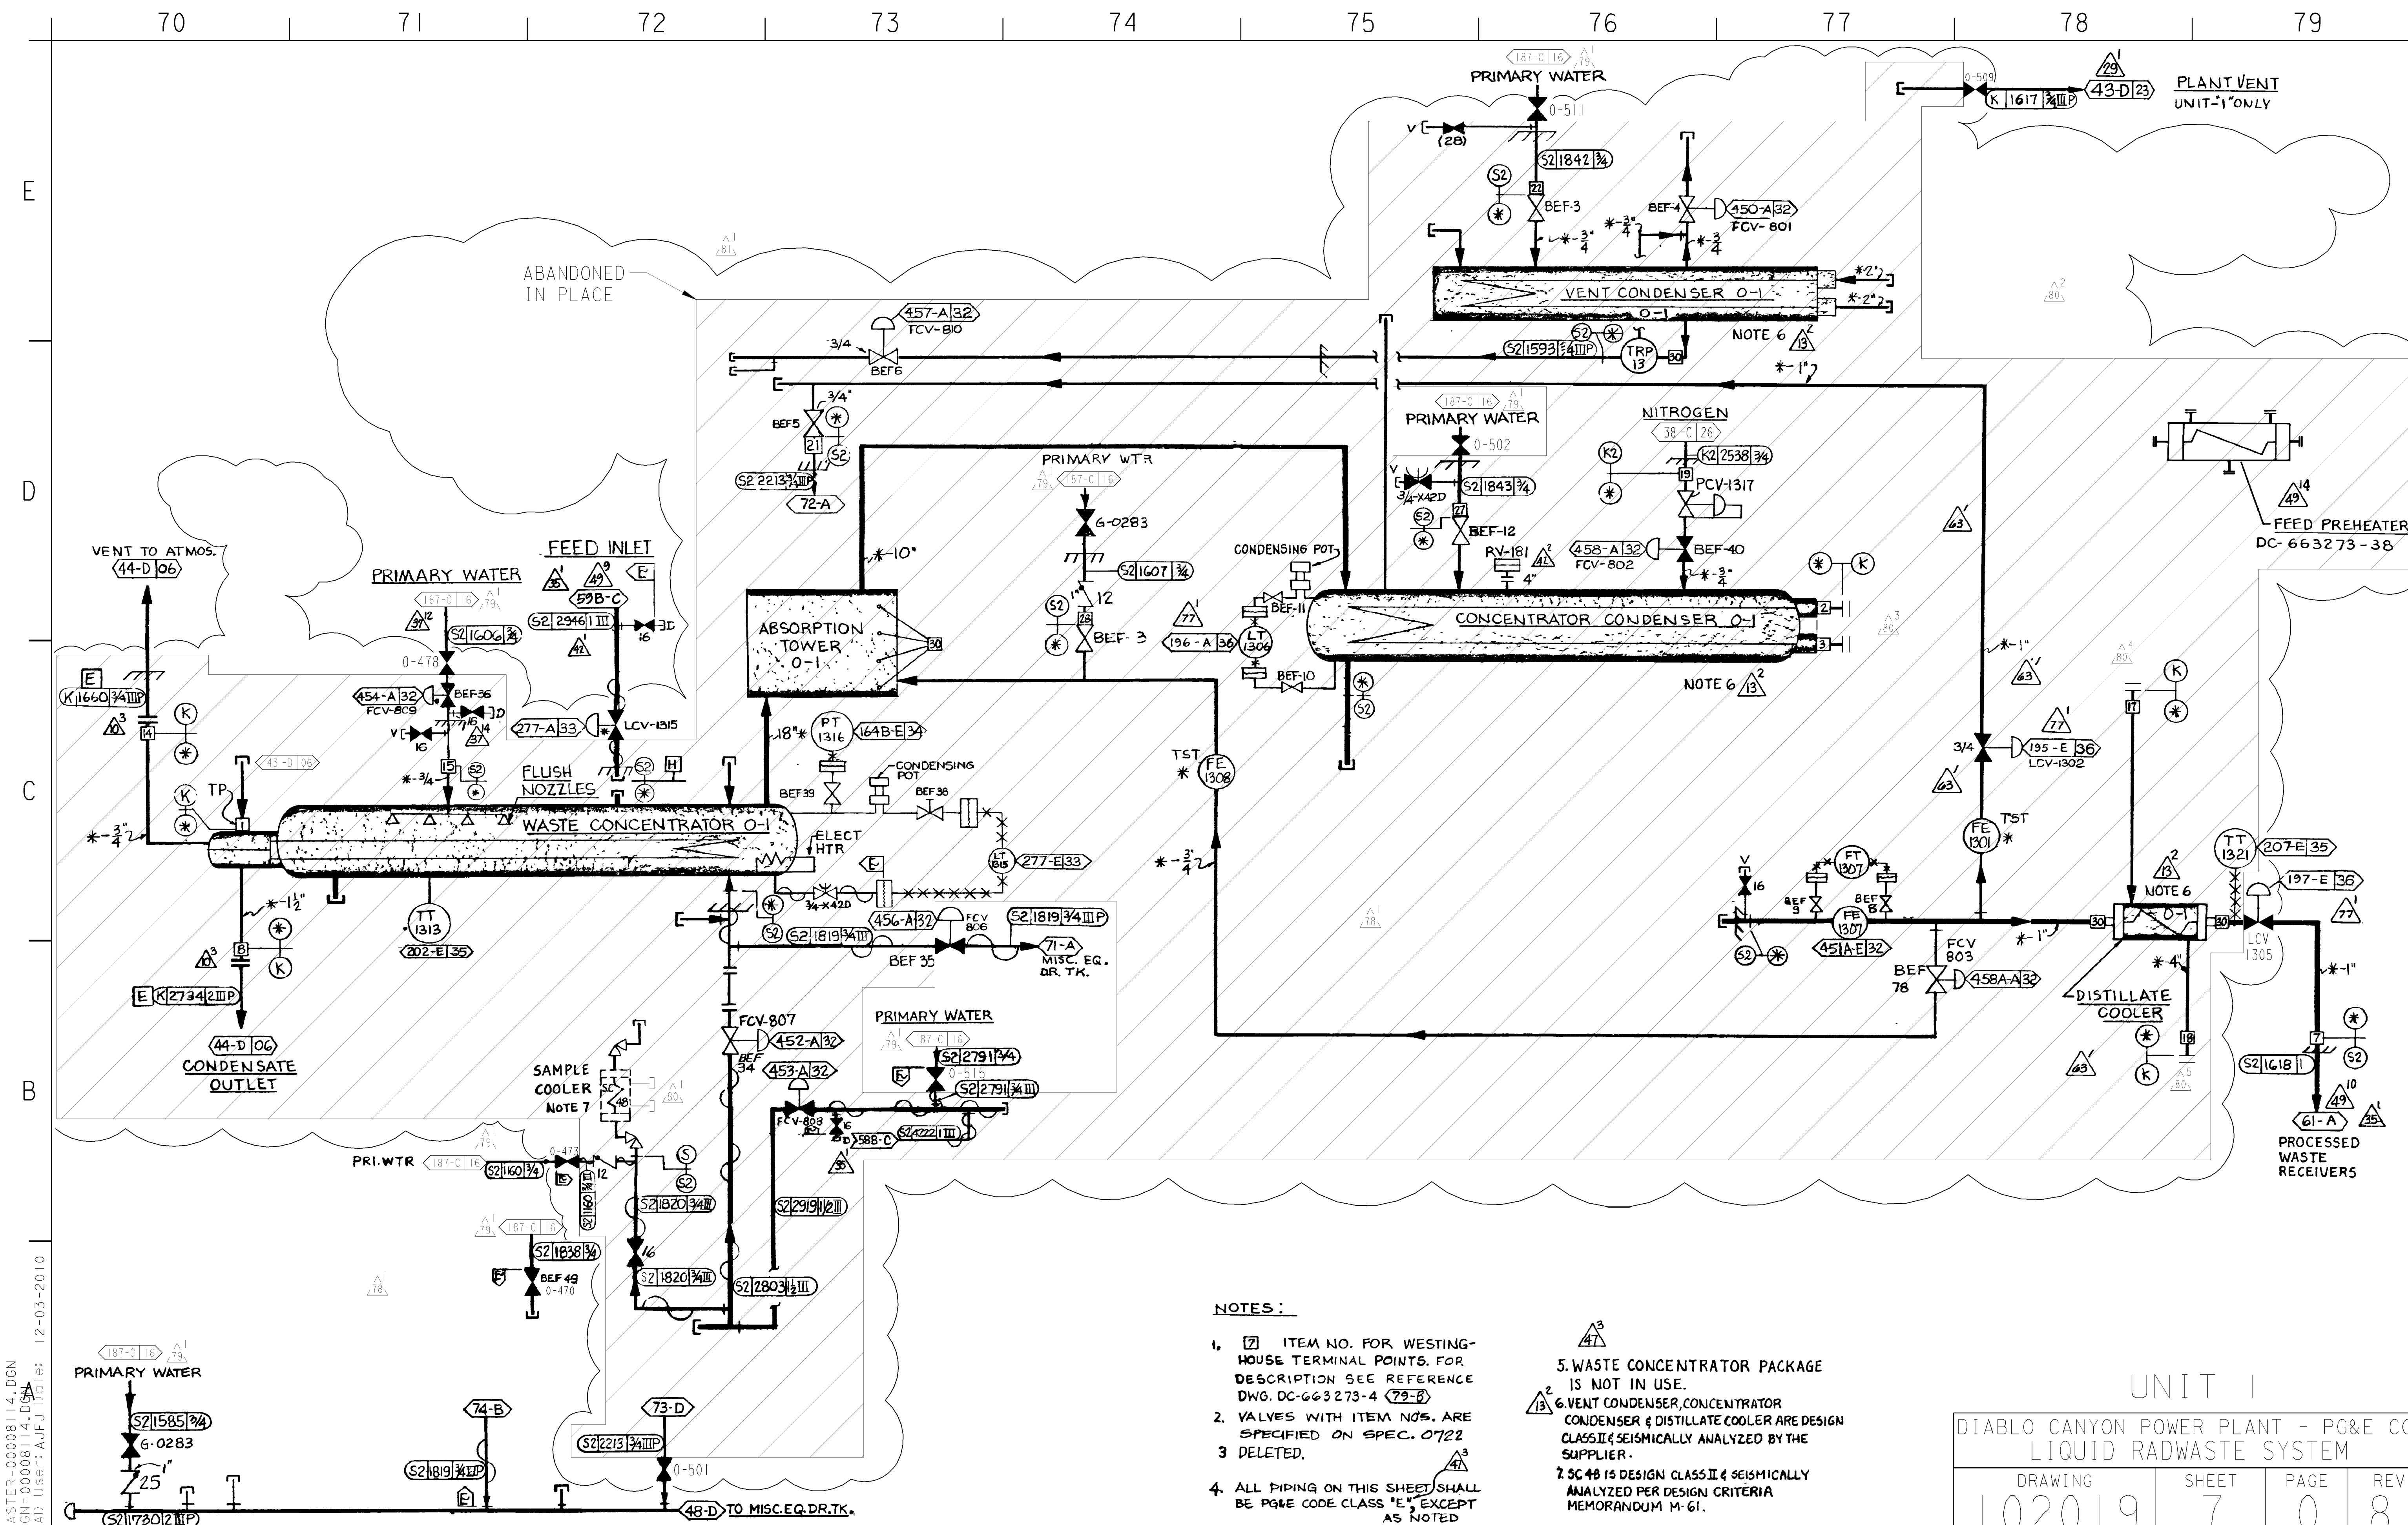


- NOTES:
1. [] ITEM NO. FOR WESTINGHOUSE TERMINAL POINTS. FOR DESCRIPTION SEE REFERENCE DWG. DC-663273-4 (79-B)
 2. VALVES WITH ITEM NOS. ARE SPECIFIED ON SPEC. 0722
 3. DELETED.
 4. ALL PIPING ON THIS SHEET SHALL BE PG&E CODE CLASS "E", EXCEPT AS NOTED
 5. WASTE CONCENTRATOR PACKAGE IS NOT IN USE.
 6. VENT CONDENSER, CONCENTRATOR CONDENSER & DISTILLATE COOLER ARE DESIGN CLASS II & SEISMICALLY ANALYZED BY THE SUPPLIER.
 7. SC 48 IS DESIGN CLASS II & SEISMICALLY ANALYZED PER DESIGN CRITERIA MEMORANDUM M-61.

UNIT 1

DIABLO CANYON POWER PLANT - PG&E CO.
LIQUID RADWASTE SYSTEM

DRAWING	SHEET	PAGE	REV
102019	7	0	81


CAD User: CMG9 Date: 6-08-1998
DGN=201958.DGN

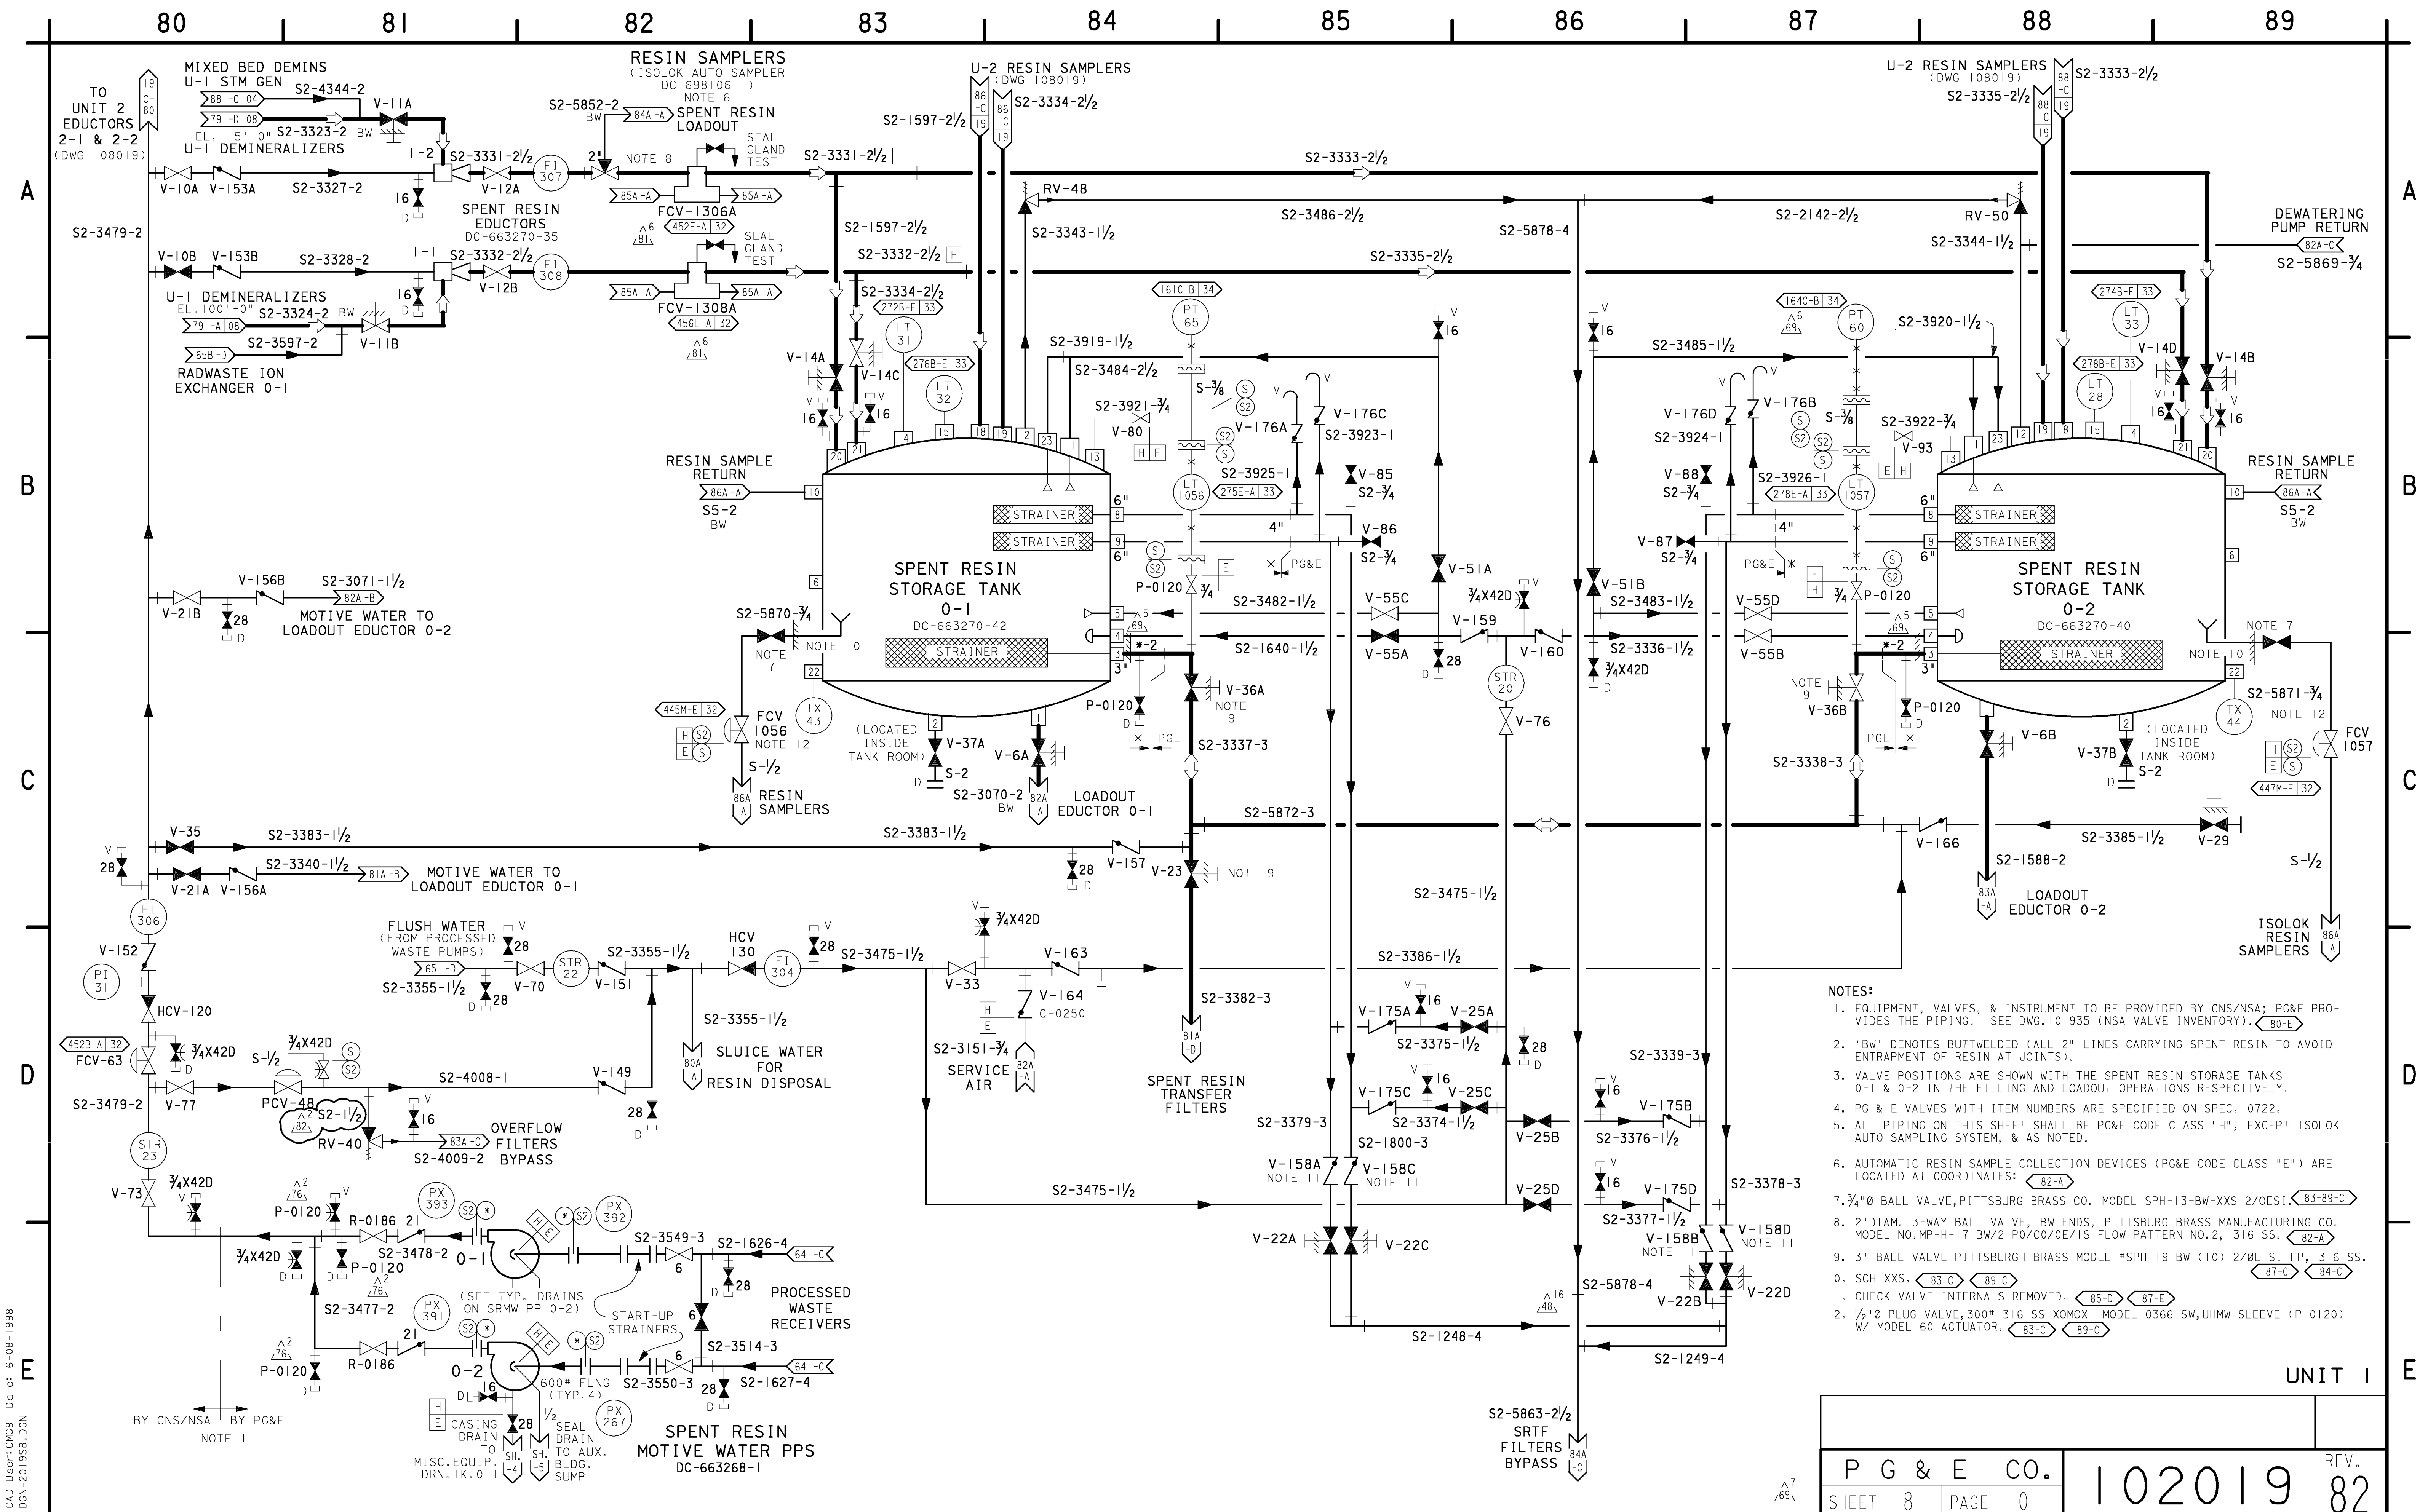


- NOTES:
- EQUIPMENT, VALVES, & INSTRUMENT TO BE PROVIDED BY CNS/NSA; PG&E PROVIDES THE PIPING. SEE DWG. 101935 (NSA VALVE INVENTORY). (80-E)
 - 'BW' DENOTES BUTTWELDED (ALL 2" LINES CARRYING SPENT RESIN TO AVOID ENTRAPMENT OF RESIN AT JOINTS).
 - VALVE POSITIONS ARE SHOWN WITH THE SPENT RESIN STORAGE TANKS 0-1 & 0-2 IN THE FILLING AND LOADOUT OPERATIONS RESPECTIVELY.
 - PG & E VALVES WITH ITEM NUMBERS ARE SPECIFIED ON SPEC. 0722.
 - ALL PIPING ON THIS SHEET SHALL BE PG&E CODE CLASS "H", EXCEPT ISOLOK AUTO SAMPLING SYSTEM, & AS NOTED.
 - AUTOMATIC RESIN SAMPLE COLLECTION DEVICES (PG&E CODE CLASS "E") ARE LOCATED AT COORDINATES: (82-A)
 - 3/4" BALL VALVE, PITTSBURGH BRASS CO. MODEL SPH-13-BW-XXS 2/OES1. (83+89-C)
 - 2" DIAM. 3-WAY BALL VALVE, BW ENDS, PITTSBURGH BRASS MANUFACTURING CO. MODEL NO. MP-H-17 BW/2 P/O/CO/OE/15 FLOW PATTERN NO. 2, 316 SS. (82-A)
 - 3" BALL VALVE PITTSBURGH BRASS MODEL *SPH-19-BW (10) 2/OE SL.FP. 316 SS. (87-C) (84-C)
 - SCH. XXS. (83-C) (89-C)
 - CHECK VALVE INTERNALS REMOVED. (85-D) (87-E)
 - 1/2" PLUG VALVE, 300# 316 SS. XOMOX MODEL 0366 SW, UHM SLEEVE (P-0120) W/ MODEL 60 ACTUATOR. (83-C) (89-C)


P G & E CO.		102019		REV.
SHEET 8	PAGE 0	82		

6/11/98	CMG9	BSGI	-	KERSI J. DALAL	MECHANICAL	M 16690	3/31/00	Revised per FCT 023040
DATE	DWN	RE	IV	PROFESSIONAL ENGINEER	PE DISC.	PE*	PE EXP.	


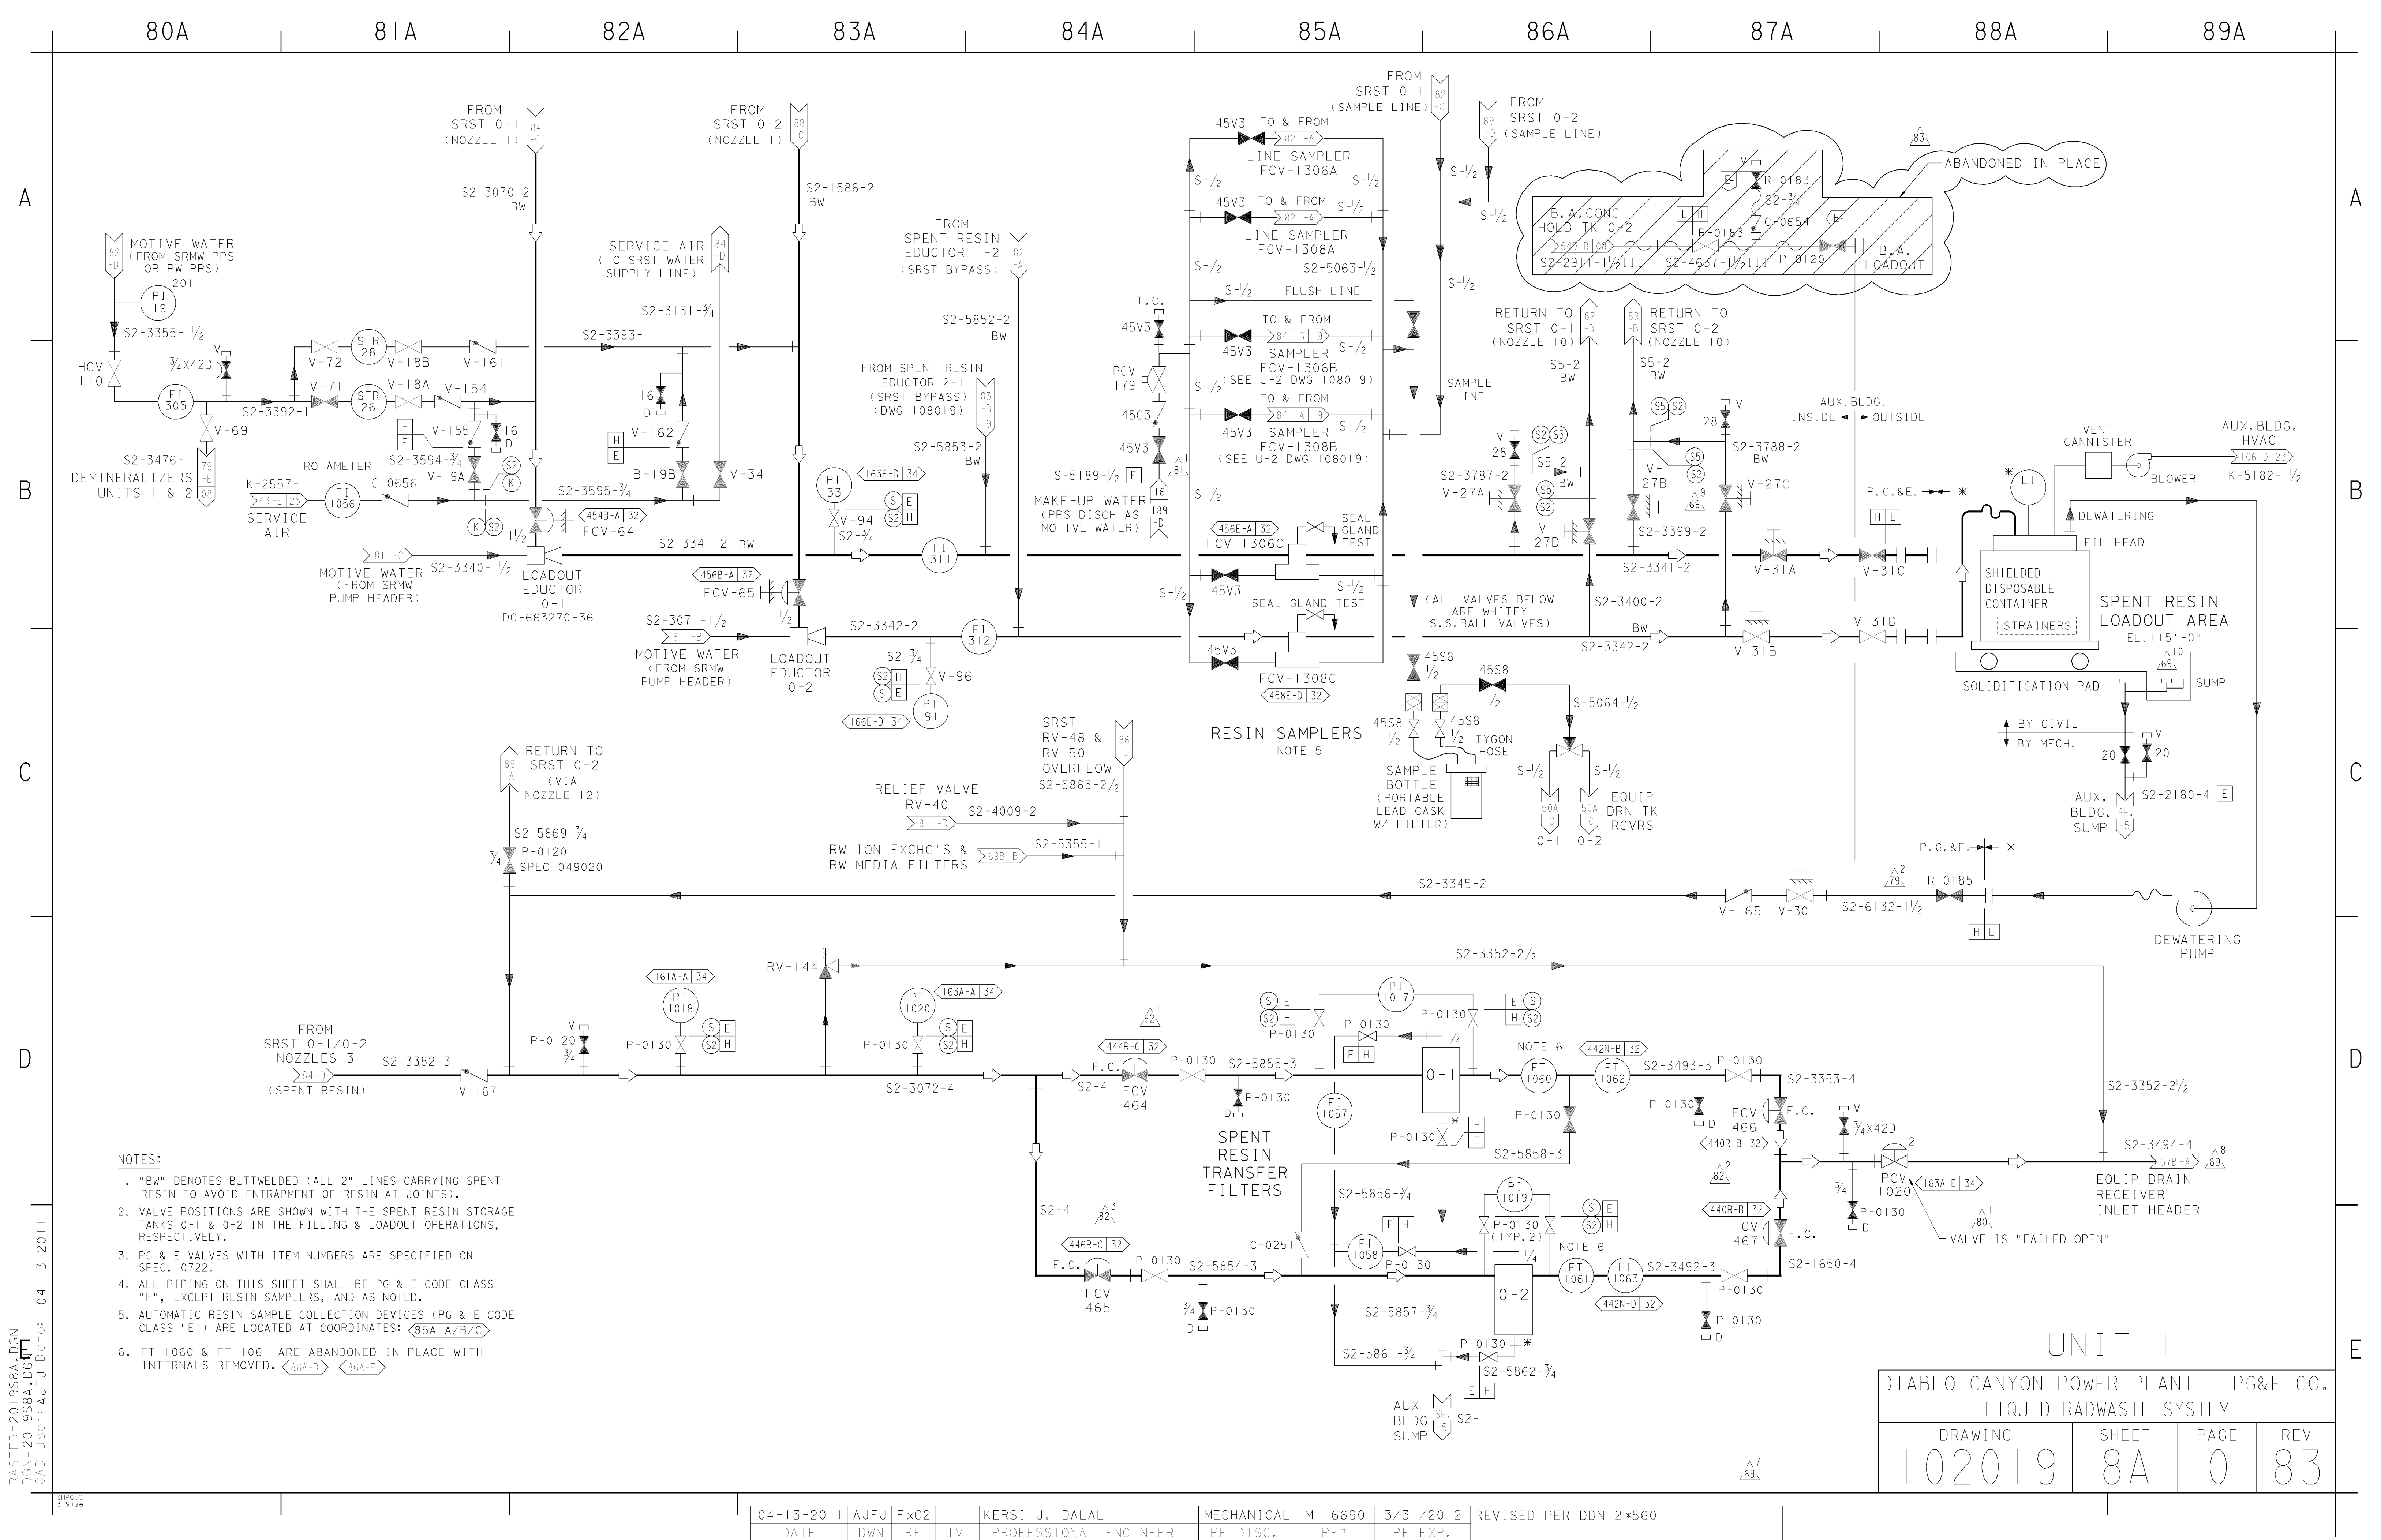


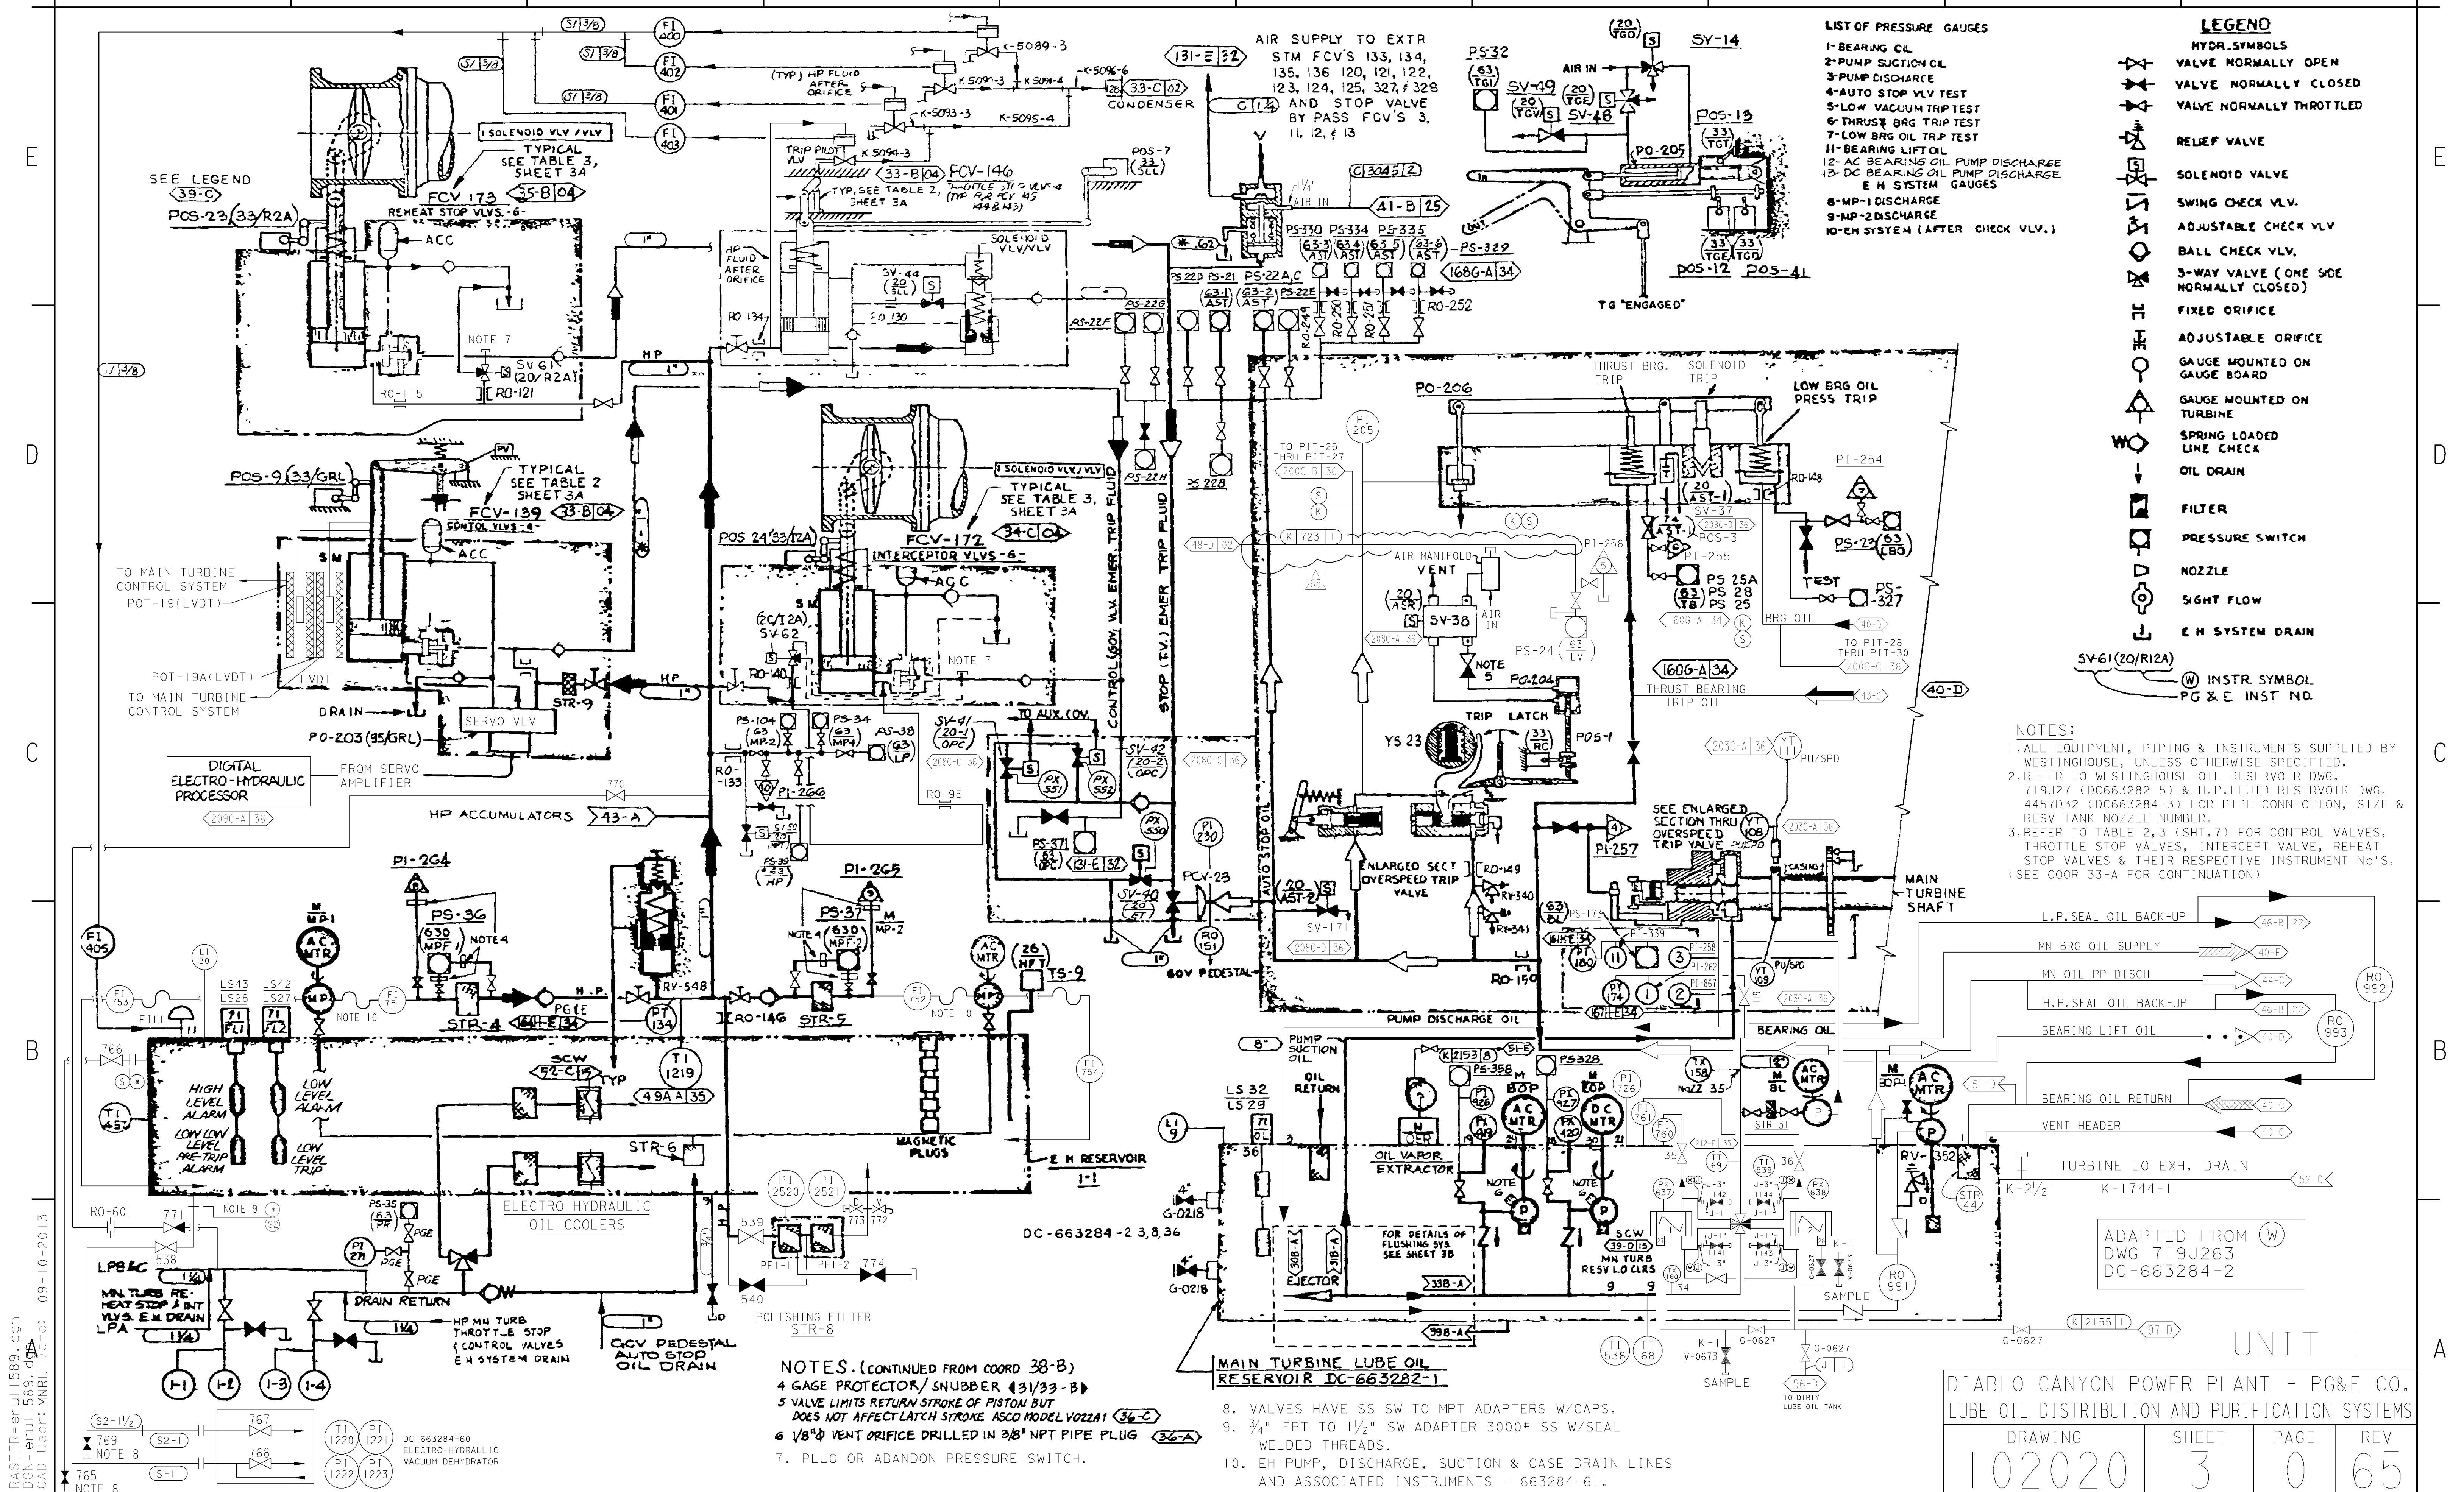

MAIN TURBINE-GENERATOR BEARING LUBRICATION SYSTEM

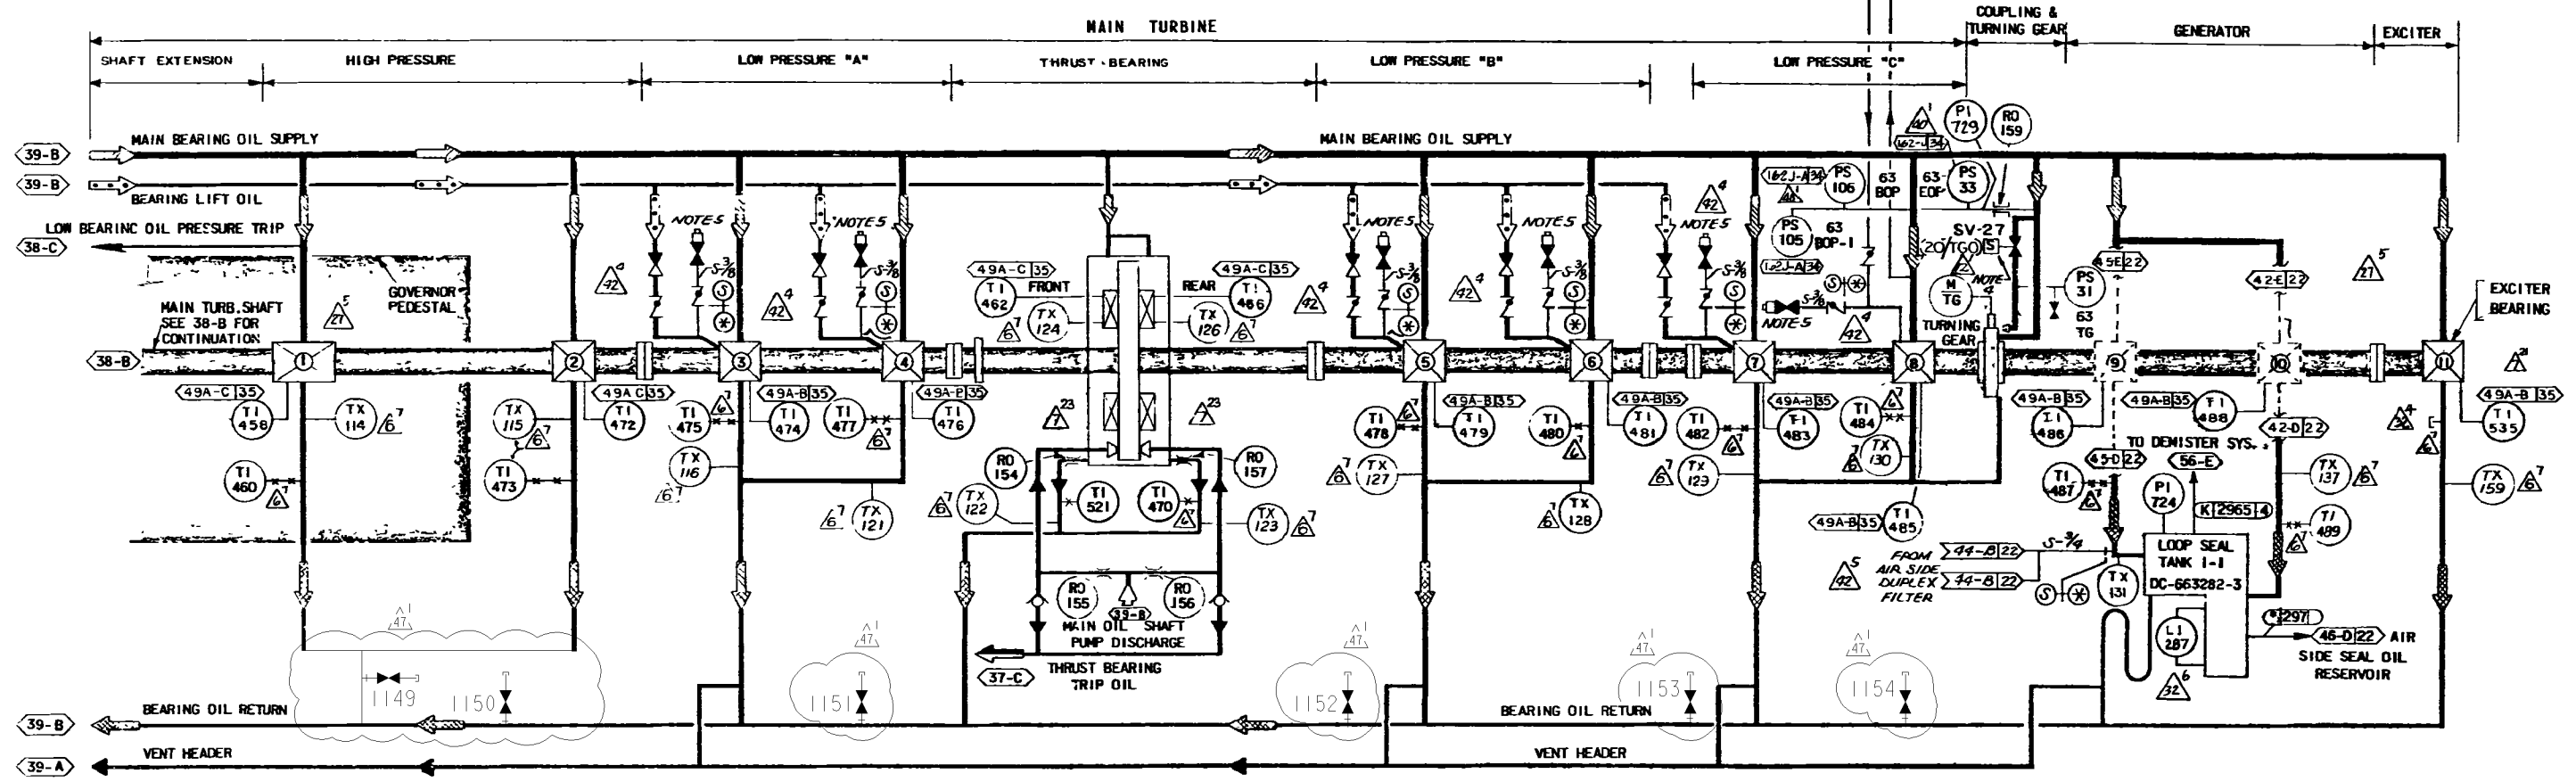

TURBINE SUPERVISORY INSTRUMENTATION

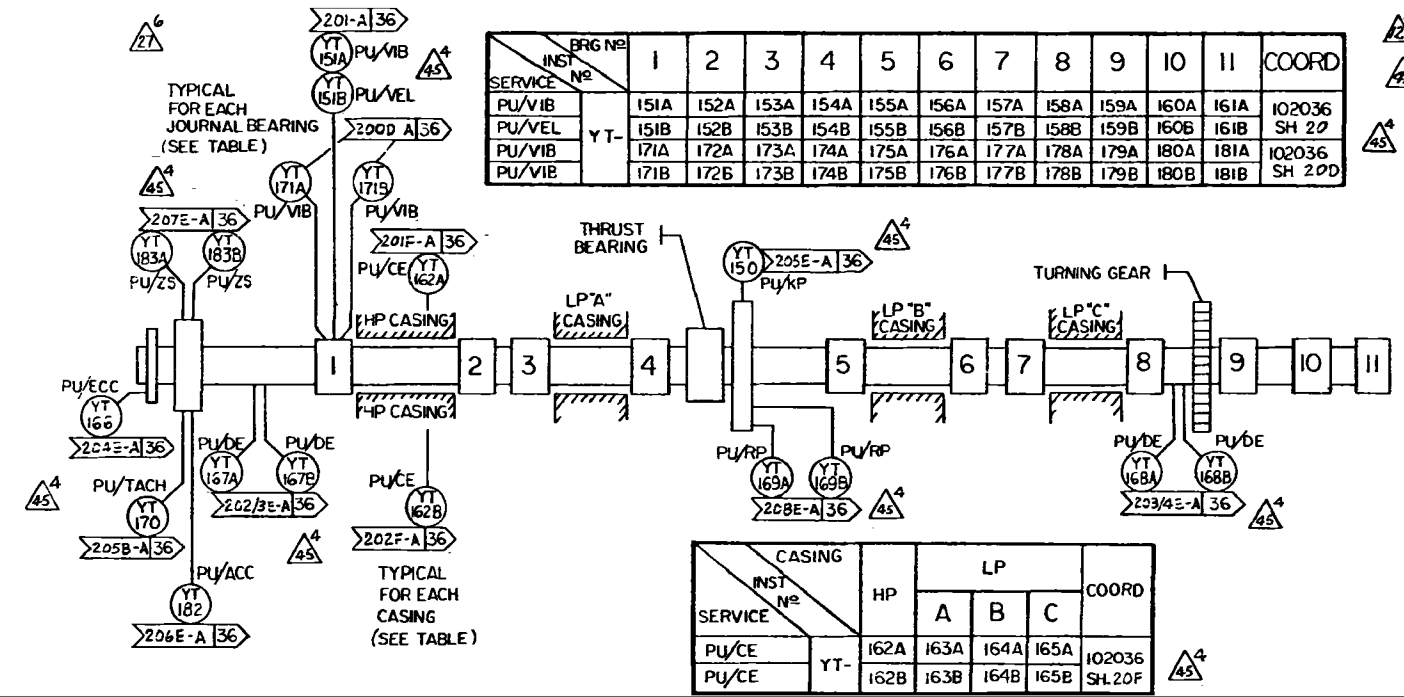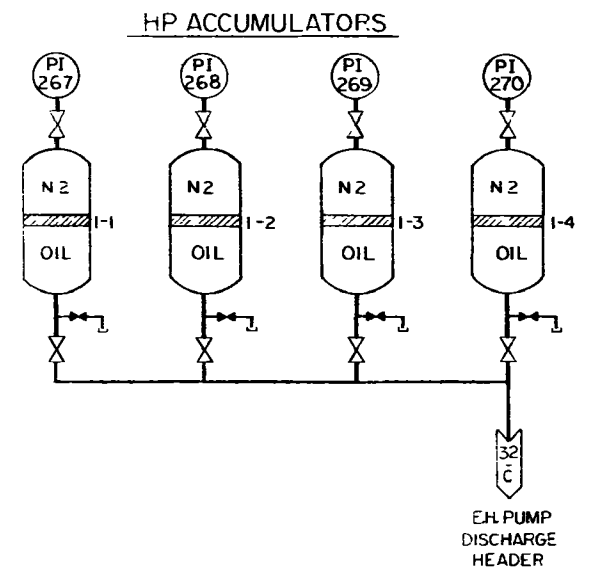

- NOTES:
- FOR BEARING SEQUENCE SEE DWG. NO. 663280-17 AND WESTINGHOUSE INSTRUCTION BOOK DC-663280-37, TAB 2.
 - FOR PIPING OIL CLEARANCES & EQUIPMENT LOCATION SEE DC-663282-4
 - ALL PIPING & INSTRUMENTS BY (U), UNLESS OTHERWISE NOTED.
 - SOLENOID VALVE WITH MANUAL OPERATOR. C.W. ROTATION FOR MANUAL OPENING C.G.W. FOR ELECTRIC OPERATION (17-D) END CONNECTION IS A BUTT WELD GREASE FITTING FOR MANUALLY PUMPED LIFT OIL, DC-663282-83 (12-17-0)

UNIT 1

DIABLO CANYON POWER PLANT - PG&E CO.			
LUBE OIL DISTRIBUTION AND PURIFICATION SYSTEMS			
DRAWING	SHEET	PAGE	REV
102020	4	0	47

RASTER=102020s4.dgn
DGN=102020s4.dgn
CAD User: ADMI Date:03-20-2009

03-20-2009	ADMI	FxC2		KERSI J. DALAL	MECHANICAL	M 16690	3/31/2010	REVISED PER DDT-4*162
DATE	DWN	RE	IV	PROFESSIONAL ENGINEER	PE DISC.	PE#	PE EXP.	

E

D

C

B

A


E

D


C

B

A

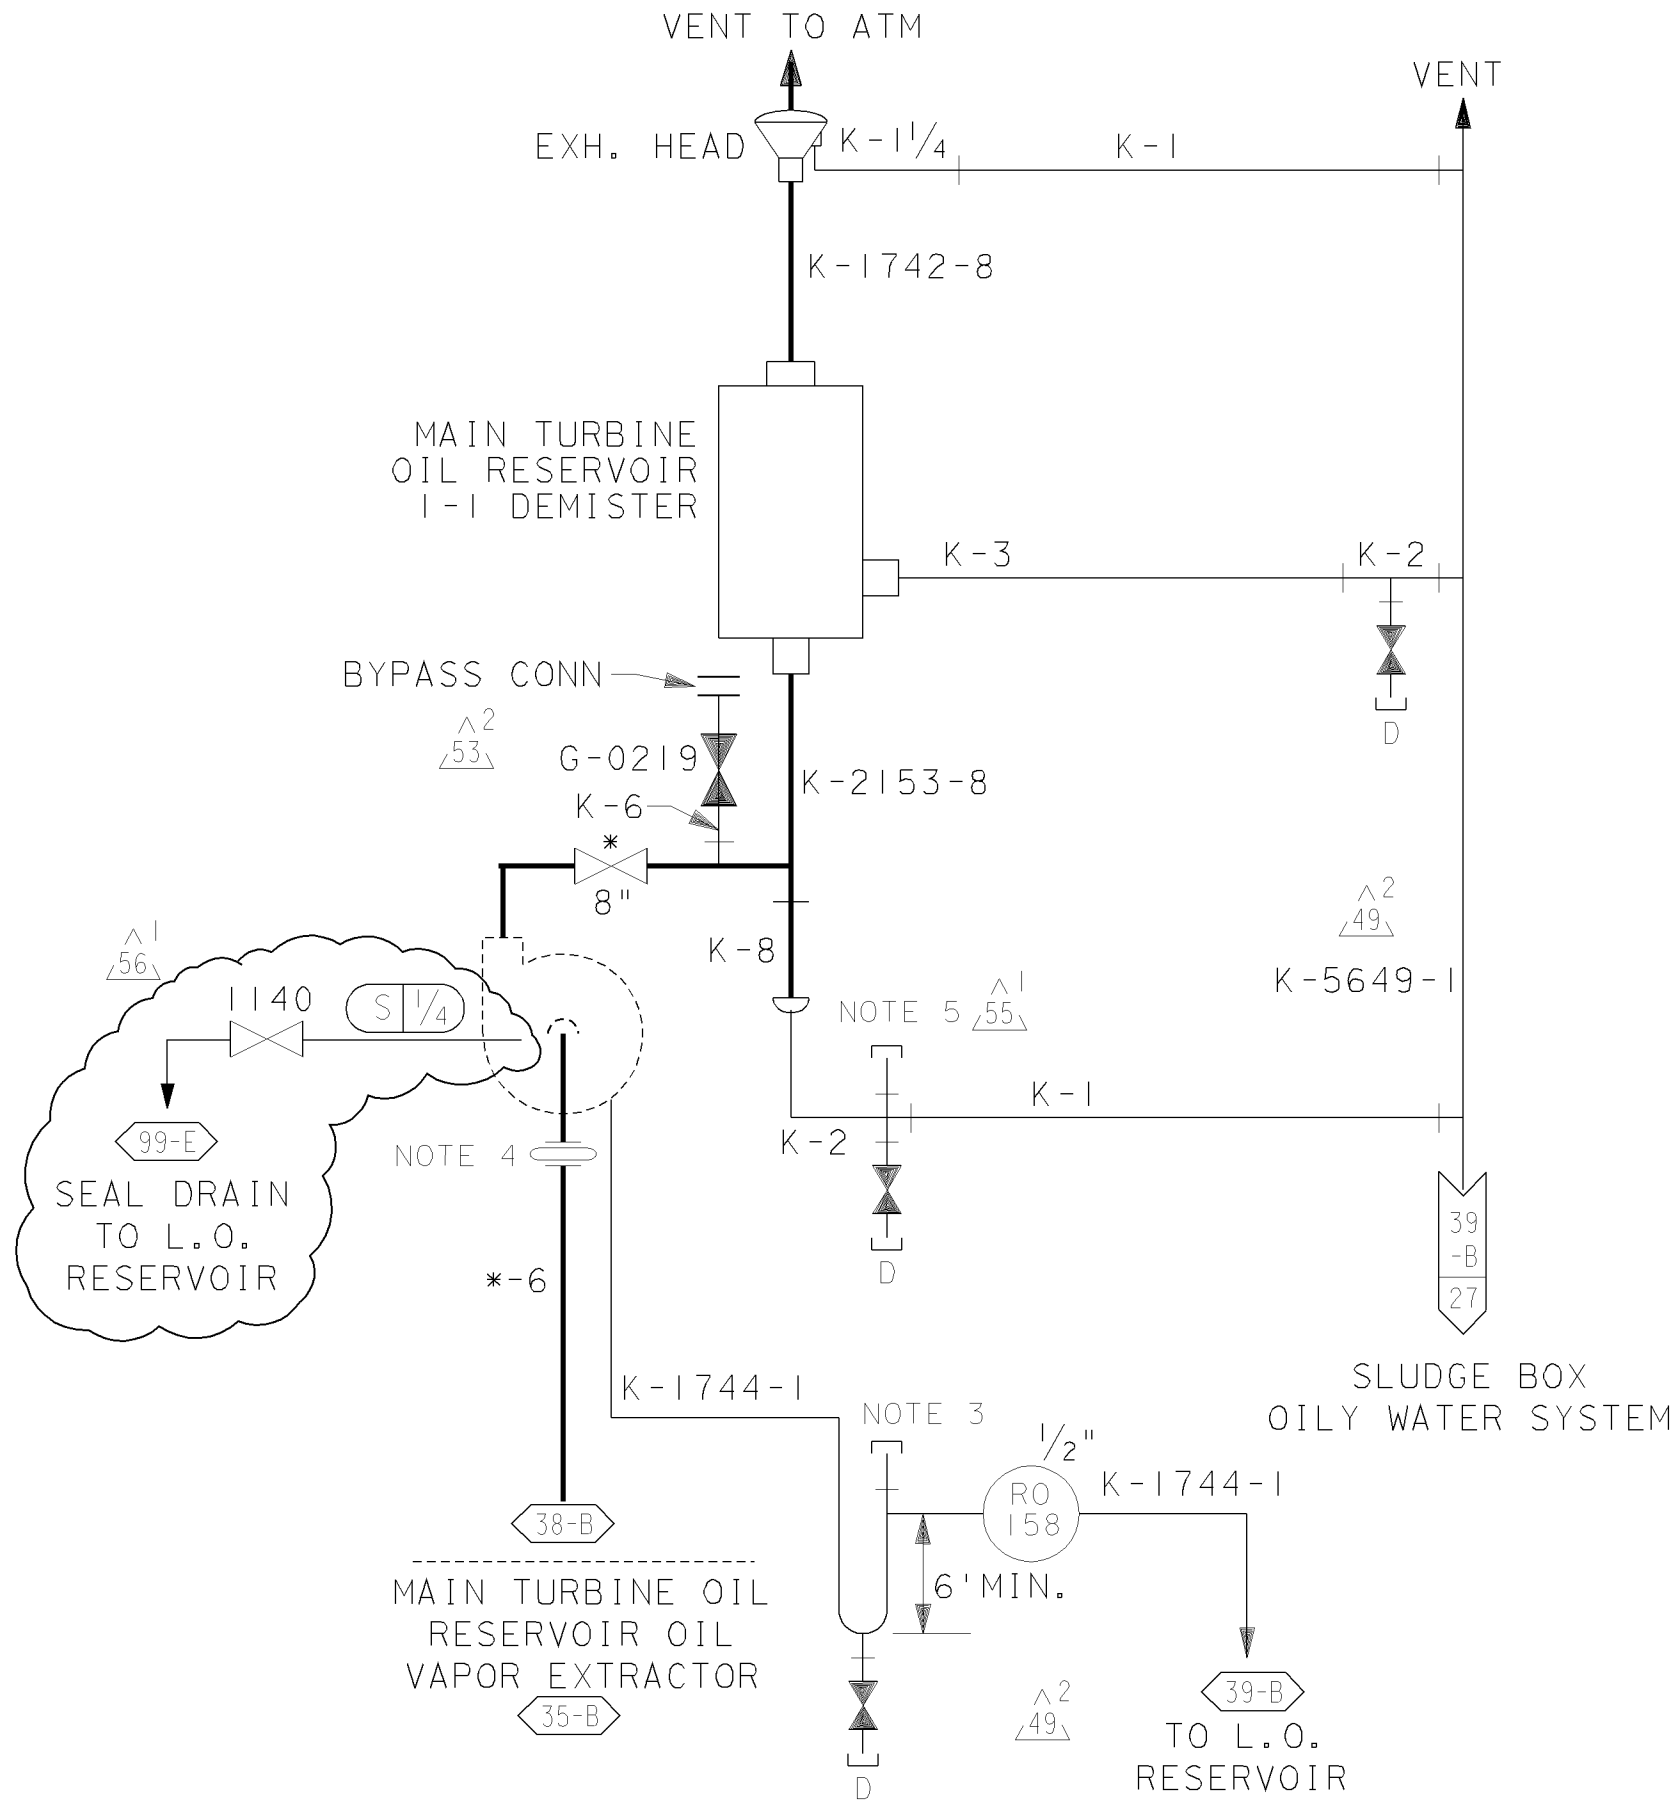


MAIN TURBINE OIL RESERVOIR
VAPOR EXTRACTOR AND
DEMISTER SYSTEM
DC-663282-1

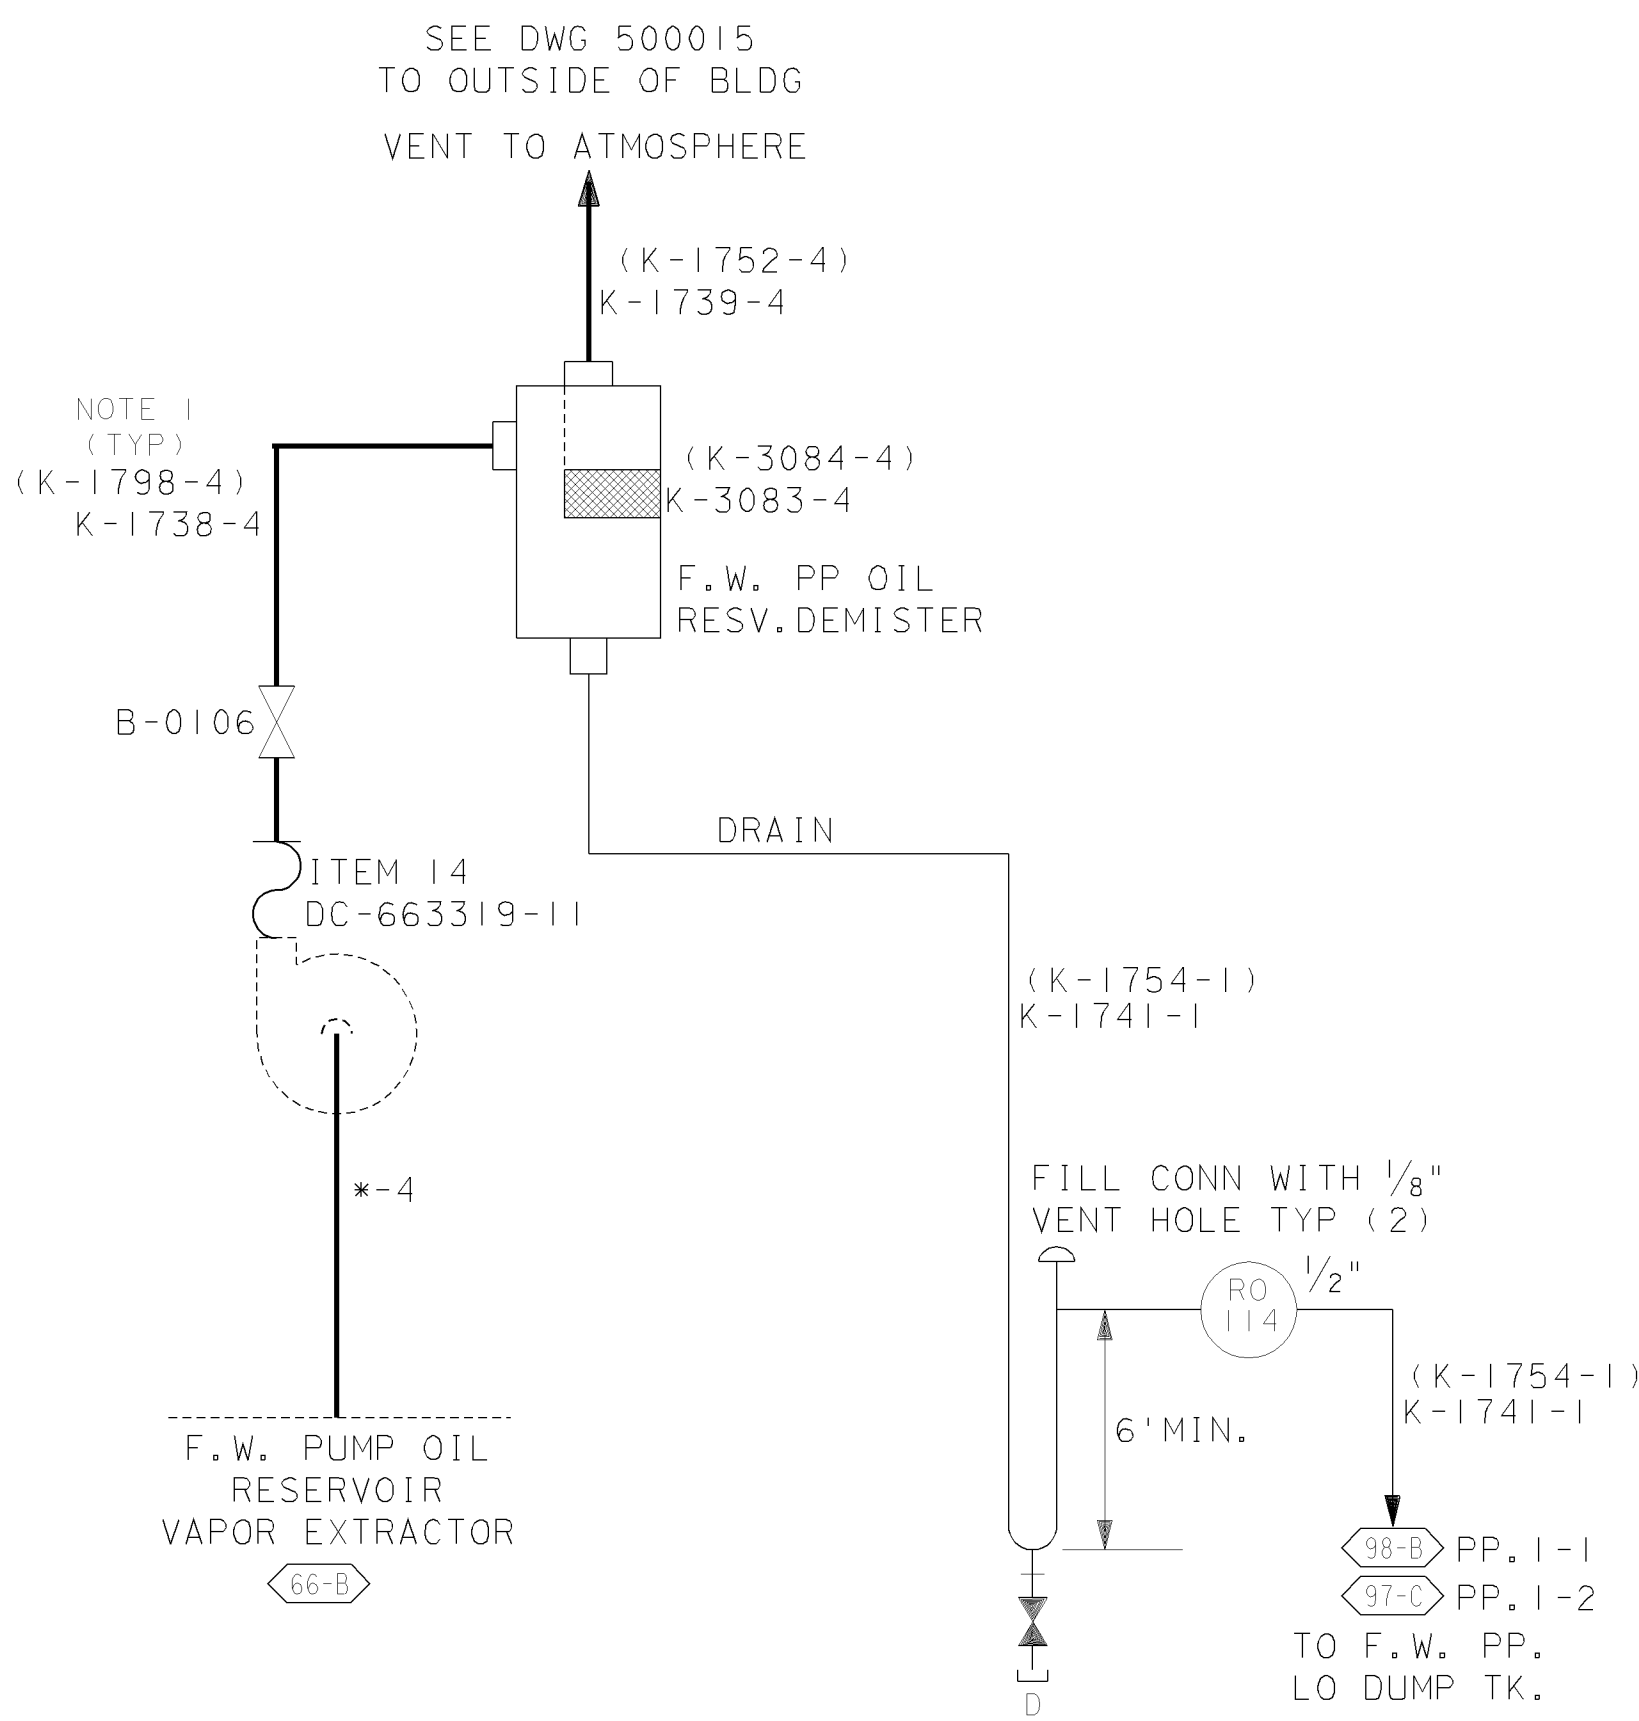

FEEDWATER PUMP OIL
RESERVOIR I-1 VAPOR
EXTRACTOR AND DEMISTER
SYSTEM

FOR FEEDWATER PUMP I-2
REFER TO NOTES 1 & 2

DC-663300-5
DC-663300-11 TAB 44

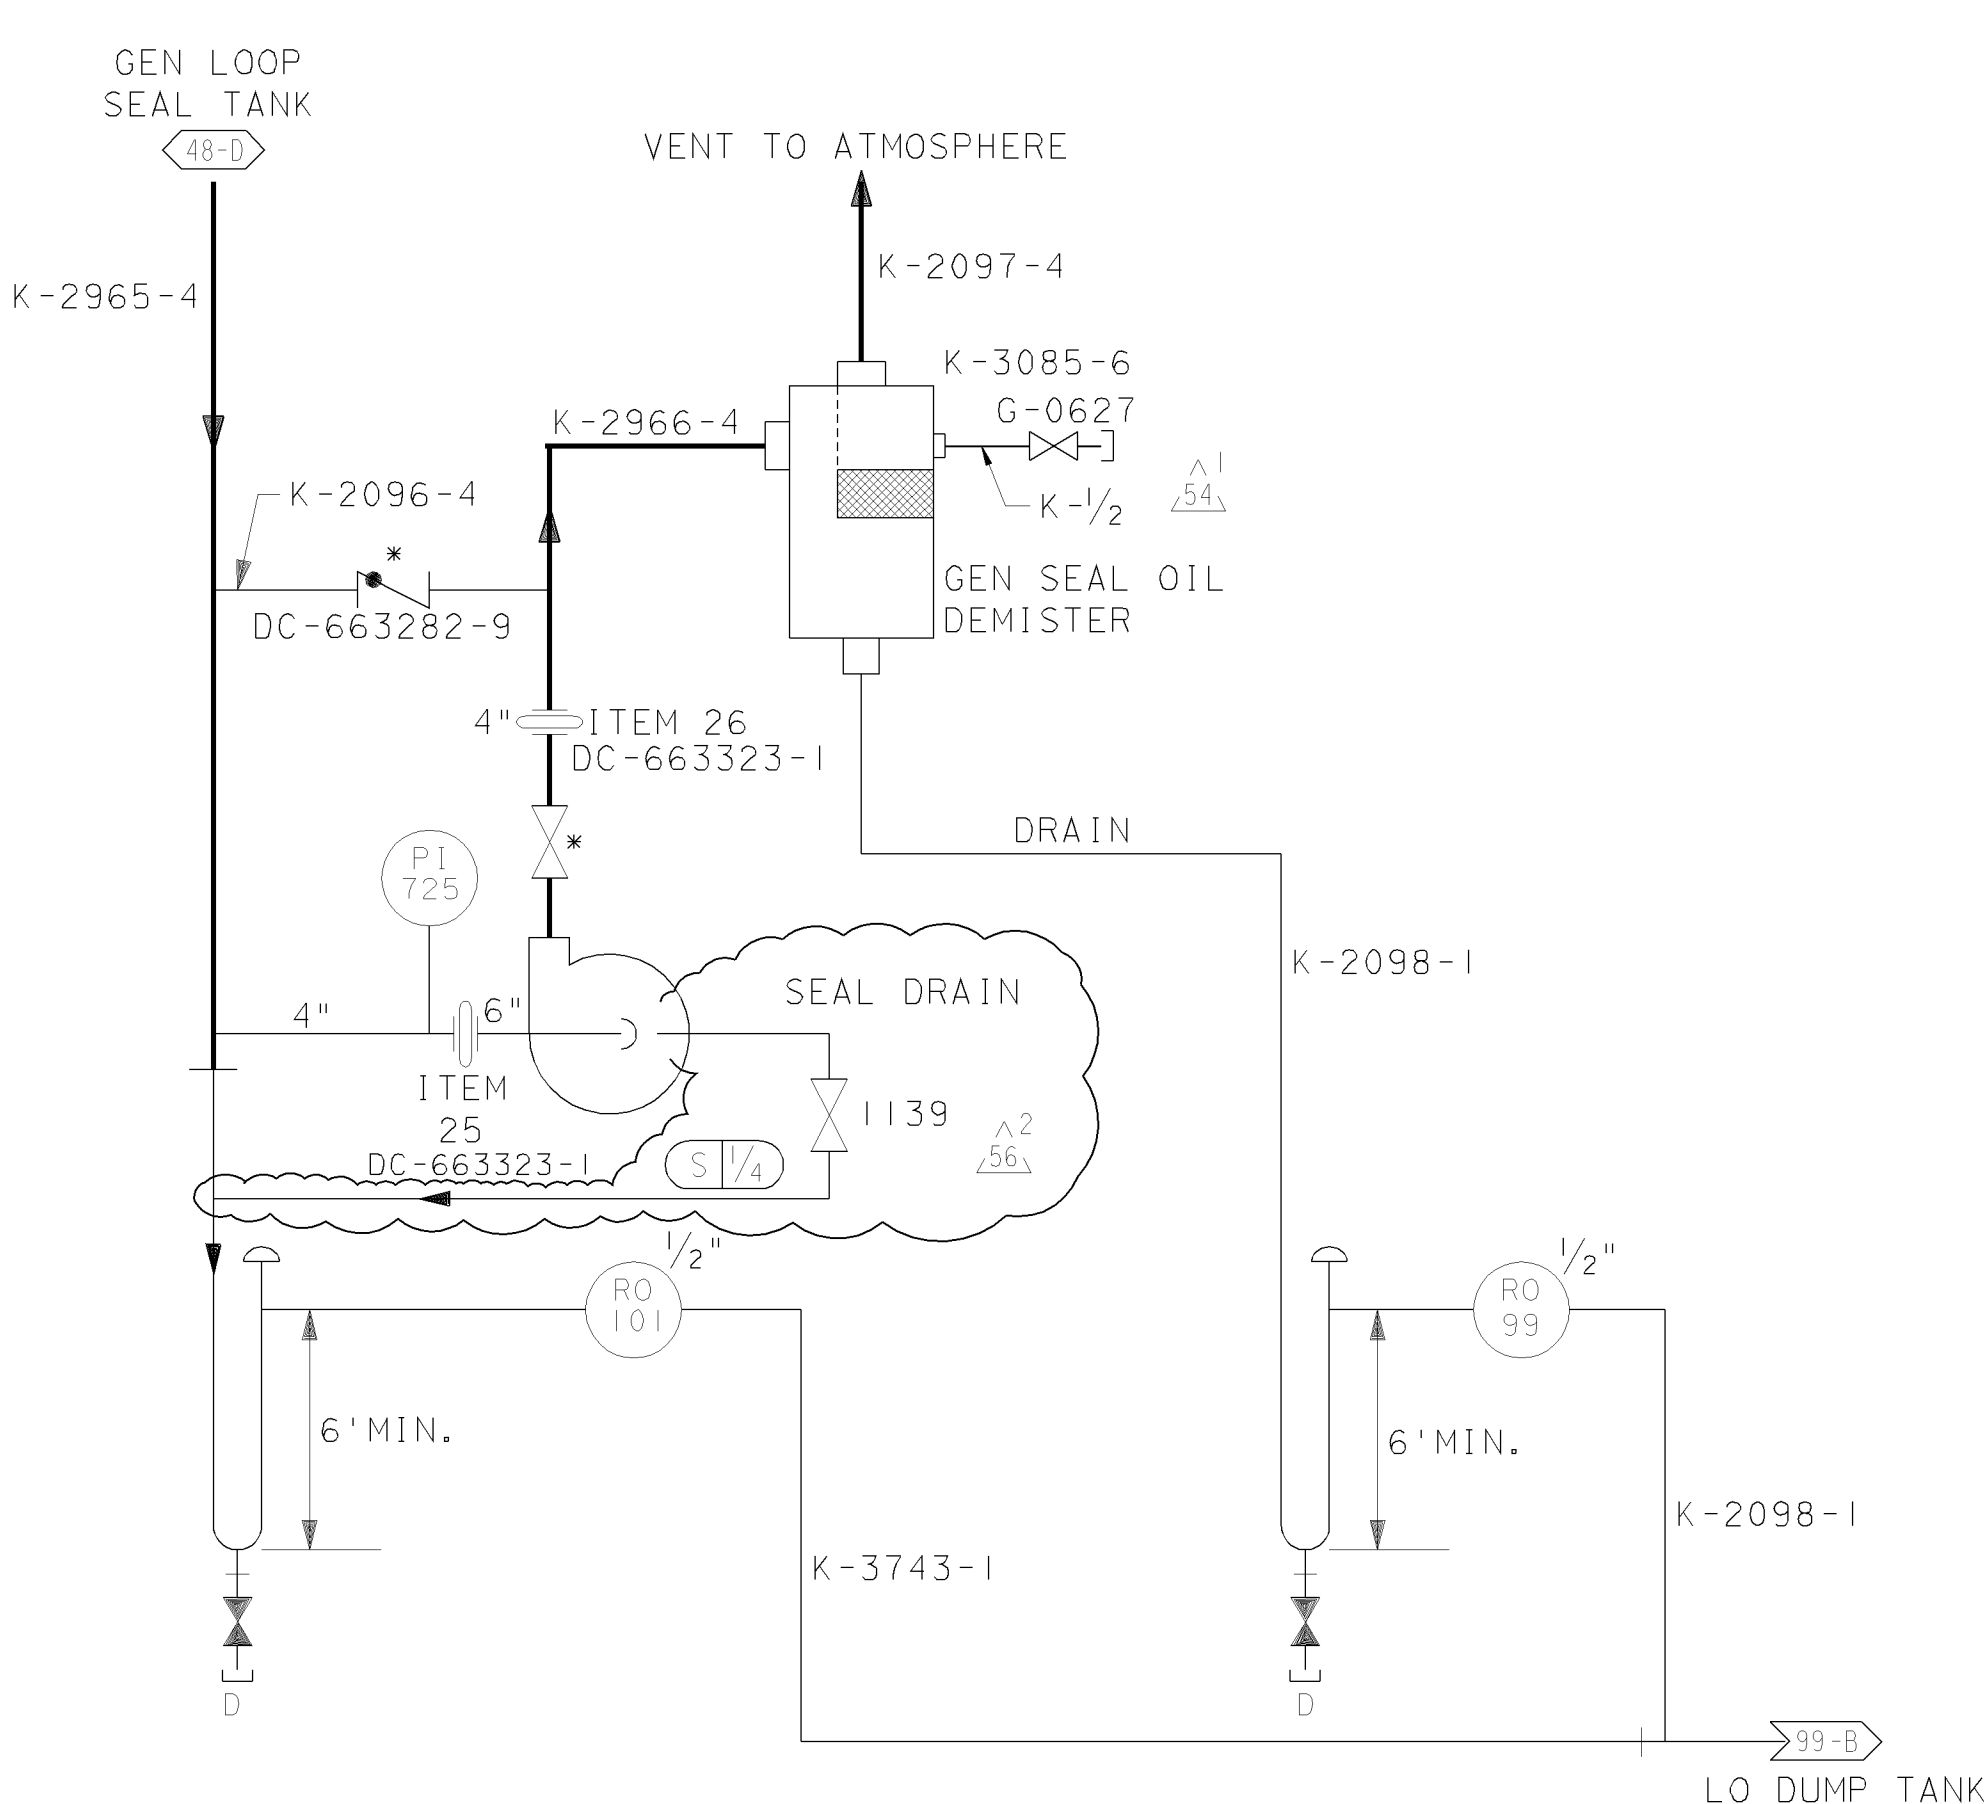

GENERATOR LOOP SEAL OIL TANK
VAPOR EXTRACTOR AND DEMISTER
SYSTEM
DC-663282-3

NOTES:


1. ALL LINE NUMBERS IN PARENTHESIS ARE FOR FEEDWATER PUMP I-2 (53-E)
2. INSTRUMENT NUMBERS FOR FW. PP. OIL RESERVOIR I-2 ARE ON SHEET 7 TABLE 4 (54-B)
3. FILL CONN WITH 1/4" VENT HOLE (52-D)
4. 8" EXPANSION JOINT, STOCK CODE 77-661 (51-D) (51-D) (51-D)
5. FILL CONN ONLY, NO VENT HOLE (52-D)

UNIT 1

DIABLO CANYON POWER PLANT - PG&E CO.

DRAWING	SHEET	PAGE	REV
102020	5	0	56

12-07-2005	MIBF	RMDI		KERSI J. DALAL	MECHANICAL	M 16690	3/31/2006	REVISED PER FCT-029947
DATE	DWN	RE	1V	PROFESSIONAL ENGINEER	PE DISC.	PE#	PE EXP.	

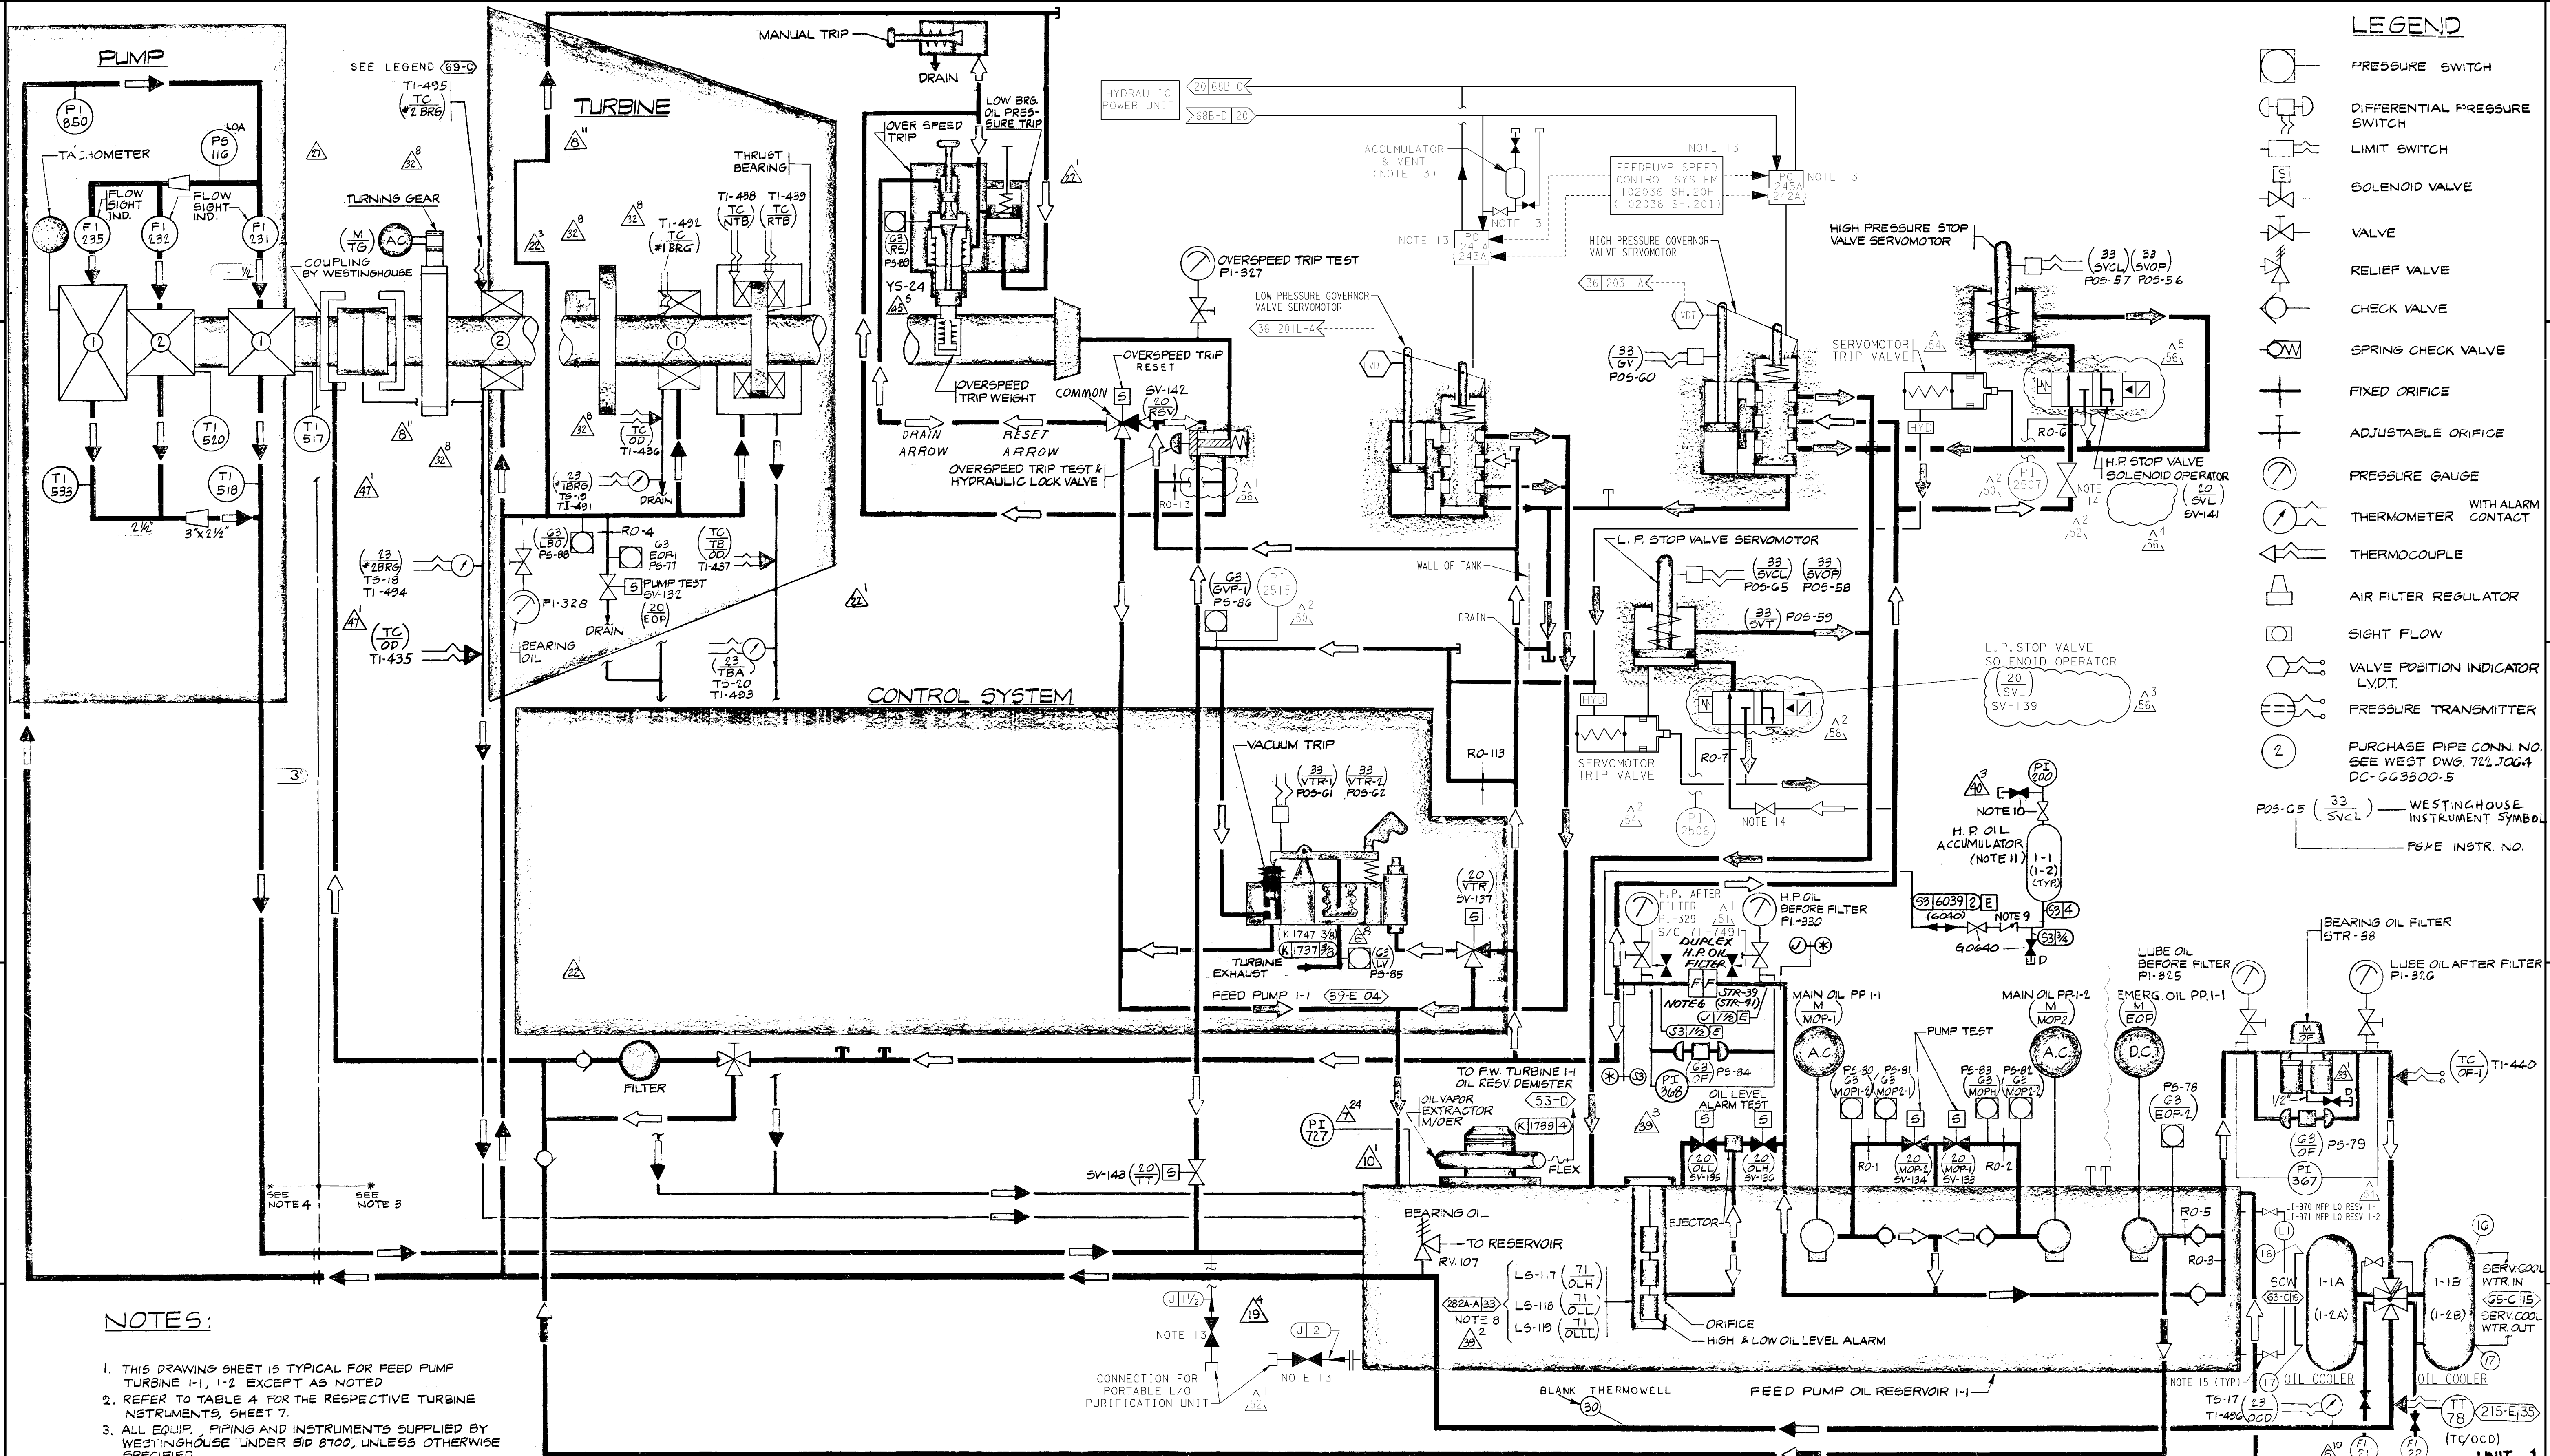

NOTES:

1. THIS DRAWING SHEET IS TYPICAL FOR FEED PUMP TURBINE 1-1, 1-2 EXCEPT AS NOTED
2. REFER TO TABLE 4 FOR THE RESPECTIVE TURBINE INSTRUMENTS, SHEET 7.
3. ALL EQUIP., PIPING AND INSTRUMENTS SUPPLIED BY WESTINGHOUSE UNDER BID 8700, UNLESS OTHERWISE SPECIFIED.
4. ALL EQUIP., PIPING AND INSTRUMENTS SUPPLIED BY BYRON JACKSON UNDER BID 8702, UNLESS OTHERWISE SPECIFIED. (61-B)
5. REFER TO TABLE 1 FOR RESPECTIVE PUMP INSTRUMENTS SHEET 7 (61-B)
6. H.P. OIL DUPLEX FILTER SUPPLIED BY PTI. (66-B)

7. DELETED.

8. SUPPLIED BY PG & E (65-A)

9. 2" CHECK VALVE S.S. (75-2904) WITH 3/16" PASS HOLE.
10. NUPRO 65-G P4T (68-C)
11. ACCUMULATOR, PI, SUPPLIED BY OILAIR, DC 663301-30. (66-C)
12. DELETED.

13. PROVIDED BY WOODWARD.
14. WHITEY MODEL SS-45F8
15. WHITEY MODEL B-45F8, DWG 698106-26.

F. W. PUMP TURBINE CONTROL OIL SYSTEM

REF. DWGS. 724JOGG DC-663301-1
724J852 DC-663301-2

P G & E CO.
SHEET 6 PAGE 0

102020
REV. 56

FEEDWATER PUMP TURBINE DRIVE TABLE 4

DESCRIPTIONS				PG & E INSTR.		102020 COORD.	① DEV. NO.
				FWP 1-1	FWP 1-2		
LINE BEARING	DRAIN OIL	NO. 1	METAL	TI-436	TI-447	62-D	TC/OD
	METAL			TI-491	TI-497	62-D	23/1BRG
THRUST BEARING	NORMAL DIRECTION	NO. 1	METAL	TS-19	TS-28	62-E	23/1BRG
	REVERSE DIRECTION			TI-492	TI-498	63-E	TC/1 BRG
LINE BEARING	DRAIN OIL	NO. 2	METAL	T2345A	T2352A	63-E	TC/NTB
	METAL			TI-438	TI-449	63-E	TC/NTB
LUBE OIL COOLERS	INLET	NO. 1	BEFORE	T2347A	T2354A	63-F	TC/RTB
	OUTLET			TI-439	TI-536	63-F	TC/RTB
BEARING OIL SUPPLY	INLET	NO. 1	BEFORE	T2348A	T2355A	63-D	TC/TB/OD
	OUTLET			TI-437	TI-448	63-D	23/TBA
MAIN OIL PUMP	INLET	NO. 1	BEFORE	TS-20	TS-33	63-D	23/TBA
	OUTLET			TI-435	TI-446	61-E	TC/OD
DISCH. TO BRG.	INLET	NO. 1	BEFORE	TI-494	TI-500	61-D	23/2BRG
	OUTLET			TS-18	TS-34	61-D	23/2BRG
HYDRAULIC POWER UNIT (HPU)	INLET	NO. 1	BEFORE	TI-495	TI-501	61-E	TC/2 BRG
	OUTLET			T2346A	T2353A	61-E	TC/2 BRG
HYDRAULIC POWER UNIT (HPU)	INLET	NO. 1	BEFORE	STR-38	STR-40	69-B	FILTER
	OUTLET			PI-325	PI-331	68-B	63/OF
HYDRAULIC POWER UNIT (HPU)	INLET	NO. 1	BEFORE	PI-326	PI-332	69-B	-
	OUTLET			TI-440	TI-443	69-B	TC/OF-1
HYDRAULIC POWER UNIT (HPU)	INLET	NO. 1	BEFORE	TI-496	TI-502	69-A	23/ODD
	OUTLET			TS-17	TS-36	69-A	23/ODD
HYDRAULIC POWER UNIT (HPU)	INLET	NO. 1	BEFORE	TT-78	TT-79	69-A	TC/ODD
	OUTLET			RV-107	RV-108	65-A	-
HYDRAULIC POWER UNIT (HPU)	INLET	NO. 1	BEFORE	PI-328	PI-334	62-D	-
	OUTLET			PS-88	PS-101	62-D	63/LBO
HYDRAULIC POWER UNIT (HPU)	INLET	NO. 1	BEFORE	FI-21	FI-70	69-B	-
	OUTLET			FI-22	FI-25	69-B	-
HYDRAULIC POWER UNIT (HPU)	INLET	NO. 1	BEFORE	RO-1	RO-14	67-B	-
	OUTLET			PS-83	PS-96	67-B	63/MP01-1
HYDRAULIC POWER UNIT (HPU)	INLET	NO. 1	BEFORE	SV-134	SV-147	67-B	20/MOP-1
	OUTLET			PS-80	PS-93	67-B	63/MOP 1-2
HYDRAULIC POWER UNIT (HPU)	INLET	NO. 1	BEFORE	RO-2	RO-15	67-B	-
	OUTLET			PS-81	PS-94	67-B	63/MOP2-1
HYDRAULIC POWER UNIT (HPU)	INLET	NO. 1	BEFORE	SV-133	SV-148	67-B	20/MOP 2
	OUTLET			PS-82	PS-95	67-B	63/MOP 2-2
HYDRAULIC POWER UNIT (HPU)	INLET	NO. 1	BEFORE	RO-3	RO-16	68-B	-
	OUTLET						

FEEDWATER PUMP TABLE 1			
DESCRIPTION		FWP 1-1	FWP 1-2
LINE BEARING	DRAIN OIL	TI-518	TI-523
	METAL	TI-517	TI-522
THRUST BEARING	OIL SUPPLY	T2349A	T2356A
	METAL	FI-231	FI-233
BEARING OIL SUPPLY	OIL SUPPLY	TI-520	TI-525
	METAL	T2350A	T2357A
HYDRAULIC POWER UNIT (HPU)	OIL SUPPLY	FI-232	FI-234
	METAL	TI-533	TI-534
HYDRAULIC POWER UNIT (HPU)	OIL SUPPLY	T2351A	T2358A
	METAL	FI-235	FI-236
HYDRAULIC POWER UNIT (HPU)	OIL SUPPLY	PI-850	PI-851
	METAL	PS-116	PS-119

DESCRIPTION		PG & E INSTR. NO.		102020 COORD.	① DEV. NO.
		FWP 1-1	FWP 1-2		
THRUST BEARING WEAR		YT-70A	YT-80A	65A-D	
KEY PHASOR		YT-71	YT-81	67A-B	
FW TURBINE BEARING	NO. 1	YT-72A	YT-82A	68A-D	
	NO. 2	YT-72B	YT-82B	68A-D	
FW PUMP BEARING	NO. 1	YT-73	YT-83	68A-B	
	NO. 2	YT-74A	YT-84A	64A-D	
LOW PRESSURE SERVOMOTOR	60V V	YT-74B	YT-84B	64A-D	
	STOP VALVE	YT-75	YT-85	64A-B	
LOW PRESSURE SERVOMOTOR	STOP VALVE	YT-76A	YT-86A	61A-D	
	STOP VALVE	YT-76B	YT-86B	61A-D	
SPEED PICKUP MPU 1	YE1509A	YT-77	YT-87	60A-D	
	YE1509B	YT-78A	YT-88A	60A-D	
SPEED PICKUP MPU 2	YE1509C	YT-78B	YT-88B	60A-D	
	YE1509D	YT-79	YT-89	60A-B	
SPEED PICKUP MPU 3	YE1509E	YT-79	YT-89	60A-B	
	YE1509F	YT-80	YT-90	60A-B	
H.P. OIL ACCUMULATOR		PI-200	PI-201	68-C	
PROTECTIVE DEVICE	VACUUM TRIP	POS-61	POS-75	65-C	33/VTR 1
	OVERSPEED TRIP	POS-62	POS-76	65-C	33/VTR 2
PICK-UP	ROTOR BEARING	PS-85	PS-98	65-B	63/LV
	THRUST BRG. WEAR	SV-137	SV-151	65-C	20/VTR
OIL VAPOR EXTRACTION VENT	ROTOR ECCENTRICITY	PI-327	PI-333	64-D	-
	TURBINE SPEED	PS-89	PS-102	63-D	63/RS
TRIP OIL	Ys-24	SV-142	SV-156	64-D	20/RSV
	RO-13	Ys-25	Ys-26	63-E	-
L.O. VAPOR EXTRACTOR VAC	PI-277	PI-278	PI-279	65-B	
	PI-280	PI-281	PI-282	65-B	


NOTE
⊗ INDICATES
COMPUTER
POINT

DIABLO CANYON POWER PLANT - PG&E CO.
LUBE OIL DISTRIBUTION AND PURIFICATION SYSTEMS

DRAWING 102020 SHEET 7 PAGE 0 REV 53

UNIT 1

P G & E CO.		102020	REV.
SHEET 8	PAGE 0		54

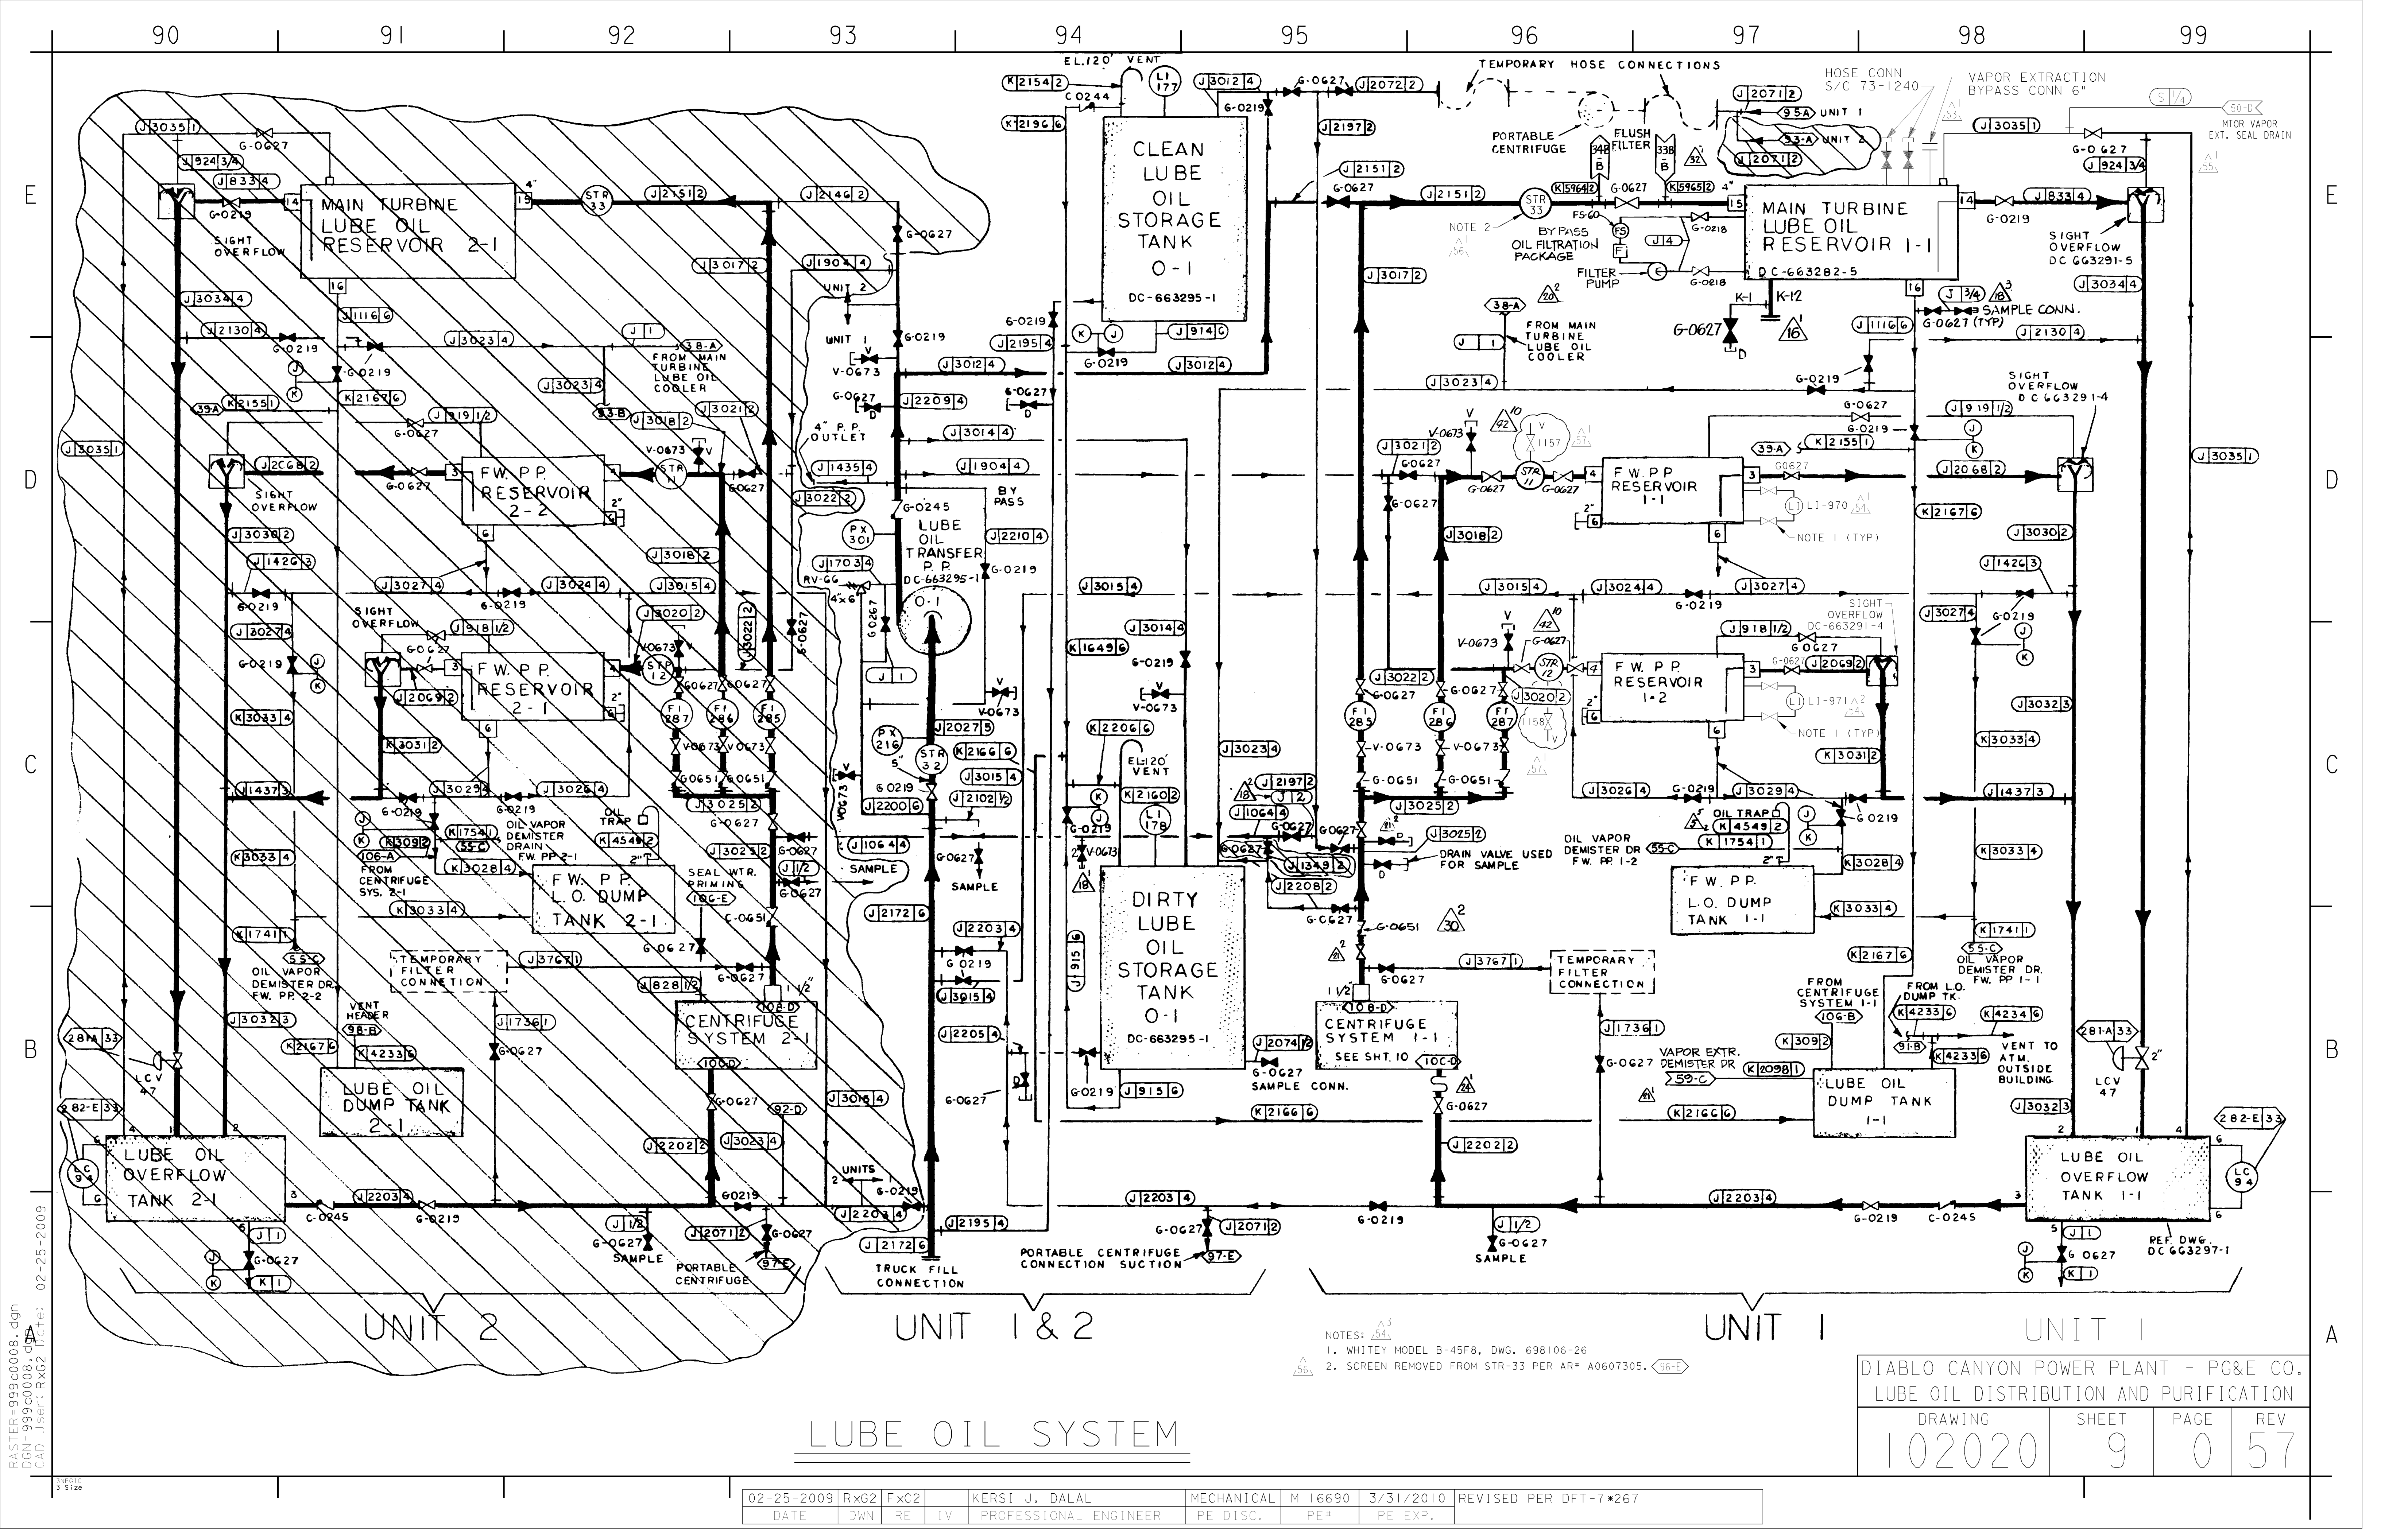

PASTER=999c0008.dgn
DCN=999c0008.dgn
CAD User: RxG2 UGte: 02-25-2009

LUBE OIL SYSTEM

- NOTES:
- 1. WHITEY MODEL B-45F8, DWG. 698106-26
 - 2. SCREEN REMOVED FROM STR-33 PER AR# A0607305.

DIABLO CANYON POWER PLANT - PG&E CO.			
LUBE OIL DISTRIBUTION AND PURIFICATION			
DRAWING	SHEET	PAGE	REV
102020	9	0	57

02-25-2009	RxG2	FxC2		KERSI J. DALAL	MECHANICAL	M 16690	3/31/2010	REVISED PER DFT-7*267
DATE	DWN	RE	IV	PROFESSIONAL ENGINEER	PE DISC.	PE#	PE EXP.	

E

D

C

B

A


E

D

C

B

A

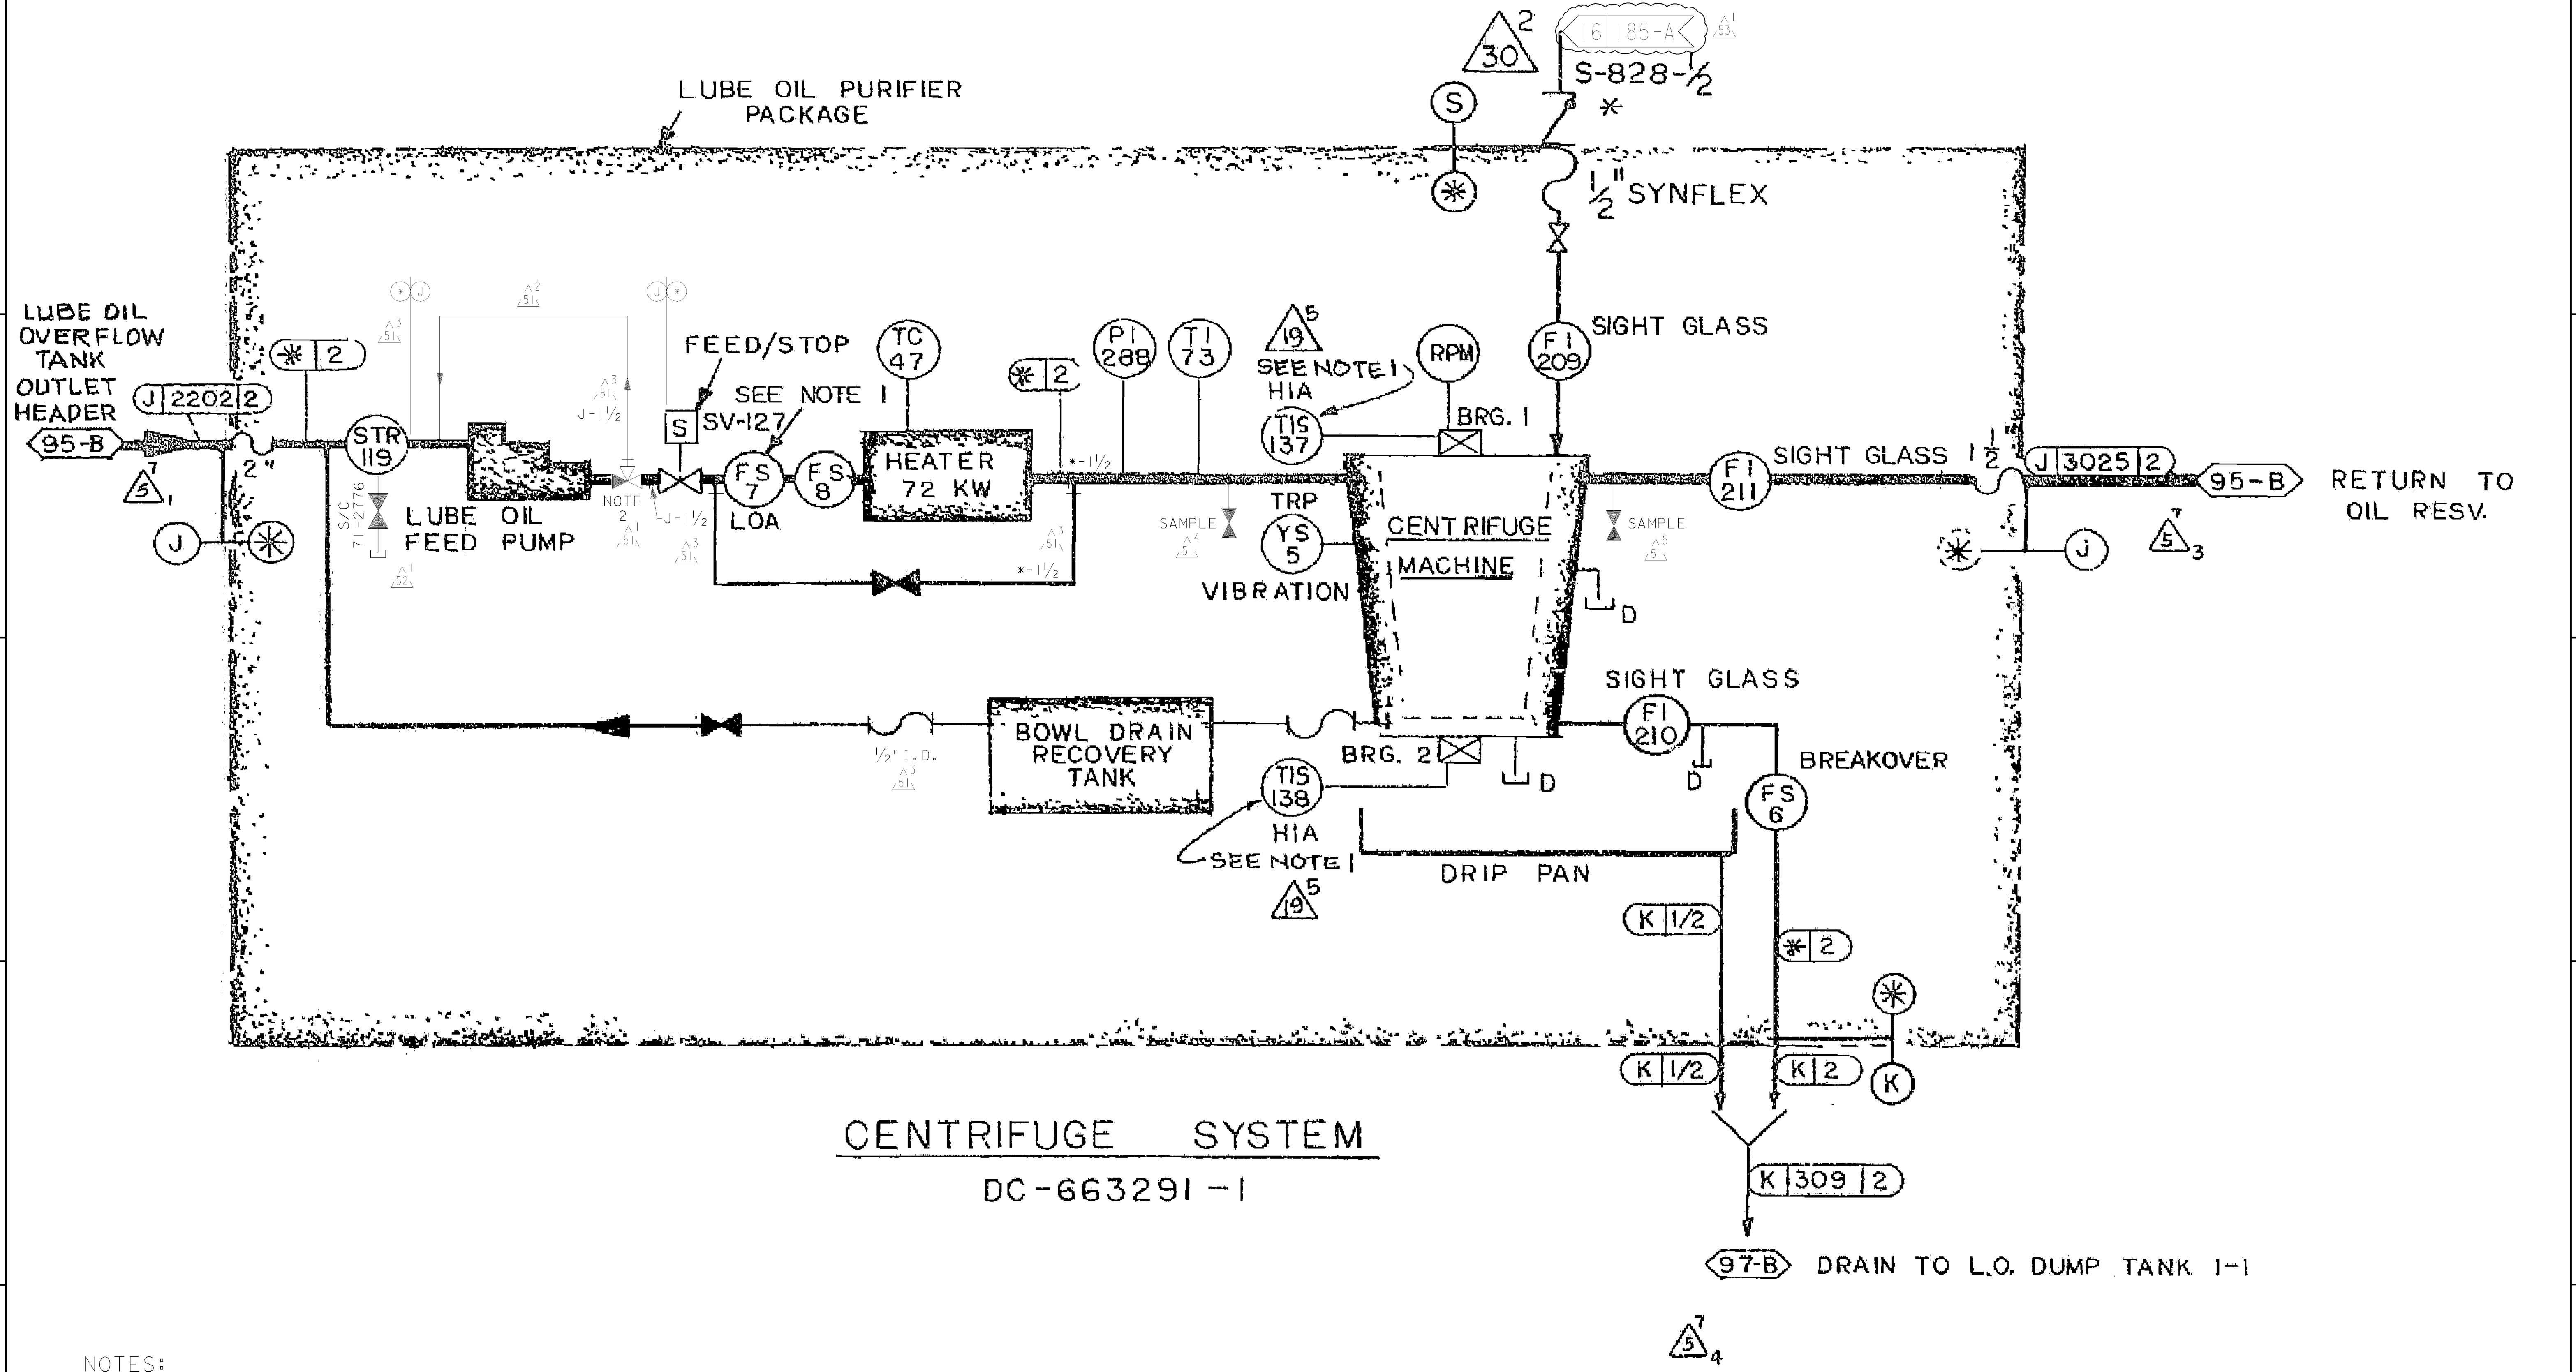

CENTRIFUGE SYSTEM
DC-663291-1

NOTES:


- 1. SUPPLIED BY P.G.&E.
- 2. JAMESBURY 3-WAY MANUAL FLOW CONTROL VALVE, MODEL AM150FD2236MT

UNIT 1			
DIABLO CANYON POWER PLANT - PG&E CO.			
DRAWING	SHEET	PAGE	REV
102020	10	0	53

01-20-2006	MIBF	RHSI		FRANCIS C. LING	MECHANICAL	M 16098	12/31/2007	REVISED PER FCT-030760
DATE	DWN	RE	1V	PROFESSIONAL ENGINEER	PE DISC.	PE#	PE EXP.	


1 NORMAL OPERATION

CENTRIFUGE SYSTEM CONTINUOUSLY RECIRCULATES AND CLEANS LUBE OIL THRU THE 3 RESERVOIRS.

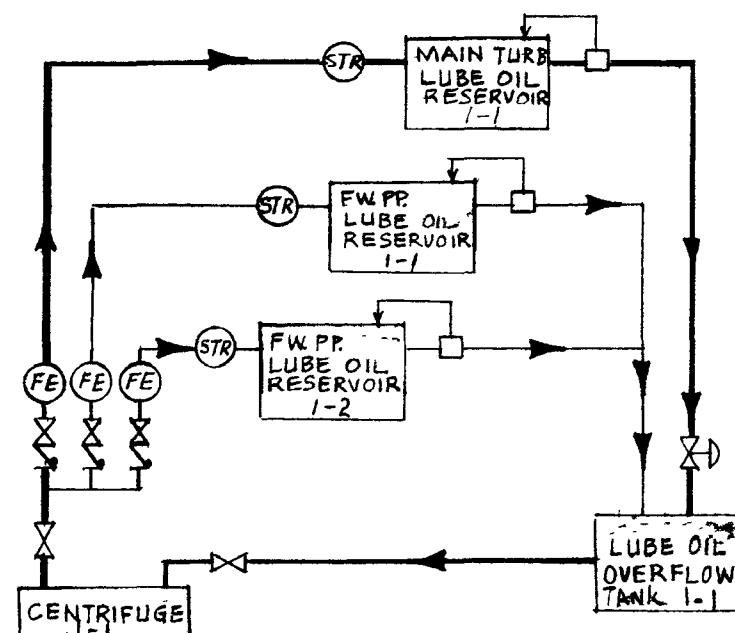


3 START UP

FILL MAIN TURBINE & FWPP 1/2 LUBE OIL RESERVOIRS FROM CLEAN OIL TANK, USING TRANSFER PUMP.

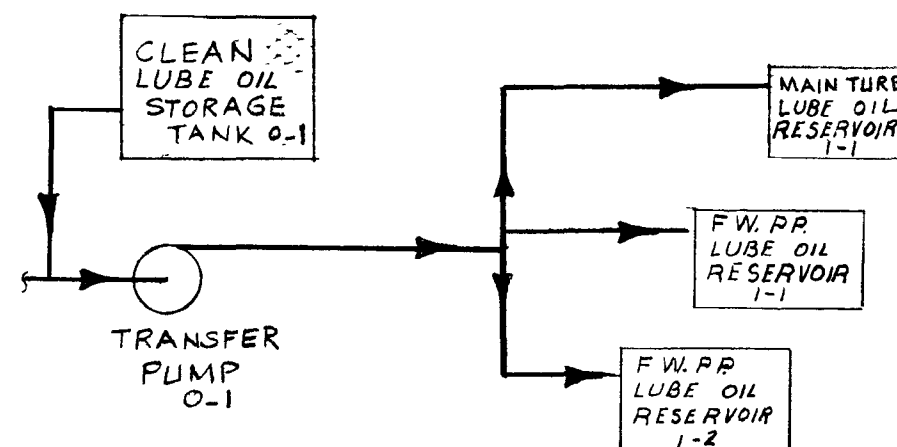


5 TRUCK FILL

USE BY-PASS AROUND TRANSFER PUMP WHEN TRUCK PUMP IS USED. TRANSFER PUMP MAYBE USED AS AN ALTERNATE TO TRUCK PUMP.

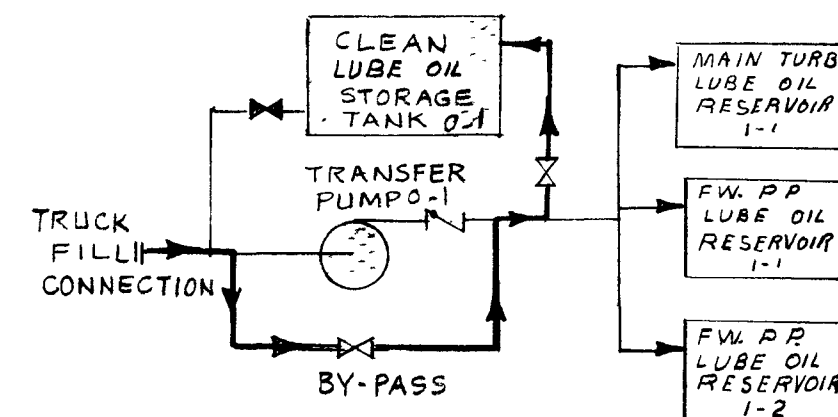


2 DRAIN RESERVOIRS

DRAIN MAIN TURBINE LUBE OIL RESERVOIR TO DIRTY LUBE OIL TANK BY GRAVITY
DRAIN FWPP RESERVOIRS TO DIRTY LUBE OIL STORAGE TANK BY USING TRANSFER PUMP.

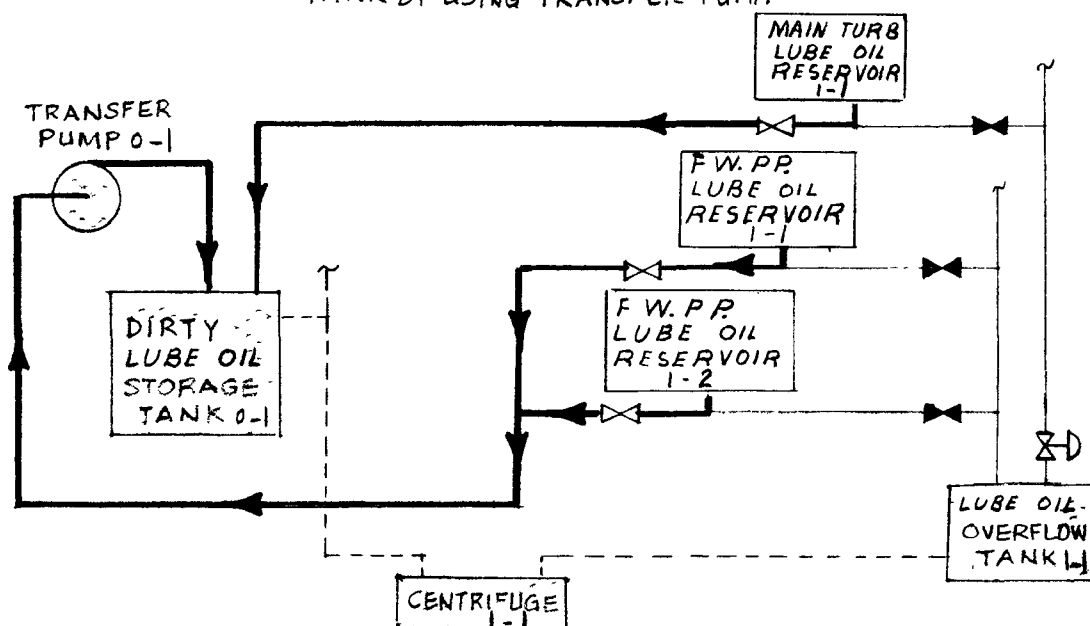


4 EMERGENCY DUMP

MANUALLY OPEN DRAIN VALVES TO DUMP TANKS

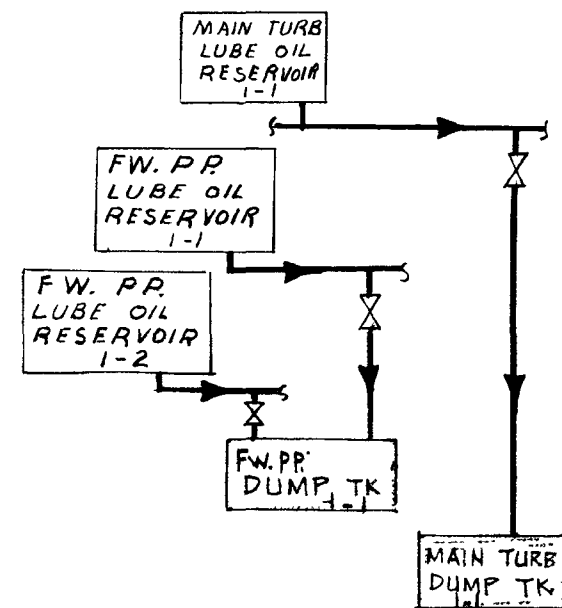

6 CLEANING DIRTY OIL

DIRTY OIL DRAINS TO CENTRIFUGE. OIL IS RECYCLED TO DIRTY OIL TANK. AFTER SEVERAL CYCLES CENTRIFUGE DISCHARGE IS ROUTED TO CLEAN OIL TANK.

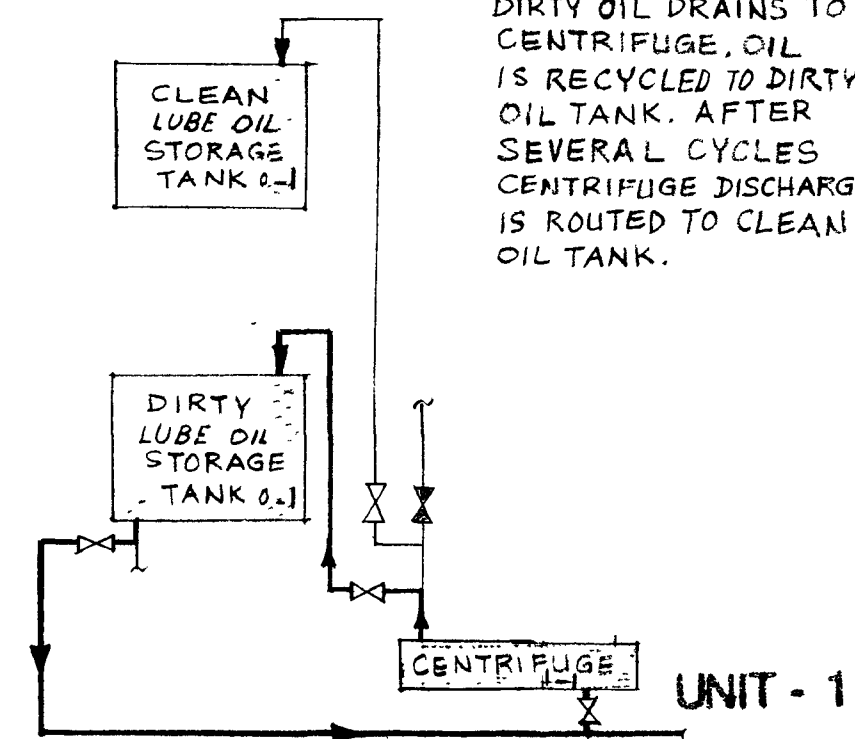

35 M/M Neg. 1


SCAN IC

INDEXED REV.

P.G.&E.CO.

SHEET NO 11 OF SHEETS
DRAWING NUMBER
102020
CHANGE 1


UNIT - 1

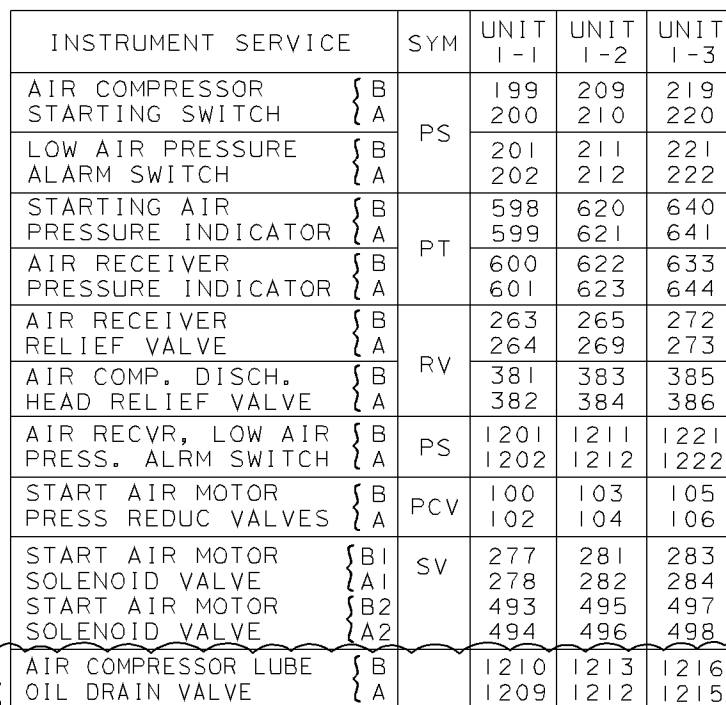

1. * DENOTES MANUFACTURER-SUPPLIED INSTRUMENTS AND EQUIPMENT.
IT IS ACCEPTABLE TO REPLACE MANUFACTURER SUPPLIED INSTRUMENT
TUBING WITH PG&E SUPPLIED S-SPEC STAINLESS STEEL TUBING.
2. FIELD PIPING THIS SYSTEM SHALL BE PG&E CLASS "C" UNLESS OTHERWISE
NOTED.
3. { } MANUFACTURER NUMBER.
4. ALL VALVES THIS SHEET WITH PG&E ITEM NO. SHALL BE UNDER SPEC 8729
(DWG 102039), UNLESS NOTED.
5. PRESSURE REDUCING VALVE PROVIDED WITH STRAINER.
6. MOUNTED ON ENGINE CONTROL PANEL.
7. STARTING AIR SOLENOID VALVES AIR EQUIPPED WITH AN EMERGENCY
MANUAL OPENING DEVICE.
8. IF GLOBE VALVES ARE INSTALLED, THE PREFERRED ORIENTATION IS WITH
THE FLOW ARROW INDICATING FLOW TOWARDS THE AIR COMPRESSOR.
9. VALVE TAG 45VI SPECS ARE IN DWG 053479.
10. THIS LINE IS K2-¾" ON AIR RECEIVER 1-I.A.
11. FIBERGLASS BLANKET-TYPE PERSONNEL PROTECTION INSULATION.

UNIT 1

DRAWING	SHEET	PAGE	REV
102021	3	0	61

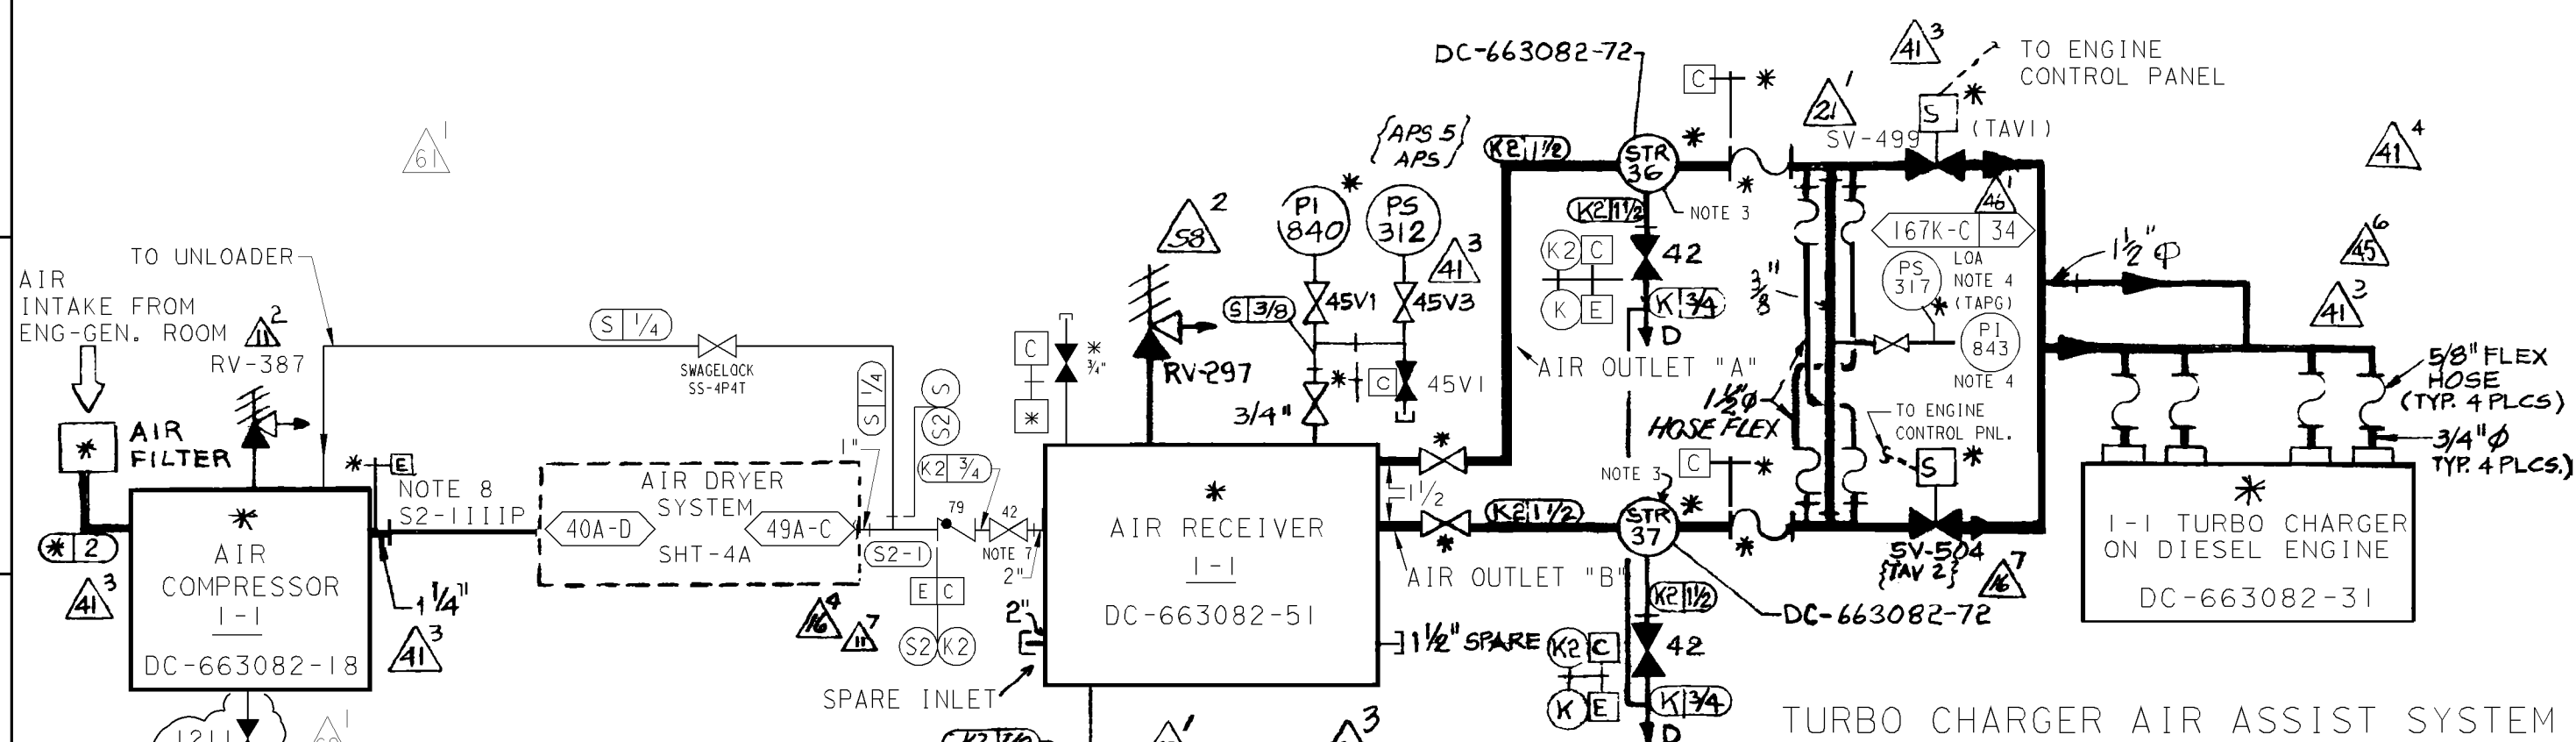

TURBO CHARGER AIR ASSIST SYSTEM

TYPICAL FOR THREE ENG. GEN UNITS
REF. DWG. DC-663082-31
REF. DWG. DC-437667-1 (ELECTRICAL)

SERVICE	INST	UNIT 1-1	UNIT 1-2	UNIT 1-3
AIR COMP. DISCH. HEAD RELIEF VALVE	RV	387	388	389
LOW AIR PRESS. ALM. SW.	PS	317	318	319
AIR RECEIVER PRESSURE INDICATORS	PI	840	841	842
TURBO CHARGER AIR ASSIST INLET PRESS. INDICATOR		843	844	845
AIR COMPRESSOR START PRESS. SWITCH	PS	312	313	314
AIR RECEIVER RELIEF VALVES	RV	297	298	299
TURBO CHARGER INLET SOLENOID VALVES	SV	499 504	505 500	501 506
AIR COMPRESSOR LUBE OIL DRAIN VALVE		1211	1214	1217
AIR RECEIVER OUTLET STRAINER	STR	36 37	44 45	83 84

- 1.* DENOTES MANUFACTURER SUPPLIED INSTRUMENTS AND EQUIPMENT. IT IS ACCEPTABLE TO REPLACE MANUFACTURER SUPPLIED INSTRUMENT TUBING WITH PG&E SUPPLIED S-SPEC STAINLESS STEEL TUBING
2. FIELD PIPING THIS SYSTEM SHALL BE PG&E CLASS [C] UNLESS NOTED
3. AIR RECEIVER OUTLET STRAINERS BE INSTALLED HORIZONTALLY [46-D/E]
4. MOUNTED ON ENGINE CONTROL PANEL [47-D]
5. ALL VALVE ON THIS SHEET WITH PG&E ITEM NOS. SHALL BE UNDER SPEC. 8729 (DWG 102039). UNLESS NOTED. [41/45/46-C&D]
6. DELETED [46]
7. IF GLOBE VALVES ARE INSTALLED THE PREFERRED ORIENTATION IS WITH THE FLOW ARROW INDICATING FLOW TOWARDS THE AIR COMPRESSOR. [43-D]
8. FIBERGLASS BLANKET TYPE PERSONNEL PROTECTION INSULATION.

UNIT 1

DIABLO CANYON POWER PLANT - PG&E CO.			
DIESEL ENGINE-GENERATOR ASSOCIATED SYSTEMS			
DRAWING	SHEET	PAGE	REV
102021	4	0	62

RASTER=102021 s4.dgn
DGN=102021 s4.dgn
CAD User: AJFJ Date: 10-10-2011

E


CD

TYPICAL FOR THREE ENGINE-GENERATOR UNITS, EXCEPT AS NOTED

SCAN	58	IC	
------	----	----	--

B

A

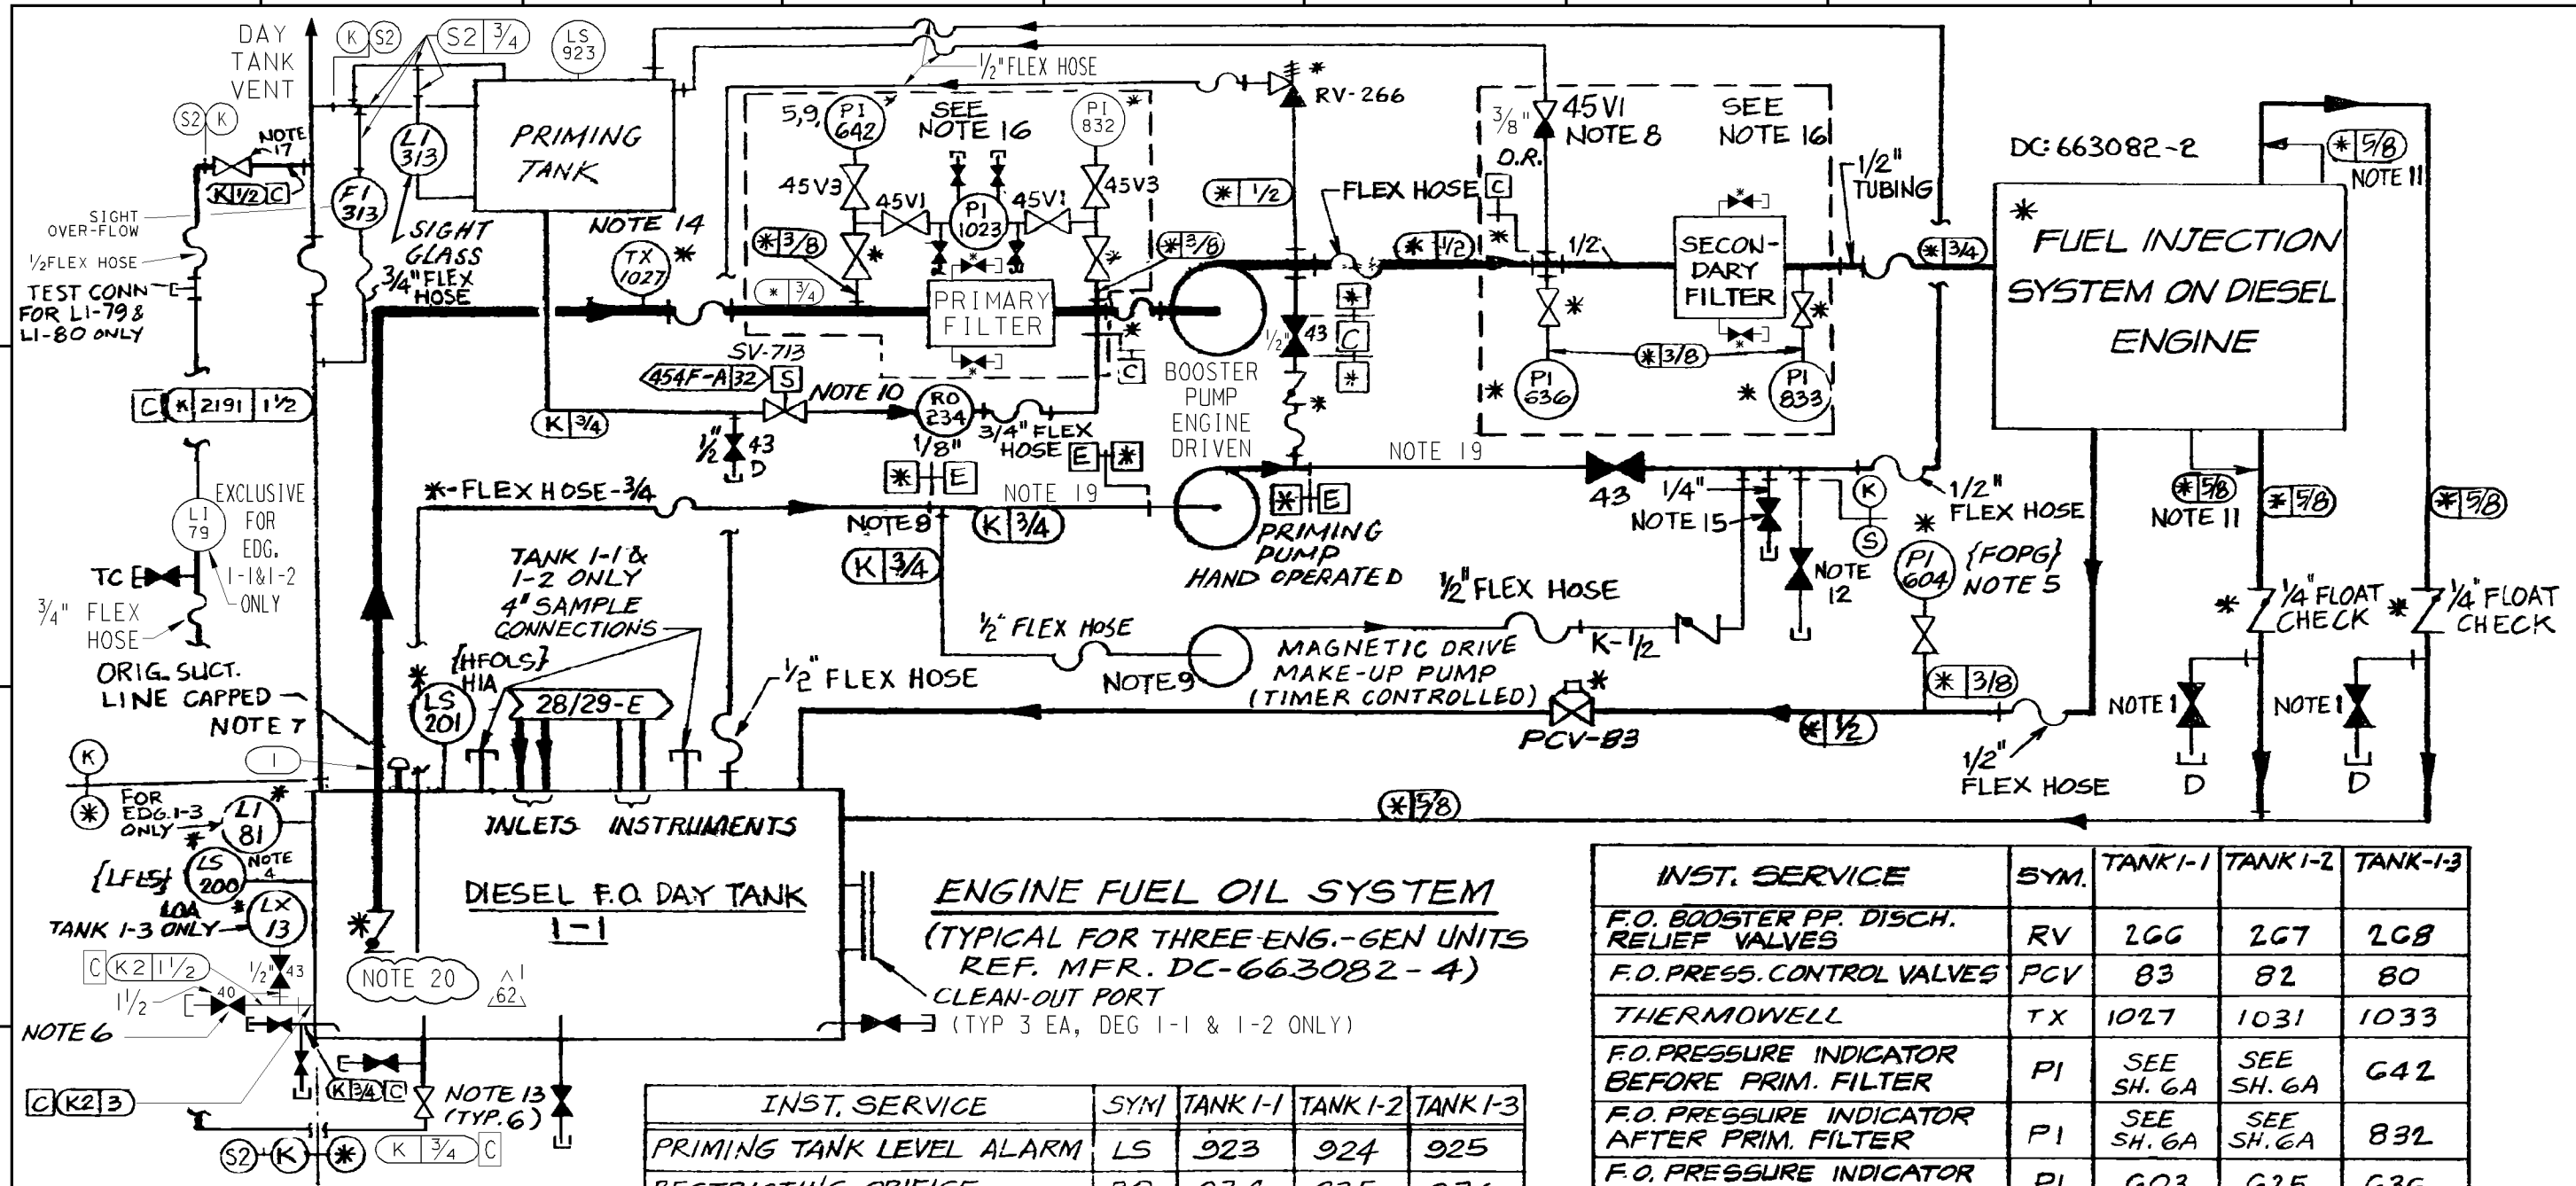

NOTES

1. 1/2" FPT WHITEY BALL VLV MODEL #SS-45F8
2. { } MANUFACTURER NO. IDENTIFICATION.
3. MANUALLY OPERATED. USED ON INITIAL START ONLY.
4. SEE MFR DWG 663082-4.
5. MOUNTED ON ENGINE CONTROL PANEL.
6. MANUAL VALVES WITH ITEM NO. SHALL BE UNDER SPEC. 8729. (FOR TK 1-3 ONLY).
7. BY SUPPLIER UNDER SPEC. 8735 WISMER & BECKER.
8. VALVE TAG 45VI SPECS. ARE IN DWG. 053479.
9. PUMP AND TEE LOCATED AT SECTION BELOW LOWEST DAY TANK FUEL OIL LEVEL.
10. OPEN-0 TO 100 RPM, CLOSED-ABOVE 100 RPM.
11. ADDITIONAL LEAKOFF ON DIESEL GENERATOR 1-1 ONLY.

ENGINE FUEL OIL SYSTEM (TYPICAL FOR THREE ENG.-GEN UNITS REF. MFR. DC-663082-4) CLEAN-OUT PORT (TYP 3 EA, DEG 1-1 & 1-2 ONLY)

INST. SERVICE	SYM	TANK 1-1	TANK 1-2	TANK 1-3
PRIMING TANK LEVEL ALARM	LS	923	924	925
RESTRICTING ORIFICE	RO	234	235	236

LINE DESCRIPTION	TANK 1-1	TANK 1-2	TANK 1-3
FUEL OIL DAY TK VENT	K-2191-1 1/2	K-2192-1 1/2	K-2123-1 1/2

12. 3/8" NUPRO PLUG VALVE MODEL #SS-6P4T.
13. MANUAL VALVES PER DWG. 6006473-222 FOR TANK 1-1 & 1-2 ONLY.
14. TI NOT INSTALLED ON TANK 1-2.
15. NUPRO CO. #SS-6P4T.
16. D/G 1-3 ONLY; FOR D/G 1-1 & 1-2 SEE SHT 6A.
17. 1/2" VELAN GATE VALVE STOCK NO 93-6840.
18. *DENOTES MANUFACTURER SUPPLIED INSTRUMENTS AND EQUIPMENT. IT IS ACCEPTABLE TO REPLACE MANUFACTURER SUPPLIED INSTRUMENT TUBING w/PG&E SUPPLIED S-SPEC STAINLESS STEEL TUBING.
19. CODE CLASS E PIPING IS QUALITY CLASS "S" AND SEISMICALLY EVALUATED FOR HOSGRI.
20. DISTANCE FROM BOTTOM OF FOOT VALVE TO BOTTOM OF DAY TANK = 1/16" (DEG 1-1), 1/4" (DEG 1-2), 1/8" (DEG 1-3).

INST. SERVICE	SYM.	TANK 1-1	TANK 1-2	TANK 1-3
F.O. BOOSTER PP. DISCH. RELIEF VALVES	RV	266	267	268
F.O. PRESS. CONTROL VALVES	PCV	83	82	80
THERMOWELL	TX	1027	1031	1033
F.O. PRESSURE INDICATOR BEFORE PRIM. FILTER	PI	SEE SH. 6A	SEE SH. 6A	642
F.O. PRESSURE INDICATOR AFTER PRIM. FILTER	PI	SEE SH. 6A	SEE SH. 6A	832
F.O. PRESSURE INDICATOR BEFORE SECOND. FILTER	PI	603	625	636
F.O. PRESSURE INDICATOR AFTER SECOND. FILTER	PI	829	831	833
F.O. PRESSURE INDICATOR	PI	604	626	637
F.O. DIP INDICATOR PRIMARY FLTR	PI	SEE SH. 6A	SEE SH. 6A	1023
HIGH F.O. LEVEL ALARM SW.	LS	201	205	209
LOW F.O. LEVEL ALARM SW.	LS	200	204	208
F.O. LEVEL INDICATOR DAY TK	LI	79	80	81
F.O. LEVEL INDICATOR PRIM. TK	LI	313	314	315
F.O. DAY TK. LEVEL TEST CONNECTION	LX	—	—	13
PRIMING TK F.O. SOLENOID VLV	SV	713	714	715
PRIMING TK F.O. FLOW INDICATOR FI	FI	313	314	315

DIABLO CANYON POWER PLANT - PG&E CO.
DIESEL ENGINE-GENERATOR ASSOCIATED SYSTEMS

UNIT 1

DRAWING	SHEET	PAGE	REV
102021	6	0	62

05-29-2013	ZNS4	Fxc2	KJD3	NOT REQUIRED	N/A	N/A	N/A	REVISED PER DFT-7*2180
DATE	DWN	RE	IV	PROFESSIONAL ENGINEER	PE DISC.	PE#	PE EXP.	

70

71

72

73

74

75

76


77

78

79

NOTES:

1. THIS SYSTEM PROVIDED COMPLETELY INSTALLED WITH ENGINE-GENERATOR UNIT
2. [] MANUFACTURER NUMBER
3. RELIEF VALVE BUILT-IN TO PUMP >74-B<
4. ENGINE DRIVEN LUBE OIL PUMP >73-B<
5. PRE-CIRC. L.O. PUMP IS ELECTRIC MOTOR DRIVEN >73-C<
6. MOUNTED ON ENGINE CONTROL PANEL >71/77-B<
7. BALL VALVES >73-D, 77-D<
8. * DENOTES MANUFACTURER SUPPLIED INSTRUMENTS AND EQUIPMENT. IT IS ACCEPTABLE TO REPLACE MANUFACTURER SUPPLIED INSTRUMENT TUBING WITH PG&E SUPPLIED S-SPEC STAINLESS STEEL TUBING
9. LUBE OIL HEATER (LOH) REPLACED WITH A NEW HEATER, LOH11, (WATLOW PART NO. 7-10-567-1) AND INSTALLED OUTSIDE THE DIESEL ENGINE SKID.
10. J-SPEC PIPING PROVIDED WITH THREADED CONNECTIONS AND PIPE FITTINGS PER RPE #P-6687.
11. PIPING QA CLASS "S", SEISMICALLY ANALYZED.

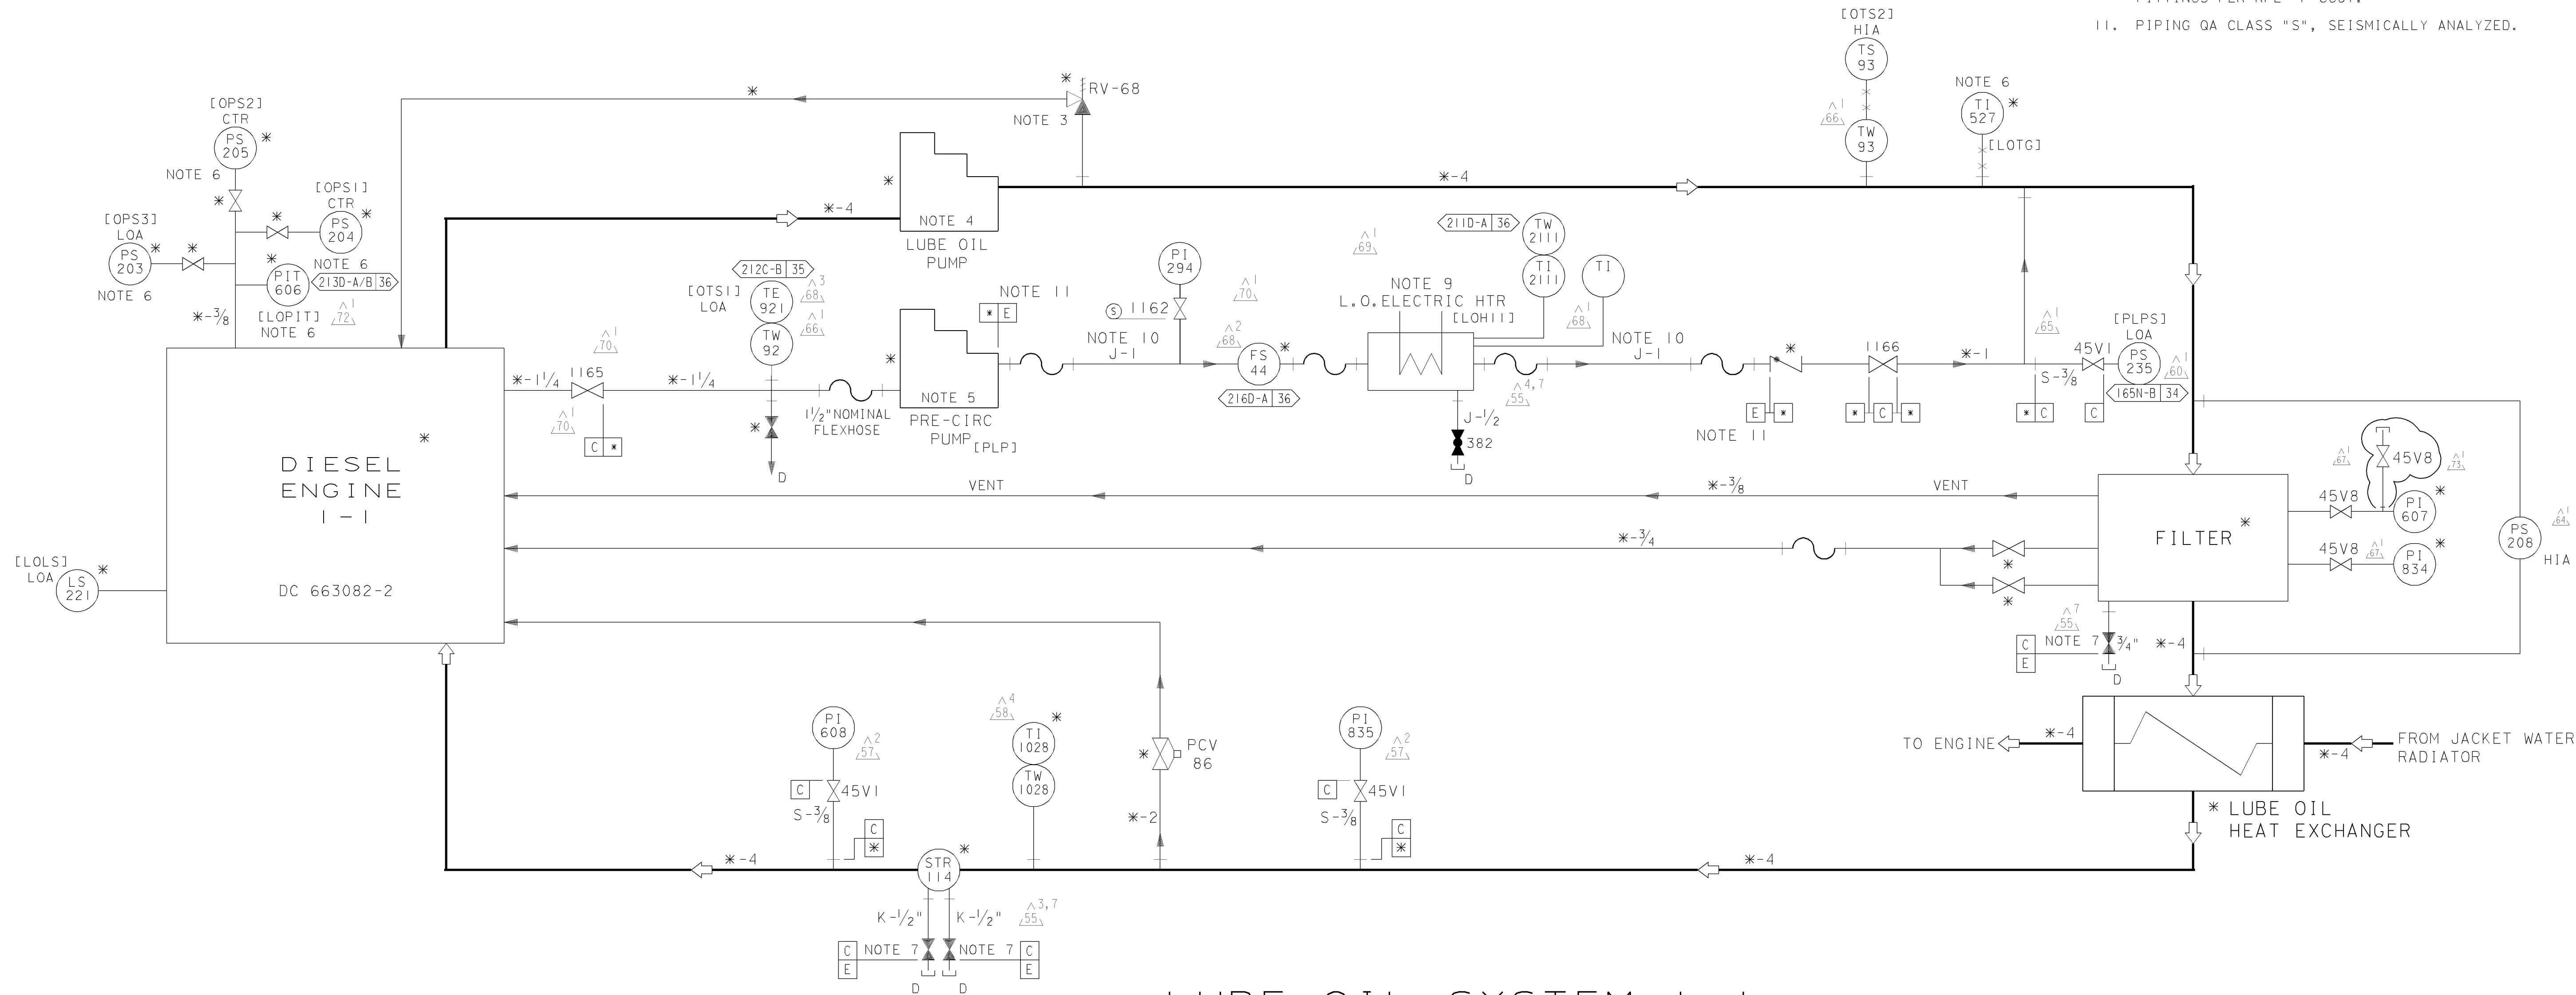

LUBE OIL SYSTEM I - I

REFERENCE MFR DWG DC 663082-16

UNIT I


DIABLO CANYON POWER PLANT - PG&E CO.
DIESEL ENGINE-GENERATOR ASSOCIATED SYSTEMS

DRAWING	SHEET	PAGE	REV
102021	7	0	73

03-05-2010	JBMX	FxC2		KERSI J. DALAL	MECHANICAL	M 16690	3/31/2010	REVISED PER DAS-6*291
DATE	DWN	RE	IV	PROFESSIONAL ENGINEER	PE DISC.	PE*	PE EXP.	

RASTER=2021st7.dgn
DGN=2021st7.dgn
CAD User: JBMX Date: 03-05-2010ENERGIC
3 Size

RASTER=102021 s8.dgn
DGN=102021 s8.dgn
CAD User: ADMI Date: 02-17-2009

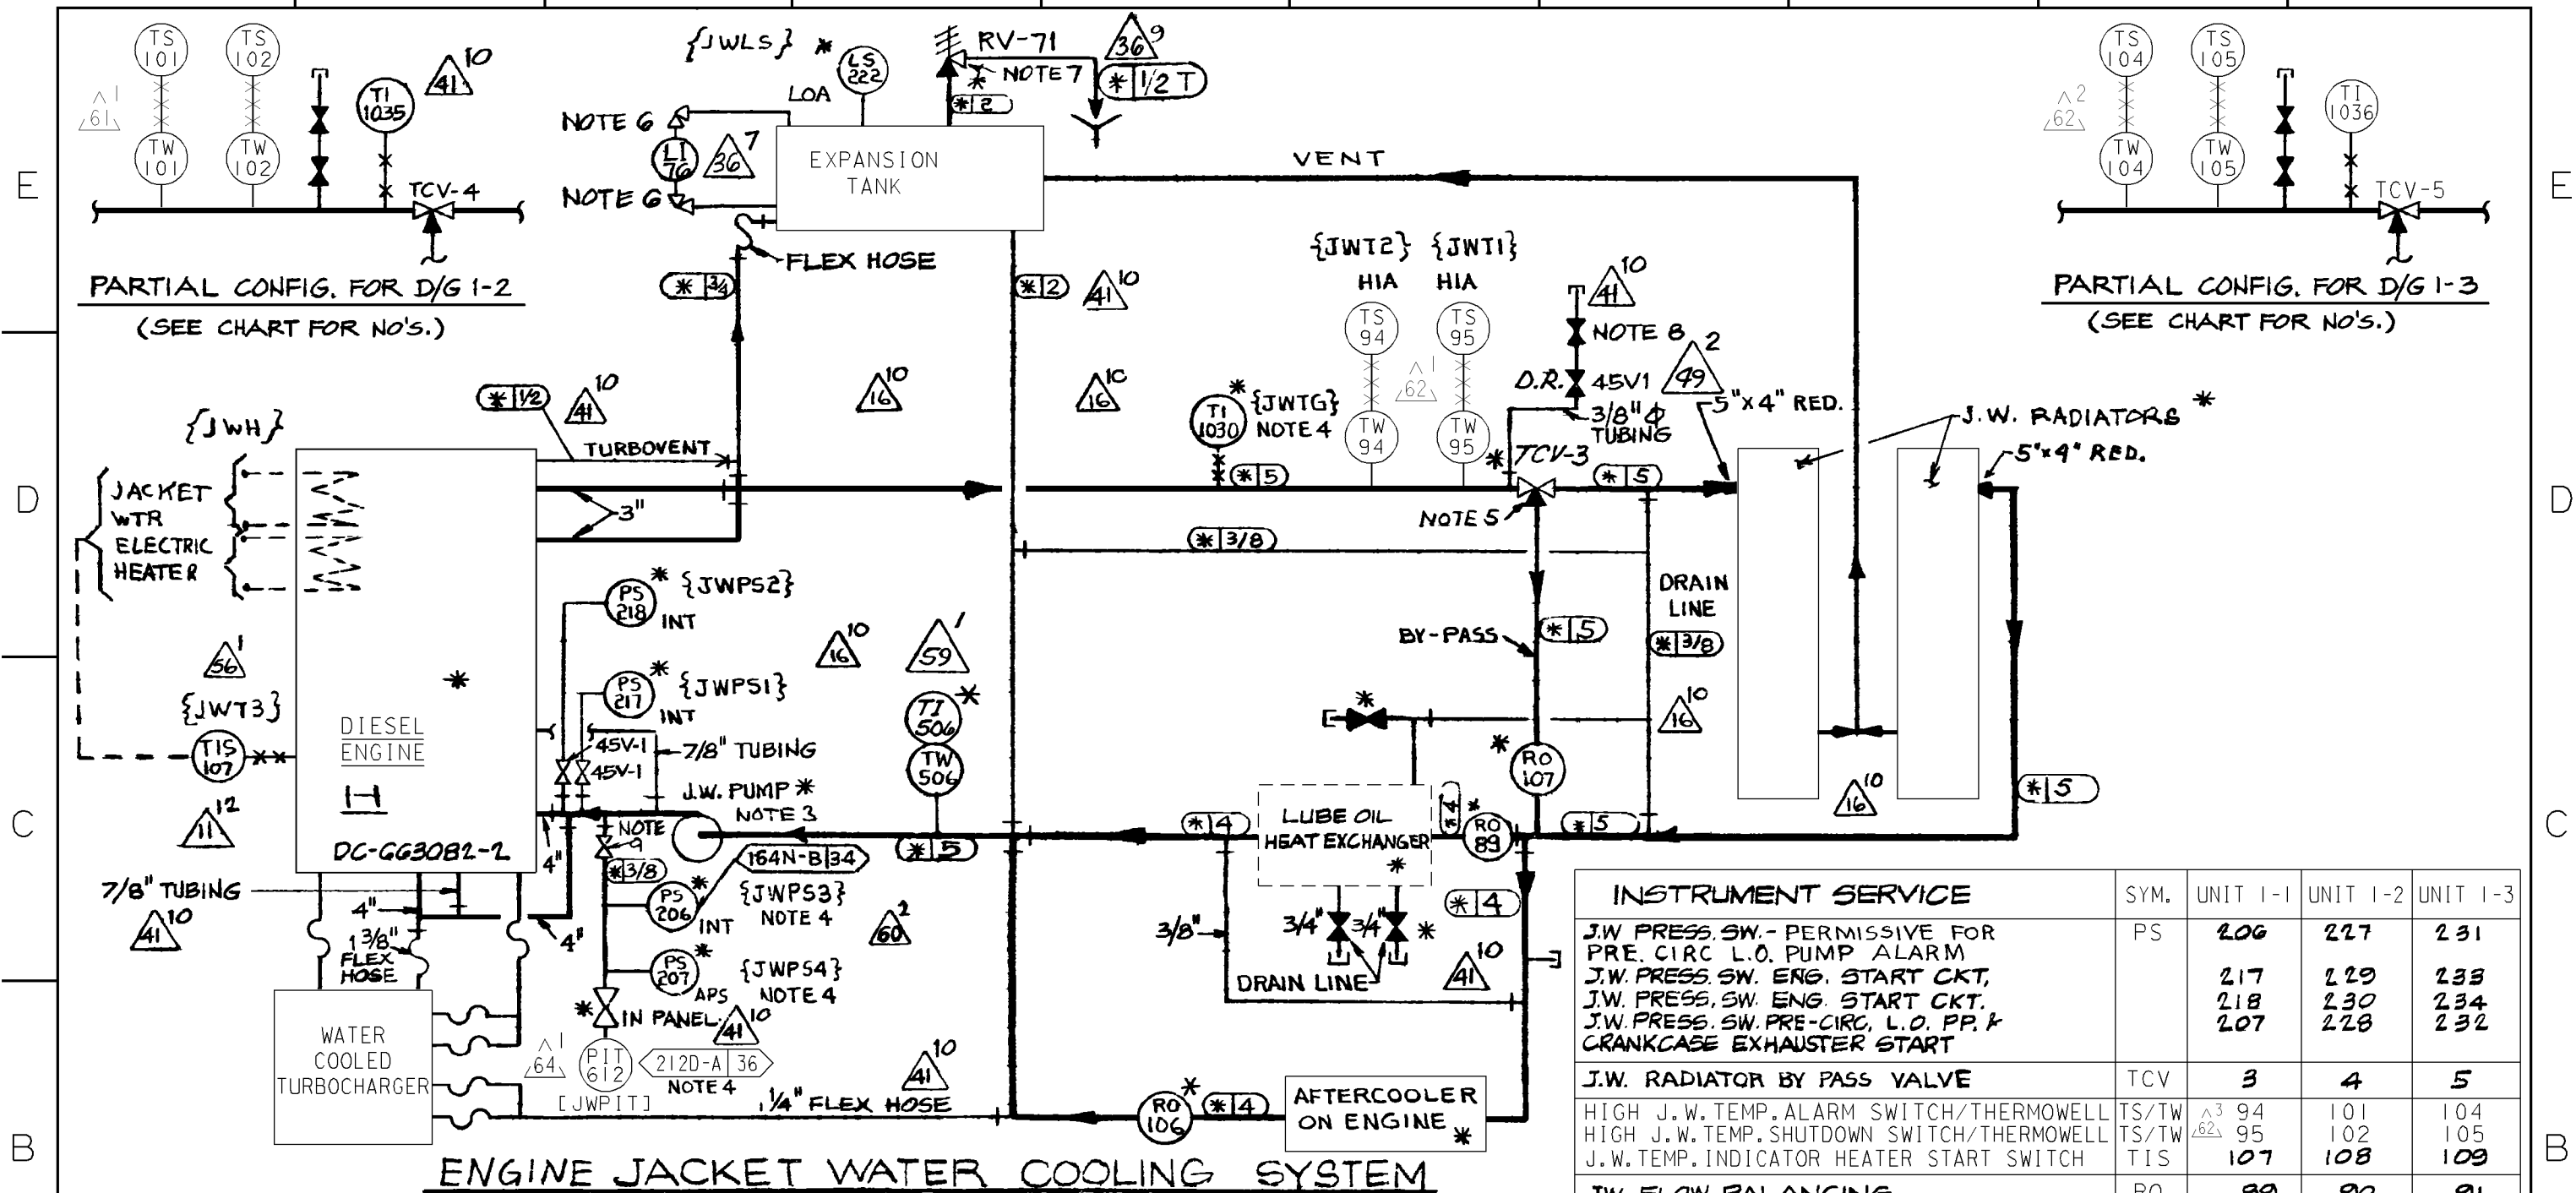

NOTES:

1. THIS SYSTEM PROVIDED COMPLETELY INSTALLED WITH ENGINE-GEN. UNITS.
2. { } MANUFACTURER NO.
3. ENGINE DRIVEN JACKET WATER PUMP. (82-C)
4. MOUNTED ON ENGINE CONTROL PANEL. (81-B, 82-B & 85-D)
5. SELF-CONTAINED CONTROL VALVE, FOR OPERATION SEE MANUFACTURER TECHNICAL MANUAL DC-GG3082-80 (85-D) (VALVE SHOWN IN HOT POSITION.)
6. PENBERTHY N7B-ST5 TUBULAR GAUGE GLASS VALVES (82-E)
7. CAP WITH SPRING RELIEF FOR VENT/VACUUM (84-E)
8. WALWORTH CO. MOD. #14 FOR D/G 1-1 & 1-2; 45V1 FOR D/G 1-3 (86-E)
9. LUNKENHEIMER MOD. #123 FOR D/G 1-2 & 1-3 ONLY (82-C)

* DENOTES MANUFACTURER SUPPLIED INSTRUMENTS AND EQUIPMENT. IT IS ACCEPTABLE TO REPLACE MANUFACTURER SUPPLIED INSTRUMENT TUBING WITH PG&E SUPPLIED 5-SPEC STAINLESS STEEL TUBING.

INSTRUMENT SERVICE	SYM.	UNIT 1-1	UNIT 1-2	UNIT 1-3
J.W. PRESS. SW. - PERMISSIVE FOR PRE. CIRC. L.O. PUMP ALARM	PS	206	217	231
J.W. PRESS. SW. ENG. START CKT.		217	229	233
J.W. PRESS. SW. ENG. START CKT.		218	230	234
J.W. PRESS. SW. PRE-CIRC. L.O. PP. & CRANKCASE EXHAUSTER START		207	228	232
J.W. RADIATOR BY PASS VALVE	TCV	3	4	5
HIGH J.W. TEMP. ALARM SWITCH/THERMOWELL	TS/TW	94	101	104
HIGH J.W. TEMP. SHUTDOWN SWITCH/THERMOWELL	TS/TW	95	102	105
J.W. TEMP. INDICATOR HEATER START SWITCH	TIS	107	108	109
J.W. FLOW BALANCING ORIFICE	RO	89	90	91
		106	108	110
		107	109	111
J.W. EXPANSION TK. PRESS. RELIEF CAP	RV	71	72	75
LOW J.W. EXPANSION TK. LEVEL ALARM SW.	LS	222	229	230
J.W. PRESSURE (INDICATING TRANSMITTER)	PIT	612	643	645
J.W. EXPANSION TK. LEVEL IND	LI	76	77	78
J.W. TEMP INDICATOR/THERMOWELL	TI/TW	506	507	508
J.W. TEMP INDICATOR	TI	1030	1035	1036

DIABLO CANYON POWER PLANT - PG&E CO.
DIESEL ENGINE-GENERATOR ASSOCIATED SYSTEMS

UNIT 1

DRAWING	SHEET	PAGE	REV
102021	8	0	65

INPG2ND
1 Size


02-17-2009	ADMI	FxC2		ALAN GLEN BARTA	ELECTRICAL	E 9271	9/30/2009	REVISED PER DDN-2*91-0
DATE	DWN	RE	IV	PROFESSIONAL ENGINEER	PE DISC.	PE#	PE EXP.	

INSTRUMENT SERVICE	SYM.	UNIT 1-1	UNIT 1-2	UNIT 1-3
CRANKCASE VACUUM ALARM SWITCH	PS	331	332	333
DIESEL GEN. STATOR TEMP. ELEMENT	TE	71	72	73
	COMP	T-2802A	T-2803A	T-2804A
ENGINE TACHOMETER TRANSMITTER	YT	1	2	3
ENGINE OVERSPEED TRIP SWITCH	YS	6	7	8
RADIATOR DISCH. TEMP. INDICATOR	TI	528	529	540
HI ROOM AIR TEMP ALARM SWITCH	TS	141	142	143
HI RADIATOR DISCH. TEMP. ALARM SW.		144	145	146
PYROMETER-CYLINDER TEMP (36PT)	TI	94	95	96
ROOM AIR TEMP. INDICATOR	TI	97	98	99
ENGINE OVERSPEED TRIP DEVICE	YS	106	107	108

NOTE

1. YS-106, 107 AND 108 ARE MECHANICAL OVERSPEED TRIP DEVICES (96-B)

2. * DENOTES MANUFACTURER SUPPLIED INSTRUMENTS AND EQUIPMENT. IT IS ACCEPTABLE TO REPLACE MANUFACTURER SUPPLIED INSTRUMENT TUBING WITH PG&E SUPPLIED S-SPEC STAINLESS STEEL TUBING

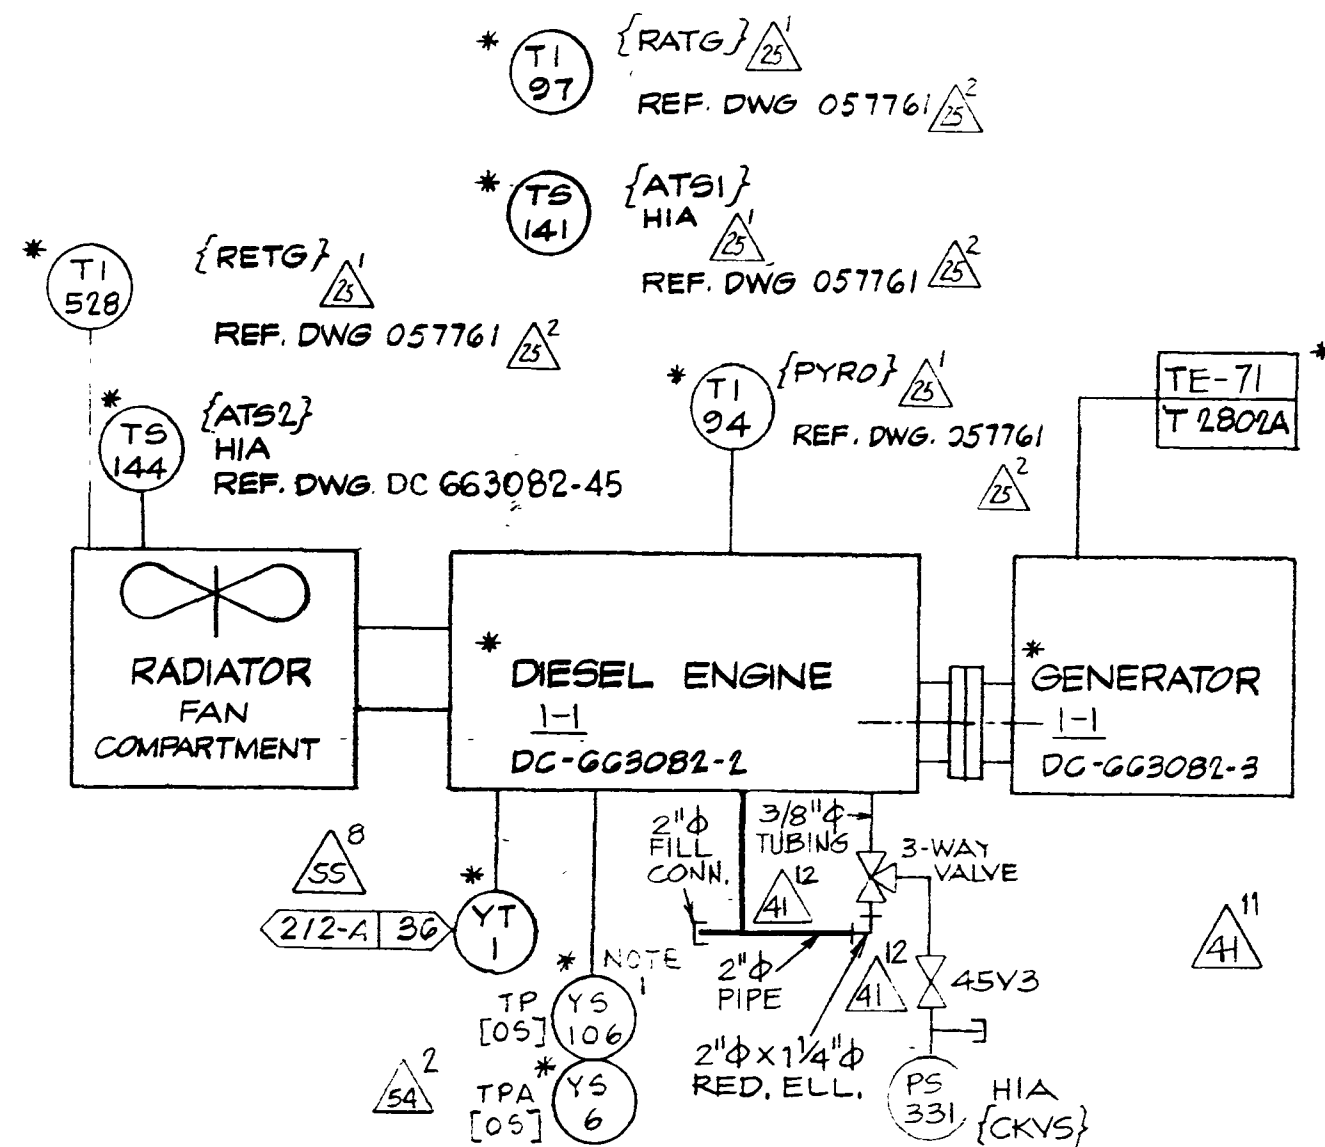

MISC. INSTRUMENTS FOR ENGINE GENERATOR UNITS
TYPICAL FOR THREE ENG. GEN. UNITS

35 M/M NEG

UNIT - 1

P.G.&E.CO.


SHEET NO 9 OF SHEETS

DRAWING NUMBER

102021

CHANGE

57

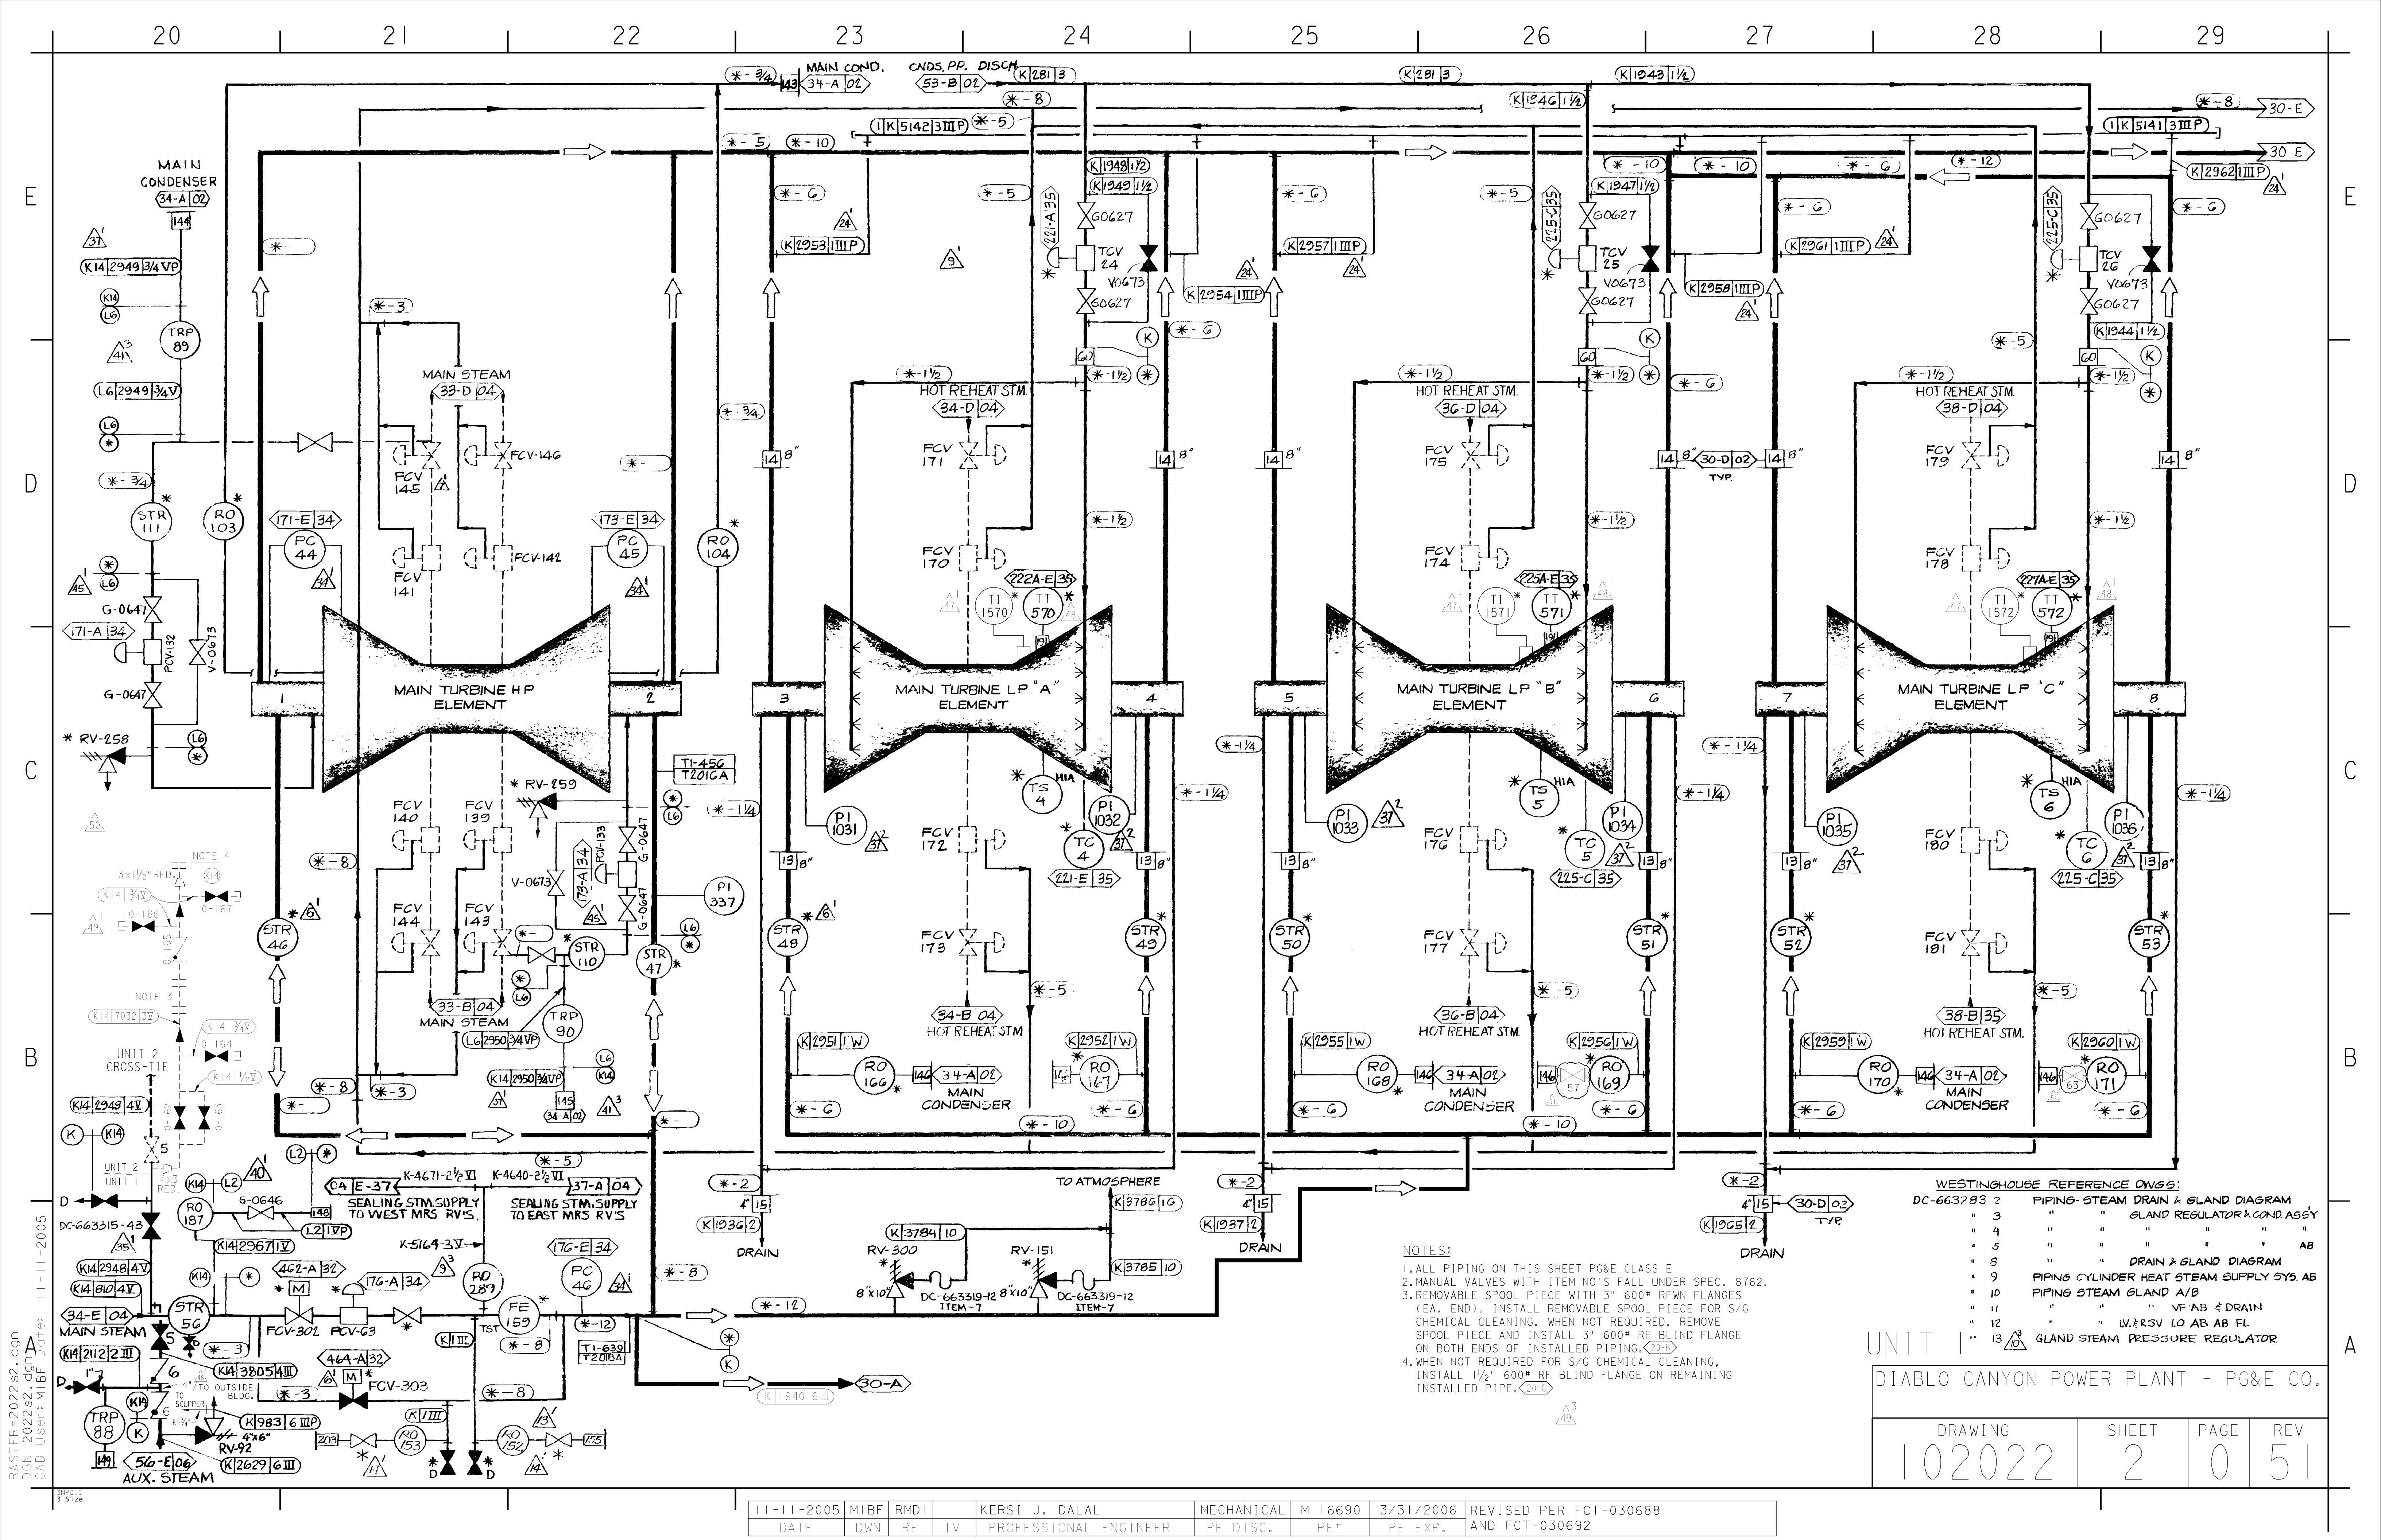


NOTES:

1. ALL PIPING ON THIS SHEET PG&E CLASS E.
2. MANUAL VALVES WITH ITEM NO'S FALL UNDER SPEC. 8762.
3. REMOVABLE SPOOL PIECE WITH 3" 600# RFWN FLANGES (EA. END). INSTALL REMOVABLE SPOOL PIECE FOR S/G CHEMICAL CLEANING. WHEN NOT REQUIRED, REMOVE SPOOL PIECE AND INSTALL 3" 600# RF BLIND FLANGE ON BOTH ENDS OF INSTALLED PIPING. (20-B)
4. WHEN NOT REQUIRED FOR S/G CHEMICAL CLEANING, INSTALL 1/2" 600# RF BLIND FLANGE ON REMAINING INSTALLED PIPE. (20-C)

WESTINGHOUSE REFERENCE DWGS:

DC-663283	2	PIPING-STEAM DRAIN & GLAND DIAGRAM
" 3	"	"
" 4	"	"
" 5	"	"
" 6	"	"
" 7	"	"
" 8	"	"
" 9	"	"
" 10	"	"
" 11	"	"
" 12	"	"
" 13	"	"


UNIT 1			
DIABLO CANYON POWER PLANT - PG&E CO.			
DRAWING	SHEET	PAGE	REV
102022	2	0	51

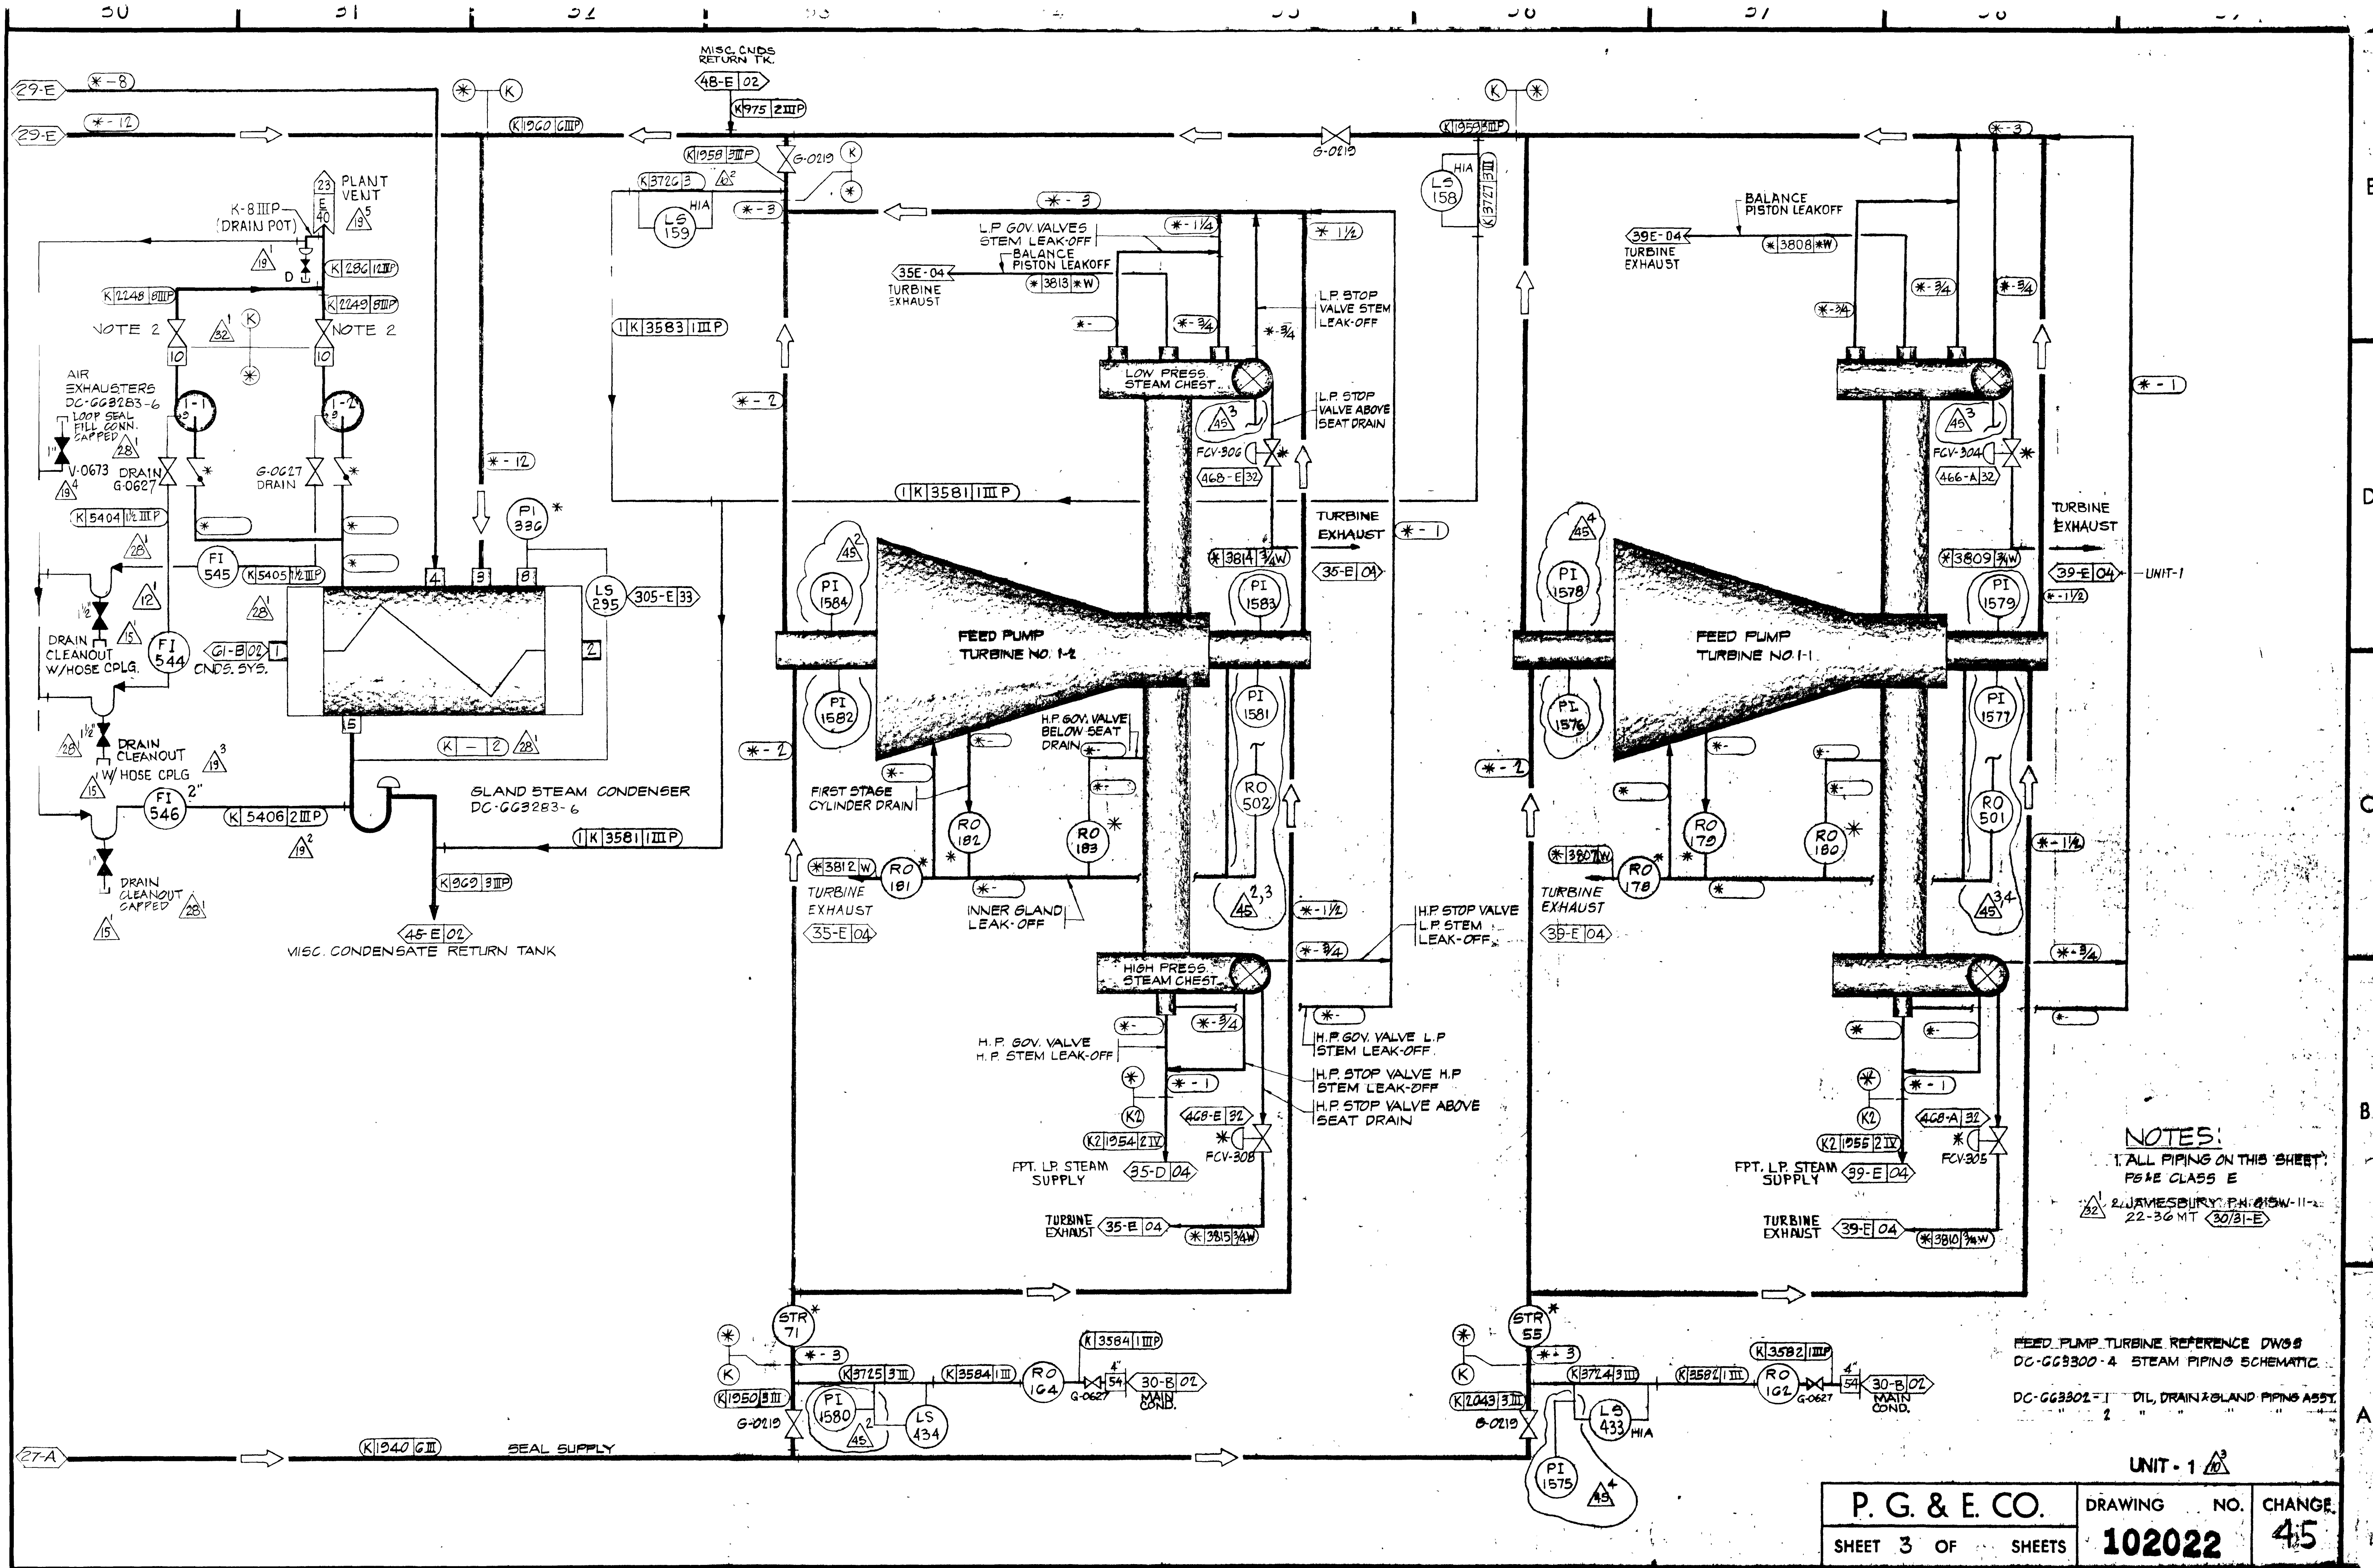

NOTES:
1. ALL PIPING ON THIS SHEET
IS CLASS E
2. JAMESBURY P.H. 11-1
22-36 MT (30/31-E)


FEED PUMP TURBINE REFERENCE DWG'S
DC-GG3300-4 STEAM PIPING SCHEMATIC
DC-GG3302-1 DIL, DRAIN & BLAND PIPING ASSY.

P. G. & E. CO.		DRAWING NO.	CHANGE
SHEET 3 OF SHEETS		102022	45

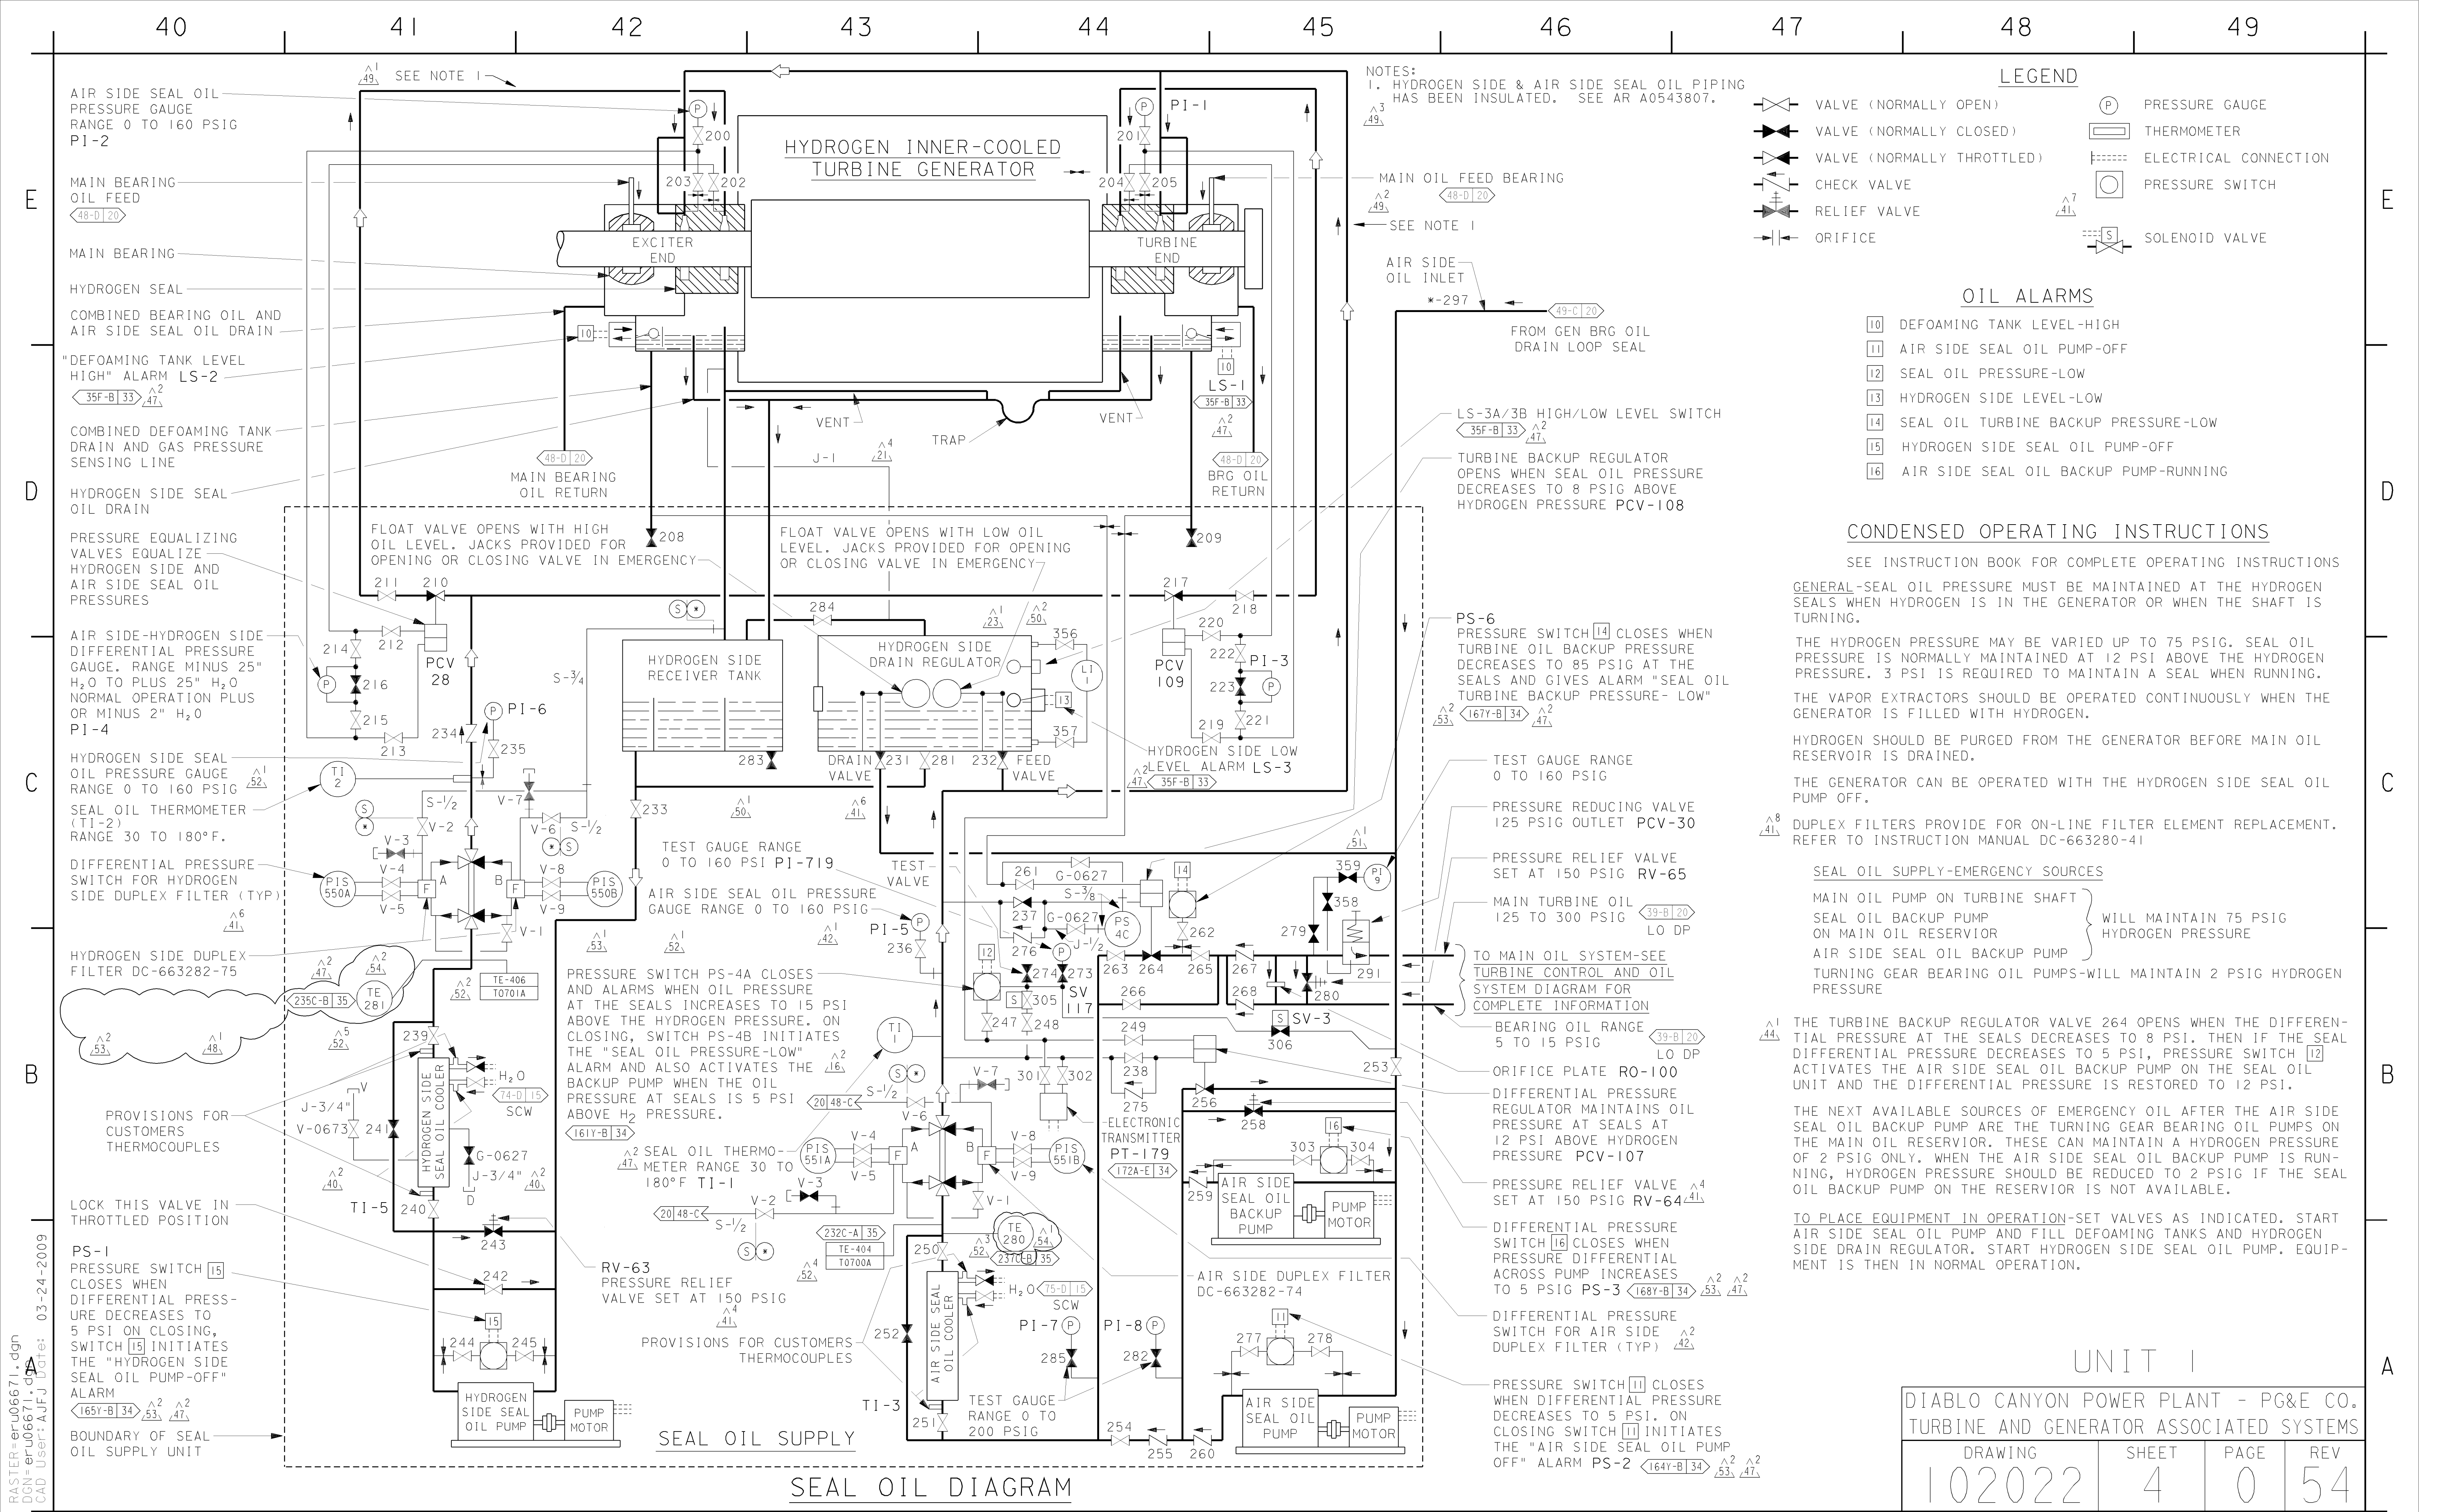


RASTER=eru06671.dgn
DGN=eru06671.dgn
CAD User: AJFJ Date: 03-24-2009

3 5/16

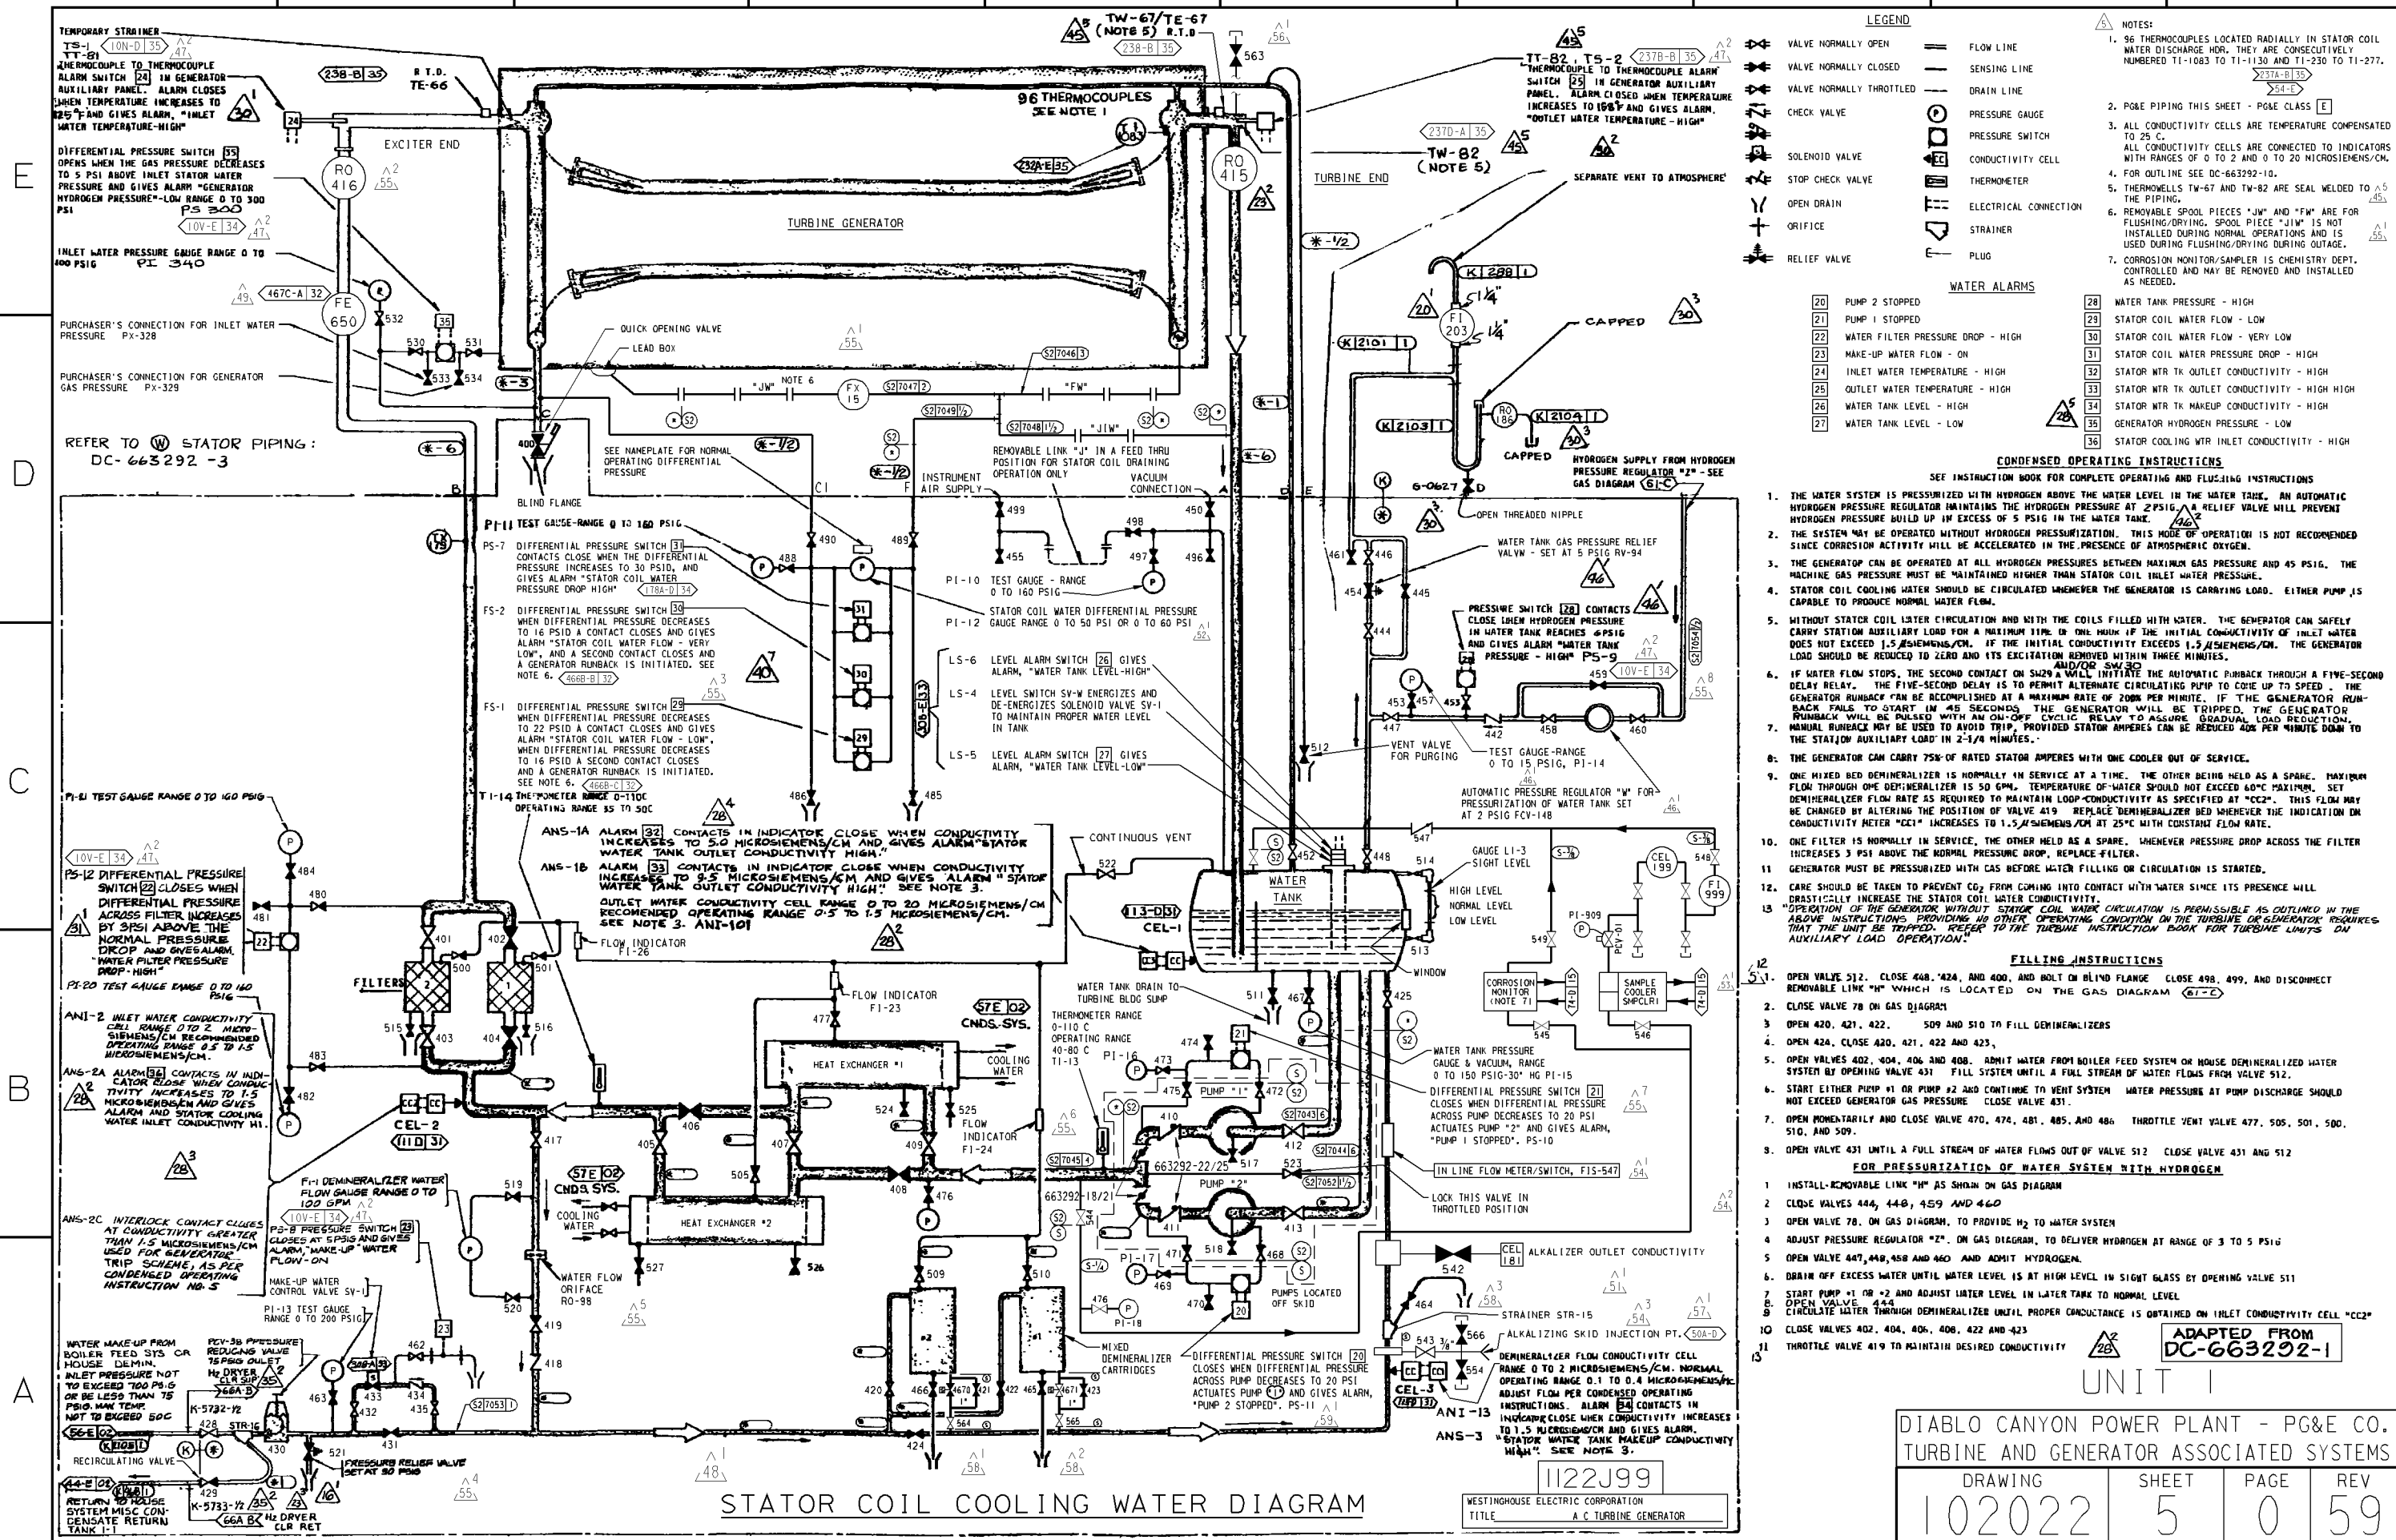

1/25/00	PMH2	FXC2	-	ALAN GLEN BARTA	ELECTRICAL	E 9271	9/30/2001	Revised per FCT 024322
DATE	DWN	RE	IV	PROFESSIONAL ENGINEER	PE DISC.	PE#	PE EXP.	

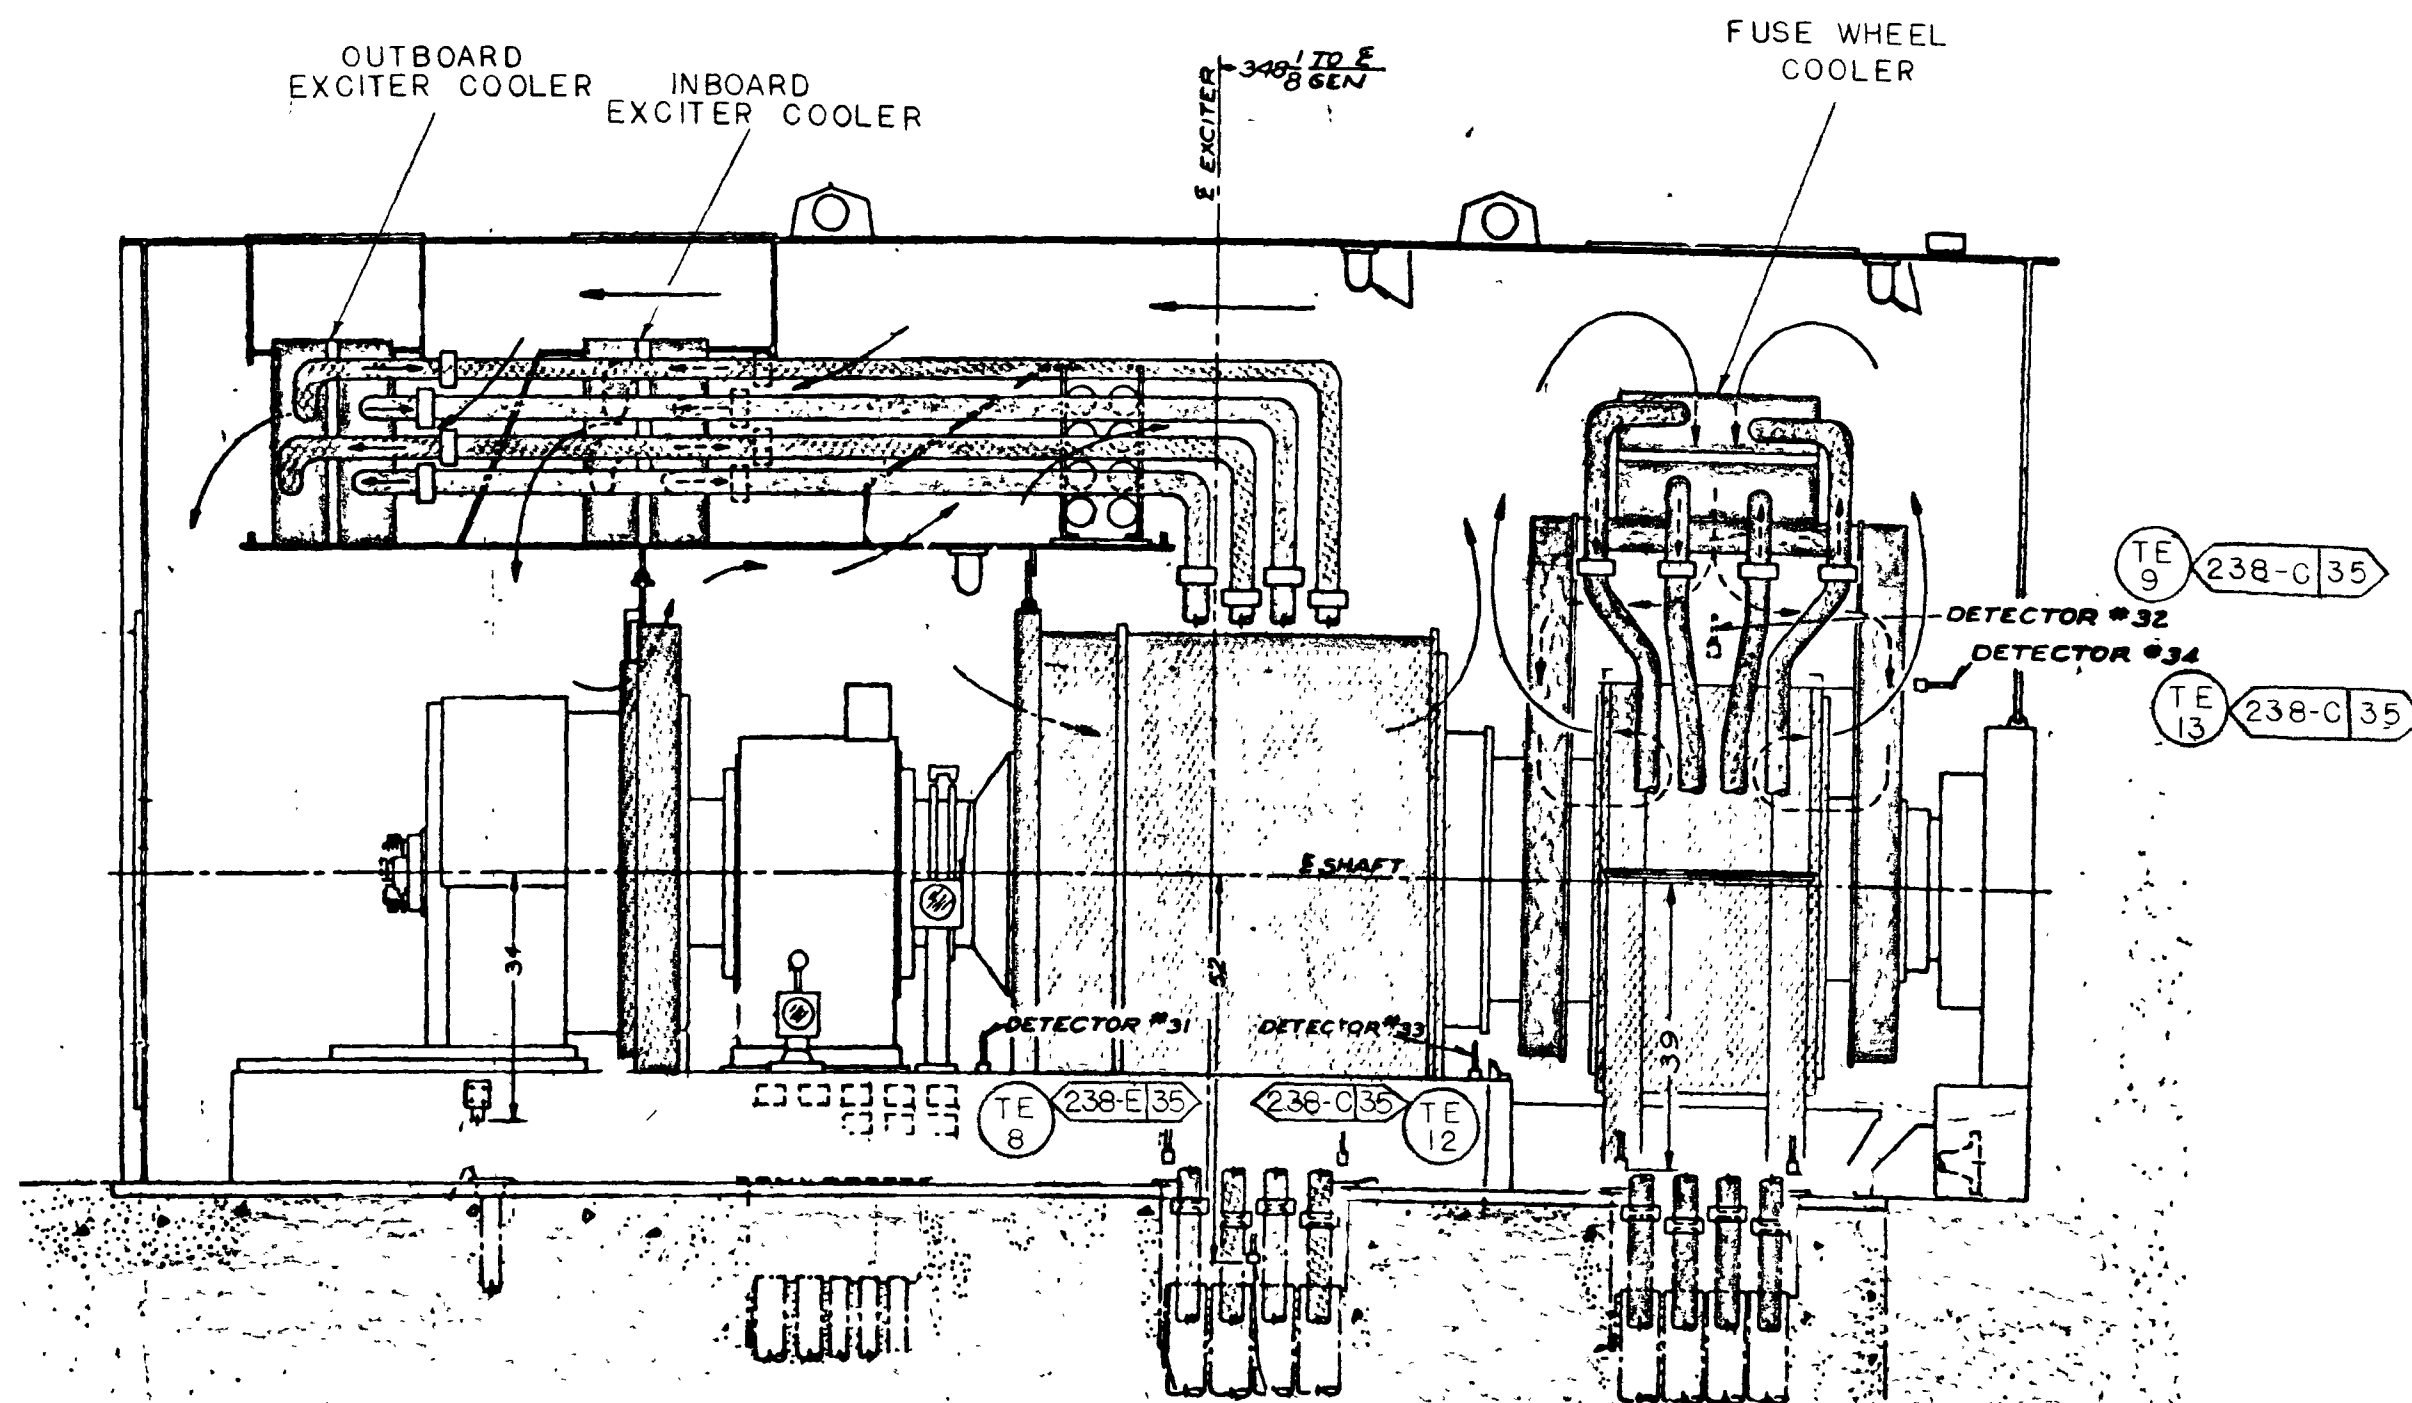

PERMANENT
MAGNET
GENERATOR

GENERATOR
EXCITER

EXCITER
FUSE
WHEEL

EXCITER COOLERS AIR TEMPERATURE
DETECTORS

ADAPTED FROM
WESTINGHOUSE DWG. 687J819
DC-663293-1

UNIT - 1

P.G.&E.C.O.

SHEET NO 7 OF SHEETS


DRAWING NUMBER

102022

CHANGE

10

35 M/M Neg. 10

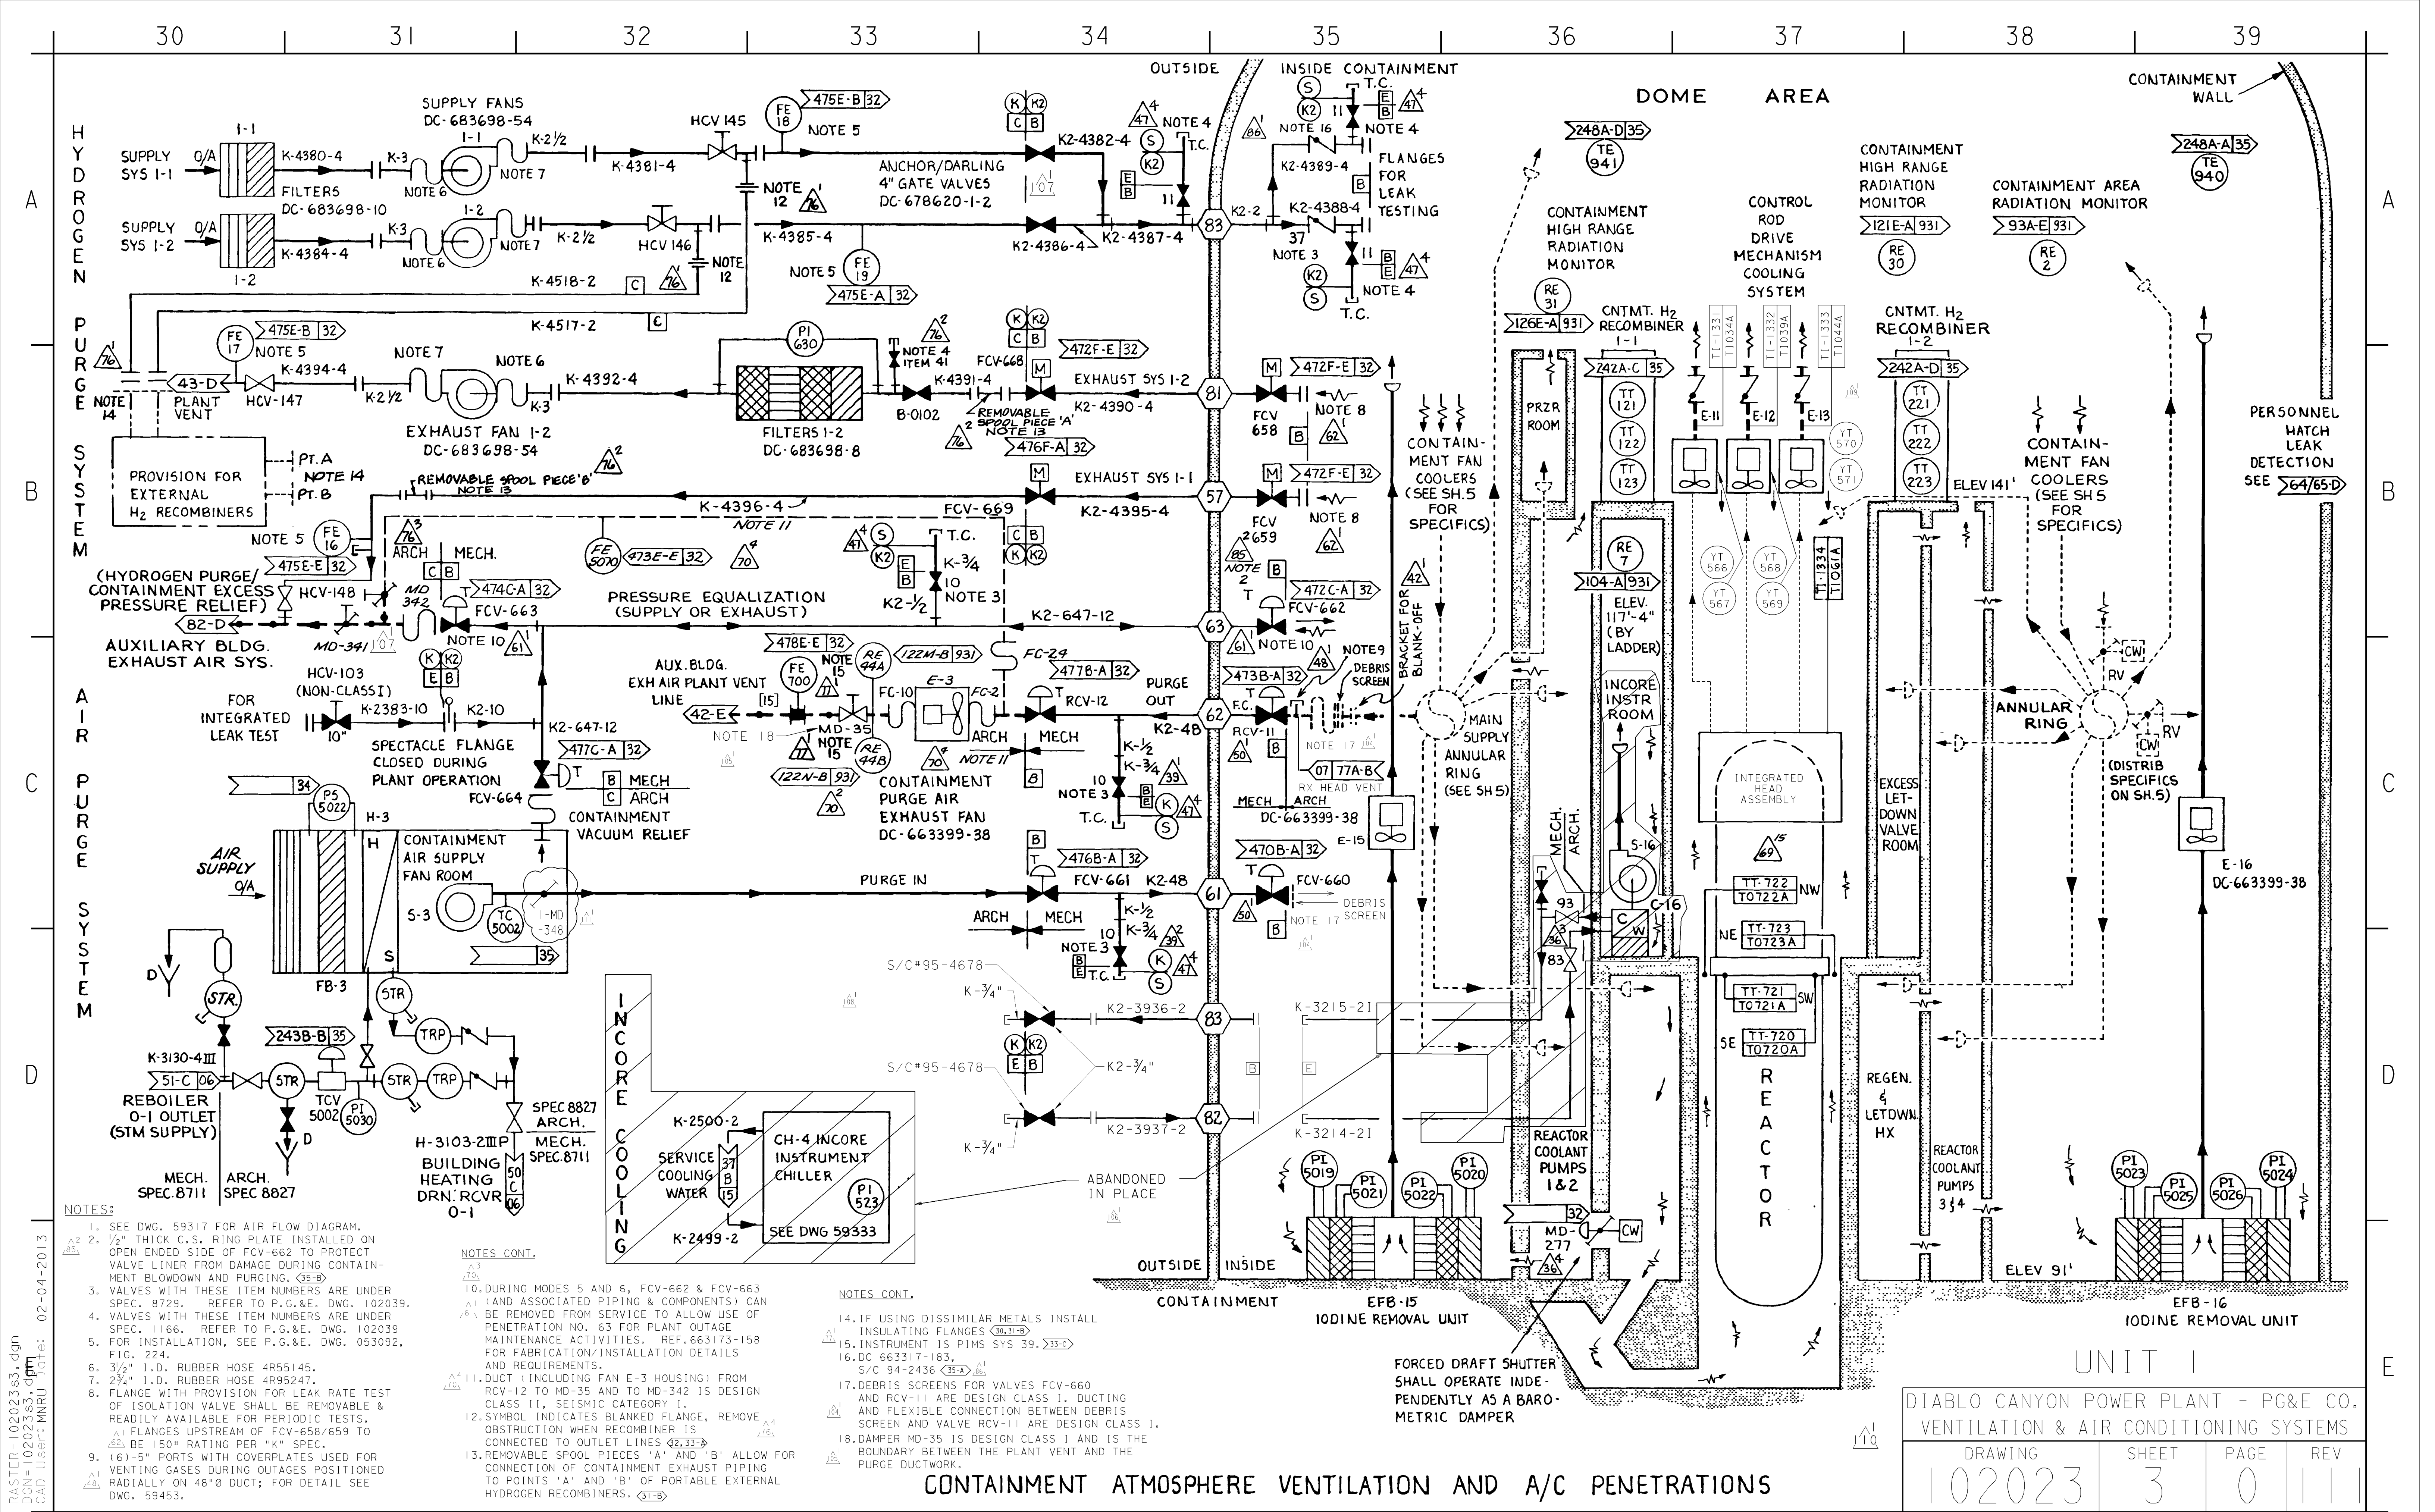

NOTES:

- SEE DWG. 59317 FOR AIR FLOW DIAGRAM.
- 1/2" THICK C.S. RING PLATE INSTALLED ON OPEN ENDED SIDE OF FCV-662 TO PROTECT VALVE LINER FROM DAMAGE DURING CONTAINMENT BLOWDOWN AND PURGING. (35-B)
- VALVES WITH THESE ITEM NUMBERS ARE UNDER SPEC. 8729. REFER TO P.G.&E. DWG. 102039.
- VALVES WITH THESE ITEM NUMBERS ARE UNDER SPEC. 1166. REFER TO P.G.&E. DWG. 102039.
- FOR INSTALLATION, SEE P.G.&E. DWG. 053092, FIG. 224.
- 3/2" I.D. RUBBER HOSE 4R55145.
- 2 3/4" I.D. RUBBER HOSE 4R95247.
- FLANGE WITH PROVISION FOR LEAK RATE TEST OF ISOLATION VALVE SHALL BE REMOVABLE & READILY AVAILABLE FOR PERIODIC TESTS.
- FLANGES UPSTREAM OF FCV-658/659 TO BE 150# RATING PER "K" SPEC.
- (6)-5" PORTS WITH COVERPLATES USED FOR VENTING GASES DURING OUTAGES POSITIONED RADIALLY ON 48" DUCT; FOR DETAIL SEE DWG. 59453.

NOTES CONT.

- DURING MODES 5 AND 6, FCV-662 & FCV-663 (AND ASSOCIATED PIPING & COMPONENTS) CAN BE REMOVED FROM SERVICE TO ALLOW USE OF PENETRATION NO. 63 FOR PLANT OUTAGE MAINTENANCE ACTIVITIES. REF. 663173-158 FOR FABRICATION/INSTALLATION DETAILS AND REQUIREMENTS.
- DUCT (INCLUDING FAN E-3 HOUSING) FROM RCV-12 TO MD-35 AND TO MD-342 IS DESIGN CLASS 1I, SEISMIC CATEGORY 1.
- SYMBOL INDICATES BLANKED FLANGE, REMOVE OBSTRUCTION WHEN RECOMBINER IS CONNECTED TO OUTLET LINES (42,33-B)
- REMOVABLE SPOOL PIECES 'A' AND 'B' ALLOW FOR CONNECTION OF CONTAINMENT EXHAUST PIPING TO POINTS 'A' AND 'B' OF PORTABLE EXTERNAL HYDROGEN RECOMBINERS. (31-B)

NOTES CONT.

- IF USING DISSIMILAR METALS INSTALL INSULATING FLANGES (30,31-B)
- INSTRUMENT IS PIMS SYS 39. (33-C)
- DC 663317-183, S/C 94-2436 (35-A)
- DEBRIS SCREENS FOR VALVES FCV-660 AND RCV-11 ARE DESIGN CLASS 1I, DUCTING AND FLEXIBLE CONNECTION BETWEEN DEBRIS SCREEN AND VALVE RCV-11 ARE DESIGN CLASS 1I.
- DAMPER MD-35 IS DESIGN CLASS 1 AND IS THE BOUNDARY BETWEEN THE PLANT VENT AND THE PURGE DUCTWORK.


CONTAINMENT ATMOSPHERE VENTILATION AND A/C PENETRATIONS

DIABLO CANYON POWER PLANT - PG&E CO.			
VENTILATION & AIR CONDITIONING SYSTEMS			
DRAWING	SHEET	PAGE	REV
102023	3	0	111

02-04-2013	MNRU	FxC2	KERSI J. DALAL	MECHANICAL	M 16690	3/31/2014	REVISED PER DFT-7*1949
DATE	DWN	RE	IV	PROFESSIONAL ENGINEER	PE DISC.	PE#	PE EXP.


CONTAINMENT ATMOSPHERE MONITORS & SAMPLING

EXHAUST

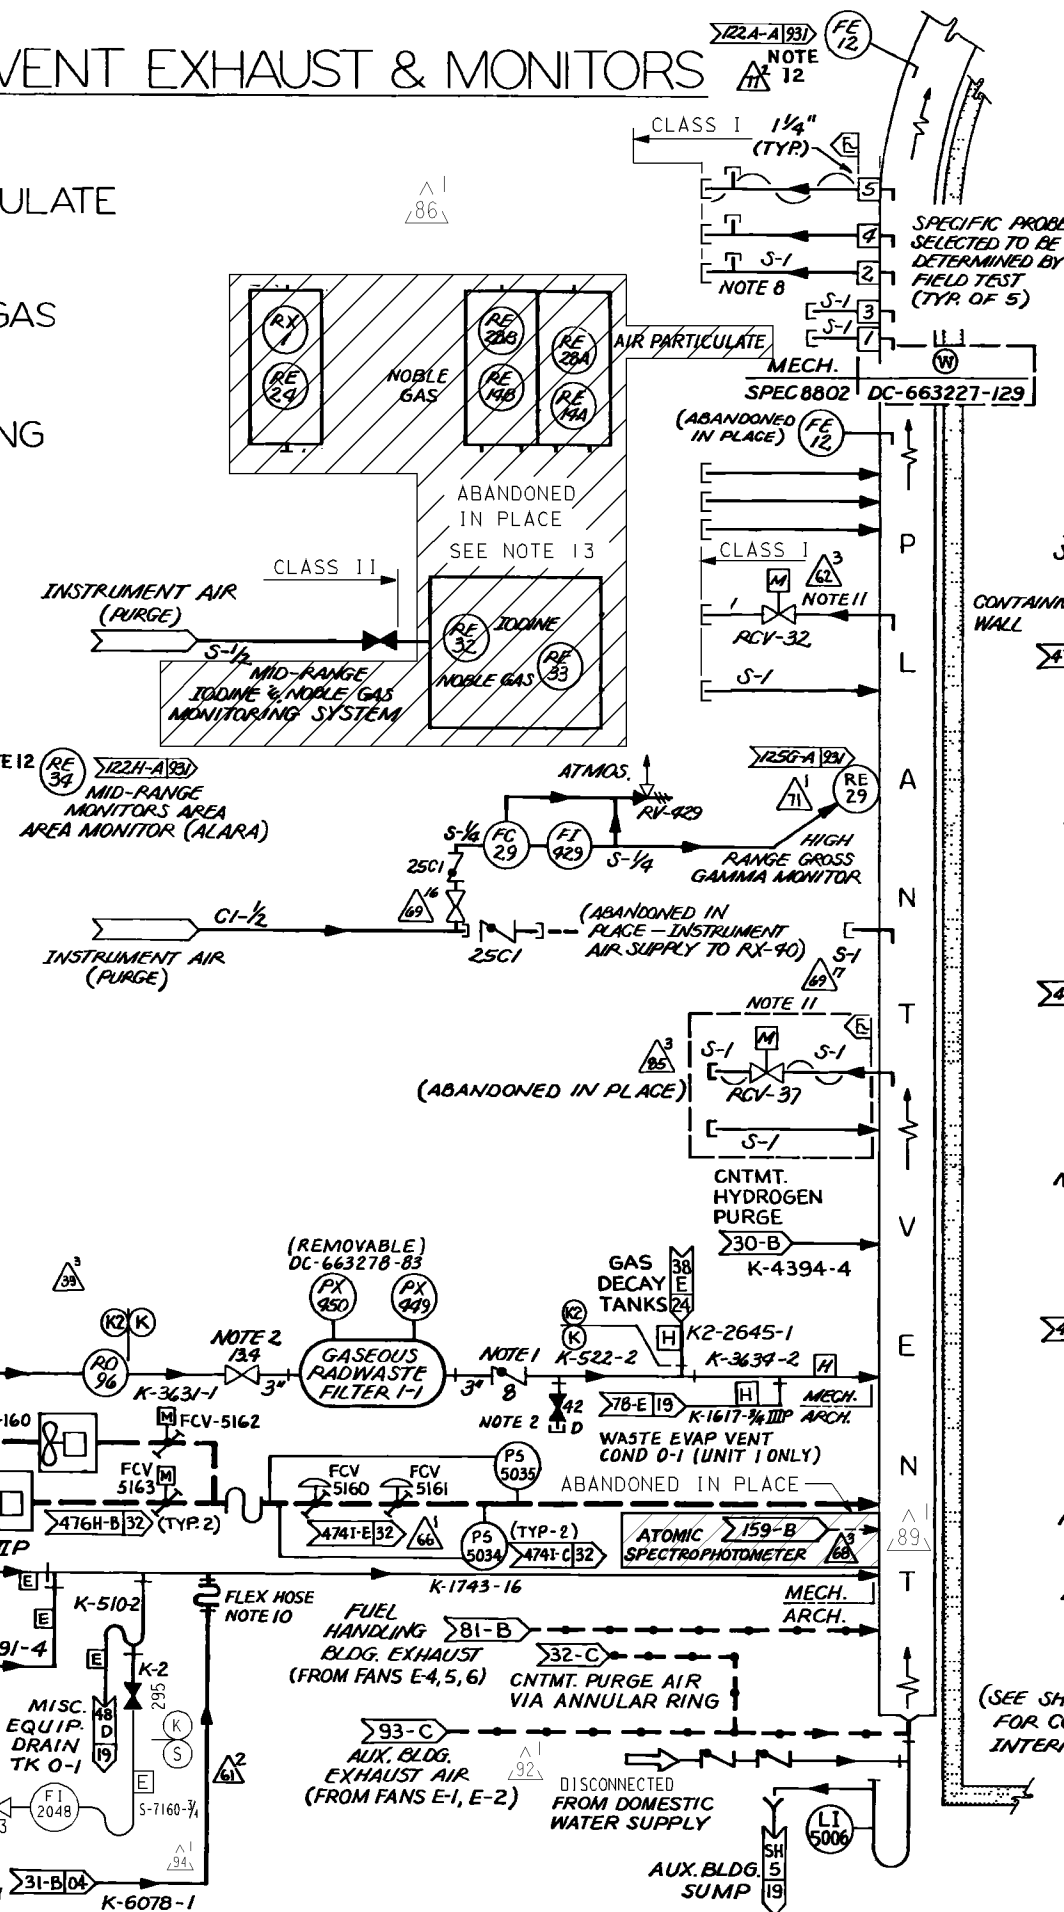

(SEE SHEETS 3, 5 & 6
FOR CONTAINMENT
INTERIOR SPECIFICS)

INSIDE \ OUTSIDE

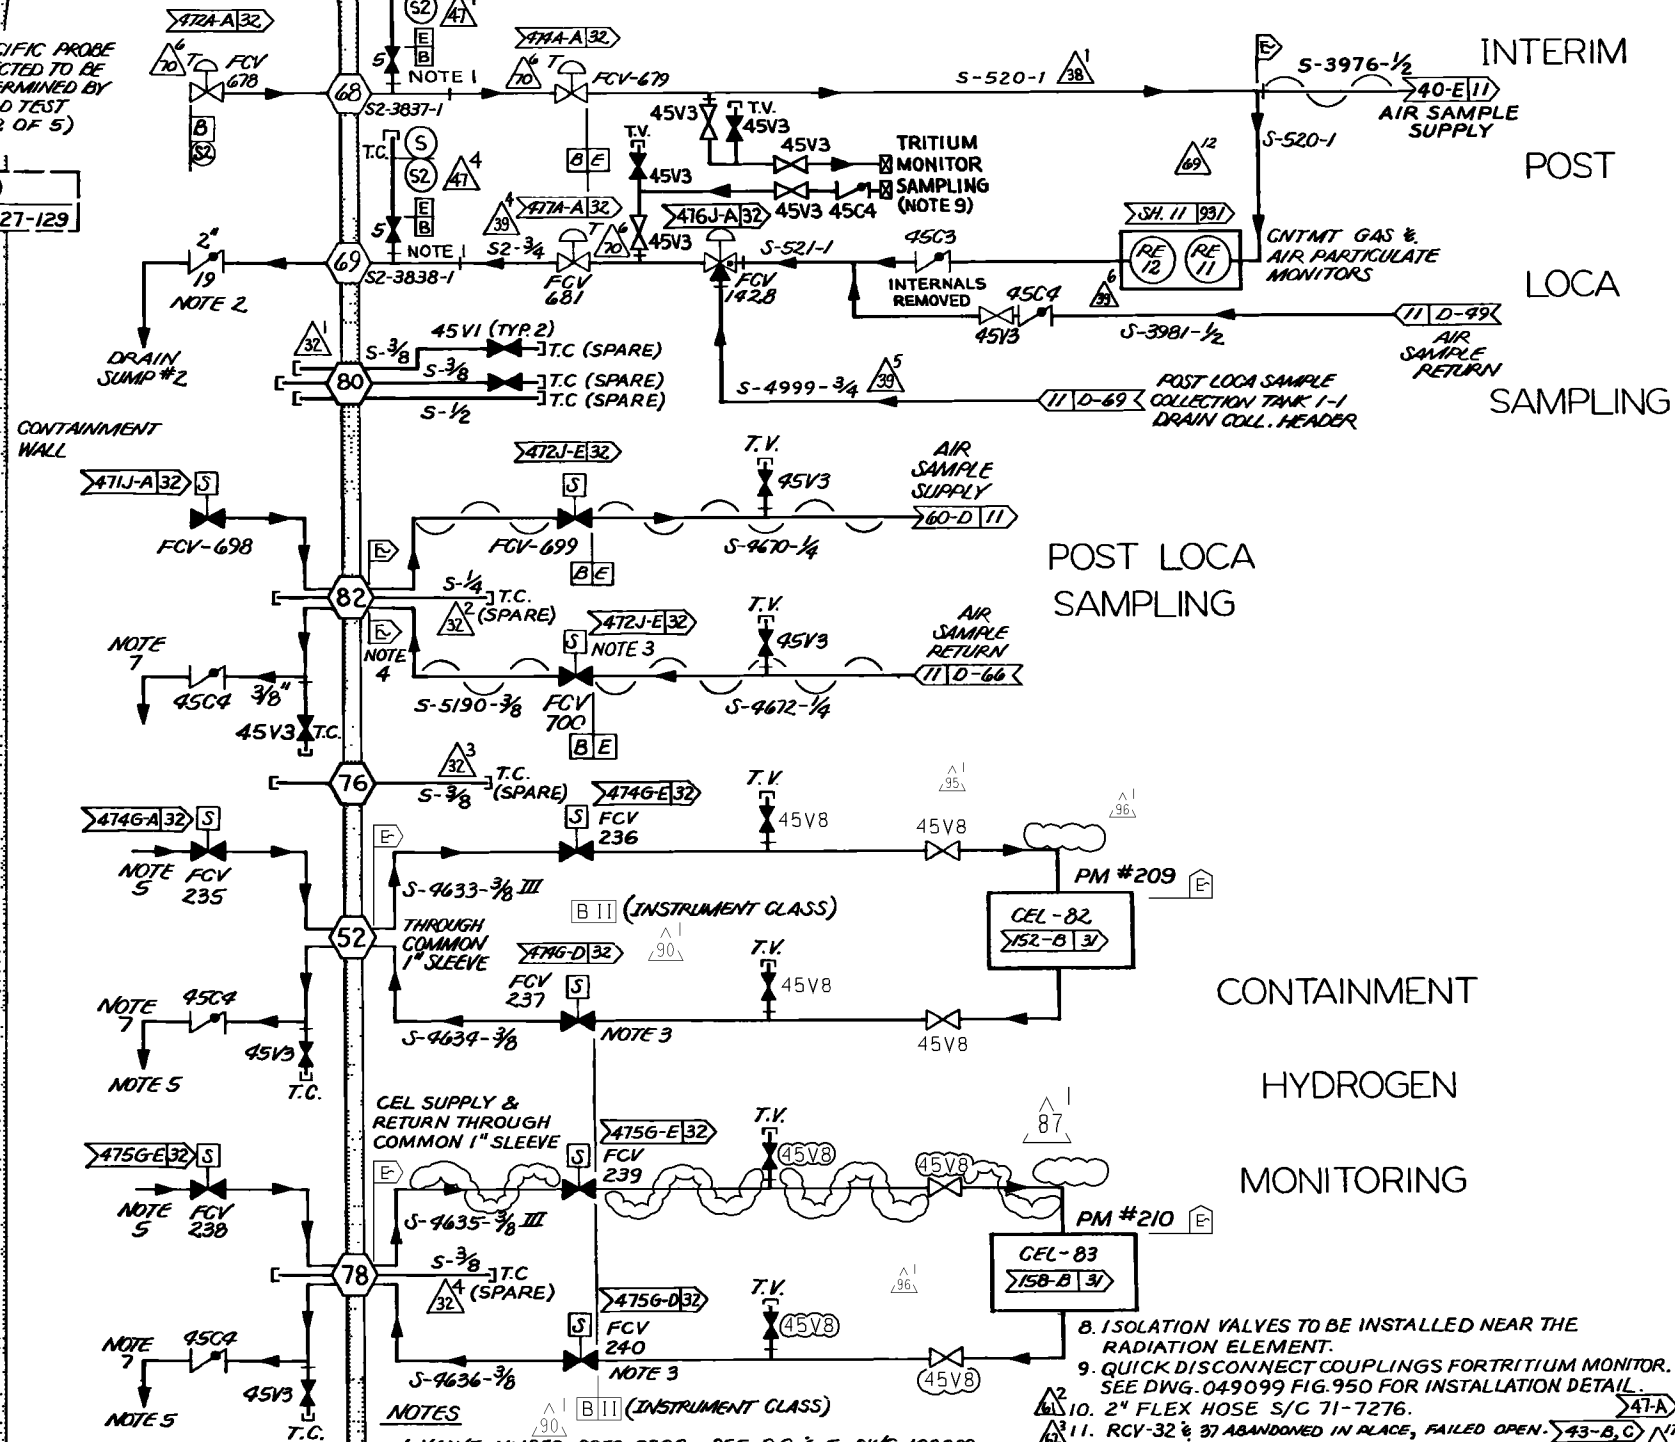

NOTES

1. VALVE UNDER SPEC. 0722, SEE P.G. & E. DWG. 102039
2. VALVE UNDER SPEC. 8729, SEE P.G. & E. DWG. 102039
3. INSTALLED IN REVERSE TO NORMAL FLOW DIRECTION TO MEET CONTAINMENT ISOLATION REQUIREMENTS.
4. CONTAINMENT AIR SAMPLE & RETURN TUBING SHALL PASS THROUGH A COMMON 2" SLEEVE. SEE DWG. 501915
5. FOR DETAILS, & DWG. 500186 FOR A COMPREHENSIVE LISTING OF MECHANICAL & ELECTRICAL PENETRATIONS.
5. END PROVISION FOR LEAK RATE TESTING.
6. DELETED
7. ELBOW TURNED DOWN (KEEP CLEAR).

8. ISOLATION VALVES TO BE INSTALLED NEAR THE RADIATION ELEMENT.

9. QUICK DISCONNECT COUPLINGS FOR TRITIUM MONITOR. SEE DWG. 049099 FIG. 950 FOR INSTALLATION DETAIL.

10. 2" FLEX HOSE S/C 71-7276.

11. RCY-32 & 37 ABANDONED IN PLACE, FAILED OPEN. 43-B, C

12. INSTRUMENT IS PIMS SYS 39. 40-B, 43-A

13. RE-24, 28A/B, 14A/B, 32&33 ARE ABANDONED IN PLACE. REFER TO DWG. 049099 SH. 7 & 11.


DIABLO CANYON POWER PLANT - PG&E CO. VENTILATION & AIR CONDITIONING SYSTEMS

DRAWING	SHEET	PAGE	REV
102023	4	0	96

RASTER=ERU87024.DGN
DGN=ERU87024.DGN
CAD User: AJFJ Date: 10-04-2010

INPGIC
I Size


10-04-2010	AJFJ	FxC2		KERSI J. DALAL	MECHANICAL	M 16690	3/31/2012	REVISED PER DDN-2*229,
DATE	DWN	RE	IV	PROFESSIONAL ENGINEER	PE DISC.	PE#	PE EXP.	DDN-2*381, & DAS-6*323

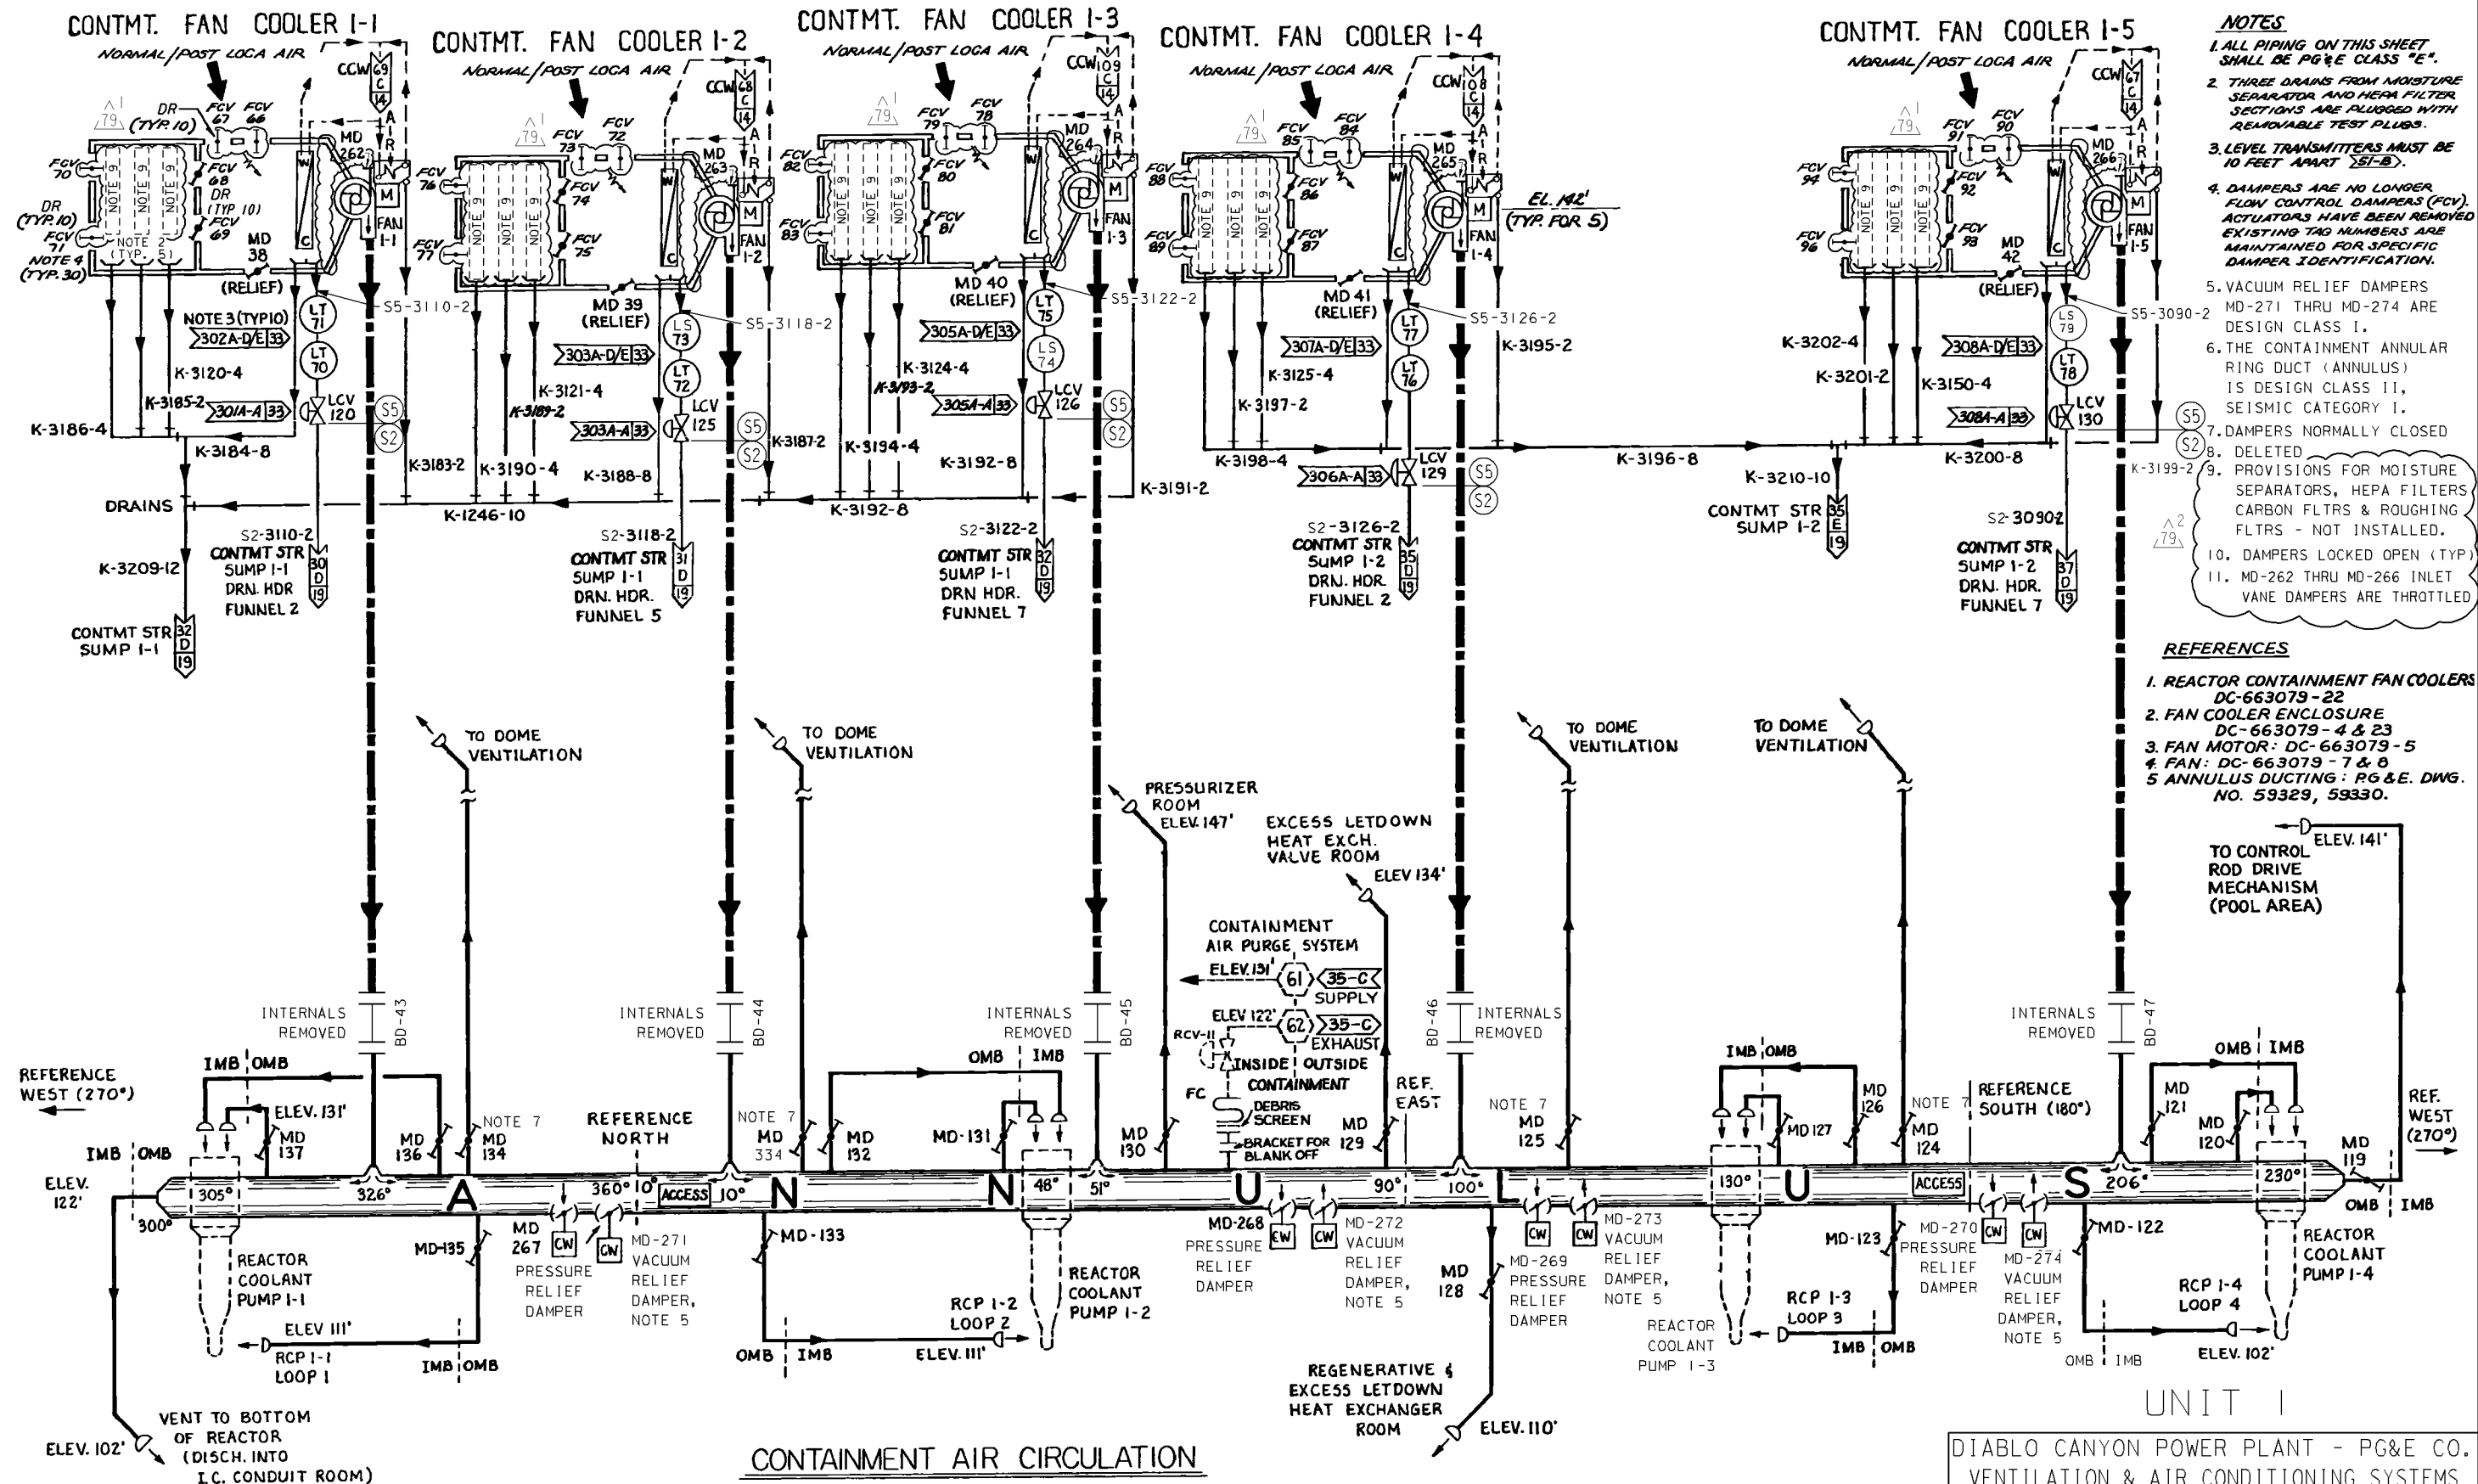

RASTER=002e1279.DGN
DGN=002e1279.DGN
CAD User: MNRU Date: 10-07-2013

INPGIC
1 Size

10-07-2013	MNRU	Fx2	KJD3	NOT REQUIRED	N/A	N/A	N/A	REVISED PER DFT-7*2260
DATE	DWN	RE	IV	PROFESSIONAL ENGINEER	PE DISC.	PE#	PE EXP.	

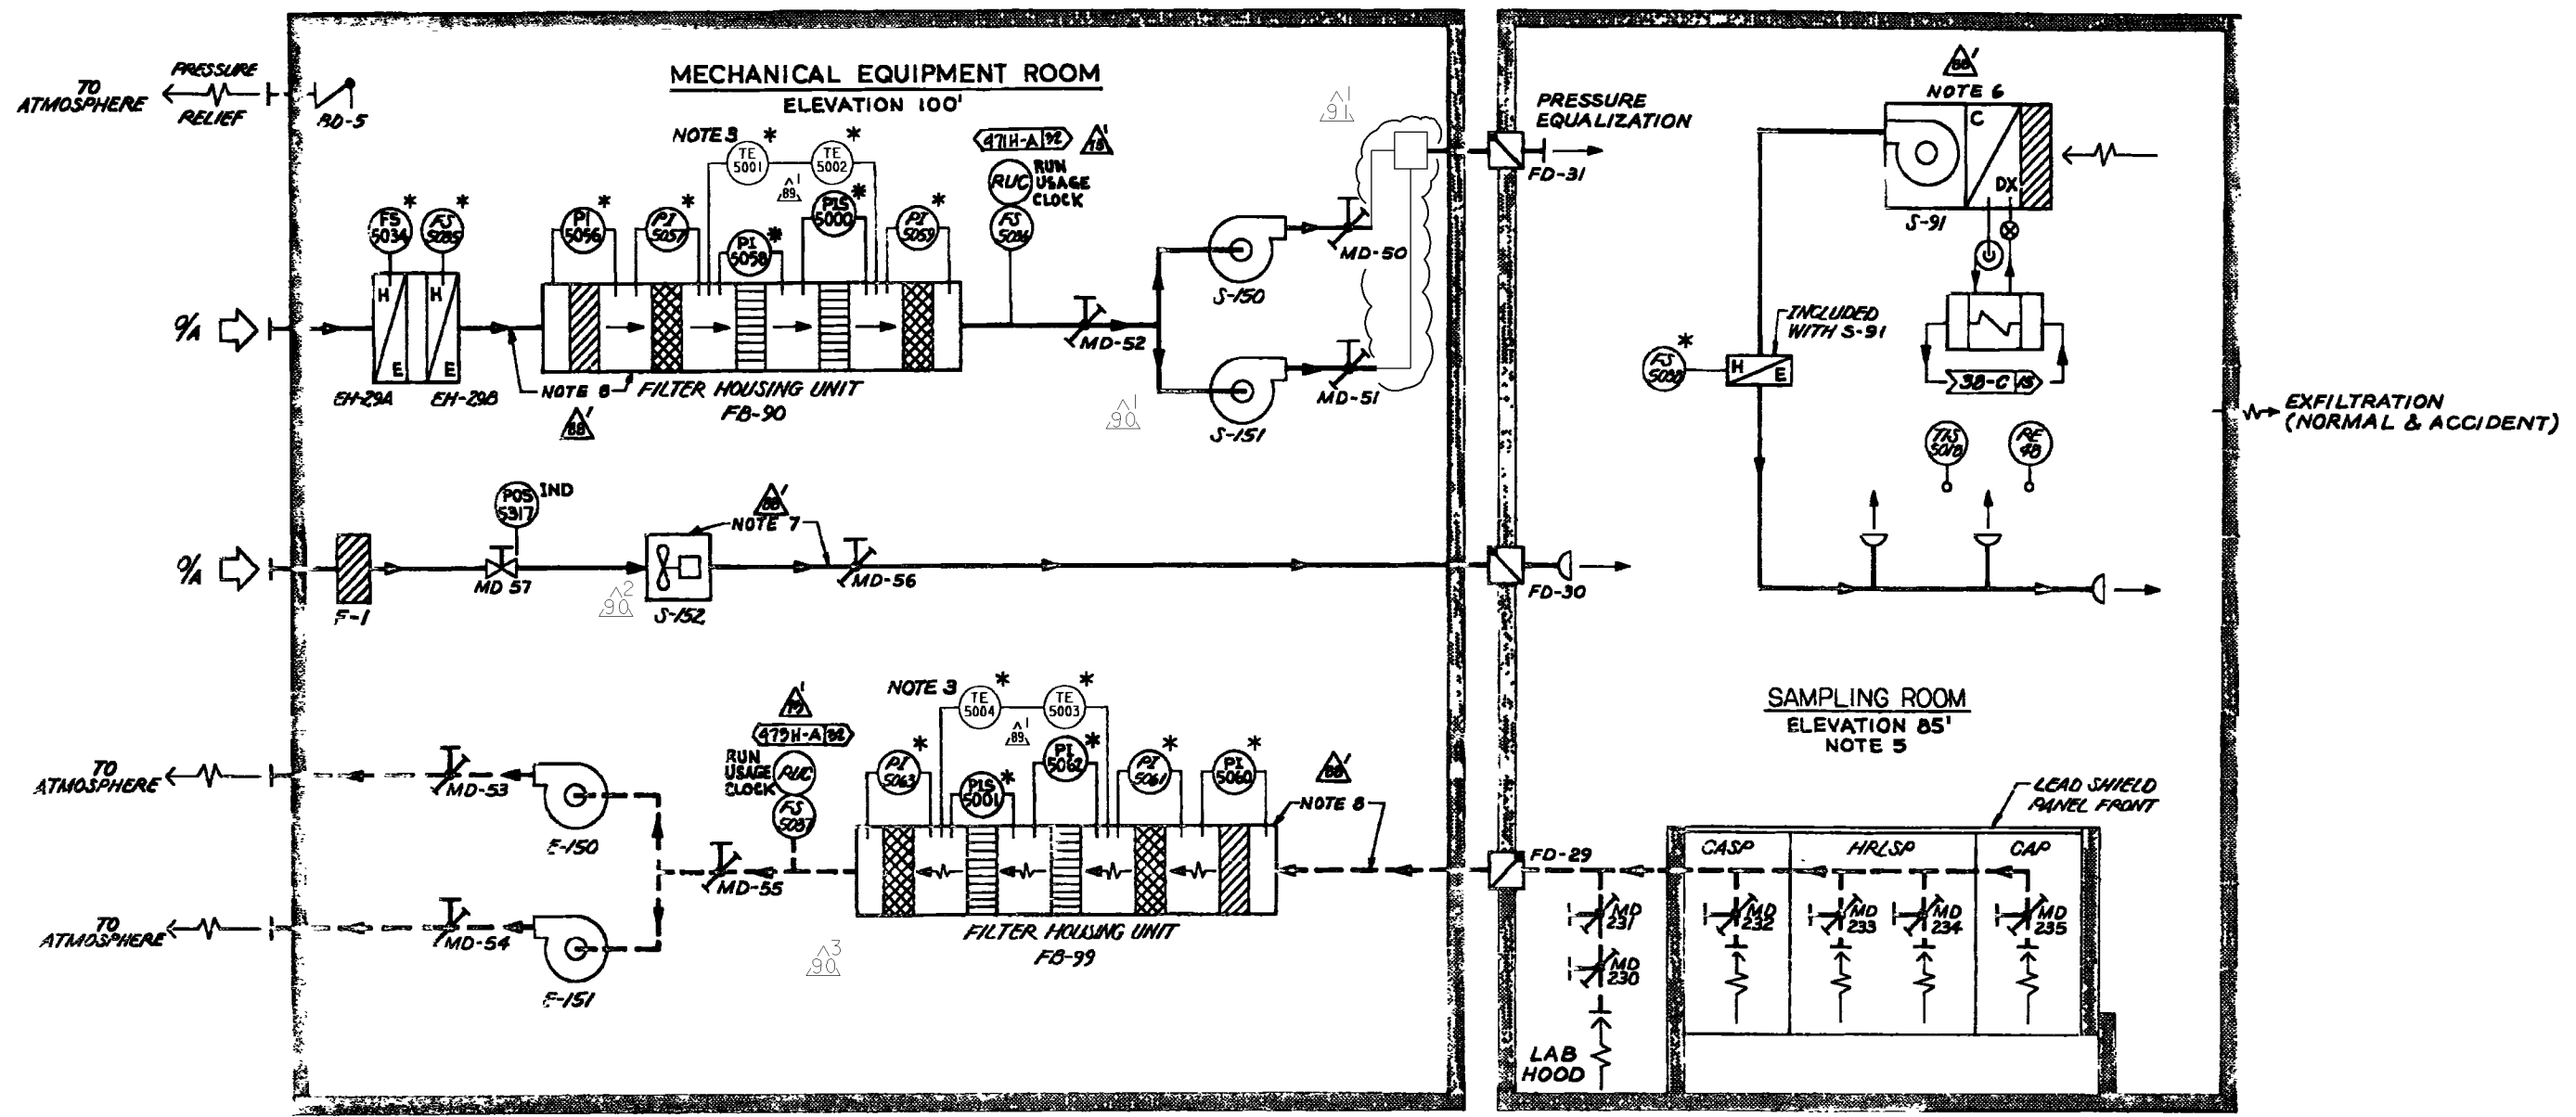

NOTES

- 1 FOR LEGEND, ABBREVIATIONS, INDEX, AND GENERAL NOTES, SEE 102023 SHEET 2 AND 102001 SHEET 3
- 2 SEE DRAWING 512904 FOR AIR FLOW DIAGRAM
- 3 CONAX RTD ASSEMBLY (RTD-43Y2-SS25TD) IS PROVIDED WITH MOORE RBA/2W ALARM SWITCH FOR FIRE PROTECTION. LOCAL ALARM IS INITIATED WITH A TEMPERATURE RISE TO 150°F. *RTD* = RESISTANCE TEMPERATURE DETECTOR. SEE DC-663278-622 FOR REFERENCE ~~72/73-A~~ ~~73/74-C~~
- 4
- 5 SEE DRAWING 102011 SHEET 6 ~~568-B(1)~~ FOR SAMPLING ROOM PHYSICAL LAYOUT
- 6 FOR NORMAL A/C SYSTEM, EQUIPMENT ARE DESIGNATED DESIGN CLASS II, BUT SUPPORTED SO THAT THEY WILL REMAIN IN PLACE AFTER A HOSGRI EVENT NOT NECESSARY TO FUNCTION AFTER THE EARTHQUAKE ~~77-A~~
- 7 FOR NORMAL SUPPLY AIR SYSTEM DUCT AND DUCT SUPPORTS ARE QUALIFIED TO SEISMIC CLASS I CRITERIA, EQUIPMENT ARE DESIGNATED DESIGN CLASS II, BUT SUPPORTED SO THAT THEY WILL REMAIN IN PLACE AFTER A HOSGRI EVENT NOT NECESSARY TO FUNCTION AFTER THE EARTHQUAKE ~~78-C~~
- 8 FOR EMERGENCY VENTILATION SYSTEM, EQUIPMENT ARE EVALUATED TO REMAIN INTACT AFTER BEING SUBJECTED TO A POSTULATED HOSGRI EVENT. CALCULATED STRESSES ARE TO BE WITHIN THE ALLOWABLES FOR DESIGN CLASS I EQUIPMENT FOR EMERGENCY DUCTWORK, DUCT AND DUCT SUPPORTS ARE QUALIFIED TO SEISMIC CLASS I CRITERIA ~~72-B~~ ~~75-C~~

5 SHEET 7 CHANGE
 26 DAMPER/EQUIP
NUMBERS

UNIT 1

POST LOCA SAMPLING SYSTEM HVAC

DIABLO CANYON POWER PLANT - PG&E CO.			
VENTILATION & AIR CONDITIONING SYSTEMS			
DRAWING	SHEET	PAGE	REV
102023	7	0	91

RASTER=eru04915.DGN
DGN=eru04915.DGN
CAD User: JARO Date: 01-15-2008

INPG2ND
1 Size


01-15-2008	JARO	Fxc2		STEPHEN PERRY BAKER	MECHANICAL	M 27135	6/30/2009	REVISED PER FCT-33147
DATE	DWN	RE	IV	PROFESSIONAL ENGINEER	PE DISC.	PE#	PE EXP.	





NOTES:

1. SUPPLY SHAFT FROM MECHANICAL EQUIPMENT ROOM (FLOOR ELEV. 154') PASSES VERTICALLY DOWN THROUGH ELEVATIONS 128' & 115' TO END AT ELEVATION 100'.
2. EXHAUST SHAFT PASSES VERTICALLY UP THROUGH ELEVATIONS 85', 100', 115', 128', & 140' TO E-27 EXHAUST FAN ROOM ON ROOF.
3. 2" NPTF BALANCING VALVE, ITT-BELL & GOSSETT MODEL CB-2 WITH 1/4" NPT DRAIN/PURGE PORT.
4. FOR LEGEND, ABBREVIATIONS, INDEX, AND GENERAL NOTES, SEE SHEET 2 (102023) OR SHEET 3 (102001).
5. SEE DRAWINGS 59346 & 59347 FOR DUCT LAYOUT.
6. THERMOSTATS, TIS-5009, TIS-5010, TIS-5011, TIS-5012, TIS-5013 & TIS-5014 ARE FOR INDICATION OF ROOM TEMP. ONLY.
7. 2" NPTF 3-WAY VALVE, BARBER COLEMAN ASSEMBLY NO. VS-9913-414-4-11.
8. DUCTWORK IS DESIGN CLASS II; DUCT AND DUCT SUPPORTS ARE SEISMICALLY QUALIFIED FOR THE H05GRI EARTHQUAKE AND DDE. (147-B,C) (148-D)

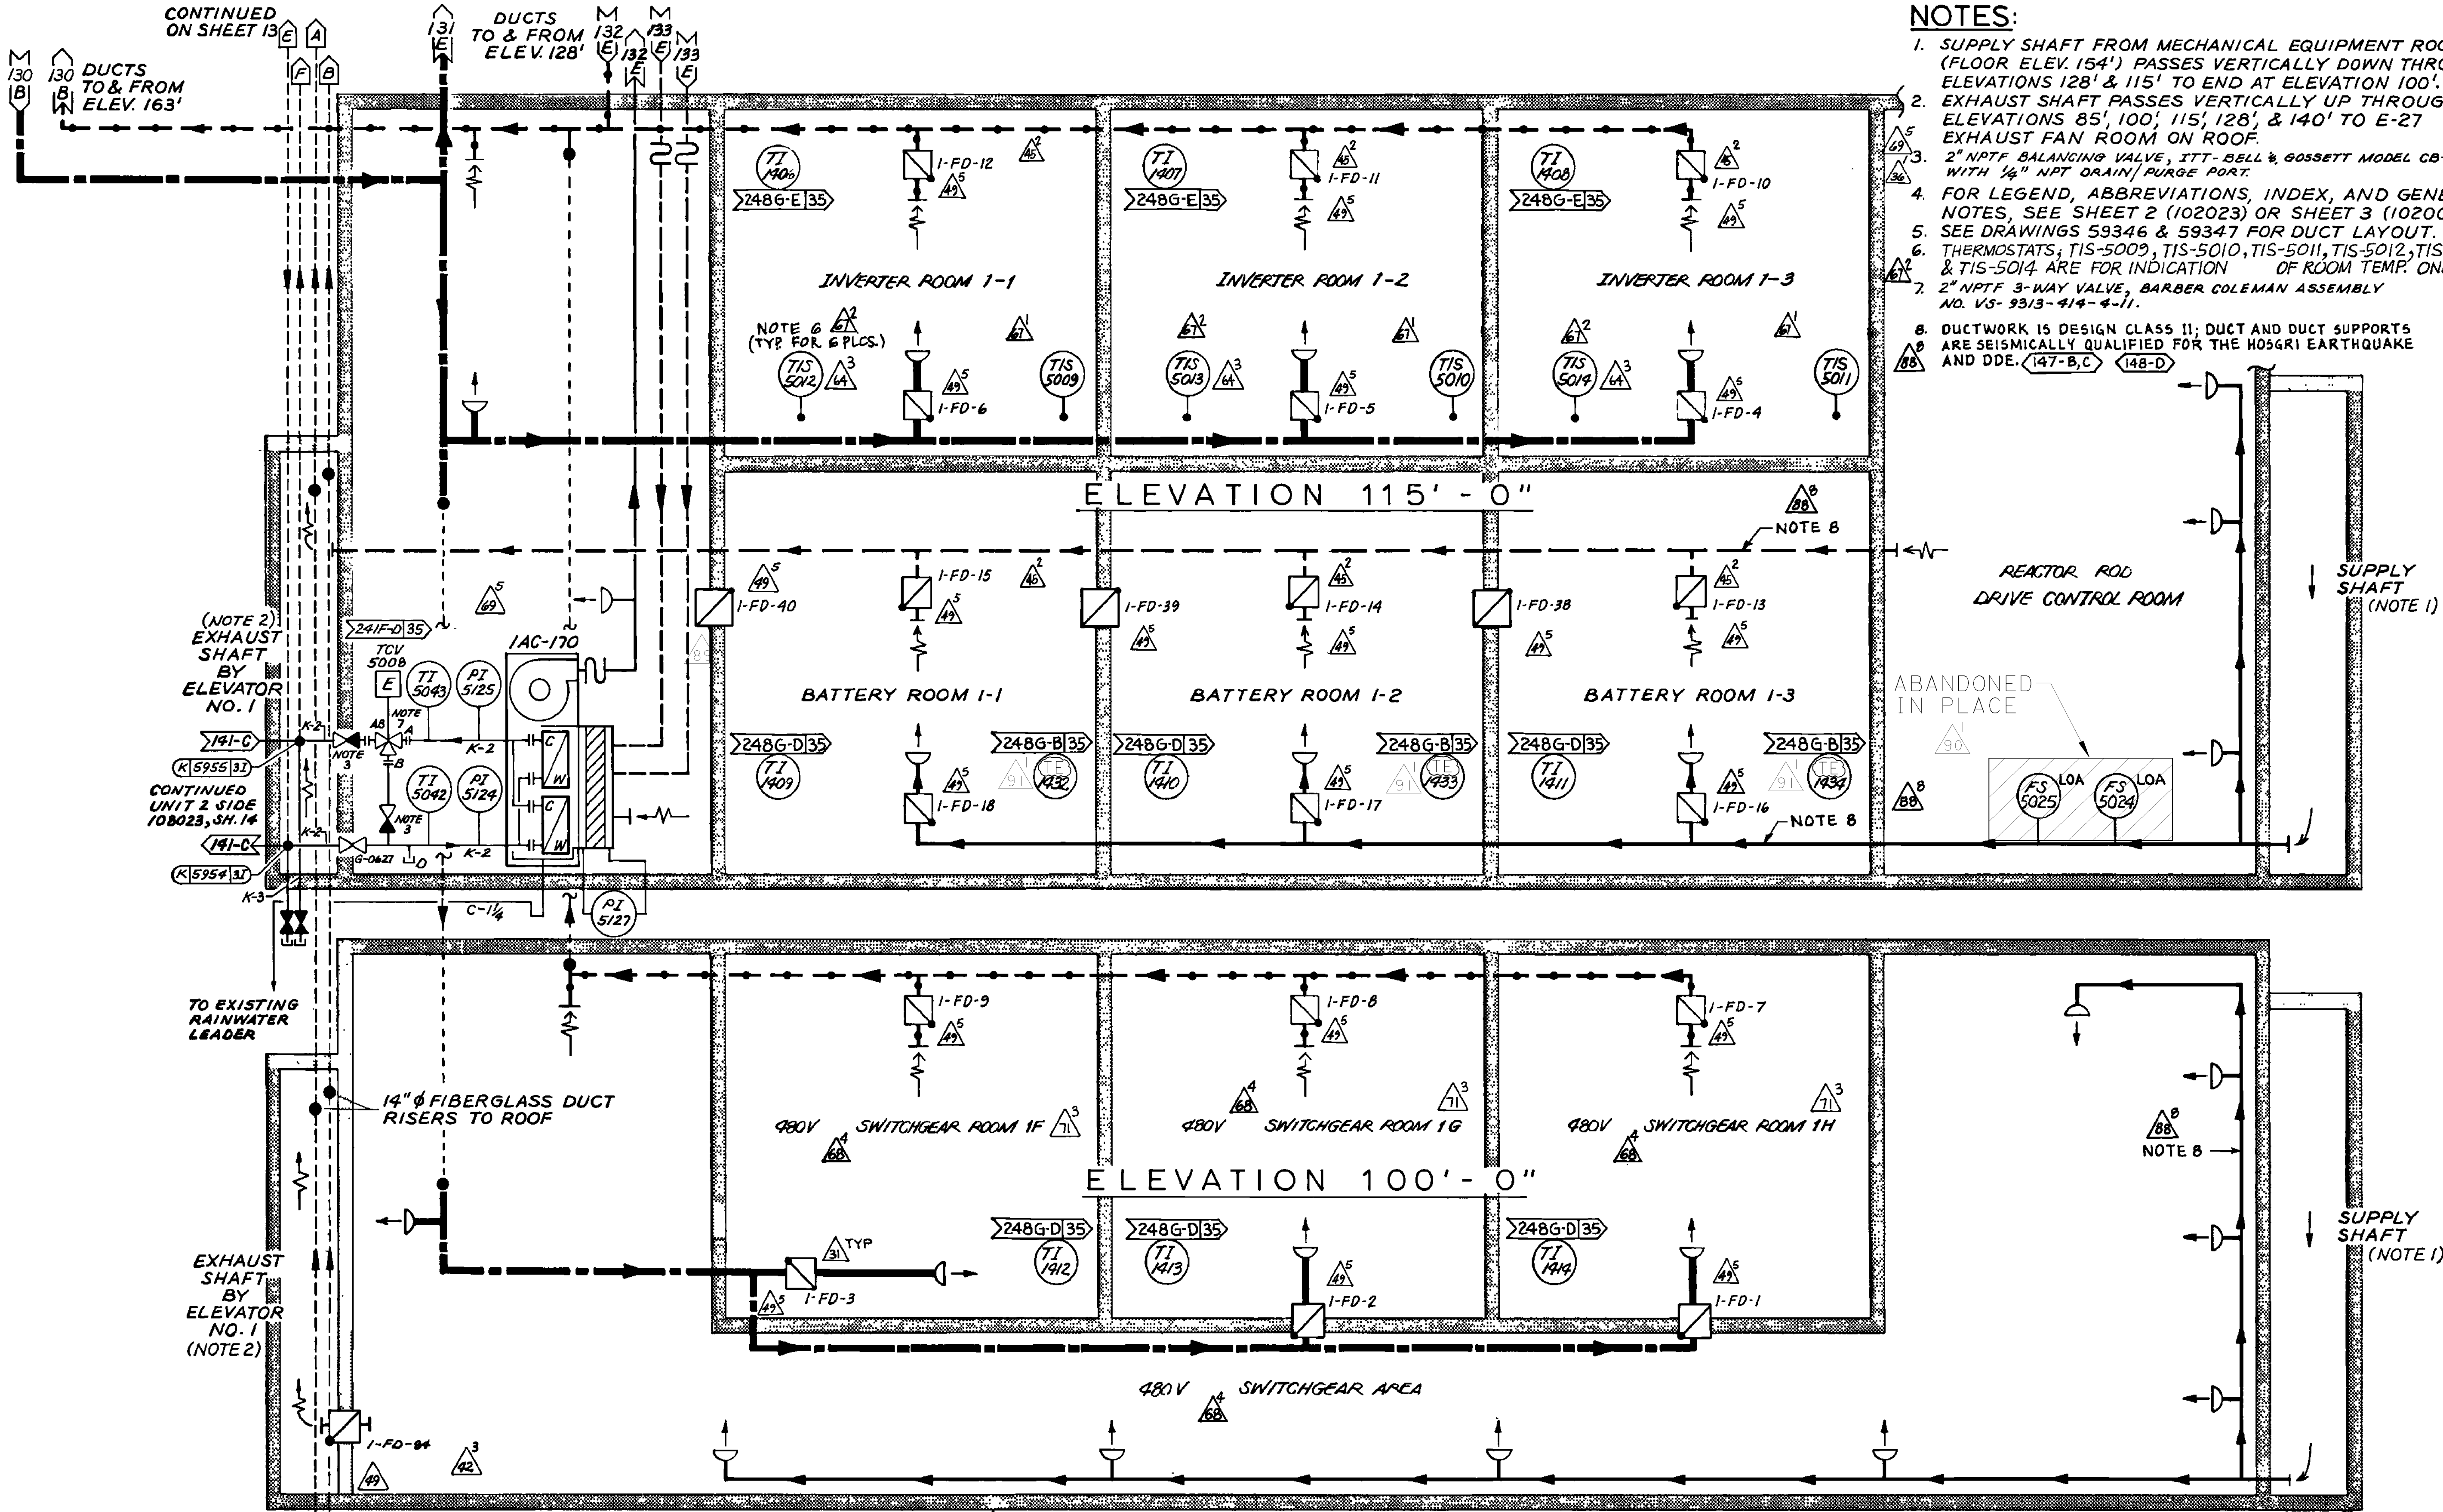

AUX. BLDG.: 480V SWITCHGEAR, BATTERY, INVERTER, AND REACTOR ROD DRIVE CONTROL ROOMS

DIABLO CANYON POWER PLANT - PG&E CO.
VENTILATION & AIR CONDITIONING SYSTEMS

DRAWING	SHEET	PAGE	REV
102023	14	0	91

UNIT 1

08-16-2011	AJFJ	Fxc2	KERSI J. DALAL	MECHANICAL	M 16690	3/31/2012	REVISED PER DAS-6*428
DATE	DWN	RE	IV	PE DISC.	PE#	PE EXP.	

RASTER=102023sl14.dgn
DGN=102023sl14.dgn
CAD User: AJFJ Date: 08-16-2011


NOTES:

1. EXHAUST SHAFT PASSES VERTICALLY UP THROUGH ELEVATIONS 85' (THIS SHEET), 100' & 115' (SHEET 14), AND 128' & 140' (SHEET 13) TO E-27 EXHAUST FAN ROOM ON ROOF (SHEET 13).
2. EXHAUST BACKDRAFT DAMPER IS DESIGN CLASS I. >159-B
3. FOR LEGEND, ABBREVIATIONS, INDEX, AND GENERAL NOTES, SEE SHEET 2 (102023) OR SHEET 3 (102001).
- 4.
5. SEE DRAWINGS 516103 & 59318 FOR AIR FLOW DIAGRAM.
6. AUXILIARY BUILDING ACCESS CONTROL AREA IS COMMON TO BOTH UNIT 1 & UNIT 2, & IS UNDER SPECIFICATION 8828.
7. ASHCROFT MODEL 30 ET INDICATING THERMOMETER.
8. ASHCROFT MODEL 1009 PRESSURE GAUGES.

SEPARATE 14" Ø FIBERGLASS DUCT RISERS TO ROOF.

EXHAUST SHAFT BY ELEVATOR NO. 1 (NOTE 1)

CONTINUED ON SHEET 14

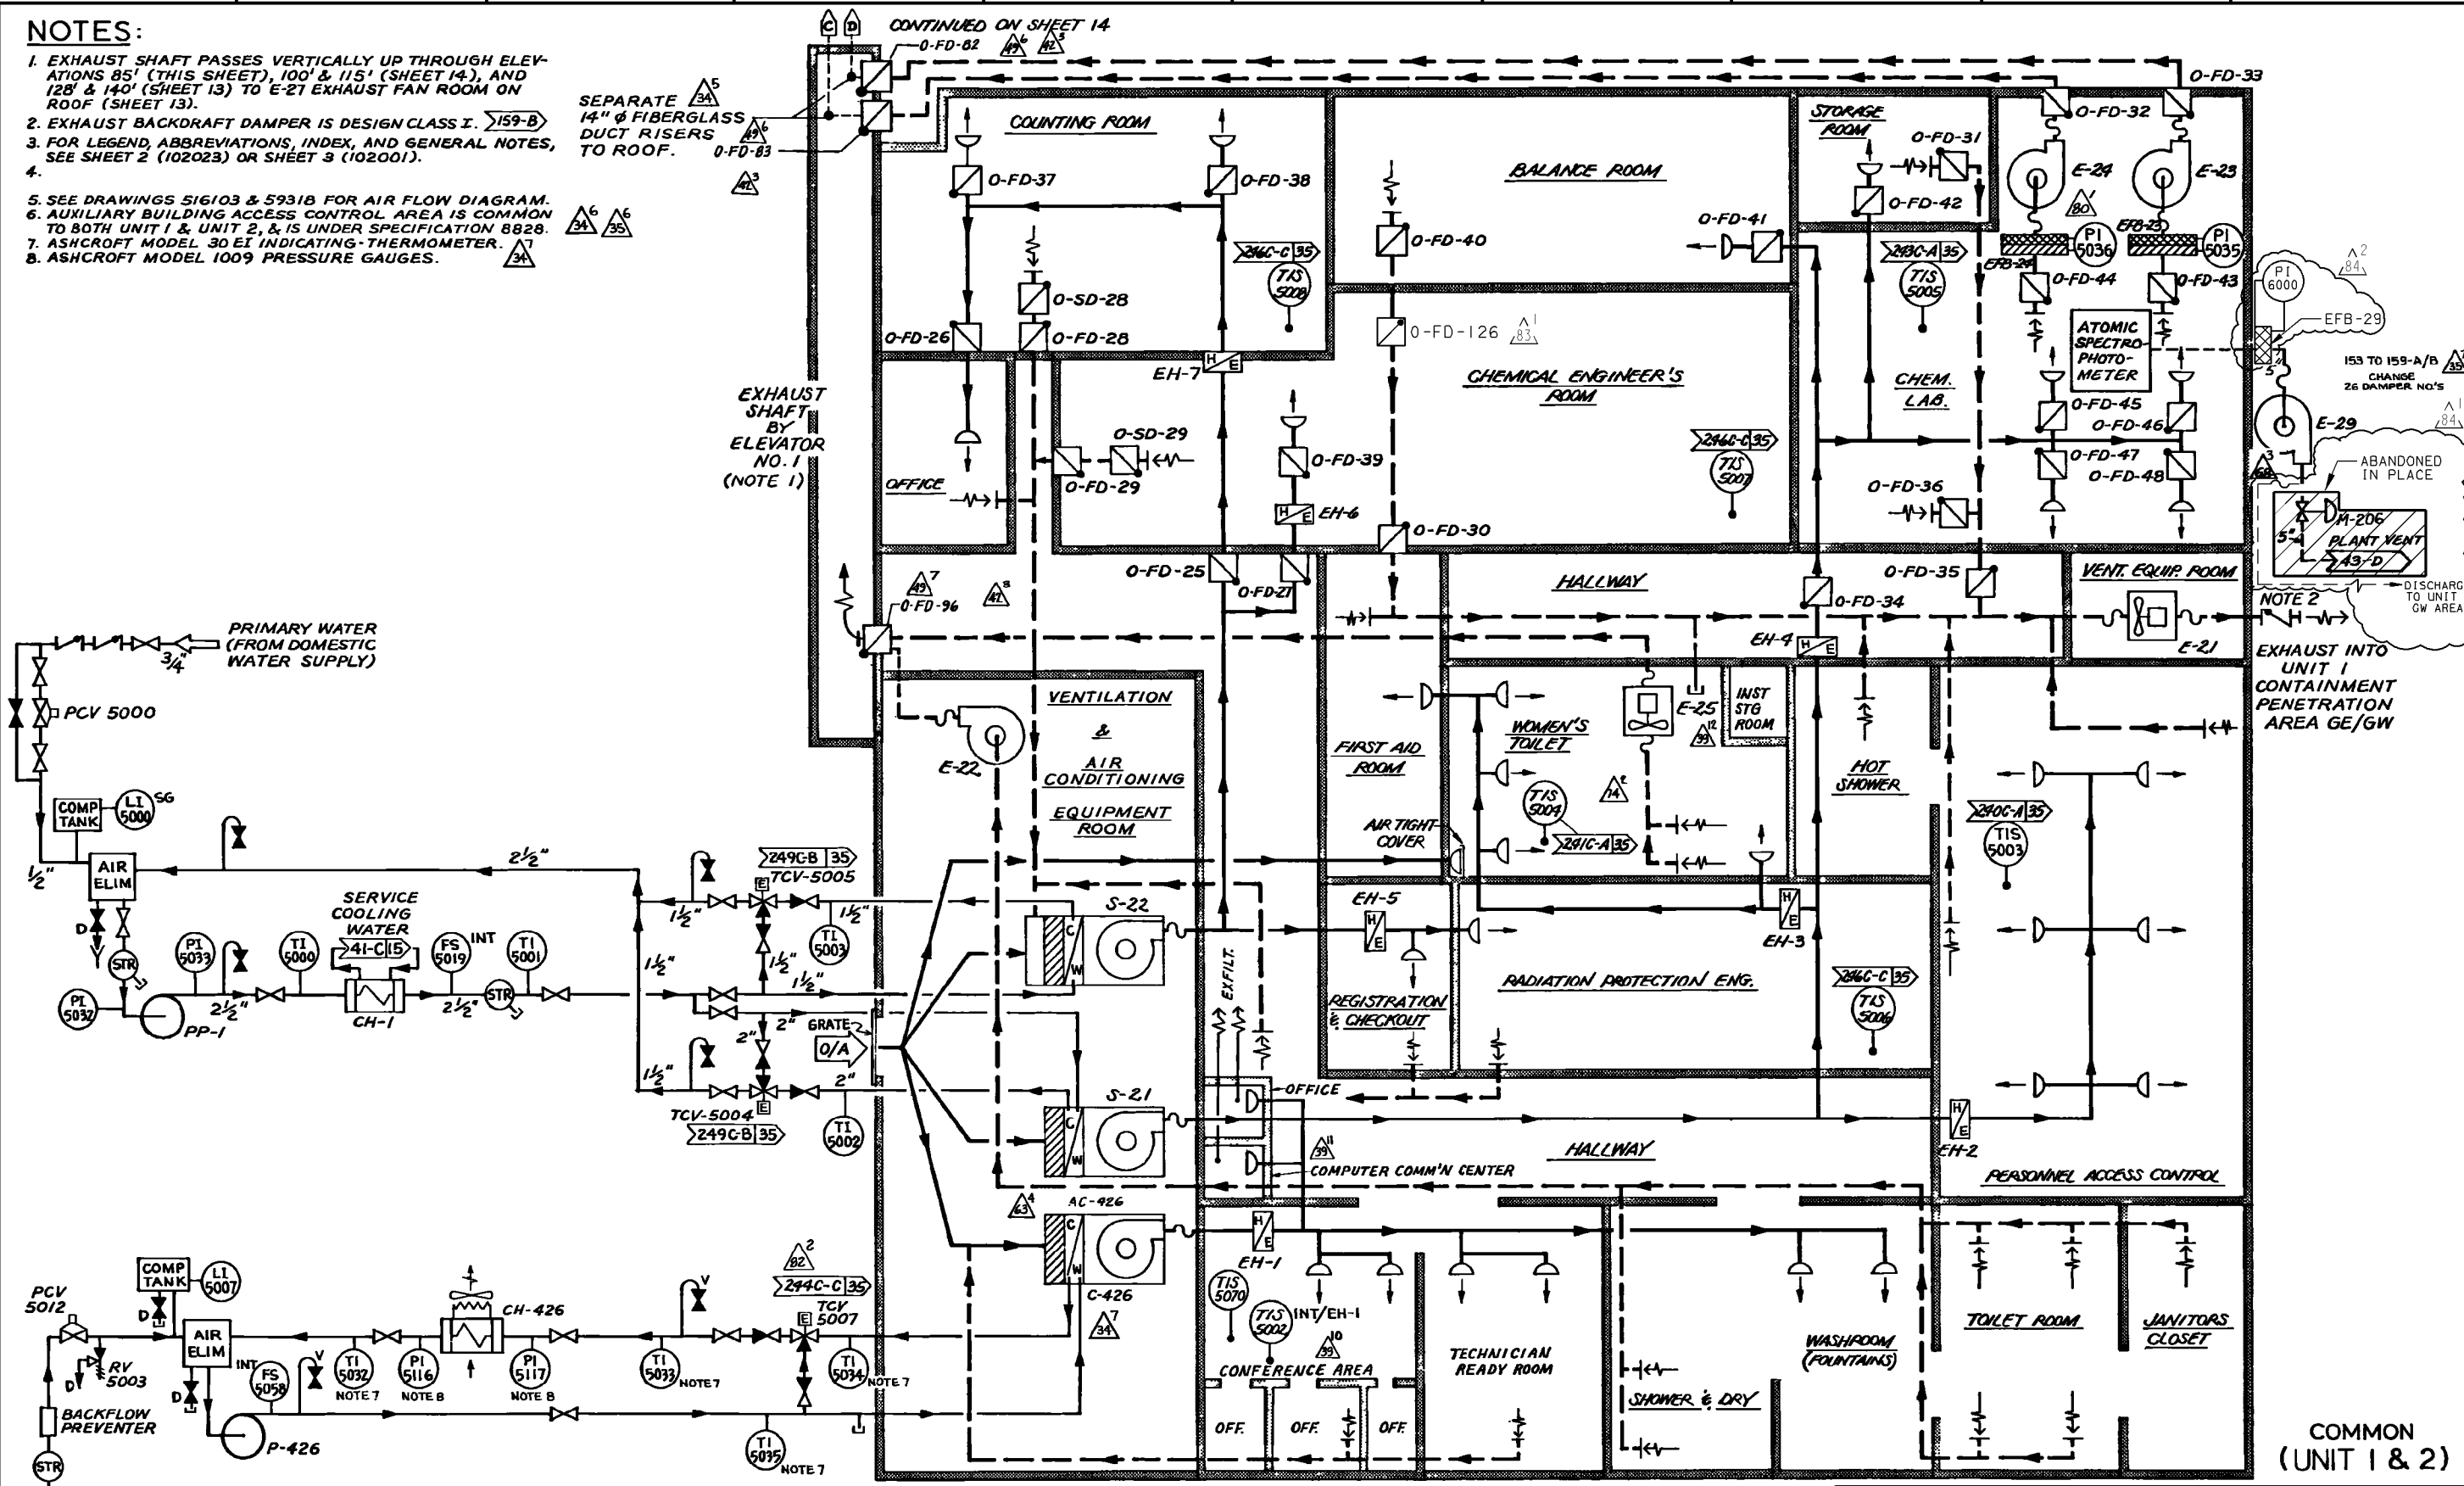

AUXILIARY BUILDING ACCESS CONTROL AREA (EL. 85'-0")


P G & E CO.		102023	REV. 84
SHEET 15	PAGE 0		

3/31/04	MIBF	FXC2	-	KERSI J. DALAL	MECHANICAL	M 16690	3/31/2006	Revised per FCT 025875-01
DATE	DWN	RE	IV	PROFESSIONAL ENGINEER	PE DISC.	PE#	PE EXP.	

CAD User: Date: 3-31-2004
DGN=2023SI5.DGN
RASTER=2023SI5.TIF

INPG2ND

170A | 171A | 172A | 173A | 174A | 175A | 176A | 177A | 178A | 179A

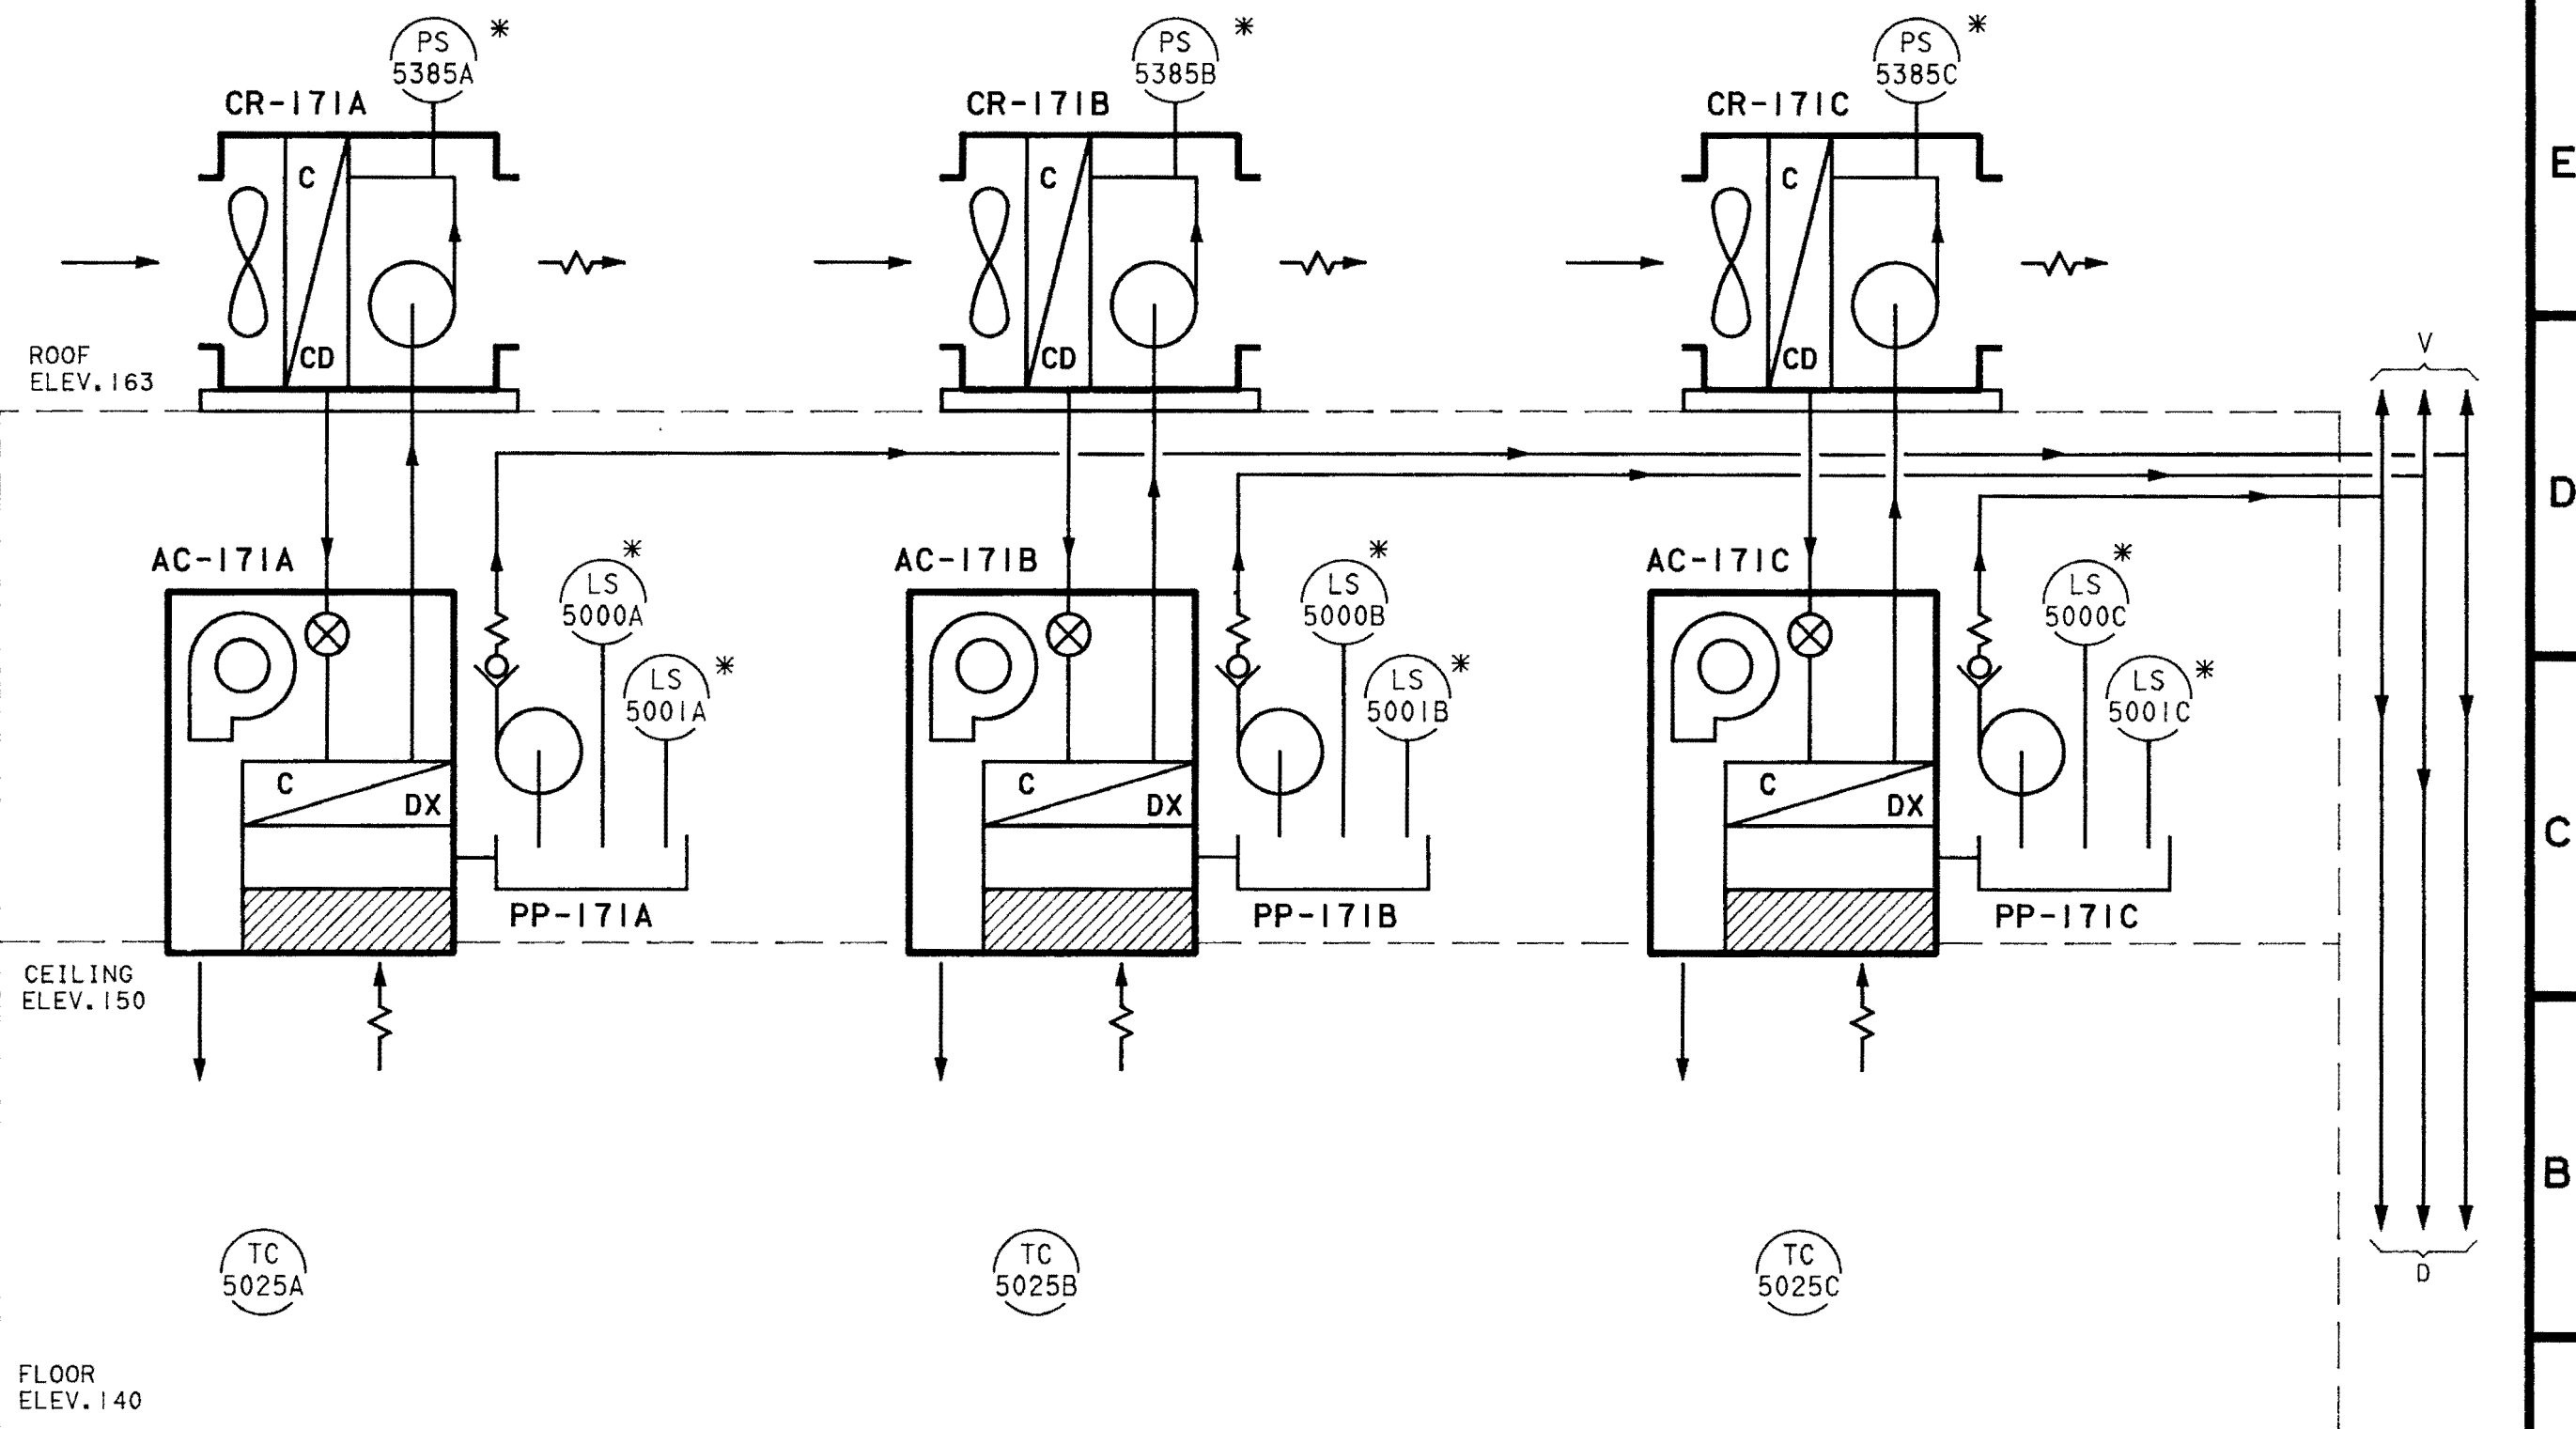

NOTE
1. COMPUTER ROOM IS LOCATED IN CONTROL ROOM
ON SHEET 17 AT 178-D/E

CONTROL ROOM COMPUTER ROOM (ELEVATION)

COMMON (UNIT 1&2)


2023S17A.M01 3-2-90 02:10 ROA

HP1SZSH2.FMT

P G & E CO.	102023	REV 48
SHEET 17A OF SHEETS	MICROFILM	

SCAN 48 IC

170B | 171B | 172B | 173B | 174B | 175B | 176B | 177B | 178B | 179B

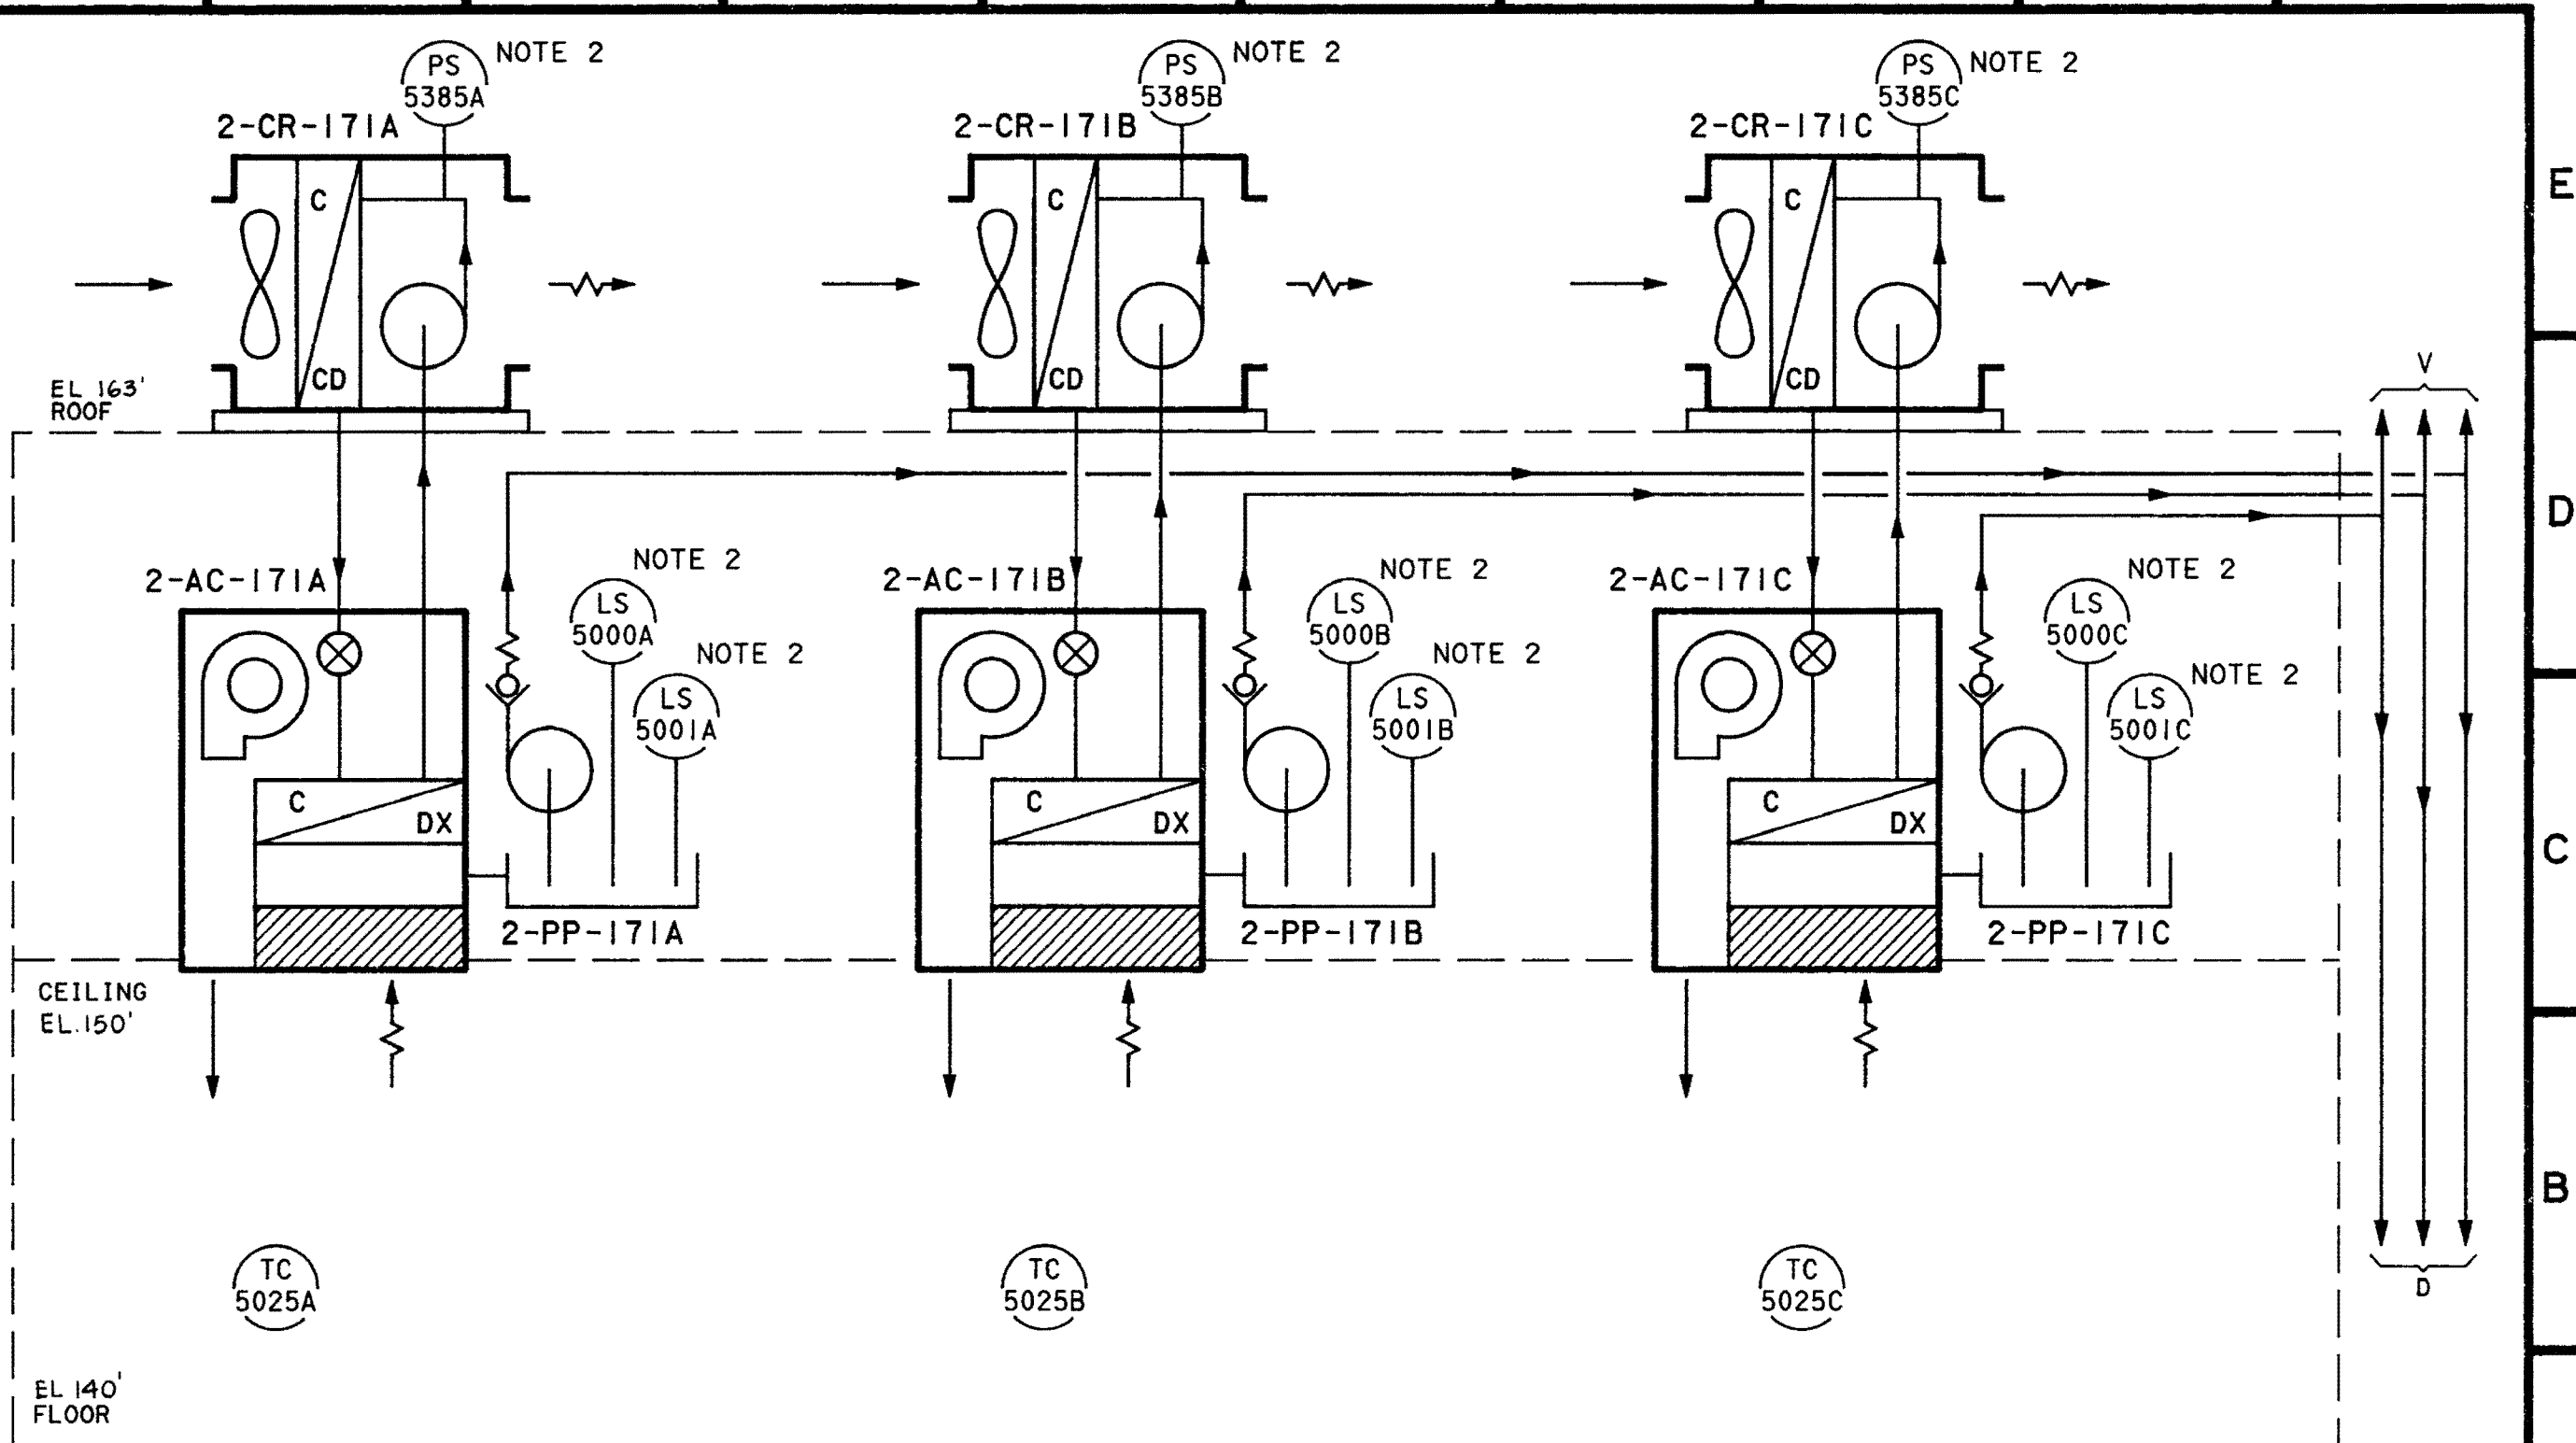

- NOTE
1. COMPUTER ROOM IS LOCATED IN CONTROL ROOM ON SHEET 16 AT 168-A/B
 2. INSTRUMENT INTEGRAL TO EQUIPMENT

2023S17B.M01 5-30-90 03:10 ROA

HP1SZSH2.FMT

CONTROL ROOM COMPUTER ROOM (ELEVATION)

4
50

P G & E CO.
SHEET 17B OF SHEETS

COMMON (UNIT 1&2)

102023 REV 50

MICROFILM

SCHEM 50 IC

A

B

C

D

E


A

B

C

D

E

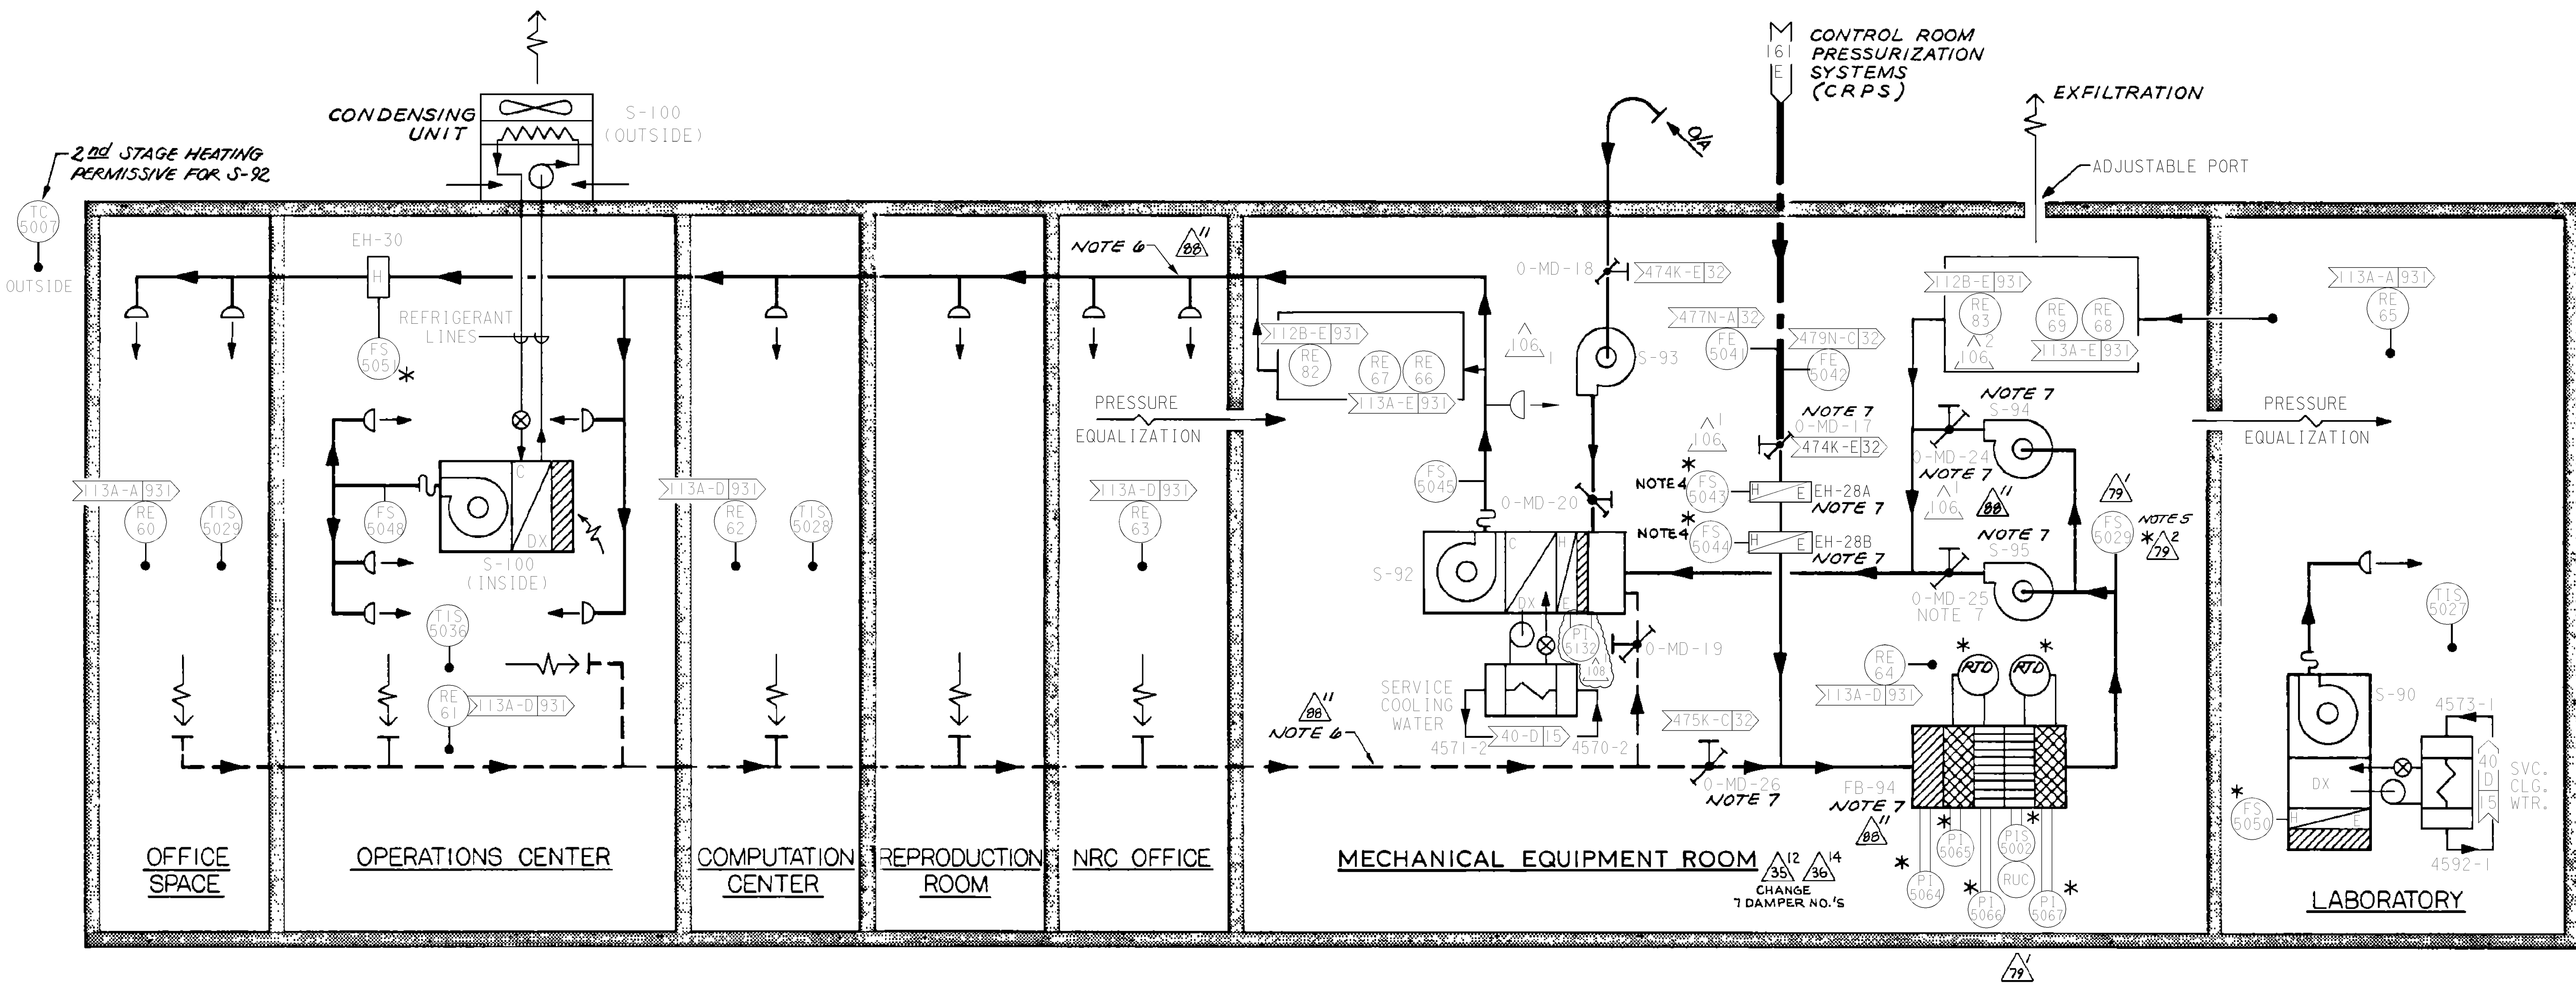

NOTES:

1. FOR LEGEND, ABBREVIATIONS, & GENERAL NOTES, SEE SHEET 2 (102023) OR SHEET 3 (102001).
2. SEE DRAWING 512904 FOR TECHNICAL SUPPORT CENTER FLOW DIAGRAM.
3. ABANDONED IN PLACE.
4. FLOW SWITCH FS-5029 OPERATES THE LOW FLOW ALARM.
5. DUCTWORK IS DESIGN CLASS II; DUCT AND DUCT SUPPORTS ARE QUALIFIED TO SEISMIC CLASS I CRITERIA.
6. EMERGENCY FILTRATION EQUIPMENT IS DESIGN CLASS II; SUPPORTS FOR EMERGENCY FILTRATION EQUIPMENT ARE ANALYZED TO SEISMIC CLASS I CRITERIA.


TECHNICAL SUPPORT CENTER HVACS
(COMMON AREA)
EL. 104'-0"

(UNITS 1 & 2)


P G & E CO.		102023	REV. 108
SHEET 19	PAGE 0		

4/10/04	MIBF	CDP3	-	KERSI J. DALAL	MECHANICAL	M 16690	3/31/2006	Revised per FCT 028099
DATE	DWN	RE	IV	PROFESSIONAL ENGINEER	PE DISC.	PE#	PE EXP.	

NOTE:
1. THE VENTILATION COAXIAL PIPE (VENT SHAFT EXTENSION)
IS DESIGN CLASS II, SEISMIC CATEGORY I (202-C)

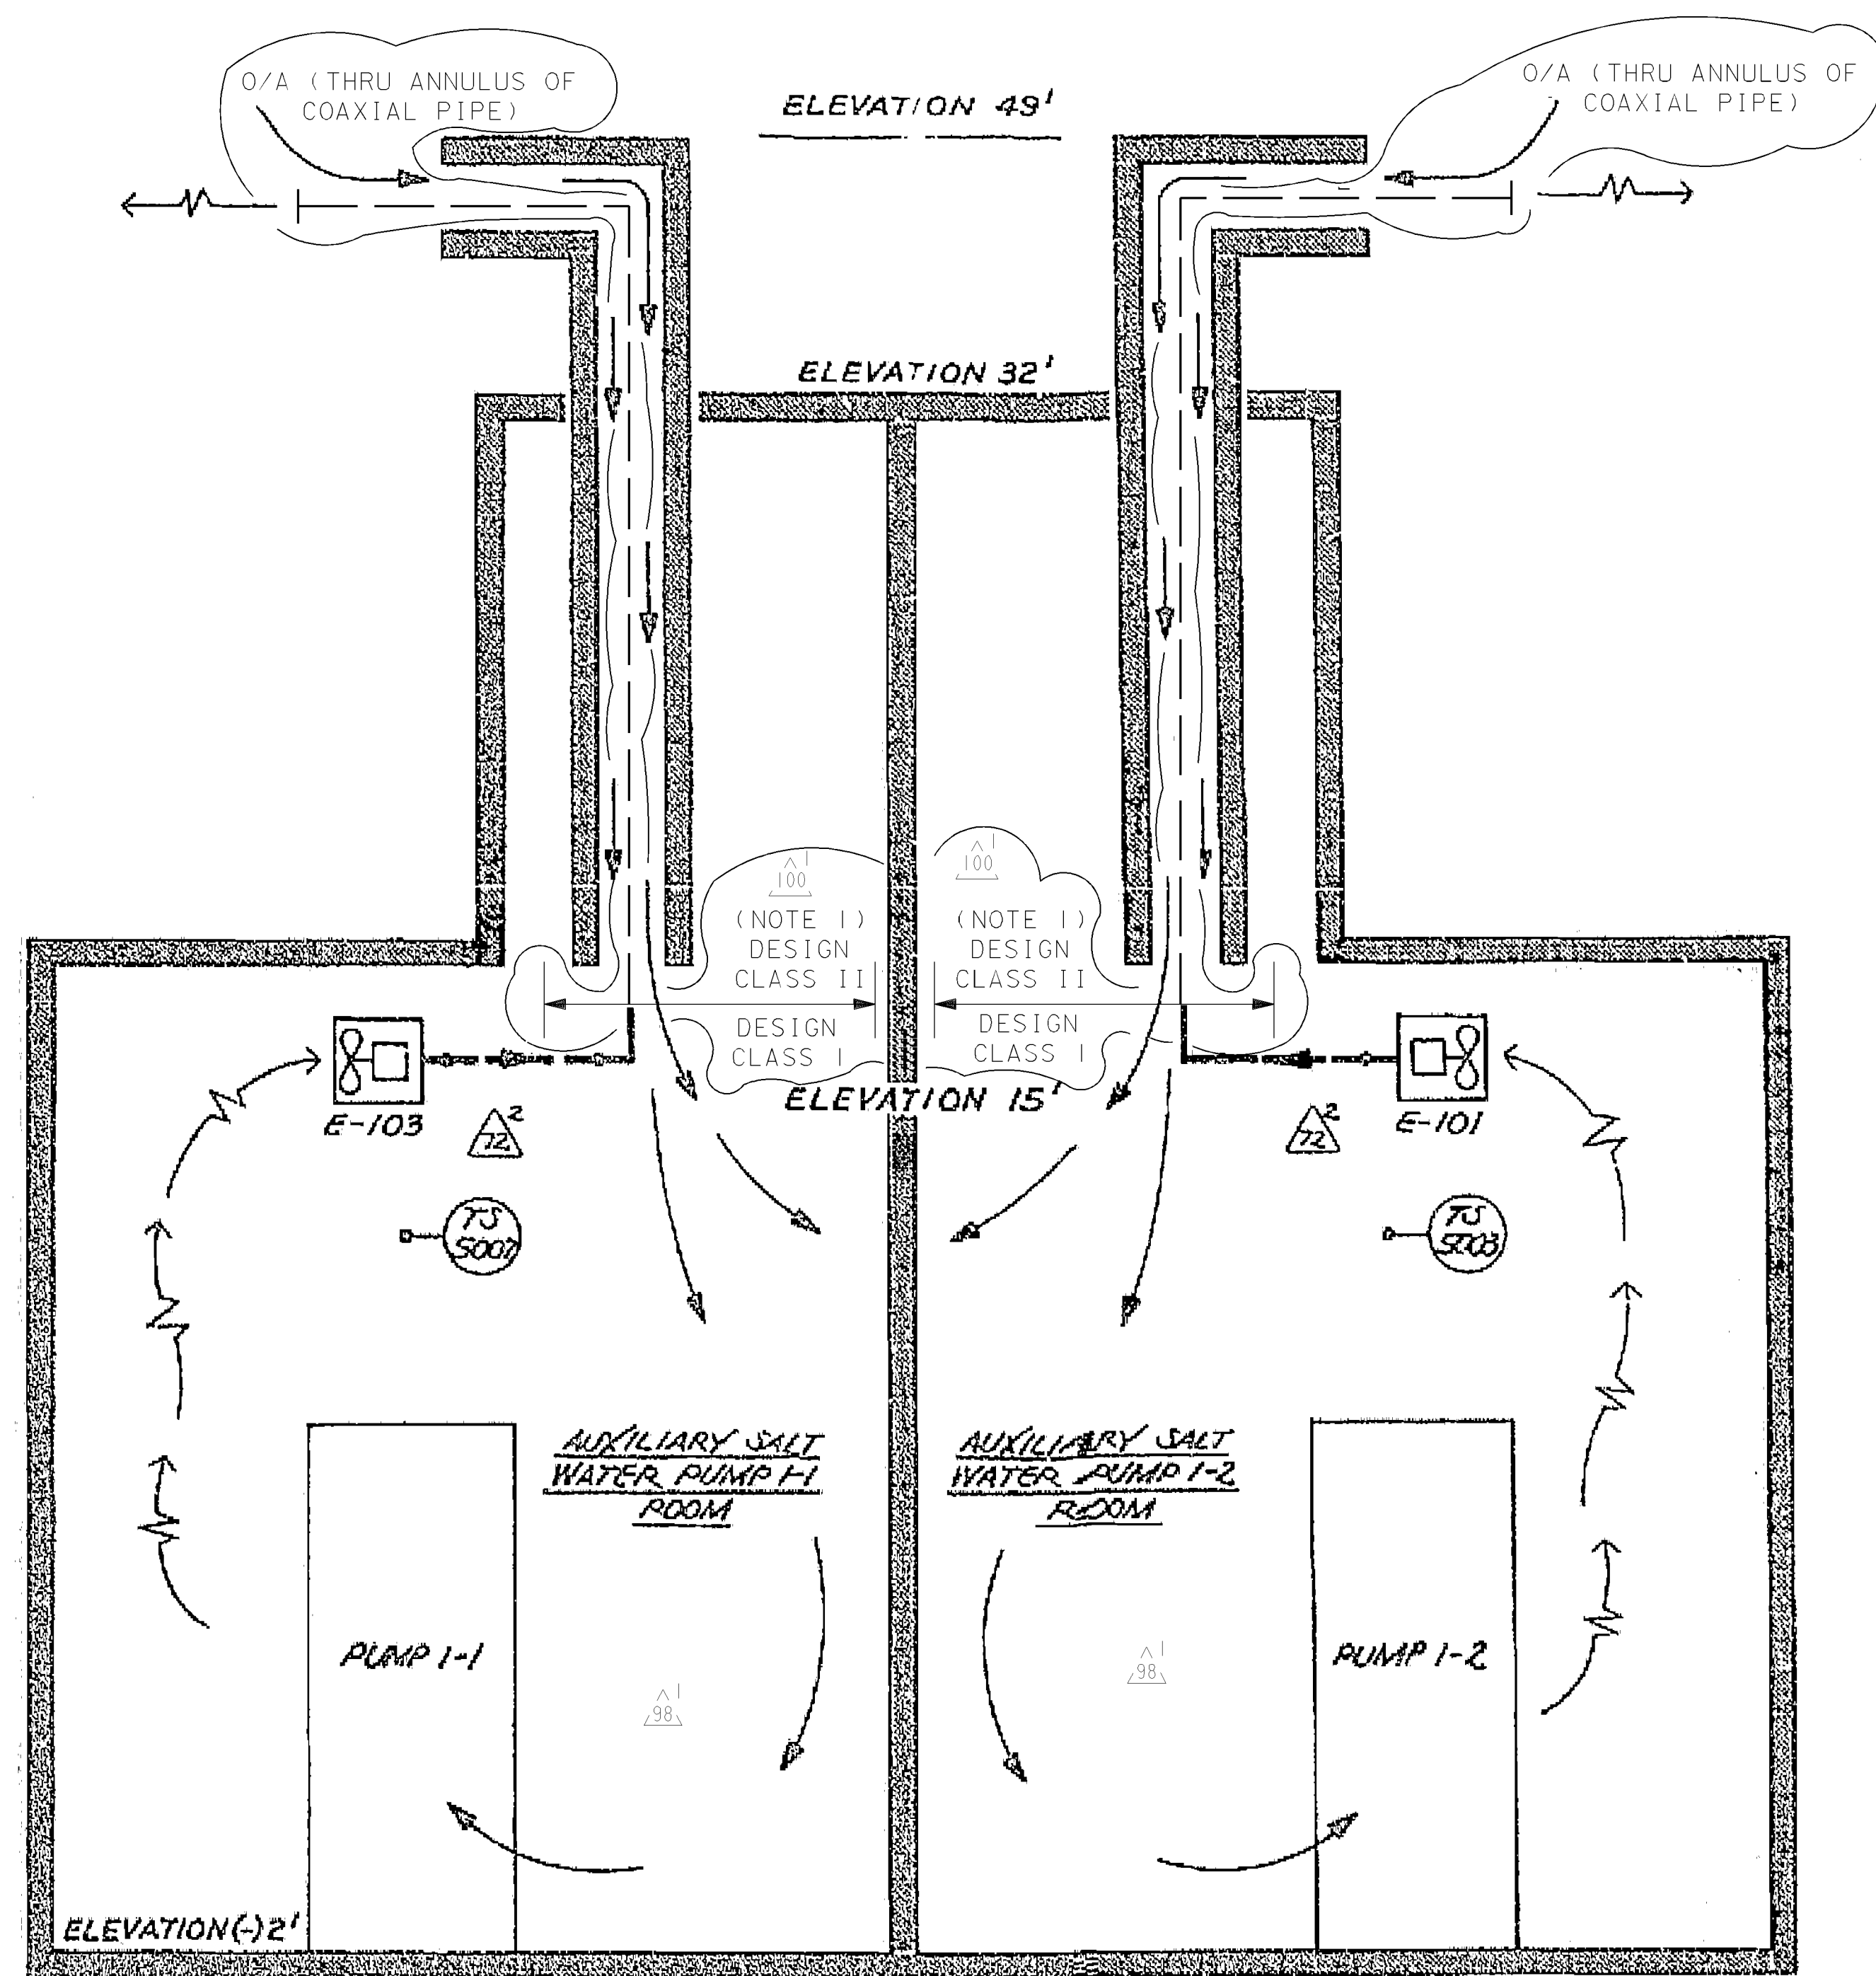


INTAKE STRUCTURE (UNIT 1)
AUXILIARY SALTWATER PUMP ROOM VENTILATION

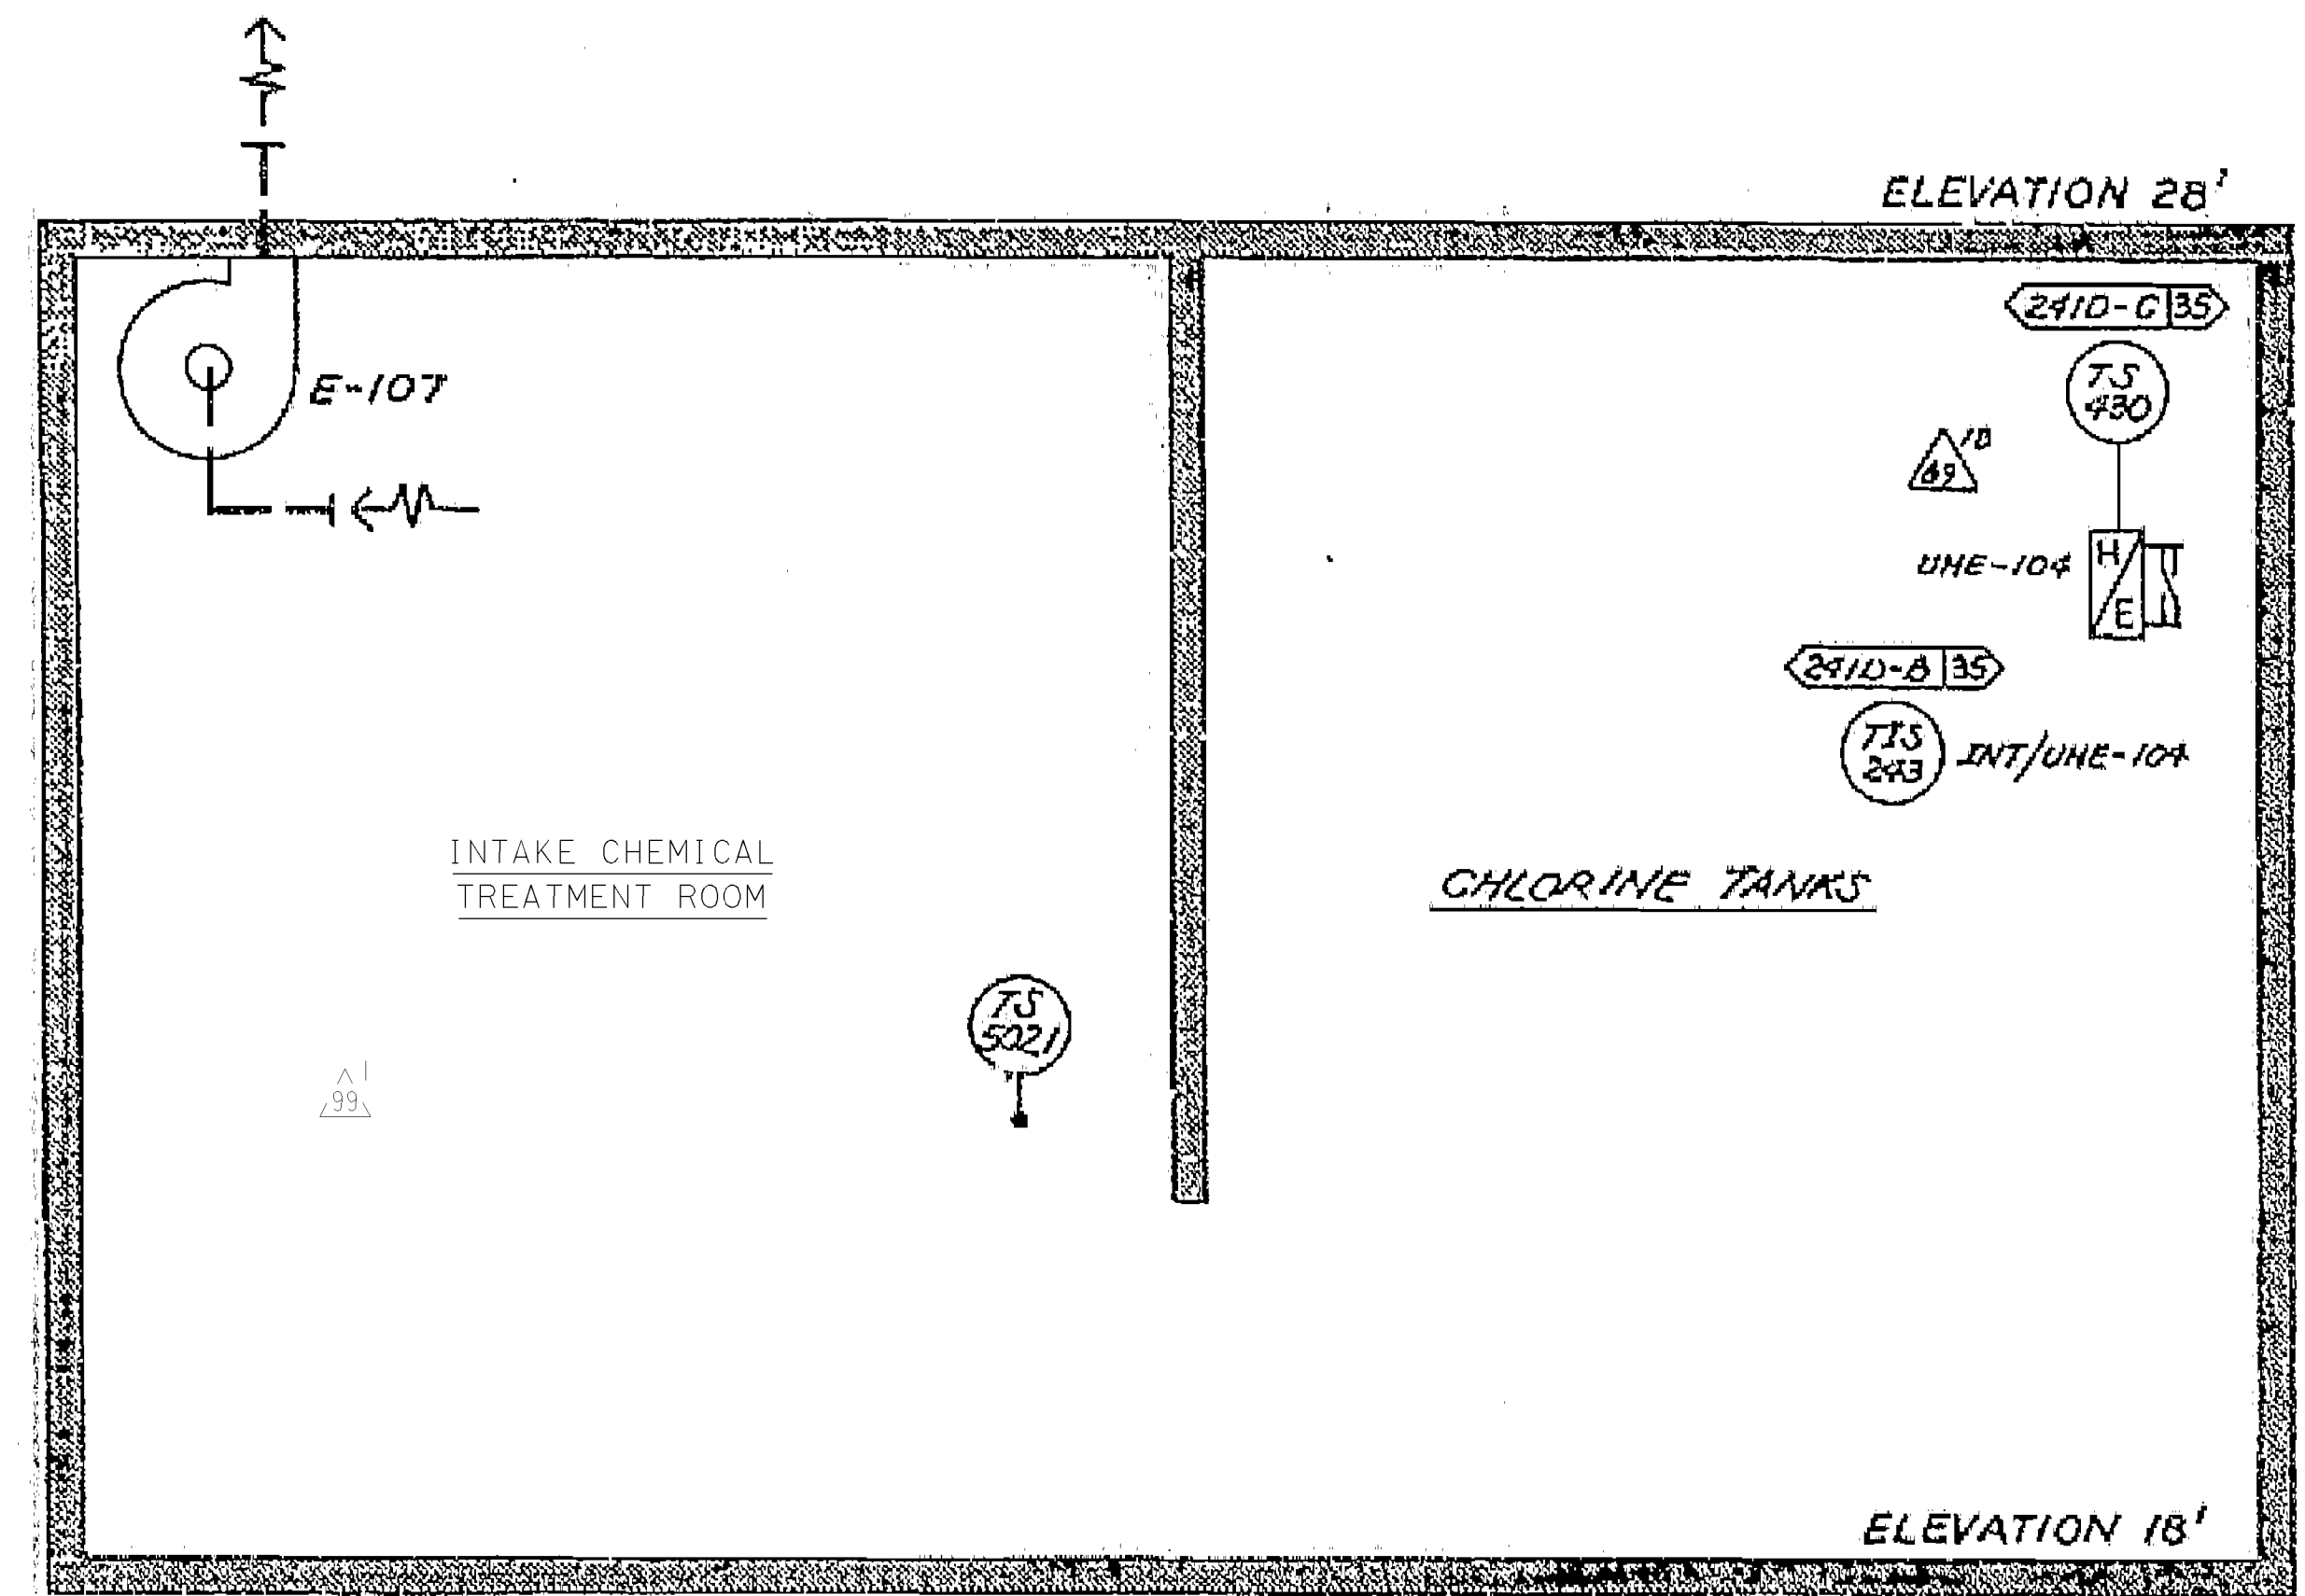


INTAKE STRUCTURE (COMMON-UNIT 1 & 2)
CHLORINATOR, EVAPORATOR, & CHLORINE TANKS ROOM
(ELEVATION 18'-0")

P G & E CO.	102023	REV.
SHEET 20 OF SHEETS		100

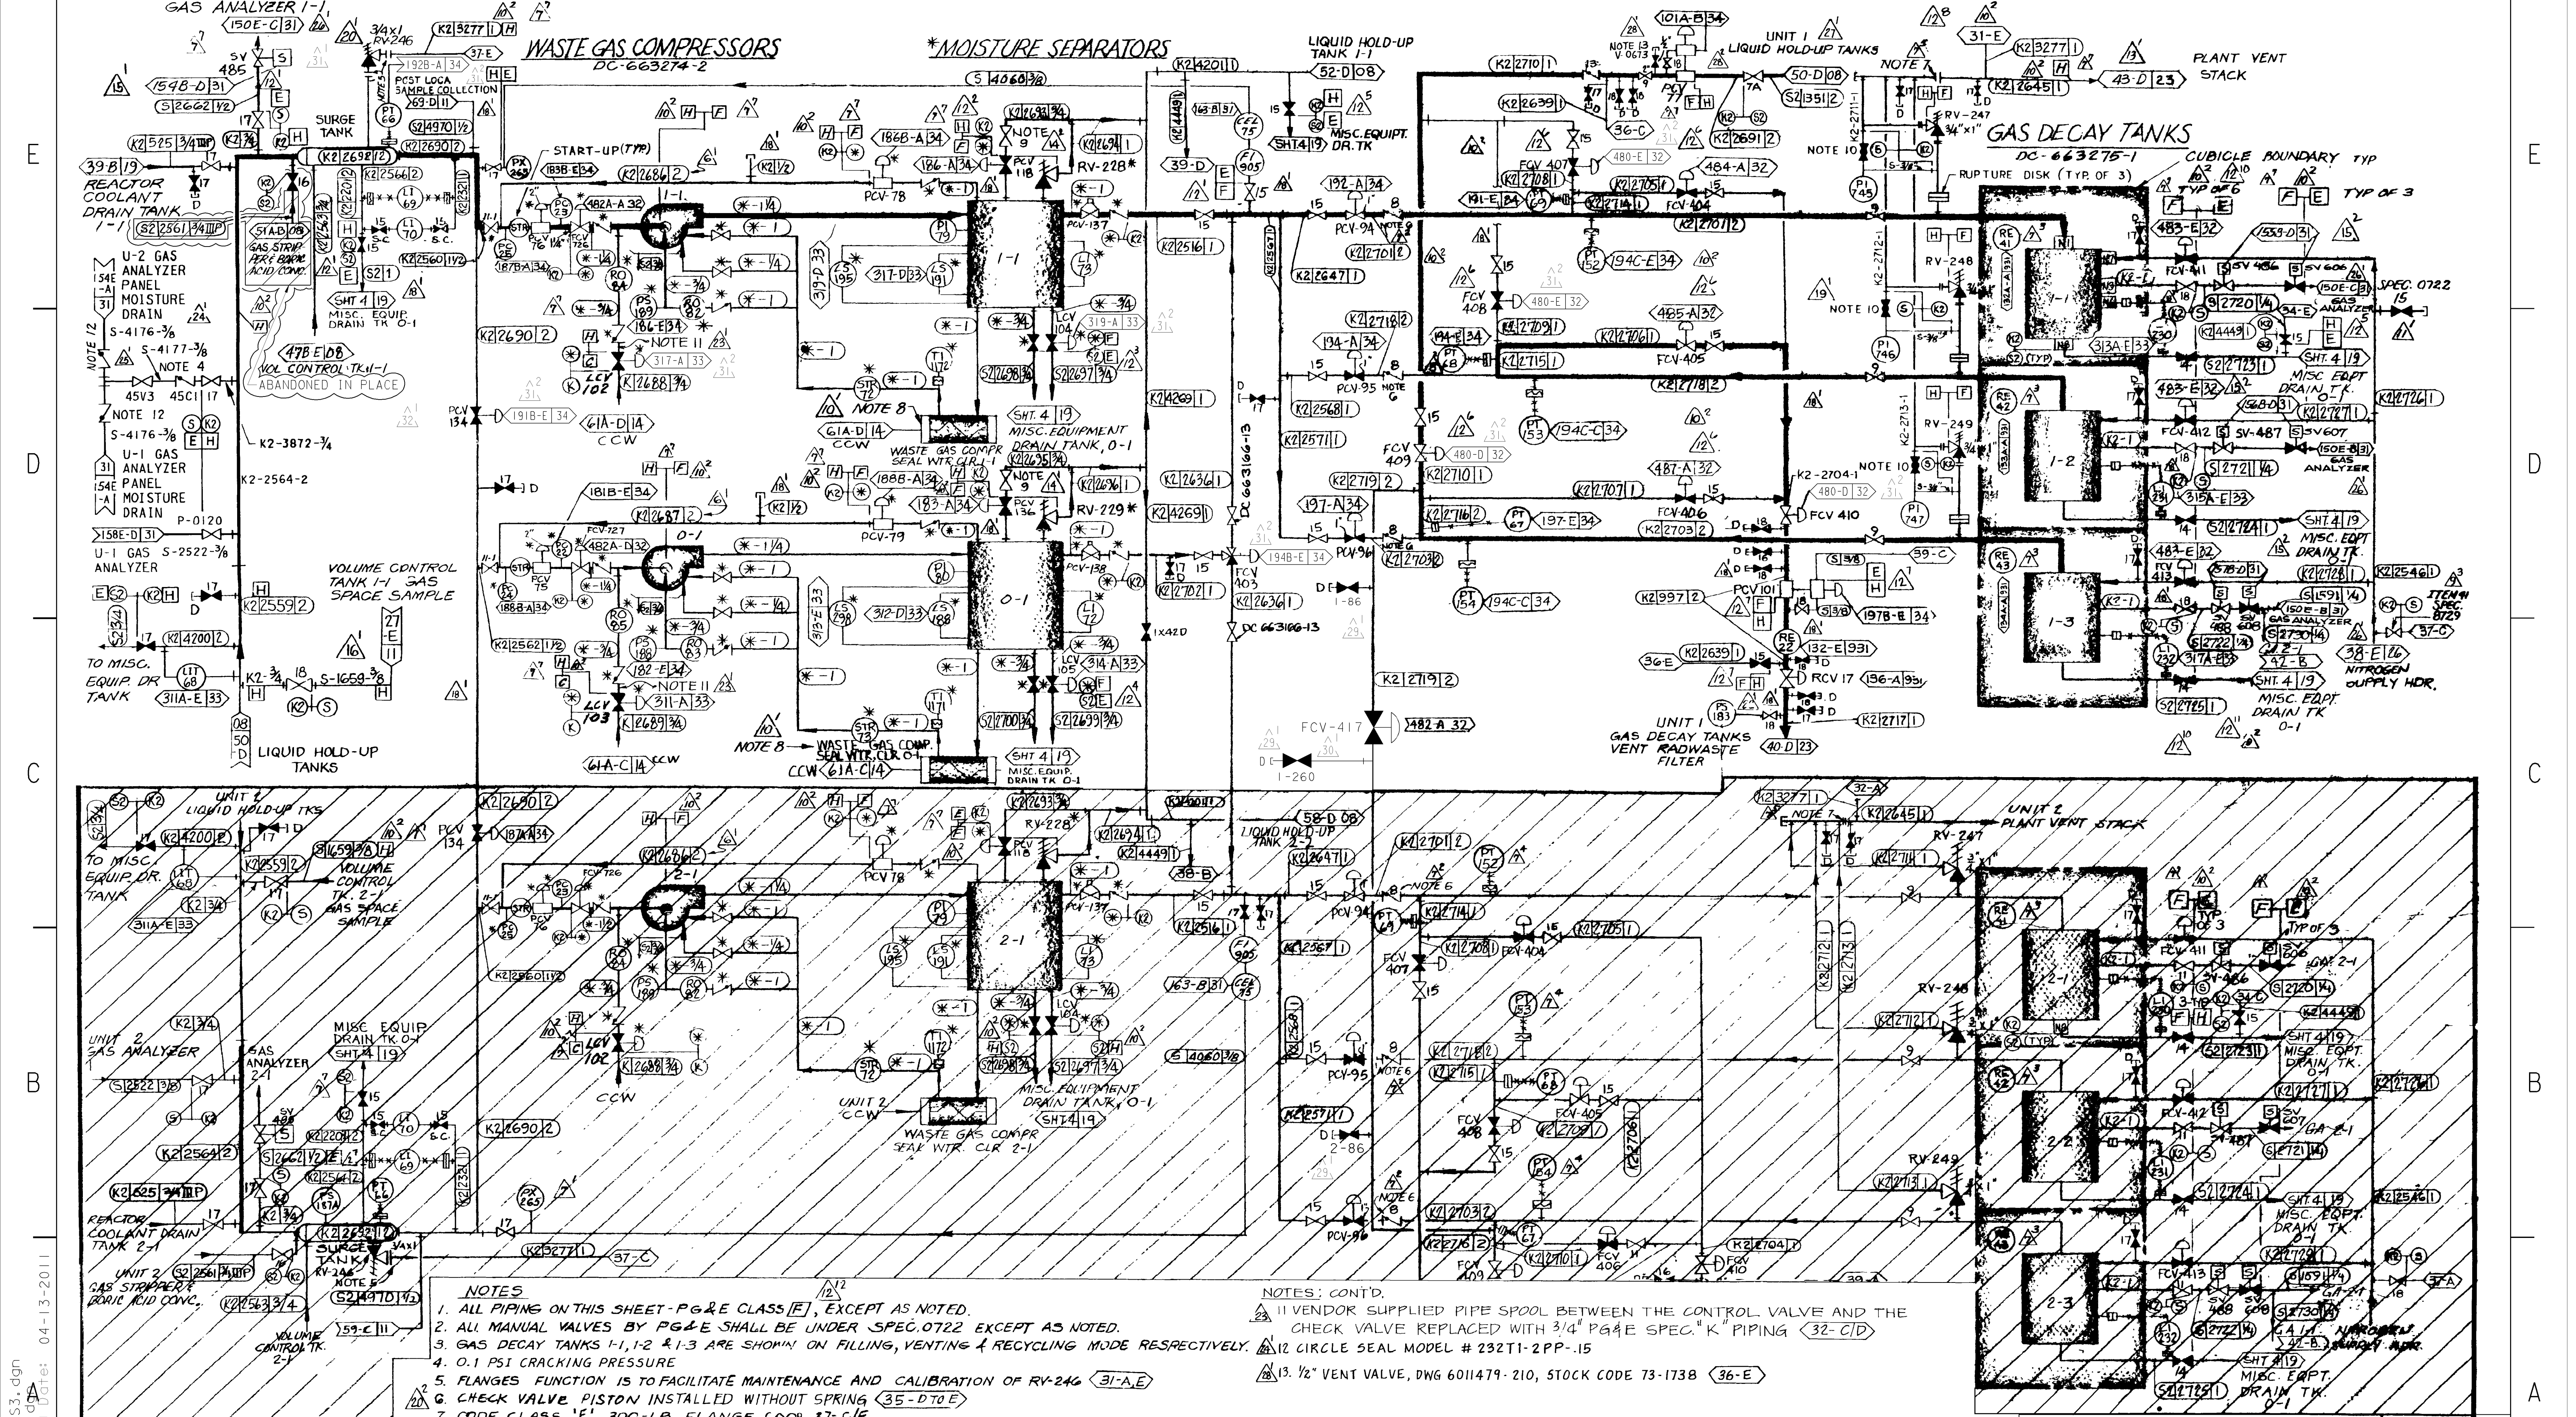

- NOTES
1. ALL PIPING ON THIS SHEET-PG&E CLASS **E**, EXCEPT AS NOTED.
 2. ALL MANUAL VALVES BY PG&E SHALL BE UNDER SPEC.0722 EXCEPT AS NOTED.
 3. GAS DECAY TANKS 1-1, 1-2 & 1-3 ARE SHOWN ON FILLING, VENTING & RECYCLING MODE RESPECTIVELY.
 4. 0.1 PSI CRACKING PRESSURE
 5. FLANGES FUNCTION IS TO FACILITATE MAINTENANCE AND CALIBRATION OF RV-246 **31-A,E**
 6. CHECK VALVE PISTON INSTALLED WITHOUT SPRING **35-DT0E**
 7. CODE CLASS 'E', 300-LB FLANGE COOR 37-C/E
 8. WASTE GAS COMPRESSOR SEAL WATER COOLERS ARE DESIGN CLASS II AND ARE SEISMICALLY ANALYZED IN ACCORDANCE WITH DESIGN CRITERIA MEMORANDUM M-61.
 9. 3/4" Ø GRINNELL DIAPHRAGM VALVE C.S FIG. 2472-B13 M. (4R-71229) **33-DE** **4**
 10. NUPRO VALVE MODEL SS-DLTW6 **37-DE**

- NOTES: CONT'D.
- 11. VENDOR SUPPLIED PIPE SPOOL BETWEEN THE CONTROL VALVE AND THE CHECK VALVE REPLACED WITH 3/4" PG&E SPEC."K" PIPING **32-C/D**
 - 12. CIRCLE SEAL MODEL # 232T1-2PP-.15
 - 13. 1/2" VENT VALVE, DWG 6011479-210, STOCK CODE 73-1738 **36-E**

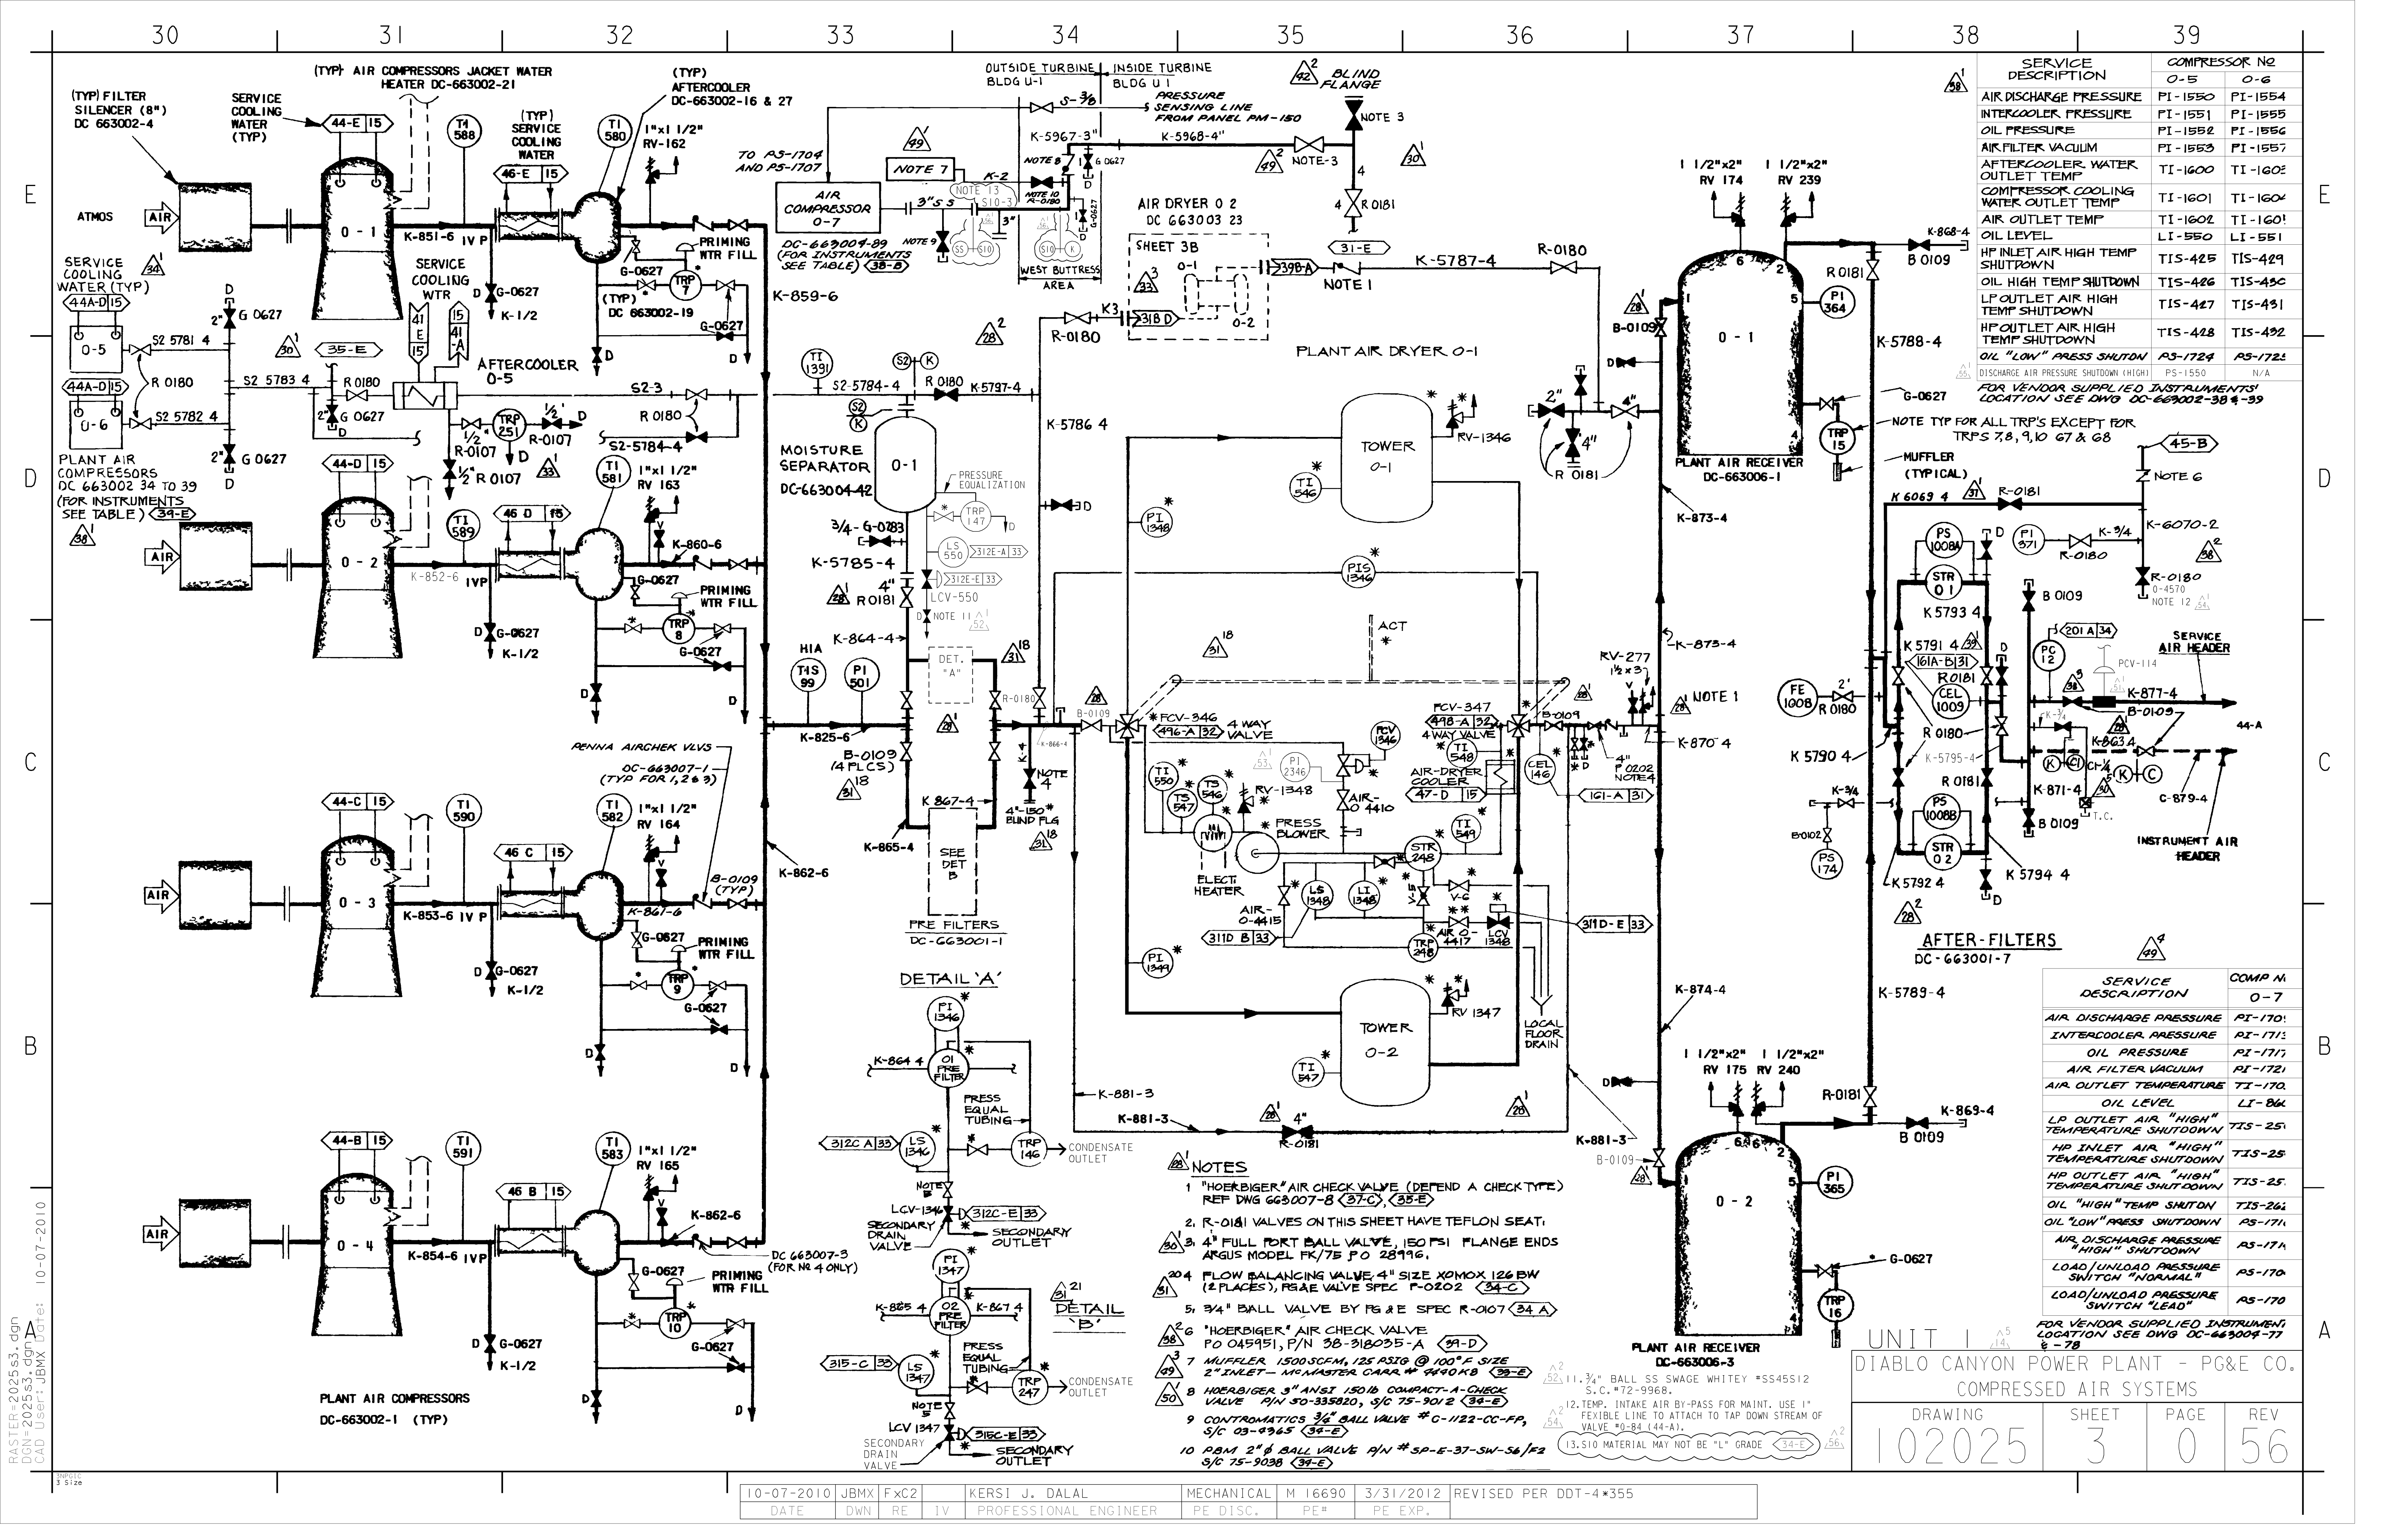

SERVICE DESCRIPTION	COMPRESSOR NO	
	0-5	0-6
AIR DISCHARGE PRESSURE	PI-1550	PI-1554
INTERCOOLER PRESSURE	PI-1551	PI-1555
OIL PRESSURE	PI-1552	PI-1556
AIR FILTER VACUUM	PI-1553	PI-1557
AFTERCOOLER WATER OUTLET TEMP	TI-1600	TI-1602
COMPRESSOR COOLING WATER OUTLET TEMP	TI-1601	TI-1604
AIR OUTLET TEMP	TI-1602	TI-1604
OIL LEVEL	LI-550	LI-551
HP INLET AIR HIGH TEMP SHUTDOWN	TIS-425	TIS-429
OIL HIGH TEMP SHUTDOWN	TIS-426	TIS-430
LP OUTLET AIR HIGH TEMP SHUTDOWN	TIS-427	TIS-431
HP OUTLET AIR HIGH TEMP SHUTDOWN	TIS-428	TIS-432
OIL "LOW" PRESS SHUTDOWN	PS-1724	PS-1725
DISCHARGE AIR PRESSURE SHUTDOWN (HIGH)	PS-1550	N/A

FOR VENDOR SUPPLIED INSTRUMENTS LOCATION SEE DWG DC-663002-38 & 39

NOTE TYP FOR ALL TRP'S EXCEPT FOR TRP'S 7, 8, 9, 10, 67 & 68

MUFFLER (TYPICAL)

NOTE 6

PCV-114

PCV-114


PCV-114

PCV-114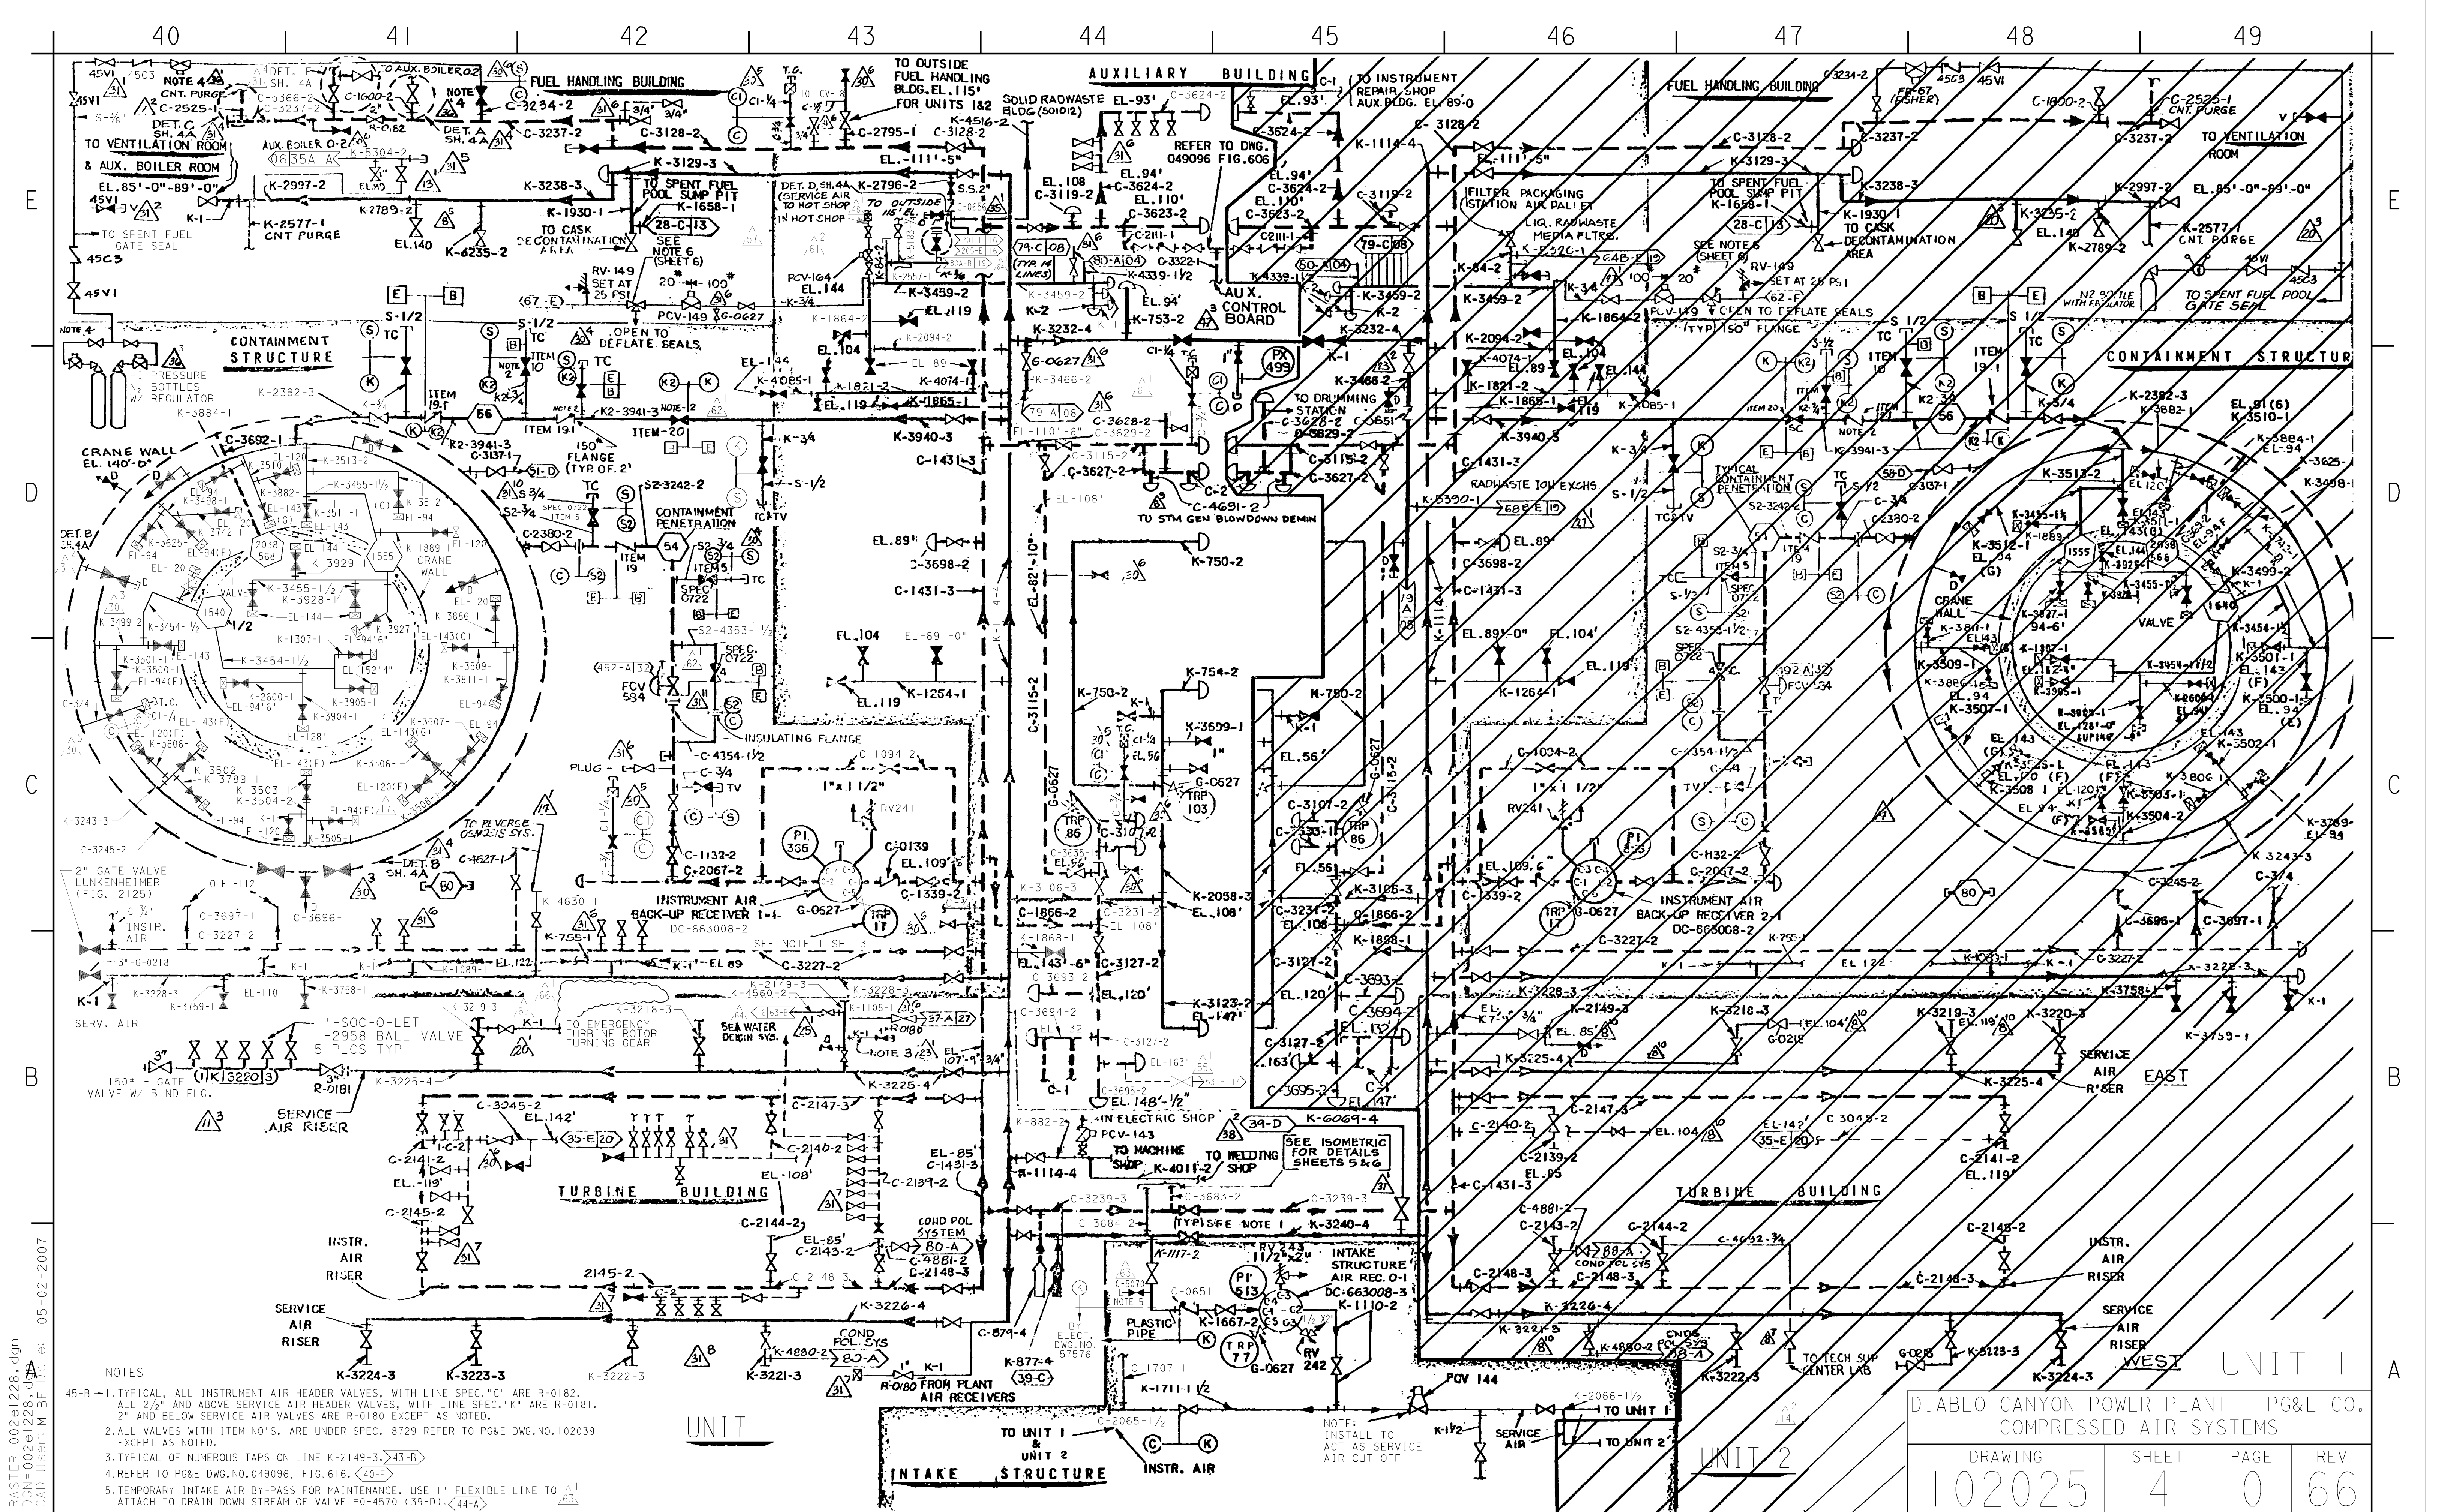

RASTER=002e1228.dgn
DGN=002e1228.dgn
CAD User=MIBF Date: 05-02-2007

NOTES
45-B-1, TYPICAL, ALL INSTRUMENT AIR HEADER VALVES, WITH LINE SPEC. "C" ARE R-0182.
ALL 2 1/2" AND ABOVE SERVICE AIR HEADER VALVES, WITH LINE SPEC. "K" ARE R-0181.
2" AND BELOW SERVICE AIR VALVES ARE R-0180 EXCEPT AS NOTED.
2. ALL VALVES WITH ITEM NO'S. ARE UNDER SPEC. 8729 REFER TO PG&E DWG. NO. 102039 EXCEPT AS NOTED.
3. TYPICAL OF NUMEROUS TAPS ON LINE K-2149-3. 43-B
4. REFER TO PG&E DWG. NO. 049096, FIG. 616. 40-E
5. TEMPORARY INTAKE AIR BY-PASS FOR MAINTENANCE. USE 1" FLEXIBLE LINE TO ATTACH TO DRAIN DOWN STREAM OF VALVE #0-4570 (39-D). 44-A

05-02-2007	MIBF	FxC2	KERSI J. DALAL	MECHANICAL	M 16690	3/31/2008	REVISED PER FCT-32137
DATE	DWN	RE	PROFESSIONAL ENGINEER	PE DISC.	PE#	PE EXP.	

DIABLO CANYON POWER PLANT - PG&E CO. COMPRESSED AIR SYSTEMS			
DRAWING	SHEET	PAGE	REV
102025	4	0	66

CAD User: MIBF Date: 5-11-2004
DGN=002E1226.DGN
RASTER=002E1226.TIF

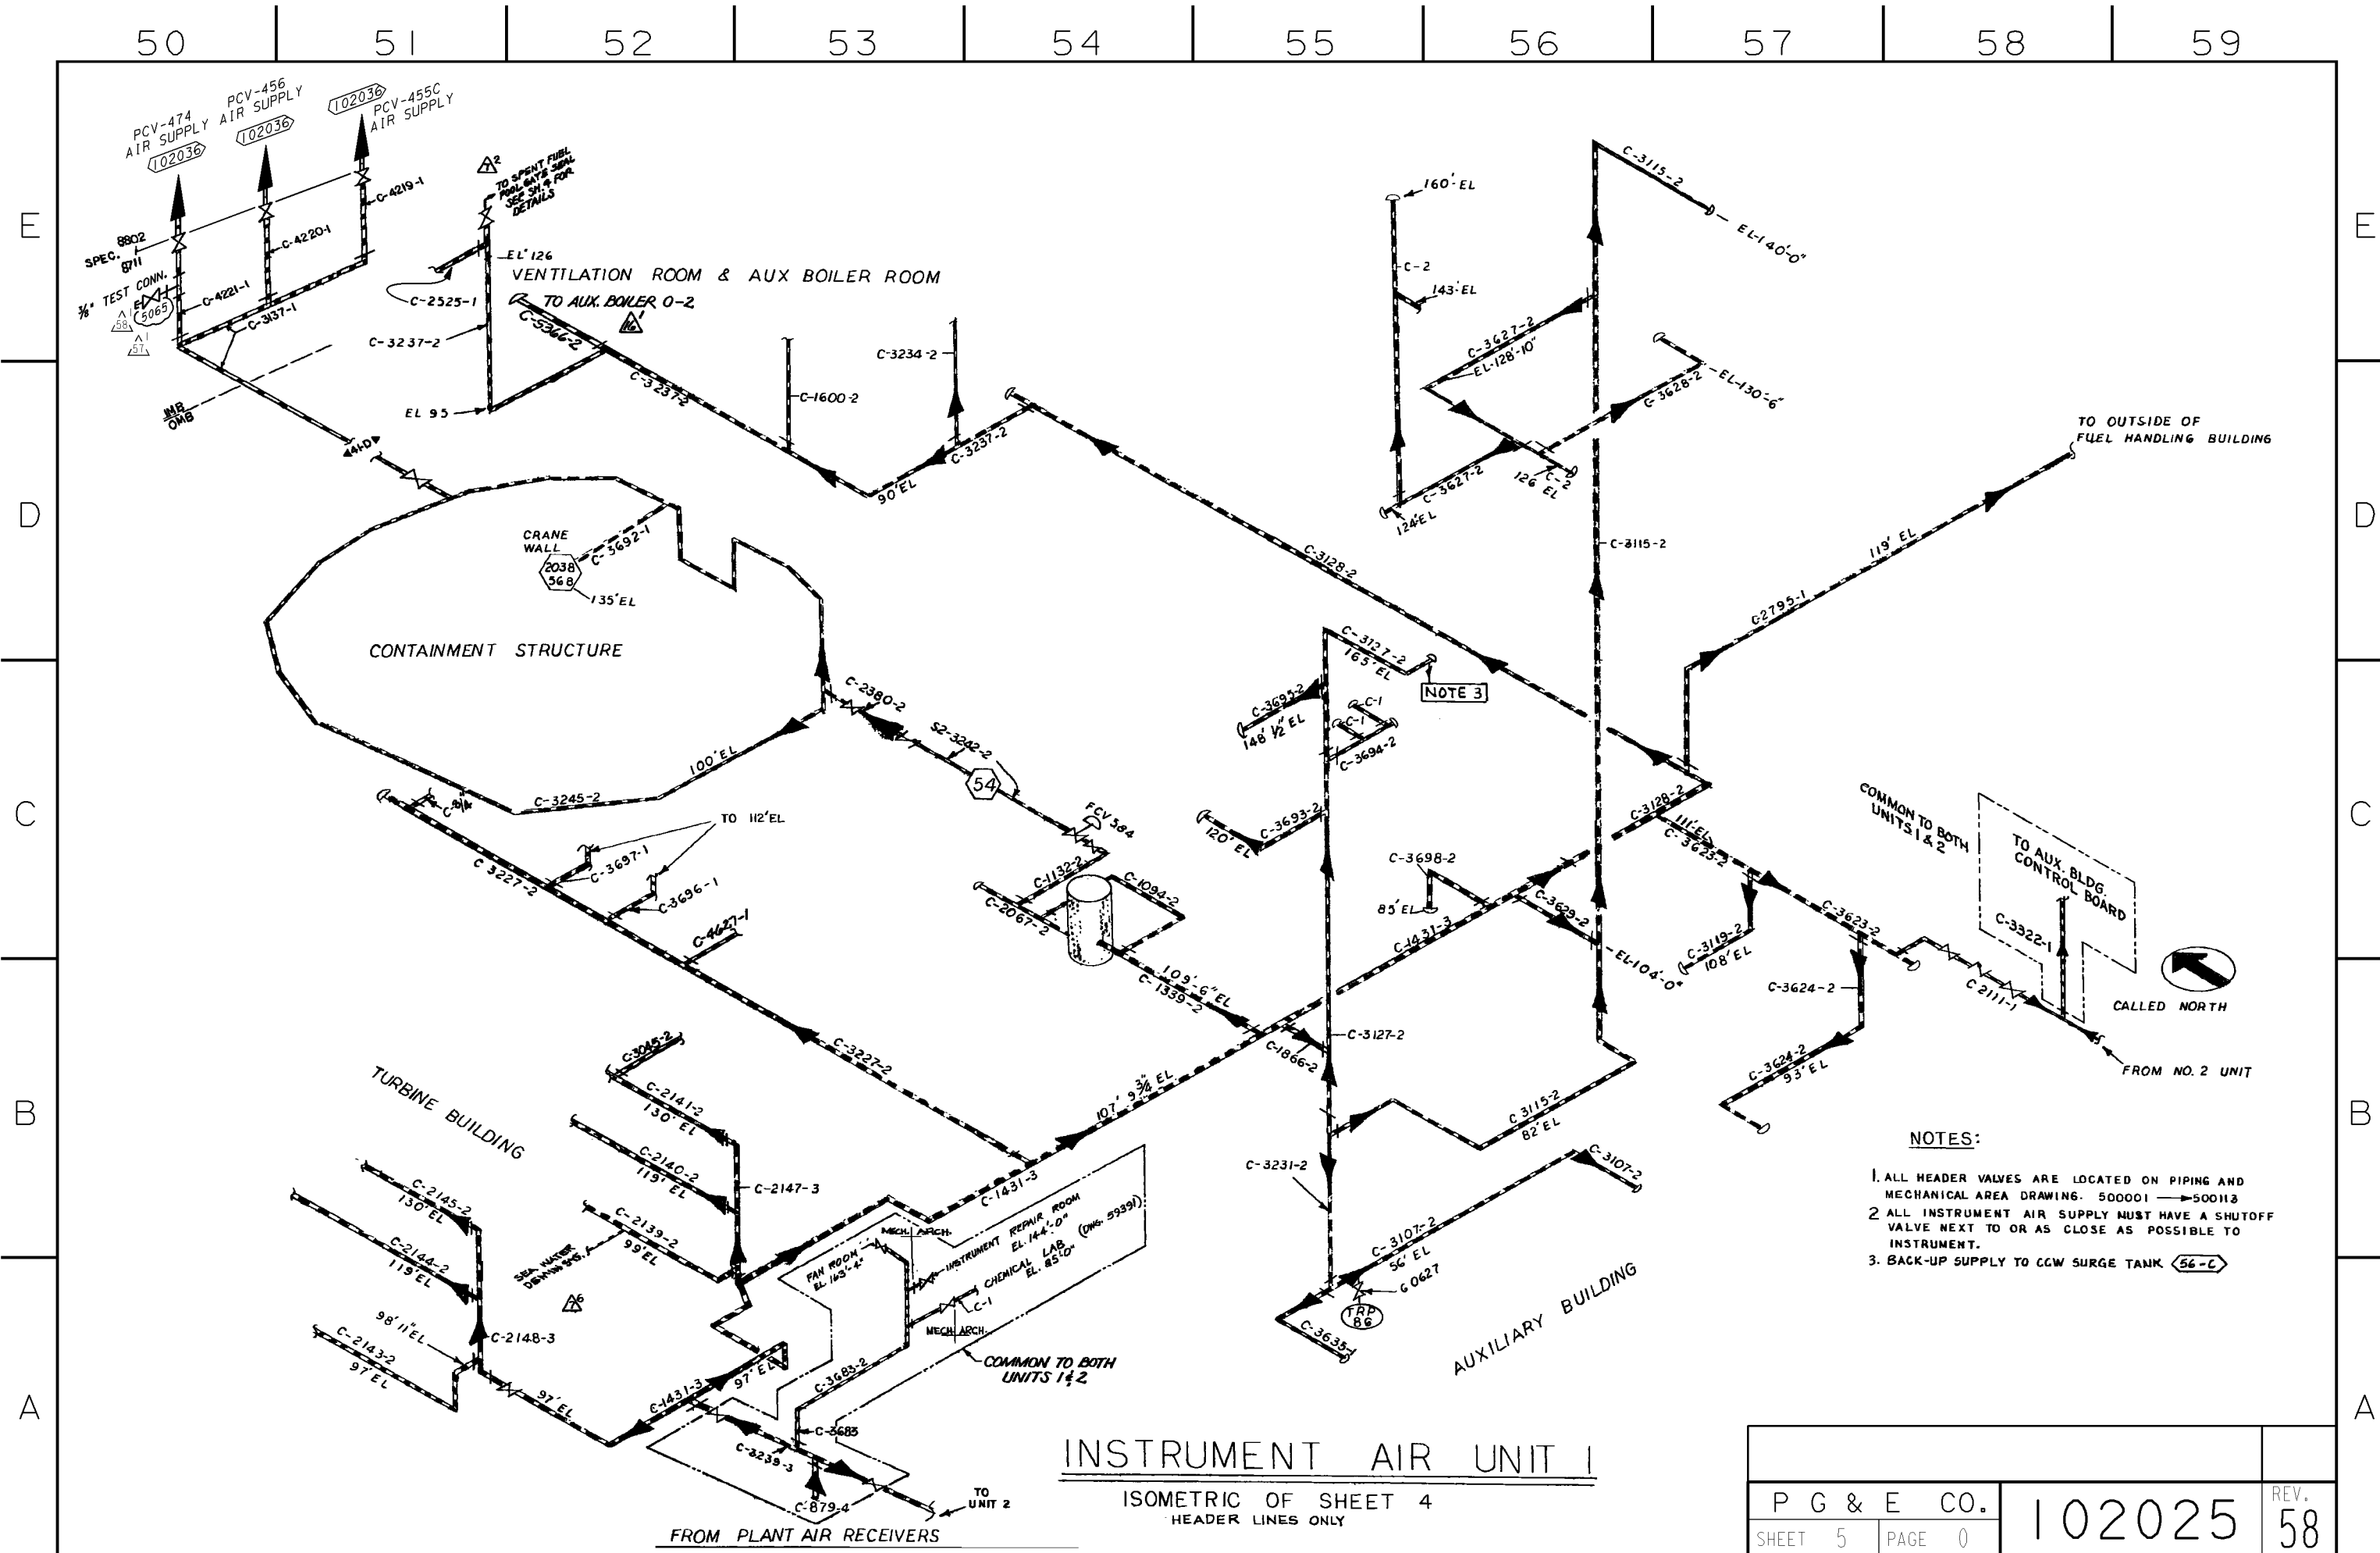

NOTES:


1. ALL HEADER VALVES ARE LOCATED ON PIPING AND MECHANICAL AREA DRAWING. 500001 - 500113
2. ALL INSTRUMENT AIR SUPPLY MUST HAVE A SHUTOFF VALVE NEXT TO OR AS CLOSE AS POSSIBLE TO INSTRUMENT.
3. BACK-UP SUPPLY TO CGW SURGE TANK (56-C)

INSTRUMENT AIR UNIT 1

ISOMETRIC OF SHEET 4
HEADER LINES ONLY

P G & E CO.		102025	REV. 58
SHEET 5	PAGE 0		

5/12/04	MIBF	LAL3	-	KERSI J. DALAL	MECHANICAL	M 16690	3/31/2006	Revised per FCT 028740
DATE	DWN	RE	IV	PROFESSIONAL ENGINEER	PE DISC.	PE#	PE EXP.	

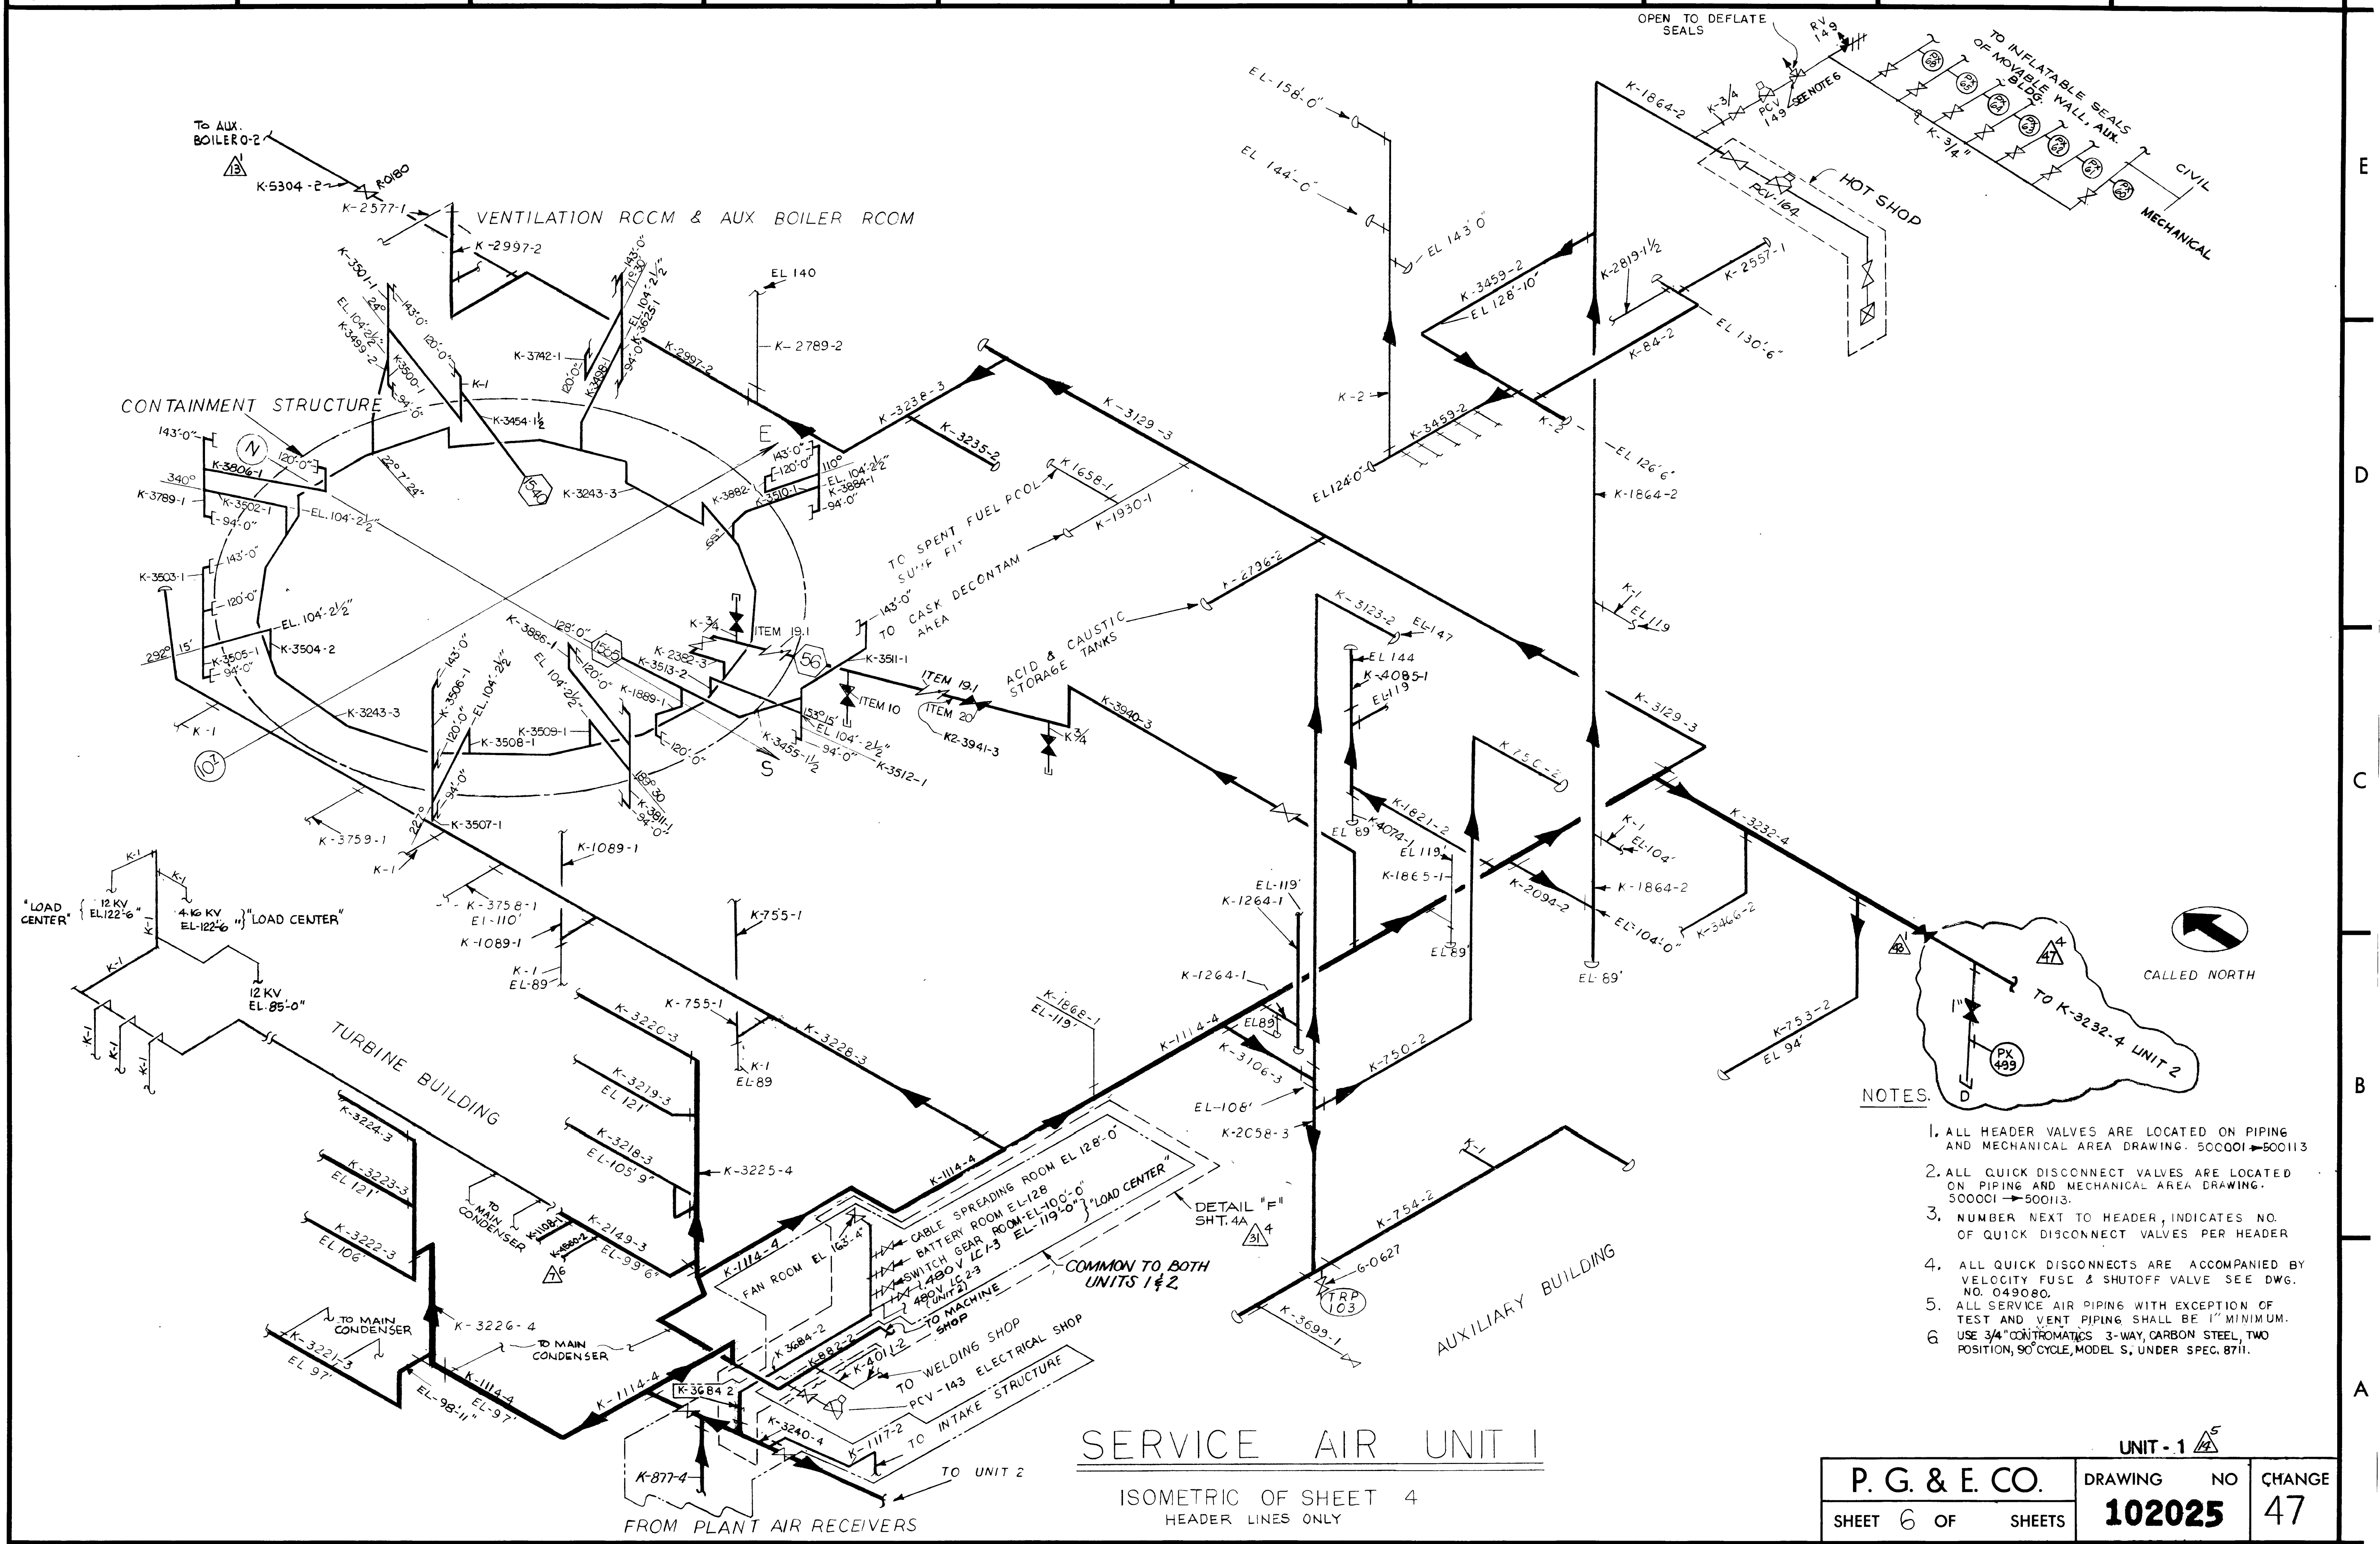

- NOTES:
1. ALL HEADER VALVES ARE LOCATED ON PIPING AND MECHANICAL AREA DRAWING. 500QOI → 500I13
 2. ALL QUICK DISCONNECT VALVES ARE LOCATED ON PIPING AND MECHANICAL AREA DRAWING. 500QOI → 500I13.
 3. NUMBER NEXT TO HEADER, INDICATES NO. OF QUICK DISCONNECT VALVES PER HEADER
 4. ALL QUICK DISCONNECTS ARE ACCOMPANIED BY VELOCITY FUSE & SHUTOFF VALVE SEE DWG. NO. 049080.
 5. ALL SERVICE AIR PIPING WITH EXCEPTION OF TEST AND VENT PIPING SHALL BE 1" MINIMUM.
 6. USE 3/4" CONTROMATICS 3-WAY, CARBON STEEL, TWO POSITION, 90° CYCLE, MODEL S, UNDER SPEC. 8711.


SERVICE AIR UNIT 1
ISOMETRIC OF SHEET 4
HEADER LINES ONLY

P. G. & E. CO.		UNIT - 1	
DRAWING	NO	CHANGE	
SHEET 6 OF	SHEETS	102025	47

NOTES:

1. ALL PIPING ON THIS SHEET SHALL BE PG&E CLASS 'E' EXCEPT AS NOTED.
2. MANUAL VALVES:
WITH ITEM No. SHALL BE UNDER SPEC. 0722.
WITH PG&E MARK No. SHALL BE UNDER SPEC. 8711.
3. VALVES WITH THIS NOTE (PCV-150, 153, 154, 155 & 156) SHALL BE LOCATED AS CLOSE TO THE TANKS AS POSSIBLE. (38-D/E)
4. PCV WITH THIS NOTE HAS AN INTEGRAL RELIEF VALVE. (PCV-145, 146, & 147) (32/34-B)
5. PRESSURE GAUGE INTEGRAL WITH PCV's
PRESSURE DOWNSTREAM OF PCV-146=115 PSIG
PRESSURE DOWNSTREAM OF PCV-145=115 PSIG (34-B)
6. 4R2 BALL VALVES DWG. 053479. (34,35,36,37 -C/D)
7. SEE DWG 341001.
8. INSTR. CLASS II; 3/4" x 0.065 WALL, SS TUBING.
9. SUPERIOR AIR HANDLING CO. MODEL No. 9. (31-B)
10. CONTROMATICS 3/4" BALL VALVE 3/4-B/C-16-22-B-C-FP.
11. CONTROMATICS 1" BALL VALVE 1-B/C-16-22-B-C-FP.
12. DELETED
13. 3/4" WHITEY MODEL #SS-63ES12.
14. FILTRITE LMO-10S- 3/4"F DUO-FINE DFN 0.45 10UN. (37-C)
15. 1" SPRING LOADED CHECK VALVE, CIRCLE SEAL 249T-8PP-6. (37-D)

NITROGEN SUPPLY SYSTEM

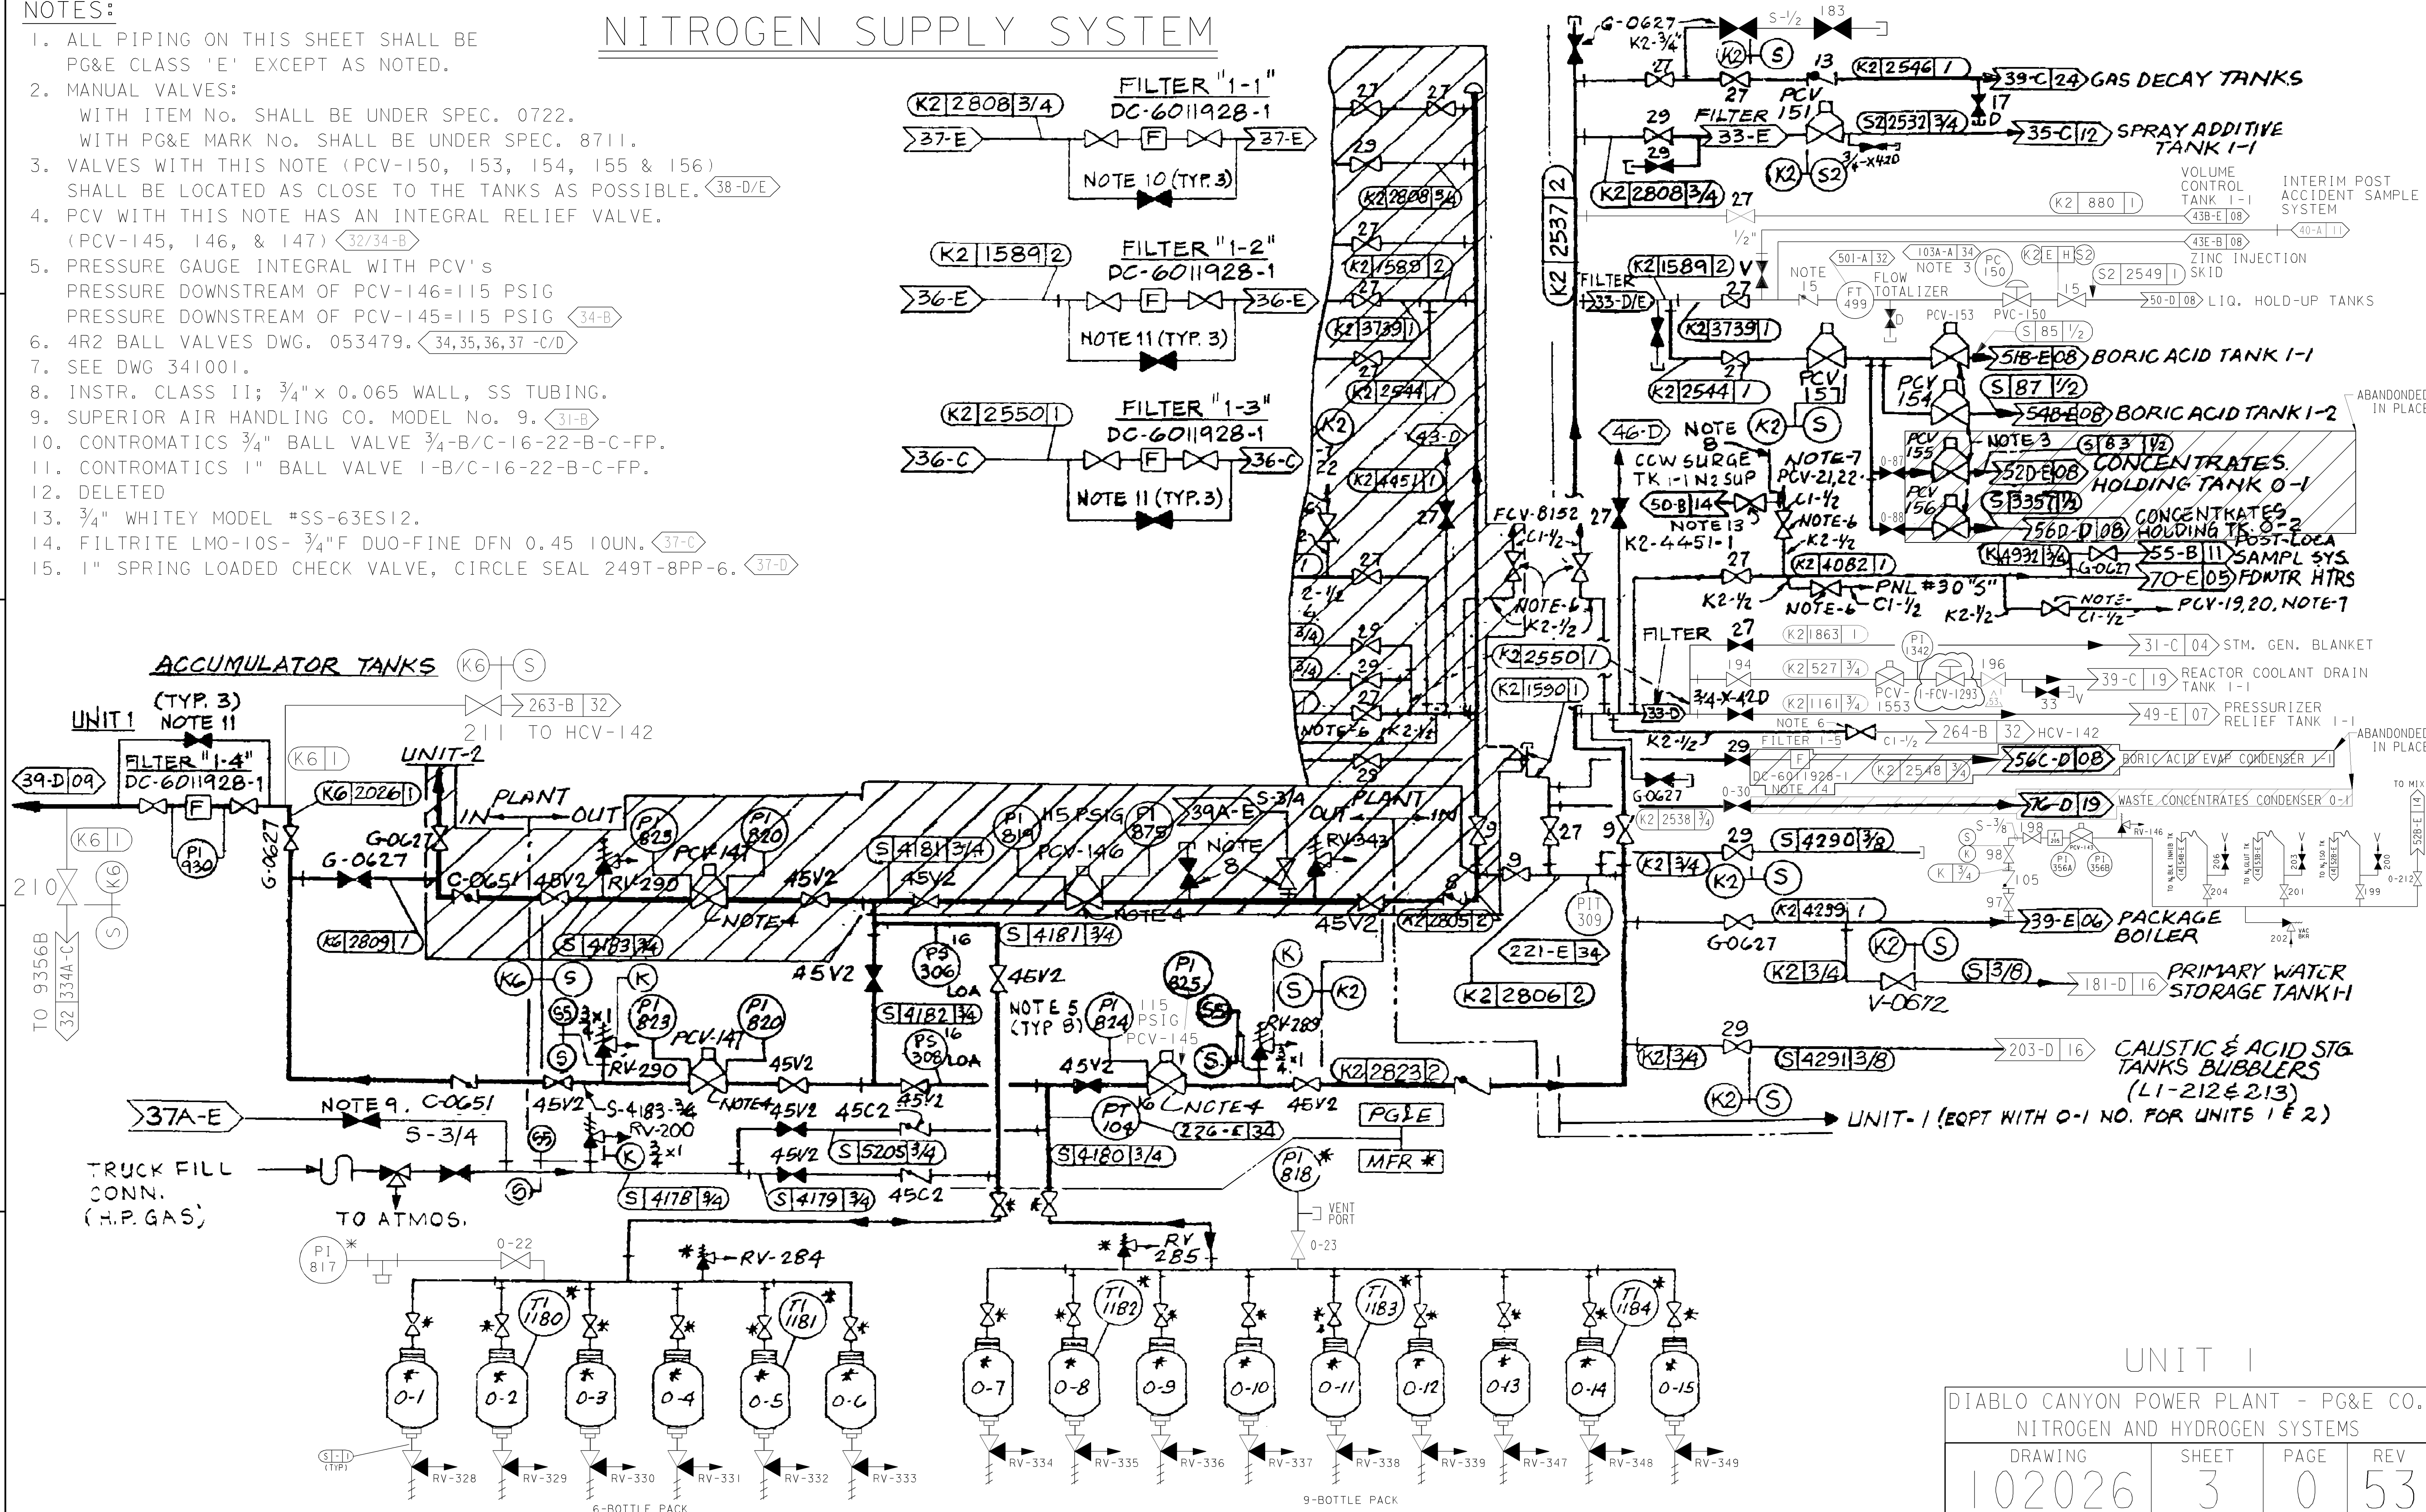

DIABLO CANYON POWER PLANT - PG&E CO.			
NITROGEN AND HYDROGEN SYSTEMS			
DRAWING	SHEET	PAGE	REV
102026	3	0	53

40

41

42

43

44

45

46

47

48

49

E

D

C

B

A


E

D

C

B

A

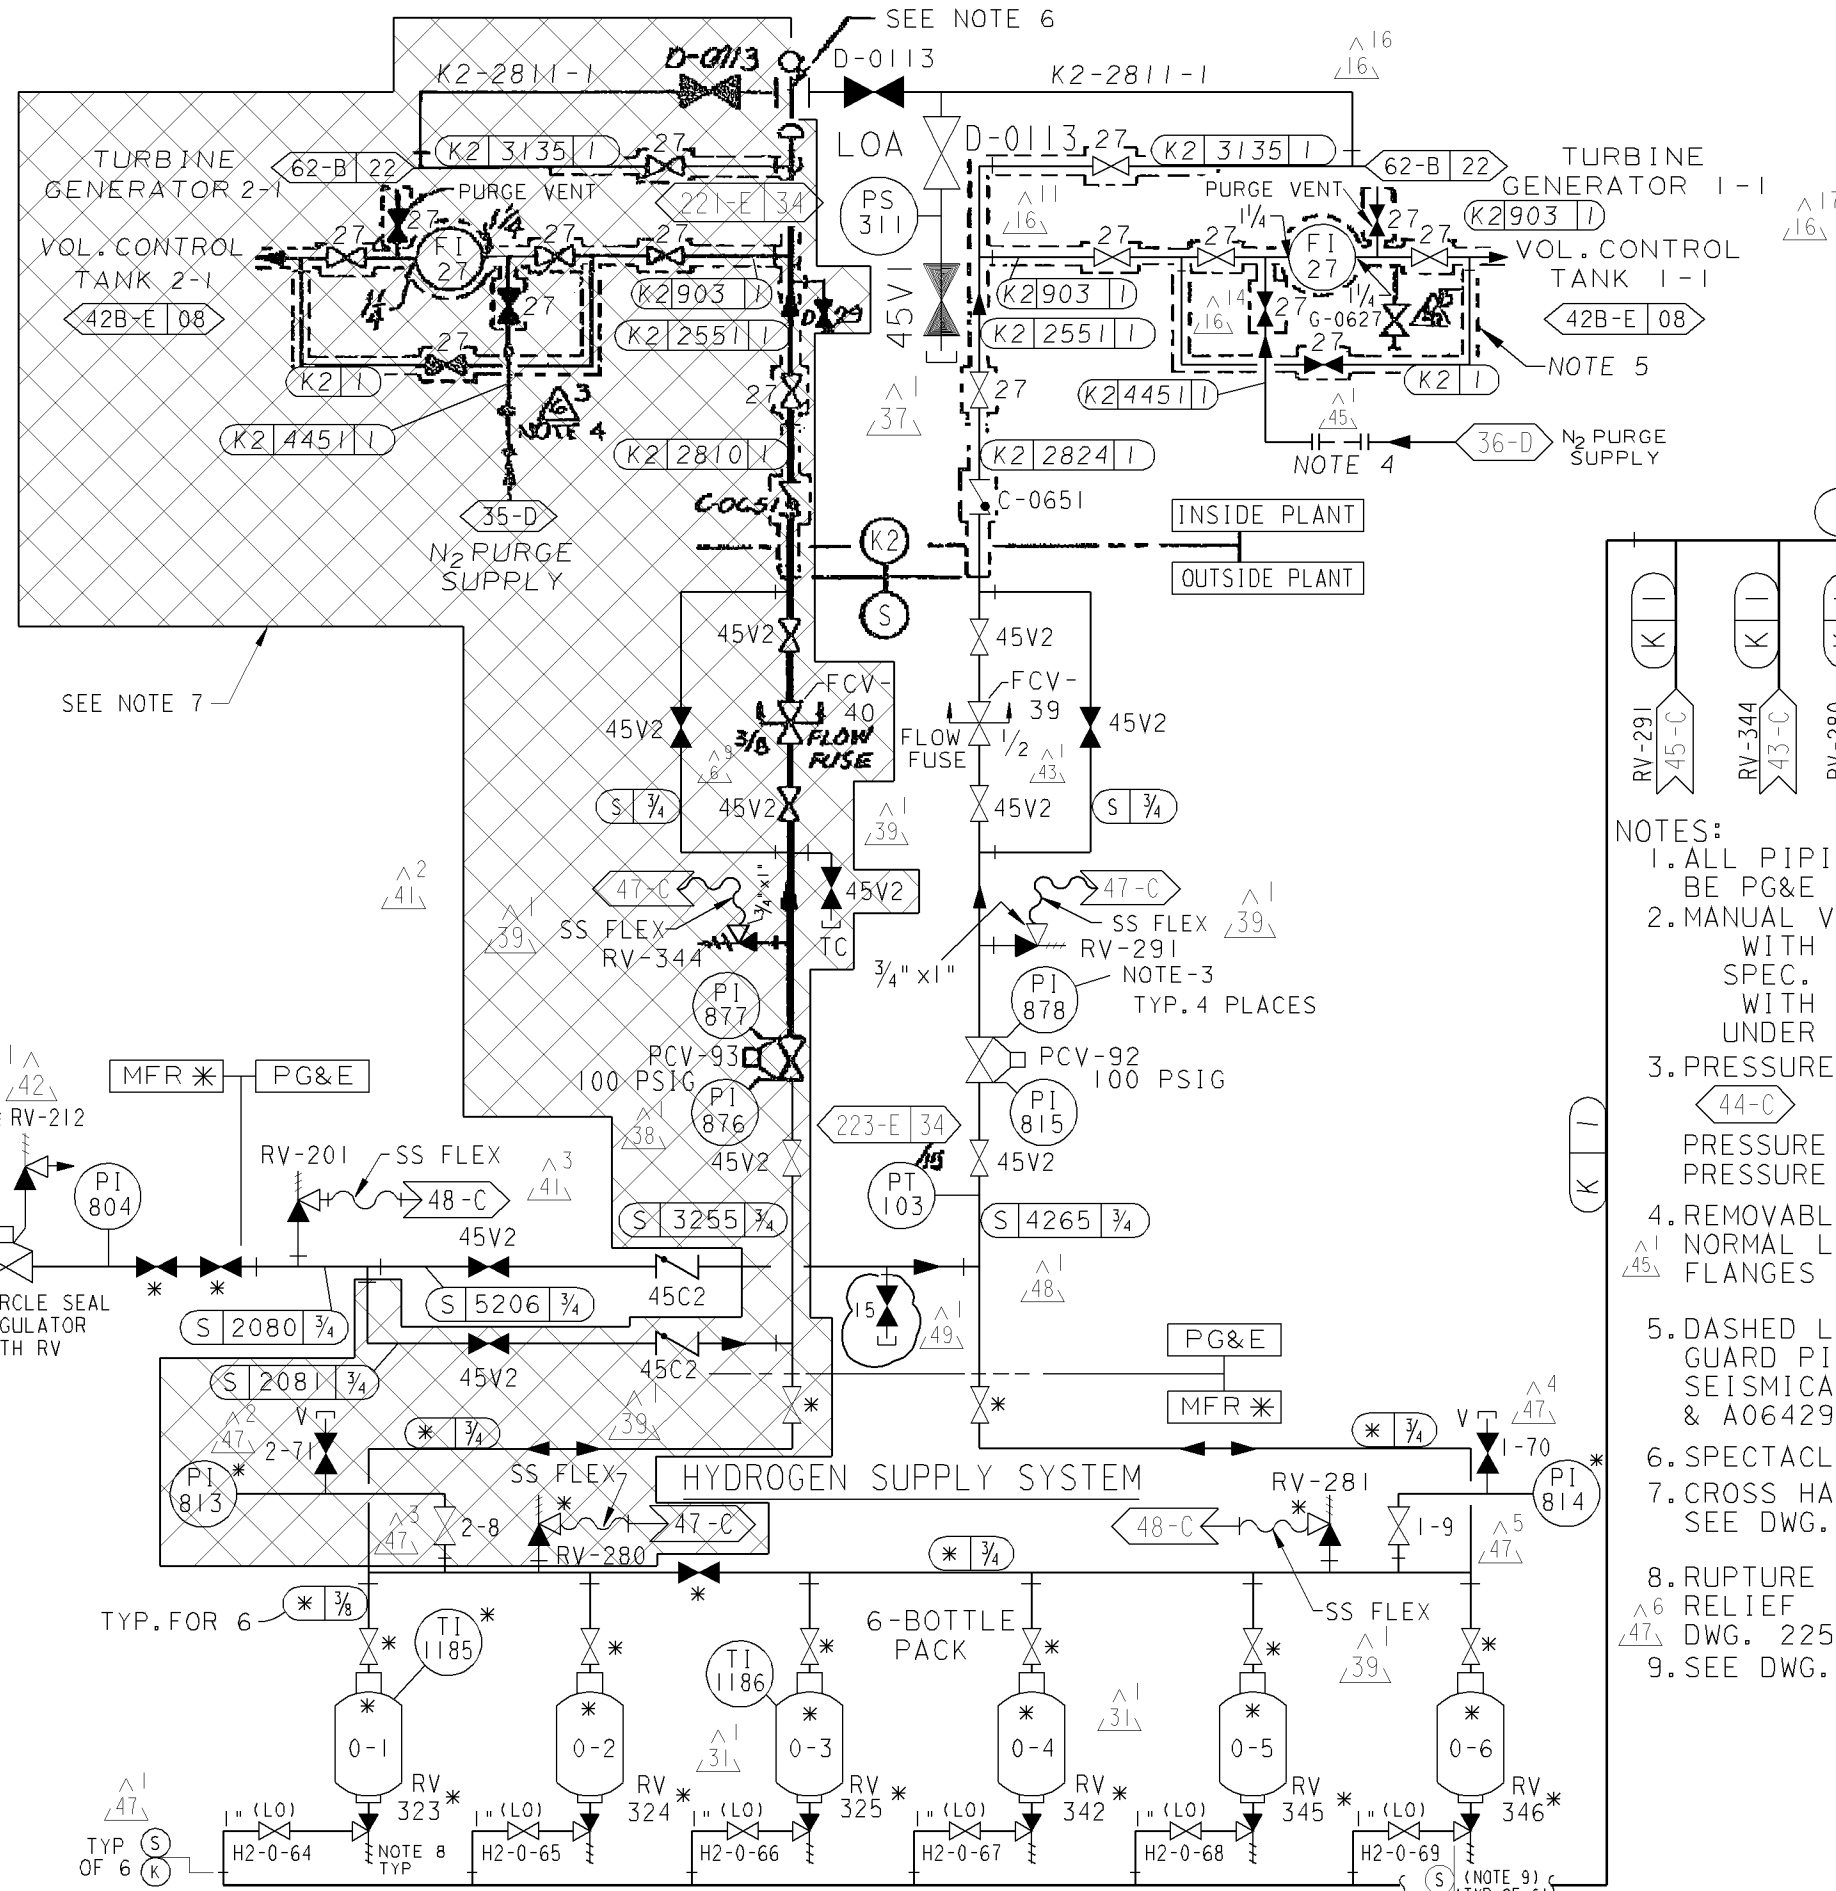

NOTES:

1. ALL PIPING ON THIS SHEET SHALL BE PG&E CLASS E.
2. MANUAL VALVES:
WITH ITEM NO. SHALL BE UNDER SPEC. 0722.
WITH PG&E MARK NO. SHALL BE UNDER SPEC. 8711.
3. PRESSURE GAGE INTEGRAL WITH PCV
44-C
PRESSURE DOWNSTREAM OF PCV-92-100 PSIG
PRESSURE DOWNSTREAM OF PCV-93-100 PSIG
4. REMOVABLE SPOOL USED TO PURGE LINE.
NORMAL LINE UP IS SPOOL REMOVED AND BLIND FLANGES INSTALLED. 45-D
5. DASHED LINES INDICATE GUARD ON PIPING.
GUARD PIPING ON HYDROGEN LINES IS SEISMICALLY QUALIFIED (REF AR# A0629995 & A0642979).
6. SPECTACLE BL. IS 1/8" THICK
7. CROSS HATCH AREA REPRESENTS UNIT-2 PIPING, SEE DWG. 108026-4.
8. RUPTURE DISCS REPLACED WITH SPRING LOADED RELIEF VALVES. PER AT-MM A0634377, REF. DWG. 225608.
9. SEE DWG. 678612-2 FOR DETAILS.

UNIT 1

DIABLO CANYON POWER PLANT - PG&E CO.
NITROGEN AND HYDROGEN SYSTEM

DRAWING	SHEET	PAGE	REV
102026	4	0	49



RASTER=2026s4.dgn
DGN=2026s4.dgn
CAD User: ADMI

Date: 08-24-2009

INPG1C
1 Size

08-24-2009	ADMI	FxC2		KERSI J. DALAL	MECHANICAL	M 16690	3/31/2010	REVISED PER DDN-2*150-0
DATE	DWN	RE	IV	PROFESSIONAL ENGINEER	PE DISC.	PE#	PE EXP.	

- NOTES:
1. ALL PIPING ON THIS SHEET SHALL BE PG&E CLASS "E"
 2. ALL PIPING TO BE "K" SPEC. UNLESS NOTED
 3. COMPONENT COOLING HEAT EXCHANGER SUMP DISCHARGE HEADER LINE 2986 TO SLOPE DOWN LIQUID RADWASTE (38-D)
 4. TO BE USED ONLY AS STANDBY (35-D)
 5. DELETED
 6. K-5728-4 INSTALLED TO DRAIN FW HEATERS. HOSE REQUIRED TO DRAIN INTO TURBINE BLDG SUMP
 7. 3"-150# FLANGED SWING CHECK VALVES, PACIFIC VALVE FIG.NO. 180-12H-CF8M OR EQUAL
 8. DELETED
 9. 4" C.S. 150# PPL PLUG VALVE
 10. 4" C.S. 150# FEP LINED 2-WAY PLUG VALVE, TUFLINE MOD. 061
 11. 4" S.S. 300# CHECK VALVE, CHEXTER FIG. 1603-C (WAFER)
 12. 3/8" REGULATING VALVE, WHITEY, B-1KS6 OR EQUAL (39-A)
 13. 4" C.S. BUTTERFLY VALVES, TEFLON LINED, 150# RATING, POSACON PART #NT100-4-SPI-BPI-GEJ-FA-I-A (WATER TYPE)
 14. 1" C.S. PLUG VALVE, POLYPROPYLENE LINED, ANSI 150# FLANGE RATING DOW MODEL 0602011
 15. 3/8" HOKE, MODEL NO. 3852 G 6Y NEEDLE VALVE
 16. 1/2" REGULATING VALVE, WHITEY, MODEL SS-7VS8
 17. 1/2", 3-WAY BALL VALVE, WHITEY, MODEL SS-4XS8
 18. CAP IS ORFICED TO PROVIDE APPROX. 2 GPM MIN. FLOW AND TO PREVENT SEDIMENT BUILD-UP
 19. EXTEND PURGE LINE BELOW SUMP LOW WATER LEVEL. (SAME AS UNIT 2)
 20. VELAN MODEL 0114C, S/C 76-5333 (36-C)
 21. CHECK VALVE STOCK CODE 70-0968 (37-D)
 22. 1/2" BALL VALVE, WHITEY, MODEL SS-45S8, STOCK CODE 72-9690.
 23. 1/2" BALL VALVE, WHITEY, MODEL SS-45F8, STOCK CODE 73-0154.
 24. PORTIONS OF LINE ARE AL-6XN MATERIAL SCH. 40 PER NMOD 60025381.

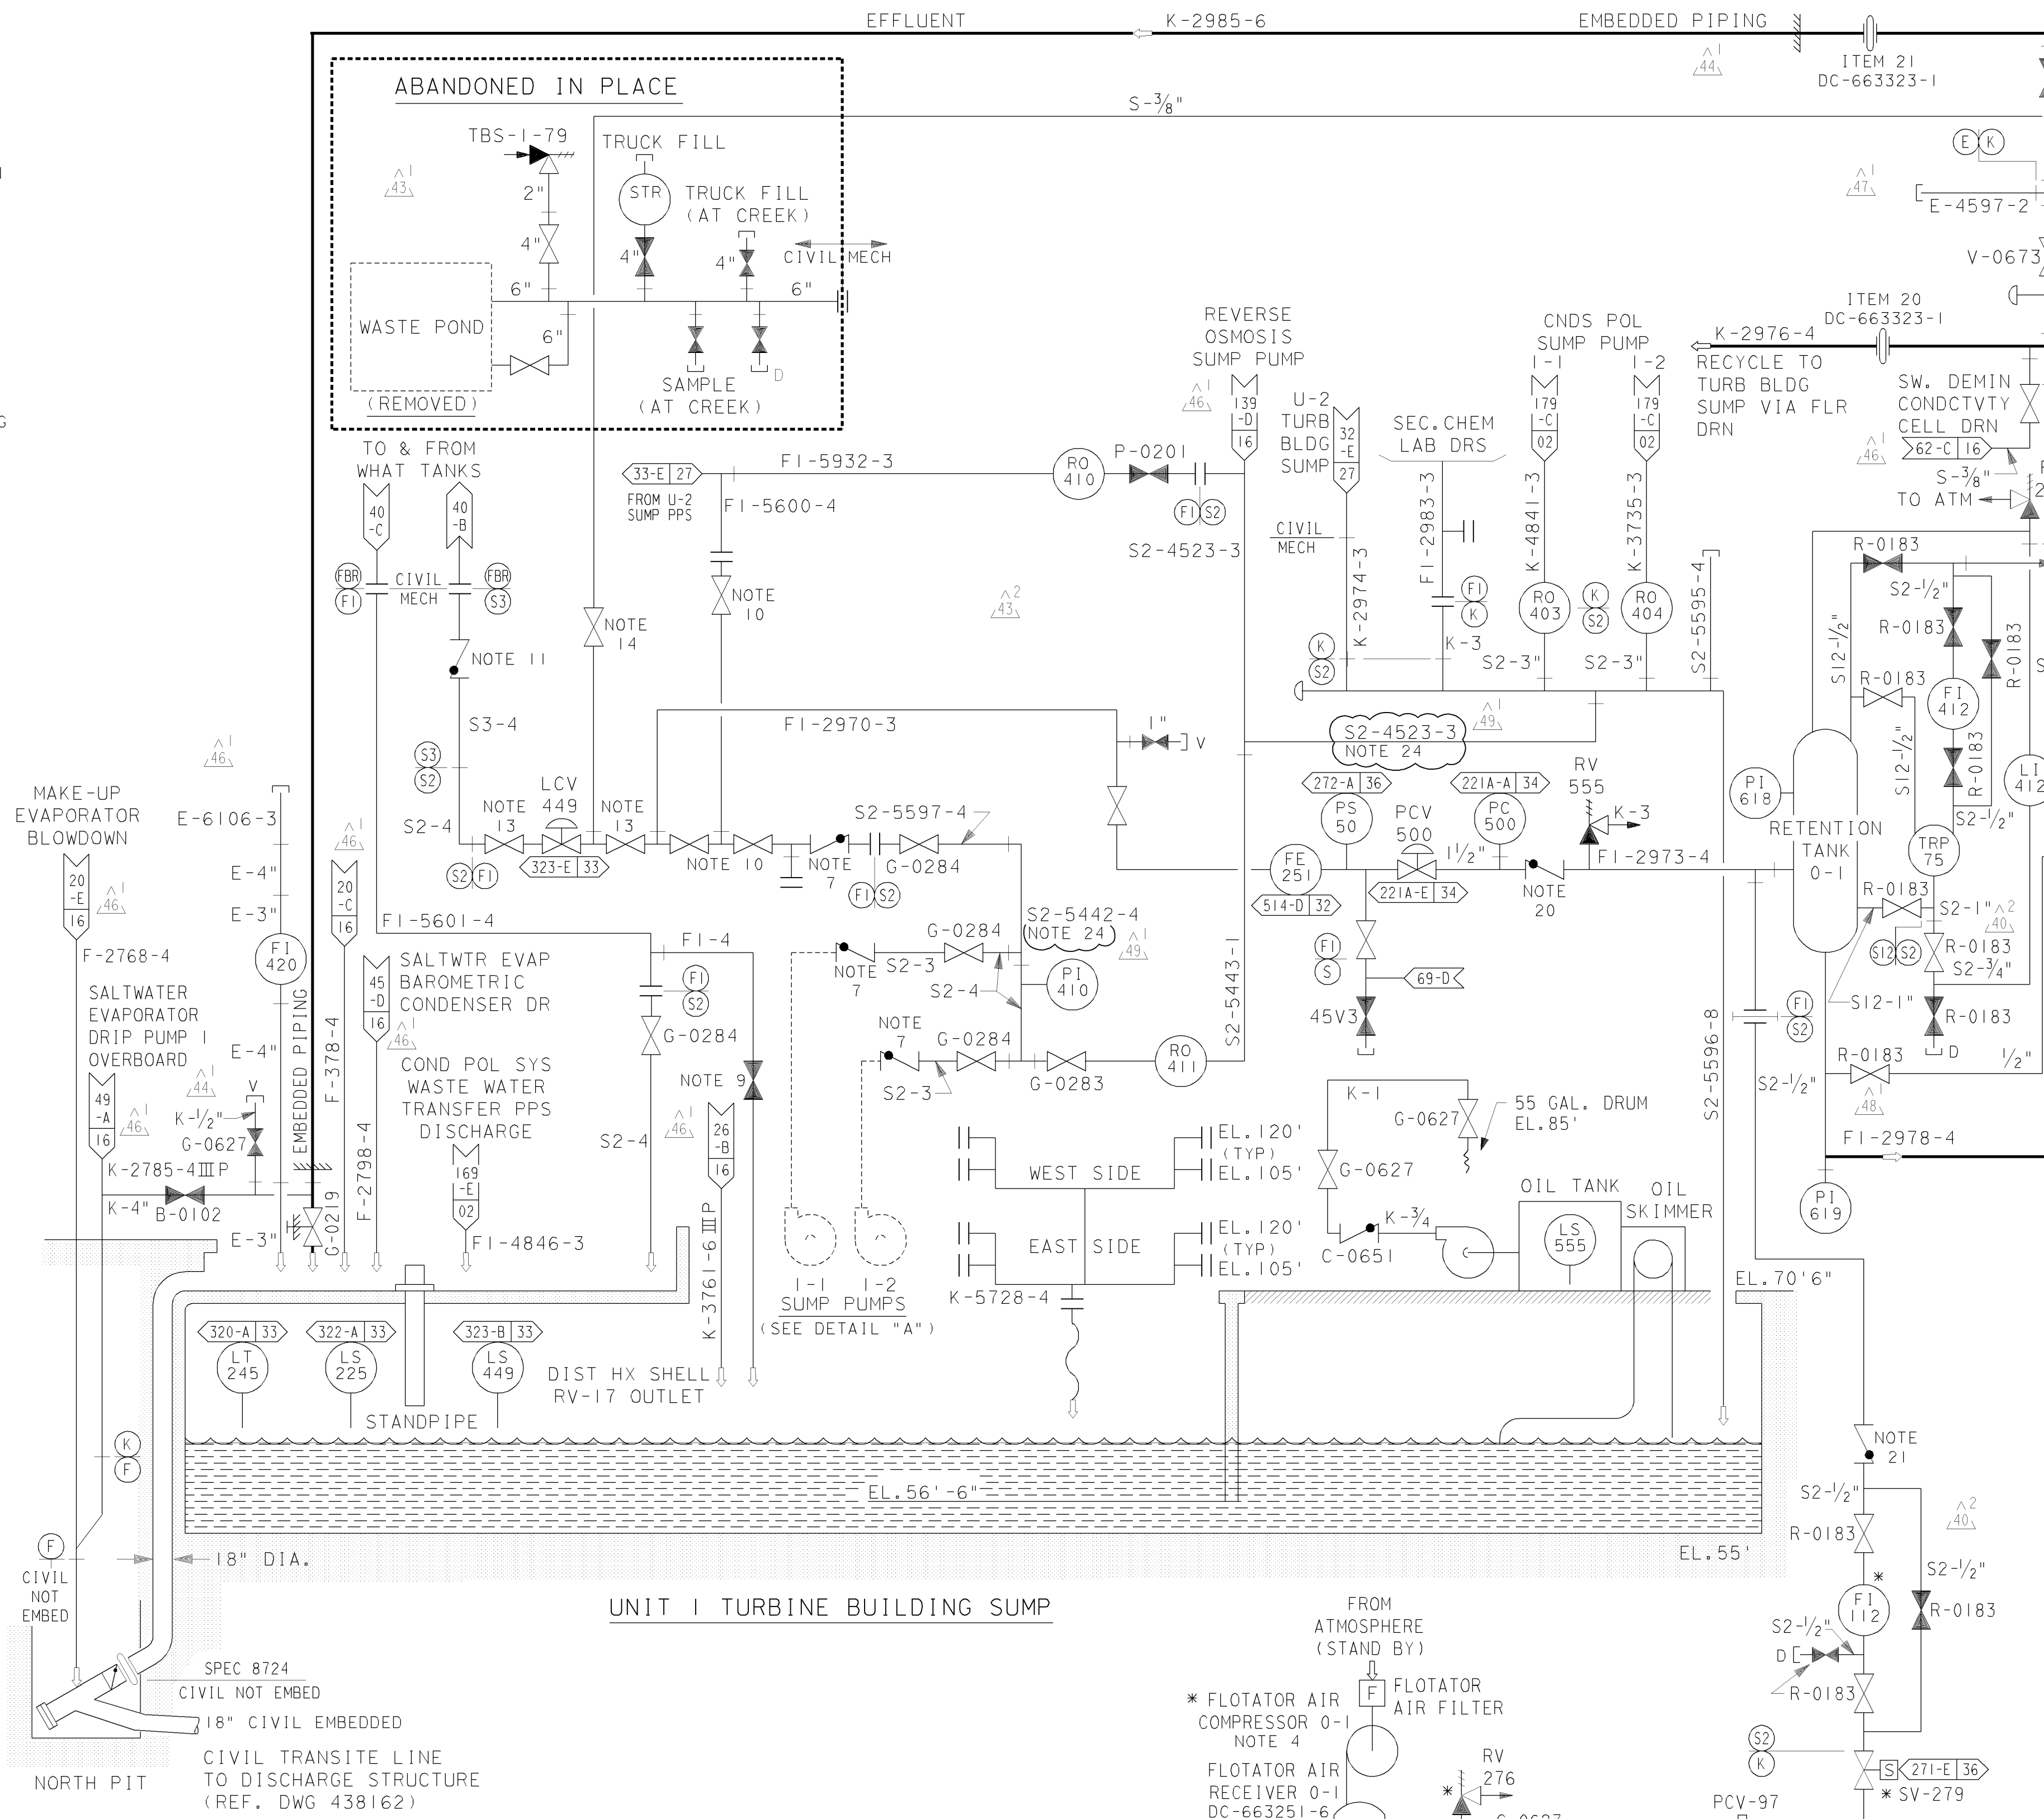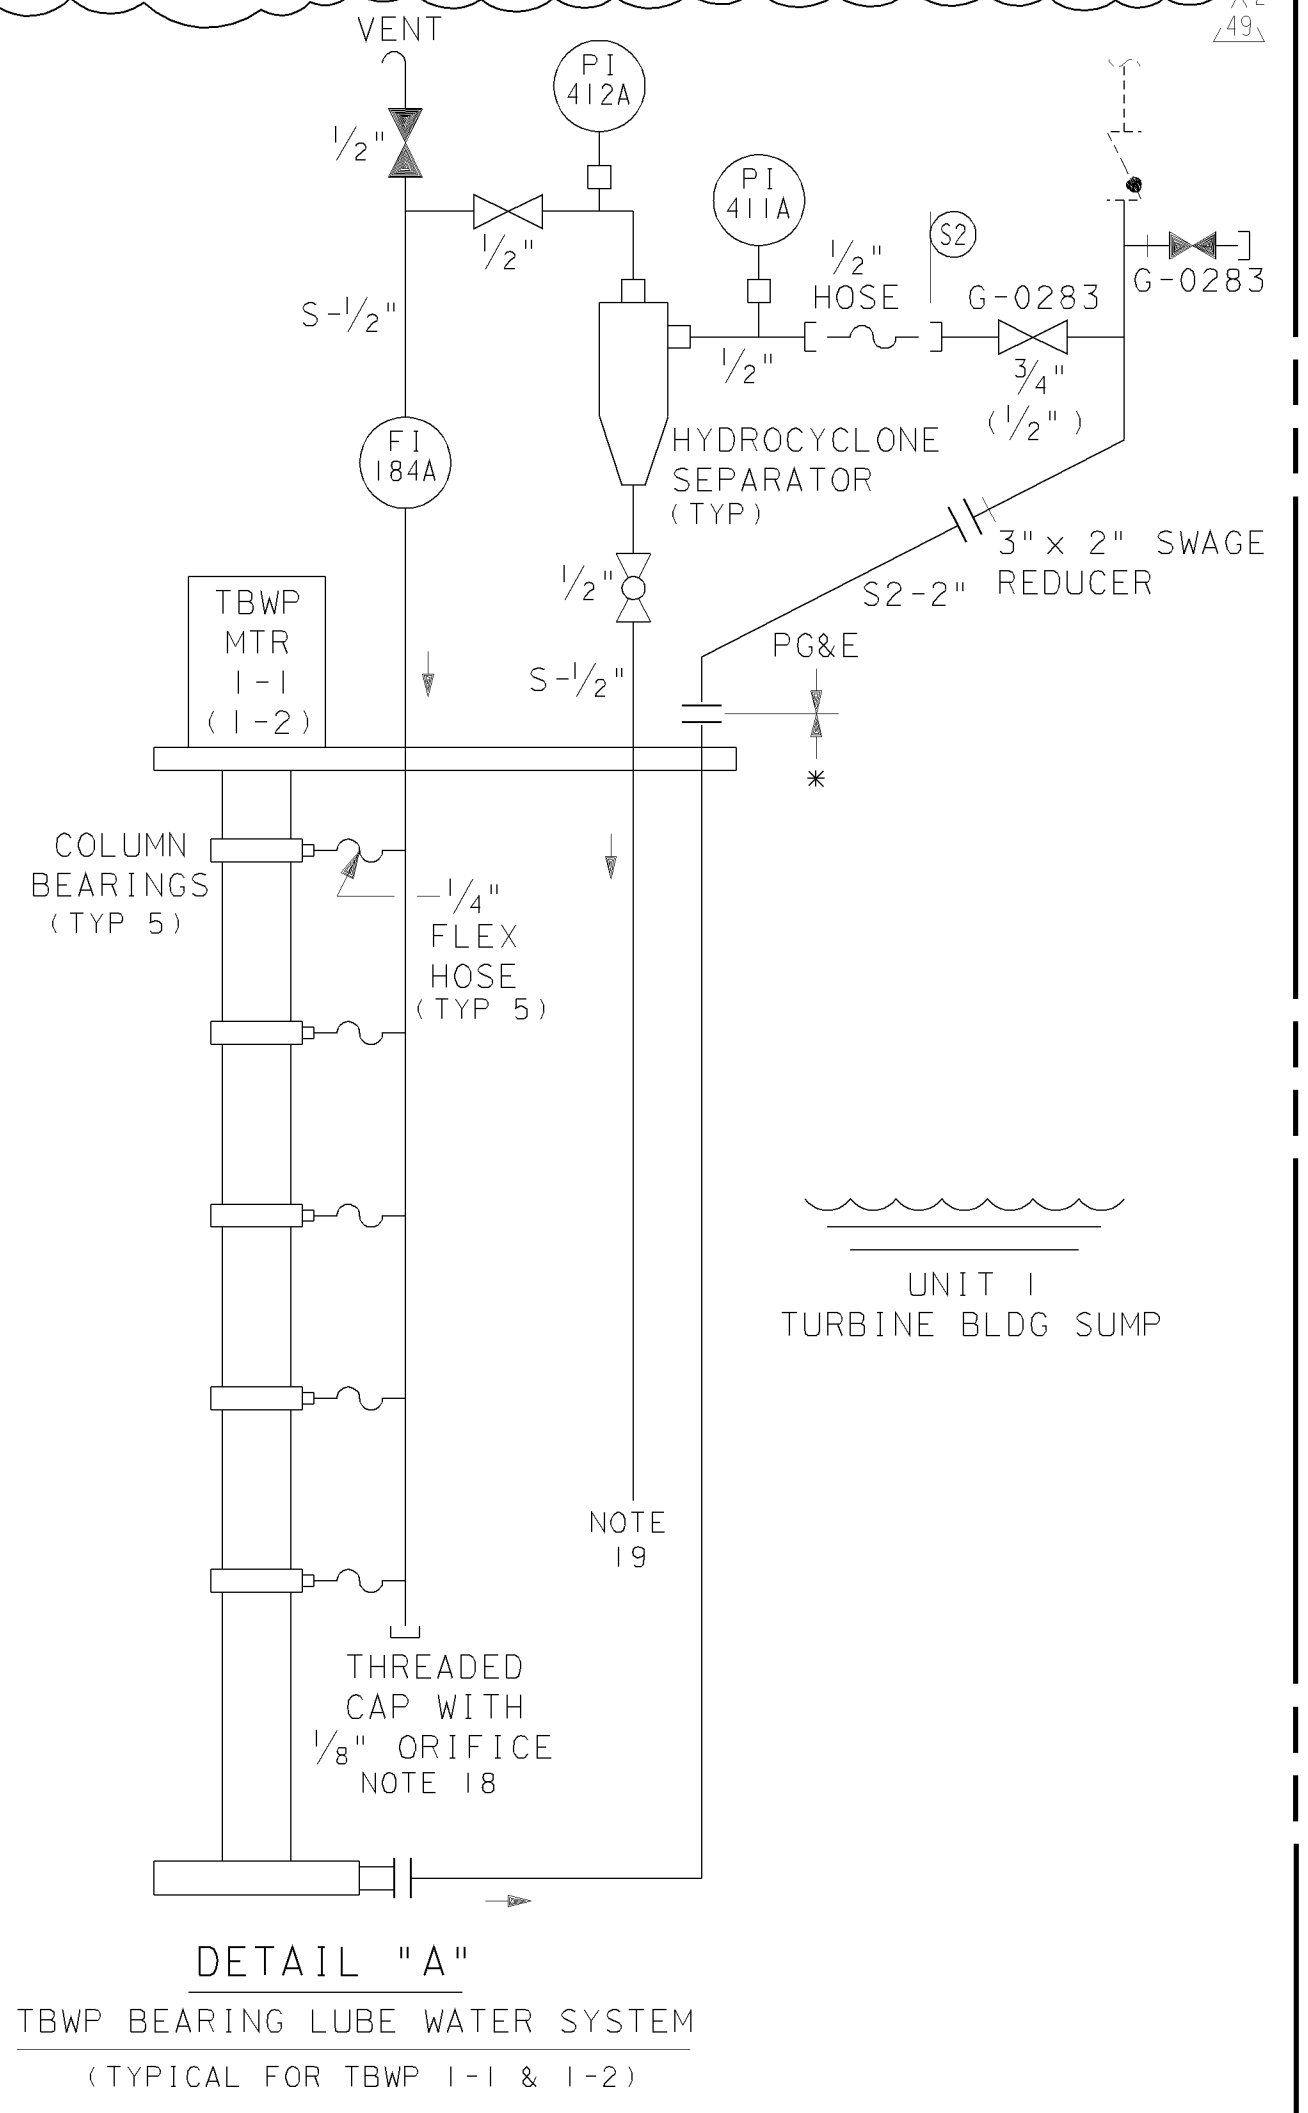


TURBINE BUILDING SUMP
OILY WATER SEPARATOR
(MAXIMUM CAPACITY 100 GPM)

DIABLO CANYON POWER PLANT - PG&E CO.
OILY WATER SEPARATOR AND TURBINE BLDG. SUMP SYSTEM

DRAWING	SHEET	PAGE	REV
102027	3	0	49

12-04-2012	MNRU	FxC2	KERSI J. DALAL	MECHANICAL	M 16690	3/31/2014	REVISED PER DDT-4*390
DATE	DWN	RE	IV	PROFESSIONAL ENGINEER	PE DISC.	PE#	PE EXP.

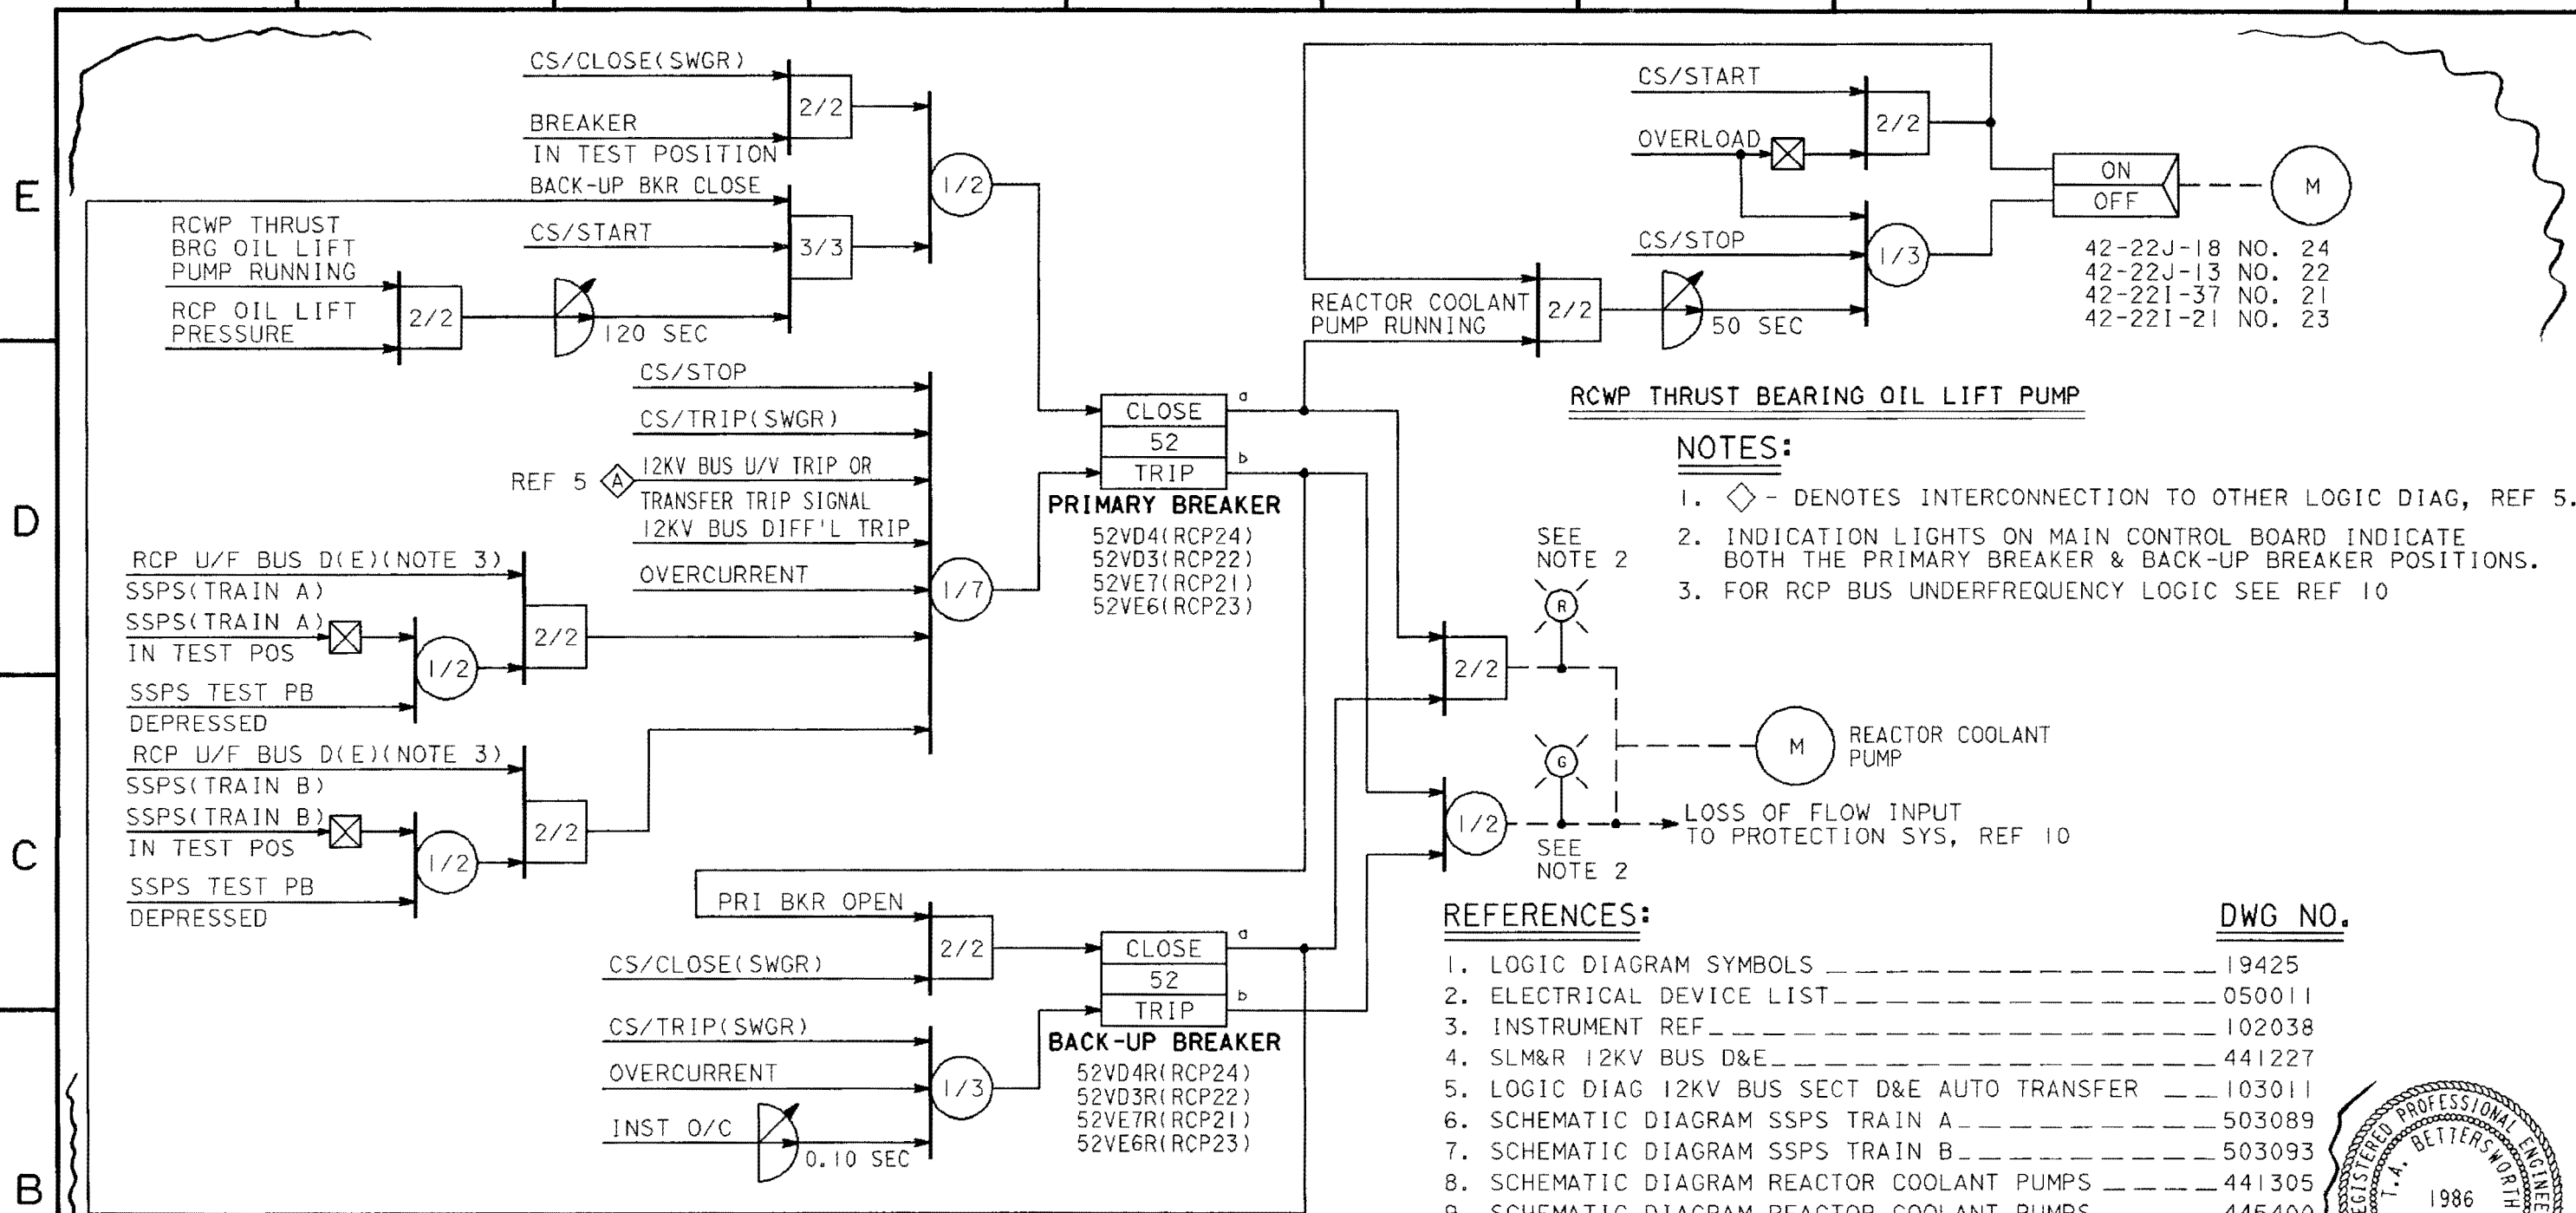


4	M Barn	U.P.	012314	12/31/94
REV	REGISTERED ENGINEER	SIGNATURE	CA REG NO.	EXP DATE

KEY ELEC SECT 3
RM INDEXED REV

UNIT 2

DWG NO.

1. LOGIC DIAGRAM SYMBOLS	19425
2. ELECTRICAL DEVICE LIST	050011
3. INSTRUMENT REF	102038
4. SLM&R 12KV BUS D&E	441227
5. LOGIC DIAG 12KV BUS SECT D&E AUTO TRANSFER	103011
6. SCHEMATIC DIAGRAM SSPS TRAIN A	503089
7. SCHEMATIC DIAGRAM SSPS TRAIN B	503093
8. SCHEMATIC DIAGRAM REACTOR COOLANT PUMPS	441305
9. SCHEMATIC DIAGRAM REACTOR COOLANT PUMPS	445400
10. FUNCTIONAL LOGIC DIAGRAM PRIMARY COOLANT SYSTEM TRIP SIGNALS	495875

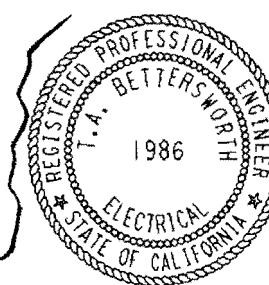

COAST VALLEYS DIVISION

MICROFILM

BILL OF MATL

DWG LIST

SUPSDS

SUPSD BY

SHEET NO.

SHEETS

102787

4

NO	DATE	DESCRIPTION	GM	DWN.	CHKD.	SUPV.	APVD.
4	1-14-94	REDRAWN; MODIFIED SCHEME (DWG CHG ONLY); REV NOTES & REF (FCT-16395)	WAA	WAA	WAA	WAA	WAA
1	9-30-75	APPROVED FOR CONSTRUCTION	169972	EZ	LRW		

REVISIONS

APPROVED BY	GM 169972
LRW	SUPV. H. HERTING
DN	DSGN. E. ZEITER
JWC	CHKD. E. ZEITER
TAB	O.K. HH DPJ
	DATE 9-30-75
	SCALES
	NONE

LOGIC DIAGRAM
REACTOR COOLANT PUMPS

DIABLO CANYON
DEPARTMENT OF ENGINEERING
PACIFIC GAS AND ELECTRIC COMPANY
SAN FRANCISCO, CALIFORNIA

102787D.E62 01-06-94 WAA

DWG TYPE
14

DWG SUBJECT
15

DRAWING TITLE
16

REACTOR COOLANT PUMPS
21

UNIT No.
16-44

DIABLO
45-50

INSTALLATION TYPE
51

DIVISION NAME
52

MISC
53

DD CODE
55 56

MAN HOURS
57 59

CADD
60

DRAWING SOURCE
70

U#1-338070

RASTER=102788.dgn
DGN=102788.dgn
CAD User:FAZI Date: 04-09-2008

E

D

C

B

A

1

2

3

4

5


6

7

8

9

10

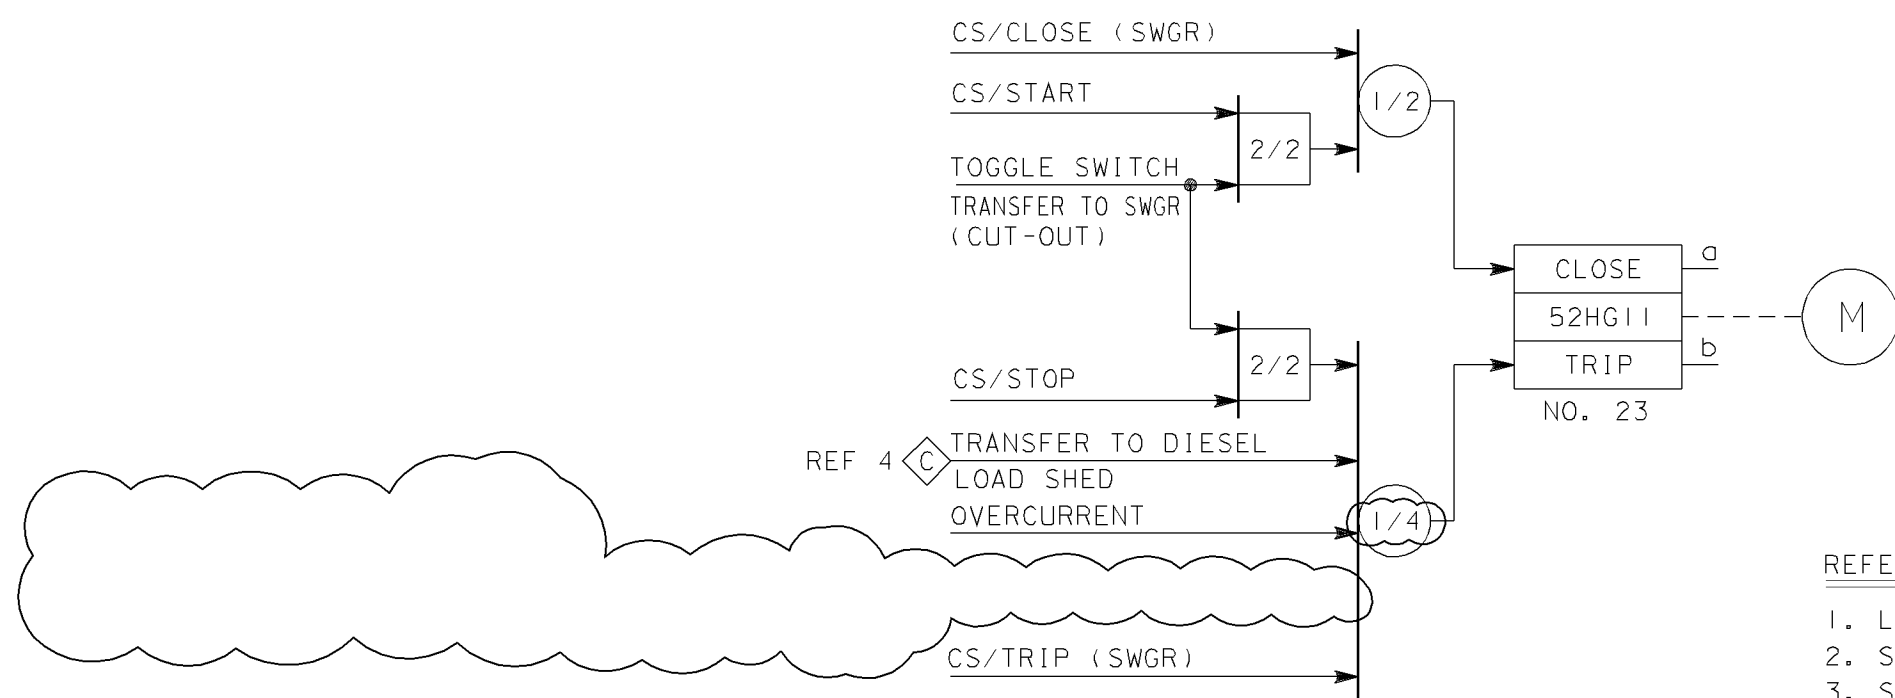


- REFERENCES:
- DWG NO.
1. LOGIC DIAGRAM SYMBOLS _____ 19425
2. SCH DIAG CHARGING PUMP #23 _____ 4008751
3. SLM&R DIAG 4KV BUS G & H _____ 441230
4. LOGIC DIAG 4KV BUS SECT G TRANS __ 441297

NUCLEAR SAFETY RELATED

KEY DWG. SECTION 3

UNIT 2

DATE			REVISION DESCRIPTION		<div>I & C</div> <div>LOGIC DIAGRAM</div> <div>(CENTRIFUGAL) CHARGING PUMP (2-3)</div> <div>DIABLO CANYON POWER PLANT</div> <div>PACIFIC GAS AND ELECTRIC COMPANY</div> <div>SAN FRANCISCO, CALIFORNIA</div>	DWG SCALE:			
04-09-2008			REVISED PER DC2-SE-50704-01			BILL OF MATL:			
D.D.	FAZI					SUPSDS:			
R.E.	FxC2					SUPSD BY:			
I.V.						DRAWING	SHEET	PAGE	REV
P.E.	AGB2				102788	1	0	5	

INPG
I Size

DRAWING SOURCE
CADD
MAN
HOURS
DD
CODE
MISC
INSTALLATION DIVISION
NAME
TYPE
PROJECT
LOCATION
DIABLO
45-50
UNIT No.
2
42
44
DWM
SUBJECT
CENTRIFUGAL CHARGING PUMPS
16-44
21
16
15
14


NOTES

- 43/TS - TRANSFER SWITCH TRANSFERS CONTROL FROM MAIN CONTROL BOARD TO HOT SHUTDOWN PANEL (LOCATED AT SWITCHGEAR).
- 43 - MODE SELECTOR SWITCH FOR SELECTING "AUTO" OR "MANUAL" MODE (LOCATED AT HOT SHUTDOWN PANEL).
- Δ - REMOTE CONTROL SWITCH LOCATED AT HOT SHUTDOWN PANEL.

REFERENCES

1. LOGIC DIAG SYMBOLS _____ 19425
2. SCHEMATIC DIAG CHARGING PP _____ 441312
3. SLM&R DIAG 4KV BUS F _____ 441229
4. SLM&R DIAG 4KV BUS G & H _____ 441230
5. LOGIC DIAG 4KV BUS F AUTO TRANSFER _____ 441286
6. LOGIC DIAG 4KV BUS G AUTO TRANSFER _____ 441297

DWG NO.

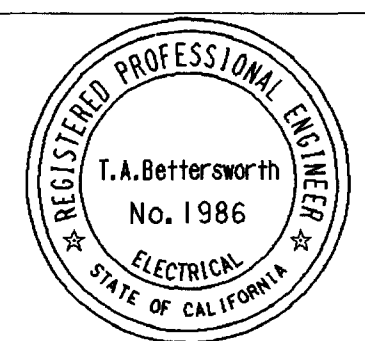

COAST VALLEYS DIVISION

MICROFILM 5

BILL OF MATL

DWG LIST

SUPSDS

SUPSD BY

SHEET NO. SHEETS

102789 5

UI-1941010

NUCLEAR SAFETY RELATED

KEY DWG--SECTION 3 UNIT 2

LOGIC DIAGRAM
CENTRIFUGAL CHARGING PUMPS

DIABLO CANYON
DEPARTMENT OF ENGINEERING
PACIFIC GAS AND ELECTRIC COMPANY
SAN FRANCISCO, CALIFORNIA

APPROVED BY	GM 169972
LRW	SUPV H. HERTING
DN	DSGN E. ZEITER
JWC	CHKD EZ
TAB	OK HH DPJ
DATE	9-23-75
SCALES	NONE

5	M Basu	Signature	C12314	12/31/94
REV	REGISTERED ENGINEER	SIGNATURE	CA REG NO.	EXP DATE

102789D.E62 04-27-94 WAA

NO.	DATE	DESCRIPTION	GM/SPEC	DWN	CHKD	SUPV	APVD BY
5	5-5-94	ADD ALARM INPUT AT 43/MAN INPUT (FCT 17116)	---	WAA	WBY	ARN	MB
4	1-20-94	REV LOGIC; DEL STAR NOTE; ADD REF 5 & 6 (FCT-16395)	---	DWL	WG	KS	MB
1	9-30-75	APPROVED FOR CONSTRUCTION	169972	EZ	---	LRW	DN

REVISIONS

NI 805

0622011

2

3

4

5

6

7

8

9

10

DRAWING
SOURCE
A 70
CADD
C 60
MAN
HOURS
57 59
DD
CODE
GD 55 56
MISC
53
INSTALLATION DIVISION
NAME
B 52
TYPE
L 51
PROJECT
LOCATION
DIABLO
45-50

UNIT NO.
42 44
DRAWING TITLE
16-44
AUX SALT WATER PUMPS

DWG
SUBJECT
15
TYPE
4 14

LOW SYSTEM PRESS

CS/START

▲ 43/MAN

2/2

LOSS OF VOLTAGE ON
OTHER ASW 4KV BUS

1/2

REF
5&6TRANSFER TO DIESEL
BLOCK AUTO START
SIS

3/3

▲ 43/AUTO

2/2

1/2

43/TS/CONTROL RM

CS/CLOSE (SWGR)

2/2

CS/NEUT

3/3

1/5

CS/NEUT

△ REMOTE

4/4

△ 43/MAN

ALARM

CS/START

△ REMOTE

2/2

ALARM

CS/STOP

△ REMOTE

2/2

▲ 43/MAN

CS/STOP

3/3

OVERCURRENT

CS/TRIP (SWGR)

1/5

REF
5&6TRANSFER TO DIESEL
LOAD SHED

NOTES

43/TS - TRANSFER SWITCH TRANSFERS CONTROL FROM
MAIN CONTROL BOARD TO HOT SHUTDOWN PANEL
(LOCATED AT SWITCHGEAR).

43 - MODE SELECTOR SWITCH FOR SELECTING
"AUTO" OR "MANUAL" MODE (LOCATED AT
HOT SHUTDOWN PANEL & MAIN CONTROL RM).


△ - REMOTE CONTROL SWITCH (LOCATED AT HOT
SHUTDOWN PANEL).

▲ - SWITCH LOCATED IN MAIN CONTROL ROOM.

CLOSE
52
TRIP

52HF8 NO. 21
52HG6 NO. 22

RM INDEXED REV. 3

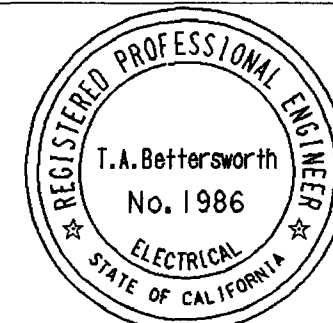

COAST VALLEYS DIVISION

MICROFILM 4

BILL OF MATL
DWG LIST
SUPSDS
SUPSD BY
SHEET NO. SHEETS

102790 4

UI = 19406 10

REFERENCES

DWG NO.

1. LOGIC DIAG SYMBOLS ———— 19425
2. SCHEM DIAG AUX SALT WATER PP — 441287
3. SLM&R DIAG 4KV BUS F ———— 441229
4. SLM&R DIAG 4KV BUS G & H ———— 441230
5. LOGIC DIAG 4KV BUS SECTION
"F" AUTO TRANSFER ———— 441286
6. LOGIC DIAG 4KV BUS SECTION
"G" AUTO TRANSFER ———— 441297

4	M Basu	Signature	C 12314	12/31/94
REV	REGISTERED ENGINEER	SIGNATURE	CA REG NO.	EXP DATE

NUCLEAR SAFETY RELATED

KEY DWG--SECTION 3 UNIT 2

102790D.E62 01-14-94 DWL

4	1-19-94	REV LOGIC, NOTES; ADDED REF 5 & 6 (FCT-16395)	—	WWL	JO	KL	MD	MD
3	5-20-93	REDRAWN; ADD DEVICE 43; RETAG 43R	—	DWL	WG	KS	MH	
		AS 43/TS; REV NOTES & LOGIC (DC2-EE-48591) (DC2-EE-48593)						
2	2-16-90	REV NOTE (FCT-010370)	169972	TE	VL	LCV	SLW	KAW
1	9-30-75	APPROVED FOR CONSTRUCTION	169972		EZ		LRW	
NO.	DATE	DESCRIPTION	GM/SPEC	DWN	CHKD	SUPV	APVD BY	

R E V I S I O N S

APPROVED BY	GM 169972
LRW	SUPV H. HERTING
DN	DSGN E. ZEITER
JWC	DWN
TAB	CHKD EZ
	OK HH DPJ
	DATE 9-30-75
	SCALES NONE

LOGIC DIAGRAM
AUXILIARY SALT WATER PUMPS

DIABLO CANYON

DEPARTMENT OF ENGINEERING
PACIFIC GAS AND ELECTRIC COMPANY
SAN FRANCISCO, CALIFORNIA

RASTER=102791.dgn
DGN=102791.dgn
CAD User:MNRU Date: 09-05-2012

E

D

C

B

A

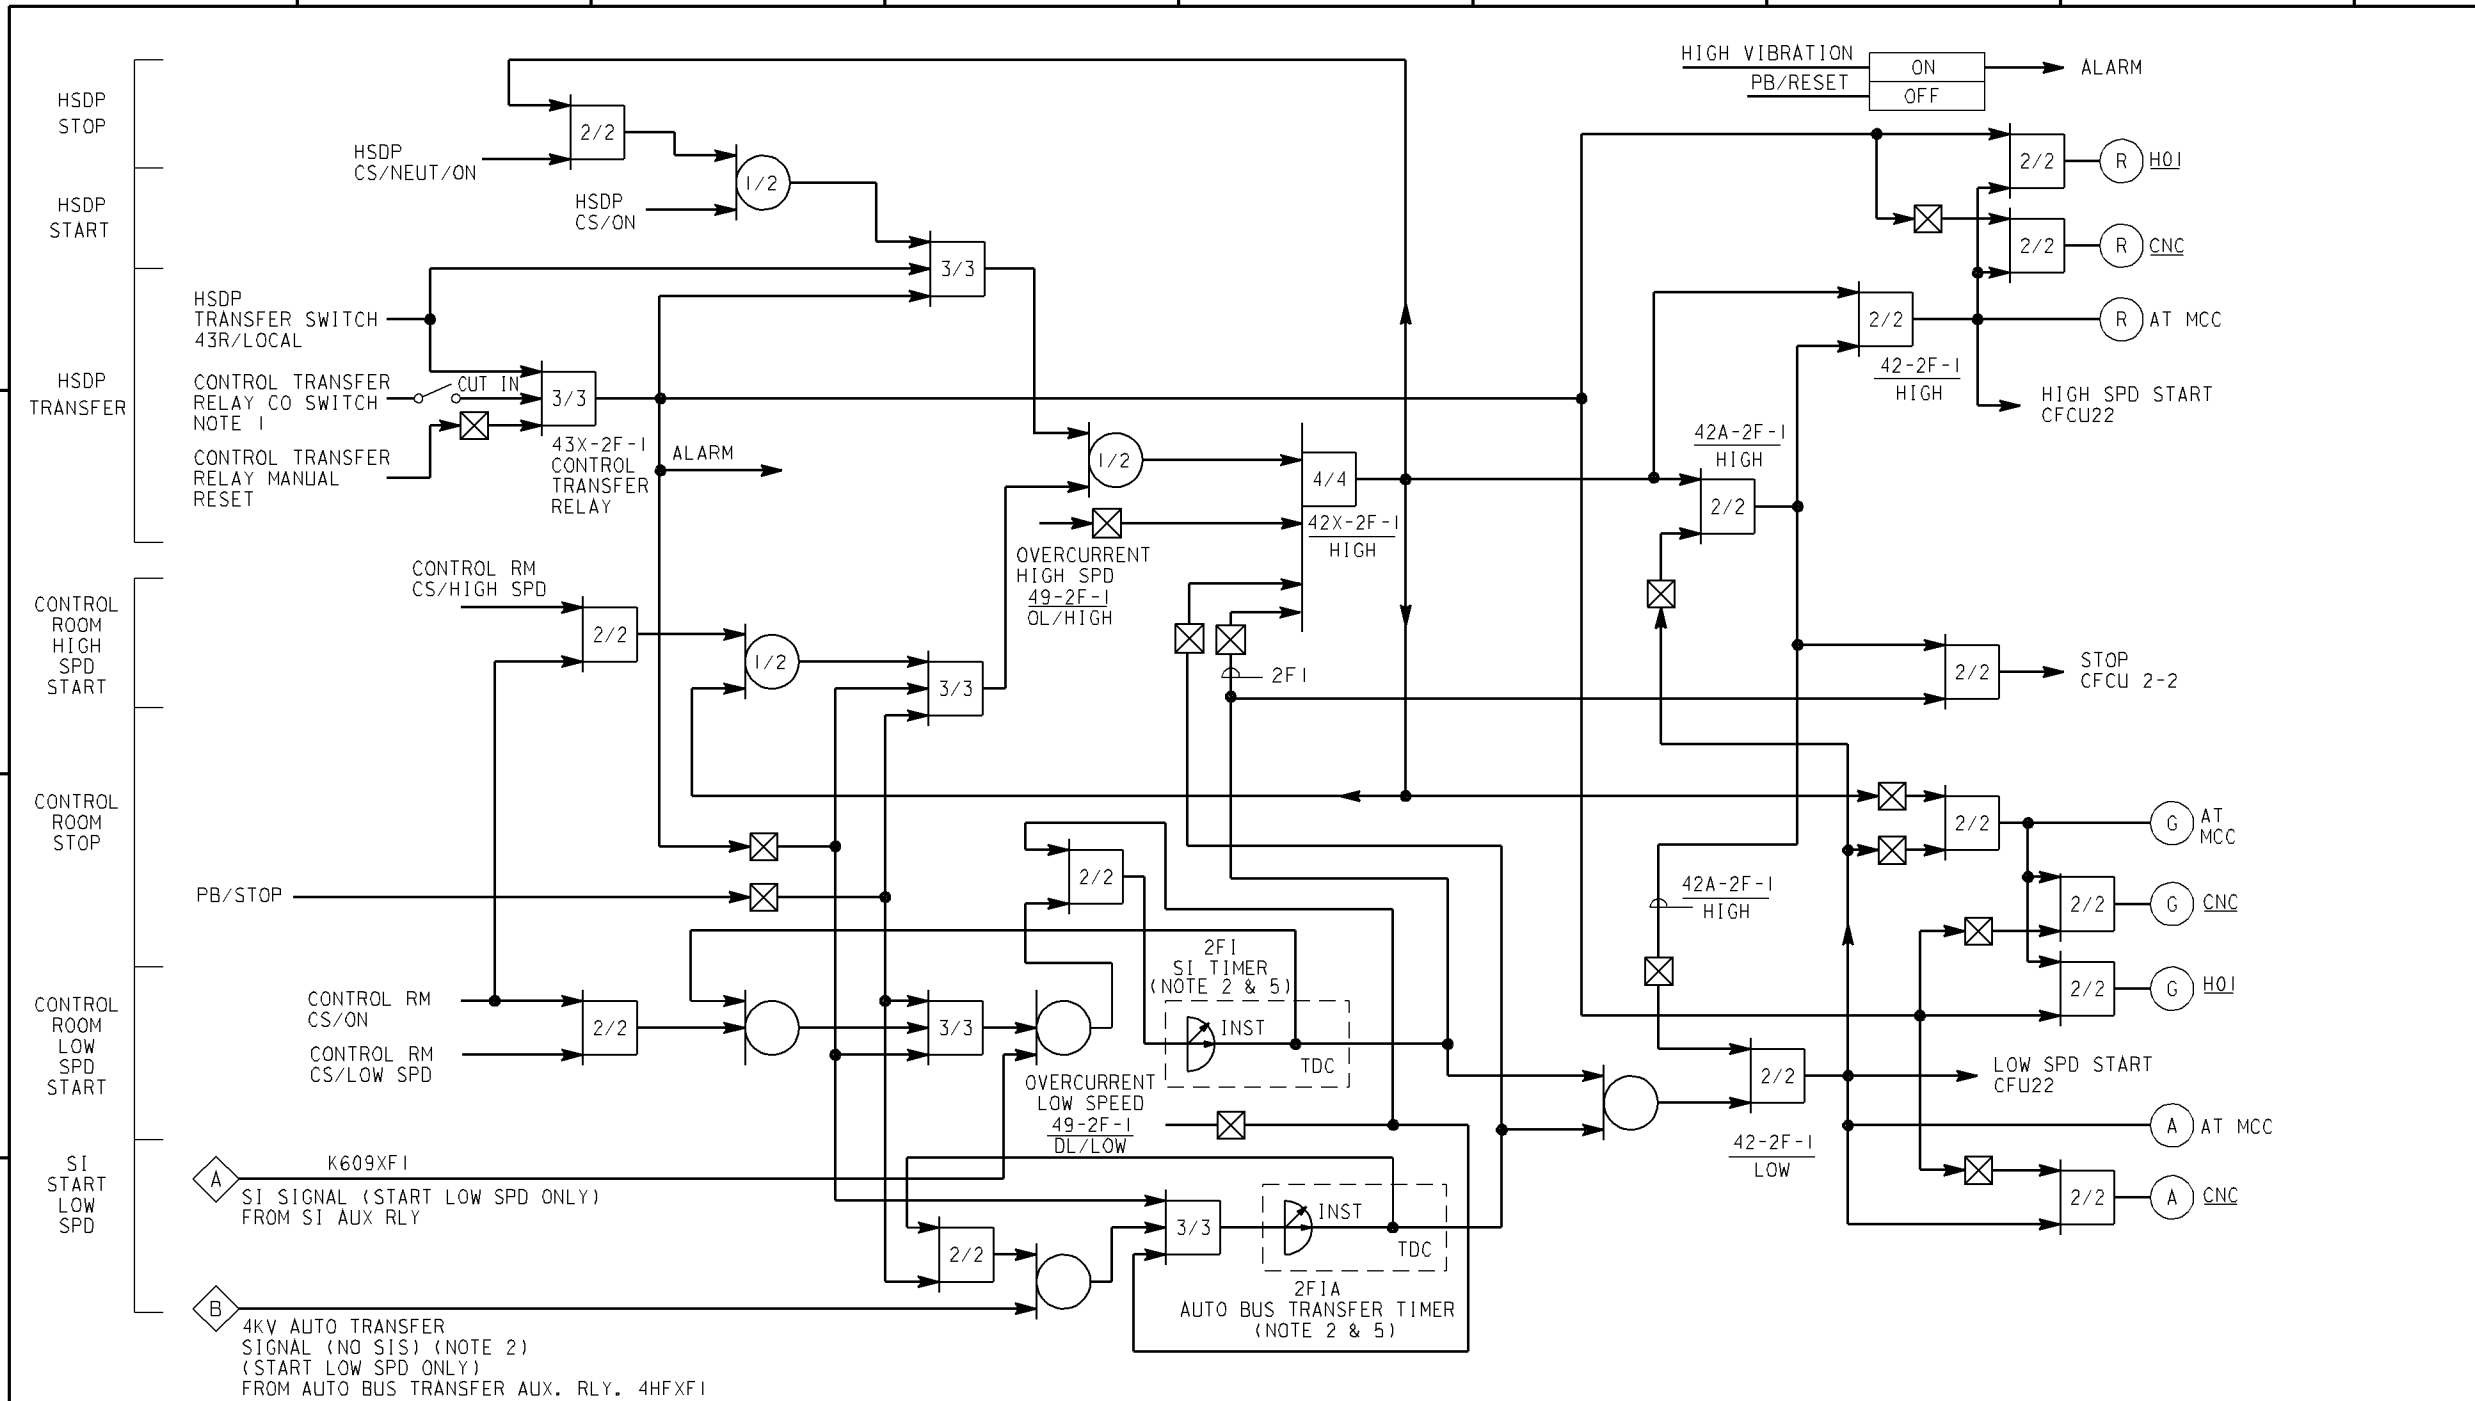


TABLE A				
CFCU	DEVICE	DESCRIPTION	SETTING	
22	2F1	SI TIMER	REF 2	
22	2F1A	AUTO XFR TIMER	REF 2	
21	2F2	SI TIMER	REF 2	
21	2F2A	AUTO XFR TIMER	REF 2	
23	2G1	SI TIMER	REF 3	
23	2G1A	AUTO XFR TIMER	REF 3	
24	2H1	SI TIMER	REF 4	
24	2H1A	AUTO XFR TIMER	REF 4	
25	2G2	SI TIMER	REF 3	
25	2G2A	AUTO XFR TIMER	REF 3	
REFERENCES:			DWG NO.	
1. LOGIC DIAG SYMBOLS			— — — 19425	
2. LOGIC DIAG 4KV "F" AUTO XFR			— 441286	
3. LOGIC DIAG 4KV "G" AUTO XFR			— 441297	
4. LOGIC DIAG 4KV "H" AUTO XFR			— 441337	
5. LIST OF ELEC DEVICES FOR			PROT & CONTROL — — — — SAP	
6. SCH DIAG FAN COOLERS			— — — 441313	
NOTES:				
1. CONTROL TRANSFER RELAY C.O. SWITCH FANS 21, 23 & 24 - NORMALLY CUT IN FANS 22, 25 - NORMALLY CUT OUT ALARM WHEN NOT IN NORMAL POSITION				
2. THE PREFIX 2 REFERS TO IEEE DEVICE #2 WHICH IS A TIME DELAY STARTING OR CLOSING RELAY. IT'S NOT REFERRING TO UNIT 2				
3. DELETED				
4. 480V AC IS REQUIRED FOR 120V CONTROL POWER.				
5. SINGLE RELAYS HAVE BEEN REPLACED WITH TWO (2) RELAYS. ONE (1) RELAY HAS INSTANTANEOUS CONTACTS AND ONE (1) RELAY HAS THE TIME DELAY CONTACTS. THE LOGIC IS THE SAME.				
LEGEND:				
43R - TRANSFERS CONTROL FROM CONTROL BOARD TO HOT SHUTDOWN PANEL (HSDP)				
◇ - DENOTES INTERCONNECTION TO OTHER LOGIC DIAG. REF 2, 3 & 4				

KEY DWG. SECTION 3


NUCLEAR SAFETY RELATED

UNIT 2

DATE		REVISION DESCRIPTION		ELECTRICAL		DWG SCALE:			
09-05-2012		REVISED PER DDN-2*933		LOGIC DIAGRAM		BILL OF MATL:			
D.D.	MNRU					SUPSDS:			
R.E.	FxC2					SUPSD BY:			
I.V.						DRAWING	SHEET	PAGE	REV
P.E.	AGB2					102791	1	0	16



DIABLO CANYON POWER PLANT
PACIFIC GAS AND ELECTRIC COMPANY
SAN FRANCISCO, CALIFORNIA

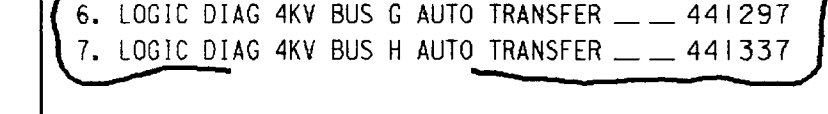

102792	4
--------	---

SAN FRANCISCO, CALIFORNIA

KEY DWG--SEC		
APPROVED BY	GM 169972	
LRW	SUPV H. HERTING	
	DSGN E. ZEITER	
DN	DWN	
JWC	CHKD EZ	
	OK HH	DPJ
TAB	DATE 9-23-75	
	SCALES NONE	

REVISIONS

CAD User: JDP7 Date: 3-03-1998
DGN=102793D.E62


E

D

C

B

A

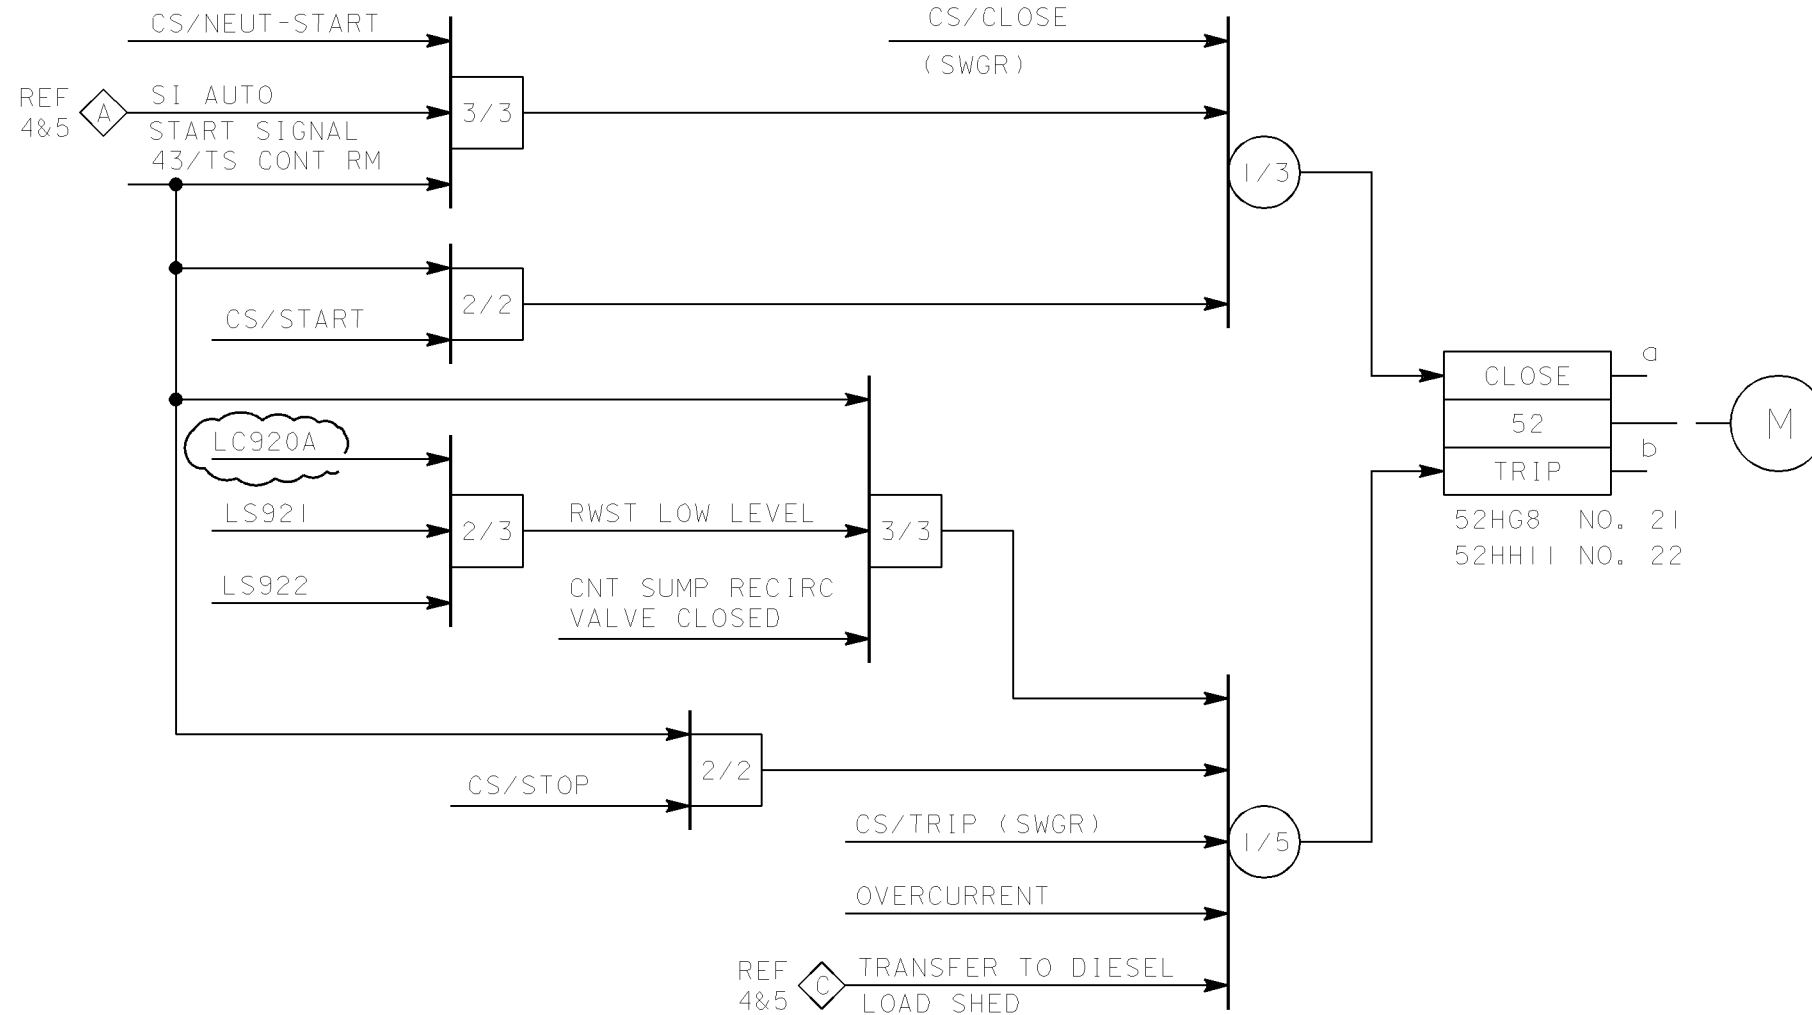


NOTE

1. 43/TS-TRANSFERS CONTROL FROM LOCAL TO CONTROL ROOM (SW LOC AT SWGR)

REFERENCES:

DWG NO.

1. SCH DIAG RES HEAT REM _ _ _ _ 441309
2. LOG DIAG SYMBOLS _ _ _ _ 19425
3. S.L. M&R DIAG 4KV G&H _ _ _ _ 441230
4. LOGIC DIAGRAM 4KV BUS "G" AUTO TRANSFER _ 441297
5. LOGIC DIAGRAM 4KV BUS "H" AUTO TRANSFER _ 441337

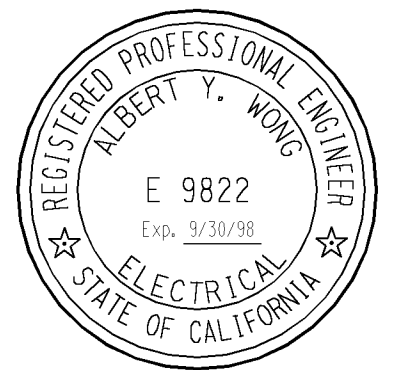

KEY DWG--SECTION 3

NUCLEAR SAFETY RELATED

UNIT 2

DATE 3/4/98		DESCRIPTION		COORDINATION	
DWN.	JDP7	Revised per FCT 022816		NUCL.	-
R.E.	KMSI			MECH.	-
INDEP. VERIFIER	-			ELEC.	-
				CIVIL	-
P.E.	AYWI			PIPING	-
				I&C	-
REVISION INFORMATION					

LOGIC DIAGRAM
RESIDUAL HEAT REMOVAL PUMPS

DIABLO CANYON POWER PLANT
PACIFIC GAS AND ELECTRIC COMPANY
SAN FRANCISCO, CALIFORNIA

DWG SCALE	
BILL OF MATL	
SUPSDS	
SUPSD BY	
SHEET NO.	OF
102793	REV 5

102794

DWG TYPE 4

SUBJECT SAFETY INJECTION PUMPS

DRAWING TITLE INJECTION PUMPS

UNIT NO 2

PROJECT LOCATION DIABLO 45-50

INSTALLATION TYPE L

DIVISION NAME B


MISC 53

DD CODE GD

MAN HOURS 57 59


CADD C

DRAWING SOURCE A 70

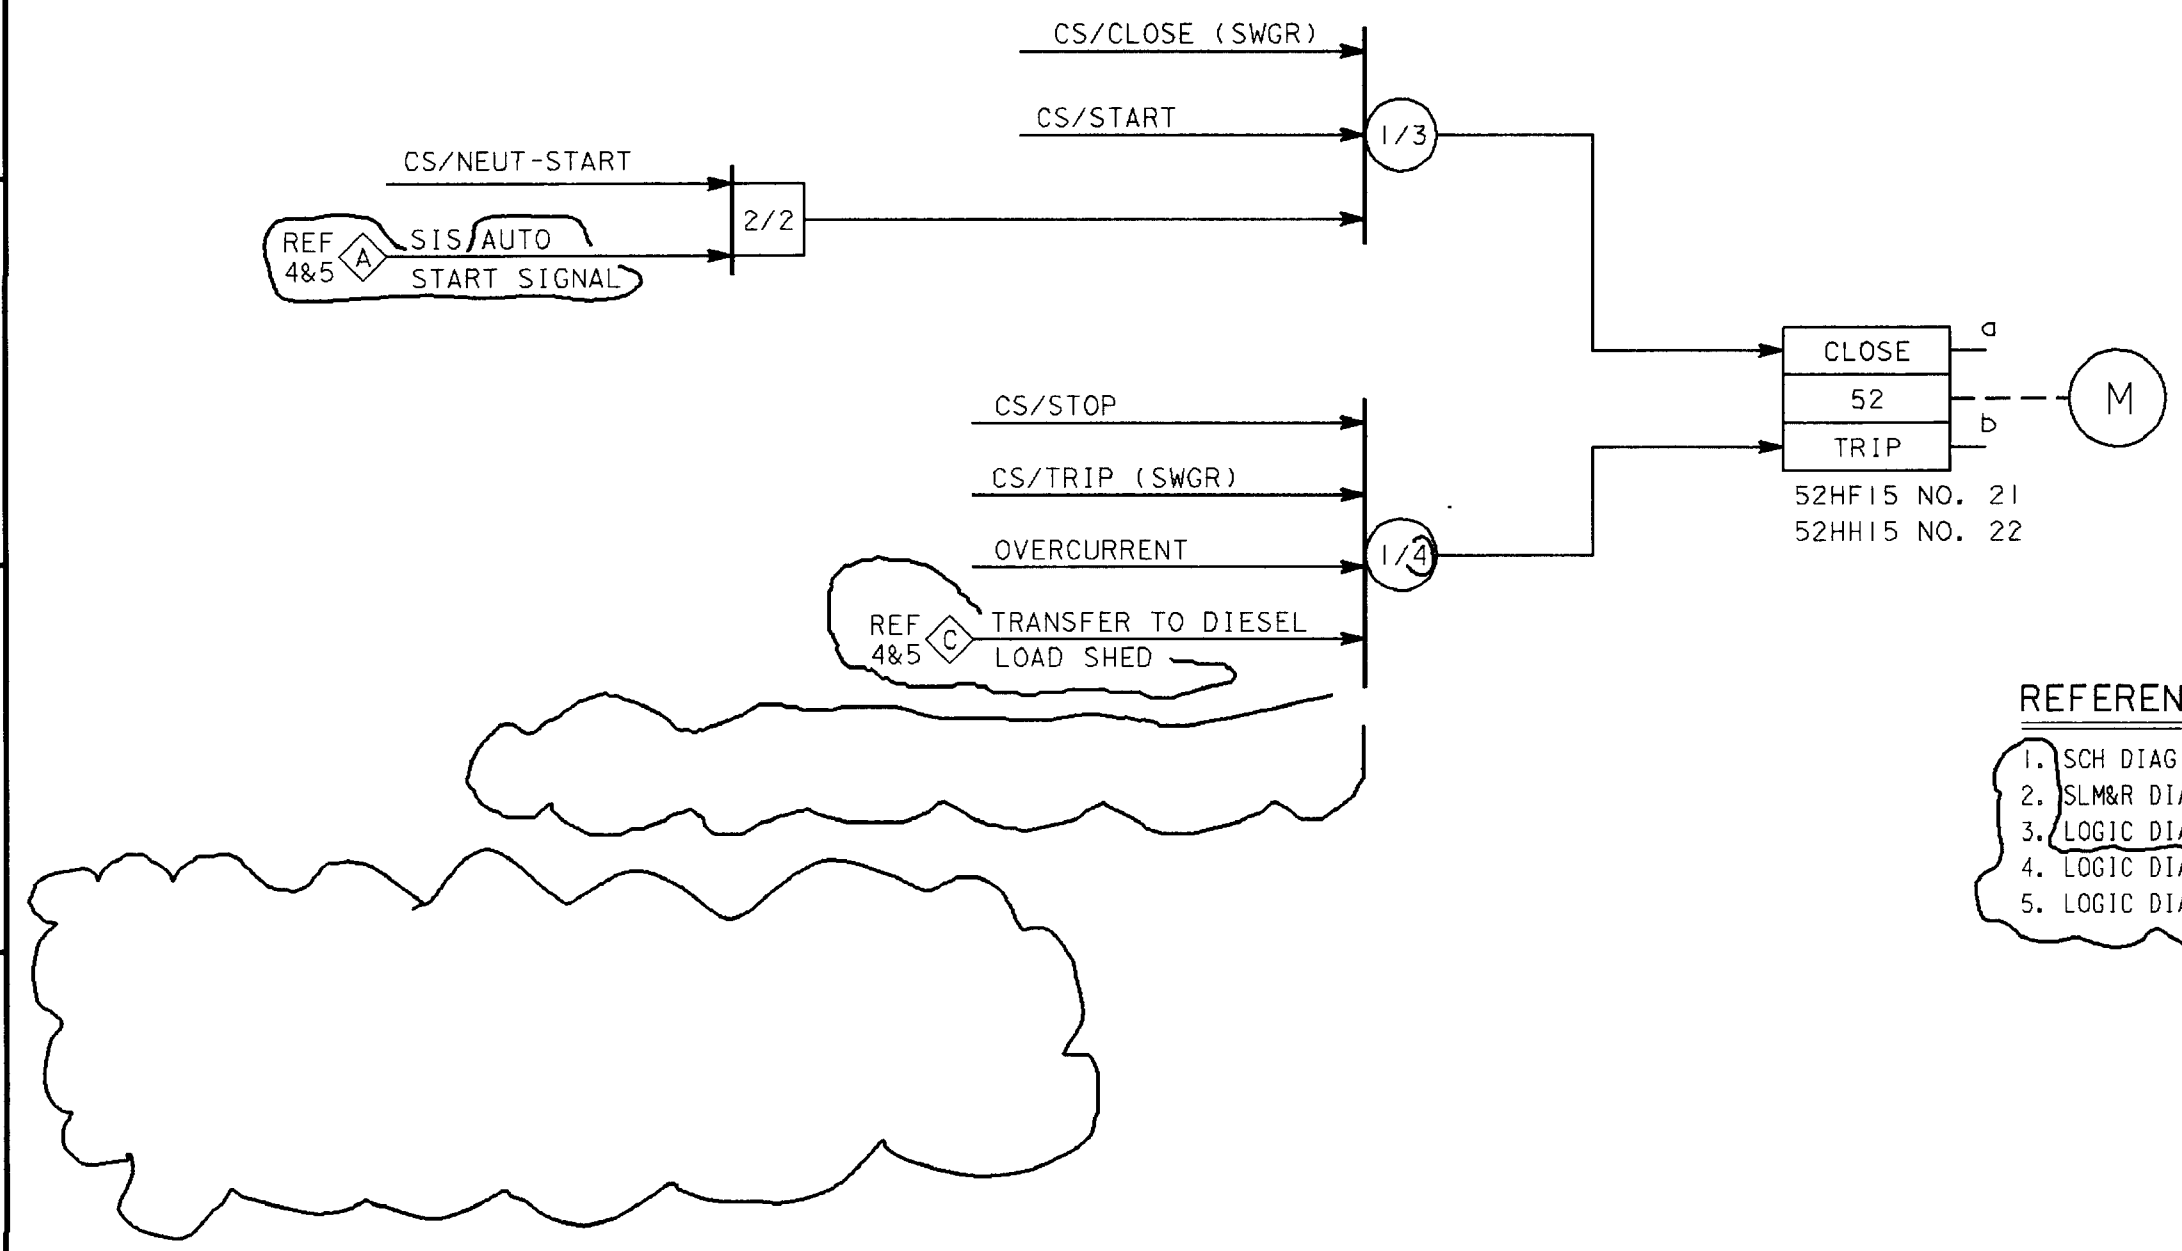

- REFERENCES
- DWG NO.
- 1. SCH DIAG SAFETY INJ PP ——— 441315
 - 2. SLM&R DIAG 4KV BUS F, G & H ——— 441229 & 441230
 - 3. LOGIC DIAG SYMBOLS ——— 19425
 - 4. LOGIC DIAG 4KV BUS "F" AUTO TRANSFER — 441286
 - 5. LOGIC DIAG 4KV BUS "H" AUTO TRANSFER — 441337

RM INDEXED REV. 2

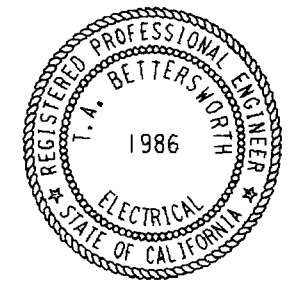

COAST VALLEYS DIVISION

MICROFILM 3

BILL OF MATL

DWG LIST

SUPSDS

SUPSD BY

SHEET NO. 102794

SHEETS 3

REV. 3

NUCLEAR SAFETY RELATED

UNIT 2

LOGIC DIAGRAM
SAFETY INJECTION PUMPS

DIABLO CANYON

DEPARTMENT OF ENGINEERING
PACIFIC GAS AND ELECTRIC COMPANY
SAN FRANCISCO, CALIFORNIA

3	M Barn	UP	C12314	12/31/94
REV	REGISTERED ENGINEER	SIGNATURE	CA REG NO.	EXP DATE


KEY DWG--SECTION 3

NO.	DATE	DESCRIPTION	GM	DWN.	CHKD.	SUPV.	APVD.
3	1-19-94	REDRAWN; REV LOGIC; DEL NOTE; ADD REF 4 & 5 (FCT-16395)	---	WWL	WY	ICL	UP
2	2-16-90	REV NOTE (FCT-10370)	169972	TC	VL/LCV	SLW	---
1	9-30-75	APPROVED FOR CONSTRUCTION	169972	EZ	---	LRW	---

APPROVED BY	GM 169972
LRW	SUPV. H HERTING
DN	DSGN. E ZEITER
JWC	DWN.
TAB	CHKD. E ZEITER
	O.K. HH / DPJ
	DATE 9-30-75
	SCALES
	NONE

DWG TYPE 4 14
SUBJECT 15
DWM SUBJECT 16
DRAWING TITLE 16-44
CONTAINMENT SPRAY PUMPS
UNIT NO. 2 42 44
PROJECT LOCATION 45-50
DIABLO
INSTALLATION TYPE L 51
DIVISION NAME B 52
MISC 53
DD CODE 55 56
MAN HOURS 57 59
CADD C 60
DRAWING SOURCE A 70


962201
102795

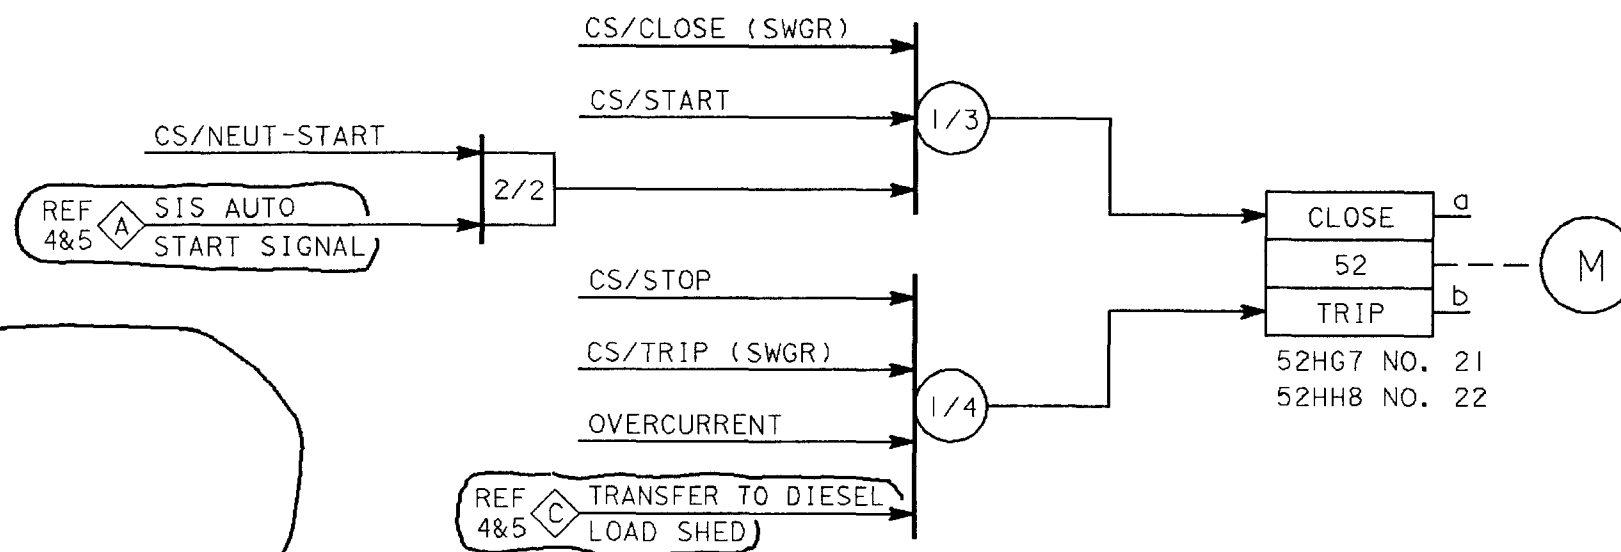

REFERENCES

- | | DWG NO. |
|---|---------|
| 1. SCH DIAG CONTAINMENT SPRAY. ——— | 441307 |
| 2. LOGIC DIAG SYMBOLS ——— | 19425 |
| 3. SLM&R DIAG 4KV BUS G & H ——— | 441230 |
| 4. LOGIC DIAG 4KV BUS G AUTO TRANSFER — | 441297 |
| 5. LOGIC DIAG 4KV BUS H AUTO TRANSFER — | 441337 |

RM INDEXED REV. 2

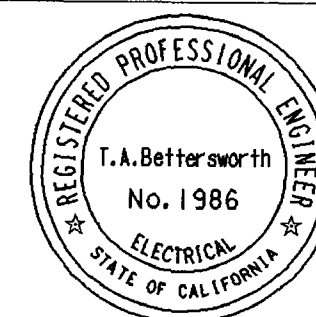

COAST VALLEYS DIVISION

MICROFILM 3

BILL OF MATL

DWG LIST

SUPSDS

SUPSD BY

SHEET NO. SHEETS

102795 3

U#1=19411

NUCLEAR SAFETY RELATED

UNIT 2

LOGIC DIAGRAM
CONTAINMENT SPRAY PUMPS

DIABLO CANYON

DEPARTMENT OF ENGINEERING
PACIFIC GAS AND ELECTRIC COMPANY
SAN FRANCISCO, CALIFORNIA

3	M. Basu	<i>[Signature]</i>	C12314	12/31/94
REV	REGISTERED ENGINEER	SIGNATURE	CA REG NO.	EXP DATE

KEY DWG--SECTION 3

NO.	DATE	DESCRIPTION	GM/SPEC	DWN	CHKD	SUPV	APVD BY
3	1-14-94	REDRAWN; REV LOGIC; DEL NOTE; ADD REF 4 & 5 (FCT-16395)	—	DWL	wg	LD	mt
2	3-2-83	RES LOGIC INPUT CNT SPRAY (DC2-EE-4377) SAN 281	169972	WC	LCV	JC	JEH SA
1	9-30-75	APPROVED FOR CONSTRUCTION	169972	EZ		LRW	

REVISIONS

APPROVED BY	GM 169972
	SUPV H. HERTING
LRW	DSGN E. ZEITER
DN	DWN
	CHKD EZ
JWC	OK HH DPJ
	DATE 9-23-75
TAB	SCALES NONE

102795D.E62 01-13-94 DWL

RASTER=102796.dgn
 DGN=102796.dgn
 CAD User:ADMI Date: 04-14-2008

E


D

C

B

A

12345678910

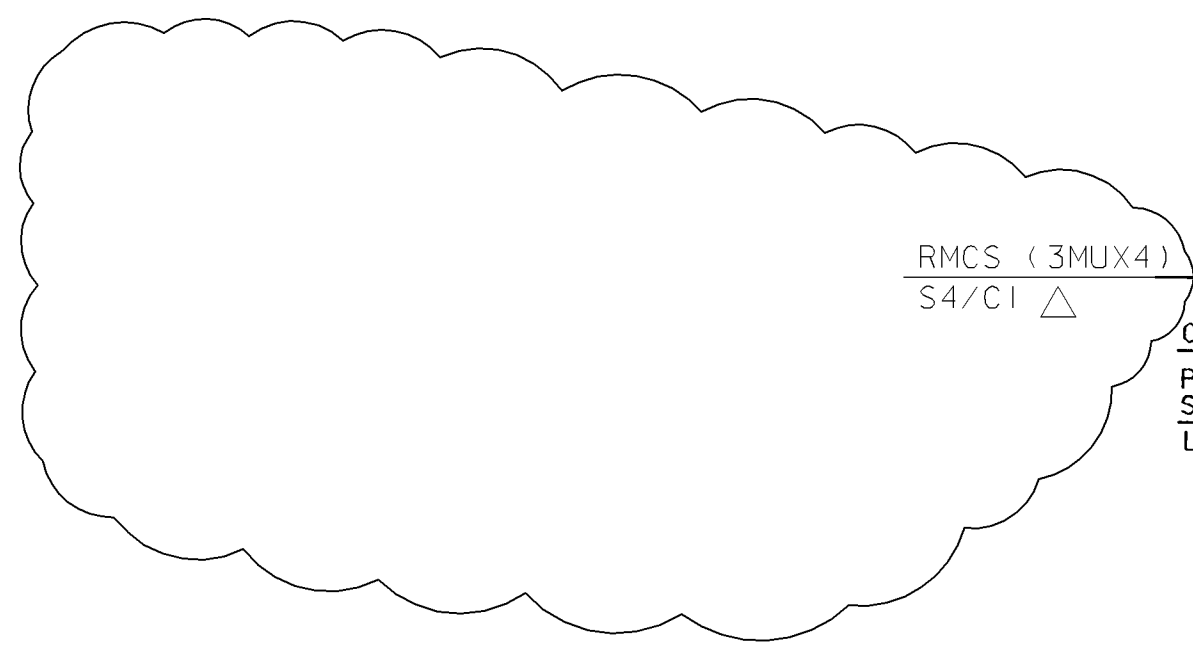

RMCS (3MUX4)
 S4/CI △

CS/AUTO
 PRIMARY WTR
 STORAGE TANK
 LOW LEVEL LS472X

3/3

CS/ON

1/2

CS/OFF

OVERCURRENT

1/2

2/2

RUN

NOTES

△ - SIGNAL FROM RMCS-RNARB PLC OUTPUT S4/CI.

REFERENCE

DWG NO.

- SCH DIAG CHEM & VOL CONT SYS _ 441321
- SCH. DIAG. RC M-U SYST.441320

NUCLEAR SAFETY RELATED

KEY DWG. SECTION 3

UNIT 2

DATE 04-14-2008			REVISION DESCRIPTION		ELECTRICAL LOGIC DIAGRAM MAKE-UP WATER PUMPS DIABLO CANYON POWER PLANT PACIFIC GAS AND ELECTRIC COMPANY SAN FRANCISCO, CALIFORNIA		DWG SCALE:			
D.D.	ADMI		REVISED PER DC2-SE-50779-01				BILL OF MATL:			
R.E.	FxC2						SUPSDS:			
I.V.							SUPSD BY:			
P.E.	RWB7						DRAWING 102796			

RASTER=102797.dgn
DGN=102797.dgn
CAD User:ADMI Date:04-14-2008

E

D

C

B

A

NOTES

43R - TRANSFERS CONTROL FROM MAIN CONTROL
OR BOARD TO HOT SHUTDOWN PANEL (HSP).
43TS 43R LOCATED AT HSP. 43TS LOCATED AT MCC.

* - CS LOCATED AT HOT SHUTDOWN PANEL

△ - SIGNAL FROM RMCS-RNARB PLC
OUTPUT S4/C0.

REFERENCE

DWG NO.

1. SCH DIAG CHEM & VOL CONT SYS - 441321
2. SCH. DIAG. RC M-U SYST. - 441320

KEY DWG. SECTION 3


NUCLEAR SAFETY RELATED

UNIT 2

DATE 04-14-2008			REVISION DESCRIPTION		ELECTRICAL LOGIC DIAGRAM BORIC ACID TRANSFER PUMPS DIABLO CANYON POWER PLANT PACIFIC GAS AND ELECTRIC COMPANY SAN FRANCISCO, CALIFORNIA				DWG SCALE:			
D.D.	ADMI		REVISED PER DC2-SE-50779-01						BILL OF MATL:			
R.E.	FxC2								SUPSDS:			
I.V.									SUPSD BY:			
P.E.	RWB7								DRAWING 102797			



DRAWING SOURCE: A 70
CADD: C 60
MAN HOURS: 57 59
DD CODE: GD 55 56
MISC: 53
INSTALLATION DIVISION NAME: B 52
PROJECT LOCATION: L 51
UNIT NO.: 42 44
DRAFTING TITLE: AUX FEEDWATER PUMPS
DWG TYPE SUBJECT: 4 14

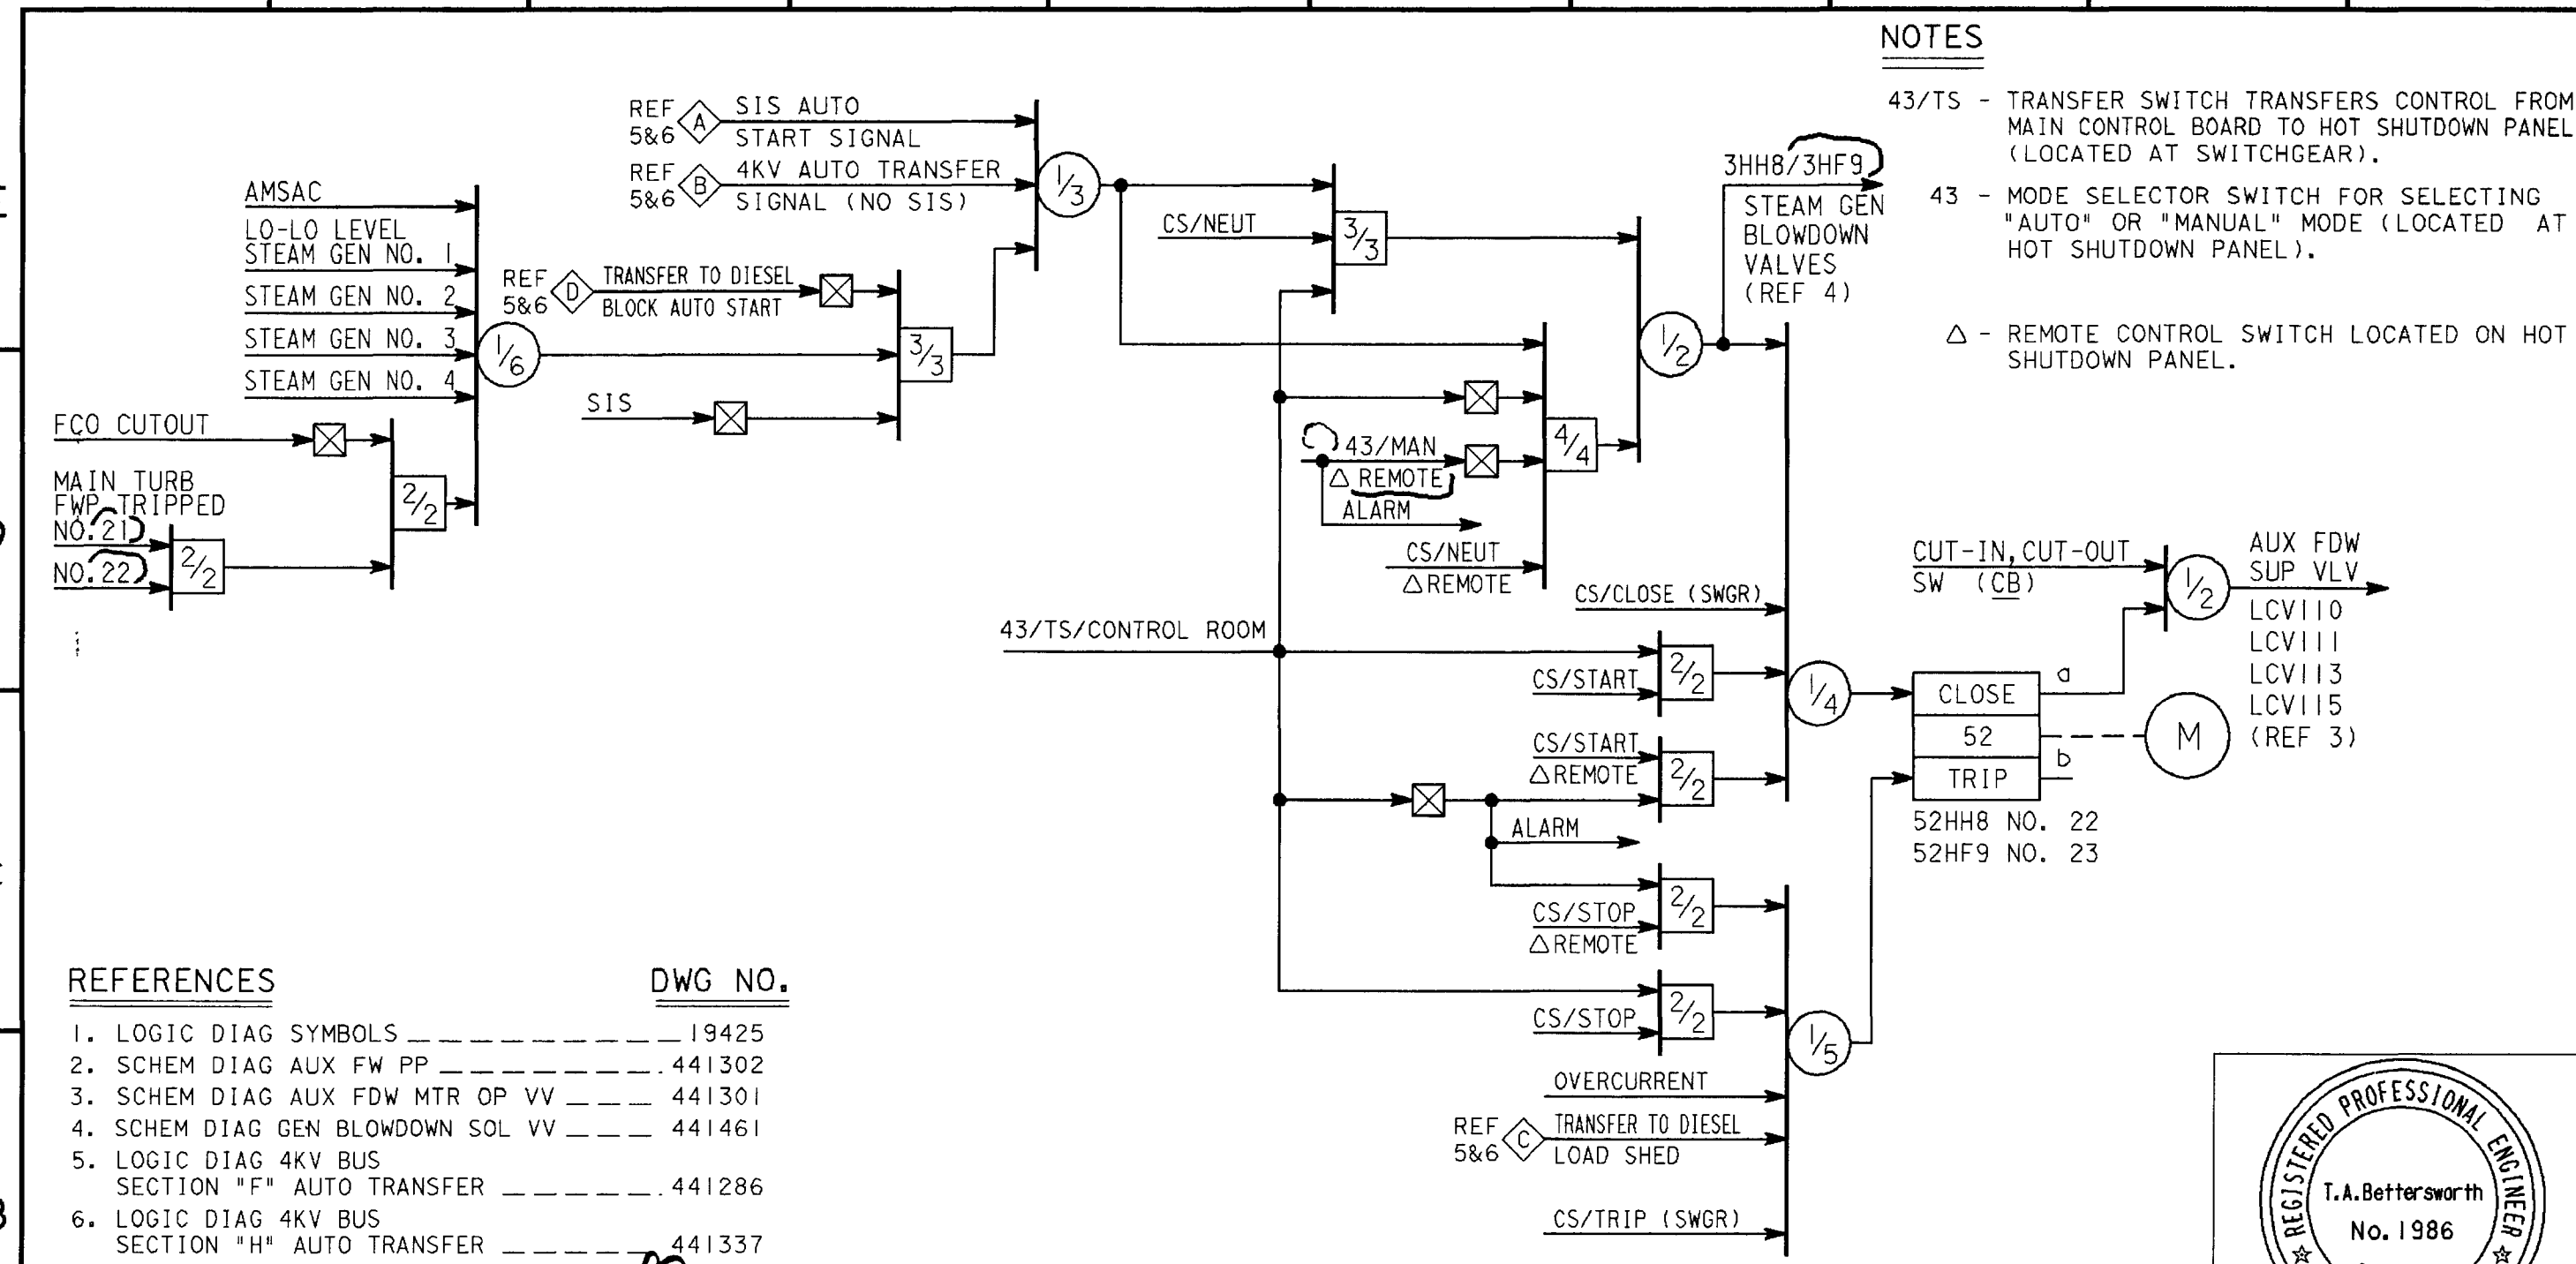

NOTES

43/TS - TRANSFER SWITCH TRANSFERS CONTROL FROM MAIN CONTROL BOARD TO HOT SHUTDOWN PANEL (LOCATED AT SWITCHGEAR).


43 - MODE SELECTOR SWITCH FOR SELECTING "AUTO" OR "MANUAL" MODE (LOCATED AT HOT SHUTDOWN PANEL).

Δ - REMOTE CONTROL SWITCH LOCATED ON HOT SHUTDOWN PANEL.

- REFERENCES**
- | | DWG NO. |
|---|---------|
| 1. LOGIC DIAG SYMBOLS | 19425 |
| 2. SCHEM DIAG AUX FW PP | 441302 |
| 3. SCHEM DIAG AUX FDW MTR OP VV | 441301 |
| 4. SCHEM DIAG GEN BLOWDOWN SOL VV | 441461 |
| 5. LOGIC DIAG 4KV BUS SECTION "F" AUTO TRANSFER | 441286 |
| 6. LOGIC DIAG 4KV BUS SECTION "H" AUTO TRANSFER | 441337 |

8	M. Basu	U.P.	C12314	12/31/94
REV	REGISTERED ENGINEER	SIGNATURE	CA REG NO.	EXP DATE

NUCLEAR SAFETY RELATED

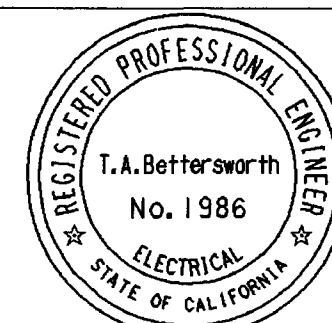

COAST VALLEYS DIVISION

MICROFILM 8

BILL OF MATL
DWG LIST
SUPSDS
SUPSD BY
SHEET NO. 102800
SHEETS 8

102800D.E62 04-28-94 WAA


KEY DWG--SECTION 3

UNIT 2

NO.	DATE	DESCRIPTION	GM/SPEC	DWN	CHKD	SUPV	APVD BY
8	5-5-94	REV LOGIC INPUT DESCRIPTIONS (FCT 17116)	WAA	WJ	ARN	MB	U.P.
7	4-28-94	REV LOGIC; DEL STAR NOTE; ADD REF 5 & 6 (FCT-16395)	WWL	WG	KS	MH/RNT	MB
1	9-30-75	APPROVED FOR CONSTRUCTION	169972	EZ		LRW	DN

APPROVED BY	GM 169972
LRW	SUPV H. HERTING
DN	DSGN E. ZEITER
JWC	DWN
TAB	CHKD EZ
	OK HH DPJ
	DATE 9-23-75
	SCALES NONE

LOGIC DIAGRAM
AUXILIARY FEEDWATER PUMPS
DIABLO CANYON
DEPARTMENT OF ENGINEERING
PACIFIC GAS AND ELECTRIC COMPANY
SAN FRANCISCO, CALIFORNIA

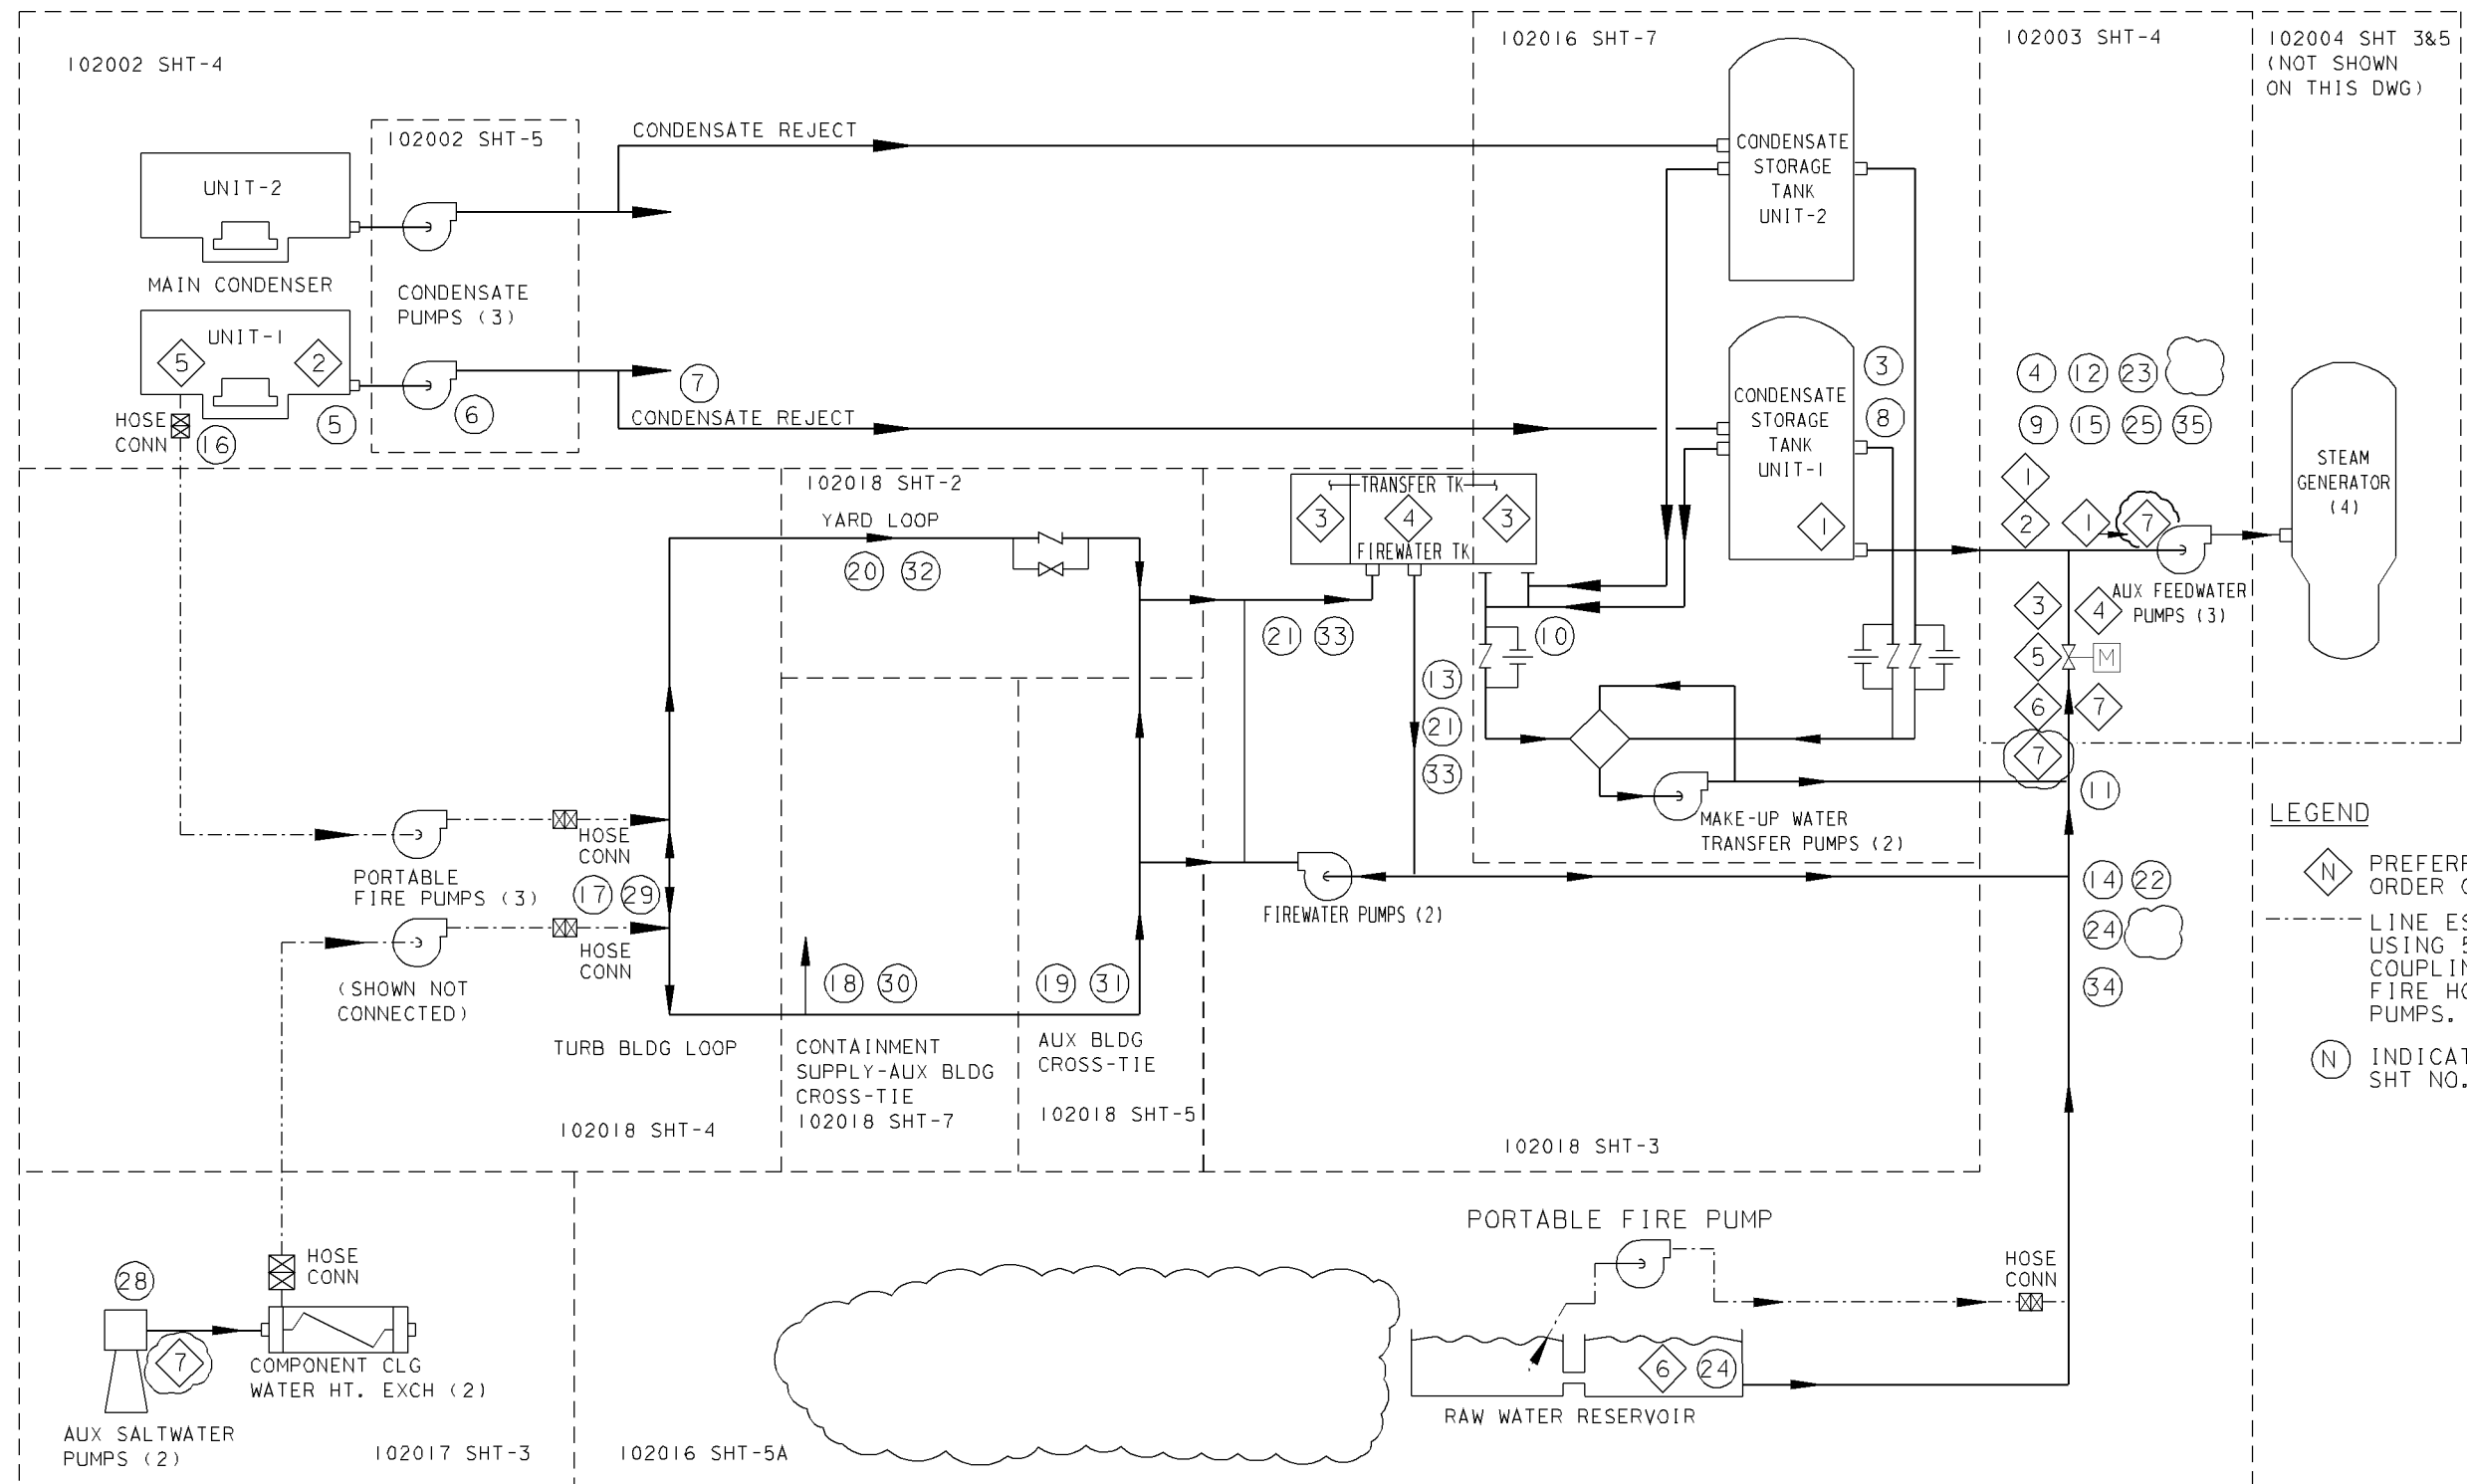

LONG TERM COOLING WATER SYSTEM PIPING SCHEM INTERFACE

NOTE 1. DISTRIBUTION LIST SAME AS DISTRIBUTION LIST FOR LAST
ISSUED PIPE SCHEMATIC 102027 CHG. 7 OF 8-6-81

UNIT 1


DIABLO CANYON POWER PLANT - PG&E CO. LONG TERM COOLING WATER SYSTEMS

DRAWING	SHEET	PAGE	REV
107031	1A	0	6

11-01-2010	JBMX	FxC2		KERSI J. DALAL	MECHANICAL	M 16690	3/31/2012	REVISED PER DDN-2*715
DATE	DWN	RE	IV	PROFESSIONAL ENGINEER	PE DISC.	PE#	PE EXP.	

RASTER=10703ISHIA.dgn
DGN=10703ISHIA.dgn
CAD User: JBMX Date: 11-01-2010

INPGIC
I Size

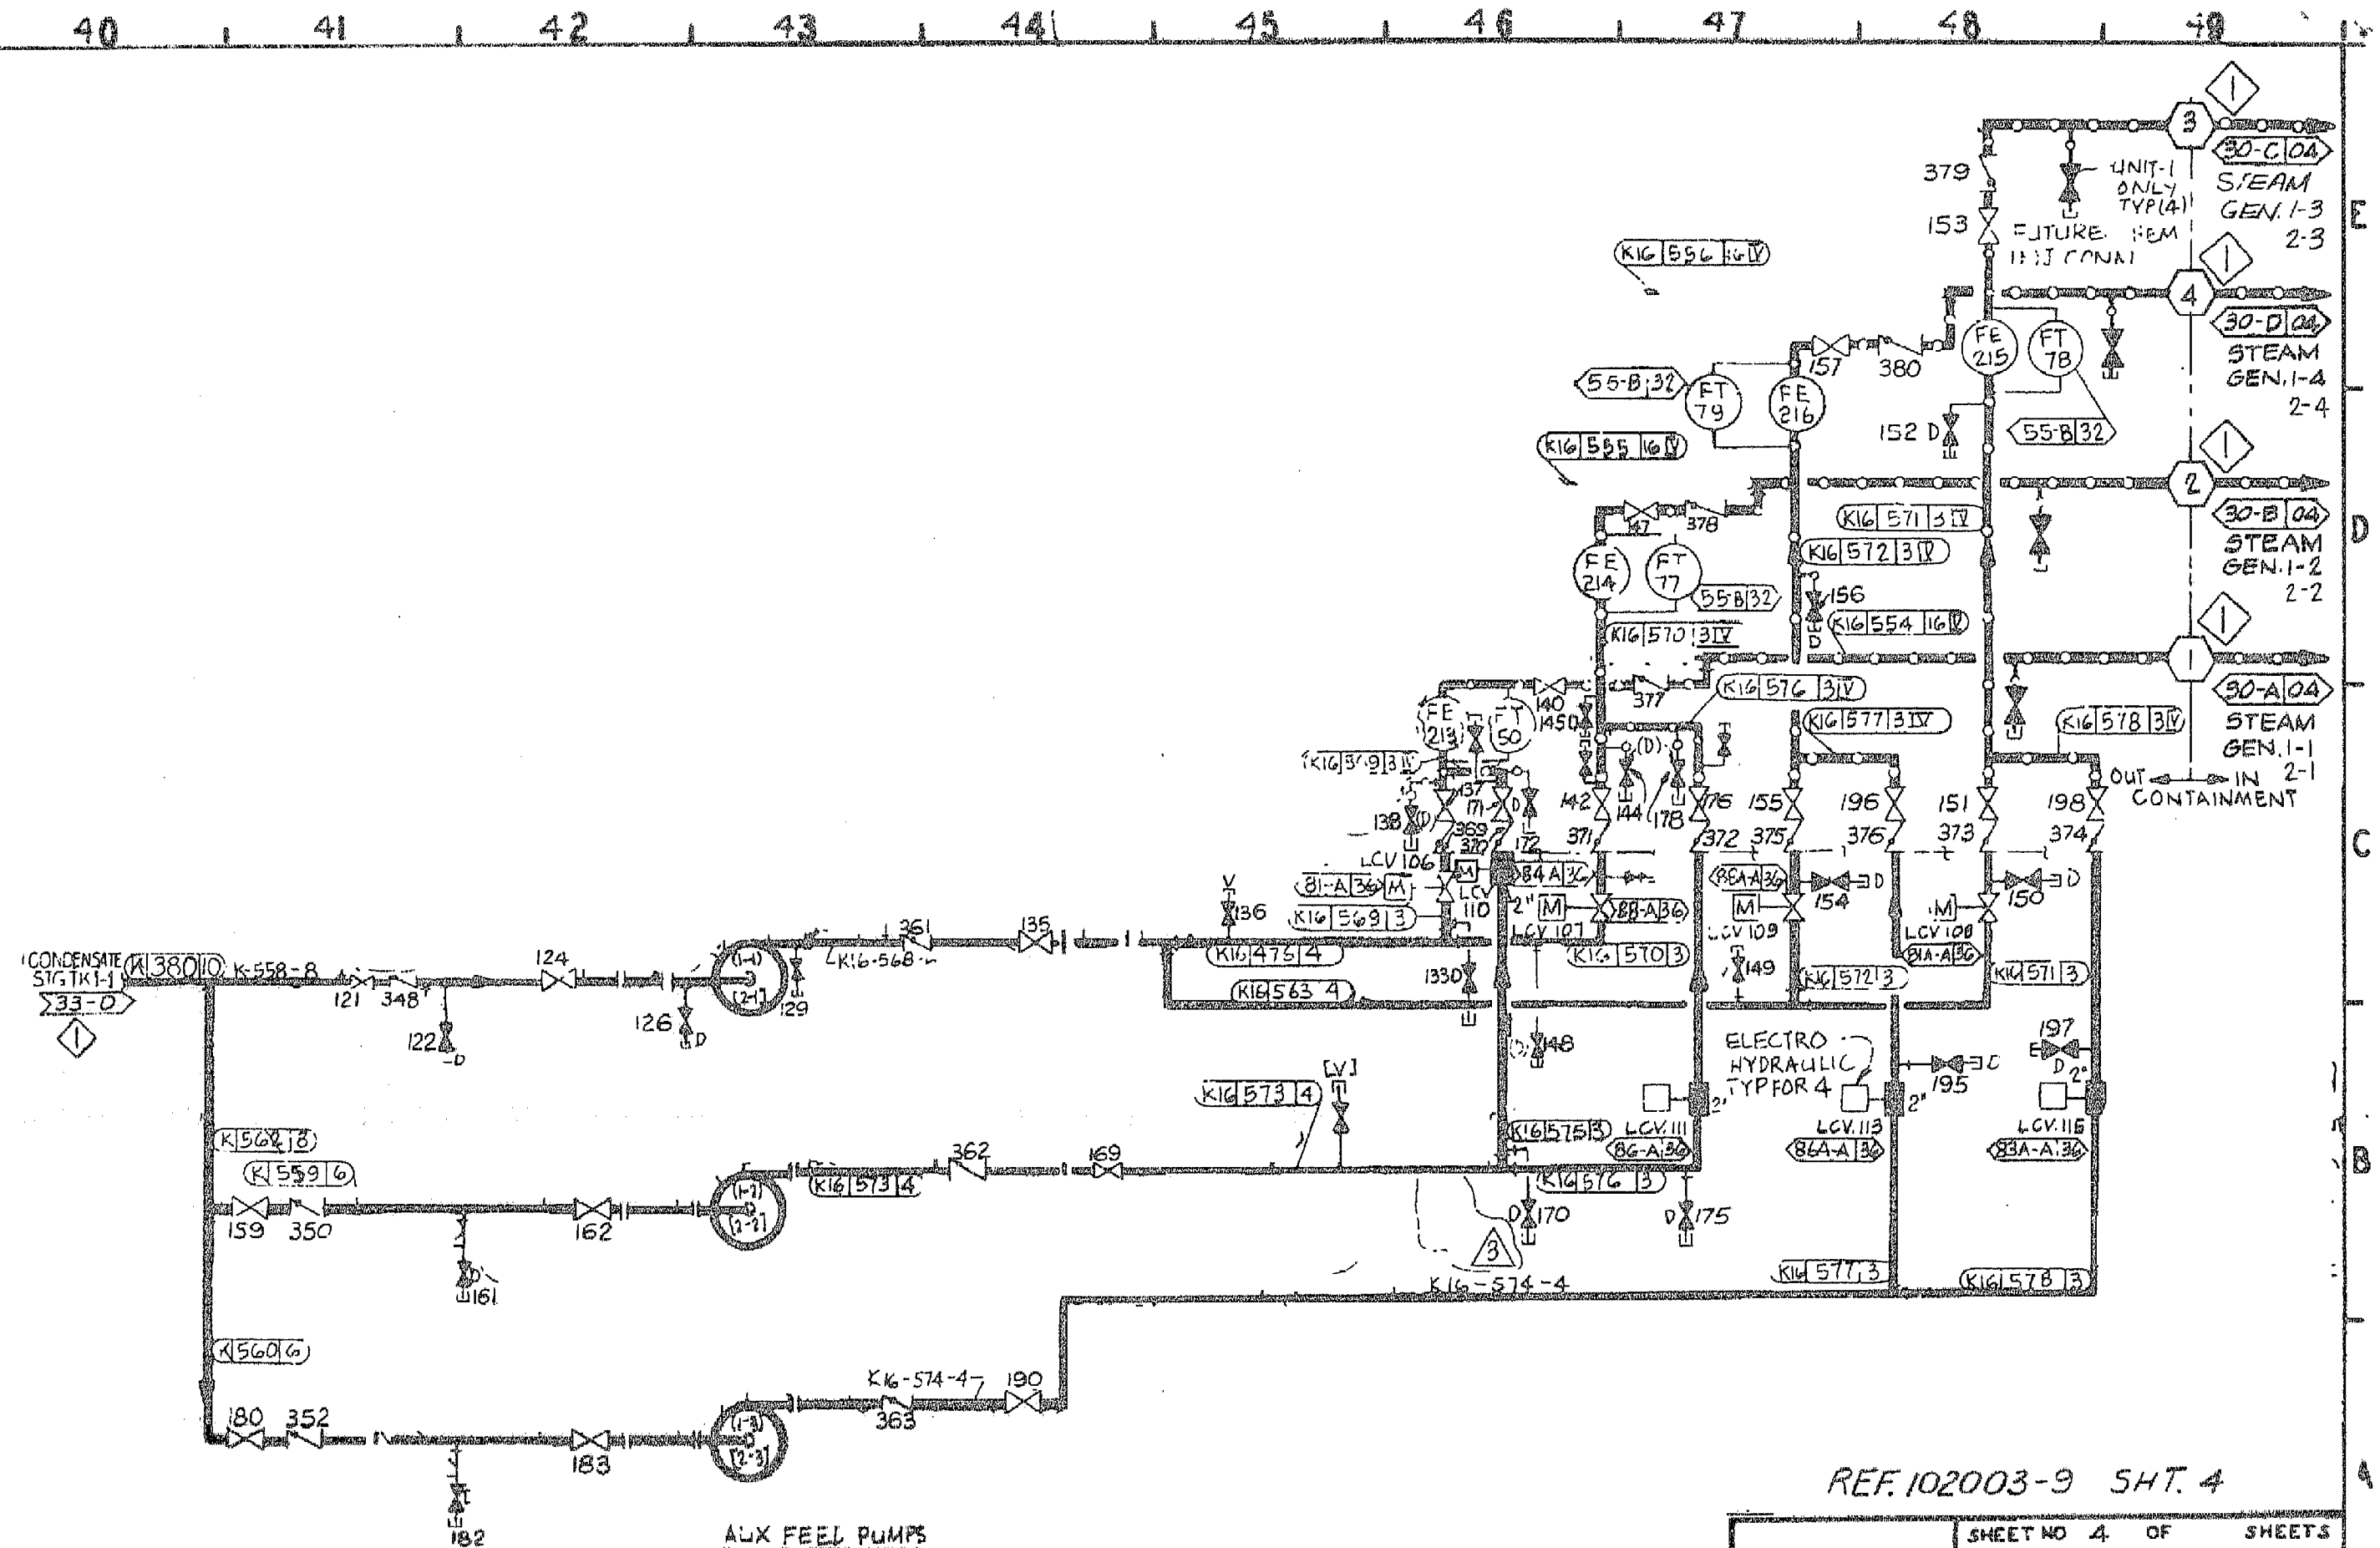


REF. 102003-9 SHT. 4

P.G.&ECQ	SHEET NO. 4 OF SHEETS	
	DRAWING NUMBER	CHANGE
	107031	3

30	31	32	33	34	35	36	37	38	39
VALVE SYMBOLS		EQUIPMENT SYMBOLS		INSTRUMENT SYMBOLS		LINE CODING		VENT, DRAIN, TELL TALE SYSTEM IDENTIFICATION	
PGE & COMMON (NOTE 7) TITLE WESTINGHOUSE		PGE & COMMON (NOTE 7) TITLE WESTINGHOUSE		COMMON (NOTE 7) TITLE		COMMON (NOTE 7) TITLE			
<div><div><div><div><div><div></div><div></div><div></div><div></div><div></div><div></div><div></div><div></div><div></div><div></div><div></div><div></div><div></div><div></div><div></div><div></div><div></div><div></div><div></div><div></div><div></div><div></div><div></div><div></div><div></div><div></div><div></div><div></div><div></div><div></div><div></div><div></div><div></div><div></div><div></div><div></div><div></div><div></div><div></div><div></div><div></div><div></div><div></div><div></div><div></div><div></div><div></div><div></div><div></div><div></div><div></div><div></div><div></div><div></div><div></div><div></div><div></div><div></div><div></div><div></div><div></div><div></div><div></div><div></div><div></div><div></div><div></div><div></div><div></div><div></div><div></div><div></div><div></div><div></div><div></div><div></div><div></div><div></div><div></div><div></div><div></div><div></div><div></div><div></div><div></div><div></div><div></div><div></div><div></div><div></div><div></div><div></div><div></div><div></div><div></div><div></div><div></div><div></div><div></div><div></div><div></div><div></div><div></div><div></div><div></div><div></div><div></div><div></div><div></div><div></div><div></div><div></div><div></div><div></div><div></div><div></diCAD User: JARO

Date: 01-24-2008

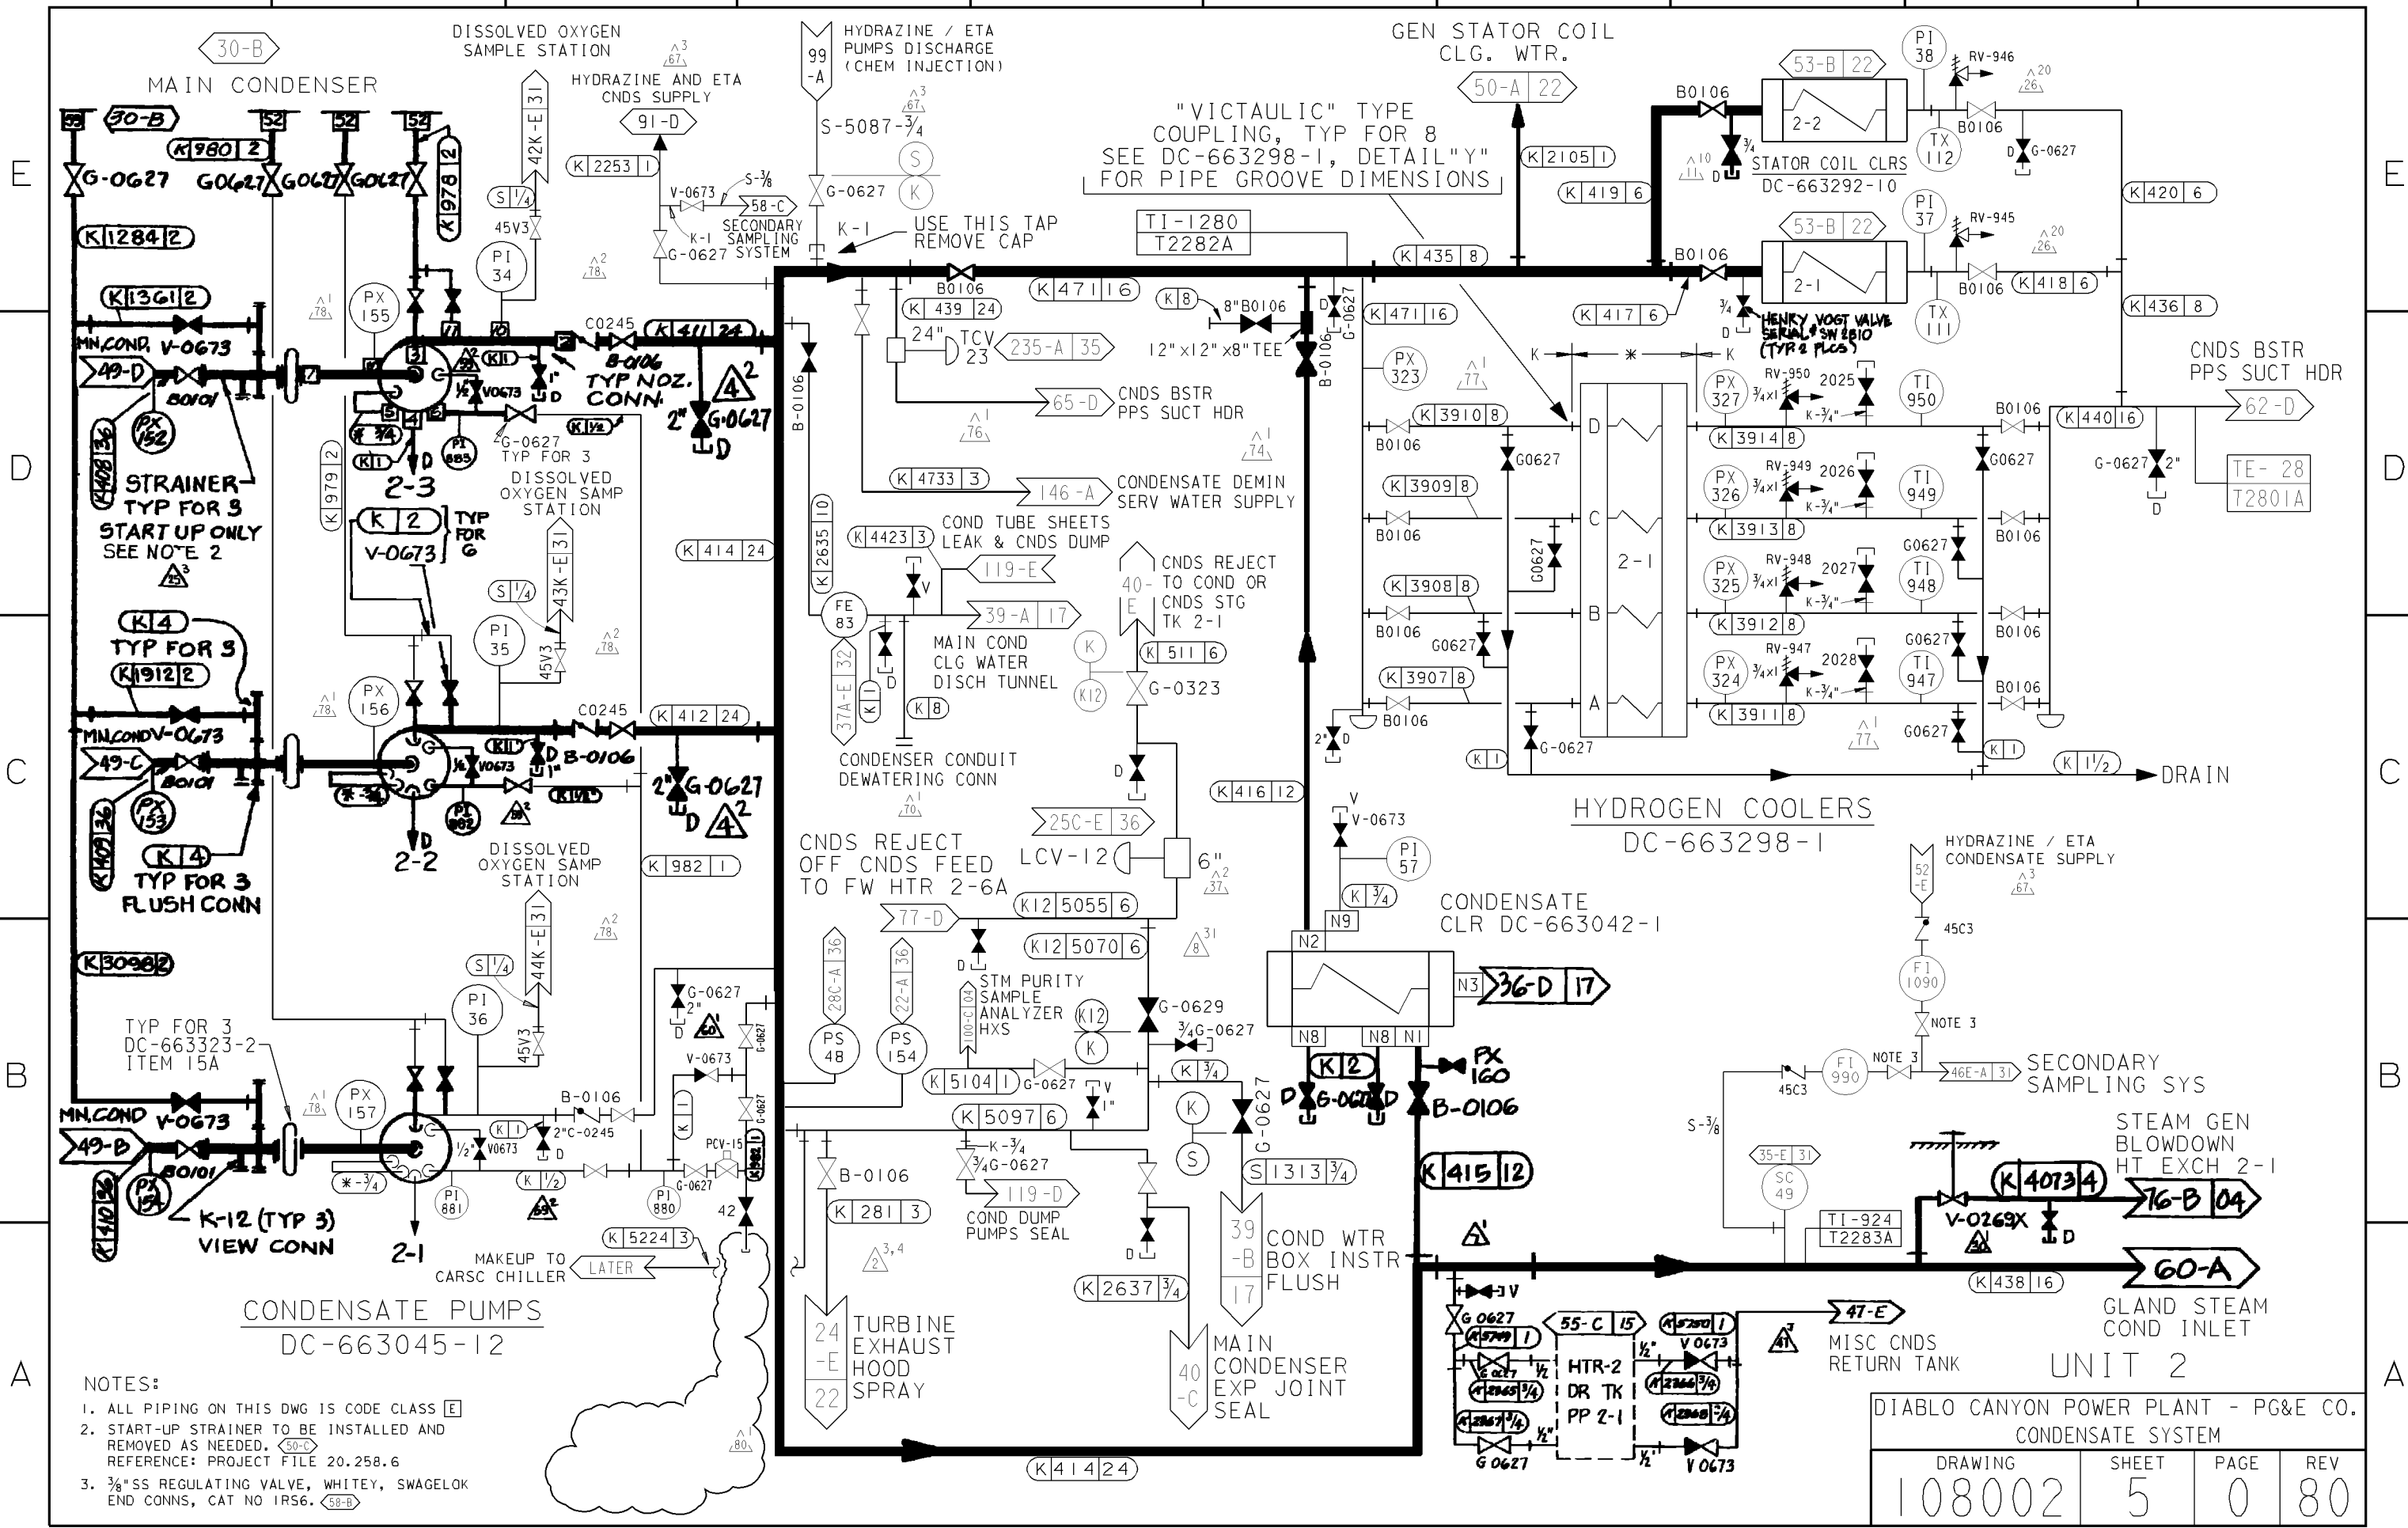

INPGIC
I Size

01-24-2008	JARO	FxC2		KERSI J. DALAL	MECHANICAL	M 16690	3/31/2008	REVISED PER FCT-32251
DATE	DWN	RE	IV	PROFESSIONAL ENGINEER	PE DISC.	PE#	PE EXP.	

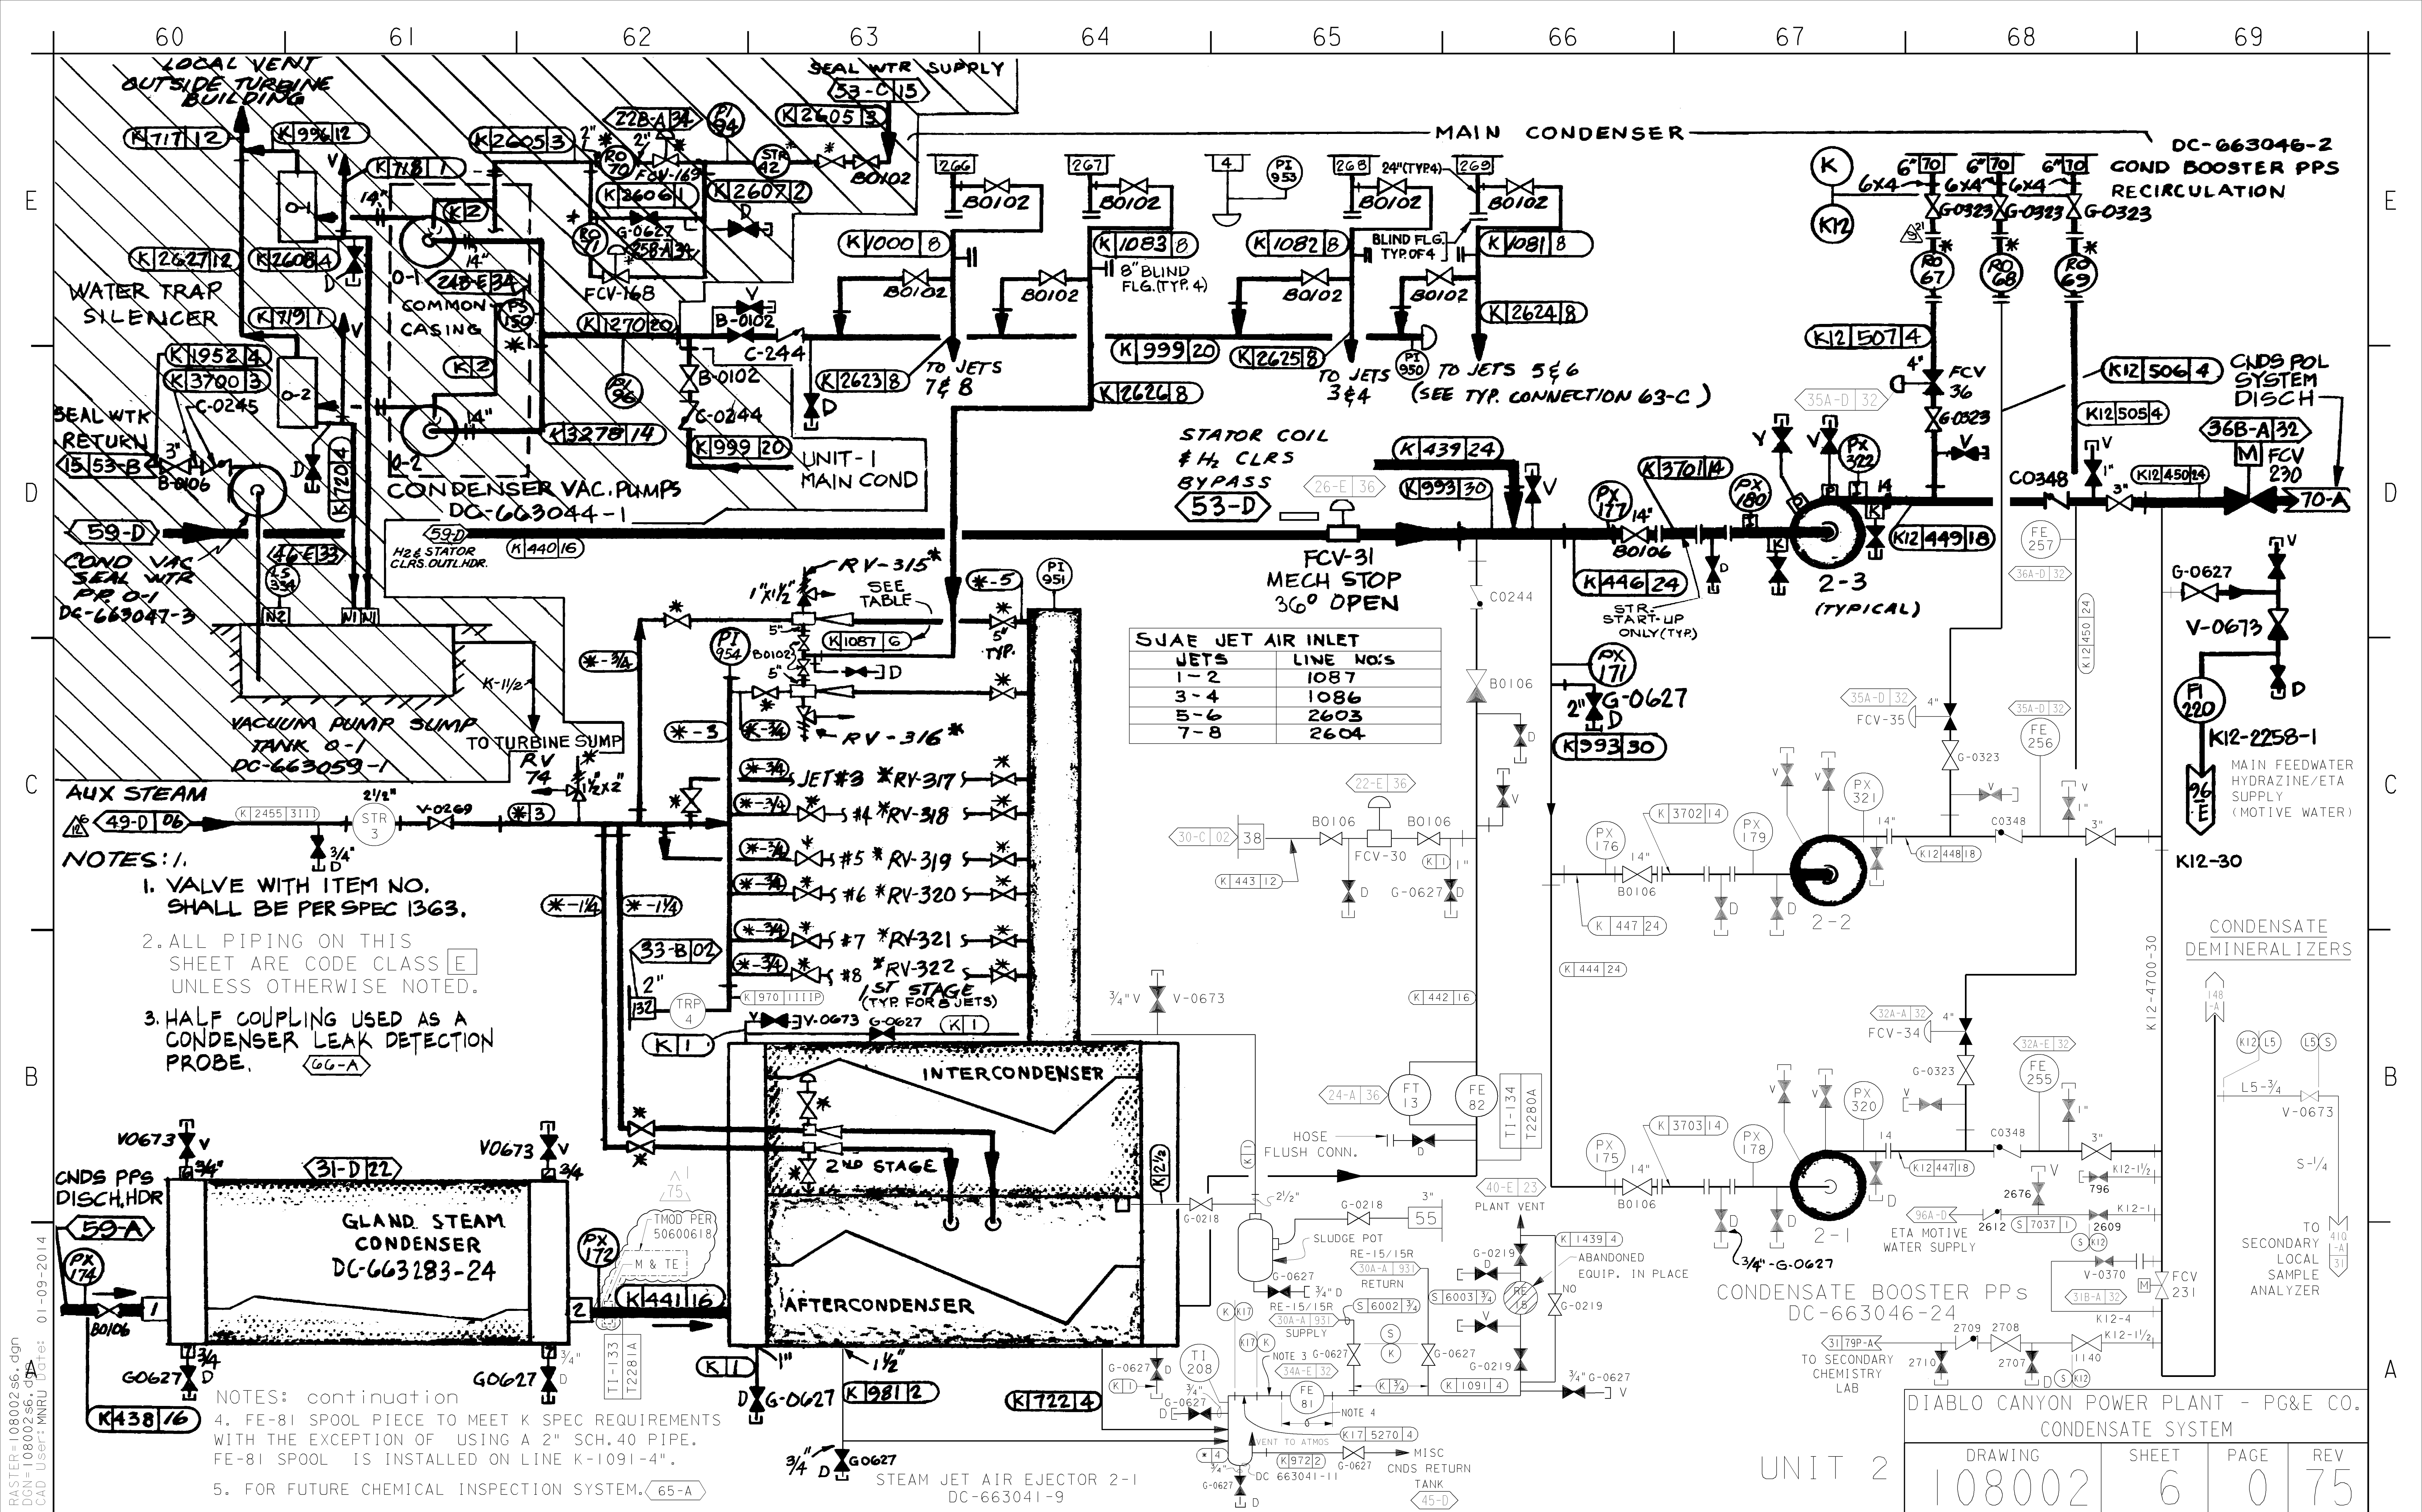

70

71

72

73

74

75

76

77

78

79

NOTES 1 ALL PIPING ON THIS SHEET
ARE CODE CLASS E

2 VALVES WITH ITEM NO
SHOULD BE UNDER SPEC 1363

3 3/8" SS REGULATING VALVE, WHITEY,
SWAGELOK END CONNS, CAT NO 1RS6 (73 B)

△1
69

△1
70

△4
DELETED
(SEE SH 11)

△3
70
ABANDONED IN PLACE

FEEDWATER HEATERS

DC-663058-34 (SHELL)
- 120 (HTR 2-6A & 2-6B CHANNEL)
- 121 (HTR 2-6C CHANNEL)

VOL73
(TYR3 PLC5)

36-205

2-6A

2-6B

2-6C

2-6D

2-6E

2-6F

2-6G

2-6H

2-6I

2-6J

2-6K

2-6L

2-6M

2-6N

2-6O

2-6P

2-6Q

2-6R

2-6S

2-6T

2-6U

2-6V

2-6W

2-6X

2-6Y

2-6Z

2-6AA

2-6AB

2-6AC

2-6AD

2-6AE

2-6AF

2-6AG

2-6AH

2-6AI

2-6AJ

2-6AK

2-6AL

2-6AM

2-6AN

2-6AO

2-6AP

2-6AQ

2-6AR

2-6AS

2-6AT

2-6AU

2-6AV

2-6AW

2-6AX

2-6AY

2-6AZ

2-6BA

2-6BB

2-6BC

2-6BD

2-6BE

2-6BF

2-6BG

2-6BH

2-6BI

2-6BJ

2-6BK

2-6BL

2-6BM

2-6BN

2-6BO

2-6BP

2-6BQ

2-6BR

2-6BS

2-6BT

2-6BU

2-6BV

2-6BW

2-6BX

2-6BY

2-6BZ

2-6CA

2-6CB

2-6CC

2-6CD

2-6CE

2-6CF

2-6CG

2-6CH

2-6CI

2-6CJ

2-6CK

2-6CL

2-6CM

2-6CN

2-6CO

2-6CP

2-6CQ

2-6CR

2-6CS

2-6CT

2-6CU

2-6CV

2-6CW

2-6CX

2-6CY

2-6CZ

2-6DA

2-6DB

2-6DC

2-6DD

2-6DE

2-6DF

2-6DG

2-6DH

2-6DI

2-6DJ

2-6DK

2-6DL

2-6DM

2-6DN

2-6DO

2-6DP

2-6DQ

2-6DR

2-6DS

2-6DT

2-6DU

2-6DV

2-6DW

2-6DX

2-6DY

2-6DZ

2-6EA

2-6EB

2-6EC

2-6ED

2-6EE

2-6EF

2-6EG

2-6EH

2-6EI

2-6EJ

2-6EK

2-6EL

2-6EM

2-6EN

2-6EO

2-6EP

2-6EQ

2-6ER

2-6ES

2-6ET

2-6EU

2-6EV

2-6EW

2-6EX

2-6EY

2-6EZ

2-6FA

2-6FB

2-6FC

2-6FD

2-6FE

2-6FF

2-6FG

2-6FH

2-6FI

2-6FJ

2-6FK

2-6FL

2-6FM

2-6FN

2-6FO

2-6FP

2-6FQ

2-6FR

2-6FS

2-6FT

2-6FU

2-6FV

2-6FW

2-6FX

2-6FY

2-6FZ

2-6GA

2-6GB

2-6GC

2-6GD

2-6GE

2-6GF

2-6GG

2-6GH

2-6GI

2-6GJ

2-6GK

2-6GL

2-6GM

2-6GN

2-6GO

2-6GP

2-6GQ

2-6GR

2-6GS

2-6GT

2-6GU

2-6GV

2-6GW

2-6GX

2-6GY

2-6GZ

2-6HA

2-6HB

2-6HC

2-6HD

2-6HE

2-6HF

2-6HG

2-6HH

2-6HI

2-6HJ

2-6HK

2-6HL

2-6HM

2-6HN

2-6HO

2-6HP

2-6HQ

2-6HR

2-6HS

2-6HT

2-6HU

2-6HV

2-6HW

2-6HX

2-6HY

2-6HZ

2-6IA

2-6IB

2-6IC

2-6ID

2-6IE

2-6IF

2-6IG

2-6IH

2-6II

2-6IJ

2-6IK

2-6IL

2-6IM

2-6IN

2-6IO

2-6IP

2-6IQ

2-6IR

2-6IS

2-6IT

2-6IU

2-6IV

2-6IW

2-6IX

2-6IY

2-6IZ

2-6JA

2-6JB

2-6JC


2-6JD

2-6JE

2-6JF

2-6JG

2-6JH

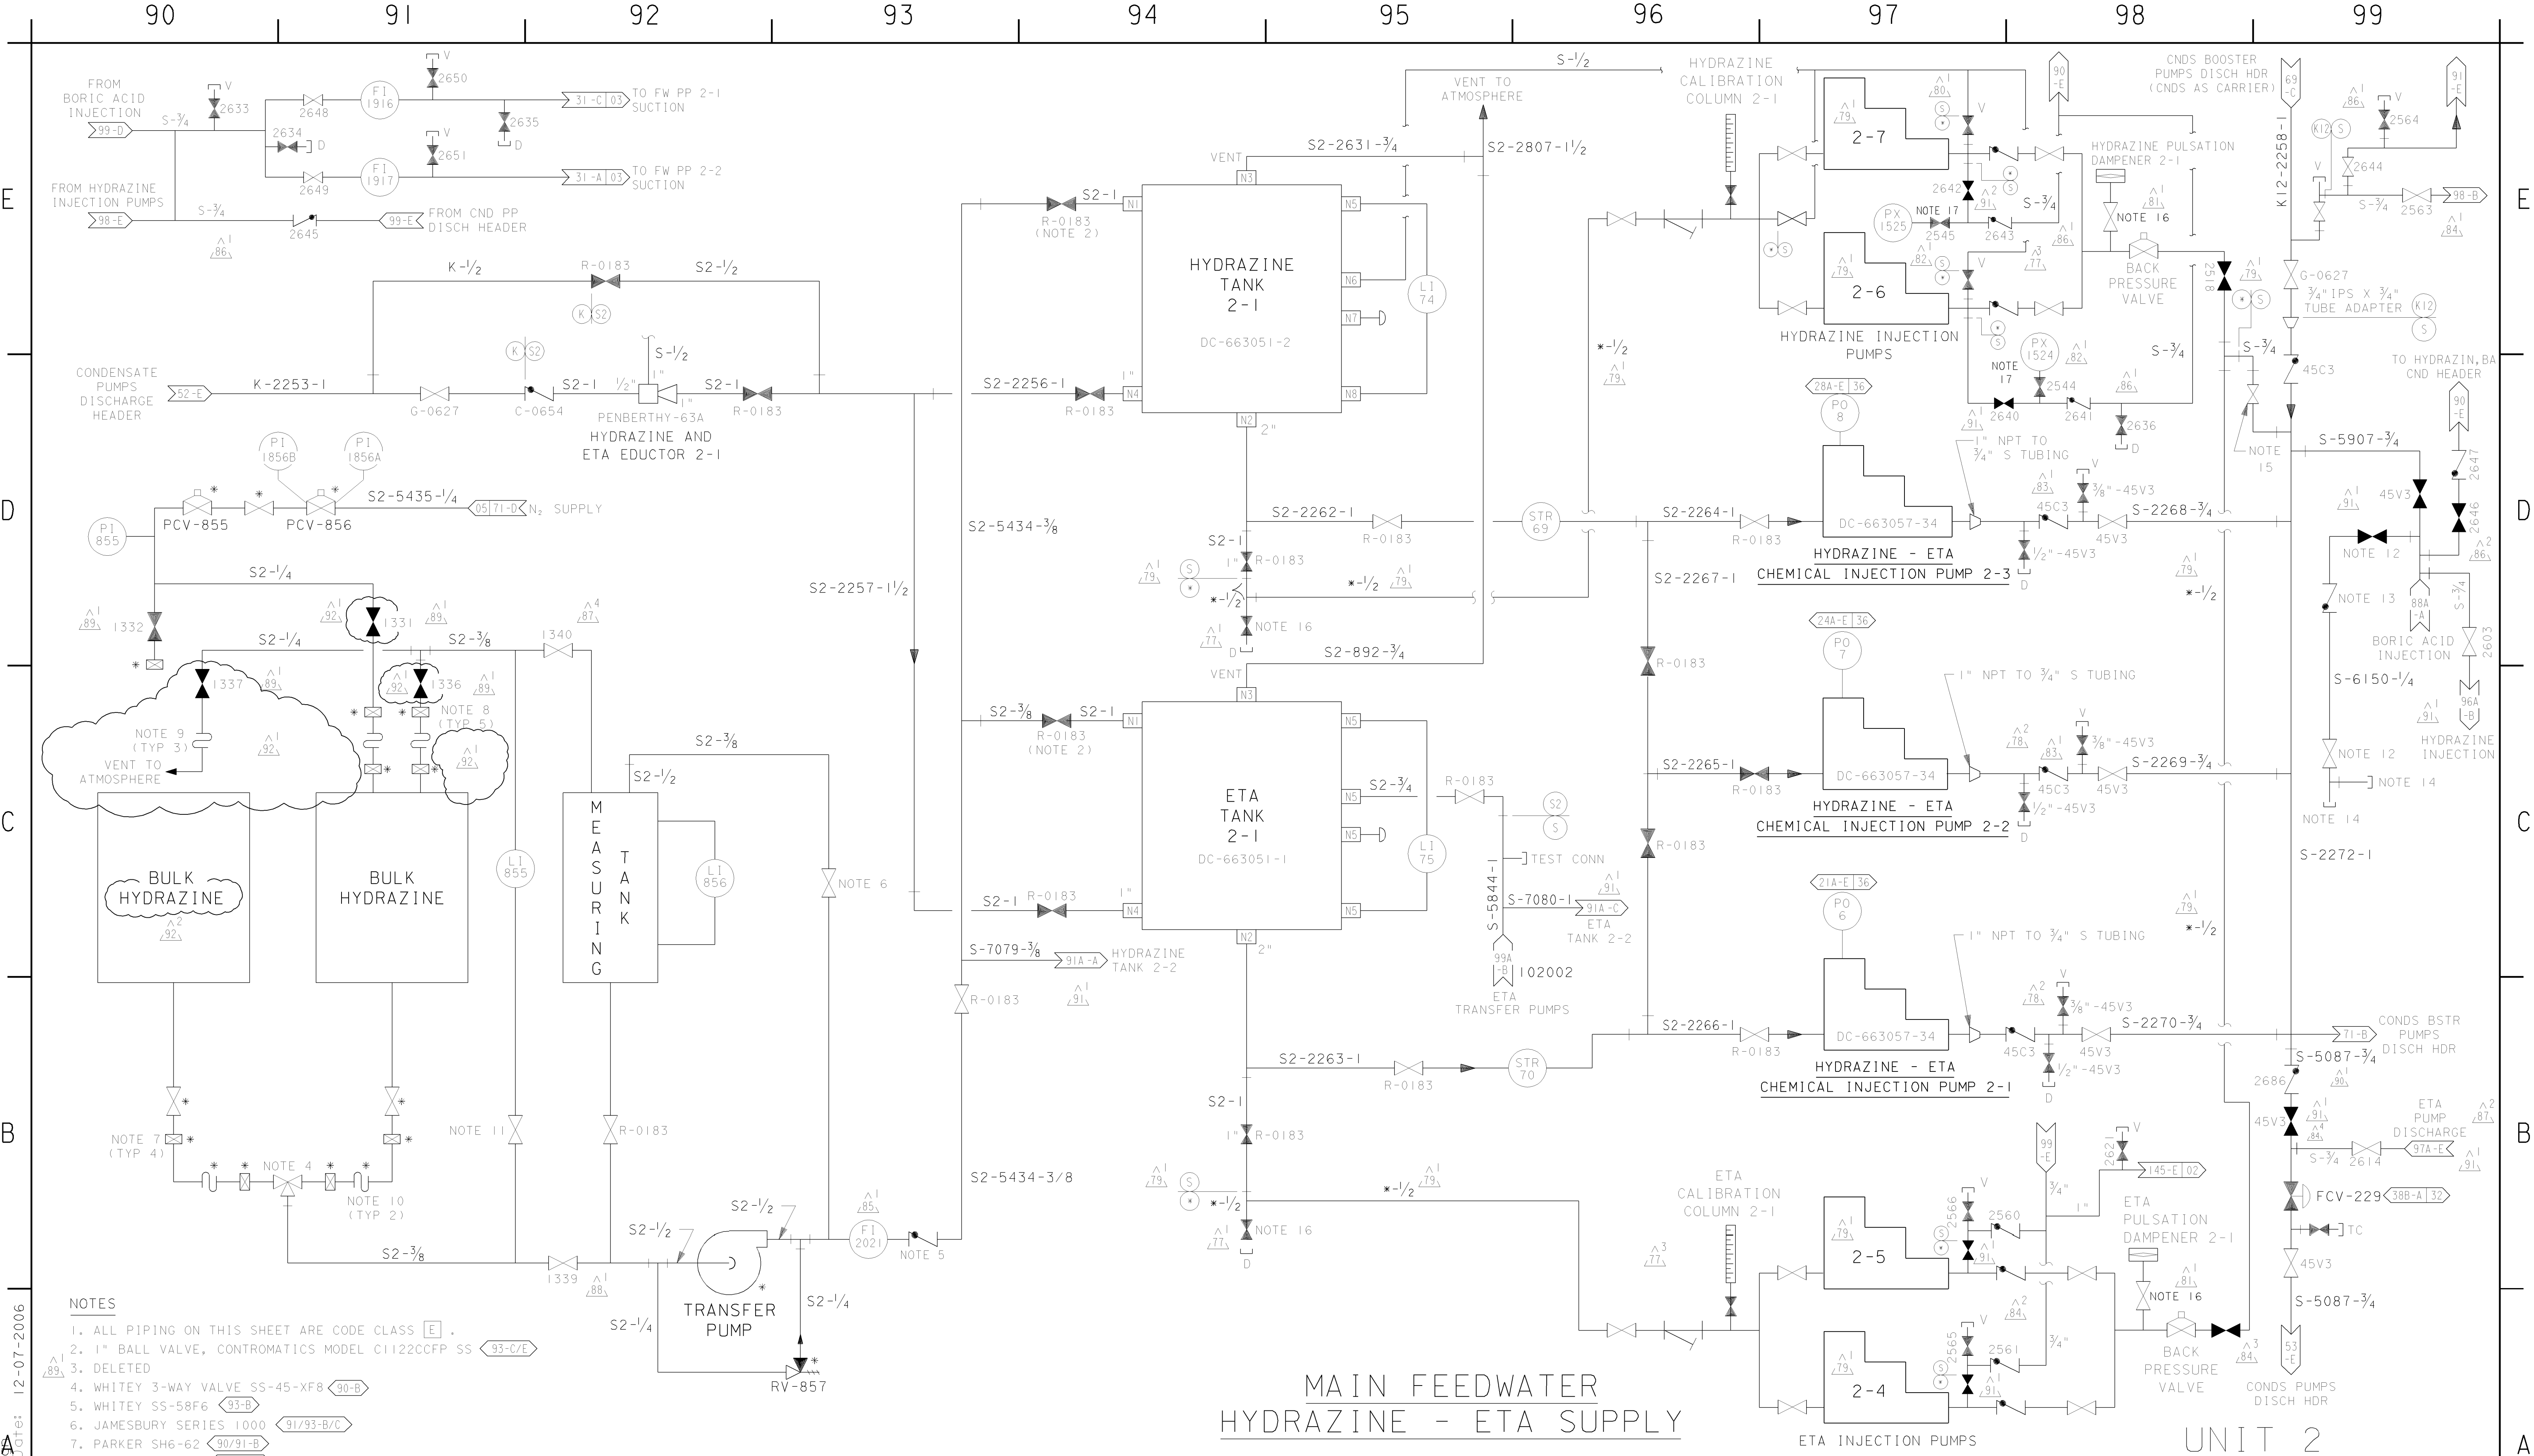

- NOTES
1. ALL PIPING ON THIS SHEET ARE CODE CLASS E.

2. 1" BALL VALVE, CONTROMATICS MODEL C1122CCFP SS 93-C/E

3. DELETED

4. WHITEY 3-WAY VALVE SS-45-XF8 90-B

5. WHITEY SS-58F6 93-B

6. JAMESBURY SERIES 1000 91/93-B/C

7. PARKER SH6-62 90/91-B

8. PARKER SH2-62 90/91-C

9. 1/4" DIAMETER POLY TUBING 90/91-C

10. 1/2" TEFLON HOSE WITH SS BRAIDING 90/91-B

11. CONTROMATICS C-1122-C PFR RPE P-6407 91-B

12. NUPRO P/N SS-4P4T1 99-D

13. NUPRO P/N SS-4C4-10 99-D

14. CONNECTION FOR CHEMICAL INJECTION 99-D

15. WHITEY P/N SS-45S16 98-D

16. APOLLO #76-103 98-A 98-E 94-D 94-B

17. WHITEY P/N SS-45S8 97-E

18. FOR FUTURE CHEMICAL INJECTION SYSTEM 87

- REFERENCES
1. PIPING SCHEMATIC AND BILL OF MATERIAL ----- DC-663057-73


2. GENERAL ARRANGEMENT ----- DC-663057-75

CORRESPONDING INSTRUMENT NOS.

	PUMP # 2-1		PUMP # 2-2		PUMP # 2-3	
	PGE NO	WESTINGHOUSE COMPUTER PT.	PGE NO.	WESTINGHOUSE COMPUTER PT.	PGE NO.	WESTINGHOUSE COMPUTER PT.
UPPER BEARING	T1-29	T2520A	T1-32	T2523A	T1-35	T2526A
LOWER BEARING	T1-30	T2521A	T1-33	T2524A	T1-36	T2527A
STATOR	T1-31	T2522A	T1-34	T2525A	T1-37	T2528A



CORRESPONDING UPPER BEARING COOLING WATER LINE NOS.

PUMP 2-1	PUMP 2-2	PUMP 2-3
2492	2493	2494
2495	2496	2497

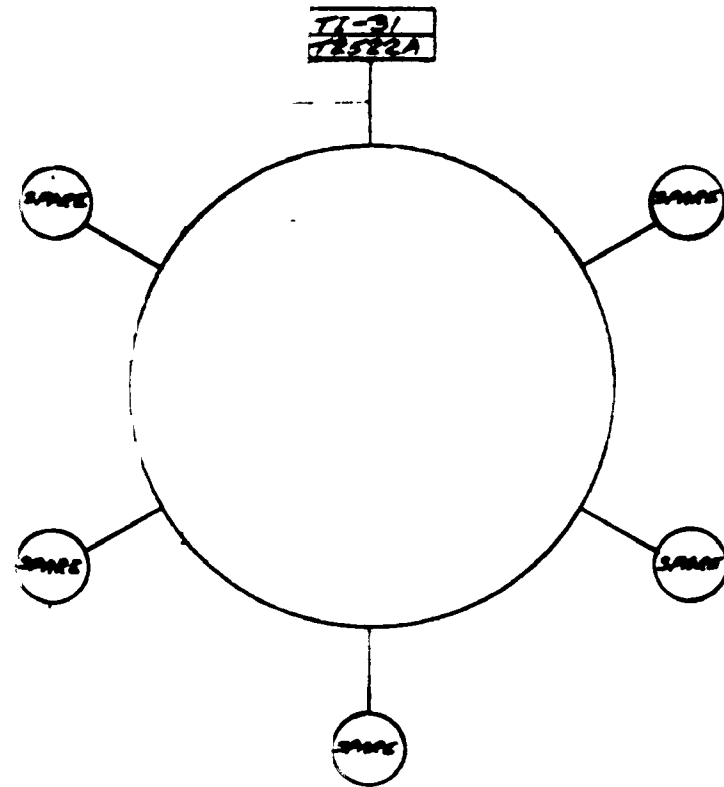

STATOR WINDING THERMOCOUPLE
COMPUTER TEMPERATURE DETECTOR
DC-663045-2

CONDENSATE PUMP MOTOR
TYP FOR (3)

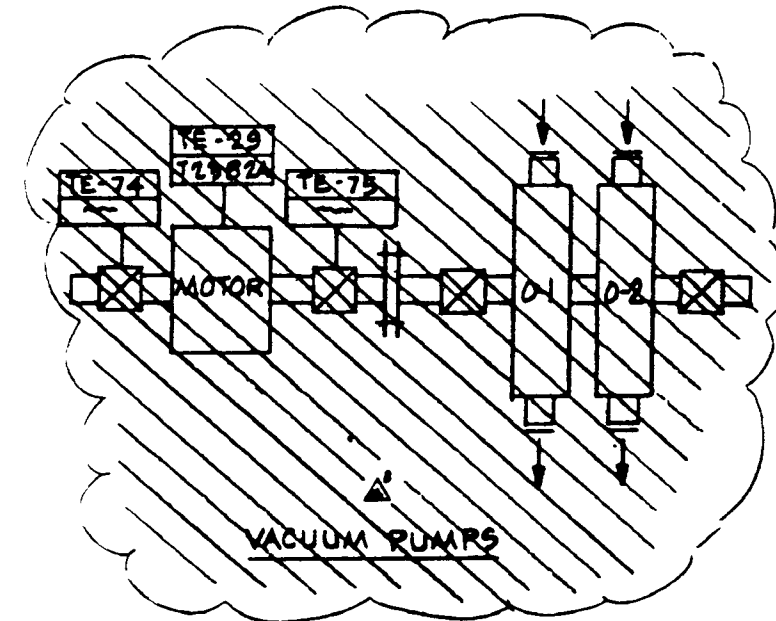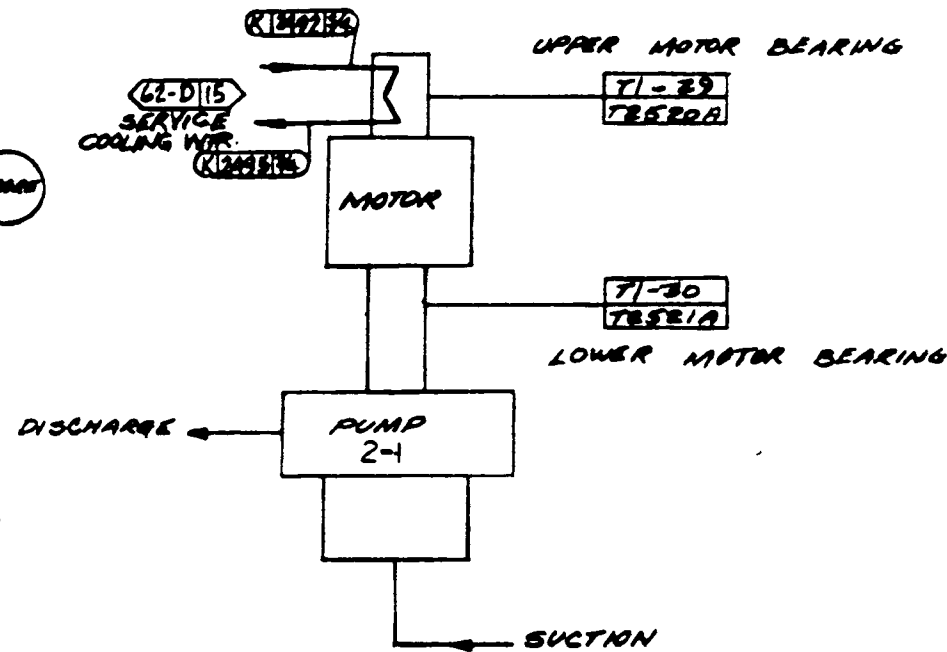

UNIT - 2

P.G. & E. CO.	DRAWING NUMBER	REVISION
SHEET 10 OF SHEETS	108002	48
	MICROFILM	H.S.

THIS DRAWING HAS BEEN REPRODUCED
WITHOUT CHANGE FROM ORIGINAL DRAWING
CHANGE NO. DATE 4/1/66 APPROVED BY

RM INDEXED REV. 48

SCAN 48 RC

35 1/4 IN NEG

MAIN CONDENSER TUBE SHEET SALT WATER LEAK DETECTION SYSTEM

E

D

C

B

A


E

D

C

B

A

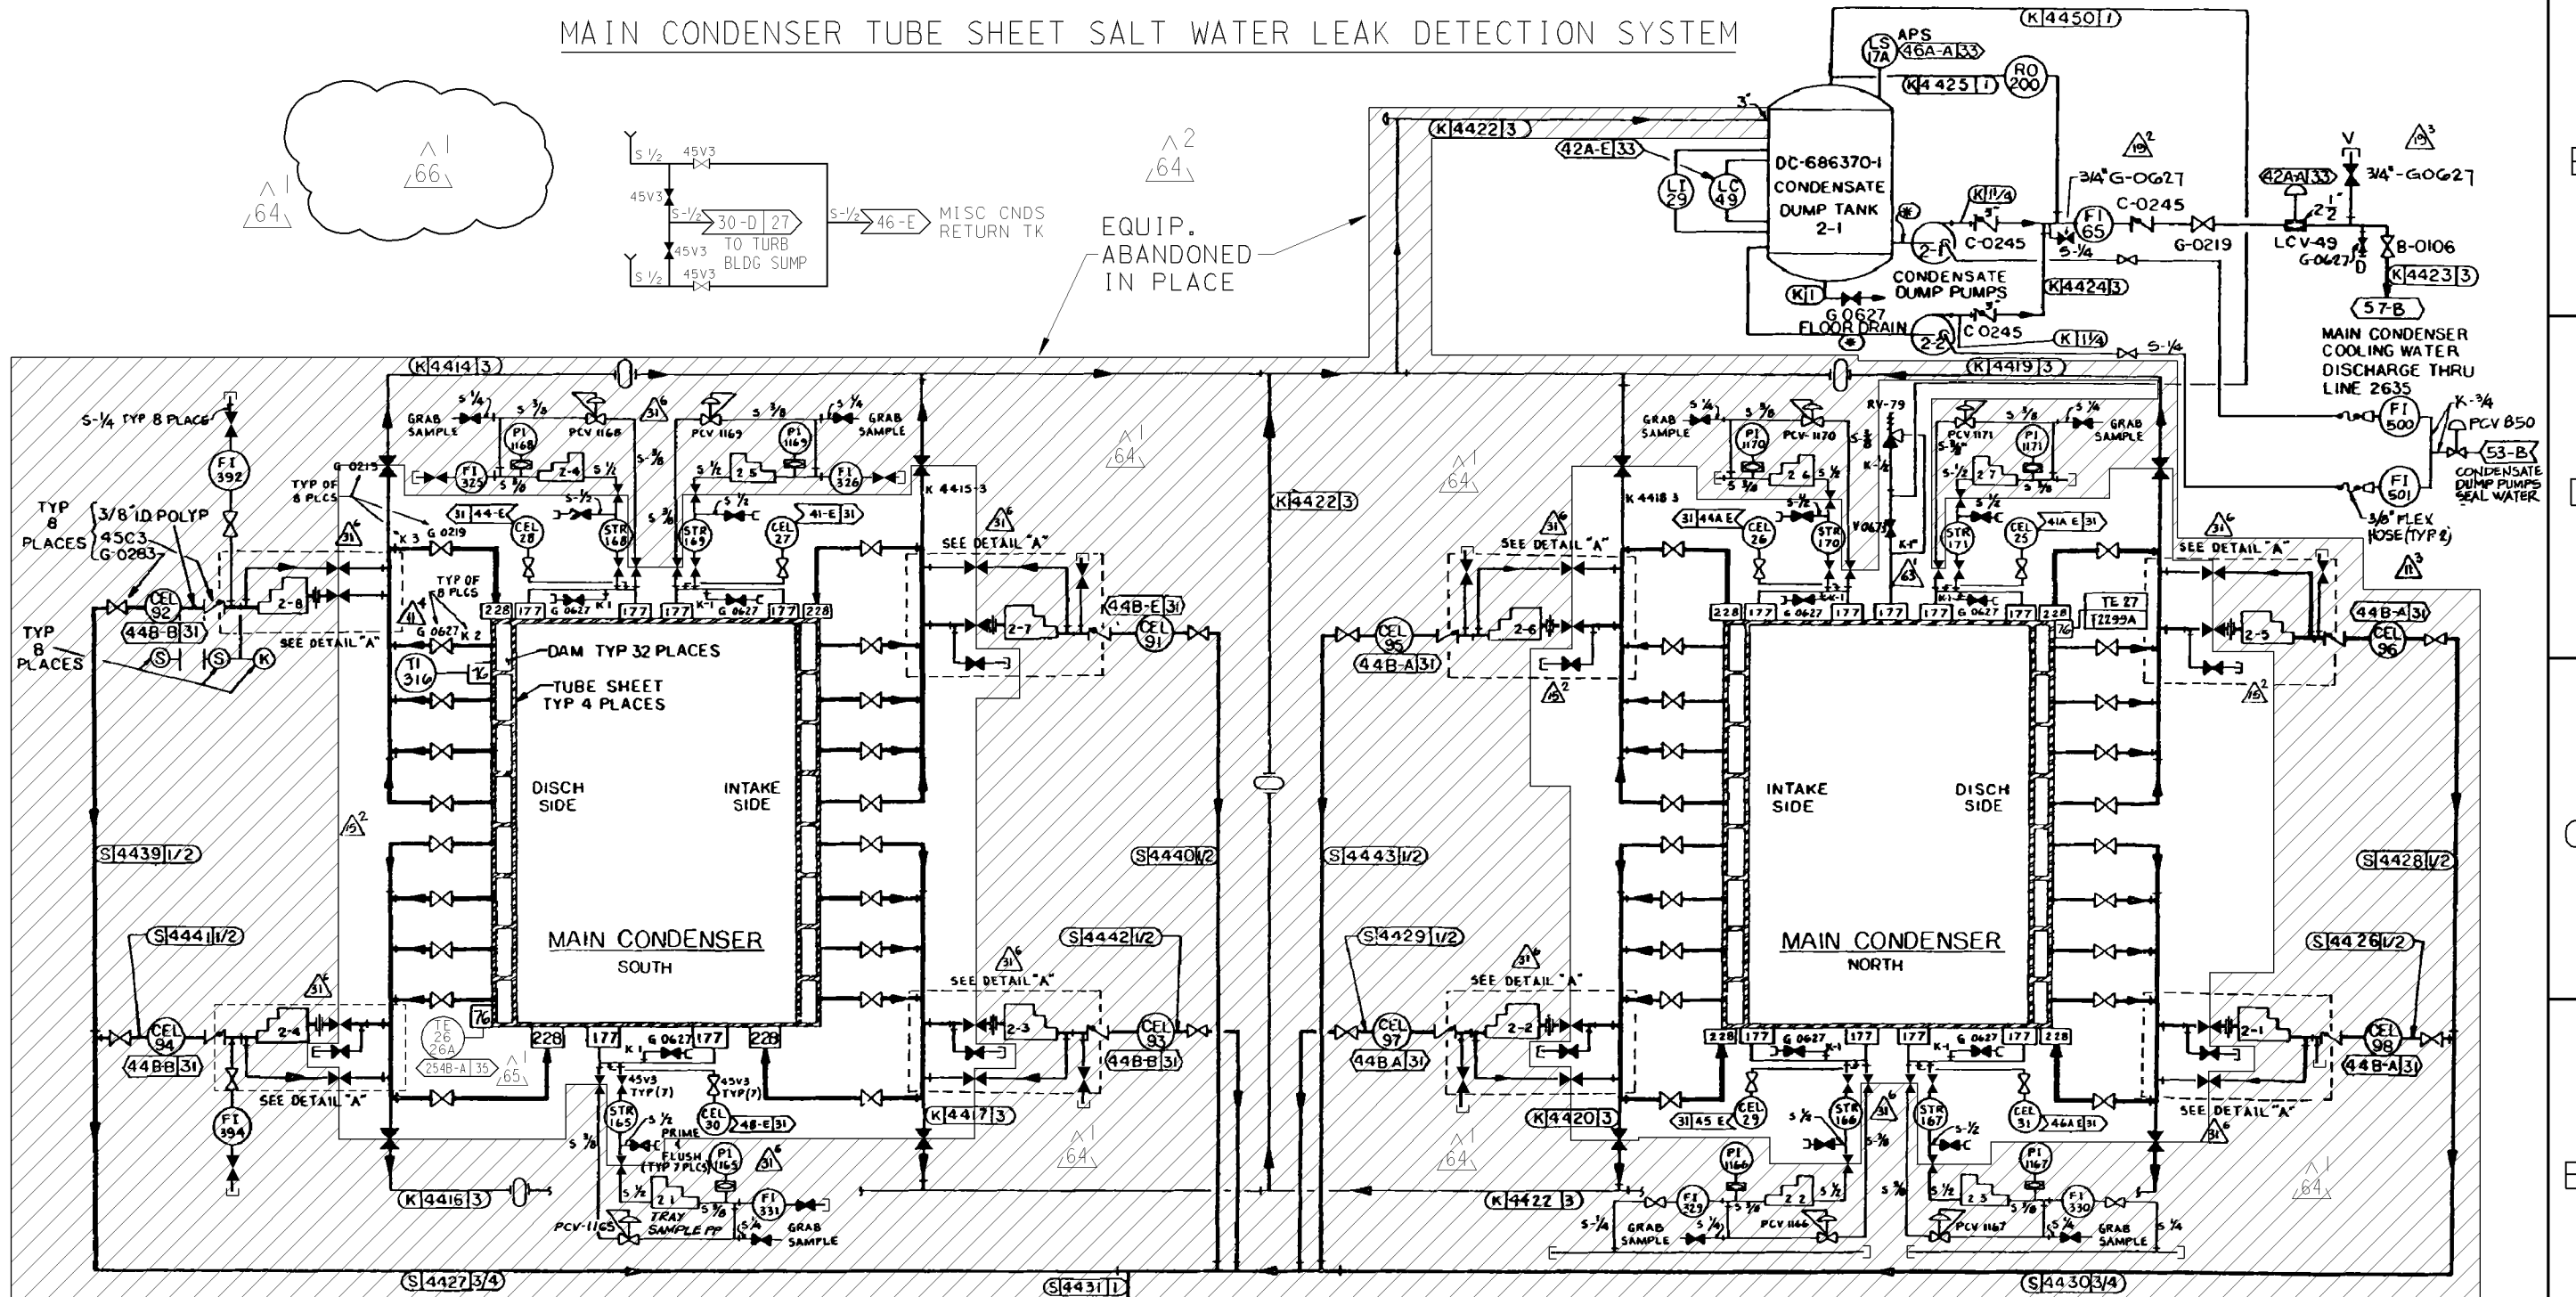

CONDENSER SAMPLE PUMP	CONDENSER ACCESS	INSTRUMENTS						GRAVITY SAMPLE INSTRUMENTS	
2-1	NW	CEL 98	FI 398	PI 1172	PCV 1172	STR 1172	CEL 198	FI 1198	
2-2	NW	CEL 97		PI 1173	PCV 1173	STR 1173	CEL 197	FI 1197	
2-3	SW	CEL 93		PI 1174	PCV 1174	STR 1174	CEL 193	FI 1193	
2-4	SW	CEL 94	FI 394	PI 1175	PCV 1175	STR 1175	CEL 194	FI 1194	
2-5	NE	CEL 96		PI 1176	PCV 1176	STR 1176	CEL 196	FI 1196	
2-6	NE	CEL 95		PI 1177	PCV 1177	STR 1177	CEL 195	FI 1195	
2-7	SE	CEL 91		PI 1178	PCV 1178	STR 1178	CEL 191	FI 1191	
2-8	SE	CEL 92	FI 392	PI 1179	PCV 1179	STR 1179	CEL 192	FI 1192	

CONDENSER TUBESHEET SAMPLES

EQUIP. ABANDONED IN PLACE

△2
△64

- NOTES
- 1 ALL PIPING SHOWN ON THIS SHEET SHALL BE PG&E CODE CLASS E
 - 2 ALL ANALYZER SENSORS (CEL) SHALL BE INSTALLED AS CLOSE AS POSSIBLE TO INSTR SUPPLY PUMPS
 - 3 THE WORD "TYPICAL" AS USED ON THIS SHEET DENOTES VALVES, PIPING, ETC WITH THE SAME SPECIFICATION AND FUNCTION
 - 4 FOR CONDENSER TRAY CONNECTIONS SEE DC 663041 IS 113-D

EQUIP. ABANDONED IN PLACE

△2
△64

UNIT 2


DIABLO CANYON POWER PLANT - PG&E CO.
CONDENSATE SYSTEM

DRAWING	SHEET	PAGE	REV
108002	11	0	66

RASTER=108002s11.dgn
DGN=108002s11.dgn
CAD User:RXG2 Date:12-09-2008

INPG1C
I Size

12-09-2008	RxG2	FxC2		ALAN GLEN BARTA	ELECTRICAL	E 9271	9/30/2009	REVISED PER DDN-2*24-0
DATE	DWN	RE	IV	PROFESSIONAL ENGINEER	PE DISC.	PE#	PE EXP.	

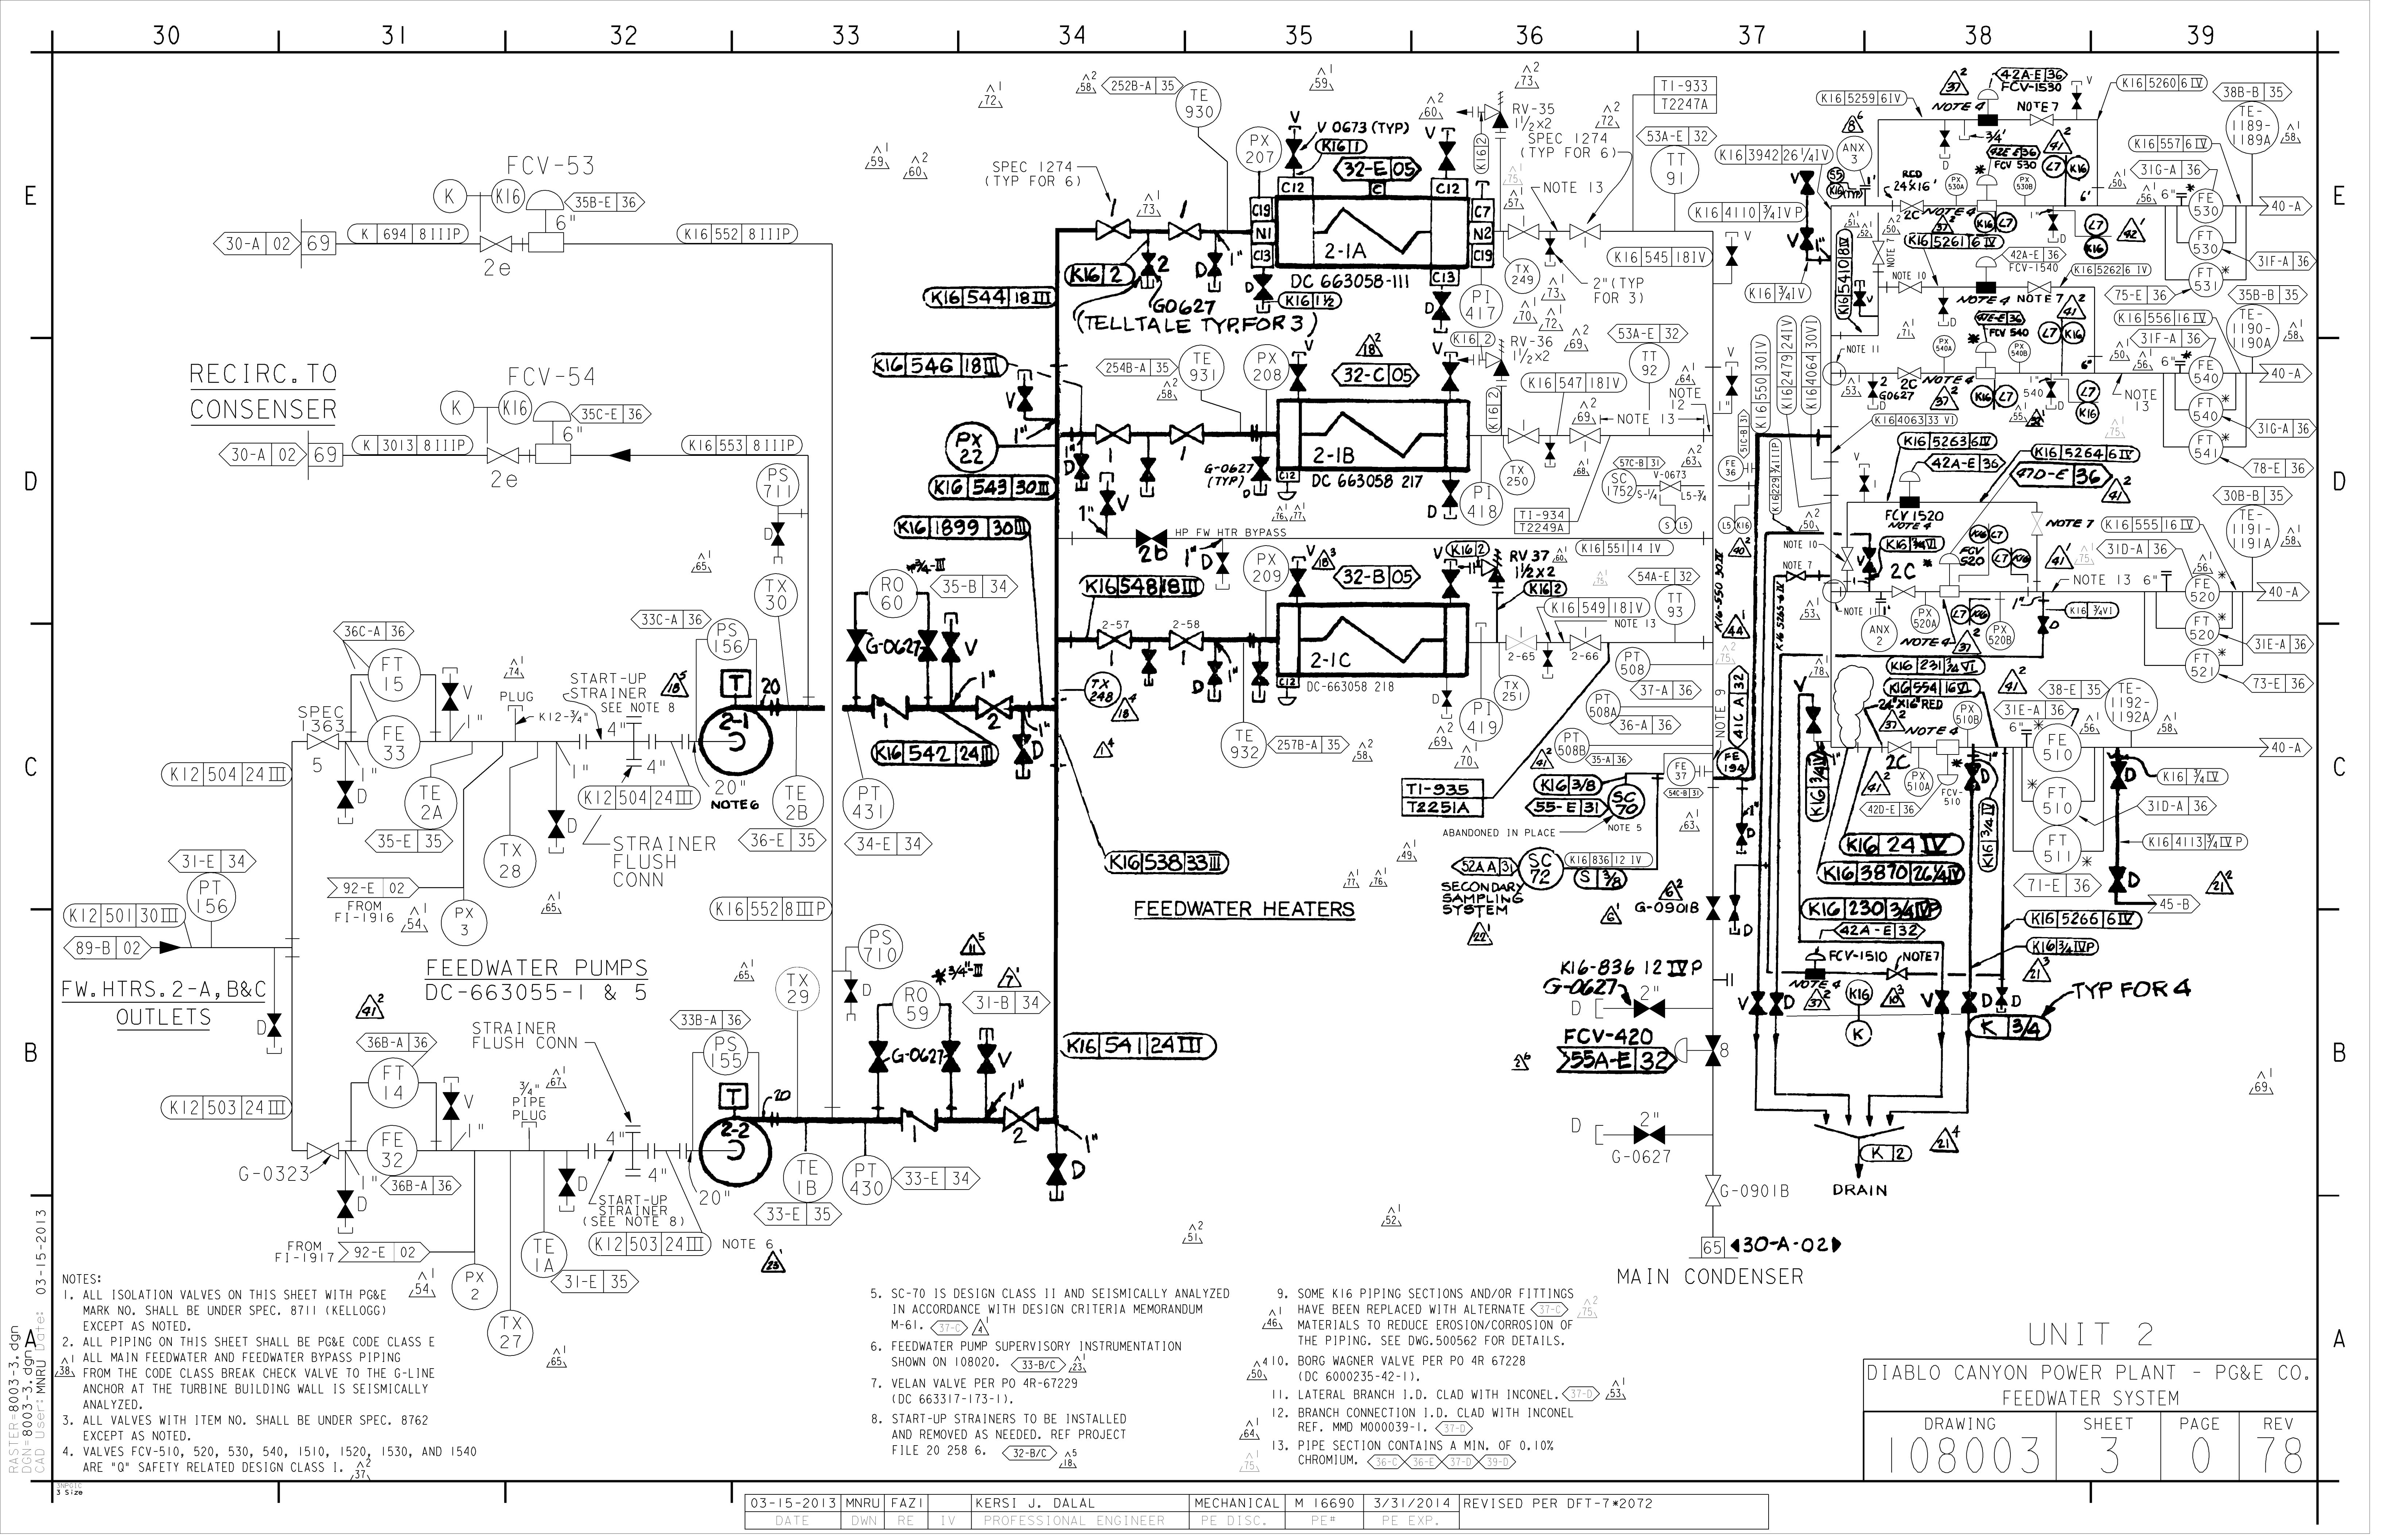


- NOTES:
1. ALL ISOLATION VALVES ON THIS SHEET WITH PG&E MARK NO. SHALL BE UNDER SPEC. 8711 (KELLOGG) EXCEPT AS NOTED.
 2. ALL PIPING ON THIS SHEET SHALL BE PG&E CODE CLASS E ALL MAIN FEEDWATER AND FEEDWATER BYPASS PIPING FROM THE CODE CLASS BREAK CHECK VALVE TO THE G-LINE ANCHOR AT THE TURBINE BUILDING WALL IS SEISMICALLY ANALYZED.
 3. ALL VALVES WITH ITEM NO. SHALL BE UNDER SPEC. 8762 EXCEPT AS NOTED.
 4. VALVES FCV-510, 520, 530, 540, 1510, 1520, 1530, AND 1540 ARE "Q" SAFETY RELATED DESIGN CLASS I.

5. SC-70 IS DESIGN CLASS II AND SEISMICALLY ANALYZED IN ACCORDANCE WITH DESIGN CRITERIA MEMORANDUM M-61.
6. FEEDWATER PUMP SUPERVISORY INSTRUMENTATION SHOWN ON 108020.
7. VELAN VALVE PER PO 4R-67229 (DC 663317-173-1).
8. START-UP STRAINERS TO BE INSTALLED AND REMOVED AS NEEDED. REF PROJECT FILE 20 258 6.
9. SOME K16 PIPING SECTIONS AND/OR FITTINGS HAVE BEEN REPLACED WITH ALTERNATE MATERIALS TO REDUCE EROSION/CORROSION OF THE PIPING. SEE DWG. 500562 FOR DETAILS.
10. BORG WAGNER VALVE PER PO 4R 67228 (DC 6000235-42-1).
11. LATERAL BRANCH I.D. CLAD WITH INCONEL.
12. BRANCH CONNECTION I.D. CLAD WITH INCONEL REF. MMD M000039-1.
13. PIPE SECTION CONTAINS A MIN. OF 0.10% CHROMIUM.

DIABLO CANYON POWER PLANT - PG&E CO.			
FEEDWATER SYSTEM			
DRAWING	SHEET	PAGE	REV
108003	3	0	78

03-15-2013	MNRU	FAZI	KERSI J. DALAL	MECHANICAL	M 16690	3/31/2014	REVISED PER DFT-7*2072
DATE	DWN	RE	IV	PE DISC.	PE#	PE EXP.	

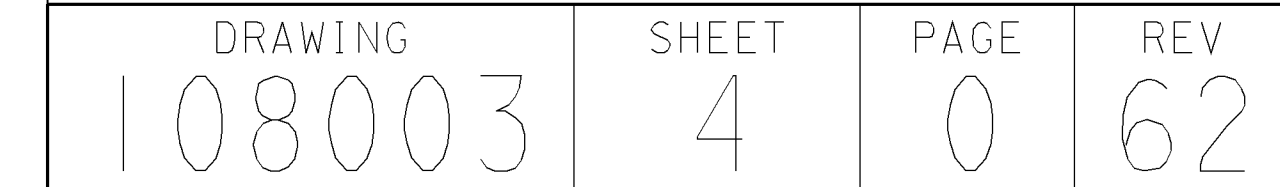

CAD User: rxg2 Date: 10-16-2002
DGN: ERU09579.DGN
RASTER: ERU09579.TIF

NOTES:


1. ALL PIPING ON THIS SHEET TO BE CODE CLASS **E**
2. ALL ISOLATION VALVES ON THIS SHEET WITH PG&E MARK NO's. SHALL BE FURNISHED BY SPEC 8711
3. PIPING & SWAGE MATERIAL SHALL BE PER SPEC S2 EXCEPT THAT THE WALL THICKNESS SHALL BE SCH. 80 & MATERIAL SHALL BE TP 304L; FOR VALVE & FLANGE, USE TP 304 **56-B,E**
4. PIPING MATERIALS SHALL BE ASTM A335 GR. P-22, SCH. 160 **54/55-B,D**
5. FLANGE PAIRS IMMEDIATELY UPSTREAM & DOWNSTREAM OF FLOW SECTIONS FE-612/FE-613 & IMMEDIATELY UPSTREAM OF PCV-72/PCV-73 ARE PER PIPE SPEC. K. **57-C,E**
6. PALL FILTER P/N: HH8600B16**TBP INSTALLED PER ATMM A0543788 **52-E** **52-B,C**

FEEDWATER PUMPS SHAFT SEAL SYSTEM
DC-663055-2,5

107-B 04
HP STM PURITY
ANALYZER
SAMPLE RETURN

P G & E CO.		108003	REV. 50
SHEET 5	PAGE 0		


3/5/03	RXG2	RHSI	KJD3	KERSI J. DALAL	MECHANICAL	M 16690	3/31/2004	Revised per AR A0543788, FCT-26712 & A0526769, FCT-25539-02
DATE	DWN	RE	IV	PROFESSIONAL ENGINEER	PE DISC.	PE#	PE EXP.	

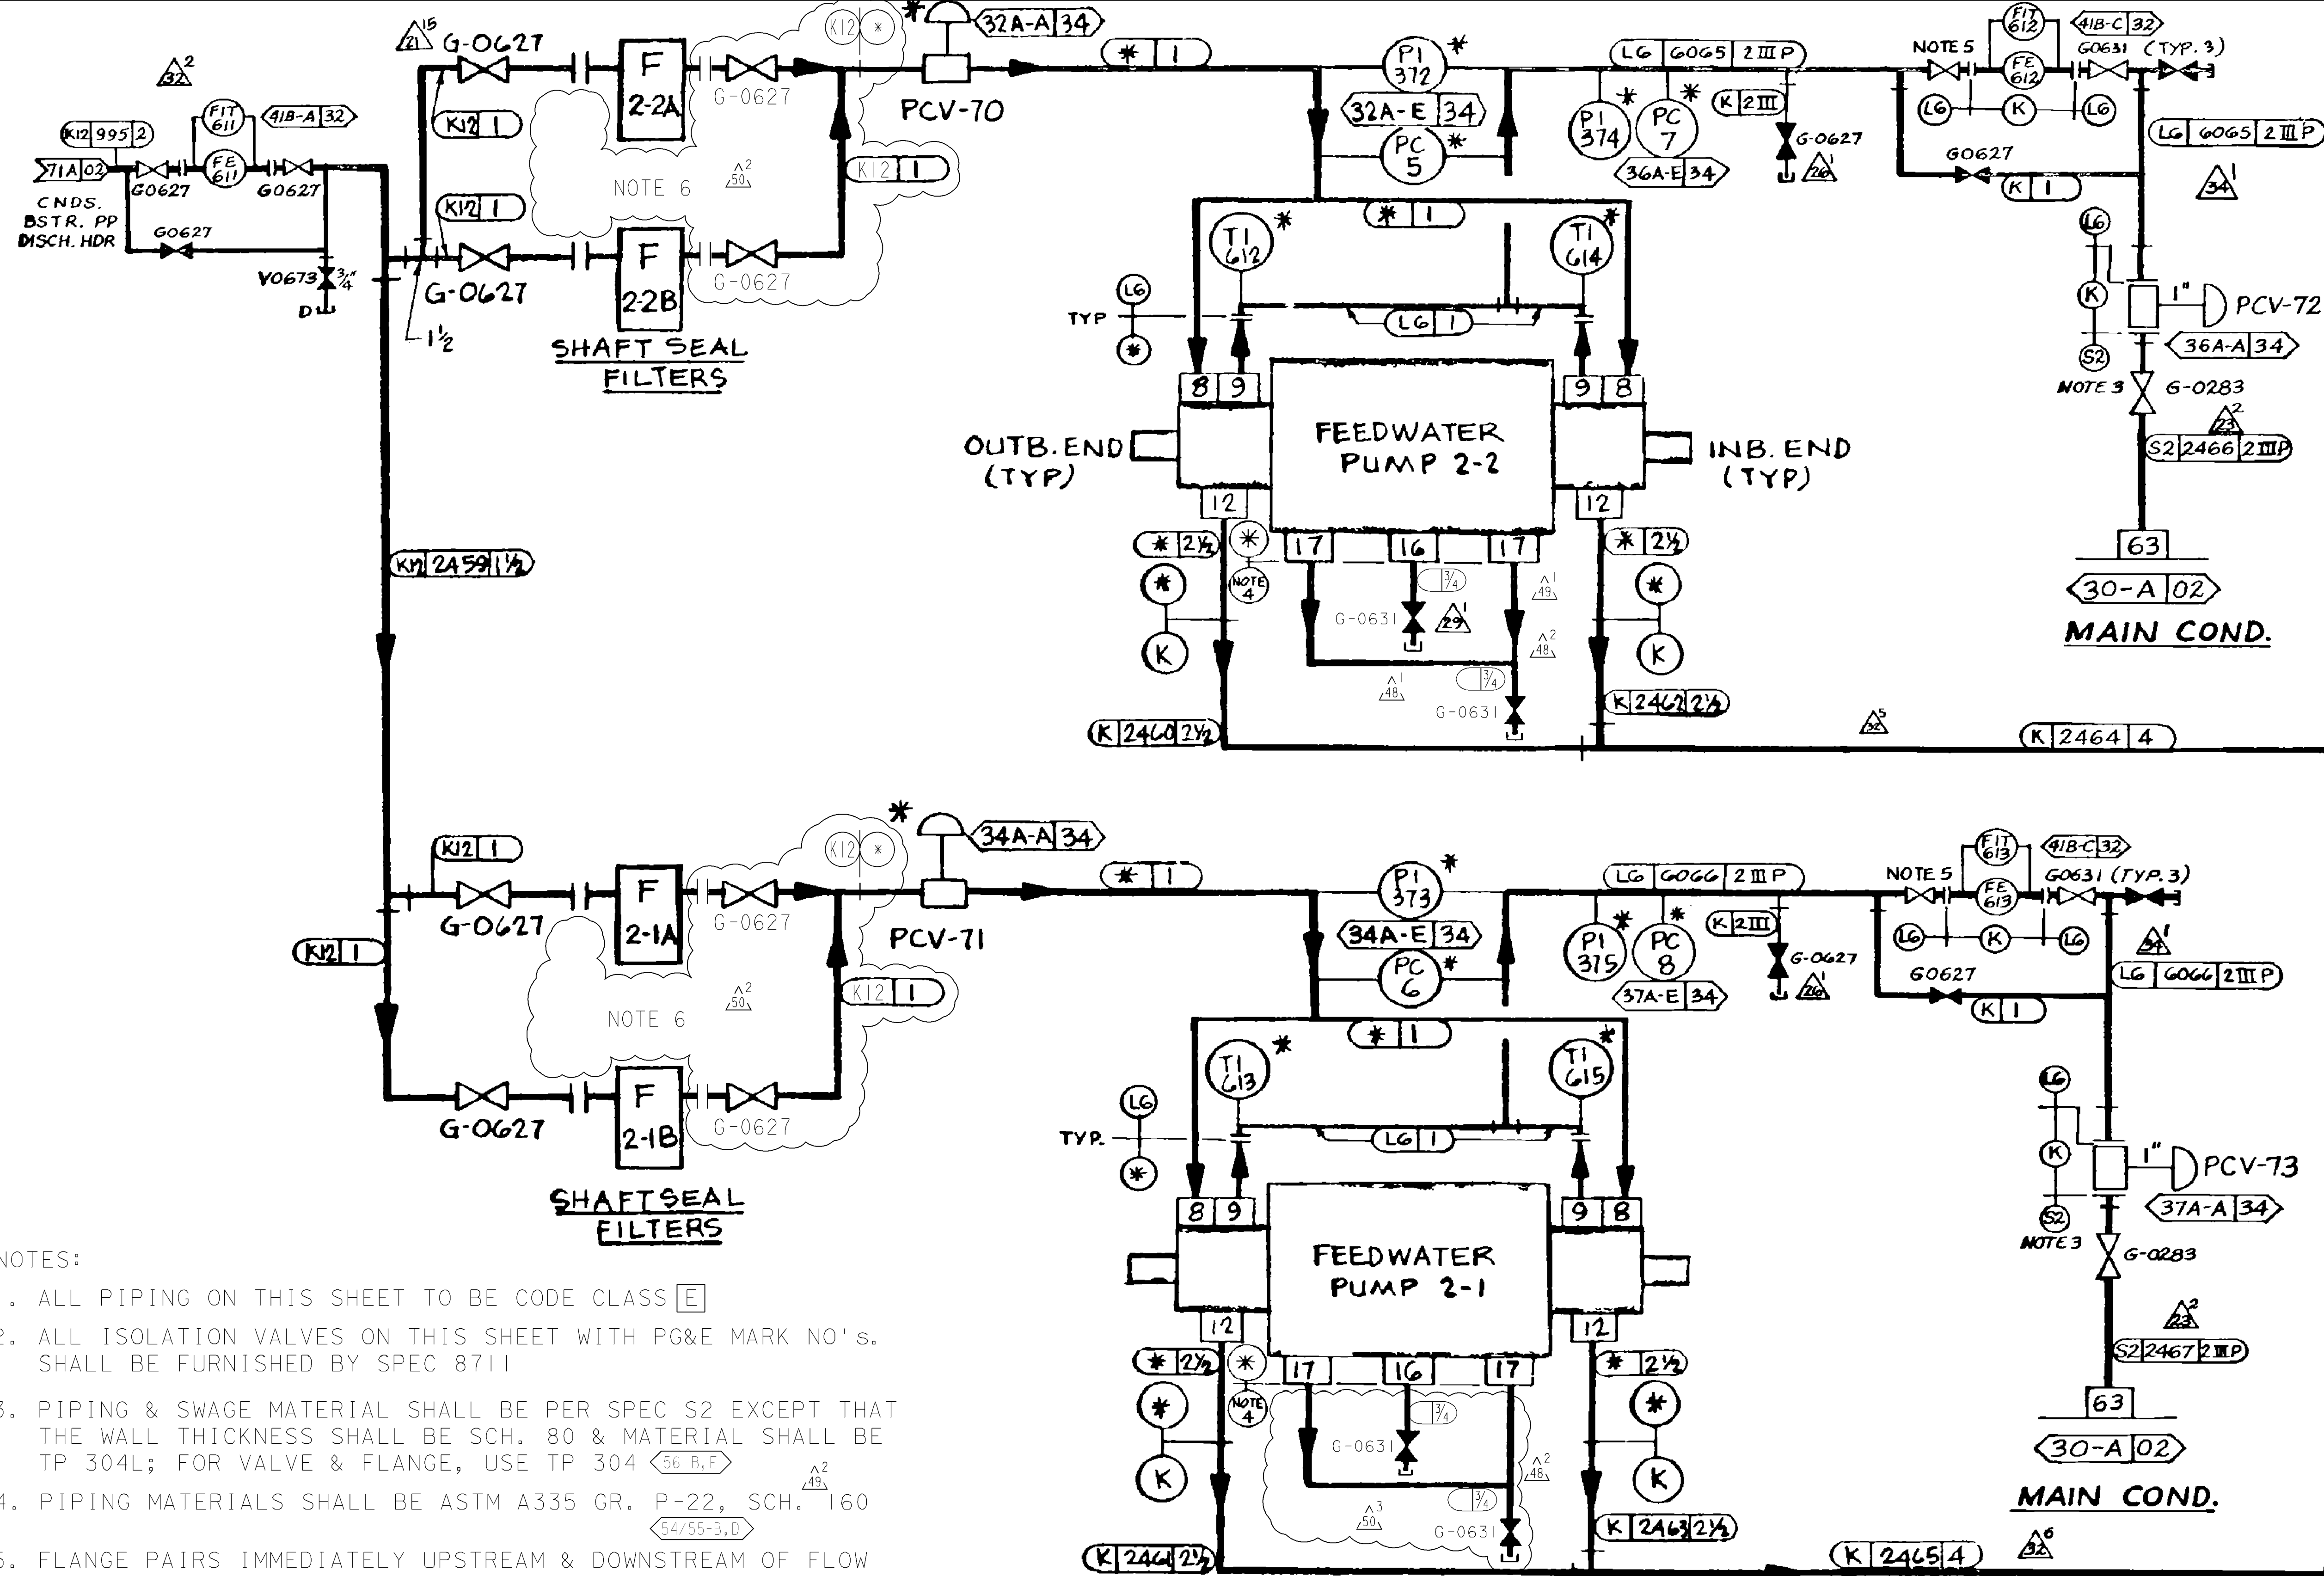

UNIT 2

29. FOR SPECTACLE PLATE DETAIL SEE DRAWING 066142.


- DC 6021772-7D FOR A CROSS-
TABLE FOR THE ORIGINAL SG N

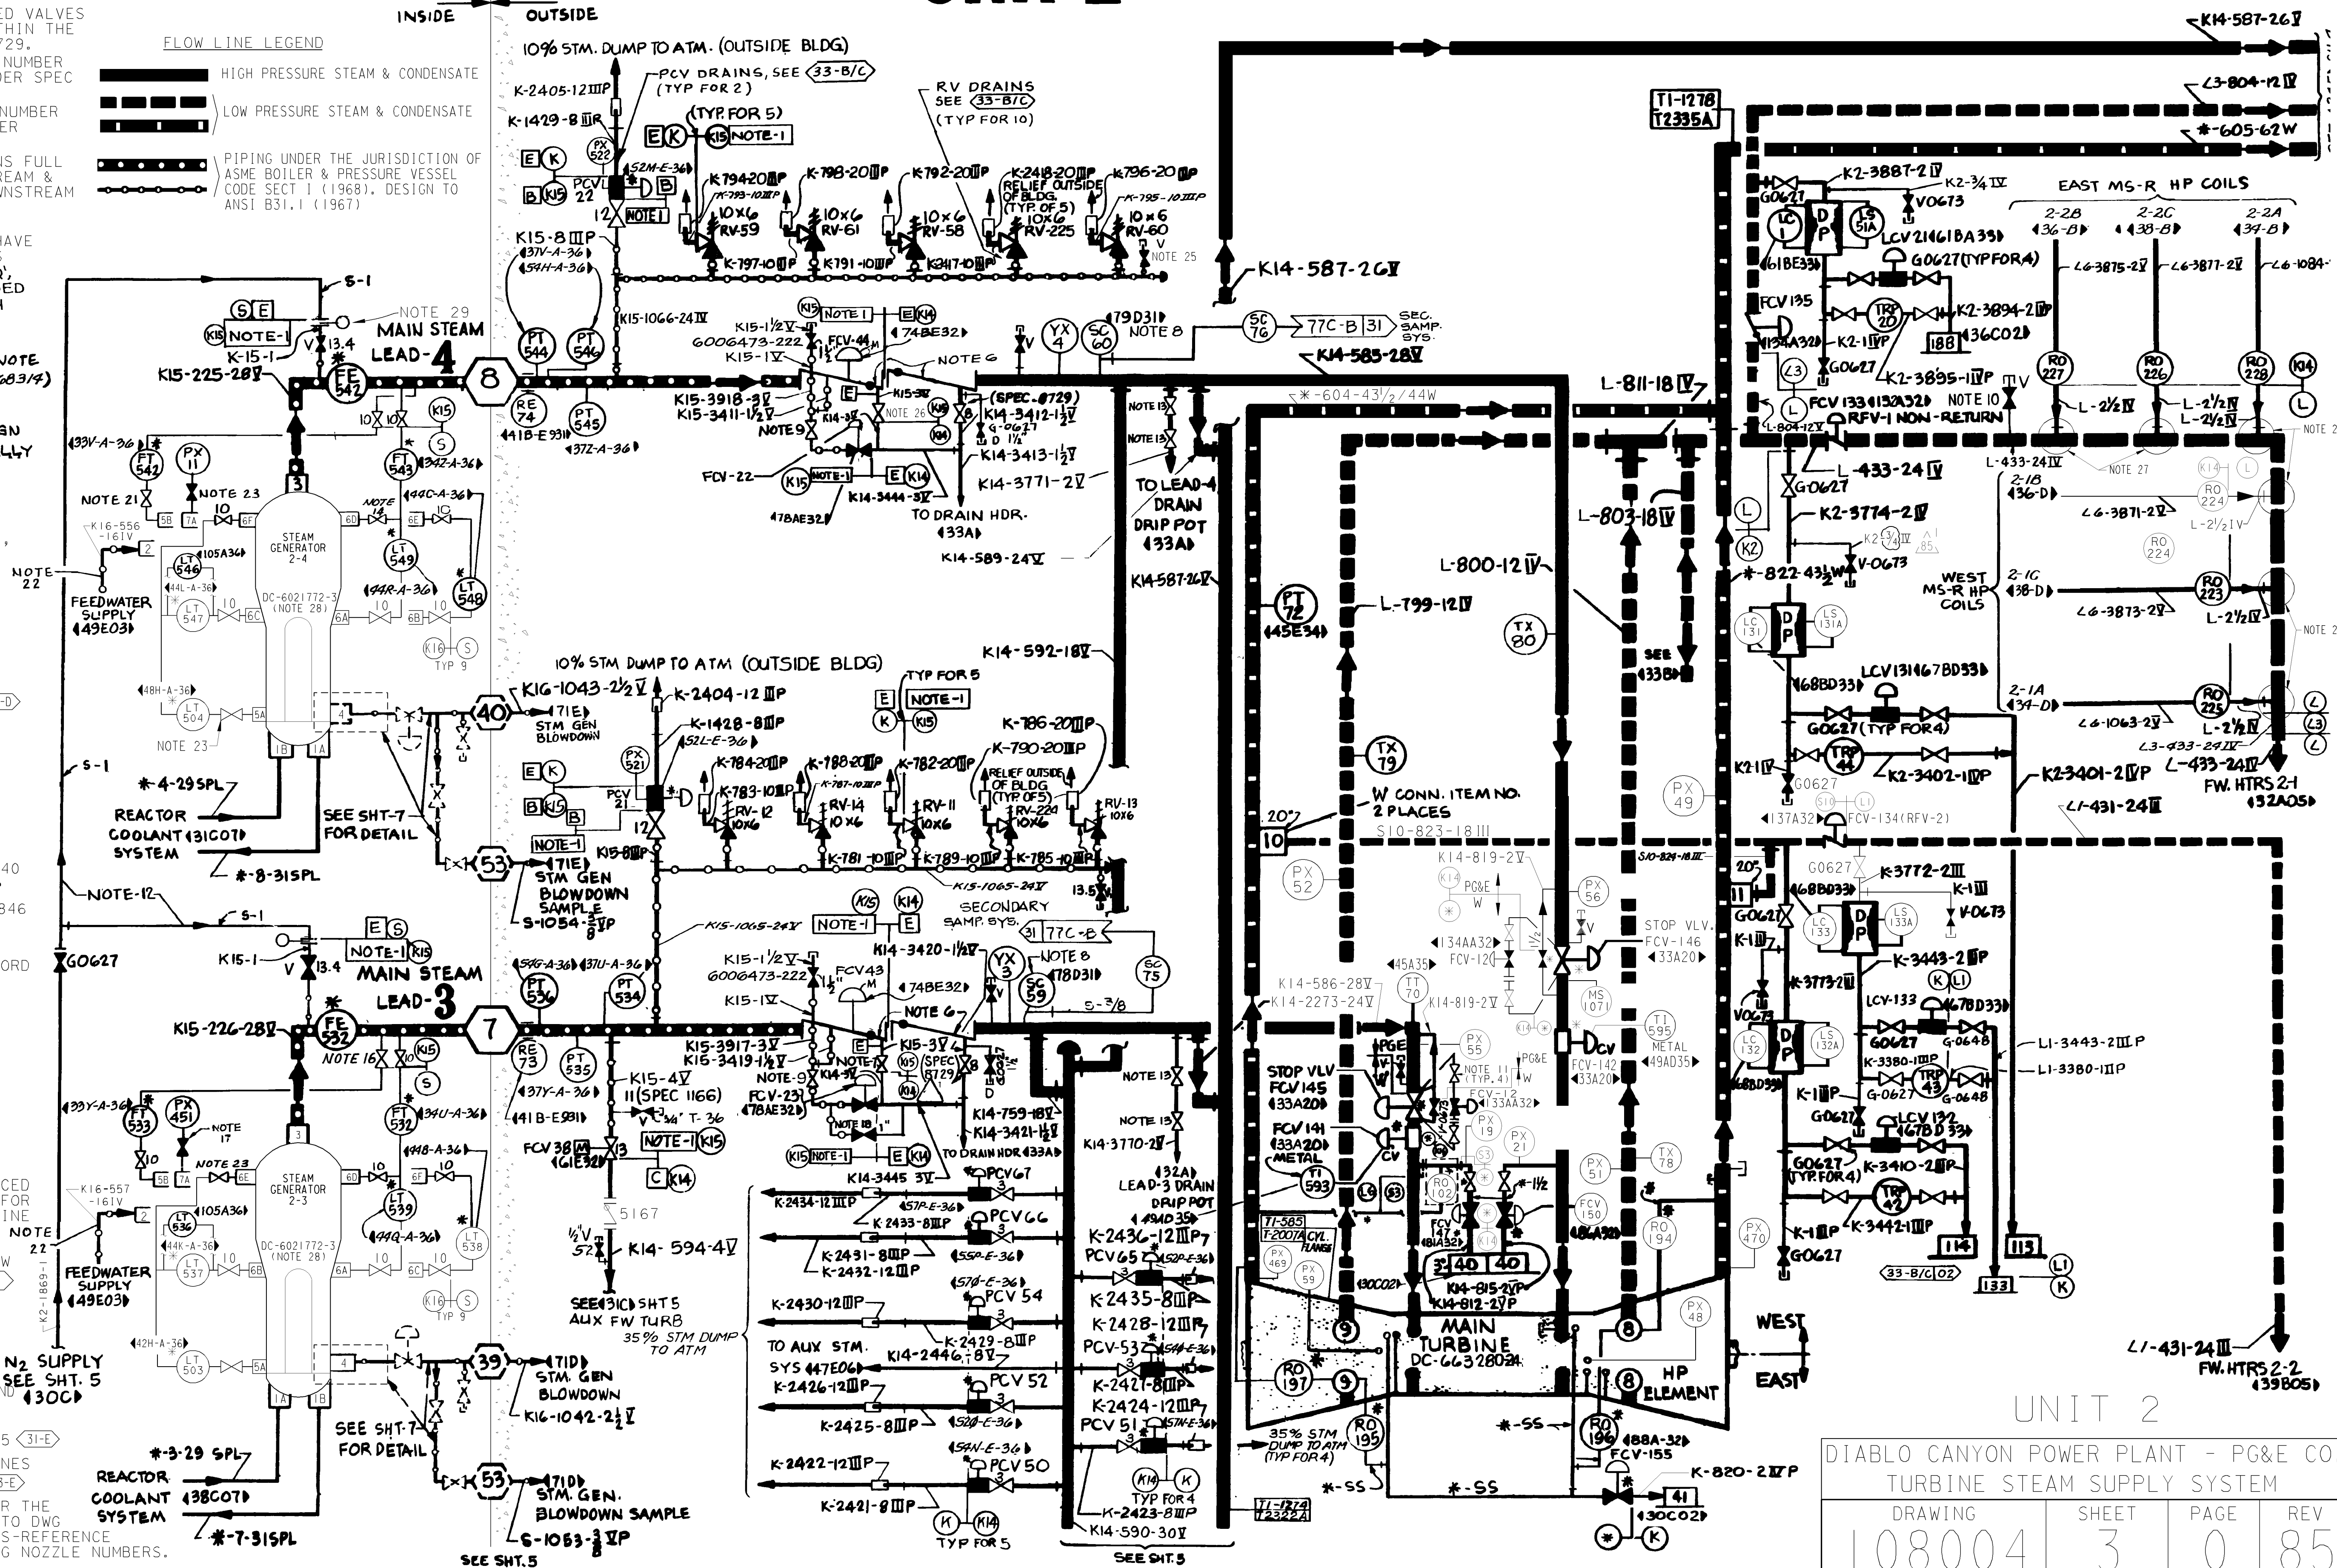

UNIT 2

DIABLO CANYON POWER PLANT - PG&E CO.
TURBINE STEAM SUPPLY SYSTEM

DRAWING	SHEET	PAGE	REV
08004	3	0	85

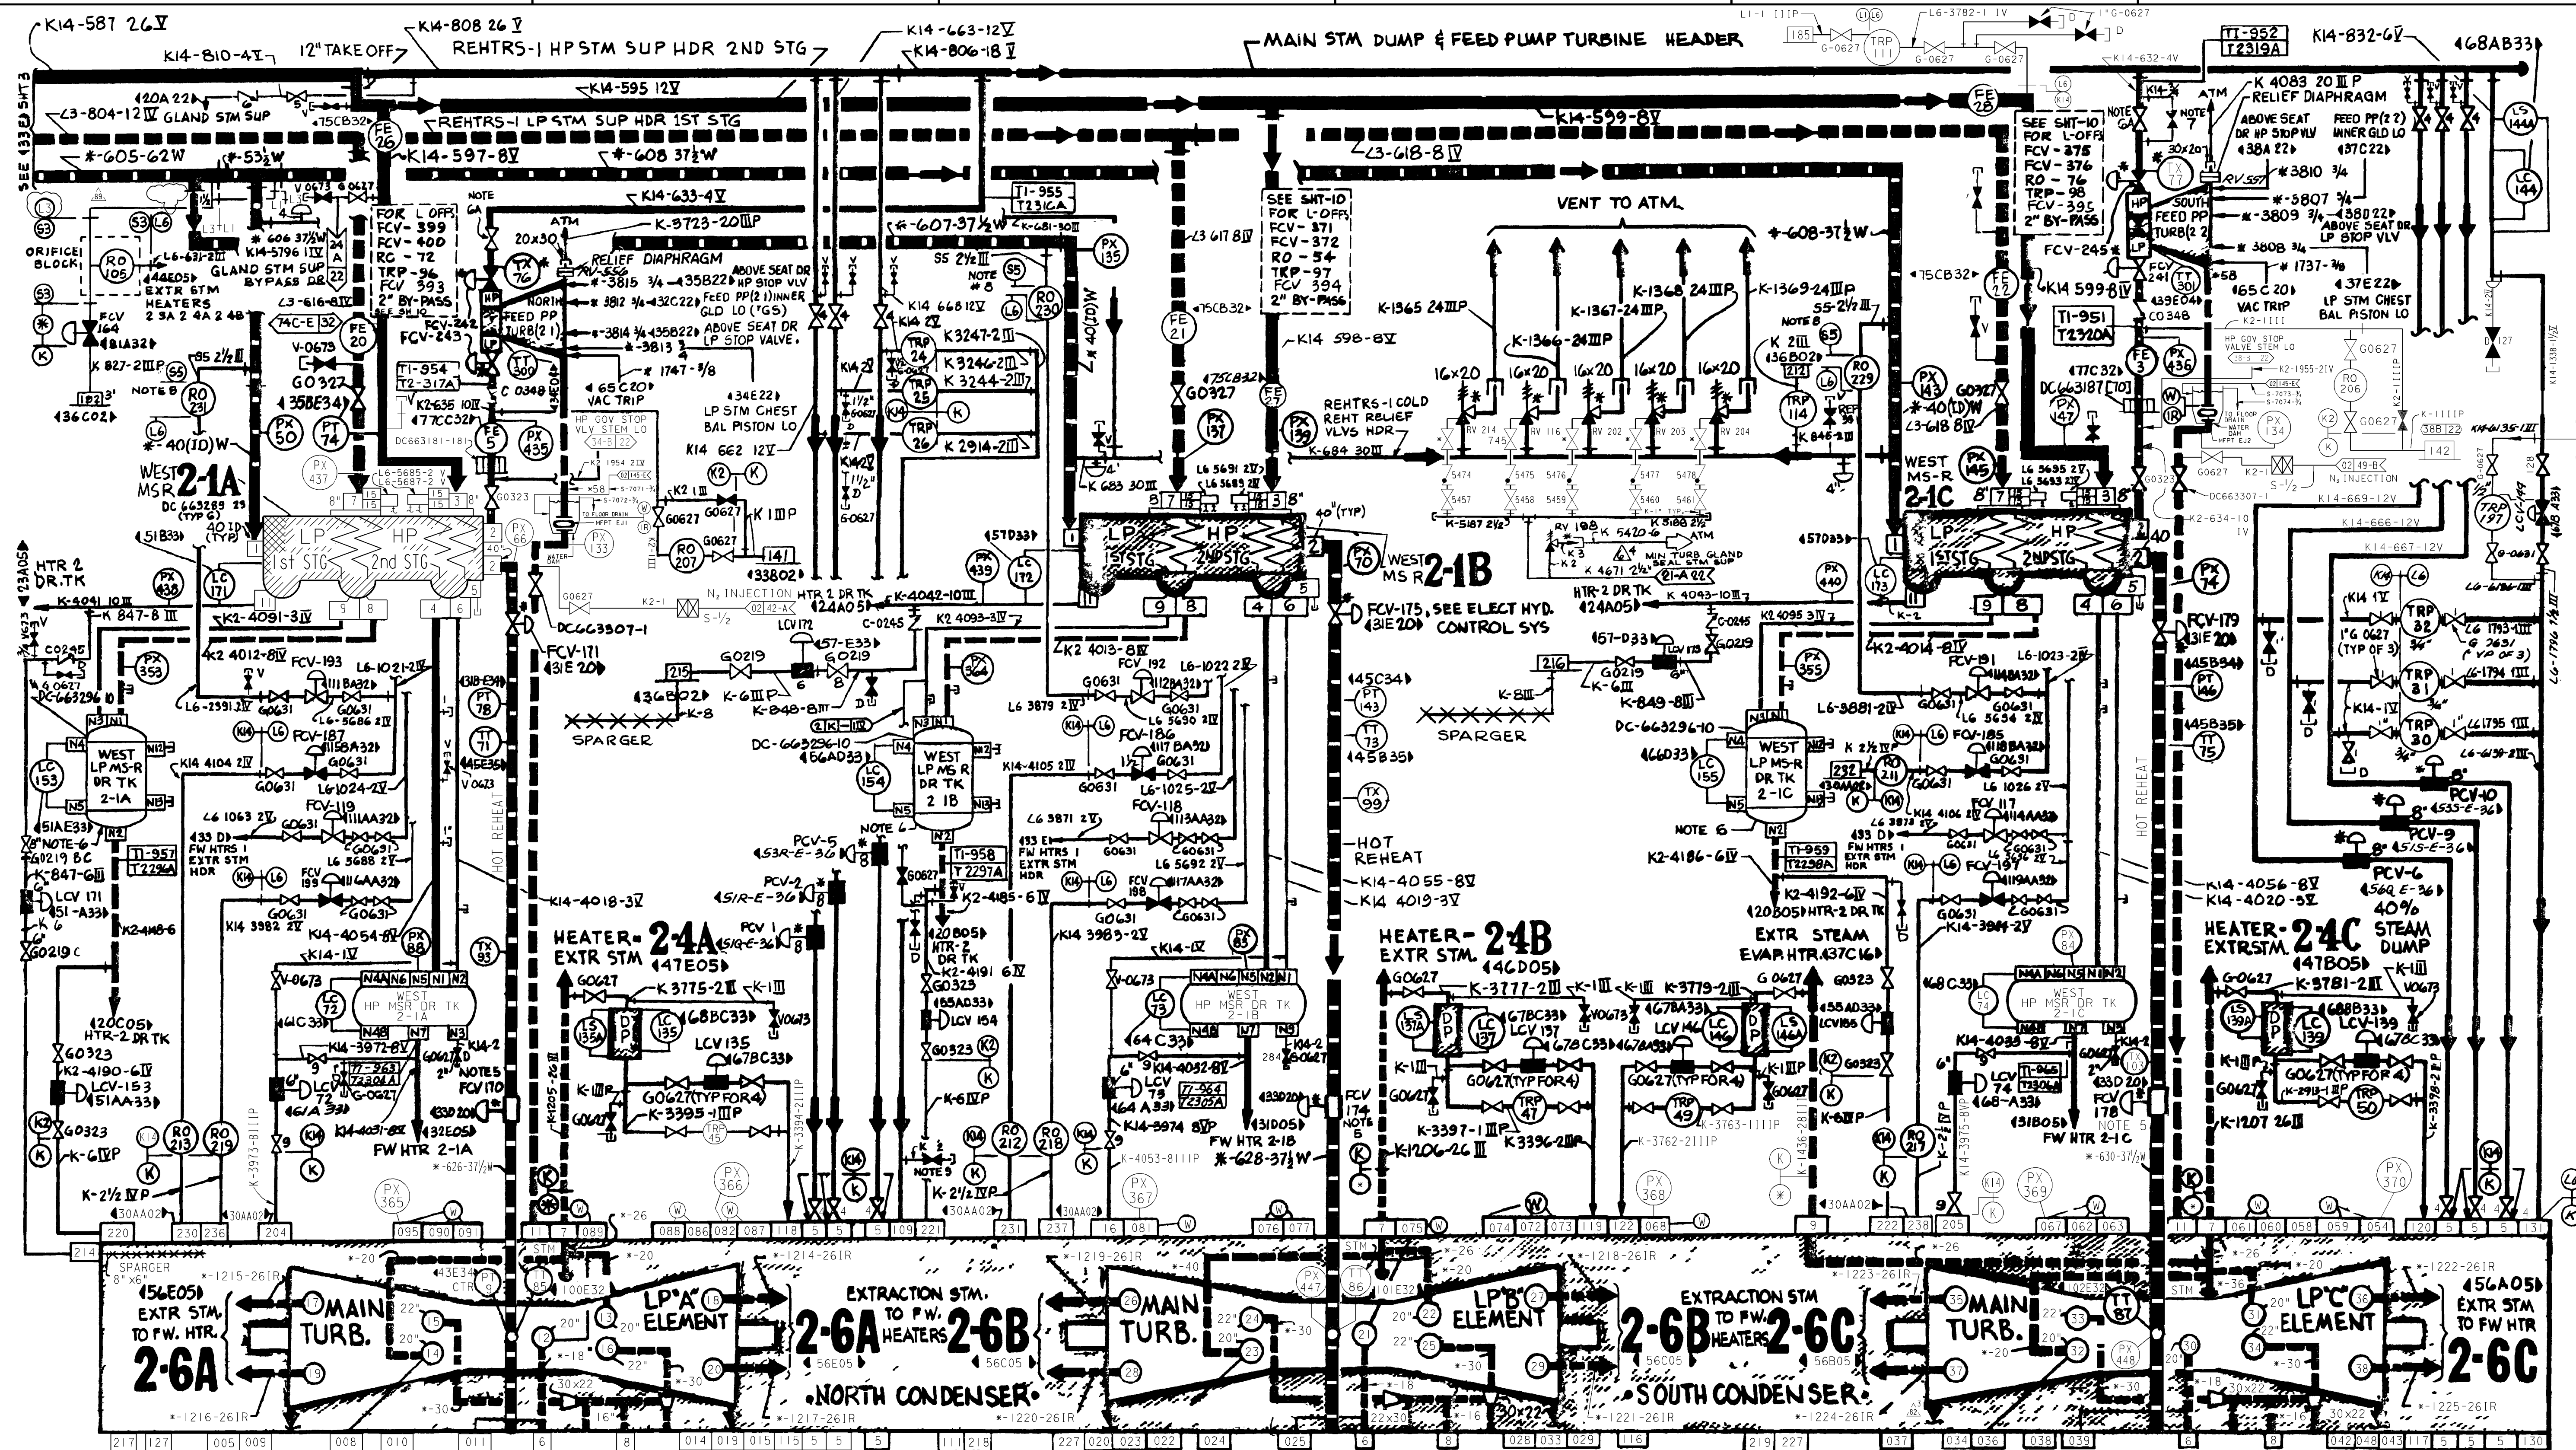

NOTES 1 PG&E CLASS CODE [] MANUAL VALVES WITH ITEM NOS ARE UNDER SPEC 8762 EXCEPT AS NOTED

2 ON ALL TRAPS AND LCV DRAINS, FULL INSULATION IS USED UPSTREAM AND PERSONNEL PROTECTION DOWNSTREAM

3 (W) DENOTES WESTINGHOUSE NOZZLE

4 ALL PIPING THIS SHEET PG&E CLASS CODE []

5 REFER TO E-H SYS. DWG 108020 6HTG 3&3A

6 ADDITIONAL INST & NOZZLES FOR LP MS-R DRAIN TANK

LP MS-R DRAIN TK	LI	LS (LOA)	LS (HIA)
2-1A	253A	253A	253B
2-1B	254A	254A	254B
2-1C	255A	255A	255B

6A 4"-600# GATE VALVE VELAN MOD #B12-2034P-02TS WITH 1/2" BYPASS VALVE STOCK CODE 85-1109 <34 38-E>

7 3/4"-1200# GLOBE VALVE, WALWORTH MODEL 5585 <39-E>

8 2 1/2" PIPING DENOTED IS PG&E PIPING SPEC 56 EXCEPT MATERIAL IS 304L AND SOCKET WELDING ENDS ARE USED AT ELBOWS <34,36,38-E>

9. 1/2" SW GLOBE VALVE, VOGT SW-12141 FHF <35-E>

10. CONDENSER N₂ INJECTION FOR DISSOLVED O₂ CONTROL IS THROUGH PX-367 AND PX-369. FOR N₂ SUPPLY, SEE DWG 108005 COORD 79-C. <36-E> <38-E>

11. DELETED

UNIT 2

DIABLO CANYON POWER PLANT - PG&E CO.
TURBINE STEAM SUPPLY SYSTEM

DRAWING	SHEET	PAGE	REV
108004	4	0	89

04-17-2013	ZNS4	FxC2	KJD3	NOT REQUIRED	N/A	N/A	N/A	REVISED PER DFT-7*2075
DATE	DWN	RE	IV	PROFESSIONAL ENGINEER	PE DISC.	PE#	PE EXP.	

STM GEN NOZZLES	
PG&E	MFR.
1-A	1A
1-B	1B
3	2
4	3
5-A	4A
5-B	4B
6	5
7	6
8D-1	7B
8D-2	7A
9A-1	8A
9A-2	8D
9B-1	8B
9B-2	8E
9C-1	8C
9C-2	8F



ABOVE NOZ EQUIV
TYP FOR ALL GEN'S
SEE NOTE 8

FLOW LINE LEGEND


- HIGH PRESSURE STEAM & CONDENSATE
- LOW PRESSURE STEAM & CONDENSATE
- PIPING UNDER THE JURISDICTION OF
ASME BOILER & PRESSURE VESSEL CODE
SECTION I (1968) DESIGN TO ANSI B31.1 (1967)

NOTES

- LIMITS OF ASME BOILER AND PRESSURE VESSEL CODE SECTION I (1968) JURISDICTION, MANUAL AND MOTOR OPERATED VALVES WITH ITEM NUMBER AND WITHIN THE LIMITS ARE UNDER SPEC.8729.
- MANUAL VALVES WITH ITEM NUMBER ON CLASS E LINES ARE UNDER SPEC.8762, EXCEPT AS NOTED. MANUAL VALVES WITH ITEM NUMBER ON CLASS B OR C LINES ARE UNDER SPEC.8729, EXCEPT AS NOTED.
- ON ALL TRAPS & LCV DRAINS FULL INSULATION IS USED UPSTREAM & PERSONNEL PROTECTION DOWNSTREAM.
- 1" GREENWOOD SPECTACLE FLANGE, ANSI 600#, DC-6012369-1.
- ALL TEAM TRAPS ARE TO HAVE INTEGRAL STEAM STRAINERS.
- CHECK VALVE IS QA CLASS 'Q', DESIGN CLASS I AND WELDED TO ISOLATION VALVE, BOTH ARE UNDER SPEC. 8721. (31-B) (31-A)
- MANUAL VALVES WITH THIS NOTE SHALL BE DC-663125-8 (4R-68314).
- (SEE TABLE (30C)) SUBSCRIPTS A,B,A-1,A-2 ETC WERE ADDED TO NOZZLE NOS TO DIFFERENTIATE SERVICE & INSTRUMENT TAGGING, REF. DWG. DC-663206-3,-44 TO -51.
- (FE-1) ORIFICE PLATE REMOVED, ORIFICE FLANGES WITH VALVES RETAINED. (31-B)
- DELETED
- SC-57 AND SC-58 ARE DESIGN CLASS II AND ARE SEISMICALLY ANALYZED IN ACCORDANCE WITH DESIGN CRITERIA MEMORANDUM M-61 (32-A) (B)
- 3/4"-2500# ORBERT GATE VALVE SUPPLIED BY WESTINGHOUSE P4 MATERIAL. (32-A)
- VALVES PER PO 4R-59911, MC #7 (31-A) (B)
- MAIN STEAM LEAD DRIP POT DRAIN PIPING SHALL BE IN ACCORDANCE WITH DC 049063 TYPE V
- VELAN B 12 205 4F 02TS (33-B)
- N₂ BLANKETING TUBING SEISMICALLY SUPPORTED (30-B)
- VELAN W04 2054B 02MS DWG DC 6006473 39 (31-B)
- HANCOCK MOD 950W (32-A) (B)
- 1" VELAN CHECK VALVE DWG # DC 6006473-169 STOCK #94-2915. (31-B)
- PORTIONS OF LINE 2416 DESIGNATED AS SPEC K2 MAY BE ASTM A53 OR ASTM A106 GR B, FUTURE INSTALLATION SHALL BE TO K2 SPEC. (31-B)
- VELAN W05-2054B-02MS, DWG DC 6006473-39. (30-A)
- DC-6006473-40, S/C 93-6847. (30-C/B)
- 3/4" GLOBE VALVE, S/C 93-6846 AND DWG 6006473-269. (30-A/B)

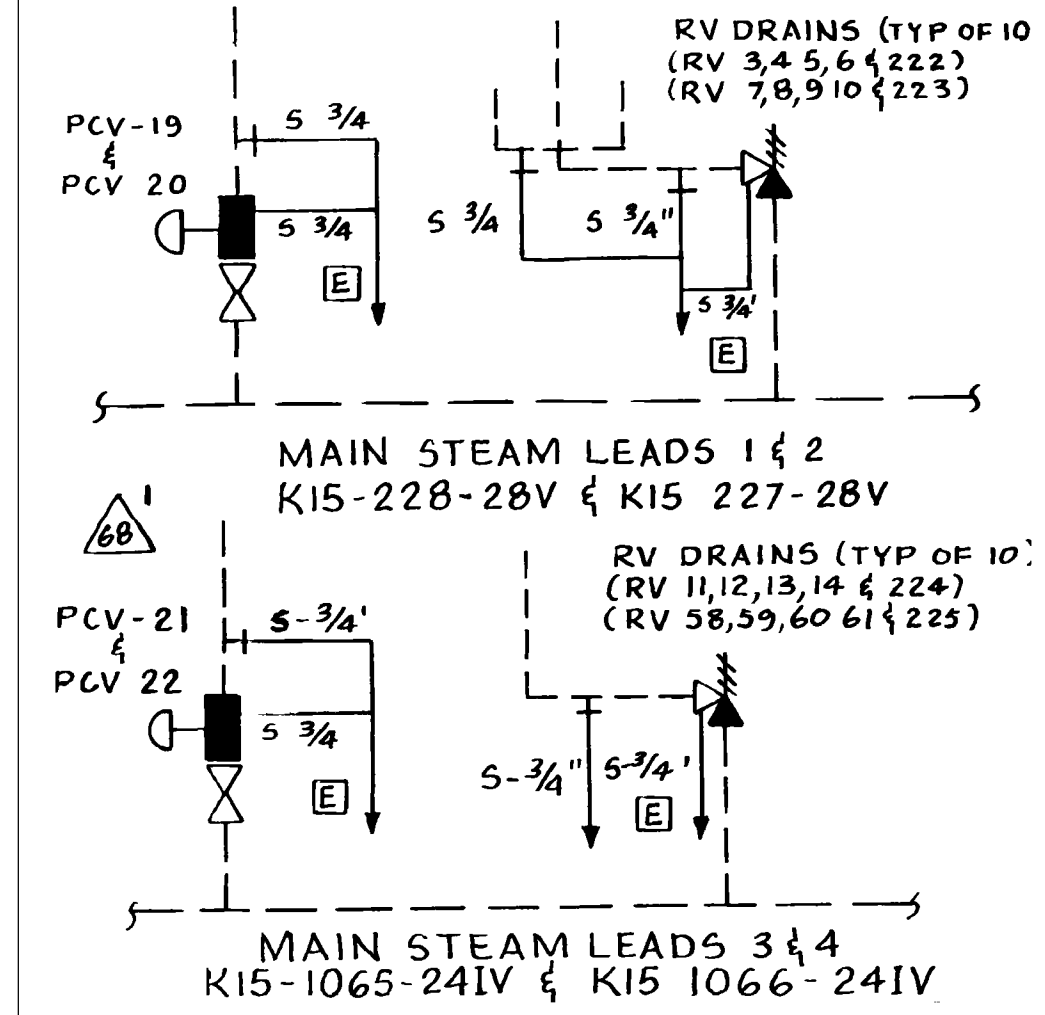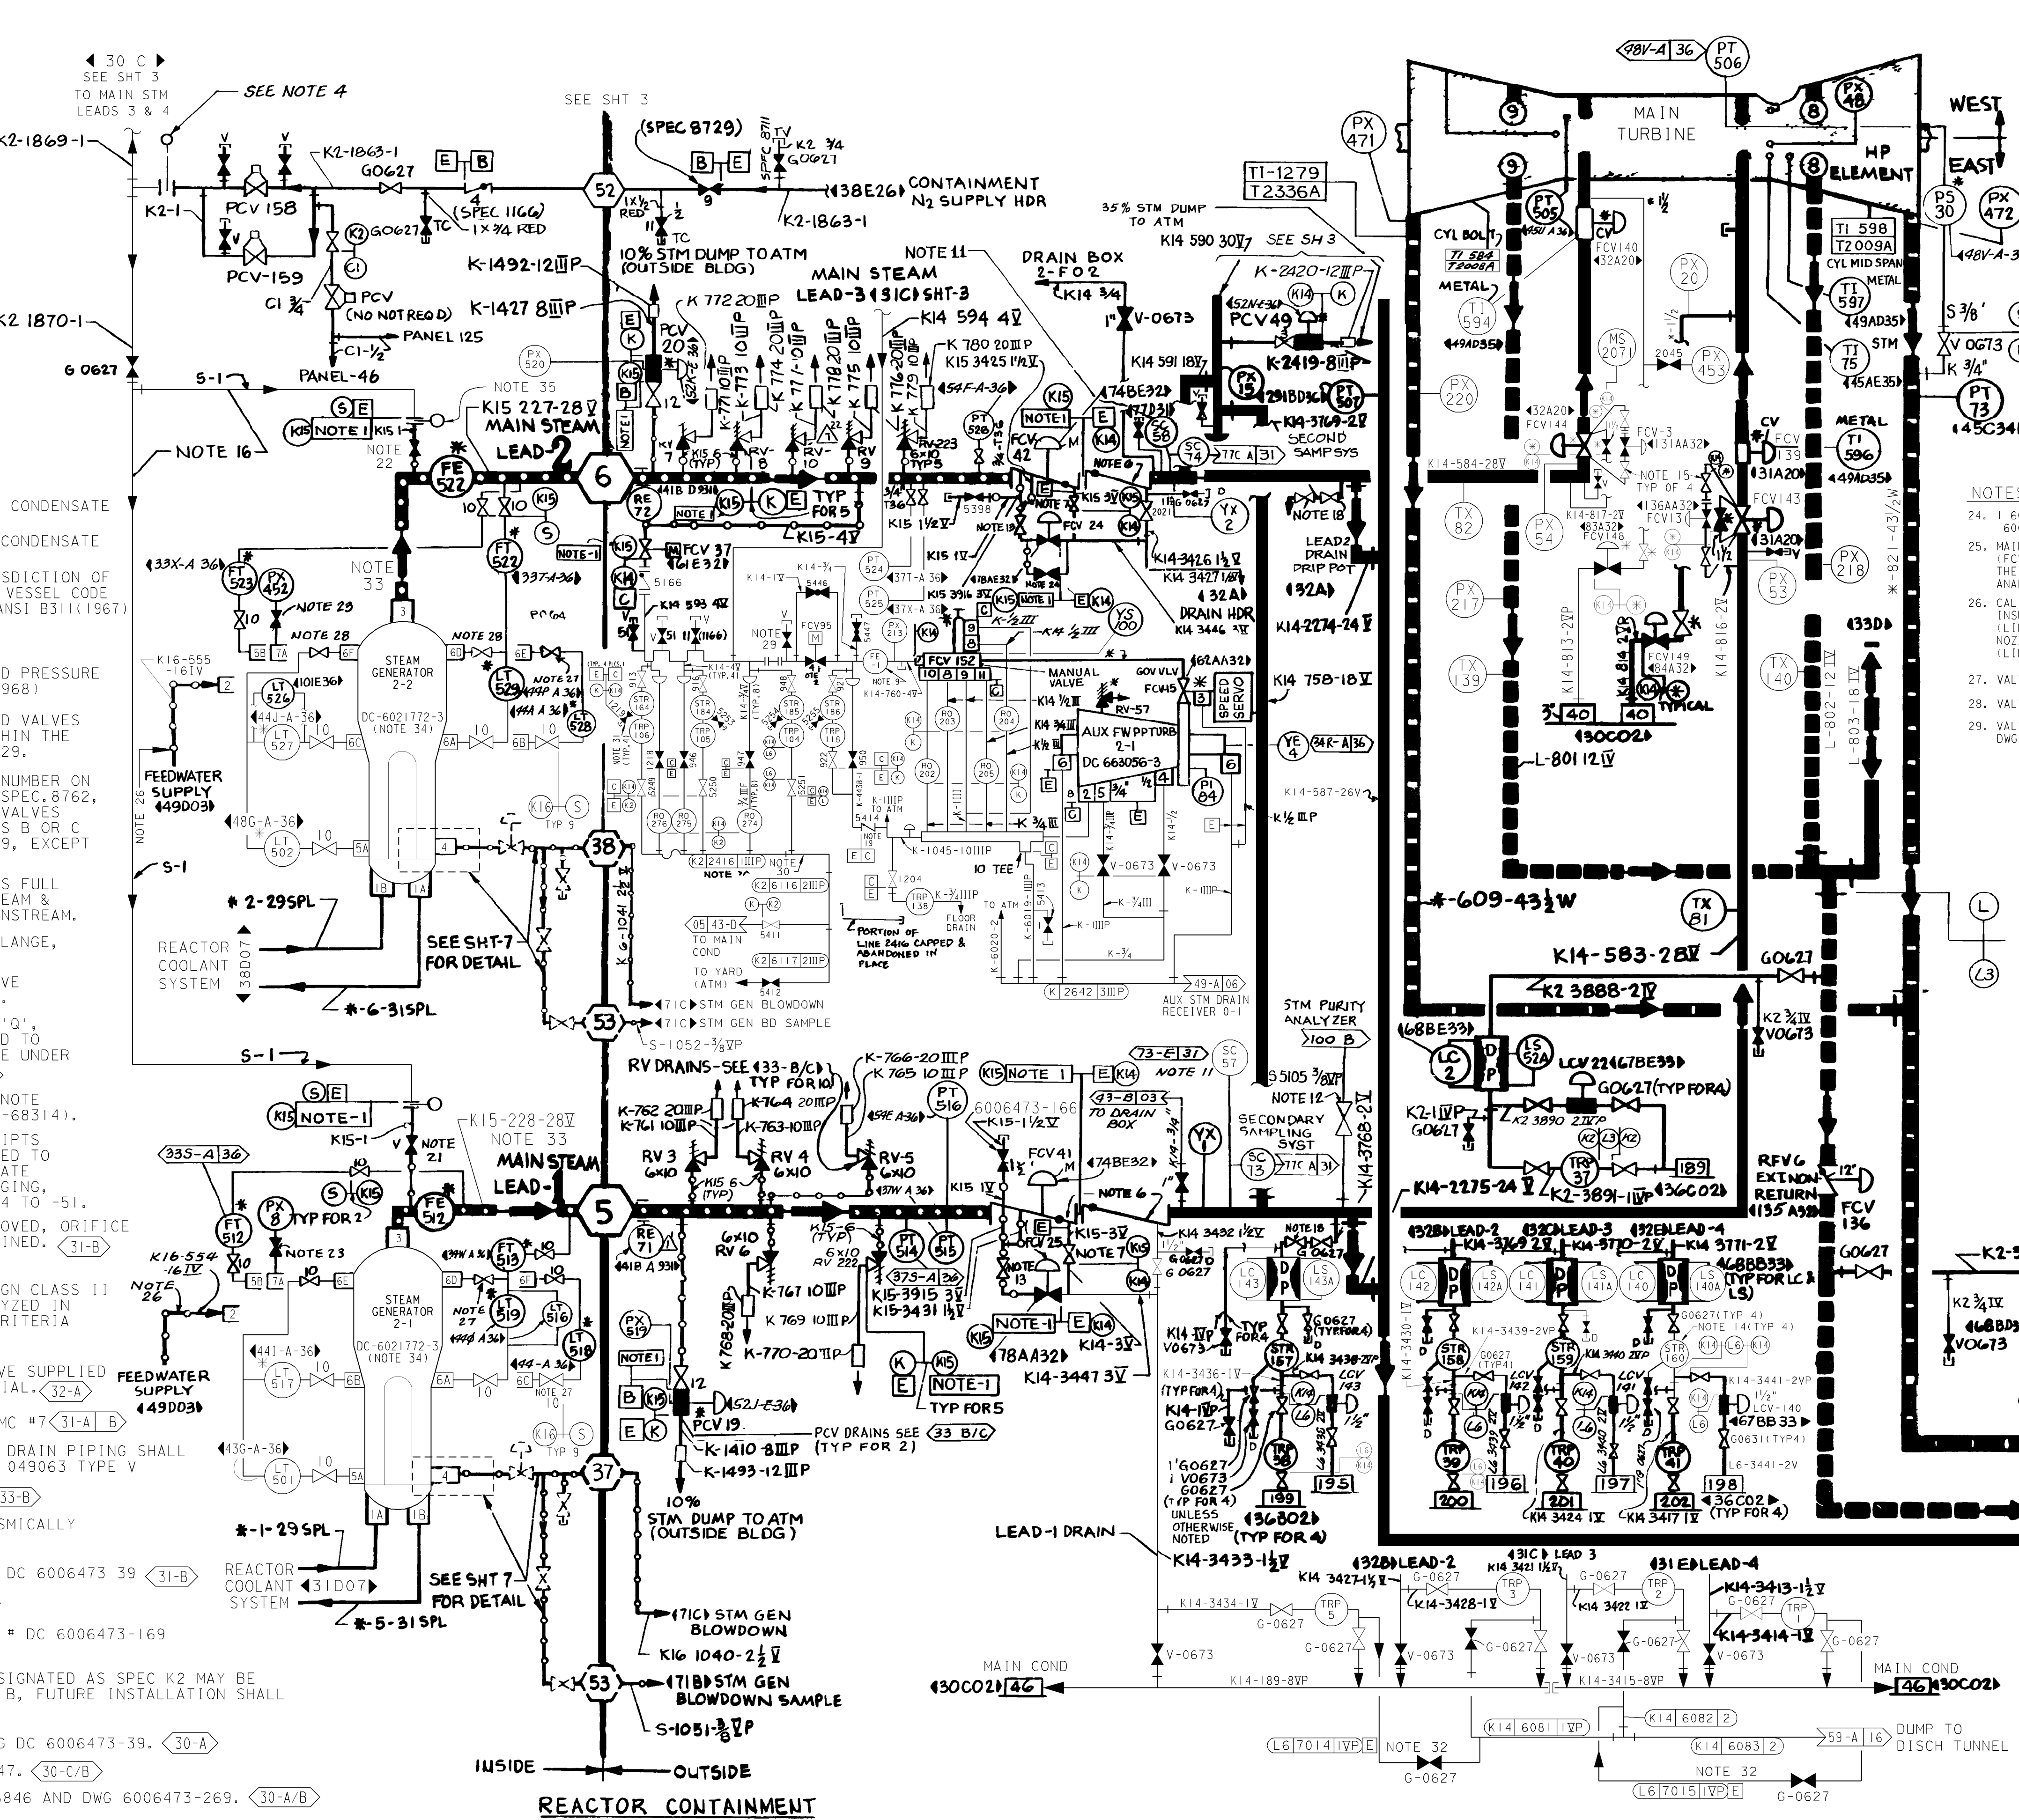

- NOTES (CONT)
- 1 600# GLOBE VALVE, RECORD NO 6006473-40
 - MAIN STEAM PIPING DOWNSTREAM OF MSIV'S (FCV-41, 42, 43 & 44) TO THE G-LINE ANCHOR AT THE TURBINE BUILDING WALL IS SEISMICALLY ANALYZED.
 - CAL SIL INSULATION REPLACED WITH BLANKET INSULATION FOR 90° ELBOWS AT ELEV 129' (LINE 554 & 555) AND FROM THE FEEDWATER NOZZLE TO JUST BELOW THE FIRST 90° ELBOW (LINE 554 & 555). (30-B/A)
 - VALVE DWG 6000235-71. (30-B/A)
 - VALVE DWG 663164-10. (30-B)
 - VALVE S/C 93-6840. (31-B)
 - A PORTION OF LINE 2416 PER SPEC "L".
 - VALVE S/C 93-6845, DWG 6006473-40
 - PORTIONS OF LINES 3414, 3434, 6081 AND 6082 INCLUDE "L6" PIPE FOR ENHANCED EROSION/CORROSION. REFER TO APPLICABLE PIPING ISOMETRIC DRAWINGS FOR LOCATIONS. (32-A) (33-A)
 - CAL SIL INSULATION REPLACED WITH PAD INSULATION PER MMD M00022. (REF. FCT-31458 FOR DETAILS). (30-A) (30-B)
 - SG NOZZLE NUMBERS ARE FOR THE REPLACEMENT SG'S. REFER TO DWG DC 6021772-7D FOR A CROSS-REFERENCE TABLE FOR THE ORIGINAL SG NOZZLE NUMBERS.
 - FOR SPECTACLE PLATE DETAIL, SEE DRAWING 066142.

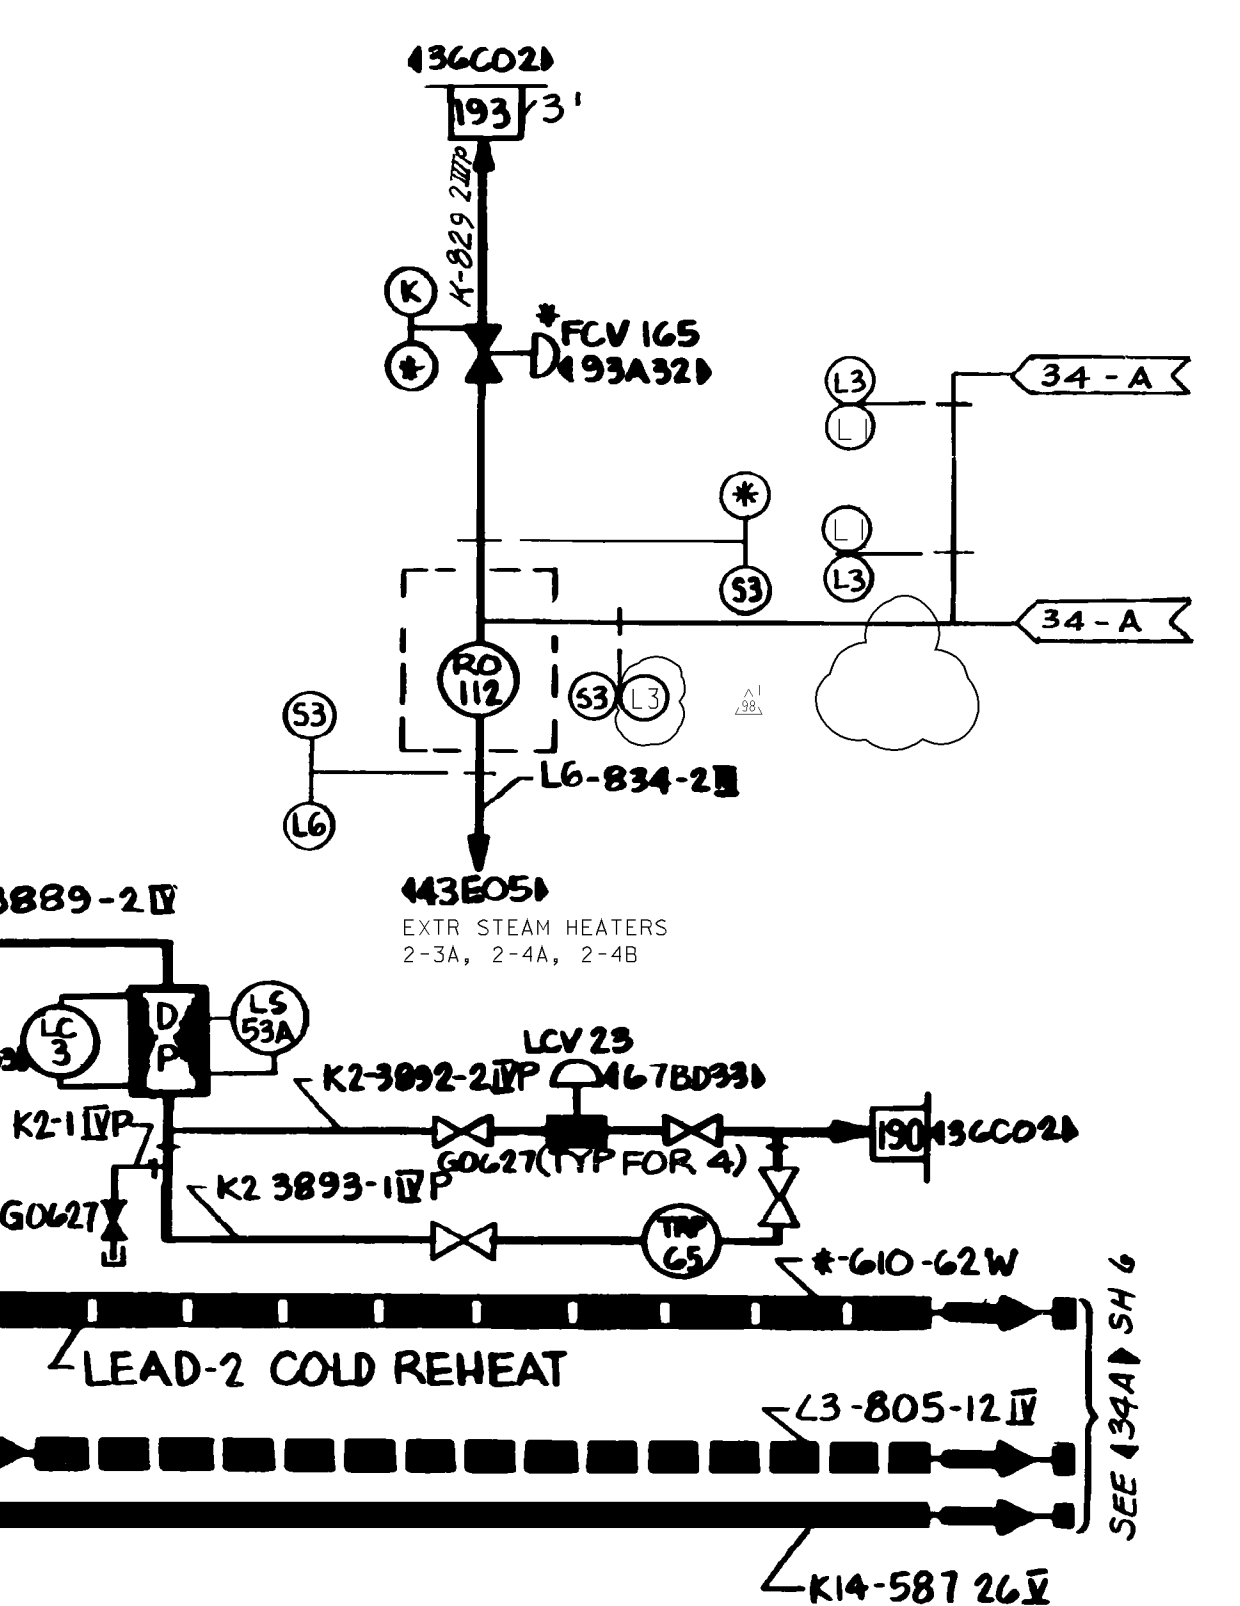

UNIT 2

DIABLO CANYON POWER PLANT - PG&E CO.			
TURBINE STEAM SUPPLY SYSTEM			
DRAWING	SHEET	PAGE	REV
108004	5	0	98

04-17-2013	ZNS4	FxC2	KJD3	NOT REQUIRED	N/A	N/A	N/A	REVISED PER DFT-7*2075
DATE	DWN	RE	IV	PROFESSIONAL ENGINEER	PE DISC.	PE*	PE EXP.	


NOTES CONT.:

7. CONDENSER N₂ INJECTION FOR DISSOLVED O₂ CONTROL IS THROUGH PX-372 AND PX-374 FOR N₂ SUPPLY, SEE DWG 108005 COORD 79-C. (35-C) (37-C)

8. DELETED Δ^2

9. DELETED Δ^2

UNIT-2

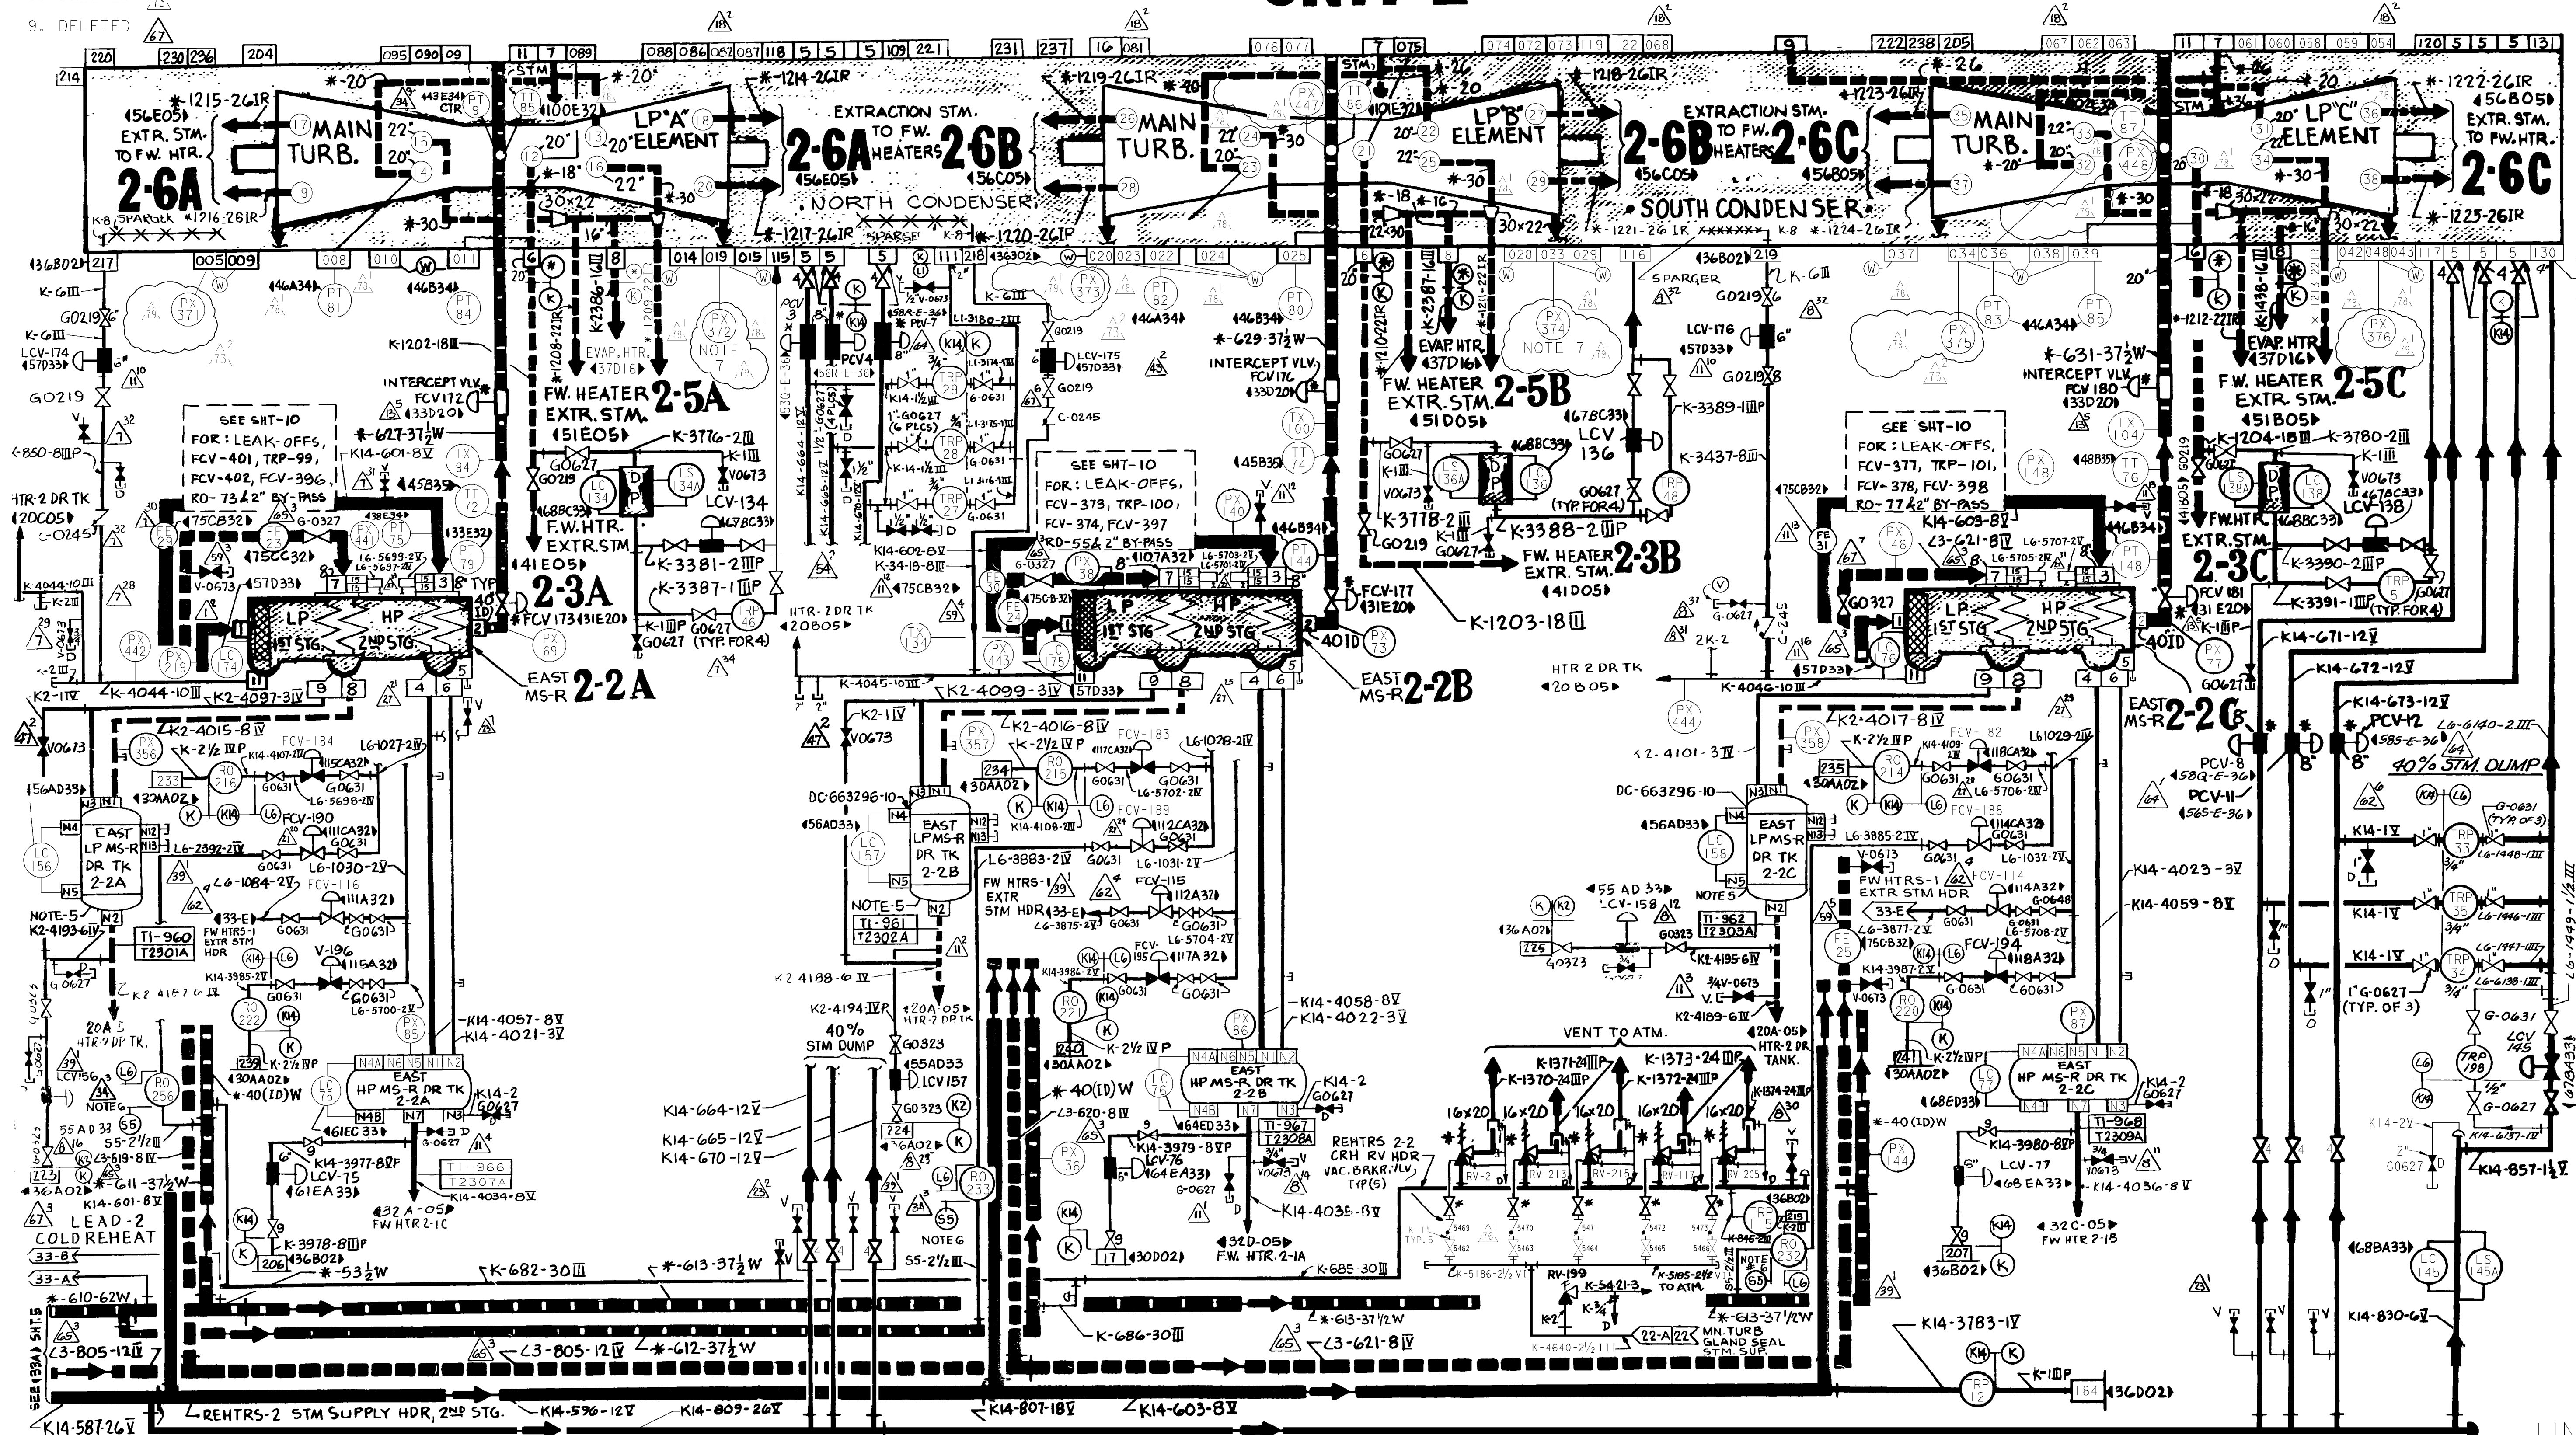

NOTES: 1. PG&E CLASS CODE [E] MANUAL & MOTOR OPERATED VALVES WITH ITEM NO. ARE UNDER SPEC. 8762.

2. ON ALL TRAP & LCV DRAINS, FULL INSULATION IS USED UPSTREAM & PERSONNEL PROTECTION DOWNSTREAM.

3. (W) DENOTES WESTINGHOUSE NOZZLE.
4. ALL PIPING THIS SHEET: PG&E CLASS CODE [E].


LP MS-R DRAIN TK.	LI	LS (LOA)	LS (LIA)
2-2A	256	256A	256B
2-2B	257	257A	257B
2-2C	258	258A	258B

6. 2 1/2" PIPING DENOTED IS PG&E PIPING SPEC. SS EXCEPT MATERIAL IS 304L & SOCKET WELDING ENDS ARE USED AT ELBOWS (34, 36, 38-A) FOR NOTES CONTINUATION SEE 34-C

DIABLO CANYON POWER PLANT - PG&E CO.
TURBINE STEAM SUPPLY SYSTEM

DRAWING SHEET PAGE REV

108004 6 0 79

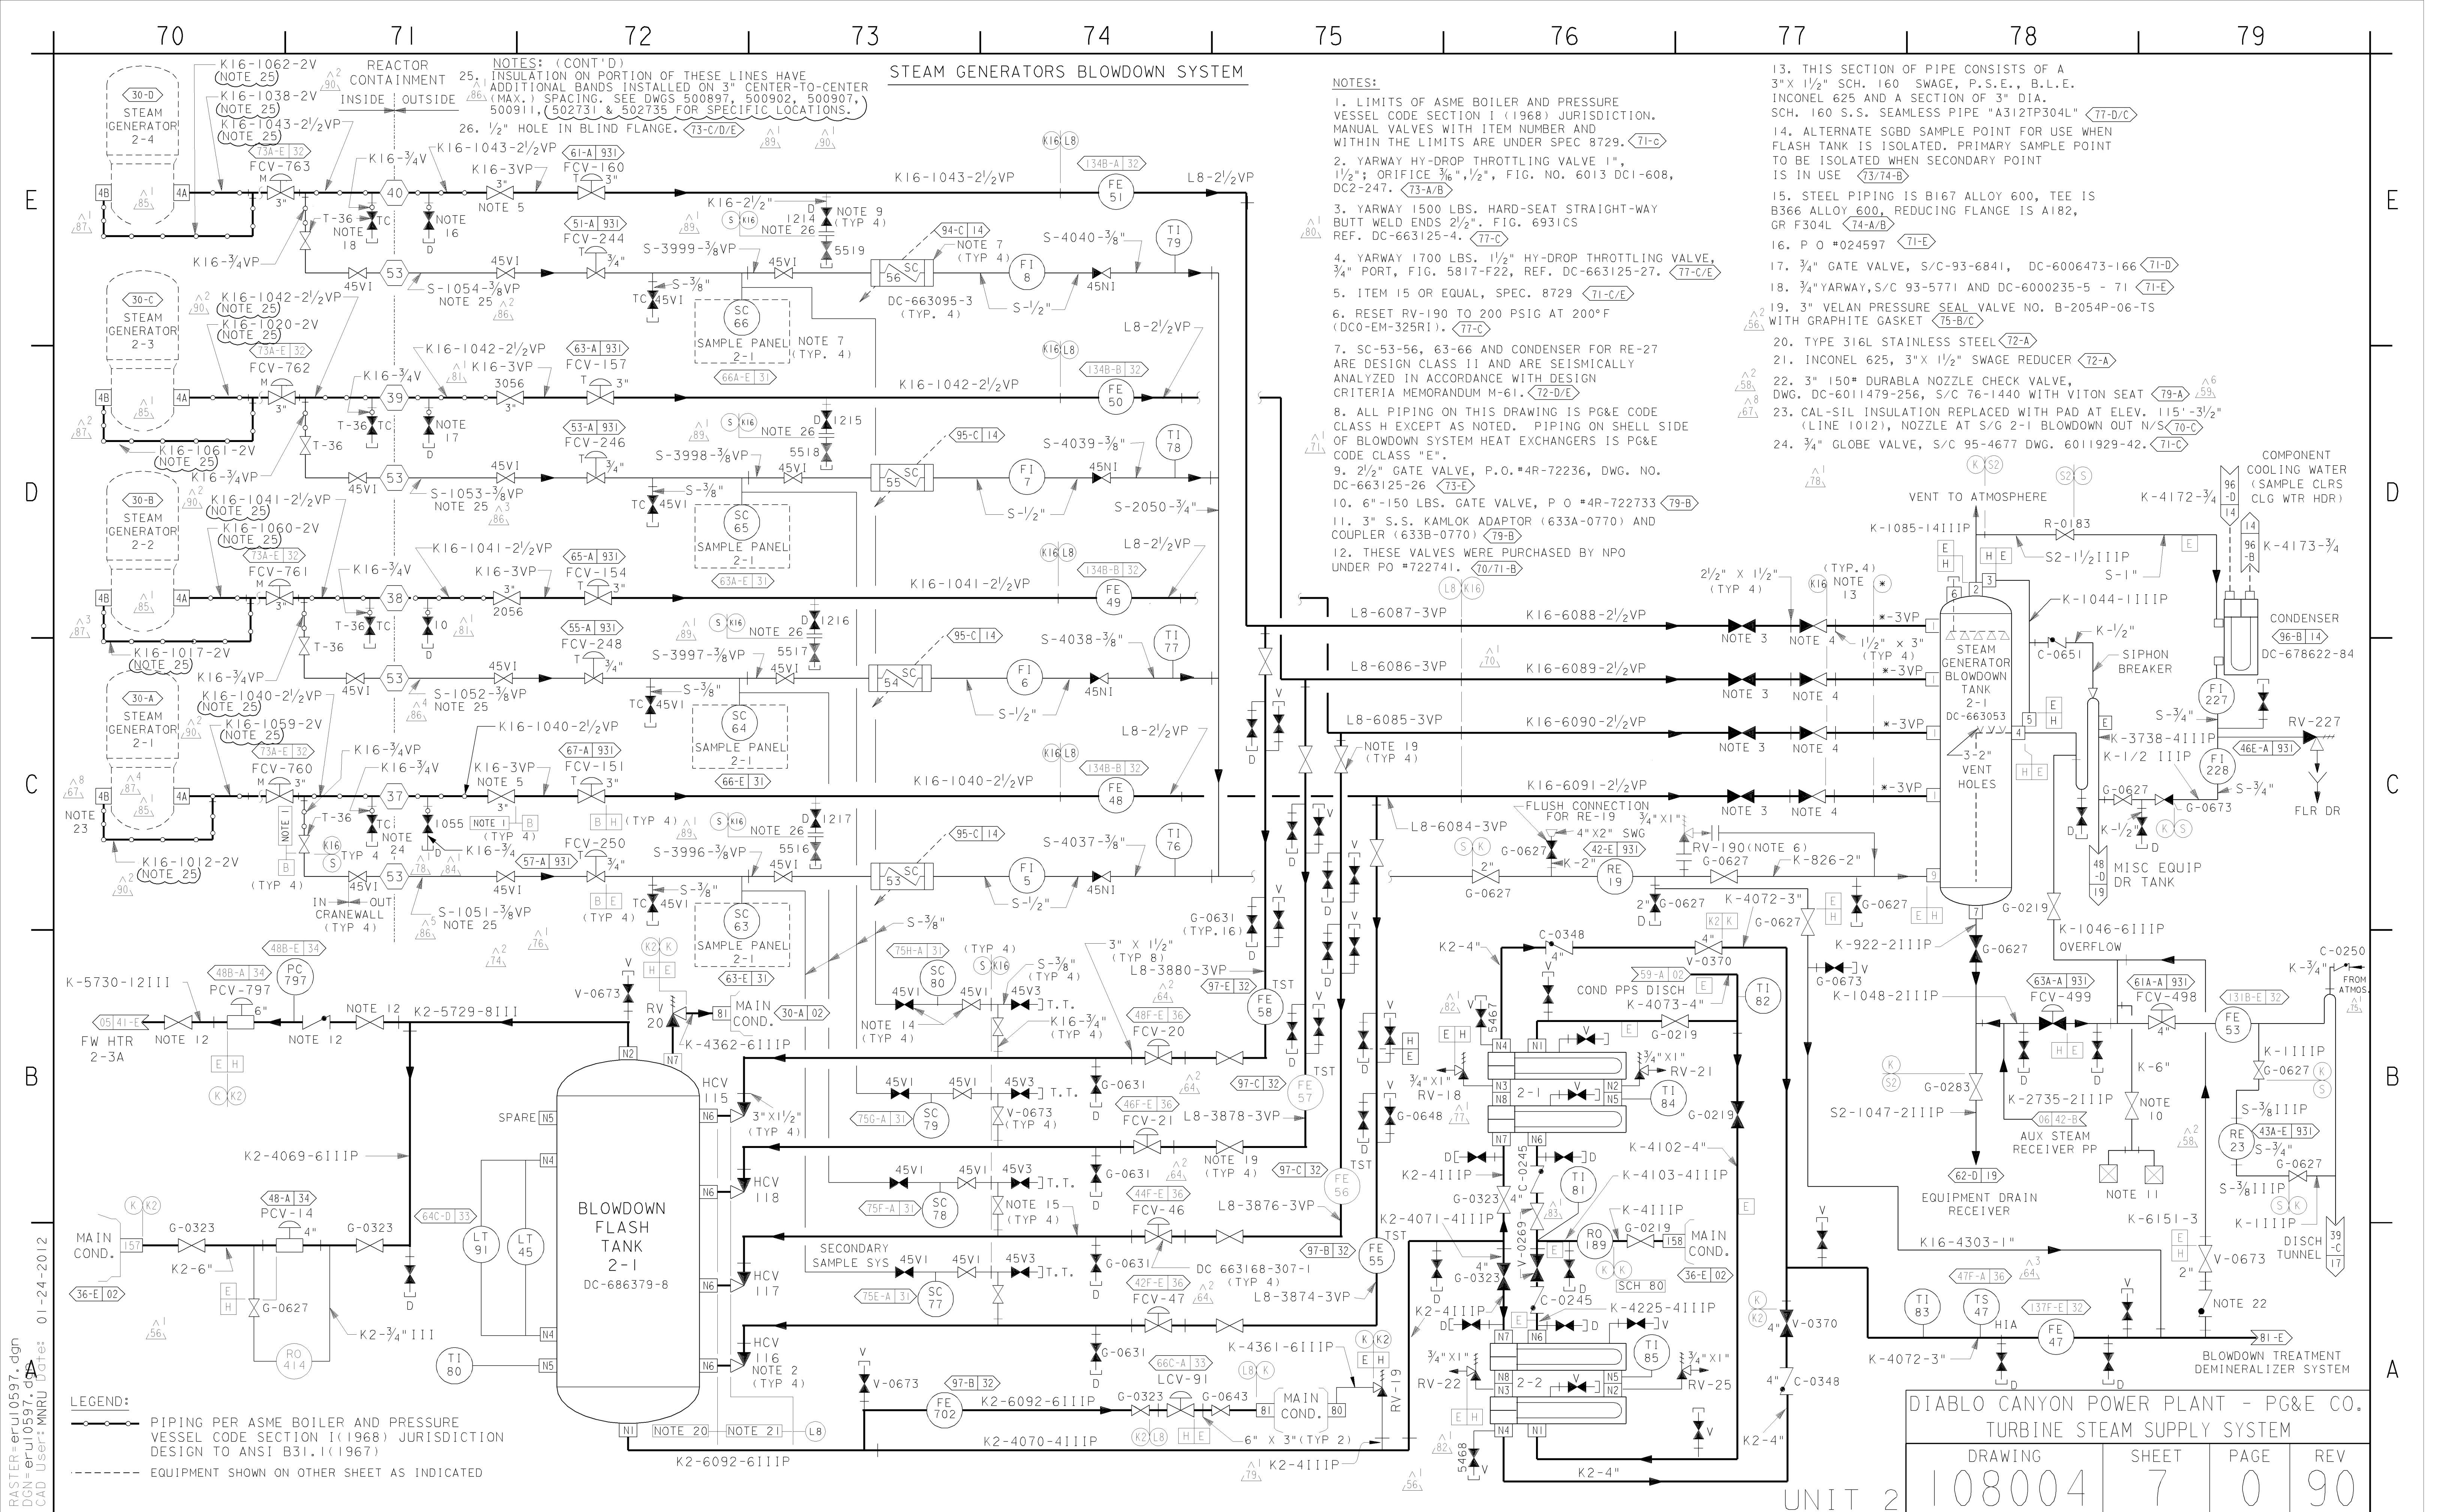


RASTER=erul0597.dgn
DGN=erul0597.dgn
CAD User=MNRU Date: 01-24-2012

3 of 26

01-24-2012	MNRU	RxG2		KERSI J. DALAL	MECHANICAL	M 16690	3/31/2012	REVISED PER DFT-7*1374-0
DATE	DWN	RE	IV	PROFESSIONAL ENGINEER	PE DISC.	PE*	PE EXP.	

STEAM GENERATORS BLOWDOWN TREATMENT DEMINERALIZER SYSTEM

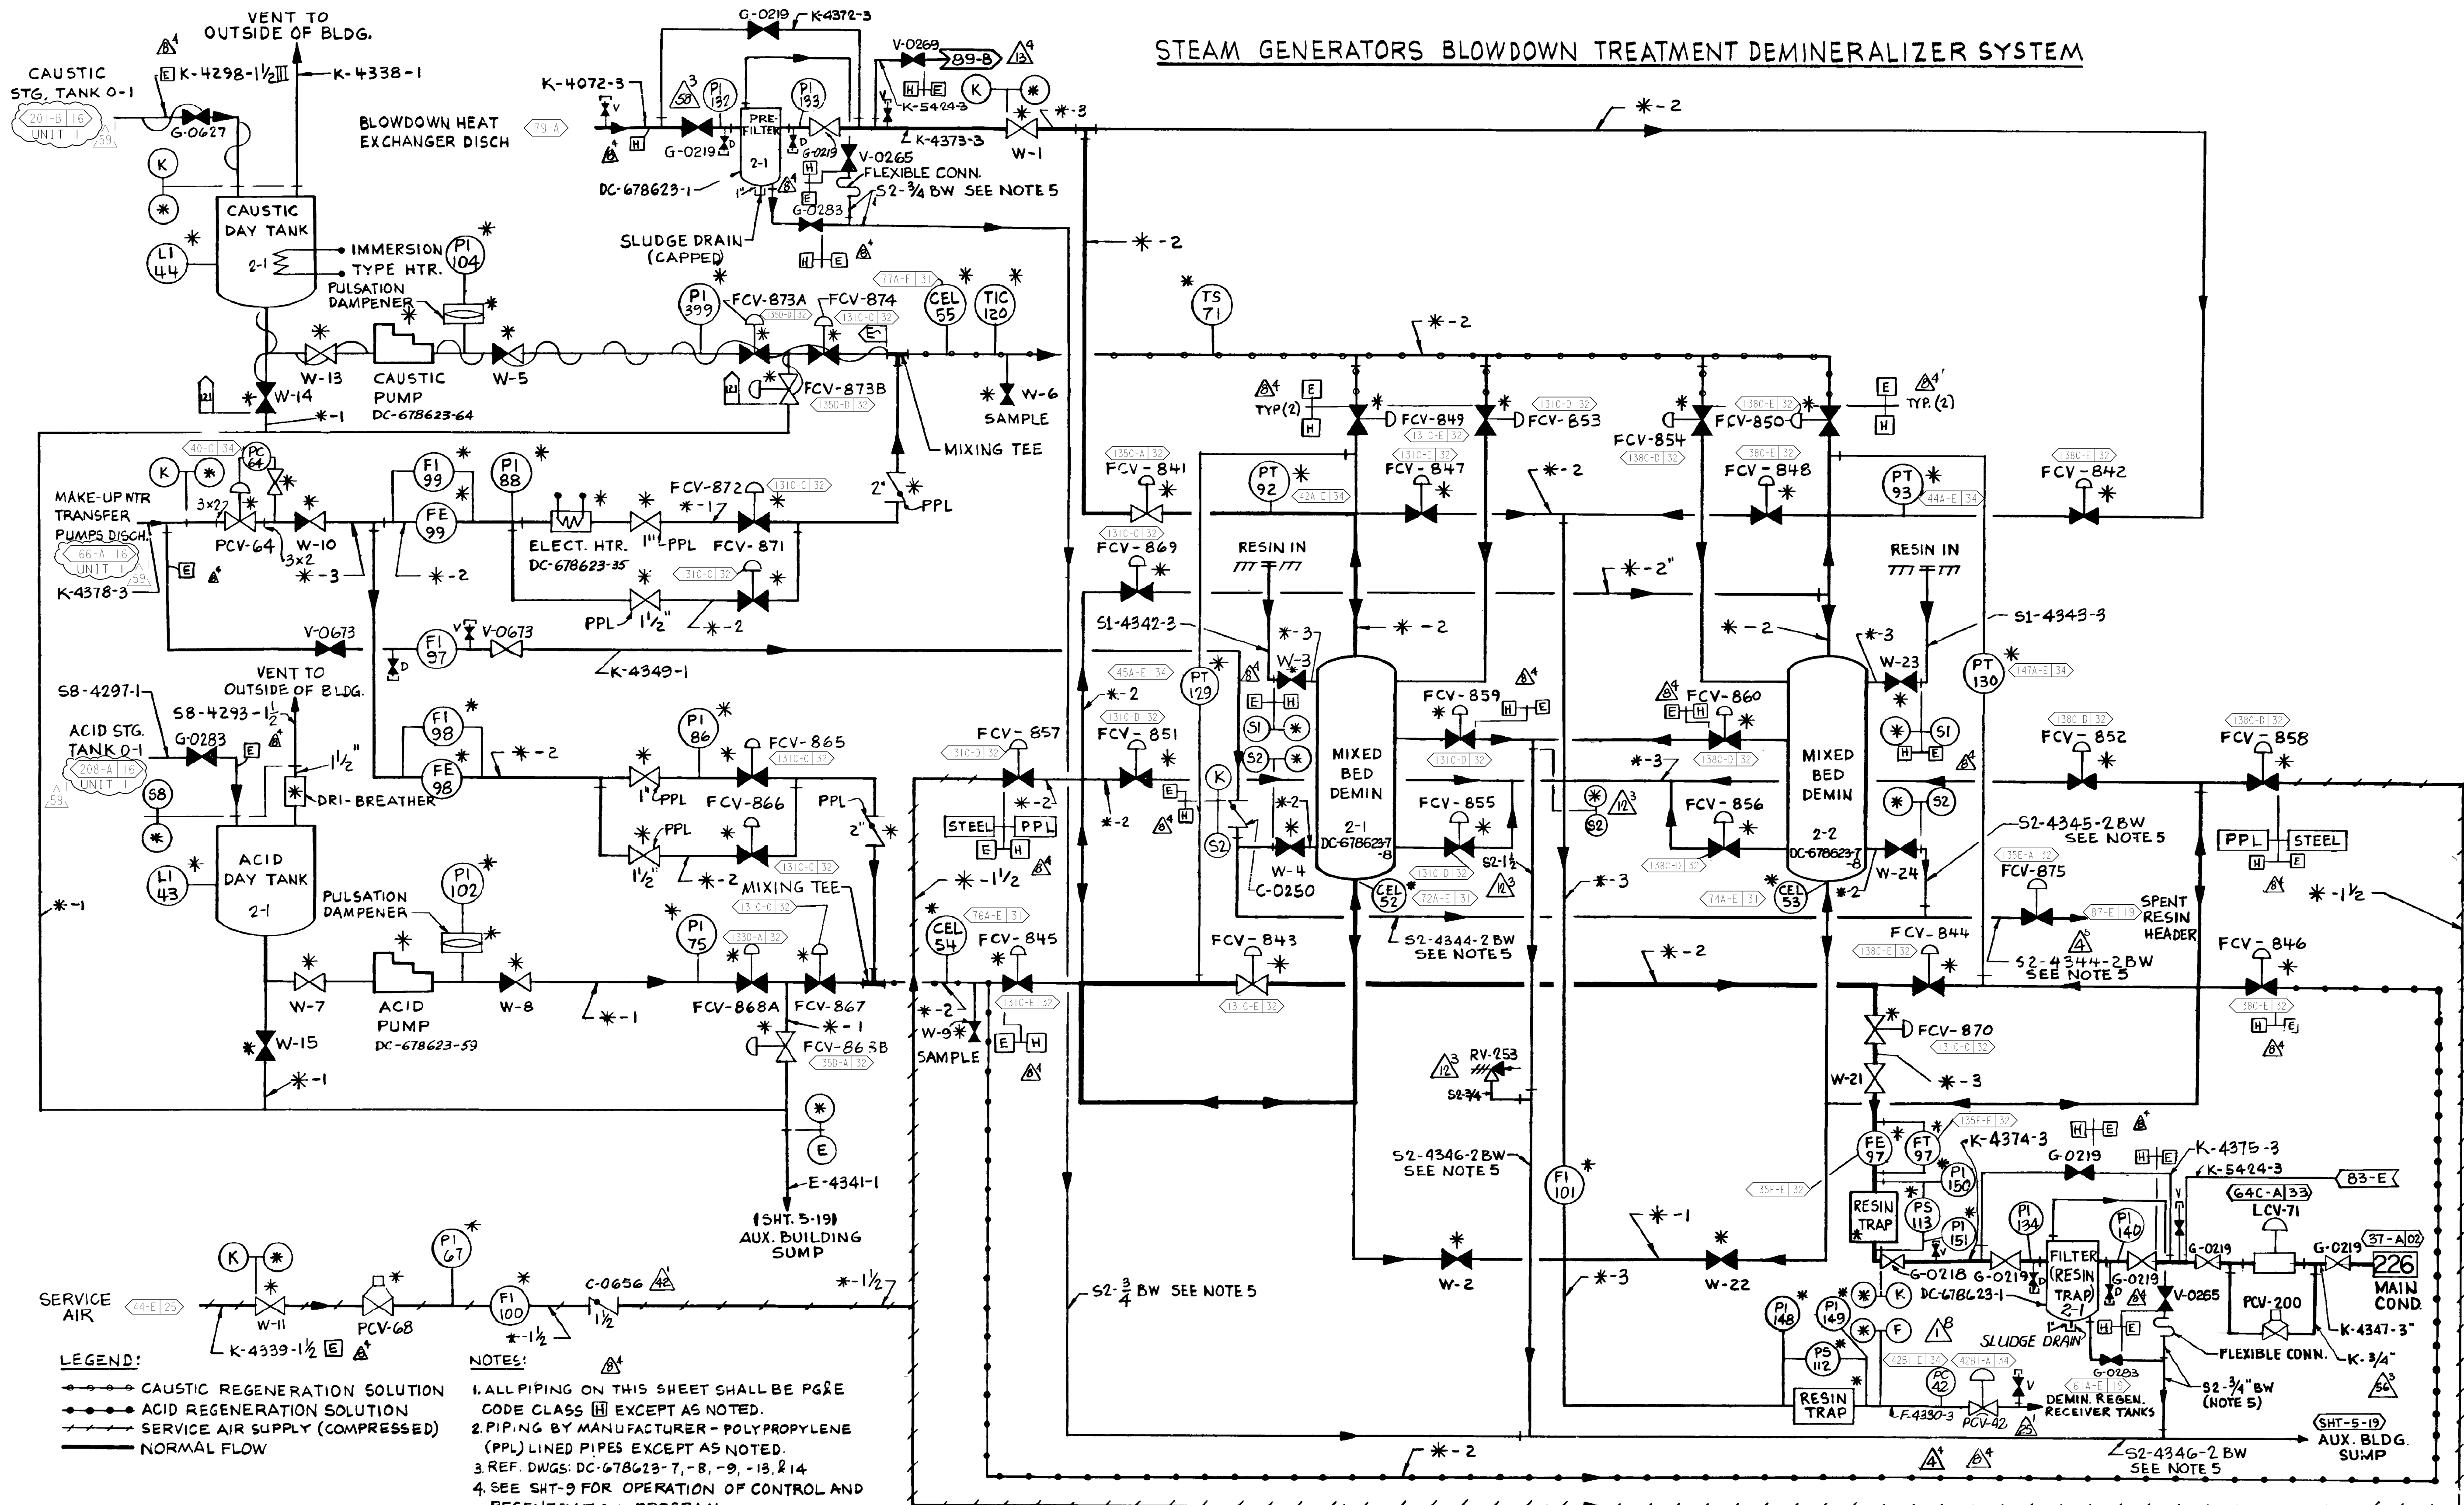

LEGEND:

- CAUSTIC REGENERATION SOLUTION
- ACID REGENERATION SOLUTION
- SERVICE AIR SUPPLY (COMPRESSED)
- NORMAL FLOW

NOTES:

- ALL PIPING ON THIS SHEET SHALL BE PG&E CODE CLASS [H] EXCEPT AS NOTED.
- PIPING BY MANUFACTURER - POLYPROPYLENE (PPL) LINED PIPES EXCEPT AS NOTED.
- REF. DWGS: DC-678623-7, -8, -9, -13, & 14.
- SEE SHT-9 FOR OPERATION OF CONTROL AND REGENERATION PROGRAM.
- B.W. DENOTES BUTTWELDED. LINES WITH THIS NOTE SHALL HAVE BUTTWELDED JOINTS TO AVOID ENTRAPMENT OF RESIN. (83E, 84B, 85B, 88A/B)

7. POST SEAL 02-1134 IS ON OF BUTTERFLY VALVE WITH 1M GEAR OPERATOR 487-A

UNIT 2

DIABLO CANYON POWER PLANT - PG&E CO.

DRAWING	SHEET	PAGE	REV
108004	8	0	59

OPERATION OF CONTROL AND REGENERATION PROGRAM FOR STEAM GENERATORS BLOWDOWN CLEAN-UP MIXED BED DEMINERALIZERS

					FLOW CONTROL VALVE (MIXED BED DEMINERALIZERS: 2-1&2-2)												FLOW CONTROL VALVE (ACID SOLUTION)										FLOW CONTROL VALVE (CAUSTIC SOLUTION)																																																																																																																																																																																																																																																																																																																																																																																																																																																																																																																																																																																																																																																																																																																																																																																																																																																																																																																																																																																																																																																																																																																																																																
STEP SWITCH NO.							A	B	E	F	C	D	G	H		I		K	L	M					N	O	P				J	Q	R	S	T																																																																																																																																																																																																																																																																																																																																																																																																																																																																																																																																																																																																																																																																																																																																																																																																																																																																																																																																																																																																																																																																																																																																																								
					FCV-841	FCV-842	FCV-843	FCV-844	FCV-845	FCV-846	FCV-847	FCV-848	FCV-849	FCV-850	FCV-851	FCV-852	FCV-853	FCV-854	FCV-855	FCV-856	FCV-857	FCV-858	FCV-859	FCV-860	FCV-869			FCV-870	FCV-865	FCV-866	FCV-867	FCV-868A	FCV-868B	-	FCV-871	FCV-872	FCV 873A	-	-	FCV-874	FCV 873B																																																																																																																																																																																																																																																																																																																																																																																																																																																																																																																																																																																																																																																																																																																																																																																																																																																																																																																																																																																																																																																																																																																																																		
STEP	FUNCTION AND DESCRIPTION	RATE (GPM)	SOURCE	TIME (MIN)	SERVICE		BACKWASH		RINSE		CAUSTIC INLET	INTER-FACE OUTLET	AIR INLET	VENT	SERIES		ISO-LATION	DI-LUTION WATER	BACK-WASH	SHUT-OFF		LEAK OFF	PUMP	DILUTION WATER		SHUT-OFF CAUSTIC	CAUSTIC TEMP CONTROL	PUMP	SHUT OFF WATER	LEAK OFF	REGEN COM- PLETE RESET	FINAL RINSE COND CHECK	TIMER RESET	REGEN COM- PLETE ALARM	REGEN RESET																																																																																																																																																																																																																																																																																																																																																																																																																																																																																																																																																																																																																																																																																																																																																																																																																																																																																																																																																																																																																																																																																																																																																								
					INLET	OUTLET	ACID INLET	OUTLET	INLET	OUTLET										WATER	ACID			COLD	HOT																																																																																																																																																																																																																																																																																																																																																																																																																																																																																																																																																																																																																																																																																																																																																																																																																																																																																																																																																																																																																																																																																																																																																																		
1	LAG			0.5																		○																																																																																																																																																																																																																																																																																																																																																																																																																																																																																																																																																																																																																																																																																																																																																																																																																																																																																																																																																																																																																																																																																																																																																																					</

LEGEND: ○ VALVE OPEN (PIN INSERTED)
● VALVE CLOSED
R PUMP RUNNING

RI REGENERANT INLET WATER
SI SERVICE INLET
⊗ PIN INSERTED

H₂SO₄ - 98% ACID
NaOH - 50% CAUSTIC

UNIT - 2

P.G. & E. CO.

DRAWING NUMBER

REVISION

SHEET 9 OF SHEETS

108004


MICROFILM

RM INDEXED REV. 1

APPD. IBC

S-1

THIS DRAWING HAS BEEN REPRODUCED
WITHOUT CHANGE FROM ORIGINAL DRAWING
DATE 2-2-80 APPROVED BY 15

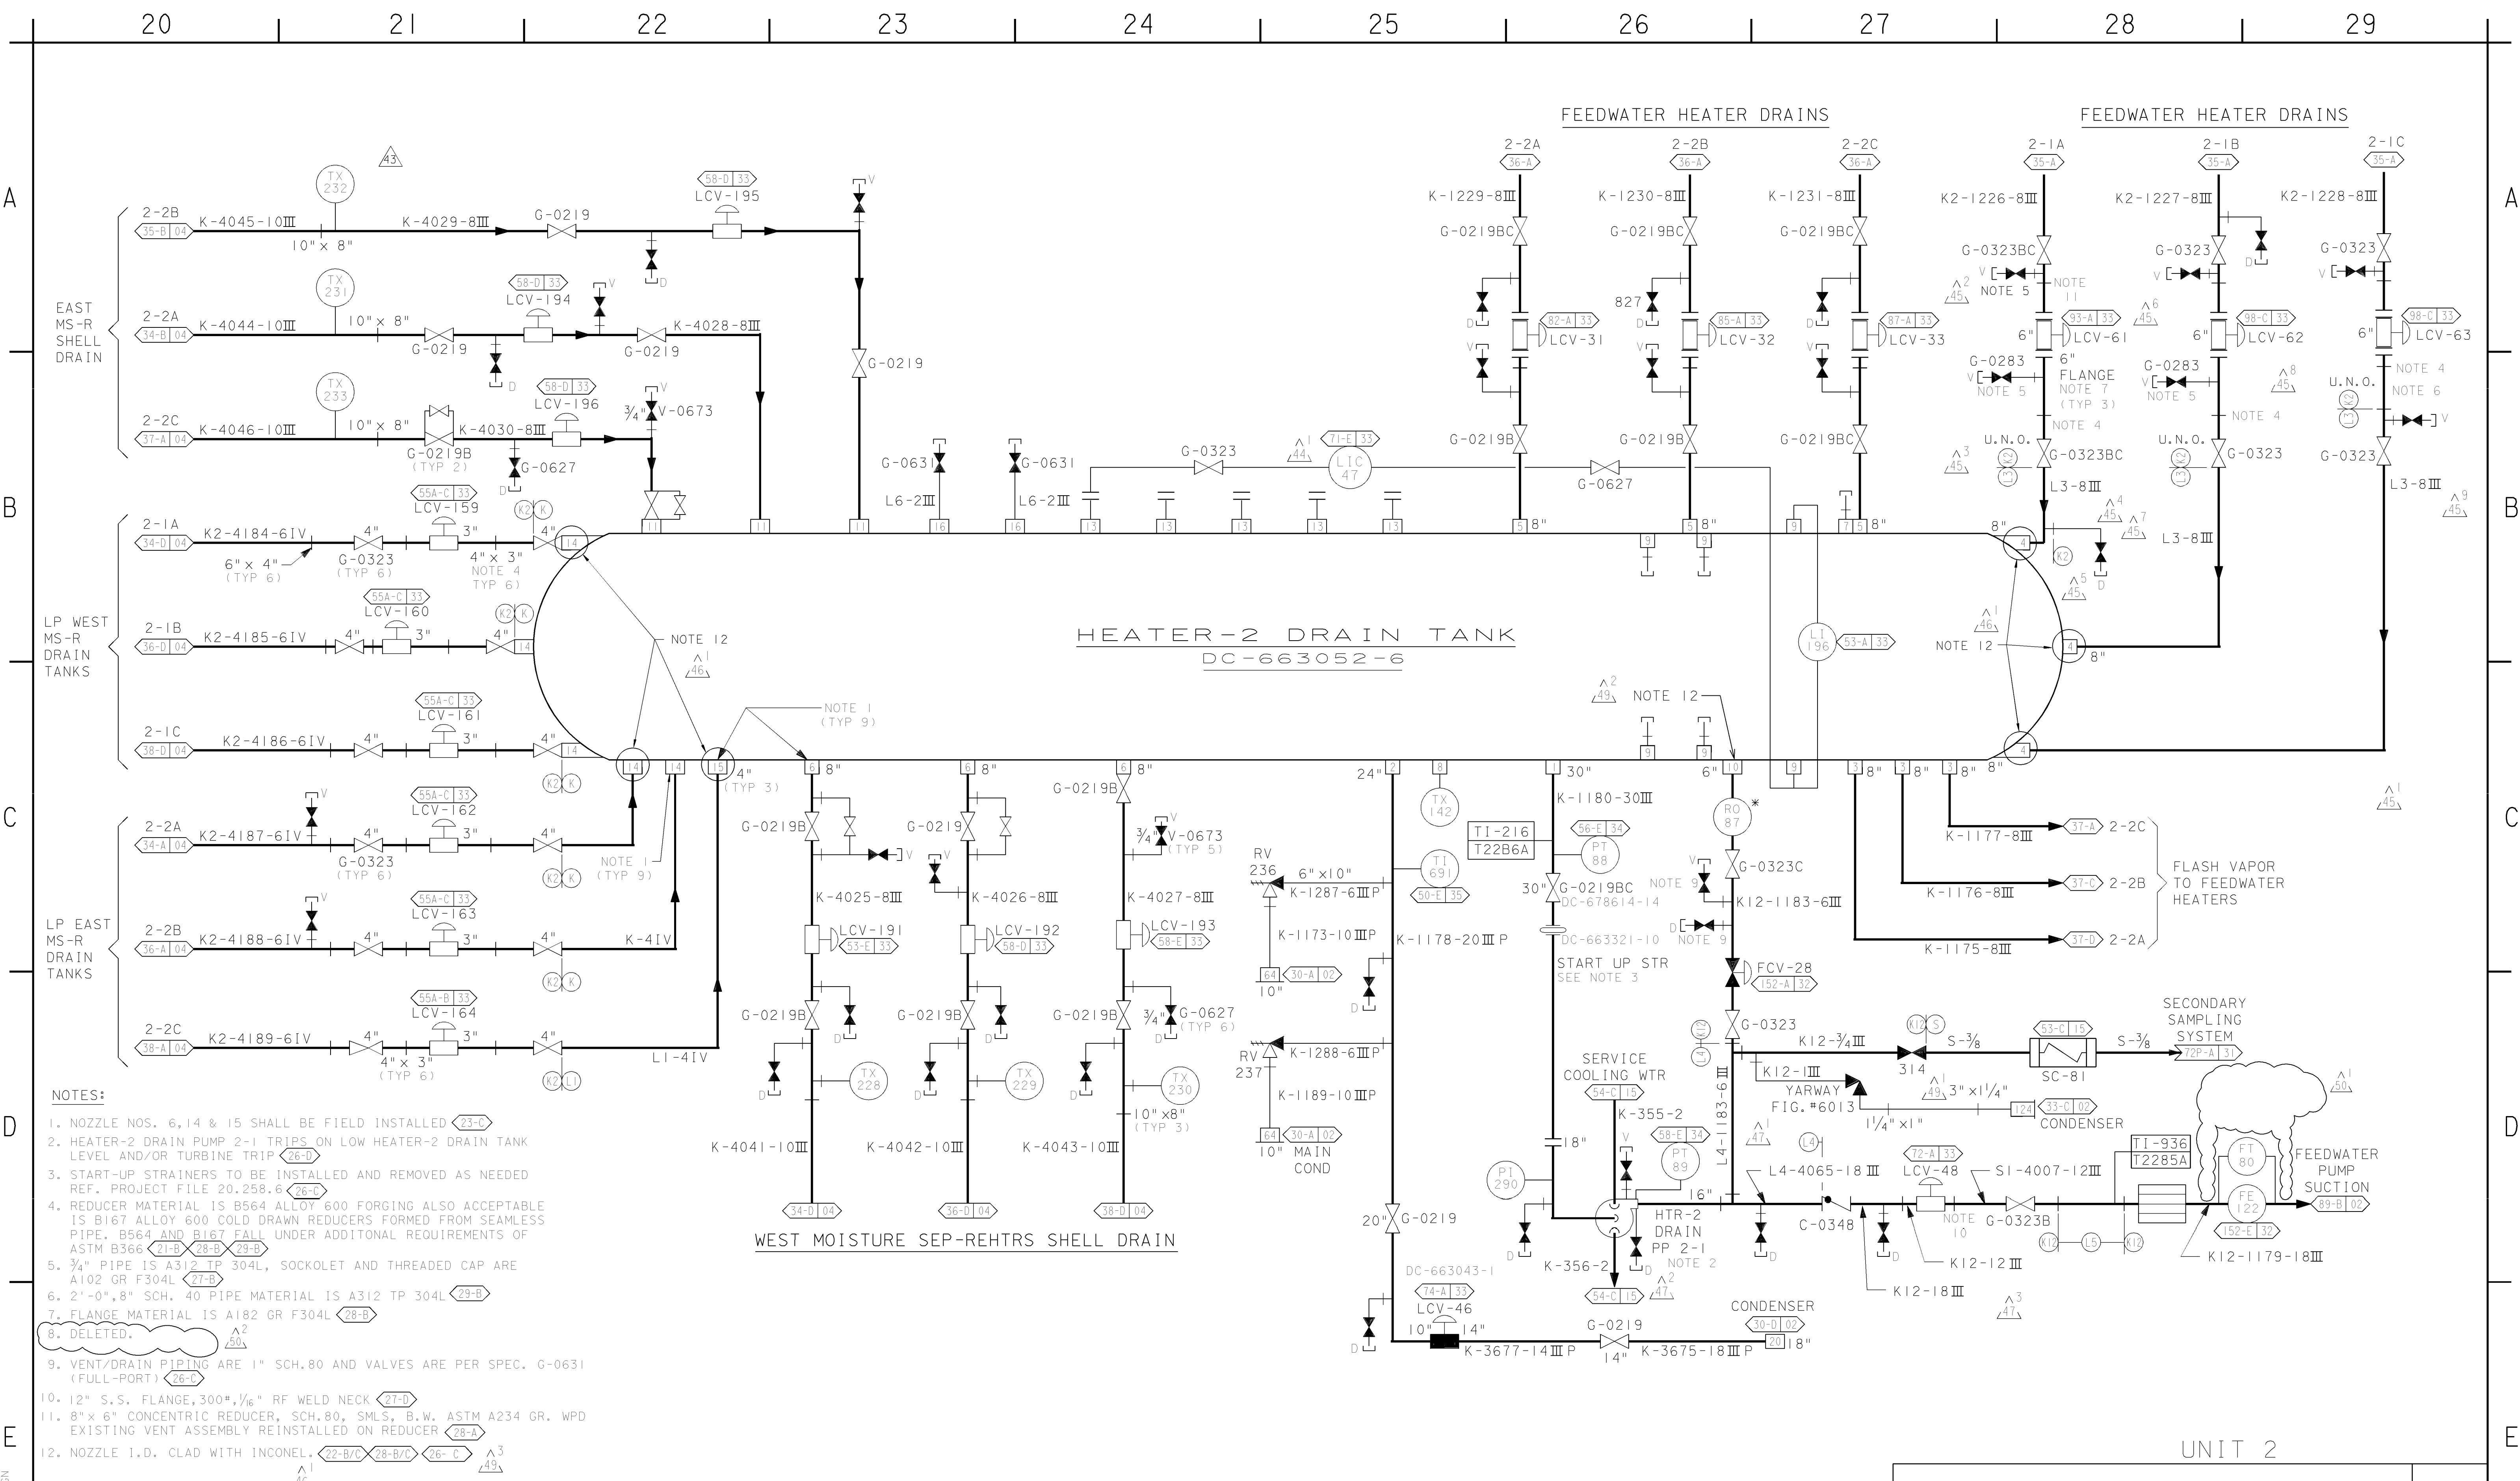

A

B

C

D

E

A

B

C

D

E

NOTES:


1. NOZZLE NOS. 6, 14 & 15 SHALL BE FIELD INSTALLED (23-C)
2. HEATER-2 DRAIN PUMP 2-1 TRIPS ON LOW HEATER-2 DRAIN TANK LEVEL AND/OR TURBINE TRIP (26-D)
3. START-UP STRAINERS TO BE INSTALLED AND REMOVED AS NEEDED REF. PROJECT FILE 20.258.6 (26-C)
4. REDUCER MATERIAL IS B564 ALLOY 600 FORGING ALSO ACCEPTABLE IS B167 ALLOY 600 COLD DRAWN REDUCERS FORMED FROM SEAMLESS PIPE. B564 AND B167 FALL UNDER ADDITIONAL REQUIREMENTS OF ASTM B366 (21-B, 28-B, 29-B)
5. 3/4" PIPE IS A312 TP 304L, SOCKLET AND THREADED CAP ARE A102 GR F304L (27-B)
6. 2'-0", 8" SCH. 40 PIPE MATERIAL IS A312 TP 304L (29-B)
7. FLANGE MATERIAL IS A182 GR F304L (28-B)
8. DELETED. (50-A)
9. VENT/DRAIN PIPING ARE 1" SCH.80 AND VALVES ARE PER SPEC. G-0631 (FULL-PORT) (26-C)
10. 12" S.S. FLANGE, 300#, 1/16" RF WELD NECK (27-D)
11. 8" x 6" CONCENTRIC REDUCER, SCH.80, SMLS, B.W. ASTM A234 GR. WPD EXISTING VENT ASSEMBLY REINSTALLED ON REDUCER (28-A)
12. NOZZLE I.D. CLAD WITH INCONEL. (22-B/C, 28-B/C, 26-C) (49-A)


MOISTURE SEPARATOR-REHEATER AND FEEDWATER HEATER DRAINS


UNIT 2

P G & E CO.		108005	REV. 50
SHEET 2	PAGE 0		

12/23/04	RHS1	BLFI	-	KERSI J. DALAL	MECHANICAL	M 16690	3/31/2006	Revised per FCT 026778
DATE	DWN	RE	IV	PROFESSIONAL ENGINEER	PE DISC.	PE#	PE EXP.	

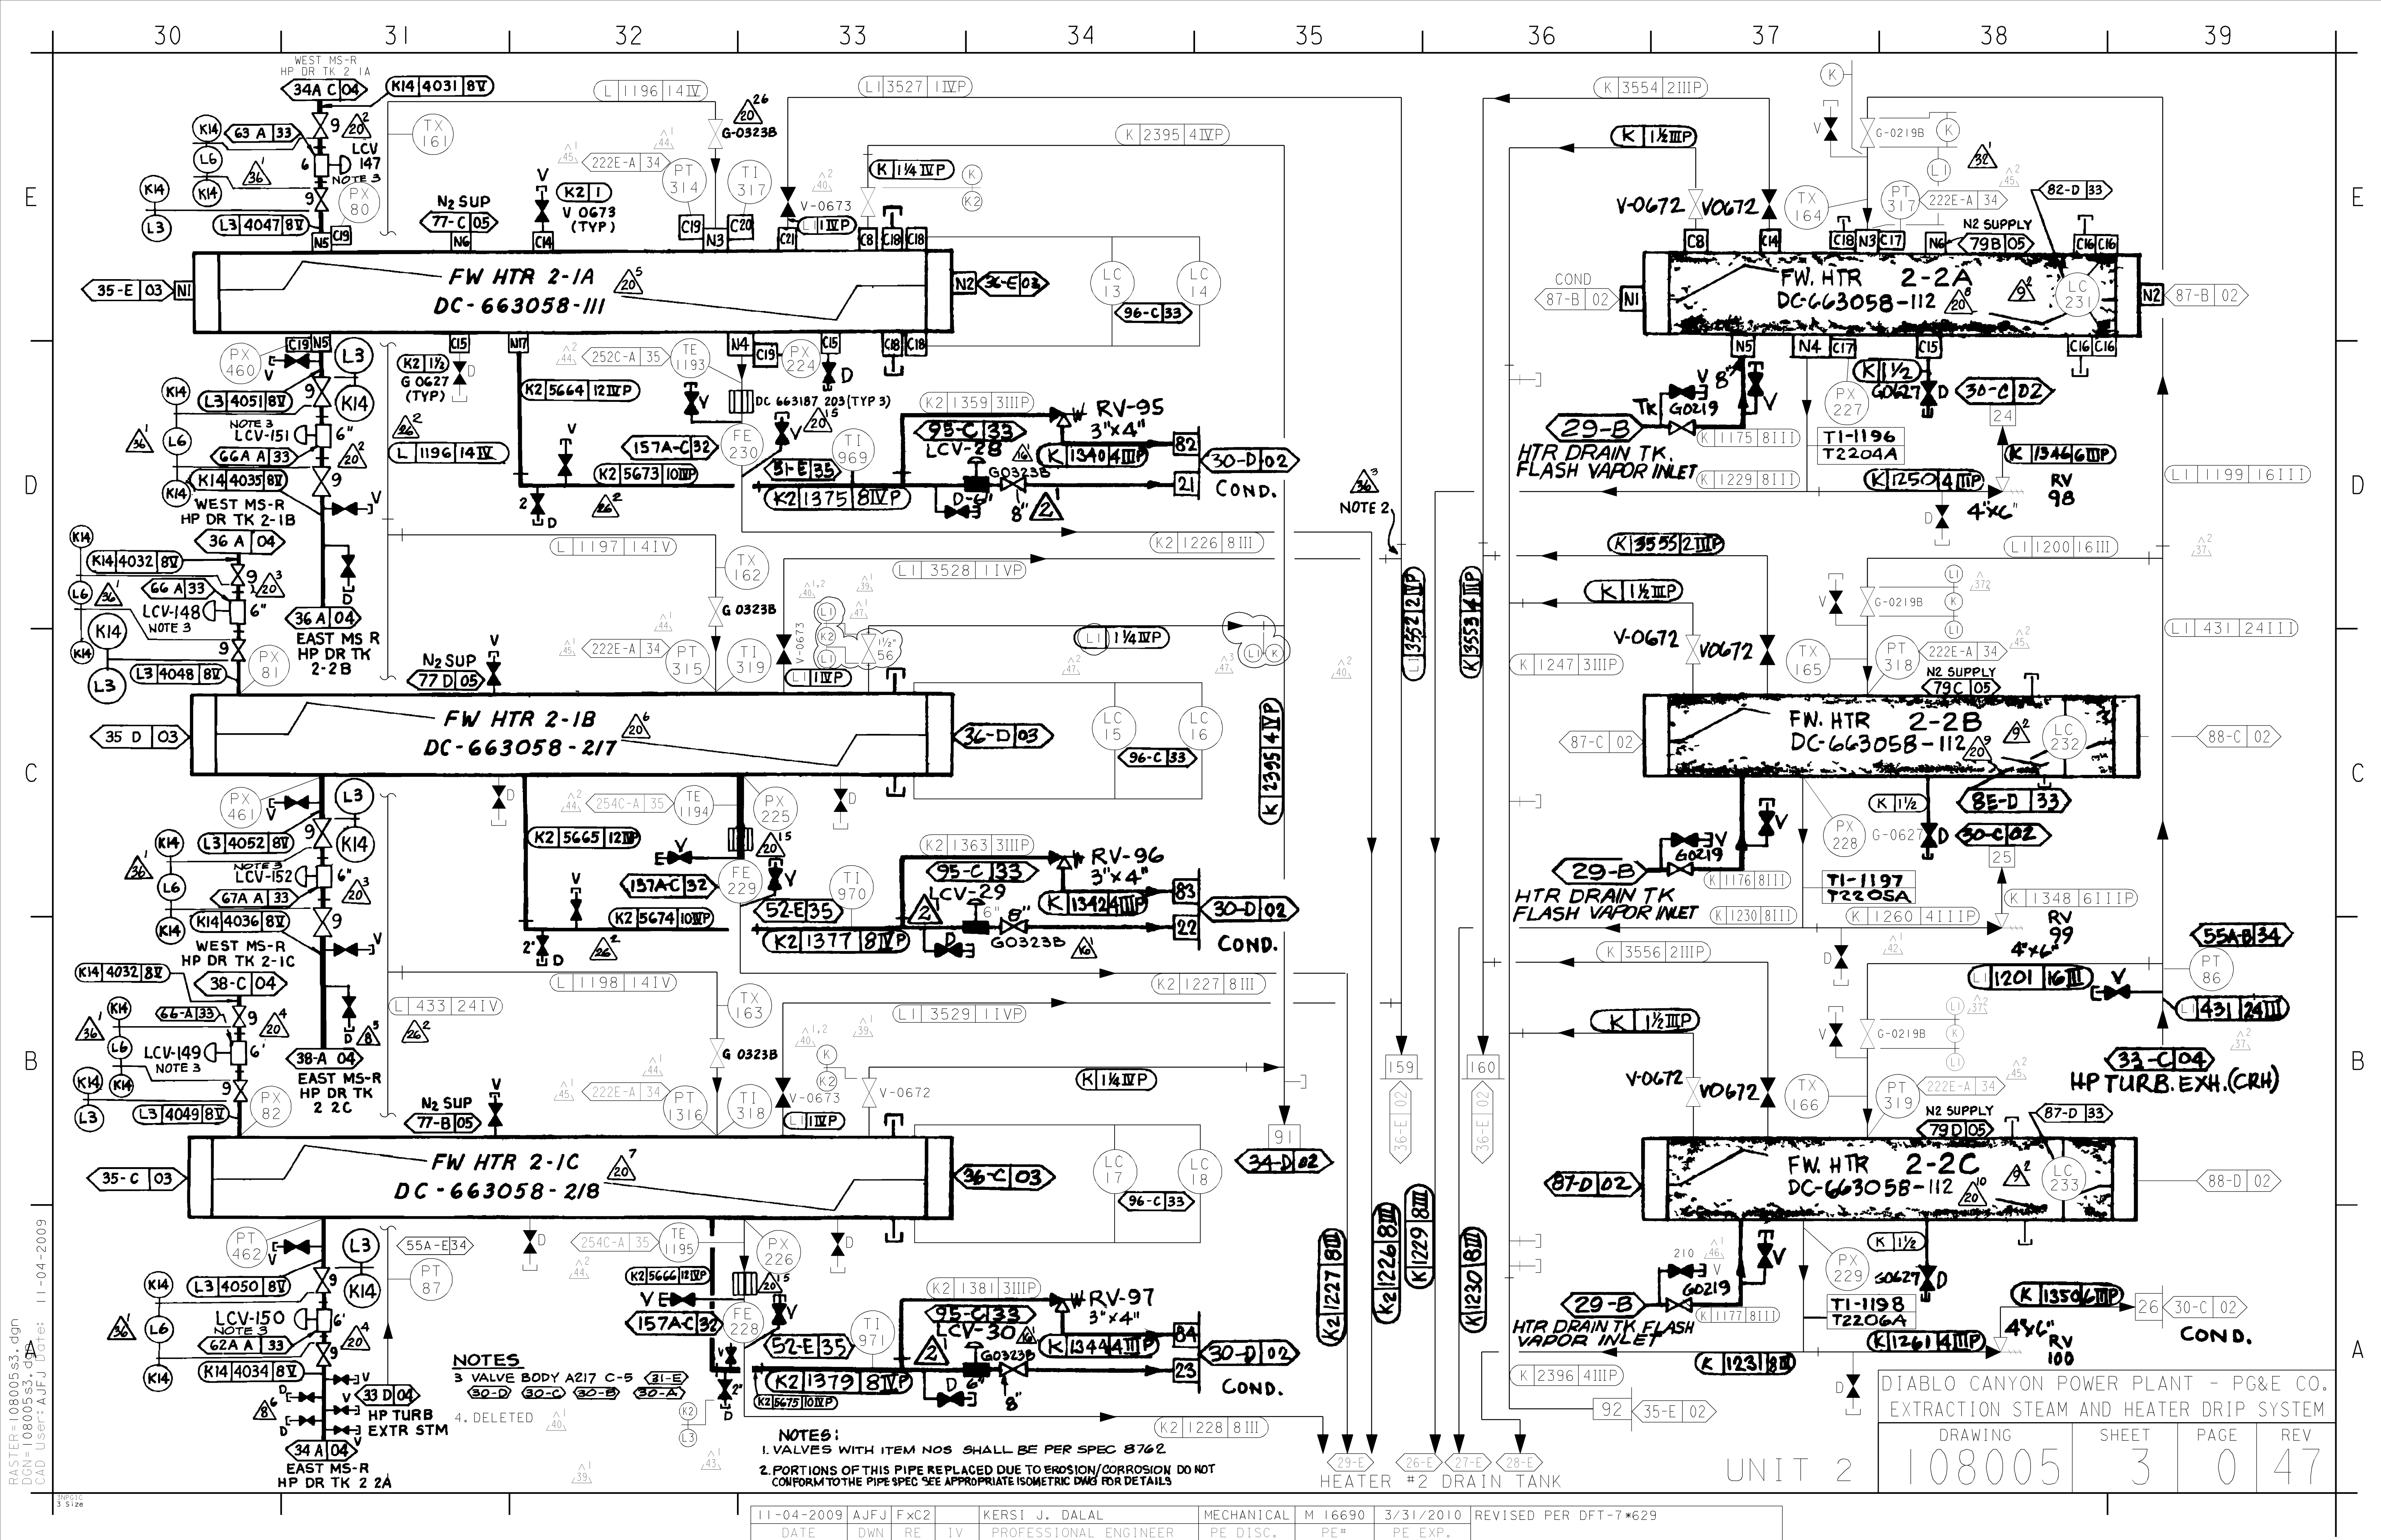

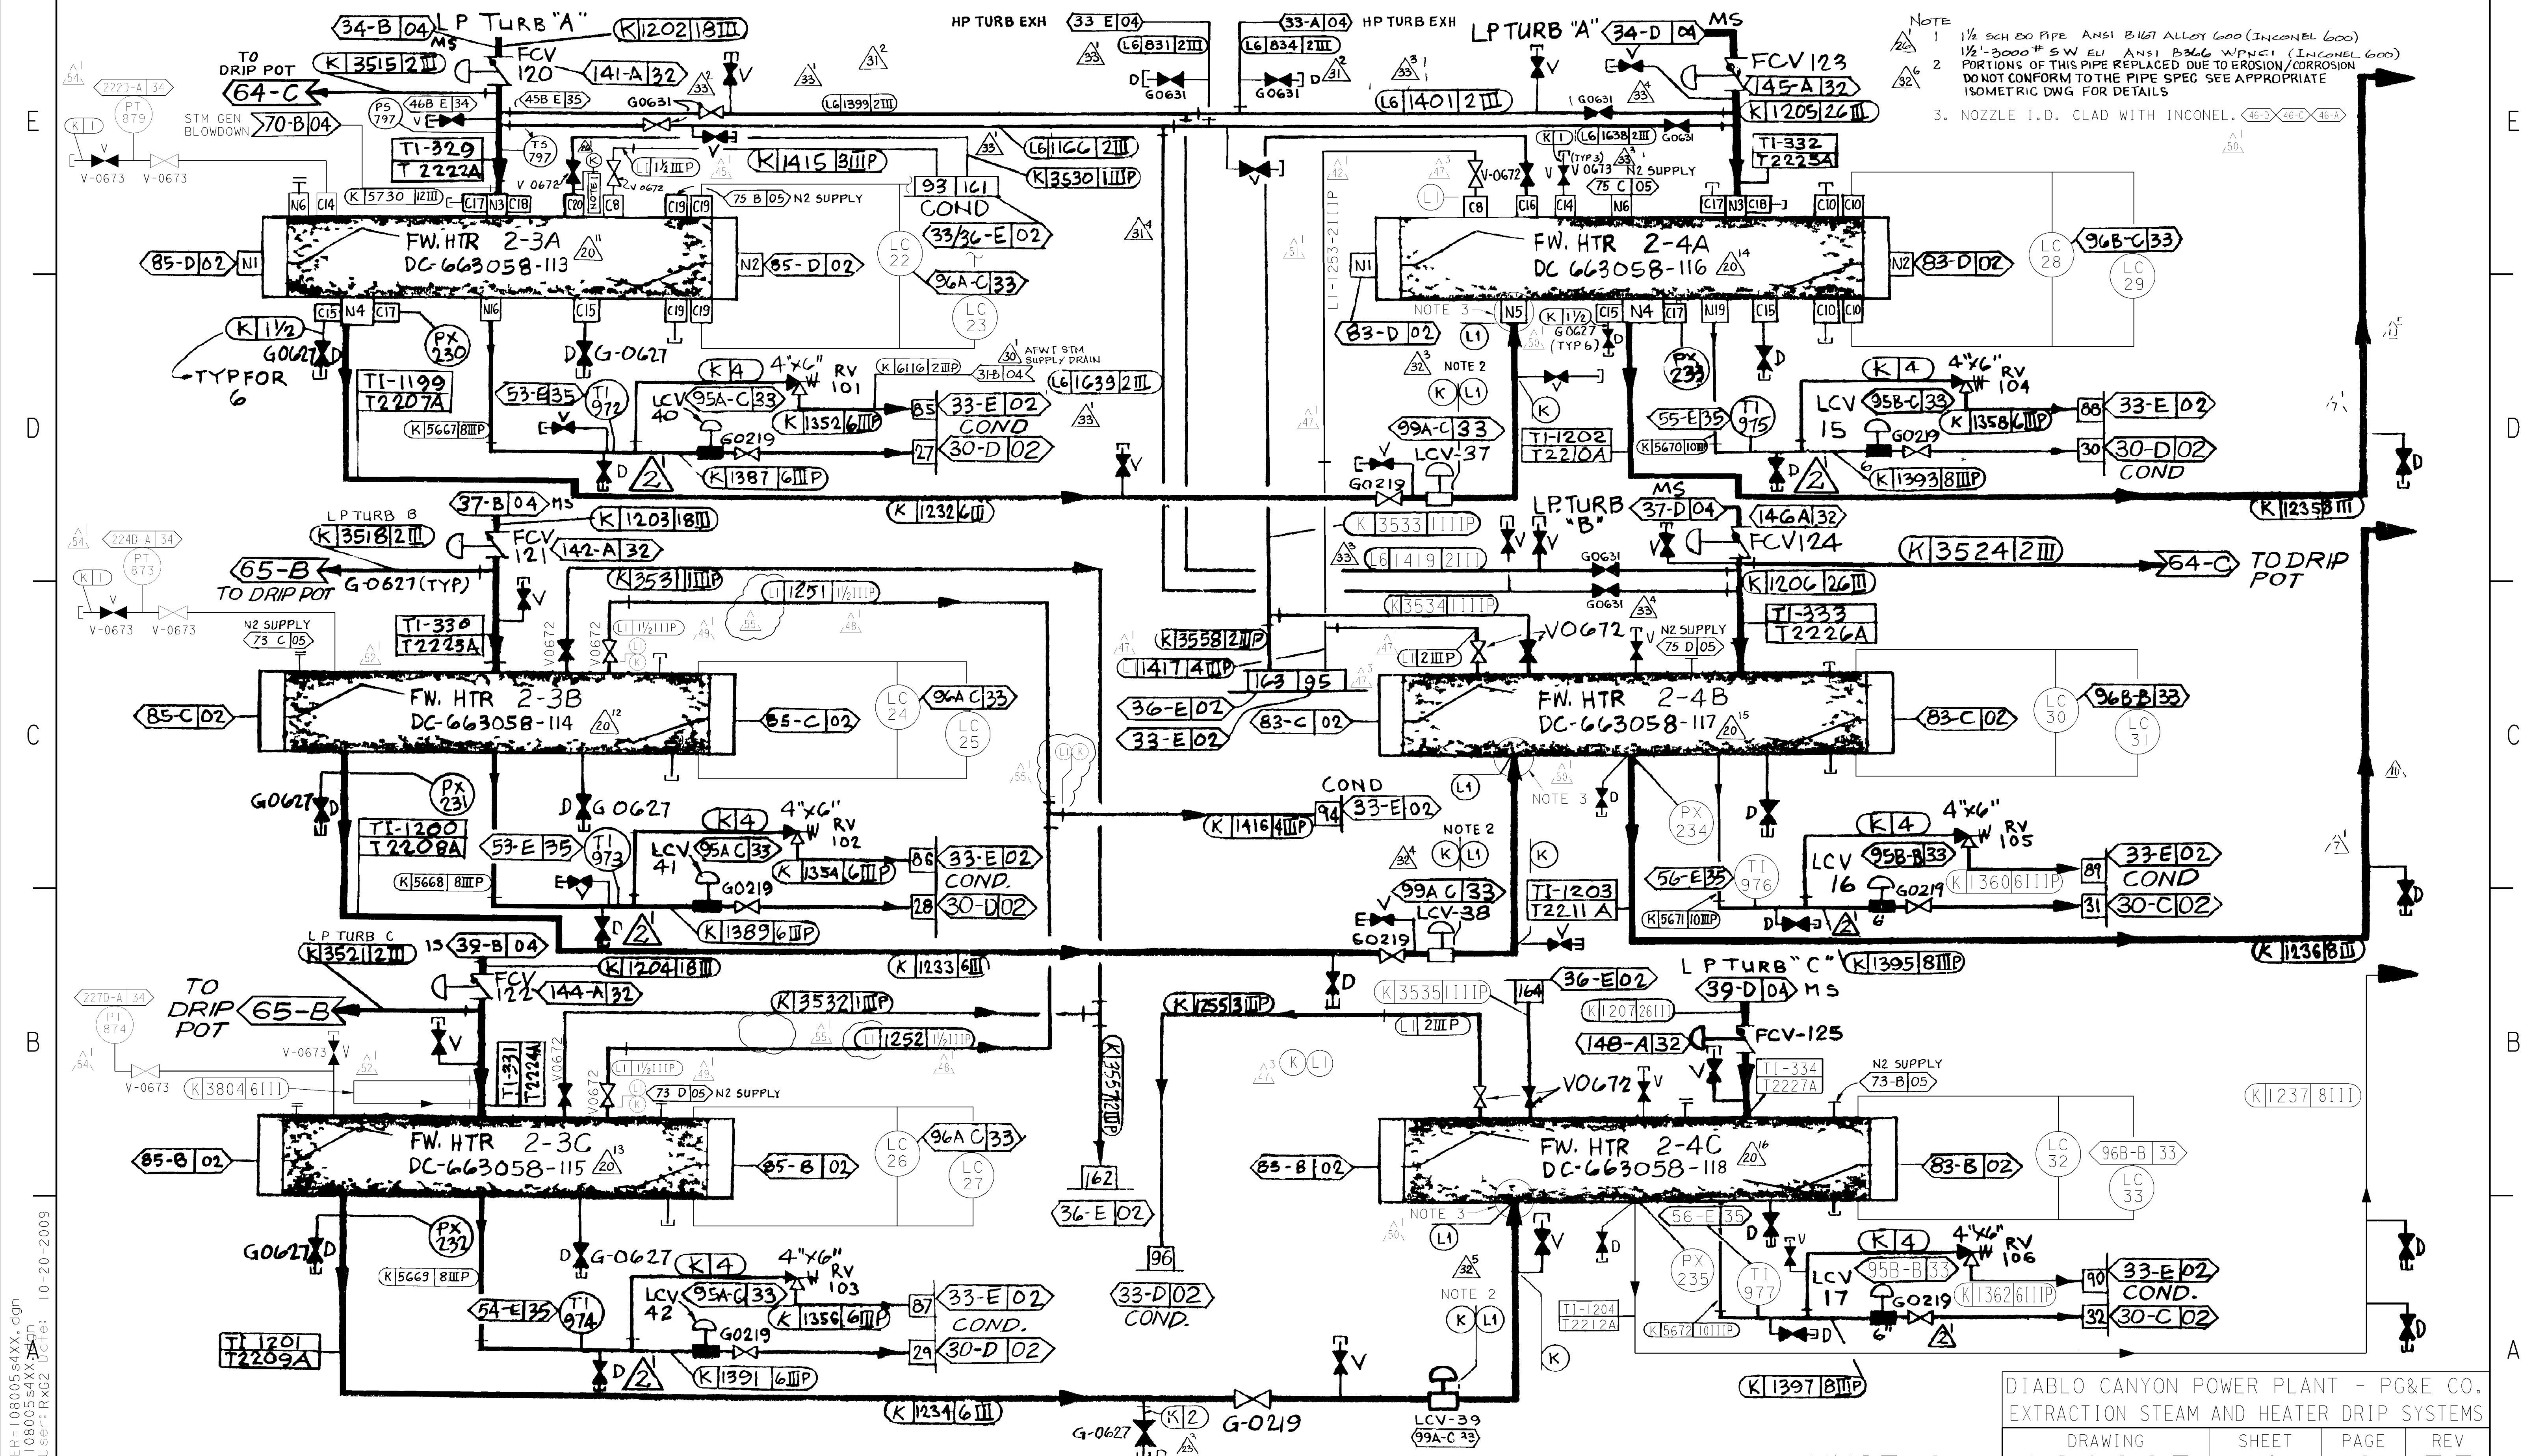

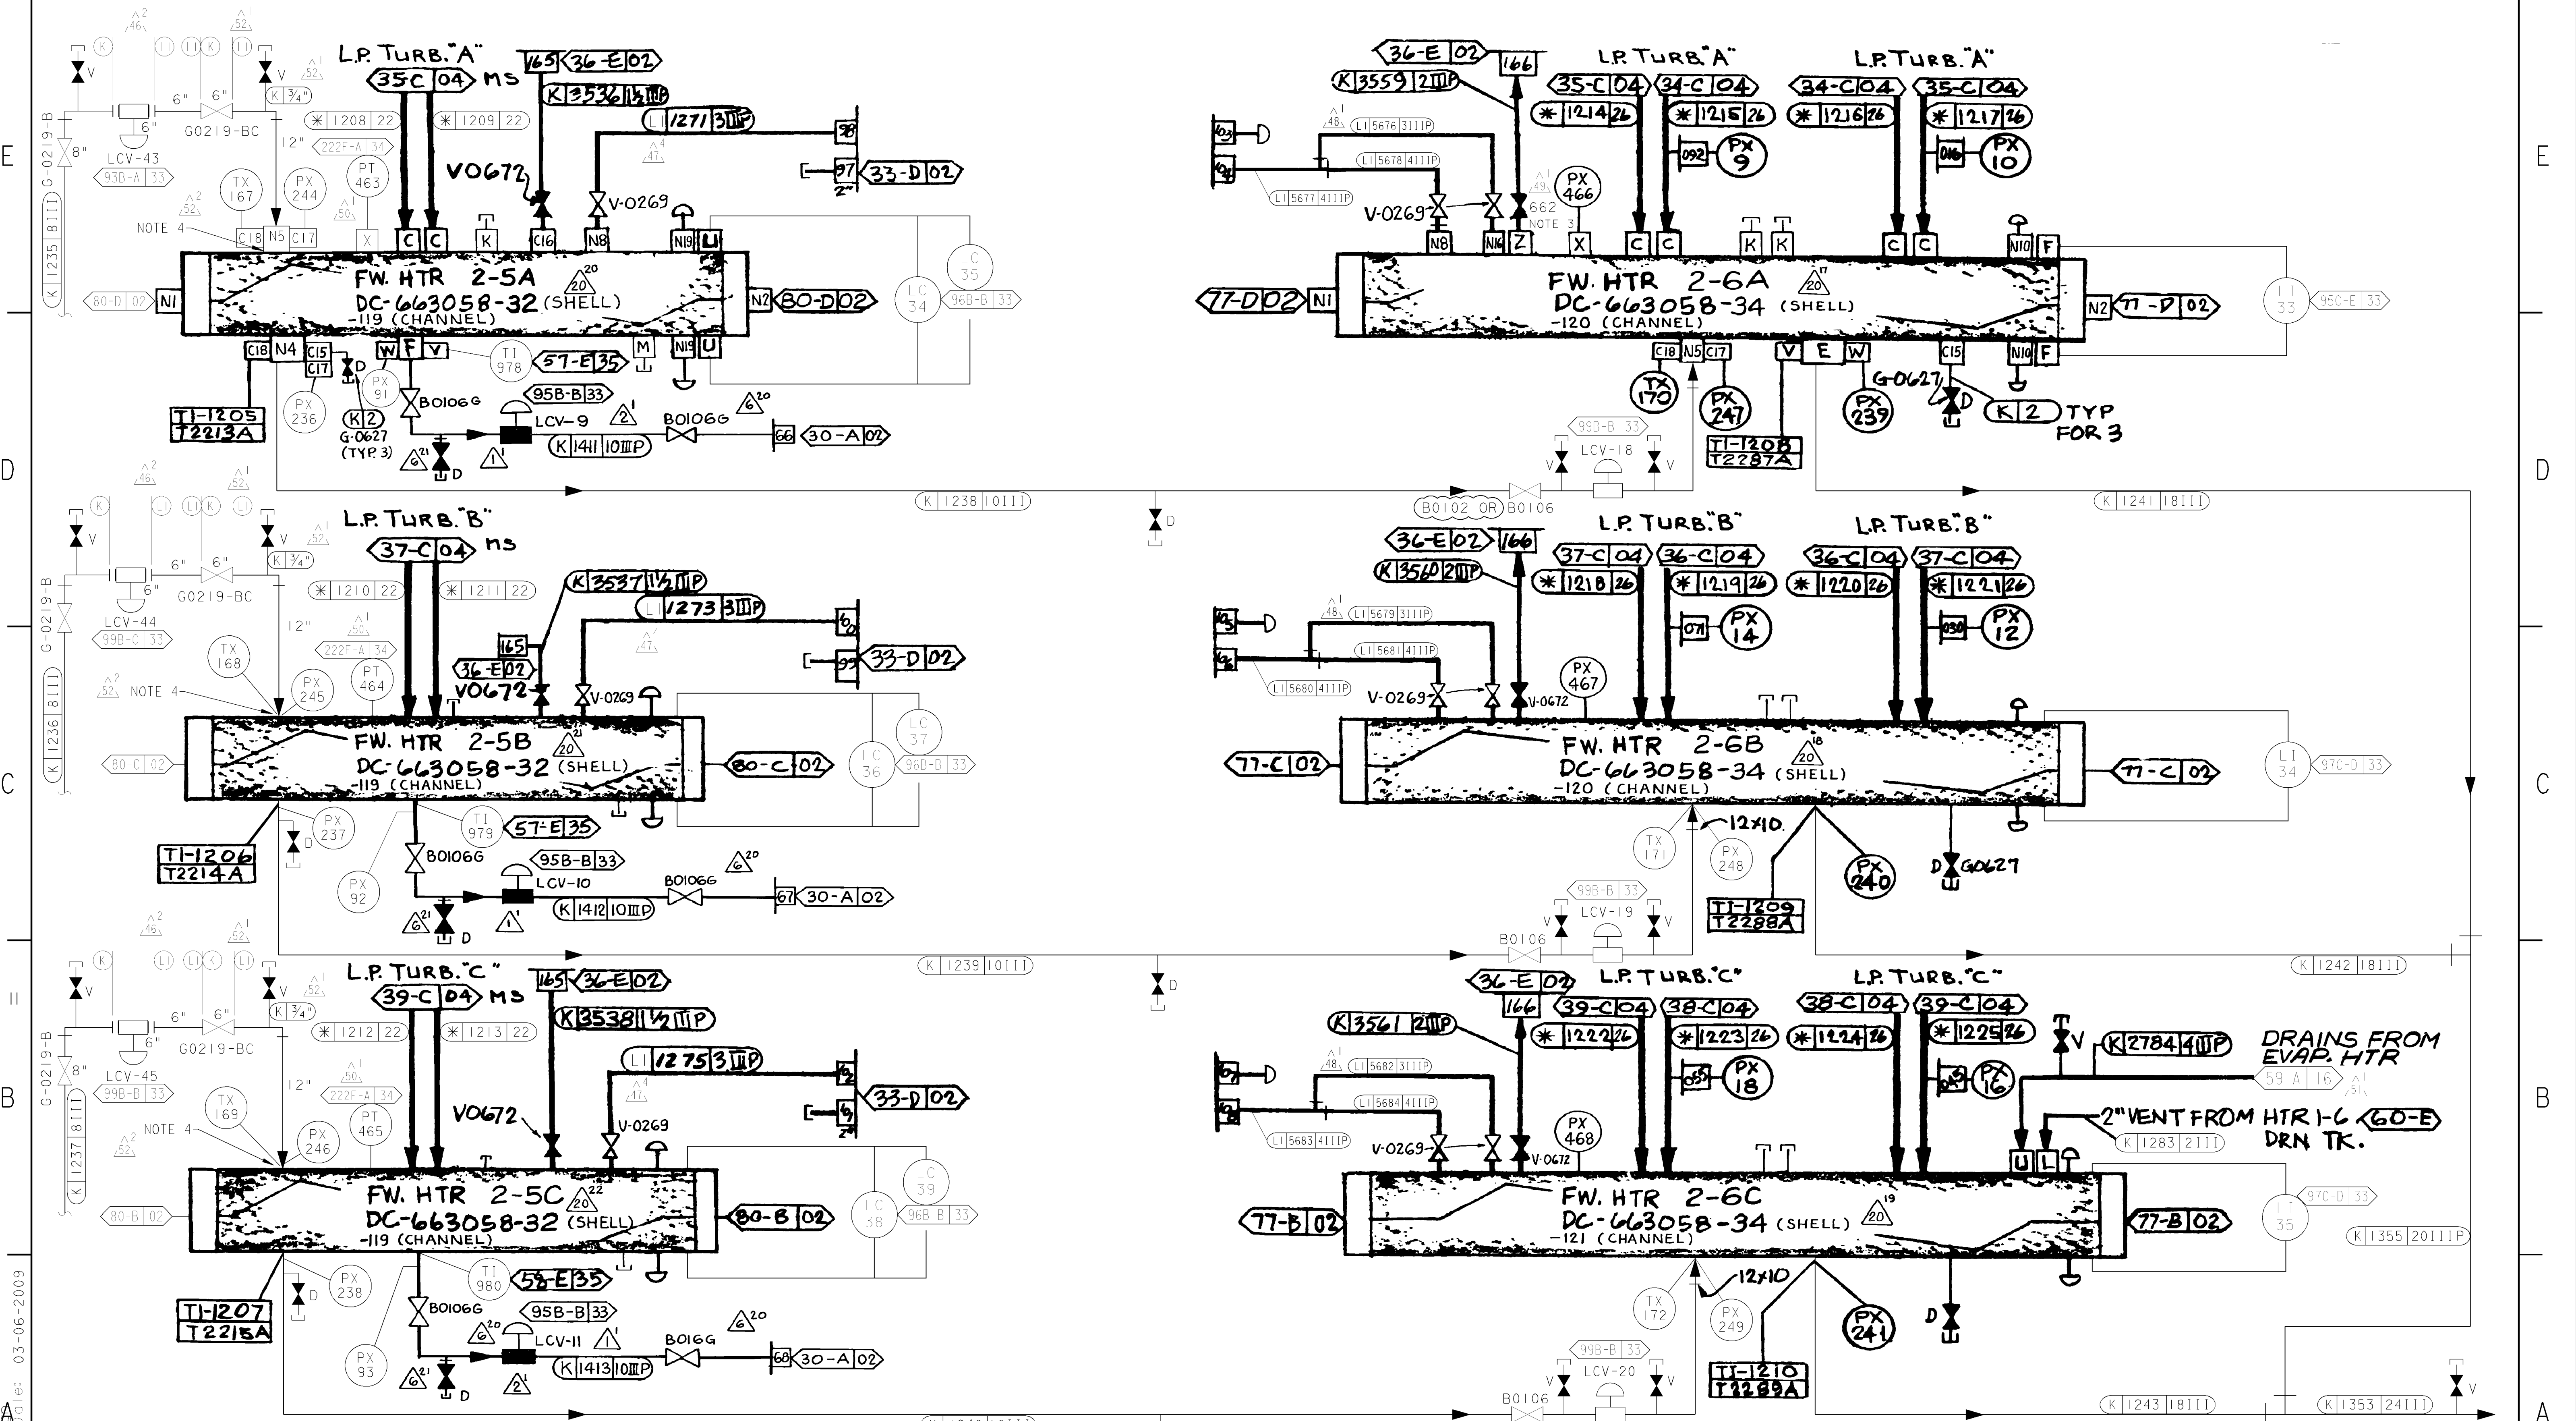


NOTE:
1. HTRS 5 & 6 ARE LOCATED IN CONDENSER NECK.
2. * INDICATES PIPING BY IR (INGERSOLL RAND) UNDER SPEC. 8701.
3. FIRST LENGTH OF PIPE AND ELBOW DOWNSTREAM OF XS-2-662 IS PIPE SPEC LI.(REF. C0182595)
4. FAC - RESISTANT CLADDING ALLIED INSIDE NOZZLE N5 REF. ATMM AR# A0638404. (50-B) (50-D) (50-E)

DIABLO CANYON POWER PLANT - PG&E CO.
EXTRACTION STEAM AND HEATER DRIP SYSTEMS

DRAWING	SHEET	PAGE	REV
108005	5	0	53

UNIT 2

THIS DRAWING HAS BEEN REPRODUCED
WITHOUT CHANGE FROM ORIGINAL DRAWING
CHANGE NO. DATE 8/25/80 APPROVED PL-5

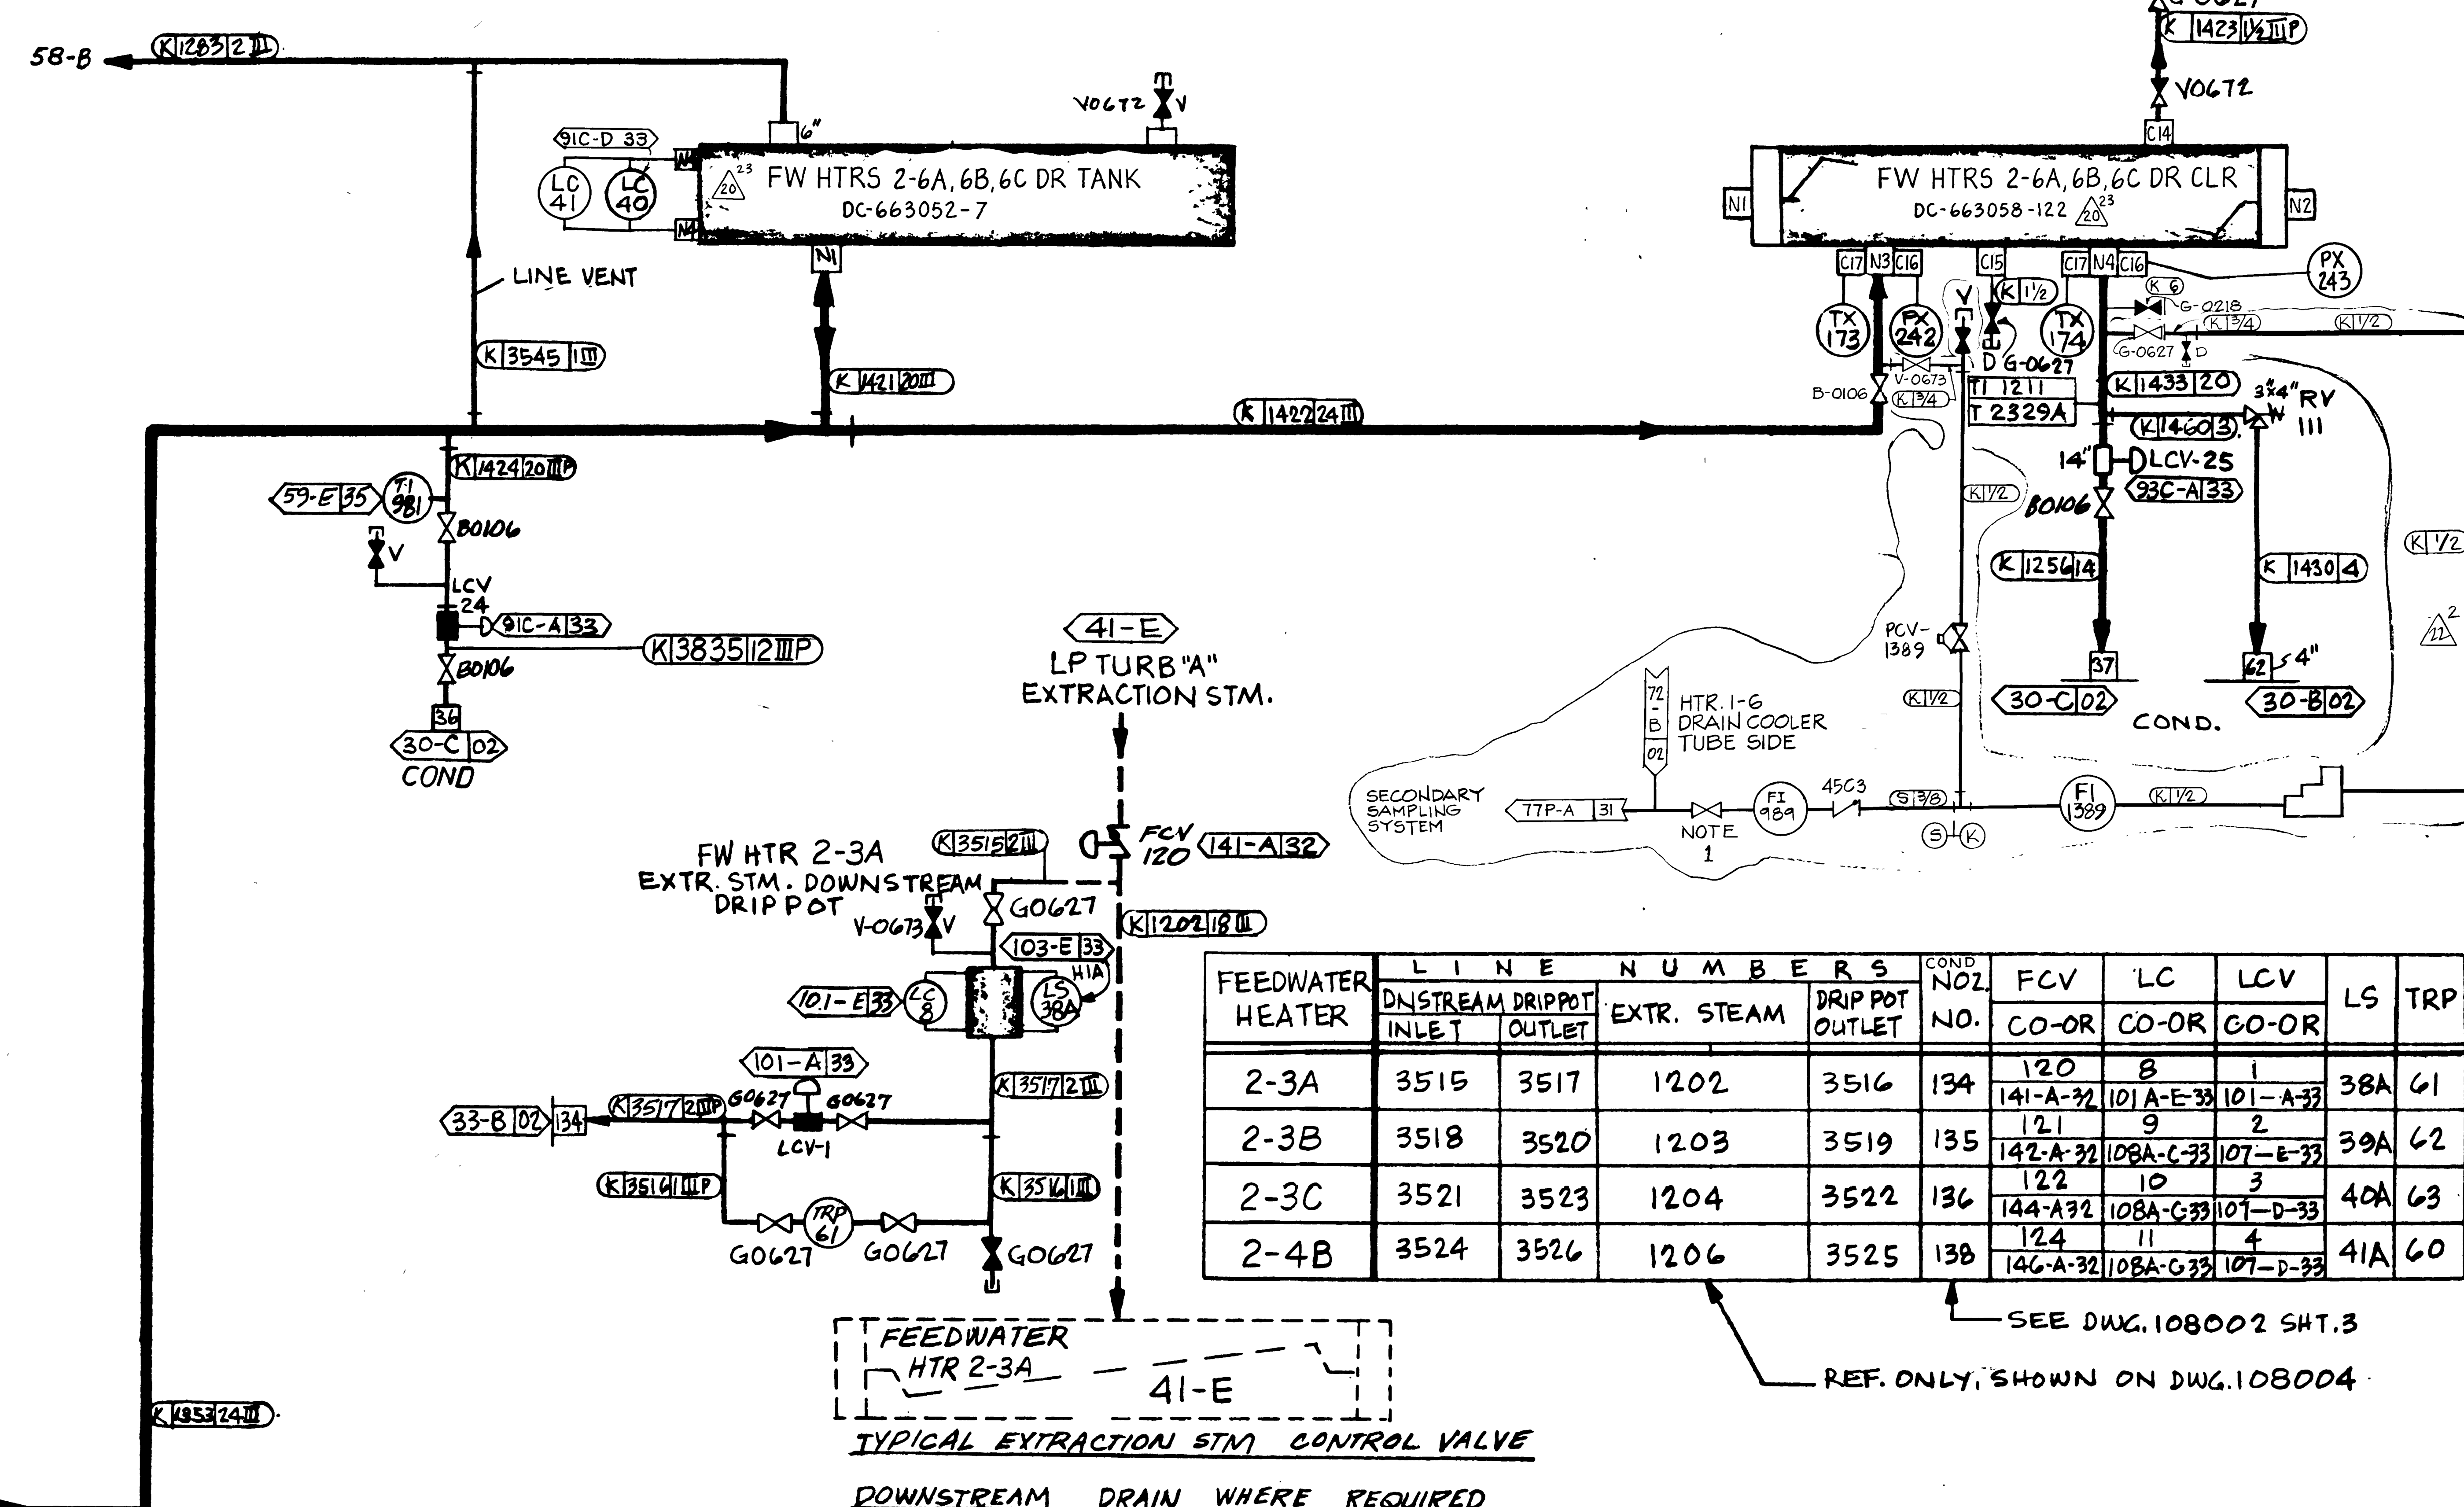


FEEDWATER HEATER	LINE NUMBERS				COND NOZ. NO.	FCV CO-OR	LC CO-OR	LCV GO-OR	LS	TRP
	DNSTREAM INLET	DRIPPOT OUTLET	EXTR. STEAM	DRIPPOT OUTLET						
2-3A	3515	3517	1202	3516	134	120	B	1	38A	61
2-3B	3518	3520	1203	3519	135	121	9	2	39A	62
2-3C	3521	3523	1204	3522	136	122	10	3	40A	63
2-4B	3524	3526	1206	3525	138	124	11	4	41A	60

FEEDWATER
HTR 2-3A
41-E
TYPICAL EXTRACTION STM CONTROL VALVE
DOWNSTREAM DRAIN WHERE REQUIRED

SEE DWG. 108002 SHT. 3
REF. ONLY, SHOWN ON DWG. 108004

NOTES:
1. 3/8" SS REGULATING VALVE, WHITEY, SWAGELOK
END CONNS., CAT NO. 1RS6 (66-C)

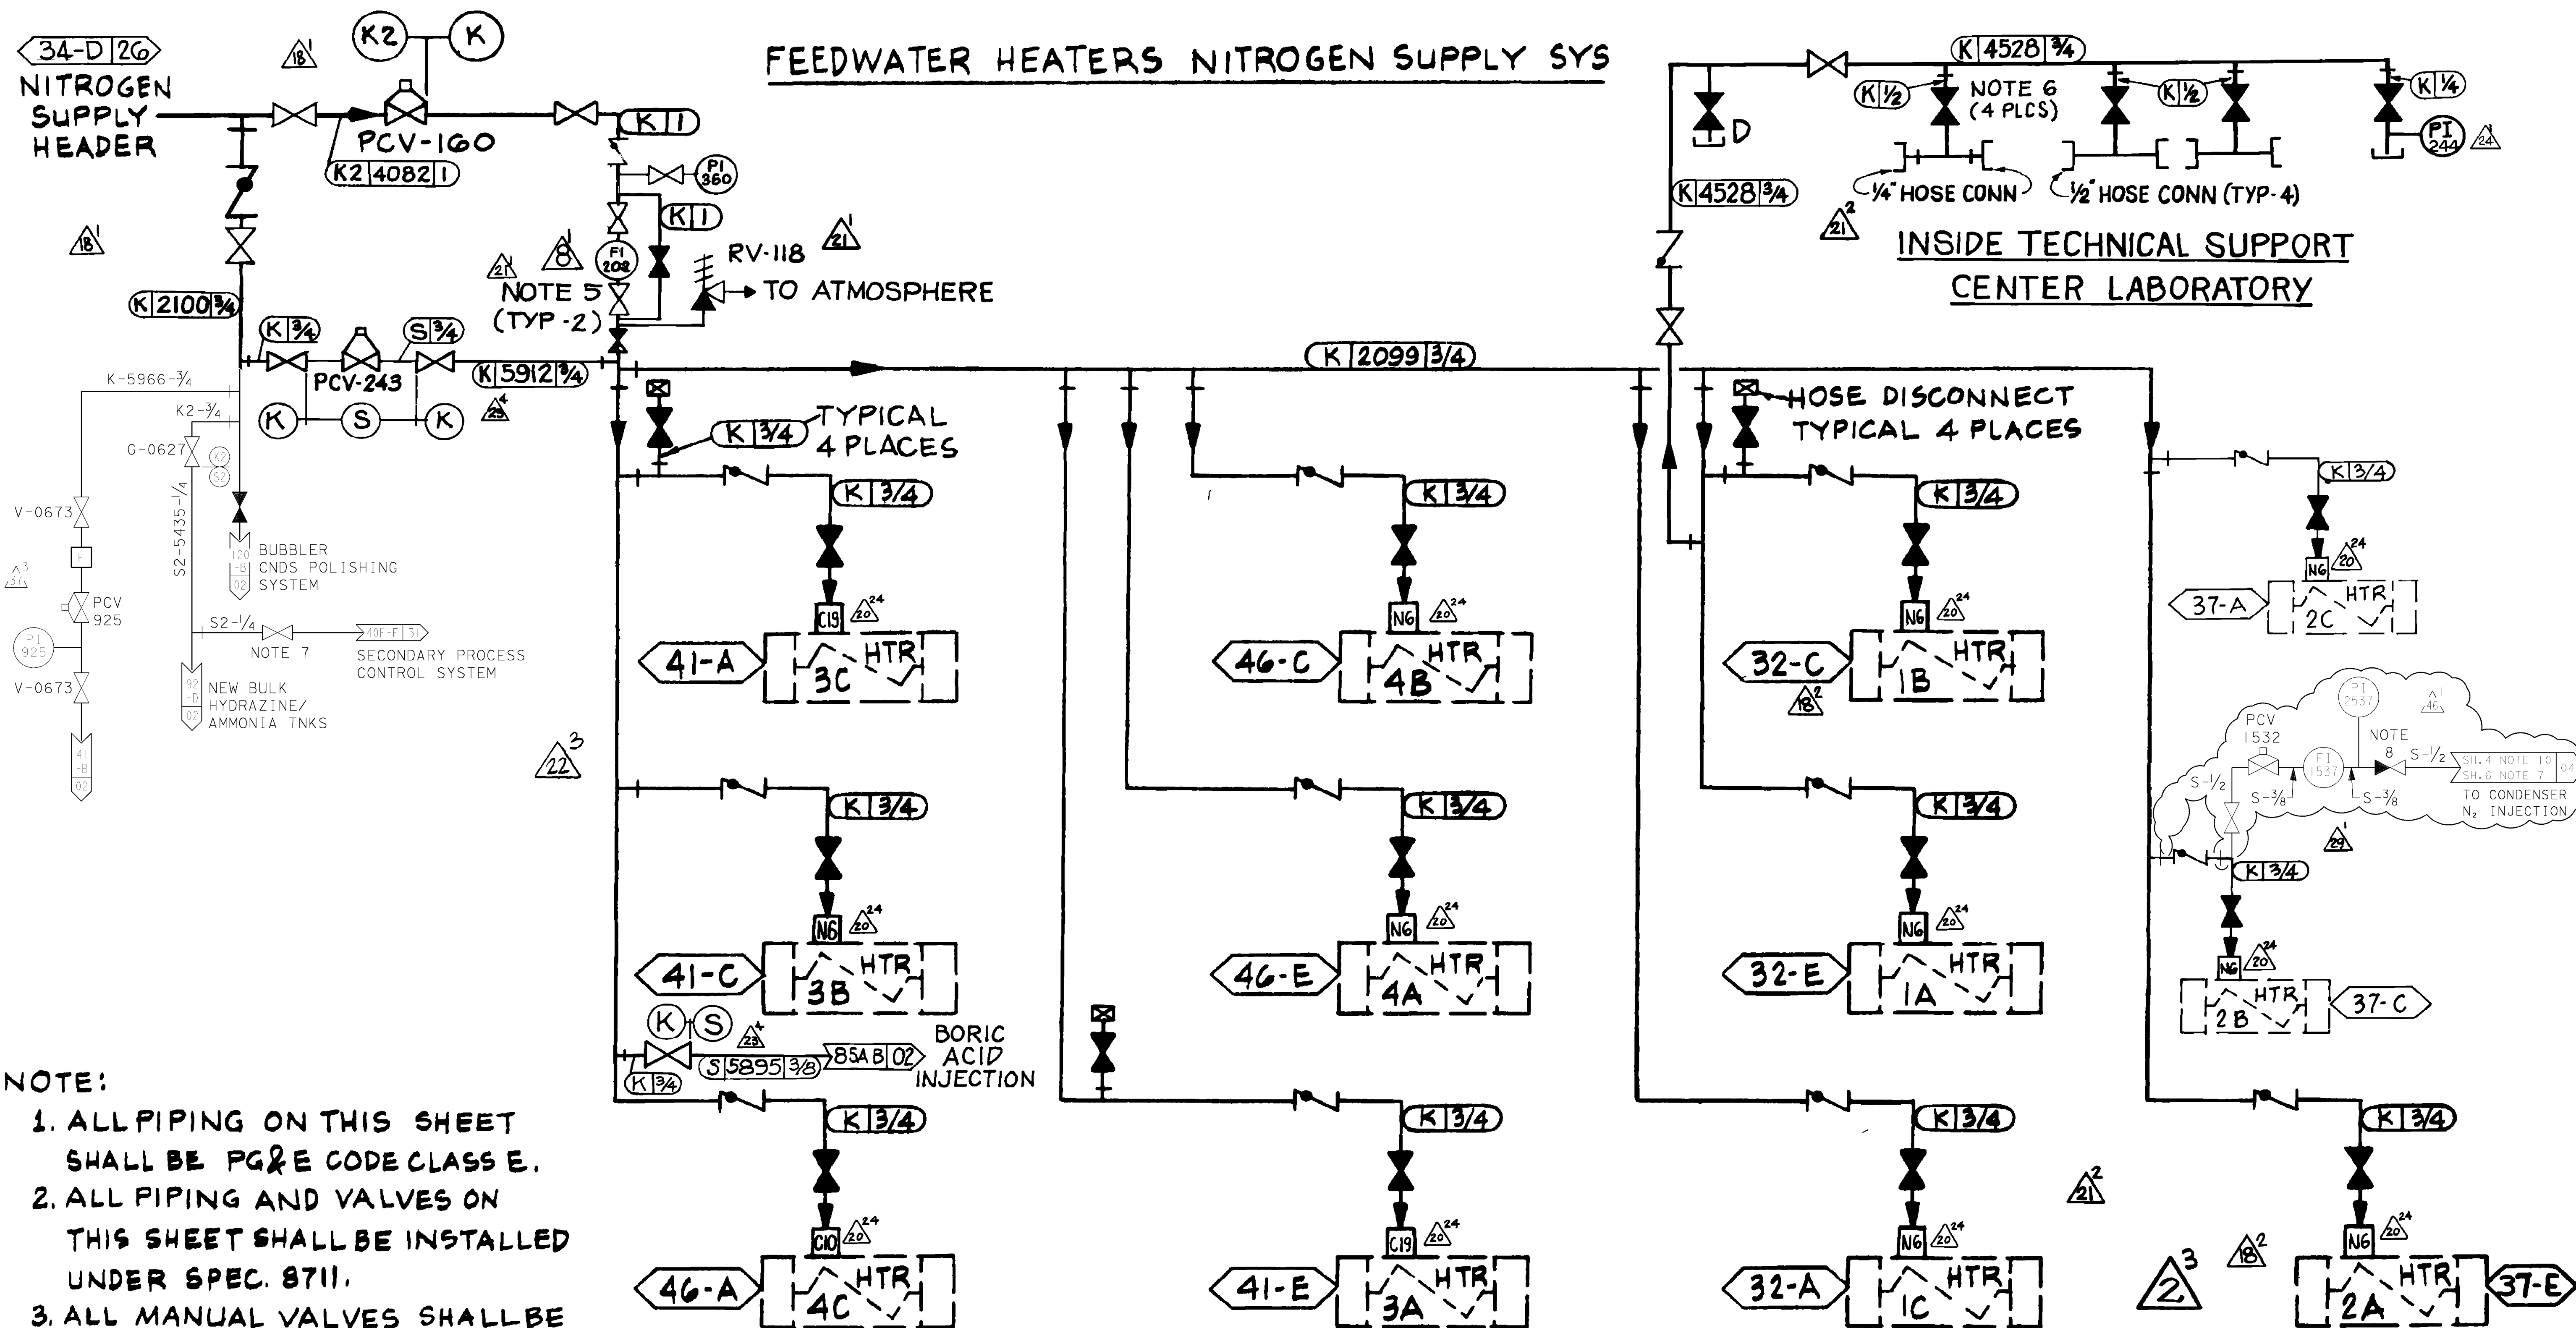

- NOTE:**
1. ALL PIPING ON THIS SHEET SHALL BE PG&E CODE CLASS E.
 2. ALL PIPING AND VALVES ON THIS SHEET SHALL BE INSTALLED UNDER SPEC. 8711.
 3. ALL MANUAL VALVES SHALL BE V-0673 UNLESS OTHERWISE NOTED
 4. ALL CHECK VALVES SHALL BE C-0651
 5. 1" VOGT GLOBE, SW-3241
 6. IDEAL AREOSMITH NEEDLE VALVES, V-51-12-43 (1/2") & 51-4-23 (1/4"), CAST BRONZE BODY WITH SS NEEDLE


7 1/4" 150 # SS, SOCKET-WELD ENDS (FOR 40S PIPE)
 GLOBE VALVE (PACIFIC MODEL #G-62-108 OR EQUAL)
 8. REGULATING VALVE, WHITEY SS-6NRF4

FEEDWATER HEATERS

UNIT - 2

P G & E CO.		108005	REV. 46
SHEET 7	PAGE 0		

6/1/1998	RJN3	JX12	-	JORGE R. DEL MAZO	MECHANICAL	M 17606	3/31/00
DATE	DWN	RE	IV	PROFESSIONAL ENGINEER	PE DISC.	PE#	PE EXP.

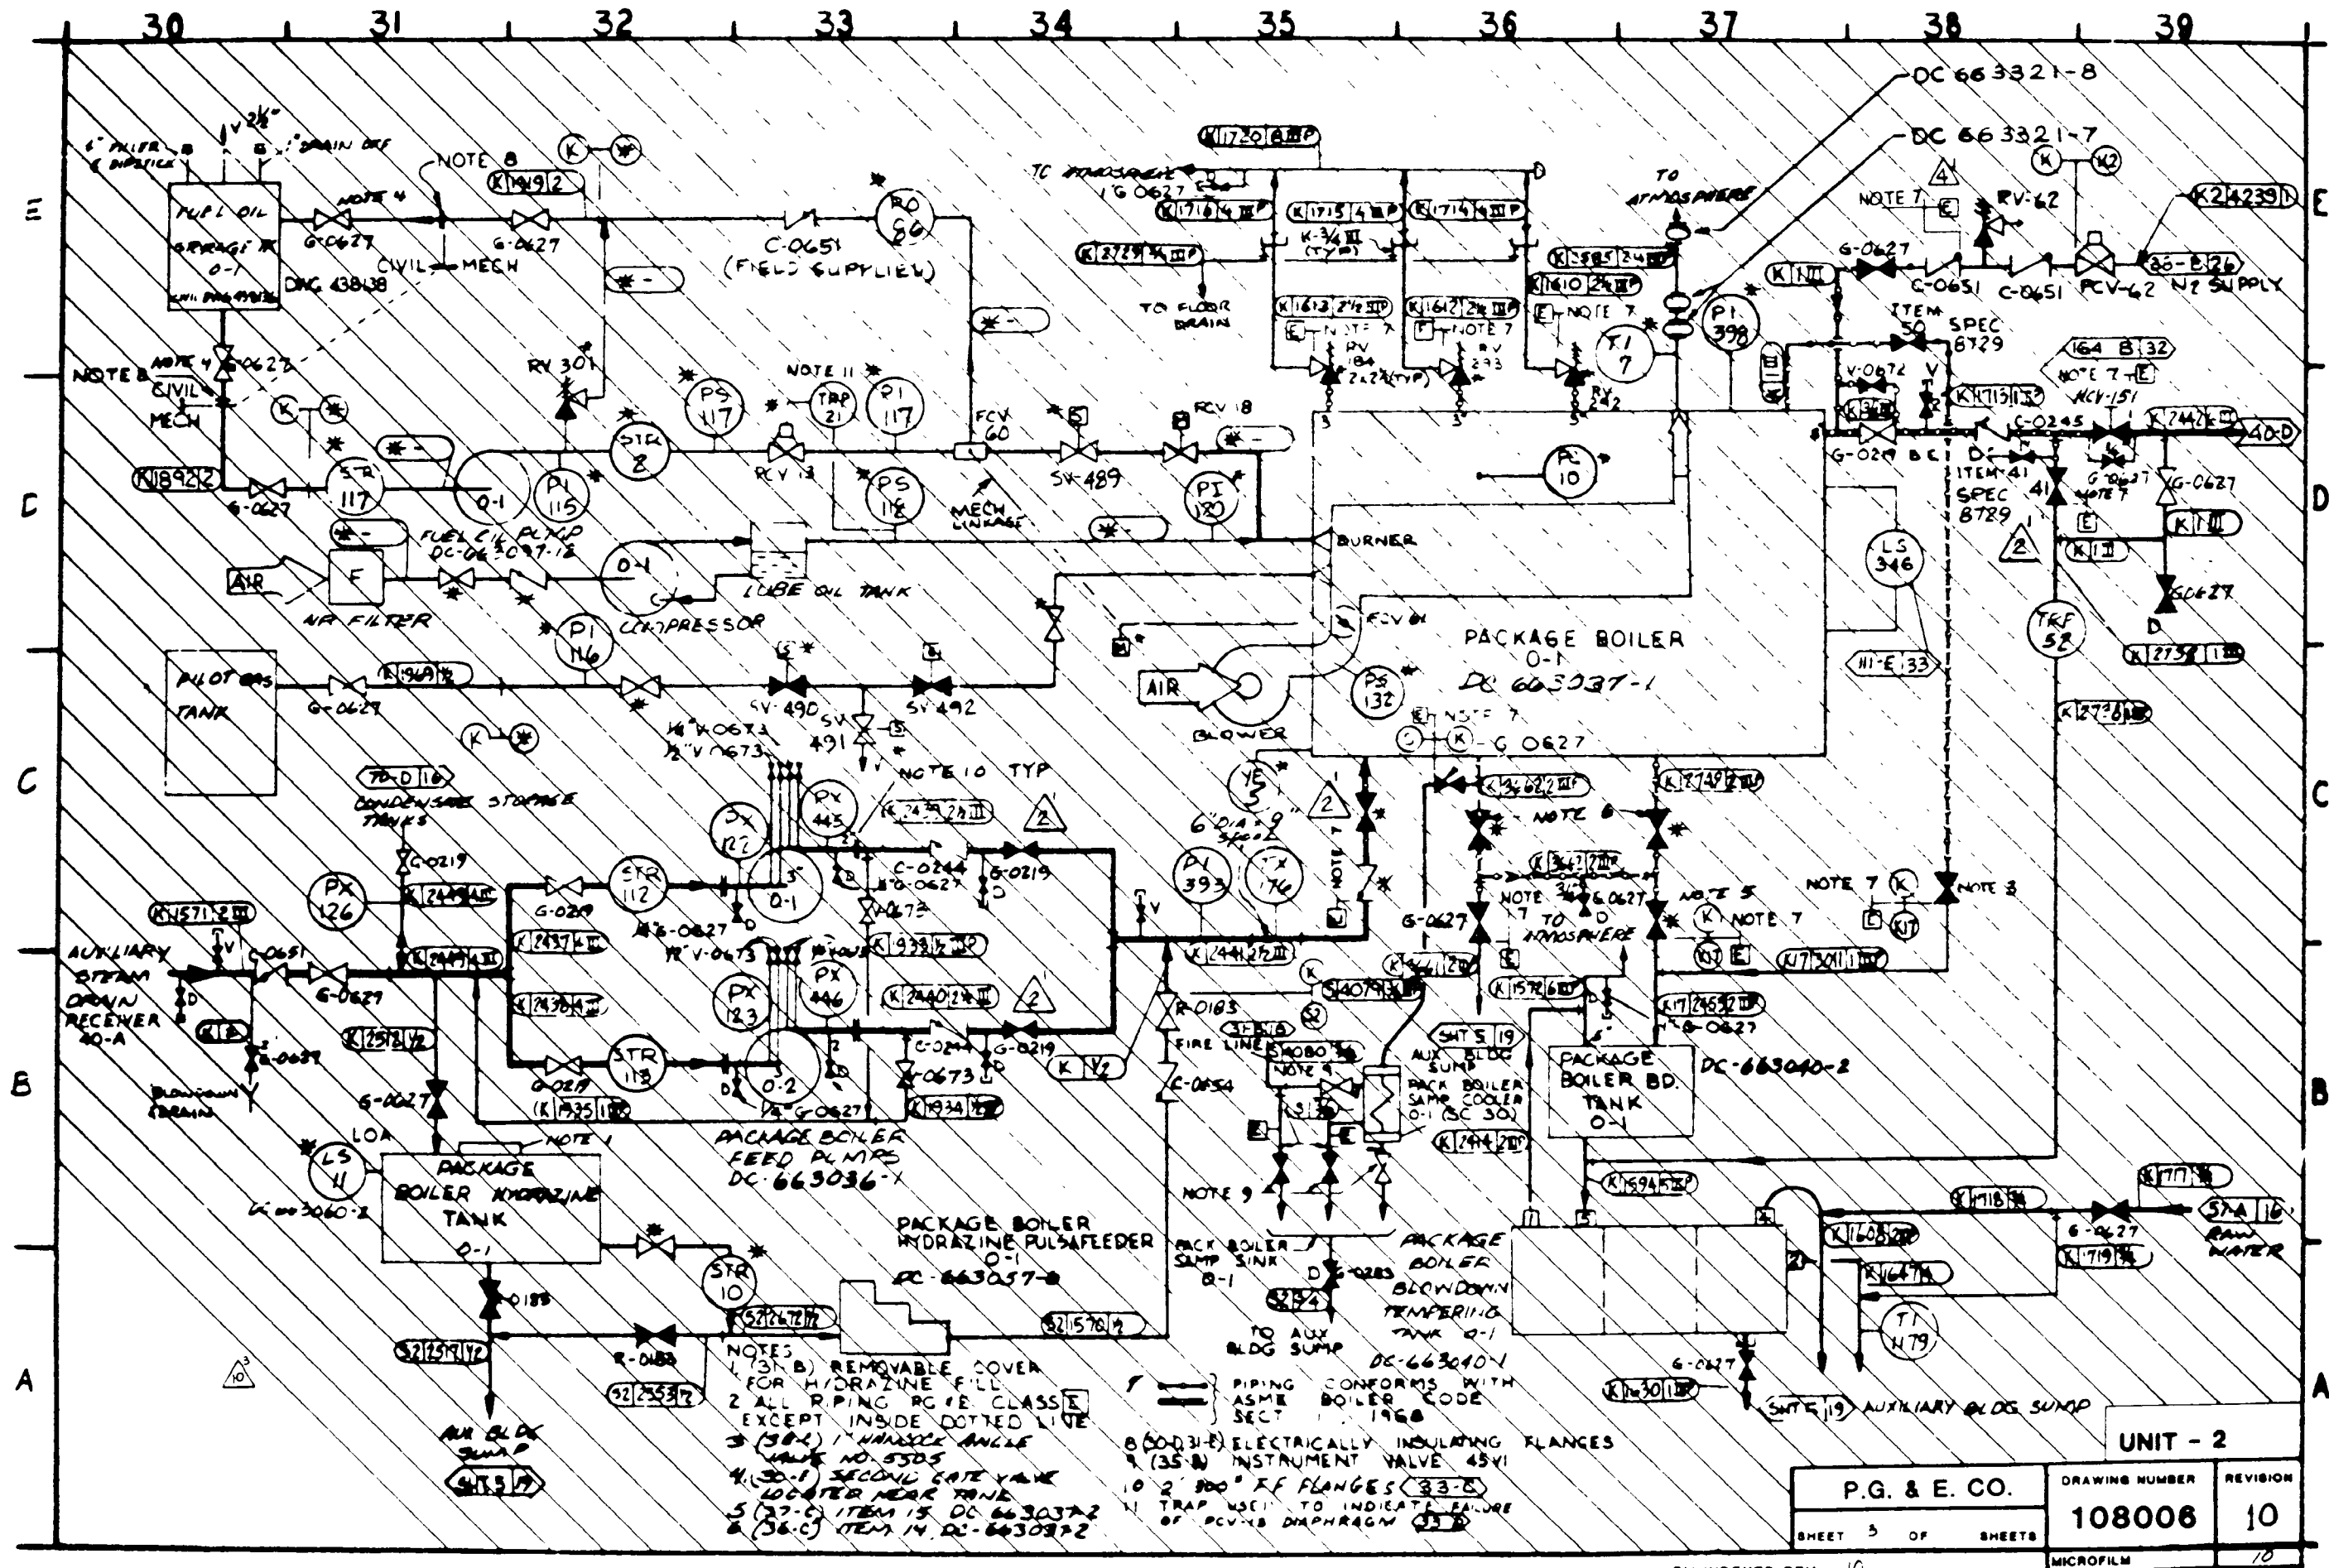

RM INDEXED REV -10-

SCAN 10

E

D

C

B


E


D

C

B

A

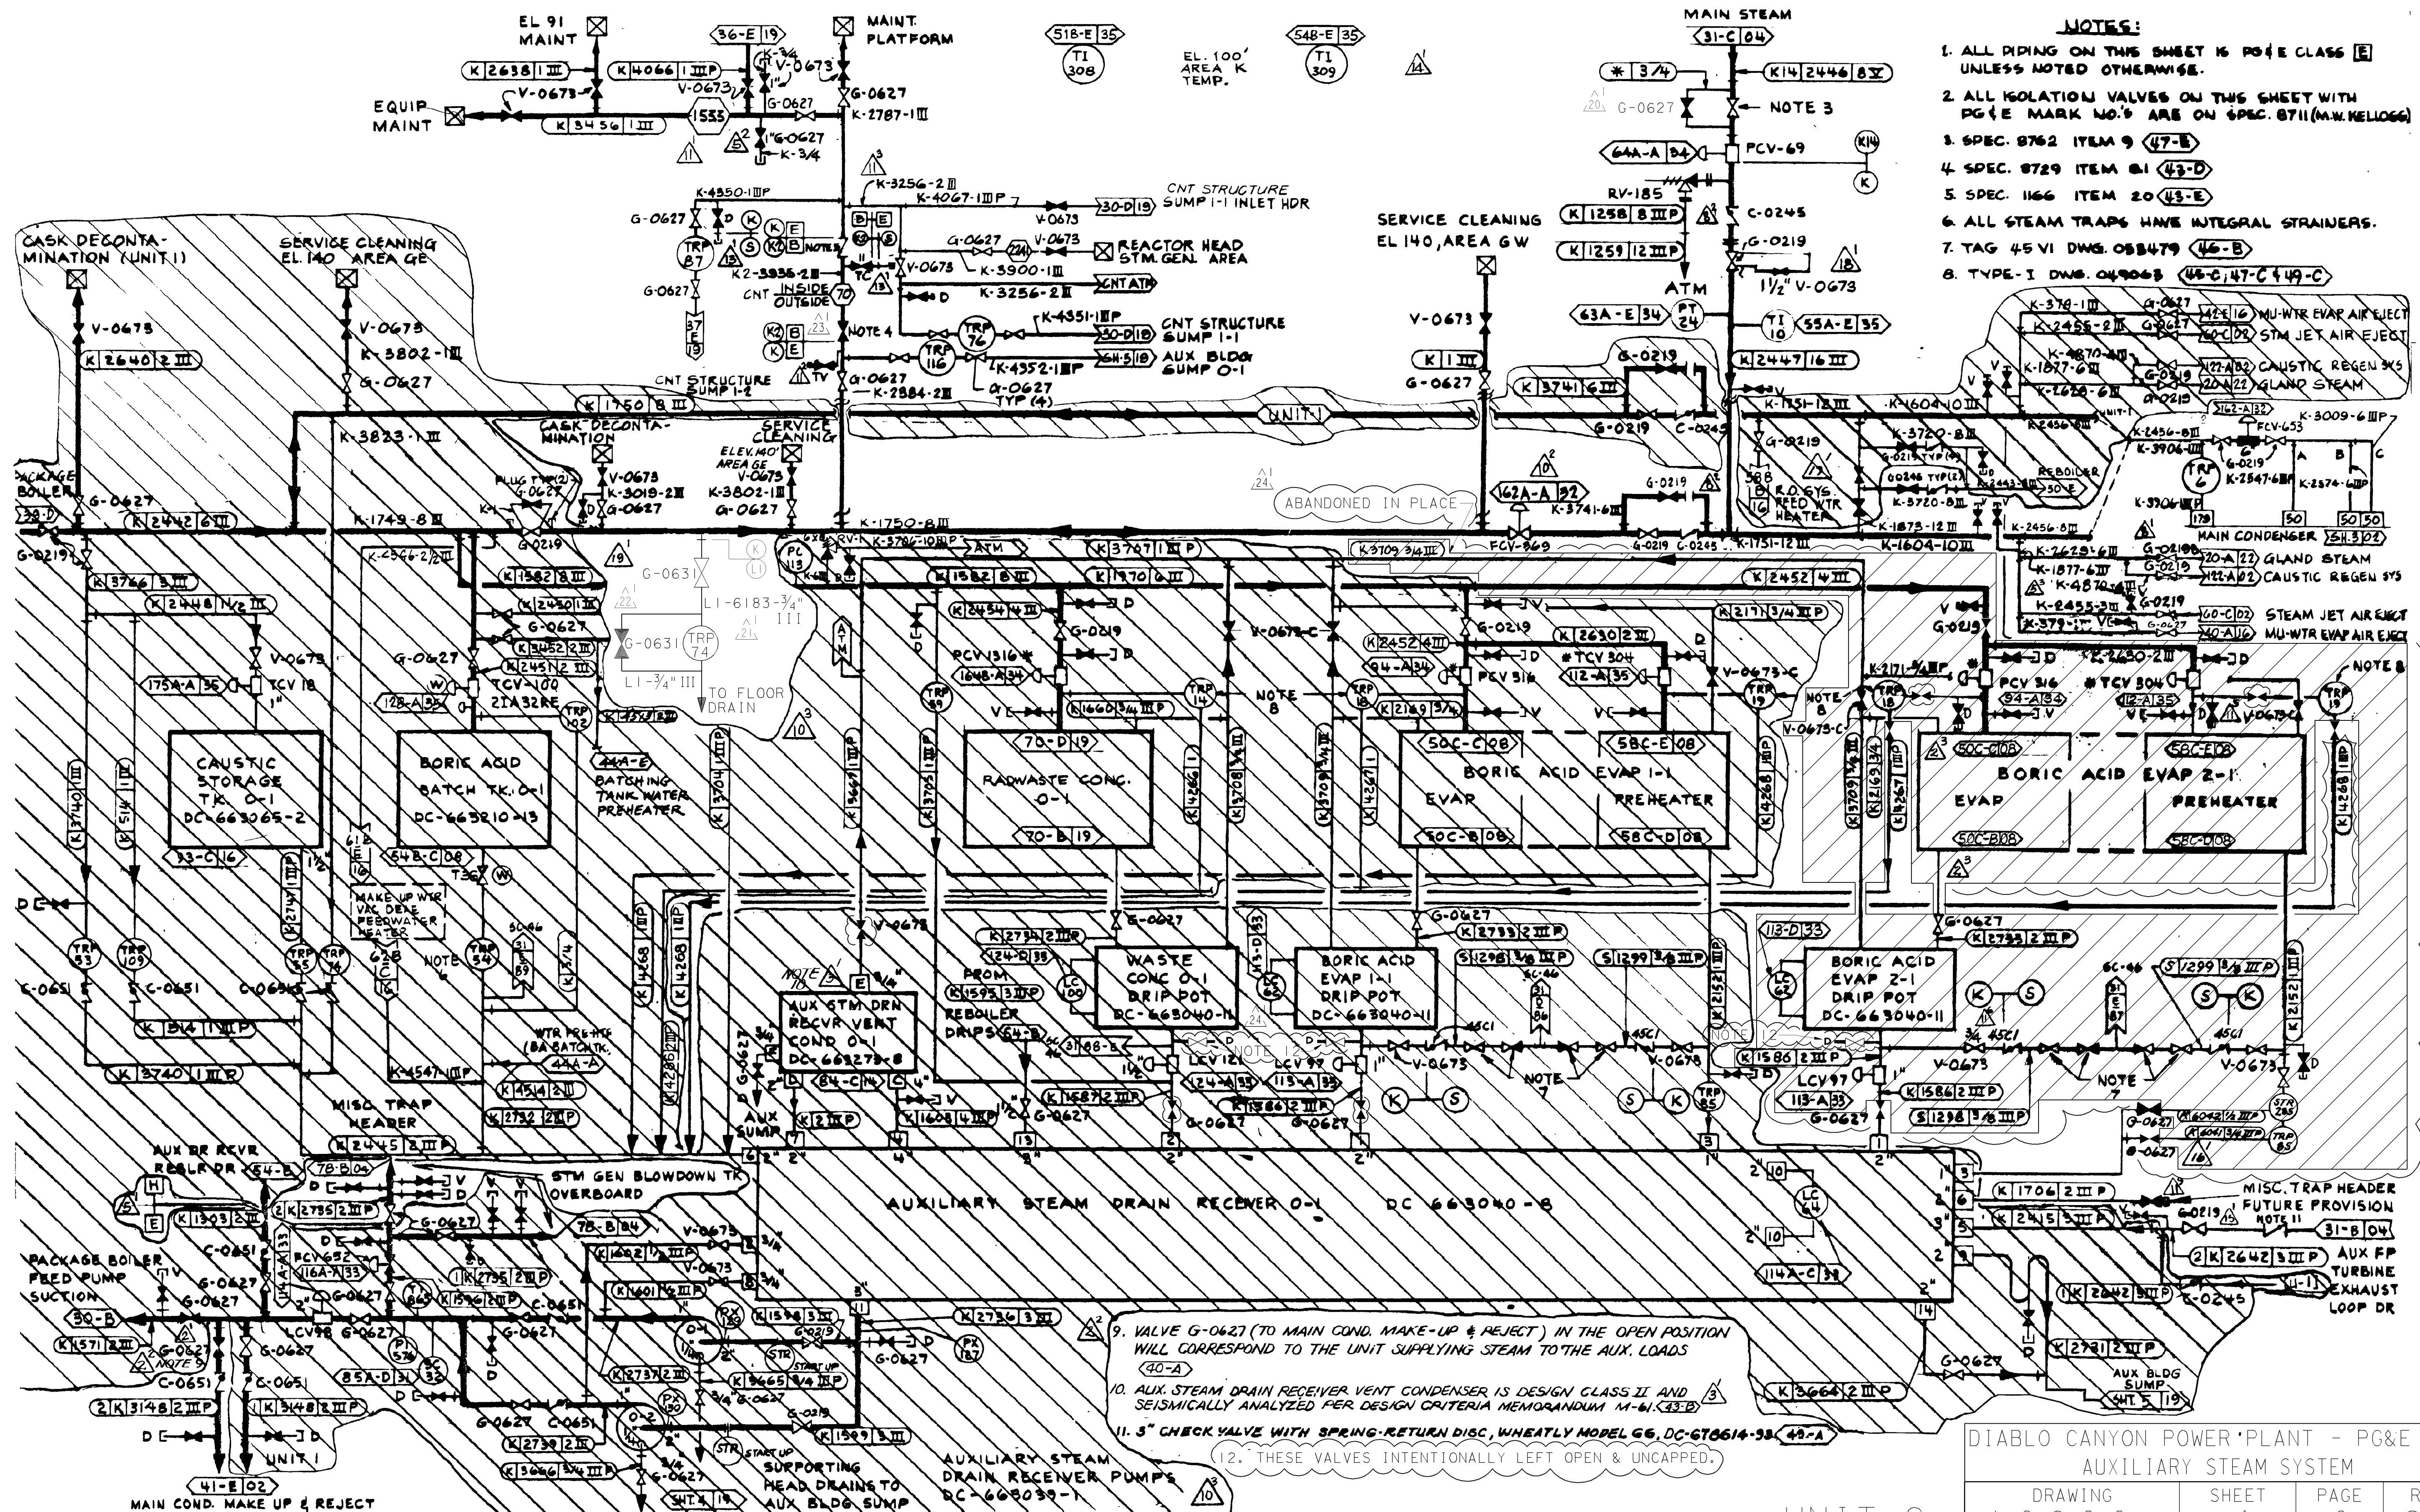

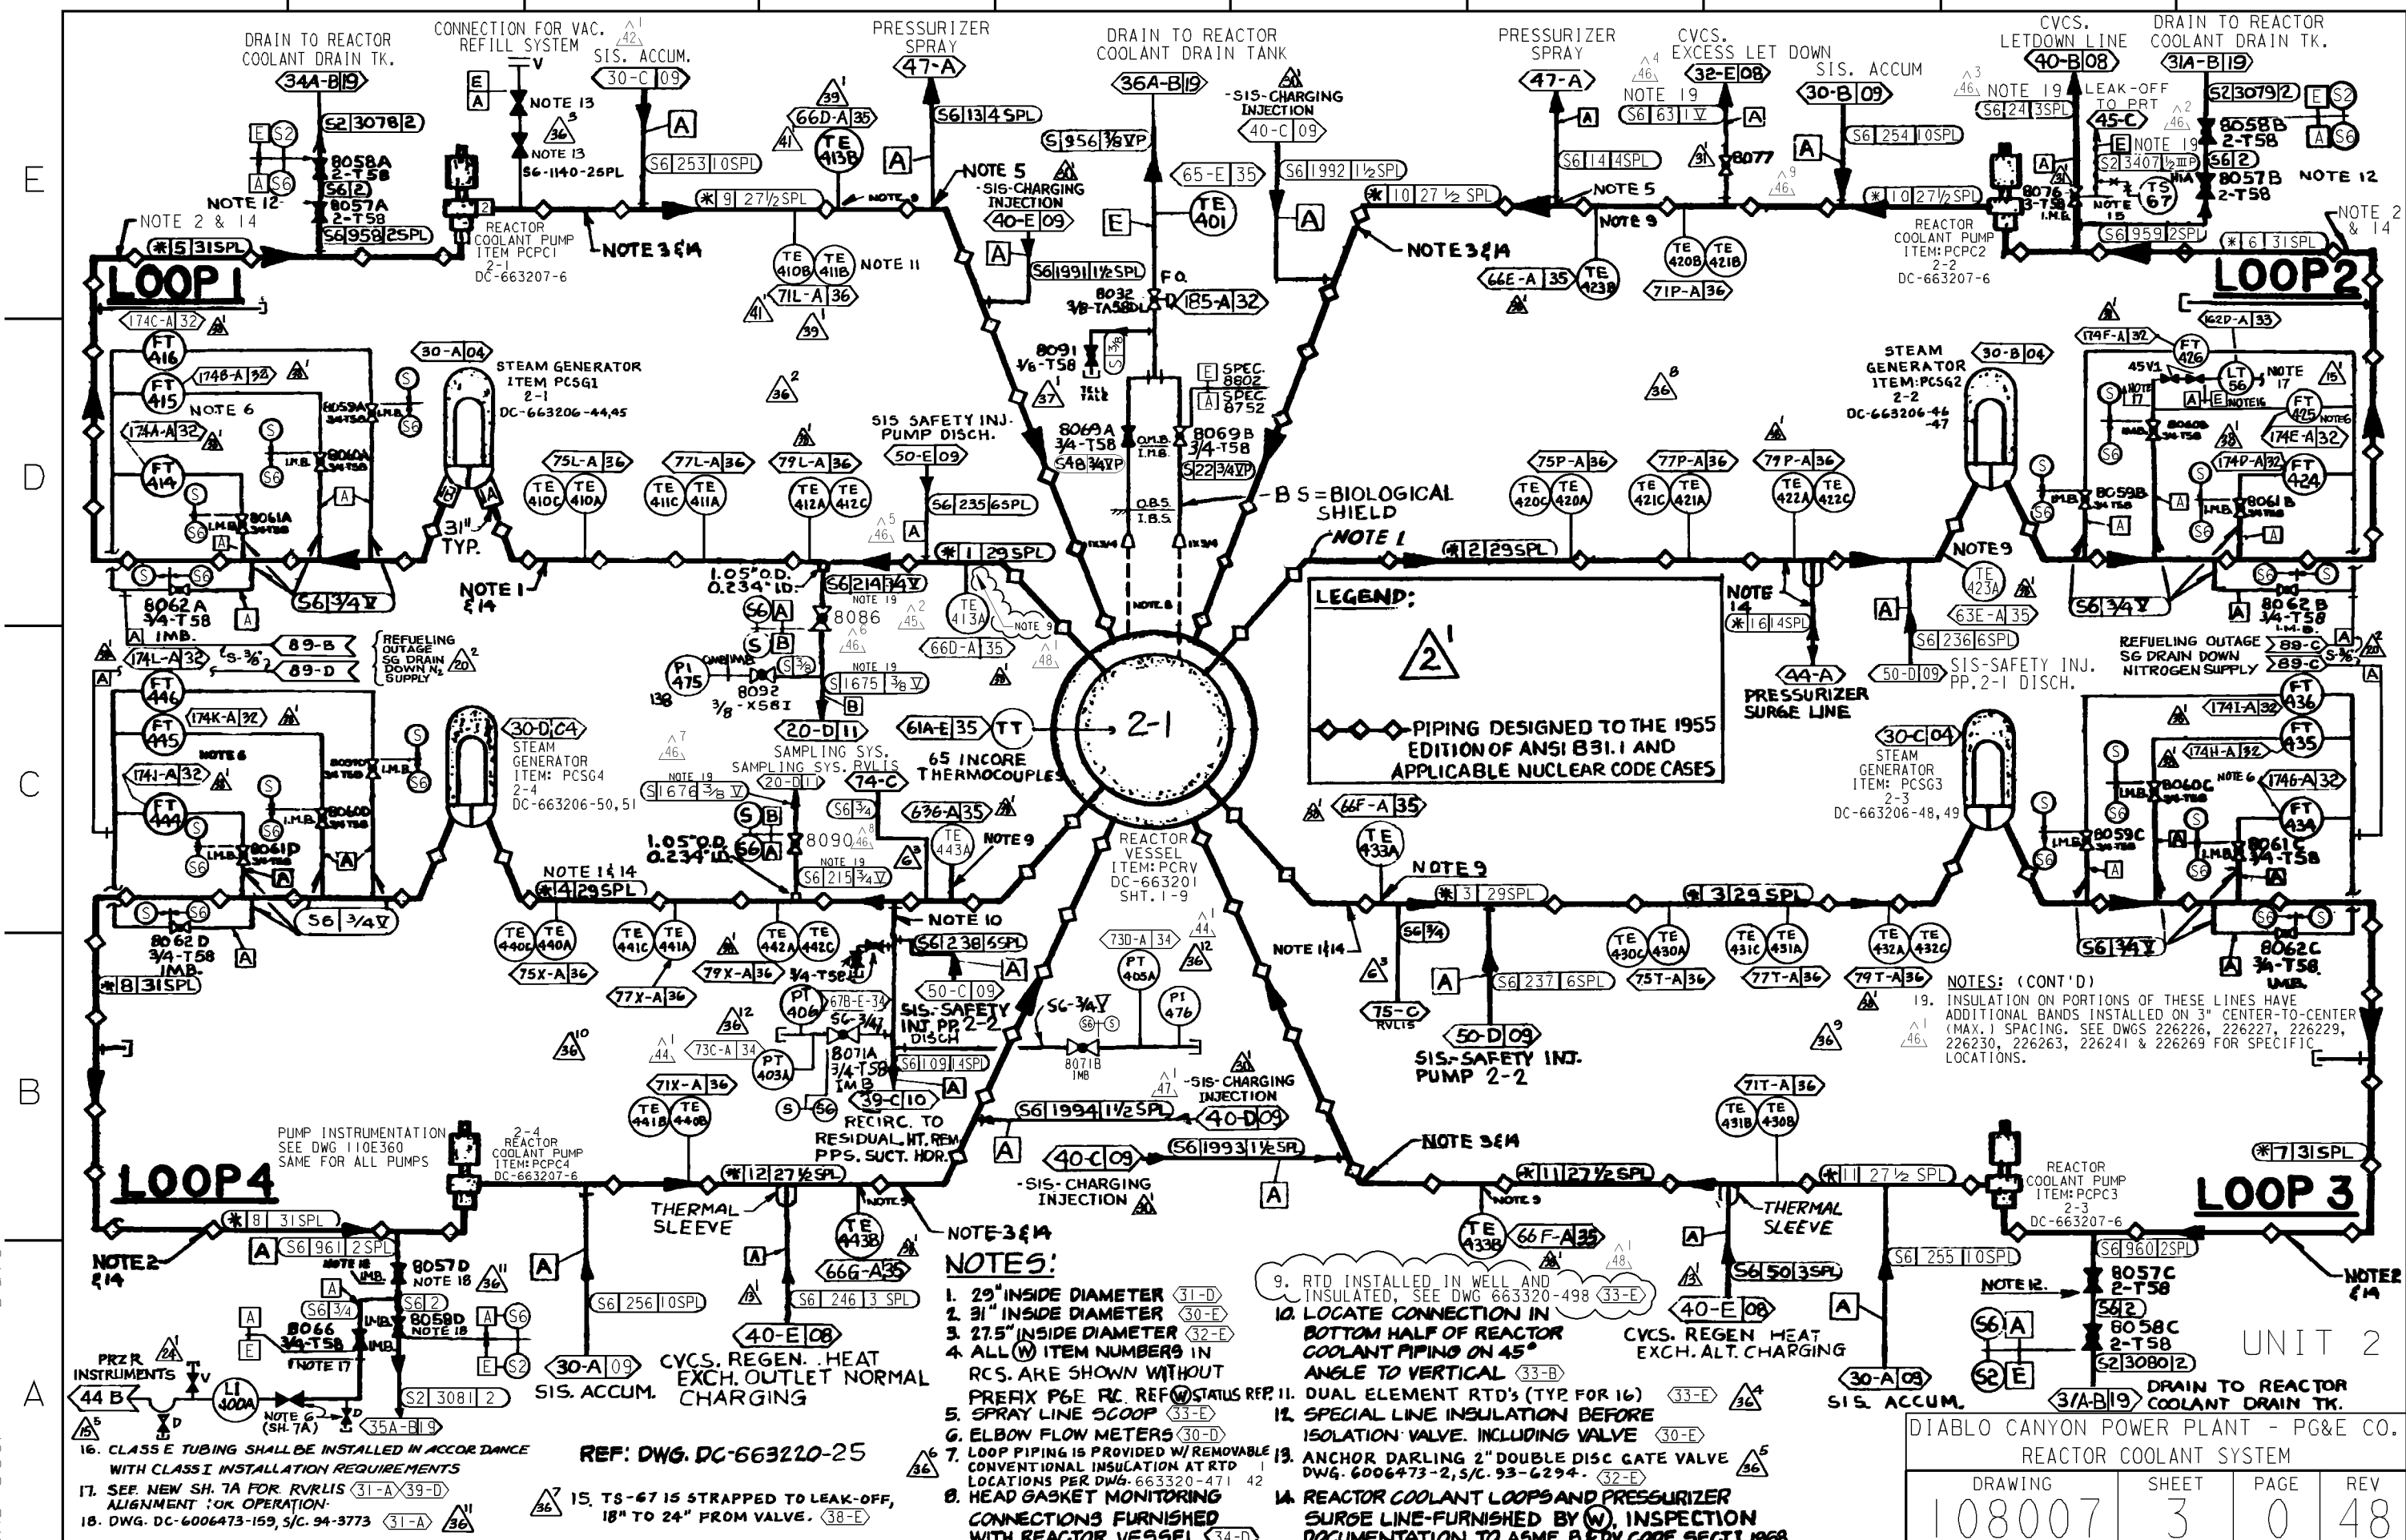

RASTER=erui0713.DGN
DGN=erui0713.DGN
CAD User: CNHK Date:06-14-2011


LEGEND: VALVE LEAK-OFF
PIPING DESIGNED TO THE 1955 EDITION OF
ANSI B31.1 AND APPLICABLE NUCLEAR CODE CASES.

NOTES CONT'D:

27. ANCHOR DARLING #1878 1" DOUBLE DISC SW SS GATE VALVE, <42>
28. INSULATION ON PORTIONS OF THESE LINES HAVE ADDITIONAL BANDS
INSTALLED ON 3" CENTER-TO-CENTER (MAX.) SPACING. SEE DWG 226254,
226258, 226259, 226267, 226269 & 449343 FOR SPECIFIC LOCATIONS:

NOTES CONT'D:

18. (DELETED)
19. SEE NEW SHT 7A FOR RVRLIS ALIGNMENT FOR OPERATION.
20. USE 3/4-X420, ITT VALVE #2471-10-M-3/4",
DWG No. 663219-267, S/C 42-2543 FOR THE TEST CONN.
21. 3"-150#, ITT BALL VALVE DWG No. 6006473-236.
22. REMOVE OPERATORS DISCONNECTED AND ABANDONED
IN PLACE. <45/46-A>
23. GLOBE VALVE, VELAN, 6011929-3.
24. VALVES 8000A, B & C HAVE 1/2" Ø HOLE DRILLED IN THE
UPSTREAM SIDE OF THE DISK; 663219-388. <41-C/B>
25. VALVES PCV-455C, 456B & 474 ARE 2" SIZE WITH ENDS
PREPARED TO MATCH 3" PIPE. <40-C/B>
26. 3/4" GLOBE VALVE, VELAN, 6011929-3, S/C 95-1989. <45-A>

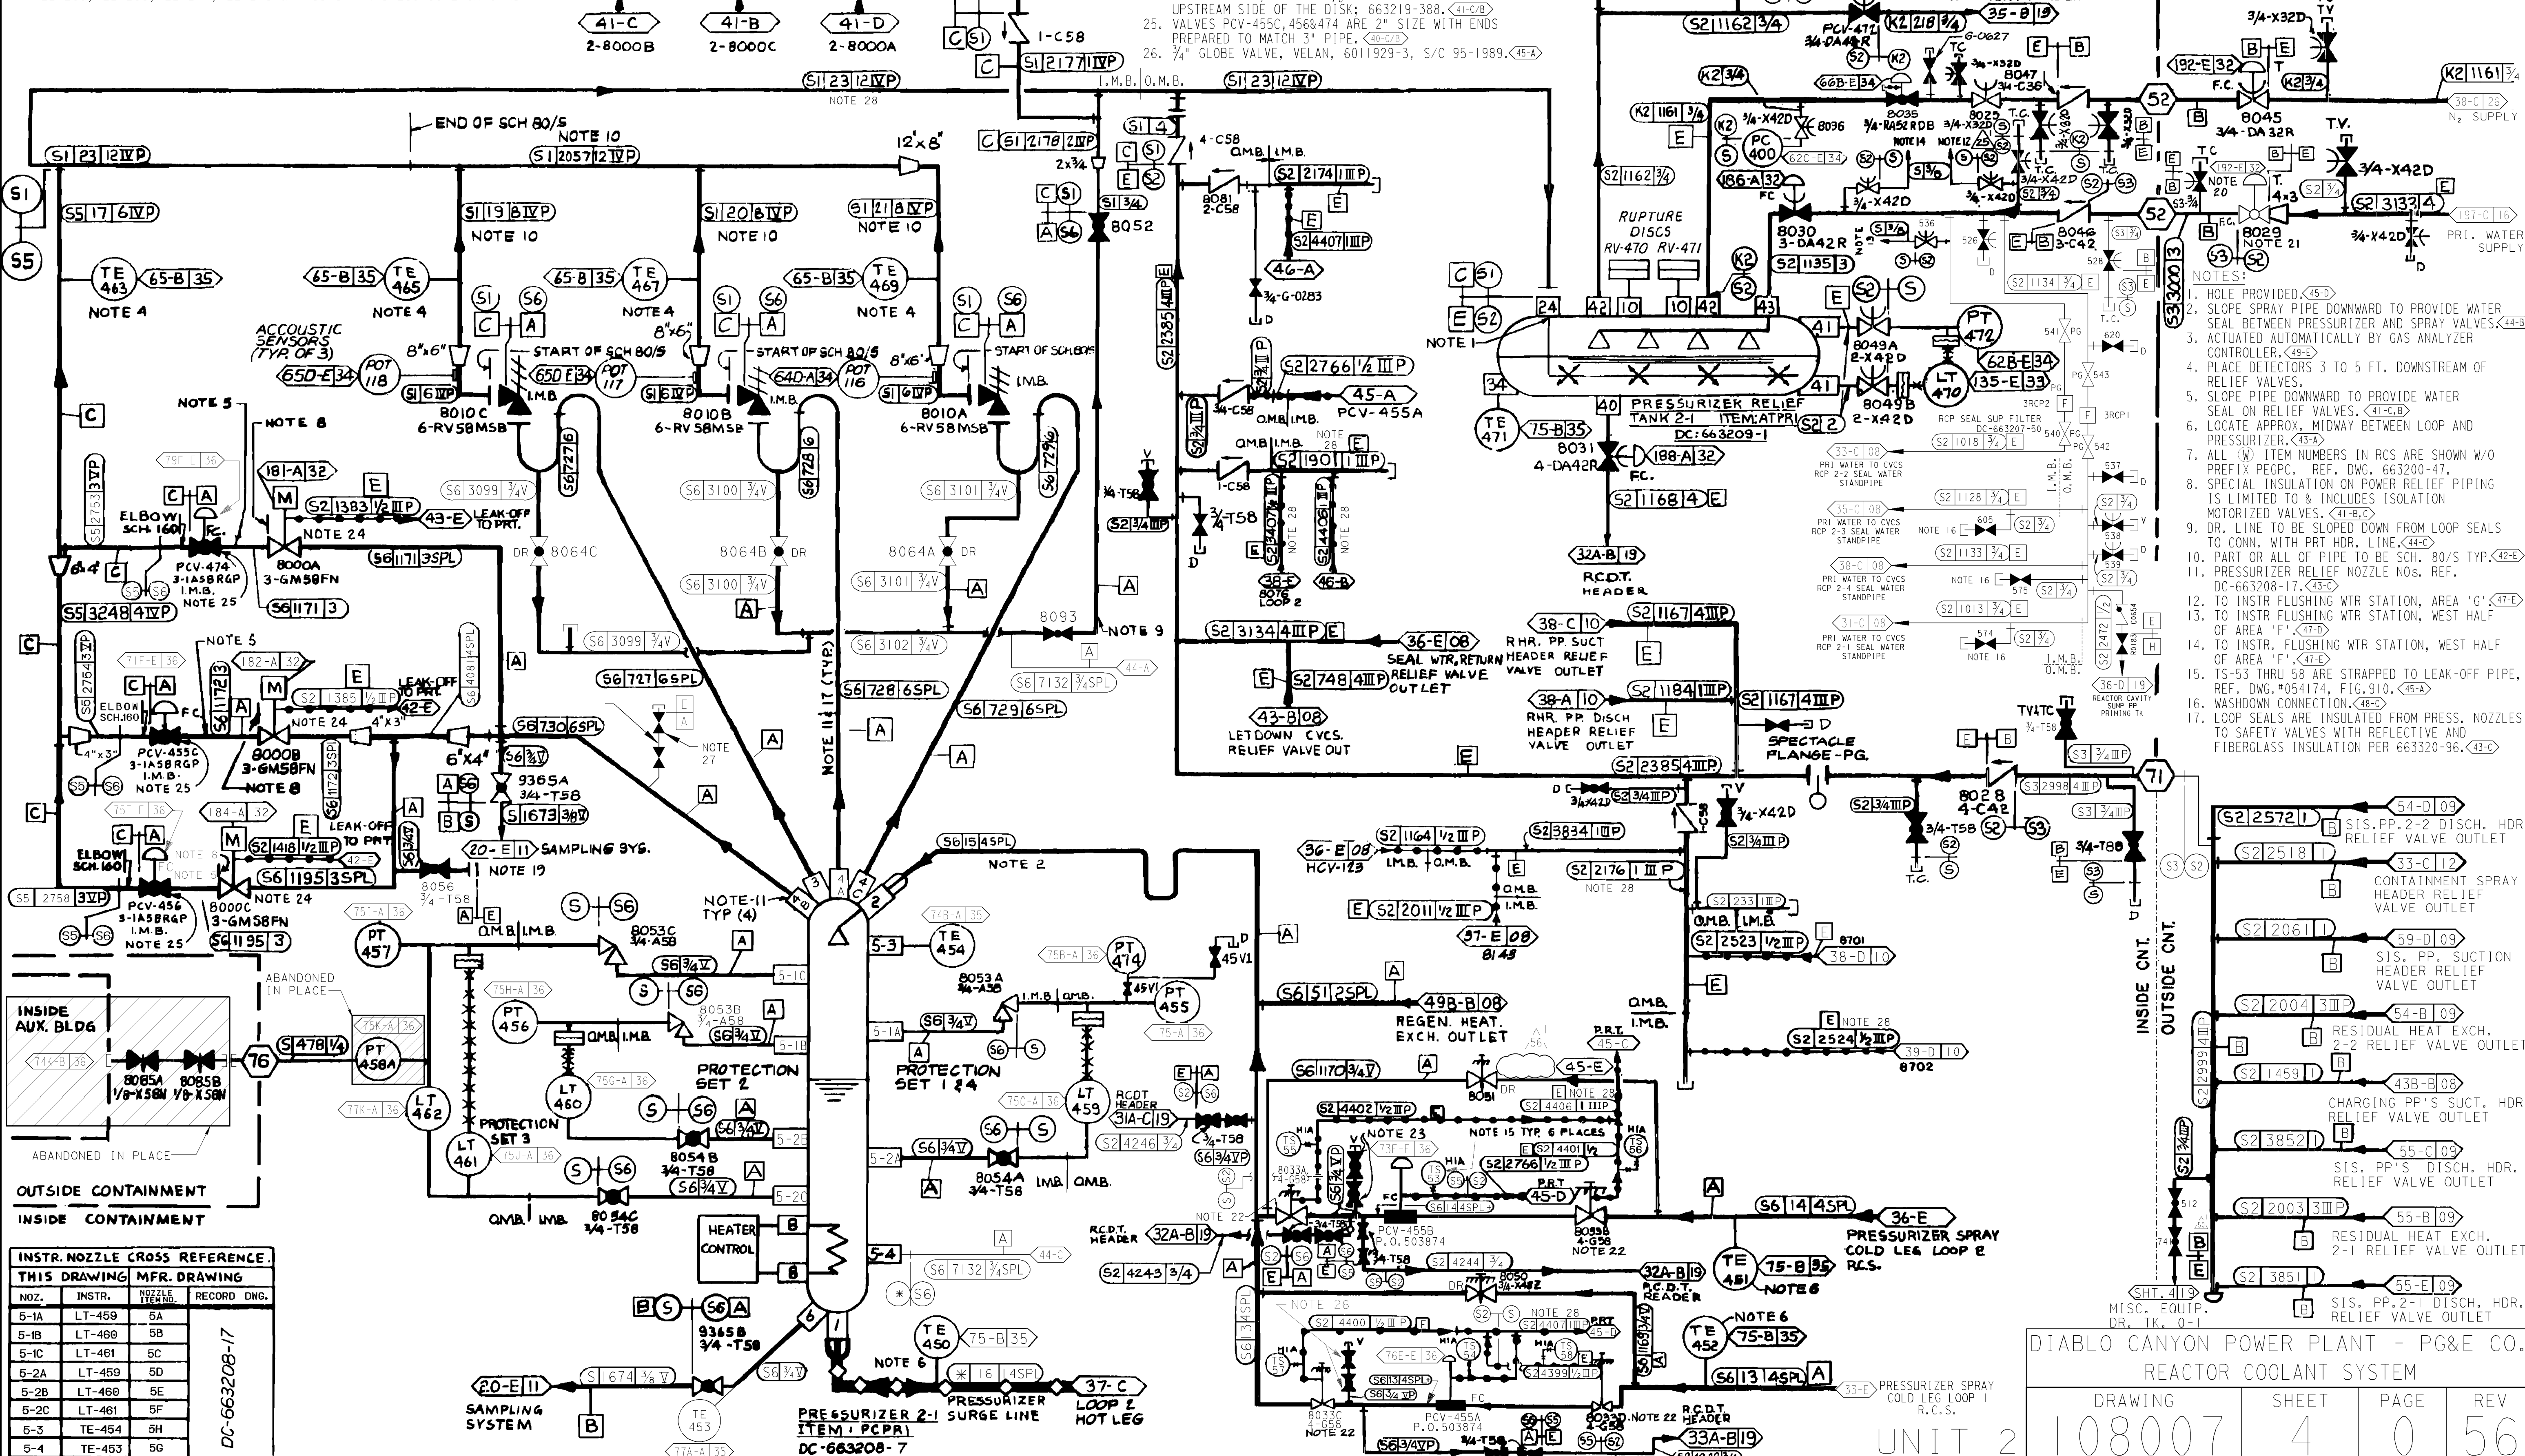

INSTR. NOZZLE CROSS REFERENCE			
THIS DRAWING	INSTR.	NOZZLE ITEM NO.	RECORD DWG.
5-1A	LT-459	5A	DC-663208-17
5-1B	LT-460	5B	
5-1C	LT-461	5C	
5-2A	LT-459	5D	
5-2B	LT-460	5E	
5-2C	LT-461	5F	
5-3	TE-454	5H	
5-4	TE-453	5G	
5-5	TE-452	5I	
5-6	TE-451	5J	

DIABLO CANYON POWER PLANT - PG&E CO.
REACTOR COOLANT SYSTEM

DRAWING	SHEET	PAGE	REV
108007	4	0	56

04-18-2013 ZNS4 Fxc2 KJD3 NOT REQUIRED

DATE DWN RE IV PROFESSIONAL ENGINEER

N/A

PE DISC.


N/A


PE#

N/A

PE EXP.

REVISED PER DFT-7*2081

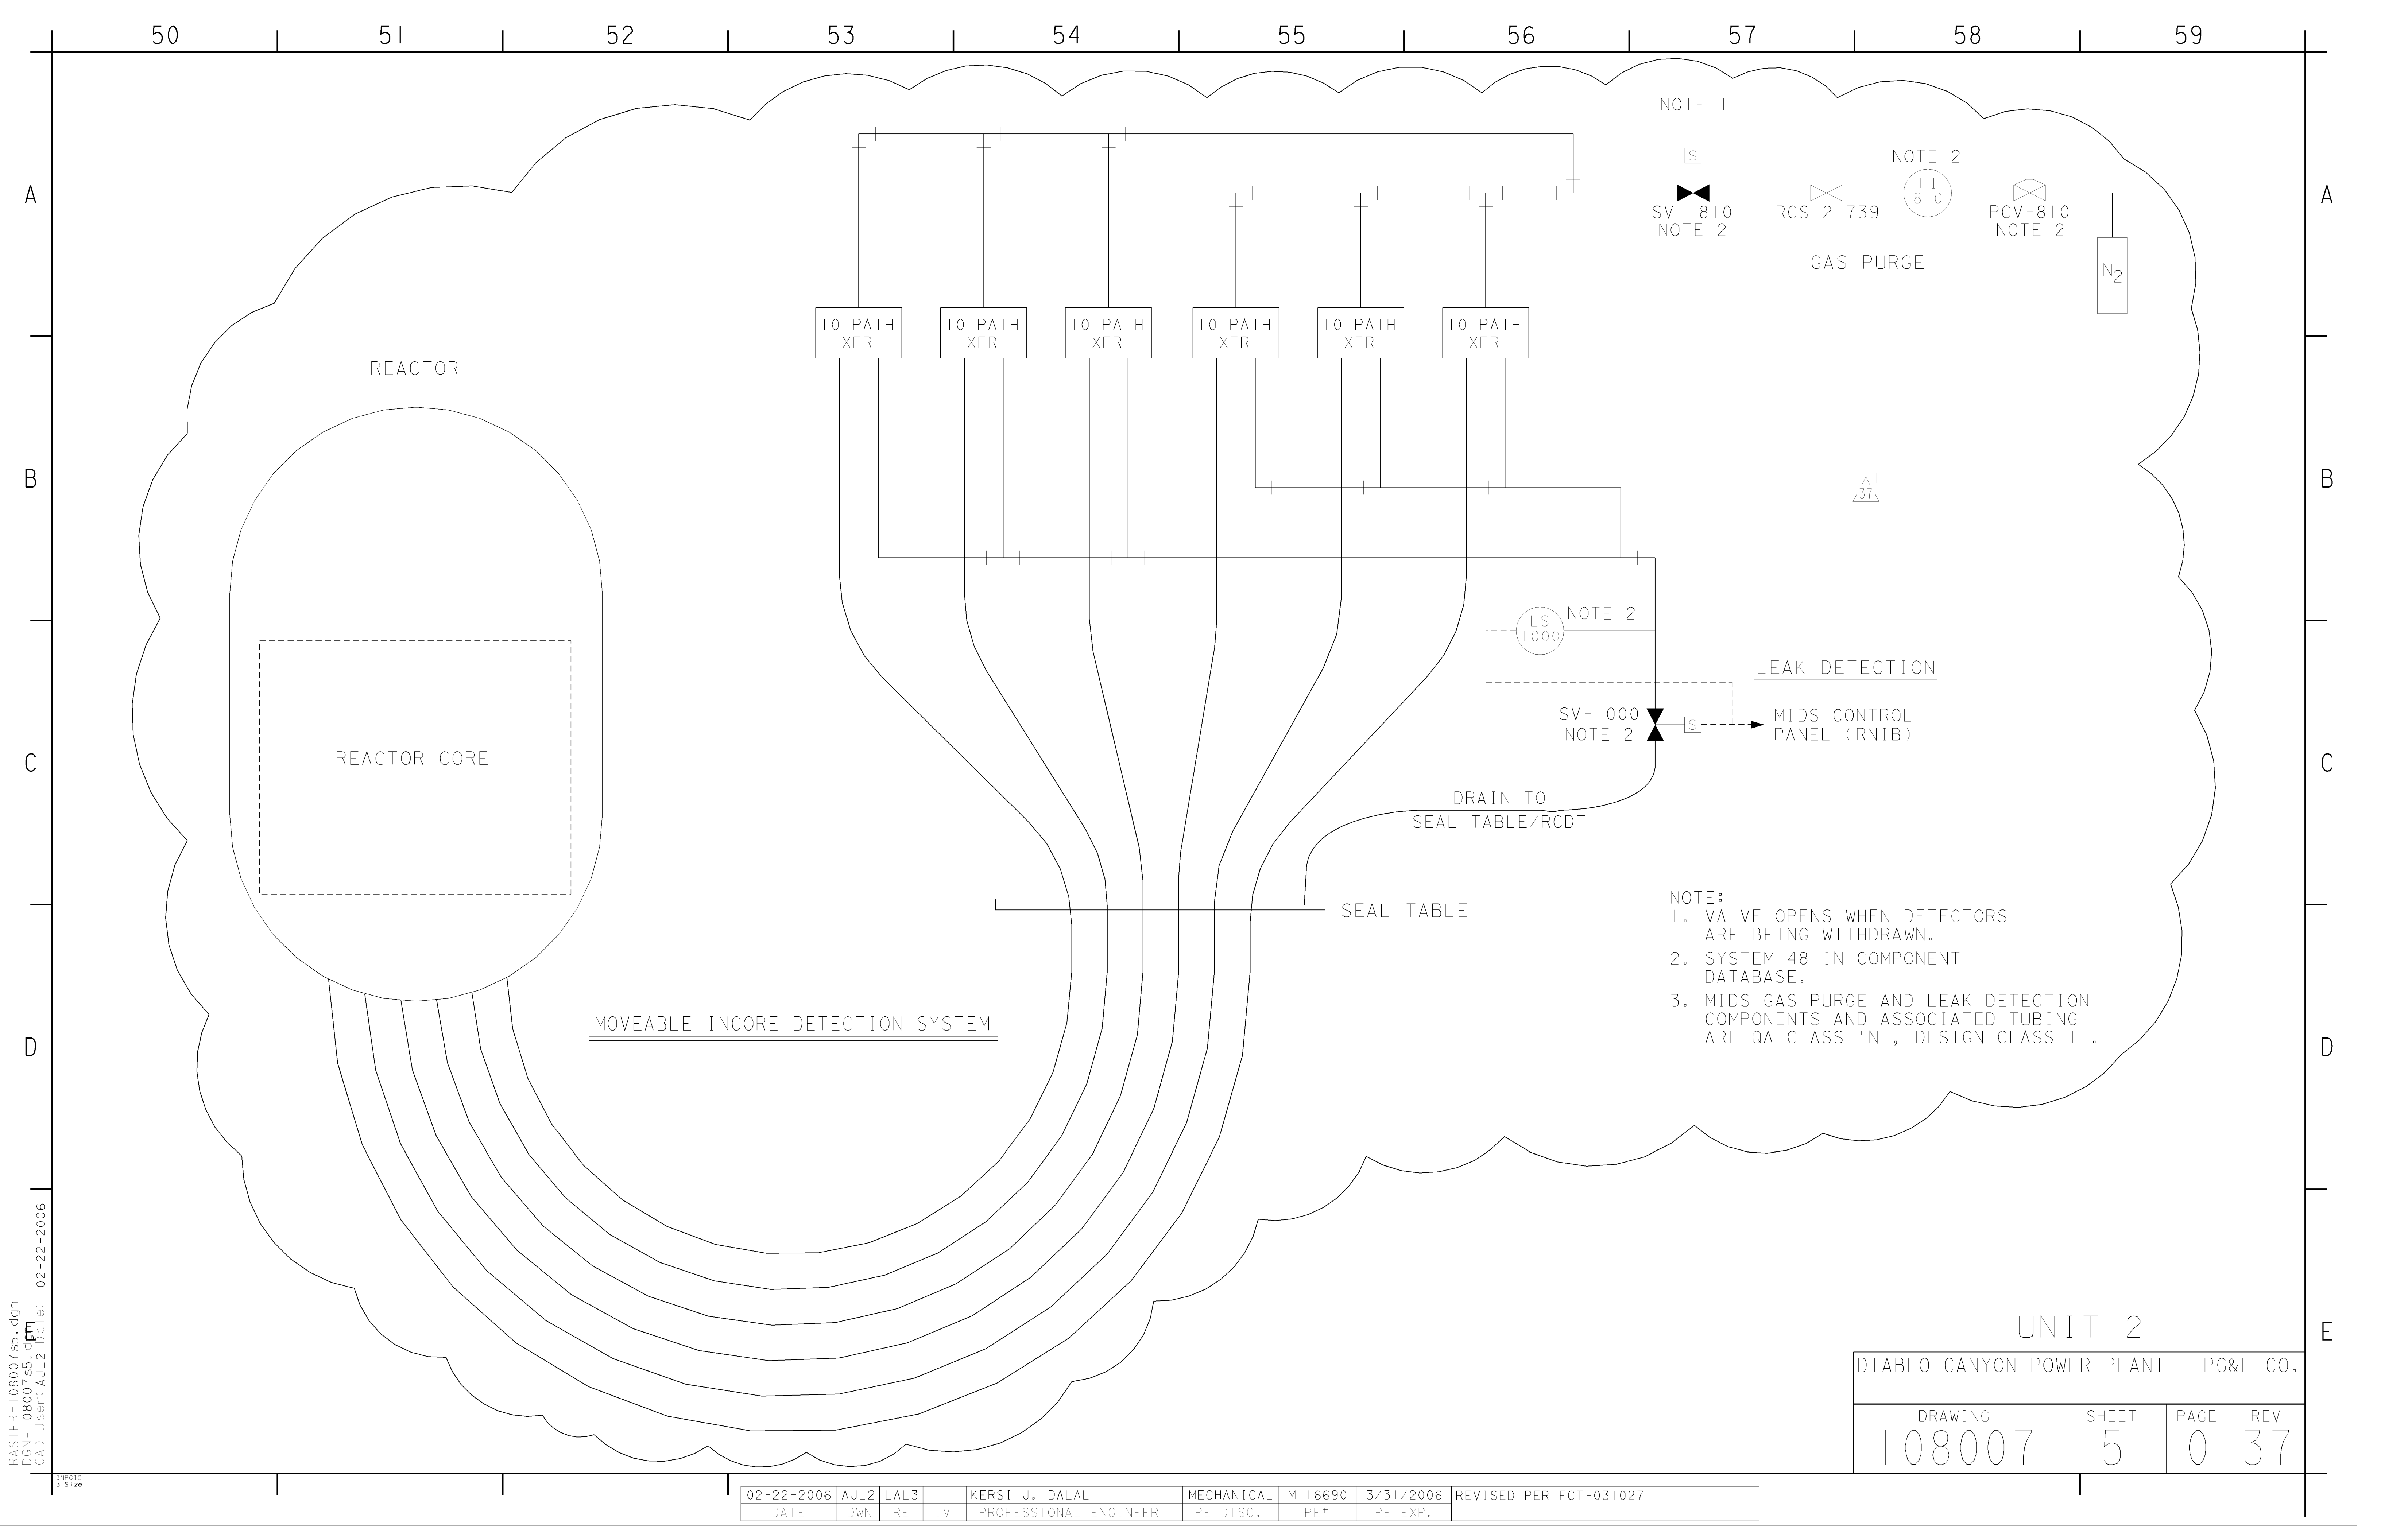


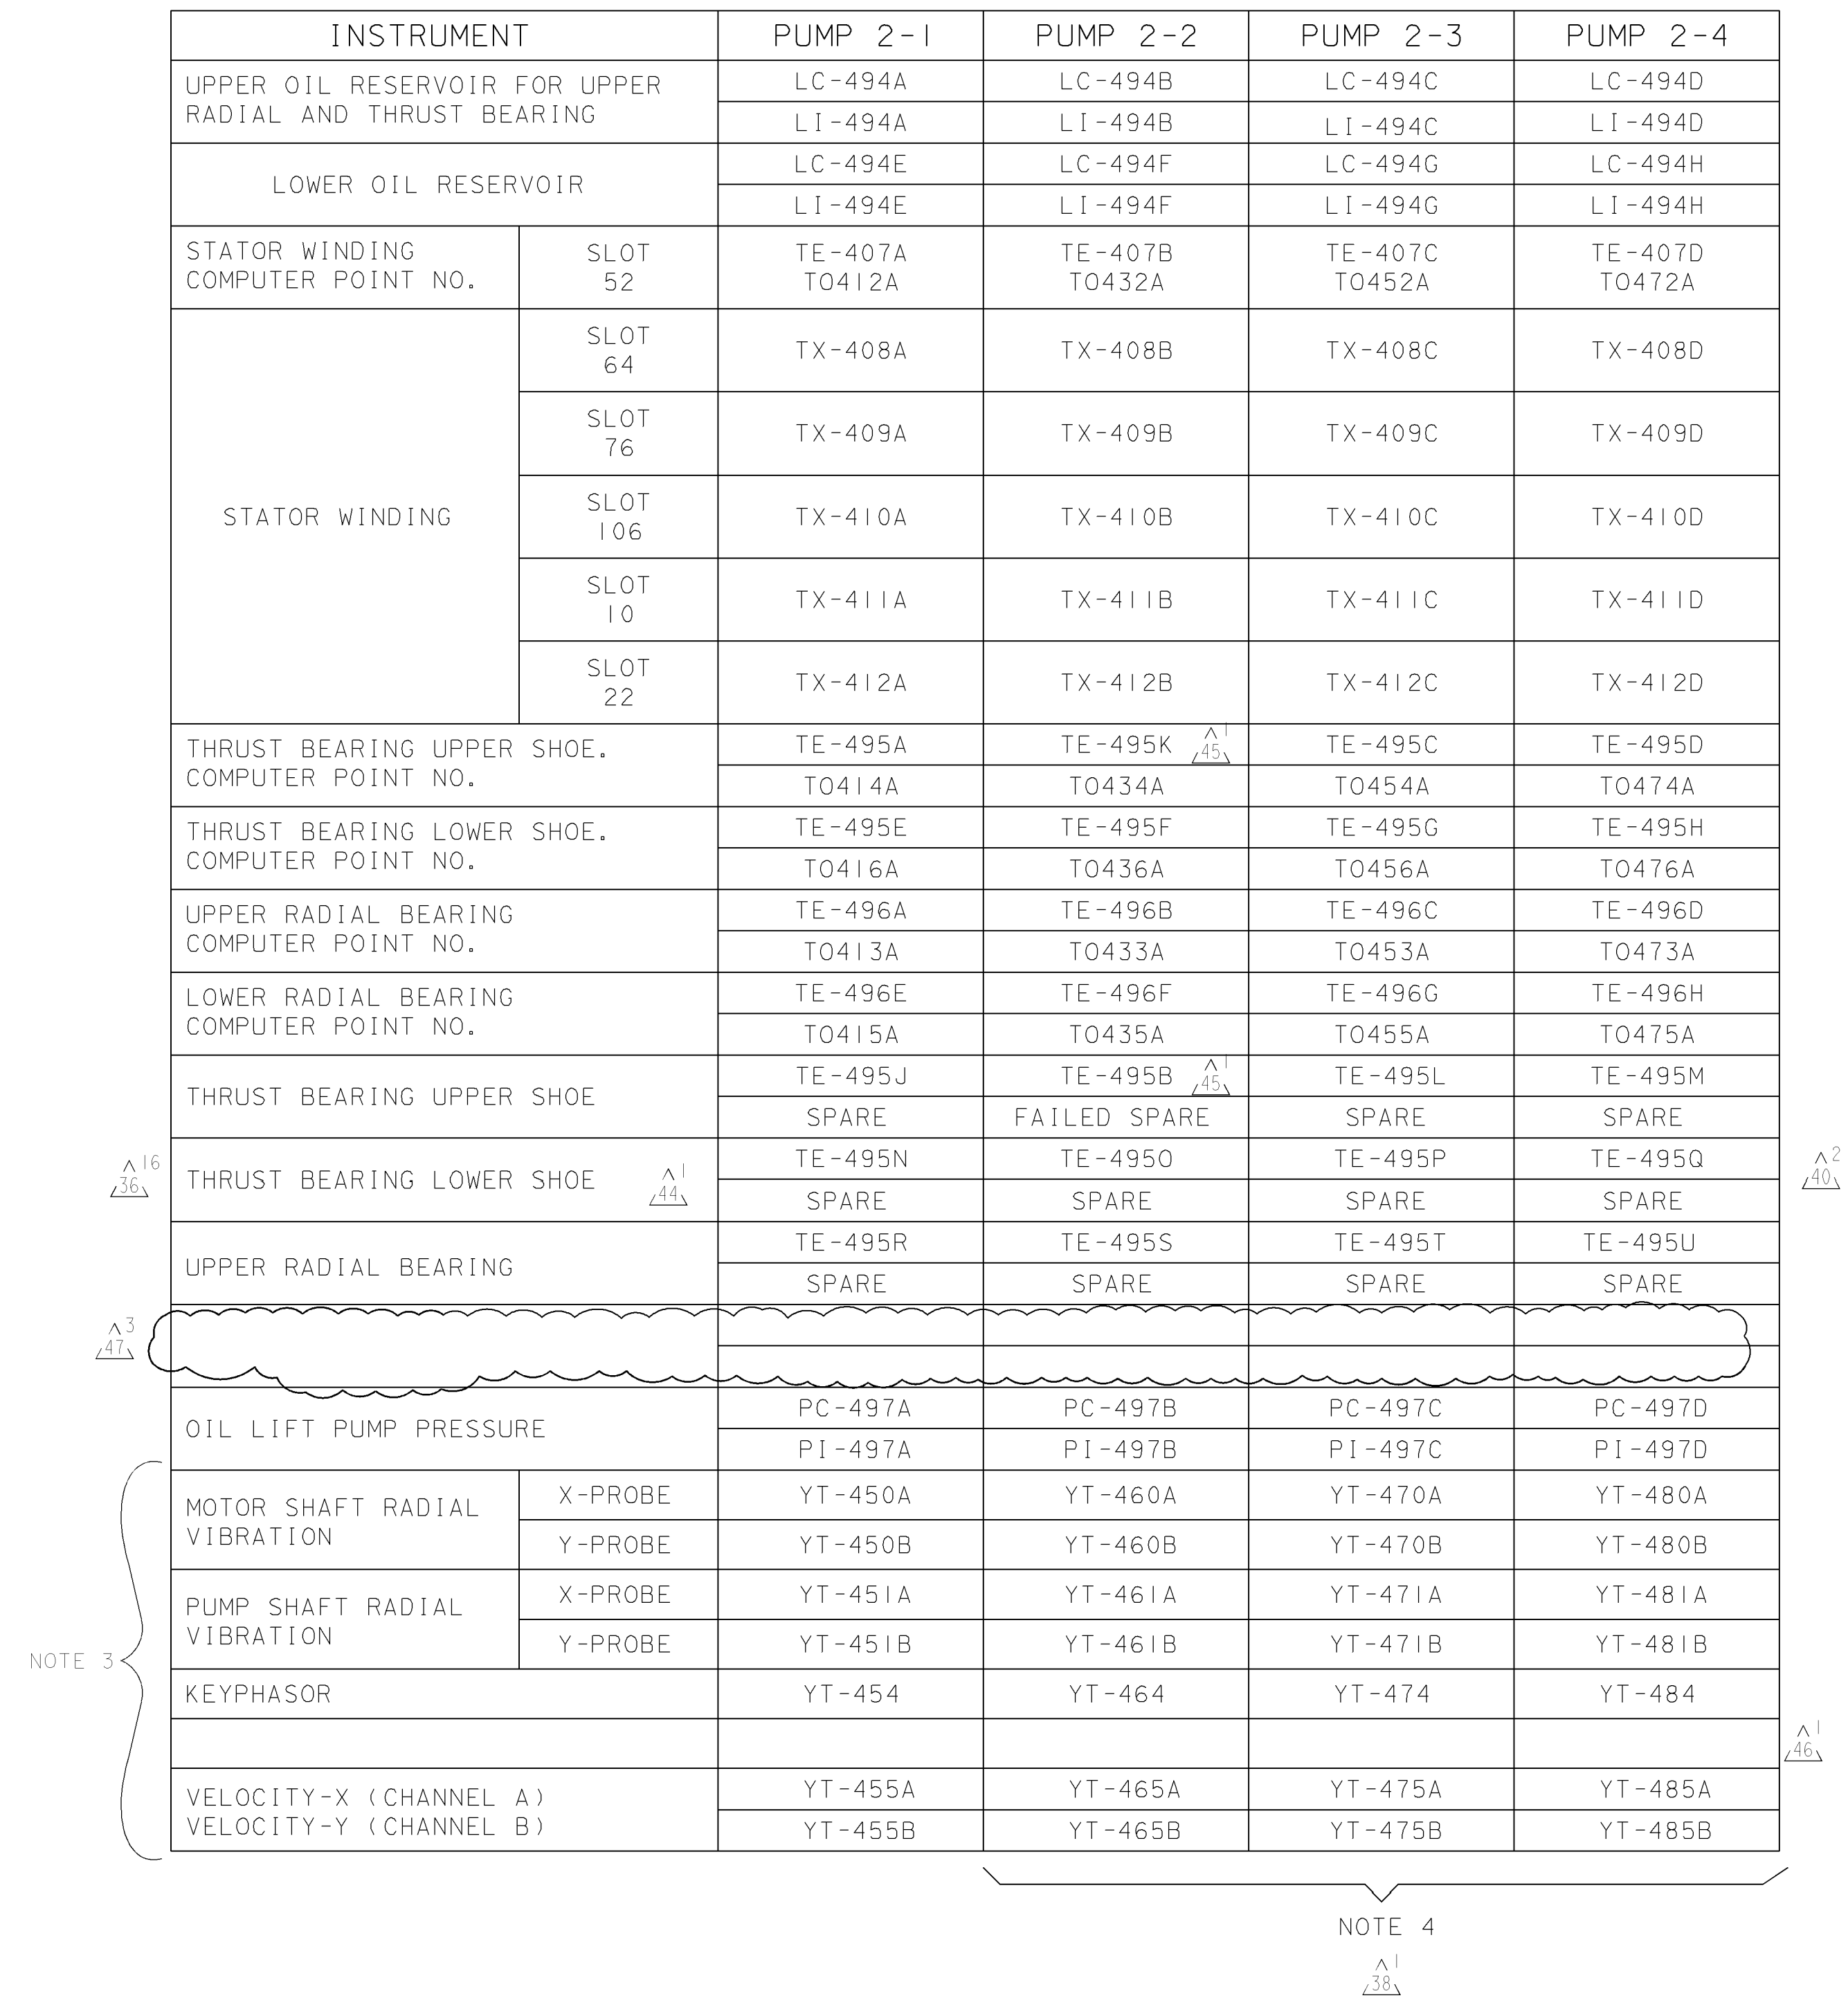

REACTOR COOLANT PUMPS INSTRUMENTATION

NOTES: (CONT'D)

12. 1" GLOBE VALVE, ANCHOR DARLING 1878,
STOCK CODE # 94-3771, DWG. 6006473-157 (30-B), (37-B), (35-B) (33-B)
13. 3/4" GLOBE VALVE, ANCHOR DARLING 1878 GB,
STOCK CODE # 94-2820, DWG. 6006473-97 (32-D), (34-A)
14. 3/4" GLOBE VALVE, ANCHOR DARLING 1878 GB,
STOCK CODE # 95-2755, DWG. 6006473-97 (32-D)
15. 3/4" CHECK VALVE, ANCHOR DARLING 1878 PC,
S/C #95-2427, DWG. 6011930-80 (38-D)
16. 3/4" GLOBE VALVE, ANCHOR DARLING 1878
S/C 95-2755, DWG. 6011930-79 (30-A), (34-A)
17. 3/4" GLOBE VALVE, VELAN W04 9076Z-13AA
S/C 95-1989 DWG. 6011929-3 (32-D)

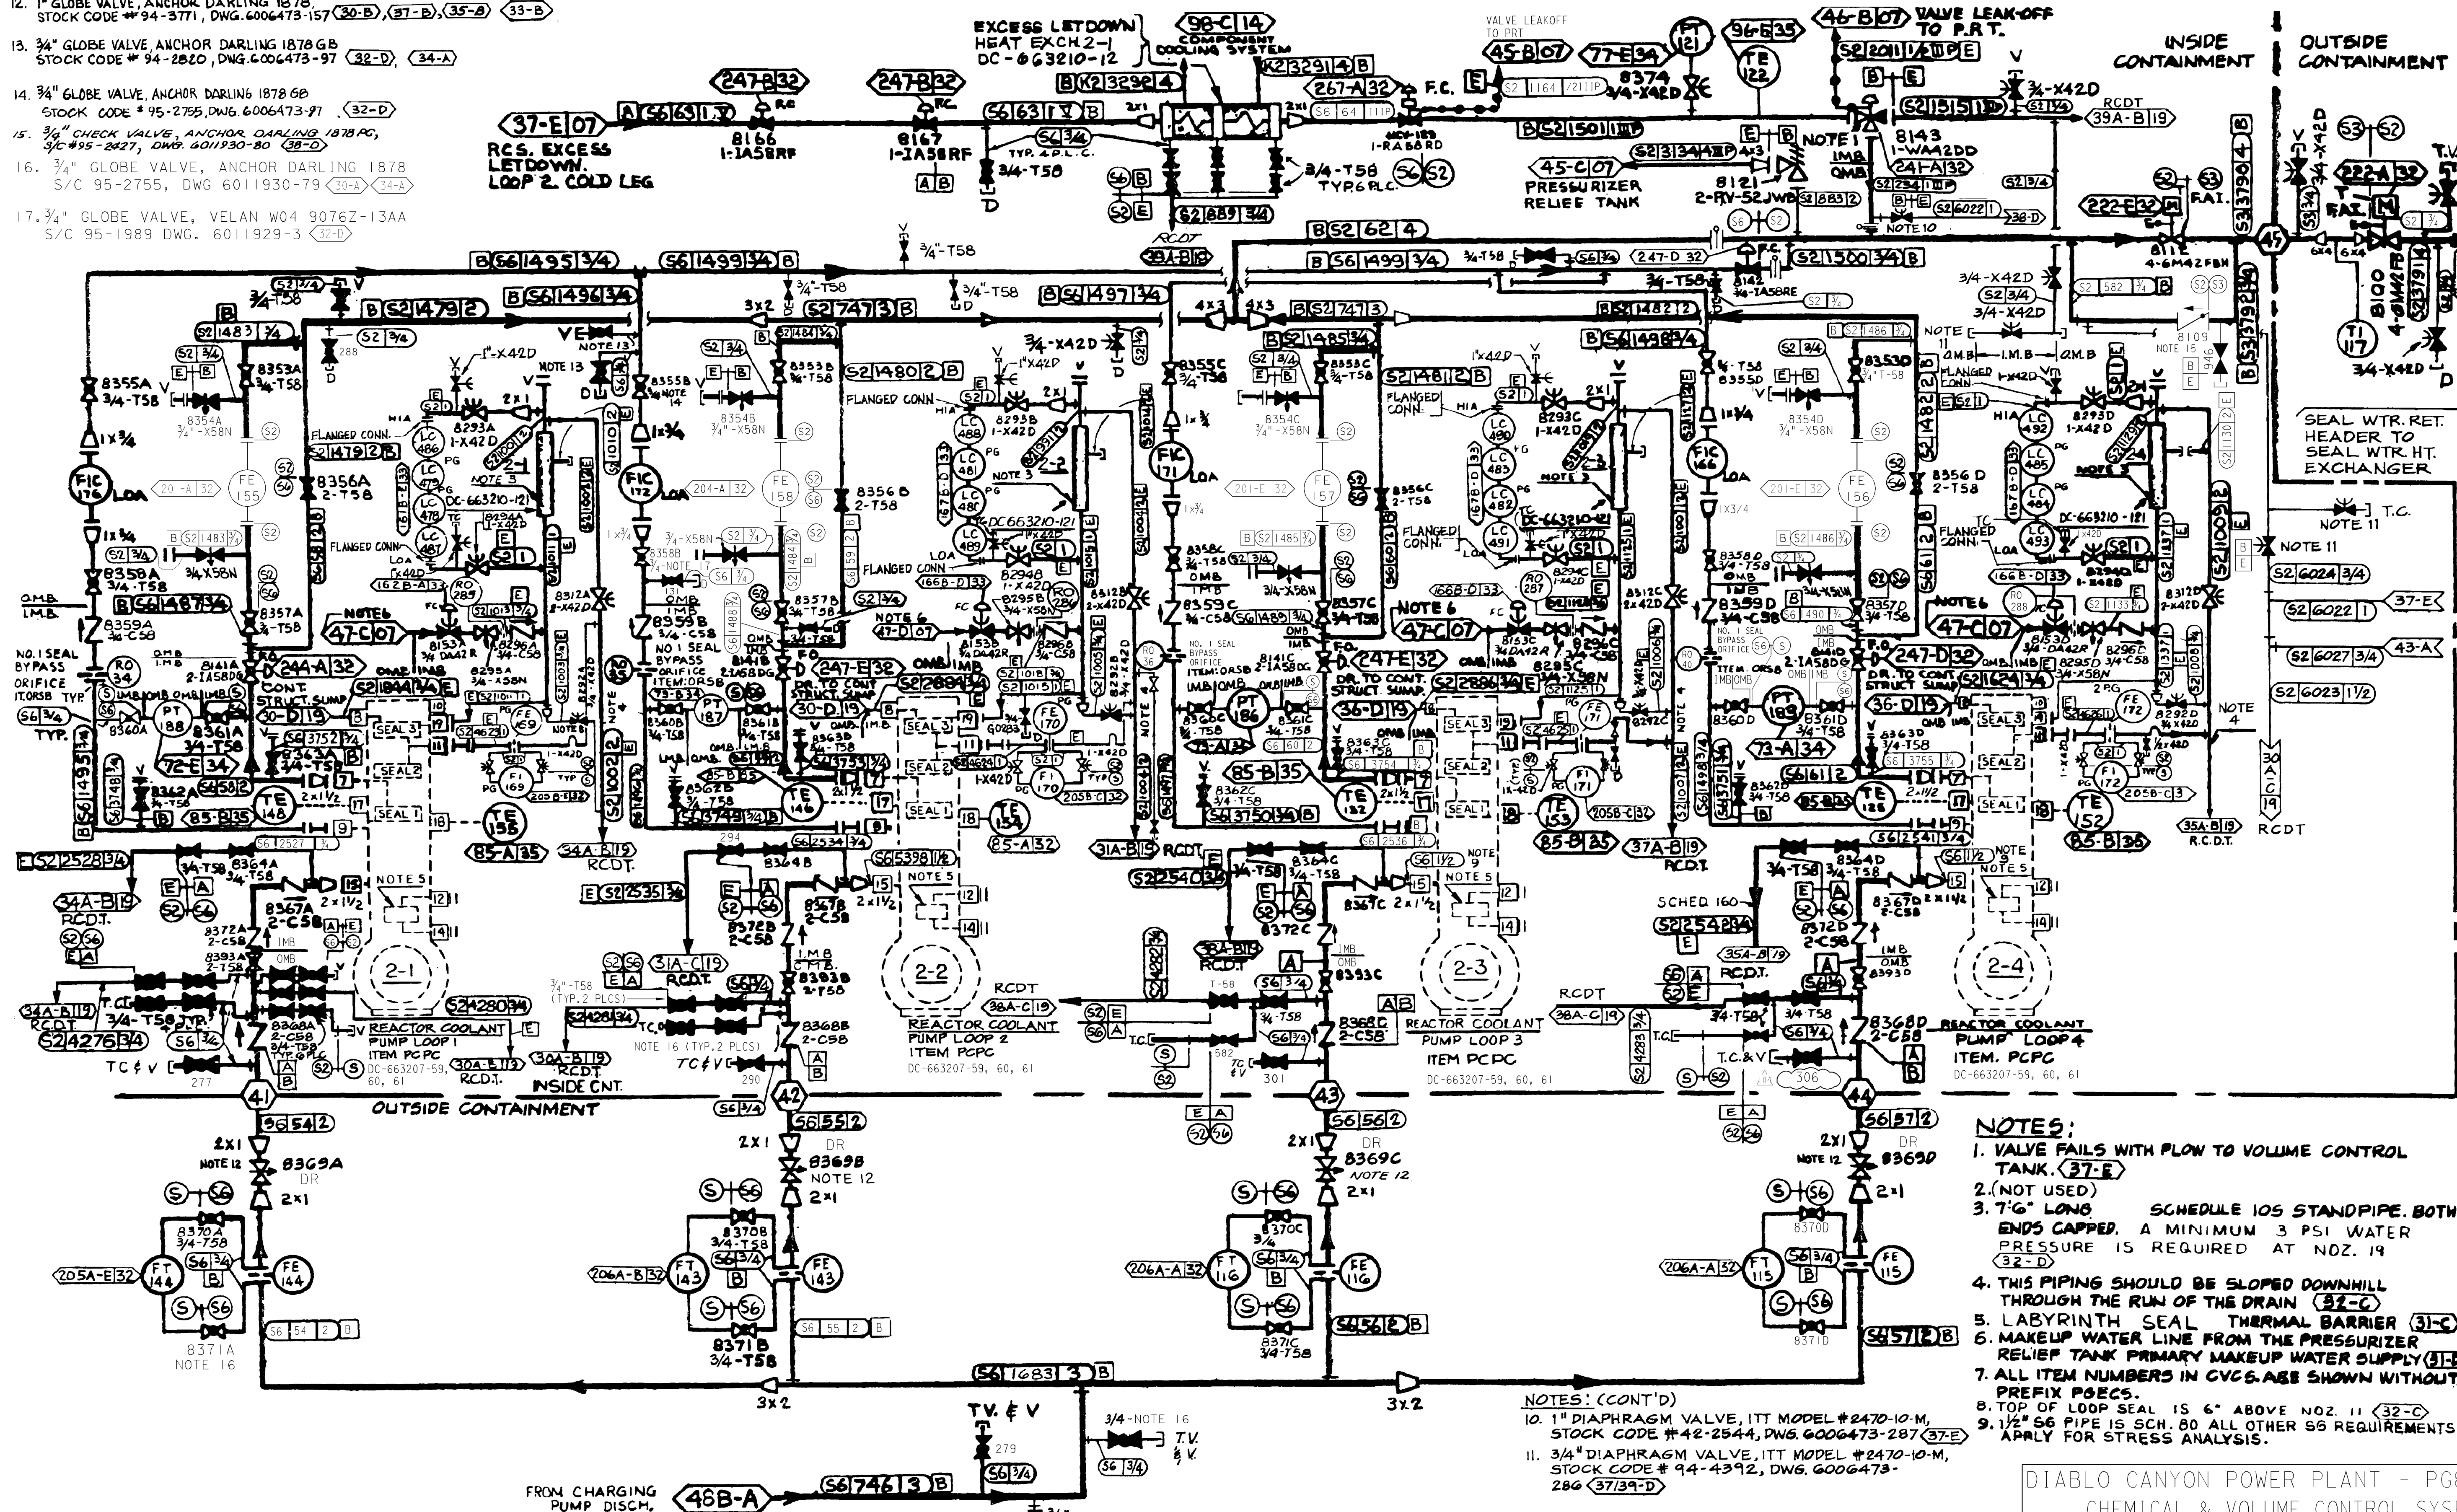

NOTES:

1. VALVE FAILS WITH FLOW TO VOLUME CONTROL TANK. (37-E)
2. (NOT USED)
3. 7'6" LONG. SCHEDULE 105 STANDPIPE. BOTH ENDS CAPPED. A MINIMUM 3 PSI WATER PRESSURE IS REQUIRED AT NOZ. 19 (32-D)
4. THIS PIPING SHOULD BE SLOPED DOWNHILL THROUGH THE RUN OF THE DRAIN (32-C)
5. LABYRINTH SEAL THERMAL BARRIER (31-C)
6. MAKEUP WATER LINE FROM THE PRESSURIZER RELIEF TANK PRIMARY MAKEUP WATER SUPPLY (31-B)
7. ALL ITEM NUMBERS IN CYCLES ARE SHOWN WITHOUT PREFIX PSECS.
8. TOP OF LOOP SEAL IS 6" ABOVE NOZ. 11 (32-C)
9. 1/4" S6 PIPE IS SCH. 80 ALL OTHER S6 REQUIREMENTS APPLY FOR STRESS ANALYSIS.

NOTES: (CONT'D)


10. 1" DIAPHRAGM VALVE, ITT MODEL #2470-10-M, STOCK CODE #42-2544, DWG. 6006473-287 (37-E)
11. 3/4" DIAPHRAGM VALVE, ITT MODEL #2470-10-M, STOCK CODE # 94-4392, DWG. 6006473-286 (37/39-D)

-NOTES CONTINUED ABOVE-

REF. DWG. DC-66320-167

DIABLO CANYON POWER PLANT - PG&E CO.
CHEMICAL & VOLUME CONTROL SYSEM


DRAWING	SHEET	PAGE	REV
108008	3	0	104

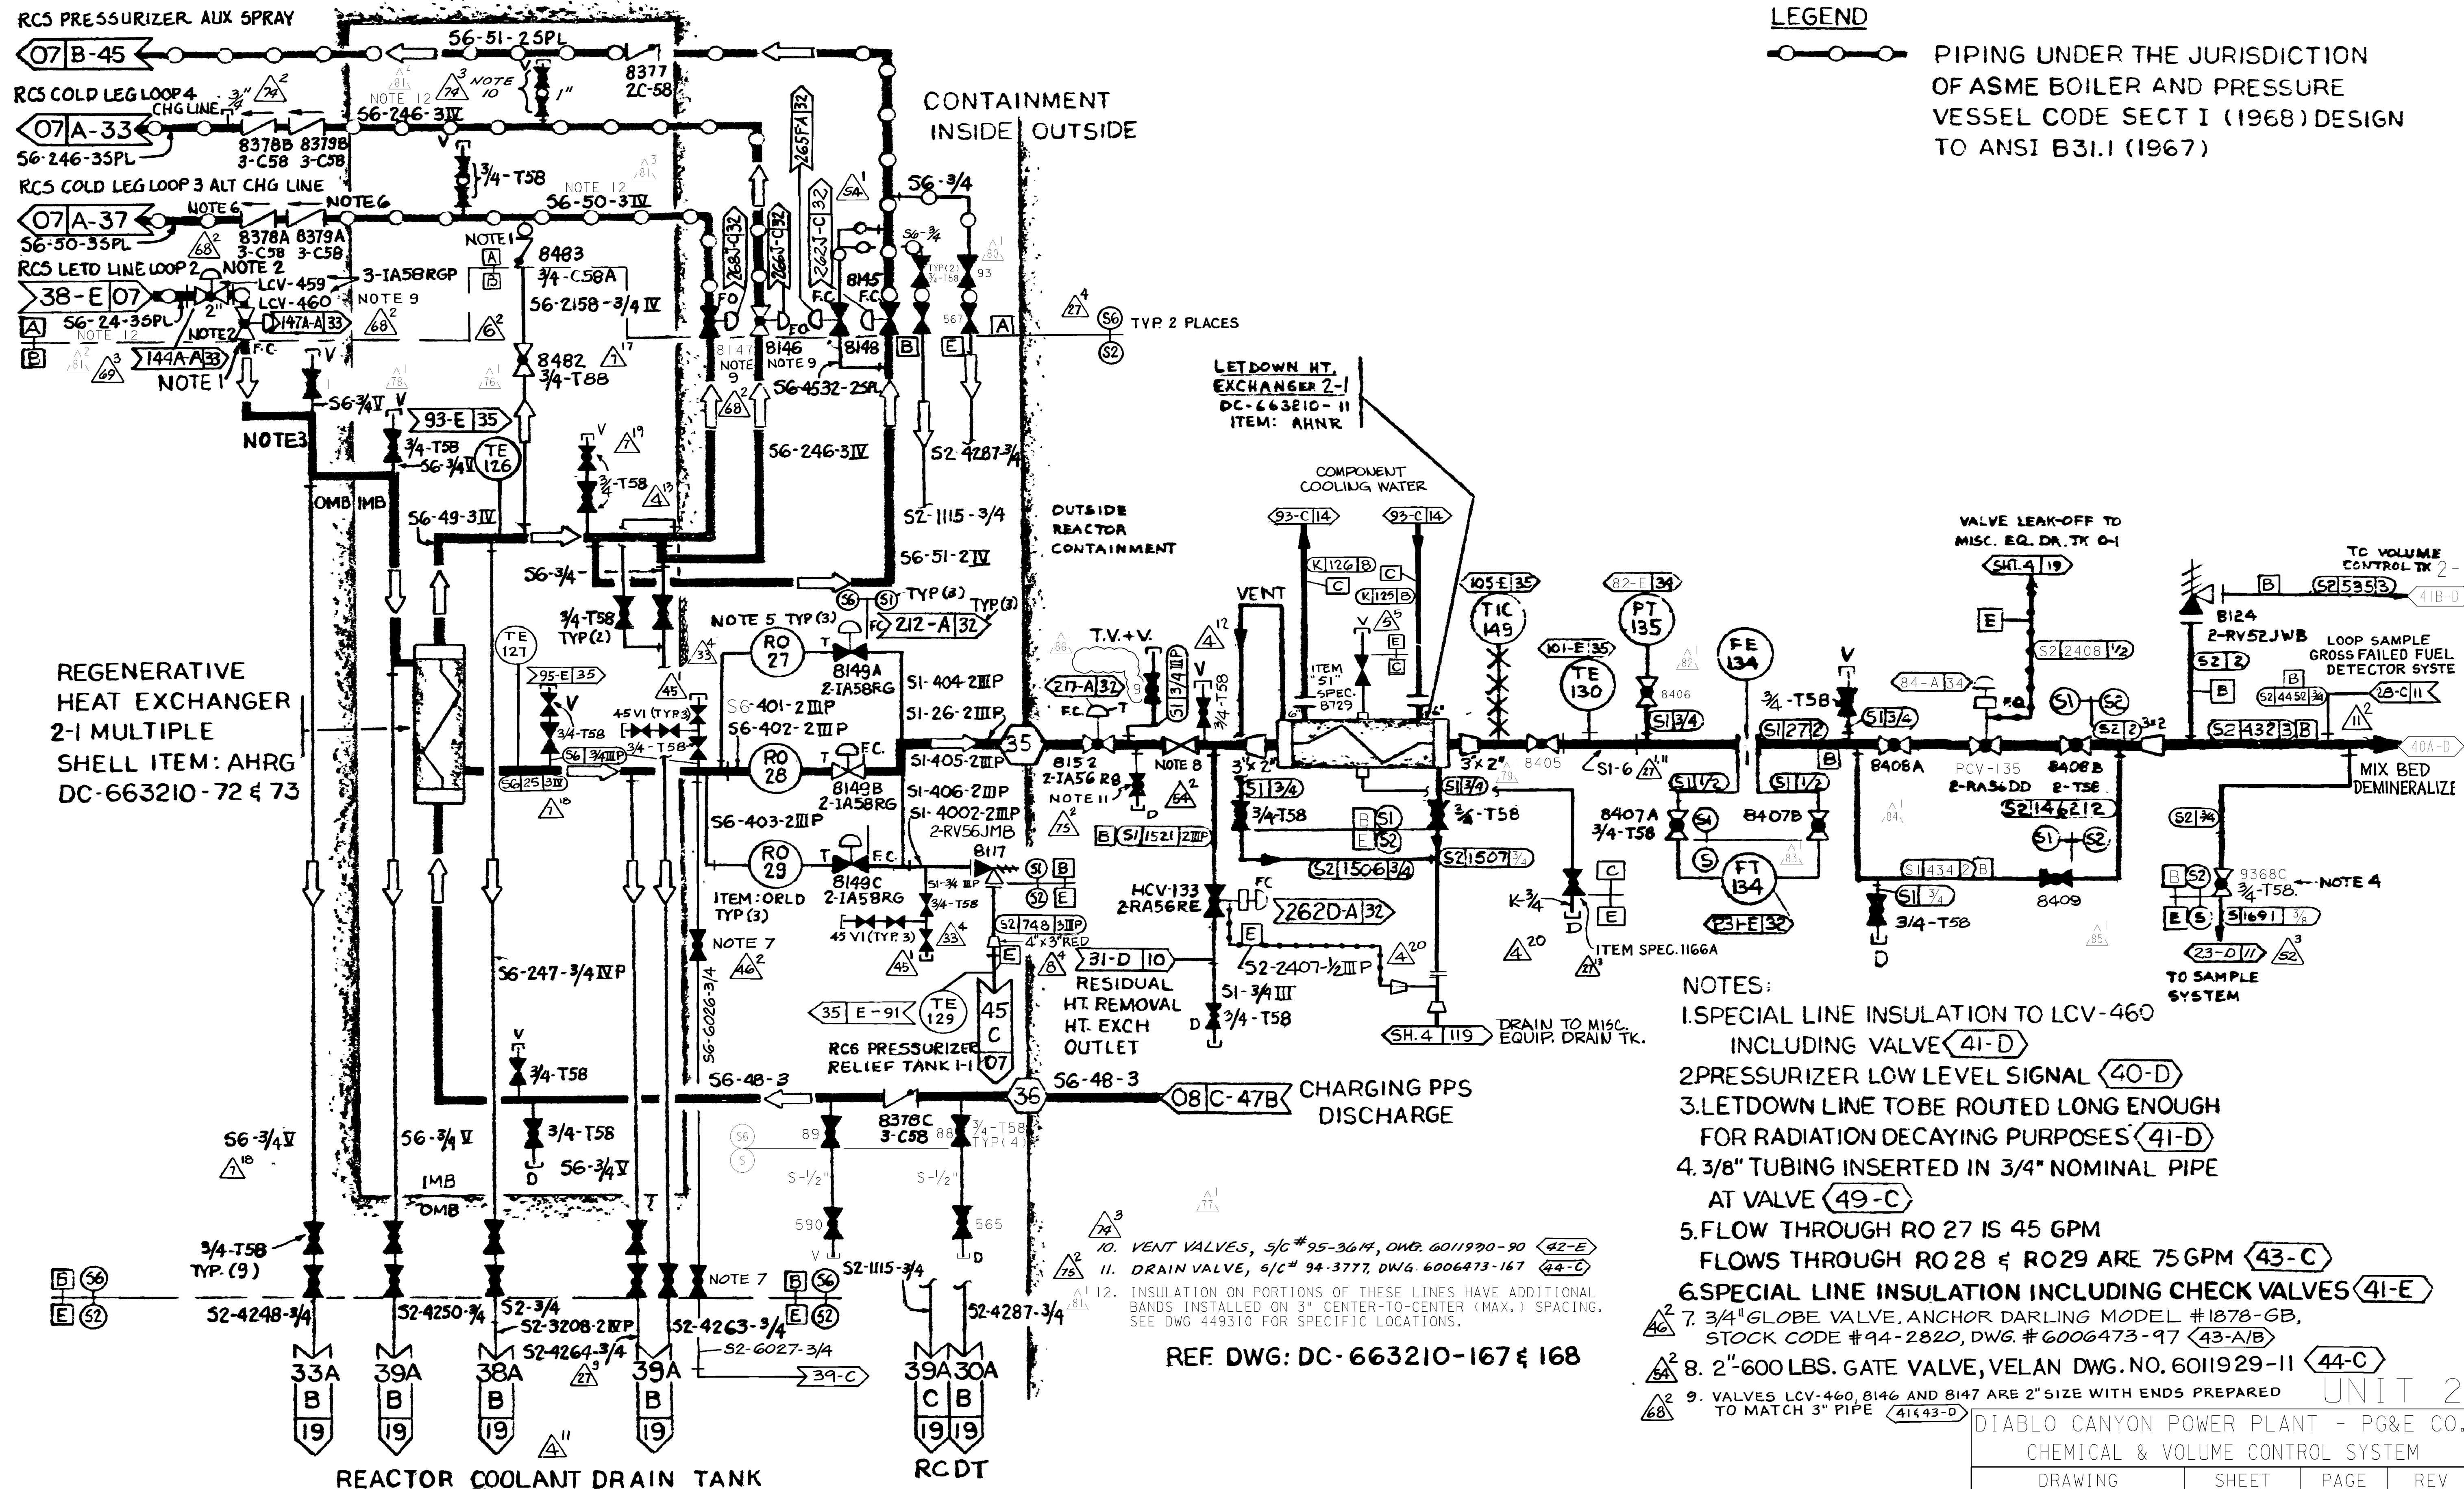

NOTES (CONT'D)

7 REINSTALLED ORIGINAL STYLE HANDWHEELS ON THESE VALVES
47A, 48A - D.C.

PORTABLE RESIN
FILL TK 0-1
ITEM ATRF 01
DC-663210-33
SEE SH.7 (COORD 70-C)

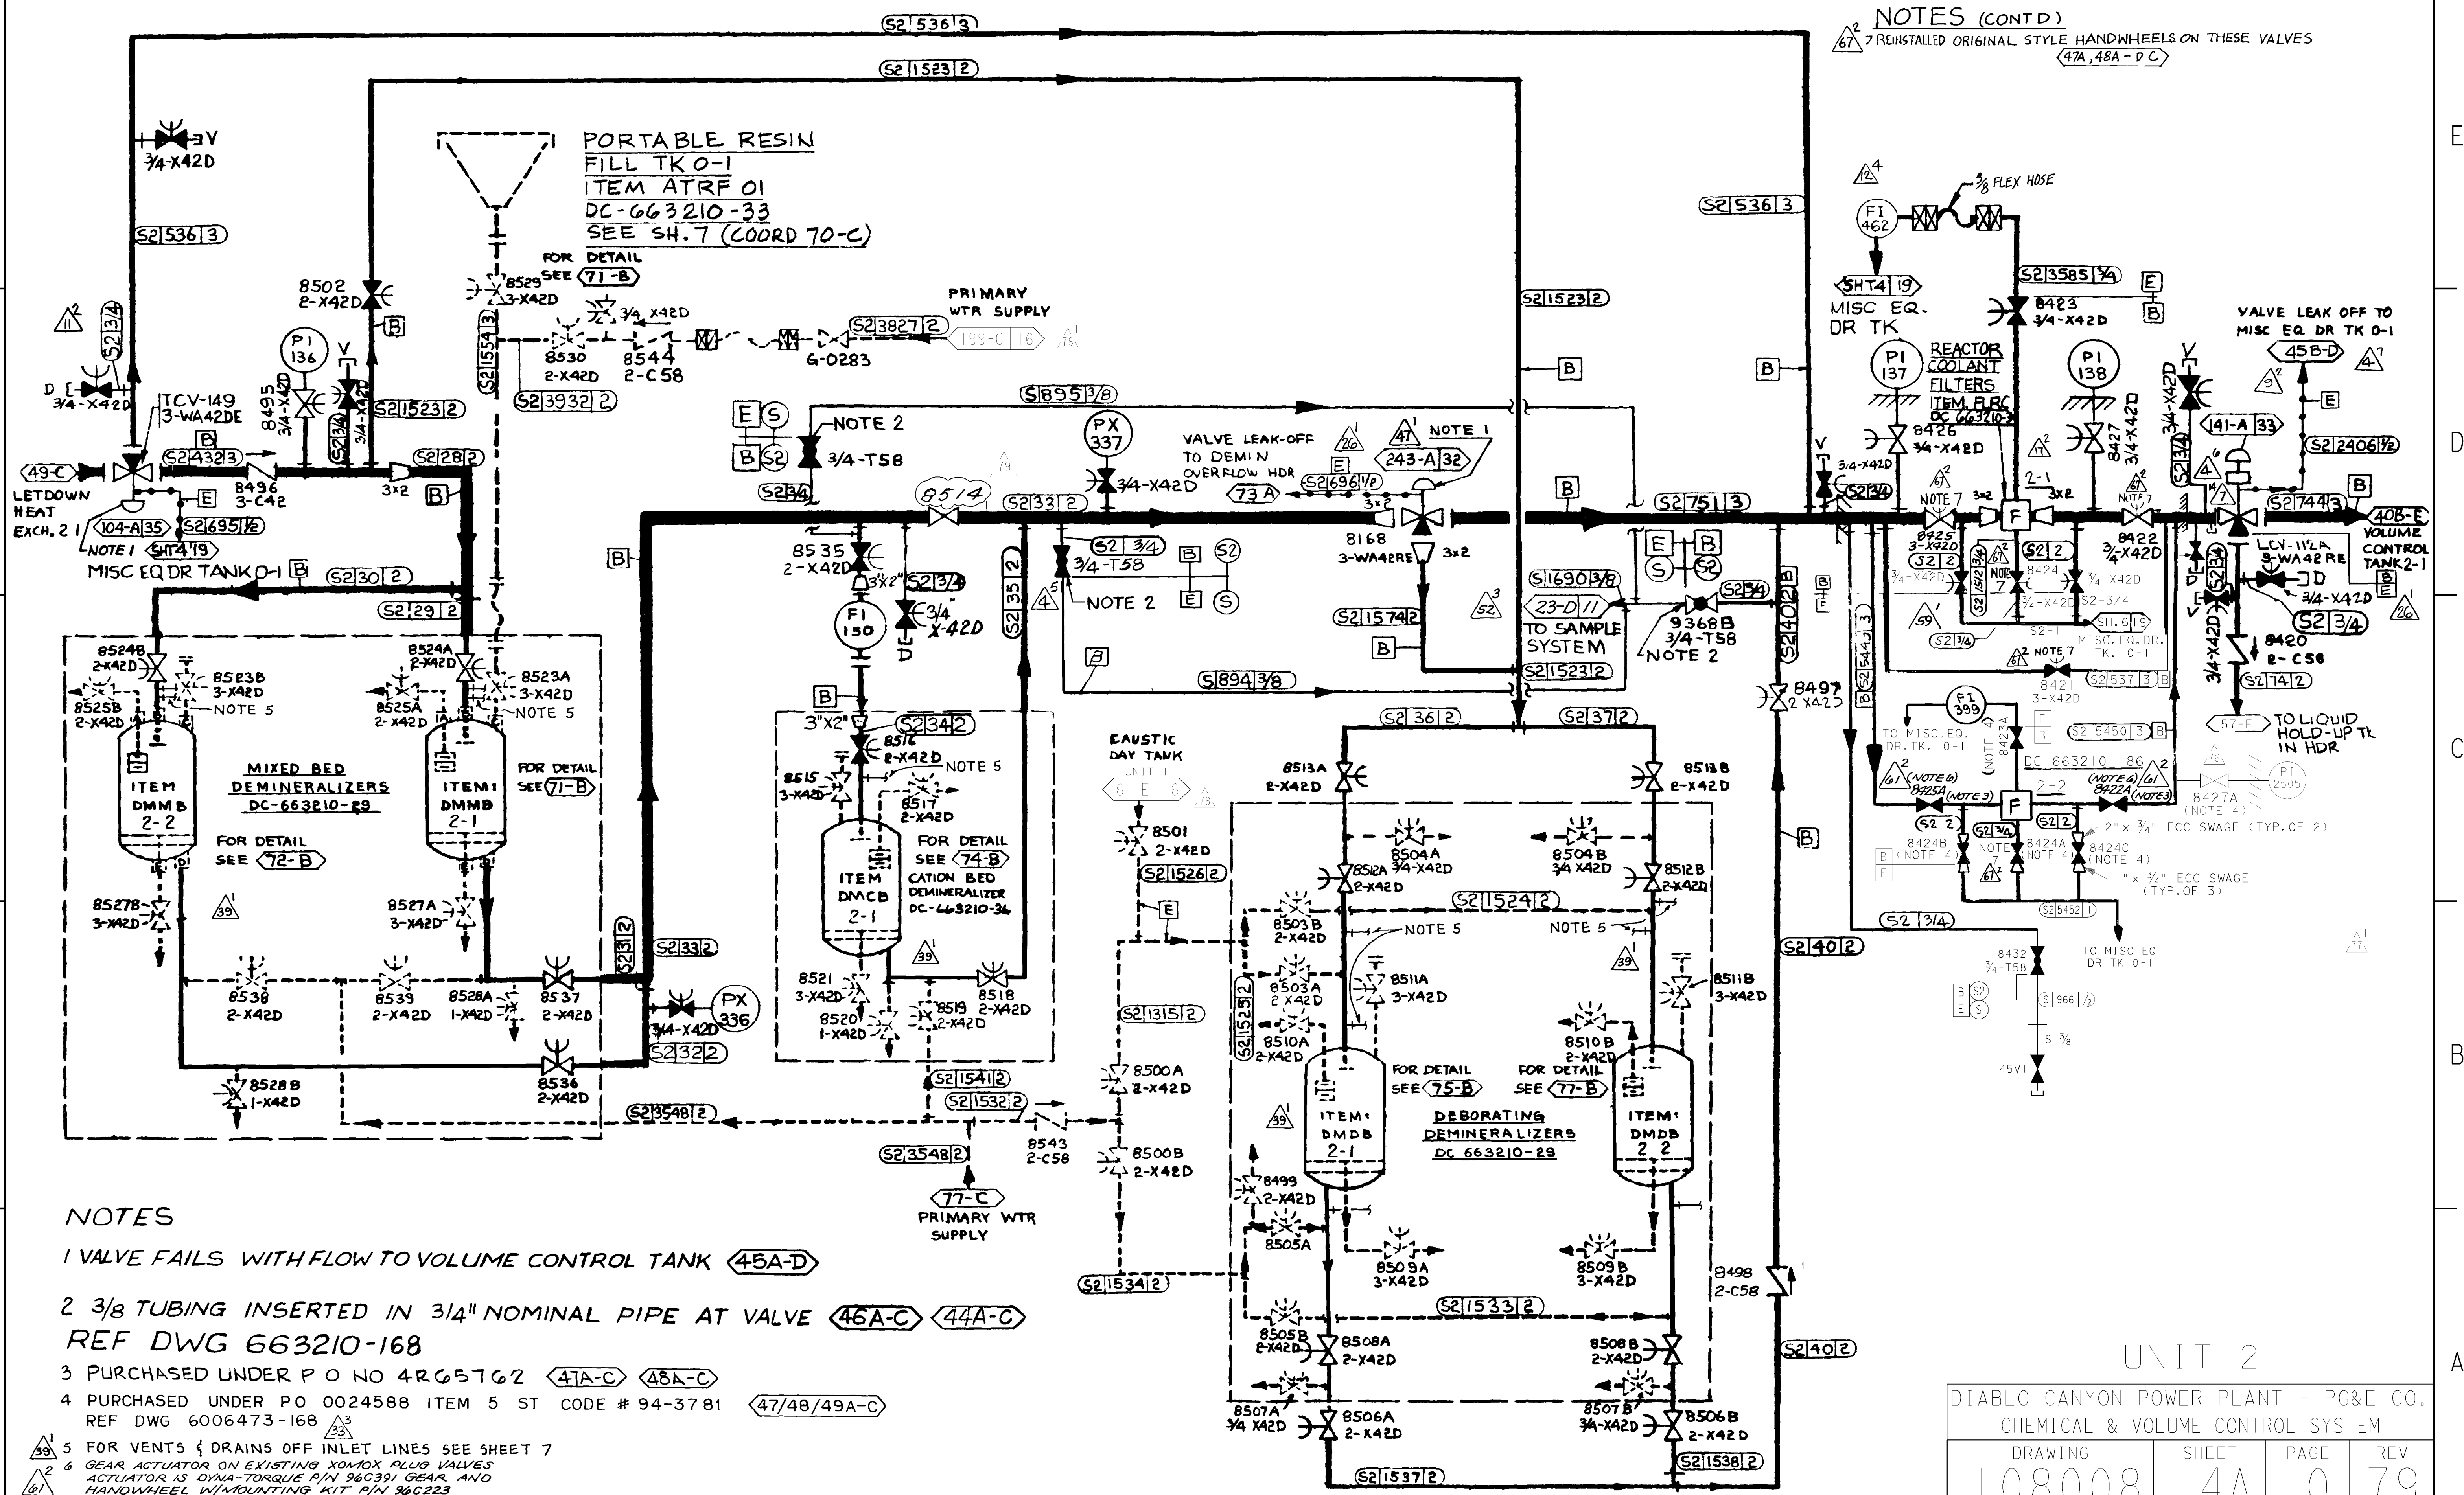

NOTES

- 1 VALVE FAILS WITH FLOW TO VOLUME CONTROL TANK 45A-D
- 2 3/8 TUBING INSERTED IN 3/4" NOMINAL PIPE AT VALVE 46A-C 44A-C
REF DWG 663210-168
- 3 PURCHASED UNDER P O NO 4RG5762 47A-C 48A-C
- 4 PURCHASED UNDER P O 0024588 ITEM 5 ST CODE # 94-3781 47/48/49A-C
REF DWG 6006473-168
- 5 FOR VENTS & DRAINS OFF INLET LINES SEE SHEET 7
- 6 GEAR ACTUATOR ON EXISTING XOMOX PLUG VALVES
ACTUATOR IS DYNA-TORQUE P/N 96C391 GEAR AND
HANDWHEEL W/MOUNTING KIT P/N 96C223


UNIT 2

DIABLO CANYON POWER PLANT - PG&E CO.
CHEMICAL & VOLUME CONTROL SYSTEM

DRAWING	SHEET	PAGE	REV
1080008	4A	0	79

NOTES

1. SPECIAL SPRING LOADED CHECK VALVE (49B-D)
2. TEMPORARY STRAINER IS PLACED IN THE SPOOL PIECE DURING FLUSHING OPERATIONS STRAINER MUST BE REMOVED BEFORE PLANT START-UP (41B-D)
3. 3/8" TUBING INSERTED IN 3/4" NOMINAL PIPE AT VALVE (45B-E)
4. SPECIAL LINE INSULATION, INCL CHK VLV (49B-D)
5. DELETED
6. VALVE ACTUATED AUTOMATICALLY BY GAS ANALYZER 1.6 CHANNEL AC 1067, (44B-E)
7. BALL VALVE, DC-6011927-23, S/C 95-5002 (COORD 43B-B)
8. PIPE BETWEEN LCV-112 B AND LCV-112 C (43B-D) IS SCH 40S PER SPEC 53
9. DASHED LINES INDICATE GUARD ON PIPING (43B-E) GUARD PIPE ON HYDROGEN LINES IS SEISMICALLY QUALIFIED (REF. AR-A0629995 AND A0642979.)
10. ANCHOR/DARLING, MODEL 1878, BOLTED BONNET, GATE VALVE, P O # 722739 ITEM 3, DC 6006473 7 (41B-A)
11. THE SECTION OF LINE S2-733-2III WHICH PENETRATES THE RHR HX ROOM HAS AN ADDITIONAL 2" OF FIBERGLASS INSULATION (43B-B)
12. 3/4" ANCHOR DARLING, MODEL 1878GB, S/C #94 2820 DC 6006473-97 (44B-B) (46B-C) (45B-C)
13. DELETED
14. 3/4-600# VELAN S W GATE VALVE, DC-6006473-167
15. DELETED
16. DELETED
17. DELETED
18. DELETED
19. REINSTALLED ORIGINAL STYLE HANDWHEELS ON THESE VALVES (40B, 41B-D, 46B, 8A)
20. 2" ANCHOR DARLING MODEL 1878 GB, S/C #94-3773 DC-6006473-159 (REACH ROD DETELED) (46B-A)
21. VALVES HCV-142 AND FCV 128 ARE 2 SIZE WITH ENDS PREPARED TO MATCH 3" PIPE (45B-C) (46B-C)
22. VALVE, S/C #95 2755 DWG 6011930 79 (46B-B)
23. DELETED
24. 3/4" VALVES (NORMALLY OPEN) STOCK CODE 94-4955 (42B-C)
25. RESTRICTING ORIFICES RO-43 AND RO-44 RECORD DWG. DC-663210-277 (44B-B) (45B-A)
26. STOCK CODE 77-7585
27. DELETED
28. SPOOL PIECE AND FLANGES ARE "S2" SCH 40.
29. 3/4" -600# GLOBE VALVE (VELAN) S/C 95-5897 (DC 6006473-168). (44B-B)
30. DELETED
31. RO-21 RESTRICTING ORIFICE FOR CCP 2-1 WITH SERIAL NO.49766 (BRAIDWOOD SPARE) IMPELLER ONLY (DWG. 6015597-2)
32. NOZZLE CHECK VALVE FROM FLOWSERVE: DC-6011930-128 (44B-C)
33. THE LTOP PRO ASSEMBLY CONSISTS OF A PRESSURE REDUCING ORIFICE (PRO), A SWAGE-TYPE REDUCER, AND A FLOW BAFFLE PER DRAWING 460584 (45B-C)
34. CCP 2-3 SUCTION PIPING FROM INSIDE THE RHR HX ROOM TO THE PUMP CONNECTION IS S2 PIPE CLASS EXCEPT THE WALL THICKNESS IS SCHEDULE 40S (43B-C)
35. SEE 108008, SHEET 9 FOR PUMP VENTS AND DRAINS (44B-C)
36. QUICK DISCONNECT FITTINGS FOR VENTS IN ACCORDANCE WITH THE MAINTENANCE MODIFICATION PACKAGE (MMP) M000031, REV.4 (44B-C) (45B-C) (2 PLACES)
37. 3/8" THK SS. SPACER
38. REMOVABLE SPOOLS FOR USE OF OVERHEAD MONORAIL (44B-C) (45B-C) (3 PLACES)

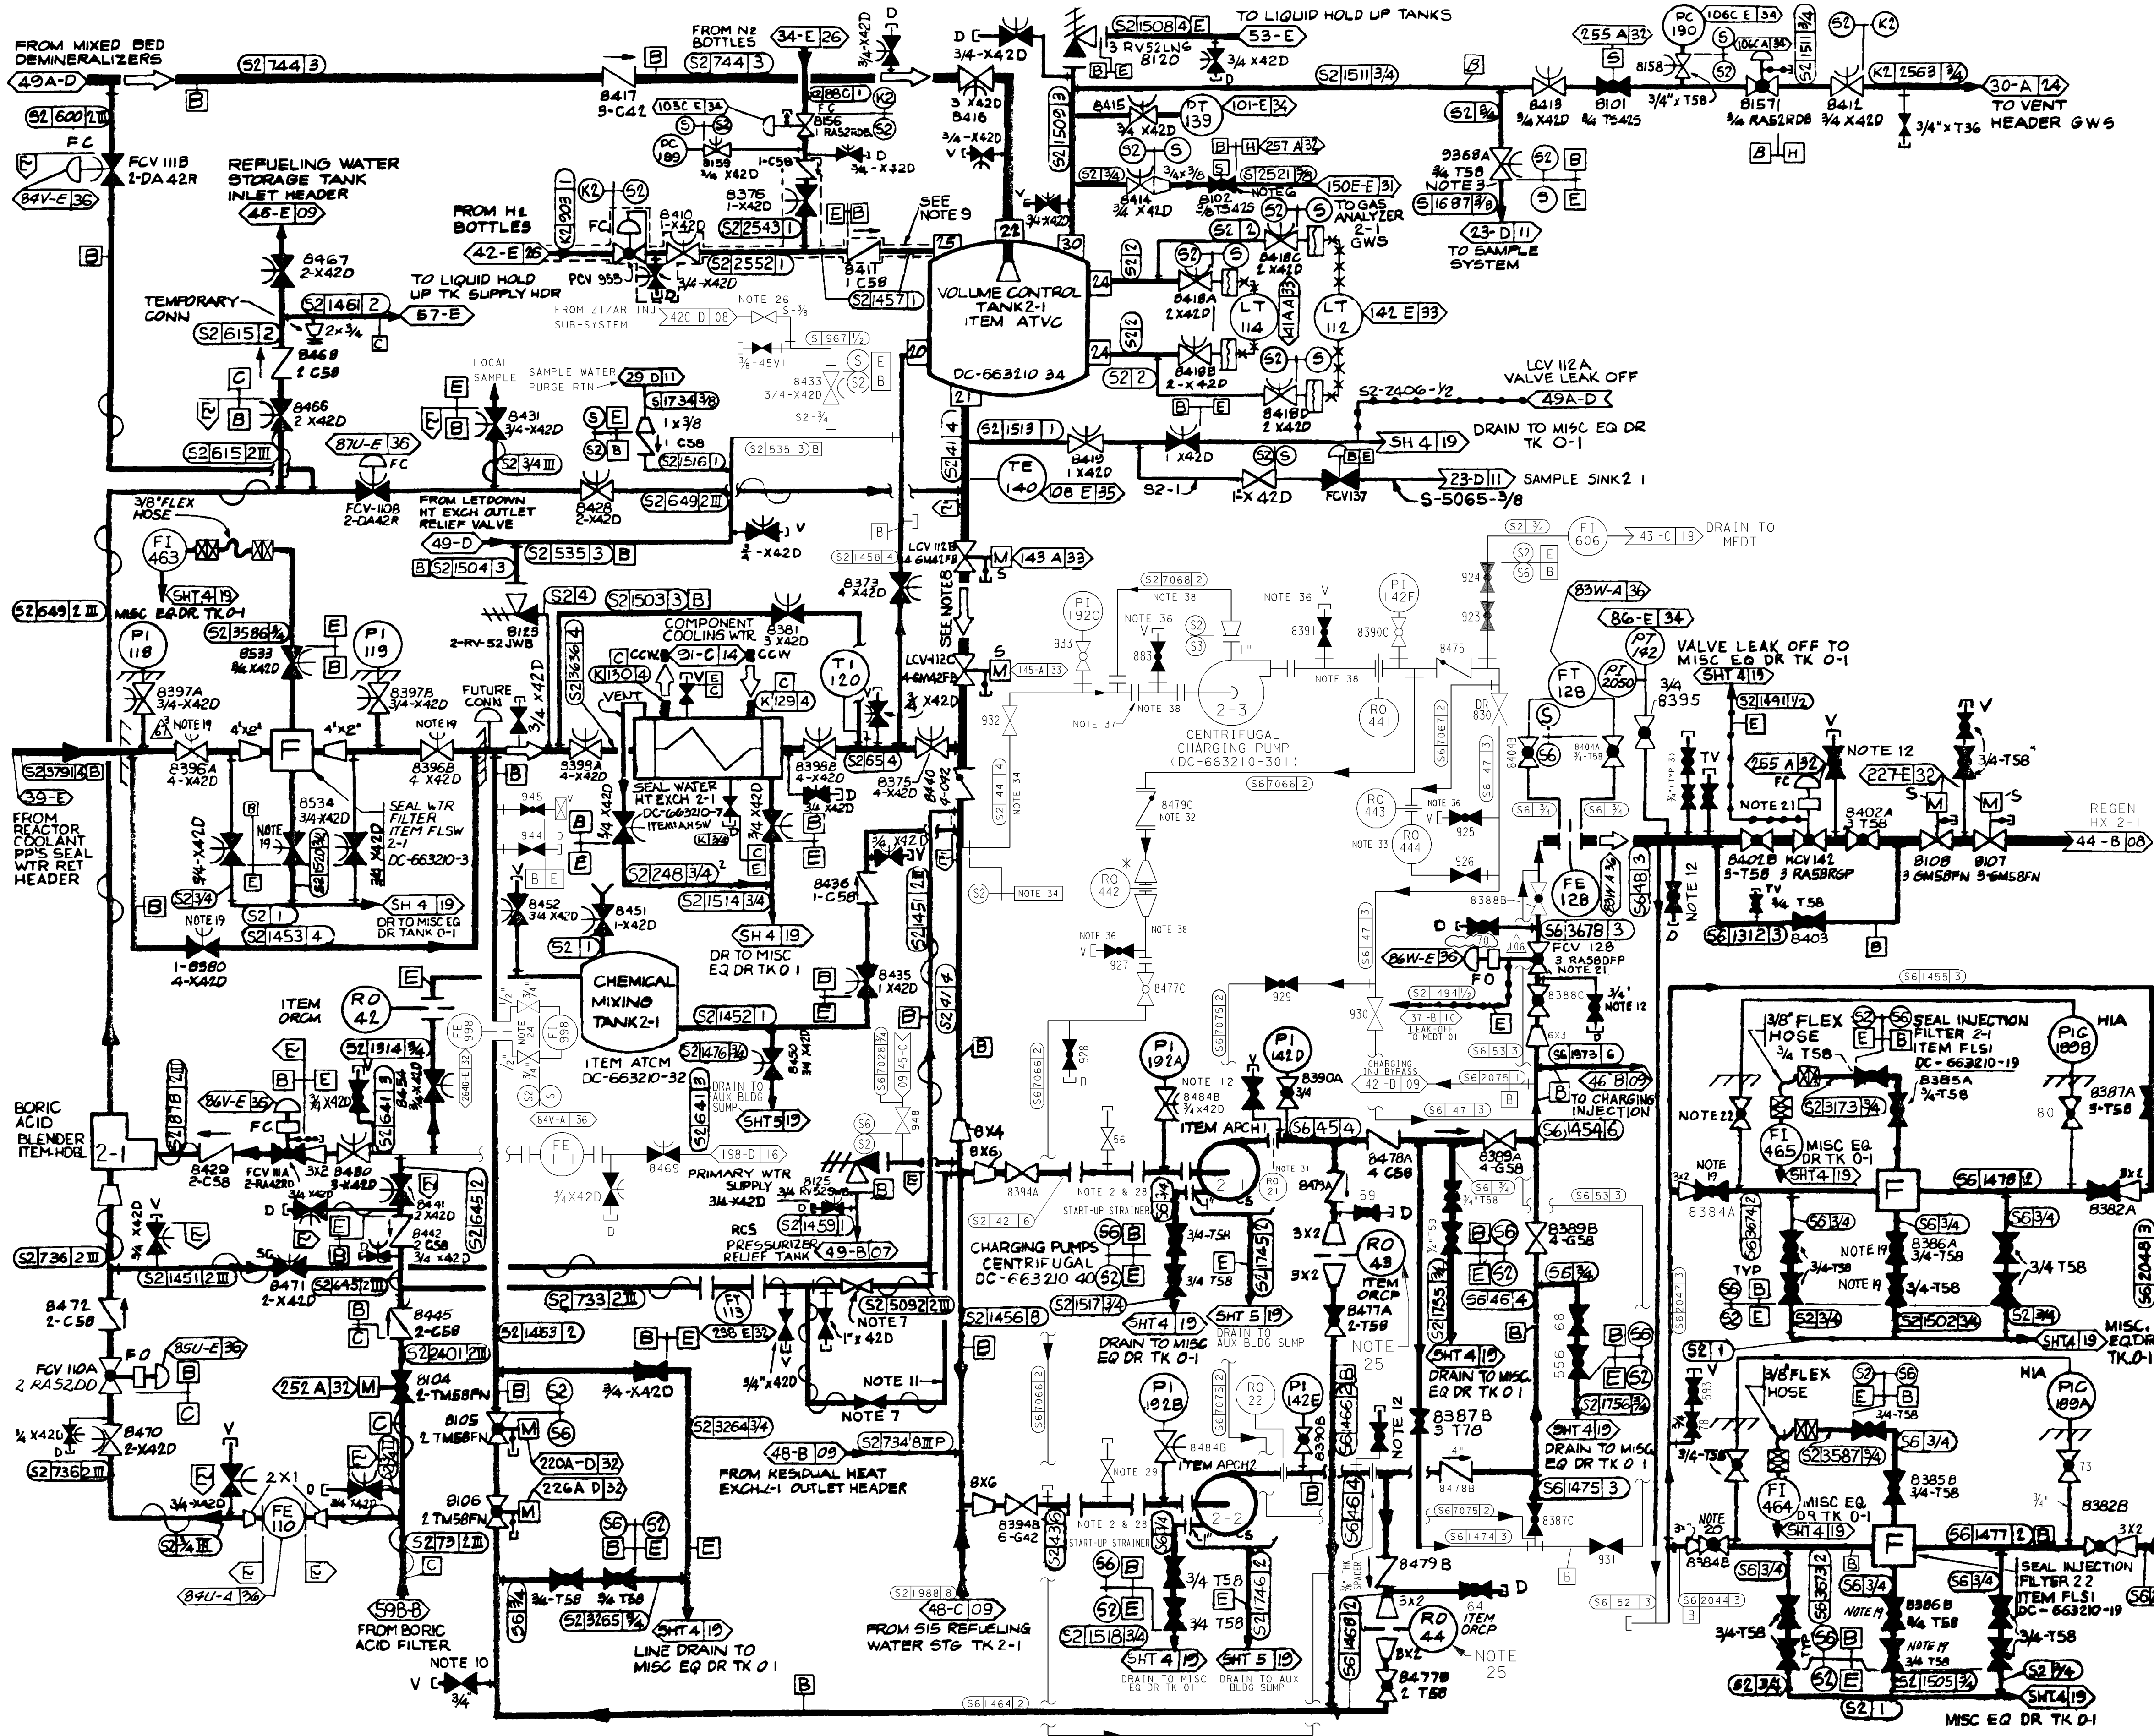


REF DWG 663210-167, -168

UNIT 2

DIABLO CANYON POWER PLANT - PG&E CO.

CHEMICAL & VOLUME CONTROL SYSTEM

DRAWING	SHEET	PAGE	REV
108008	4B	0	106

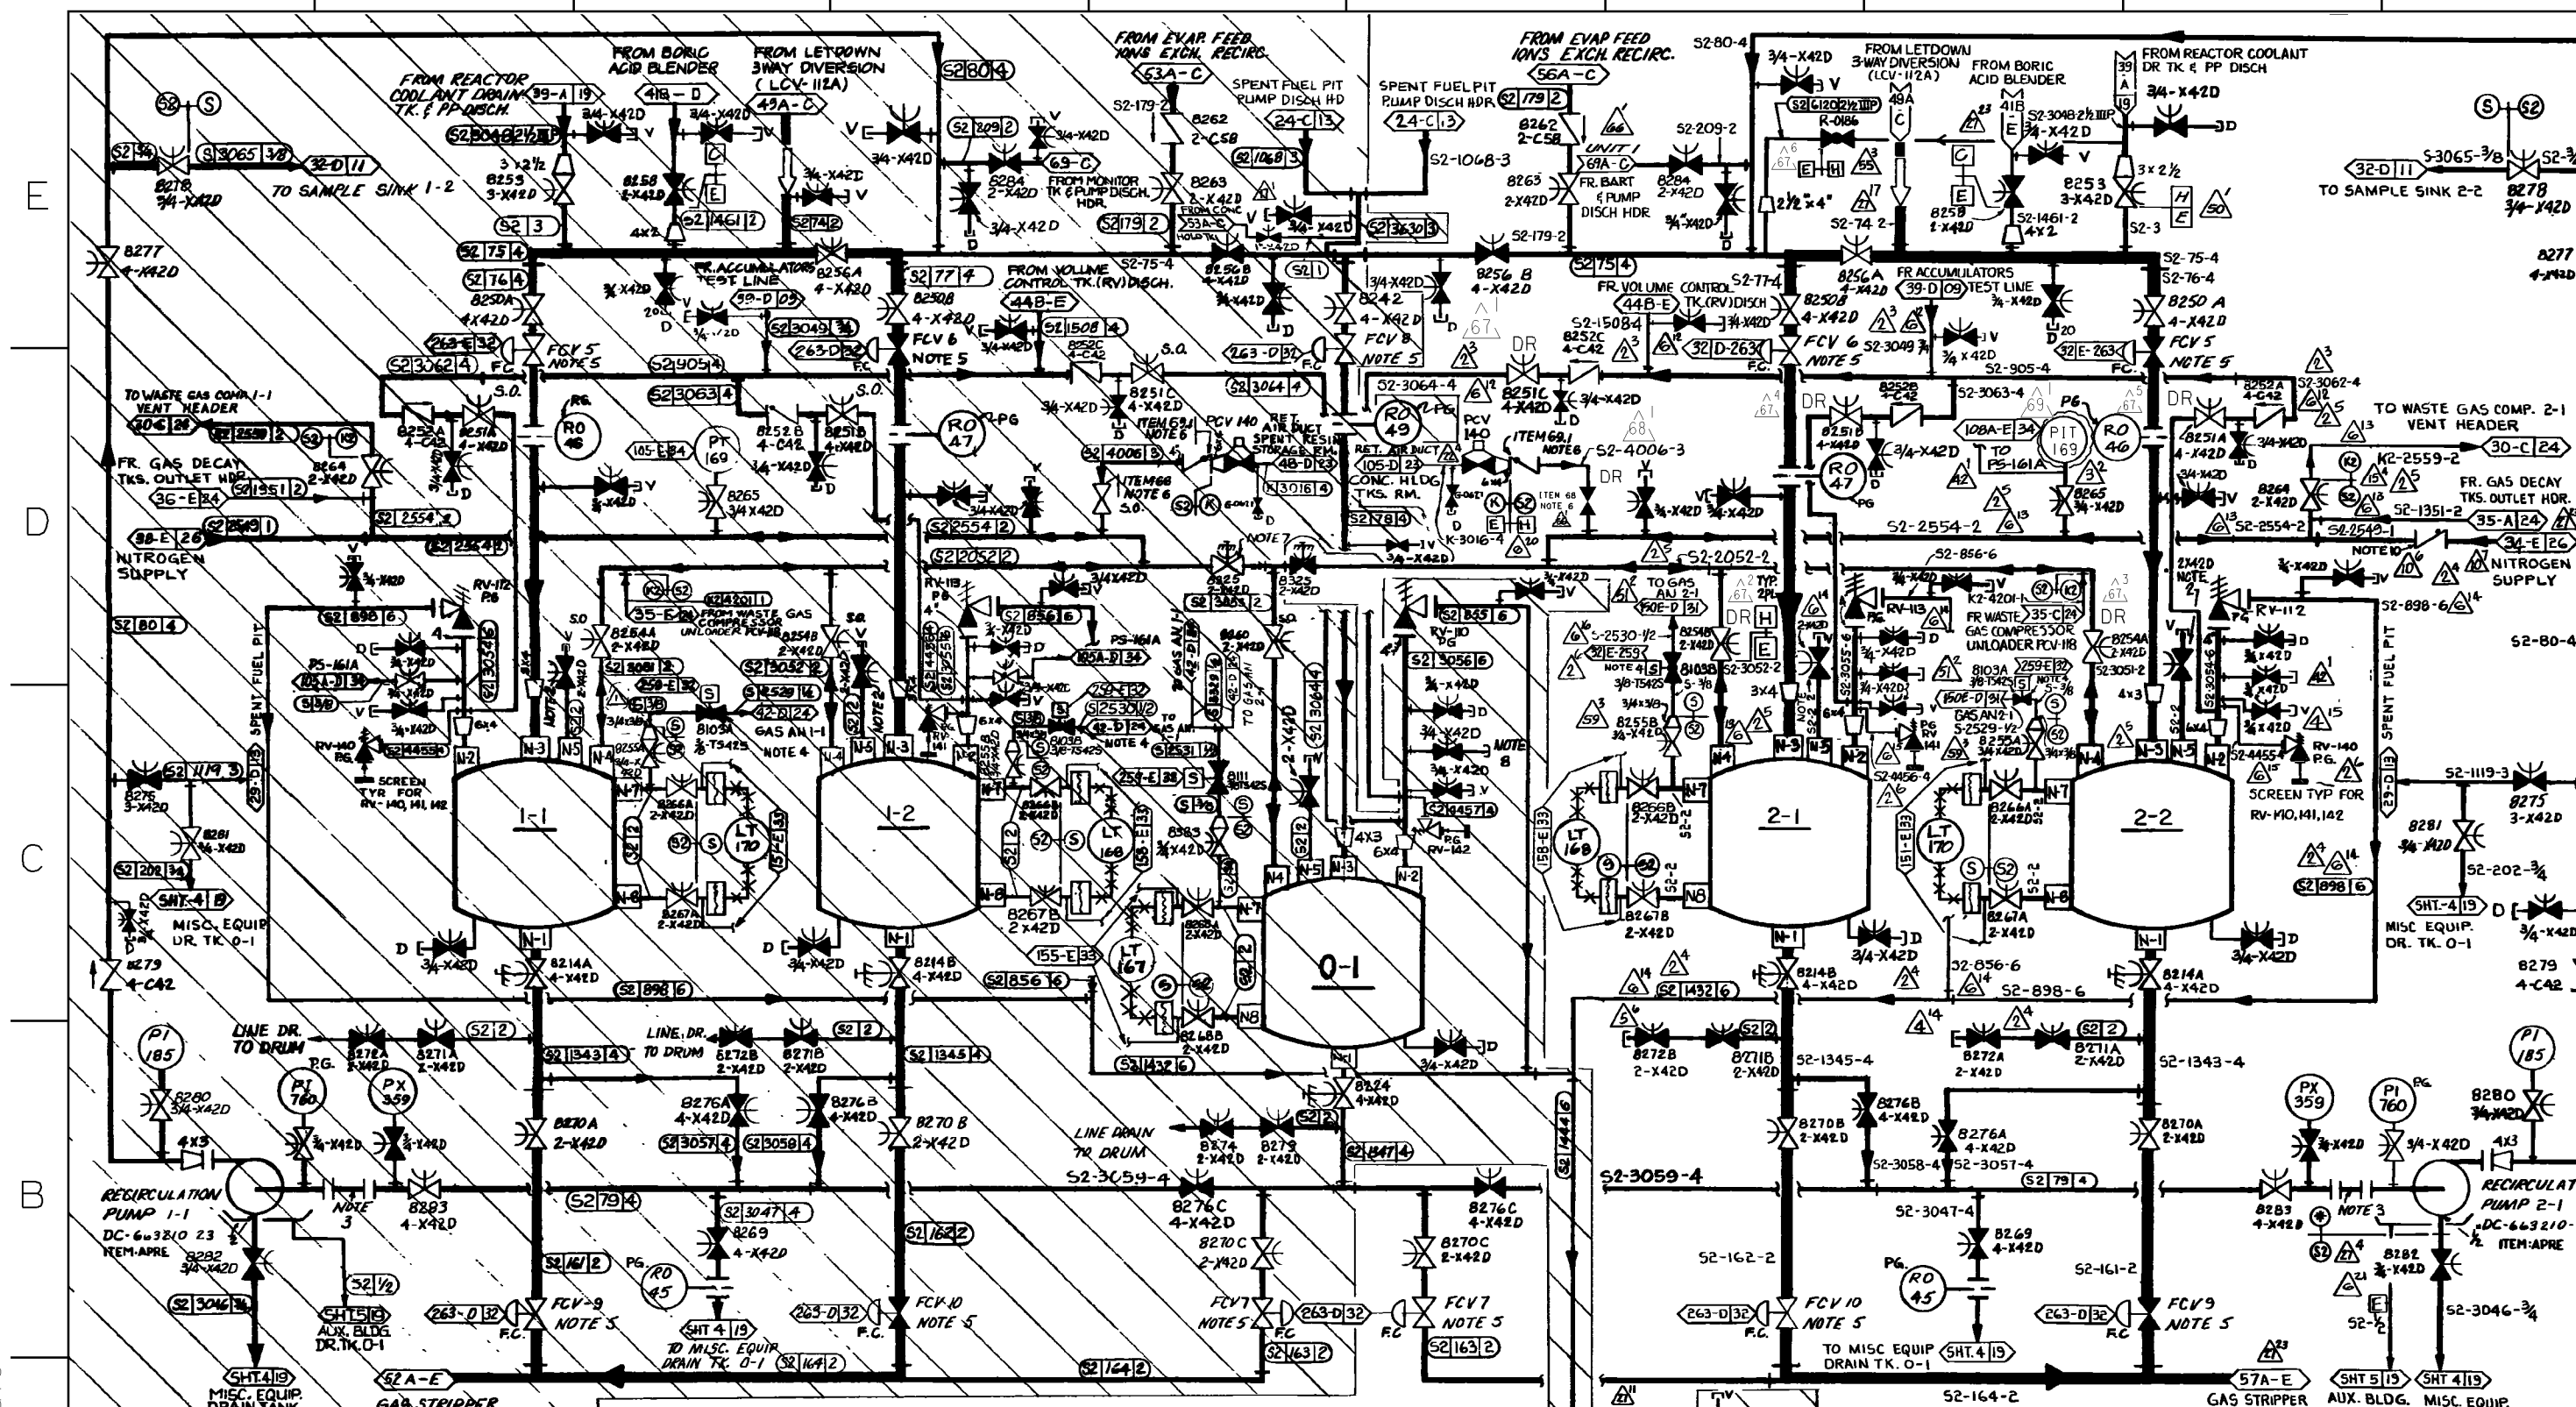

NOTES:

1. TANKS BY PG&E (54-A)

2. TO BE USED FOR START-UP, THEN CAPPED (51-C)

3. TEMPORARY STRAINER IS PLACED IN THE SPOOL PIECE DURING INITIAL FLUSHING OPERATIONS. STRAINER MUST BE REMOVED BEFORE PLANT START UP (51-D)

4. VALVE ACTUATED AUTOMATICALLY BY GAS ANALYZER, IFC CHANNEL NO. AC-1067. (51-C)

5. PG&E VALVES COVERED BY SPEC. 0732. (51-E)

6. PG&E VALVES COVERED BY SPEC. 8729. (54-D)

7. INTERLOCKED REACH RODS WILL BE USED TO ENSURE ONE VALVE REMAINS OPEN AT ALLTIMES. (54-D)

LIQUID HOLD-UP TANKS

NOTE 1 DC-663233-3

8. FUTURE CONNECTION TO PS-161 IF OPERATING CONDITION REQUIRES (55-C)

9. ALL PIPING IS PG&E CLASS E, EXCEPT AS NOTED

10. KEROTEST MODEL 3060B OR EQUIV. 1", 600" CARBON STEEL CHECK VALVE WITH SOFT SEATS (V-TON) FOR GAS SERVICE VALVE TYPE TO BE DOCUMENTED ON AS-BUILT. (50-D)

REF. DWG.: DC-663210-169

UNIT 2

DIABLO CANYON POWER PLANT - PG&E CO.
CHEMICAL & VOLUME CONTROL SYSTEM

DRAWING	SHEET	PAGE	REV
1080008	5	0	69

RASTER=1080008s5.dgn
DGN=1080008s5.dgn
CAD User: AJFJ Date: 07-27-2011

50A

51A

52A

53A

54A

55A

56A

57A

58A

59A

NOTES:

1. FOR DETAILS REFER TO SHEET 5C (52A-B)
2. STRAINER REQUIRES FLANGE AND SUCTION PIPING FLEXIBLE ENOUGH TO FACILITATE INSTALLATION OF PANCAKE STRAINERS FOR START-UP. (51A-E) (54A-C)
3. FOR VENTS & DRAINS OFF INLET LINES SEE SHEET 7
4. SPEC 0722, ITEM 21 (51A-A) (58A-A)
5. ALL PIPING ON THIS DRAWING IS PG&E CODE CLASS E, EXCEPT AS NOTED.
6. BLANK PLATE INSTALLED PER "S2" SPEC, CODE CLASS E. (58A-B)

ABANDONED IN PLACE

REF DWG DC-663210-16


UNIT 2

DIABLO CANYON POWER PLANT - PG&E CO.
CHEMICAL & VOLUME CONTROL SYSTEM

DRAWING	SHEET	PAGE	REV
108008	5A	0	58

RASTER=8008s5a.dgn
DGN=8008s5a.dgn
CAD User: CNHK Date: 07-21-2011INPG1C
1 Size

07-21-2011	CNHK	RxG2		KERSI J. DALAL	MECHANICAL	M 16690	3/31/2012	REVISED PER DFT-7*1265-0
DATE	DWN	RE	IV	PROFESSIONAL ENGINEER	PE DISC.	PE#	PE EXP.	

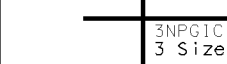

RASTER=erui0634.DGN
DGN=erui0634.DGN
CAD User: AJFJ Date: 04-22-2011

E
D
C
B
A

50C

51C

52C

53C

54C

55C

56C

57C

58C

59C

UNIT-2 BORIC ACID EVAPORATOR

ABANDONED IN PLACE

STRIPPING COLUMN

ABSORPTION TOWER

PRIMARY WATER SUP.

PRIMARY WATER SUP.

PRIMARY WTR SUP

AUX STEAM

VENT TO ATM.

PRIMARY WTR SUP

VENT CONDENSER (NOTE 6)

NITROGEN SUP.

FEED PREHEATER

AUX STEAM DRAIN RECEIVER 0-1

EVAPORATOR 2-1 CONDENSER

EVAPORATOR 2-1

VENT TO ATM.

PRIMARY WTR SUP.

FLUSH CONNECTION

BORIC ACID EVAP. DRIP POT

BORIC ACID CONCENTRATE PUMPS

PRIMARY WTR SUP.

CONC. HOLDING TANK 0-1

DISTILLATE PUMPS

DISTILLATE COOLER (NOTE 8)

EVAP. COND. DEMIN. INLET

NOTES:

1. STRAINERS REQUIRE FLANGE AND SUCTION PIPING FLEXIBLE ENOUGH TO FACILITATE INSTALLATION OF PANCAKE STRAINERS FOR START-UP.
2. THIS SYSTEM IS PROVIDED AS A PACKAGE AND SUPPLIED BY WESTINGHOUSE. SEE DC-663210-148 FOR PIPING AND VALVE SPECS. INCLUDED IN THE EQUIPMENT SKID ASSEMBLY.
3. FOR REF. NOS. INDICATED BY "SEE REF. DWG. DC-663210-02".
4. ALL VALVE WITH ITEM NUMBERS TO BE UNDER SPEC. 0722.
5. 3/8" TUBING INSERTED IN 3/4" NOMINAL PIPE AT VALVE. (56C-2)
6. HIGH POINT LOOP IN LINE 2561 TO PREVENT LIQUID FROM ENTERING VENT HEADER (57C-E).
7. ALL PIPING SHOWN ON THIS SHEET SHALL BE CLASS "E" EXCEPT AS NOTED.
8. VENT CONDENSER, EVAPORATOR CONDENSER AND DISTILLATE COOLER ARE DESIGN CLASS II AND ARE SEISMICALLY ANALYZED BY THE SUPPLIER.
9. SAMPLE COOLER 47 IS DESIGN CLASS II AND IS SEISMICALLY ANALYZED PER DESIGN CRITERIA MEMORANDUM M-G1.
10. DRAGON MODEL 500F 3/8" GLOBE VALVE, 45V OR EQUIVALENT. (59C-2)
11. HCV-740 IS A XOMOX MODEL 126SW-3/4" WITH XOMOX 7 SLFEE. (54C-B)
12. RV-54 RUPTURE DISK INTERNAL REMOVED.
13. THESE VALVE INTENTIONALLY LEFT OPEN & UNCAPPED.

DIABLO CANYON POWER PLANT - PG&E CO.
CHEMICAL & VOLUME CONTROL SYSTEM


DRAWING	SHEET	PAGE	REV
1080008	5C	0	73

UNIT 2

AUX BLDG. SUMP
SH. 519

INPGIC
I Size

04-22-2011	AJFJ	Fxc2	KERSI J. DALAL	MECHANICAL	M 16690	3/31/2012	REVISED PER DDN-2*560
DATE	DWN	RE	PROFESSIONAL ENGINEER	PE DISC.	PE#	PE EXP.	

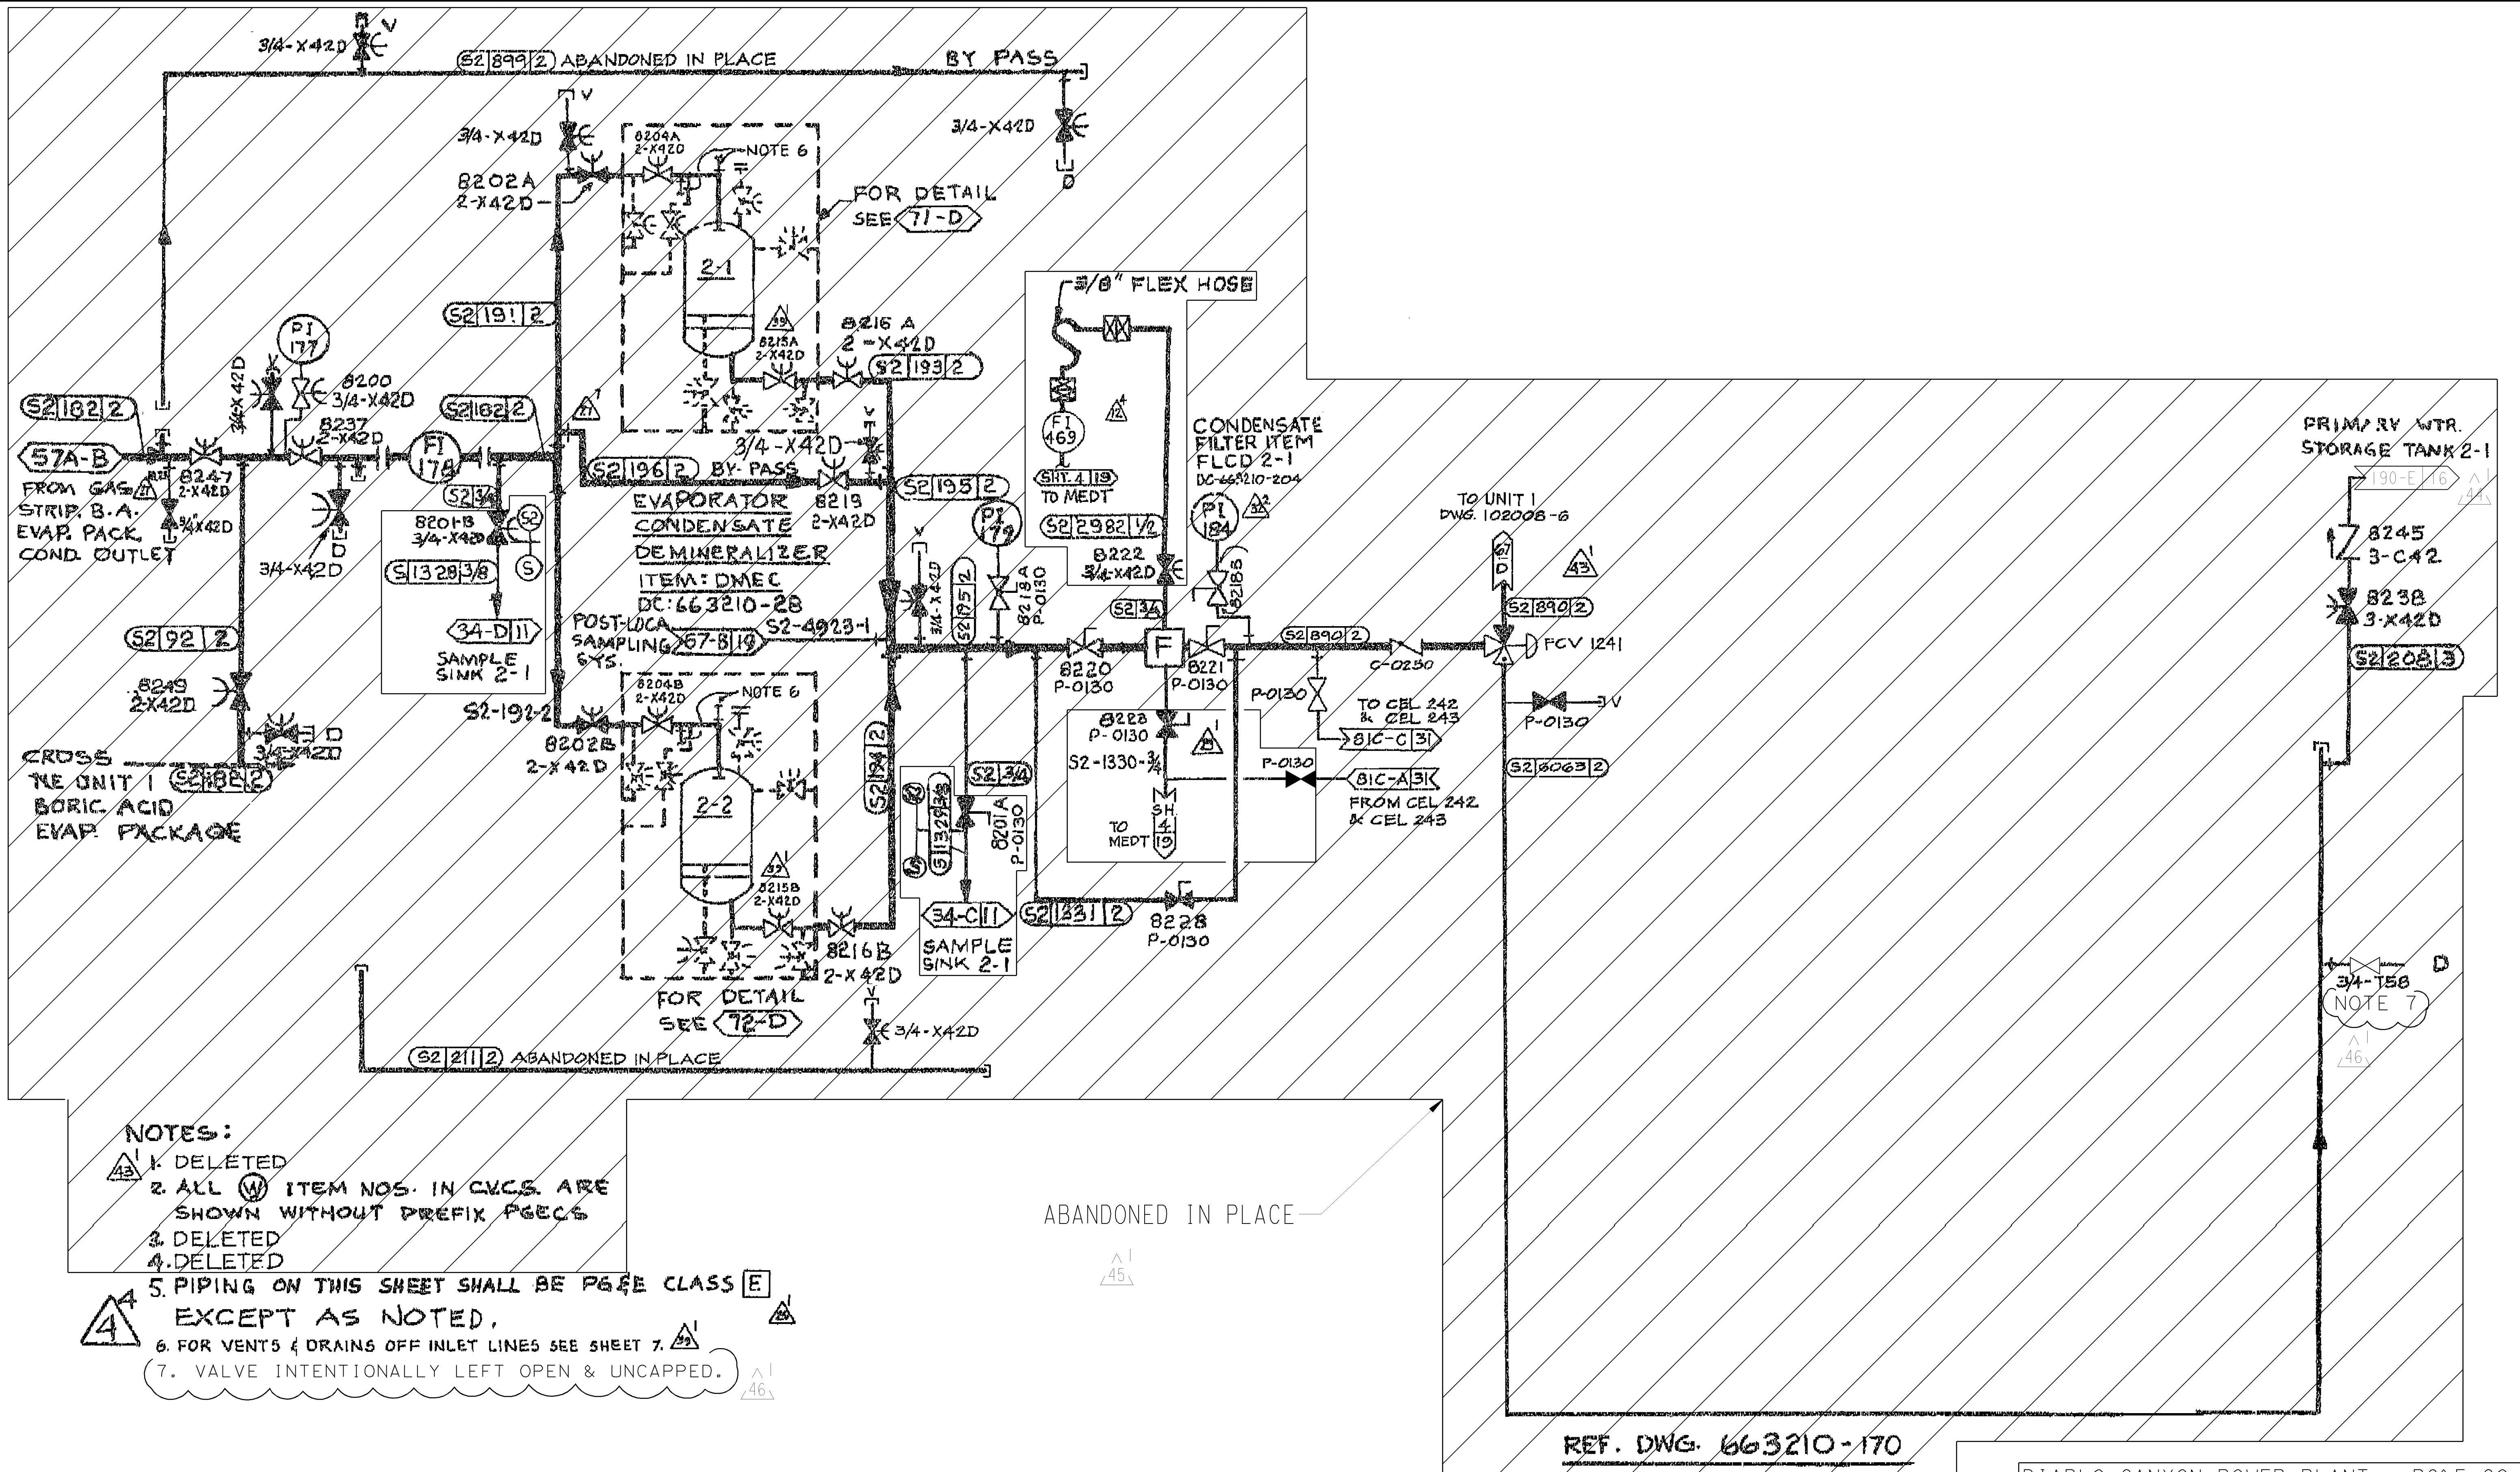

REF. DWG. 663210-170

DIABLO CANYON POWER PLANT - PG&E CO. CHEMICAL & VOLUME CONTROL SYSTEM



UNIT 2

DRAWING

| 08008

6

PAGE	REV
0	46

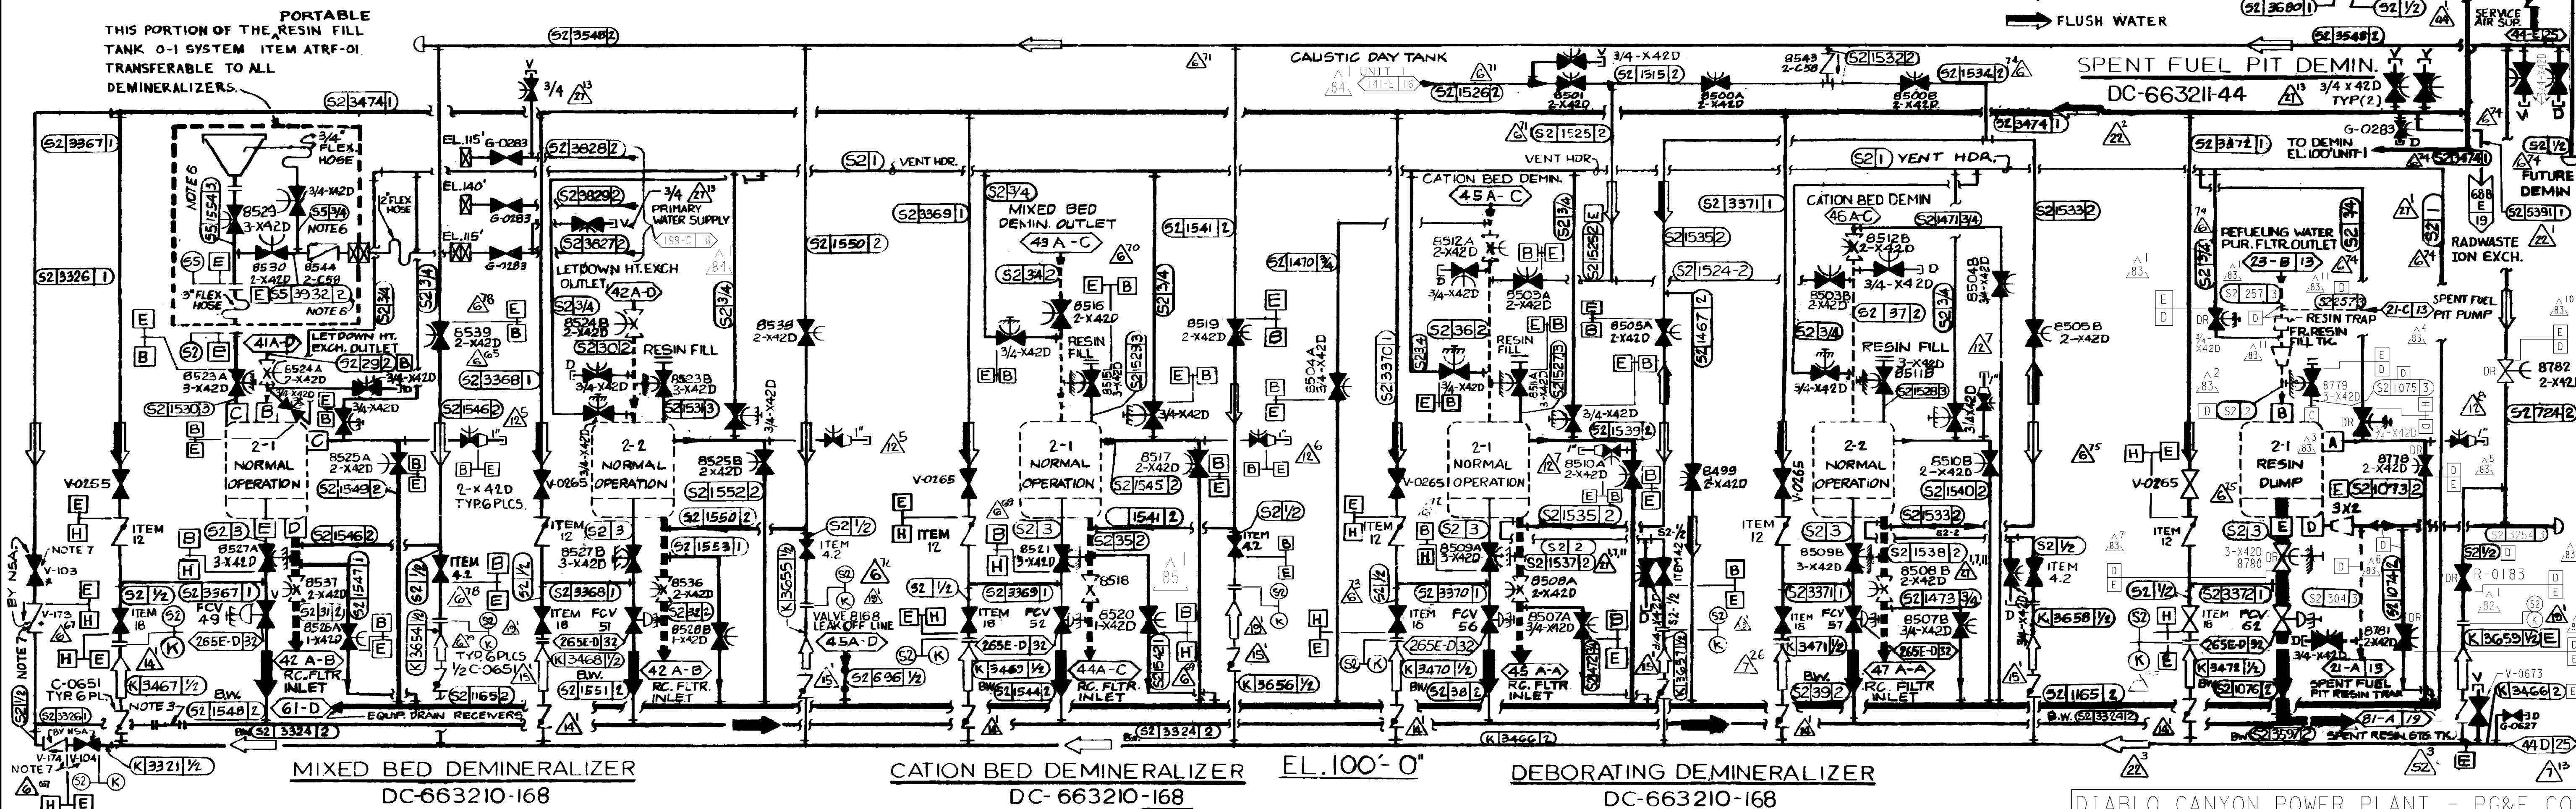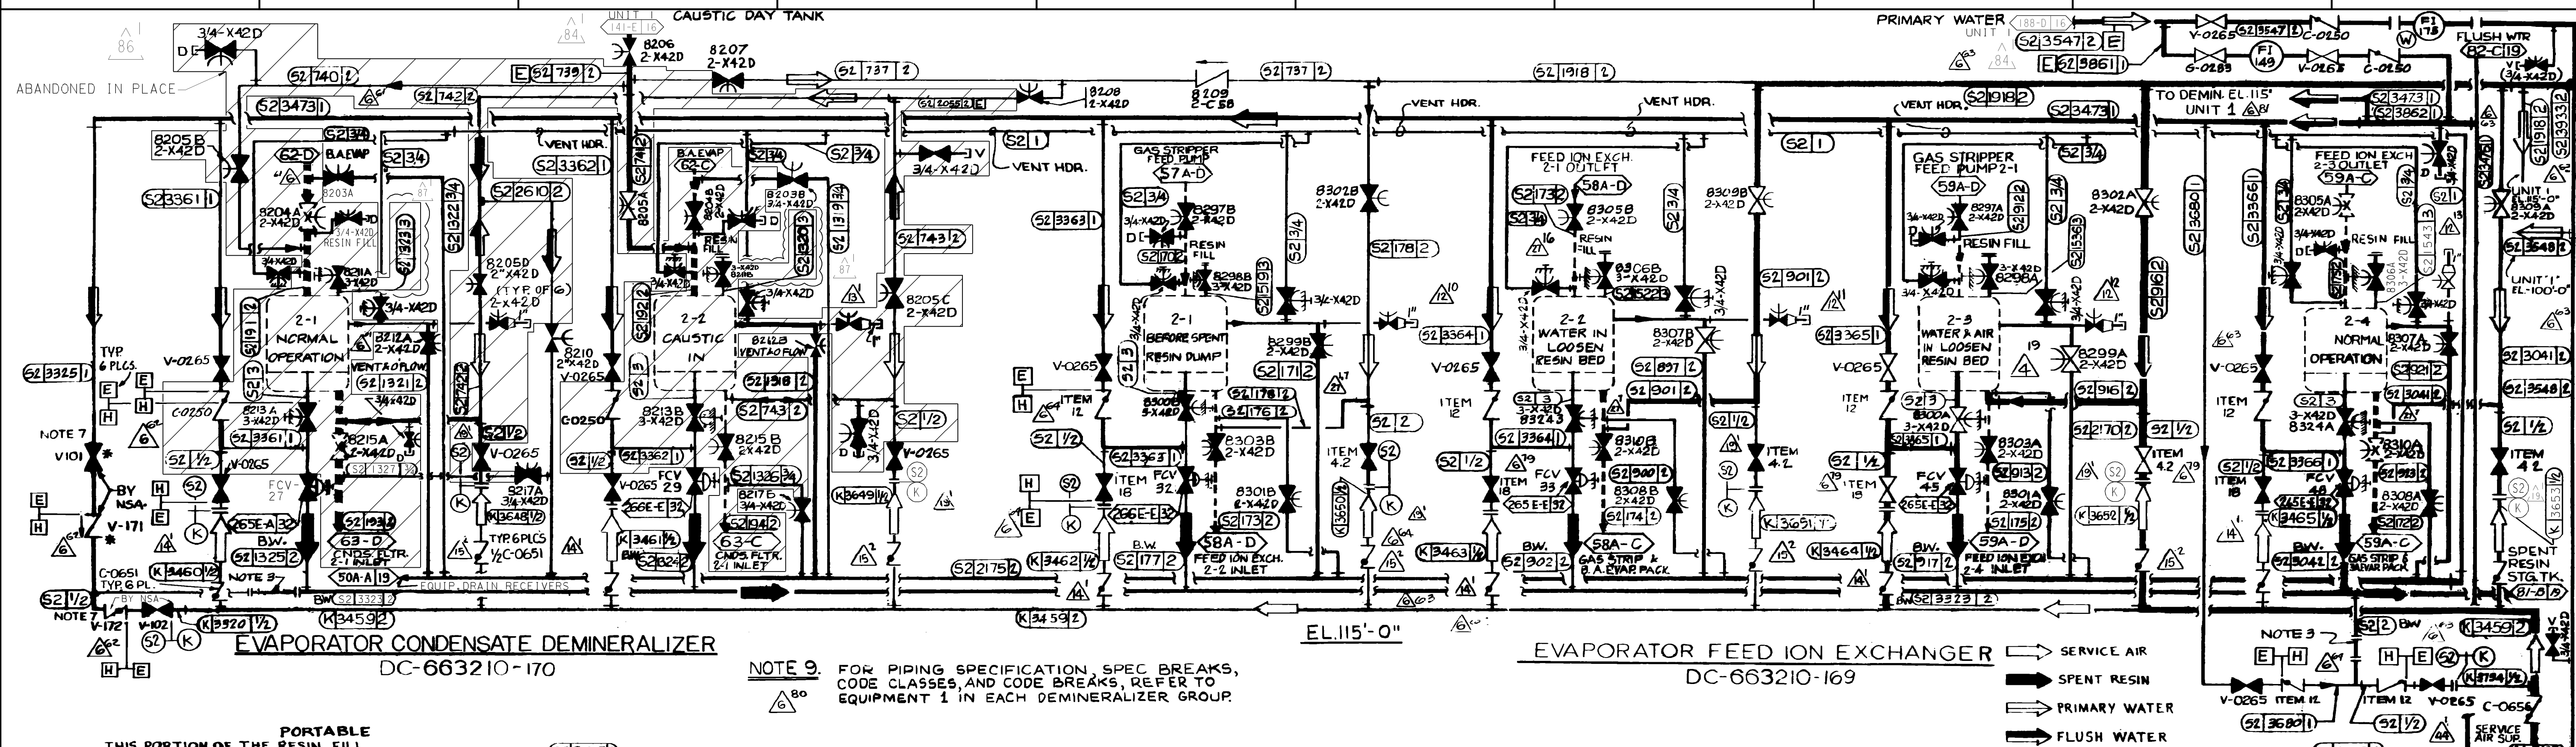

NOTES: 1. DELETED

2. B.W. INDICATES-BUTTWELDED (72-A)

3. 1" FLANGED SPOOL FOR CLEANOUT ENTRY INTO 2" LINE. (70.79-AD)
4. ALL VALVES WITH ITEM NOS. TO BE UNDER SPEC. 0722 UNLESS NOTED.
5. DELETED A 77

6. SPEC. "55" APPLIES TO PIPE ONLY, EXCLUDING FLANGES AND VALVES.


7. VALVES PROVIDED BY "NSA" SEE DWG. 101935

DIABLO CANYON POWER PLANT - PG&E CO. CHEMICAL & VOLUME CONTROL SYSTEM

DRAWING	SHEET	PAGE	REV
---------	-------	------	-----


UNIT 2	108008	7	0	87
--------	--------	---	---	----

NOTES: (CONT'D)
14. INSULATION ON PORTIONS OF THESE LINES HAVE ADDITIONAL BANDS INSTALLED ON 3" CENTER-TO-CENTER (MAX.) SPACING. SEE DWG 226607, 226608, 226609, 226610 & 226573 FOR SPECIFIC LOCATIONS.
15. MECHANICAL TRAVEL STOP INSTALLED ON VALVES 302A-D & 303A-D TO LIMIT OPEN STEM TRAVEL (REF. DWG# 6011930-140, PAGE 3).

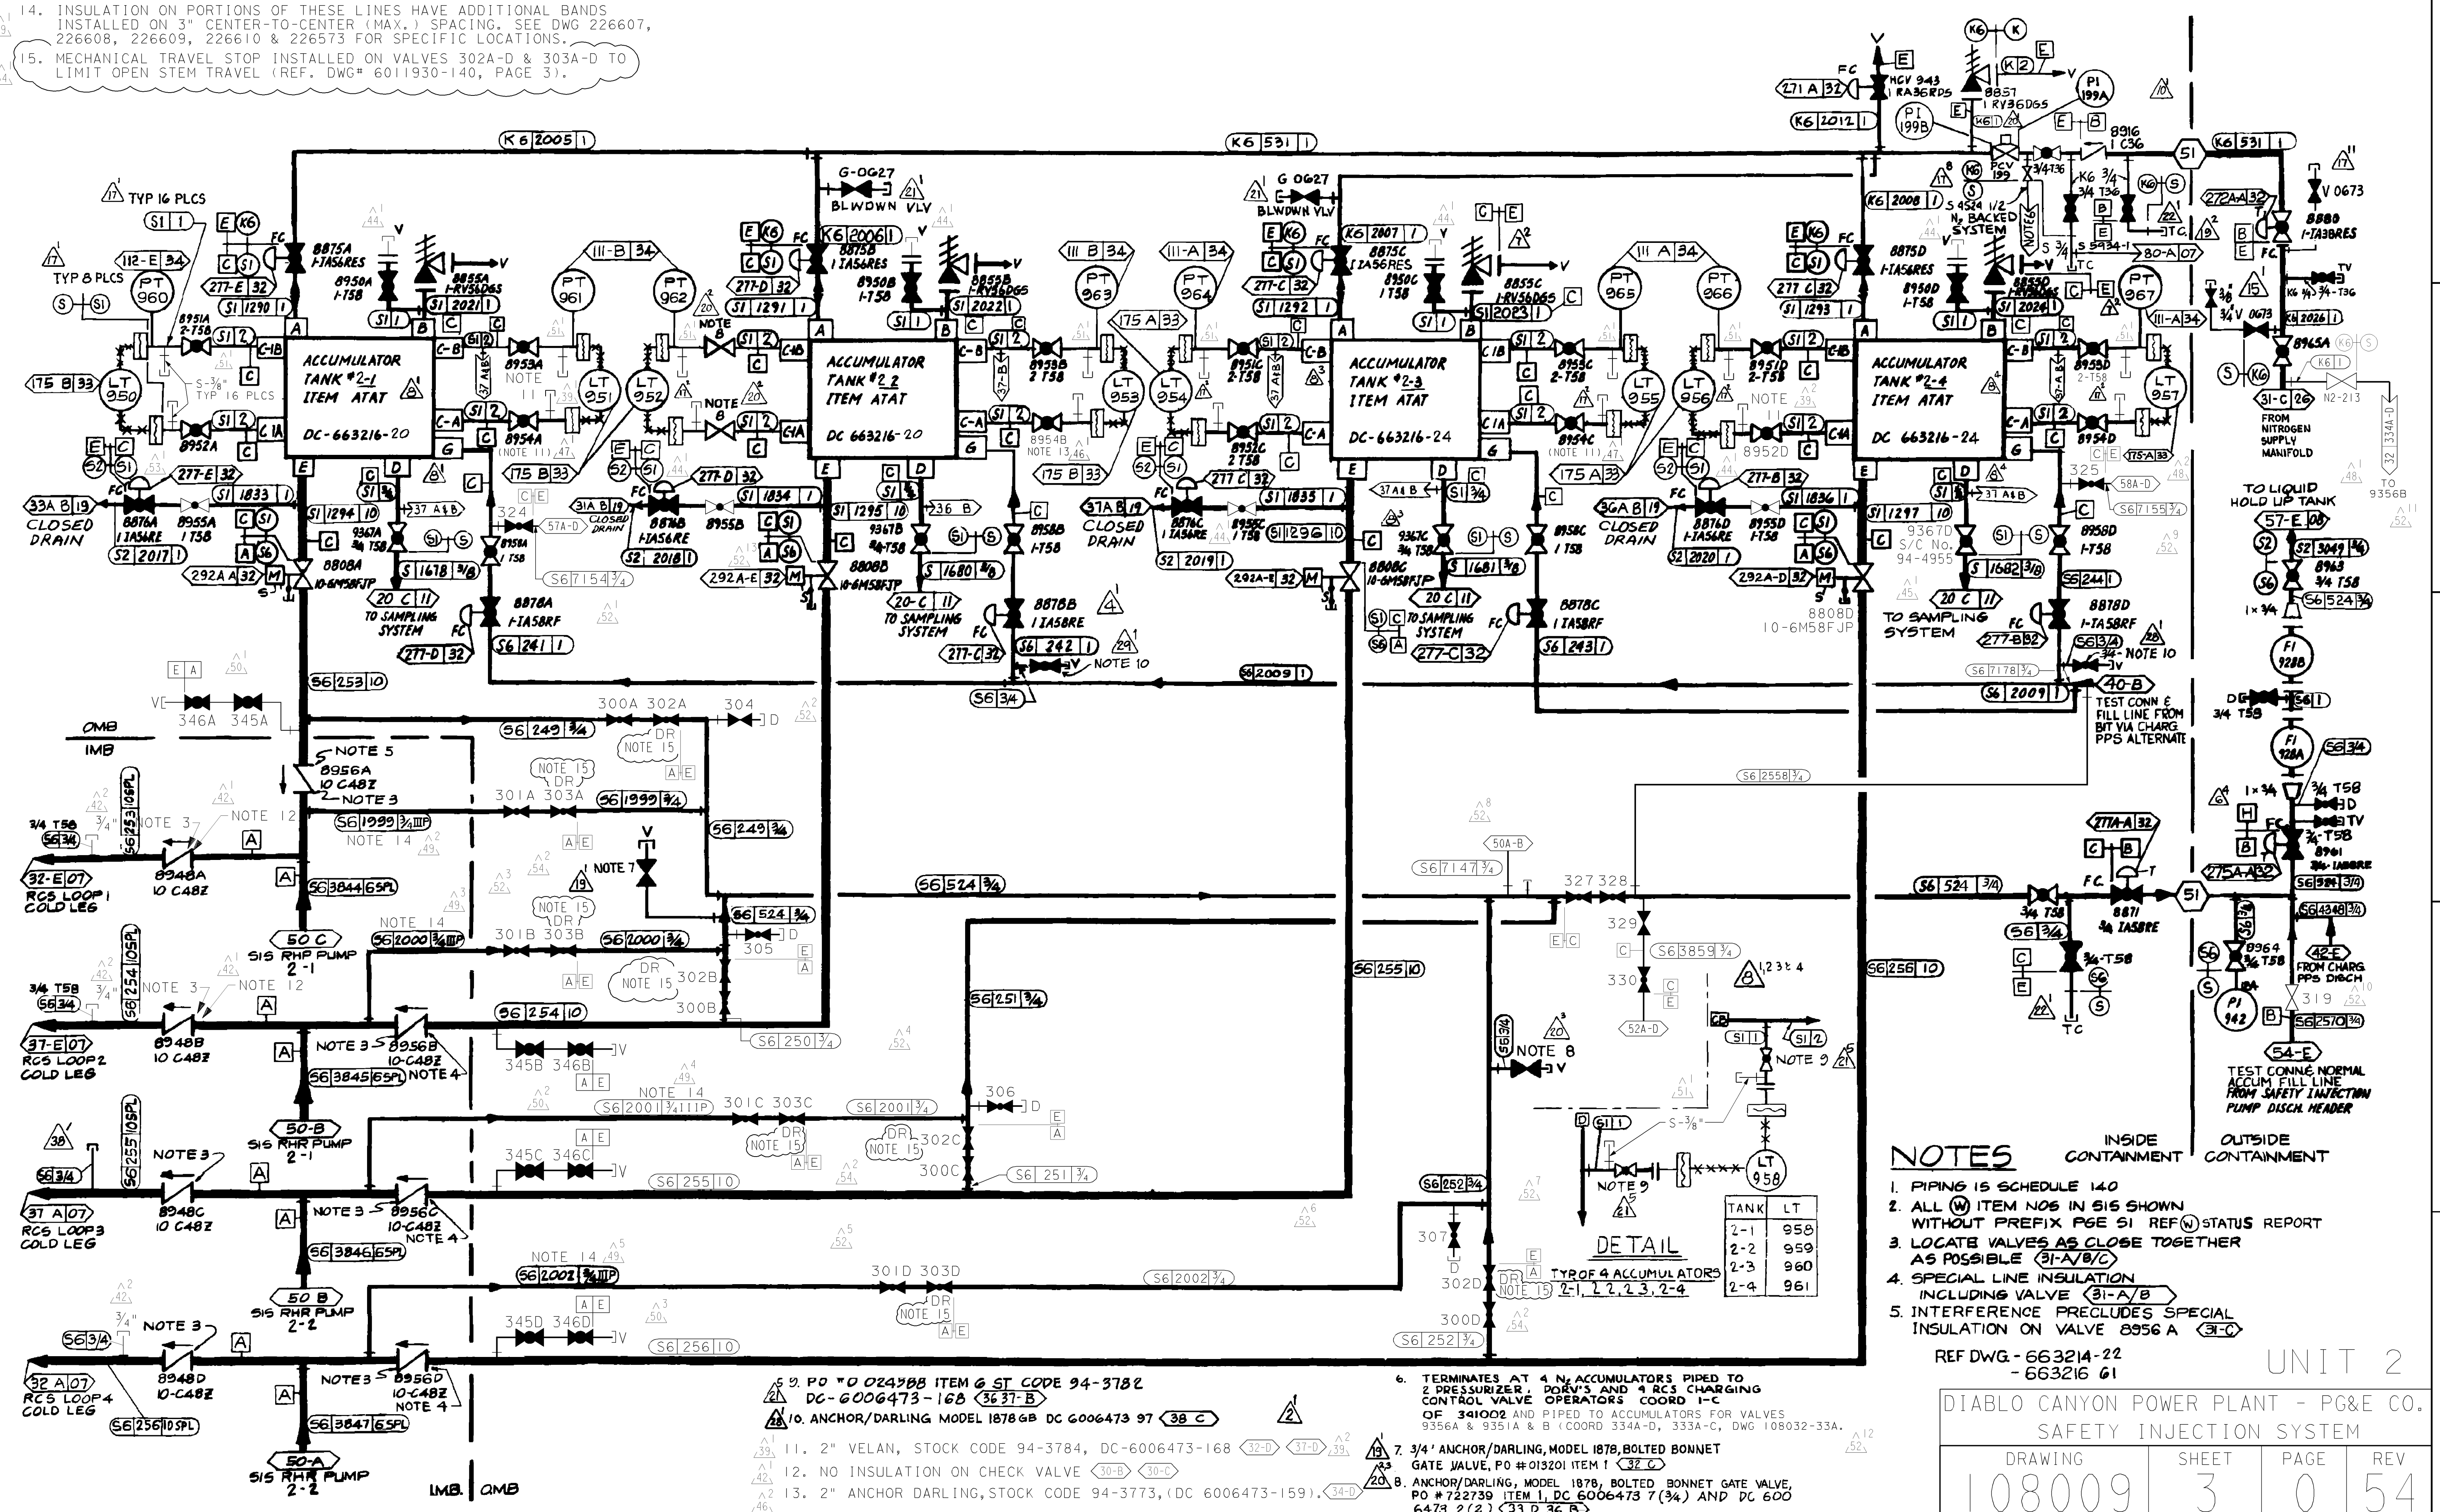

RASTER=er04924.dgn
DGN=er04924.dgn
CAD User: AJFJ Date: 05-16-2011



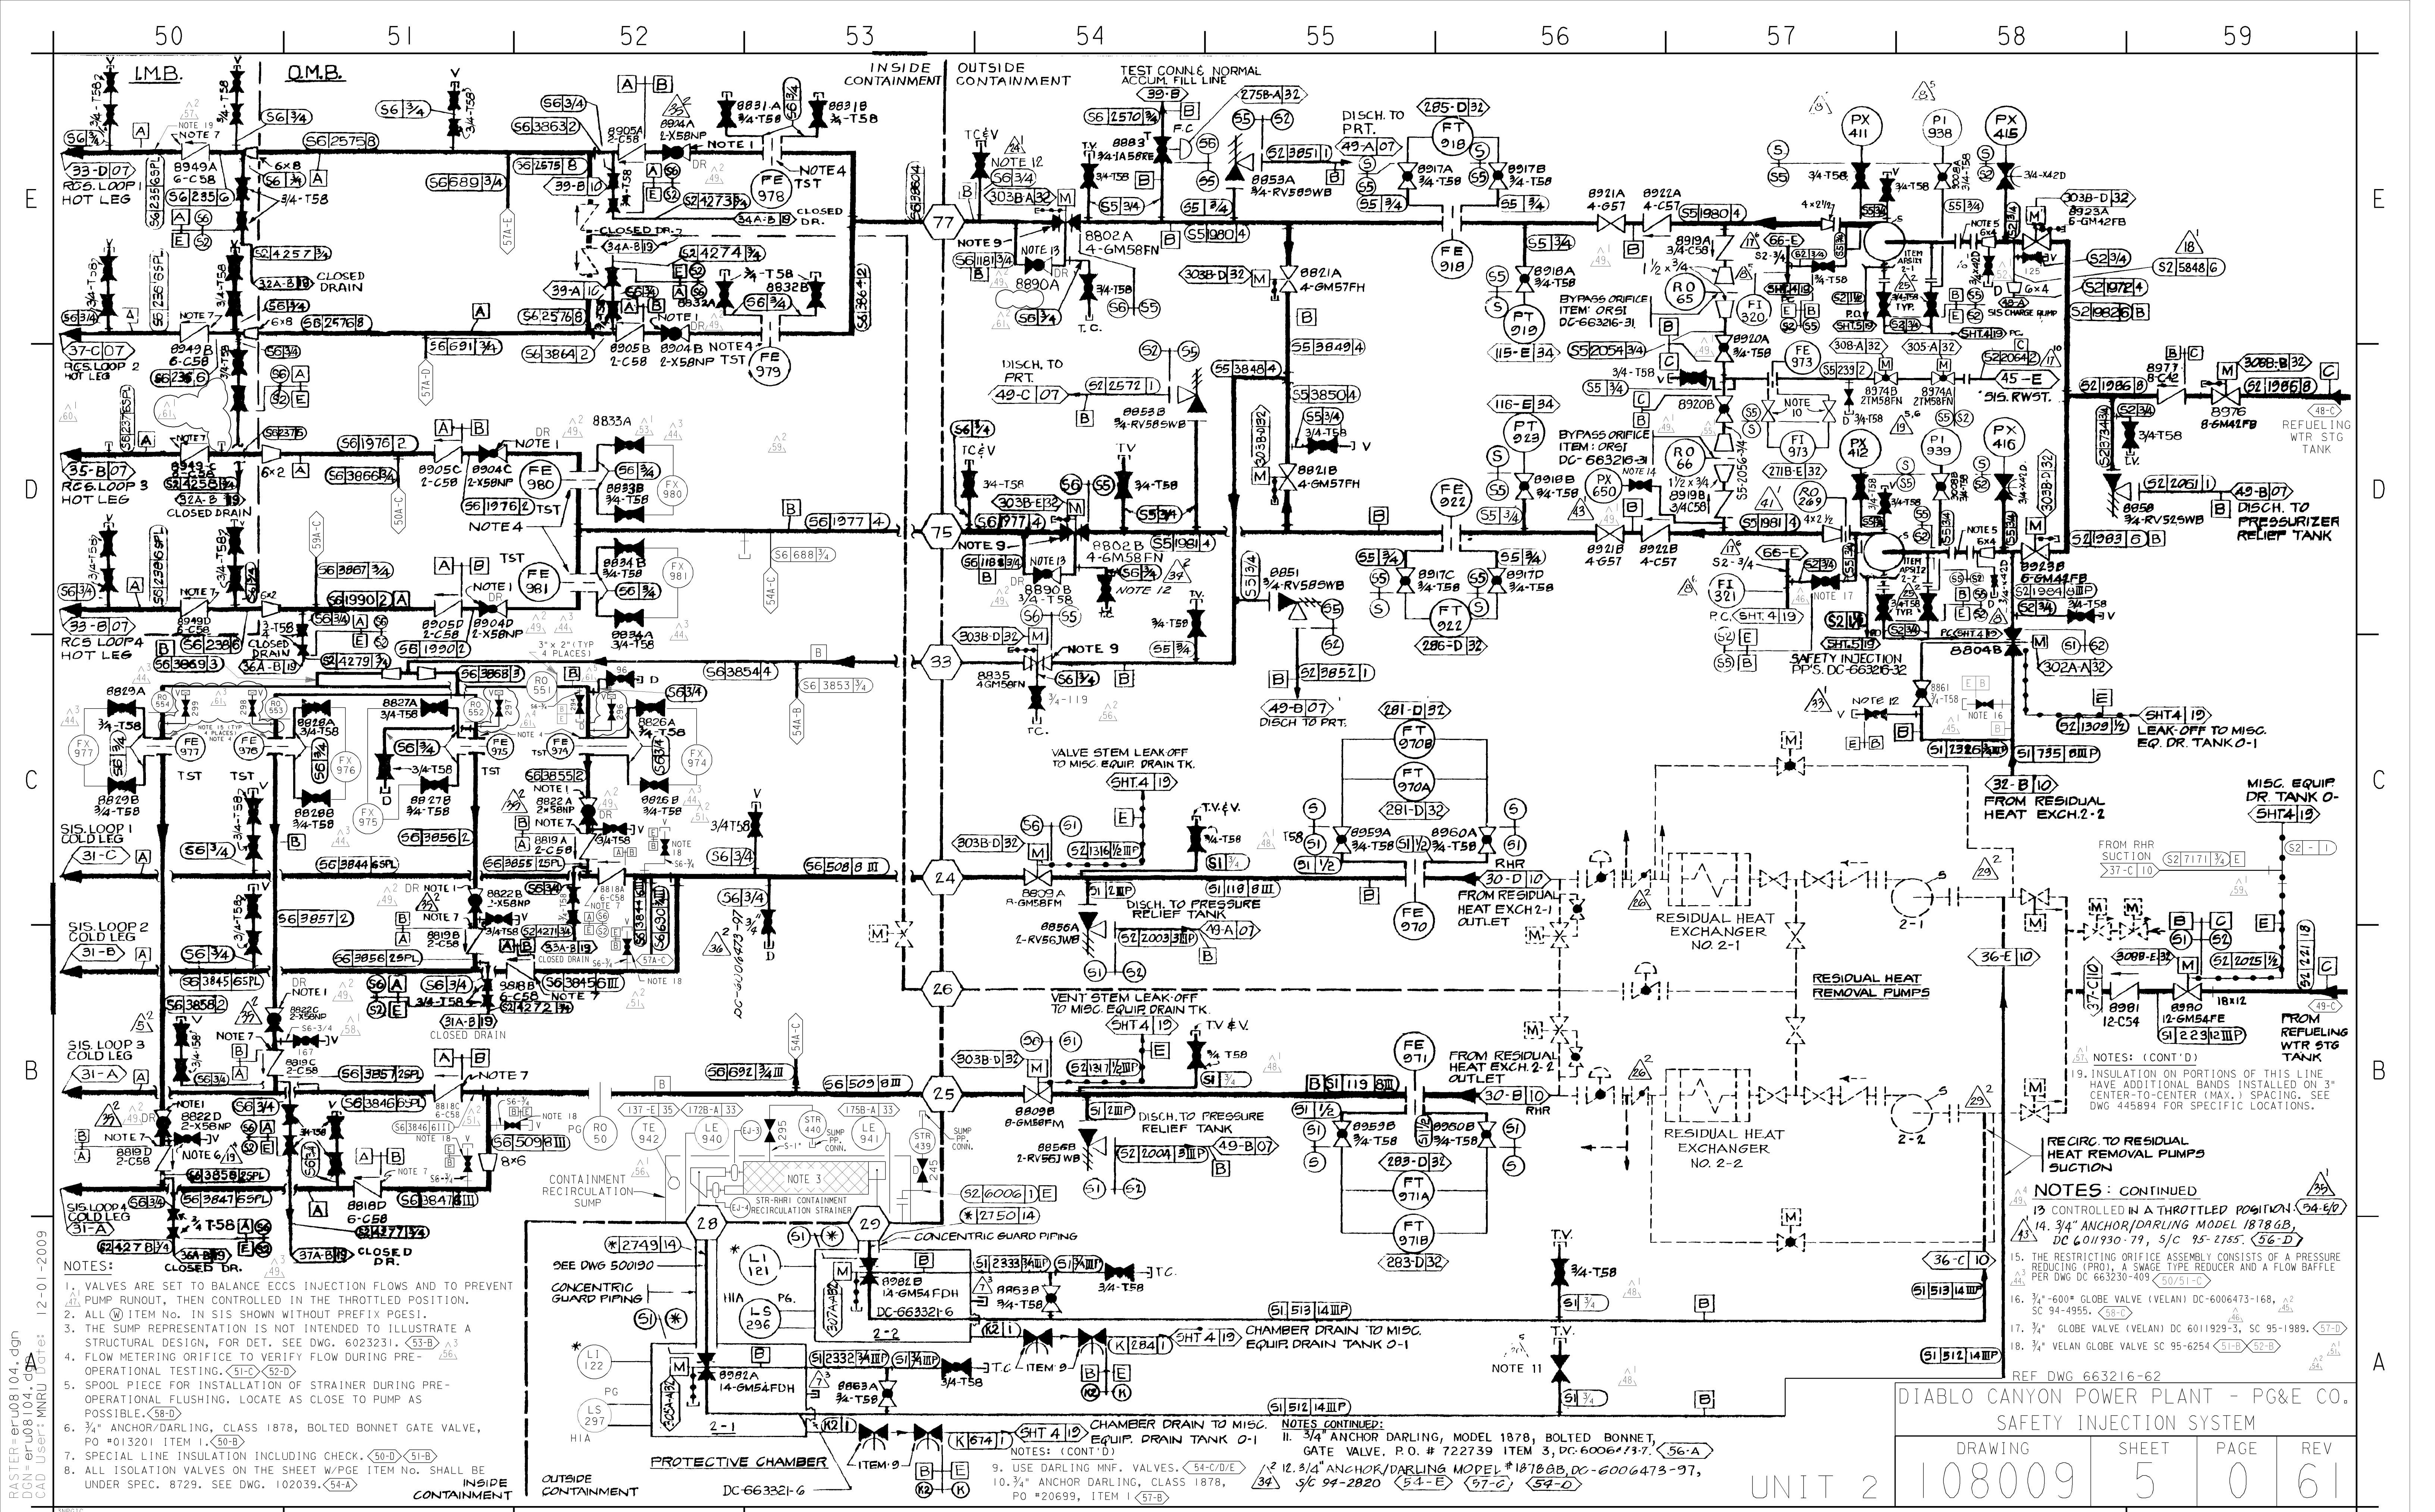

NOTES:

1. VALVES ARE SET TO BALANCE ECCS INJECTION FLOWS AND TO PREVENT PUMP RUNOUT, THEN CONTROLLED IN THE THROTTLED POSITION.
2. ALL (M) ITEM NO. IN SIS SHOWN WITHOUT PREFIX PGES1.
3. THE SUMP REPRESENTATION IS NOT INTENDED TO ILLUSTRATE A STRUCTURAL DESIGN, FOR DET. SEE DWG. 6023231. (53-B) (56-A)
4. FLOW METERING ORIFICE TO VERIFY FLOW DURING PRE-OPERATIONAL TESTING. (51-C) (52-D)
5. SPOOL PIECE FOR INSTALLATION OF STRAINER DURING PRE-OPERATIONAL FLUSHING. LOCATE AS CLOSE TO PUMP AS POSSIBLE. (58-D)
6. 3/4" ANCHOR/DARLING, CLASS 1878, BOLTED BONNET GATE VALVE, PO #013201 ITEM 1. (50-B)
7. SPECIAL LINE INSULATION INCLUDING CHECK. (50-D) (51-B)
8. ALL ISOLATION VALVES ON THE SHEET W/PGE ITEM NO. SHALL BE UNDER SPEC. 8729. SEE DWG. 102039. (54-A)

NOTES: (CONT'D)


13. CONTROLLED IN A THROTTLED POSITION. (54-E) (54-F)
14. 3/4" ANCHOR/DARLING MODEL 1878GB, DC 6011930-79, S/C 95-2755. (56-D)
15. THE RESTRICTING ORIFICE ASSEMBLY CONSISTS OF A PRESSURE REDUCING (PRO), A SWAGE TYPE REDUCER AND A FLOW BAFFLE PER DWG DC 663230-409 (50/51-C)
16. 3/4" 600" GLOBE VALVE (VELAN) DC-6006473-168, A2 SC 94-4955. (58-D)
17. 3/4" GLOBE VALVE (VELAN) DC 6011929-3, SC 95-1989. (57-D)
18. 3/4" VELAN GLOBE VALVE SC 95-6254 (51-B) (52-B)

DIABLO CANYON POWER PLANT - PG&E CO.
SAFETY INJECTION SYSTEM

DRAWING	SHEET	PAGE	REV
108009	5	0	61

12-01-2009	MNRU	FxC2	KERSI J. DALAL	MECHANICAL	M 16690	3/31/2010	REVISED PER DFT-7*636-0
DATE	DWN	RE	IV	PE DISC.	PE*	PE EXP.	7*644-0 AND DAS-6*256-0

60 61 62 63 64 65 66 67 68 69

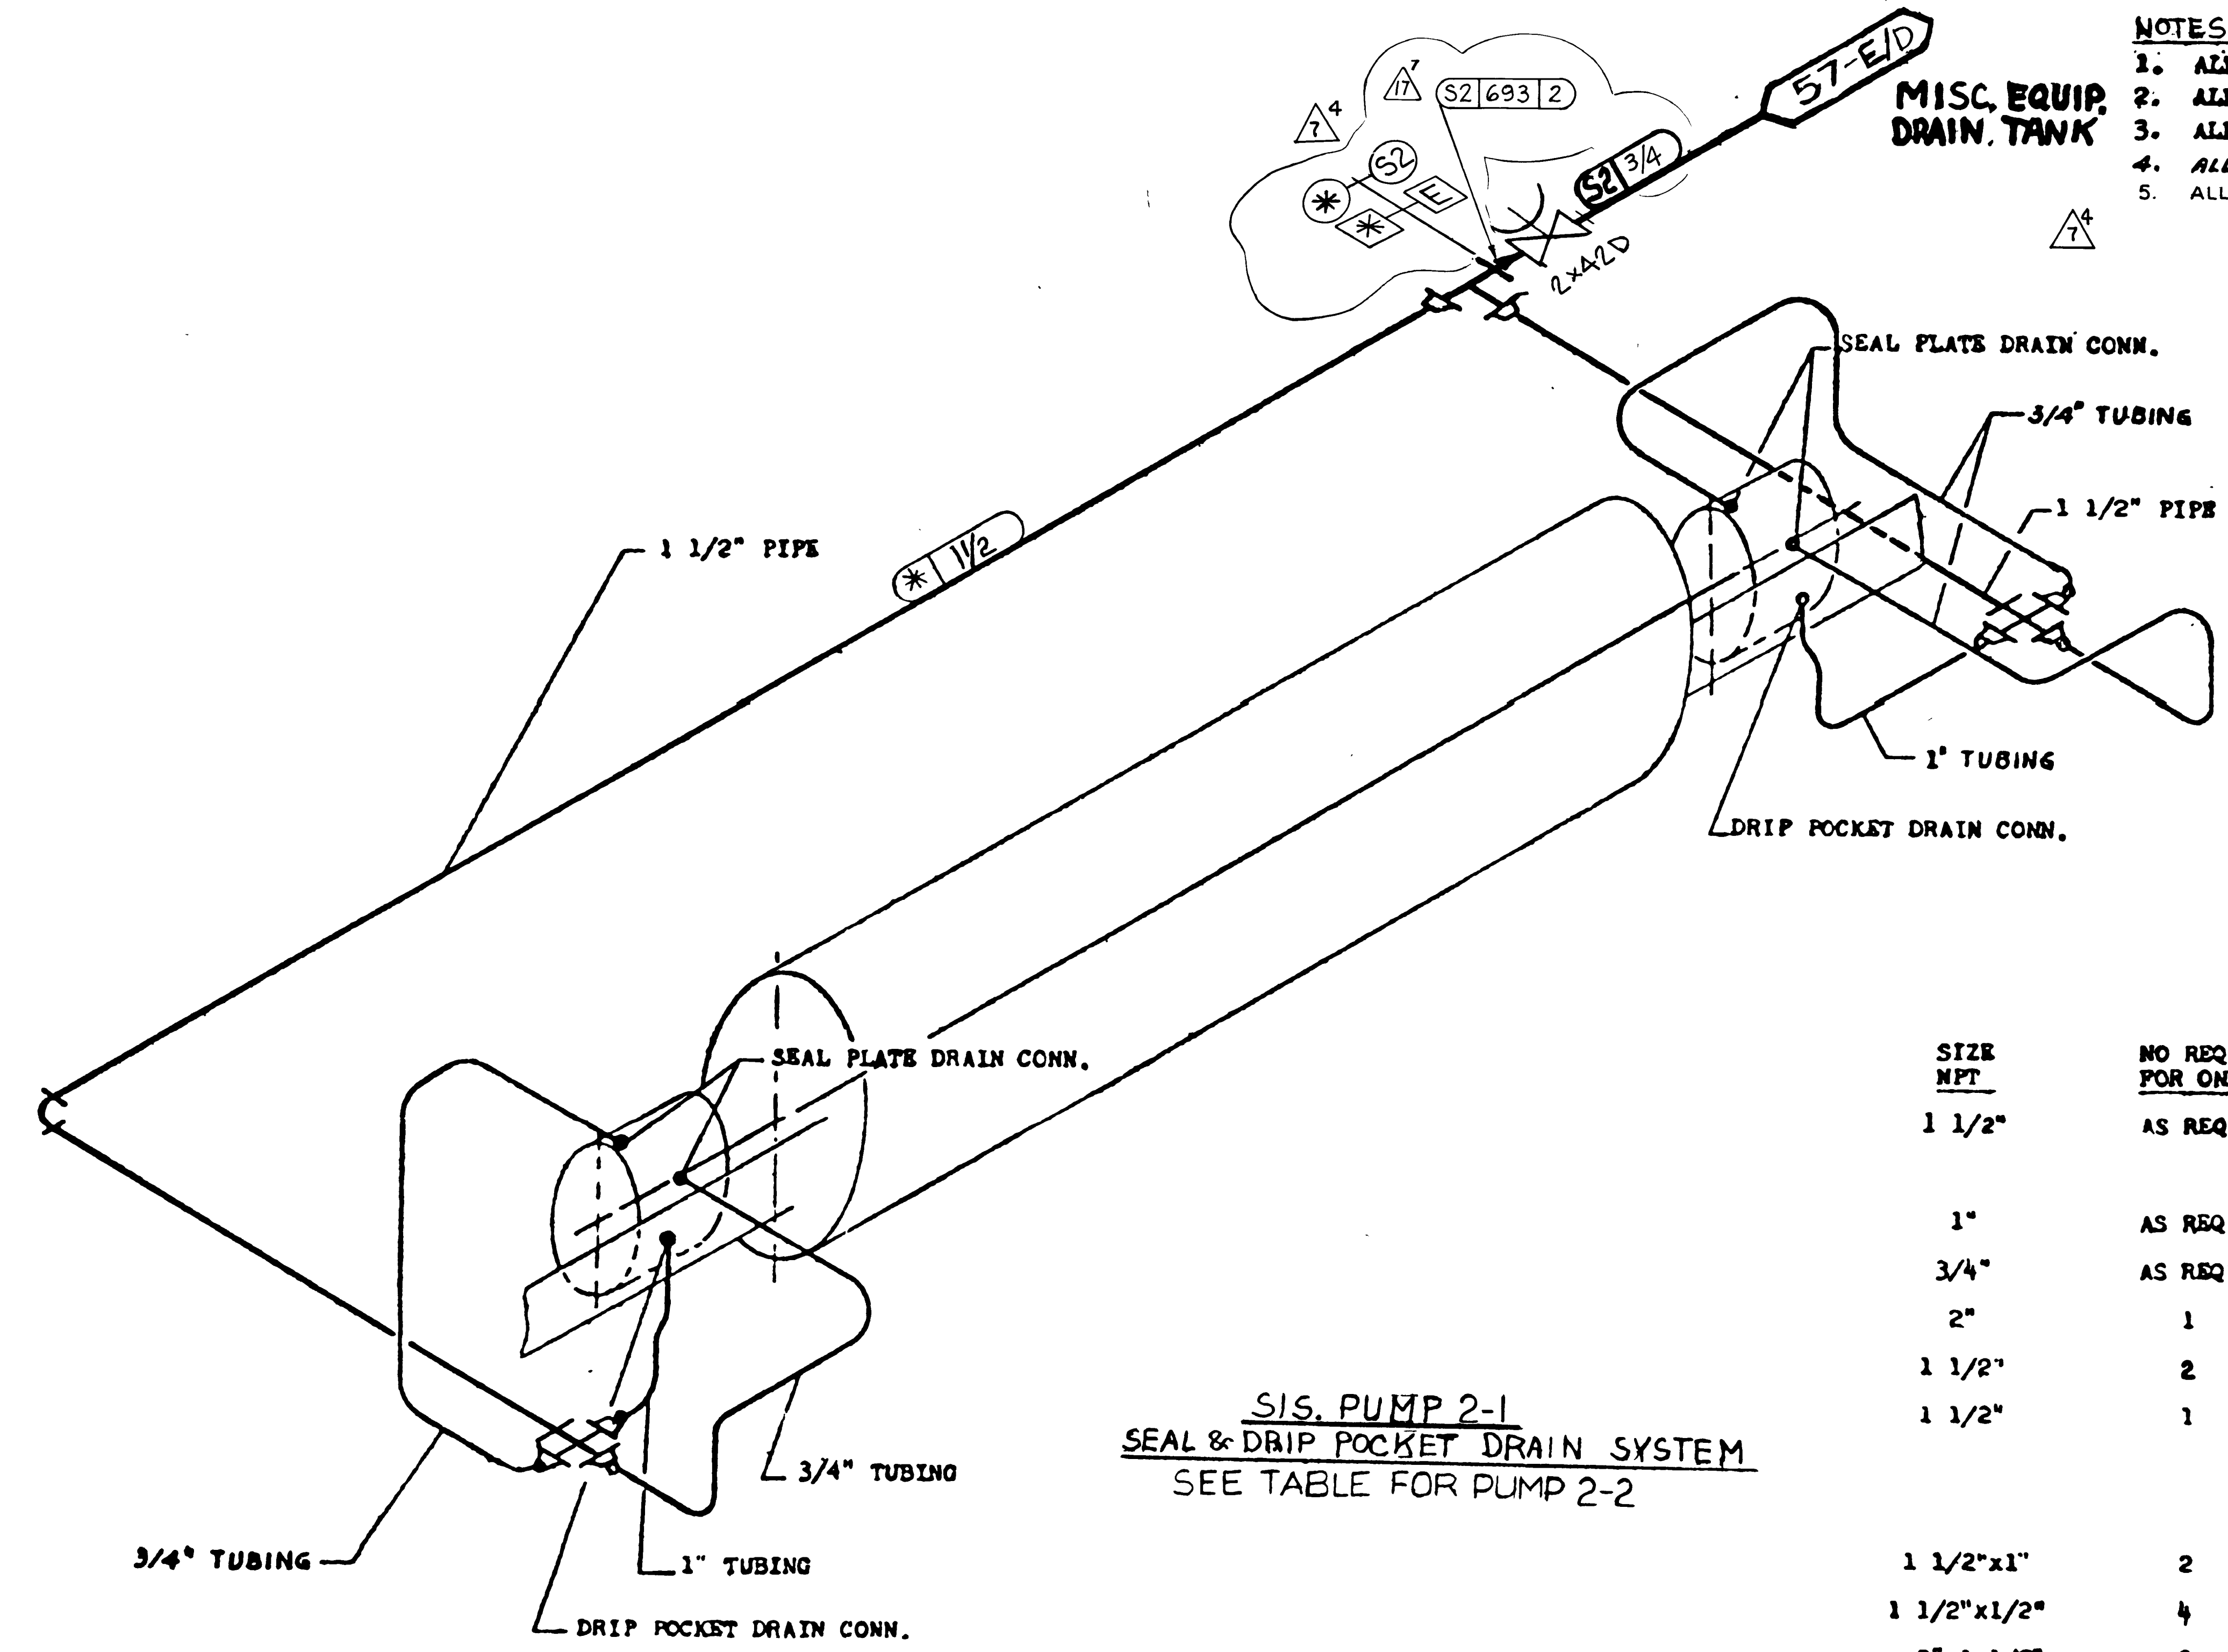

- NOTES:
- 1. ALL TUBING STEEL
 - 2. ALL PIPE SCH 40 - ASTM A53
 - 3. ALL CONNECTORS - S.S.
 - 4. ALL PIPE FITTINGS - ASTM A-105 GR. 2
 - 5. ALL PIPING ON THIS SHEET IS CONSIDERED CODE CLASS "E"

SIS PUMP	2-1	2-2
DRAIN LINE NUMBER	S216932	S216142

SIS. PUMP 2-1
SEAL & DRIP POCKET DRAIN SYSTEM
SEE TABLE FOR PUMP 2-2

SIZE NPT	NO REQ'D. FOR ONE	DESCRIPTION
1 1/2"	AS REQ'D.	PIPE - C.T.S.
1"	AS REQ'D.	TUBING .049 WALL THICKNESS
3/4"	AS REQ'D.	TUBING .049 WALL THICKNESS
2"	1	TEE - 2000#
1 1/2"	2	CROSS-2000#
1 1/2"	1	ELBOW - 2000#
1 1/2"x1"	2	HEX BUSHING
1 1/2"x1 1/2"	4	HEX BUSHING
2"x1 1/2"	2	HEX BUSHING
1"	4	16-16 FBZ-SS-OR EQUAL ①
1/2"	8	12-8 FBZ-SS-OR EQUAL ①

NESTINGHOUSE EL. CORP.-APP.

PUMP NO.	SPIN NO.
② 45493/99	PSE SIAPSI - 1/2
45491/92	AEP SIAPSI - 1/2
45490/94	AMP SIAPSI - 1/2
45495/96	PNJ SIAPSI - 1/2
45497/98	PGE SIAPSI - 1/2
45489/500	PEG SIAPSI - 1/2

SAFETY INSTRUCTION
CUST. OR. NO. 54-E-705-03A SUPP
DATE: 6-25-69

DC-663216-28

UNIT - 2


OUR OR. NO. 346-854
242-JYCN-10564

P G & E CO.	DRAWING NUMBER	REVISION
SHEET 6 OF SHEETS	108009	17

RM INDEXED REV 17 MICROFILM

THIS DRAWING HAS BEEN REPRODUCED
WITHOUT CHANGE FROM ORIGINAL DRAWING
CHANGE NO. 1 ON 6-25-69 APPROVED: BLS

SCANNED 11/17
APPD 12/17

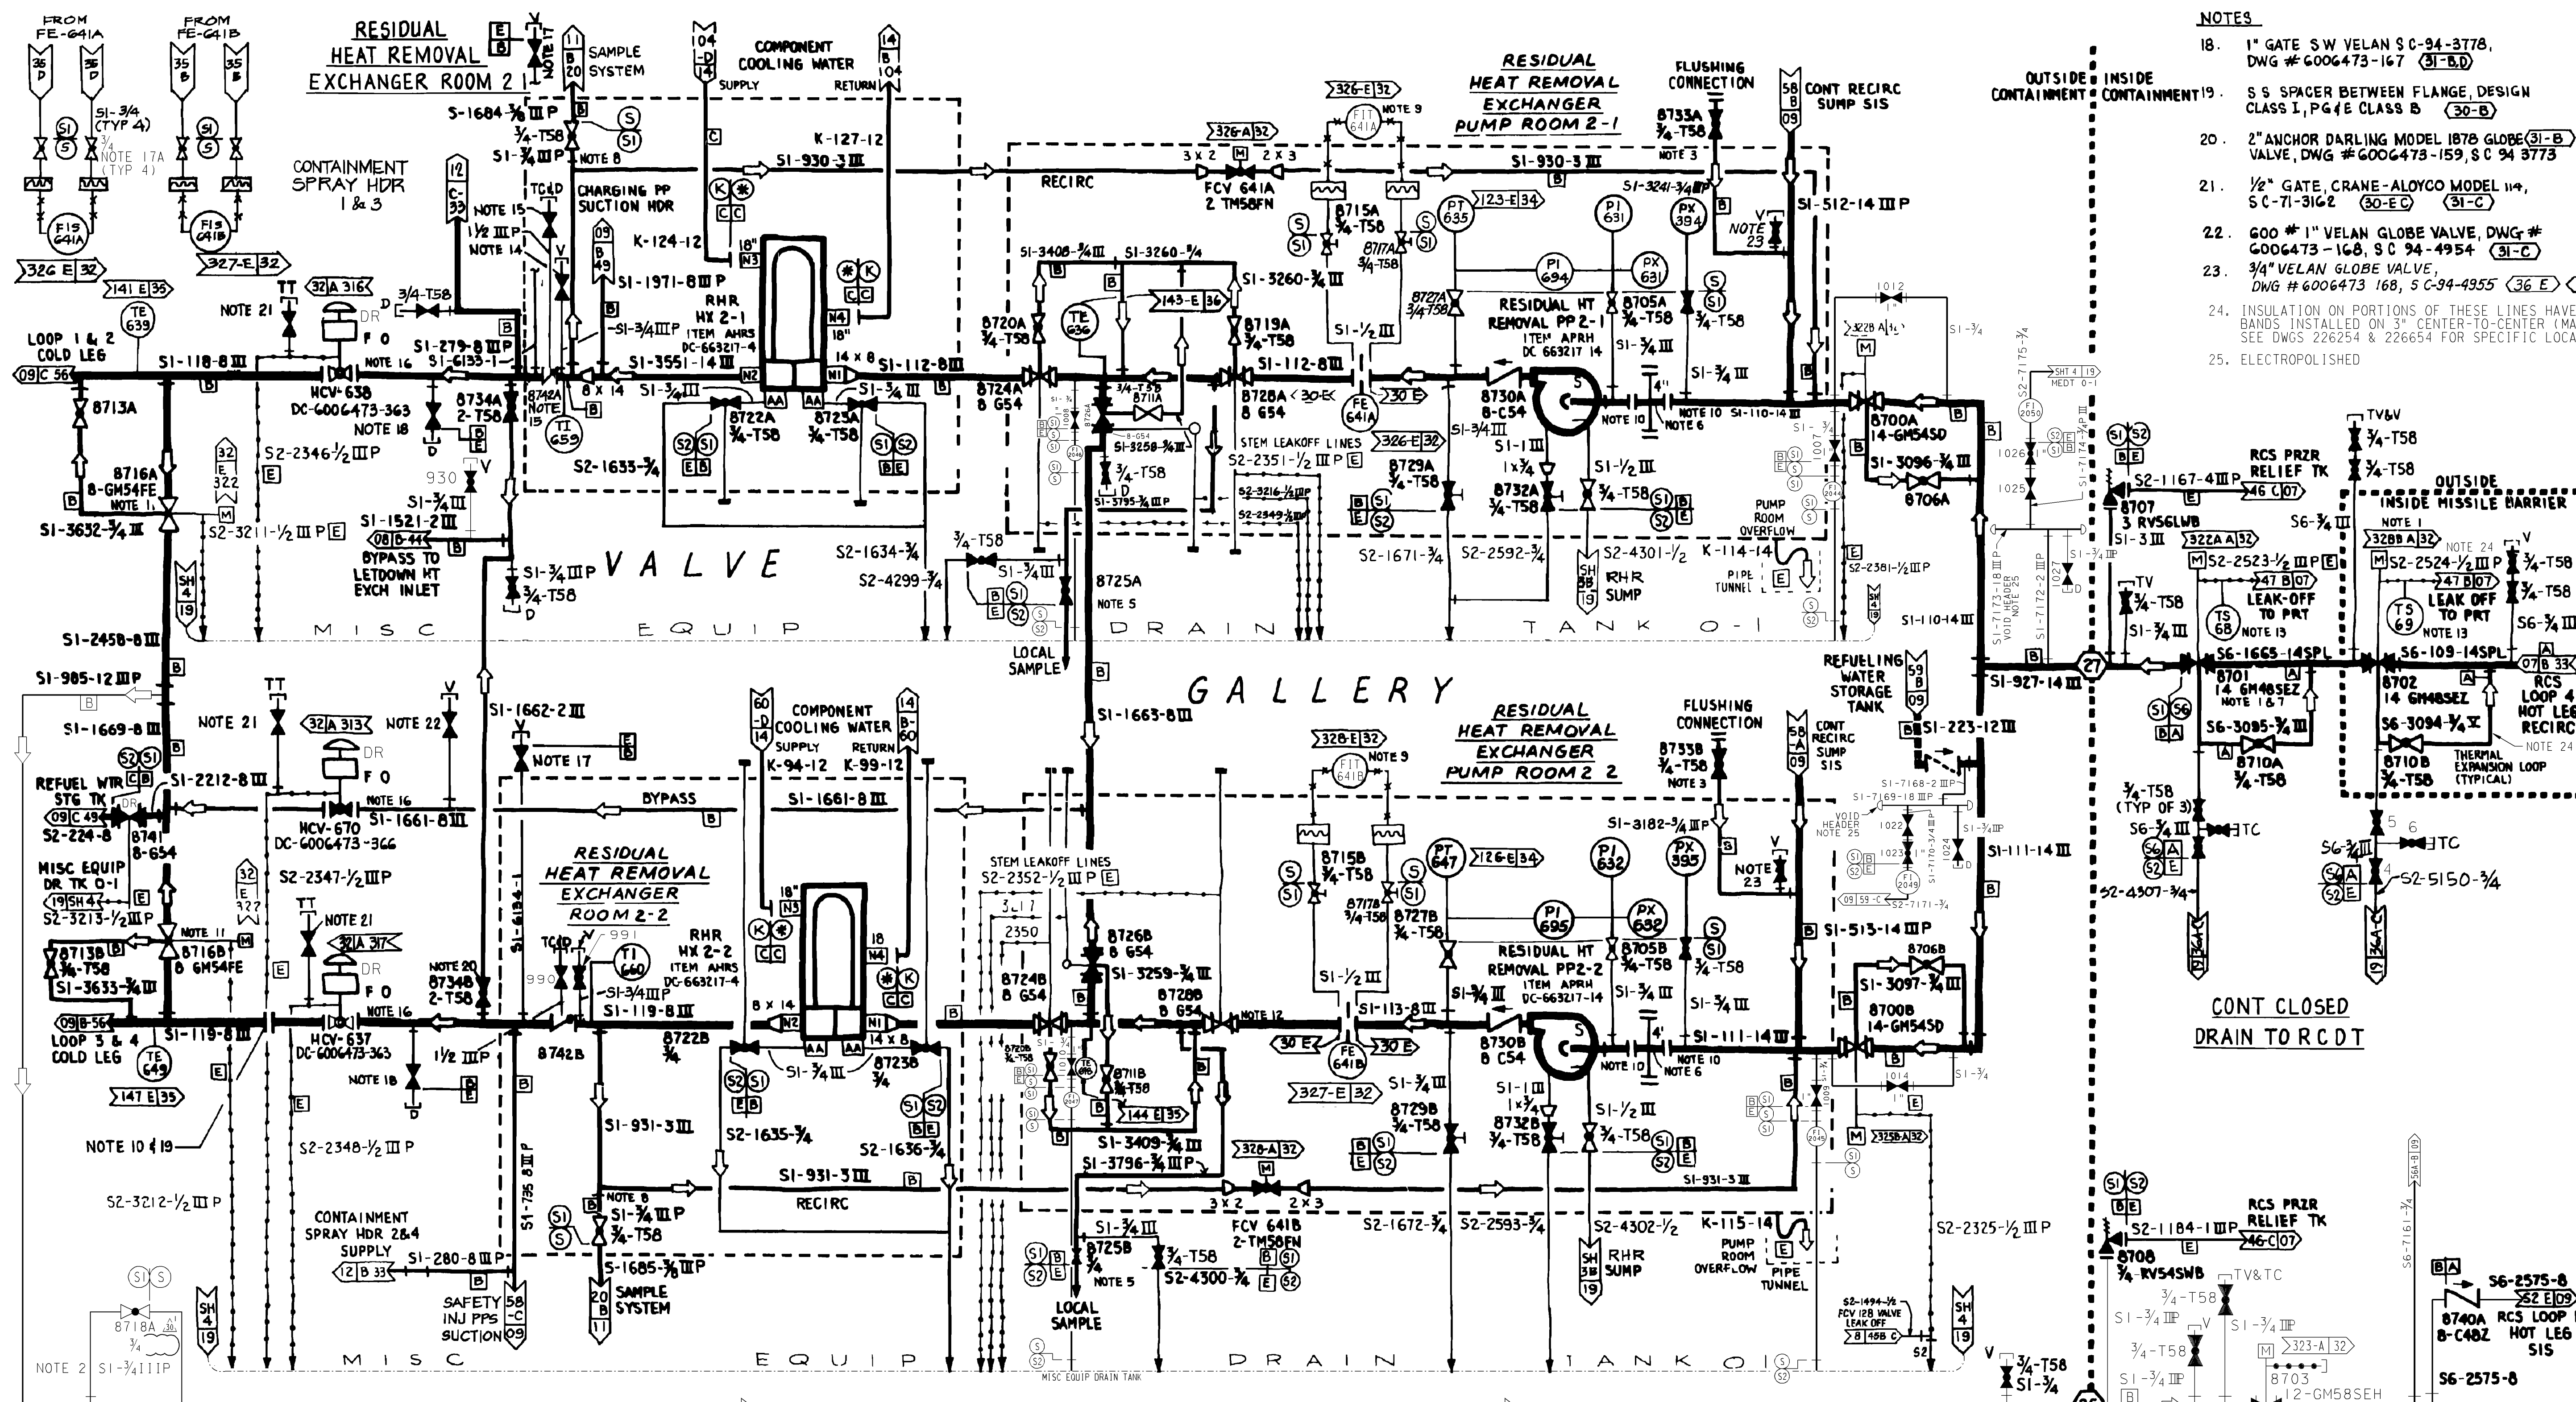

- NOTES**
- 1" GATE SW VELAN SC-94-3778, DWG # 6006473-167 (31-B)
 - S S SPACER BETWEEN FLANGE, DESIGN CLASS I, PG&E CLASS B (30-B)
 - 2" ANCHOR DARLING MODEL 1878 GLOBE (31-B) VALVE, DWG # 6006473-159, S C 94 3773
 - 1/2" GATE, CRANE-ALOYCO MODEL 114, S C-71-3162 (30-E) (31-C)
 - 600 # 1" VELAN GLOBE VALVE, DWG # 6006473-168, S C 94-4954 (31-C)
 - 3/4" VELAN GLOBE VALVE, DWG # 6006473 168, S C-94-4955 (36-E) (36-C)
 - INSULATION ON PORTIONS OF THESE LINES HAVE ADDITIONAL BANDS INSTALLED ON 3" CENTER-TO-CENTER (MAX.) SPACING. SEE DWGS 226254 & 226654 FOR SPECIFIC LOCATIONS.
 - ELECTROPOLISHED

- NOTES**
- VALVE INTERLOCKED WITH REACTOR COOLANT SYSTEM PRESSURE SIGNAL (38-C) (39-D)
 - ELBOW TAPS FOR FLOW METER (30-A)
 - LOCATE ABOVE RESIDUAL HEAT REMOVAL PUMP SHIELDING (36-C)
 - ALL (W) ITEM NOS ARE SHOWN WITHOUT PREFIX PGE-AC, REFER TO (W) STATUS REPORT DC 663200 47
 - LOCATE VALVE OUTSIDE SHIELD WALL. SAMPLE LINE MUST BE AT A LOWER ELEVATION THAN THE 8 INCH PIPE BEING SAMPLED (34-B)
 - TEMPORARY STRAINER IS PLACED IN THE SPOOL PIECE DURING INITIAL FLUSHING OPERATIONS. STRAINER MUST BE REMOVED BEFORE PLANT START UP (36-B)
 - SPECIAL LINE INSULATION INCLUDING VALVE (38-C)
 - LOCATE SAMPLE LINE CONNECTION AS CLOSE AS POSSIBLE TO THE 8 INCH RHR HX DISCHARGE LINE (32-B)
 - LOCATE ORIFICE FLOW METER INDICATION OUTSIDE OF SHIELD WALL (35-C)
 - 300" 316 SS FLANGES (36-B) & (38-B) AND 4 PCS FLUSHING SPOOLS FLANGES ON LINE NO 110 & 111
 - VALVES 8716 A & B ARE ALOYCO DC-663219-593 (30-D)
 - USE CRANE VALVE WITH SOLID DISK DC-663219-440 (34-B)
 - TS 68 AND TS 69 ARE TO BE STRAPPED TO PIPE 18"-24" FROM VALVE (38(39-D)
 - ANCHOR DARLING MODEL 1878 DWG #6006473-97 (32-D) (31-E) (38/39-A)
 - ANCHOR DARLING, PO 37211, TC/D DWG #6006473-260 DWG #6006473-254, 8742A (32-D)
 - 600" SS FLANGES (31-B,C,D)
 - 1" ANCHOR DARLING MODEL 1878 GLOBE VALVE DWG # 6006473-157 (32-E)
 - 17A VELAN MODEL NO 104-2574 1-1315 DWG # 6006473-221 (36-E)

REF DWG DC-663217-5

DIABLO CANYON POWER PLANT - PG&E CO.

RESIDUAL HEAT REMOVAL SYSTEM

DRAWING	SHEET	PAGE	REV
108010	3	0	30

UNIT 2

SPACE REQUIRED TO REMOVE EXCHANGER CASING

1/2" NIPPLE - PLAIN END - VENT - CUST.'S CONN.

COMPONENT COOLING WATER SUPPLY & RETURN HEADER TYPICAL


SUPPLY	LINE NO.	R.H.R. PP. 2-1 SEAL WTR. CLR.	R.H.R. PP. 2-2 SEAL WTR. CLR.
		CO-OR	CO-OR
RETURN	LINE NO.	K-128-1	K-100-1
		106-C-14	64-C-14

- (B) 3/4" - 300# RAISED FACE FLANGE - PUMPING RING OUTLET-PIPED TO HEAT EXCHANGER [PRESSURE DROP 1 PSI]
- (A) 1/2" P.T. - VENT OR QUENCH
- (B) 1/2" P.T. - DRAIN (GLAND DRAIN)
- (EA) 1/2" P.T. - FLUSHING CONN.-PIPED FROM HEAT EXCHANGER
- (L) 1/2" P.T. - COOLING LIQUID - IN
- (M) 1/2" P.T. - COOLING LIQUID - OUT
- (G) 1" 300# RF. FLANGE-CASING DRAIN

DYE PENETRATE TEST REQUIRED.
ALL SEALWELDS PER PT ASME-3
NO POSTWELD HEAT TREATMENT REQUIRED.

RECIRCULATION OF LIQUID FROM SEAL WITH PUMPING RING - THRU COOLER & BACK TO SEAL.

RESIDUAL HEAT REMOVAL PUMP 2-1
SHAFT SEAL (TYP); REF DWG DC-663217-25

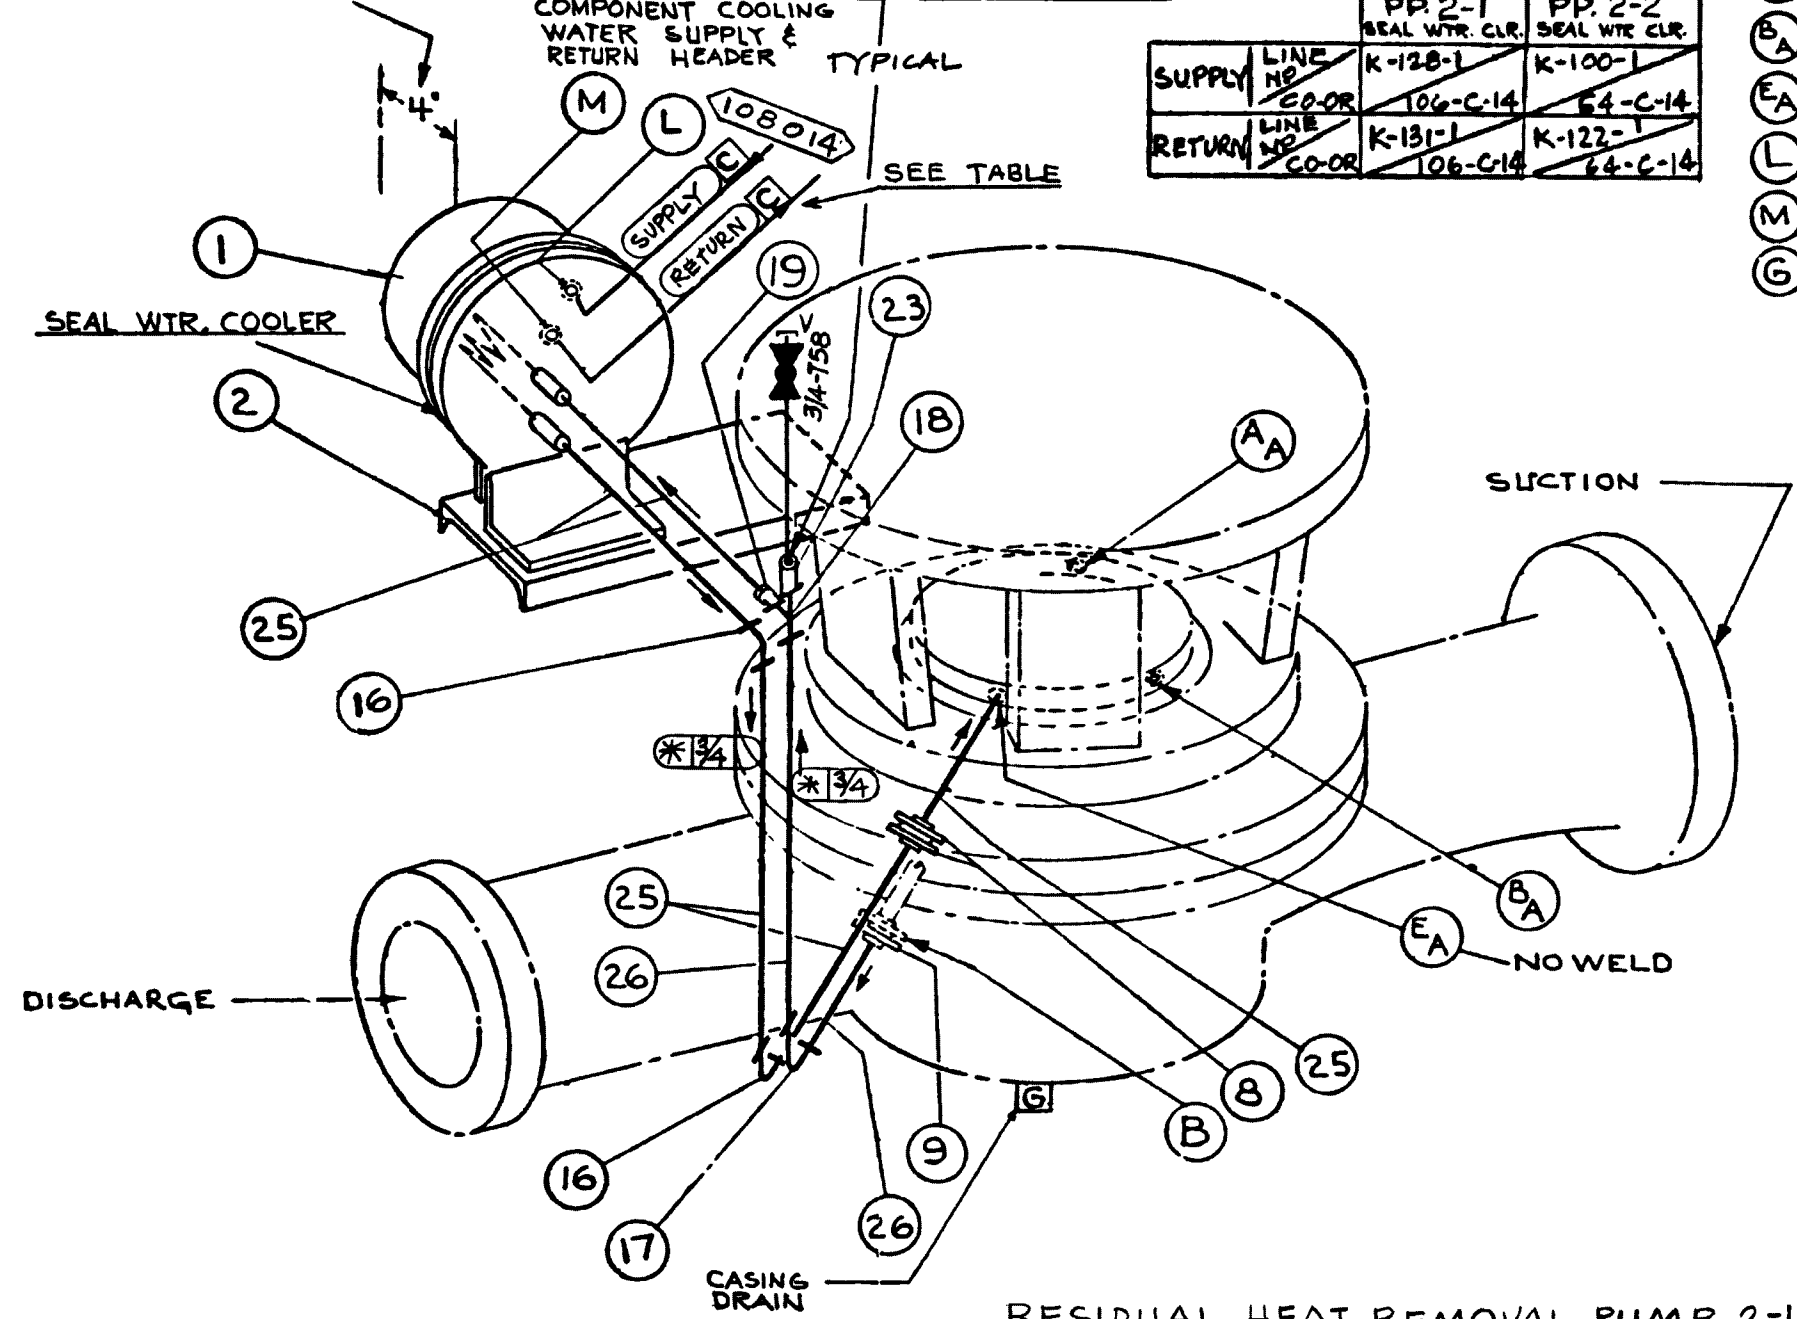


CAD User:RXG2 Date:10-06-2000
DGN=8010S4.DGN
RASTER=8010S4.TIF

UNIT 2

P G & E CO.		108010	REV. 16
SHEET 4	PAGE 0		

10/6/00	RXG2	NDNI	-	KERSI J. DALAL	MECHANICAL	M 16690	3/31/2004	Revised per FCT 025183
DATE	DWN	RE	IV	PROFESSIONAL ENGINEER	PE DISC.	PE#	PE EXP.	

SERVICE	PG&E INSTR.NO.	
	PUMP 1	PUMP 2
MOTOR OUTBD.BRG.TEMP./COORD.	TI-170 148E-35	TI-172 148E-35
MOTOR INBD.BRG.TEMP.	TI-171 148E-35	TI-173
MOTOR OUTBD.L.O.GAGE	LI-115	LI-117
MOTOR INBD.L.O.GAGE	LI-116	LI-118
MOTOR STATOR TEMP.	TI-509 TO-659A	TI-514 TO-665A
MOTOR STATOR TEMP.	TX-153	TX-223
MOTOR STATOR TEMP.	TX-154	TX-224
MOTOR STATOR TEMP.	TX-155	TX-225
MOTOR STATOR TEMP.	TX-156	TX-226
MOTOR STATOR TEMP.	TX-157	TX-227

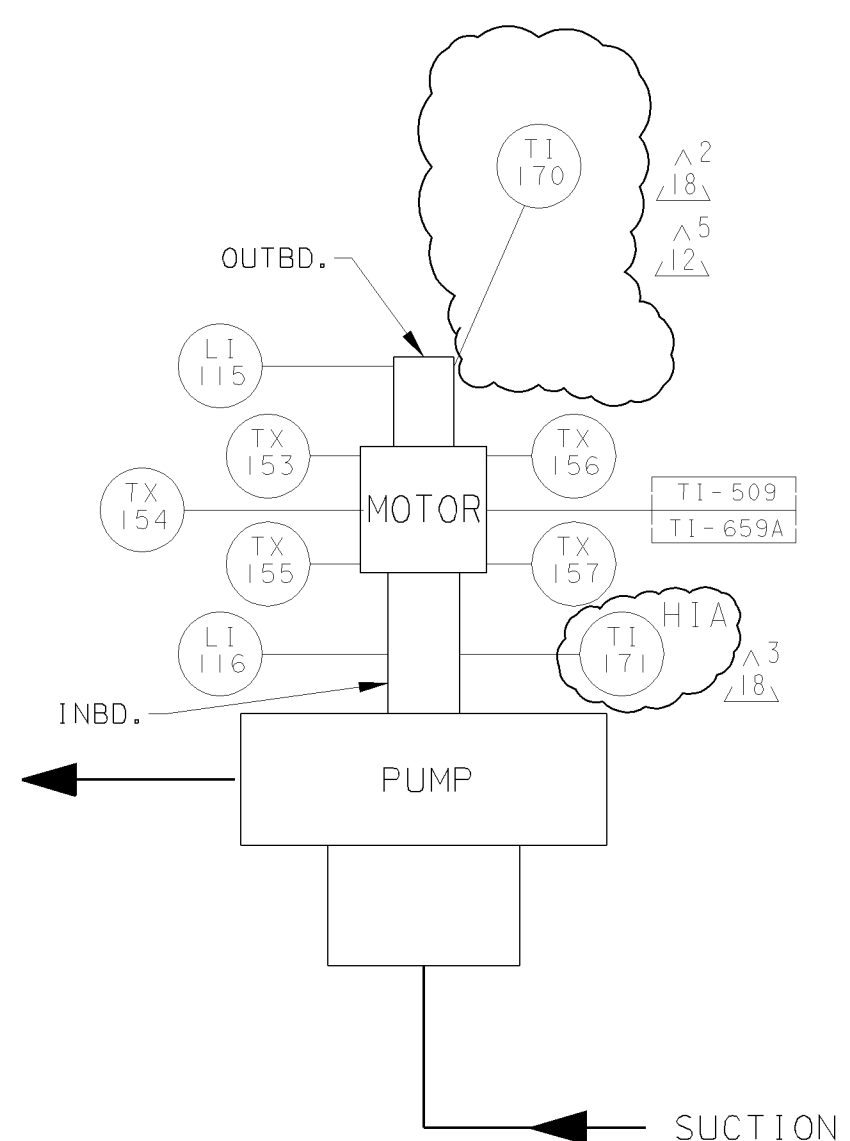


RESIDUAL HEAT REMOVAL
PUMP TYP.

REFERENCE DRAWING DC-663217-24

UNIT 2

DIABLO CANYON POWER PLANT - PG&E CO. RESIDUAL HEAT REMOVAL SYSTEM			
DRAWING	SHEET	PAGE	REV
108010	5	0	18

RASTER=8010s5.dgn
DGN=8010s5.dgn
CAD User: MIBF Date: 05-25-2006

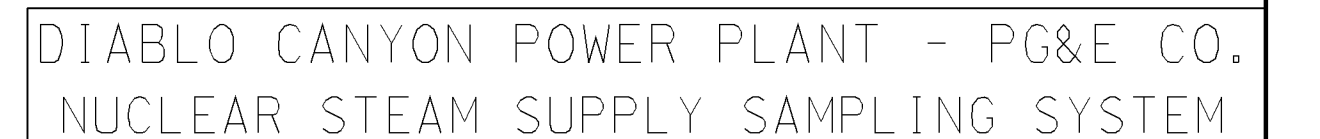

DRAWING 108011	SHEET 2	PAGE 0	REV 45
-------------------	------------	-----------	-----------

RASTER=001f1108.dgn
DGN=001f1108.dgn
CAD User: MIBF Date: 02-01-2006

A

B

C

D

E

30

31

32

33

34

35


36

37

38

39

MAKE-UP
WATER SUPPLY
(RINSE)

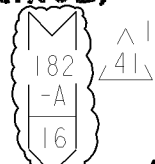



HOLD UP
TANKS 2-1, 2-2, 0-1
OUTLET SAMPLE



5-3065-3/8

5-3060-3/8

SAMPLE
GAS STRIPPER
FEED PUMP
2-2 2-1

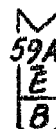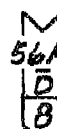

EVAP FD
ION EXCH'S
OUTLET SAMPLE




5-3061-3/8

5-3043-3/8

SPARE

5-887-3/8

SAMPLE EVAP COND
DEMINERALIZER
OUTLET INLET



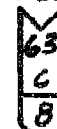


5-1329-3/8

5-1328-3/8

SPENT FUEL SYSTEM (SFS) POOL RECIRCULATION SAMPLES


SFS PUMP 2-1 DISCHARGE (PI-652)	SFS PUMP 2-2 DISCHARGE (PI-646)	RWP PUMP DISCHARGE (PI-674B)	SFS FILTER 2-1 DISCHARGE (PI-654)
25-D 13	25-D 13	24-C 13	20-E 13

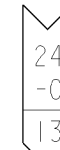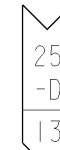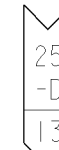

SAMPLE SINK 2-3
(S/C 74-6770)

*-3

S2-6174-1

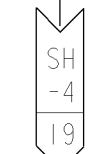


MEDT
0-1

NOTE 2
TYP OF (B)

NOTES:

1. ALL PIPE & TUBING ON THIS SHEET SHALL BE PG & E CLASS "E" & INSTRUMENT CLASS II RESPECTIVELY.
2. ALL VALVES EXCEPT AS NOTED SHALL BE "WHITEY" 6LR56 SPEC. 8802

SAMPLE SINK 2-2
DC-678611-154

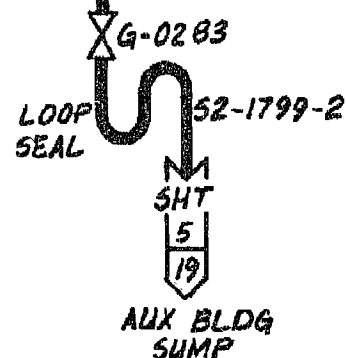

UNIT 2			
DIABLO CANYON POWER PLANT - PG&E CO.			
DRAWING	SHEET	PAGE	REV
108011	3	0	41

INPGIC
1 Size

02-01-2006	MIBF	KJD3		FRANCIS C. LING	MECHANICAL	M 16098	12/31/2007	REVISED PER FCT-030760
DATE	DWN	RE	IV	PROFESSIONAL ENGINEER	PE DISC.	PE#	PE EXP.	

40

41

42

43

44

45

46

47

48

49

A

B

C

D

E

THIS SHEET IS LEFT BLANK INTENTIONALLY

UNIT 1 HAS AN INTERIM POST LOCA SAMPLING SYSTEM INSTALLED
AND THE SCHEMATIC IS SHOWN ON SHEET 4 OF 102011.

UNIT 2 WILL NOT HAVE AN INTERIM POST LOCA SAMPLING SYSTEM.
THIS SHEET IS LEFT BLANK TO PRESERVE IDENTICAL
DRAWING SHEET COORDINATES FOR IDENTICAL SYSTEM
COMPONENTS IN BOTH UNITS.

UNIT-2

P.G. & E. CO.

DRAWING NUMBER

REVISION

SHEET 4 OF SHEETS

108011

1

RM INDEXED REV 1

MICROFILM


SCANNED

APR 26 1981

SCAN 1 IC



POST-LOCA SAMPLING SYSTEM

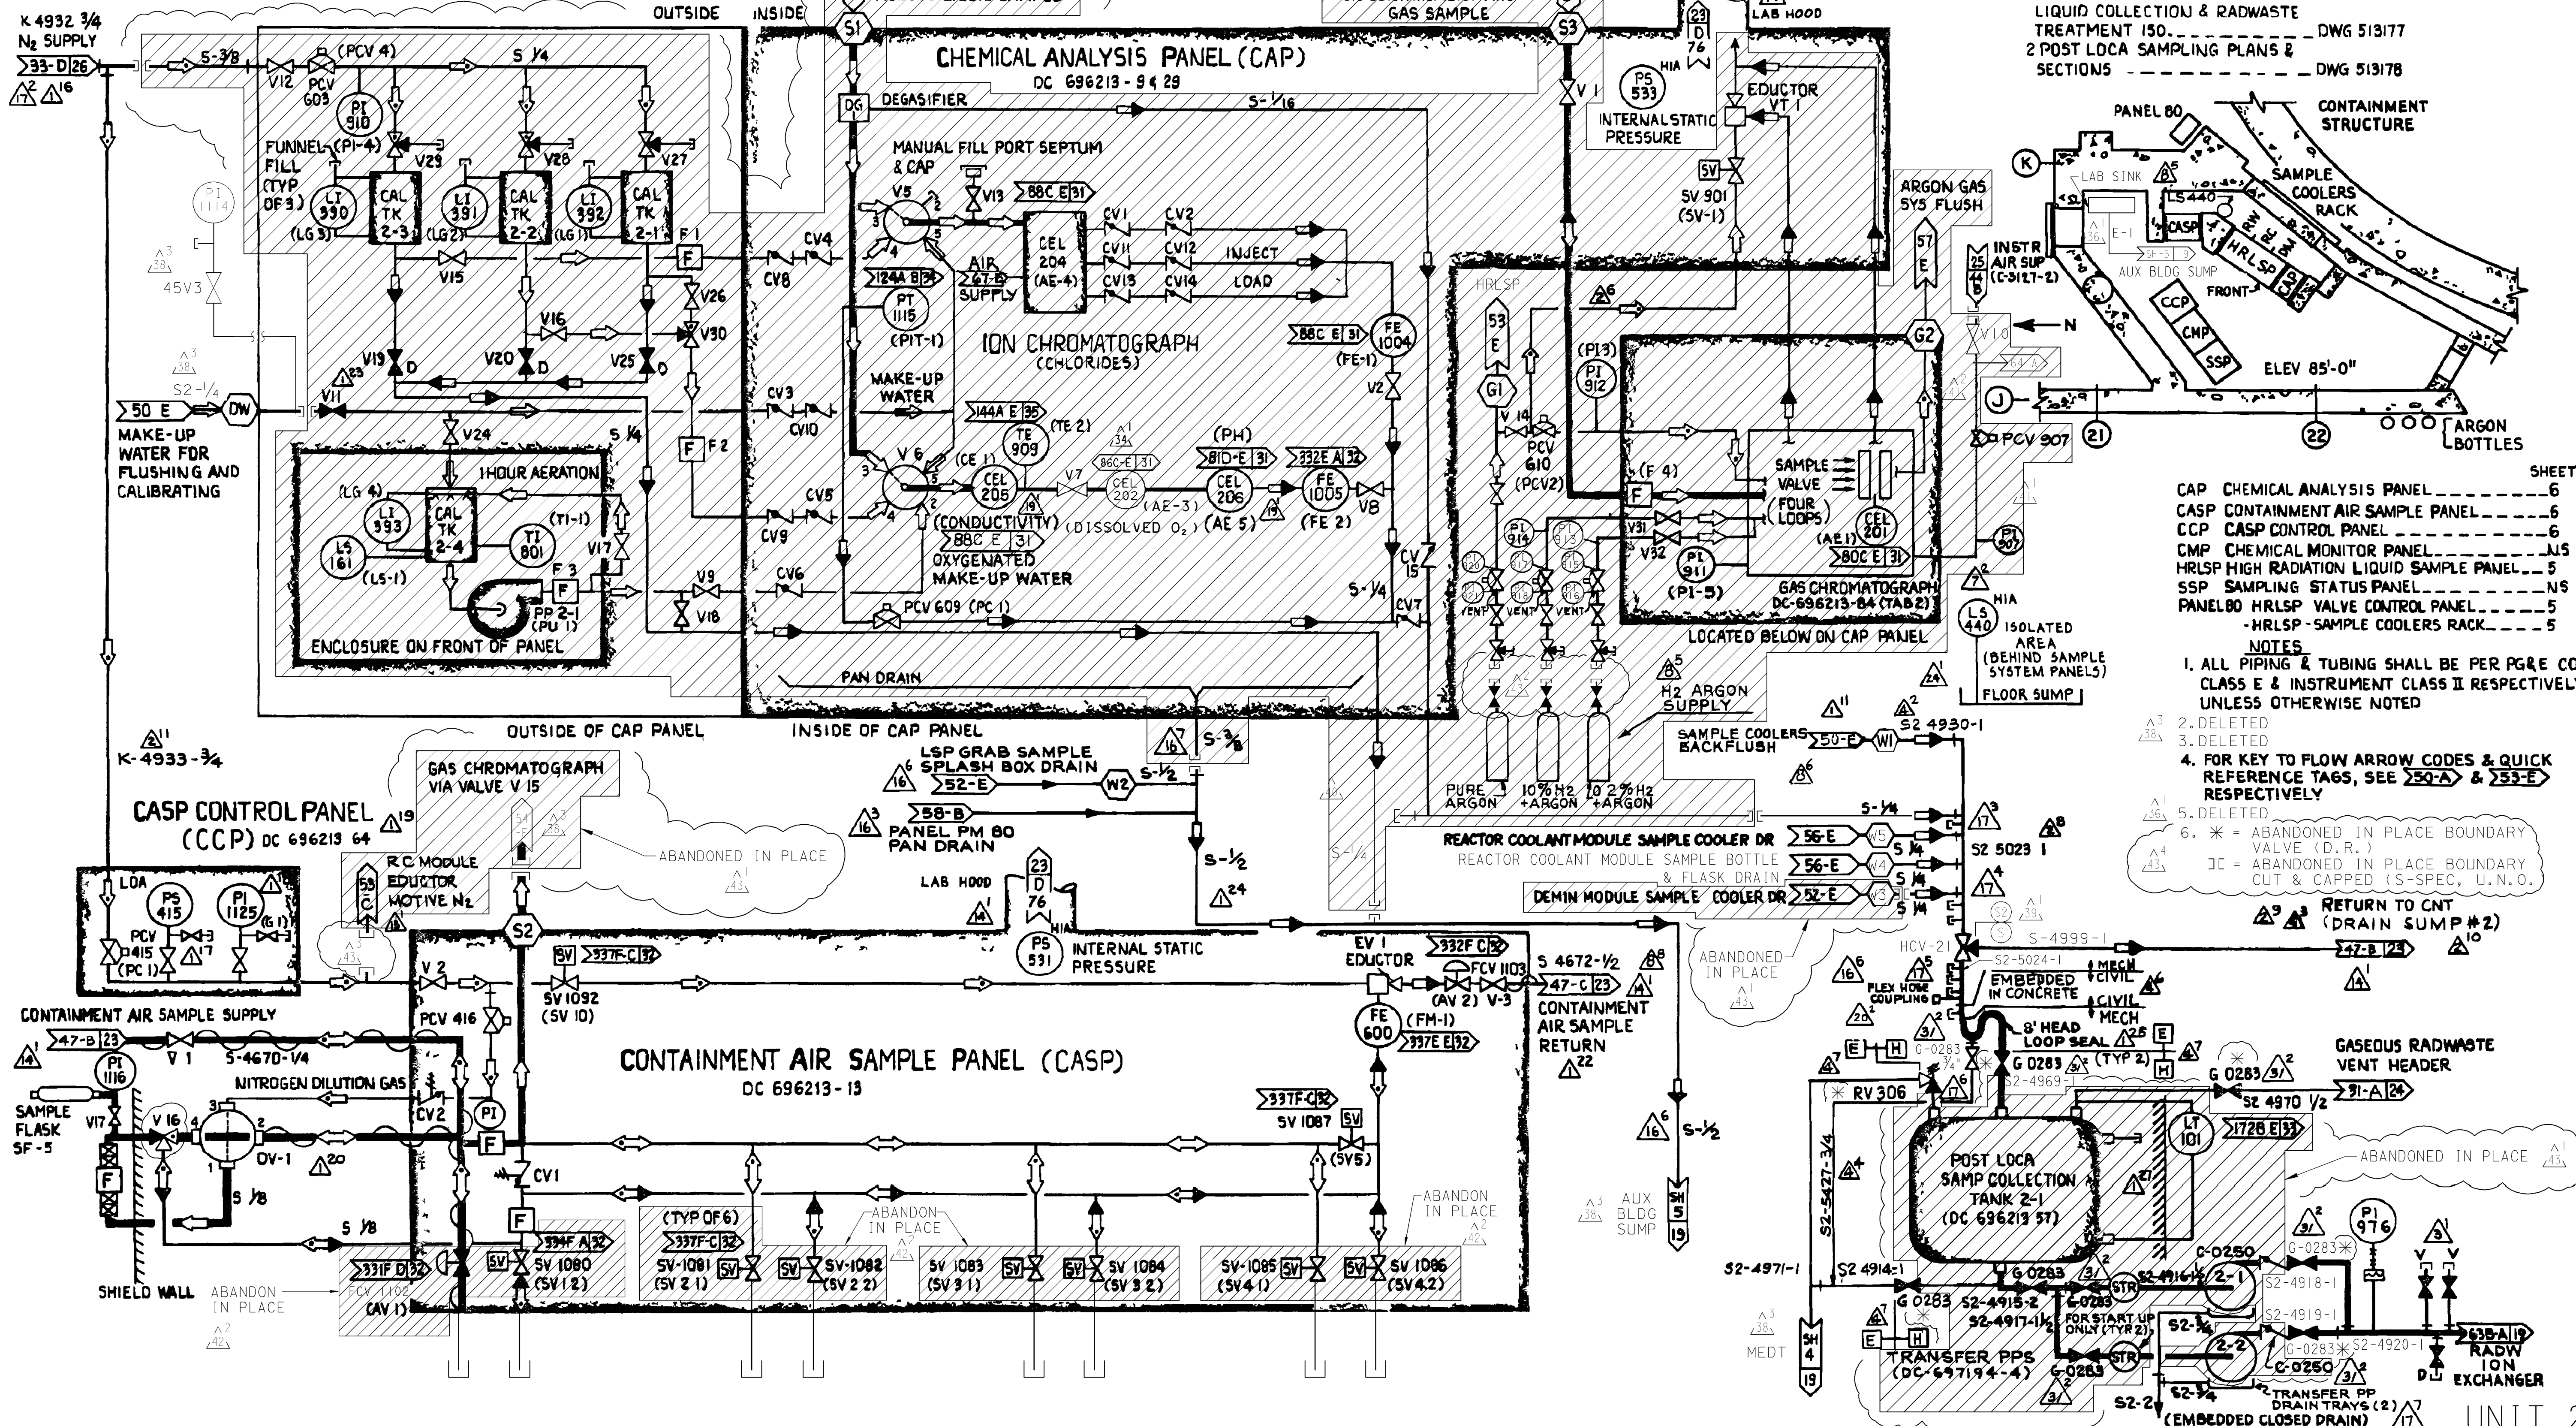

P G & E CO.


SHEET 6

PAGE 0

108011

REV.

43

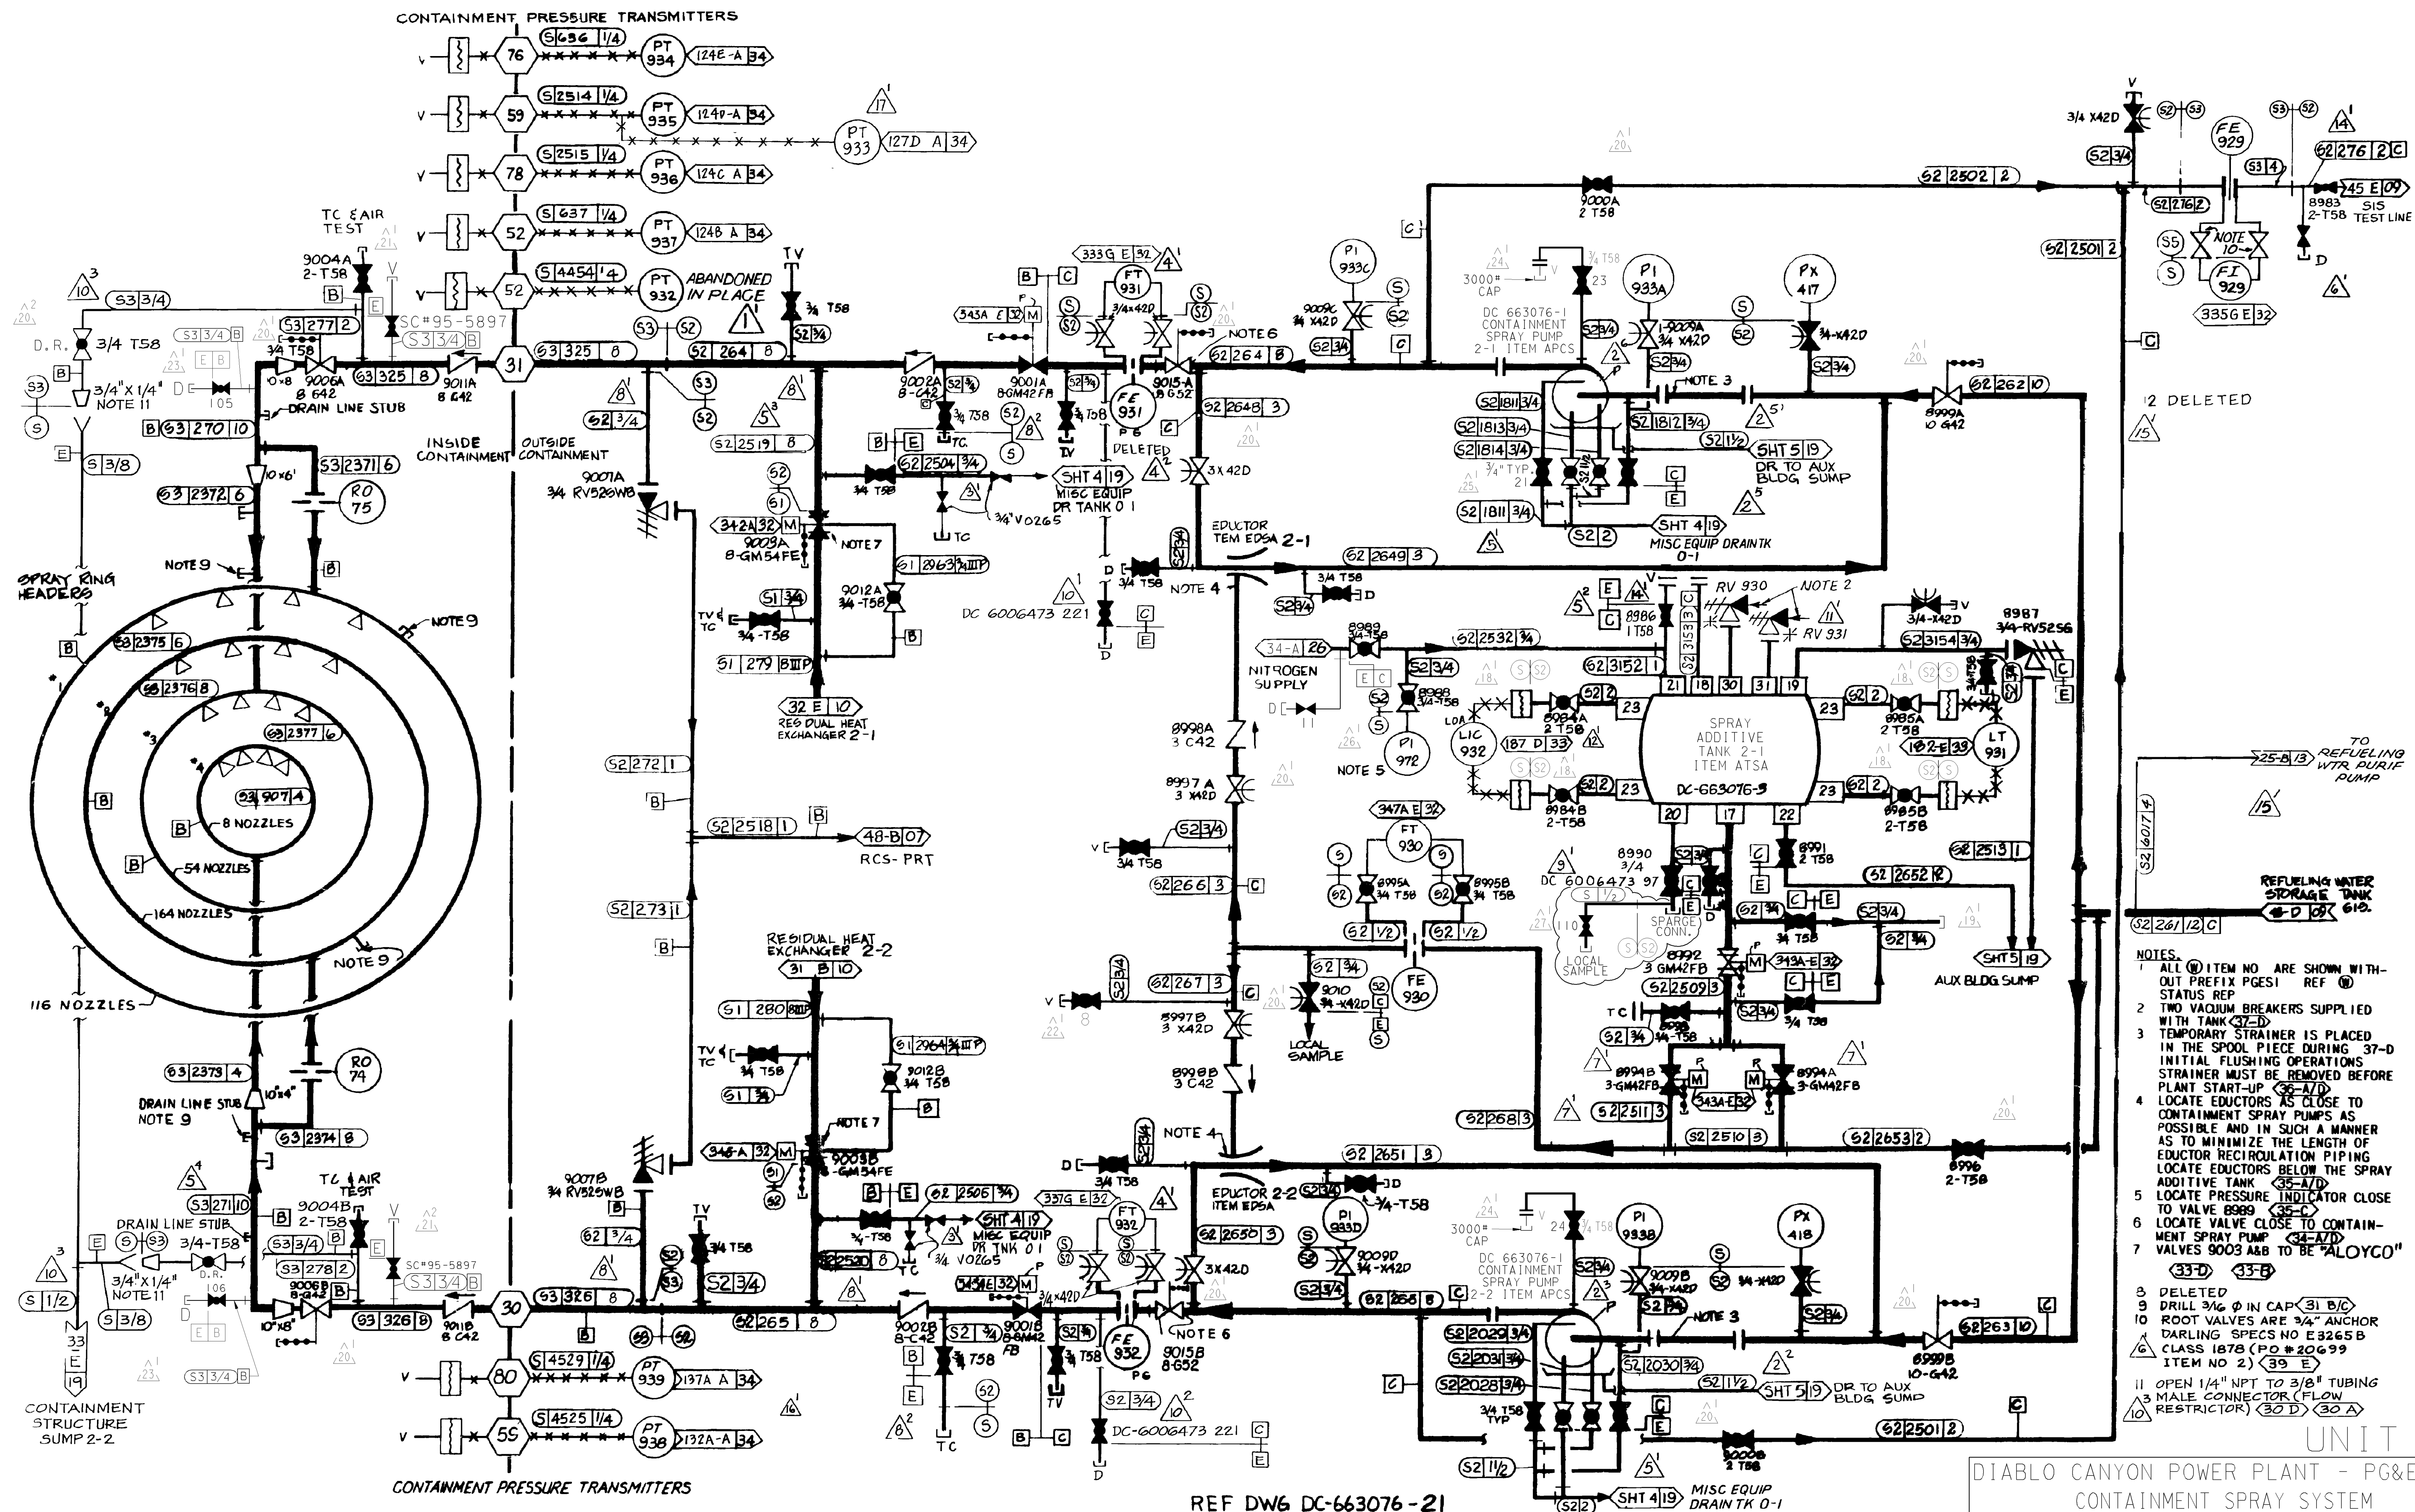


REF DWG DC-663076-21

DIABLO CANYON POWER PLANT - PG&E CO. CONTAINMENT SPRAY SYSTEM

DRAWING	SHEET	PAGE	REV
080 2	3	0	27




RASTER=I08012S3.dgn
DGN=I08012S3.dgn
CAD User: AJFJ Date:

03-23-2011	AJFJ	FxC2		KERSI J. DALAL	MECHANICAL	M 16690	3/31/2012	REVISED PER DDT-4*488-0
DATE	DWN	RE	IV	PROFESSIONAL ENGINEER	PE DISC.	PE#	PE EXP.	

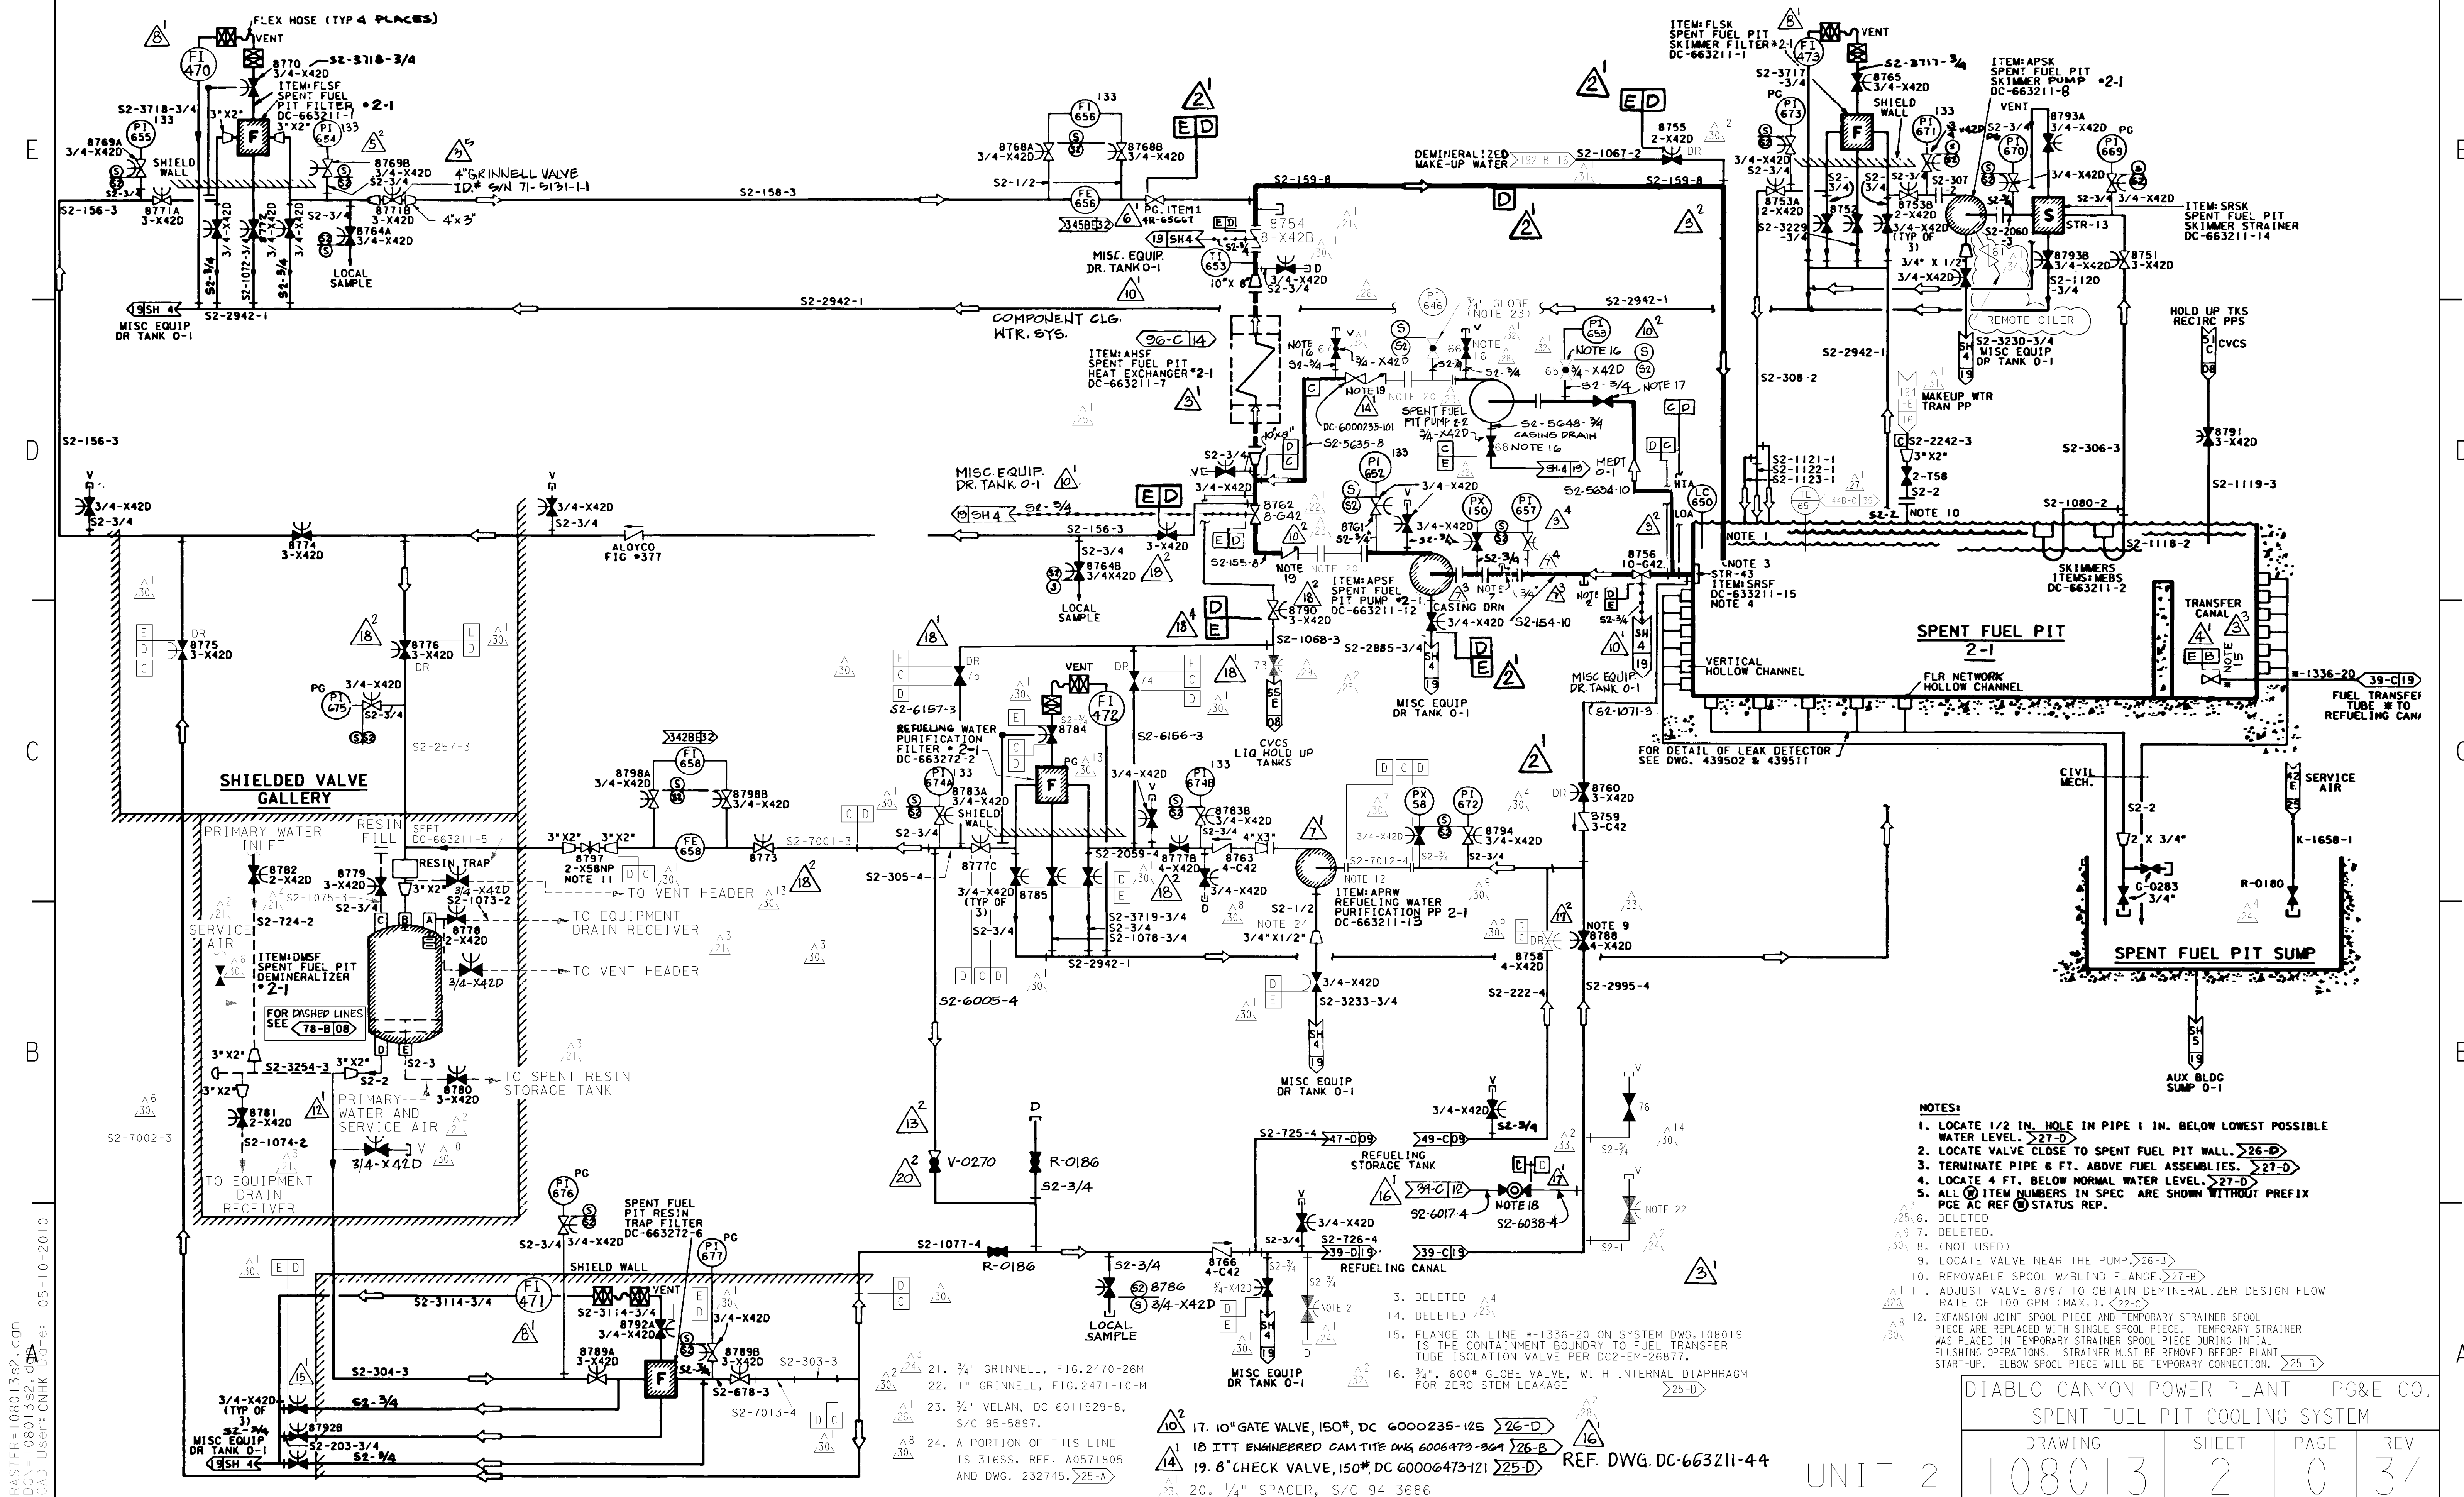


E
D
C
B
A

COMPONENT COOLING WATER PUMPS
DC-663213-2

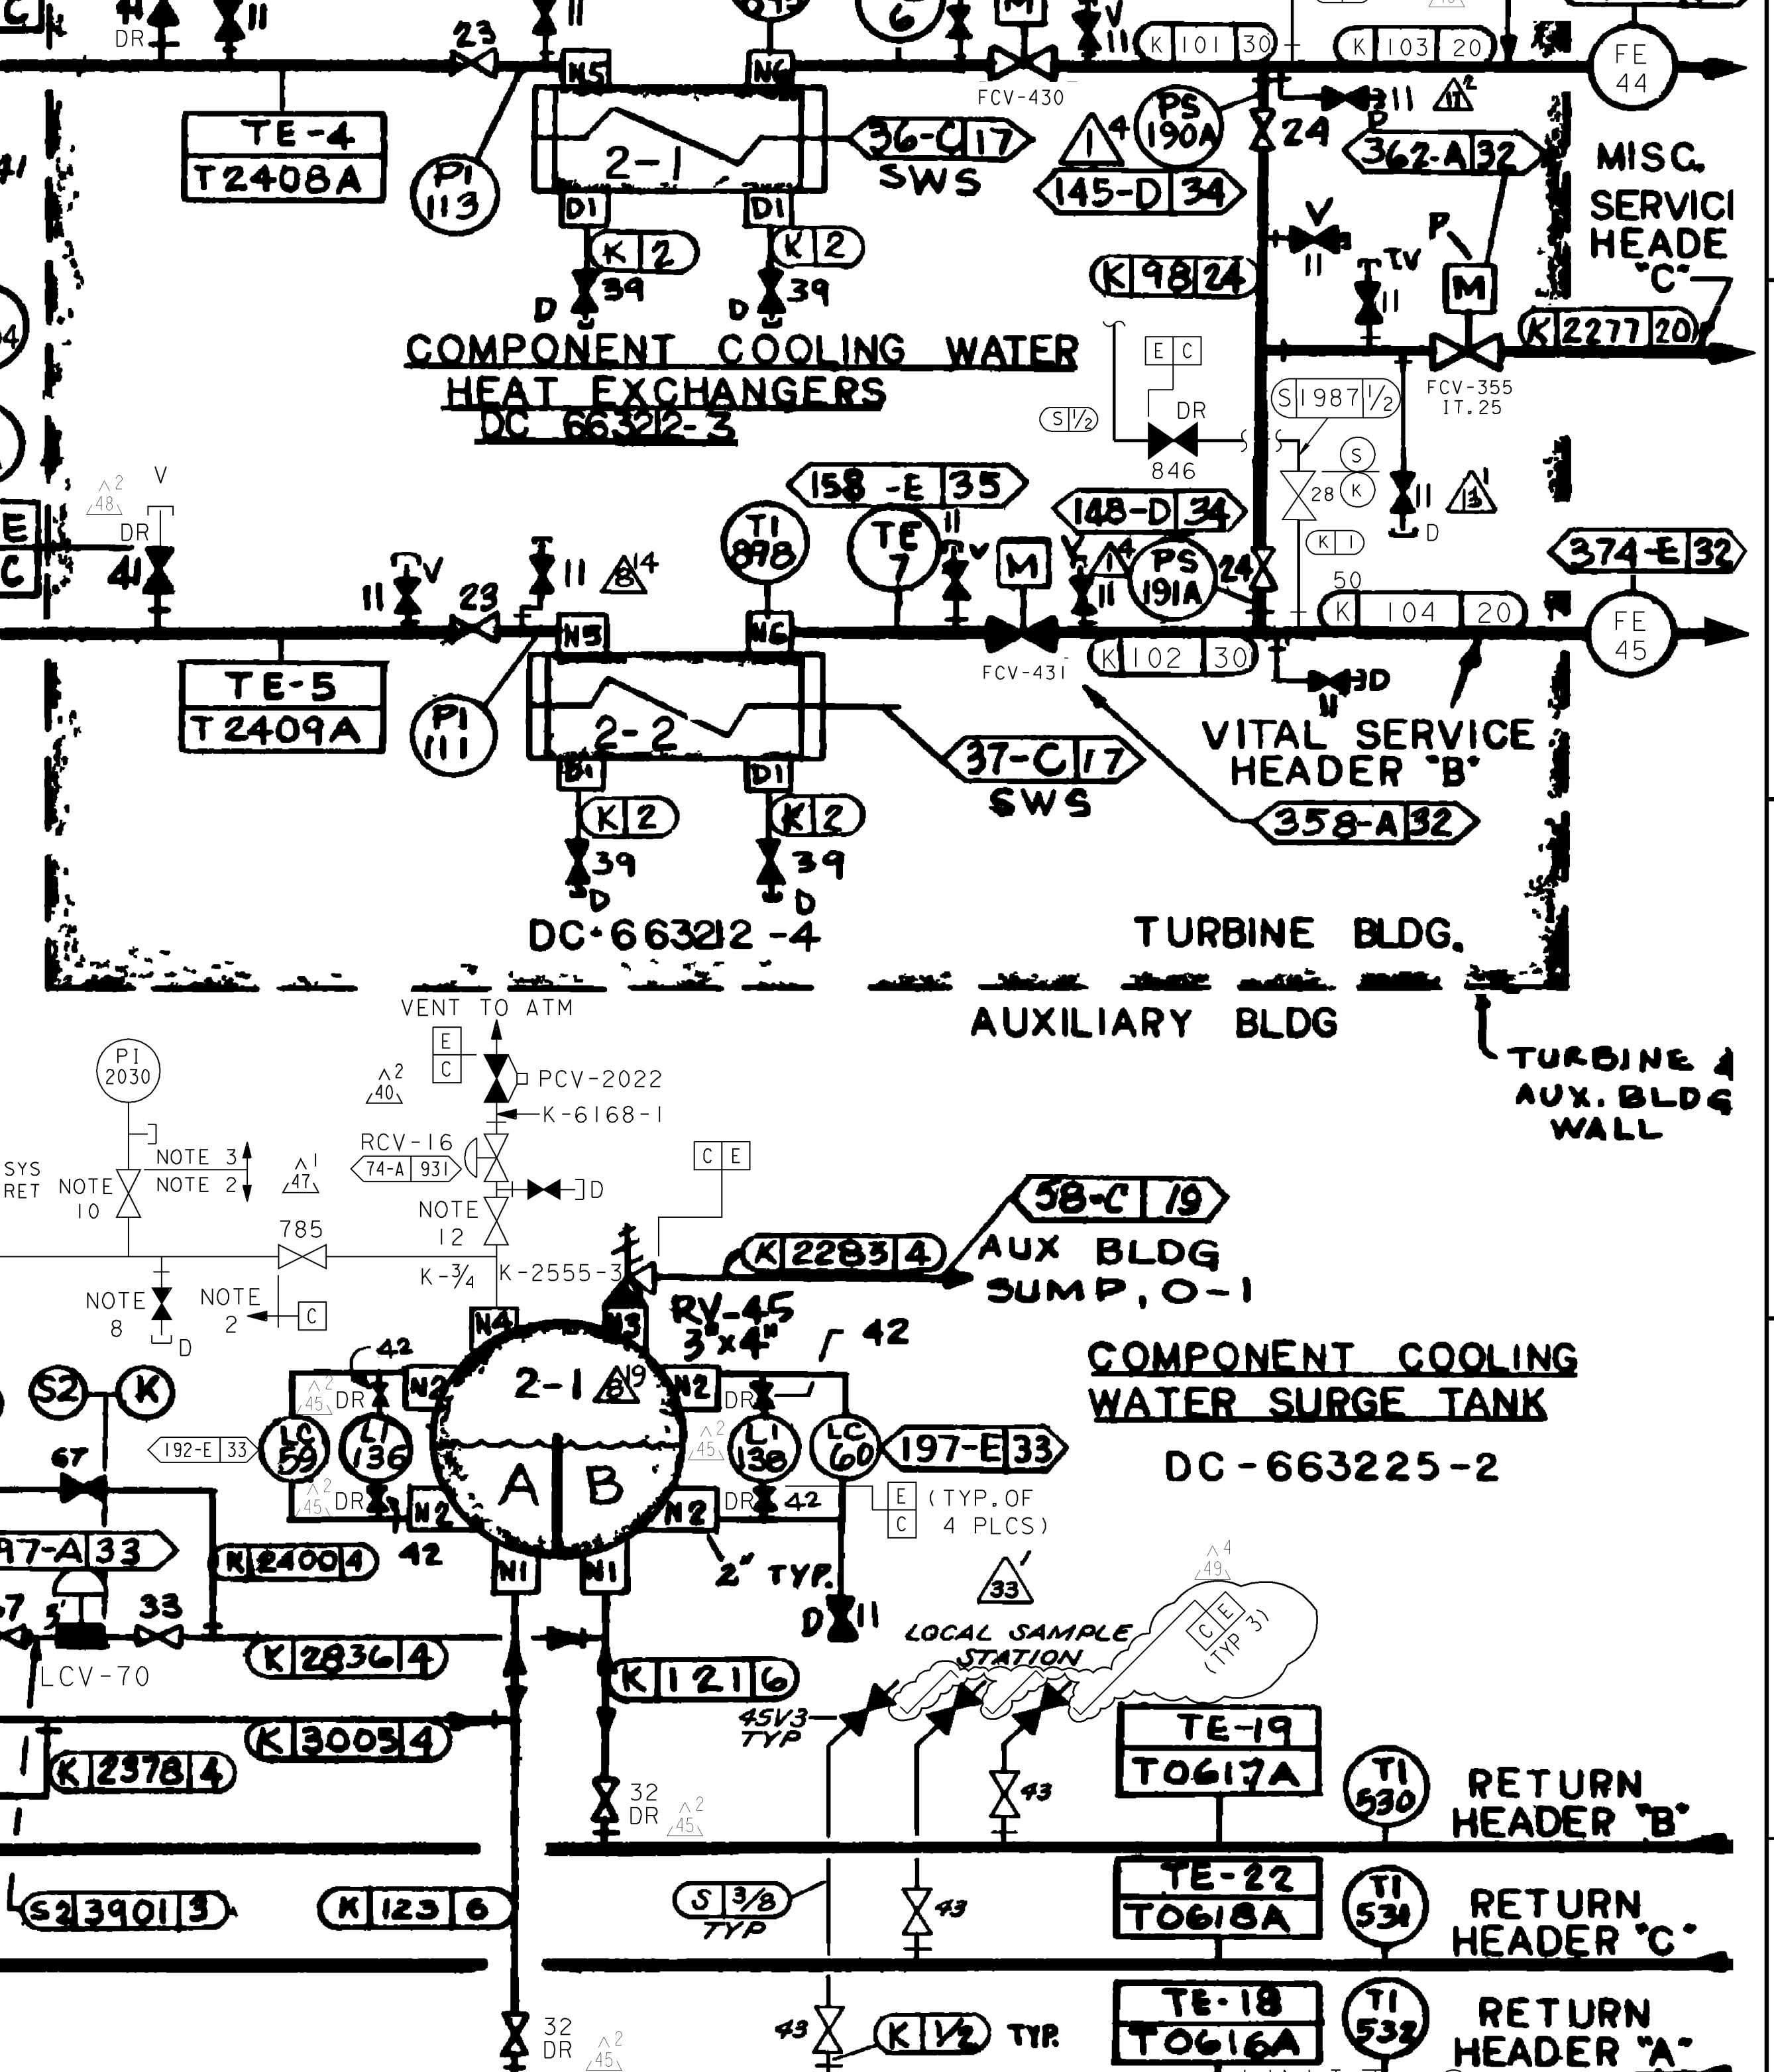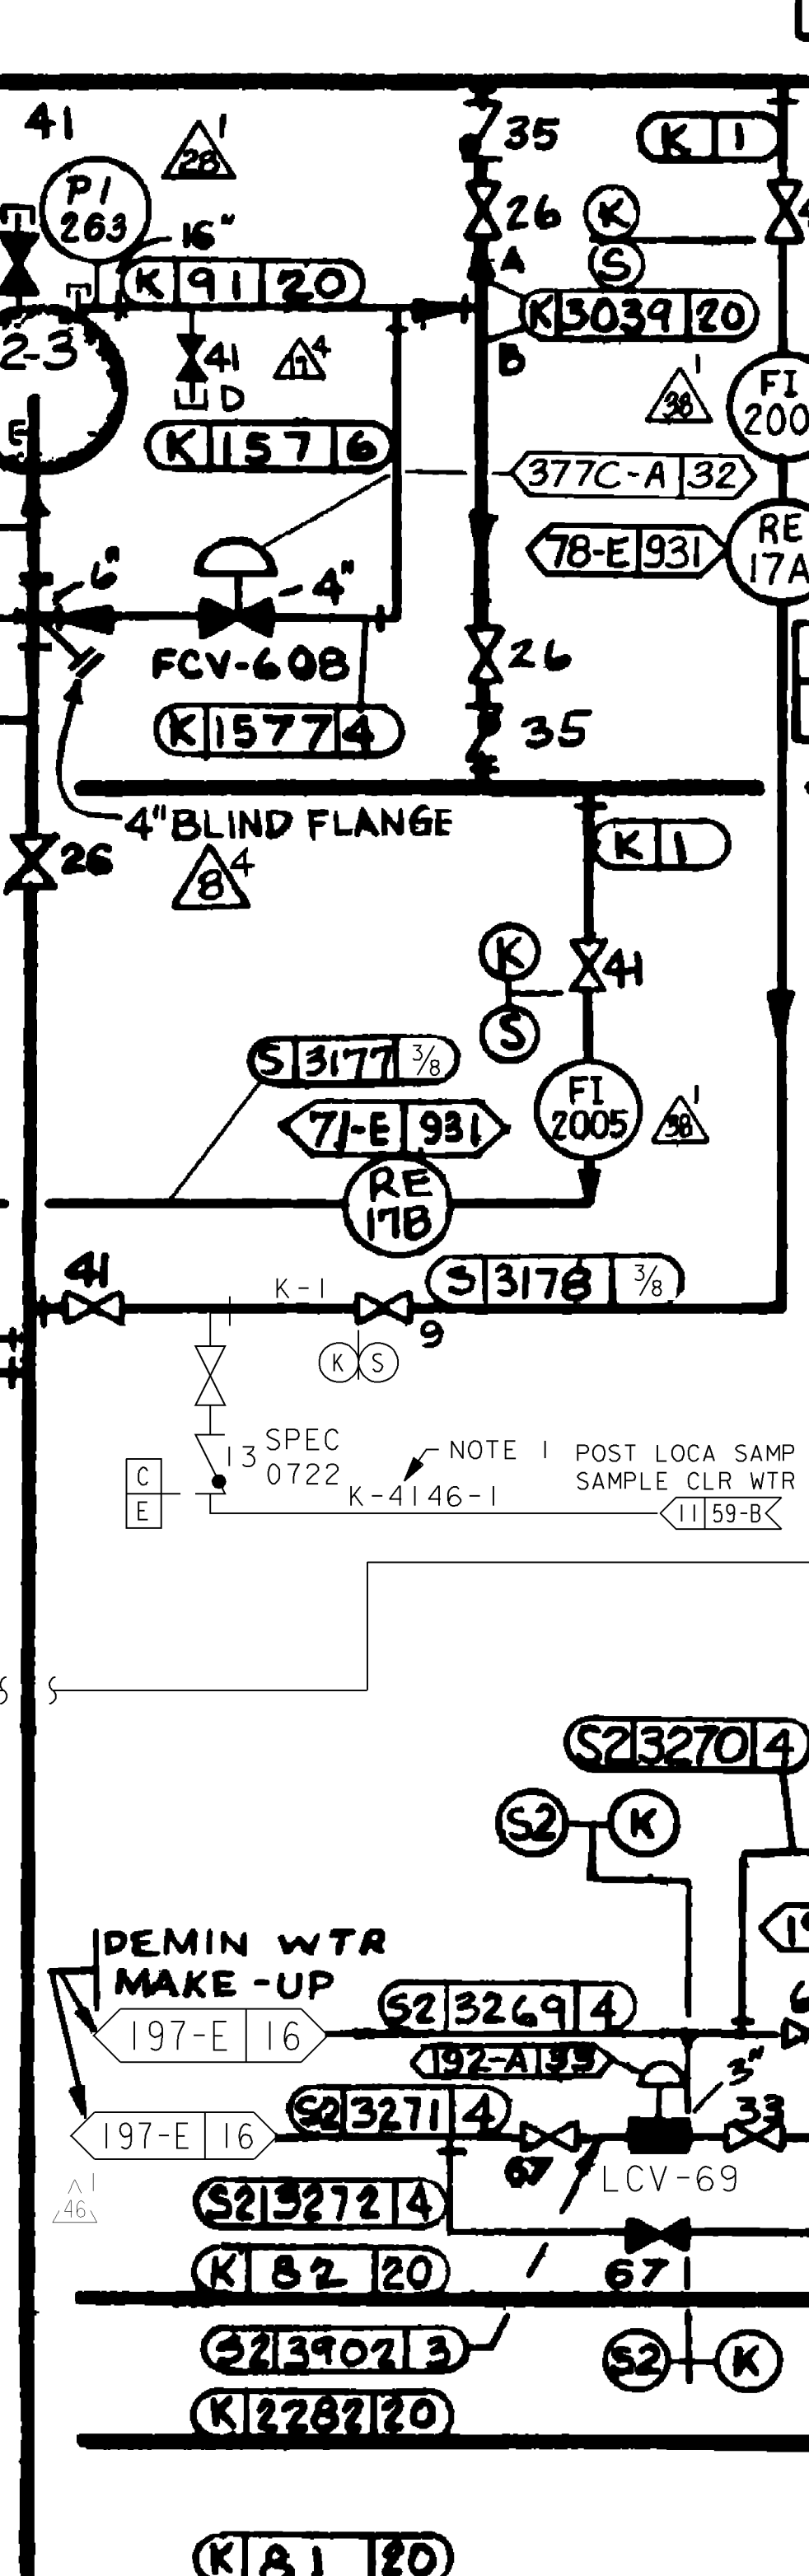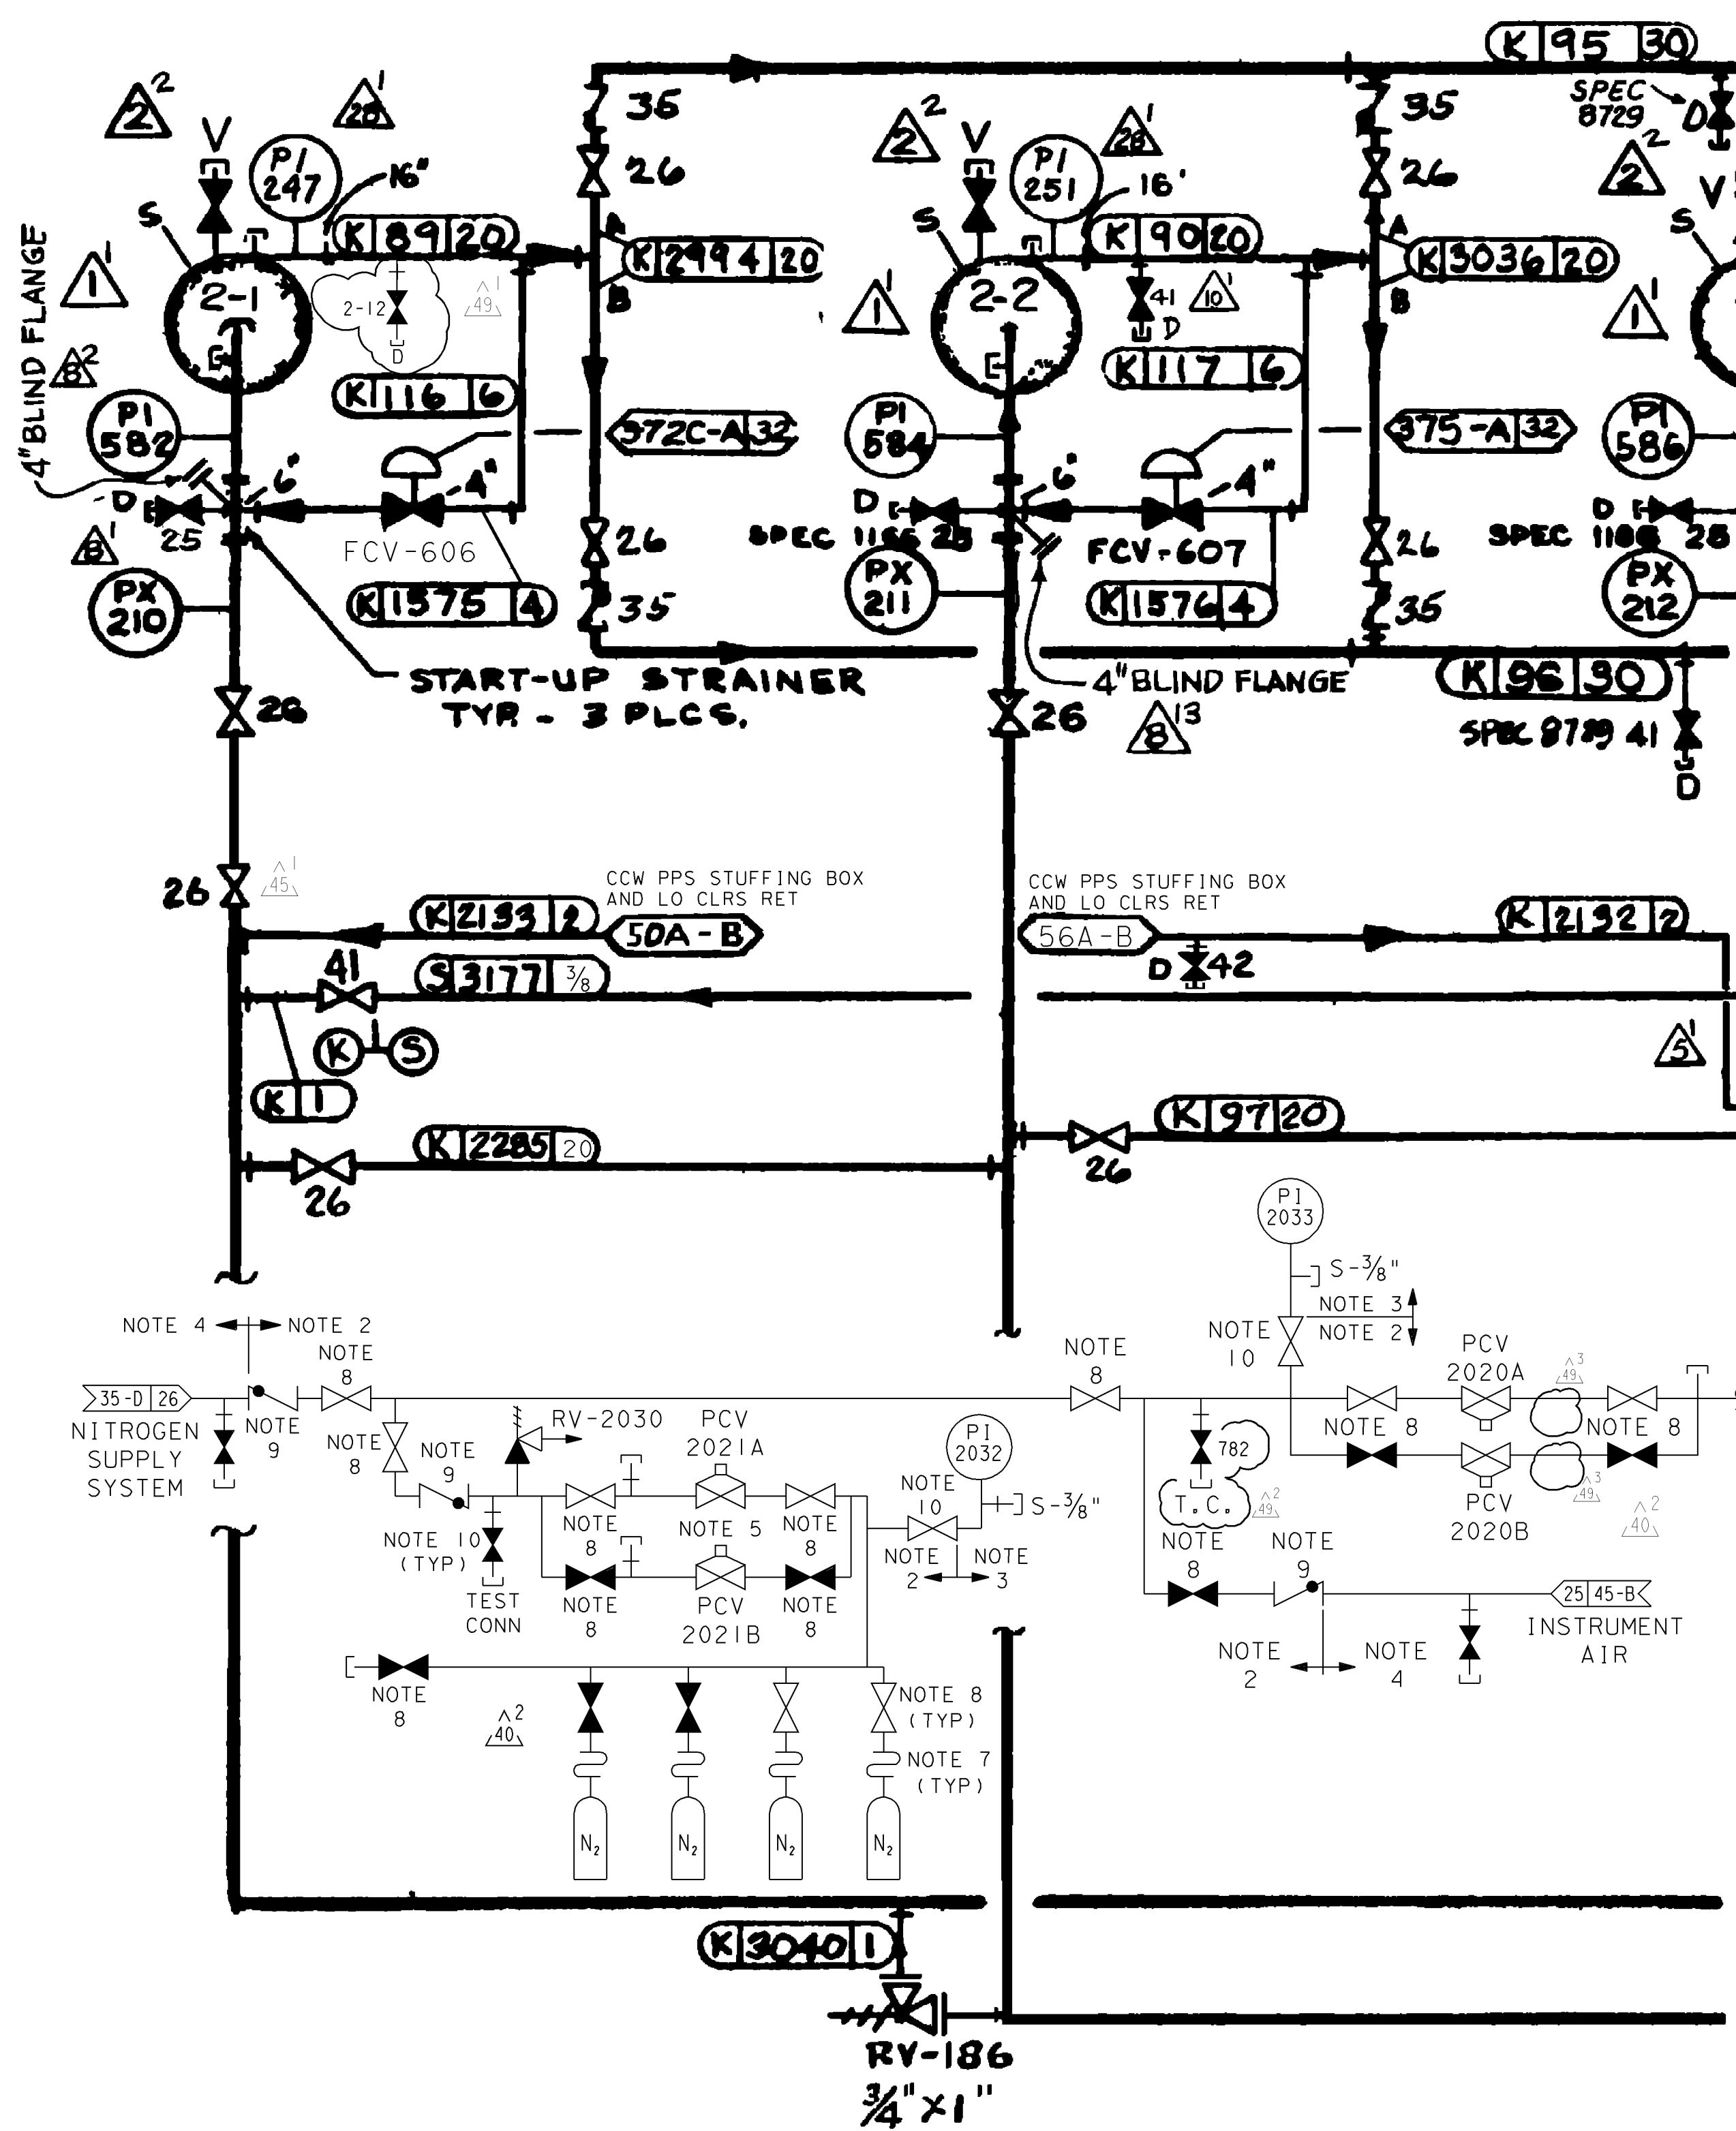

- NOTES:
1. CODE CLASS "E" PORTION OF LINE 4146 SHALL BE SEISMICALLY ANALYZED TO DESIGN CLASS I CRITERIA (55-C)
 2. INSTRUMENT DESIGN CLASSIFICATION ID (53-B) (56-C)
 3. INSTRUMENT DESIGN CLASSIFICATION IC (53-C) (56-C)
 4. INSTRUMENT DESIGN CLASSIFICATION II (53-B)
 5. PCV HAS AN INTEGRAL RELIEF VALVE
 6. UNLESS SPECIFIED OTHERWISE THE SURGE TANK PRESSURIZATION LINES ARE 3/4" x 0.065" WALL SS TUBING
 7. 1/2" FLEXIBLE TUBING, SWAGelok NO. 8R-8
 8. WHITEY MODEL NO. SS-63ES12 (53-B) (56-C)
 9. NUPRO MODEL NO. SS-CH16S12-1 (53-B)
 10. 3/8" WHITEY MODEL NO. SS-43ES6-SH (53-B) (56-C)
 11. DELETED
 12. VALVE, PG&E DWG. 6011929-34, S/C 95-4119 (56-C)
 13. VALVE (SEALED CLOSED) REC. DWG. 6006473-40, S/C 93-6847 (58-B)

DIABLO CANYON POWER PLANT - PG&E CO. COMPONENT COOLING WATER SYSTEM			
DRAWING	SHEET	PAGE	REV
108014	5	0	49

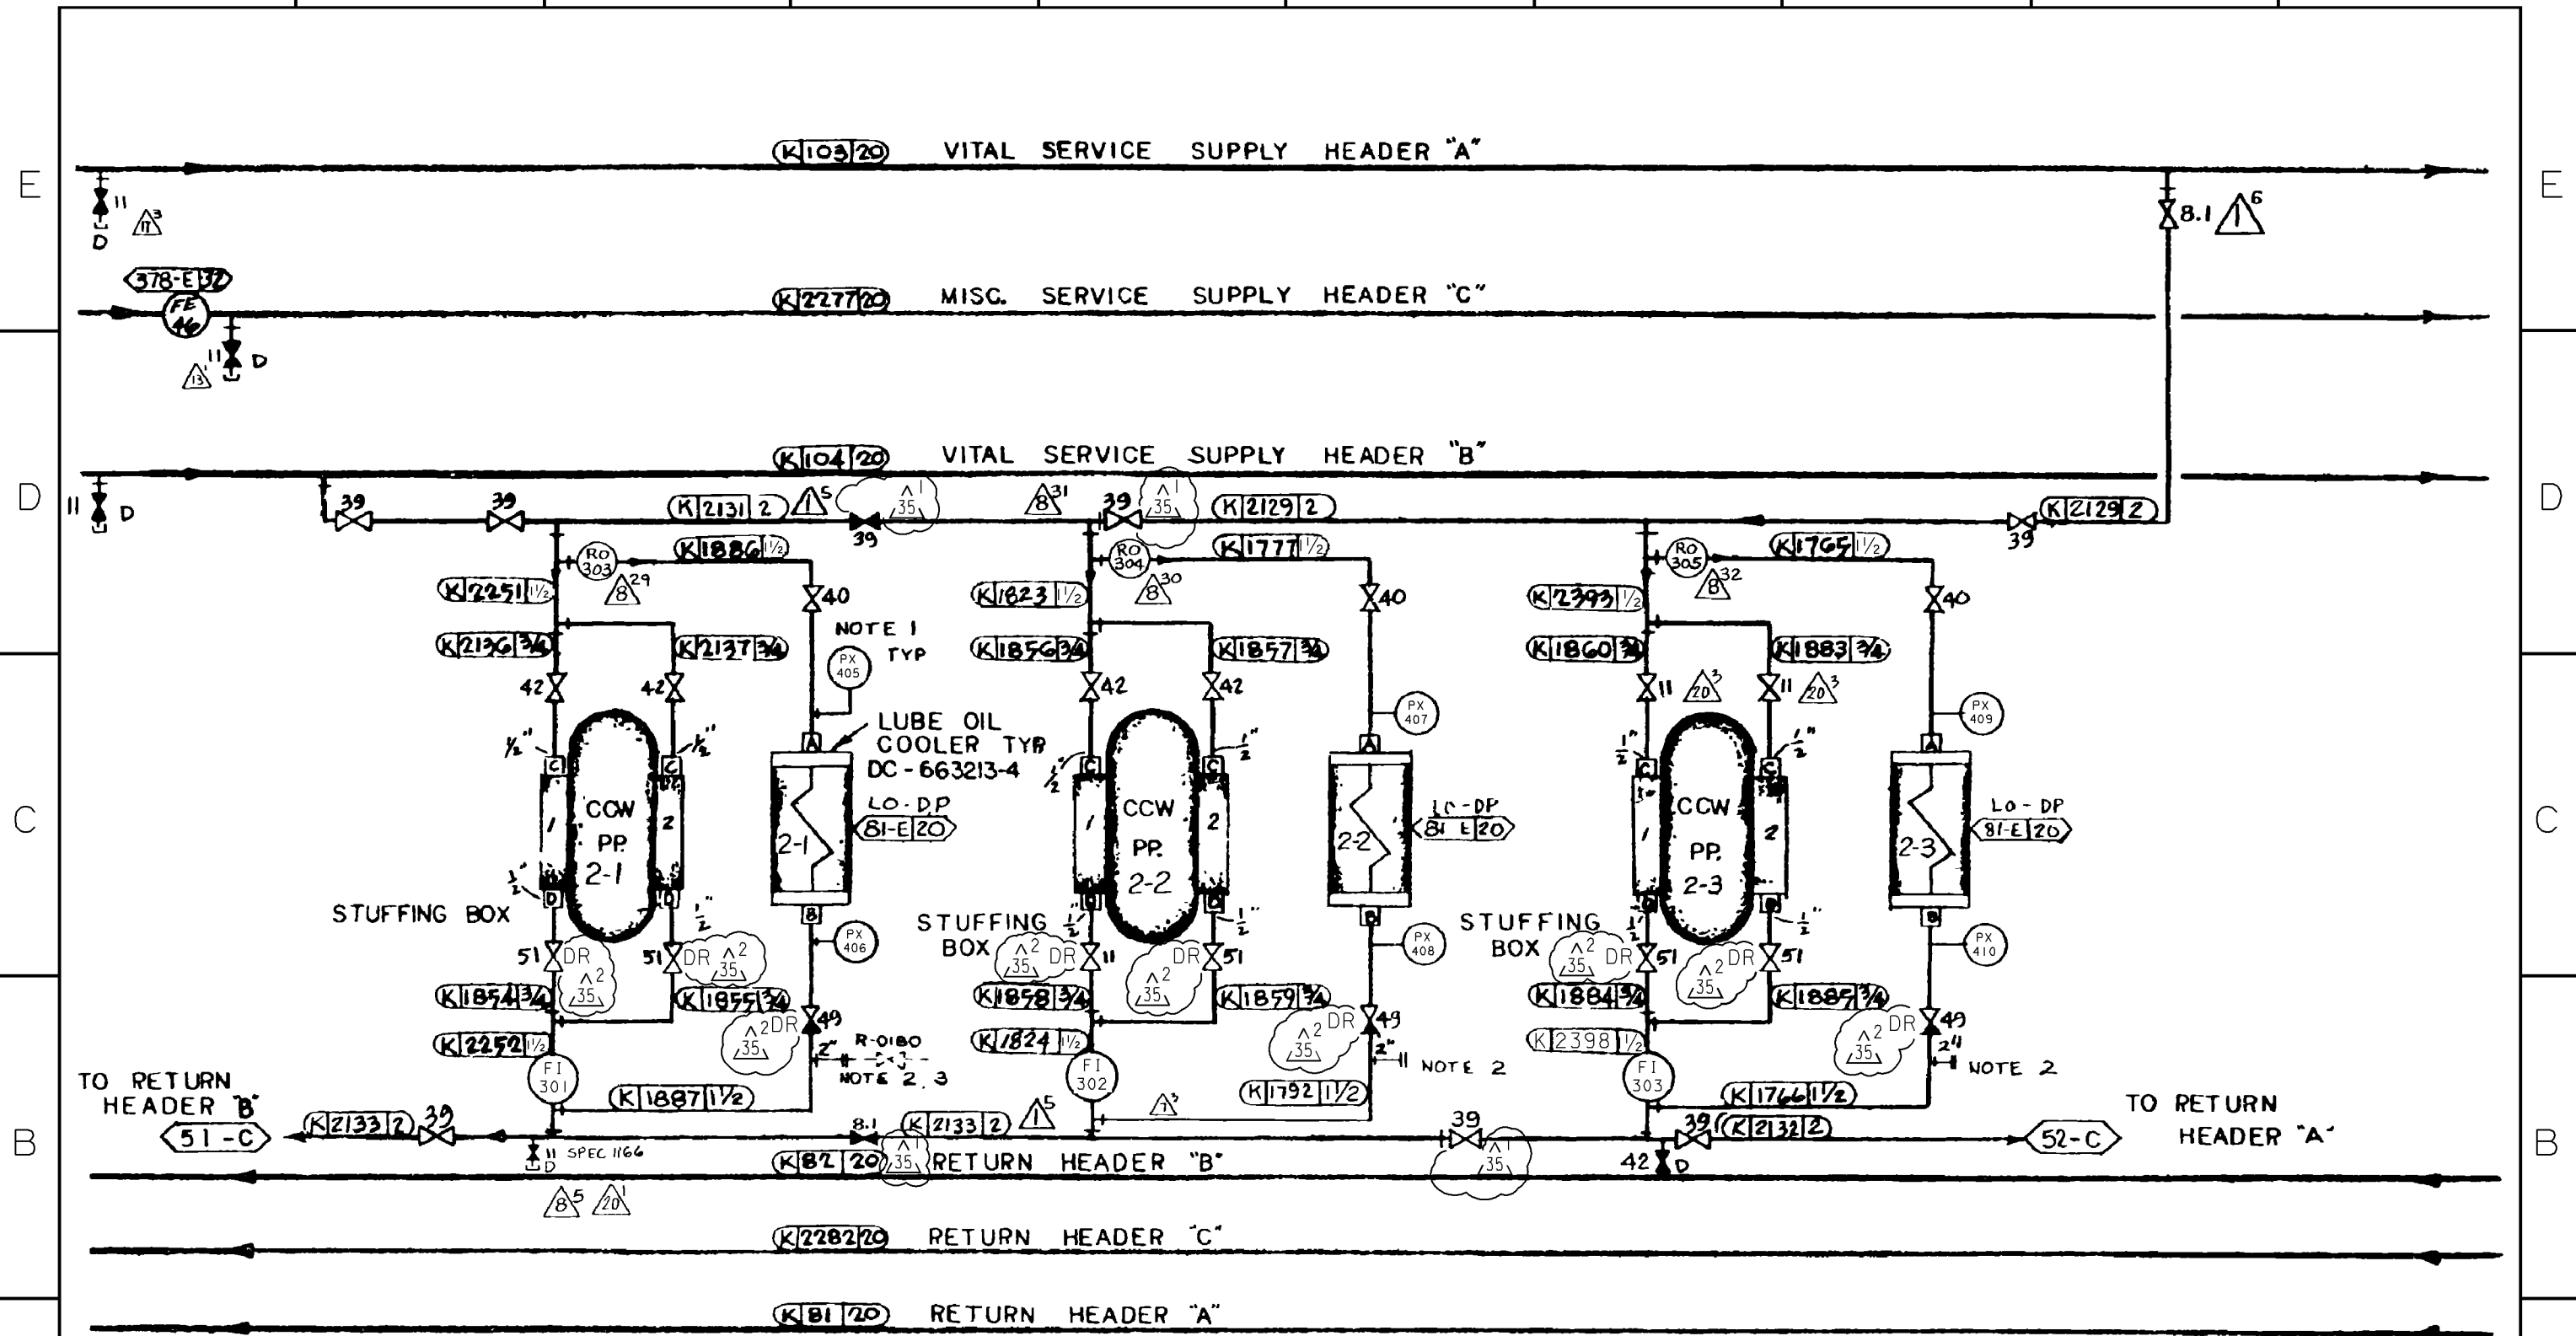

NOTES:

1. PXS TO BE LOCATED WITHIN 1' OF HEAT EXCHANGER (53A-D)
2. LOCATE FLANGE FOR EASY CONNECTION OF TEMPORARY VALVE AND PRESSURE TEST GAGE. REPLACE WITH BLIND FLANGE AFTER TEST (53A-B)
3. VALVE IS NON-CLASS I. 2" BALL VALVE WITH 2" FLANGE AT ONE END AND 2" MALE NIPPLE AT OTHER END. ONLY ONE VALVE WILL BE USED AT SEVERAL


3 (CONT.) TEST POINTS, REMOVE VALVE PRIOR TO OPERATION. SYS IS CLASS I (53A-B)

UNIT 2

P G & E CO.		108014	REV. 35
SHEET 5A	PAGE 0		

3/2/01	PMH2	FXC2	-	KERSI J. DALAL	MECHANICAL	M 16690	3/31/2004	Revised per FCT 025489
DATE	DWN	RE	IV	PROFESSIONAL ENGINEER	PE DISC.	PE#	PE EXP.	

8. THE INSTRUMENT AIR TO FCV-360 AND TCV-27 HAS BEEN ISOLATED. BOTH VALVES ARE FULLY OPEN. 66-B

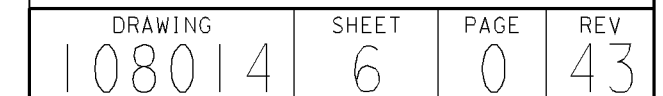




DRAWING	SHEET	PAGE	REV
108014	6A	0	30

 $\triangle q'$

09-30-2009	AJFJ	FxC2		KERSI J. DALAL	MECHANICAL	M 16690	3/31/2010	REVISED PER DDN-2*171
DATE	DWN	RE	IV	PROFESSIONAL ENGINEER	PE DISC.	PE#	PE EXP.	

NOTES:
1. ST. GEN. BLOWDOWN SAMPLE COOLERS & COND. FOR SGBDTV
SAMPLE ARE DESIGN CLASS II & SEISMICALLY ANALYZED PER
DESIGN CRITERIA MEMORANDUM T-10 (FORMERLY M-61) (95/96-C)
2. DELETED
3. CODE CLASS "E" PORTIONS OF LINES 4172 & 4173 SHALL BE
SEISMICALLY ANALYZED TO DESIGN CLASS I CRITERIA. (95-B,D)

4. S/C 93-5909, DWG. 6006473-8 (92-B)
5. S/C 94-3774, DWG. 6006473-141 (93-B)
6. S/C 93-6841, DWG. 6006473-166 (93-B)
7. 1/4" THICK BLIND PLATE INSTALLED BETWEEN FLANGES.

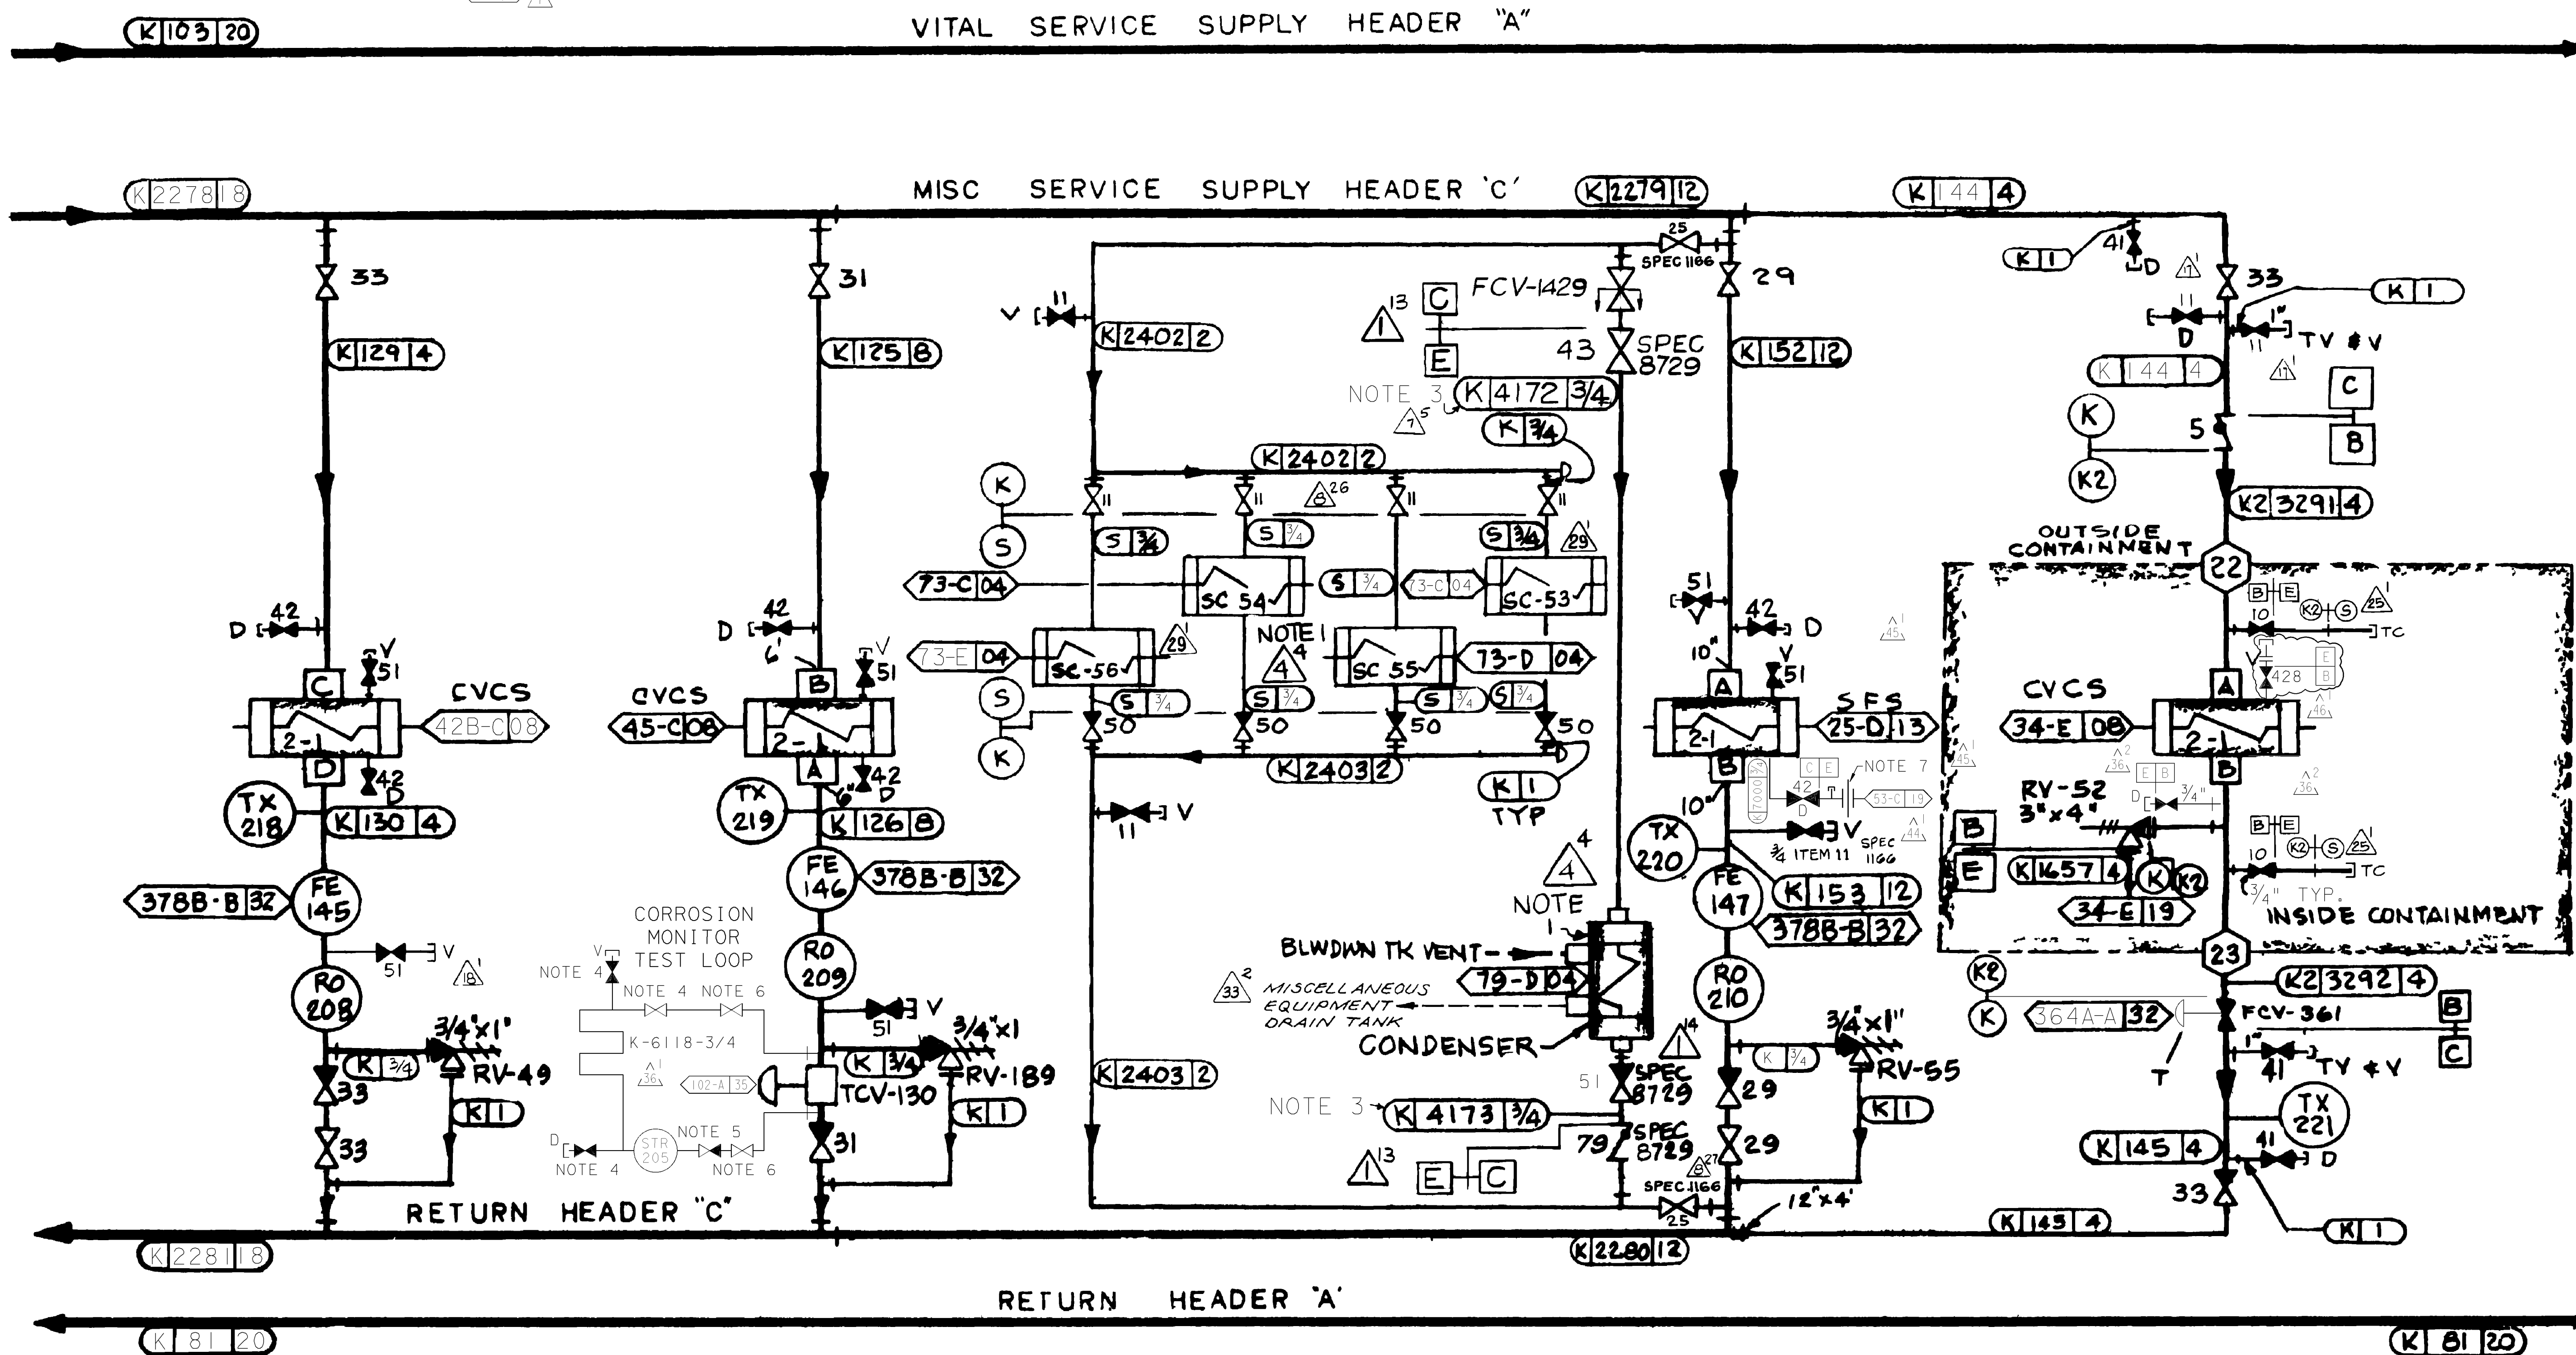

SEAL WATER HEAT
EXCHANGER
DC-663210-7

LETDOWN HEAT
EXCHANGER
DC-663210-11

STEAM GENERATOR BLOWDOWN
SAMPLE COOLERS
FOR RADIATION MONITORS
DC-663095-3

HEADER "C"
COMPONENTS

SPENT FUEL PIT
HEAT EXCHANGER
DC-663211-7

EXCESS LETDOWN HEAT
EXCHANGER
DC-663210-12


UNIT - 2

P G & E CO.		108014	REV. 46
SHEET 9	PAGE 0		

NOTES CONT: 8. DRAIN W/ QUICK-DISCONNECT COUPLING W/ INTEGRAL CHECK VALVE FOR EMERGENCY TIE-IN TO FIRE PROTECTION SYSTEM (108018-5A). COUPLING TO BE REMOVED WHEN DRAINING IS REQUIRED.

9. DRAIN W/ QUICK-DISCONNECT COUPLING W/ INTEGRAL CHECK VALVE. DRAIN HOSE TO BE ATTACHED FOR ROUTING FLOW TO FLOOR DRAINS WHEN FPS TIE-IN (NOTE 8) IS OPERATIONAL. COUPLING TO BE REMOVED WHEN DRAINING IS REQUIRED.

10. THE INSTRUMENT AIR TO FCV-366 AND TCV-28 HAS BEEN ISOLATED. BOTH VALVES ARE FULLY OPEN. (106-B)

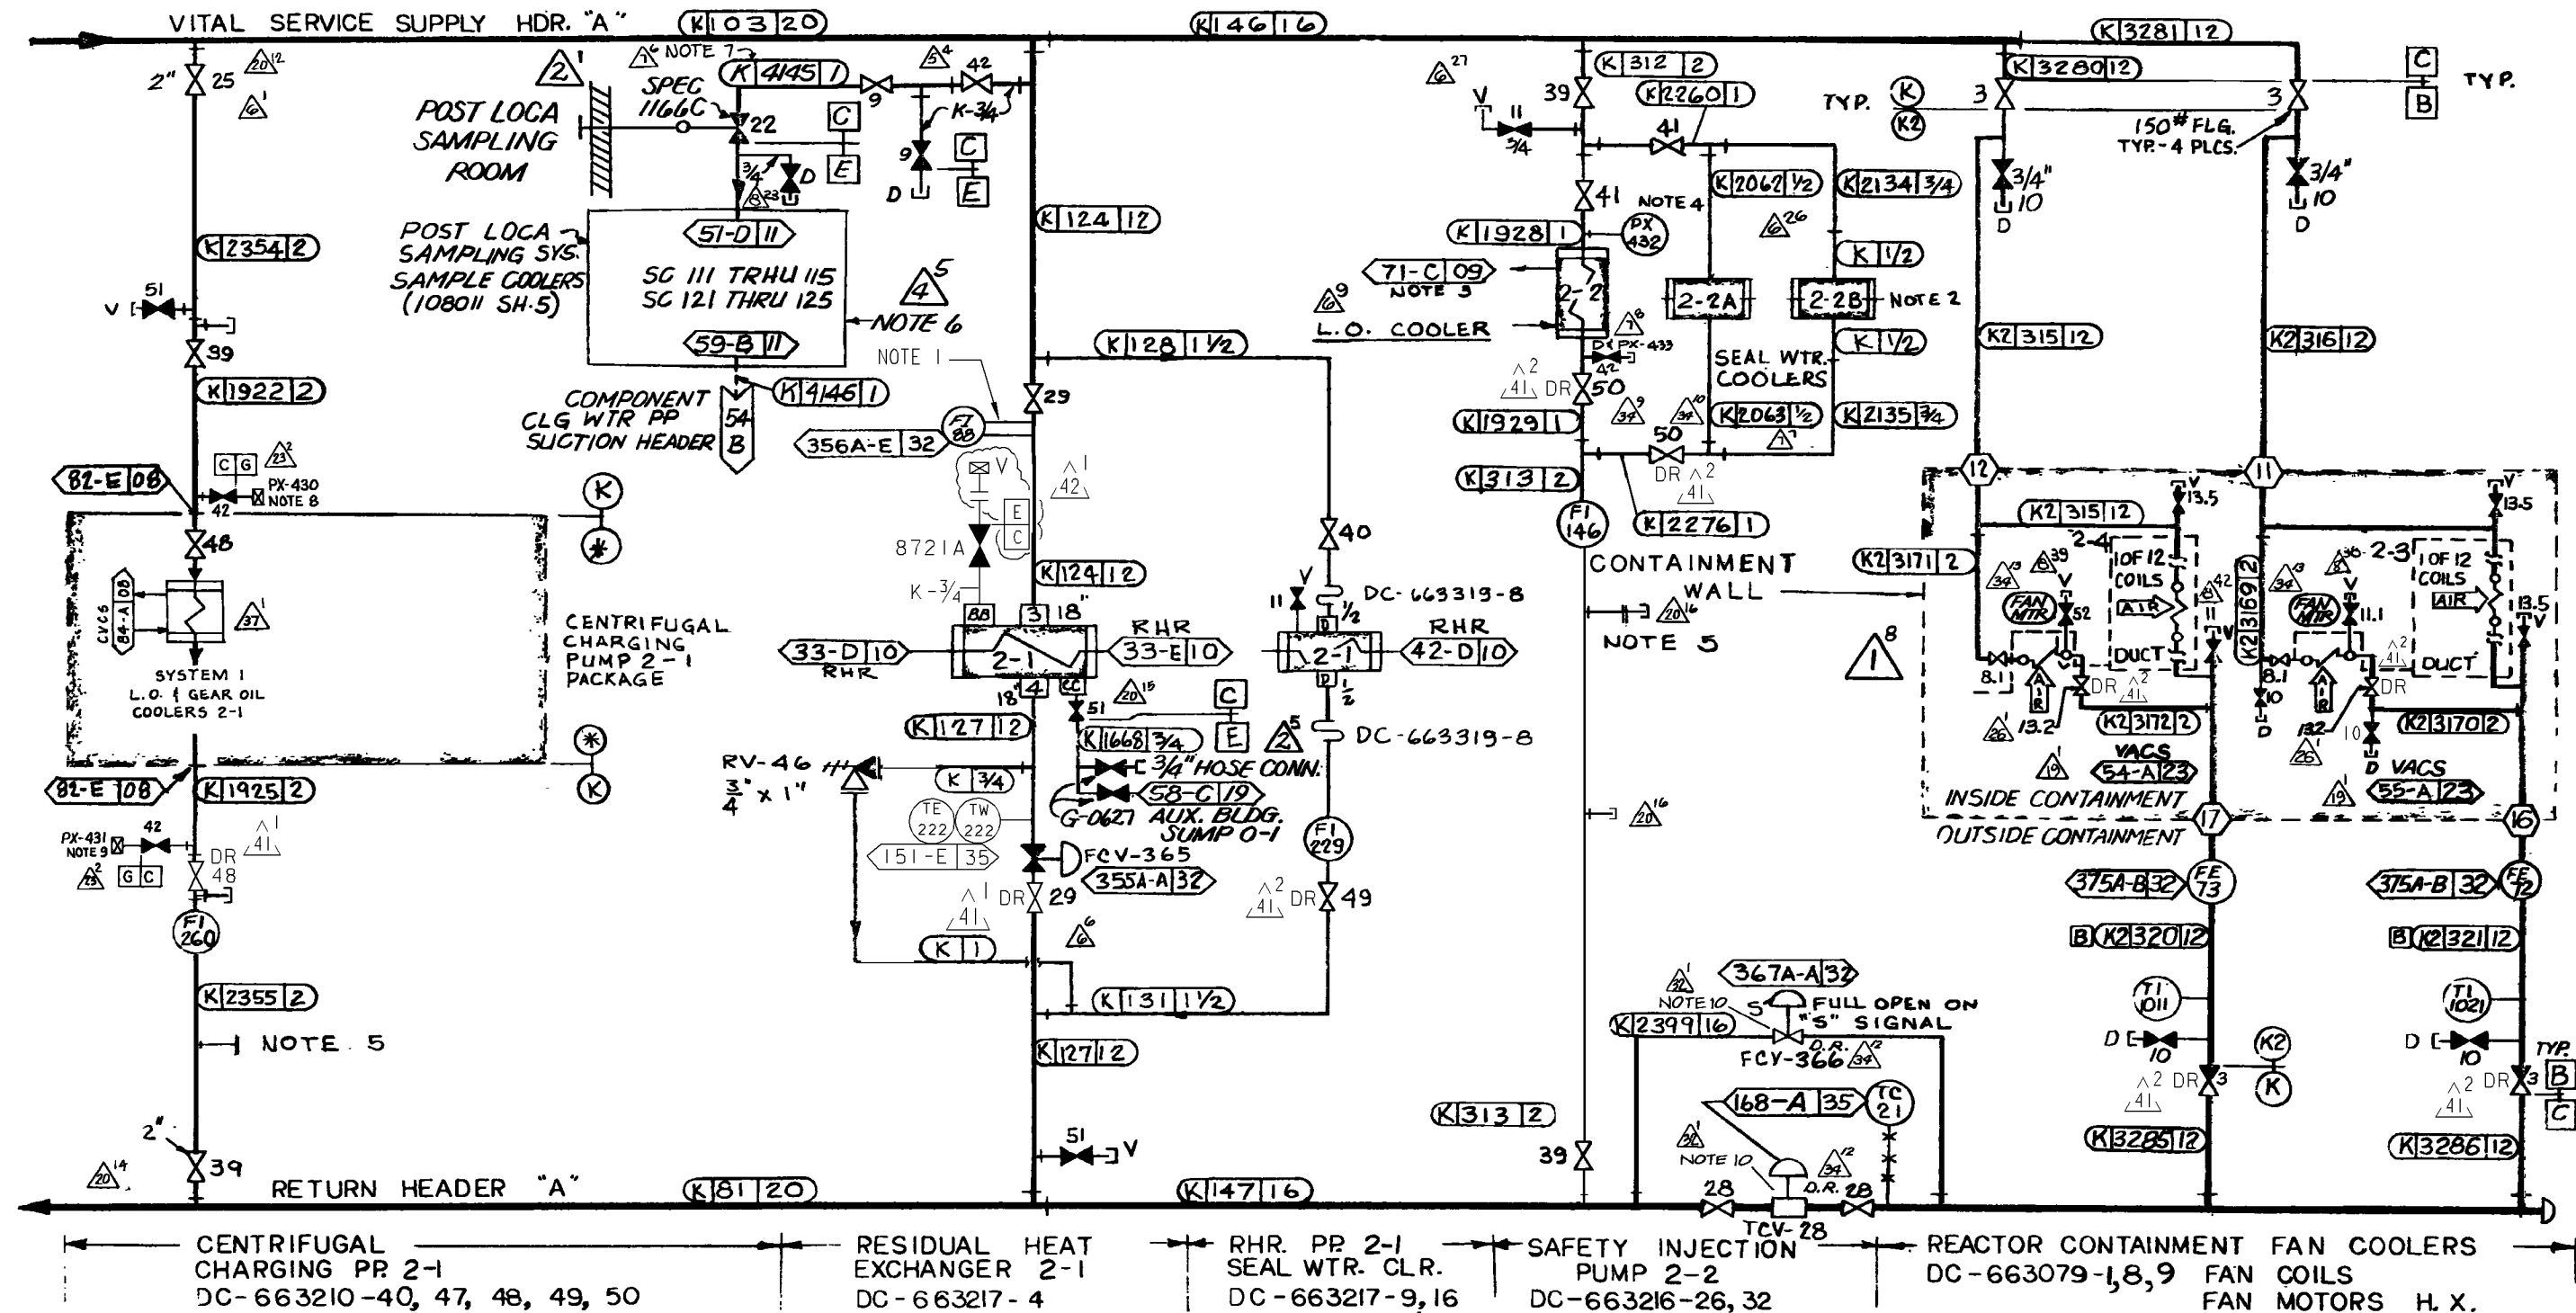

NOTES:


- ELBOW TAPS FOR FLOW INDICATION (104-D)
- REFER TO SIS PP SEAL FLUSH SYSTEM DIAGRAM, PG&E RECORD NO. DC-663216-27 (107-D)
- REFER TO SIS PP LUBE OIL COOLER SYSTEM MFR. DWG., PG&E RECORD NO. DC-663216-26 (105-D)
- PX'S TO BE LOCATED WITHIN 1' OF H.X. (106-E)
- 2" BLIND FLANGE SEE NOTES 2 & 3 SH. 5A (100-B)
- POST LOCA SAMPLE COOLERS ARE DESIGN CLASS II & SEISMICALLY ANALYZED PER DGM M-45 (103-D)
- CODE CLASS "E" PORTION OF LINE 4145 SHALL BE SEISMICALLY ANALYZED TO DESIGN CLASS I CRITERIA (102-E)

HEADER "A" COMPONENTS

UNIT 2

DIABLO CANYON POWER PLANT - PG&E CO.
COMPONENT COOLING WATER SYSTEM

DRAWING	SHEET	PAGE	REV
108014	10	0	42

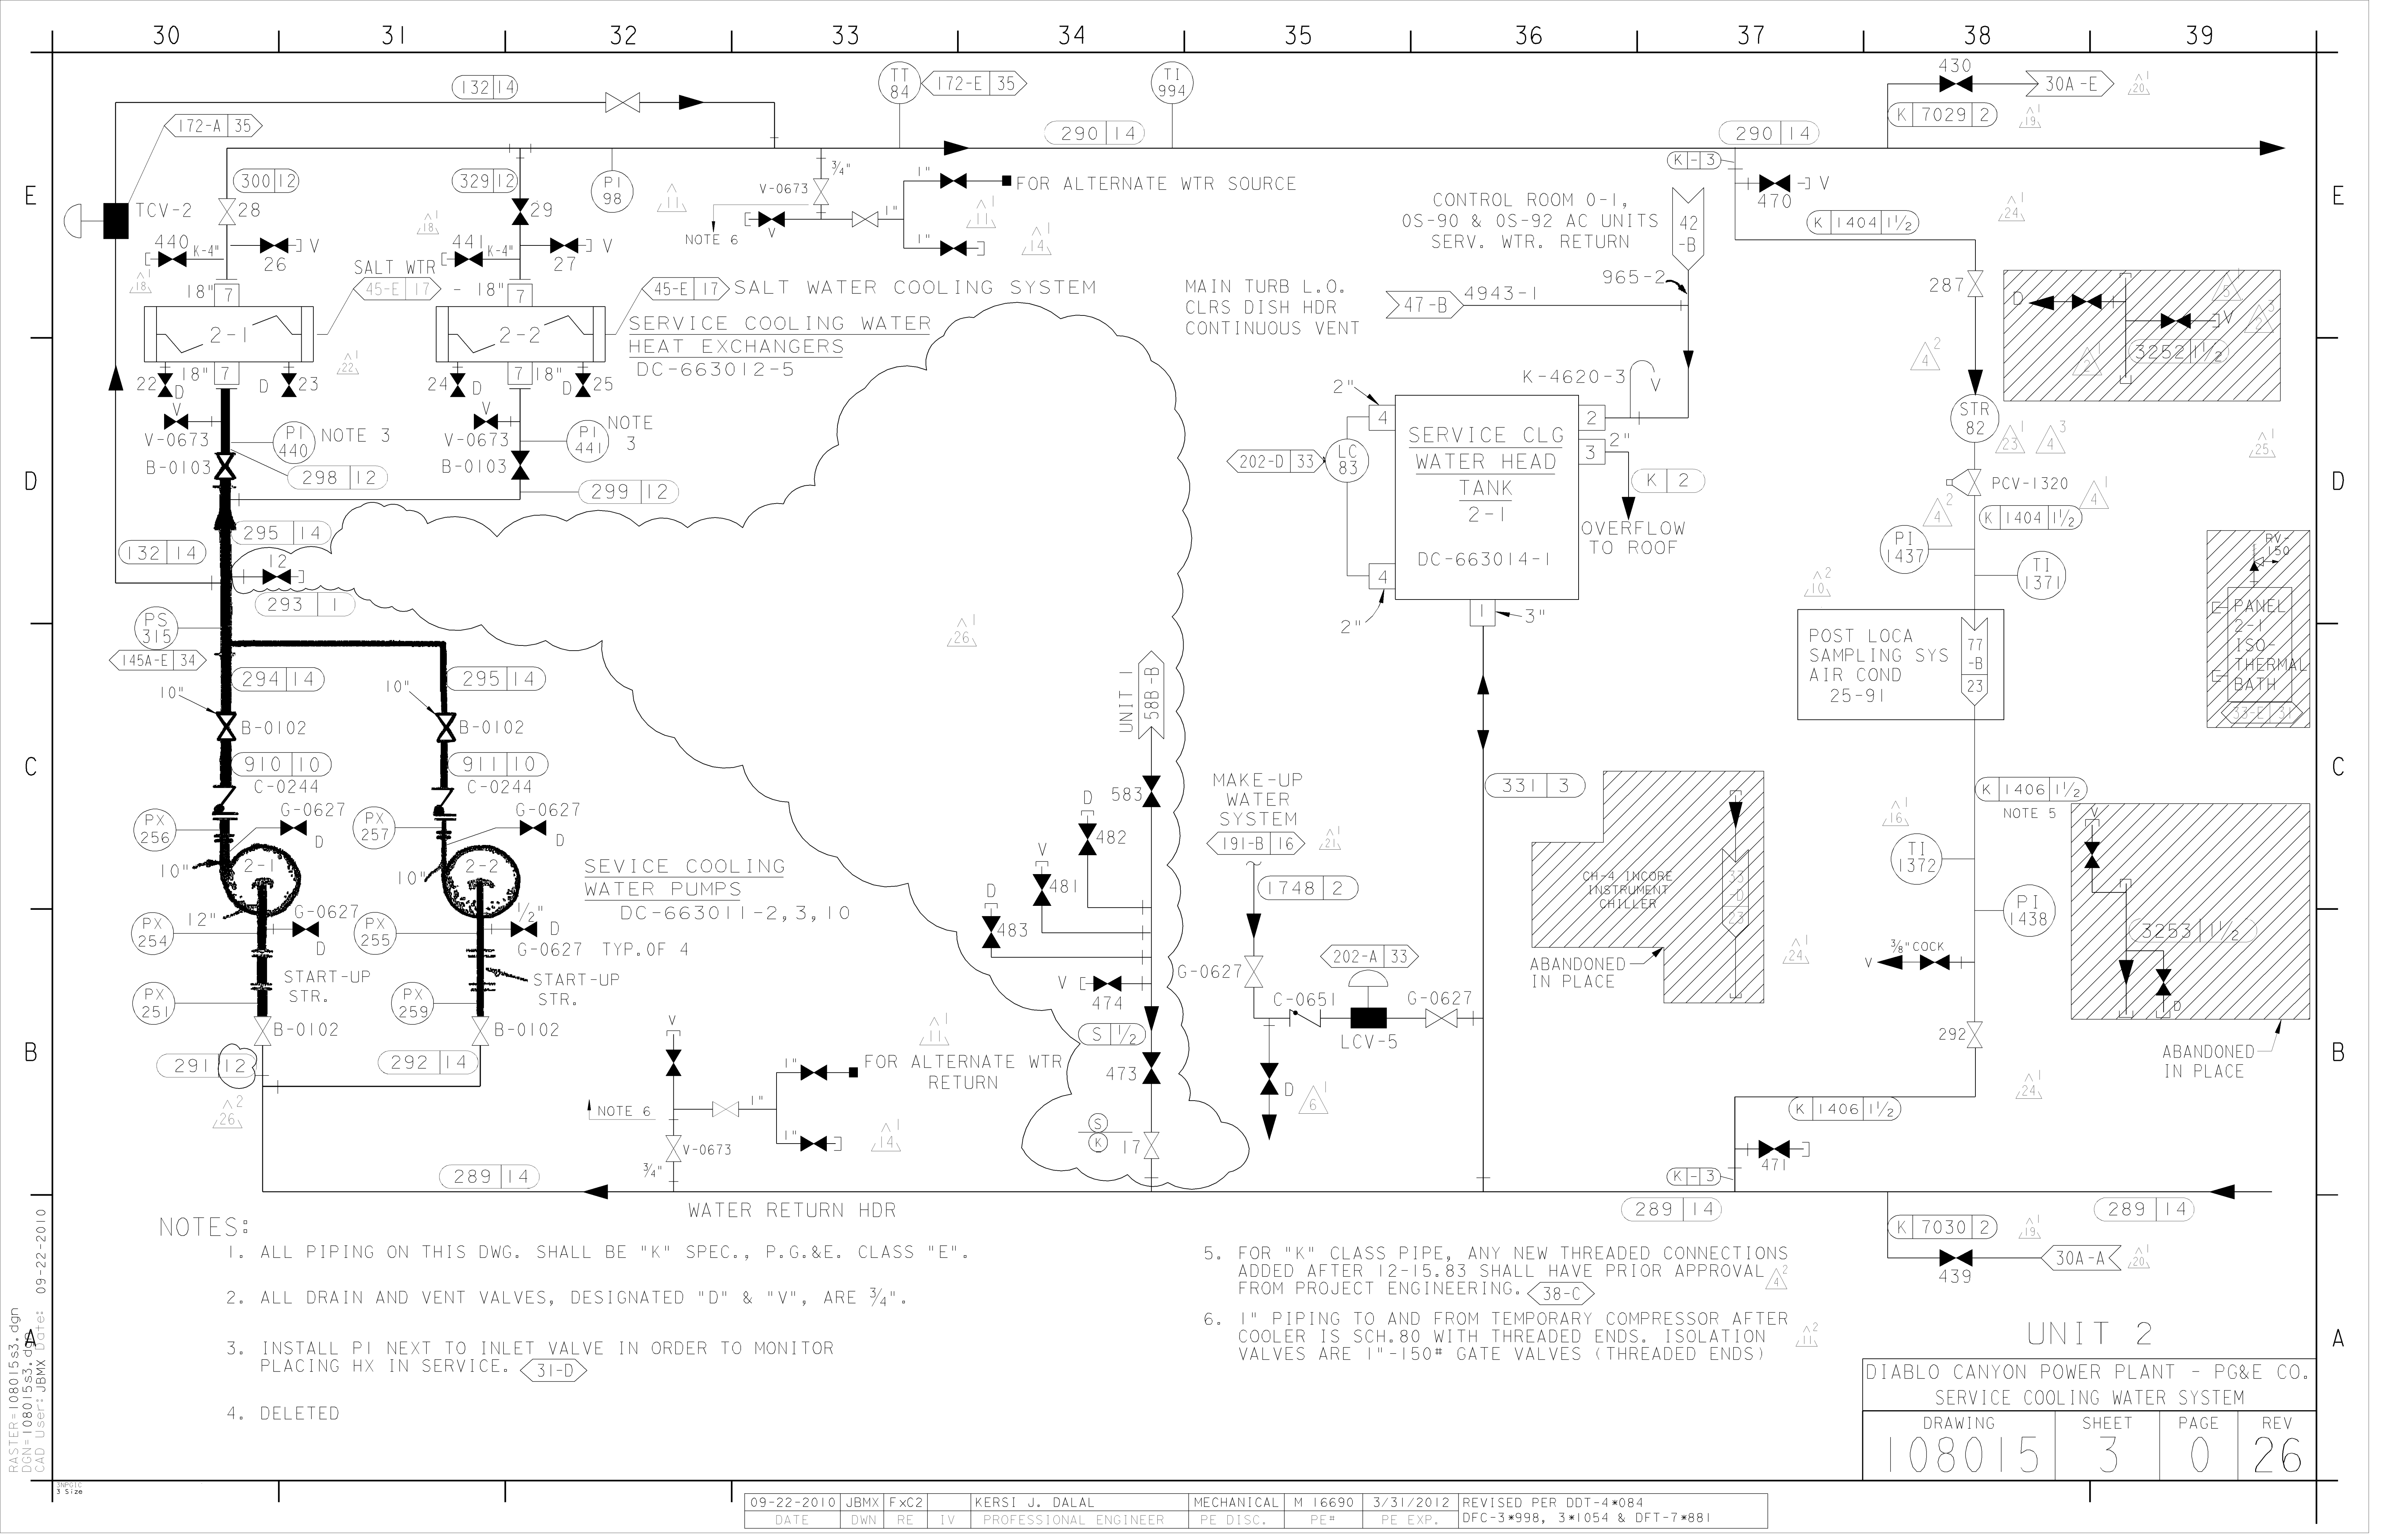


NOTES:

1. ALL PIPING ON THIS DWG. SHALL BE "K" SPEC., P.G.&E. CLASS "E".
2. ALL DRAIN AND VENT VALVES, DESIGNATED "D" & "V", ARE 3/4".
3. INSTALL PI NEXT TO INLET VALVE IN ORDER TO MONITOR PLACING HX IN SERVICE. (31-D)
4. DELETED

5. FOR "K" CLASS PIPE, ANY NEW THREADED CONNECTIONS ADDED AFTER 12-15.83 SHALL HAVE PRIOR APPROVAL FROM PROJECT ENGINEERING. (38-C)
6. 1" PIPING TO AND FROM TEMPORARY COMPRESSOR AFTER COOLER IS SCH.80 WITH THREADED ENDS. ISOLATION VALVES ARE 1"-150# GATE VALVES (THREADED ENDS)

UNIT 2			
DIABLO CANYON POWER PLANT - PG&E CO.			
SERVICE COOLING WATER SYSTEM			
DRAWING	SHEET	PAGE	REV
108015	3	0	26

09-22-2010	JBMX	Fxc2		KERSI J. DALAL	MECHANICAL	M 16690	3/31/2012	REVISED PER DDT-4*084
DATE	DWN	RE	IV	PROFESSIONAL ENGINEER	PE DISC.	PE#	PE EXP.	DFC-3*998, 3*1054 & DFT-7*881

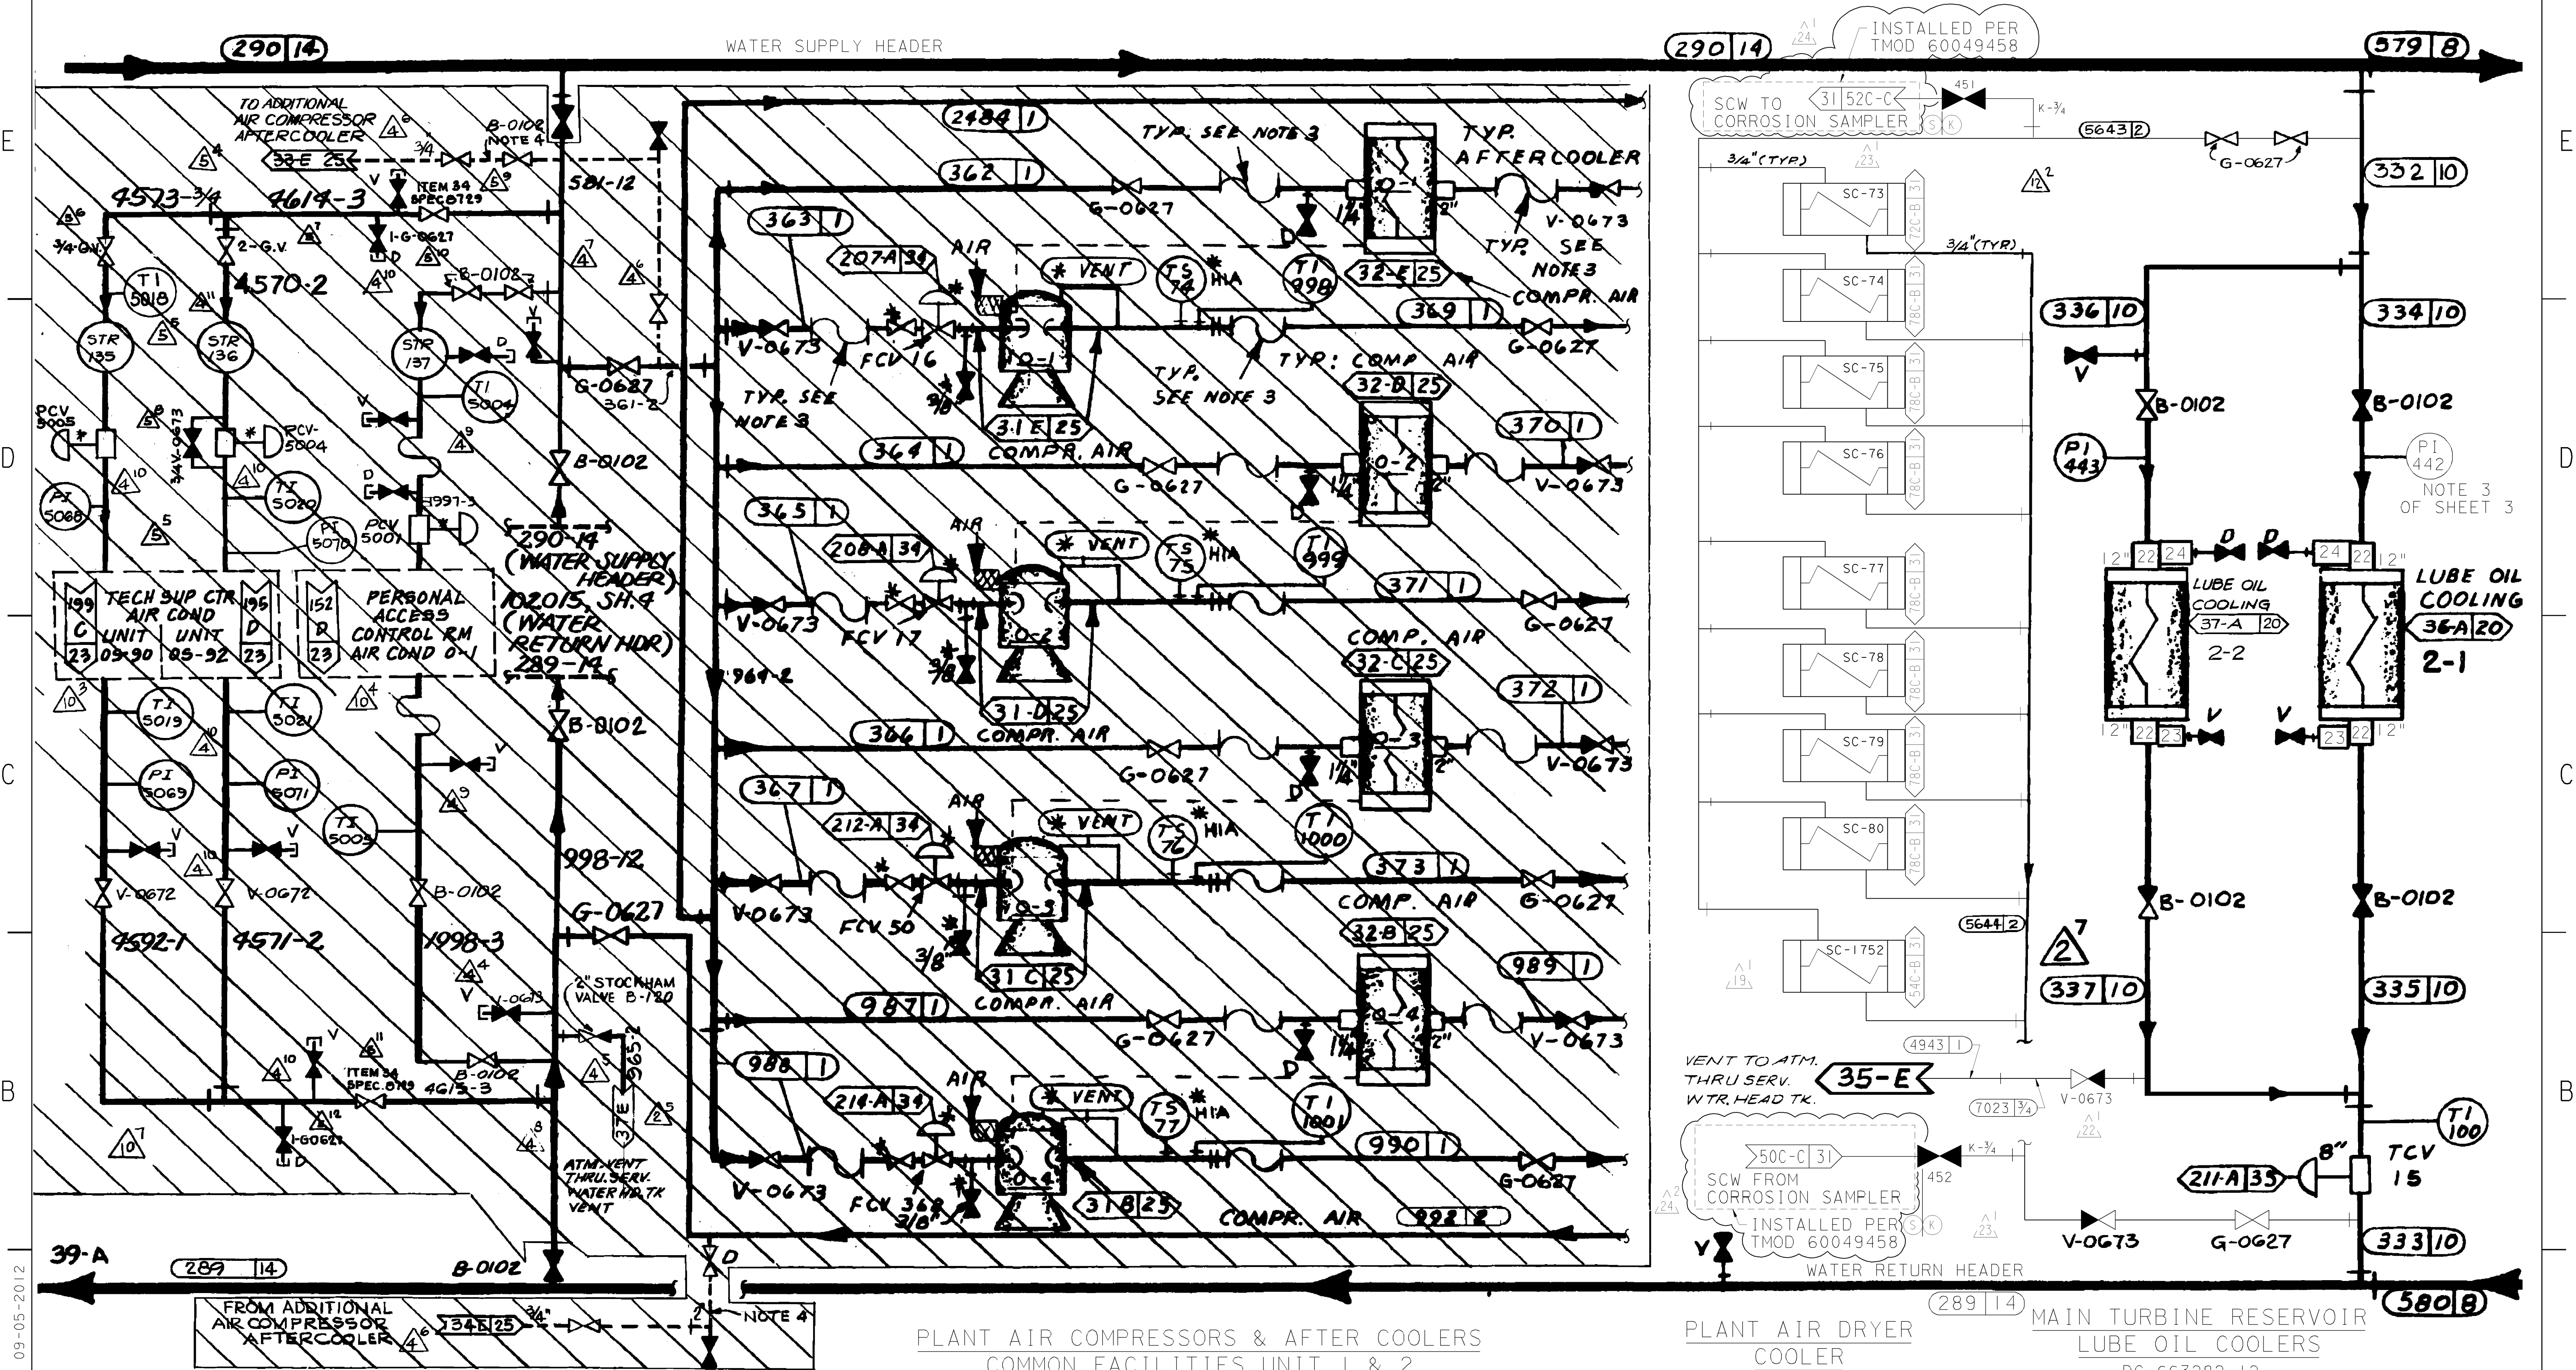

PLANT AIR COMPRESSORS & AFTER COOLERS
COMMON FACILITIES UNIT 1 & 2

AIR COMPRESSORS
DC-663002-1 DC-663002-16

PLANT AIR DRYER
COOLER

DC-663003-5


MAIN TURBINE RESERVOIR
LUBE OIL COOLERS

DC-663282-12

UNIT 2

DIABLO CANYON POWER PLANT - PG&E CO.
SERVICE COOLING WATER SYSTEM

DRAWING	SHEET	PAGE	REV
108015	4	0	24

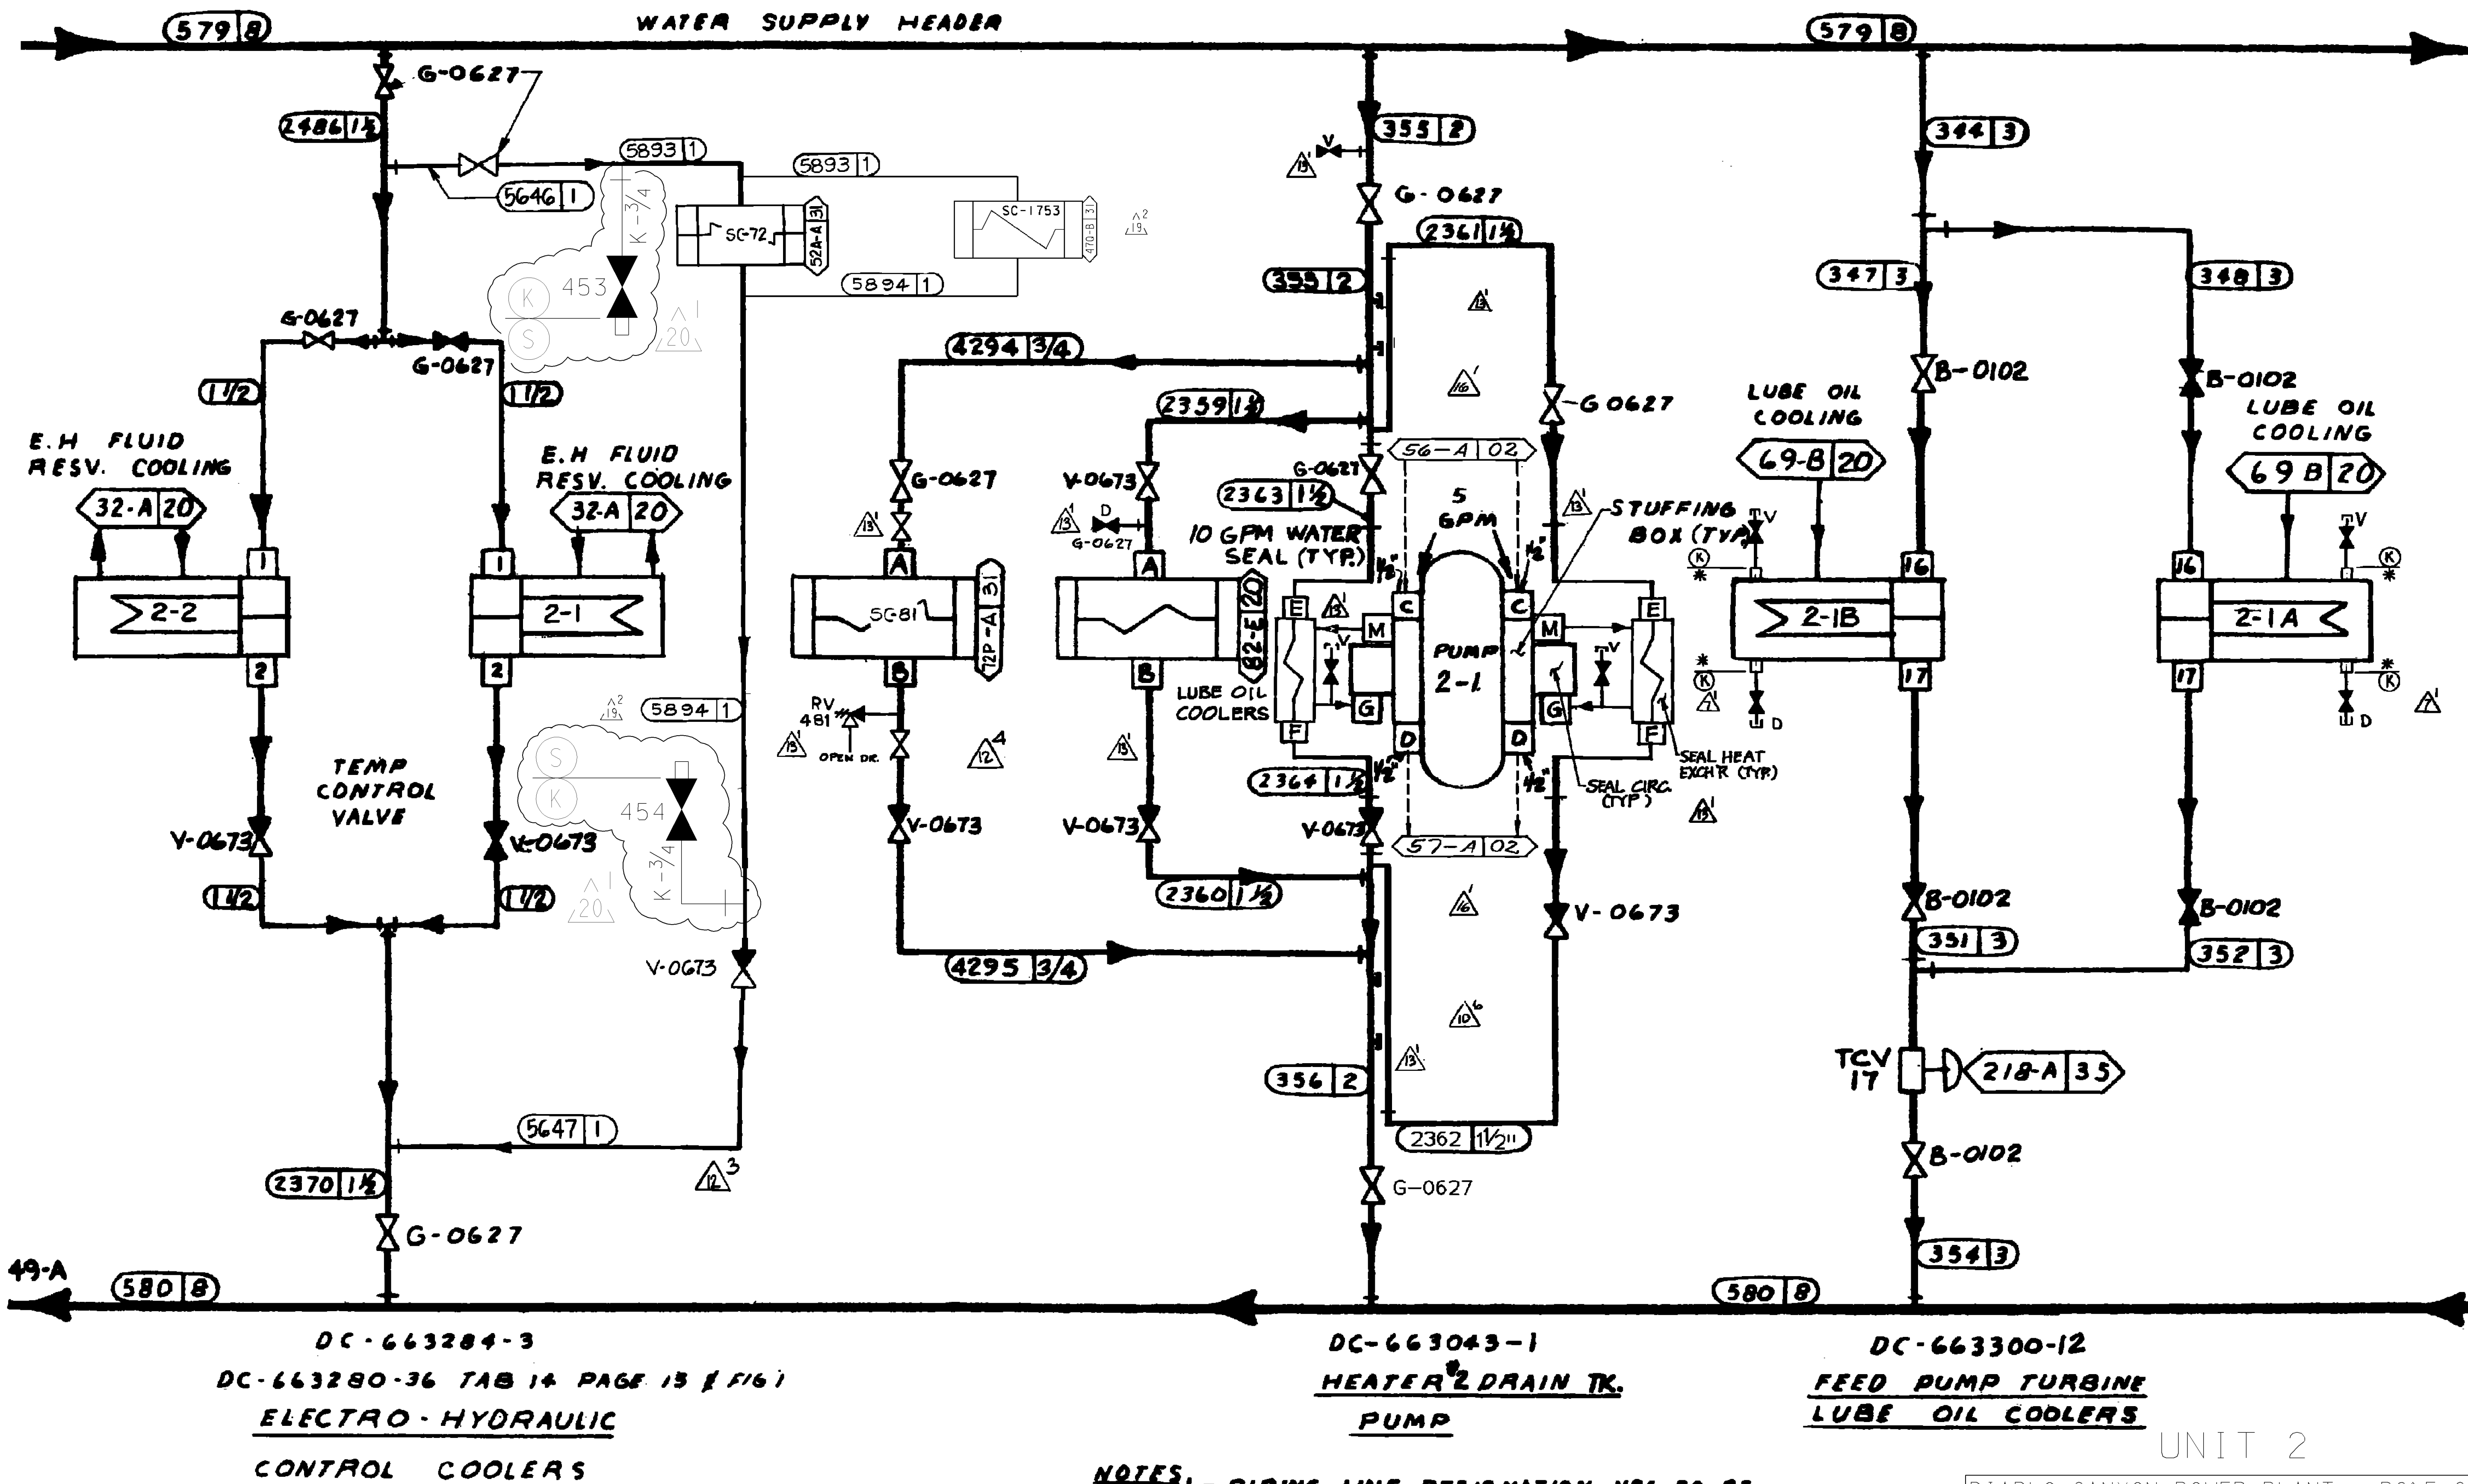

NOTES


1.- PIPING LINE DESIGNATION NOS TO BE "K" SPECS.

2.- ALL PIPING THIS SHEET SHALL BE P. G. & E. CLASS E.

DIABLO CANYON POWER PLANT - PG&E CO.
SERVICE COOLING WATER SYSTEM

DRAWING	SHEET	PAGE	REV
108015	5	0	20

THIS DRAWING HAS BEEN REPRODUCED
WITHOUT CHANGE FROM ORIGINAL DRAWING
CHANGE NO. 1 DATE 2-2-64 APPROVED BLS

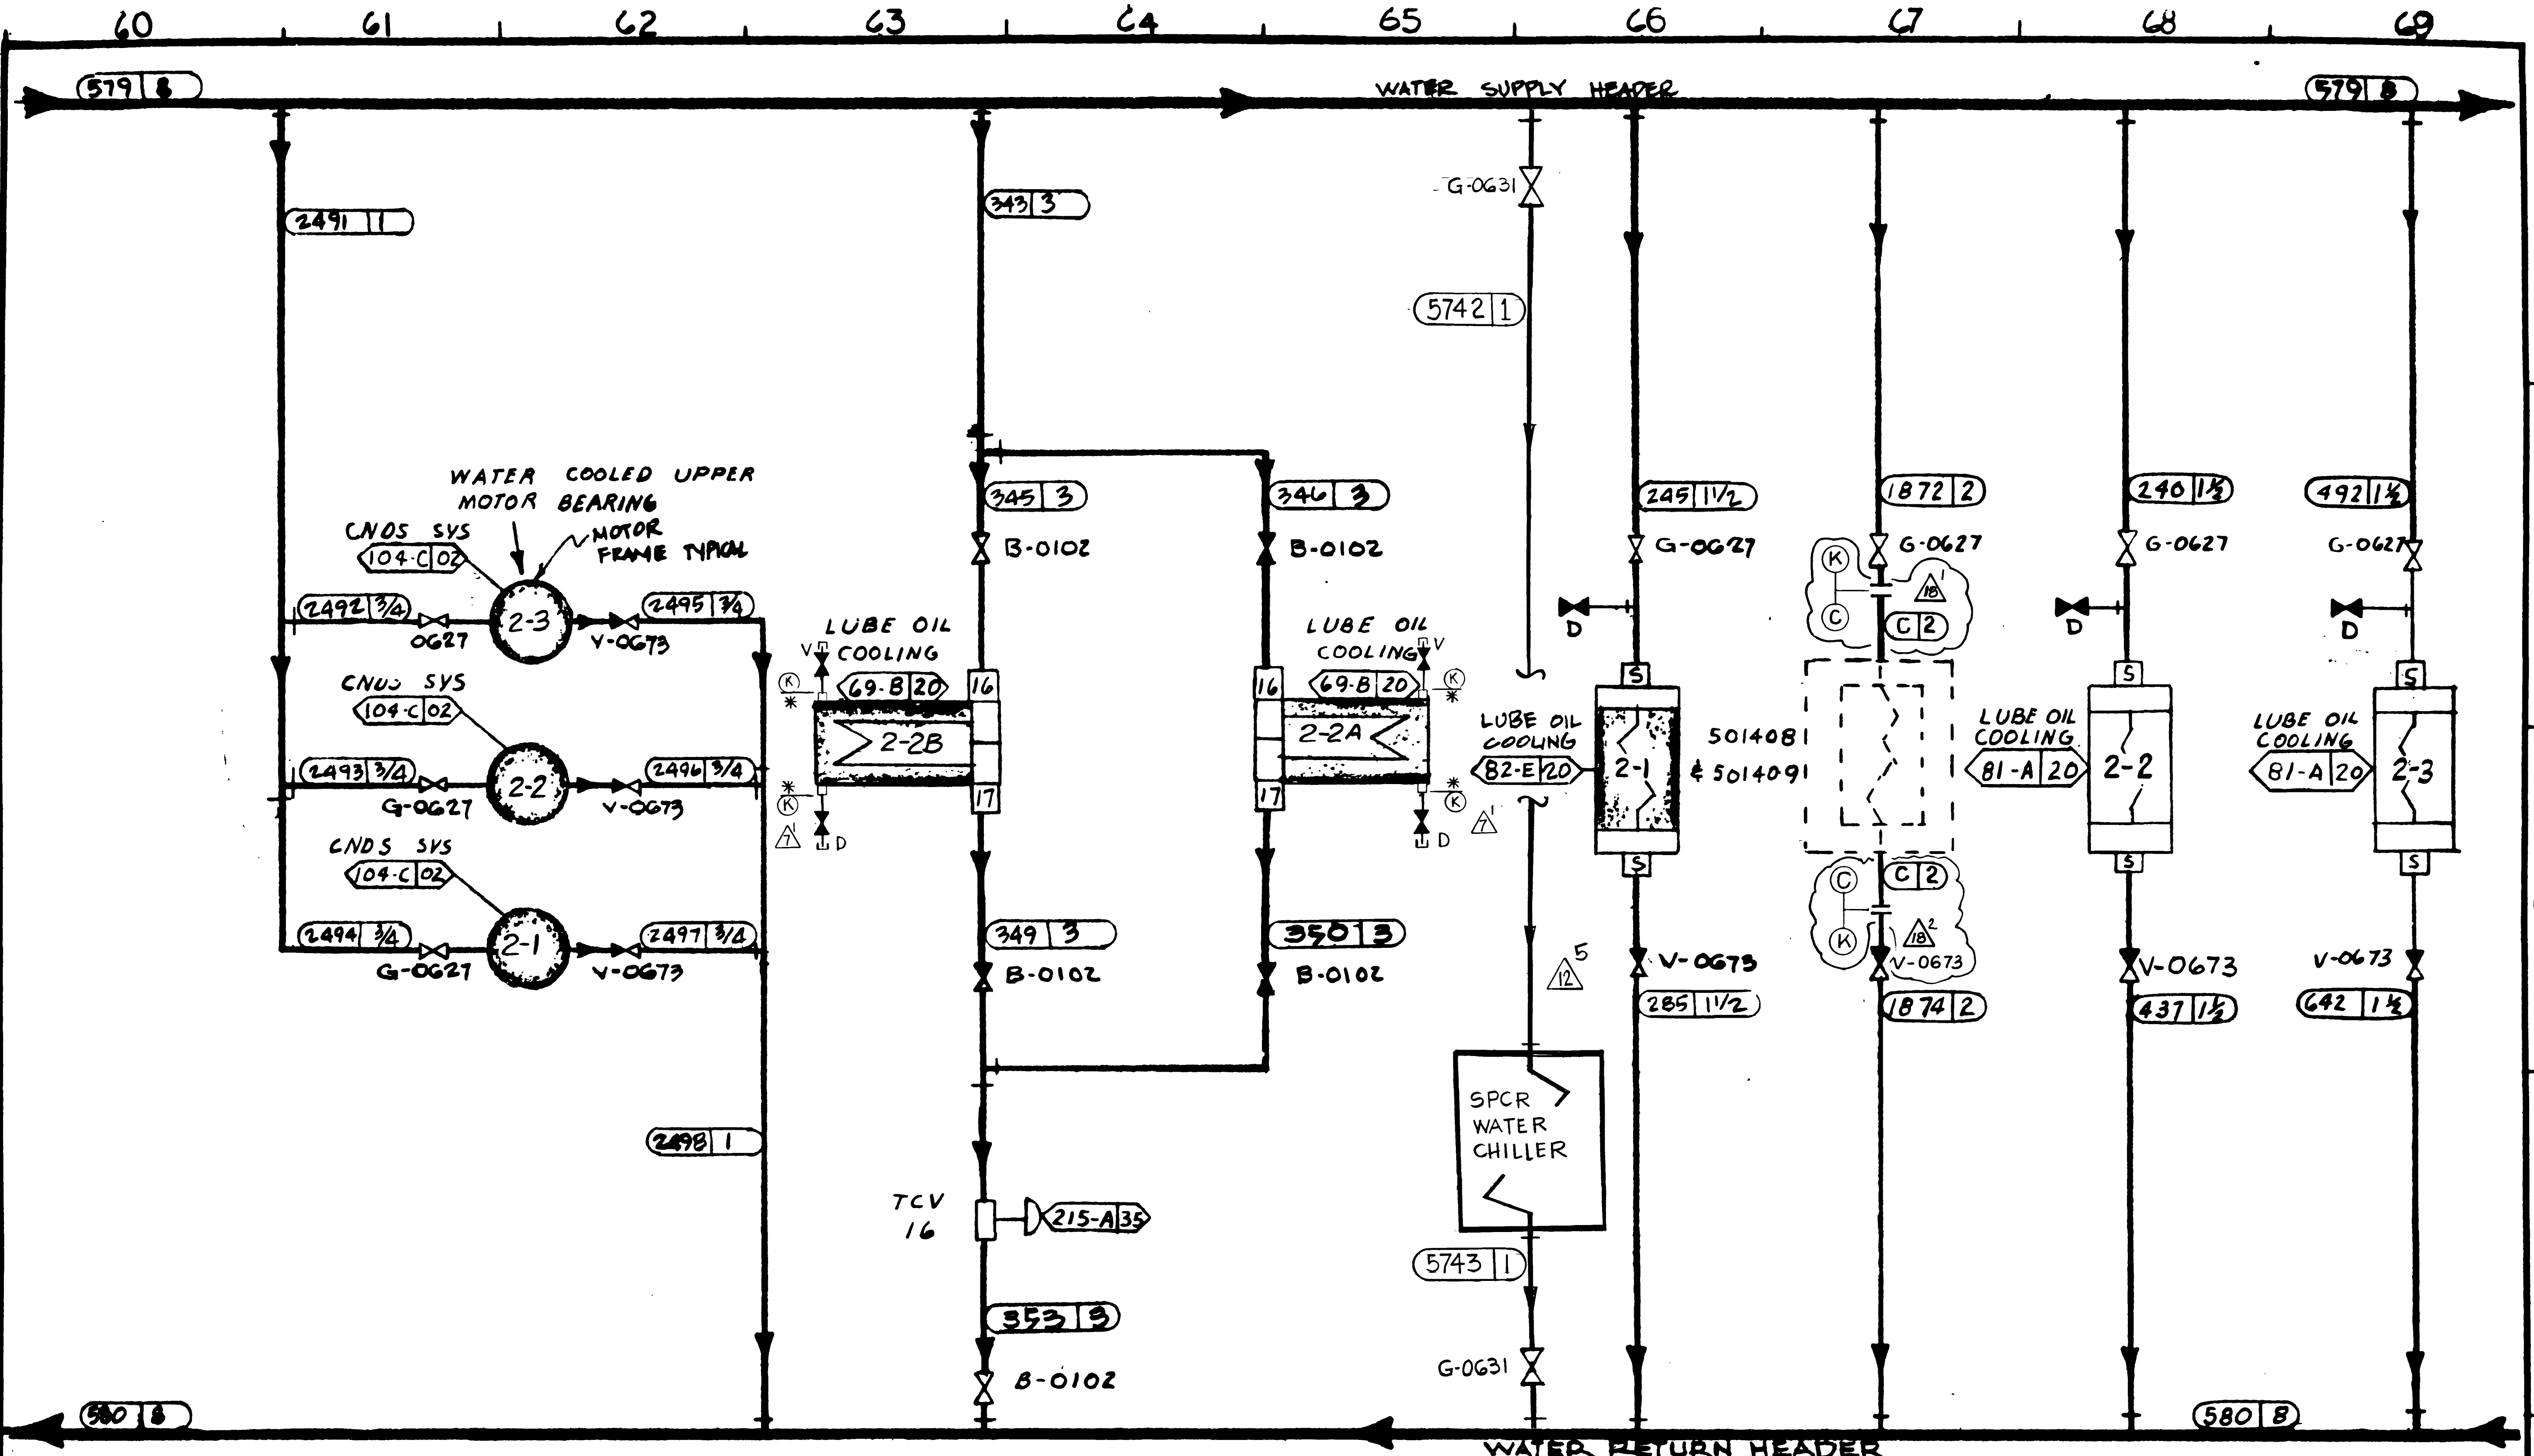

NOTES

1. PIPING LINE DESIGNATION N.B. TO BE "K" SPECS. (UNLESS OTHERWISE SPECIFIED)
2. ALL PIPING THIS SHEET SHALL BE P G & E CLASS "E".


P.G. & E.CO.		DRAWING NUMBER	REVISION
SHEET 6 OF 8		108015	18

E

D

C

B

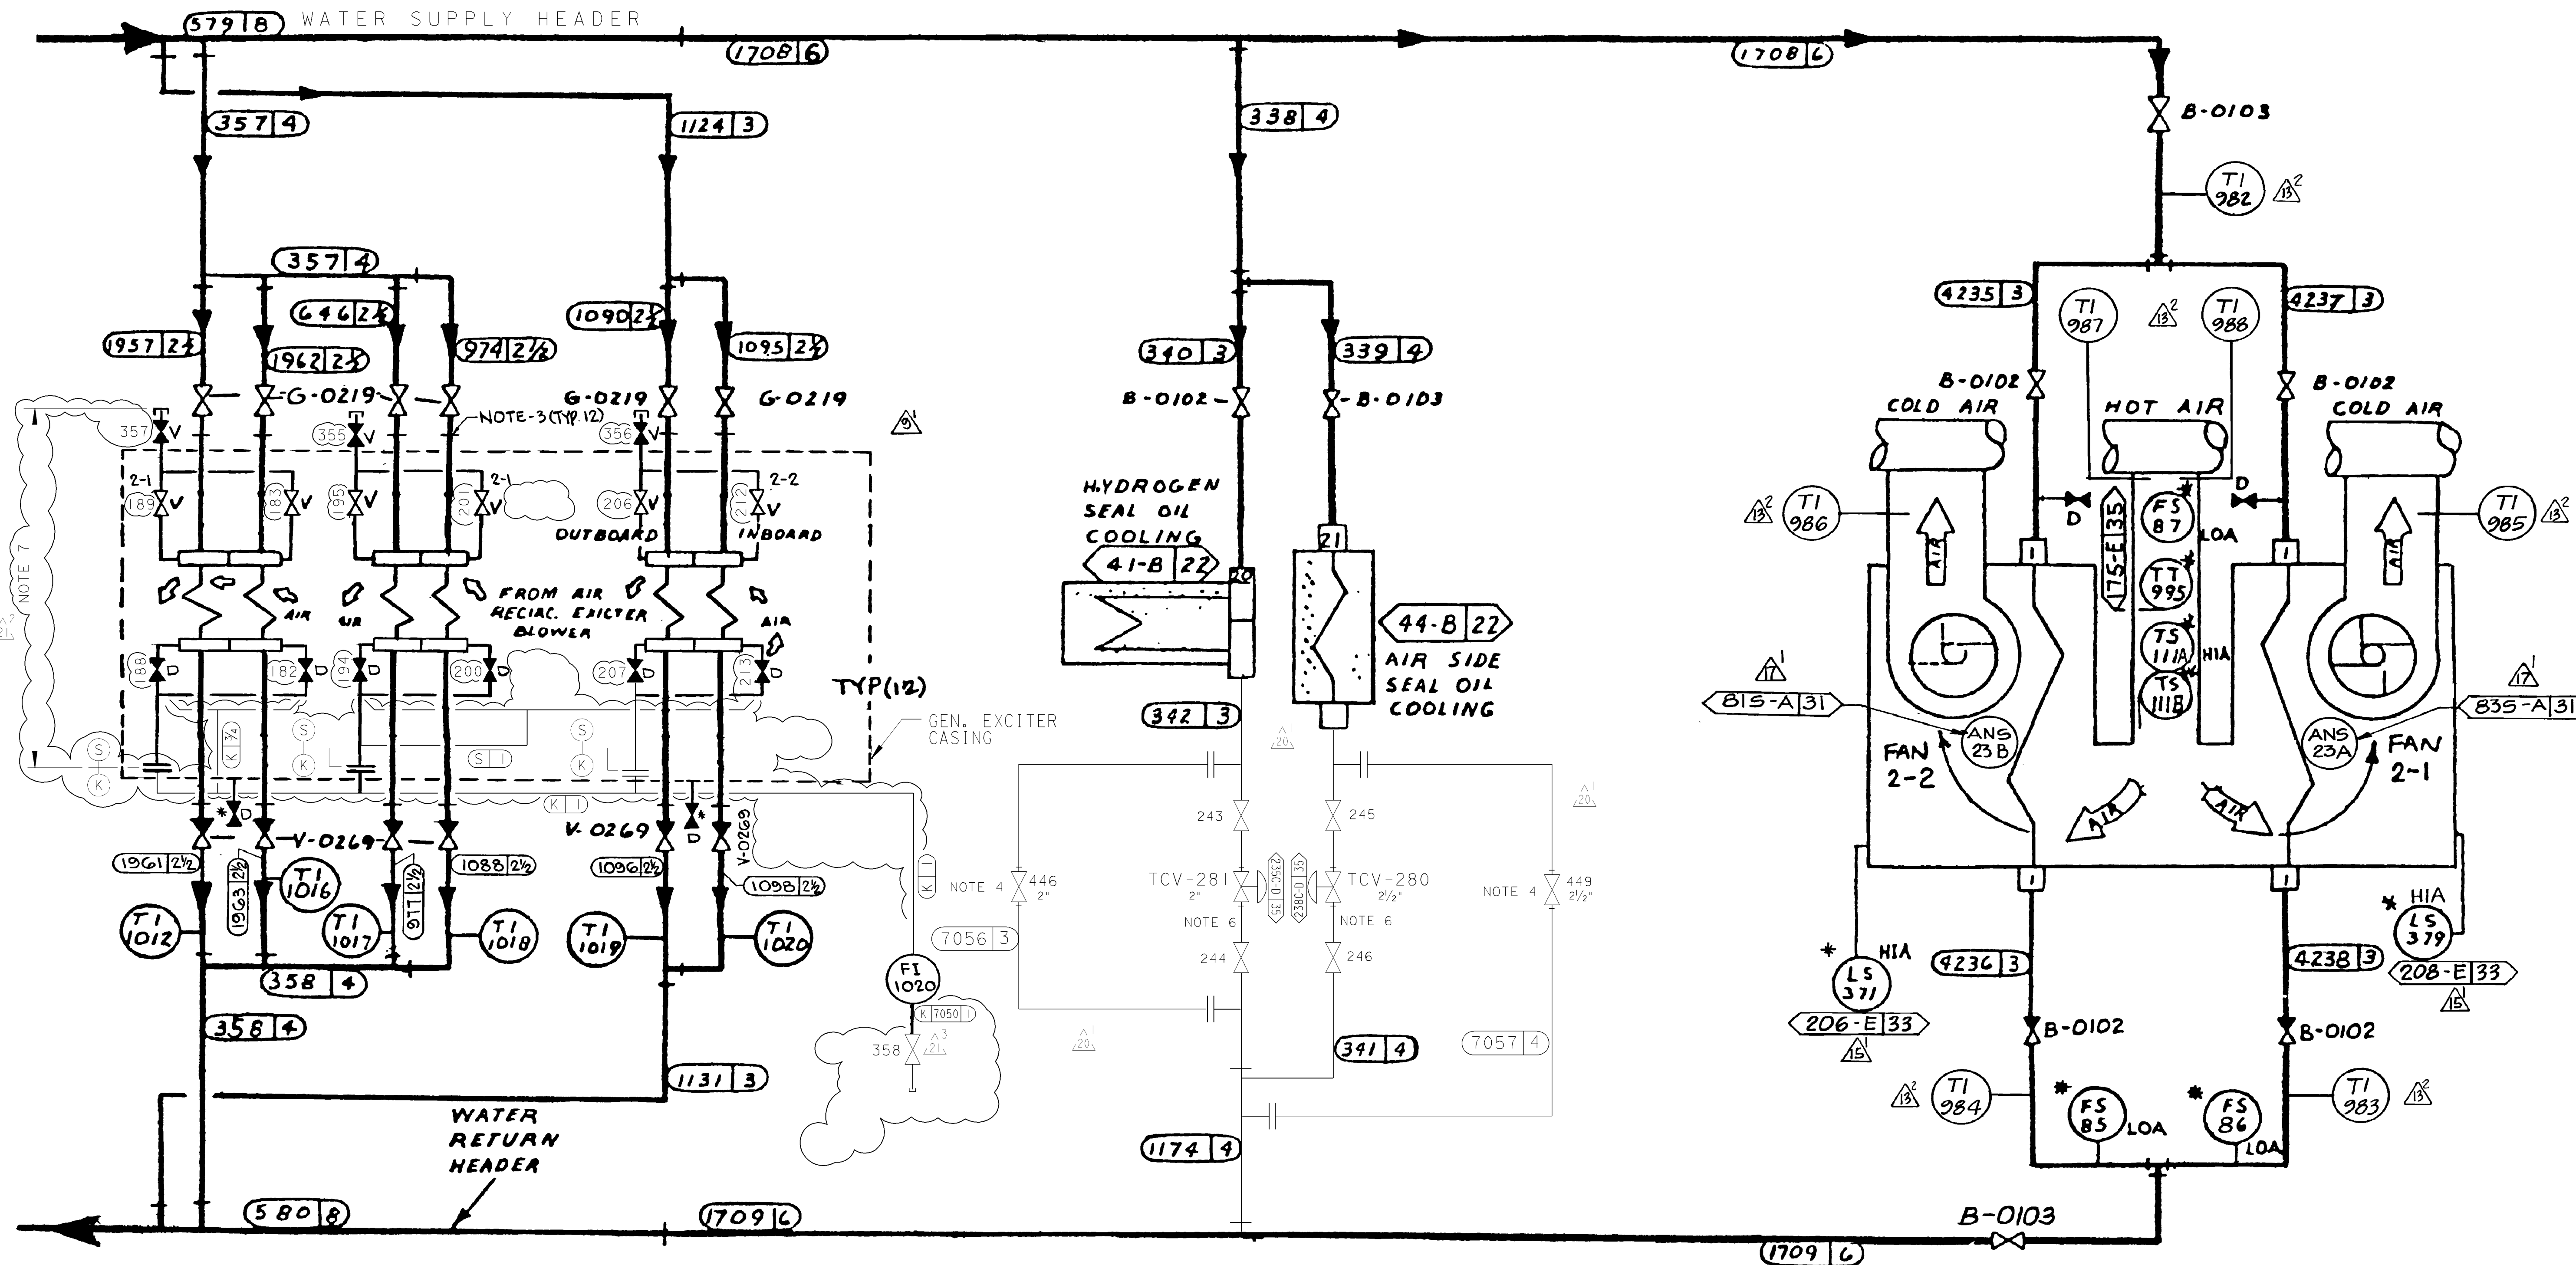

DC-663293-1 GENERATOR EXCITER
2 COILS PER COOLER

DC-663293-1 FUSE WHEEL
2 COILS PER COOLER

DC-663282-30 GENERATOR SEAL OIL COOLERS


DC-663326-55 ISO-PHASE BUS COOLERS
1 COIL PER COOLER

UNIT 2

DIABLO CANYON POWER PLANT - PG&E CO.
SERVICE COOLING WATER SYSTEM

DRAWING	SHEET	PAGE	REV
108015	7	0	21

- NOTES:
1. PIPING LINE DESIGNATION NO'S TO BE "K" SPEC.
 2. ALL PIPING THIS SHEET SHALL BE PG&E CLASS "E".
 3. "VICTAULIC" TYPE COUPLING TYP. OF 12. SEE DC 663293-1 71-D
 4. FISHER CLASS 150 RF FLANGED WITH 1008/40 ACTUATOR. 2" S.C. 78-9003. 2 1/2" S.C. 78-9002. 18
 5. 3" BTFL VALVE S.C. 75-5546. 4" BTFL VALVE S.C. 72-9649. 18
 6. THE REDUCERS ARE 4" x 2 1/2" AND 3" x 2" REDUCING ELBOWS. (REF. A0610663) 19
 7. SS TUBING FOR COOLER VENTS AND DRAINS BY PG&E; SEE N-MOD A0703483. 21

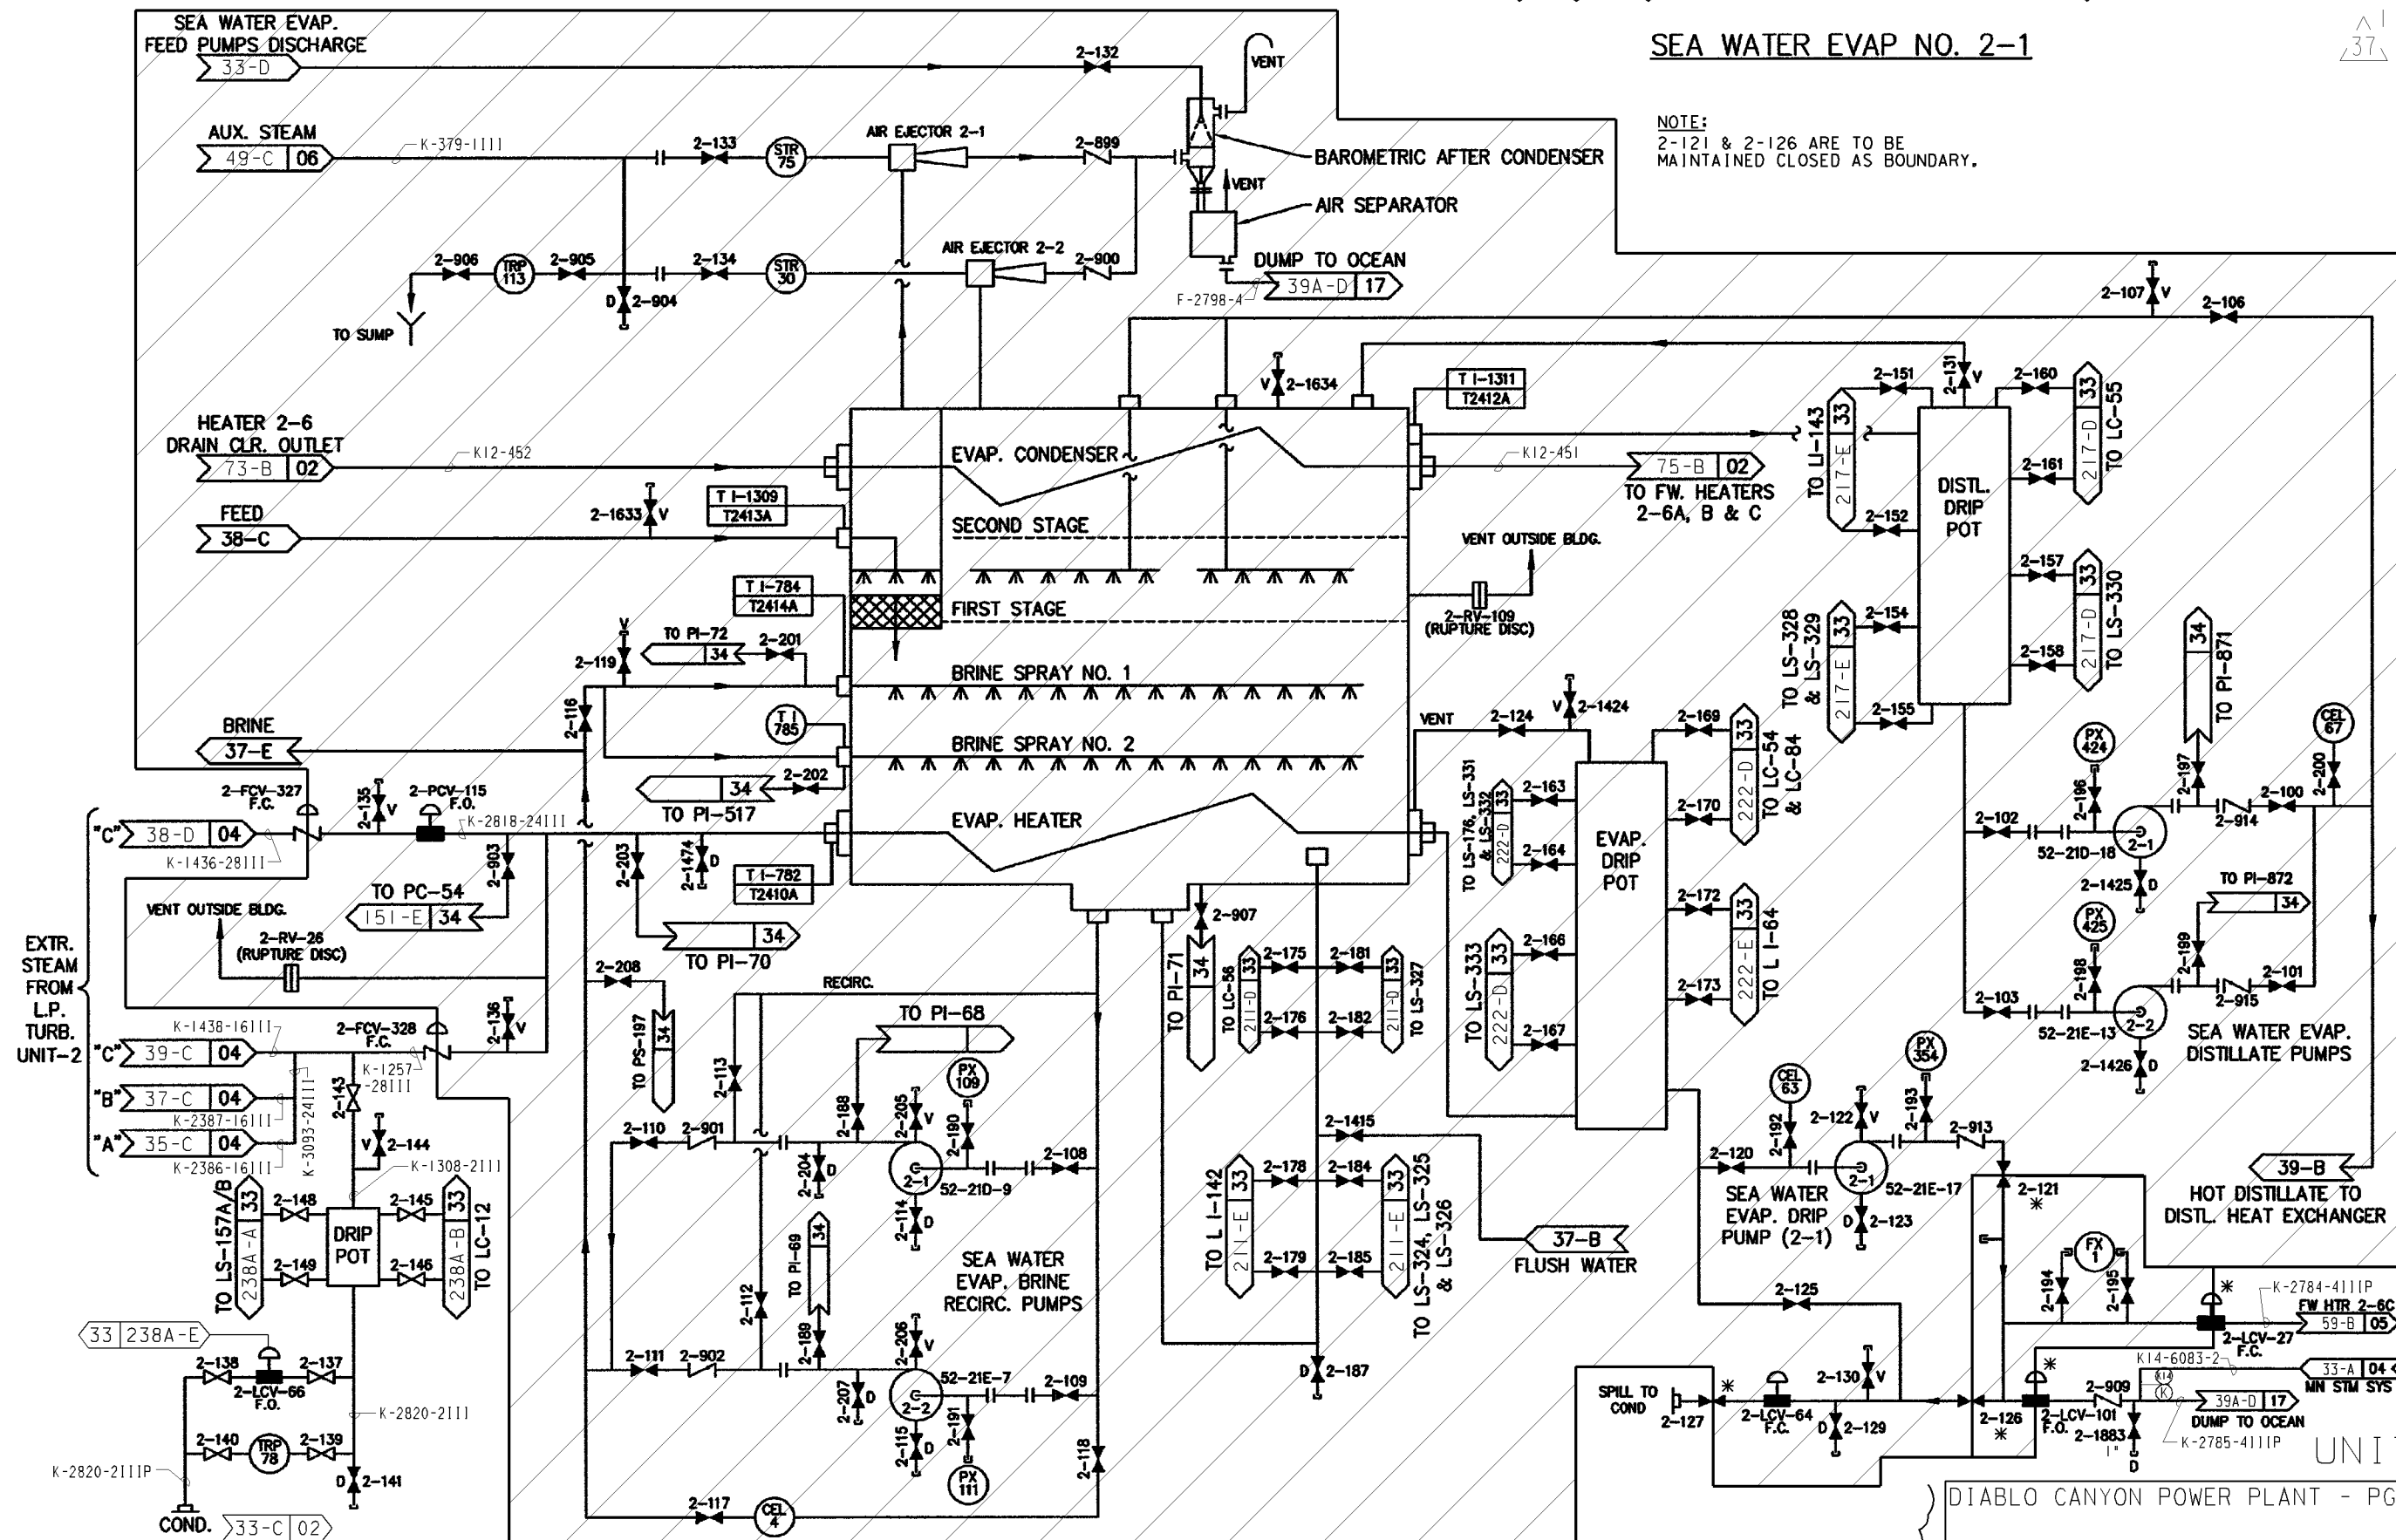

NOTE:
2-121 & 2-126 ARE TO BE
MAINTAINED CLOSED AS BOUNDARY.

UNIT 2

DIABLO CANYON POWER PLANT - PG&E CO.

SHADED AREA ABANDONED EQUIP

*EXTENDED ABANDONMENT TO LCV 27 & LCV 101
121, 126, 127 REMAIN BOUNDARY AS WELL

DRAWING

SHEET

	PAGE
--	------

REV

0806

(

37

01-20-2006

MIBF

KJD3

--	--

FRANCIS C. LING

MECHANICAL

M 16098

12/31/2007

REVISÉD PER FCT-030760

DATE _____

DWN

	RF
--	----

IV

PROFESSIONAL ENGINEER


PF DISC.

PF #

PF EXP.

RASTER=8016s05.dgn
 DGN=8016s05.dgn
 CAD User: MIBF Date: 01-20-2006

INPG1C
Size

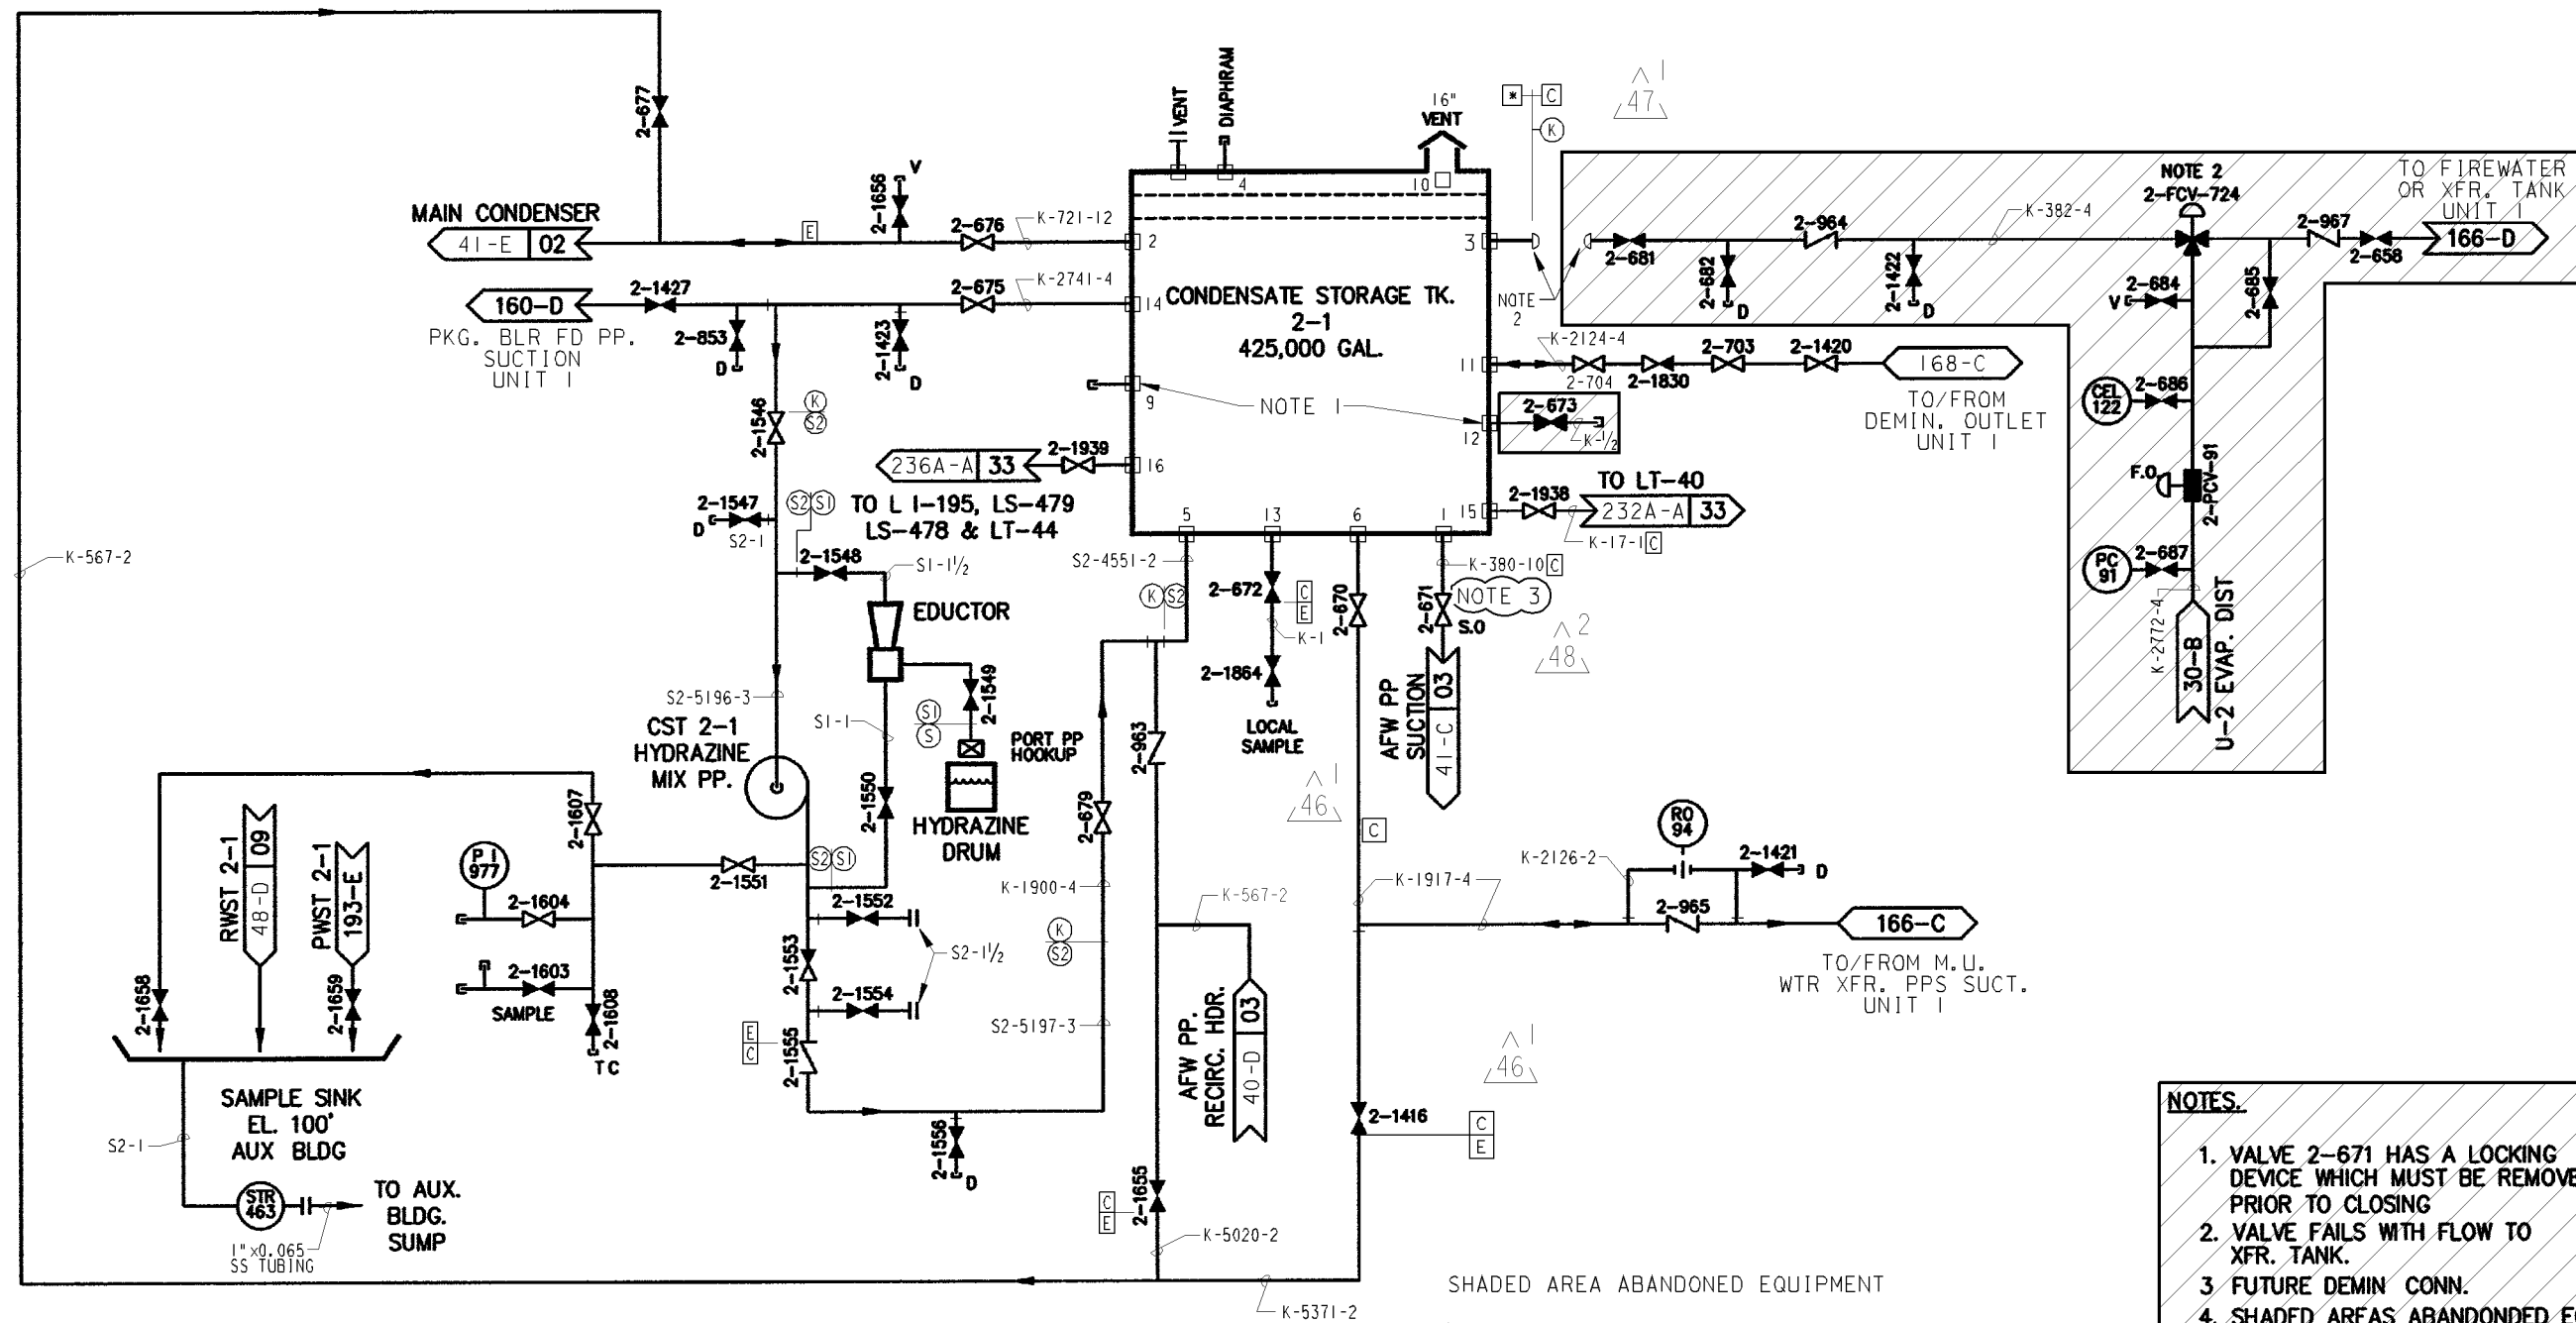




Date: 11-21-2012

INPGIC
I Size

REVISED PER DDN-2*971

UNIT 2			
DIABLO CANYON POWER PLANT - PG&E CO.			
MAKE-UP WATER SYSTEM			
DRAWING	SHEET	PAGE	REV
108016	19	0	6

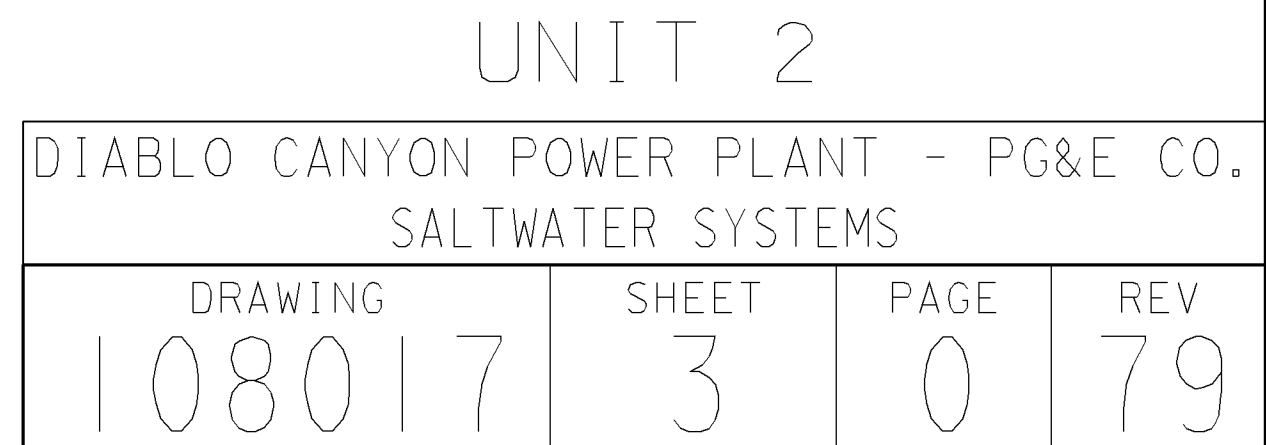REVISÉD PER DFT-7*2012


NOTES:

- 1. ALL PIPING ON THIS SHEET IS P.G.&E. CLASS E UNLESS OTHERWISE NOTED.
- 2. DEMUSSELING PROCEDURE STARTS AFTER THE SCREENS OF BOTH UNITS HAVE BEEN WASHED (42-C).
- 3. SEAL INJECTION 3/4" FLEXHOSE CROSS TIE (44-B).
- 4. TEMPORARY CONNECTION INSTALLED AT FX FOR FRESH WATER DEMUSSELING PROCESS, WHICH IS USED AS ALTERNATIVE TO HT DEMUSSELING (46-C).
- 5. COMPLIES WITH "S" SPECIFICATION EXCEPT TUBING IS 3/4" WALL IS 0.065" & FLANGES ARE 2" ISO #FFSW A182 GR F304. (45,46,47,48 E)

DEMUSSELING FLOW SCHEME


LEGEND

- CLOSED GATE
- OPEN OR PARTIALLY OPEN THROTTLED GATE
- WARM WATER
- COLD WATER TO SCREEN REFUSE SUMP

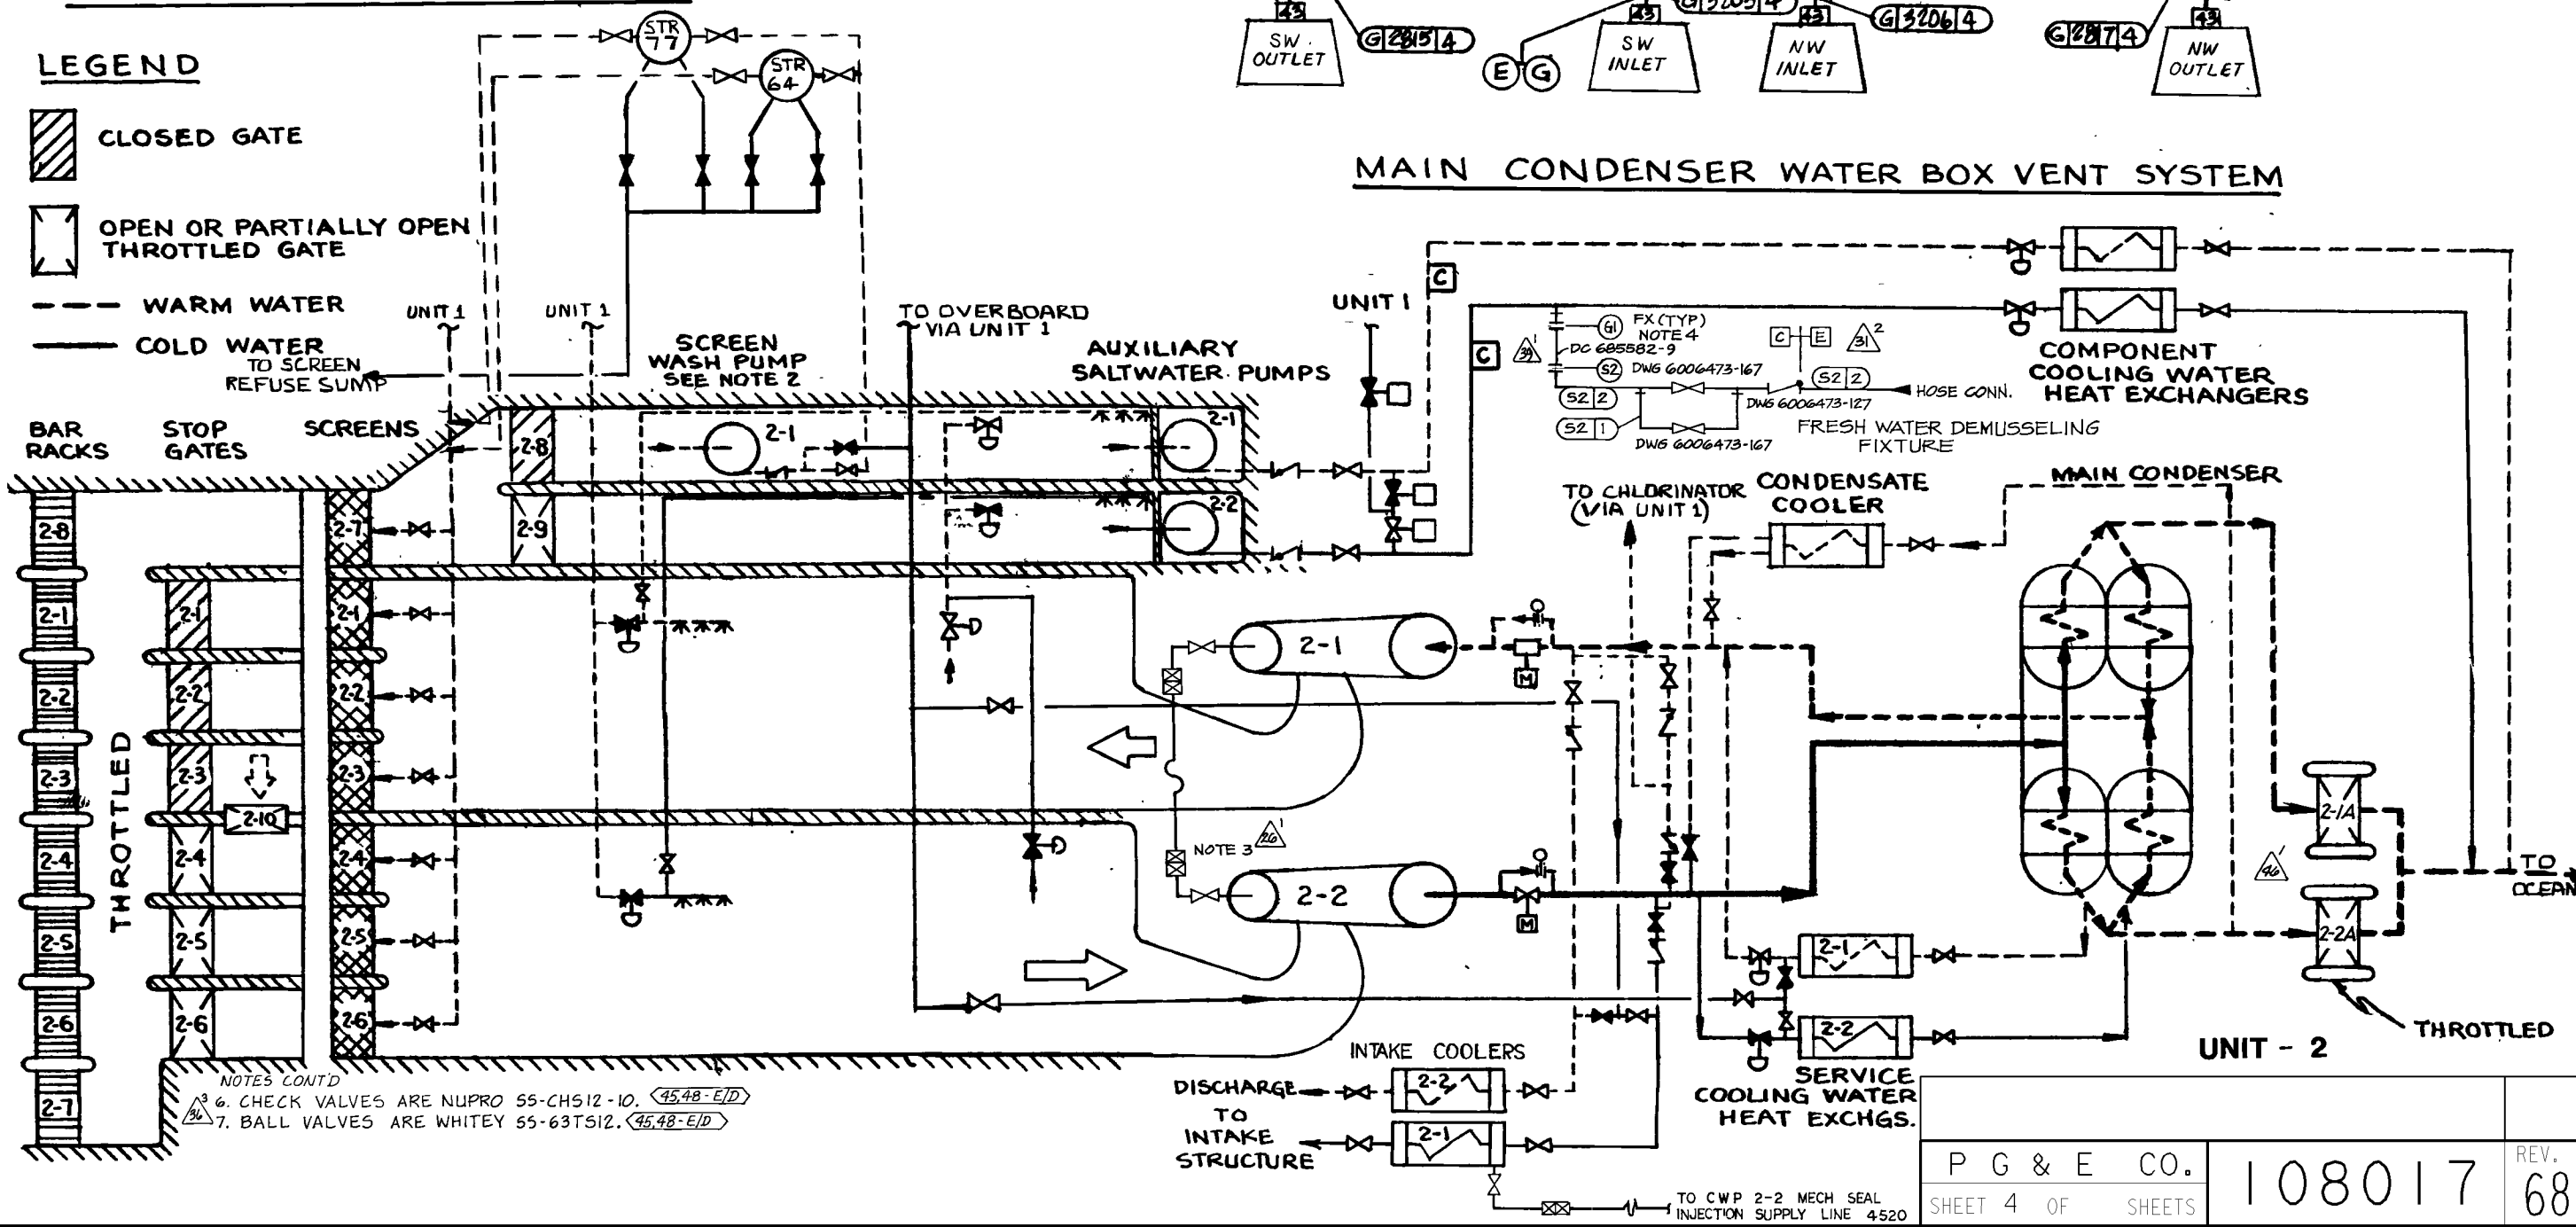


50 51 52 53 54 55 56 57 58 59

NOTE: CHLORINATION SYSTEM IS
COMMON TO BOTH UNITS. SEE
UNIT-1 - DWG. 102017 SH-5

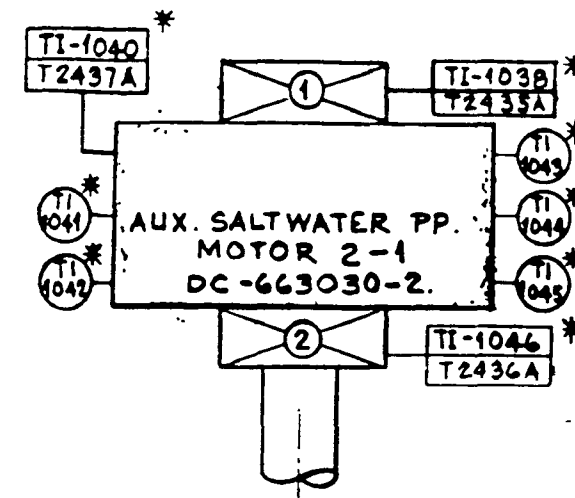

AUXILIARY SALTWATER PUMP MOTOR INSTRUMENT NOS.		
LOCATION	PP. MOTOR 2-1	PP. MOTOR 2-2
UPPER BEARING ①	TI-1038 T2435A	TI-1047 T2439A
LOWER BEARING ②	TI-1046 T2436A	TI-1055 T2440A
MOTOR STATOR WINDING	TI-1040 T2437A	TI-1049 T2441A
	TI-1041	TI-1050
	TI-1042	TI-1051
	TI-1043	TI-1052
	TI-1044	TI-1053
	TI-1045	TI-1054

AUXILIARY SALTWATER PP.
MOTOR INSTRUMENTATION

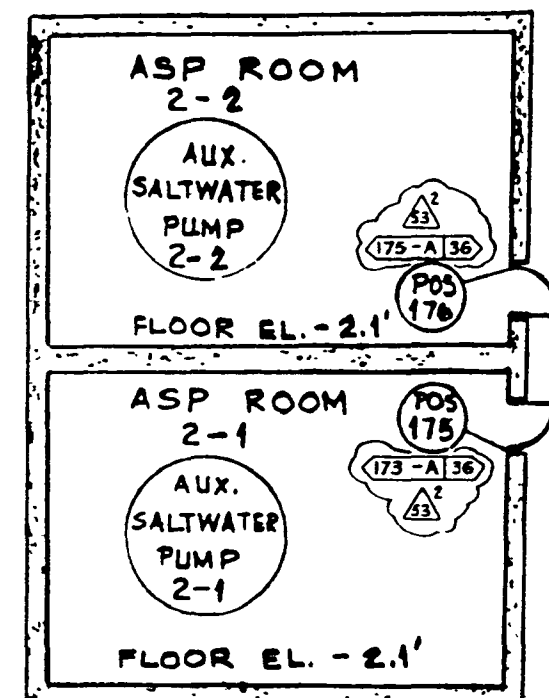


AUXILIARY SALTWATER PUMP
WATERTIGHT ROOMS


UNIT- 2

P.G. & E. CO.	DRAWING NUMBER	REVISION
	108017	53
SHEET 5 OF SHEETS		MICROFILM

SCAN 53 IC

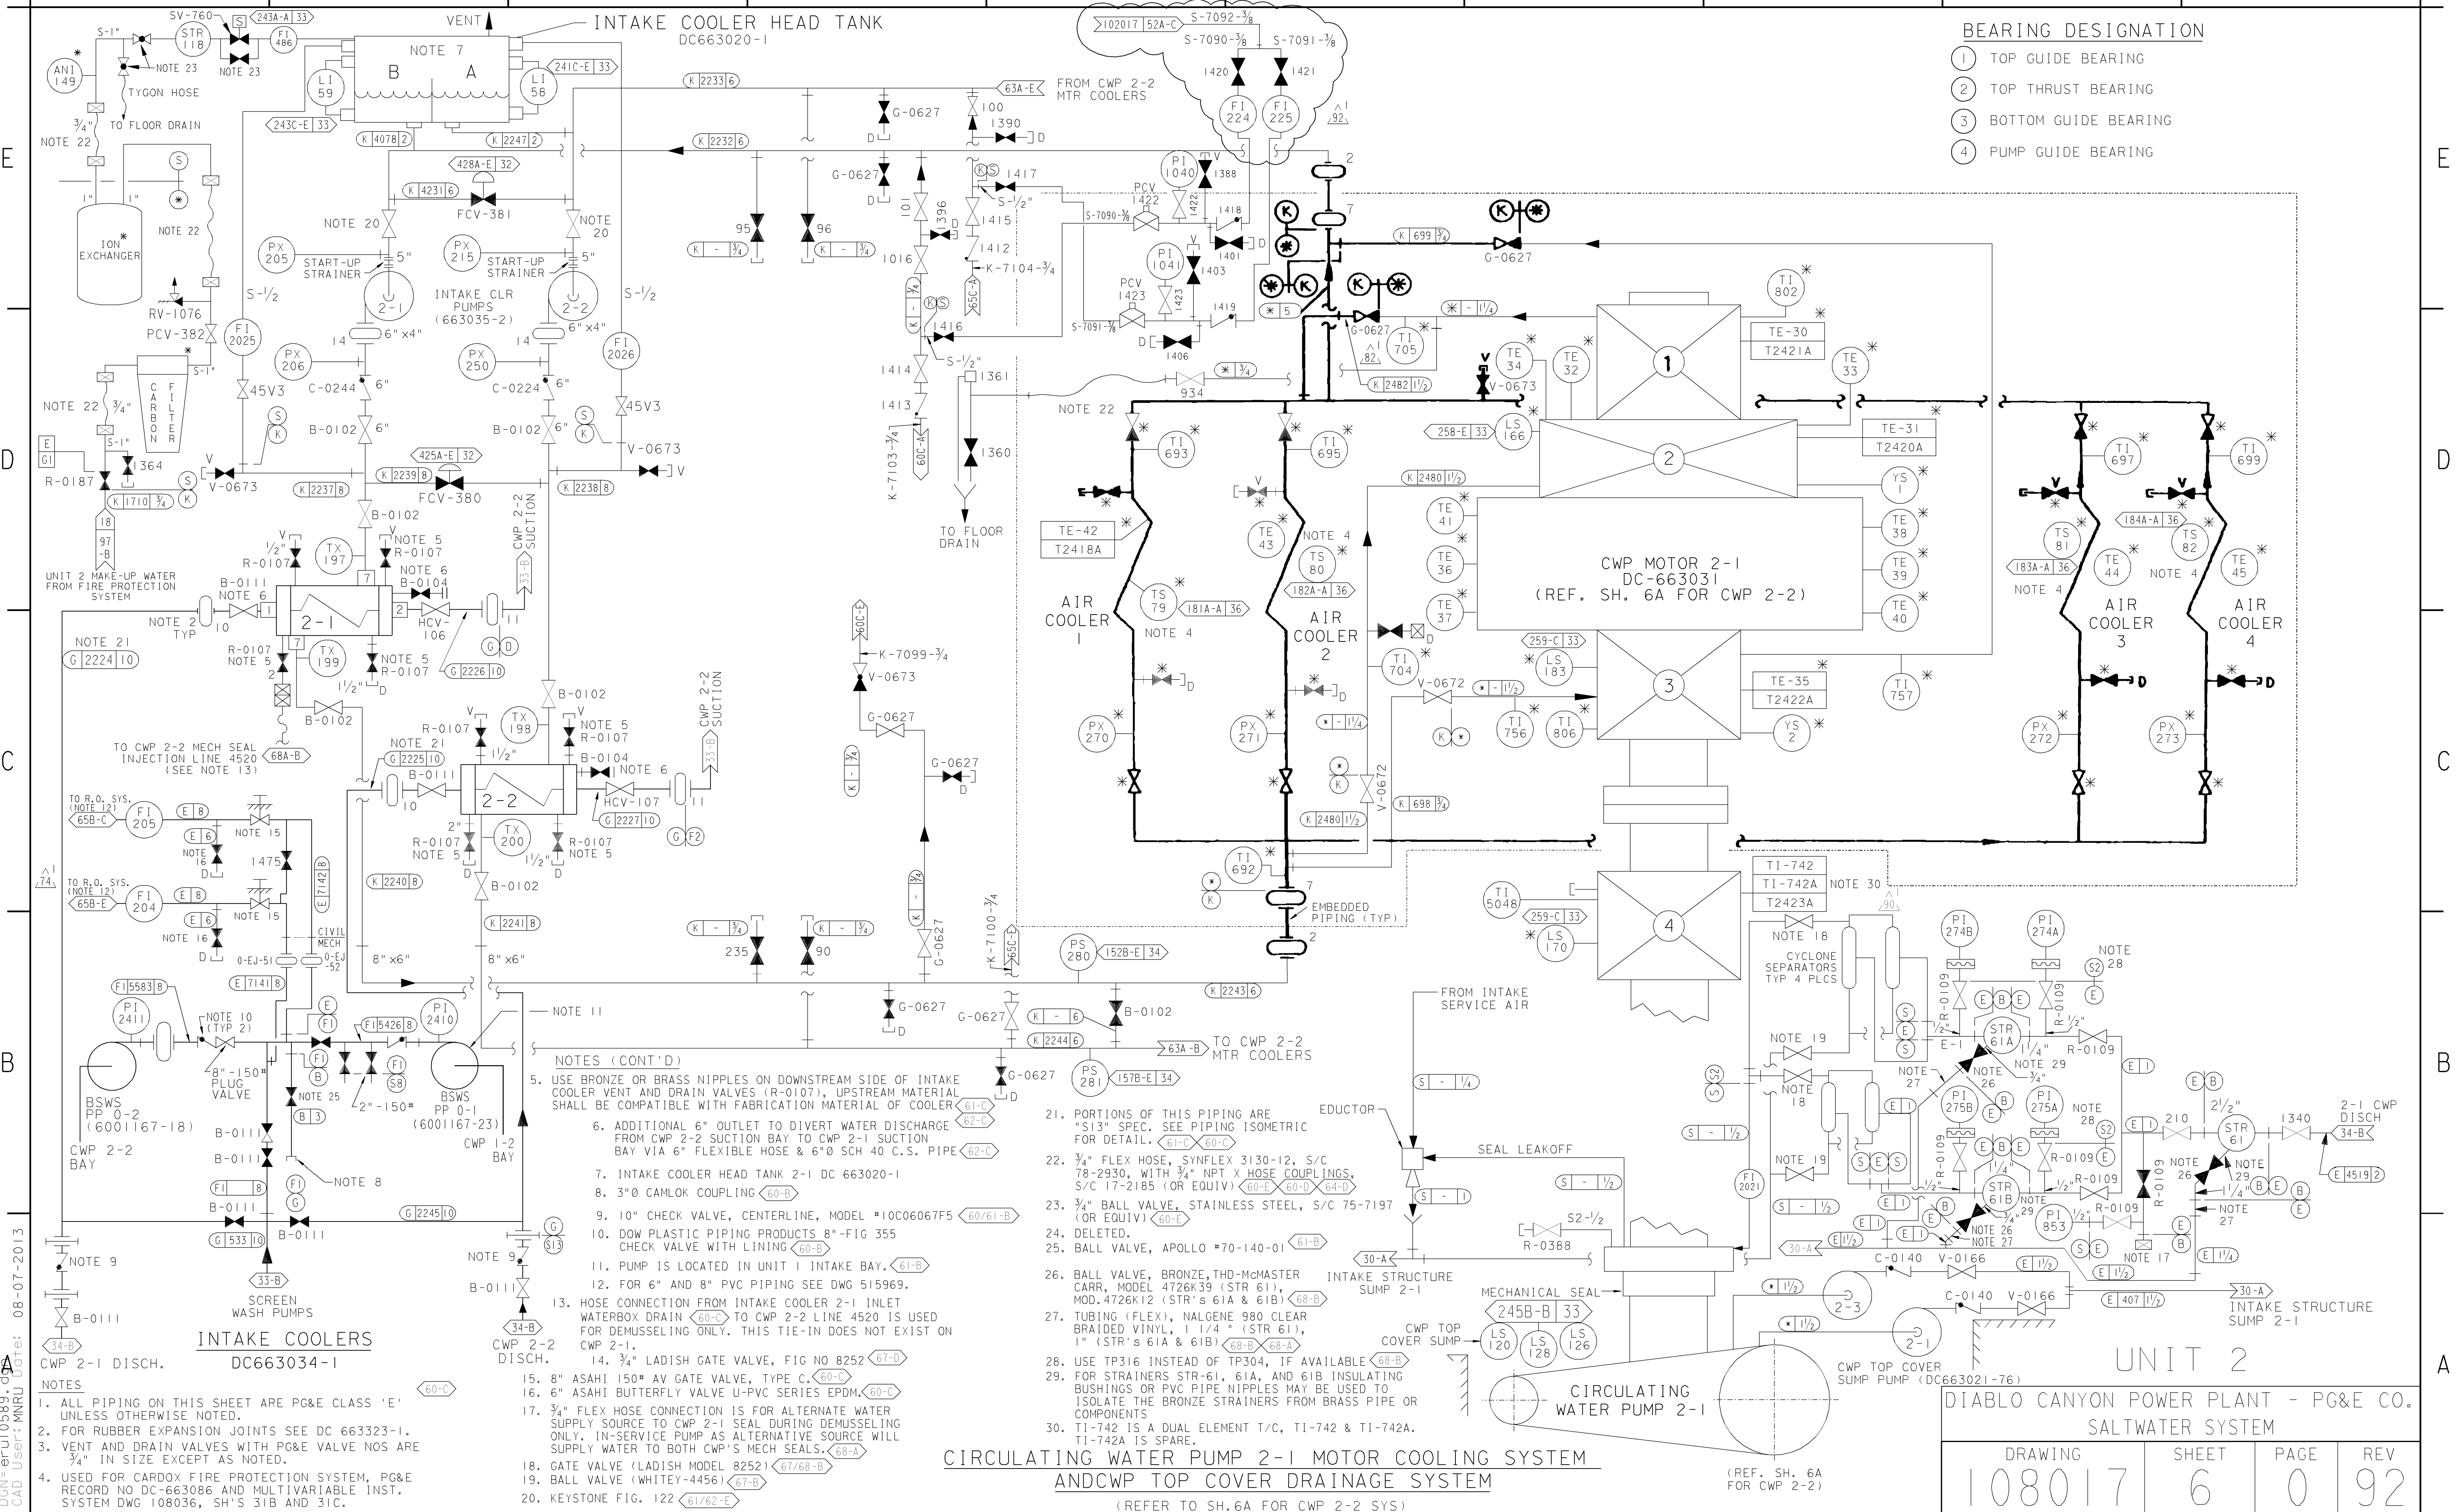

RASTER:erul0589.dgn
DGN:erul0589.dgn
CAD User: MNRU Date: 08-07-2013

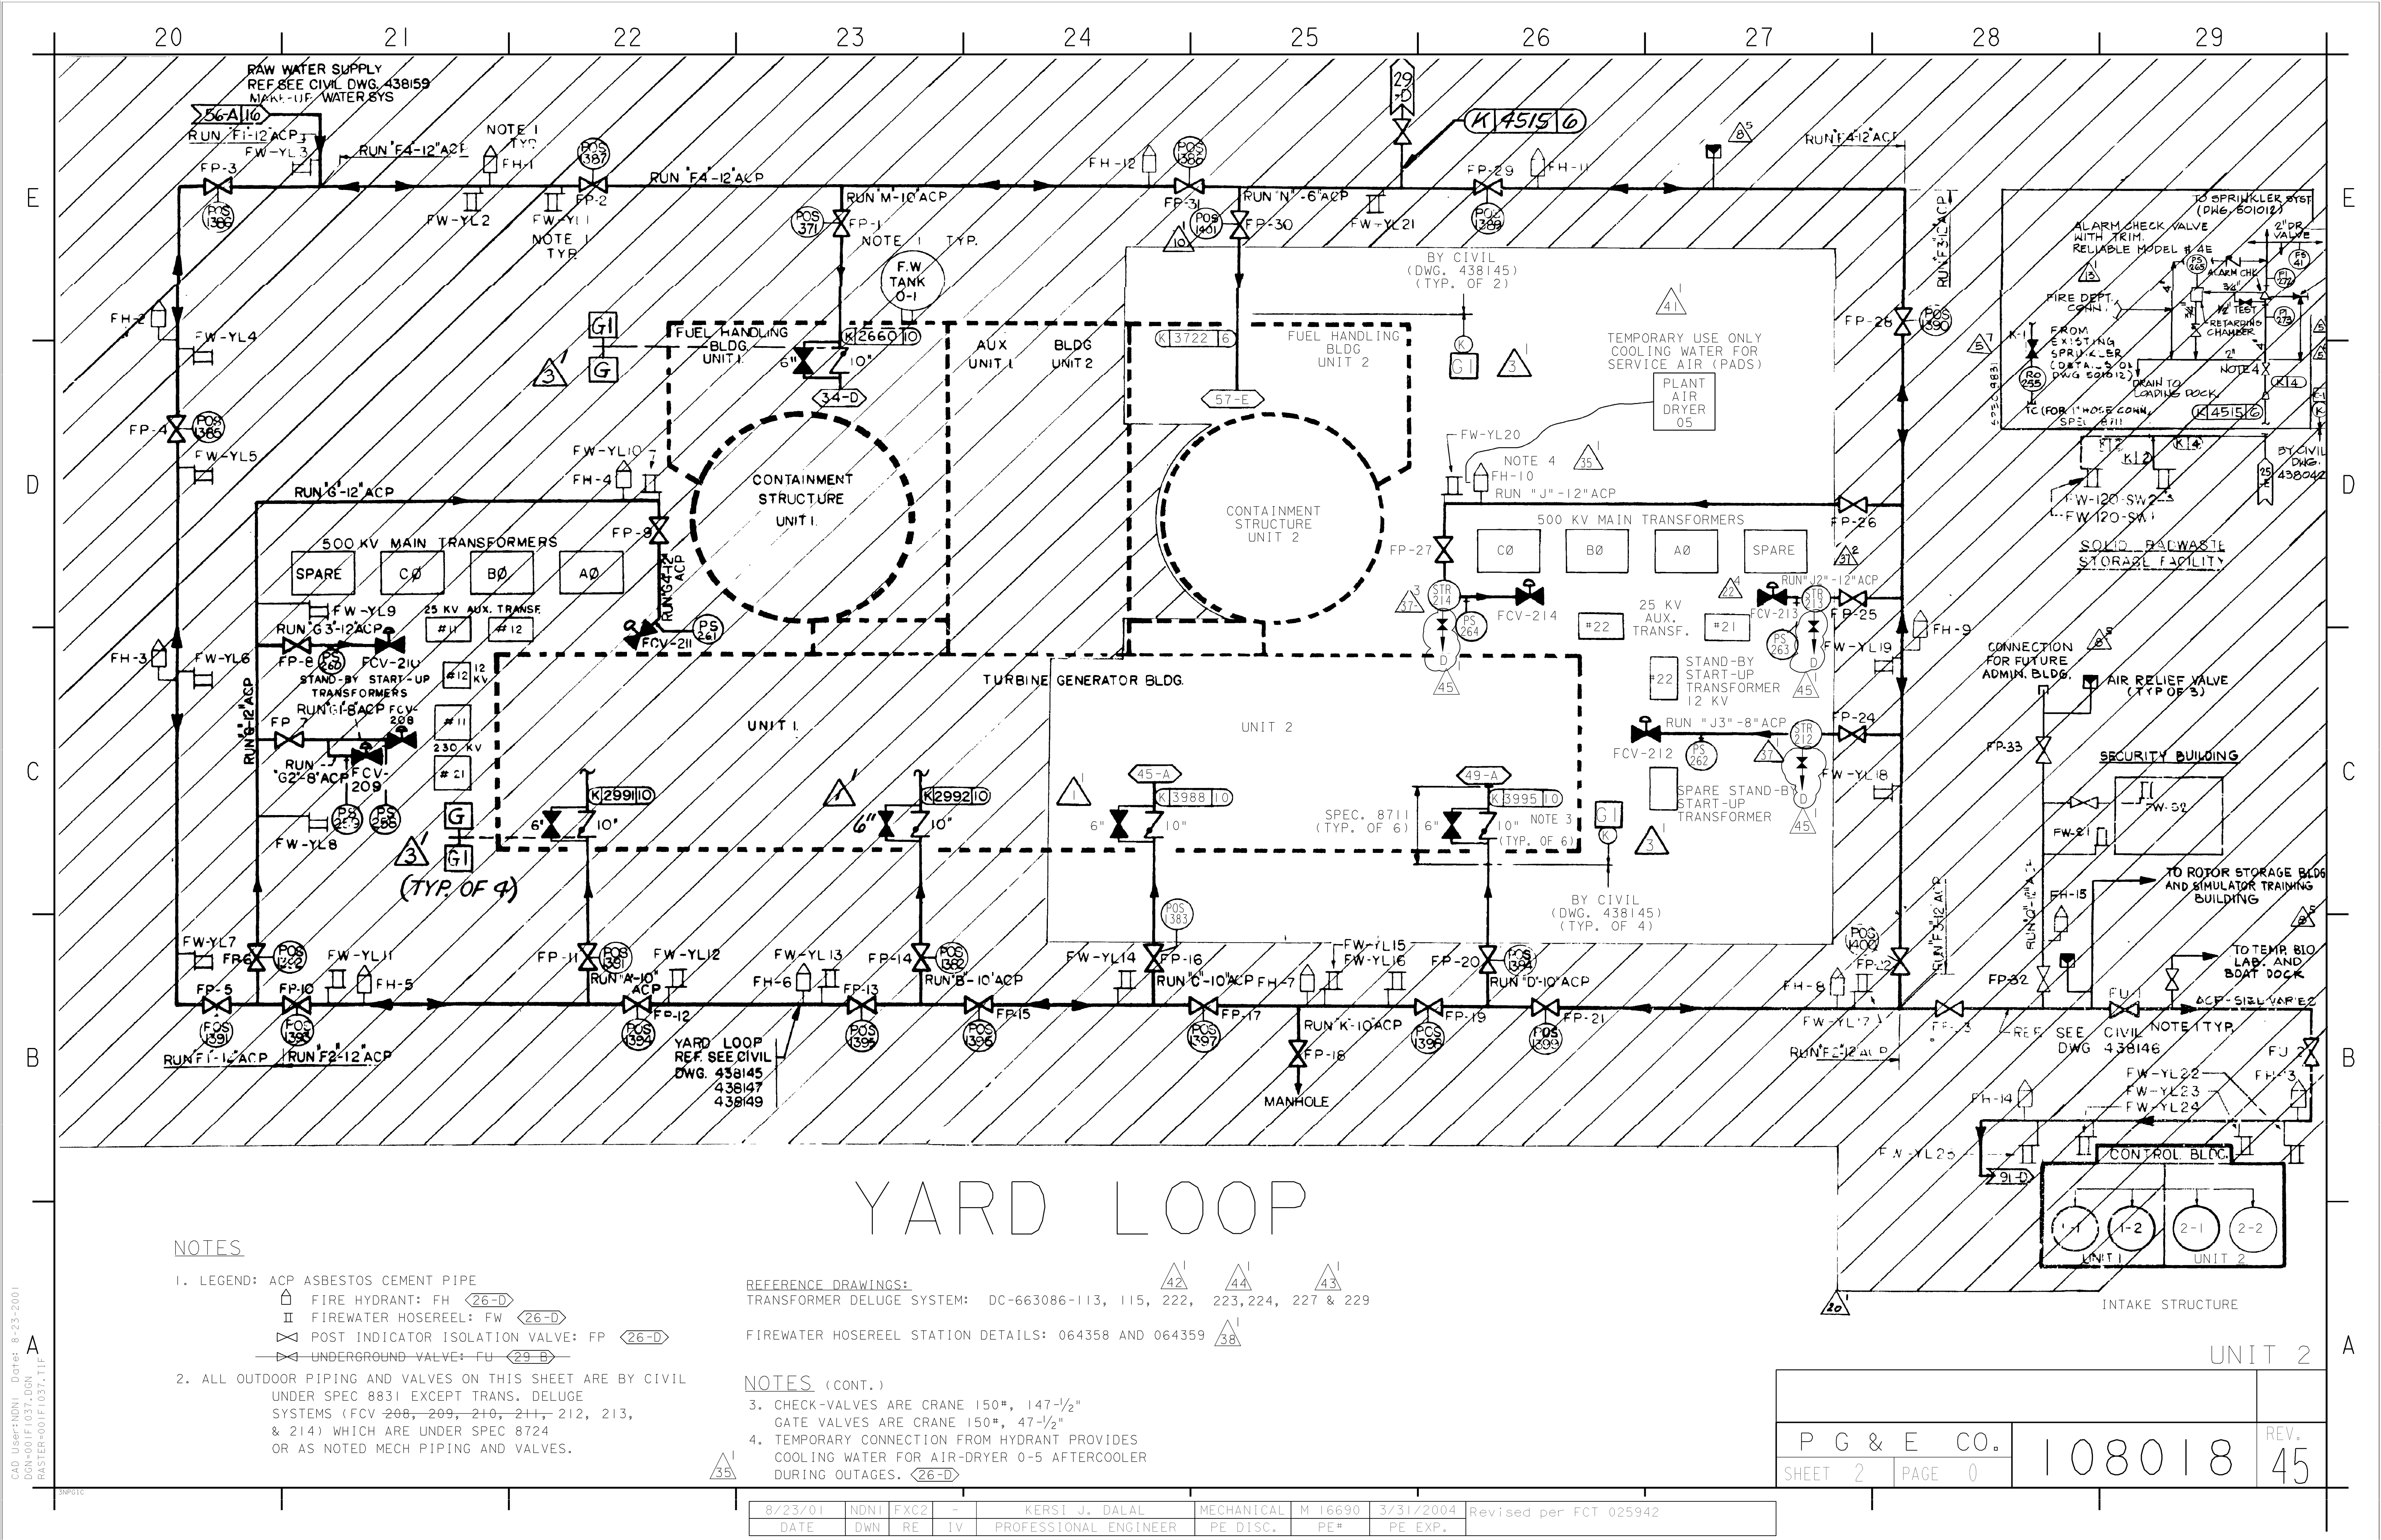

NOTES

1. LEGEND: ACP ASBESTOS CEMENT PIPE
FH FIRE HYDRANT: FH (26-D)
FW FIREWATER HOSEREEL: FW (26-D)
FP POST INDICATOR ISOLATION VALVE: FP (26-D)
FU UNDERGROUND VALVE: FU (29-B)
2. ALL OUTDOOR PIPING AND VALVES ON THIS SHEET ARE BY CIVIL UNDER SPEC 8831 EXCEPT TRANS. DELUGE SYSTEMS (FCV-208, 209, 210, 211, 212, 213, & 214) WHICH ARE UNDER SPEC 8724 OR AS NOTED MECH PIPING AND VALVES.

REFERENCE DRAWINGS:
TRANSFORMER DELUGE SYSTEM: DC-663086-113, 115, 222, 223, 224, 227 & 229


FIREWATER HOSEREEL STATION DETAILS: 064358 AND 064359

NOTES (CONT.)

3. CHECK-VALVES ARE CRANE 150#, 147-1/2"
GATE VALVES ARE CRANE 150#, 47-1/2"
4. TEMPORARY CONNECTION FROM HYDRANT PROVIDES COOLING WATER FOR AIR-DRYER 0-5 AFTERCOOLER DURING OUTAGES. (26-D)

P G & E CO.		108018	REV. 45
SHEET 2	PAGE 0		

8/23/01	NDNI	FXC2	-	KERSI J. DALAL	MECHANICAL	M 16690	3/31/2004	Revised per FCT 025942	
DATE	DWN	RE	IV	PROFESSIONAL ENGINEER	PE DISC.	PE#	PE EXP.		

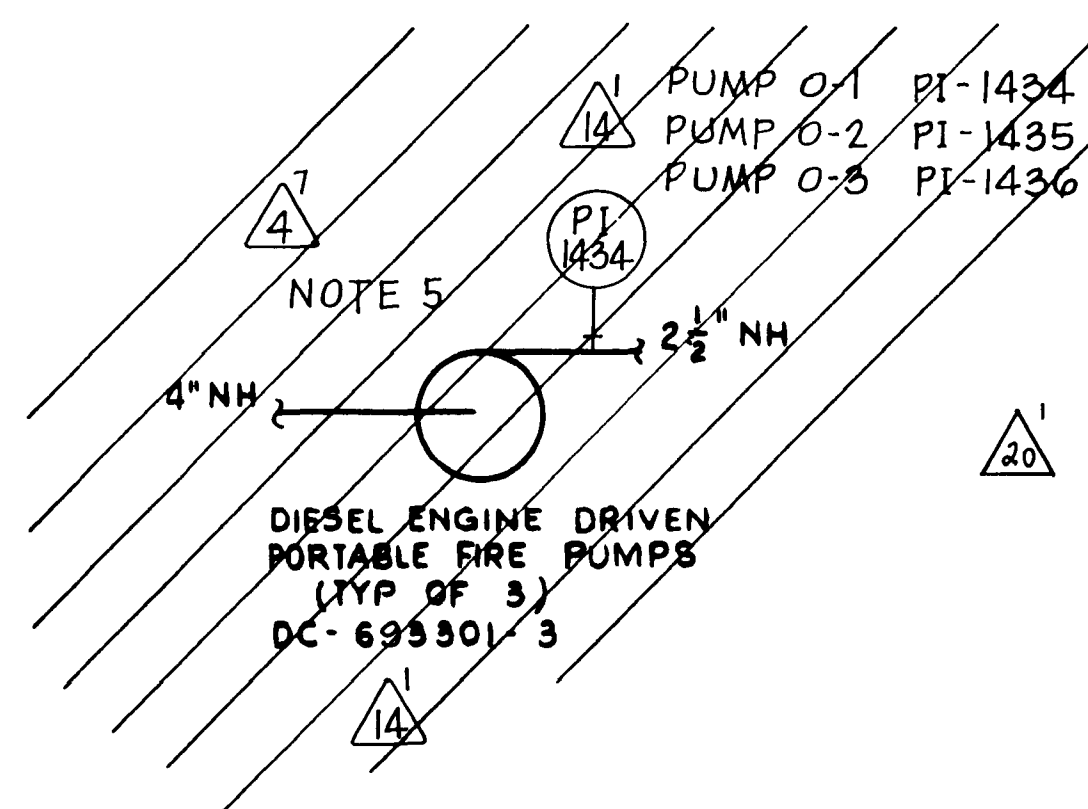

TO DELAVAL
HEATER

NOTES


1. ALL PIPING ON THIS SHEET IS UNDER SPEC. 8831 AND PG&E CLASS "G" EXCEPT AS NOTED. UNLESS OTHERWISE NOTED, PIPING INSIDE TURBINE BUILDING IS SPEC. "K".
2. PIPING WITH DOUBLE ASTERISKS ARE UNDER SPEC. 8724

3. 2 1/2" NATIONAL HOSE THREADED CONNECTION (CAPPED) FOR PORTABLE DIESEL ENGINE DRIVEN FIRE PUMPS. SPEC. 8711. CHECK VALVES ARE LUNKENHEIMER MODEL NO. 157 3C. (46-B) (47-B)

TURBINE
BUILDING

5. THE PORTABLE FIRE PUMPS ARE SEISMICALLY ANALYZED IN ACCORDANCE WITH DESIGN CRITERIA MEMORANDUM M-45.
6. THE VALVE IS PROVIDED WITH CHAIN OPERATOR FOR ACCESSIBILITY.

UNIT-2 CONTAINMENT
STRUCTURE

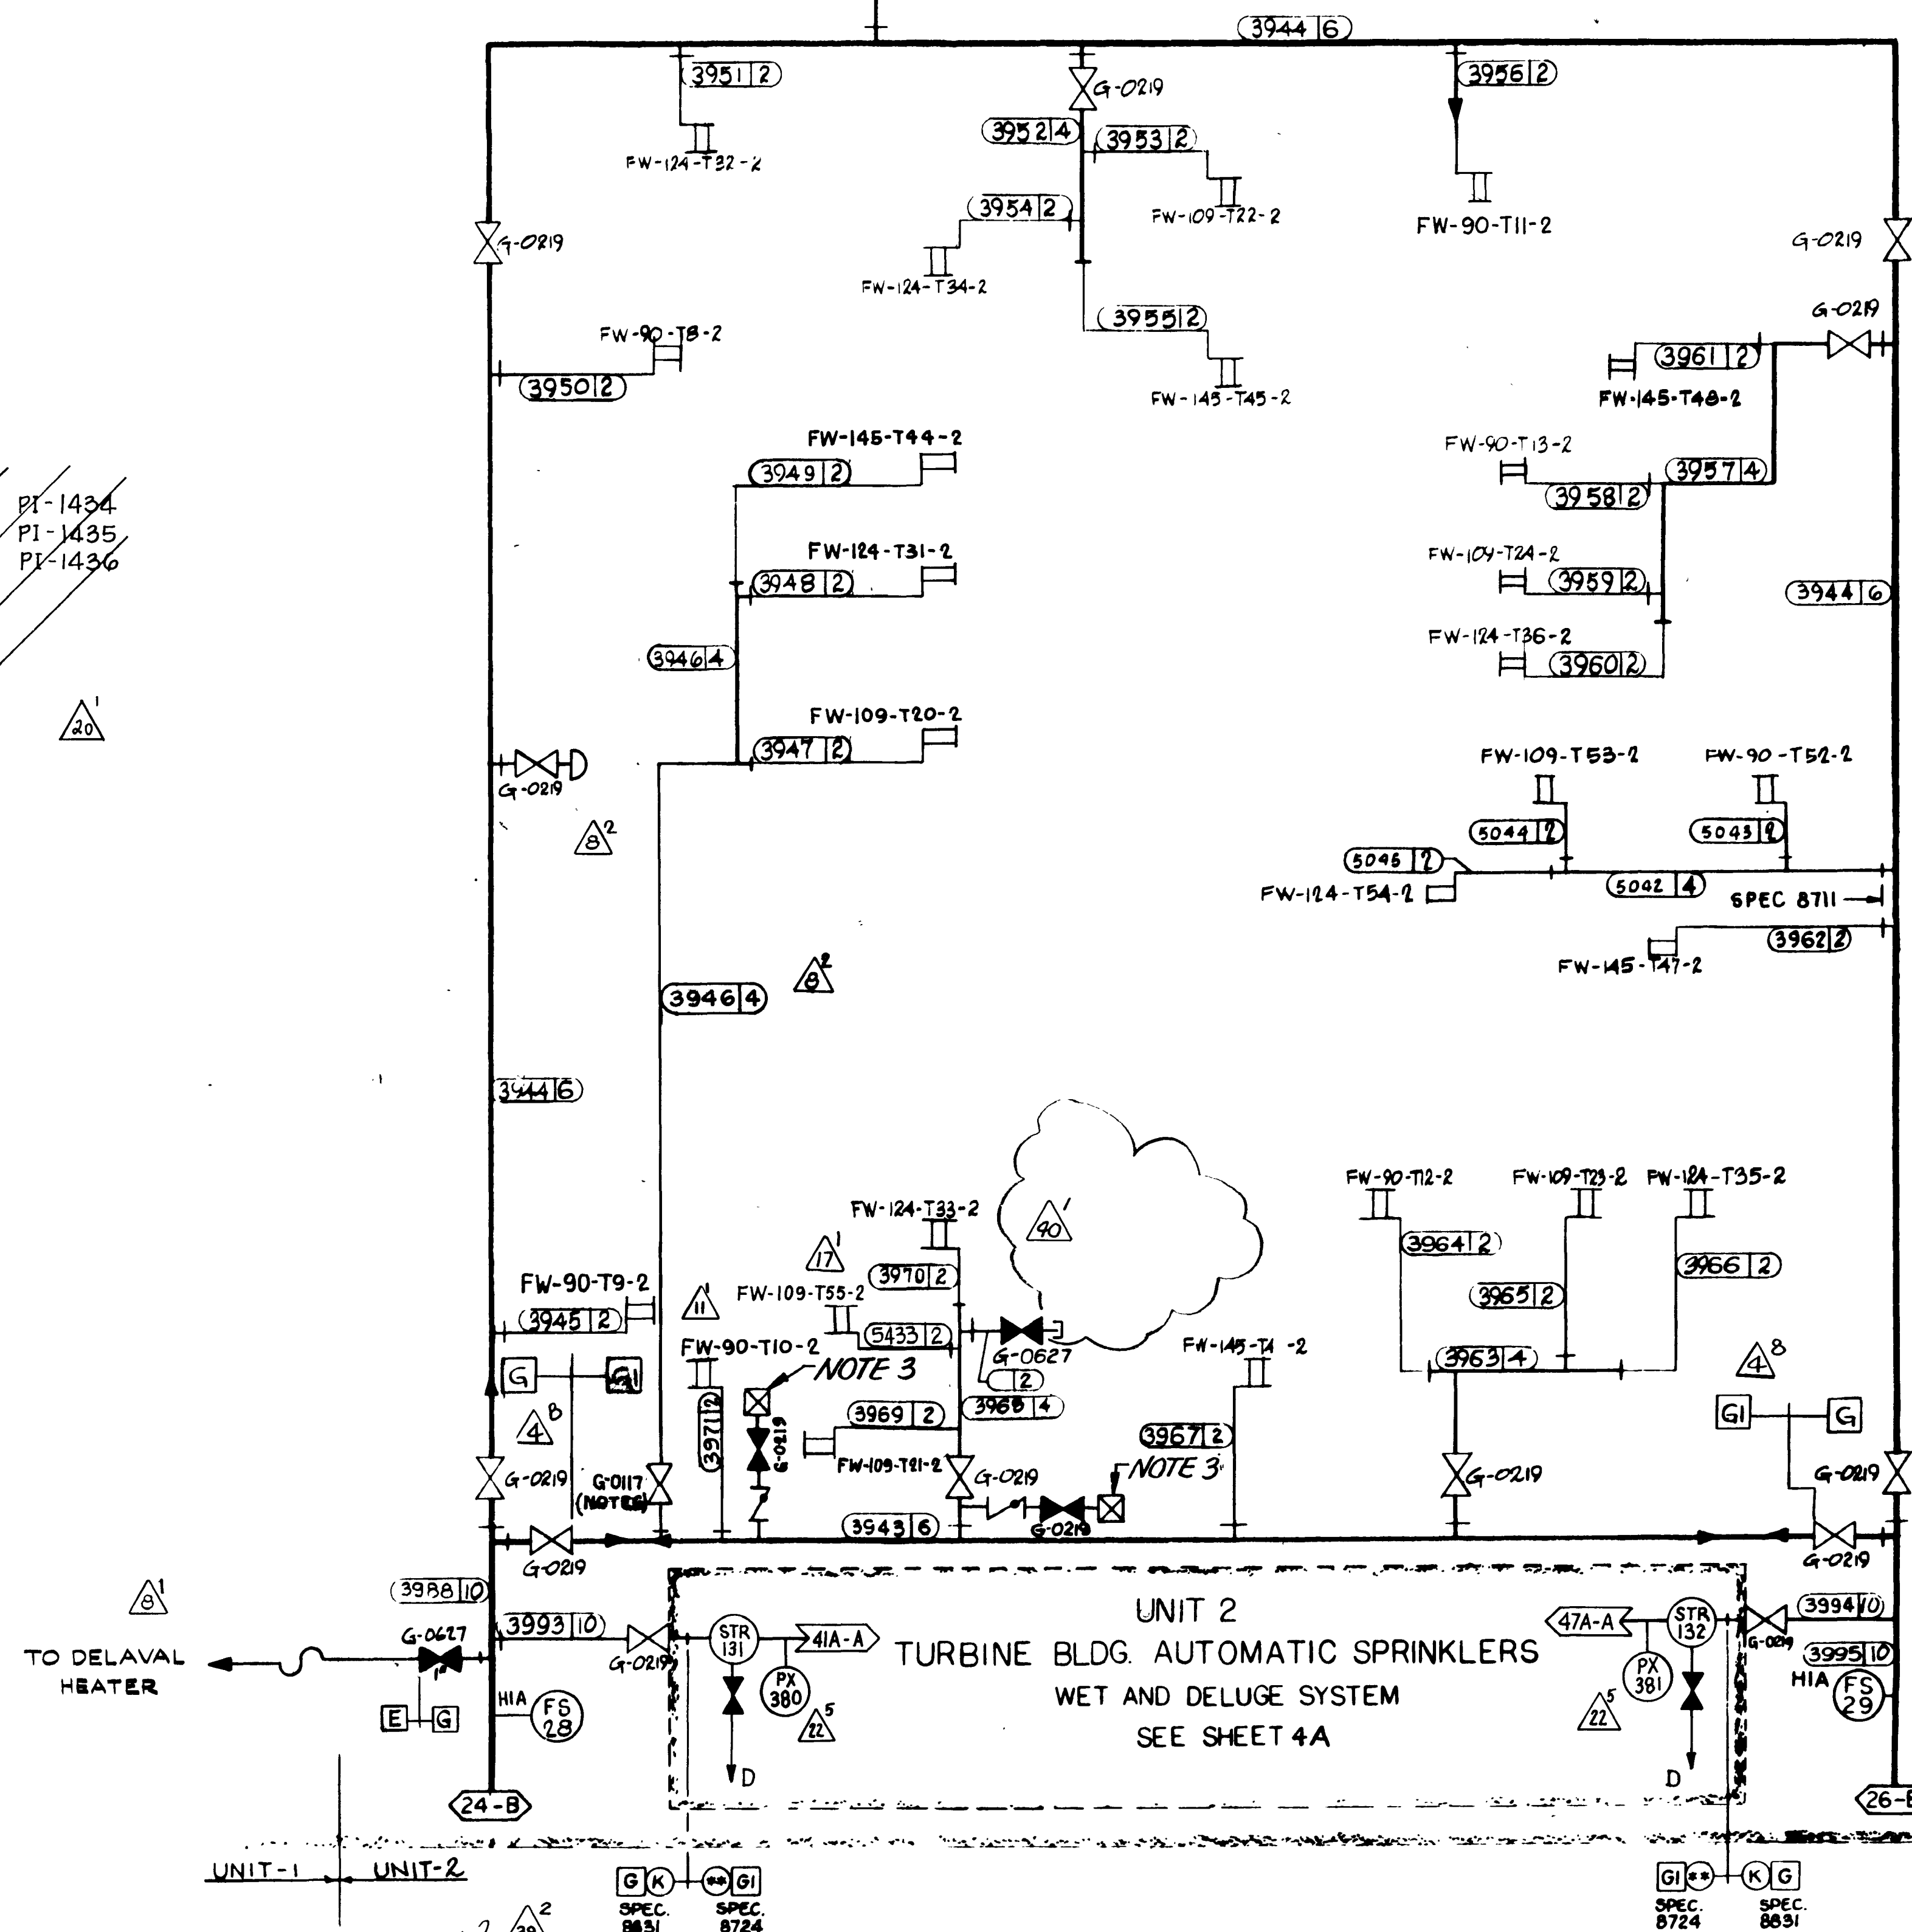

UNIT - 2

P. G. & E. CO.


SHEET 4 OF SHEETS

DRAWING NUMBER

108018



REVISION


40

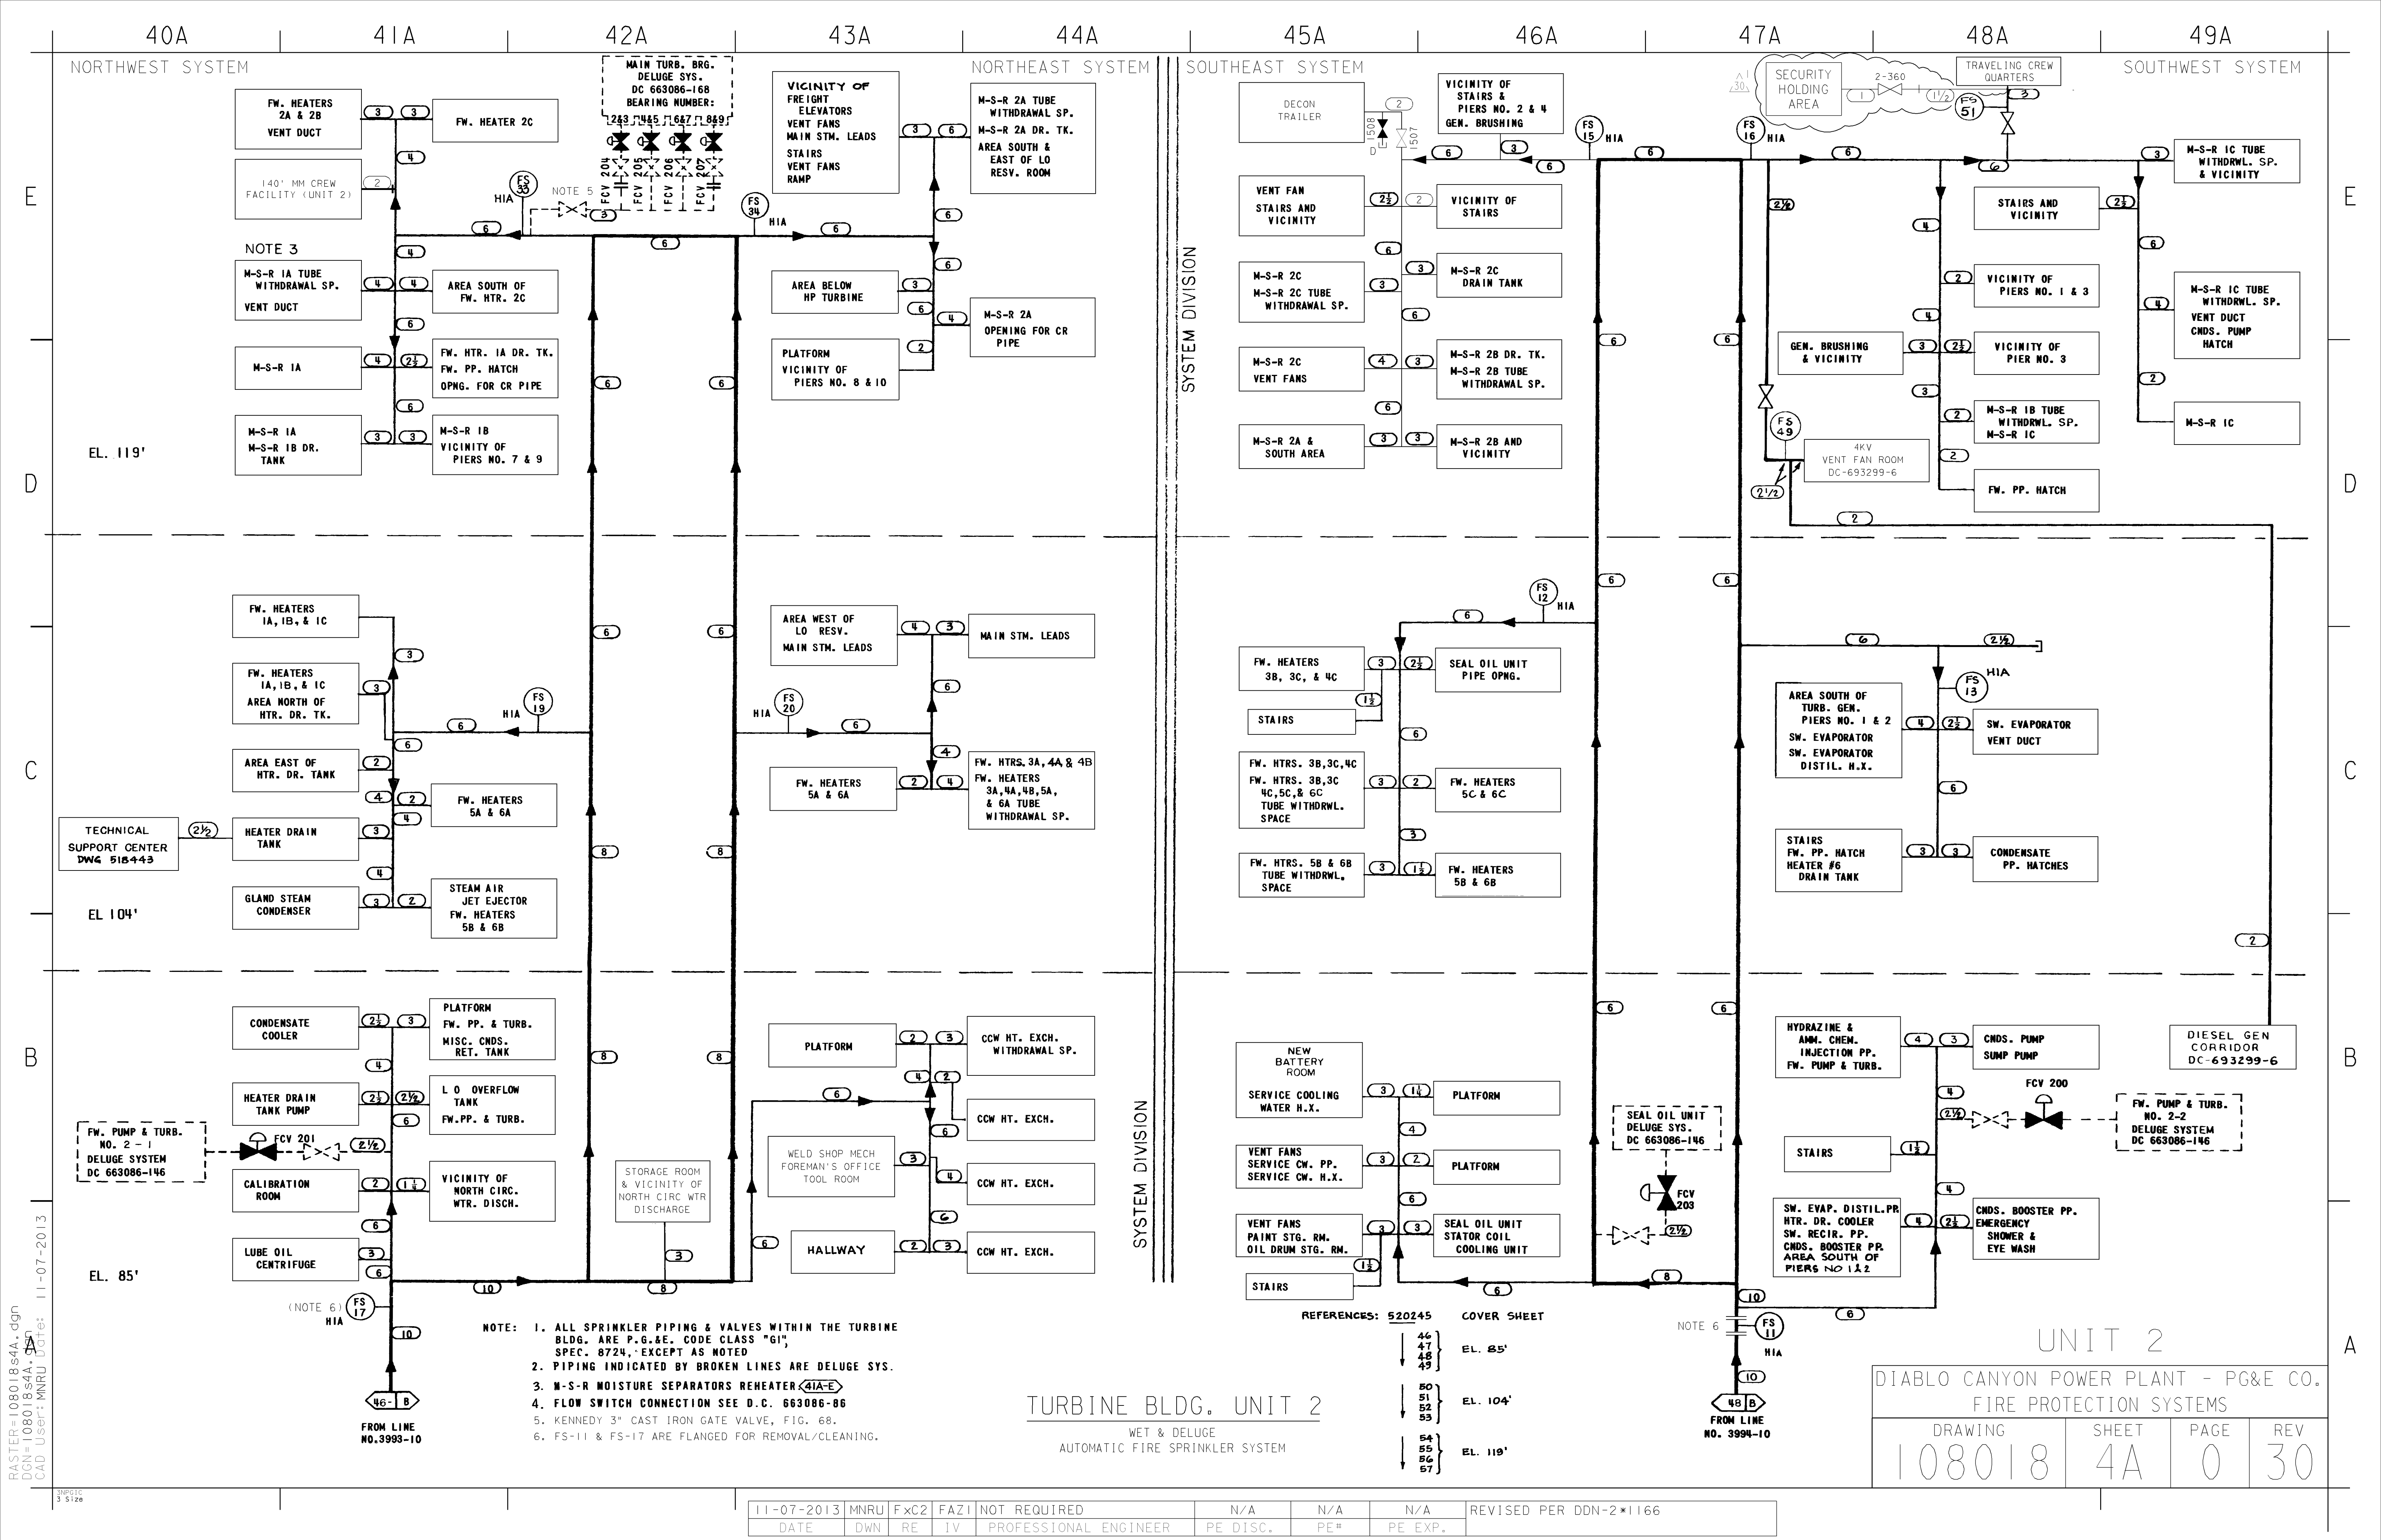




DRAWING 080 8	SHEET 5	PAGE 0	REV 28
----------------------	------------	-----------	-----------

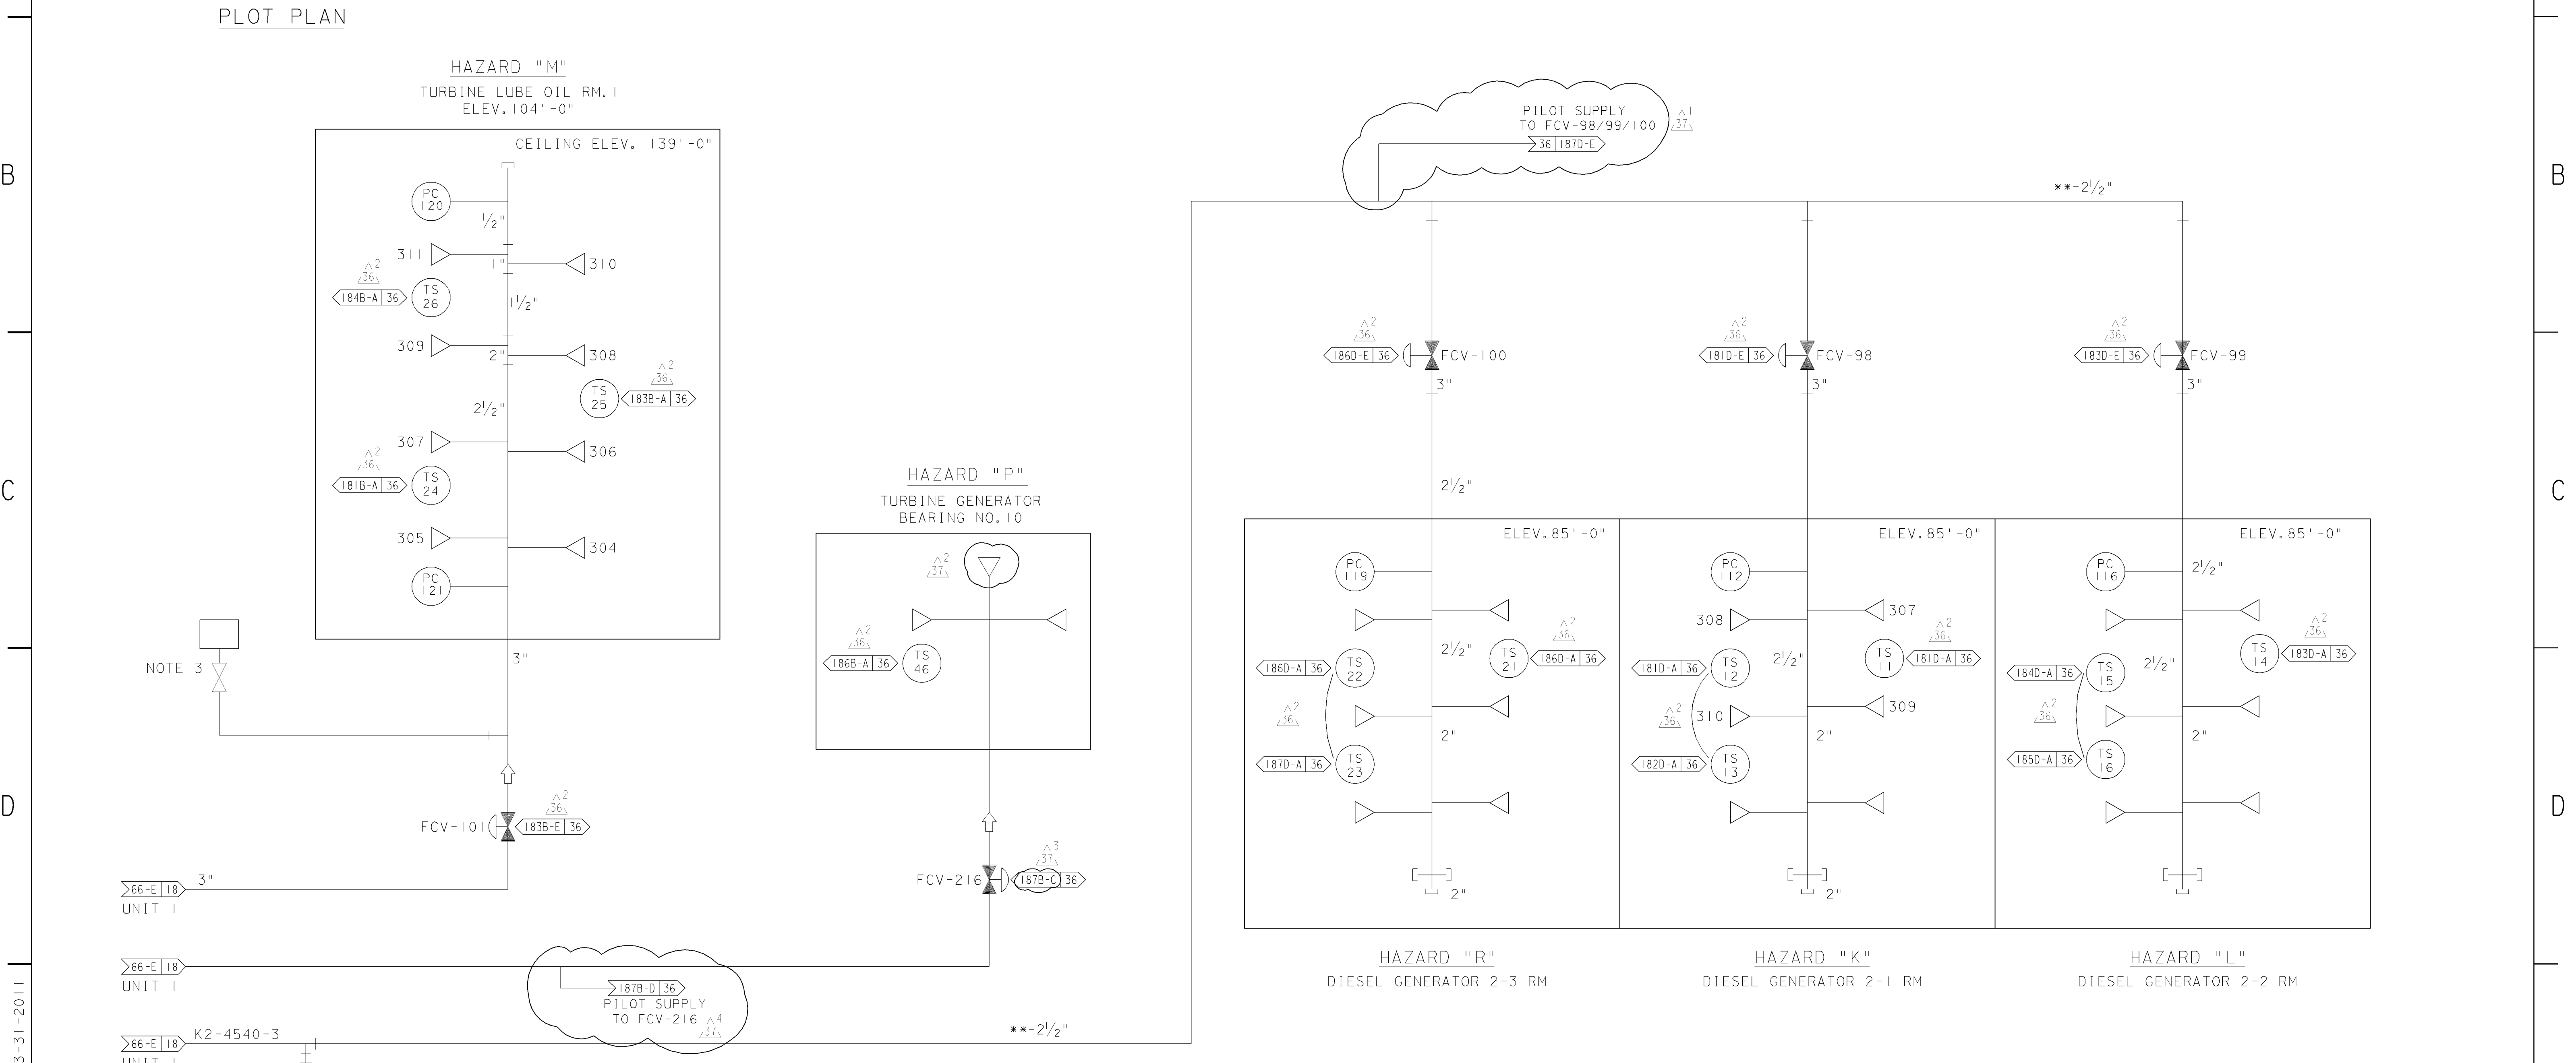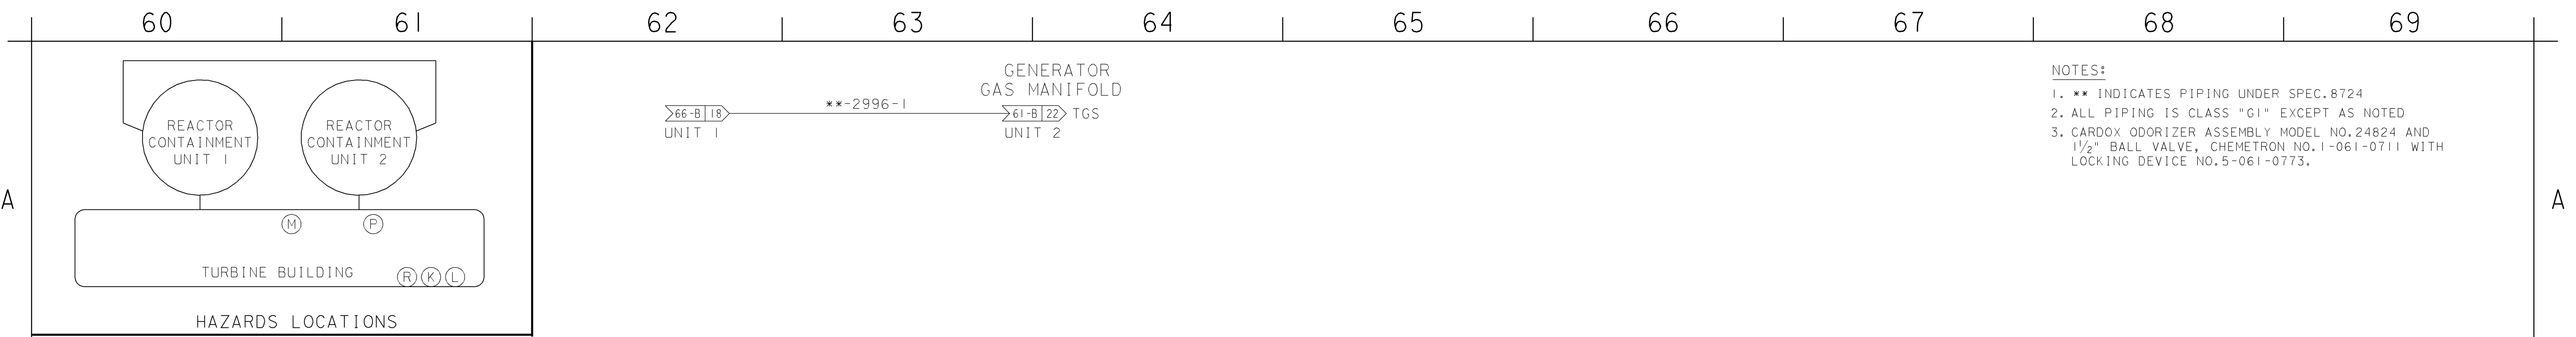

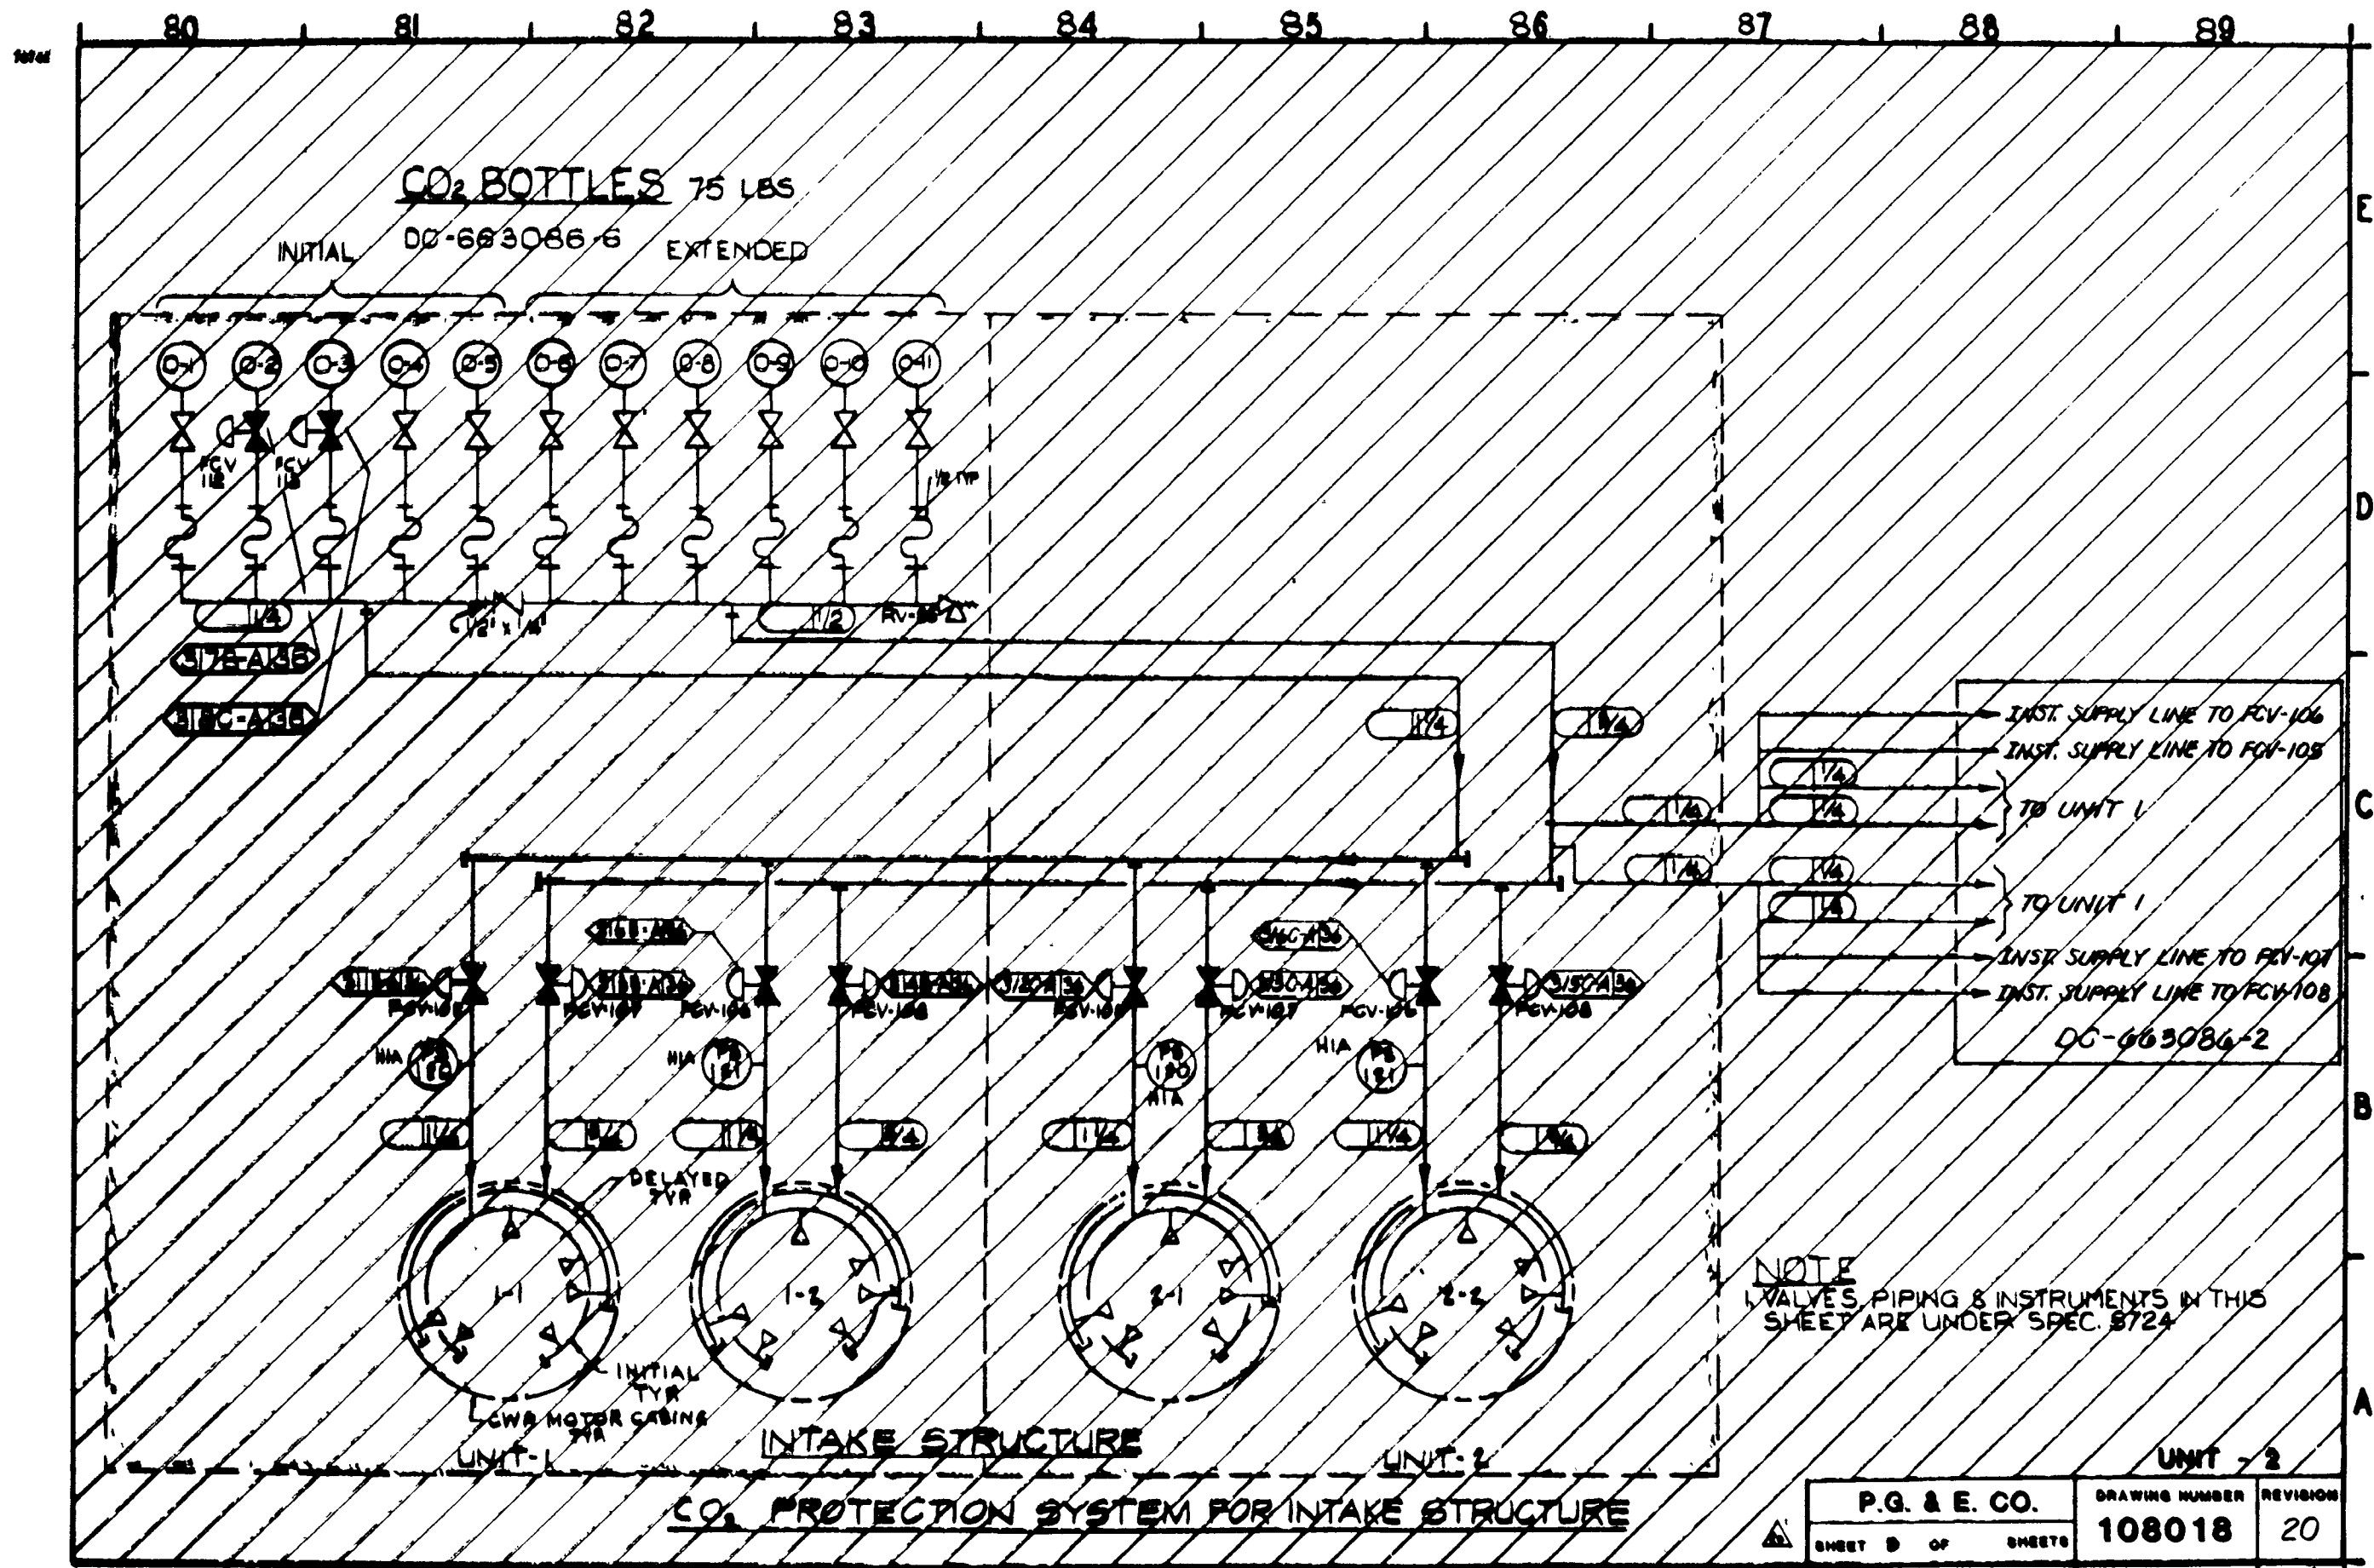

THIS DRAWING HAS BEEN REPRODUCED
WITHOUT CHANGE FROM ORIGINAL, EXCEPT
WHERE SHOWN OTHERWISE.

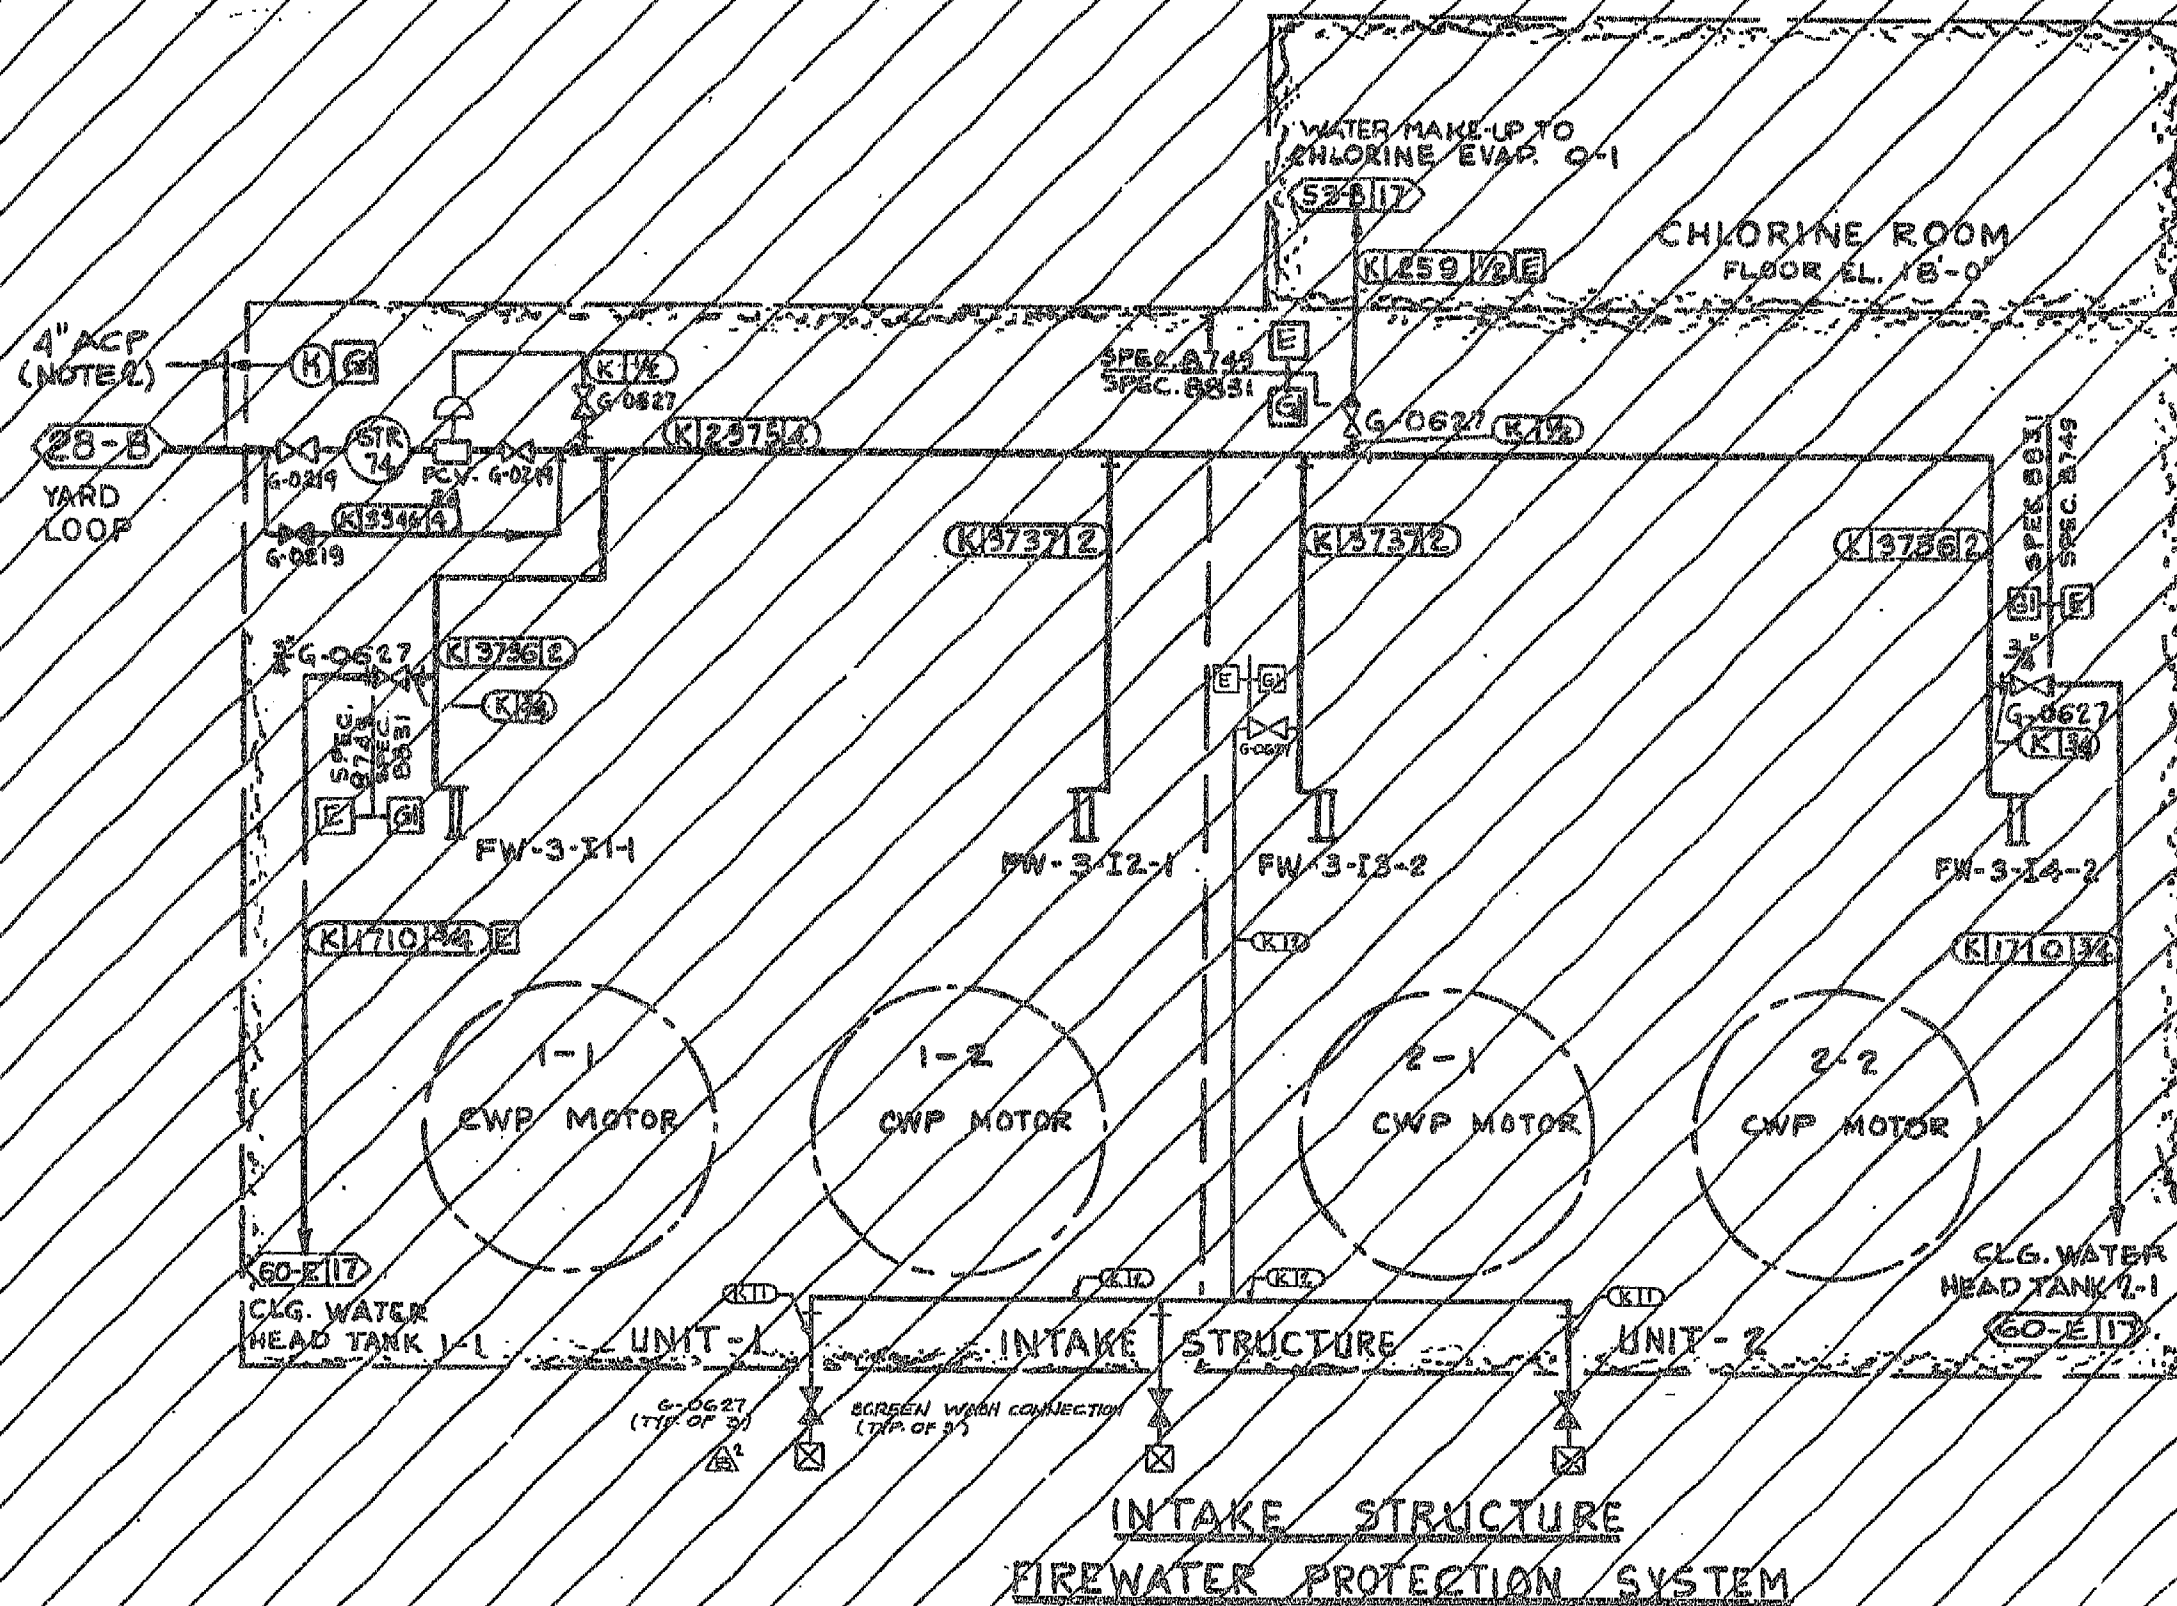

NOTES

1. DELETED
2. ASBESTOS CEMENT PIPE BY CIVIL, REF DWG. 430146.

108 018 CHANGE 1
SH. 9


ALL CHANGES HAVE BEEN INCORPORATED
WITHOUT CHANGE FROM ORIGINAL DRAWING
DATE 1-15-1960 BY 108 018

RM INDEXED REV. 20

P.G. & E. CO.		DRAWING NUMBER	REVISION
SHEET 9 OF SHEETS		108018	20
MICROFILM			20

SCANNED: 20

UNIT - 2

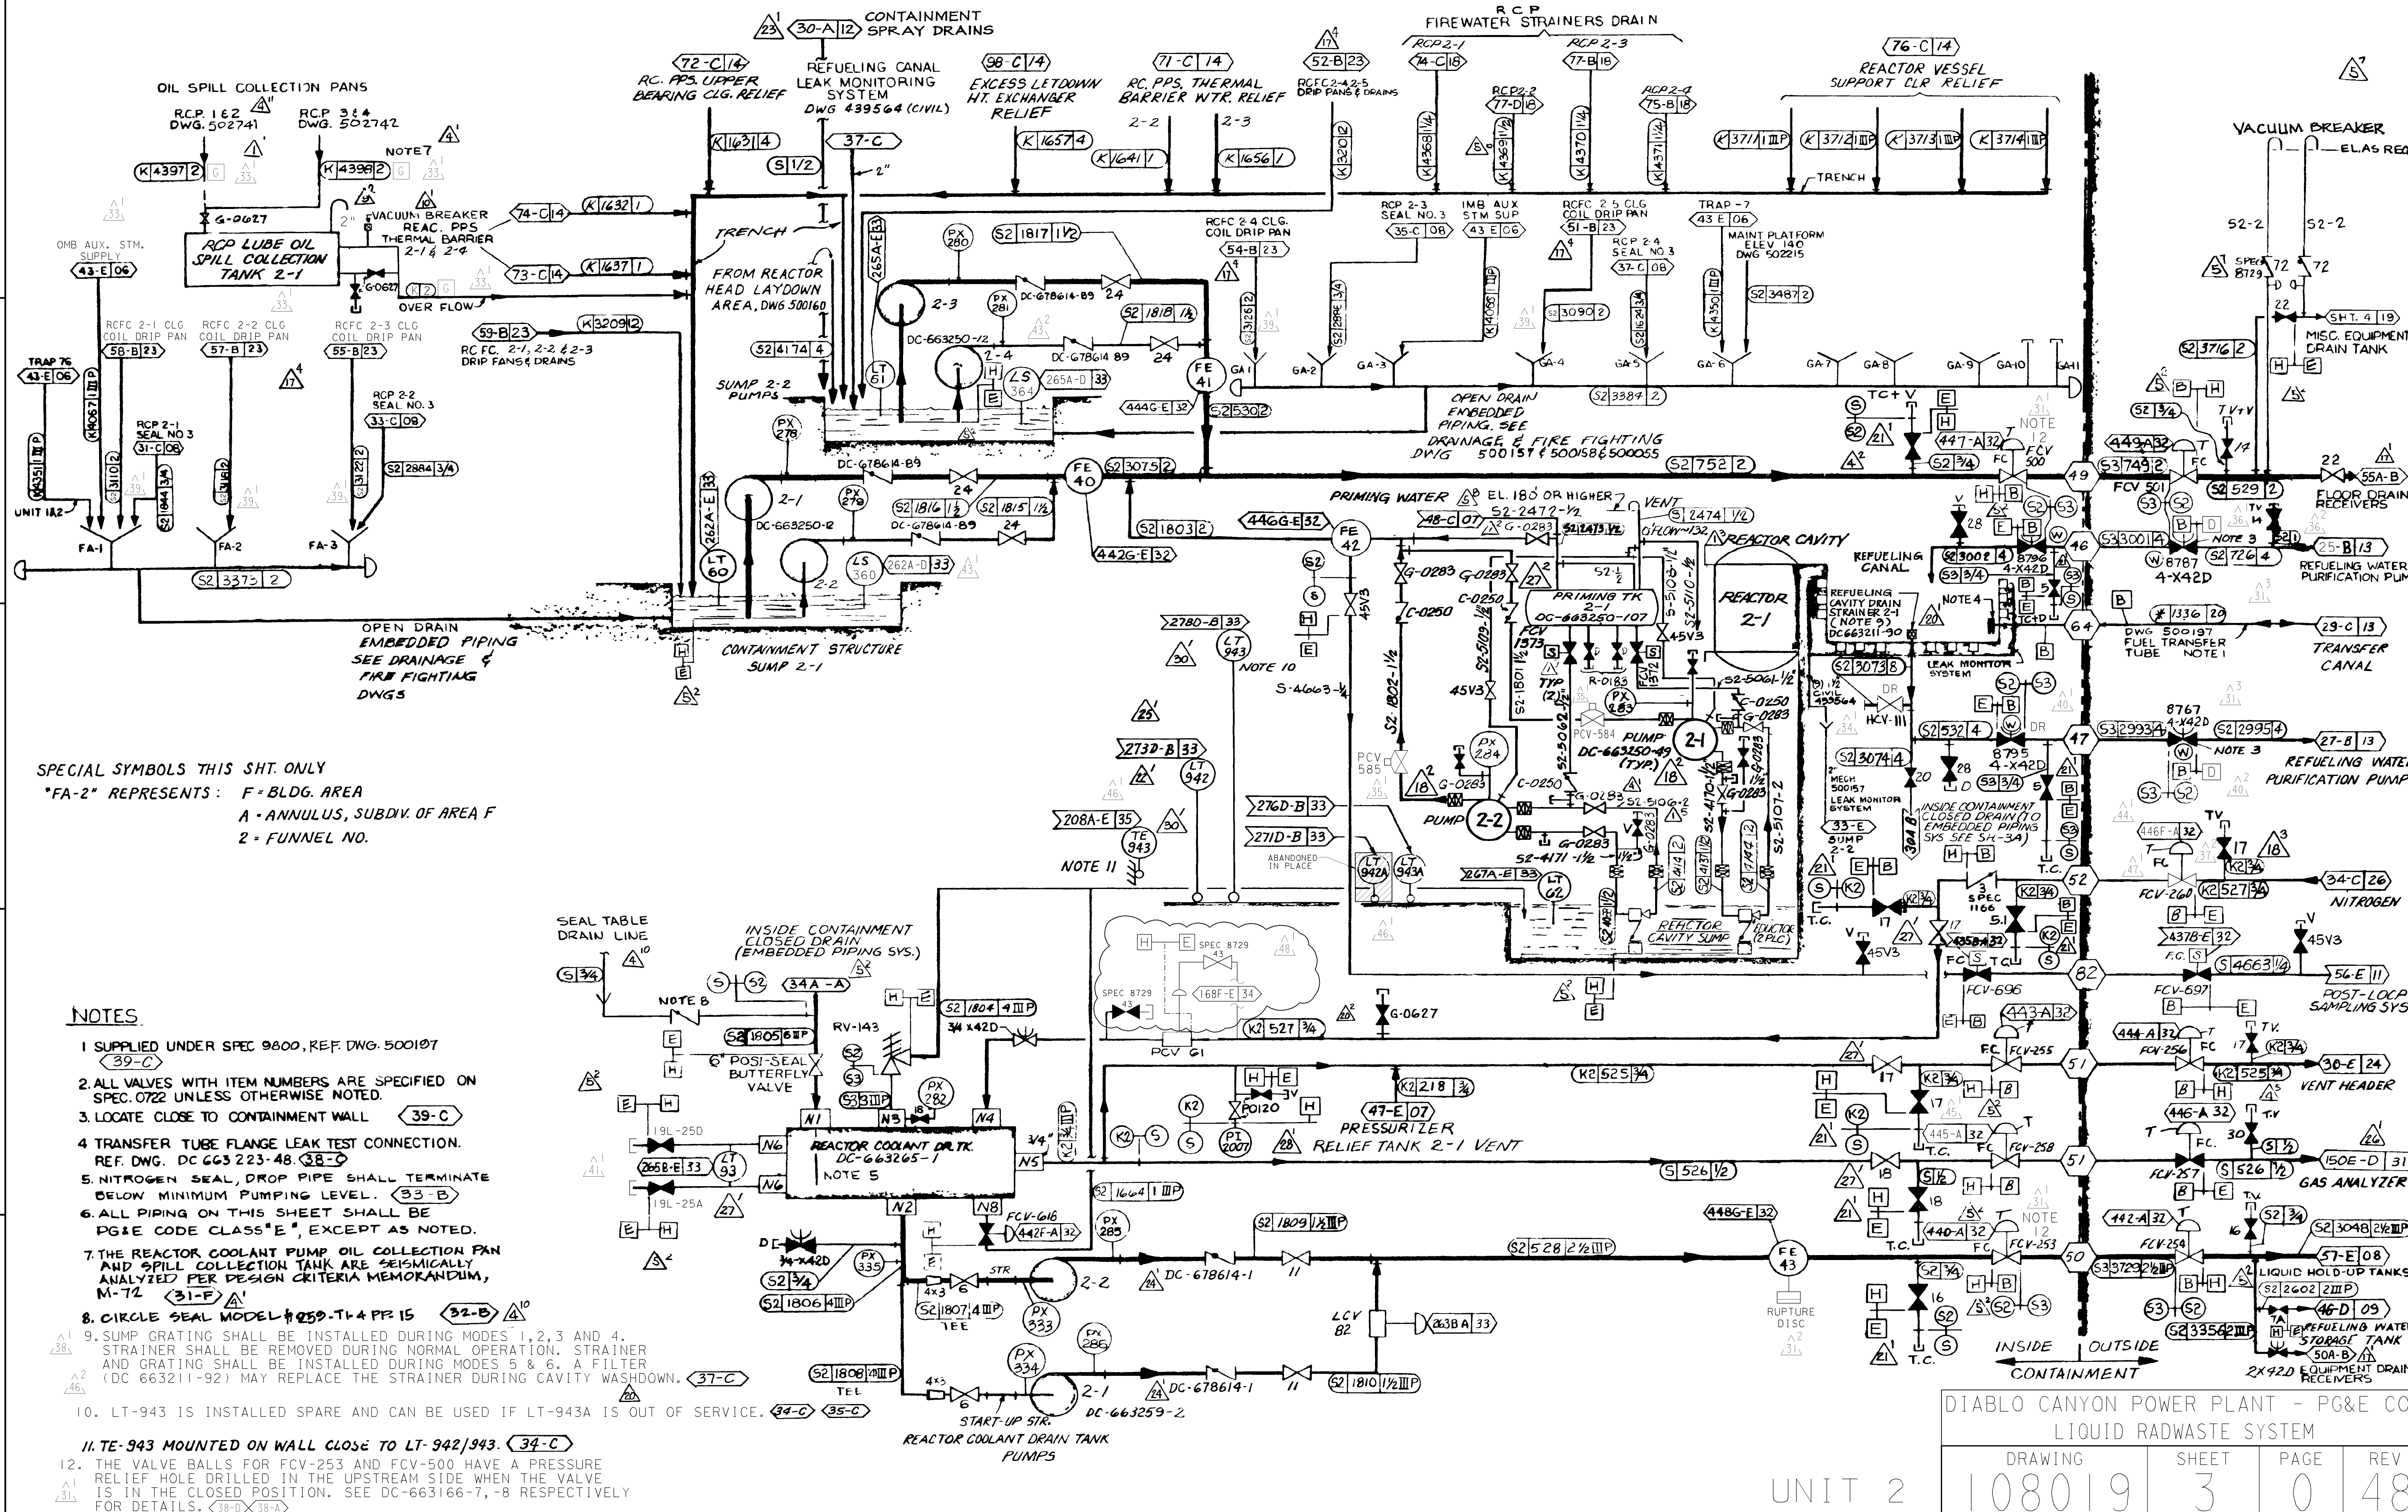

DIABLO CANYON POWER PLANT - PG&E CO.
 LIQUID RADWASTE SYSTEM

UNIT 2

DRAWING	SHEET	PAGE	REV
108019	3	0	48

E

D

C

B

06-02-2010
DGN: 108019S3A.dgn
CAD User: GN07 Date:

A


E

D

C

B

A

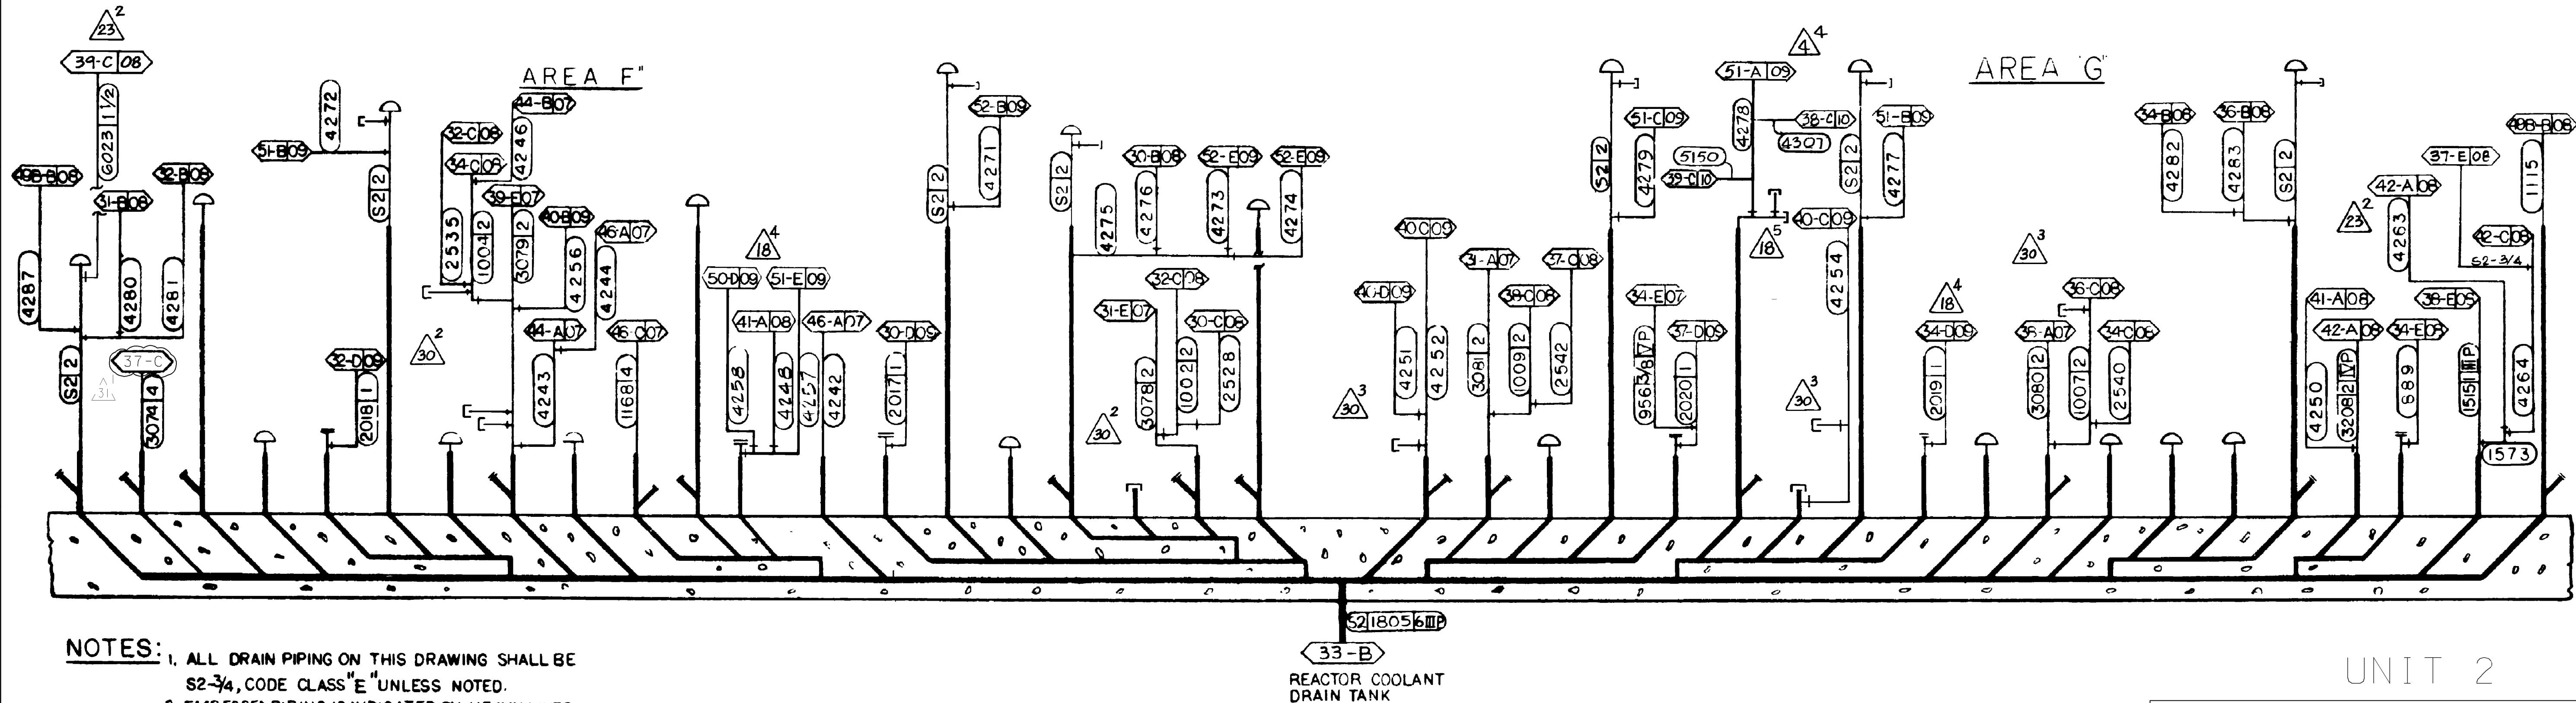

NOTES:
1. ALL DRAIN PIPING ON THIS DRAWING SHALL BE S2-3/4, CODE CLASS "E" UNLESS NOTED.
2. EMBEDDED PIPING IS INDICATED BY HEAVY LINES
REF. DWG. No. 501008 & 501009


INSIDE CONTAINMENT
CLOSED DRAIN TO EMBEDDED
PIPING SYSTEM.

UNIT 2

DIABLO CANYON POWER PLANT - PG&E CO.
LIQUID RADWASTE SYSTEM

DRAWING	SHEET	PAGE	REV
108019	3A	0	31

06-02-2010	GN07	Fxc2		KERSI J. DALAL	MECHANICAL	M 16690	3/31/2012	REVISED PER DFT-7*808
DATE	DWN	RE	IV	PROFESSIONAL ENGINEER	PE DISC.	PE#	PE EXP.	

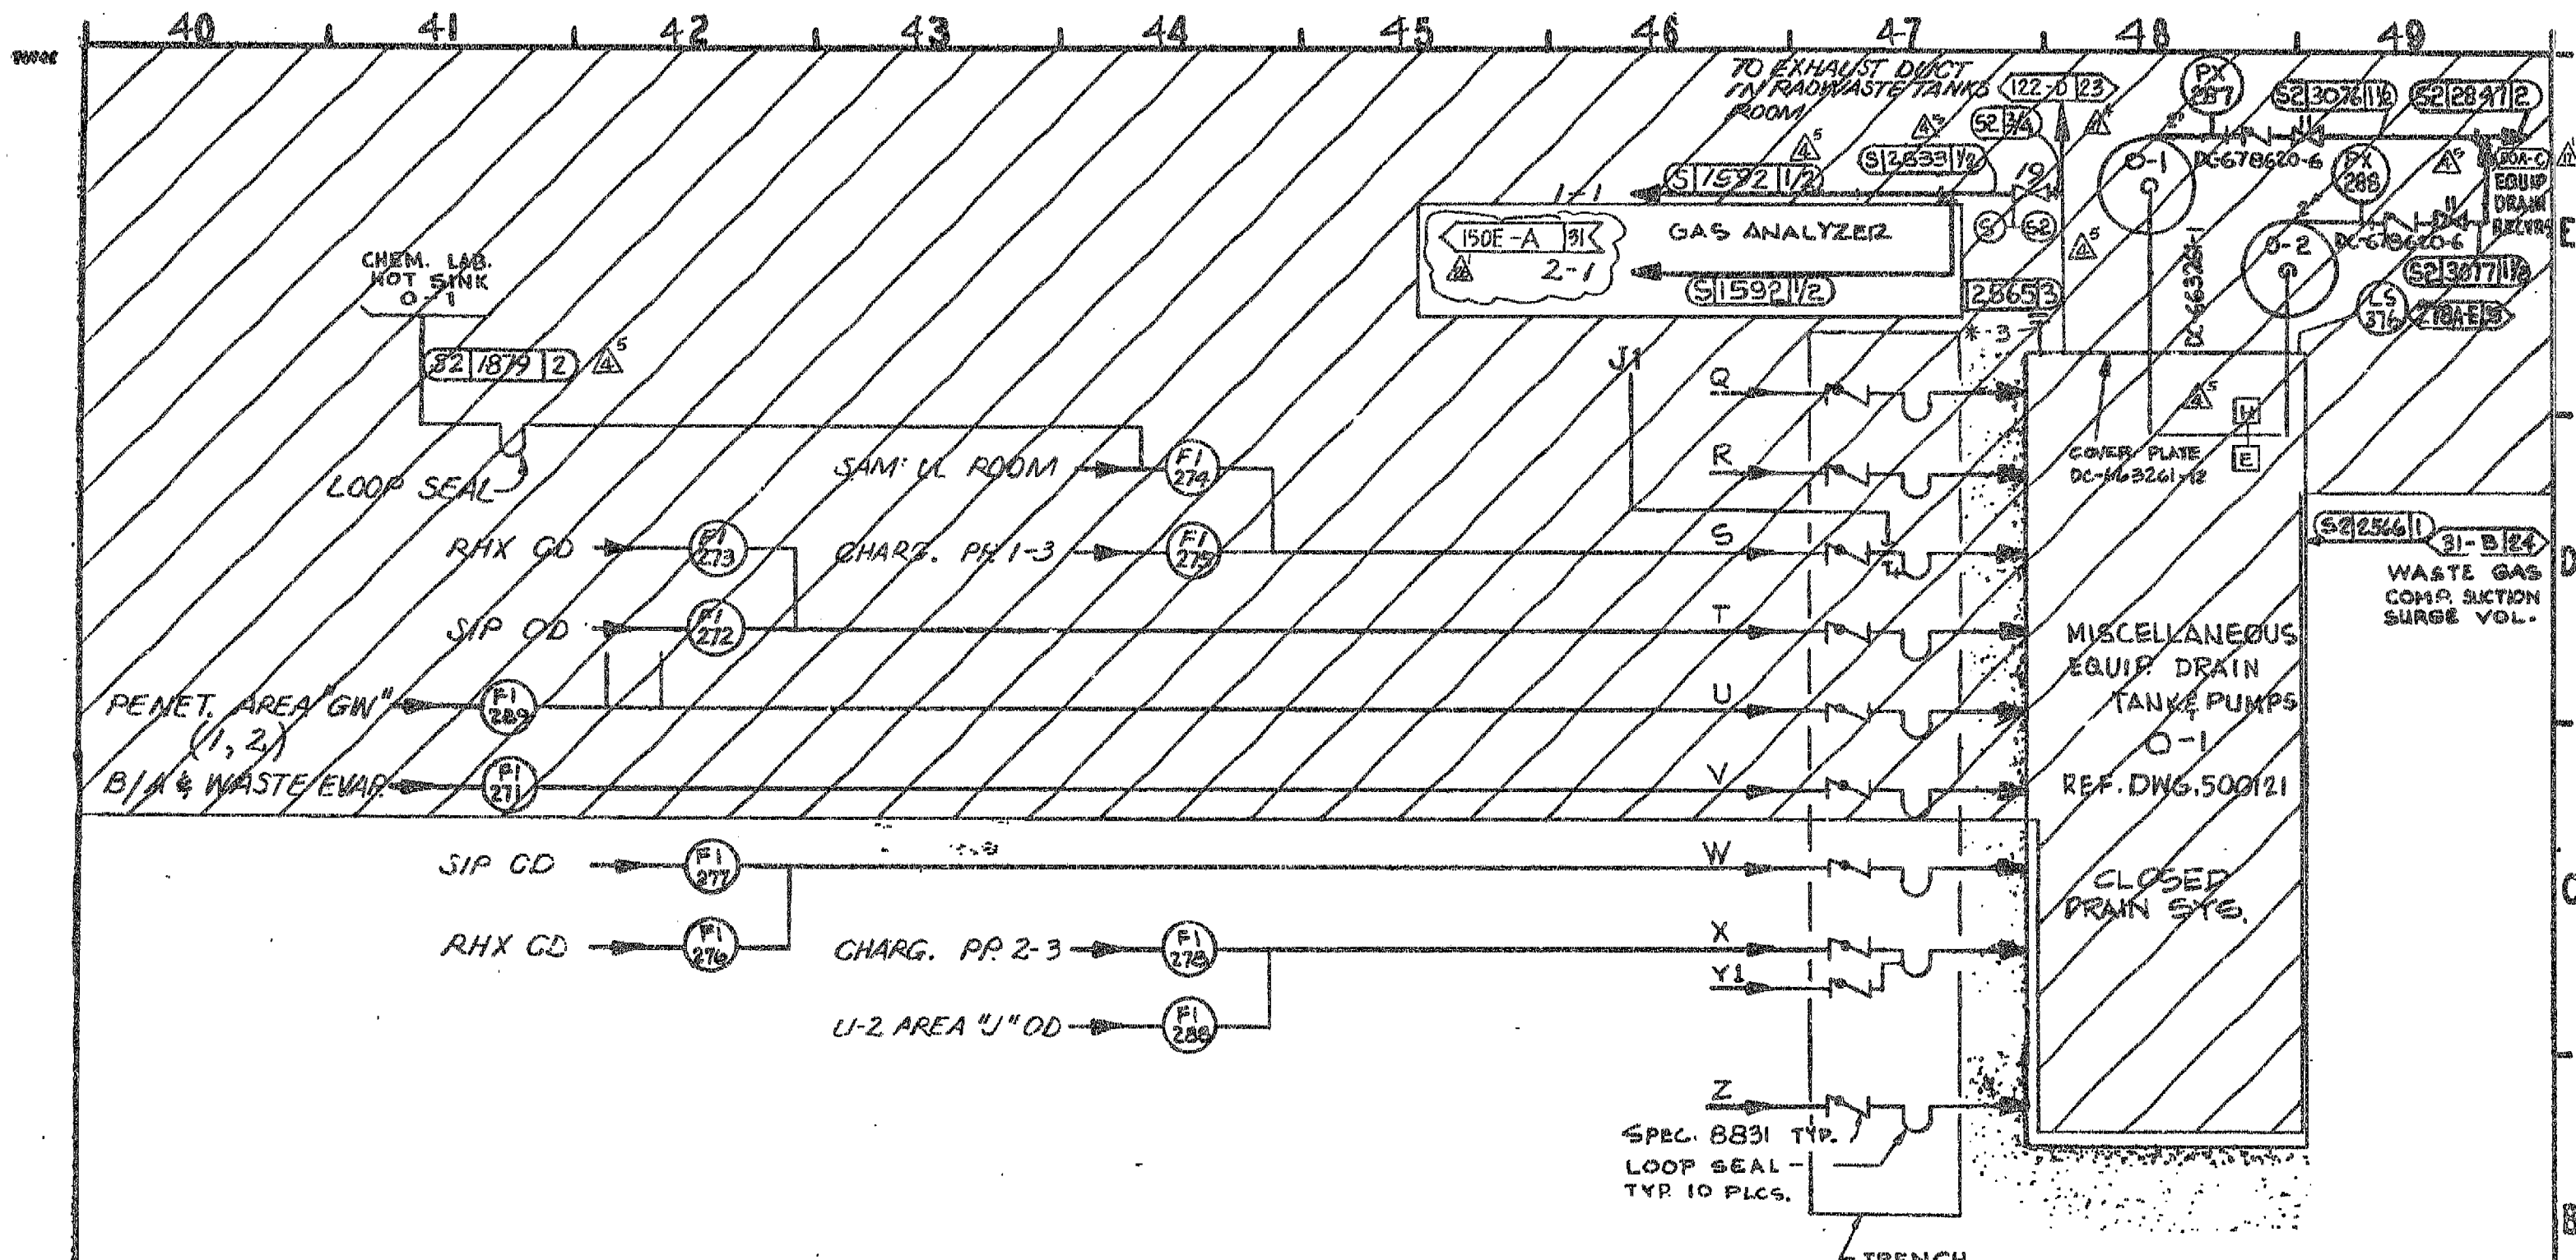

NOTES


1. VALVES WITH ITEM NOS. Δ^5 ARE SPECIFIED ON SPEC. 0722 UNLESS OTHERWISE NOTED.
2. FOR DRAIN COLLECTION PIPING TO AND INCLUDING HEADERS P TO Z REFER TO PG&E DRAINAGE AND FIRE FIGHTING DRAWINGS 500121 TO 500132; 500994 TO 500996 & 500998 TO 501005 AND 501012.
3. ALL PIPING ON THIS DRAWING SHALL BE PG&E CODE CLASS "E", EXCEPT AS NOTED.

UNIT - 2

P.G. & E. CO.		DRAWING NUMBER	REVISION
SHEET 4 OF SHEETS		108019	26
		MICROFILM	

THIS DRAWING HAS BEEN REPRODUCED WITHOUT CHANGE FROM ORIGINAL DRAWING
 MANA NO. 1 DATE 2-24-66 APPROVED BLS

UNIT - 26

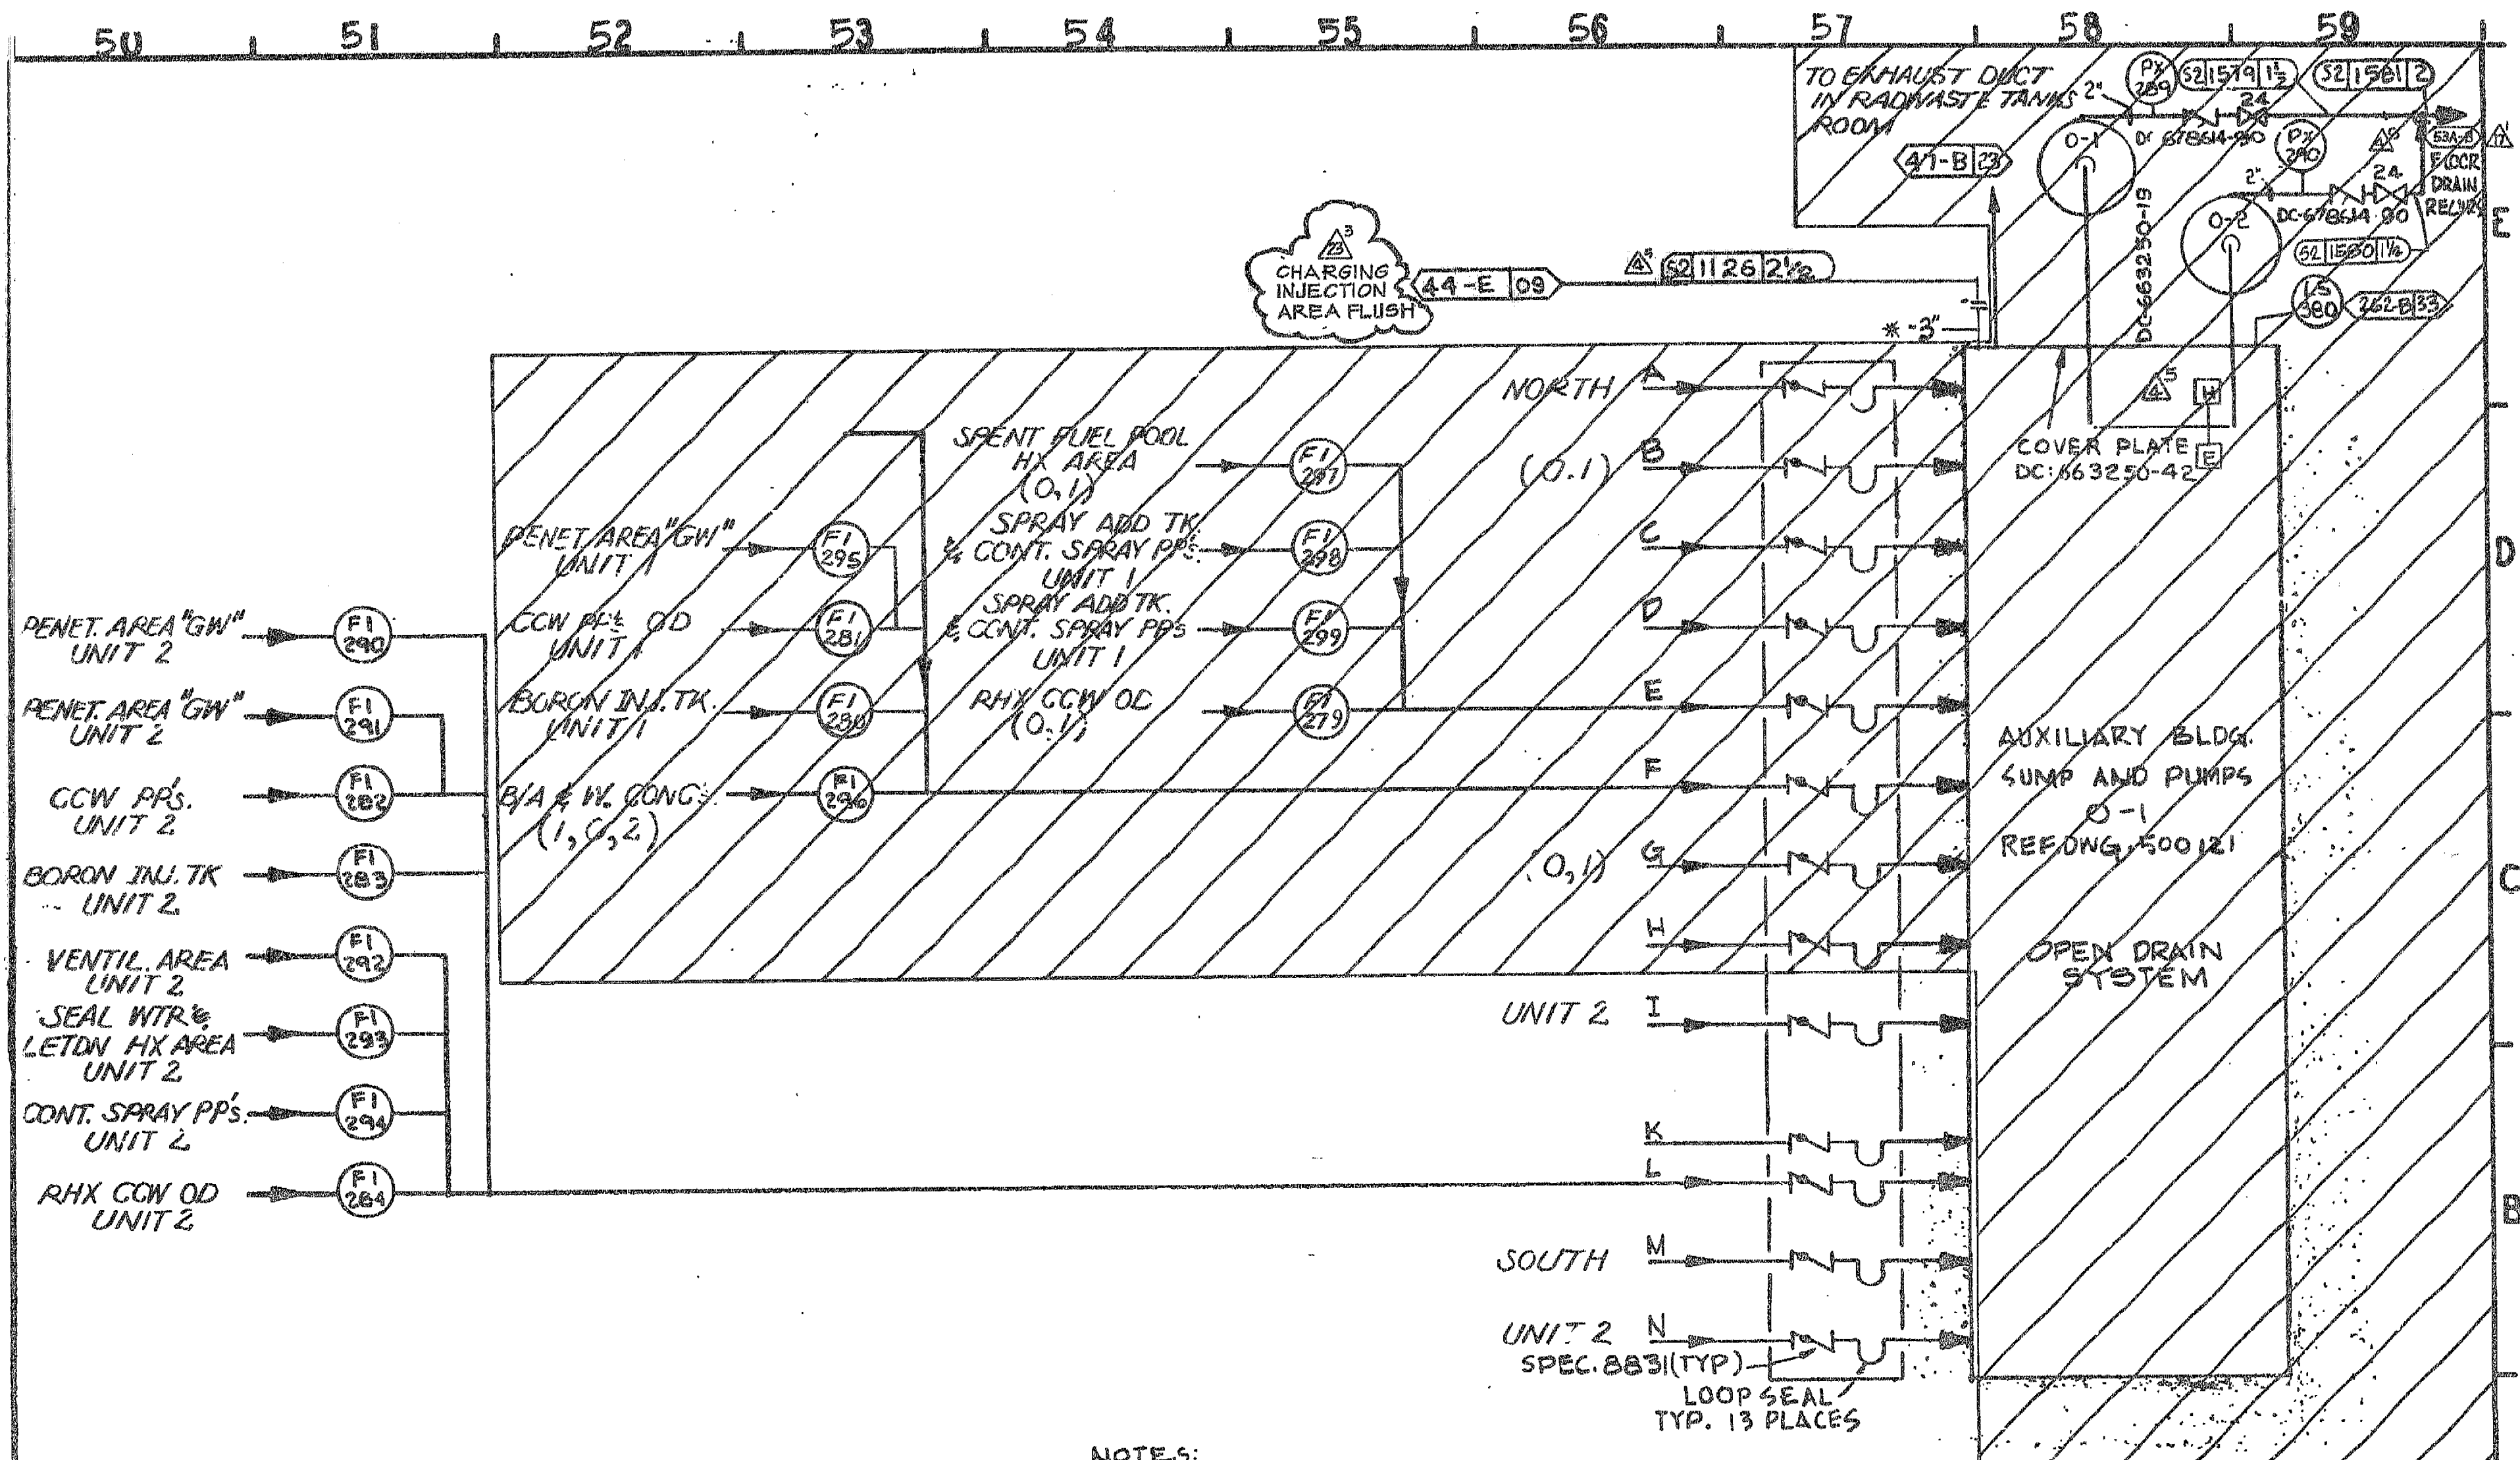

NOTES:

1. VALVES WITH ITEM NOS. Δ ARE SPECIFIED ON SPEC 0722 UNLESS OTHERWISE NOTED
2. FOR DRAIN COLLECTION PIPING TO AND INCLUDING HEADERS A TO N, REFER TO PG & E DRAINAGE AND FIRE FIGHTING DRAWINGS 500121 TO 500132; 500994 TO 500996 AND 500998 TO 501005
3. ALL PIPING ON THIS DRAWING SHALL BE PG & E CODE CLASS 'E' EXCEPT AS NOTED.

UNIT - 2

P.G. & E. CO.

DRAWING NUMBER

108019

REVISION

23

SHEET 5 OF

SHEETS


MICROFILM


23

SCANNED 23

 REPRODUCED FROM ORIGINAL DRAWING
 WITHOUT CHANGE FROM ORIGINAL DRAWING
 CHANGE NO. 1 DATE 10/1/73

INDEXED REV - 23

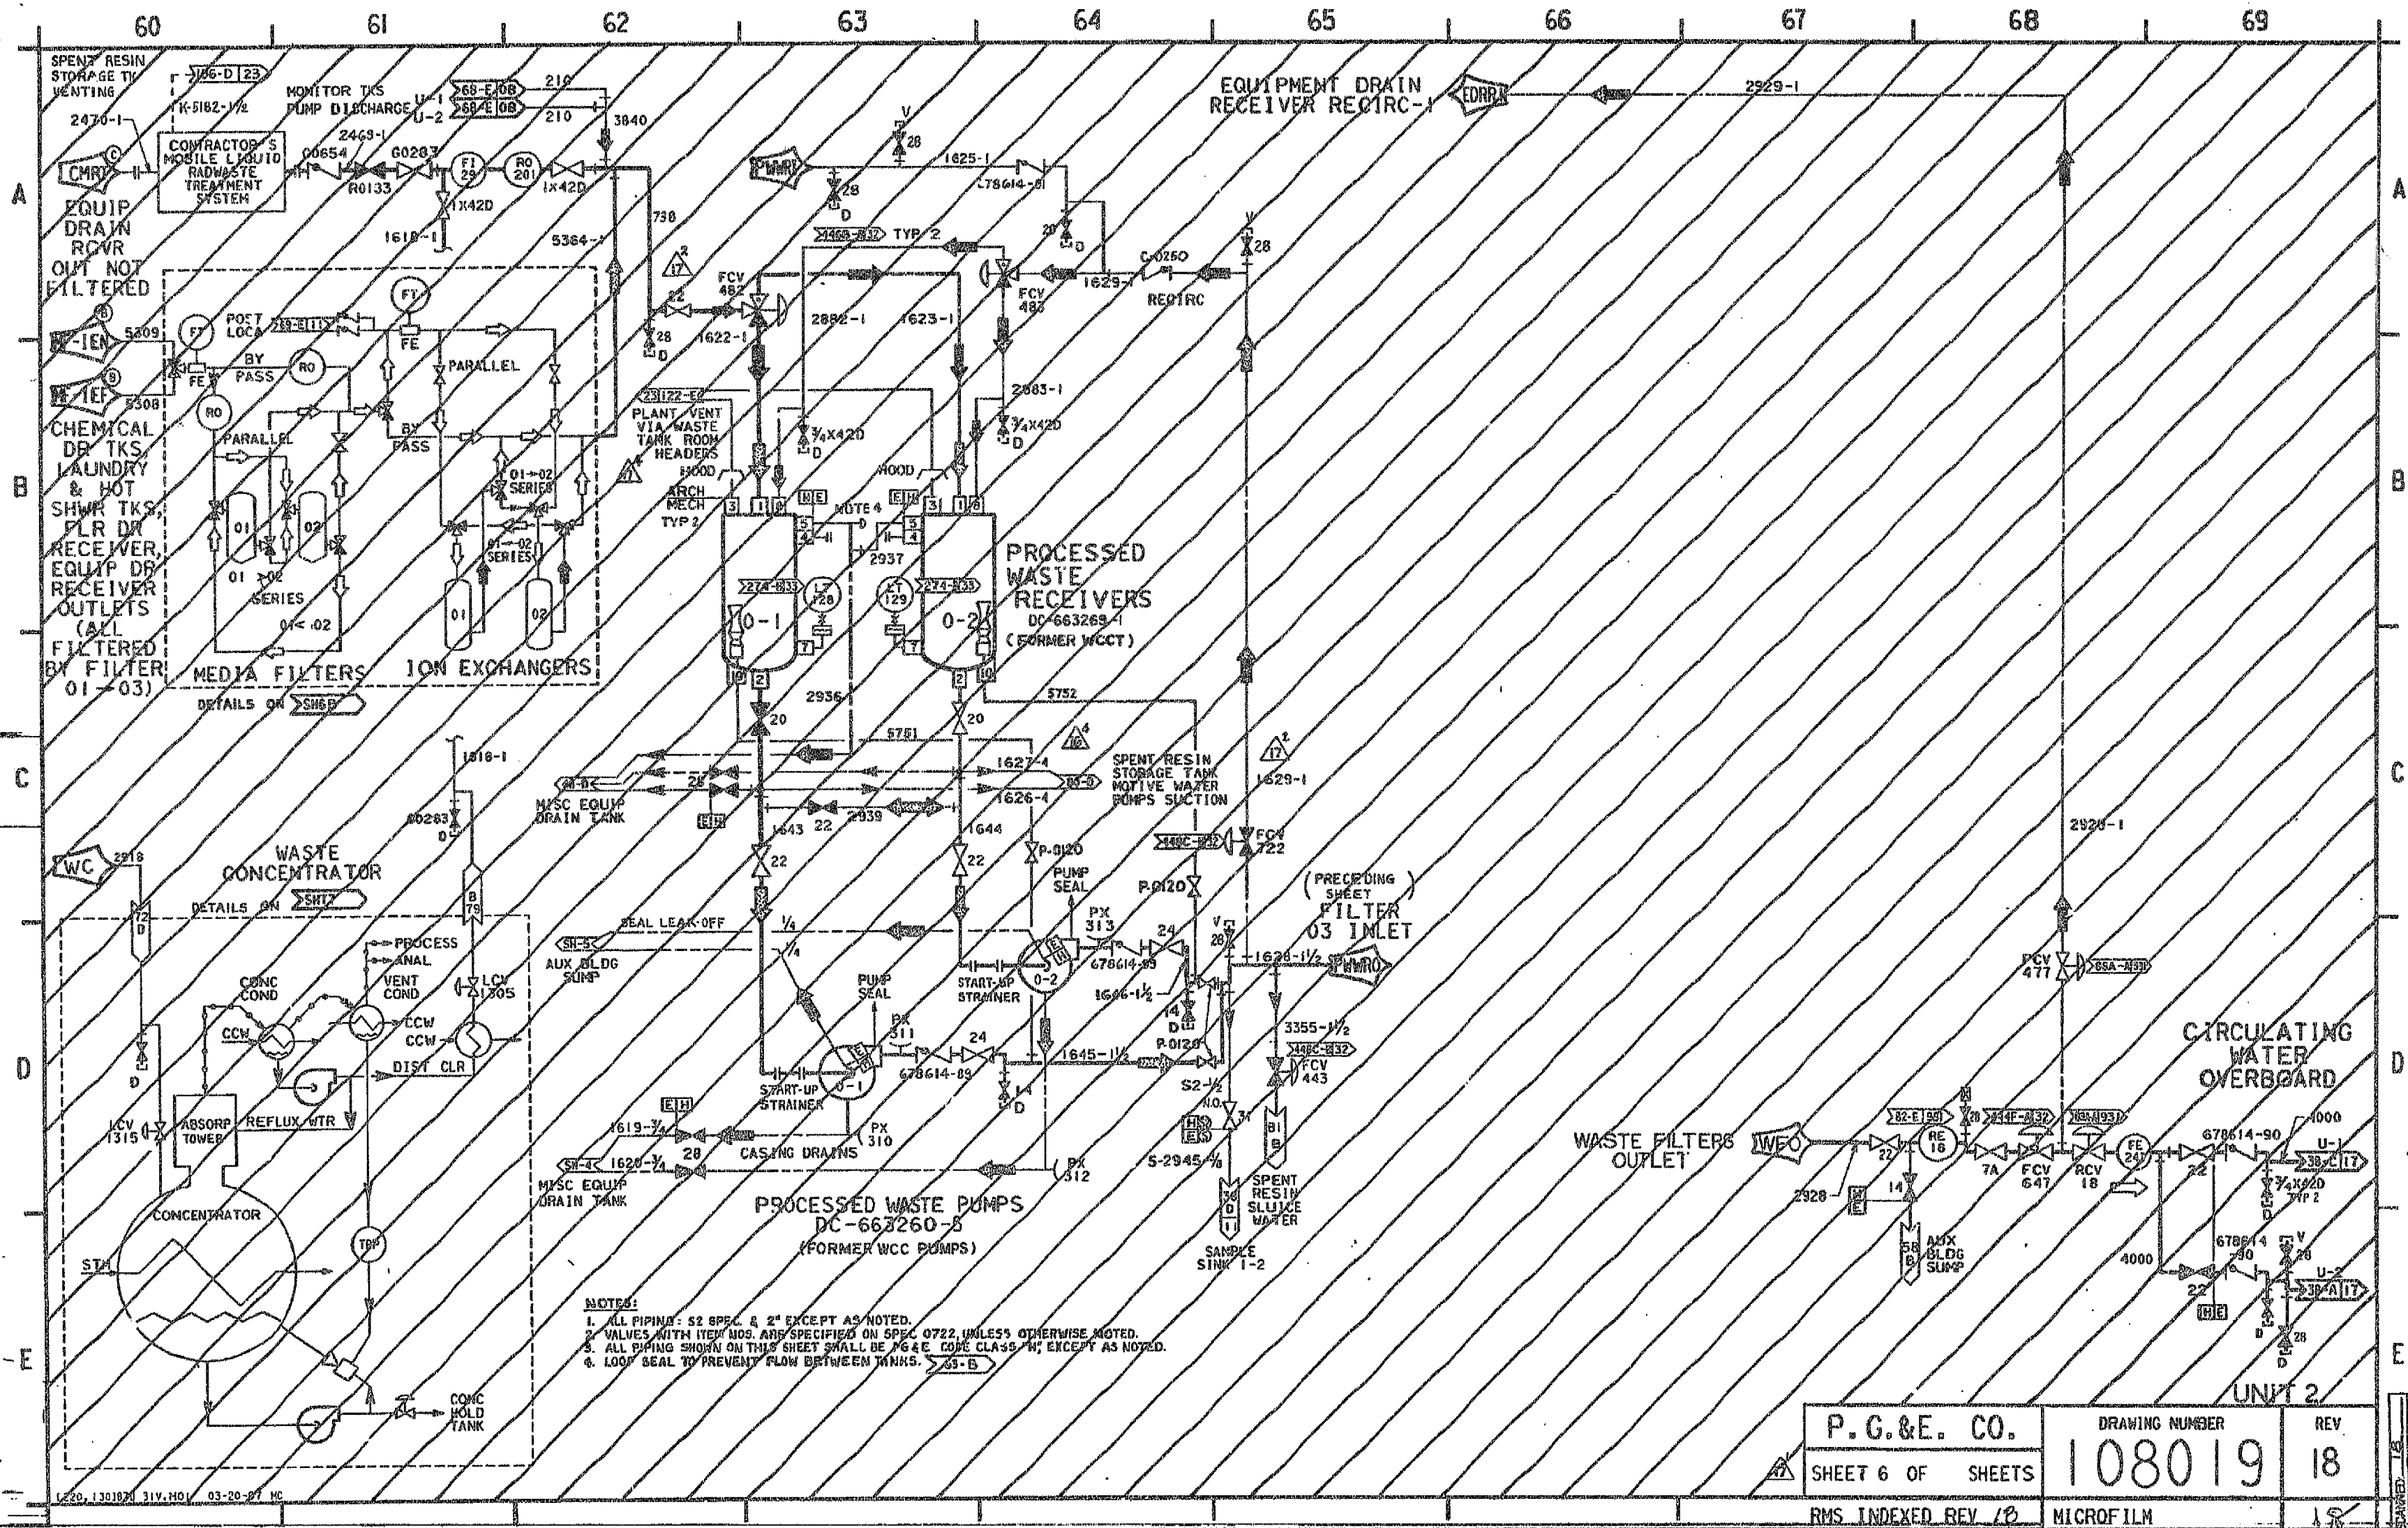

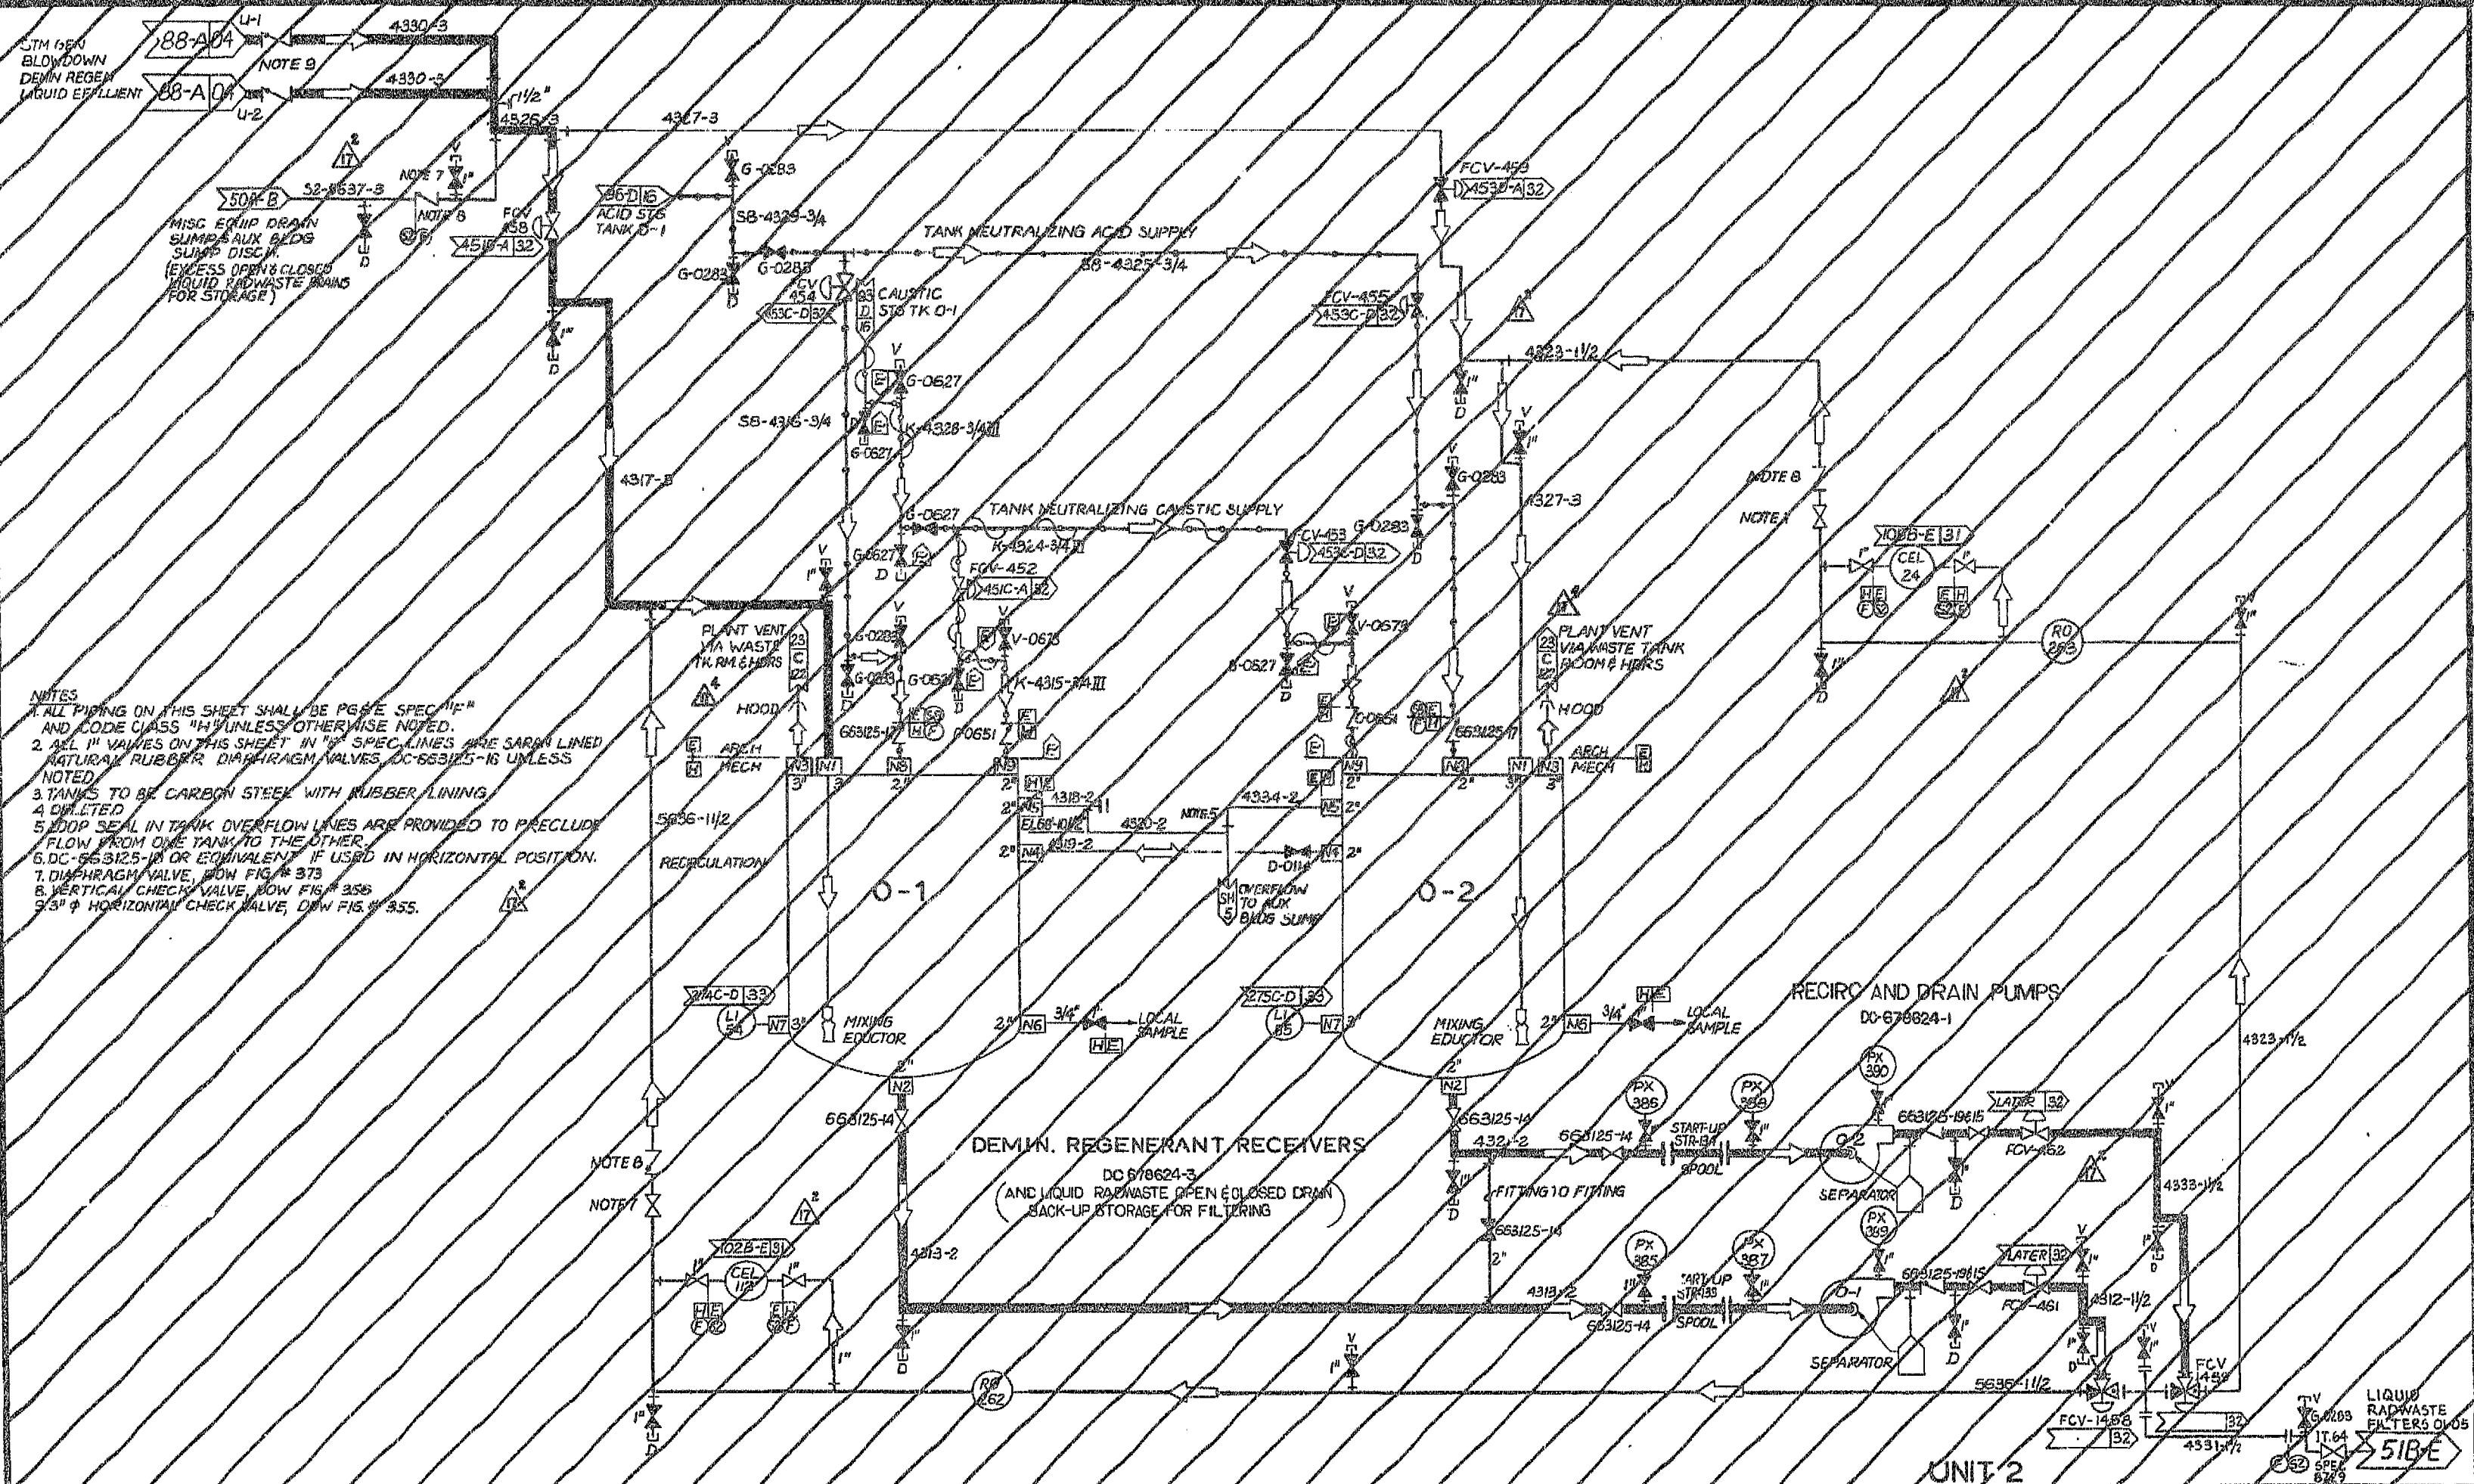

NOTES
1. ALL PIPING ON THIS SHEET SHALL BE PG&E SPEC "F" AND CODE CLASS "H" UNLESS OTHERWISE NOTED.
2. ALL 1" VALVES ON THIS SHEET IN "H" SPEC. LINES ARE SARGO LINED NATURAL RUBBER DIAPHRAGM VALVES, DC-663125-16 UNLESS NOTED.
3. TANKS TO BE CARBON STEEL WITH RUBBER LINING.
4. DETELED
5. DOP SEAL IN TANK OVERFLOW LINES ARE PROVIDED TO PRECLUDE FLOW FROM ONE TANK TO THE OTHER.
6. DC-663125-14 OR EQUIVALENT IF USED IN HORIZONTAL POSITION.
7. DIAPHRAGM VALVE, DOW FIG. # 373
8. VERTICAL CHECK VALVE, DOW FIG. # 356
9. 3" & HORIZONTAL CHECK VALVE, DOW FIG. # 355.

UNIT 2

P. G. & E. CO.		DRAWING NUMBER	REVISION
SHEET 6A OF SHEETS		108019	18
RM 1-DEX REV. 18		MICROFILM	

A

B

C

D

E


A

B

C

D

E

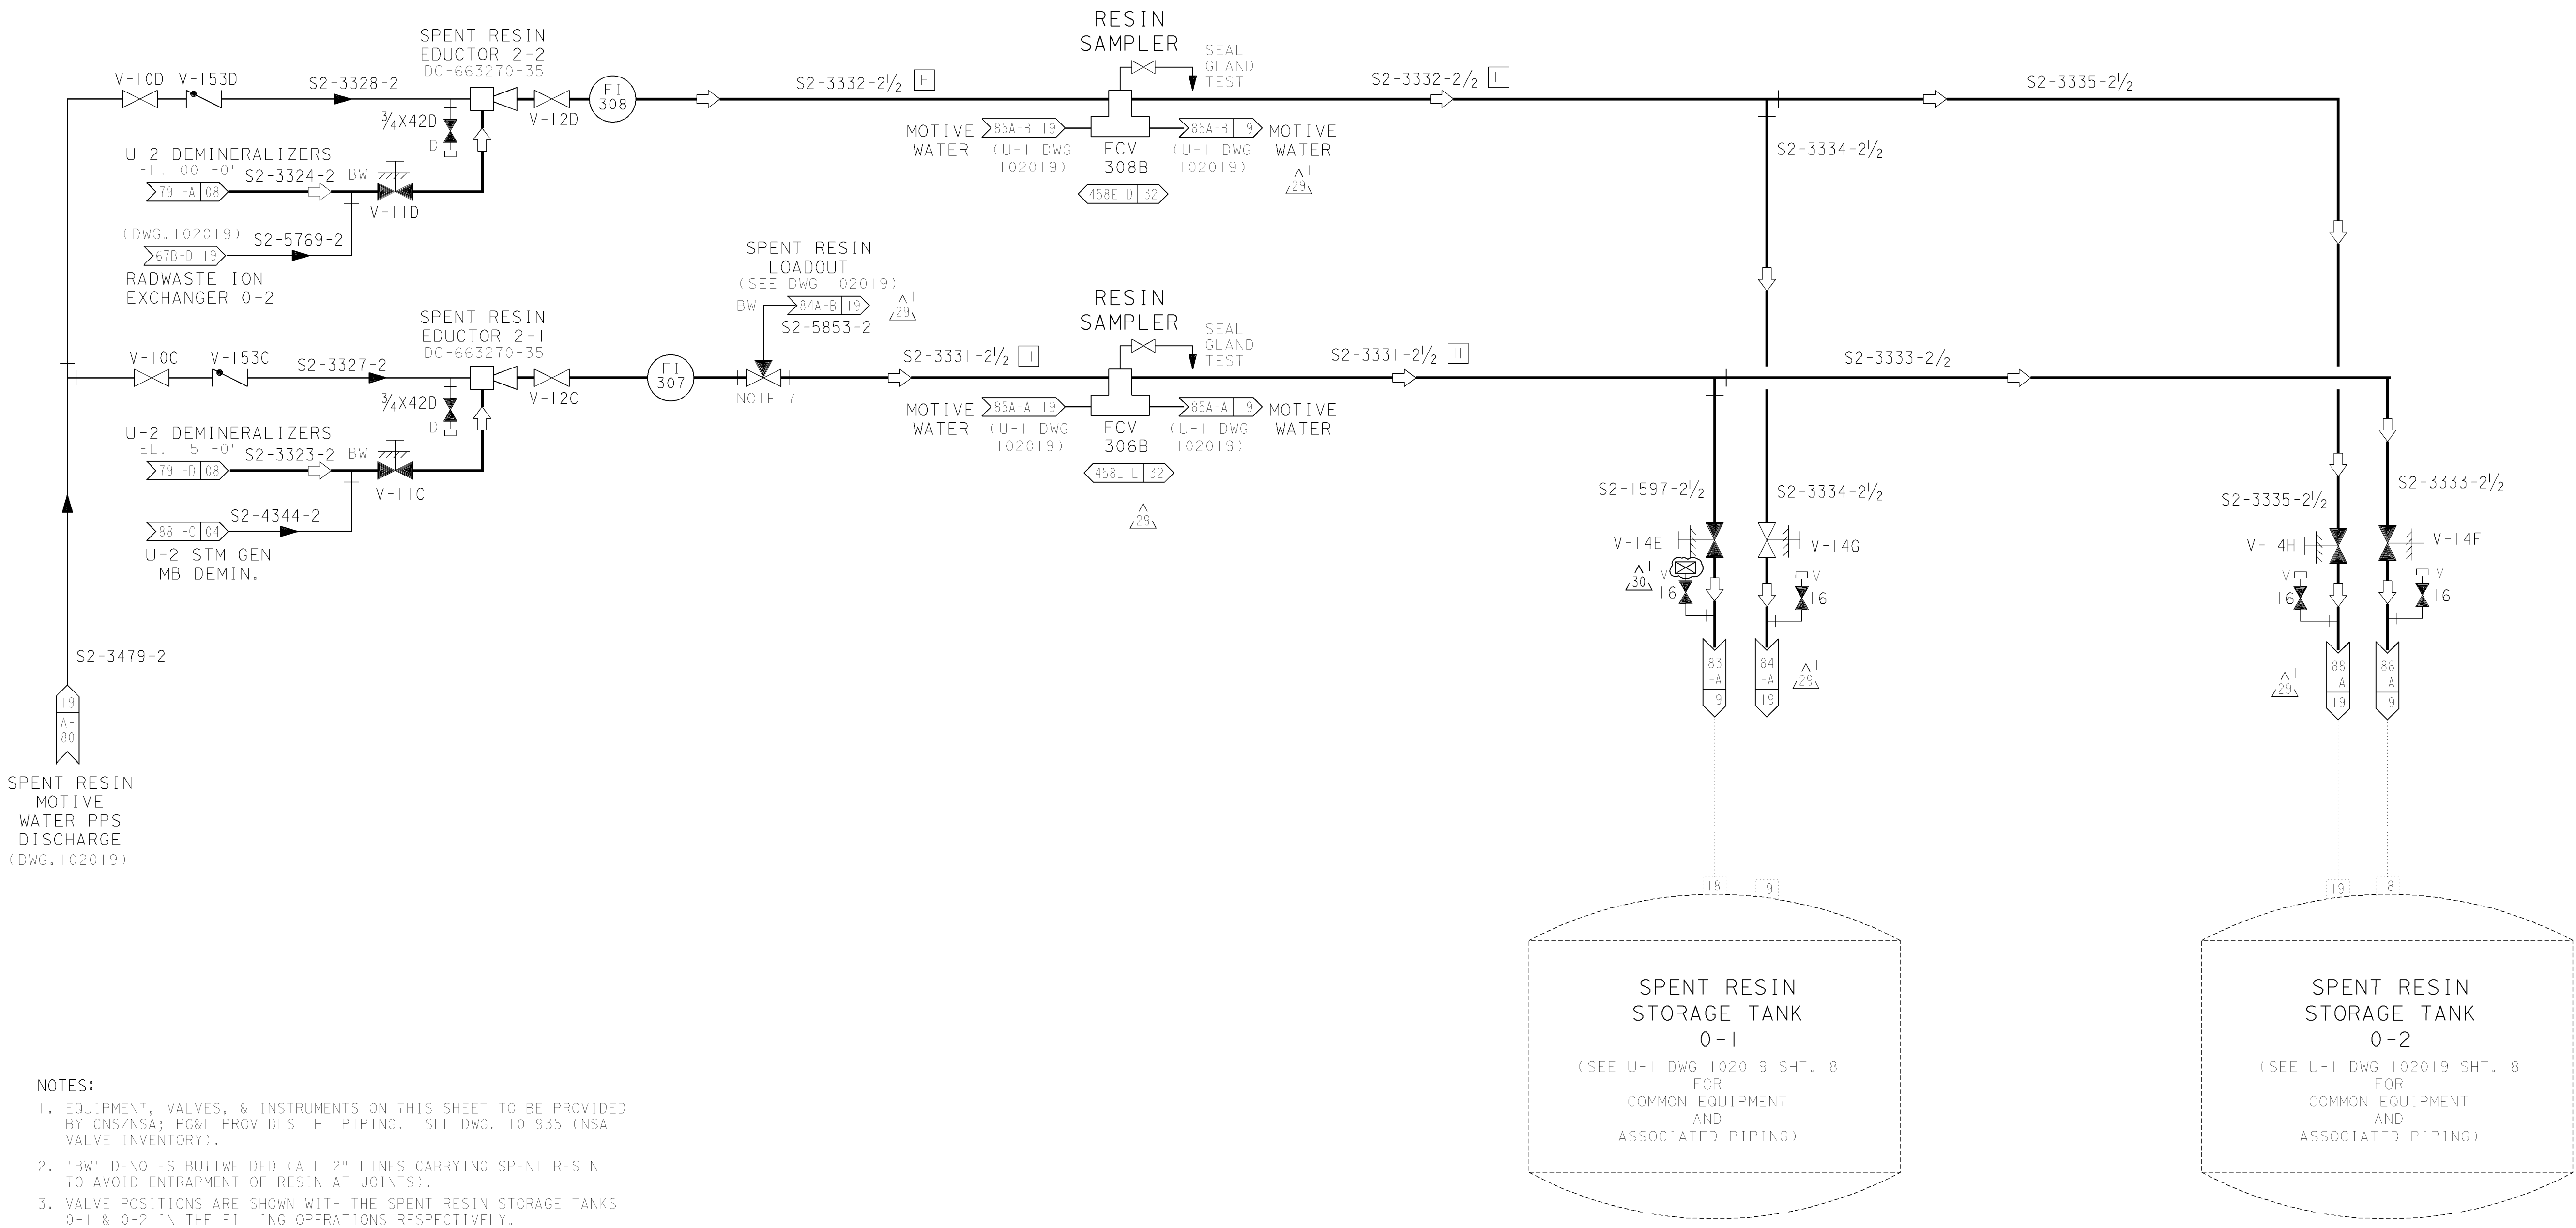

- NOTES:
- 1. EQUIPMENT, VALVES, & INSTRUMENTS ON THIS SHEET TO BE PROVIDED BY CNS/NSA; PG&E PROVIDES THE PIPING. SEE DWG. 101935 (NSA VALVE INVENTORY).
 - 2. 'BW' DENOTES BUTTWELDED (ALL 2" LINES CARRYING SPENT RESIN TO AVOID ENTRAPMENT OF RESIN AT JOINTS).
 - 3. VALVE POSITIONS ARE SHOWN WITH THE SPENT RESIN STORAGE TANKS 0-1 & 0-2 IN THE FILLING OPERATIONS RESPECTIVELY.
 - 4. PG & E VALVES WITH ITEM NUMBERS ARE SPECIFIED ON SPEC. 0722.
 - 5. ALL PIPING ON THIS SHEET SHALL BE PG & E CODE CLASS "H", EXCEPT RESIN SAMPLING SYSTEM, AND AS NOTED.
 - 6. AUTOMATIC RESIN SAMPLE COLLECTION DEVICES (PG & E CODE CLASS "E") ARE LOCATED AT COORDINATES: 84-A/1
 - 7. 2" DIAM. 3-WAY BALL VALVE, BW ENDS, PITTSBURG BRASS MANUFACTURING CO., MODEL NO. MP-H-17BW/2" P0/C0/0E/1S FLOW PATTERN NO.2, 316 SS. 83-B

SPENT RESIN
STORAGE TANK
0-1
(SEE U-1 DWG 102019 SHT. 8
FOR
COMMON EQUIPMENT
AND
ASSOCIATED PIPING)

SPENT RESIN
STORAGE TANK
0-2
(SEE U-1 DWG 102019 SHT. 8
FOR
COMMON EQUIPMENT
AND
ASSOCIATED PIPING)

UNIT 2


P G & E CO.		108019	REV. 30
SHEET 8	PAGE 0		

6/19/03	RHS1	RXG2	-	KERSI J. DALAL	MECHANICAL	M 16690	3/31/2004	Revised per FCT 027618
DATE	DWN	RE	IV	PROFESSIONAL ENGINEER	PE DISC.	PE#	PE EXP.	



CAD User:RHS1 Date: 6-19-2003
DGN:8019S8.DGN

3/19/2010

MAIN TURBINE-GENERATOR BEARING LUBRICATION SYSTEM

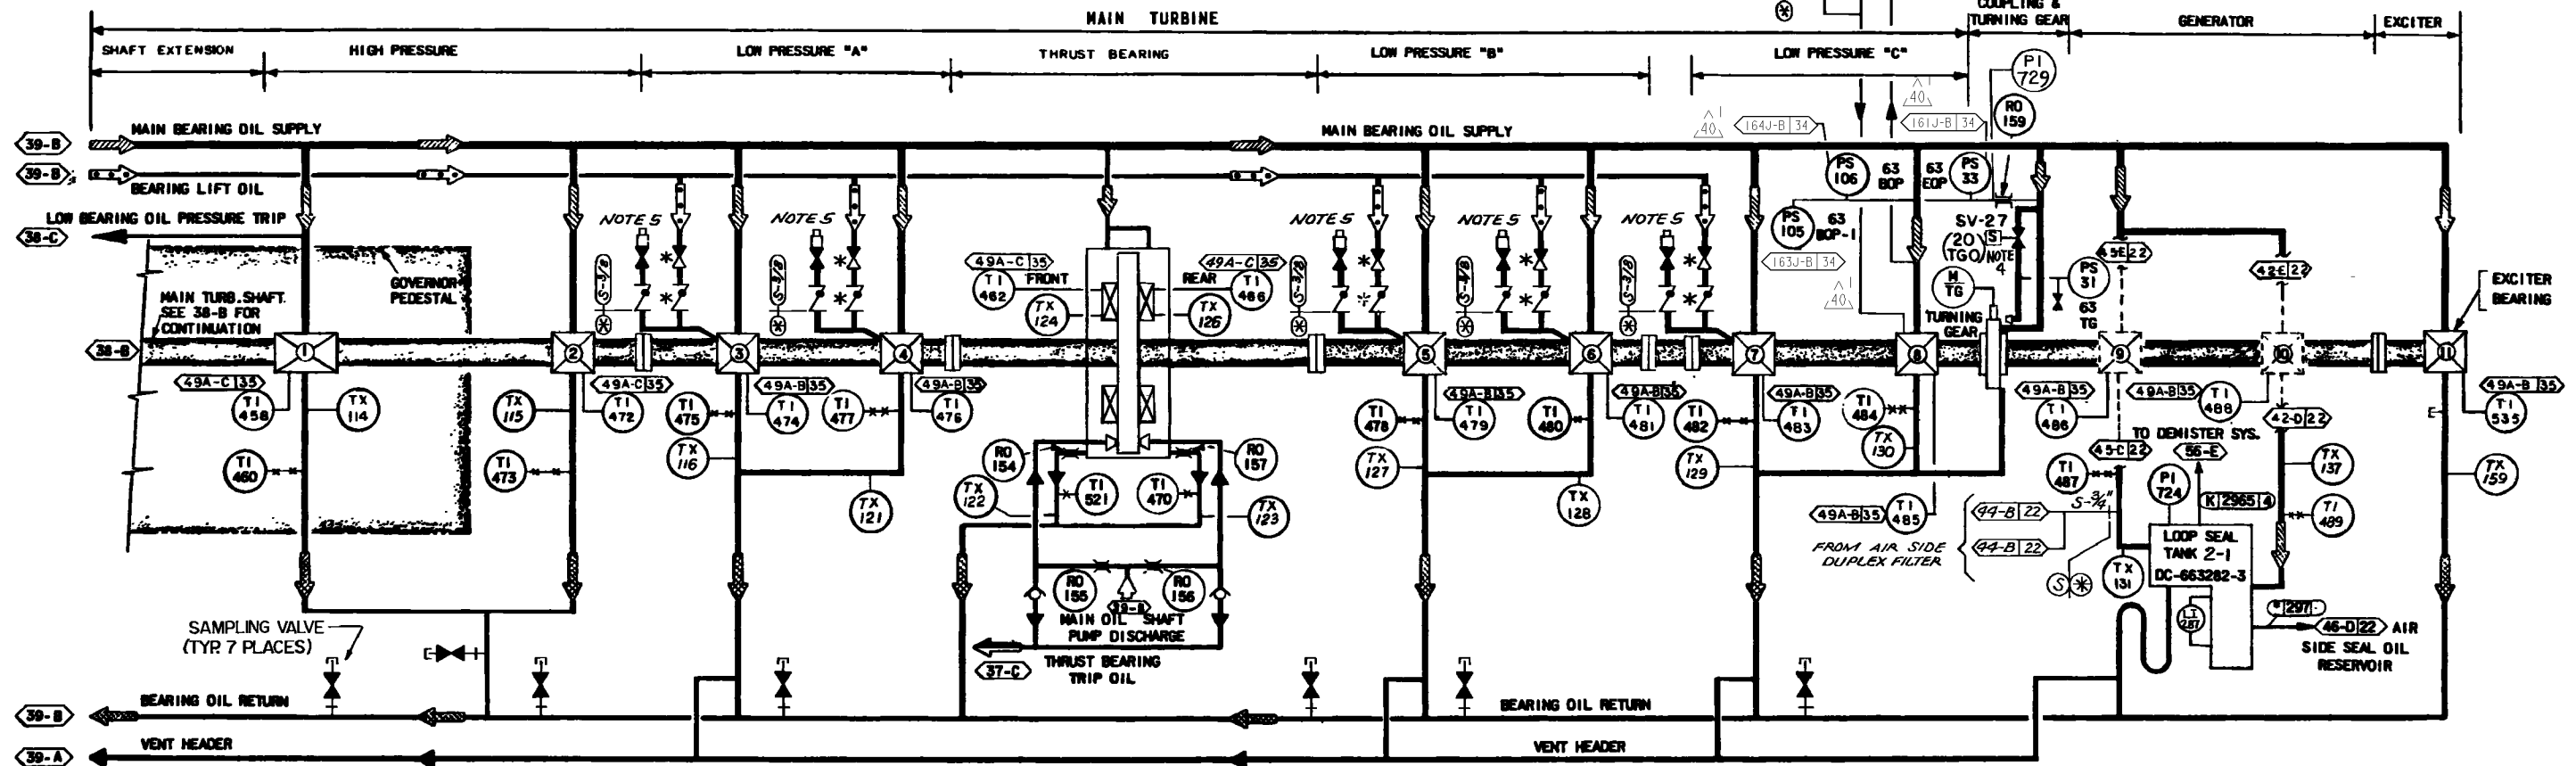

TURBINE SUPERVISORY INSTRUMENTATION

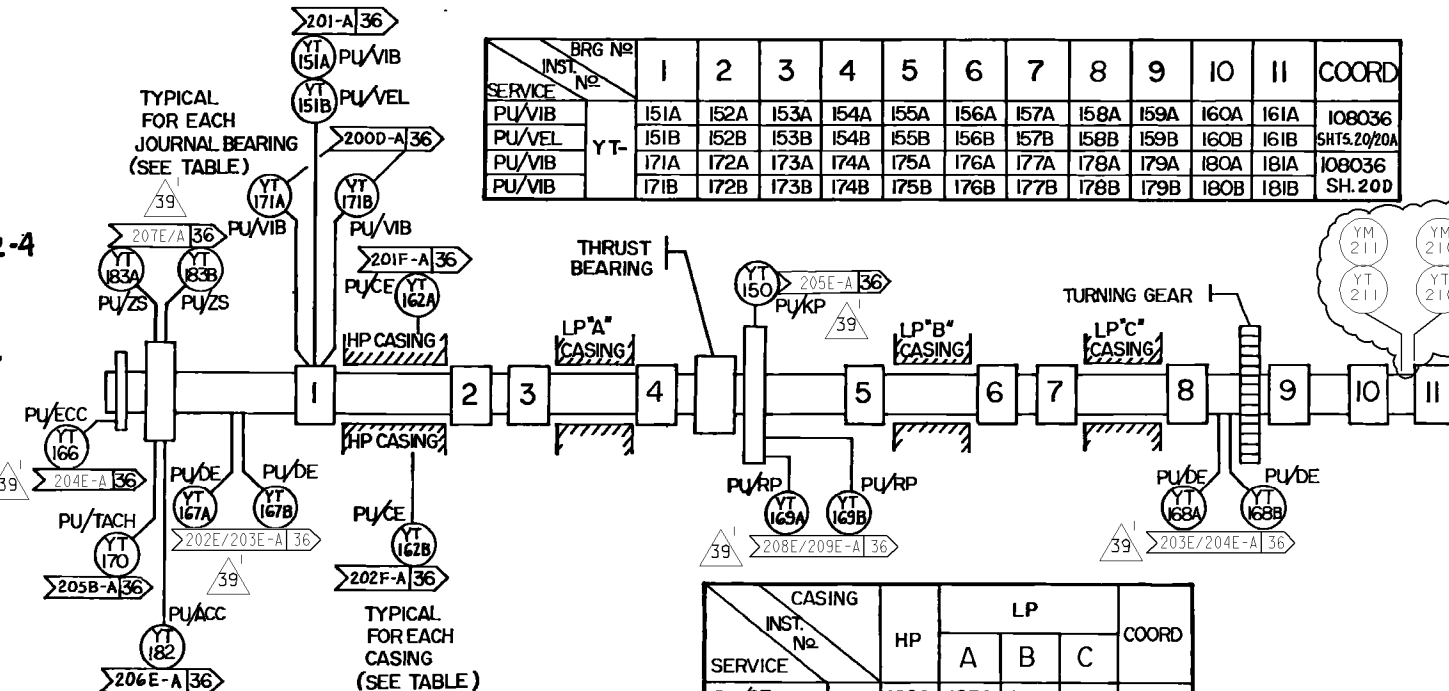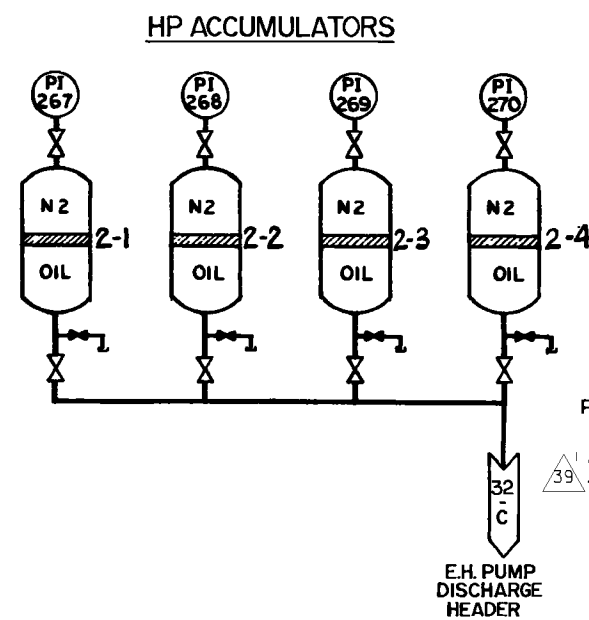


- NOTES:
1. FOR BEARING SEQUENCE SEE DNG. NO. 663280-17 AND WESTINGHOUSE INSTRUCTION BOOK DC-663280-37, TAB 2.
 2. FOR PIPING OIL CLEARANCES & EQUIPMENT LOCATION SEE DC-663282-4
 3. ALL PIPING & INSTRUMENTS BY (B), UNLESS OTHERWISE NOTED.
 4. SOLENOID VALVE WITH MANUAL OPERATOR, C.W. ROTATION FOR MANUAL OPENING, C.C.W. FOR ELECTRIC OPERATION (47-D)
 5. END CONNECTION IS A GREASE FITTING FOR MANUALLY PUMPED LIFT OIL, DC-663282-90 (42/46-D) (46/47-E)

UNIT 2

DIABLO CANYON POWER PLANT - PG&E CO.			
LUBE OIL DISTRIBUTION AND PURIFICATION SYSTEM			
DRAWING	SHEET	PAGE	REV
108020	4	0	41

RASTER=1080204.dgn
DGN=1080204.dgn
CAD User: MIBF Date:05-31-2006

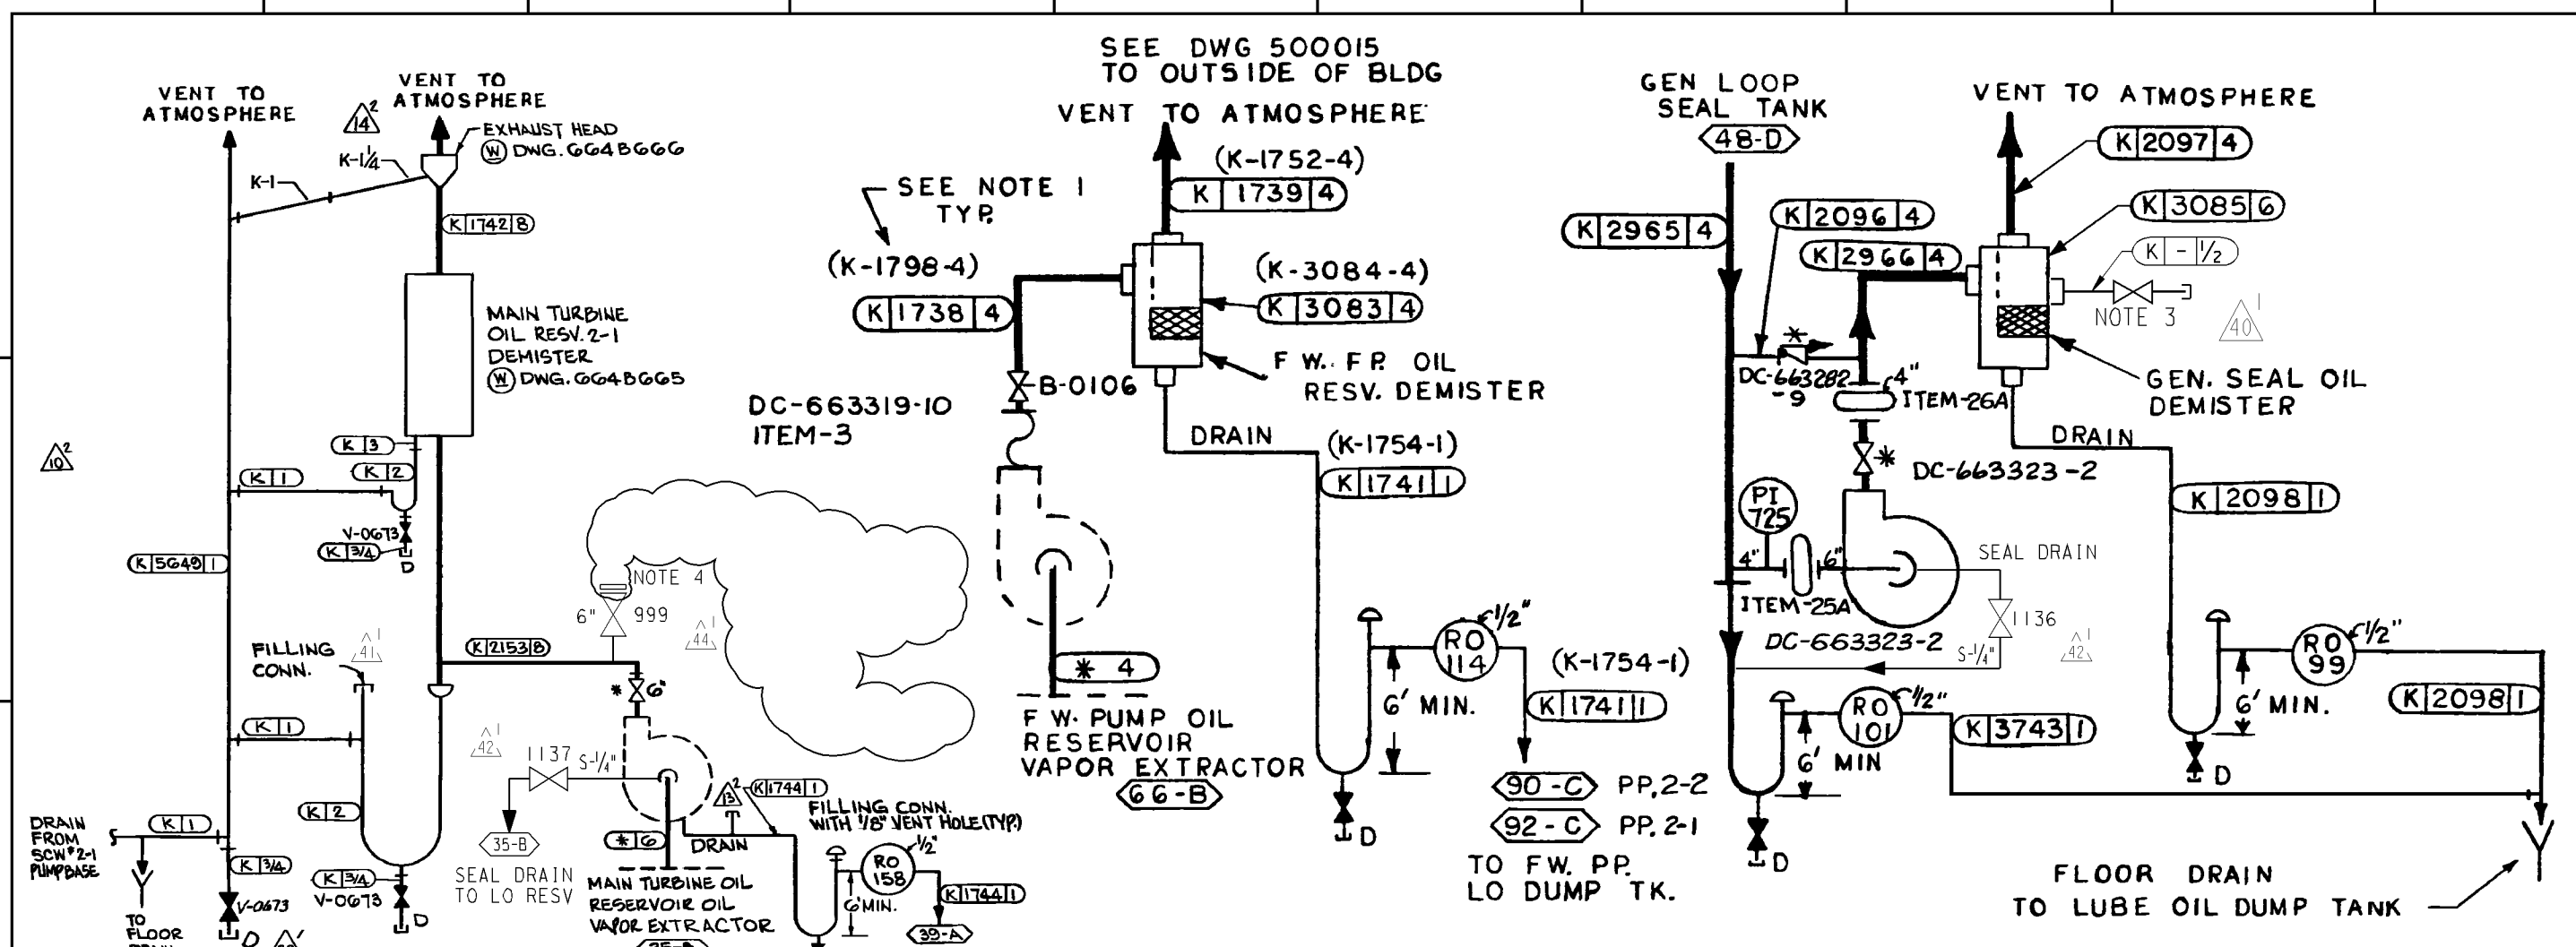

**MAIN TURBINE OIL RESERVOIR
VAPOR EXTRACTOR &
DEMISTER SYSTEM**
DC-663282-1

**FEEDWATER PUMP OIL
RESERVOIR 2-2
VAPOR EXTRACTOR &
DEMISTER SYSTEM**
FOR FEEDWATER PUMP 2-1
REFER TO NOTES 1 AND 2
DC-663300-5
DC-663300-11 TAB-44

**GENERATOR LOOP SEAL OIL TANK
VAPOR EXTRACTOR &
DEMISTER SYSTEM**
DC-663282-3


- NOTES:**
- 1. ALL LINE NUMBERS IN PARENTHESIS ARE FOR FEEDWATER PUMP 2-1 (53-E)
 - 2. INSTRUMENT NUMBERS FOR FW. PP OIL RESV. 2-1 ARE ON SHEET 7 TABLE 4 (54-B)
 - 3. NIBCO BALL VALVE S/C 78-1246, DWG. #6611479-402.
 - 4. TEMPORARY VAPOR EXTRACTOR CONNECTION (DISCHARGE)

UNIT 2

DIABLO CANYON POWER PLANT - PG&E CO. LUBE OIL DISTRIBUTION AND PURIFICATION SYSTEMS			
DRAWING	SHEET	PAGE	REV
108020	5	0	44

RASTER=108020s5.dgn
DGN=108020s5.dgn
CAD User: AJFJ Date: 08-12-2009

08-12-2009	AJFJ	FxC2		KERSI J. DALAL	MECHANICAL	M 16690	3/31/2010	REVISED PER DDT-4*298
DATE	DWN	RE	IV	PROFESSIONAL ENGINEER	PE DISC.	PE#	PE EXP.	

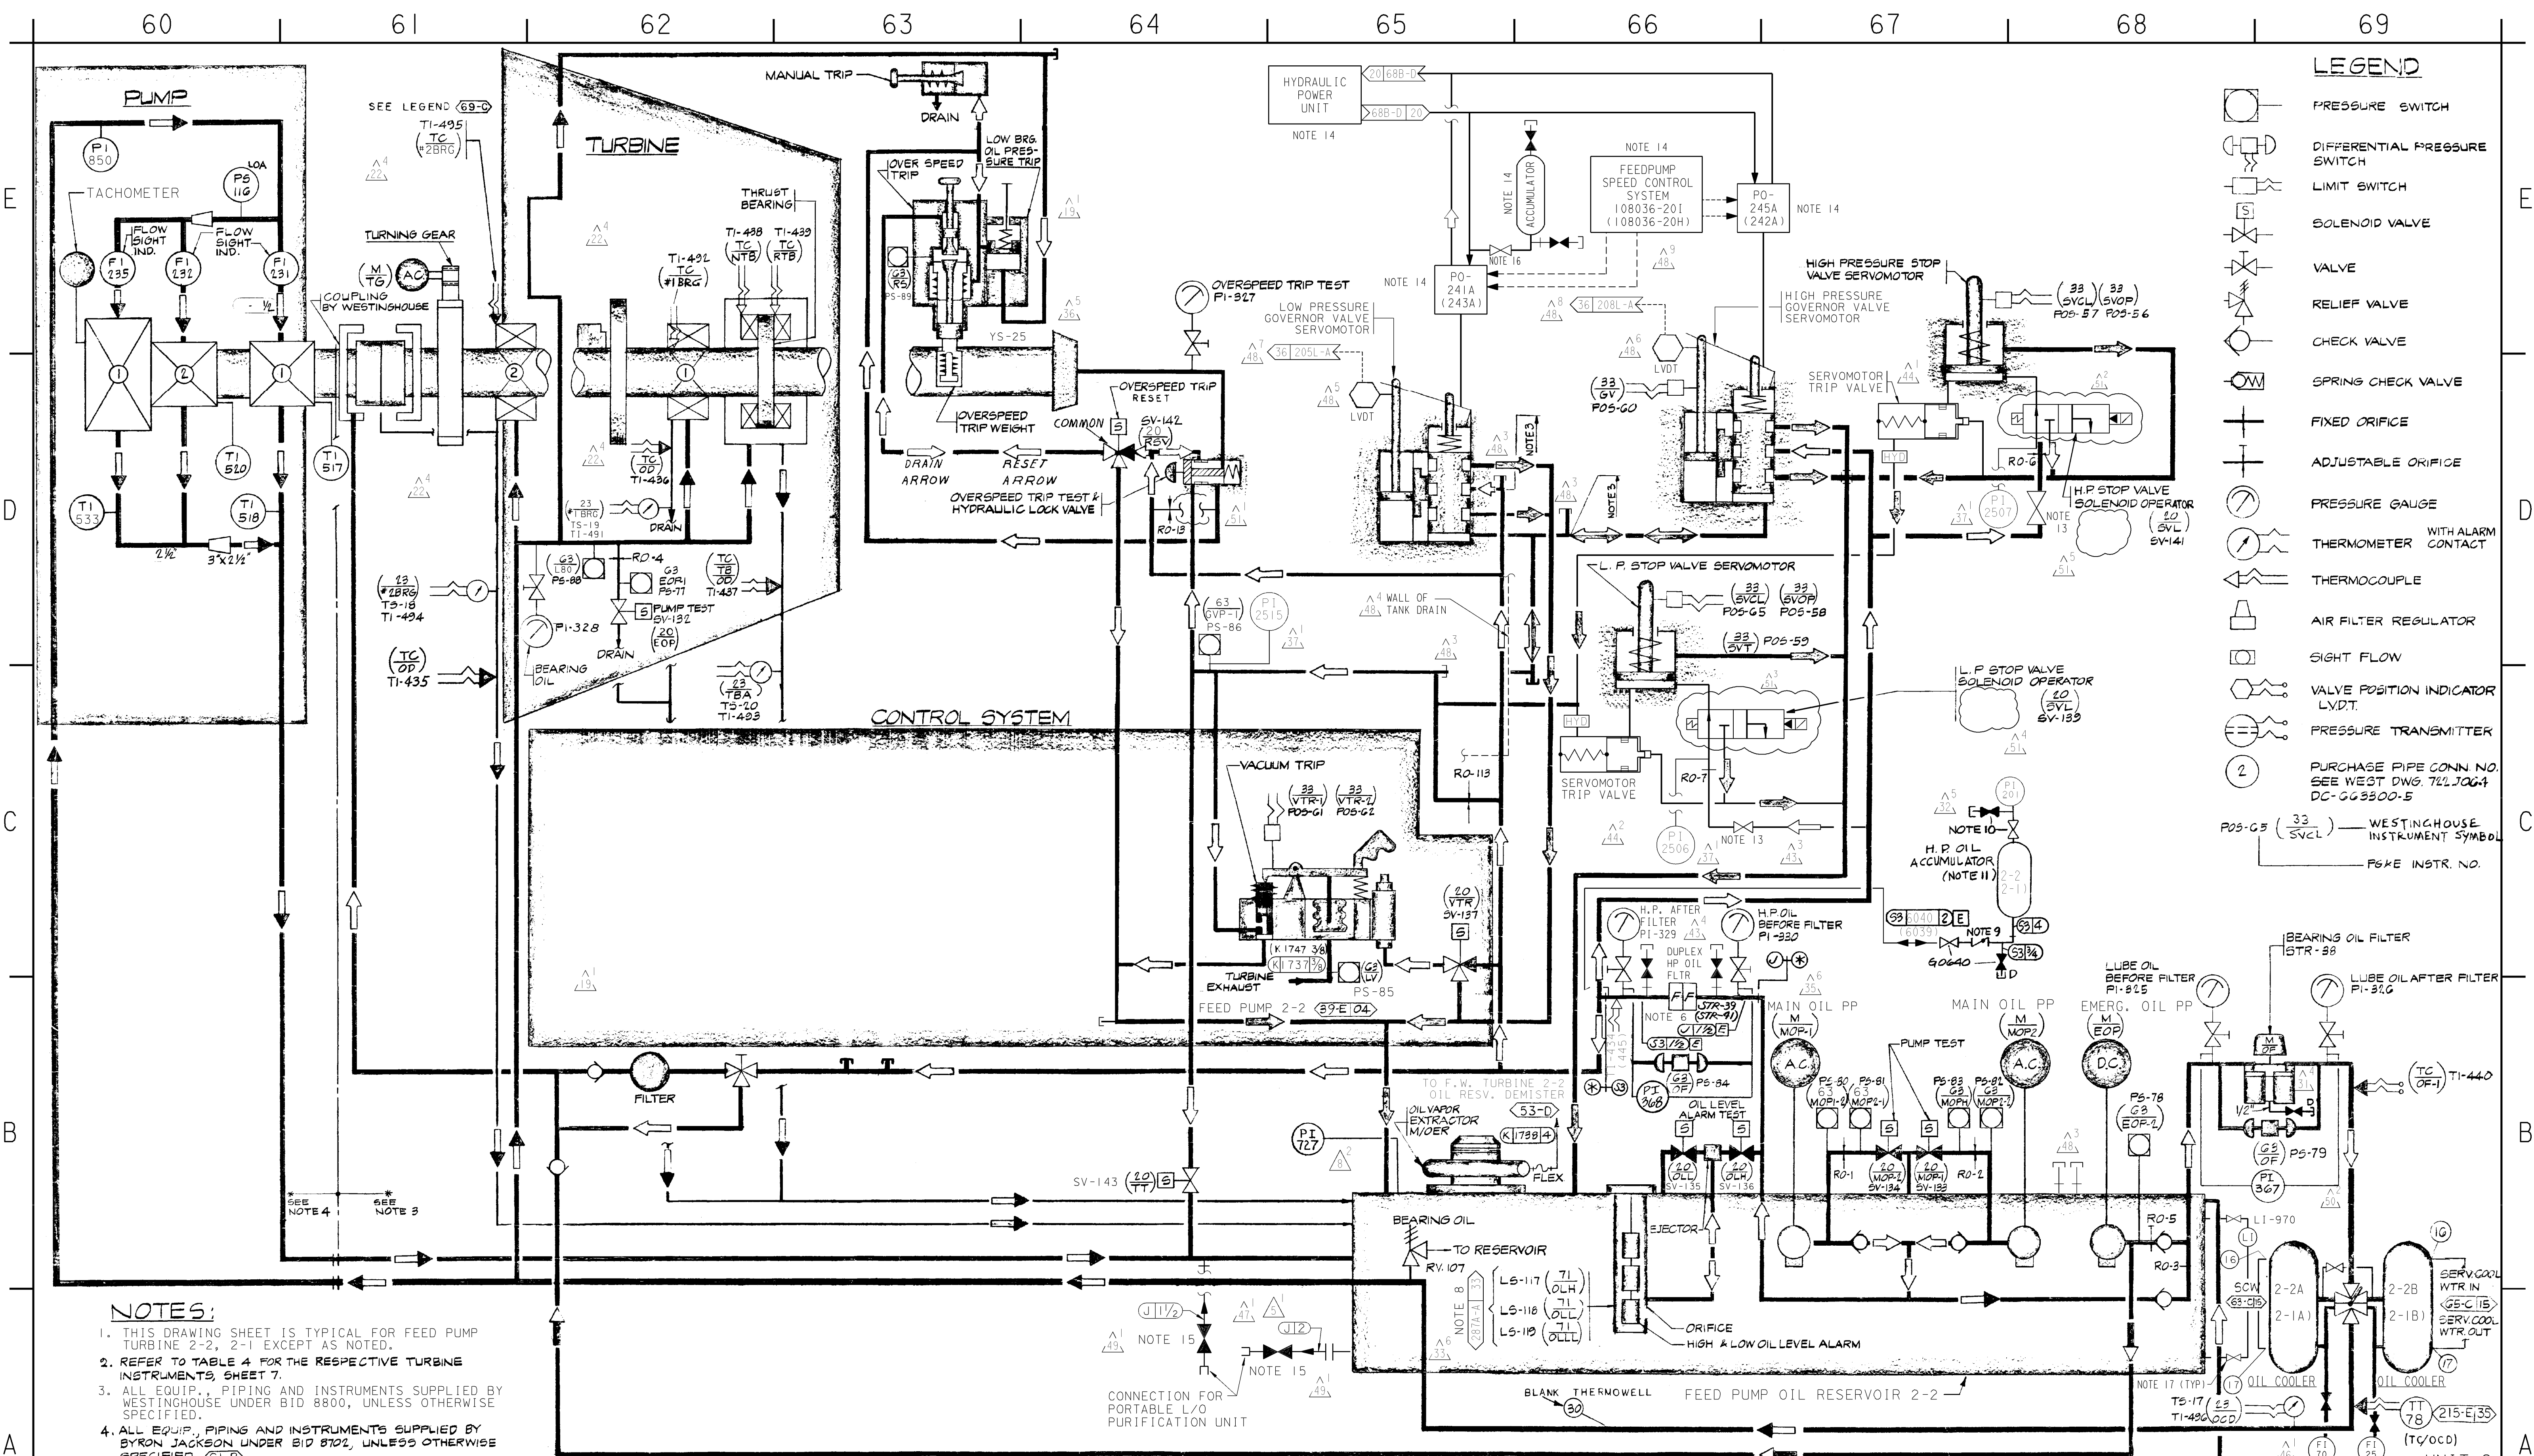

DESCRIPTIONS				PG & INSTR		108020 COORD	(W) DEV. NO.
				FWP 2-2	FWP 2-1		
LINE BEARING		DRAIN OIL	NO 1	TI-436	TI-447	62-D	TC/OD
		METAL		TI-491	TI-497	62-D	23/1BRG
				TS-19	TS-28	62-E	23/1BRG
				TI-492	TI-498	63-E	TC/1 BRG
THRUST BEARING	NORMAL DIRECTION REVERSE DIRECTION	METAL	NO 1	T2345A	T2352A	63-E	TC/NTB
				TI-438	TI-449	63-E	TC/NTB
				T2347A	T2354A	63-F	TC/RTB
				TI-439	TI-536	63-D	TC/TB/OD
LINE BEARING		DRAIN OIL	NO 2	T2348A	T2355A	63-D	23/TBA
		METAL		TI-437	TI-448	63-D	23/TBA
				TS-20	TS-33	61-E	TC/OD
				TI-435	TI-500	61-D	23/2BRG
LUBE OIL COOLERS	INLET	BEFORE AFTER	NO 1	TS-18	TS-34	61-D	23/2BRG
				TI-495	TI-501	61-E	TC/2 BRG
				T2346A	T2353A	69-B	FILTER
				PI-325	PI-331	68-B	63/OF
BEARING OIL SUPPLY	OUTLET		NO 1	PI-326	PI-332	69-B	-
				TI-440	TI-443	69-B	TC/OF-1
				TI-496	TI-502	69-A	23/ODD
				TS-17	TS-36	69-A	23/ODD
MAIN OIL PUMP	NO 1	START & TEST RUNNING	NO 2	TT-78	TT-79	69-A	TC/ODD
				RV-107	RV-108	65-A	-
				PI-328	PI-334	62-D	-
				PS-88	PS-101	62-D	63/LBO
HYDRAULIC POWER UNIT (HPU)	NO 1	START & TEST RUNNING	NO 2	FI-70	FI-21	69-A	-
				FI-25	FI-22	69-A	-
				RO-1	RO-14	67-B	-
				PS-83	PS-96	67-B	63/MP01-1
HYDRAULIC POWER UNIT (HPU)	NO 2	START & TEST RUNNING	NO 2	SV-133	SV-148	67-B	20/MOP-1
				PS-80	PS-93	67-B	63/MOP 1-2
				RO-2	RO-15	67-B	-
				PS-81	PS-94	67-B	63/MOP2-1
HYDRAULIC POWER UNIT (HPU)	NO 1	START & TEST RUNNING	NO 2	SV-134	SV-147	67-B	20/MOP 2
				PS-82	PS-95	67-B	63/MOP 2-2
				RO-3	RO-16	68-B	-
				HYDRAULIC POWER UNIT (HPU)	NO 2	START & TEST RUNNING	NO 2
PCV-1562	PCV-1552	648-C	RV-2				
HPU2F1	HPU1F1	658-D	NA				
HPU2F2	HPU1F2	658-C	NA				
HYDRAULIC POWER UNIT (HPU)	NO 1	START & TEST RUNNING	NO 2	TI-1519	TI-1509	658-B	NA
				LI-1519	LI-1509	658-B	NA
				PI-1519	PI-1509	648-E	NA
				TS-1519	TS-1509	618-B	NA
HYDRAULIC POWER UNIT (HPU)	NO 2	START & TEST RUNNING	NO 2	LS-1519	LS-1509	618-B	NA
				PS-1524	PS-1514	658-D	DS-1
				PS-1525	PS-1515	658-C	DS-2
				PS-1520	PS-1510	668-D	PS 3-1, PS 3-2
HYDRAULIC POWER UNIT (HPU)	NO 1	START & TEST RUNNING	NO 2	PS-1522	PS-1512	638-D	PS-1
				PS-1523	PS-1513	638-C	PS-2
				PS-1521A	PS-1511A	678-D	NA
				PS-1521B	PS-1511B	688-D	NA
HYDRAULIC POWER UNIT (HPU)	NO 2	START & TEST RUNNING	NO 2	PS-1521C	PS-1511C	688-D	NA

NOTES:


1. TI-446 IS DOWNSTREAM OF TS-34/TI-500.
IN 2-1 TURBINE IN BOARD BEARING OIL DRAIN LINE.

FEEDWATER PUMP TURBINE DRIVE TABLE 4

DESCRIPTIONS				PG & INSTR NO.		108020	(W)
				FWP 2-2	FWP 2-1	COORD	DEV. NO.
EMERGENCY OIL PUMP	NO 1	START & TEST		PS-77	PS-90	62-D	63/EOP 1
				SV-132	SV-146	62-C	20/EOP
				RO-4	RO-17	62-D	-
				PS-78	PS-91	68-B	63/EOP 2
RESERVOIR OIL LEVEL		RUNNING		RO-5	RO-18	68-B	-
				LS-117	LS-123	66-A	71/OLH
				SV-136	SV-150	67-B	20/OLH
				LS-118	LS-124	66-A	71/OLL
H P OIL SYSTEM		TEST		SV-135	SV-128	66-B	20/OLL
				LS-119	LS-125	66-A	71/OLL
				LI-970	LI-971	68-B	-
				PI-330	PI-347	66-B	-
HIGH PRESSURE SERVOMOTOR		STOP VALVE		PI-329	PI-335	66-B	-
				STR-39	STR-41	66-B	FILTER
				PS-84	PS-97	66-B	63/OF
				PI-368	PI-370	66-B	-
HIGH PRESSURE SERVOMOTOR		GOV V		TI-434	TI-445	66-B	-
				RO-6	RO-19	67-D	-
				POS-56&57	POS-70&71	68-D	33/SVOP&SVCL
				SV-141	SV-155	68-D	20/SVL
FEEDWATER PUMP TABLE 1				PI-2507	PI-2509	68-D	-
				POT-20	POT-22	66-D	DELETED
				POS-60	POS-74	66-D	63/GV
				PO-245A	PO-242A	66-E	33/GV

FEEDWATER PUMP TABLE 1				PG & INSTR NO.		108020	(W)
				FWP 2-2	FWP 2-1	COORD	DEV. NO.
LINE BEARING	DRAIN OIL	NO 1		TI-518	TI-523	61-D	-
				TI-517	TI-522	61-D	-
				T2349A	T2356A	61-D	-
				FI-231	FI-233	61-D	-
THRUST BEARING	METAL	NO 2		TI-520	TI-525	61-D	-
				T2350A	T2357A	61-D	-
				FI-232	FI-234	60-D	-
				TI-533	TI-534	60-D	-
BEARING OIL SUPPLY	OIL SUPPLY	NO. 1		T2351A	T2358A	60-D	-
				FI-235	FI-236	60-D	-
				PI-850	PI-851	60-E	-
				PS-116	PS-119	60-E	-

DESCRIPTION				PG&E INSTR NO		108020	(W) DEV NO	
				FWP 2-2	FWP 2-1	COORD		
PICK-UP	THRUST BRG WEAR			YT-80A	YT-70A	66A-C	PU/VB PU/VB	
				YT-80B	YT-70B	66A-C		
	KEY PHASOR			YT-81	YT-71	69A-B		
	FW TURBINE BRG	NO 1	YT-82A	YT-72A	68A-C			
			YT-82B	YT-72B	68A-C			
		NO 2	YT-83	YT-73	68A-B			
			YT-84A	YT-74A	64A-C			
	FW PUMP BRG	NO 1	YT-84B	YT-74B	64A-C			
			YT-85	YT-75	64A-B			
		NO 2	YT-86A	YT-76A	61A-C			
			YT-86B	YT-76B	61A-C			
	SPEED PICKUP MPU1 ^{Δ2} _{43Δ} SPEED PICKUP MPU2 SPEED PICKUP MPU3	NO 1	YT-87	YT-77	61A-B			
YT-88A			YT-78A	60A-C				
NO 2		YT-88B	YT-78B	60A-C				
		YT-89	YT-79	60A-B				
			YE-1519A	YE-1509A	65A-B			
			YE-1519B	YE-1509B	66A-B			
			YE-1519C	YE-1509C	66A-B			
			YT-20	YT-22	62A-B			
ROTOR BEARING			YT-2014	YT-2012	67A-B			
			YT-2015	YT-2013	63A-B			
ROTOR ECCENTRICITY			—	—	—	—		
^{Δ1} _{43Δ} LOW PRESSURE SERVOMOTOR				PO-241A	PO-243A	65-E	— 63/GV 33/SVOP/SVCL	
				POT-21	POT-23	65-D		
				PO1-21	PO1-23	65-D		
				POS-58&65	POS-72&79	66-D		
LOW PRESSURE SERVOMOTOR				STOP VALVE	POS-59	POS-73	66-D	33/SVT
				SV-139	SV-153	67-C	20/SVL ^{Δ2} _{45Δ}	
				RO-7	RO-20	66-C	—	
				PI-2506	PI-2508	66-C	—	
^{Δ4} _{22Δ}								
PROTECTIVE DEVICE		VACUUM TRIP		POS-61	POS-75	65-C	33/VTR 1	
				POS-62	POS-76	65-C	33/VTR 2	
				PS-85	PS-98	65-B	63/LV	
				SV-137	SV-151	65-C	20/VTR	
				PI-327	PI-333	64-D	—	
				PS-89	PS-102	63-D	63/RS	
				SV-142	SV-156	64-D	20/RSV	
				YS 25	YS-24	64-E	—	
				RO-13	RO-26	64-D	—	
^{Δ4} _{22Δ}								
^{Δ5} _{32Δ} H P OIL ACCUMULATOR				PI-201	PI-200	67-C	^{Δ6} _{19Δ}	
OIL VAPOR EXTRACTION VENT				RO-114	RO-38	55-D	—	
				RO-113	RO-37	65-C	—	
TRIP OIL				PS-86	PS-99	64-C	63/GVP-1	
				SV-143	SV-157	64-B	20/TT	
				PI-2515	PI-2516	65-D	—	
L.O. VAPOR EXTRACTOR VAC				PI-727	PI-726	65-B		

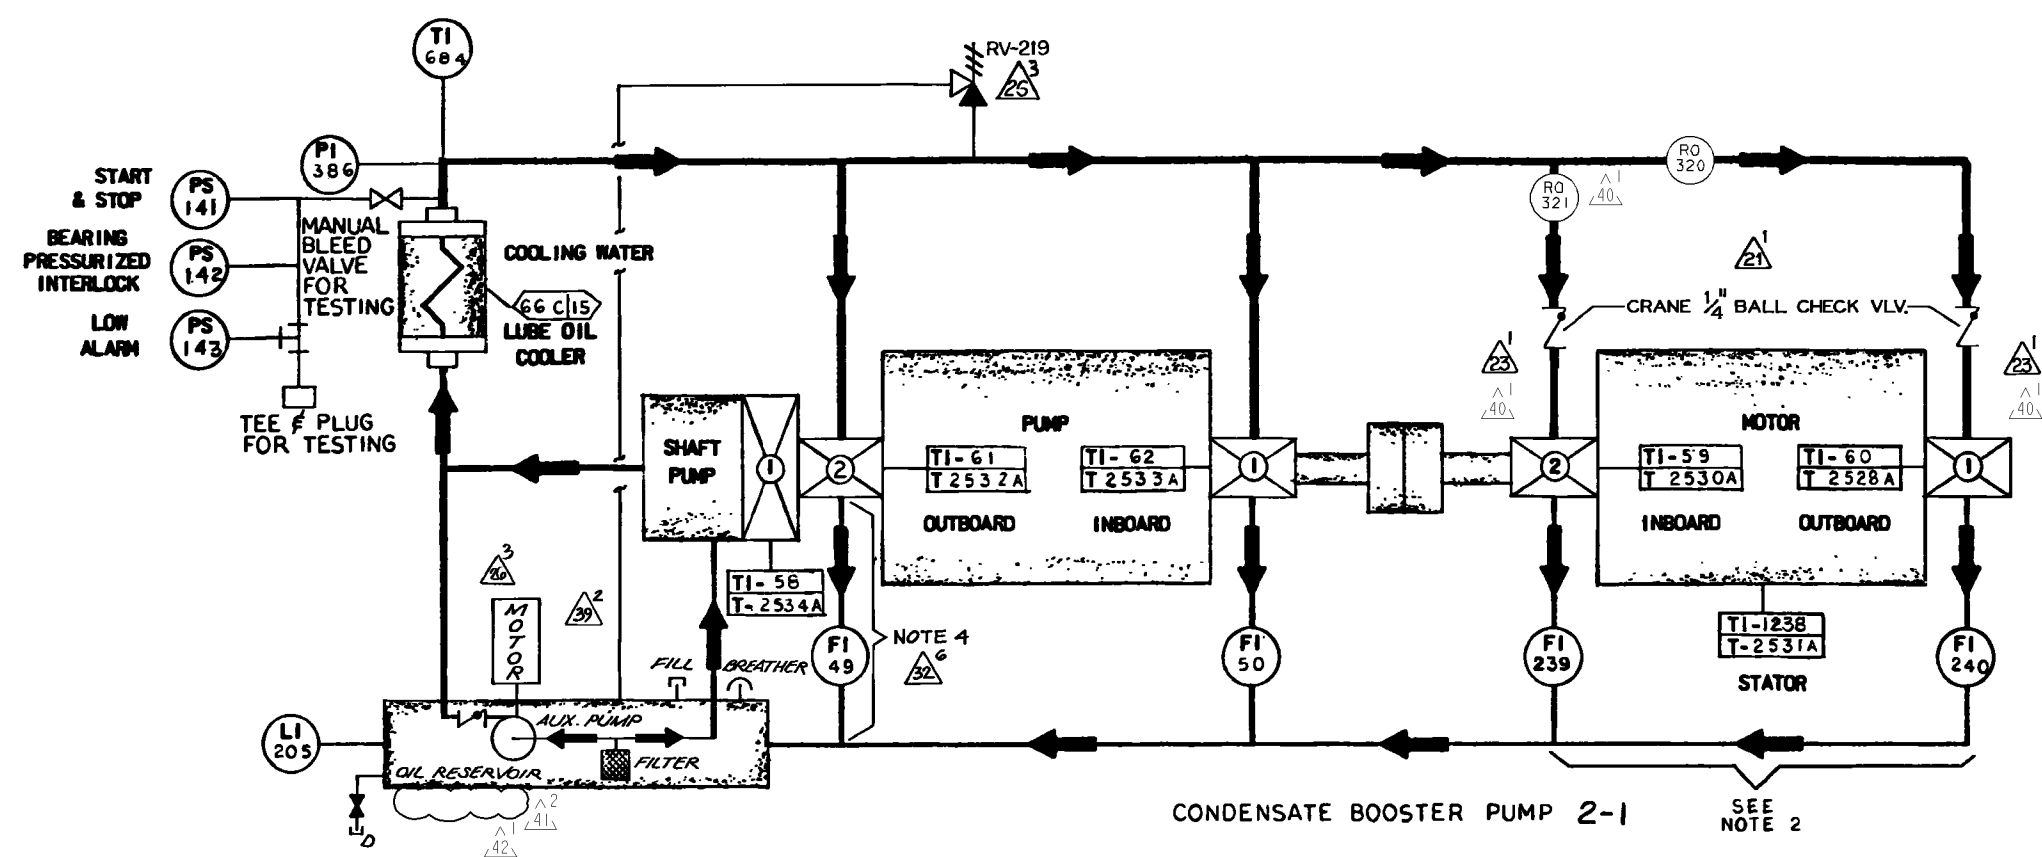

INSTRUMENT NUMBERS																						
LUBE OIL PUMP SYSTEM		PUMPING SYSTEM								DISTRIBUTION & RETURN SYSTEM												
		LUBE OIL COOLER WATER SUPPLY CROSS REF. COOR-SCHEM. 1020 XX	OIL RESEV. LEVEL	AUXILIARY LUBE OIL PUMP			HEADER		PUMP					MOTOR								
				RELIEF VALVE	START & STOP	INTRL. PRESS- URIZE BRGS. BEFORE ROLLING	PRESSURE		TEMP.	BEARING										STATOR		
							LO ALARM	INDIC.		XCH'GR OUT	BRG: METAL			BRG: OIL RETURN			BRG: METAL					
											1 THRUST	2 OUTBOARD	1 INBOARD	2 OUTBRD.	1 INBOARD	2 OUTBRD.	1 INBOARD	2 OUTBRD.				
LI	RV	PS	PS	PS	PI	TI	TEMP. INDIC. COMPUTER POINT	T1XXXX TXXXXA	FI		TEMP. INDIC. COMPUTER POINT	T1XXXX TXXXXA										
COMPONENT	2-1	53A-C-14	201	233	322	244	321	859	1256	1257 0640	1258 0639	1259 0638	245	246	SELF- LUBRICATED BEARING SEE NOTE NO. 2	1269 0637	1268 0636	1024 0641				
COOLING WATER	2-2	54A-C-14	202	234	324	245	323	860	1260	1261 0646	1262 0645	1263 0644	247	248		1271 0643	1270 0642	1025 0647				
DC 663213-4	2-3	57A-C-14	203	235	326	246	325	861	1264	1265 0652	1266 0651	1267 0650	249	250		1273 0649	1272 0648	1026 0653				
HEATER 2 DRAIN TANK DC 663043-1		55-C-15	204	218	138	139	140	385	683	NONE	57 2433	56 2434	47	45		55 2431	54 2430	1232 2432				
CONDENSATE BOOSTER DC 663046-16		2-1	66-C-15	205	219	141	142	143	386	684	58 2534	61 2532	62 2533	49	50	239	240	59 2530	60 2529	1238 2531	320	321
		2-2	67-C-15	206	220	144	145	146	387	685	63 2540	66 2538	67 2539	51	52	241	242	64 2536	65 2535	1244 2537	322	323
		2-3	69-C-15	207	221	147	148	149	388	686	68 2546	71 2544	72 2545	53	54	243	244	69 2542	70 2541	1250 2543	324	325

2
31

NOT
1. ALL
2. COM
HEA
WIT
3. COM
ARE

3
31

MOTOR BRG. OIL RO
OUTBOARD INBOARD


- NOTES
- 1. ALL PIPING AND INSTRUMENTS ARE FURNISHED BY THE EQPT. VENDOR.
 - 2. COMPONENT COOLING WATER PUMP MOTORS AND HEATER 2 DRAIN TANK PUMP MOTOR ARE EQUIPPED WITH BEARING AUTOMATIC OILERS.
 - 3. COMPONENT COOLING WATER PUMP LUBE OIL SYSTEMS ARE DESIGN CLASS I.
 - 4. CONDENSATE BOOSTER PUMPS DRAIN LINE EQUIPPED WITH FLEXIBLE HOSE. (83-D)

UNIT 2

DIABLO CANYON POWER PLANT - PG&E CO.
LUBE OIL DISTRIBUTION AND PURIFICATION SYSTEMS

DRAWING	SHEET	PAGE	REV
108020	8	0	42

RASTER=108020s8.dgn
DGN=108020s8.dgn
CAD User: FAZI Date: 01-08-2009

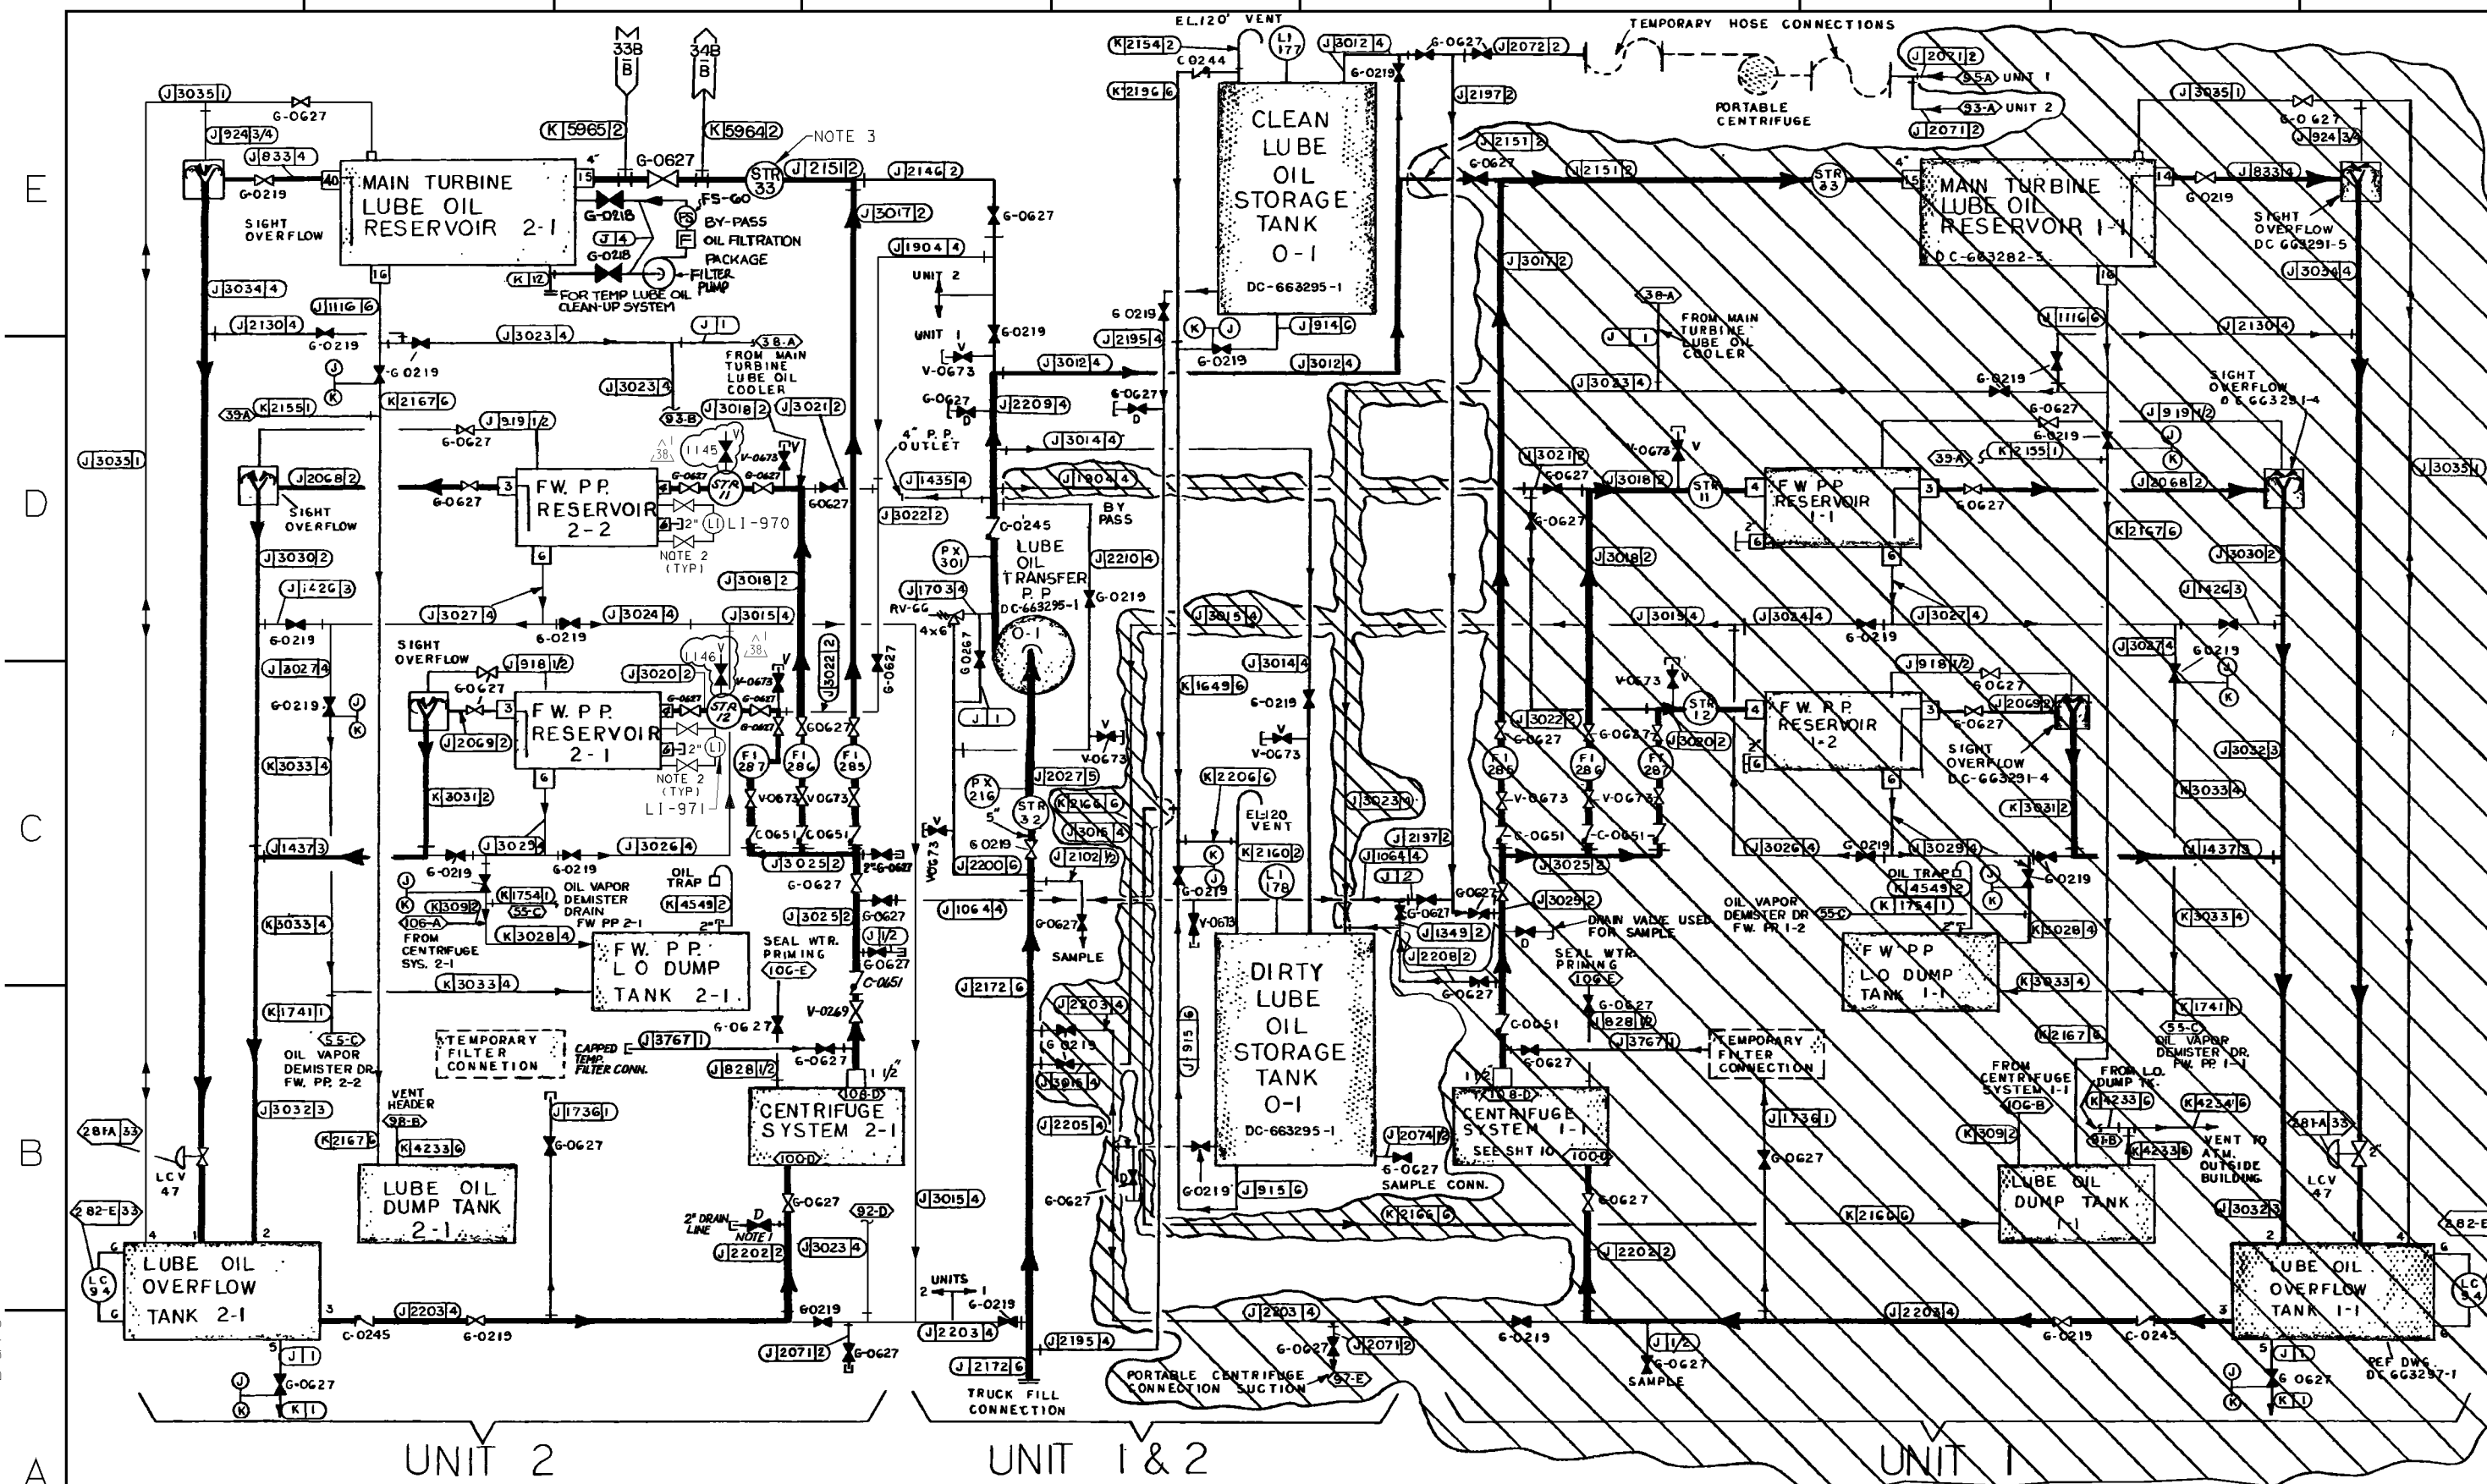

NOTES:

- 1. 2" THREADED STOCKHAM FIG. B 150S.
- 2. WHITEY MODEL B-45F8, DWG. 698106-26. (92-C 92-D)
- 3. SCREEN REMOVED FROM STR-33 PER AR# A0607305. (93-E)

LUBE OIL SYSTEM

UNIT 2

DIABLO CANYON POWER PLANT - PG&E CO.
LUBE OIL DISTRIBUTION AND PURIFICATION

DRAWING	SHEET	PAGE	REV
108020	9	0	38

RASTER=108020s9.dgn
DGN=108020s9.dgn
CAD User: MNRU Date: 10-14-2013


INPC1C
I Size

10-14-2013	MNRU	RxG2	KJD3	NOT REQUIRED	N/A	N/A	N/A	REVISED PER DDT-4*202
DATE	DWN	RE	IV	PROFESSIONAL ENGINEER	PE DISC.	PE #	PE EXP.	

CAD User: CRC2 Date: 6-23-1999
DGN=8020S10.DGN
RASTER=8020S10.TIF

E
D
C
B
A

E
D
C
B
A

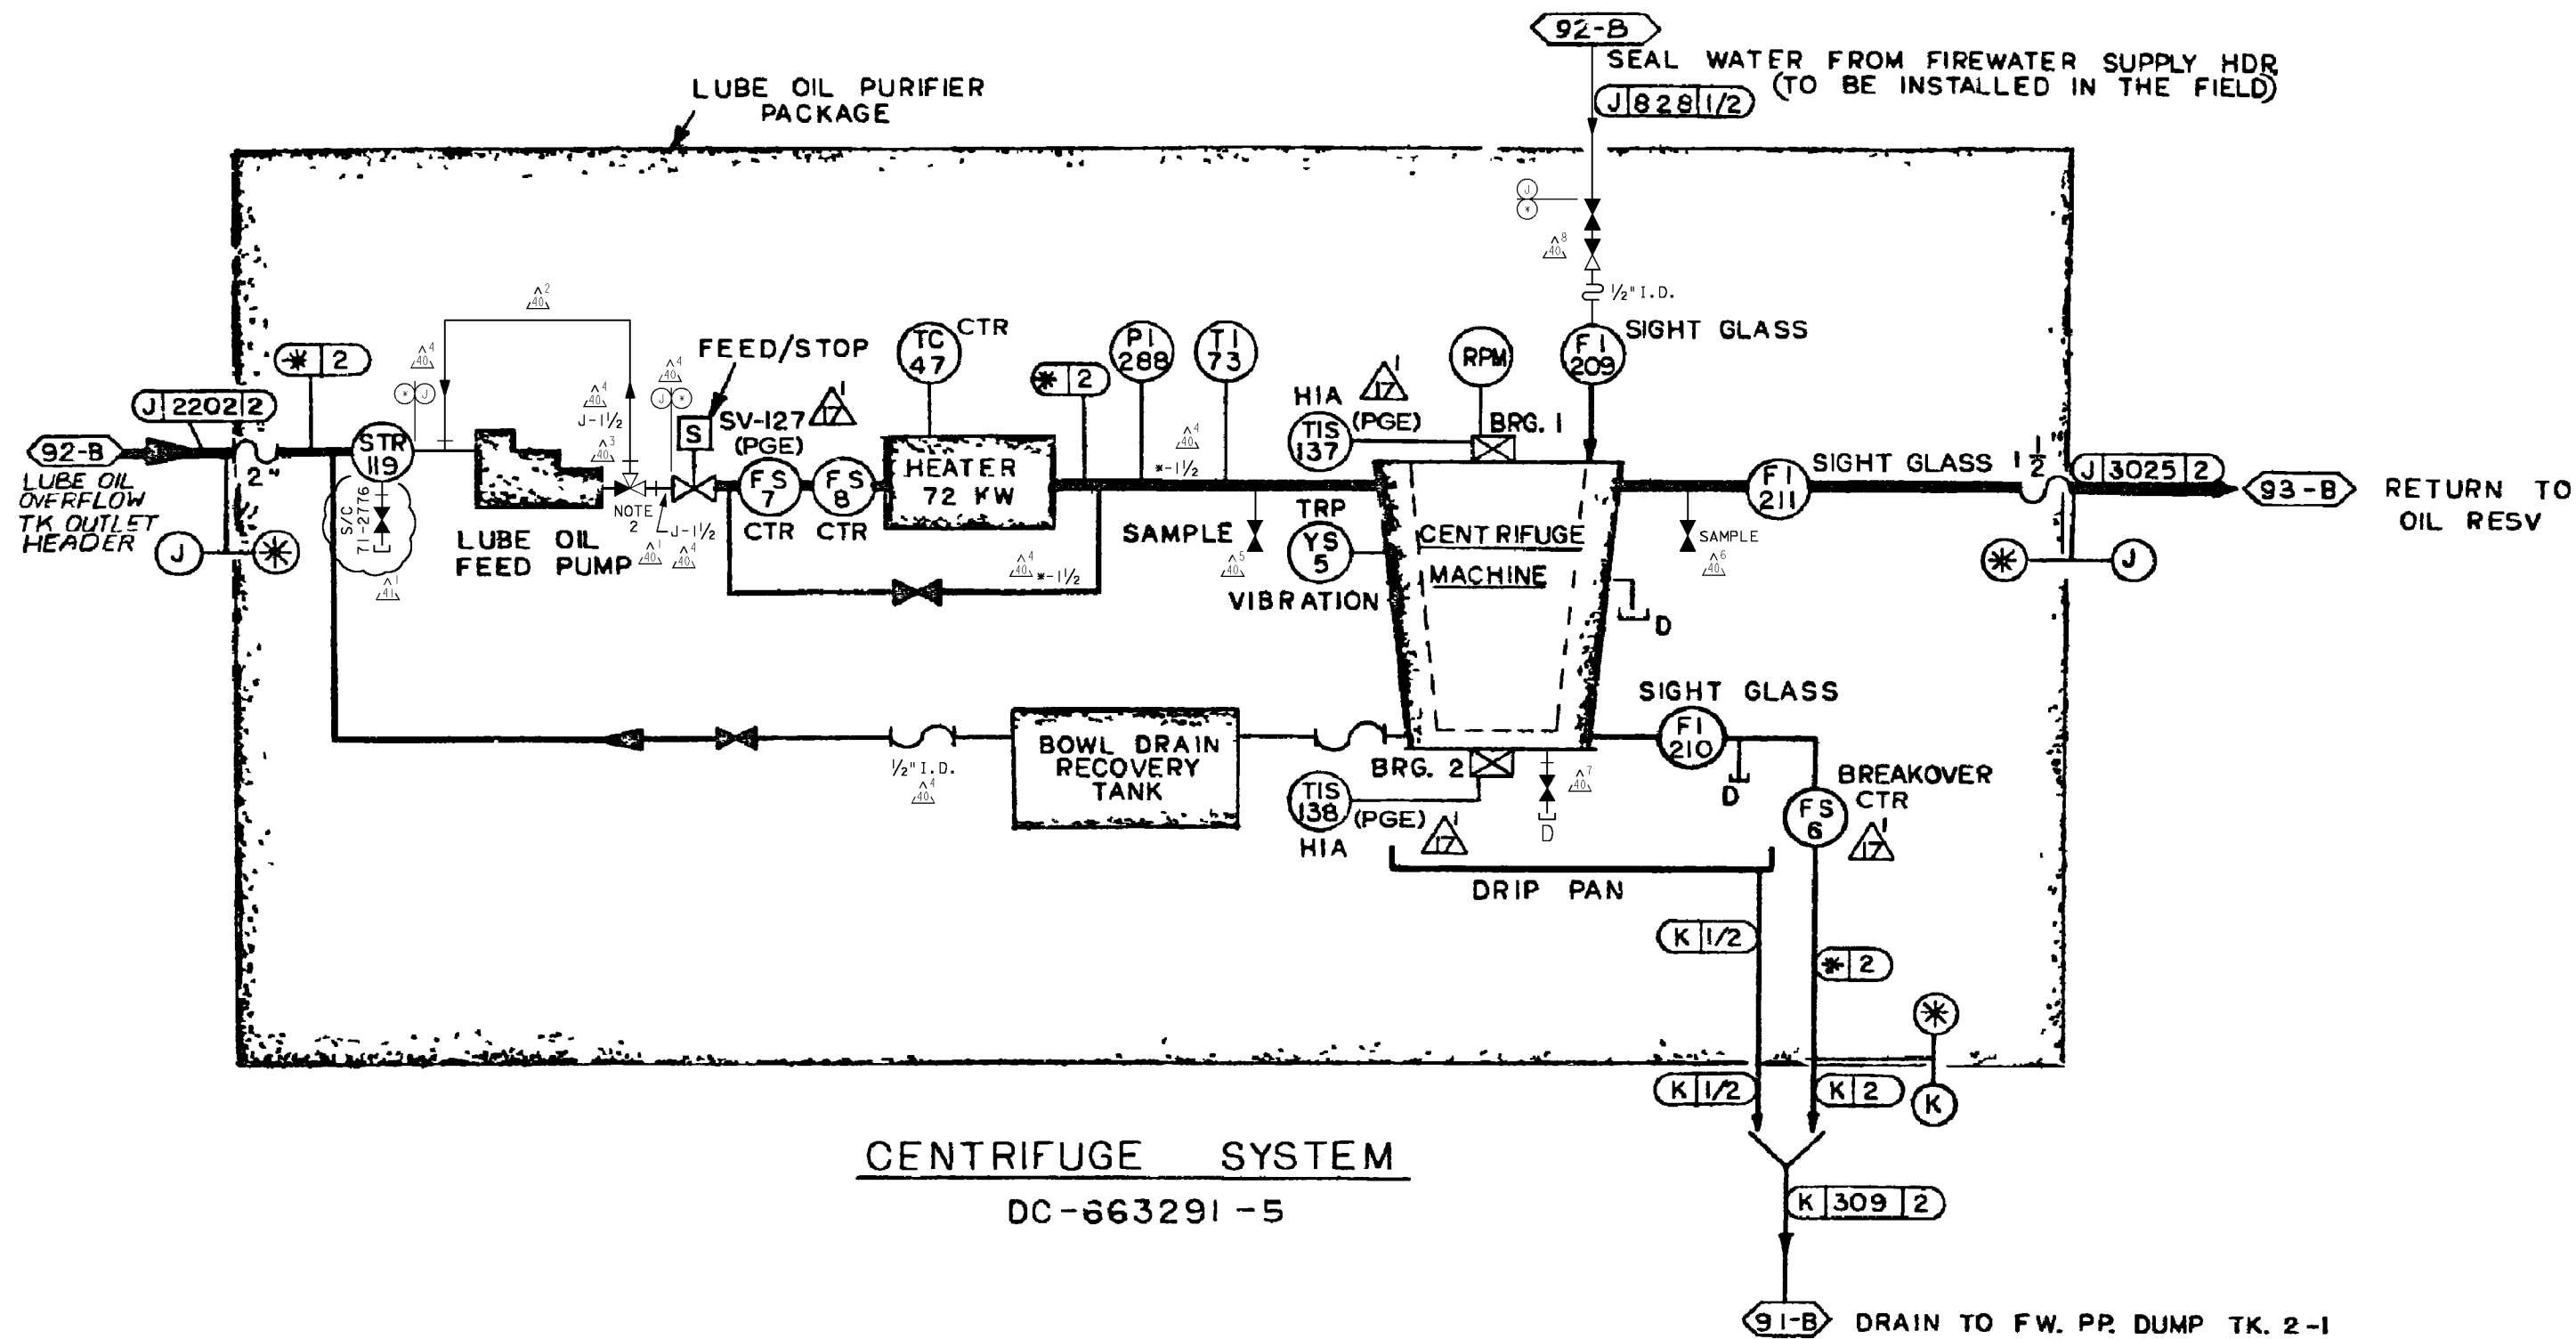

NOTES:

1. ALL INSTRUMENTS ARE SUPPLIED BY THE EQUIPMENT VENDOR EXCEPT AS NOTED.
2. JAMESBURY 3-WAY MANUAL FLOW CONTROL VALVE, MODEL AM150FD2236MT. (102-B)

UNIT 2

P G & E CO.		108020	REV. 41
SHEET 10	PAGE 0		

INPGIC

6/24/99	CRC2	RMDI	-	LARRY DEAN SMITH	MECHANICAL	M 14568	12/31/1999	Revised per FCT 024057
DATE	DWN	RE	IV	PROFESSIONAL ENGINEER	PE DISC.	PE#	PE EXP.	

110

111

112

113

114

115

116


117

118


119

1 NORMAL OPERATION


CENTRIFUGE SYSTEM CONTINUOUSLY RECIRCULATES AND CLEANS LUBE OIL THRU THE 3 RESERVOIRS.

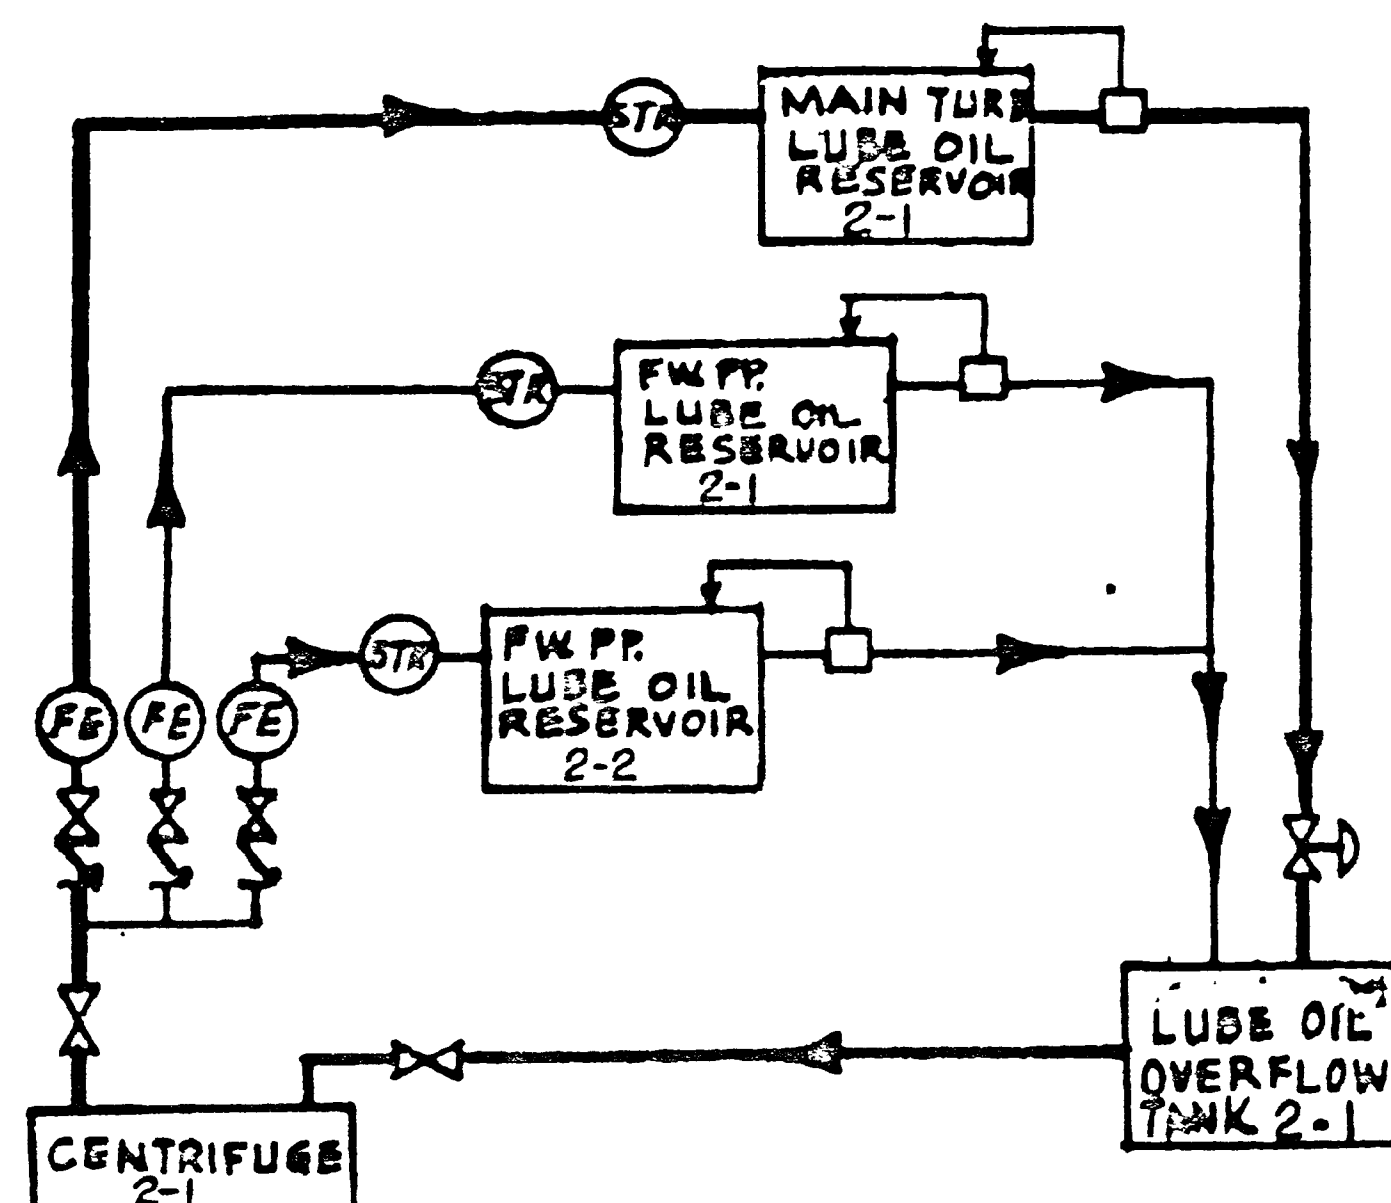**3 START UP**


FILL MAIN TURBINE & FW.P.P. 1/2 LUBE OIL RESERVOIRS FROM CLEAN OIL TANK, USING TRANSFER PUMP.

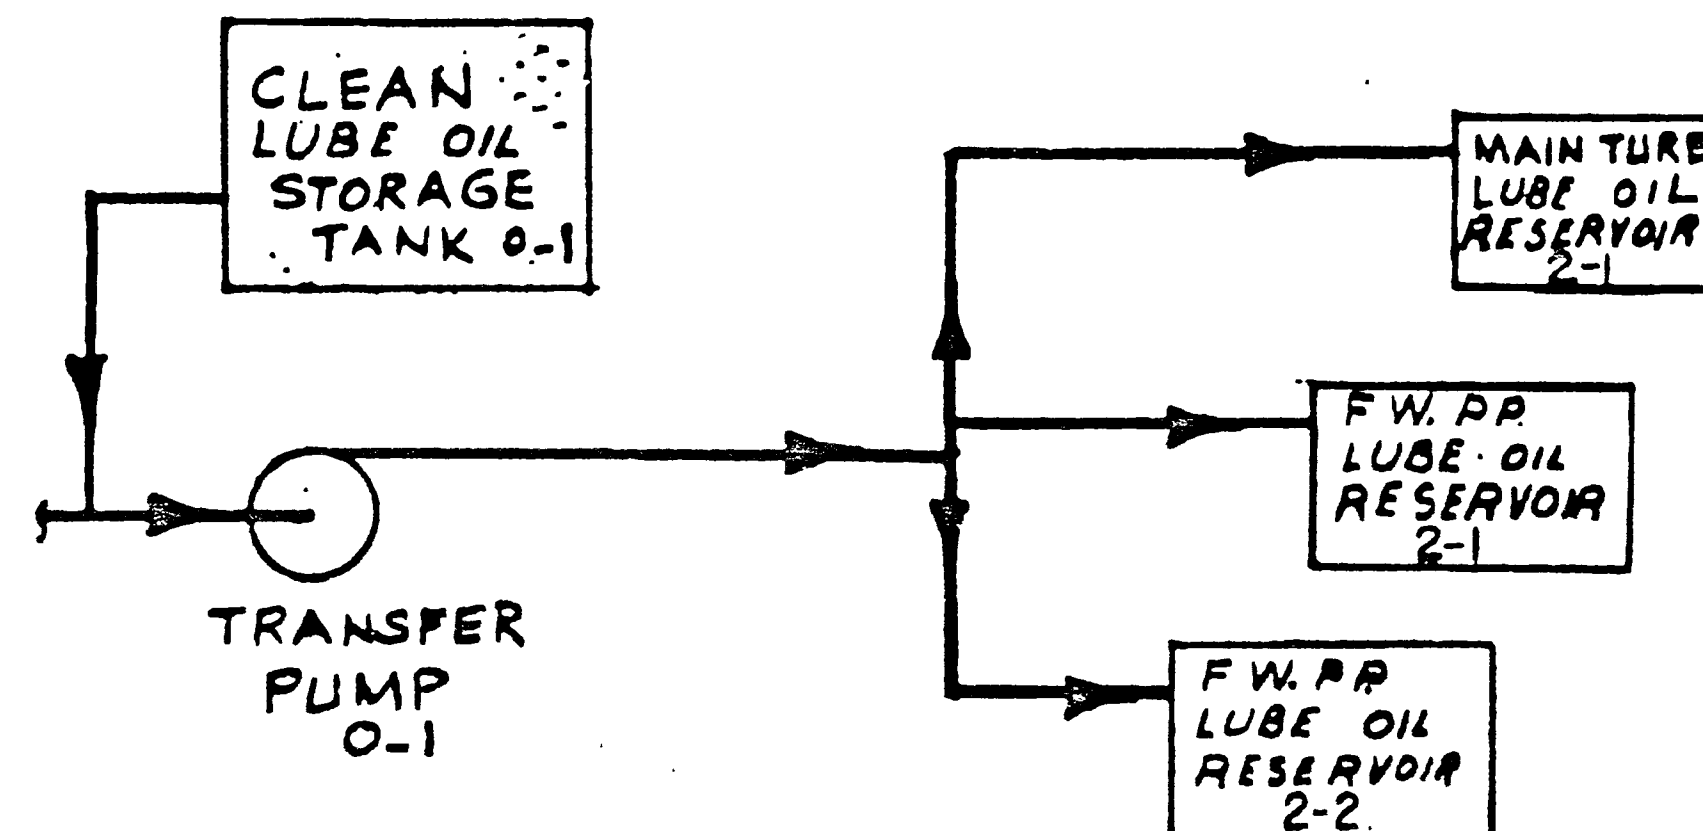**5 TRUCK FILL**


USE BY-PASS AROUND TRANSFER PUMP WHEN TRUCK PUMP IS USED. TRANSFER PUMP MAYBE USED AS AN ALTERNATE TO TRUCK PUMP.

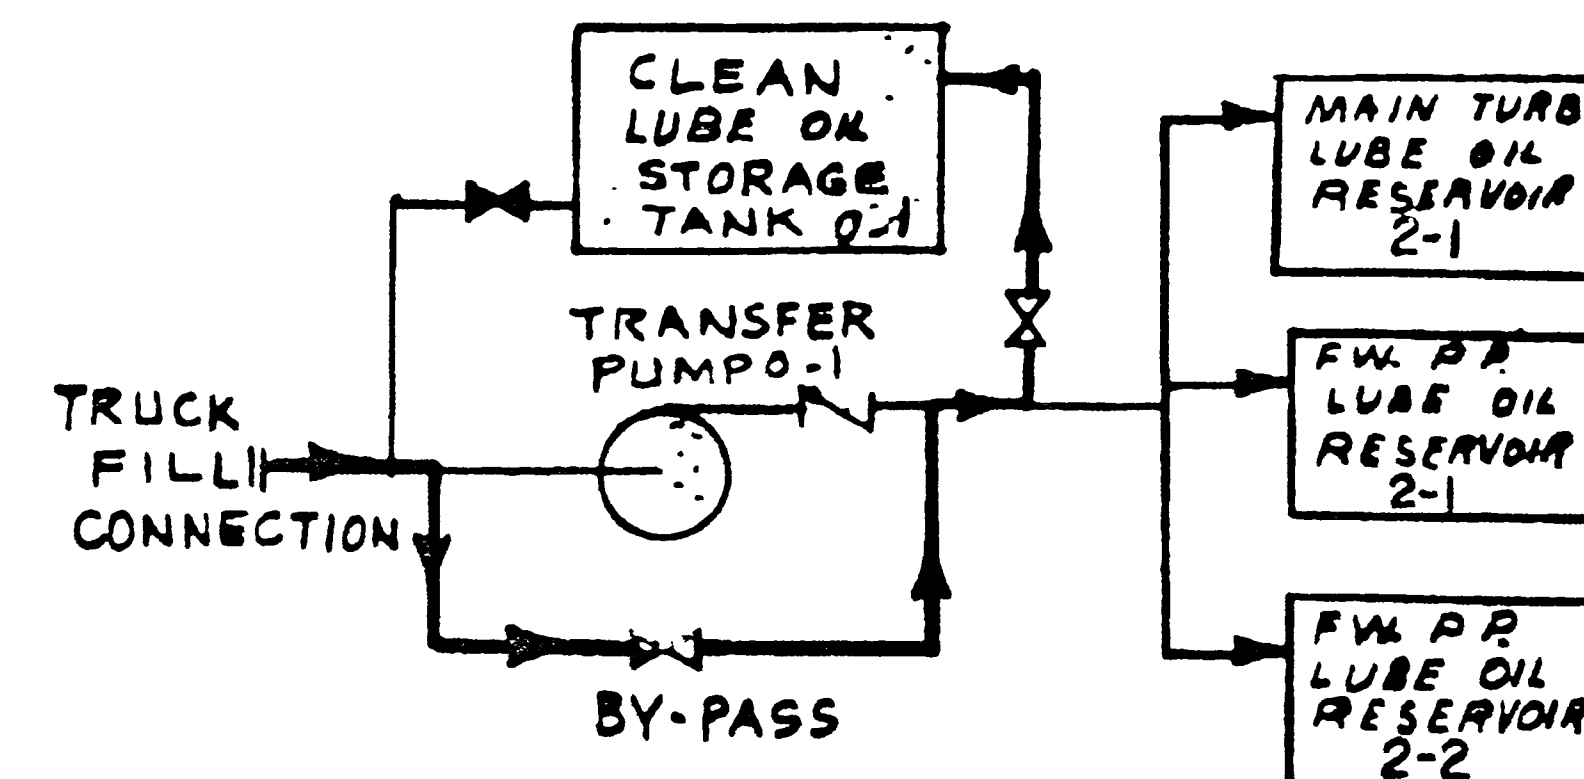**2 DRAIN RESERVOIRS**


DRAIN MAIN TURBINE LUBE OIL RESERVOIR TO DIRTY LUBE OIL TANK BY GRAVITY. DRAIN FW.P.P. RESERVOIRS TO DIRTY LUBE OIL STORAGE TANK BY USING TRANSFER PUMP.

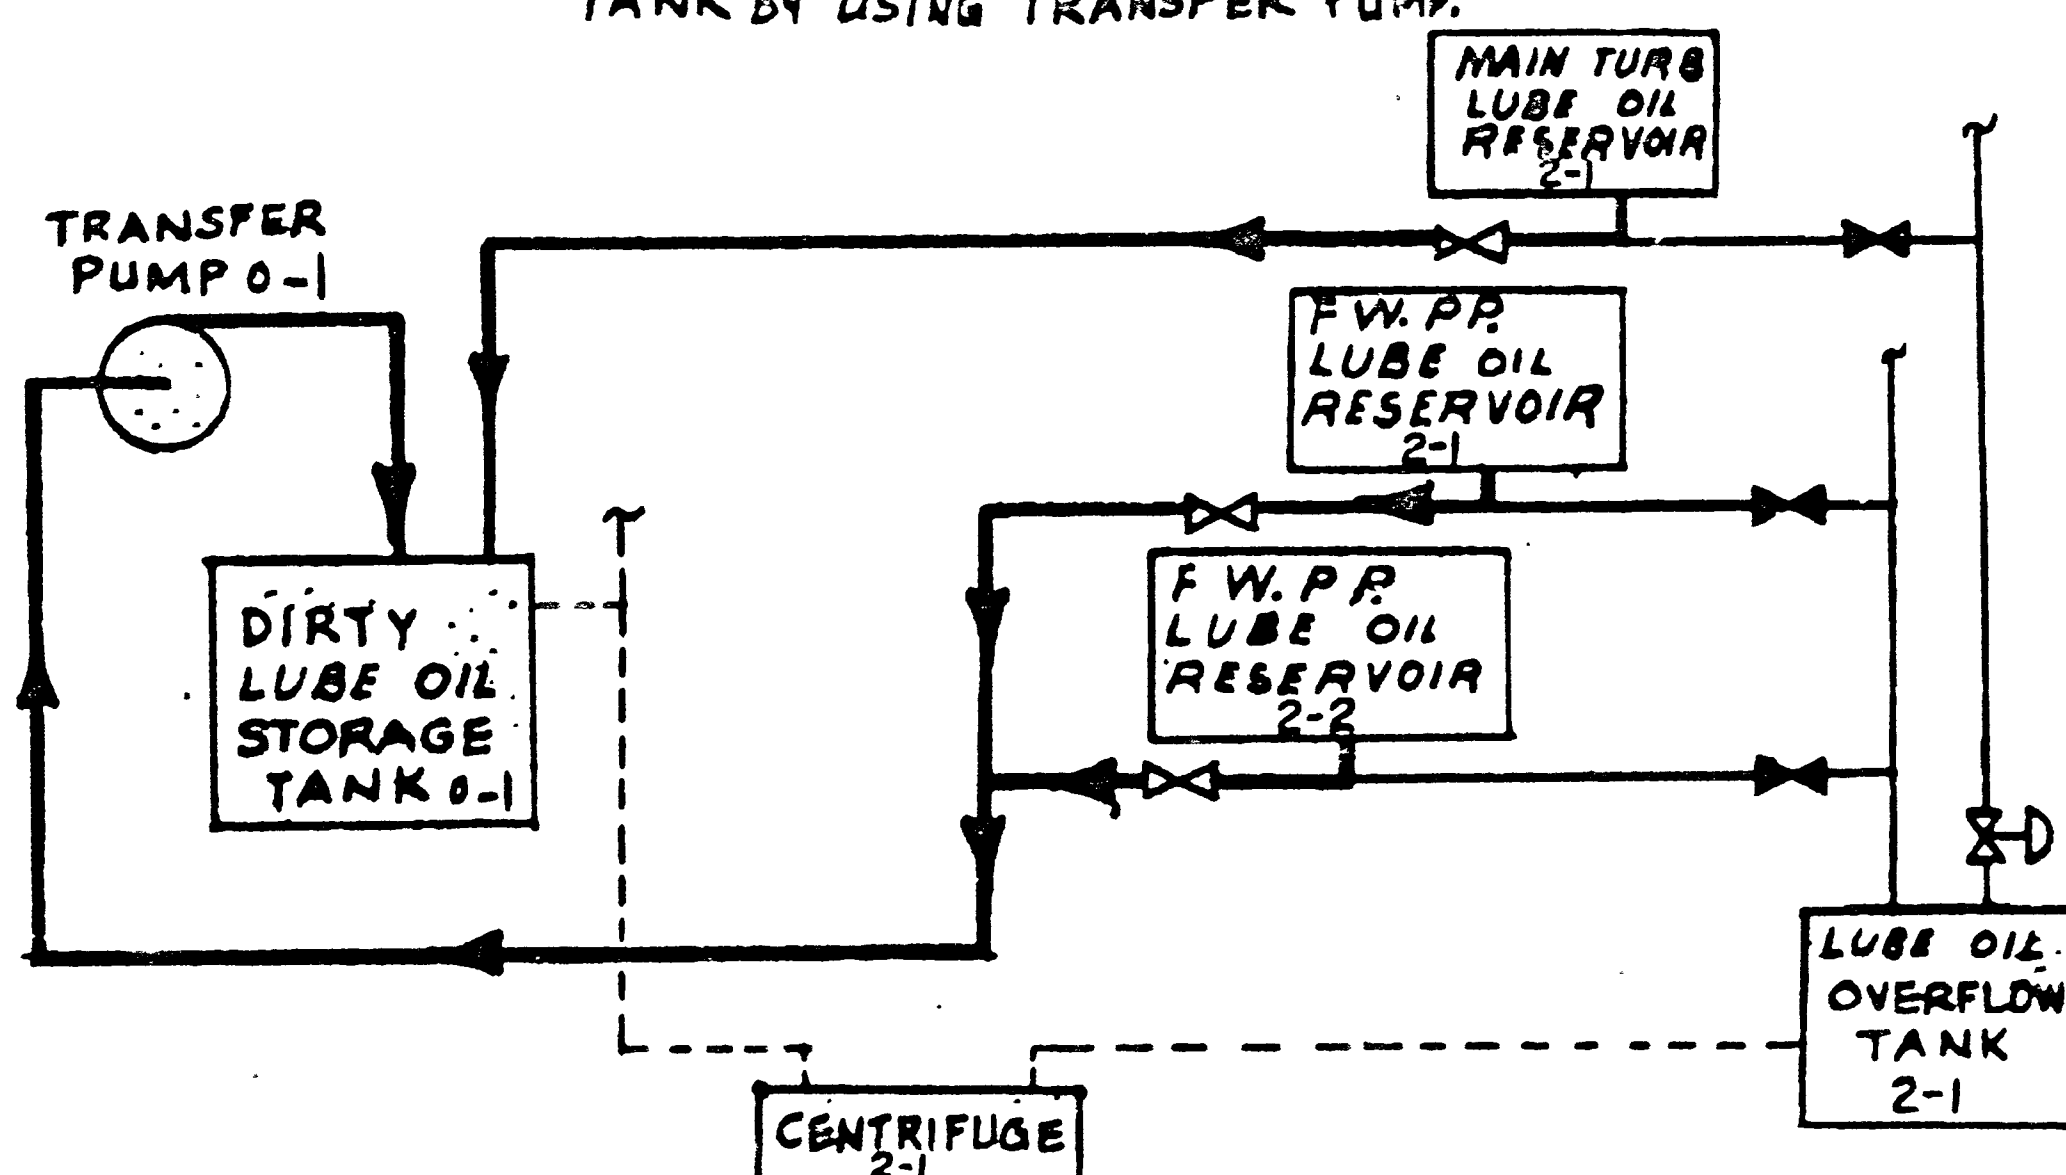**4 EMERGENCY DUMP**

MANUALLY OPEN DRAIN VALVES TO DUMP TANKS

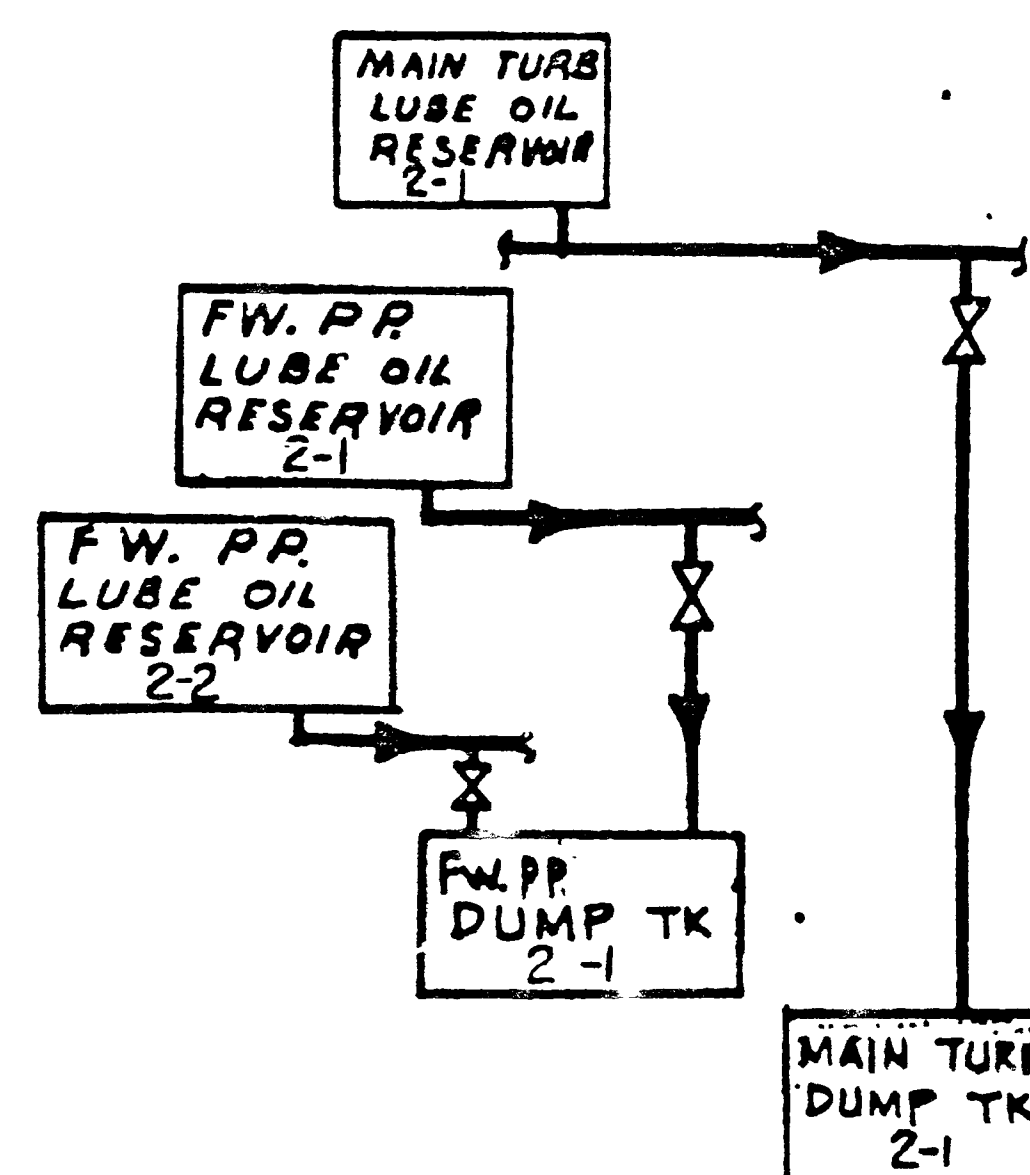**6 CLEANING DIRTY OIL**

DIRTY OIL DRAINS TO CENTRIFUGE. OIL IS RECYCLED TO DIRTY OIL TANK. AFTER SEVERAL CYCLES CENTRIFUGE DISCHARGE IS ROUTED TO CLEAN OIL TANK.

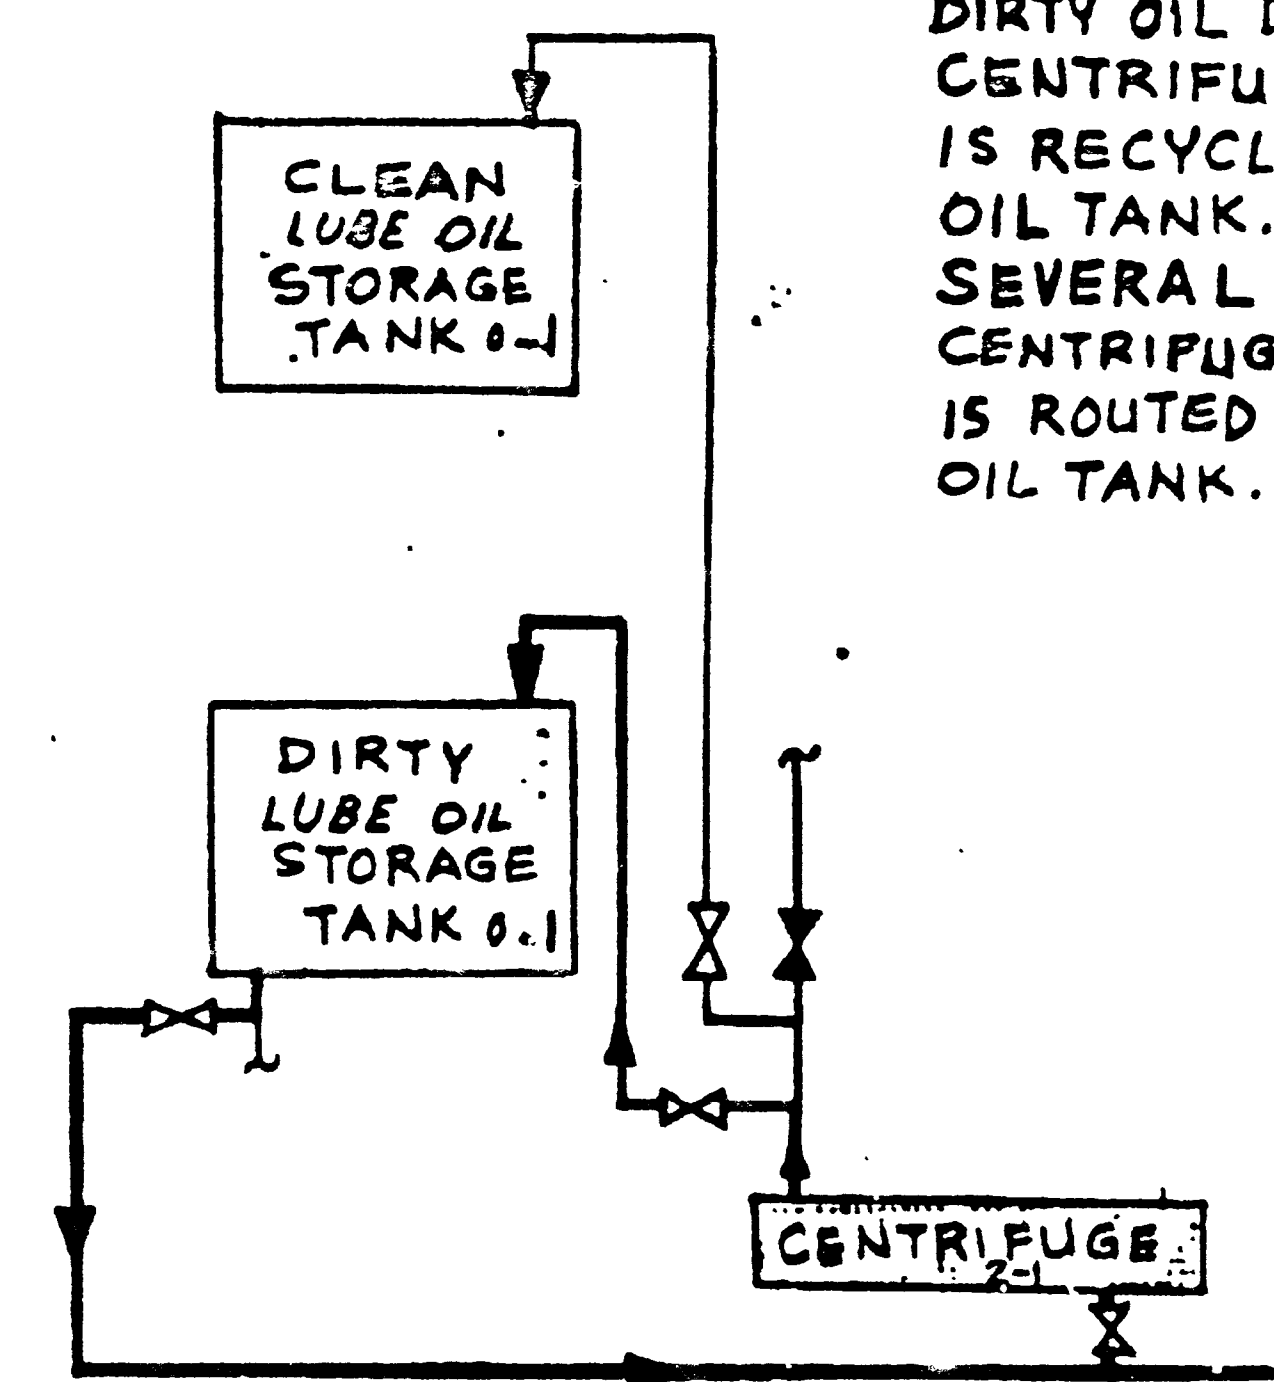

UNIT - 2

P.G. & E. CO.

DRAWING NUMBER

REVISION

SHEET 11 OF 11 SHEETS

108020

10

RM INDEXED REV. 10

MICROFILM


10

SCANNED 10

SCAN 10 10

THIS DRAWING HAS BEEN REPRODUCED WITHOUT CHANGE FROM ORIGINAL DRAW. CHANGE NO. DATE 2/2/1964 APPROVED

- NOTES:
1. ALL PIPING ON THIS SYSTEM SHALL BE PG&E CLASS Ⓢ, EXCEPT AS NOTED.
 2. GATE VALVE PER DWG DC-6006473-166, S/C 93-6844
 3. ✱ DENOTES MANUFACTURER SUPPLIED INSTRUMENTS AND EQUIPMENT. IT IS ACCEPTABLE TO REPLACE MANUFACTURER SUPPLIED INSTRUMENT TUBING WITH PG&E SUPPLIED S-SPEC STAINLESS STEEL TUBING
 4. 2½" BALL VALVE PER DWG DC-6011930-56, S/C 95-1194
 5. 2" BALL VALVE PER DWG DC-6011930-55, S/C 95-1193
 6. LCV-85, LCV-86, LCV-88 AND LCV-89 PER DWG DC-6011930-42
 7. PIPING IN THE DFO TRENCHES, EXCEPT FOR SUPPLY LINES TO DIESEL 2-3, HAS BEEN COATED TO PREVENT CORROSION
 8. FOR THE PURPOSE OF LEAK DETECTION, A GORE-TEX CABLE WHICH IS WATERPROOF BUT ABSORBS HYDROCARBONS IS ATTACHED TO EACH HEADER OF THE DGFO PIPING FROM THE PUMP VAULTS TO THE DG ROOMS. THE CABLES ARE TAGGED AS FOLLOWS: CEL-502 FOR UNIT 2 HEADER A, CEL-504 FOR UNIT 2 HEADER B.

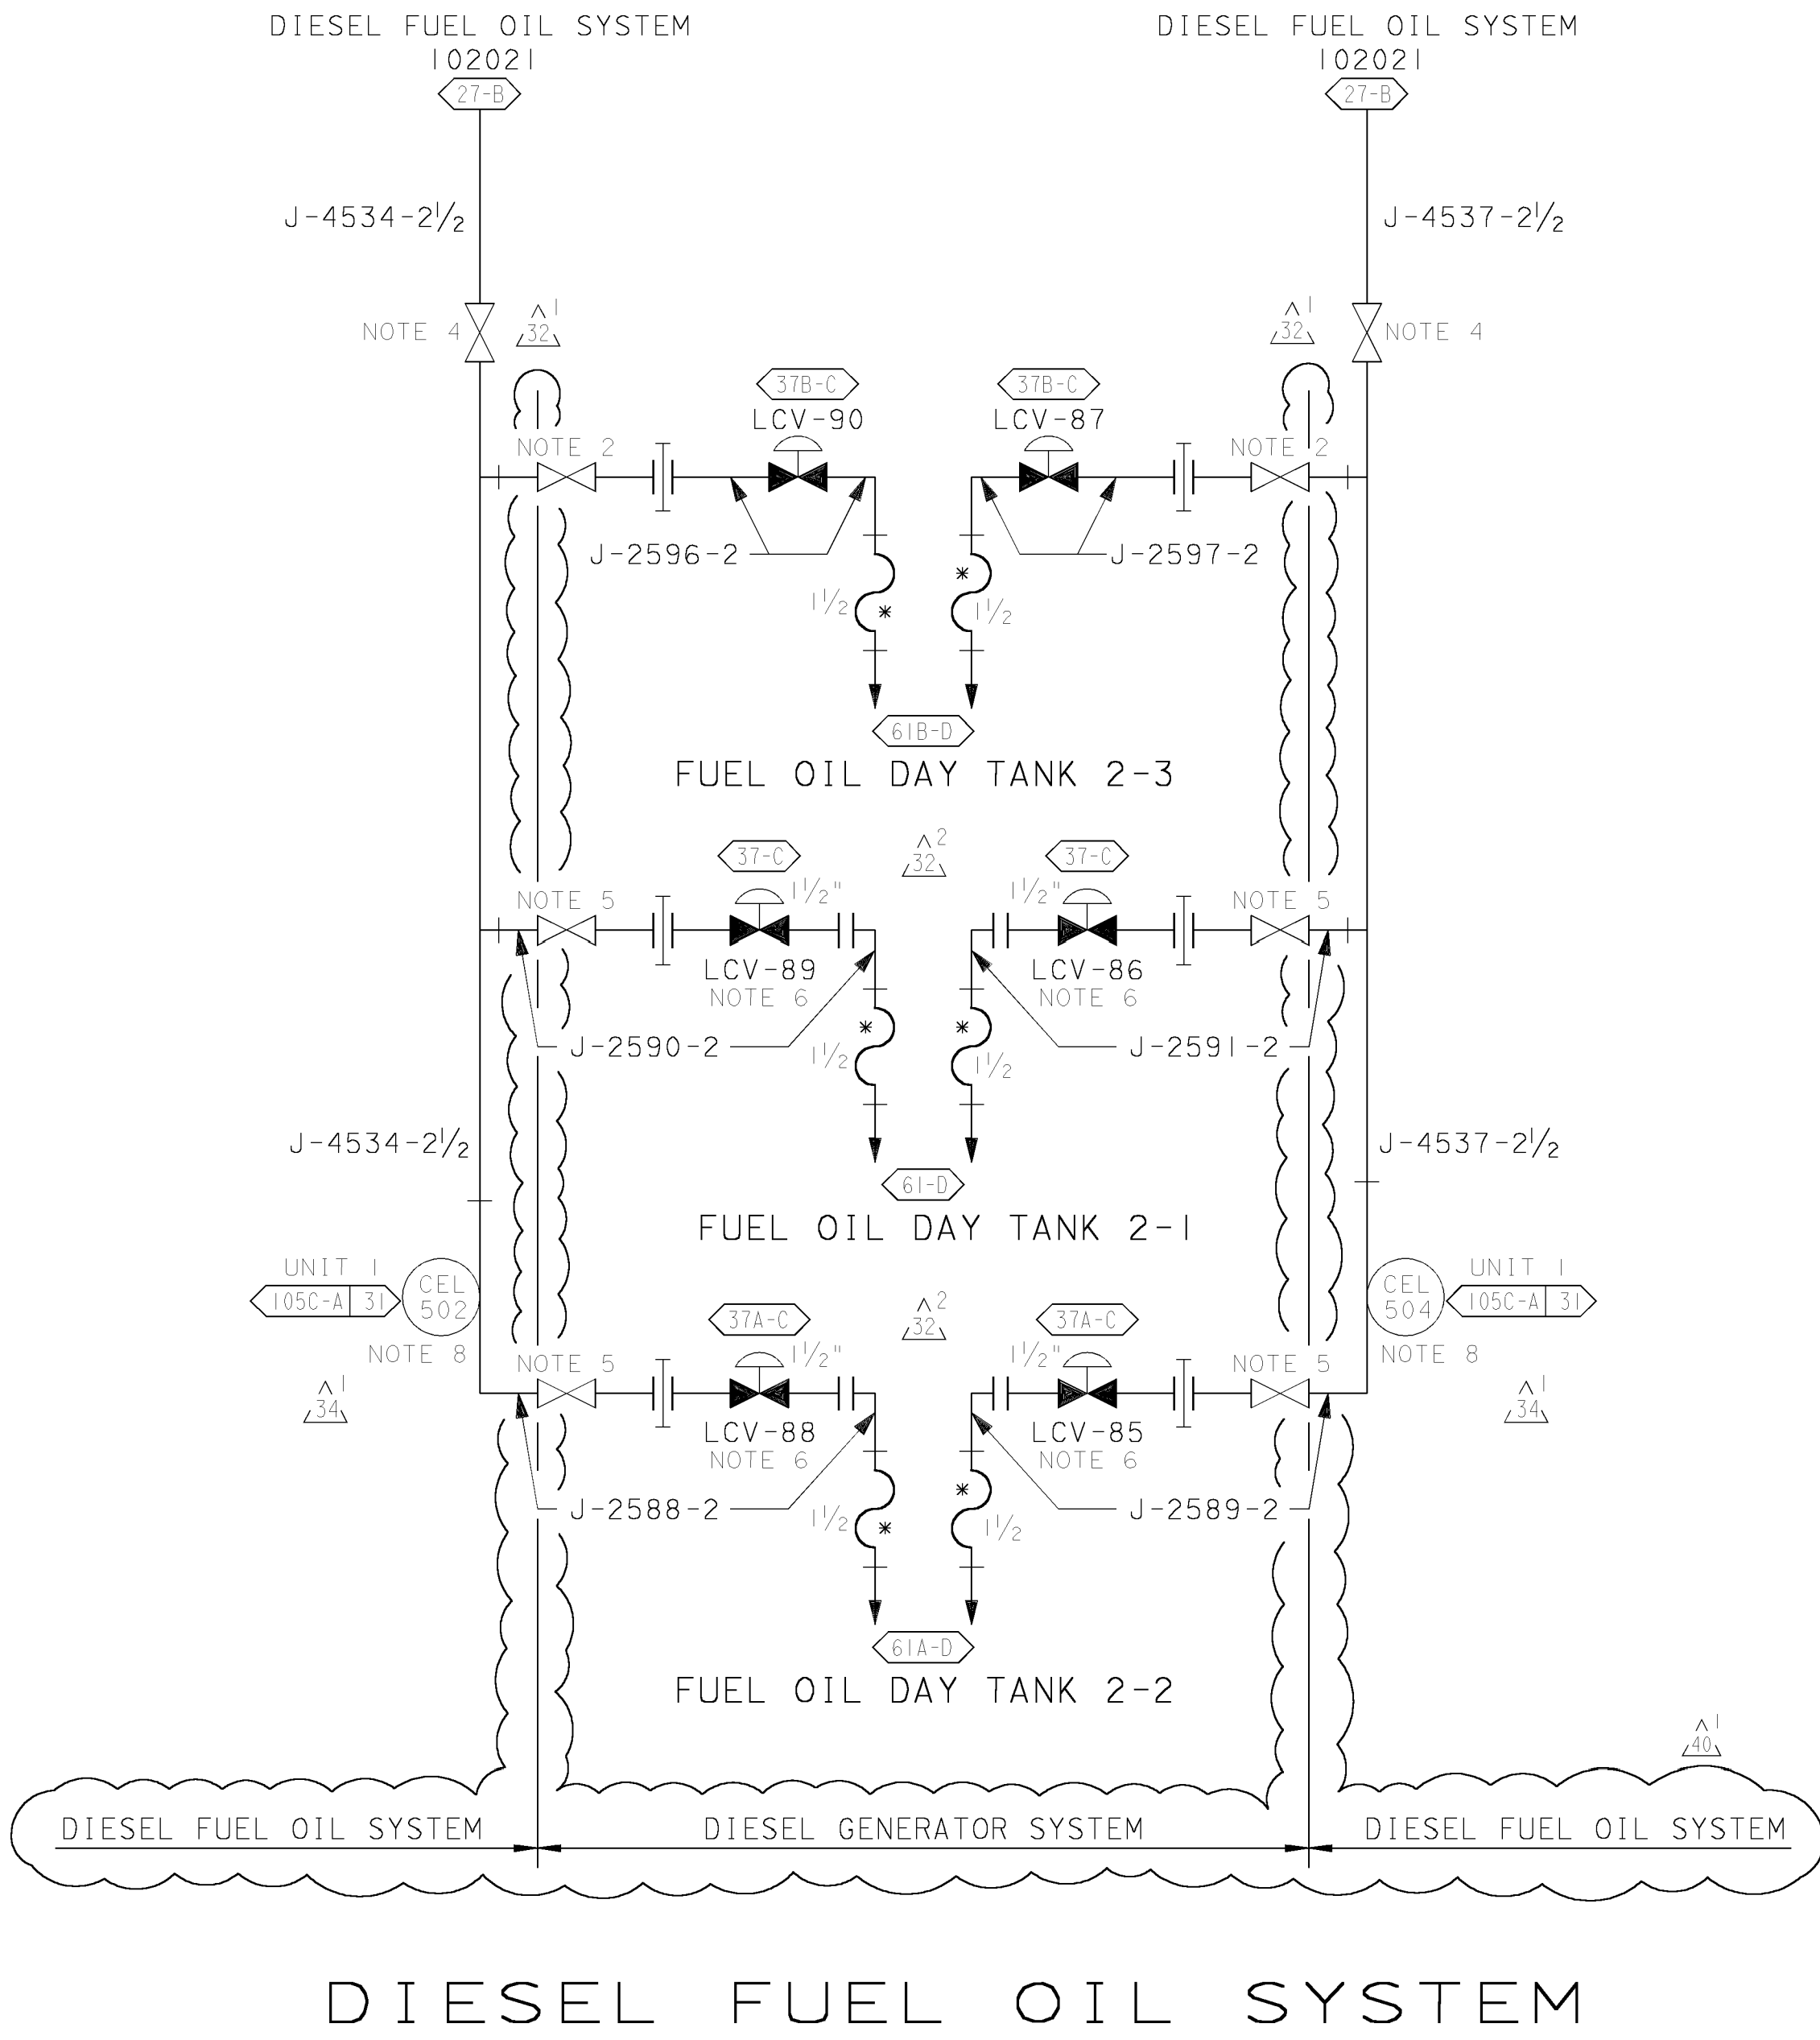


P G & E CO.		108021	REV. 40
SHEET 2	PAGE 0		

3/22/00	RXG2	FXC2	-	KERSI J. DALAL	MECHANICAL	M 16690	3/31/2000	Revised per FCT 024733
DATE	DWN	RE	IV	PROFESSIONAL ENGINEER	PE DISC.	PE#	PE EXP.	

NOTES:

- * DENOTES MANUFACTURER SUPPLIED INSTRUMENTS & EQUIPMENT. IT IS ACCEPTABLE TO REPLACE MANUFACTURER SUPPLIED INSTRUMENT TUBING WITH PG&E SUPPLIED S-SPEC STAINLESS STEEL TUBING
- FIELD PIPING ON THIS SYSTEM SHALL BE PG&E CLASS C UNLESS OTHERWISE NOTED
- [] MANUFACTURER NUMBER
- ALL VALVES ON THIS SHEET WITH PG&E ITEM NO. SHALL BE UNDER SPEC. 8729 (DWG 108039), UNLESS OTHERWISE NOTED
- PRESSURE REDUCING VALVE PROVIDED WITH STRAINER 36-C,E
- MOUNTED ON ENGINE CONTROL PANEL 37-B,D
- STARTING AIR SOLENOID VALVES AIR EQUIPPED WITH AN EMERGENCY MANUAL OPENING DEVICE 37-B,C,D,&E
- 2" A.W. CASH MODEL E-55 37-C,E
- VALVE TAG 45VI SPECS. ARE IN DWG 053479 37-B,D
- NORGREN MICRO-FOG LUBRICATOR 38-C,E
- ORIFICED SLIDER SHOWN IN POSITION CONTROLLING FLOWRATE FOR DRYER REGENERATION 32-B,D
- N.O. - AIR TO CLOSE
N.C. - AIR TO OPEN 32-B,D
- IF GLOBE VALVES ARE INSTALLED, THE PREFERRED ORIENTATION IS WITH THE FLOW ARROW INDICATING FLOW TOWARDS THE AIR COMPRESSOR. 35-C,E
- FIBERGLASS BLANKET TYPE PERSONNEL PROTECTION INSULATION. 30-B,D

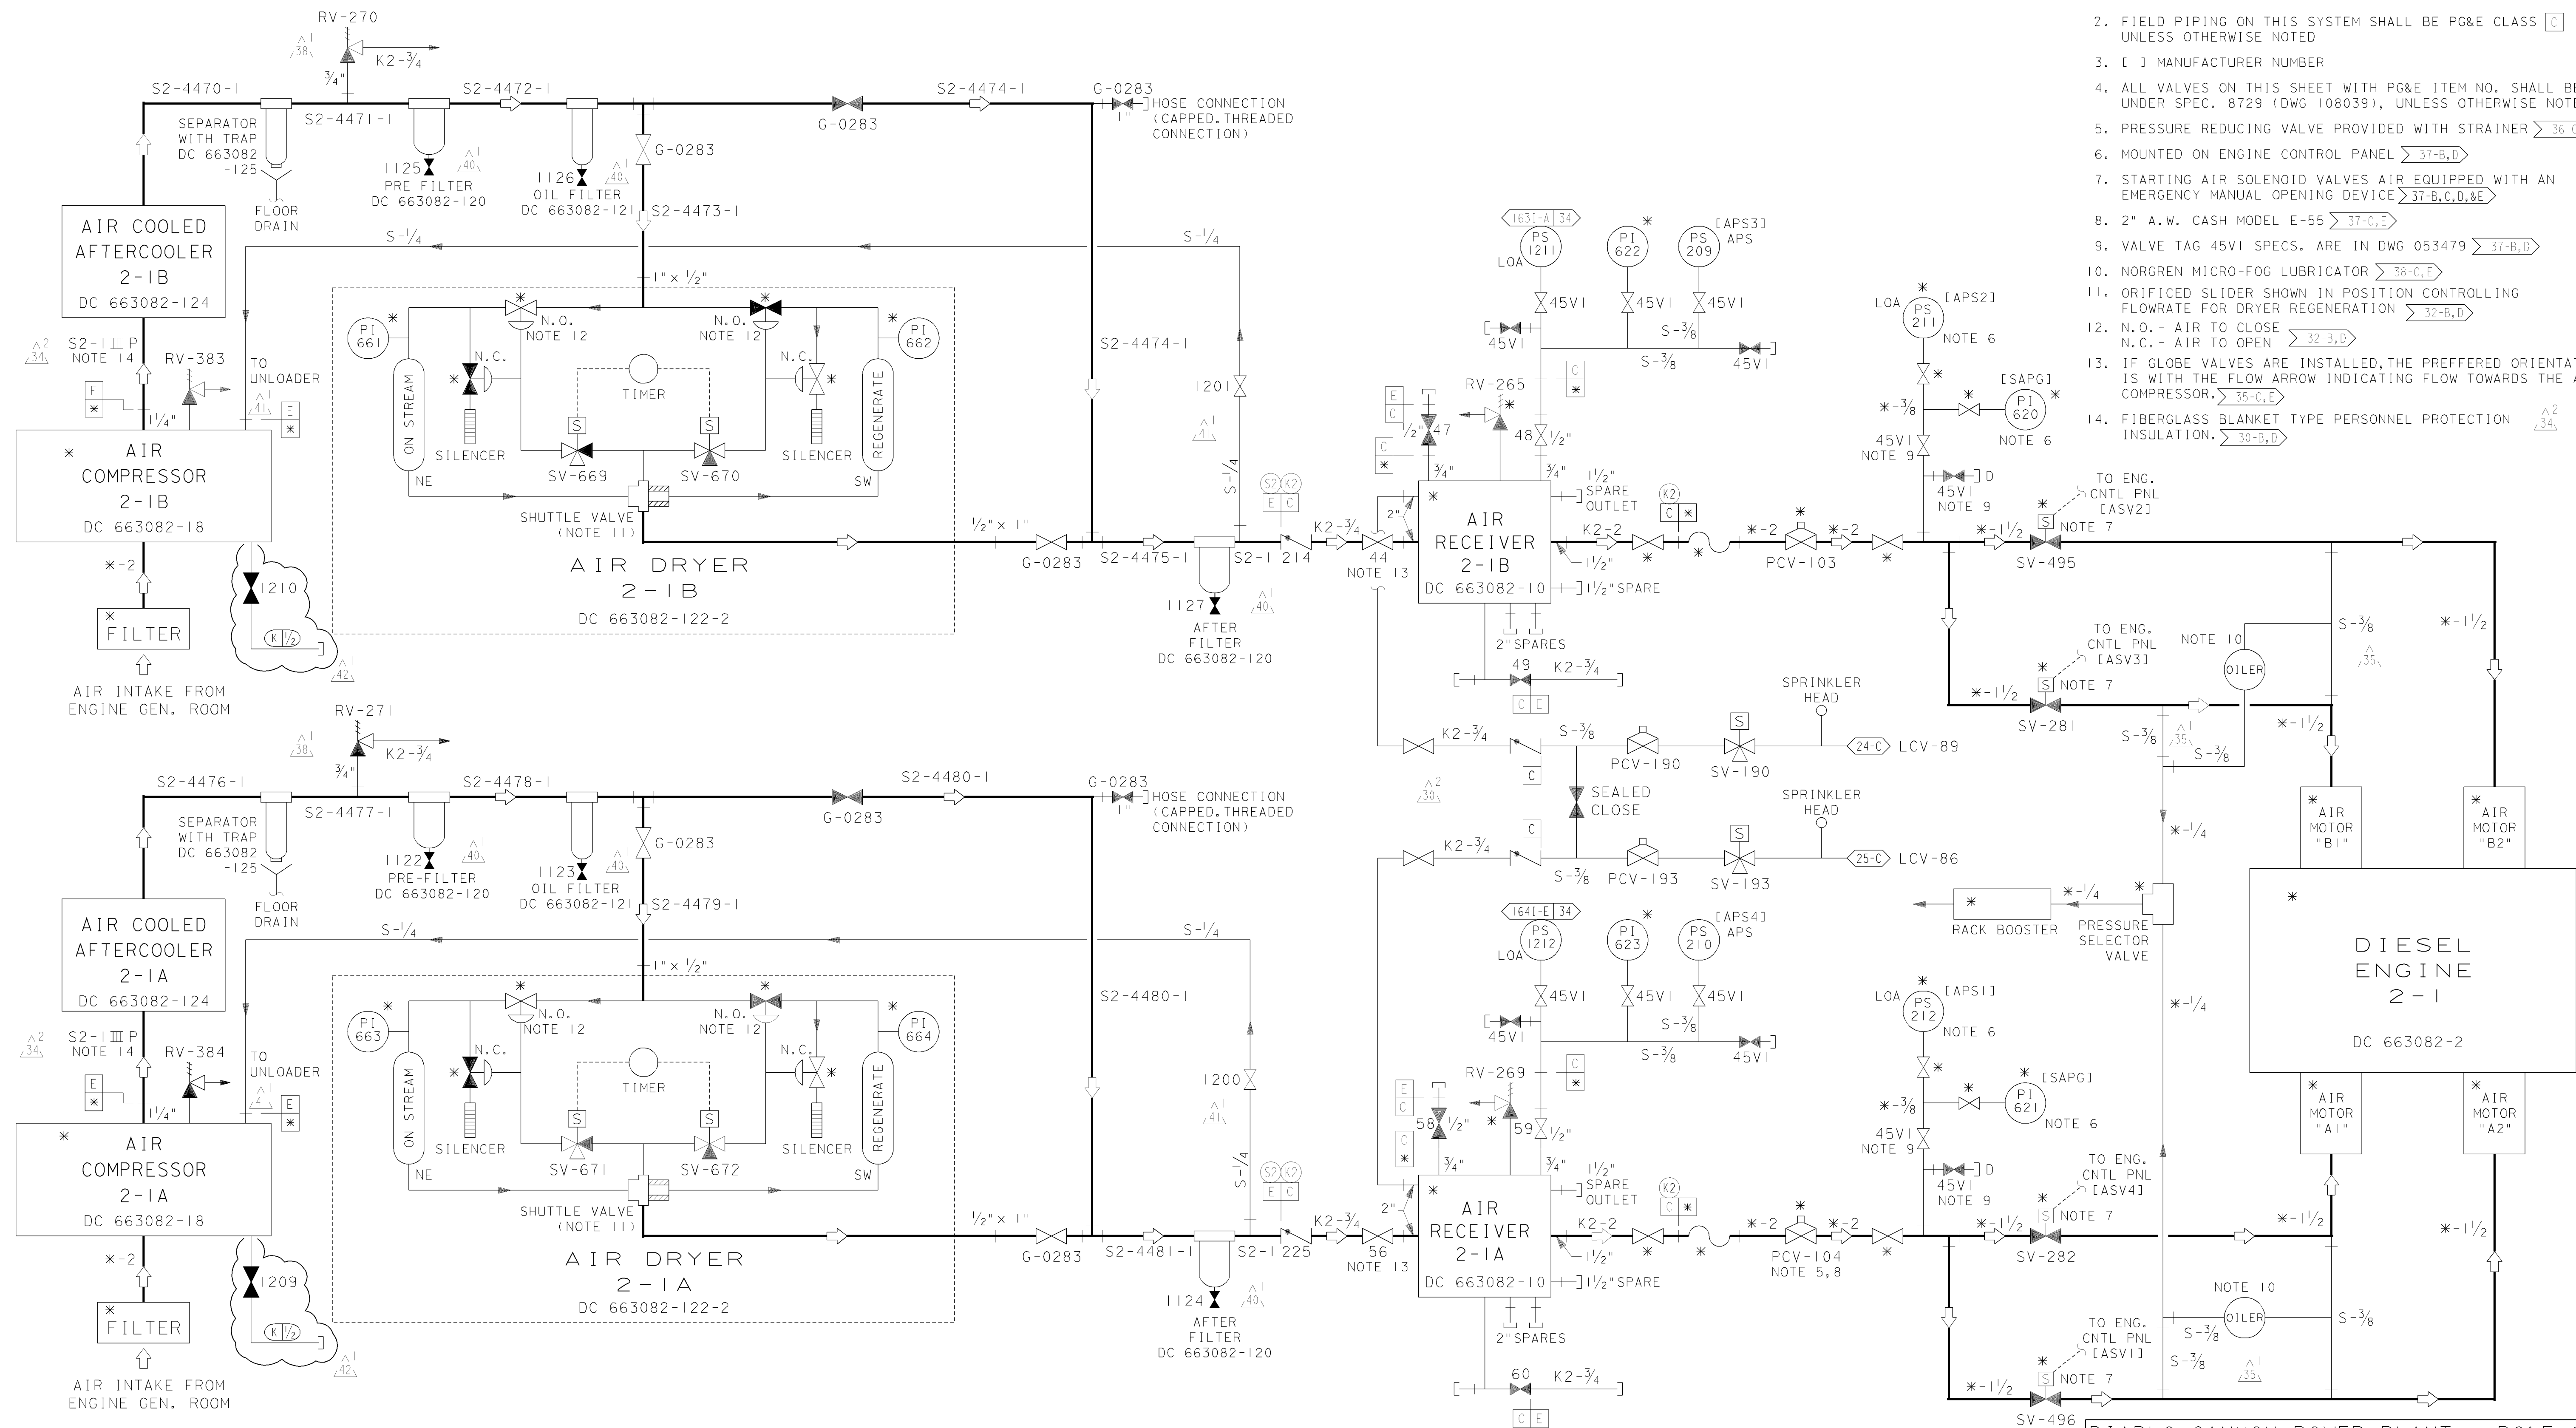

A

B

C

D

A


B

C

D

E

- NOTES:
- * DENOTES MANUFACTURER SUPPLIED INSTRUMENTS & EQUIPMENT. IT IS ACCEPTABLE TO REPLACE MANUFACTURER SUPPLIED INSTRUMENT TUBING WITH PG&E SUPPLIED S-SPEC STAINLESS STEEL TUBING
 - FIELD PIPING ON THIS SYSTEM SHALL BE PG&E CLASS C UNLESS OTHERWISE NOTED
 - AIR RECEIVER OUTLET STRAINERS BE INSTALLED HORIZONTALLY >47-B,C
 - MOUNTED ON ENGINE CONTROL PANEL >48-C
 - ALL VALVES ON THIS SHEET WITH PG&E ITEM NOS. SHALL BE UNDER SPEC. 8729 (DWG 108039), UNLESS OTHERWISE NOTED >45/46/47-B,C&D
 - ORIFICED SLIDER SHOWN IN POSITION CONTROLLING FLOWRATE FOR DRYER REGENERATION. >42-C
 - N.O. AIR TO CLOSE >42-C
N.C. AIR TO OPEN
 - IF GLOBE VALVES ARE INSTALLED, THE PREFERRED ORIENTATION IS WITH THE FLOW ARROW INDICATING FLOW TOWARDS THE AIR COMPRESSOR. >45-C
 - CHECK VALVE PER DC 6006473-169, S/C 94-3815 >45-C
 - FIBERGLASS BLANKET TYPE PERSONNEL PROTECTION INSULATION. >40-D

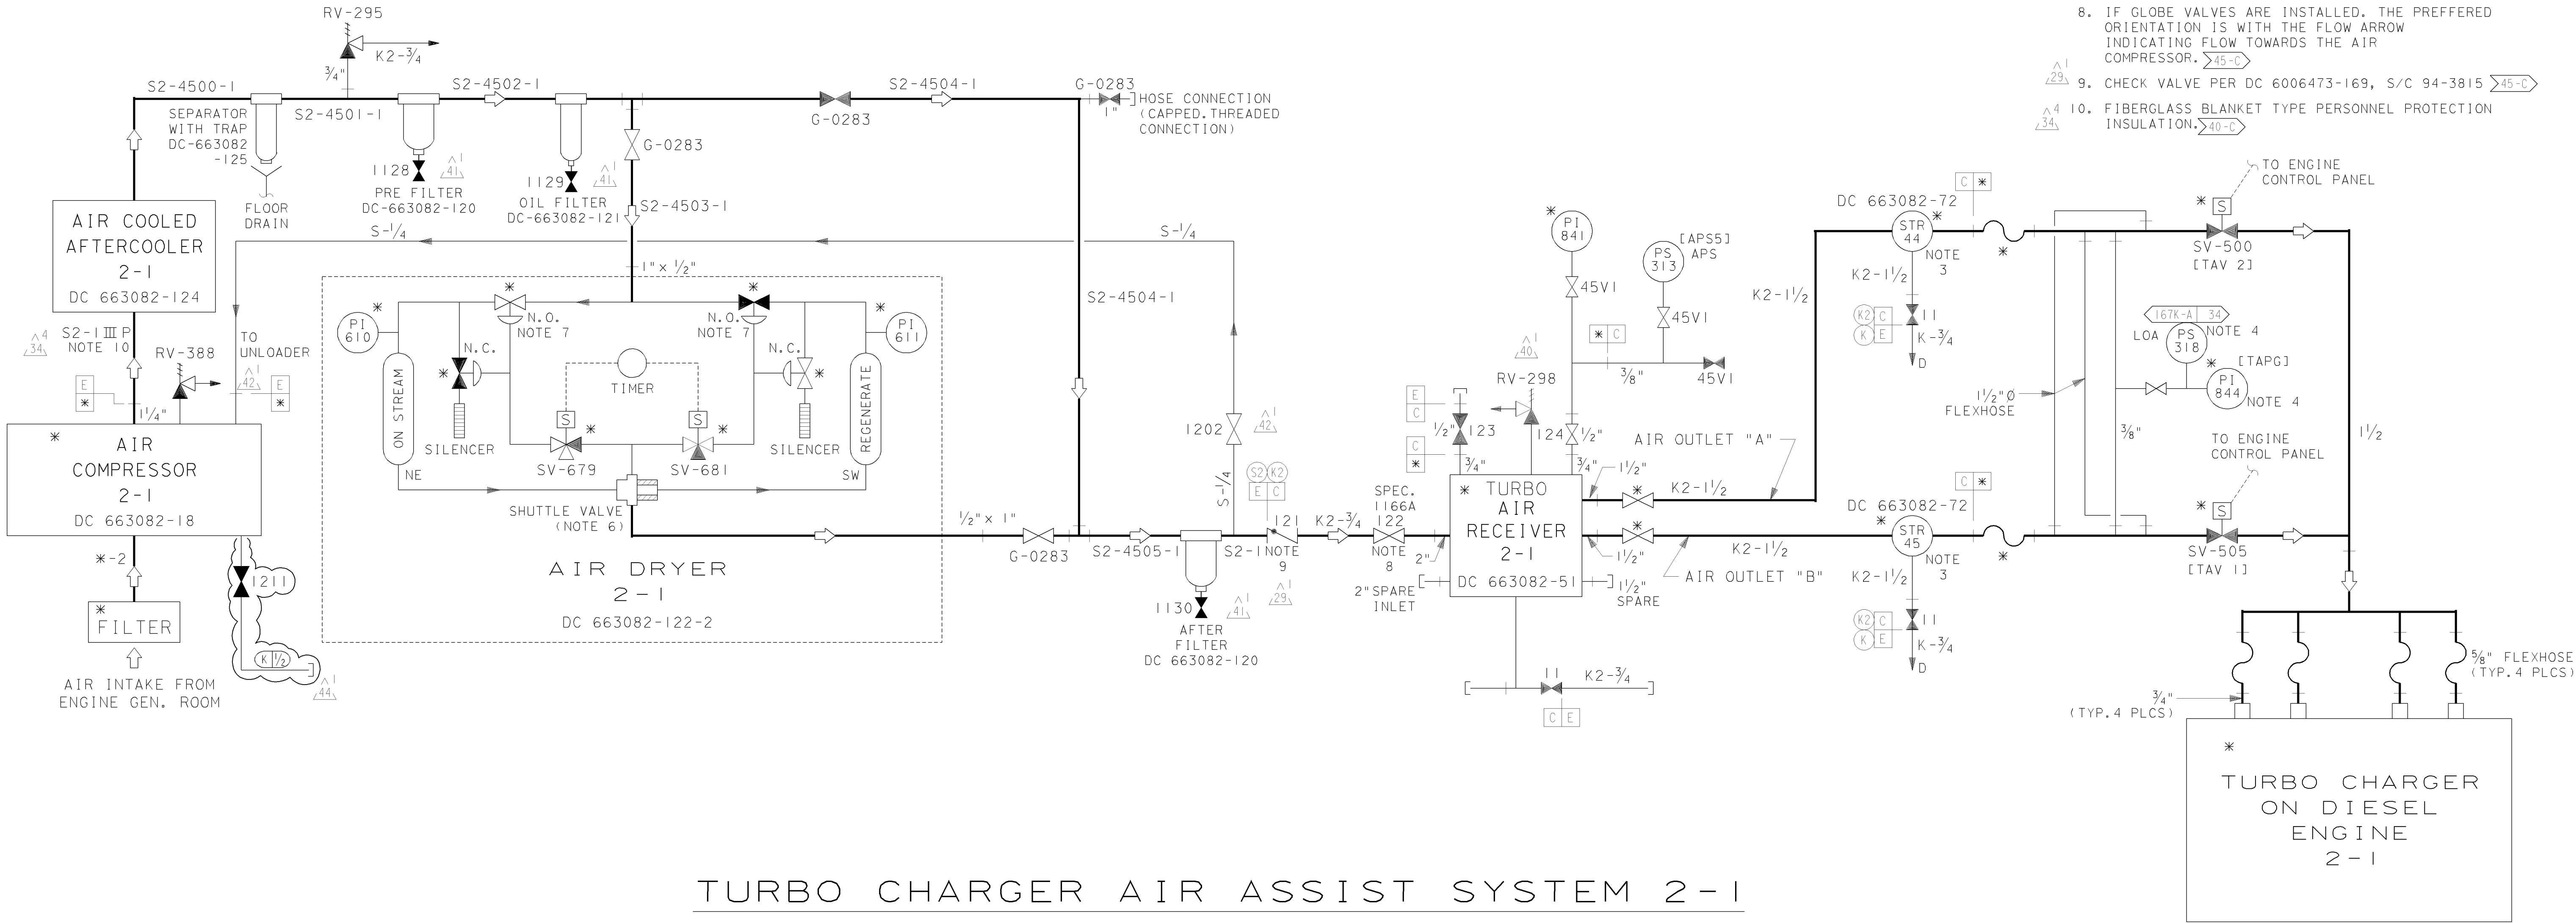

TURBO CHARGER AIR ASSIST SYSTEM 2-1

REFERENCE MFR. DWG. DC-663082-31

UNIT 2

DIABLO CANYON POWER PLANT - PG&E CO.
DIESEL ENGINE-GENERATOR ASSOCIATED SYSTEMS

DRAWING	SHEET	PAGE	REV
108021	4	0	44

10-10-2011	AJFJ	RxG2		KERSI J. DALAL	MECHANICAL	M 16690	3/31/2012	REVISED PER DFT-7*1303
DATE	DWN	RE	1V	PROFESSIONAL ENGINEER	PE DISC.	PE#	PE EXP.	

RASTER=108021.s4.dgn
DCN=108021.s4.dgn
CAD User:TAJFJ D07e: 10-10-2011

3 5126

A

B

C

D

E

A

B

C

D

E

CAD User: AJL2 Date: 12-16-2003
DGN: 802155.DGN

3/16/2010

50

51

52

53

54

55

56


57

58

59

NOTES:

1. INDICATES PG&E PIPING CODE CLASS
2. * DENOTES MANUFACTURER SUPPLIED INSTRUMENTS & EQUIPMENT. IT IS ACCEPTABLE TO REPLACE MANUFACTURER SUPPLIED INSTRUMENT TUBING WITH PG&E SUPPLIED S-SPEC STAINLESS STEEL TUBING
3. [] MANUFACTURER NUMBER IDENTIFICATION
4. ** PIPING TO BE INSTALLED UNDER SPEC.8711 & PROVIDED UNDER DC-663084-1 51/52-B, C&D
5. MOUNTED ON ENGINE CONTROL PANEL 58-C
6. DIESEL GENERATOR EXHAUST SILENCER SEISMICALLY QUALIFIED FOR HOSGRI CRITERIA. EQUIPMENT SUPPORTS FOR THE DIESEL GENERATOR EXHAUST SILENCER SEISMICALLY QUALIFIED IN ACCORDANCE WITH DESIGN CRITERIA MEMORANDUM M-72 54-C

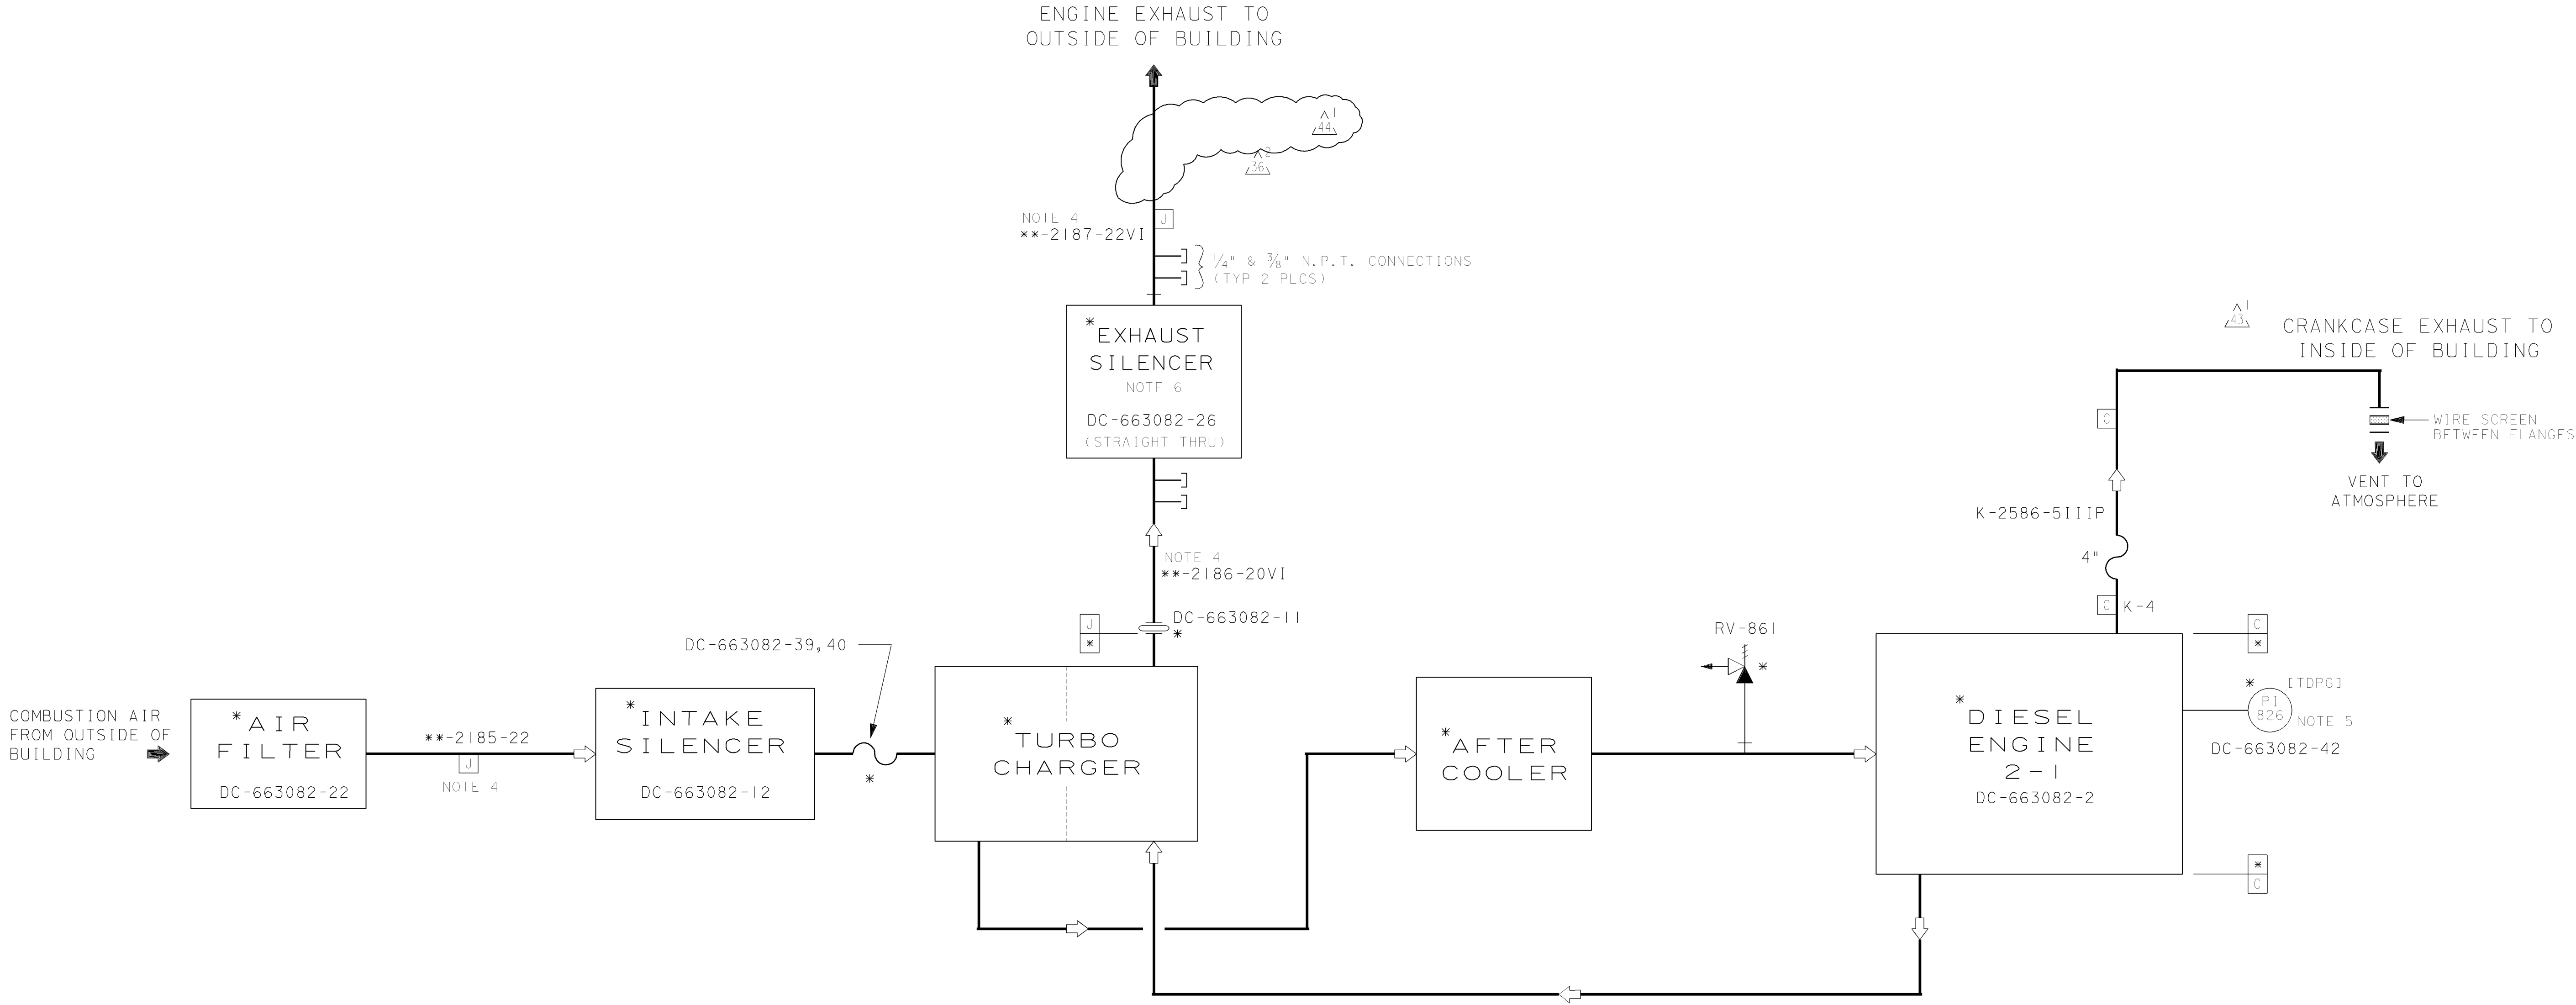

COMBUSTION AIR AND EXHAUST SYSTEM 2-1

UNIT 2

P G & E CO.		108021	REV.
SHEET 5	PAGE 0		44

12/17/03	AJL2	RMD1	-	KERSI J. DALAL	MECHANICAL	M 16690	3/31/2004	Revised per FCT 028077
DATE	DWN	RE	IV	PROFESSIONAL ENGINEER	PE DISC.	PE#	PE EXP.	

A

B

C

D

E


A

B

C

D

E

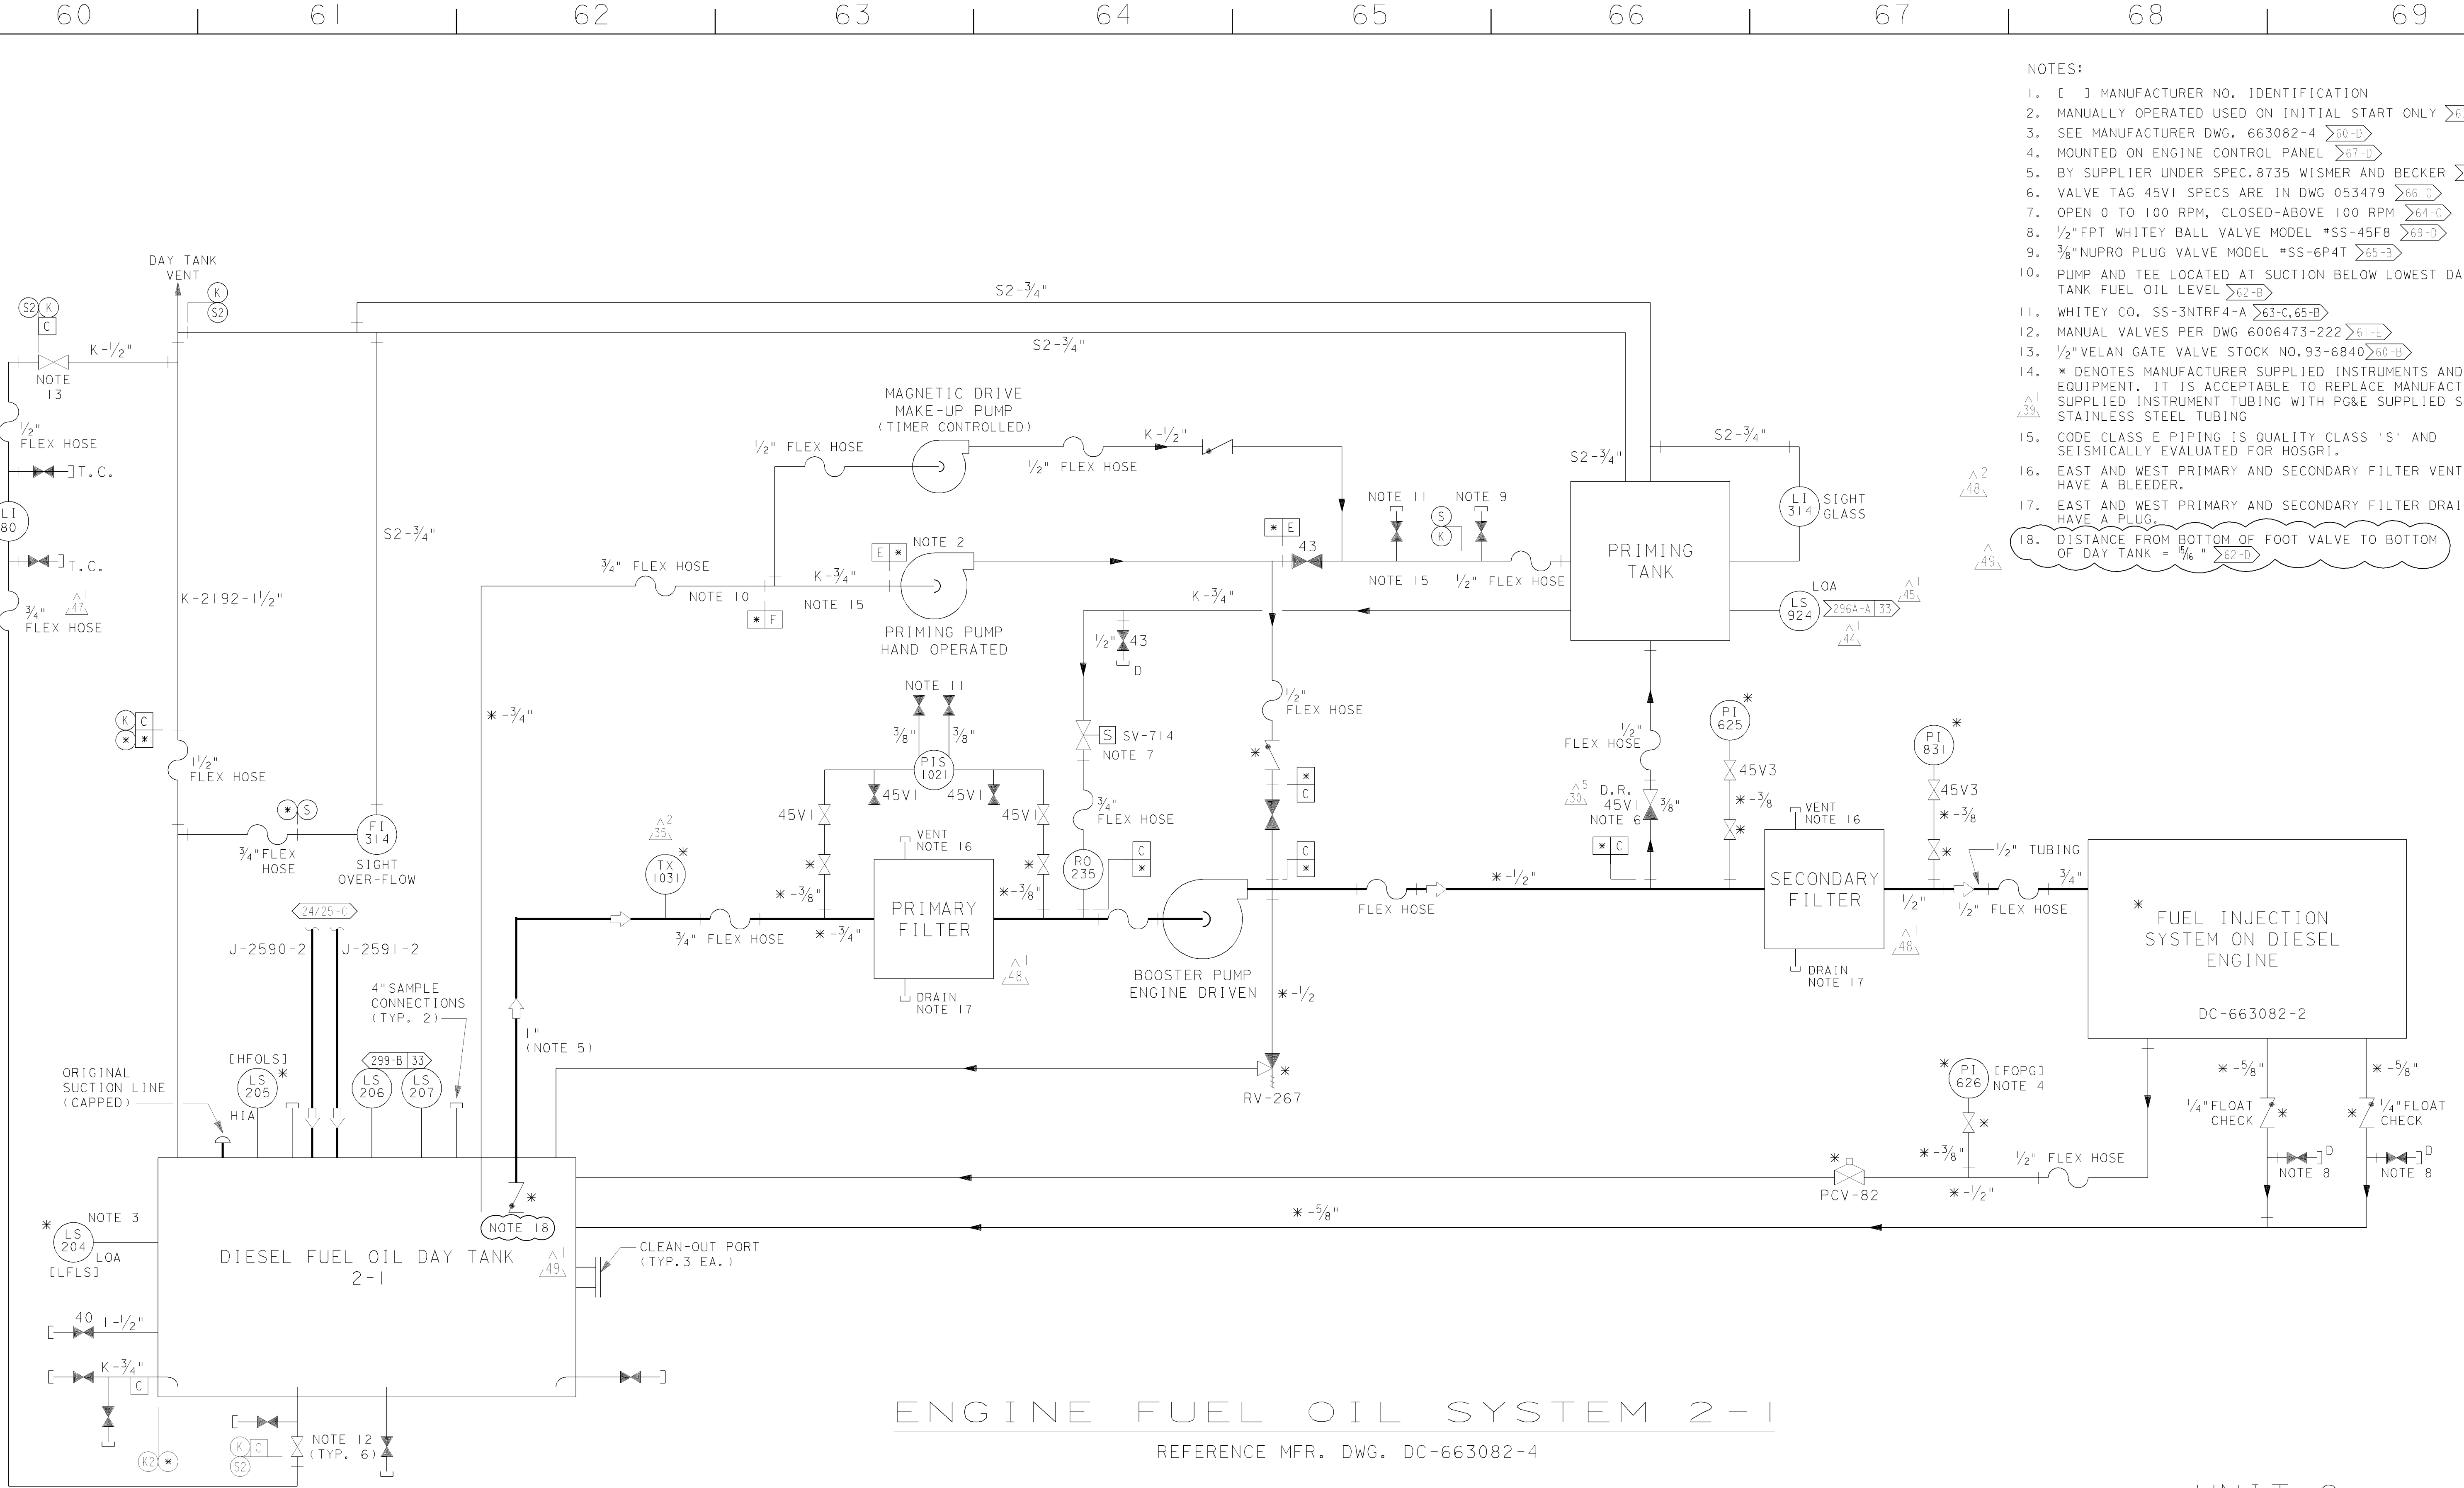

- NOTES:
- [] MANUFACTURER NO. IDENTIFICATION
 - MANUALLY OPERATED USED ON INITIAL START ONLY >63-B
 - SEE MANUFACTURER DWG. 663082-4 >60-D
 - MOUNTED ON ENGINE CONTROL PANEL >67-D
 - BY SUPPLIER UNDER SPEC.8735 WISMER AND BECKER >62-D
 - VALVE TAG 45VI SPECS ARE IN DWG 053479 >66-C
 - OPEN 0 TO 100 RPM, CLOSED-ABOVE 100 RPM >64-C
 - 1/2" FPT WHITEY BALL VALVE MODEL #SS-45F8 >69-D
 - 3/8"NUPRO PLUG VALVE MODEL #SS-6P4T >65-B
 - PUMP AND TEE LOCATED AT SUCTION BELOW LOWEST DAY TANK FUEL OIL LEVEL >62-B
 - WHITEY CO. SS-3NTRF4-A >63-C,65-B
 - MANUAL VALVES PER DWG 6006473-222 >61-E
 - 1/2"VELAN GATE VALVE STOCK NO.93-6840 >60-B
 - * DENOTES MANUFACTURER SUPPLIED INSTRUMENTS AND EQUIPMENT. IT IS ACCEPTABLE TO REPLACE MANUFACTURER SUPPLIED INSTRUMENT TUBING WITH PG&E SUPPLIED S-SPEC STAINLESS STEEL TUBING
 - CODE CLASS E PIPING IS QUALITY CLASS 'S' AND SEISMICALLY EVALUATED FOR HOSGR1.
 - EAST AND WEST PRIMARY AND SECONDARY FILTER VENTS HAVE A BLEEDER.
 - EAST AND WEST PRIMARY AND SECONDARY FILTER DRAINS HAVE A PLUG.
 - DISTANCE FROM BOTTOM OF FOOT VALVE TO BOTTOM OF DAY TANK = 19/16" >62-D

ENGINE FUEL OIL SYSTEM 2-1
REFERENCE MFR. DWG. DC-663082-4

UNIT 2

DIABLO CANYON POWER PLANT - PG&E CO. DIESEL ENGINE-GENERATOR ASSOCIATED SYSTEMS			
DRAWING	SHEET	PAGE	REV
108021	6	0	49

01-03-2013	AJFJ	FxC2		KERSI J. DALAL	MECHANICAL	M 16690	3/31/2014	REVISED PER DFT-7*1941
DATE	DWN	RE	1V	PROFESSIONAL ENGINEER	PE DISC.	PE#	PE EXP.	

RASTER=108021s6.dgn
DCN=108021s6.dgn
CAD User:TAJFJ Date: 01-03-2013

A

B

C

D


A

B

C

D

E

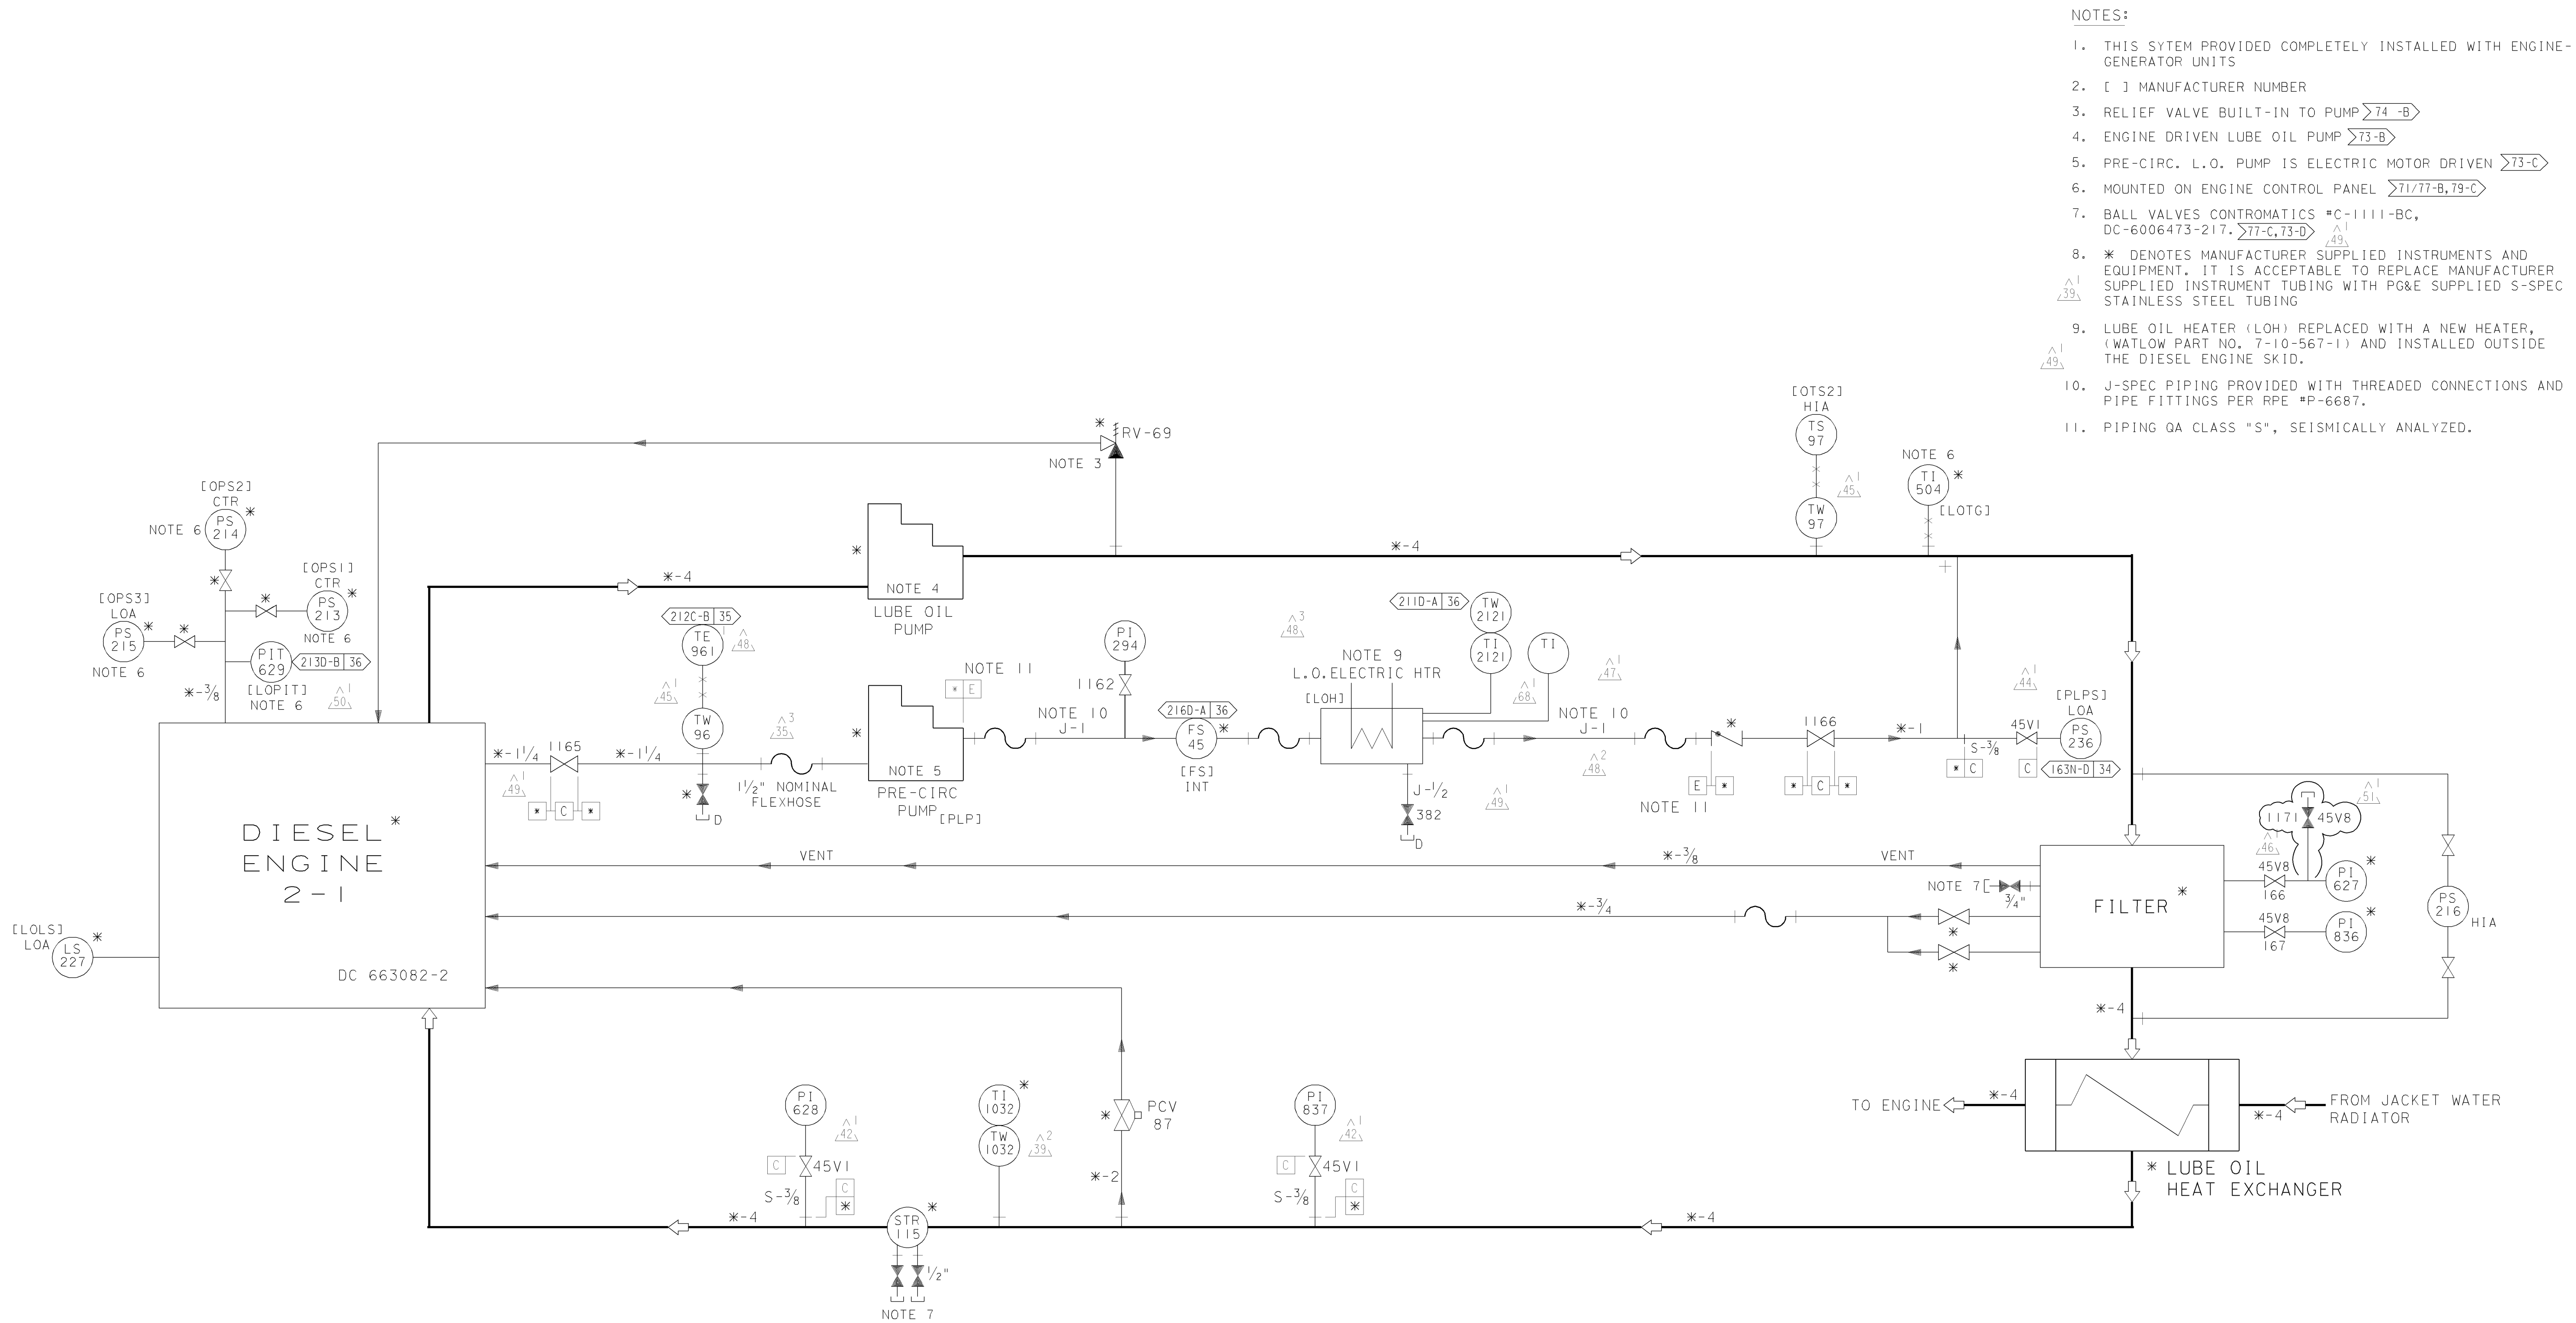

- NOTES:
1. THIS SYTEM PROVIDED COMPLETELY INSTALLED WITH ENGINE-GENERATOR UNITS
 2. [] MANUFACTURER NUMBER
 3. RELIEF VALVE BUILT-IN TO PUMP 74-B
 4. ENGINE DRIVEN LUBE OIL PUMP 73-B
 5. PRE-CIRC. L.O. PUMP IS ELECTRIC MOTOR DRIVEN 73-C
 6. MOUNTED ON ENGINE CONTROL PANEL 71/77-B,79-C
 7. BALL VALVES CONTROMATICS *C-1111-BC, DC-6006473-217. 77-C,73-D
 8. * DENOTES MANUFACTURER SUPPLIED INSTRUMENTS AND EQUIPMENT. IT IS ACCEPTABLE TO REPLACE MANUFACTURER SUPPLIED INSTRUMENT TUBING WITH PG&E SUPPLIED S-SPEC STAINLESS STEEL TUBING
 9. LUBE OIL HEATER (LOH) REPLACED WITH A NEW HEATER, (WATLOW PART NO. 7-10-567-1) AND INSTALLED OUTSIDE THE DIESEL ENGINE SKID.
 10. J-SPEC PIPING PROVIDED WITH THREADED CONNECTIONS AND PIPE FITTINGS PER RPE *P-6687.
 11. PIPING QA CLASS "S", SEISMICALLY ANALYZED.

LUBE OIL SYSTEM 2-1
REFERENCE MFR. DWG. DC 663082-16

UNIT 2

DIABLO CANYON POWER PLANT - PG&E CO. DIESEL ENGINE GENERATOR SYSTEMS			
DRAWING	SHEET	PAGE	REV
108021	7	0	51

04-09-2010	GN07	AJL2		KERSI J. DALAL	MECHANICAL	M 16690	3/31/2012	REVISED PER DAS-6*298
DATE	DWN	RE	IV	PROFESSIONAL ENGINEER	PE DISC.	PE*	PE EXP.	

RASTER=108021\$7.DGN
DGN=108021\$7.DGN
CAD User: GN07 Date: 04-09-2010

A

B

C

D

E

A


B

C

D

E

- NOTES:
- THIS SYTEM PROVIDED COMPLETELY INSTALLED WITH ENGINE-GENERATOR UNITS
 - [] MANUFACTURER NUMBER
 - ENGINE DRIVEN JACKET WATER PUMP >83-C<
 - MOUNTED ON ENGINE CONTROL PANEL >83-D & 86-B<
 - SELF-CONTAINED CONTROL VALVE, FOR OPERATION SEE MANUFACTURER TECHNICAL MANUAL DC-663082-80>87-B< (VALVE SHOWN IN HOT POSITION)
 - PENBERTHY N7B-ST5 TUBULAR GAUGE GLASS VALVES >84-C<
 - CAP WITH SPRING RELIEF FOR VENT/VACUUM >85-B<
 - LUNKENHEIMER MODEL #123 >83-D<
 - * DENOTES MANUFACTURER SUPPLIED INSTRUMENTS AND EQUIPMENT. IT IS ACCEPTABLE TO REPLACE MANUFACTURER SUPPLIED INSTRUMENT TUBING WITH PG&E SUPPLIED S-SPEC STAINLESS STEEL TUBING

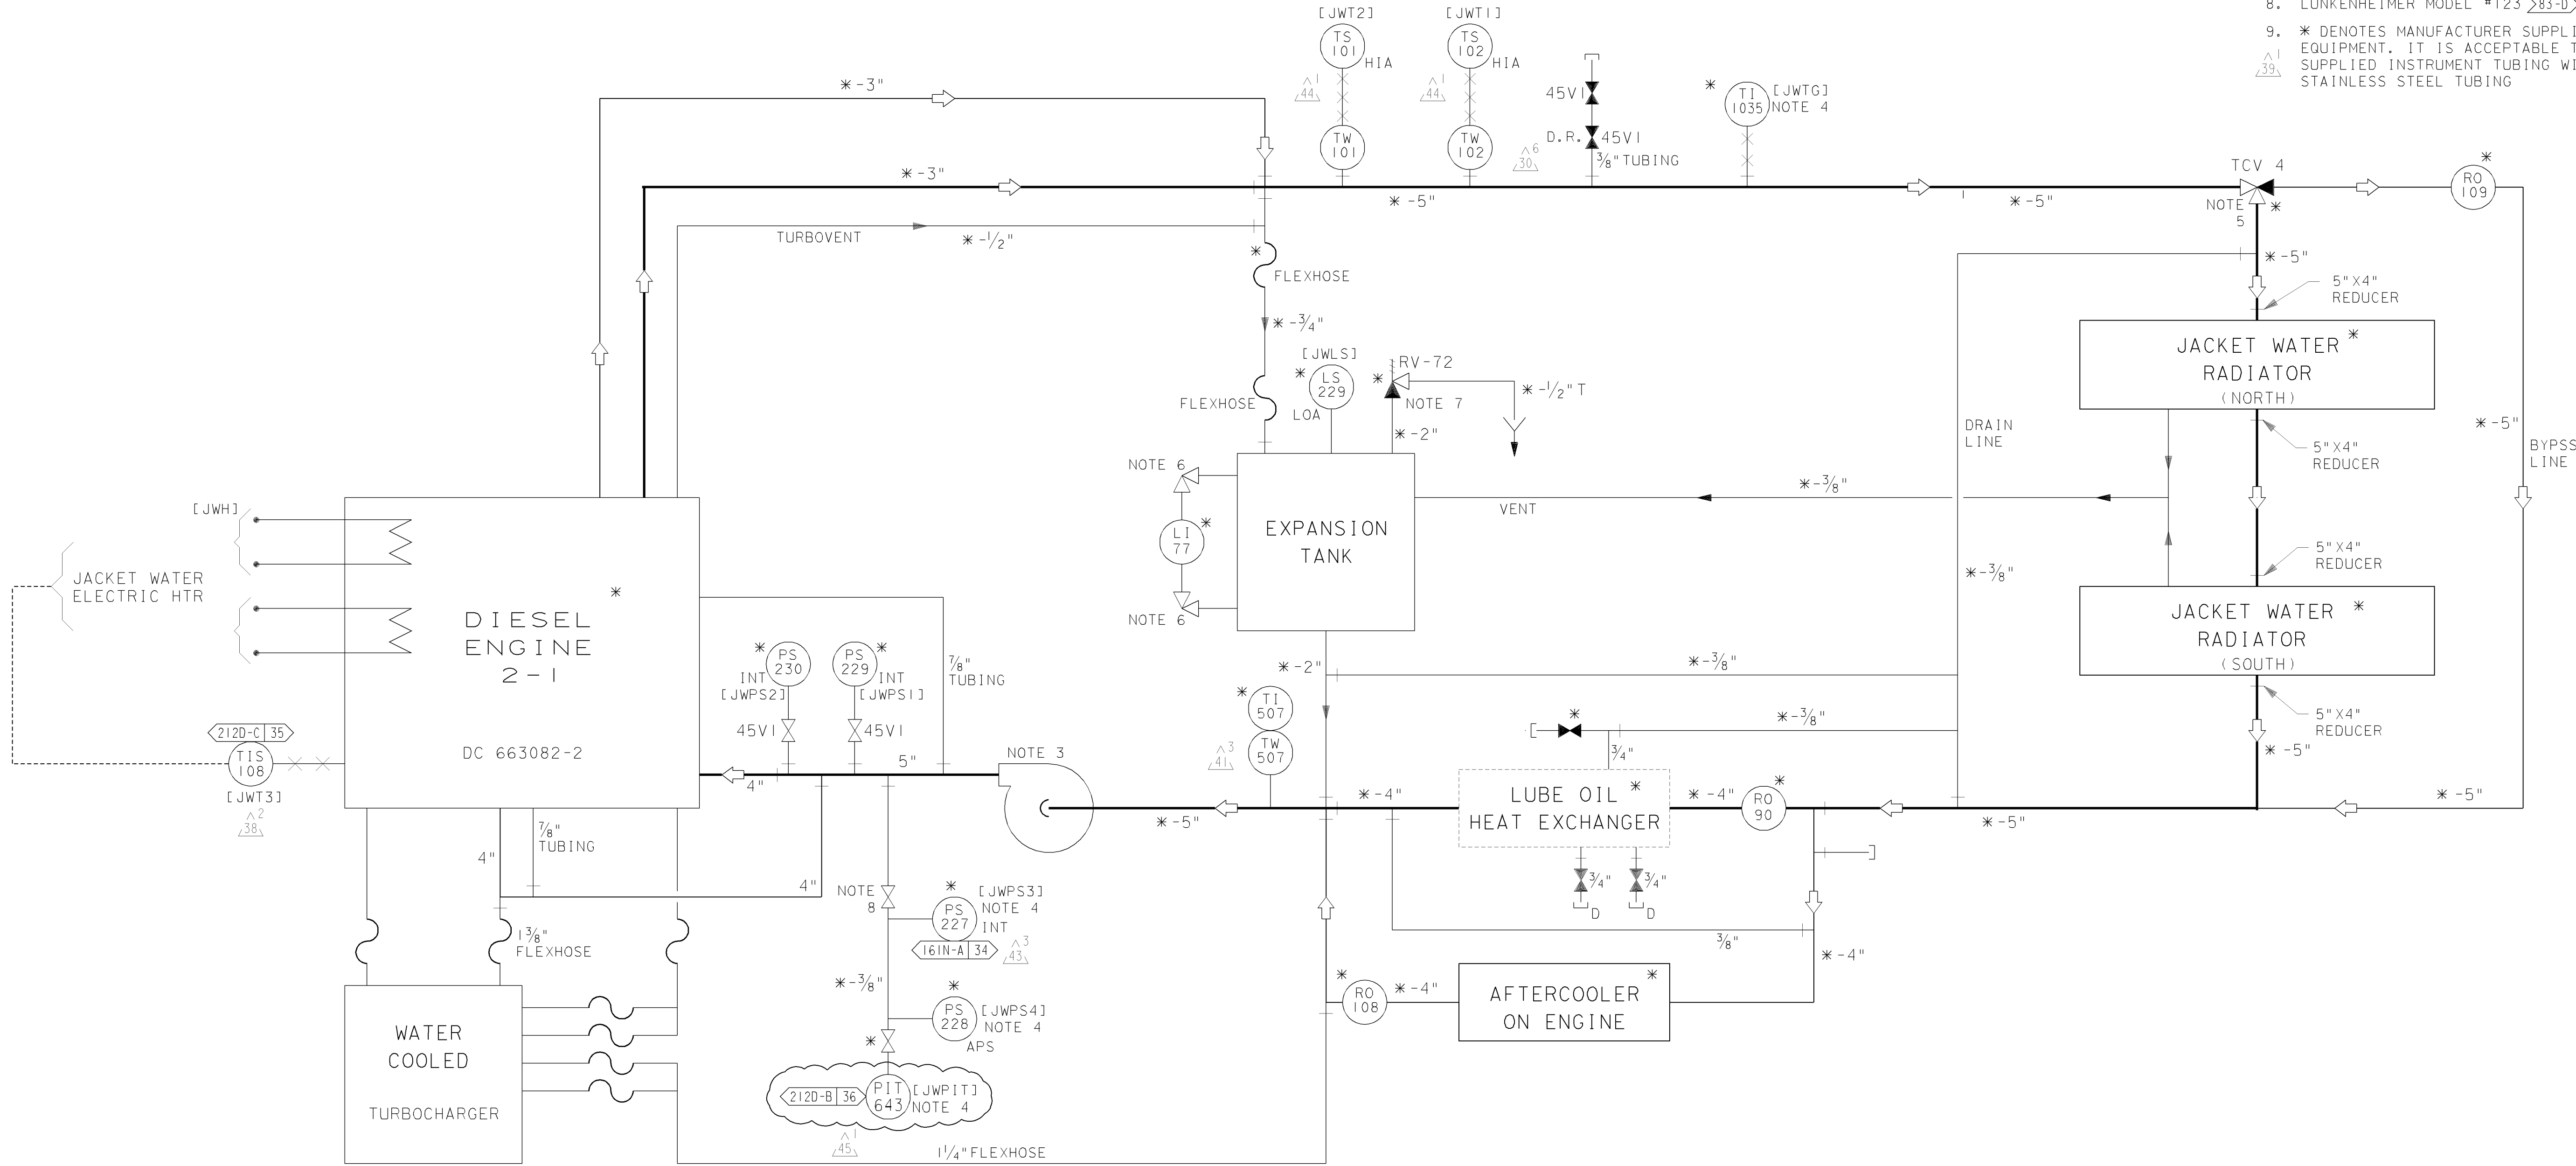

ENGINE JACKET WATER COOLING SYSTEM 2-1

REFERENCE MFR. DWG. DC-663082-17

UNIT 2


DIABLO CANYON POWER PLANT - PG&E CO.
DIESEL ENGINE-GENERATOR ASSOCIATED SYSTEMS

DRAWING	SHEET	PAGE	REV
108021	8	0	45

11-06-2008	RxG2	FxC2		ALAN GLEN BARTA	ELECTRICAL	E 9271	9/30/2009	REVISED PER DDN-2*77-0
DATE	DWN	RE	IV	PROFESSIONAL ENGINEER	PE DISC.	PE#	PE EXP.	

RASTER=108021s8.DGN
DGN=108021s8.DGN
CAD User: RxG2 Date: 11-06-2008

3 5128

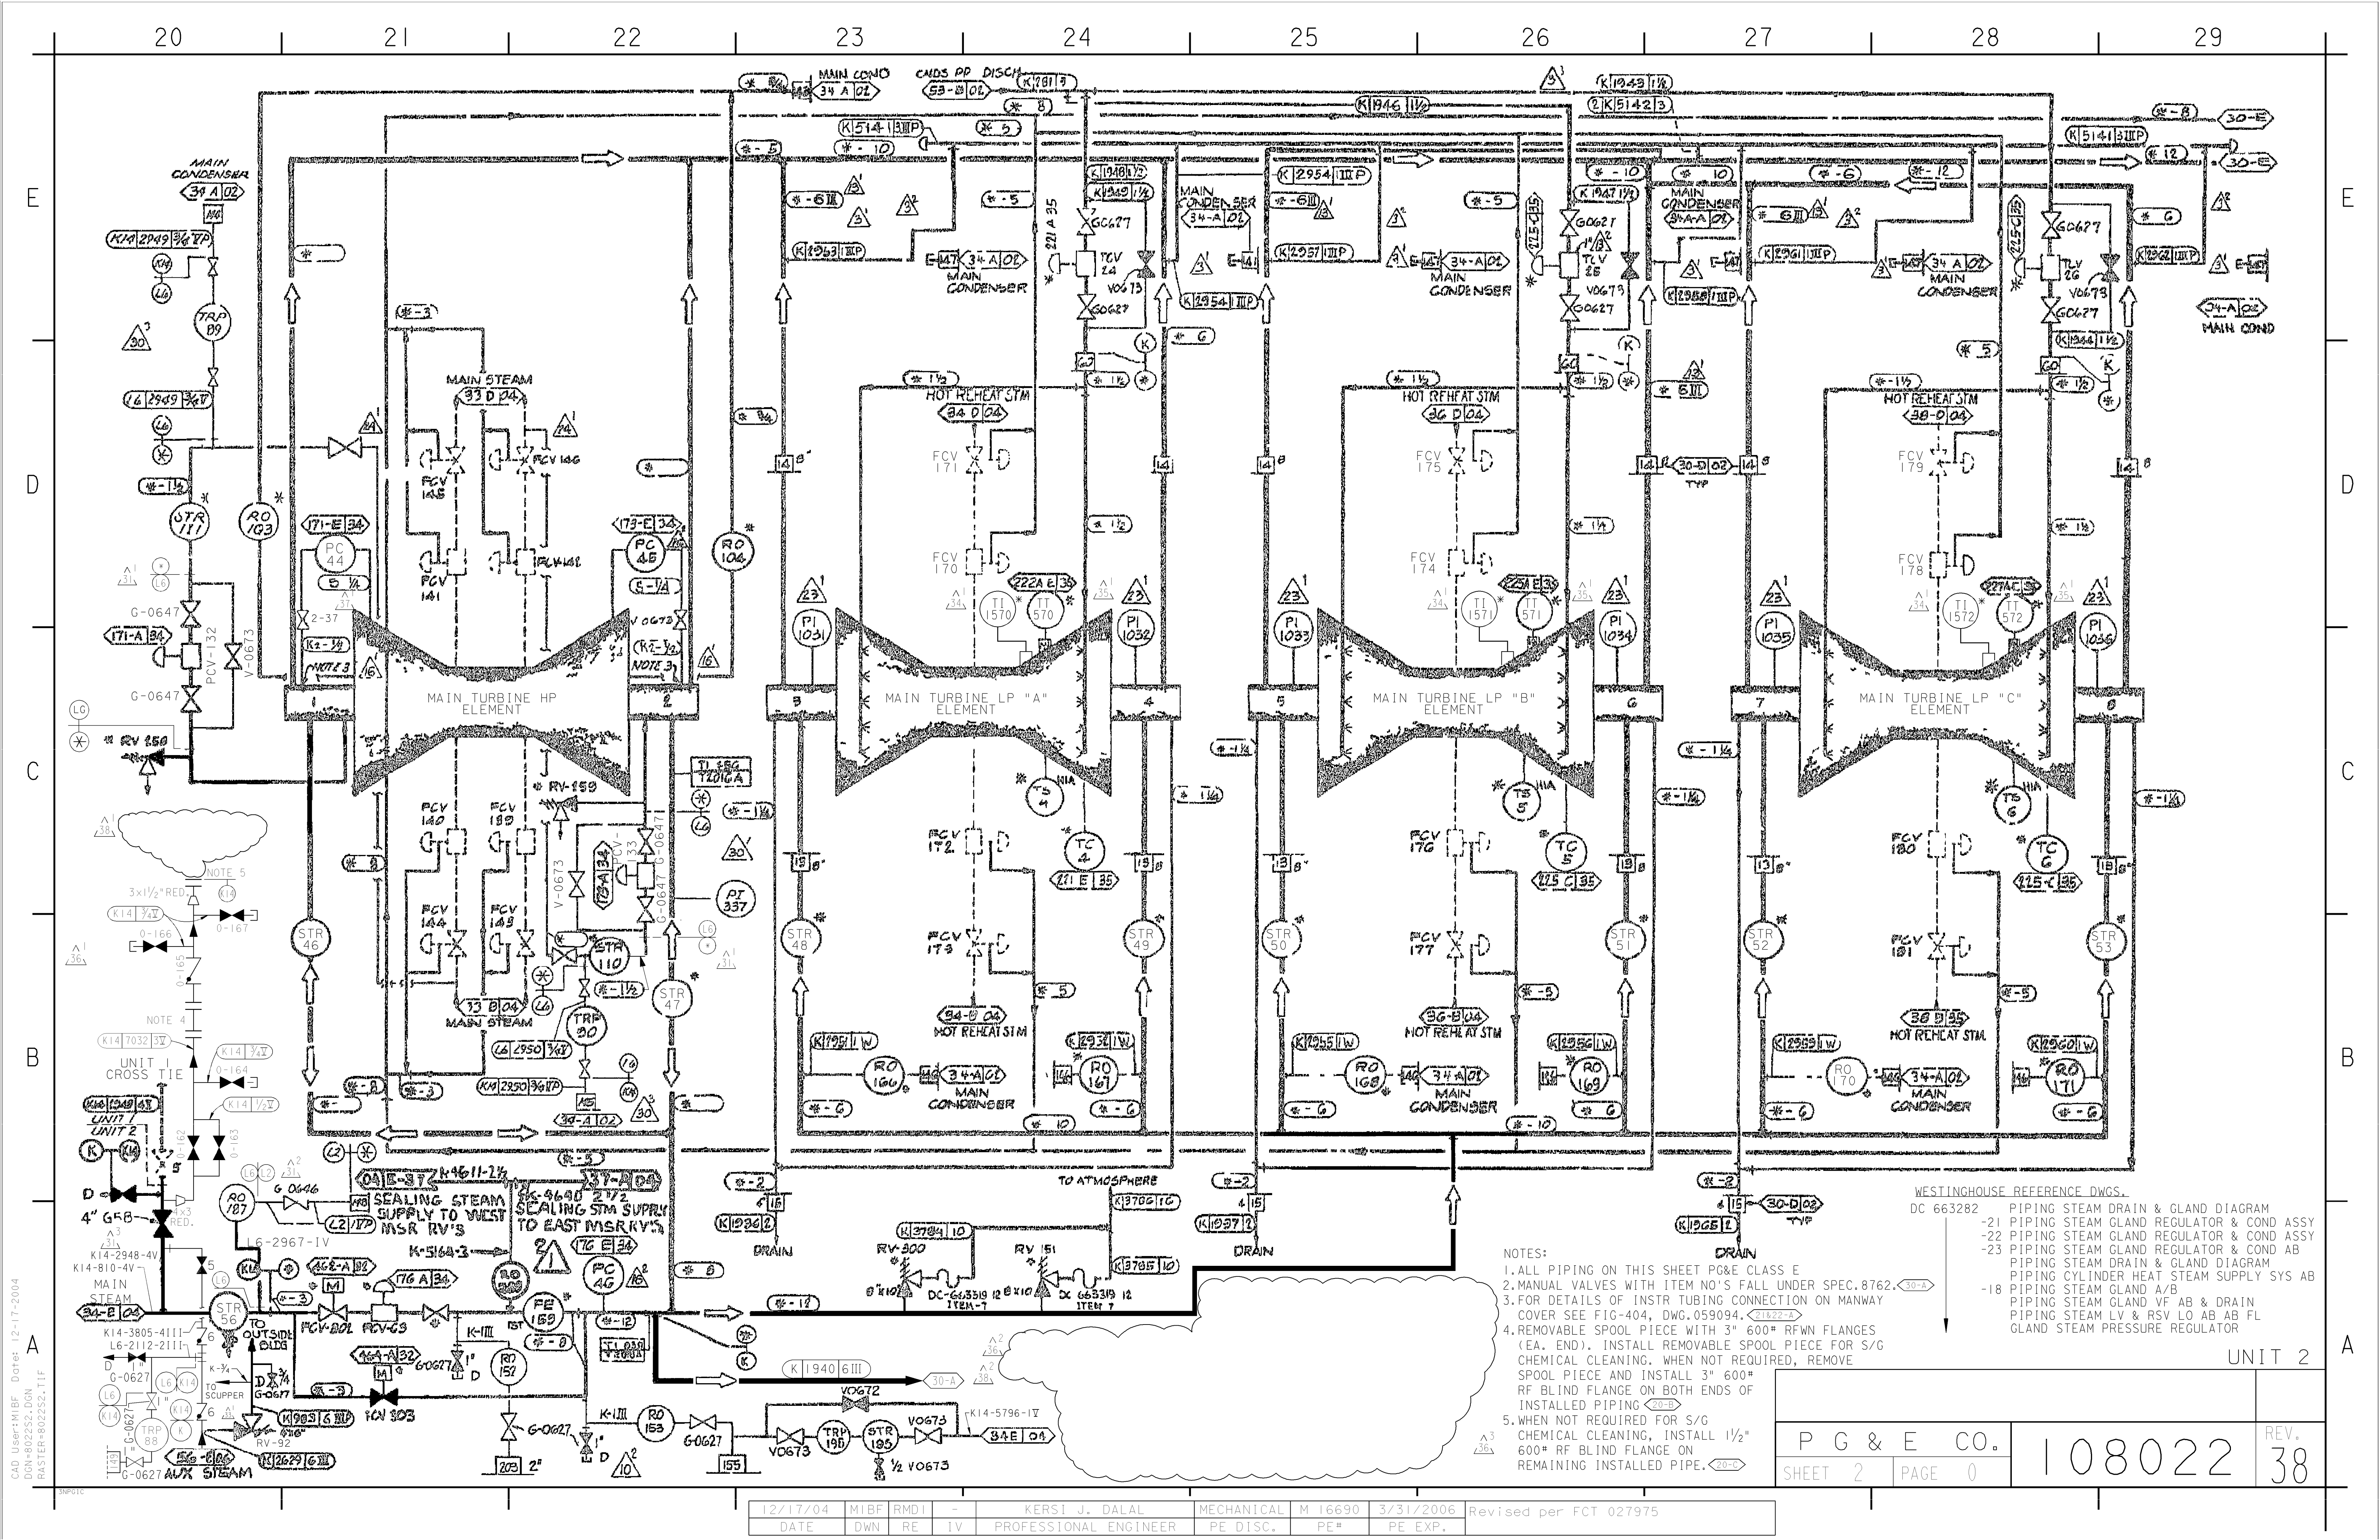

NOTES:

1. ALL PIPING ON THIS SHEET PG&E CLASS E
2. MANUAL VALVES WITH ITEM NO'S FALL UNDER SPEC. 8762.
3. FOR DETAILS OF INSTR TUBING CONNECTION ON MANWAY COVER SEE FIG-404, DWG. 059094.
4. REMOVABLE SPOOL PIECE WITH 3" 600# RFWN FLANGES (EA. END). INSTALL REMOVABLE SPOOL PIECE FOR S/G CHEMICAL CLEANING. WHEN NOT REQUIRED, REMOVE SPOOL PIECE AND INSTALL 3" 600# RF BLIND FLANGE ON BOTH ENDS OF INSTALLED PIPING
5. WHEN NOT REQUIRED FOR S/G CHEMICAL CLEANING, INSTALL 1 1/2" 600# RF BLIND FLANGE ON REMAINING INSTALLED PIPE.

WESTINGHOUSE REFERENCE DWGS.
DC 663282


- 21 PIPING STEAM DRAIN & GLAND DIAGRAM
- 22 PIPING STEAM GLAND REGULATOR & COND ASSY
- 23 PIPING STEAM GLAND REGULATOR & COND AB
- 18 PIPING STEAM DRAIN & GLAND DIAGRAM
- 18 PIPING STEAM GLAND A/B
- 18 PIPING STEAM GLAND VF AB & DRAIN
- 18 PIPING STEAM LV & RSV LO AB AB FL
- 18 GLAND STEAM PRESSURE REGULATOR


UNIT 2

P G & E CO.	108022	REV. 38
SHEET 2	PAGE 0	



UNIT 2

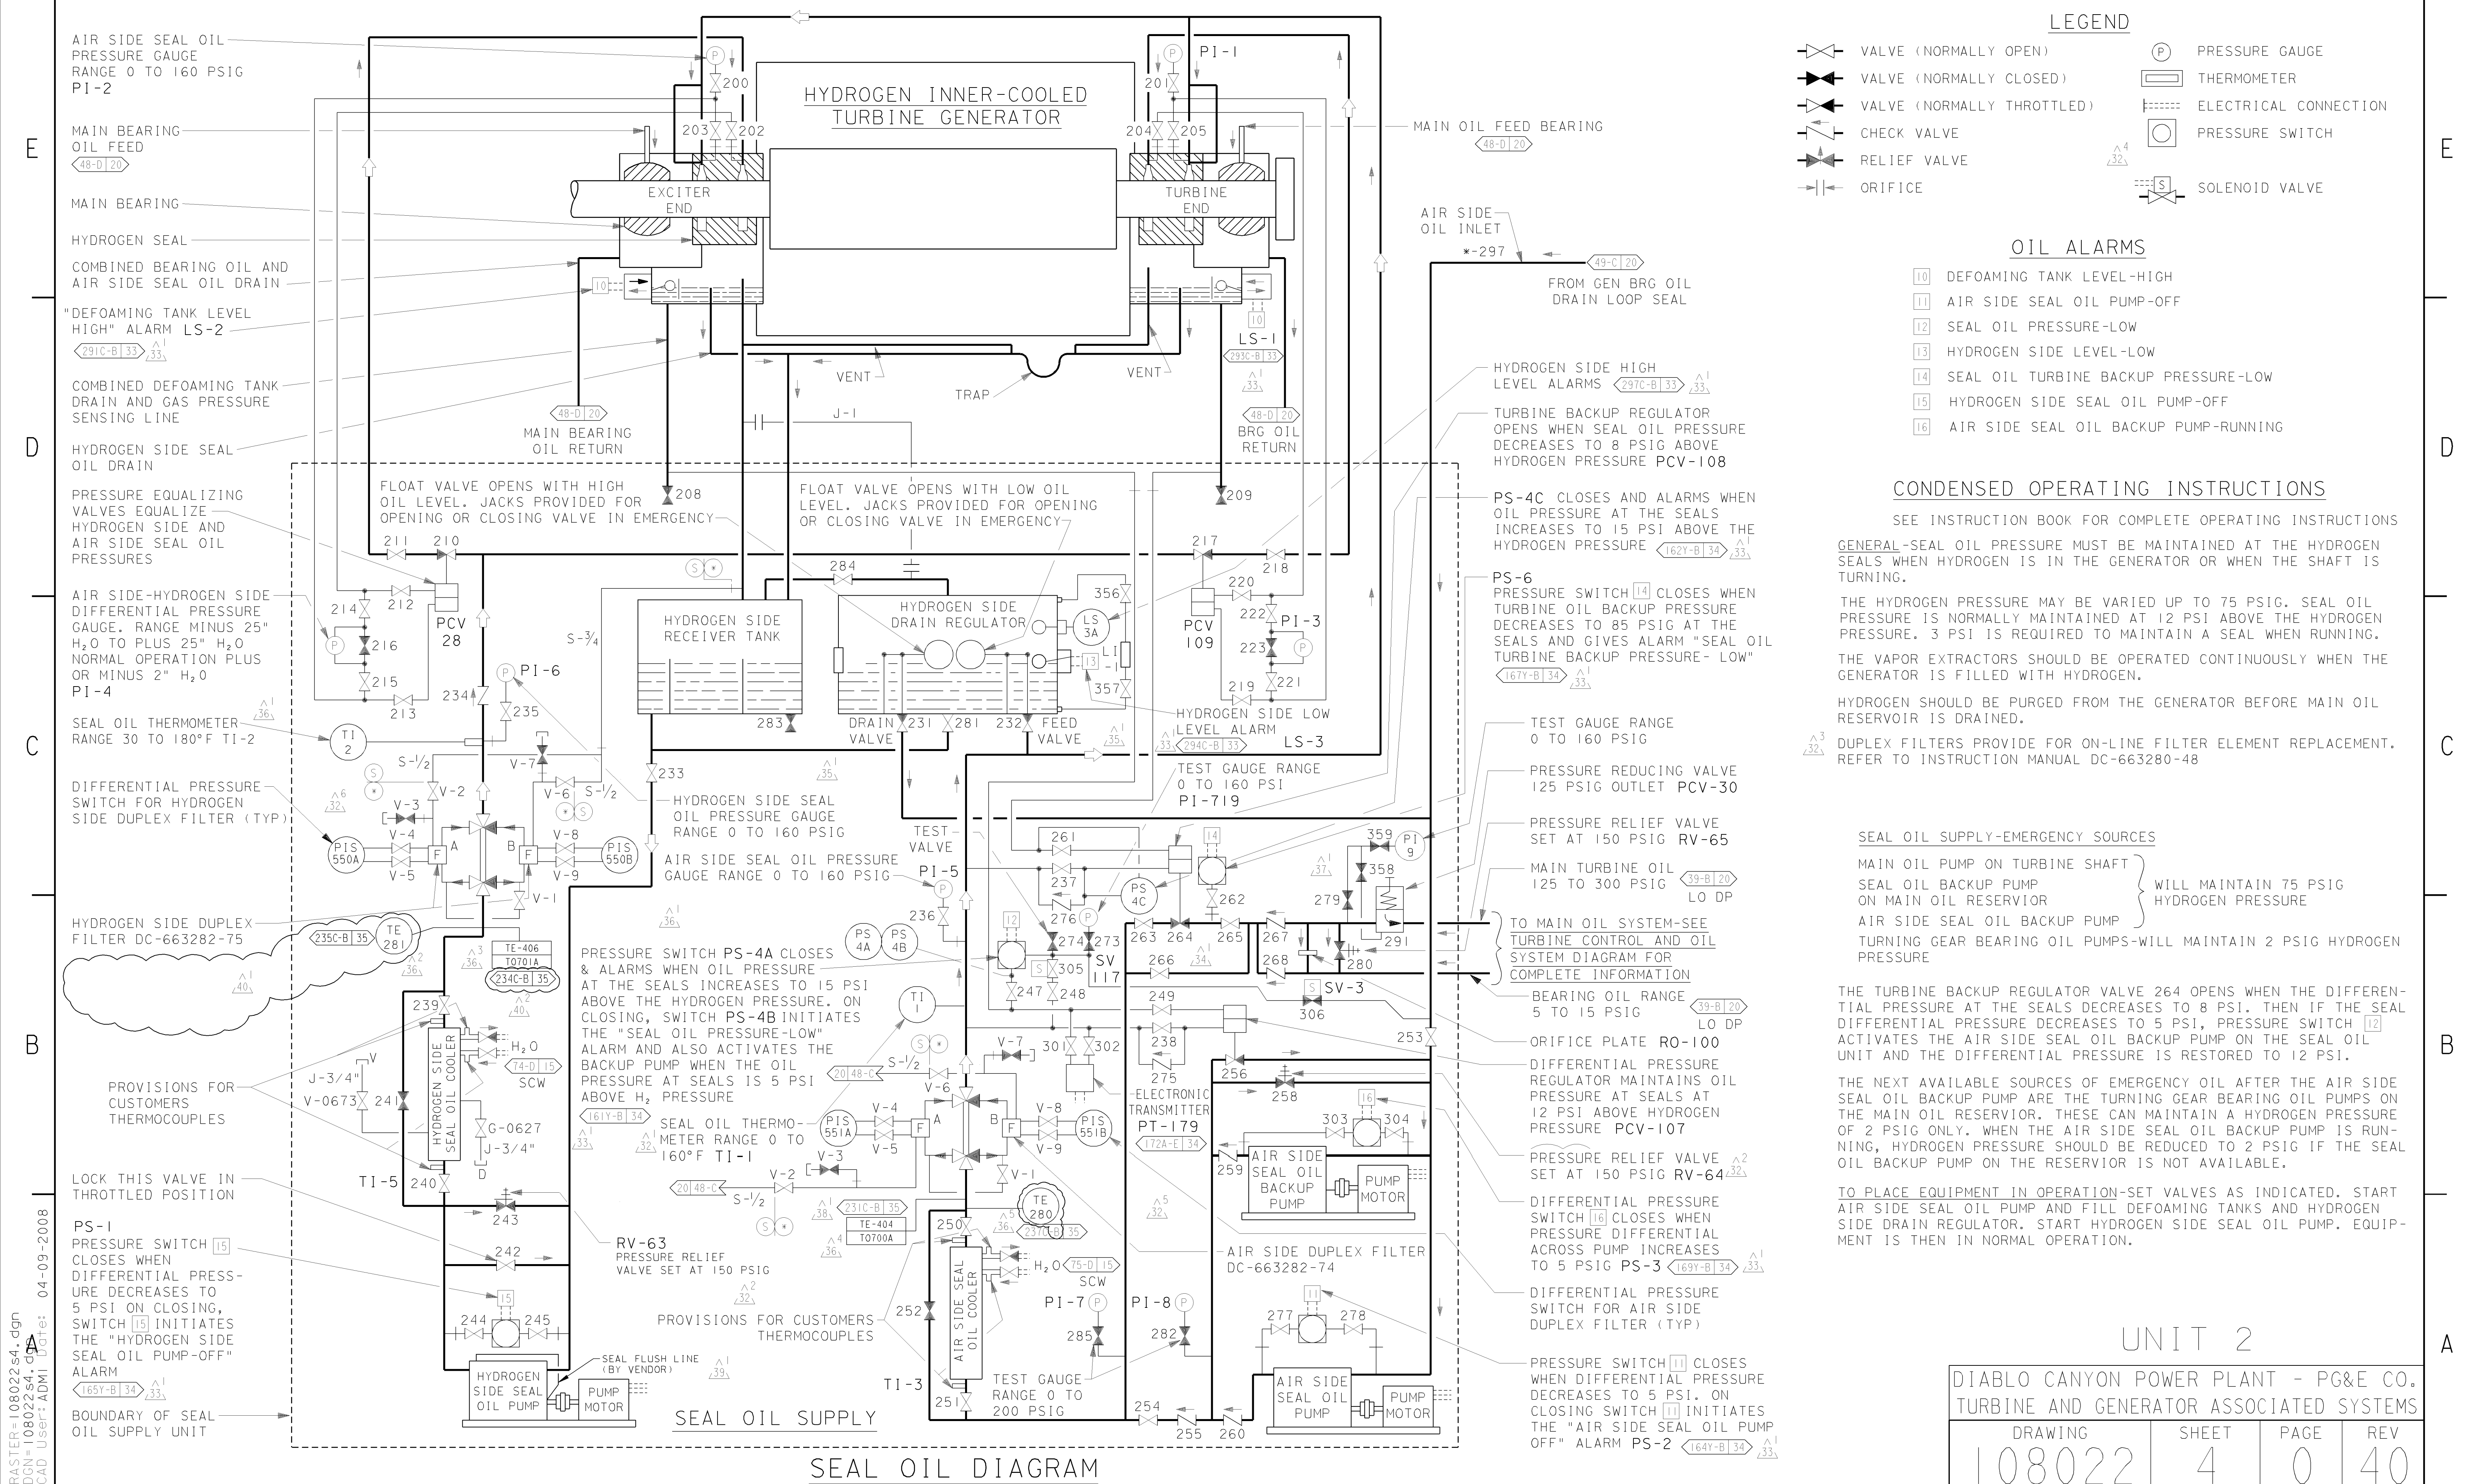

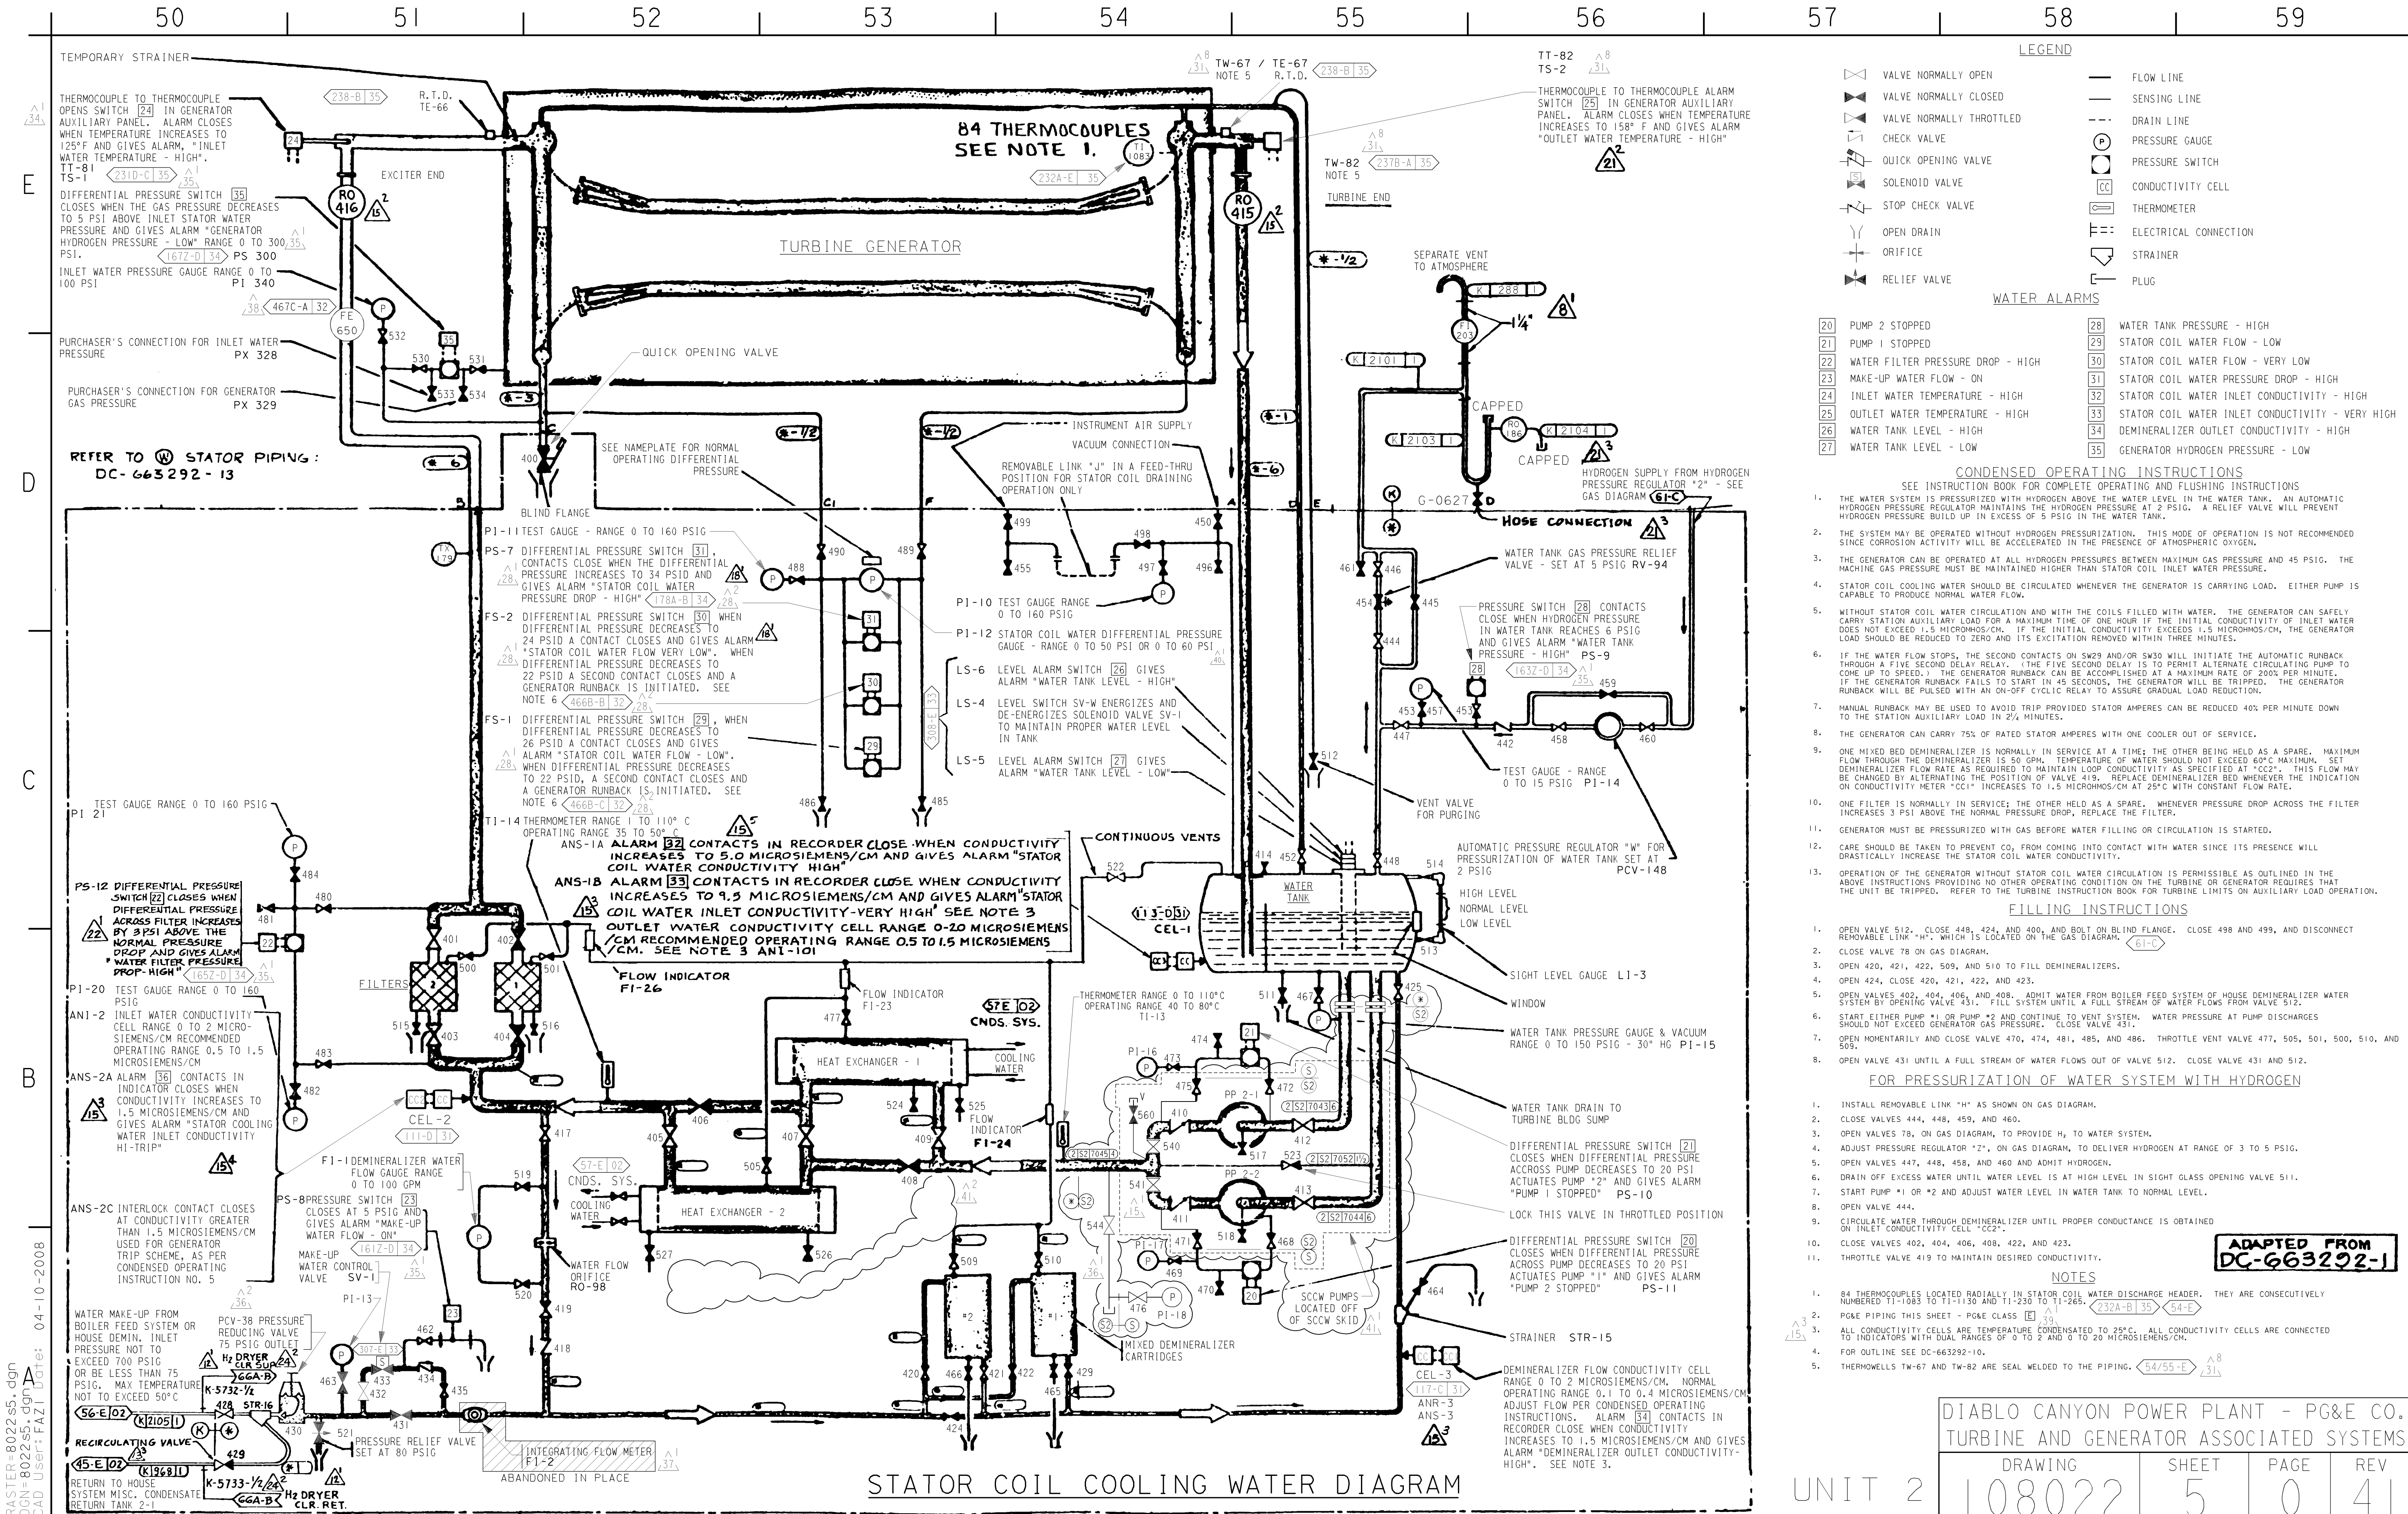

RASTER=802255.dgn
DCN=802255.dgn
CAD User: FAZI Date: 04-10-2008

04-10-2008	FAZI	FxC2	KERSI J. DALAL	MECHANICAL	M 16690	3/31/2010	REVISED PER DC2-SM-50841-00
DATE	DWN	RE	IV	PE DISC.	PE#	PE EXP.	

DIABLO CANYON POWER PLANT - PG&E CO.			
TURBINE AND GENERATOR ASSOCIATED SYSTEMS			
DRAWING	SHEET	PAGE	REV
108022	5	0	41

A

B

C

D

E

A


B

C

D

E

HYDROGEN INNER-COOLED TURBINE GENERATOR

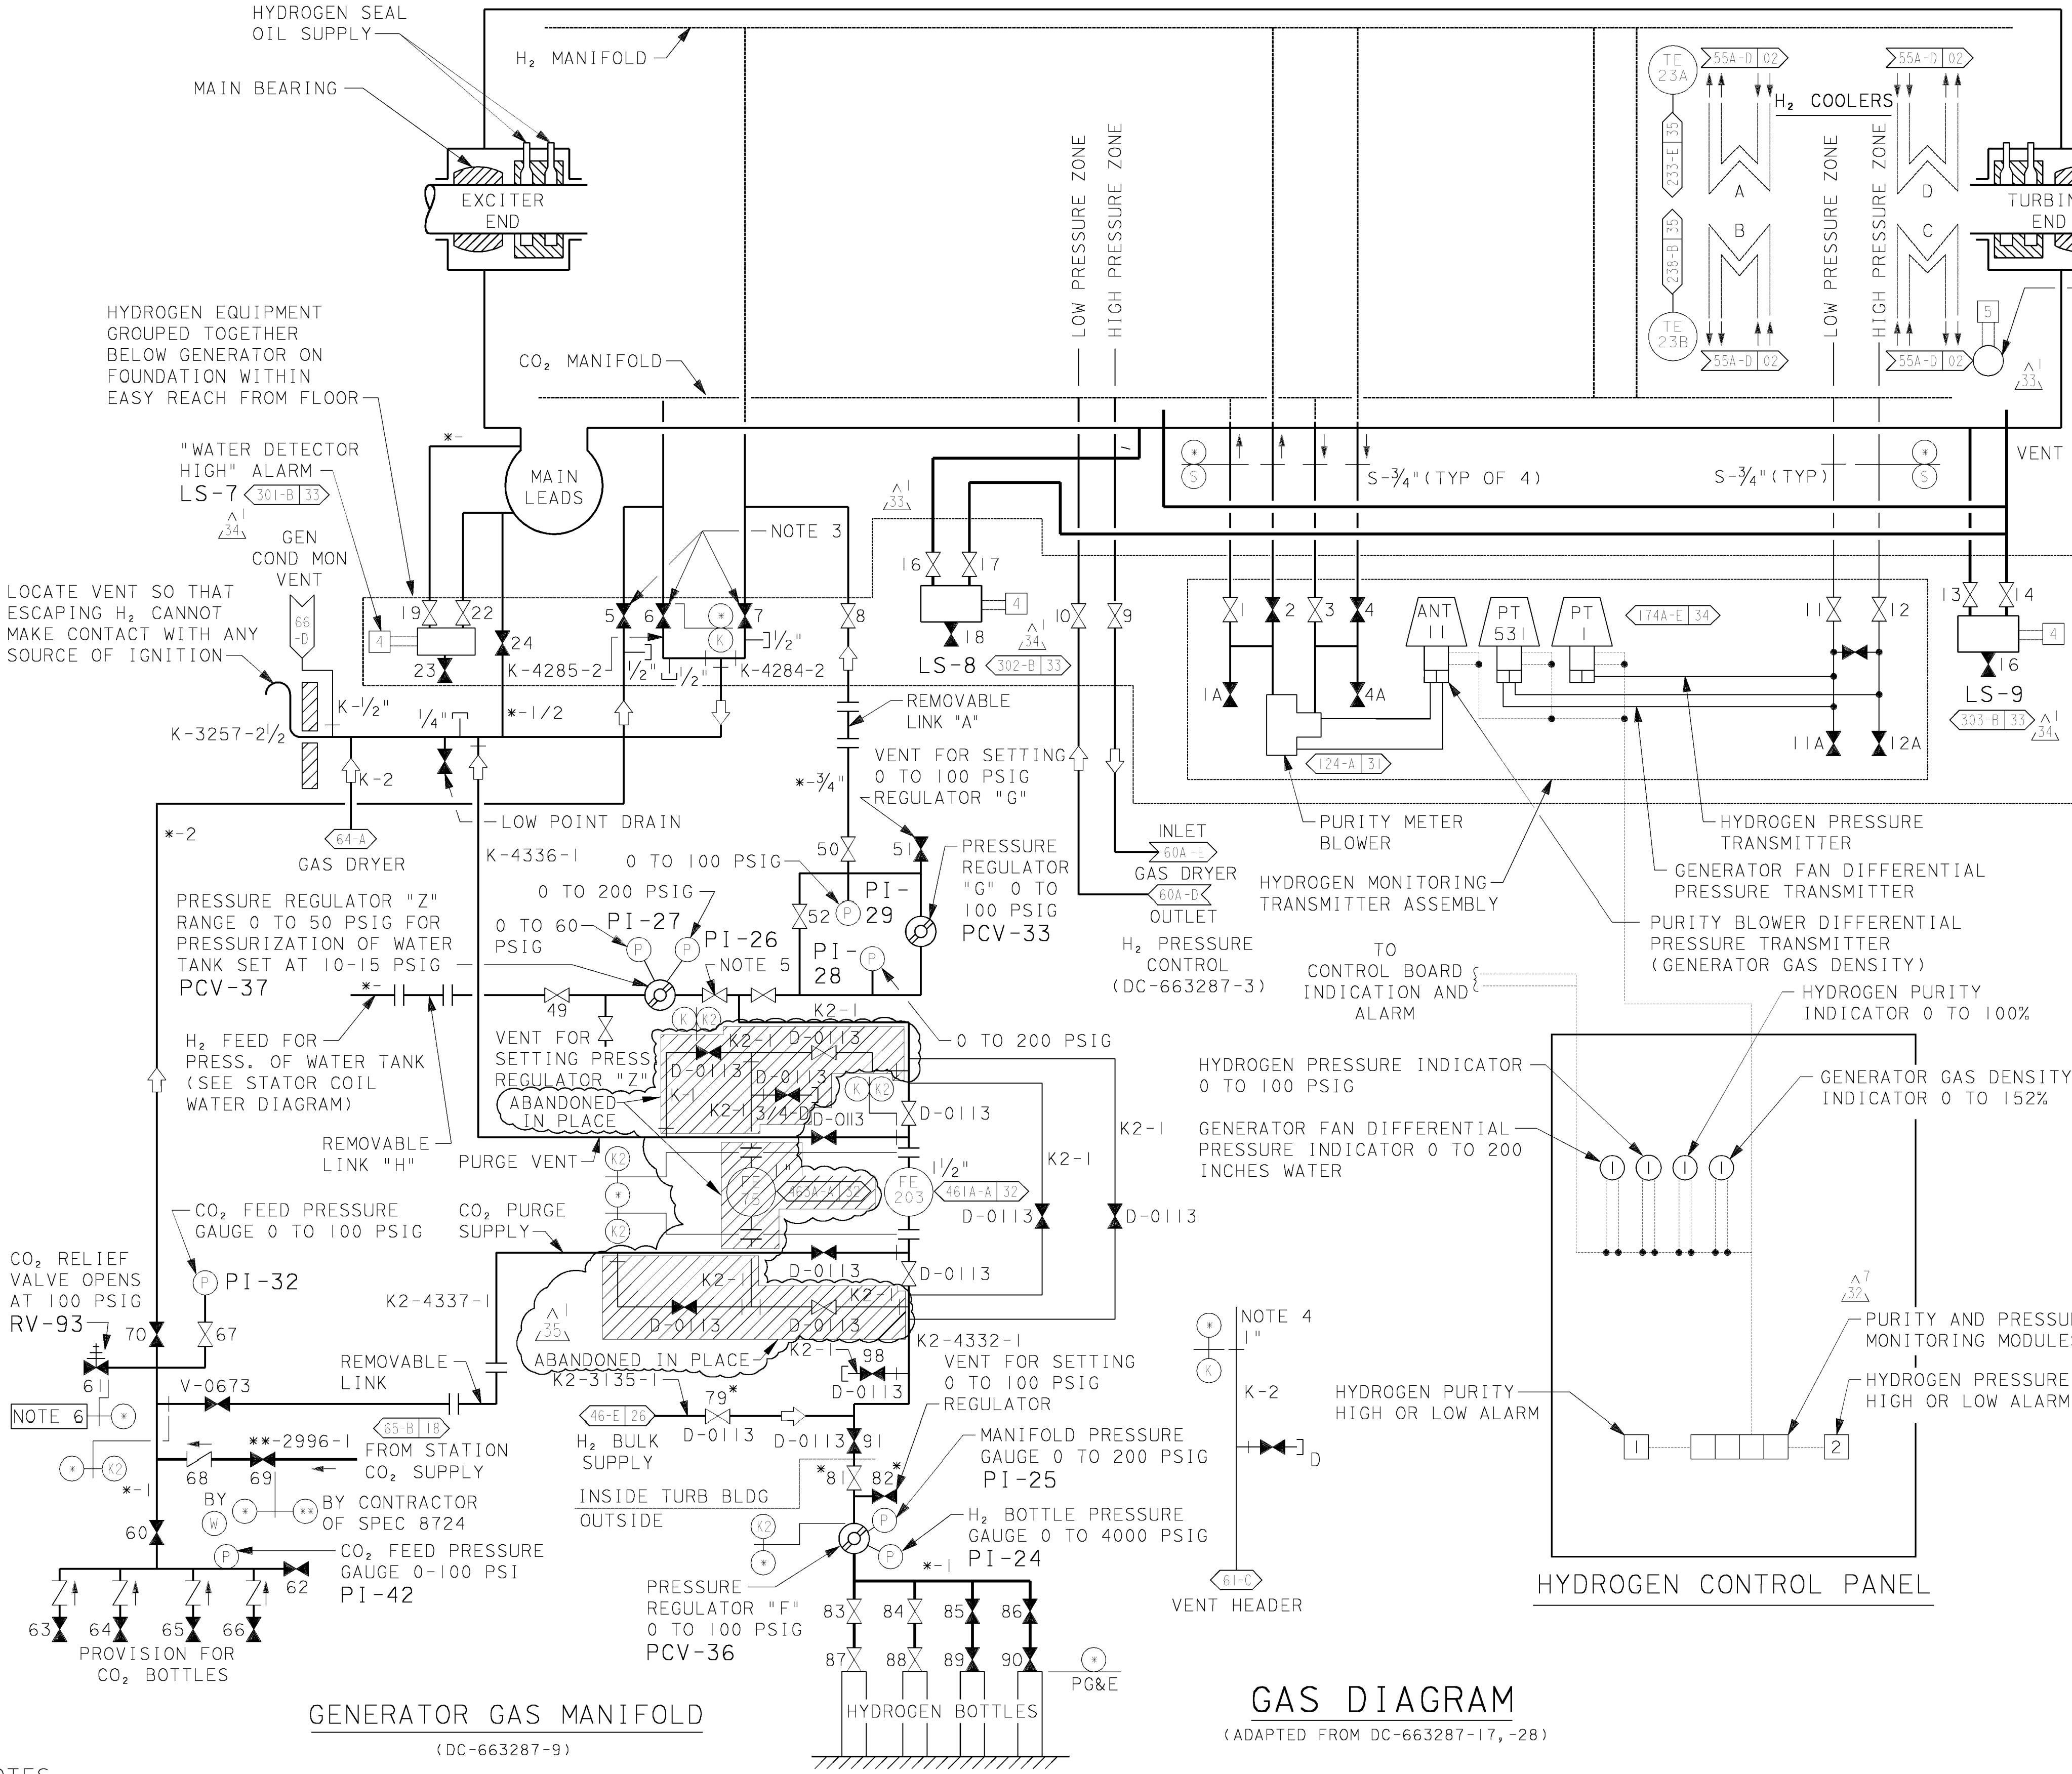

GAS ALARMS

- 1 HYDROGEN PURITY - HIGH OR LOW
- 2 HYDROGEN PRESSURE - HIGH OR LOW
- 3 HYDROGEN SUPPLY PRESSURE - LOW
- 4 WATER DETECTOR - HIGH
- 5 HYDROGEN TEMPERATURE - HIGH

LEGEND

- PRESSURE SWITCH
- ⊙ PRESSURE GAUGE
- ⌵ VALVE (NORMALLY CLOSED)
- ⌴ VALVE (NORMALLY OPEN)
- ⌵⌴ RELIEF VALVE
- ⌵⌴ TWO-WAY VALVE
- ELECTRICAL CONNECTION
- ⊙ PRESSURE REGULATOR

CONDENSED OPERATING INSTRUCTIONS

GENERAL

1. THE GAS CHANGING OPERATION MAY BE PERFORMED WITH THE GENERATOR AT STANDSTILL, ON TURNING GEAR, OR ROLLING AT SPEED NOT EXCEEDING 1000 RPM.
2. SHAFT SEAL OIL PRESSURE MUST BE MAINTAINED.
3. THE NORMAL SETTING OF VALVES IS INDICATED ON THE DIAGRAM.

REPLACING AIR WITH CO2

1. DISCONNECT THE REMOVABLE LINKS "A" & "H". DISCONNECT REMOVABLE LINK "J" ON WATER DIAGRAM.
2. CLOSE VALVES 1, 3, 8, 50 & 78 OPEN VALVES 2, 4, 5, 7, 60 & 70. USING CYLINDERS:
 3. ADMIT CO2 BY OPENING BOTTLE VALVES 63 TO 66. OPEN VALVES WIDE AND DO NOT THROTTLE. OBSERVE CO2 RELIEF VALVE OR PRESSURE GAUGE TO DETERMINE THE NUMBER OF BOTTLES THAT MAY BE OPENED. BOTTLES ARE EMPTY WHEN FROST DISAPPEARS FROM THE FLEXIBLE LEADERS. ONE AND ONE-HALF VOLUMES OF CO2 ARE REQUIRED. STANDARD CO2 BOTTLES CONTAIN 440 CUBIC FEET. PURITY SHOULD READ 95% GREATER IN CO2.USING BULK SUPPLY:
 4. BULK CO2 SUPPLY MAY BE USED FOR PURGING. CLOSE VALVE 60. OPEN VALVES 69 AND 70. ADMIT CO2 PER SAME INSTRUCTIONS AS FOR CYLINDERS.
4. WHEN FINISHED, CHANGE FOLLOWING VALVES BACK TO NORMAL. CLOSE VALVES 2, 4, 5, 7, 60 AND 70. OPEN VALVES 1 AND 3.

REPLACING CO2 WITH H2

1. REPLACE REMOVABLE LINK "A" AND OPEN VALVES 6, 8 & 50. USING CYLINDERS:
 2. OPEN VALVES 81, 83, 84, 87 AND 88. OPEN PRESSURE REGULATOR "F" AT BOTTLES. HYDROGEN MAY THEN BE FED BY ADJUSTING PRESSURE REGULATOR "G" AT HYDROGEN PRESSURE CONTROL. FOR MORE RAPID PURGING OPEN VALVE 52. WHEN BOTTLE PRESSURE AT THE HYDROGEN BOTTLE PRESSURE GAUGE DROPS TO 200 PSIG. CLOSE VALVES 83, 84, 87 AND 88. OPEN VALVES 85, 86, 89 AND 90 AND CONTINUE. TWO AND ONE-HALF VOLUMES OF H2 ARE REQUIRED TO REPLACE CO2 IN THE GENERATOR AT ONE-HALF PSIG. ONE ADDITIONAL VOLUME IS REQUIRED FOR EACH 15 PSIG INCREASE IN PRESSURE. STANDARD H2 BOTTLES CONTAIN 190 CUBIC FEET. PURITY METER SHOULD READ 95% GREATER IN H2.USING BULK SUPPLY:
 3. BULK H2 SUPPLY MAY USED BE FOR PURGING AND FILLING. CLOSE VALVE 81 AND OPEN VALVE 79. ADMIT H2 PER SAME INSTRUCTIONS AS FOR CYLINDERS.
3. CLOSE VALVE 52 IF USED, THEN CLOSE VALVE 6.
4. OPEN VALVE 24 FOR APPROXIMATELY TWO MINUTES TO PURGE LOW AREAS, THEN CLOSE VALVE 24.
5. MAINTAIN DESIRED PRESSURE IN GENERATOR BY MEANS OF THE PRESSURE REGULATOR "G" AT THE HYDROGEN PRESSURE CONTROL.
6. OPERATION IS THEN NORMAL AS INDICATED ON DIAGRAM.
7. OPEN VALVE 78 PER INSTRUCTIONS ON WATER DIAGRAM.
8. INSTALL REMOVABLE LINK "H" PER WATER DIAGRAM.

NORMAL H2 OPERATION

SET PRESSURE REGULATOR "G" ON THE HYDROGEN PRESSURE CONTROL TO MAINTAIN THE DESIRED HYDROGEN PRESSURE IN THE GENERATOR. THE PRESSURE MAY BE VARIED TO 75 PSIG.

REPLACING H2 WITH CO2

1. CLOSE VALVES 8, 50, 53 & 78 OPEN VALVE 7 AND VENT HYDROGEN PRESSURE.
2. DISCONNECT REMOVABLE LINK "A".
3. THIS OPERATION IS THE SAME AS REPLACING AIR WITH CO2 EXCEPT THAT TWO VOLUMES OF CO2 ARE REQUIRED.

PRESSURIZATION OF STATOR COIL WATER SYSTEM

FOR PRESSURIZATION OF THE STATOR COIL WATER SYSTEM, SEE STATOR COIL WATER DIAGRAM.

GENERATOR GAS MANIFOLD

(DC-663287-9)

GAS DIAGRAM

(ADAPTED FROM DC-663287-17, -28)

NOTES

1. ALL PIPING ON THIS SHEET PG&E CLASS "E".
2. REFER TO DC-663287-16 FOR PRESSURE MEASURING STATION CONFIGURATION.
3. VALVES 5, 6 & 7 SUPPLIED BY PG&E; PACKLESS METAL DIAPHRAGM WITH SOFT SEAT KEROTEST OR EQUIVALENT.
4. THIS PIPE SECTION USED TO CONNECT TO THE REPLACED GAS DRYER AND SHALL BE ABANDONED IN PLACE FOR FUTURE USE.
5. EXISTING VALVE REPLACED WITH CRANE MODEL NO.384P
6. "AQUATROL" 1" BRONZE VALVE (MODEL 89) SET TO OPEN AT 100 PSIG.

P G & E CO.


SHEET 6 PAGE 0

108022

REV. 35

1/25/00	PMH2	FXC2	-	ALAN GLEN BARTA	ELECTRICAL	E 9271	9/30/2001	Revised per FCT 024323
DATE	DWN	RE	IV	PROFESSIONAL ENGINEER	PE DISC.	PE#	PE EXP.	

70 71 72 73 74 75 76 77 78 79

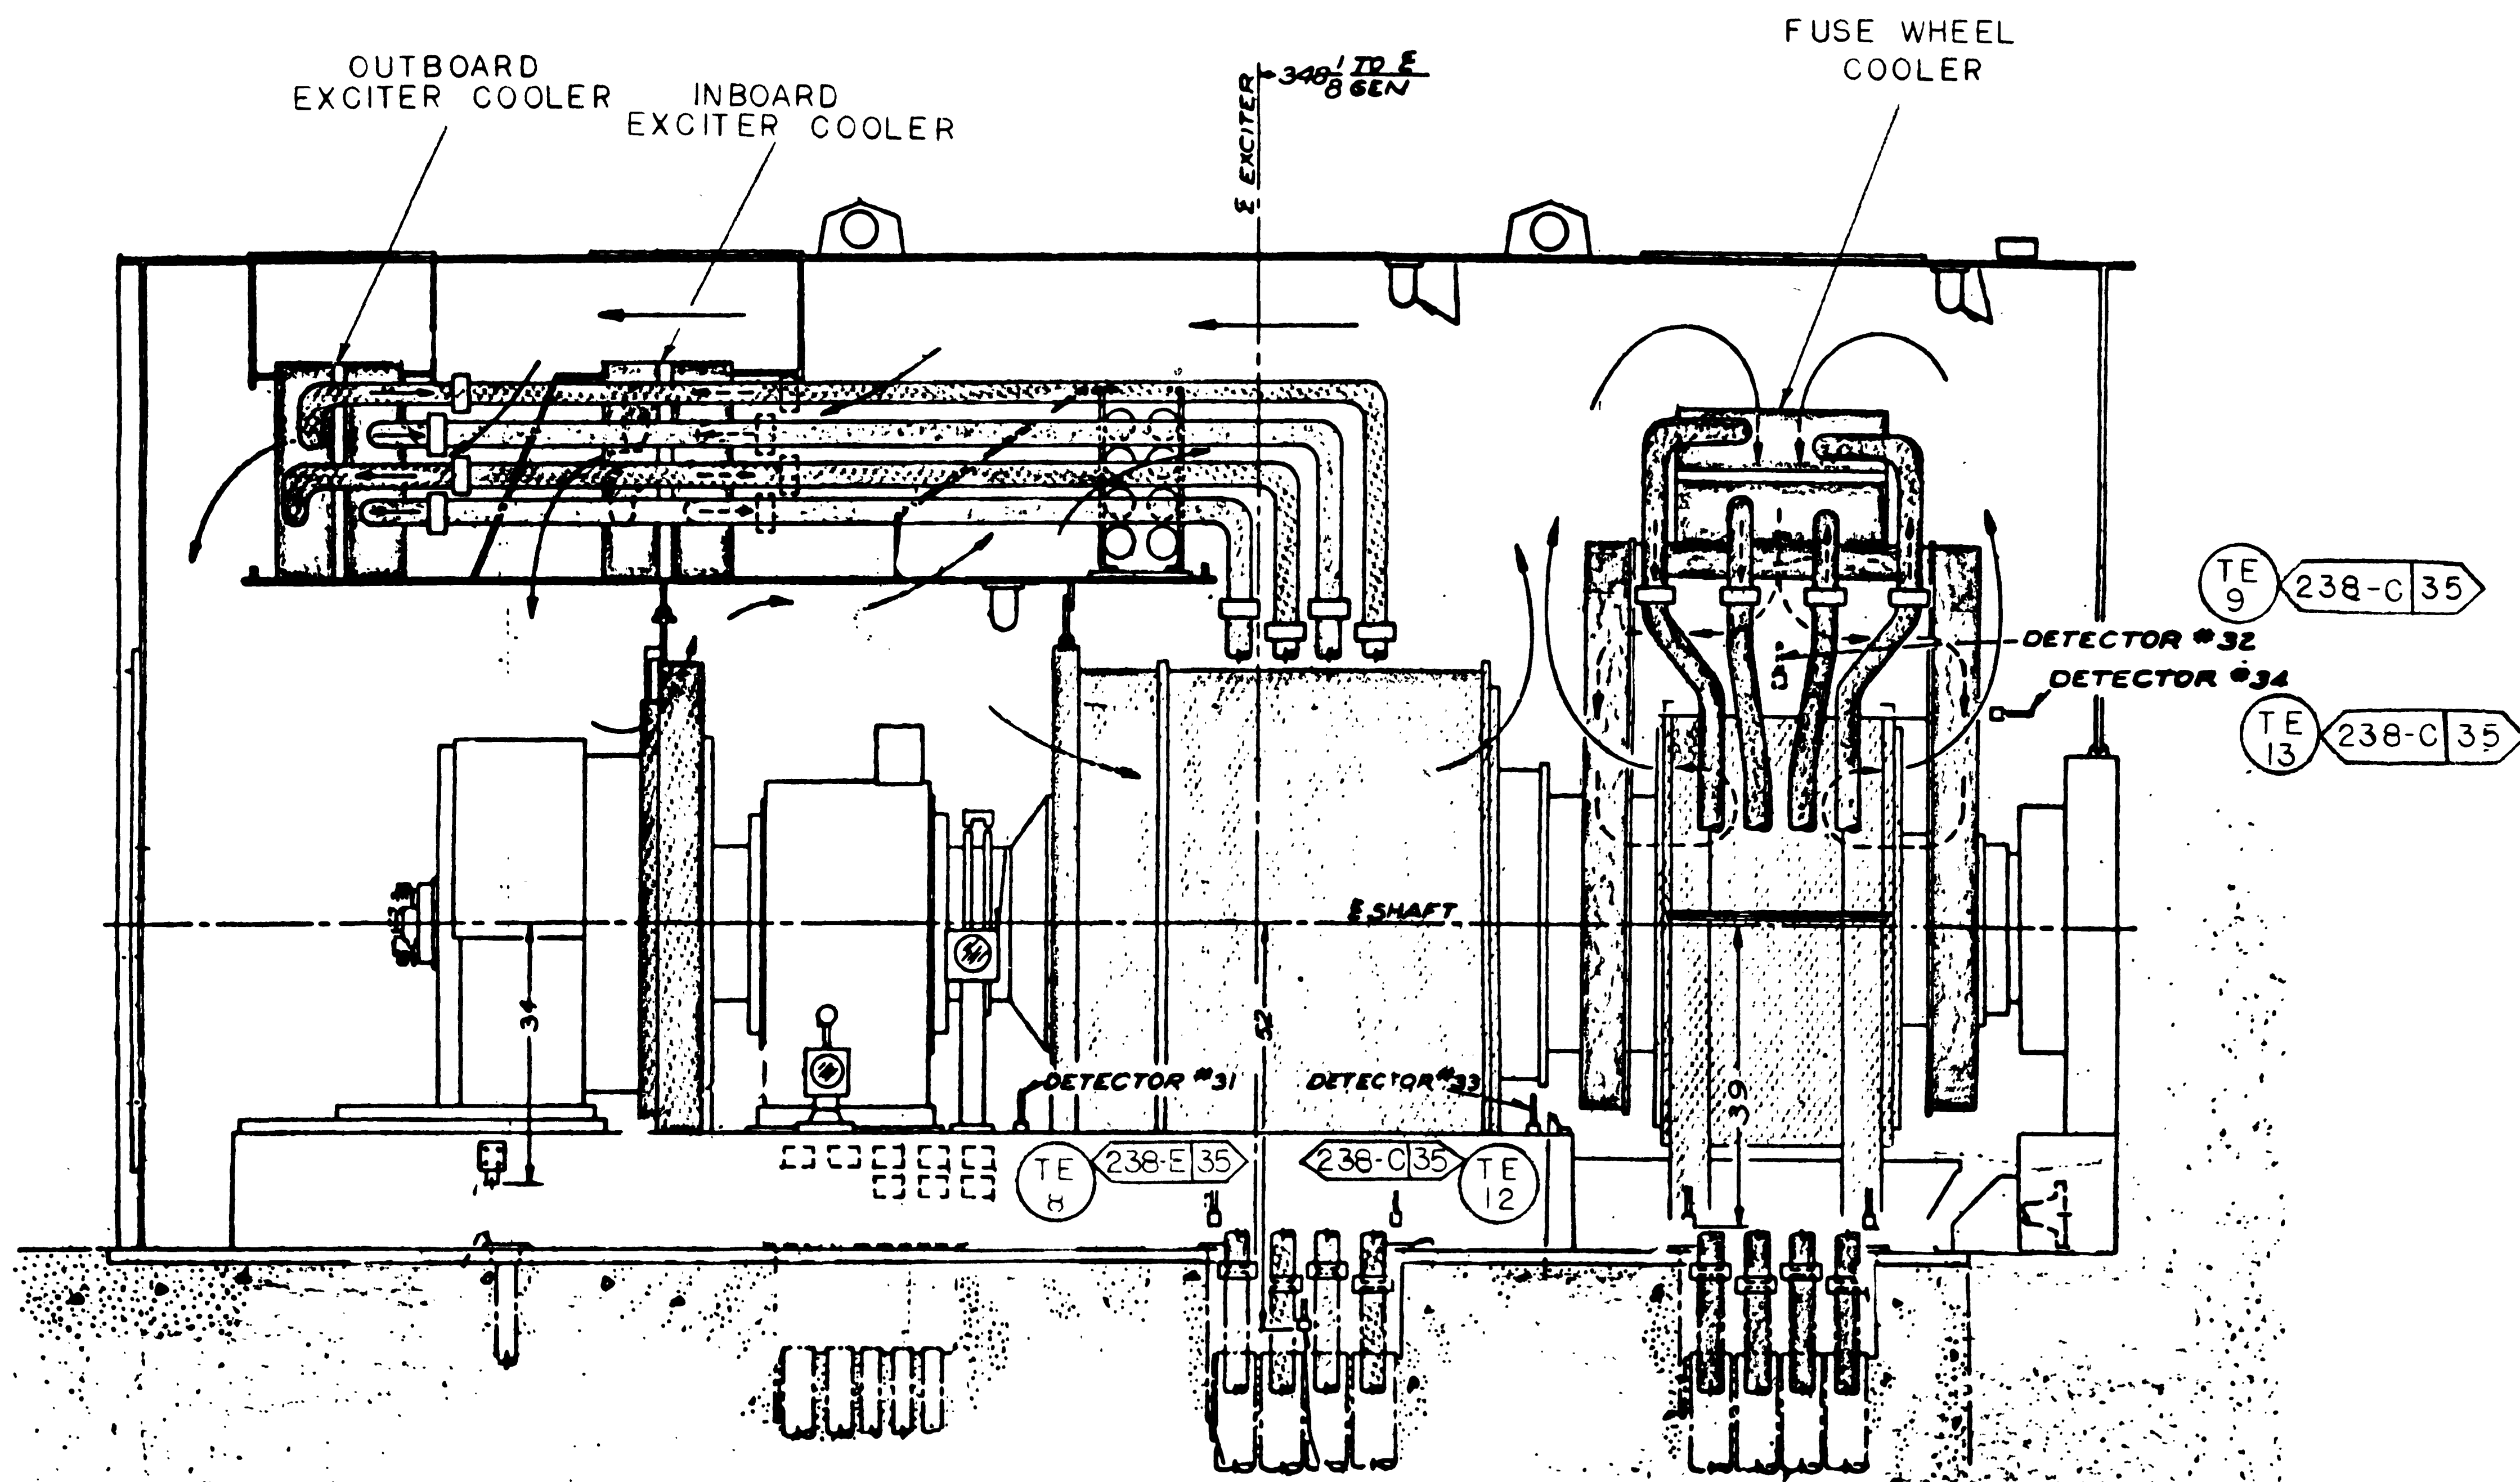

PERMANENT
MAGNET
GENERATOR

GENERATOR
EXCITER

EXCITER
FUSE
WHEEL

ADAPTED FROM
WESTINGHOUSE DWG. 687J819
DC-663293-1

EXCITER COOLERS AIR TEMPERATURE DETECTORS







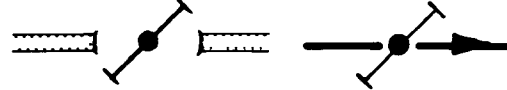
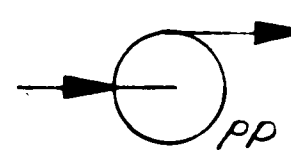

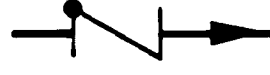
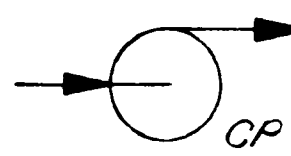




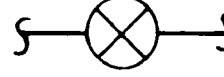
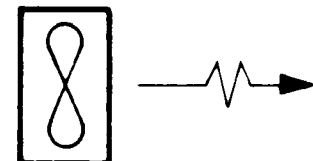








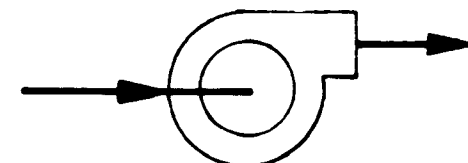

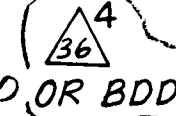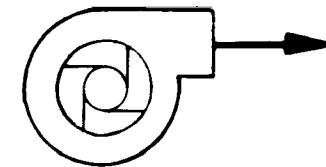



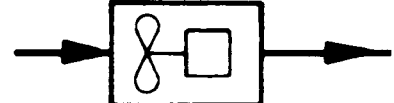


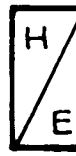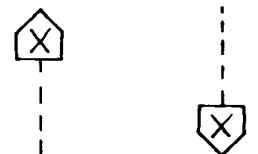








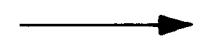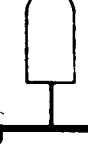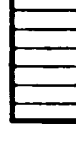

UNIT - 2

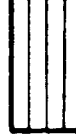
P.G. & E. CO.	DRAWING NUMBER	REVISION
	108022	1
SHEET 7 OF SHEETS		
MICROFILM		

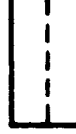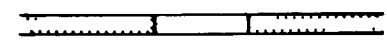RM INDEXED REV. 1

THIS DRAWING HAS BEEN REPRODUCED
WITHOUT CHANGE FROM ORIGINAL DRAWING
CHANGE NO. DATE APPROVED

AN DC

20	21	22	23	24	25	26	27	28	29
<p>LEGEND</p> <p>HVAC UNIQUE SYMBOLS</p> <p>(SEE DWG 108001 SHEET 3 FOR PIPING SYMBOLS)</p>						<p>HVAC UNIQUE ABBREVIATIONS</p> <p>(SEE DWG 108001 SHEET 3 FOR PIPING ABBREVIATIONS)</p>			
	CENTRIFUGAL FAN		SUPPLY AIR DUCT - CLASS II & III (PIPING WHEN LINE NUMBER IS PRESENT)		BUTTERFLY VALVE OR POSITIVE SHUT-OFF DAMPER	<p> BD OR BDD — BACK DRAFT DAMPER</p>			
	CENTRIFUGAL FAN (WITH INLET VANES)		SUPPLY AIR DUCT - CLASS I SAFETY RELATED VENTILATION SYSTEM.		DAMPERS (IN WALL & IN DUCTING, RESPECTIVELY)	<p>C — COOLING COIL</p>			
	PUMP		EXHAUST OR RETURN AIR DUCT - CLASS II & III VENTILATION		BACK DRAFT DAMPER	<p>CH — CHILLER</p>			
	COMPRESSOR		EXHAUST OR RETURN AIR DUCT - CLASS I SAFETY RELATED VENTILATION SYSTEM.		FIRE OR SMOKE DAMPER	<p>CNTMT — CONTAINMENT</p>			
	VANEAXIAL FAN		IMAGINARY BOUNDARY FOR SYSTEMS, FUTURE EQUIPMENT OUTLINE, OR PROPOSED PIPING LINE.		EXPANSION VALVE	<p>CP — COMPRESSOR</p>			
	PROPELLER OR TUBEAXIAL FAN		CHANGE OF ELEVATION OR LEVEL PROJECTION LINE WITH ORIGIN & DESTINATION		THERMOSTATIC AIR VENT	<p>CR — CONDENSER</p>			
	HEATING COIL E - ELECTRIC S - STEAM (ELECTRIC SHOWN)		PROJECTION LINE (SEE PRECEDING) CROSS REFERENCES: ALPHA CHARACTER = RETURN AIR NUMERIC CHARACTER = SUPPLY AIR		SIGHT GLASS	<p>CRDM — CONTROL ROD DRIVE MECHANISM</p>			
	COOLING COIL W - WATER DX - DIRECT EXPANSION CD - CONDENSER (WATER SHOWN)		SUPPLY AIR DIFFUSER		CHARGING VALVE	<p>DX — DIRECT EXPANSION COIL</p>			
	ROUGHING FILTER (PRE-FILTER)		EXHAUST OR RETURN REGISTER		FLOW ELEMENT (AIR MONITOR)	<p>E — EXHAUST FAN</p>			
	HEPA FILTER		SUPPLY AIR FLOW		SMOKE DETECTOR	<p>EFB — EXHAUST FILTER BANK</p>			
	CHARCOAL FILTER		EXHAUST AIR FLOW		RECORDING USAGE CLOCK	<p>EFC — EXHAUST FILTER CHARCOAL</p>			
	LOUVRE		(F) FLOOR OR (C) CEILING OPENING E.G. C+F MEANS OPENINGS BOTH ON CEILING AND ON FLOOR.		ANALYSIS SENSOR HVAC: TEMPERATURE & HUMIDITY PIPING: CONDUCTIVITY ELEMENT	<p>EFH — EXHAUST FILTER HEPA</p>			
	DEMISTER (MOISTURE SEPARATOR)		"WINDOW" OPENING OR OPENING IN WALL			<p>EFR — EXHAUST FILTER ROUGHING</p>			
			ELECTRIC OPERATOR (SOLID STATE)			<p>EH — ELECTRIC HEATER</p>			
			MOTOR OPERATOR			<p>EXH. — EXHAUST</p>			
			PNEUMATIC OPERATOR			<p>FAI. — FAIL AS IS</p>			
			MANUAL OPERATOR			<p>FB — FILTER BANK</p>			
			COUNTERWEIGHT			<p>FC — FLEXIBLE CONNECTOR</p>			
						<p>F.C. — FAIL CLOSE</p>			
						<p>FD — FIRE DAMPER</p>			
						<p>F.O. — FAIL OPEN</p>			
						<p>FU — FILTER UNIT</p>			
						<p>HVAC — HEATING, VENTILATION, & AIR CONDITIONING</p>			
						<p>M — MODE DAMPER</p>			
						<p>MD — MANUAL DAMPER</p>			
						<p>MOD — MOTOR OPERATED DAMPER</p>			
						<p>O/A — OUTSIDE AIR</p>			
						<p>PP — PUMP</p>			
						<p>S — SUPPLY FAN</p>			
						<p>SD — SMOKE DAMPER</p>			
						<p>SG — SIGHT GLASS</p>			
						<p>SUP. — SUPPLY</p>			
						<p> TV — FIRE DAMPER OR SMOKE DAMPER</p>			
UNIT 2									
P.G.&E. CO.						DRAWING NUMBER		REV	
SHEET 2 OF SHEETS						108023		36	
RMS INDEXED REV						MICROFILM			

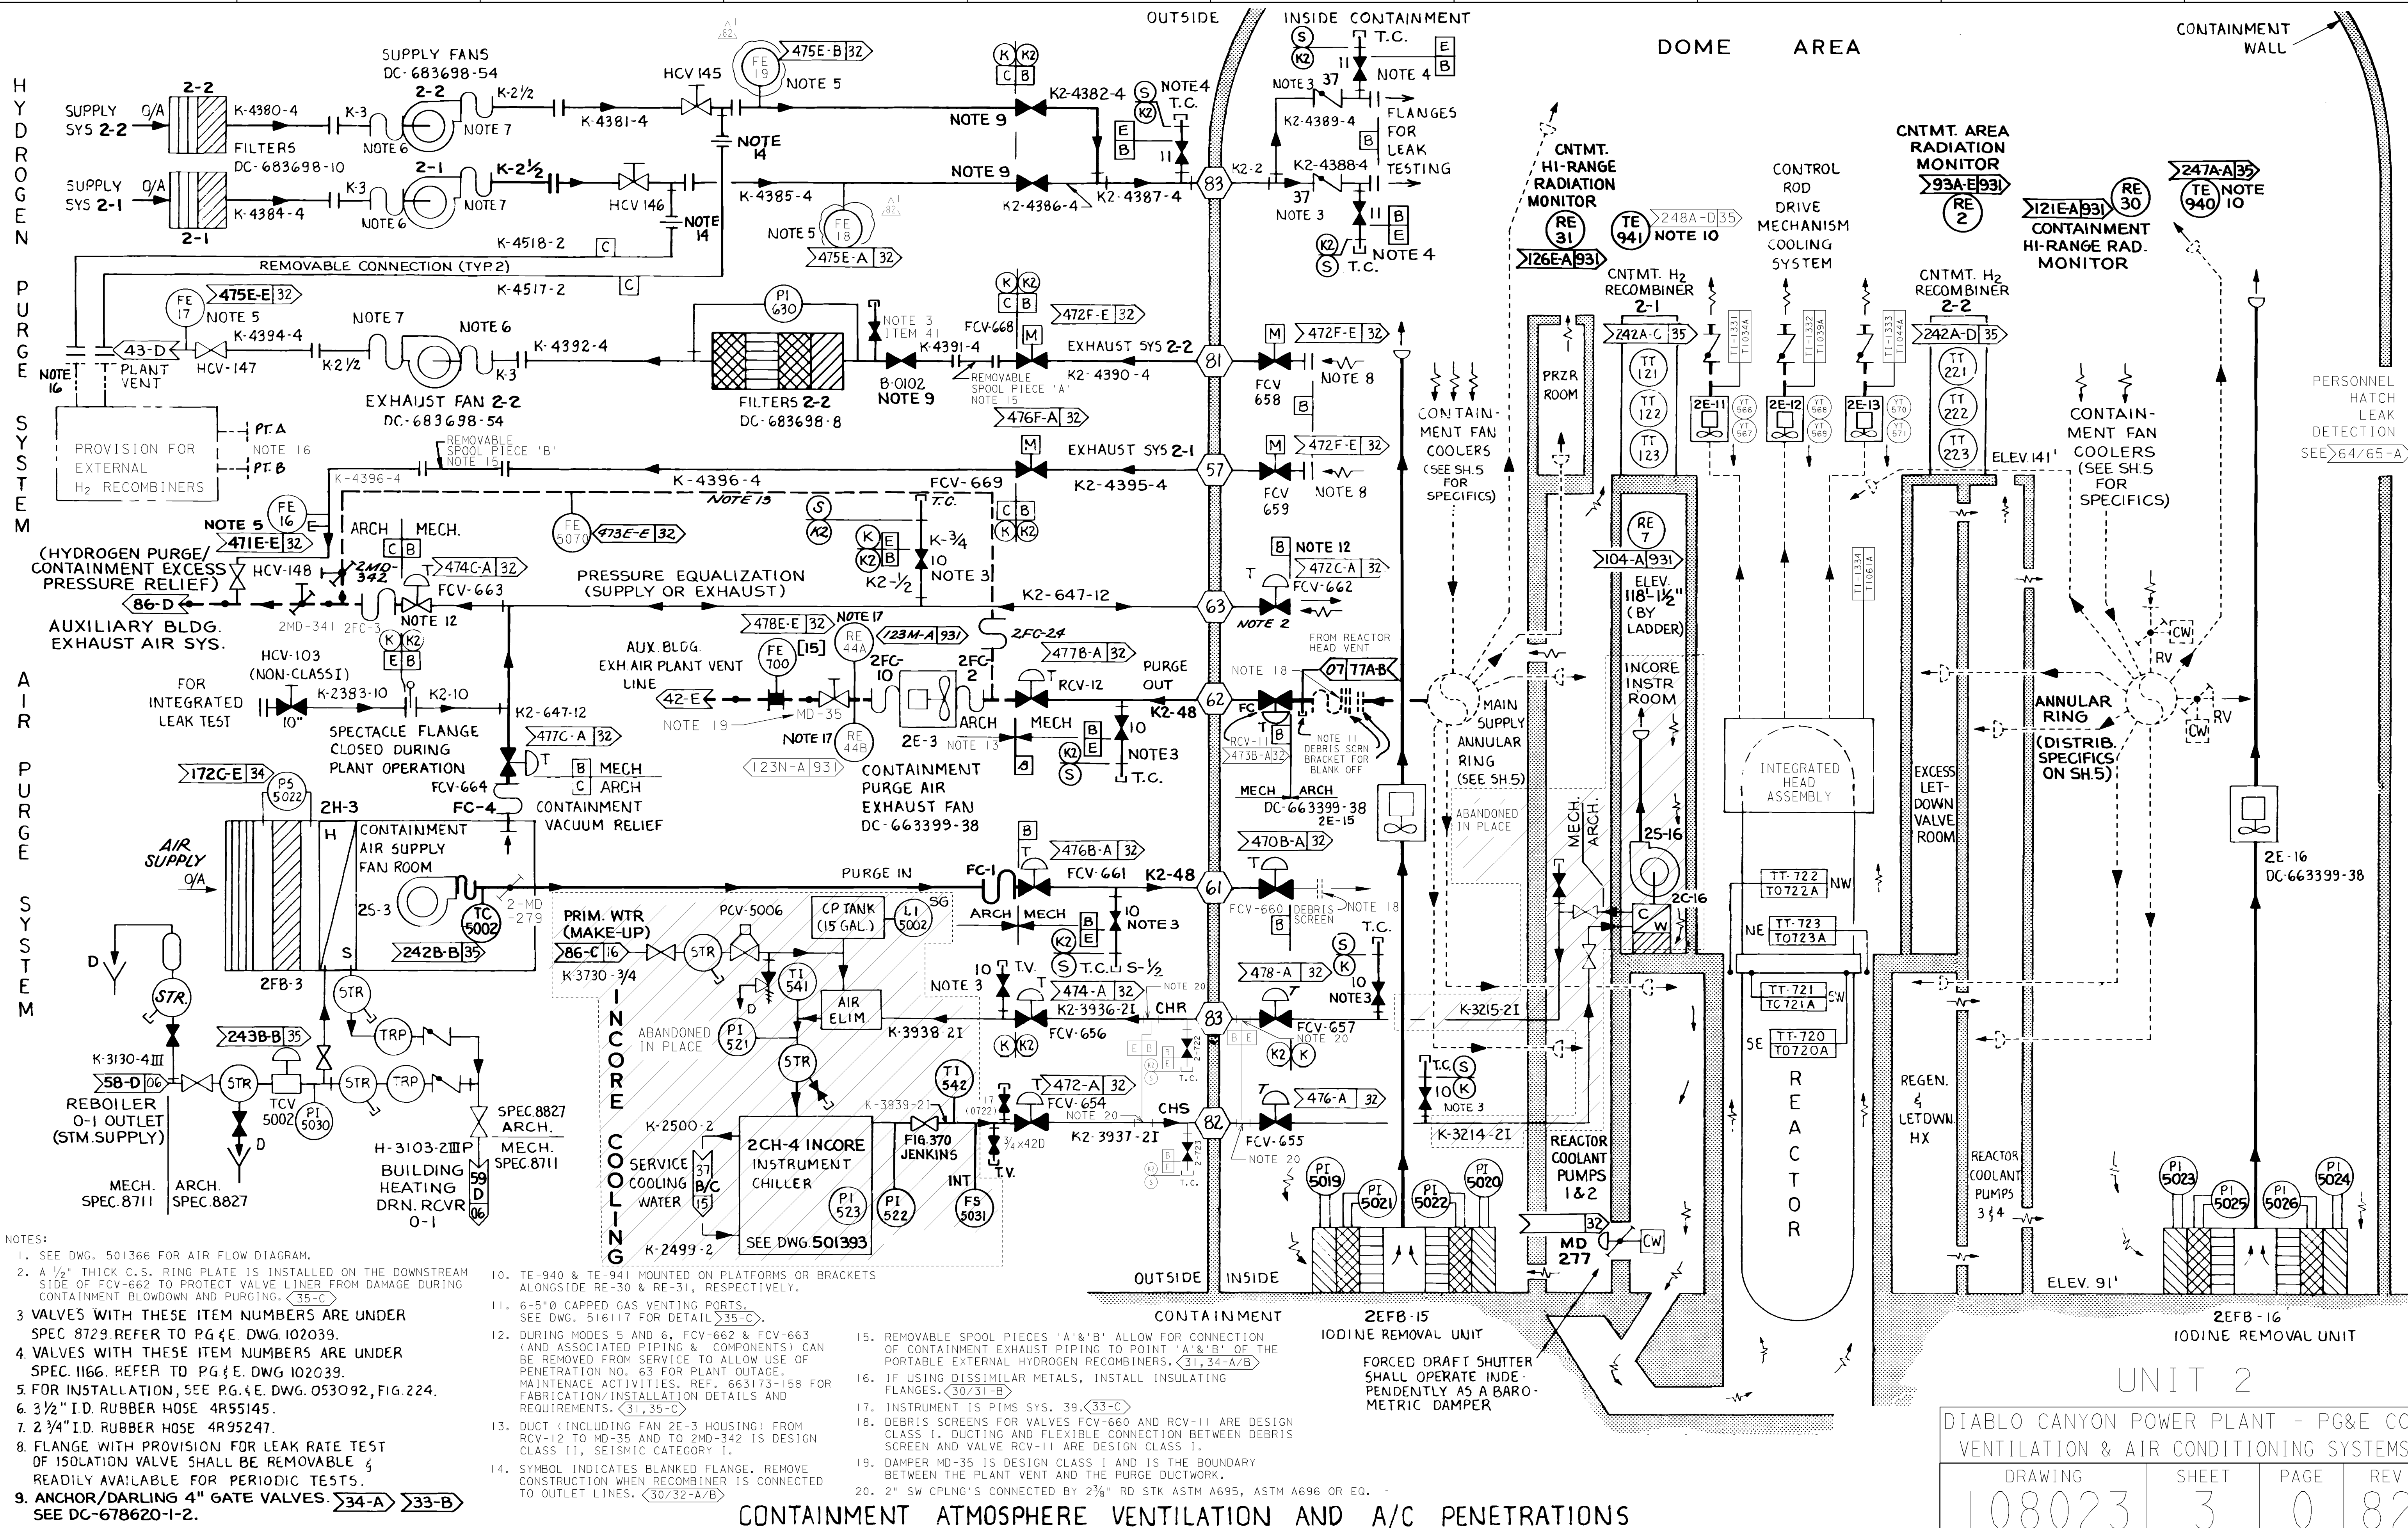

NOTES:

1. SEE DWG. 501366 FOR AIR FLOW DIAGRAM.

2. A 1/2" THICK C.S. RING PLATE IS INSTALLED ON THE DOWNSTREAM SIDE OF FCV-662 TO PROTECT VALVE LINER FROM DAMAGE DURING CONTAINMENT BLOWDOWN AND PURGING. 35-C

3. VALVES WITH THESE ITEM NUMBERS ARE UNDER SPEC. 8729. REFER TO PG. 4 E. DWG. 102039.

4. VALVES WITH THESE ITEM NUMBERS ARE UNDER SPEC. 1166. REFER TO PG. 4 E. DWG. 102039.

5. FOR INSTALLATION, SEE PG. 4 E. DWG. 053092, FIG. 224.

6. 3 1/2" I.D. RUBBER HOSE 4R95145.

7. 2 3/4" I.D. RUBBER HOSE 4R95247.

8. FLANGE WITH PROVISION FOR LEAK RATE TEST OF ISOLATION VALVE SHALL BE REMOVABLE & READILY AVAILABLE FOR PERIODIC TESTS.

9. ANCHOR/DARLING 4" GATE VALVES. 34-A 33-B
SEE DC-678620-1-2.

10. TE-940 & TE-941 MOUNTED ON PLATFORMS OR BRACKETS ALONGSIDE RE-30 & RE-31, RESPECTIVELY.

11. 6-5"Ø CAPPED GAS VENTING PORTS.
SEE DWG. 51617 FOR DETAIL 35-C.

12. DURING MODES 5 AND 6, FCV-662 & FCV-663 (AND ASSOCIATED PIPING & COMPONENTS) CAN BE REMOVED FROM SERVICE TO ALLOW USE OF PENETRATION NO. 63 FOR PLANT OUTAGE, MAINTENANCE ACTIVITIES. REF. 663173-158 FOR FABRICATION/INSTALLATION DETAILS AND REQUIREMENTS. 31, 35-C

13. DUCT (INCLUDING PAN 2E-3 HOUSING) FROM FCV-112 TO MD-35 AND TO 2MD-342 IS DESIGN CLASS II, SEISMIC CATEGORY I.

14. SYMBOL INDICATES BLANKED FLANGE. REMOVE CONSTRUCTION WHEN RECOMBINER IS CONNECTED TO OUTLET LINES. 30/32-A/B

15. REMOVABLE SPOOL PIECES 'A' & 'B' ALLOW FOR CONNECTION OF CONTAINMENT EXHAUST PIPING TO POINT 'A' & 'B' OF THE PORTABLE EXTERNAL HYDROGEN RECOMBINERS. 31, 34-A/B

16. IF USING DISSIMILAR METALS, INSTALL INSULATING FLANGES. 30/31-B

17. INSTRUMENT IS PIMS SYS. 39. 33-C

18. DEBRIS SCREENS FOR VALVES FCV-660 AND RCV-11 ARE DESIGN CLASS I. DUCTING AND FLEXIBLE CONNECTION BETWEEN DEBRIS SCREEN AND VALVE RCV-11 ARE DESIGN CLASS I.

19. DAMPER MD-35 IS DESIGN CLASS I AND IS THE BOUNDARY BETWEEN THE PLANT VENT AND THE PURGE DUCTWORK.

20. 2" SW CPLNG'S CONNECTED BY 2 3/8" RD STK ASTM A695, ASTM A696 OR EQ.

OUTSIDE INSIDE

CONTAINMENT

CONTAINMENT ATMOSPHERE VENTILATION AND

PLANT VENT EXHAUST & MONITORS

CONTAINMENT ATMOSPHERE MONITORS & SAMPLING

AIR PARTICULATE
& NOBLE GAS
MONITORING

HIGH
LEVEL

RADIATION
MONITORING

PLANT

MISC.

EXHAUST

POST LOCA
SAMPLING

CONTAINMENT
HYDROGEN
MONITORING

- NOTES:
1. VALVE UNDER SPEC 0722, SEE PG&E DWG 102039
 2. VALVE UNDER SPEC 8729, SEE PG&E DWG 102039
 3. INSTALLED IN REVERSE TO NORMAL FLOW DIRECTION TO MEET CONTAINMENT ISOLATION REQUIREMENTS
 4. CONTAINMENT AIR SAMPLE & RETURN TUBING SHALL PASS THROUGH A COMMON 2" SLEEVE SEE DWG 501915 FOR DETAILS, DWG 501035 FOR A COMPREHENSIVE LISTING OF MECHANICAL & ELECTRICAL PENETRATIONS
 5. END PROVISION FOR LEAK RATE TESTING
 6. DELETED
 7. ELBOW TURNED DOWN (KEEP, CLEAR)
 8. ISOLATION VALVES TO BE INSTALLED NEAR RADIATION ELEMENTS
 9. QUICK DISCONNECT COUPLINGS FOR TRITIUM MONITOR SEE DWG 049099 FIG 950 FOR INSTALLATION DETAIL
 10. VALVE UNDER SPEC 8179, PO #013226, DC 663316-111
 11. RCV-32 AND RCV-37 ARE ABANDONED IN PLACE, FAILED OPEN
 12. WHITEY VALVE MODEL B44F4
 13. INSTRUMENT IS PIMS SYS 39
 14. RE-24, RE-28A/B, RE-14A/B, RE-32 & RE-33 ARE ABANDONED IN PLACE. REFER TO DWG. 049099 SH. 7A, 7B & 11.

UNIT 2



DIABLO CANYON POWER PLANT - PG&E CO.
VENTILATION & AIR CONDITIONING SYSTEMS

DRAWING	SHEET	PAGE	REV
108023	4	0	85

08-03-2010	MNRU	FxC2		KERSI J. DALAL	MECHANICAL	M 16690	3/31/2012	REVISED PER DFT-7*850-0
DATE	DWN	RE	IV	PROFESSIONAL ENGINEER	PE DISC.	PE#	PE EXP.	

- NOTES**
1. ALL PIPING ON THIS SHEET SHALL BE PG&E CLASS "E"
 2. THREE DRAINS FROM MOISTURE SEPARATOR AND HEPA FILTER SECTIONS ARE PLUGGED WITH REMOVABLE TEST PLUG (52, 55, 56, 58, 59-8)
 3. LEVEL TRANSMITTERS MUST BE 10 FEET APART (58-B)
 4. DAMPERS ARE NO LONGER FLOW CONTROL DAMPERS (FCV) ACTUATORS HAVE BEEN REMOVED EXISTING TAG NUMBERS ARE MAINTAINED FOR SPECIFIC DAMPER IDENTIFICATION. (52-A)
 5. VACUUM RELIEF DAMPERS MD-271 THRU MD-274 ARE DESIGN CLASS I
 6. THE CONTAINMENT ANNULAR RING DUCT (ANNULUS) IS DESIGN CLASS II, SEISMIC CATEGORY I.
 - 7.
 8. PROVISION FOR QUICK REMOVAL OF DUCT (53-0)
 9. PROVISIONS FOR MOISTURE SEPARATORS, HEPA FILTERS, CARBON FLTRS & ROUGHING FLTRS - NOT INSTALLED.
 10. DAMPERS NORMALLY CLOSED.
 11. DAMPERS LOCKED OPEN (TYP)
 12. MD-262 THRU MD-266 INLET VANE DAMPERS ARE THROTTLED

- REFERENCES**
1. REACTOR CONTAINMENT FAN COOLERS = DC-663079-22
 2. FAN COOLER ENCLOSURE = DC-663079-4 & 23
 3. FAN MOTOR = DC-663079-5
 4. FAN = DC-663079-7 & 8
 5. ANNULUS DUCT LAYOUT = PG & E DWG NO 501389 & 501390
 6. BACKDRAFT DAMPERS MD 262 THRU MD-266 = DC-663079-37

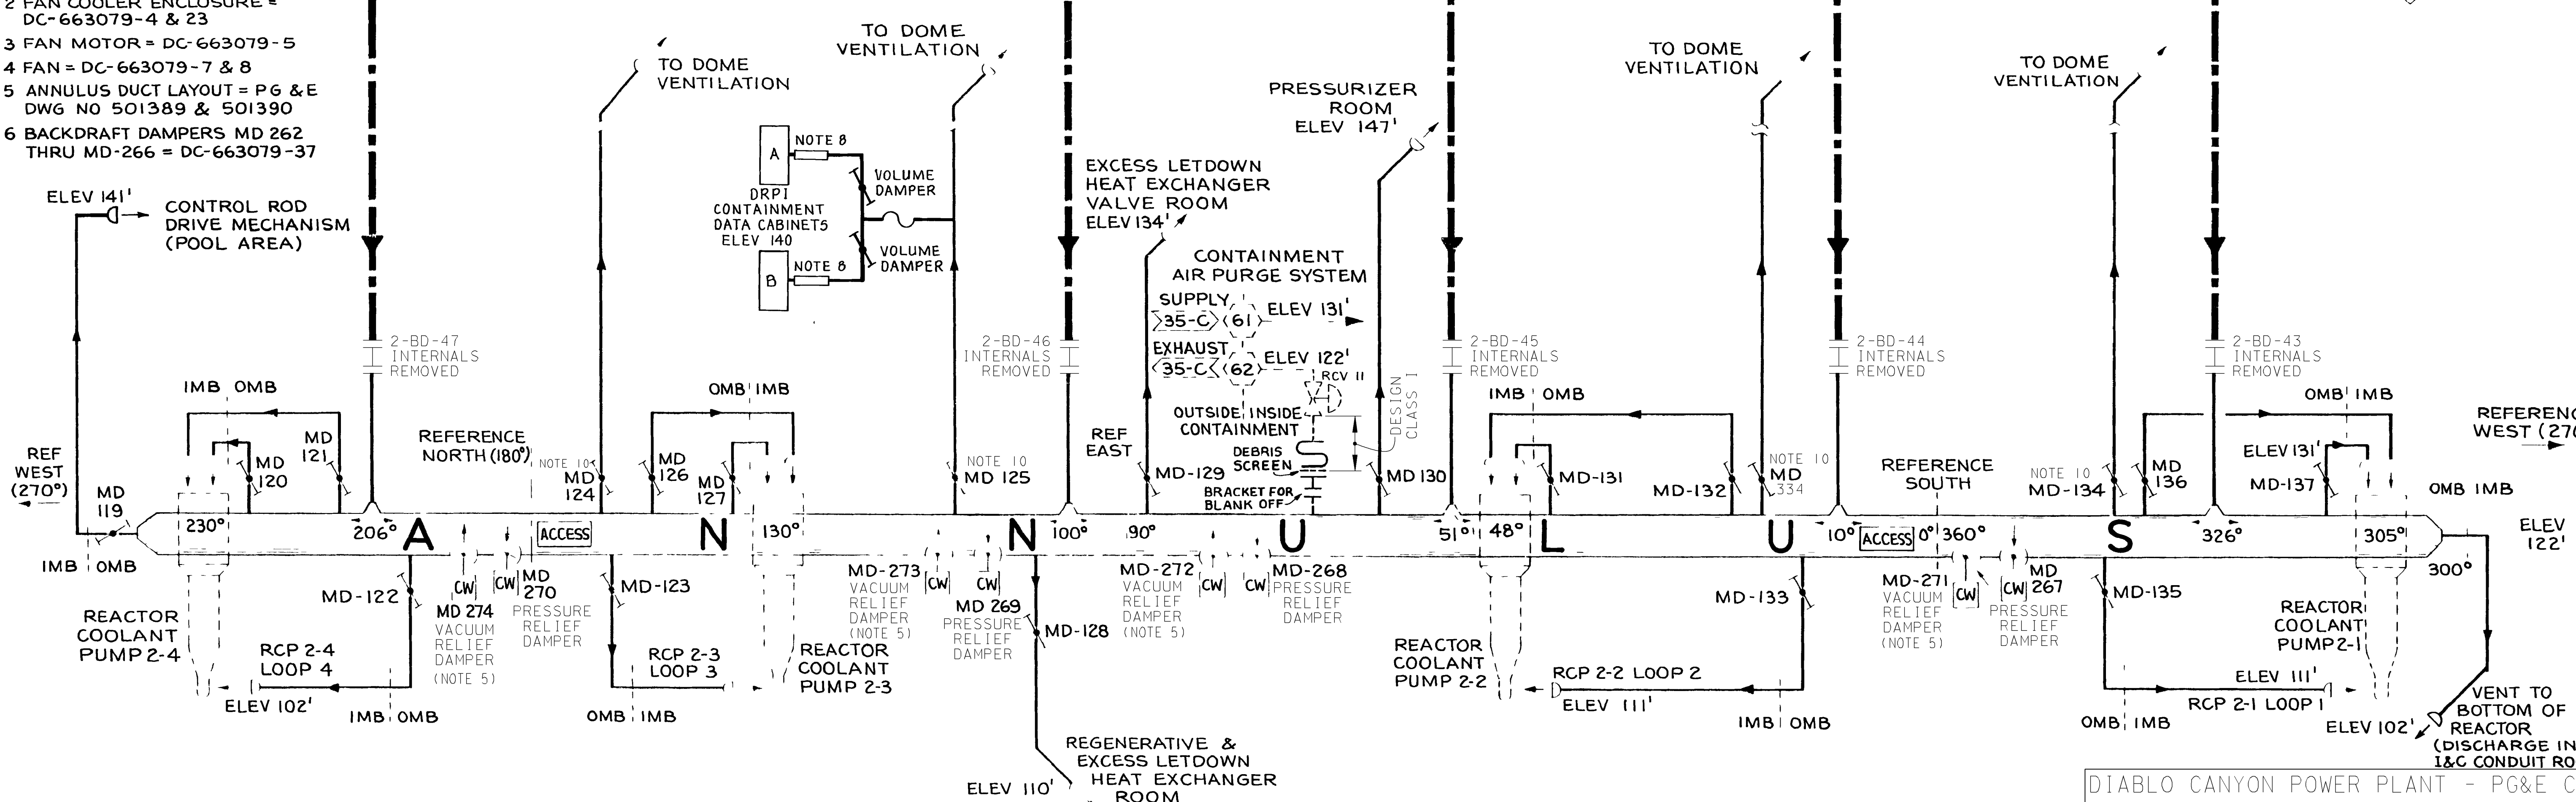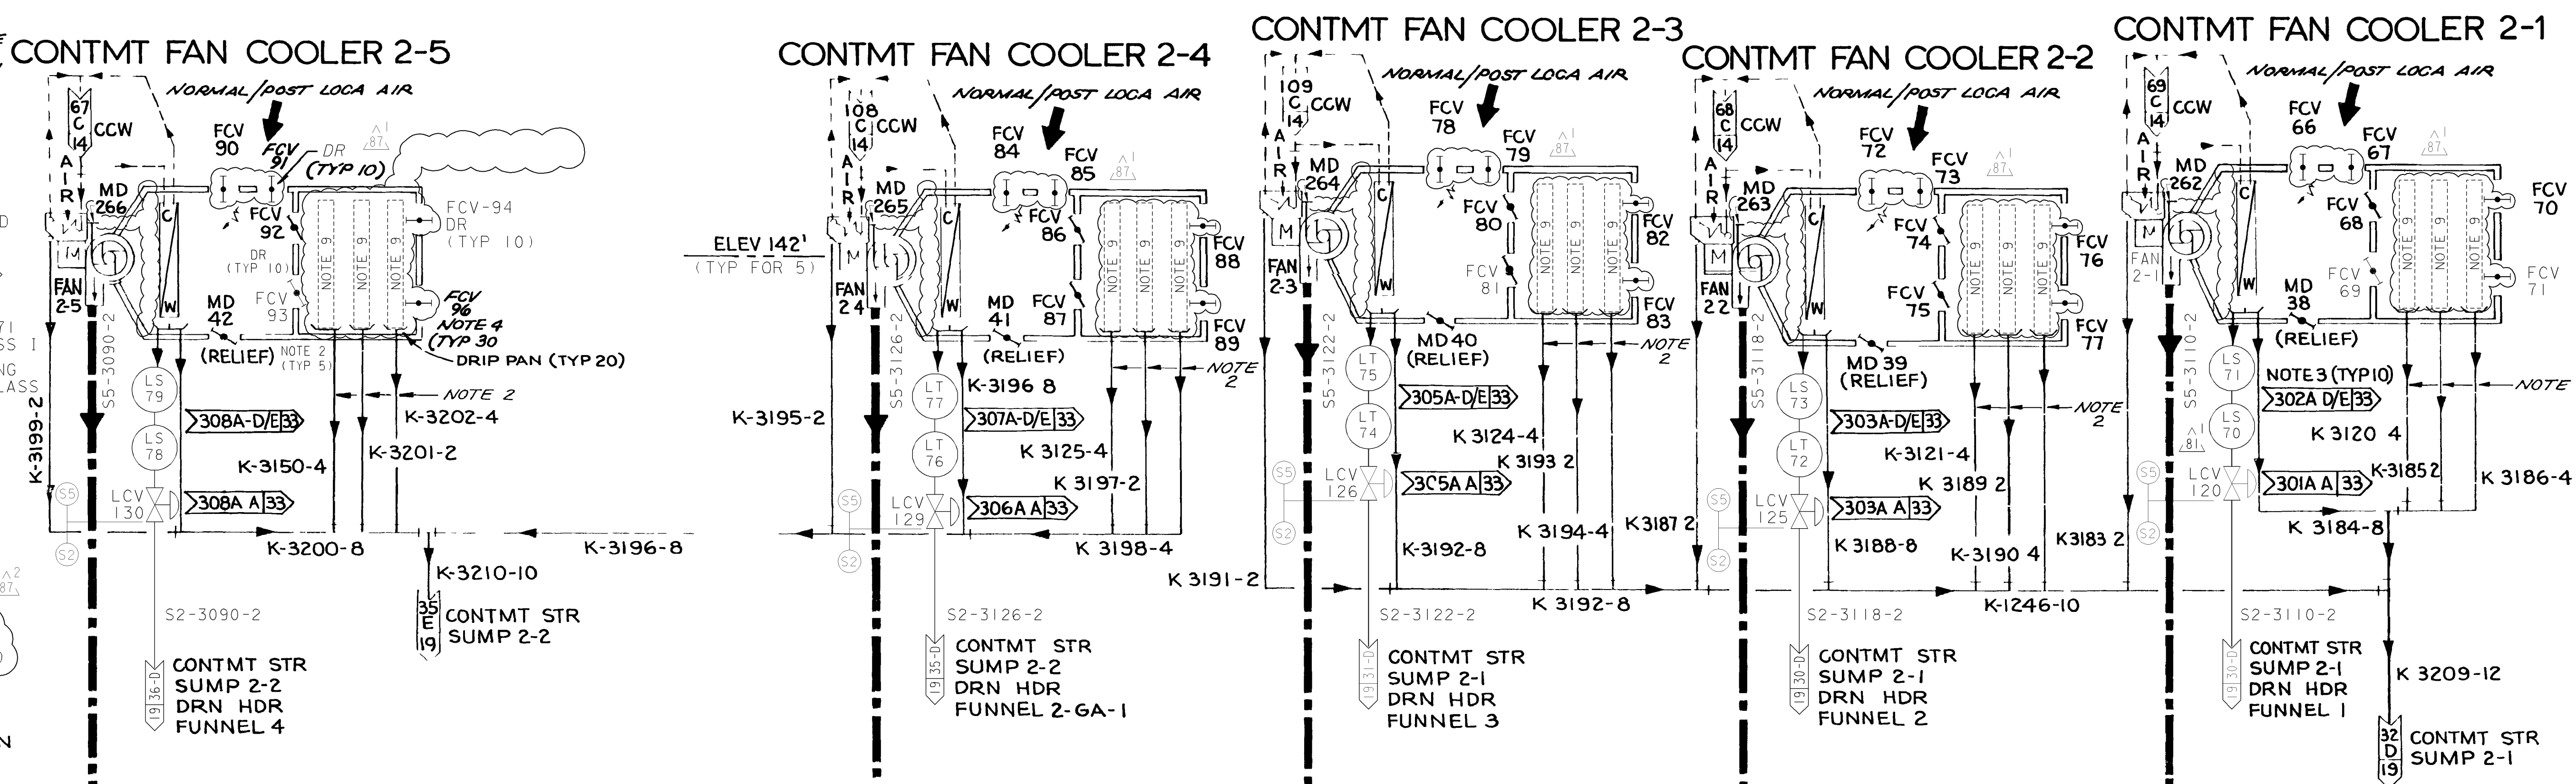

CONTAINMENT AIR CIRCULATION

UNIT 2

DIABLO CANYON POWER PLANT - PG&E CO.			
VENTILATION & AIR CONDITIONING SYSTEM			
DRAWING	SHEET	PAGE	REV
108023	5	0	87

10-07-2013	MNRU	FxC2	KJD3	NOT REQUIRED	N/A	N/A	N/A	REVISED PER DFT-7*2260
DATE	DWN	RE	IV	PROFESSIONAL ENGINEER	PE DISC.	PE#	PE EXP.	



A

B

C

D

E


A

B

C

D

E


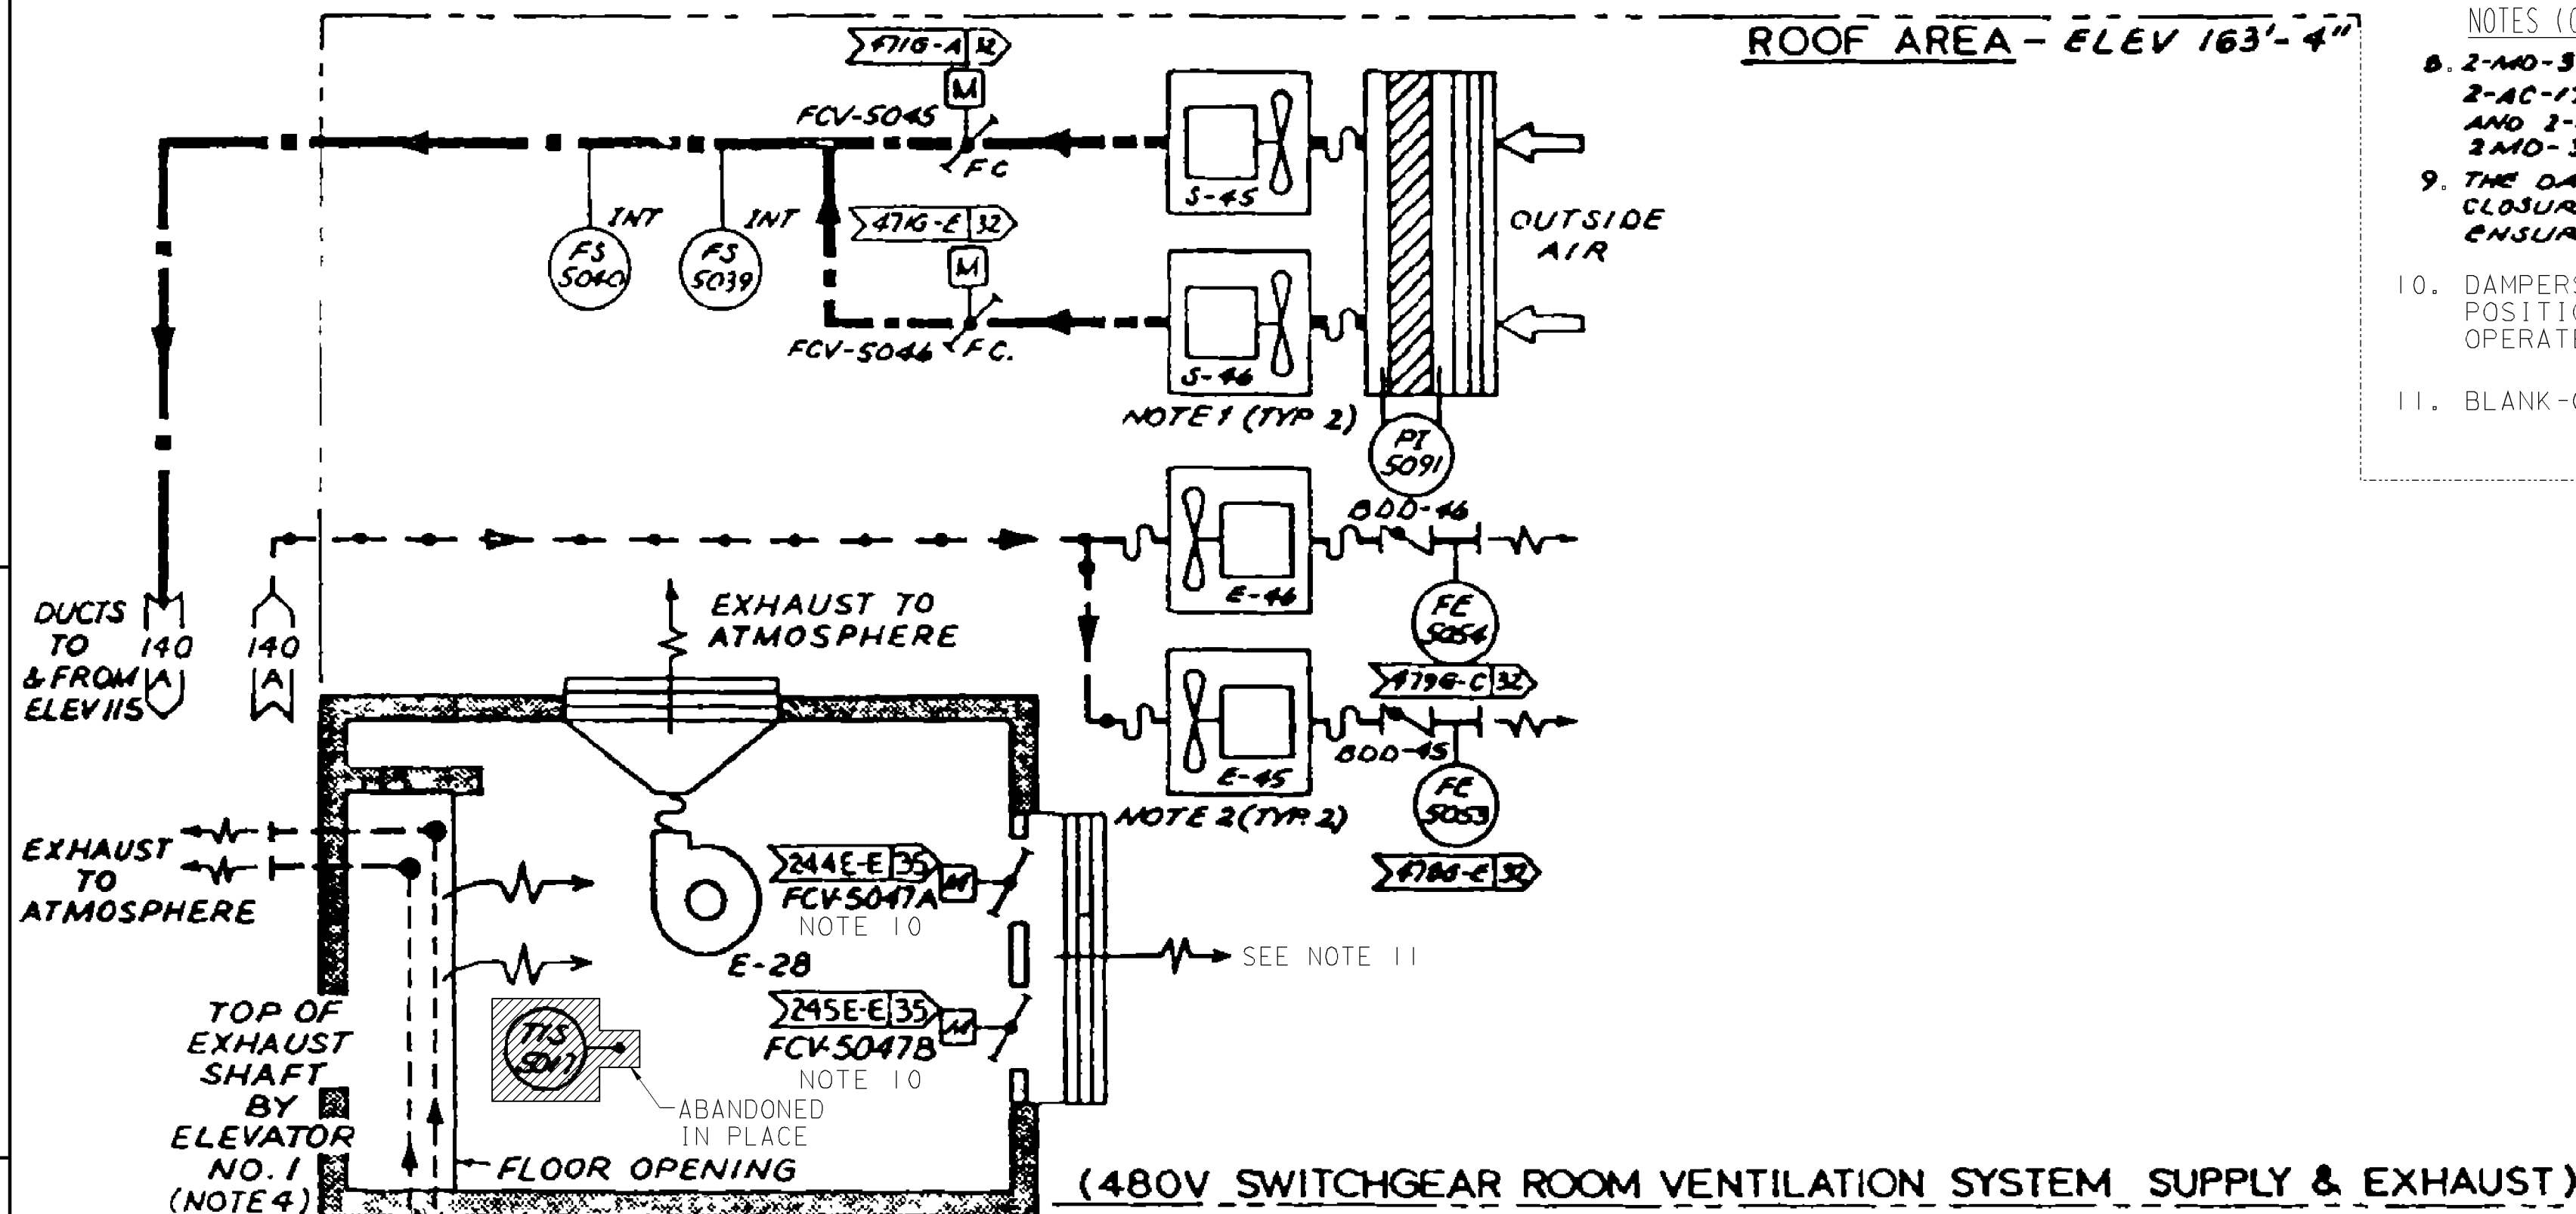


NOTES (CONT.)


- 8. 2-MD-336 IS OPEN, 2-MD-337 AND 2-MD-338 ARE CLOSED WHEN 2-AC-170 IS IN OPERATION. 2-MD-336 IS CLOSED, 2-MD-337 AND 2-MD-338 ARE OPEN WHEN 2-AC-170 IS NOT IN OPERATION. 2-MD-336 AND 2-MD-337 BELONG TO DESIGN CLASS I.
- 9. THE DAMPER HAS BEEN EQUIPPED WITH SPRING AIDED CLOSURE MECHANISM (POSITIVE CLOSURE SPRINGS) TO ENSURE POSITIVE CLOSING.
- 10. DAMPERS FCV-5047A AND FCV-5047B ARE ABANDONED IN THE CLOSED POSITION AND ELECTRICAL WIRING DISCONNECTED FROM MOTOR OPERATED DAMPER ACTUATORS.
- 11. BLANK-OFF PLATE INSTALLED ON EXHAUST LOUVER/DAMPER.

NOTES.

- 1. 100% REDUNDANT AND/OR SEPARATE SUPPLY FANS ON VITAL BUS.
 - 2. 100% REDUNDANT AND/OR SEPARATE EXHAUST FANS ON VITAL BUS.
 - 3. SUPPLY SHAFT FROM MECHANICAL EQUIPMENT ROOM (FLOOR ELEVATION 154'-0") PASSES VERTICALLY DOWN THROUGH ELEVATIONS 128' AND 115' TO END AT ELEVATION 100'.
 - 4. EXHAUST SHAFT PASSES VERTICALLY UP THROUGH ELEVATIONS 85', 100', 115', 128' AND 140' TO E-28 EXHAUST FAN ROOM ON ROOF.
 - 5. FIRE DAMPERS 2-FD-41 AND 2-FD-220 ARE INTERLOCKED WITH PC-123 & PC-122, RESPECTIVELY, OF THE CO₂ SUPPRESSION SYSTEM HAZARD N (REF DWG 108018 SH 6) TO CLOSE UPON ACTIVATION OF THE UNIT 2 CABLE SPREADING ROOM CO₂ SYSTEM. SEE SHEET 2 (108023) OR SHEET 3 (108001).
 - 6. FOR LEGEND, ABBREVIATIONS, INDEX, & GENERAL NOTES, SEE SHEET 2 (108023) OR SHEET 3 (108001).
 - 7. SEE DRAWINGS 59348, 59349 FOR DUCT LAYOUT.
- CONT. AT LEFT-

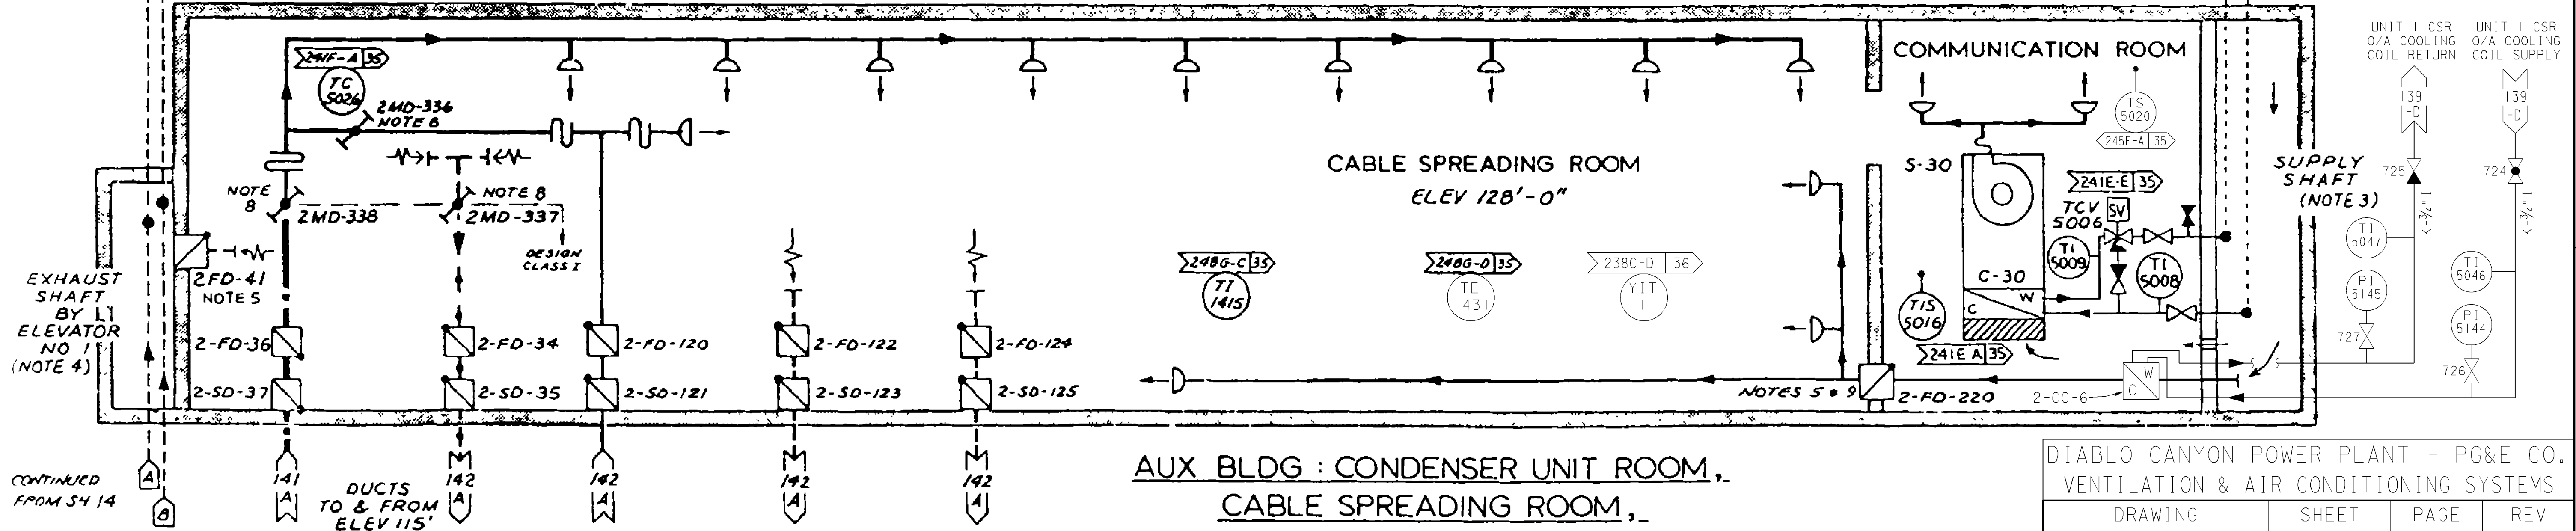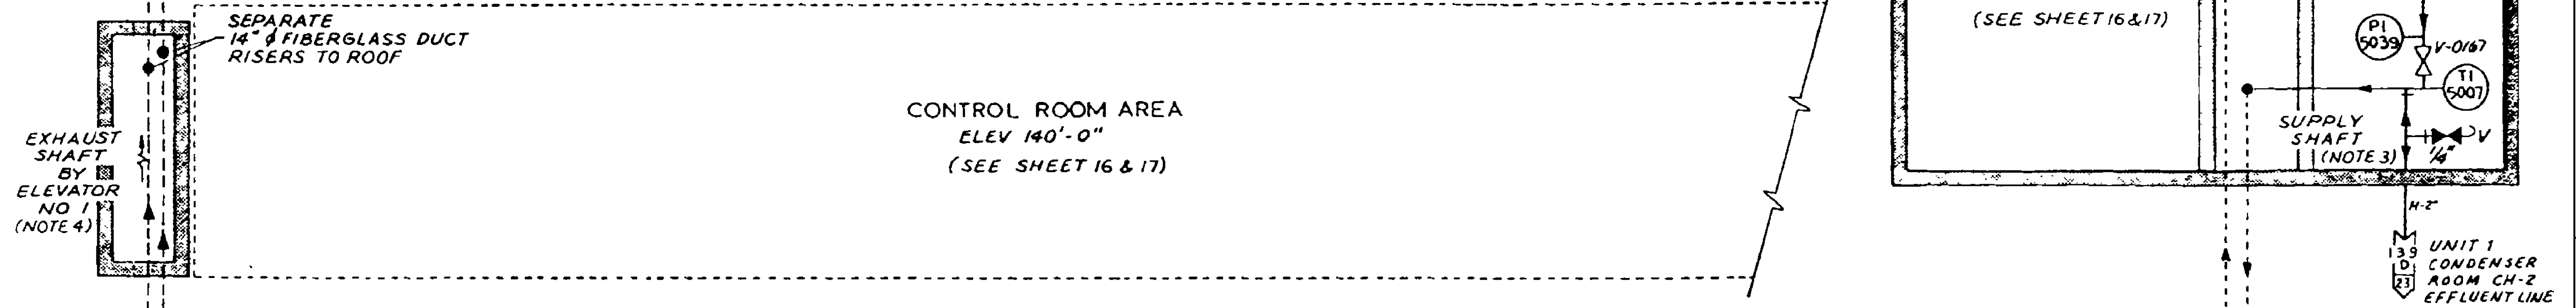

AUX BLDG : CONDENSER UNIT ROOM,
CABLE SPREADING ROOM,
480V SWITCHGEAR ROOM SUPPLY & EXHAUST

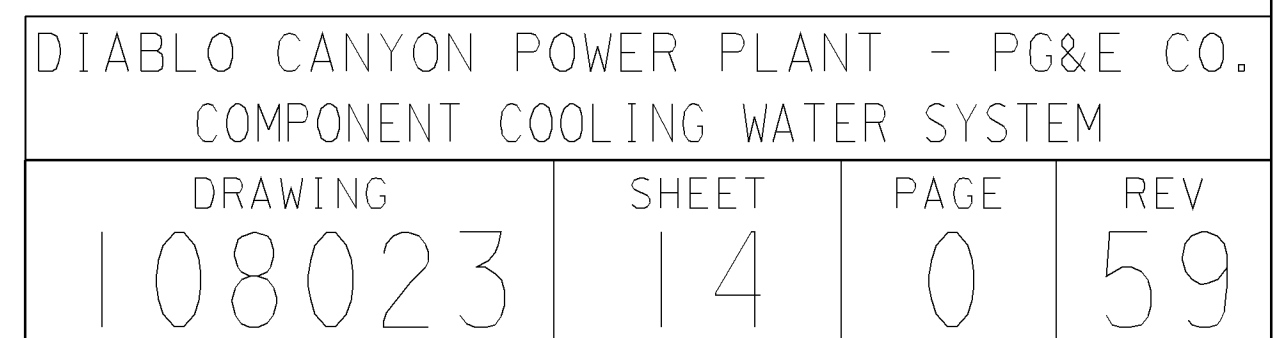

NOTE:
1. THE VENTILATION COAXIAL PIPE (VENT SHAFT EXTENSION)
IS DESIGN CLASS II, SEISMIC CATEGORY I (202-C)


A

B


C

D

E

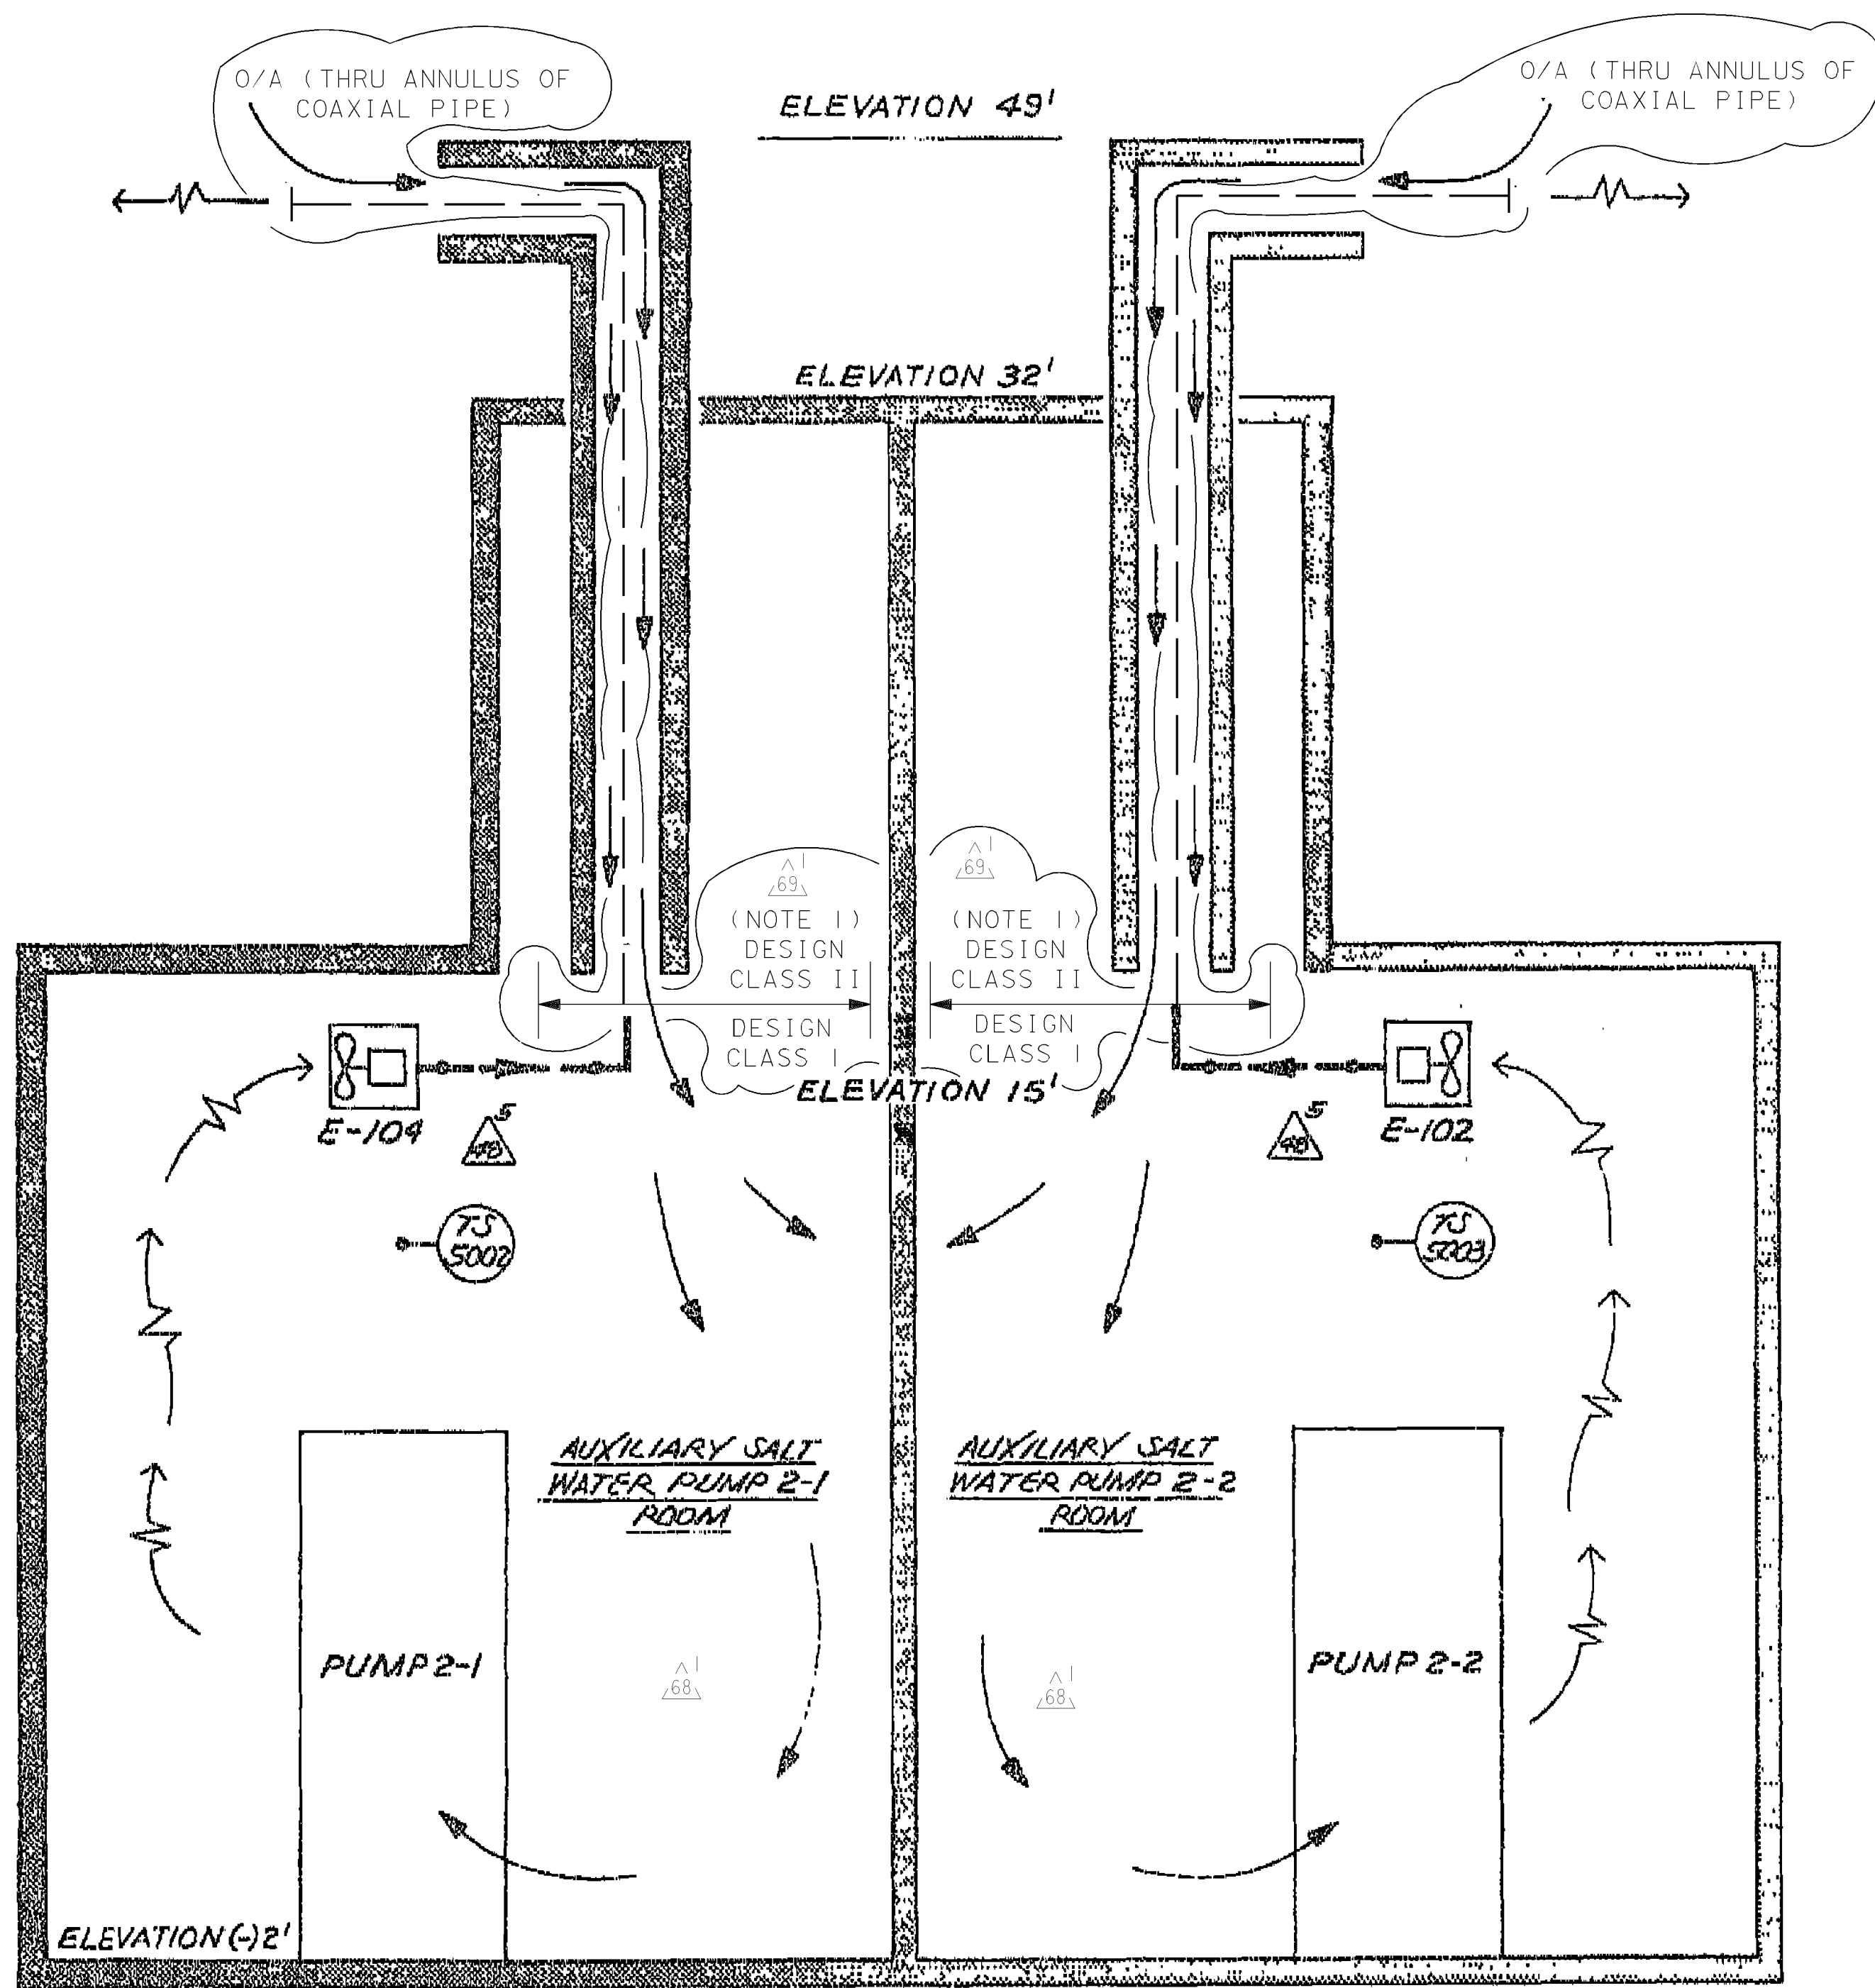

INTAKE STRUCTURE (UNIT 2)
AUXILIARY SALTWATER PUMP ROOM VENTILATION

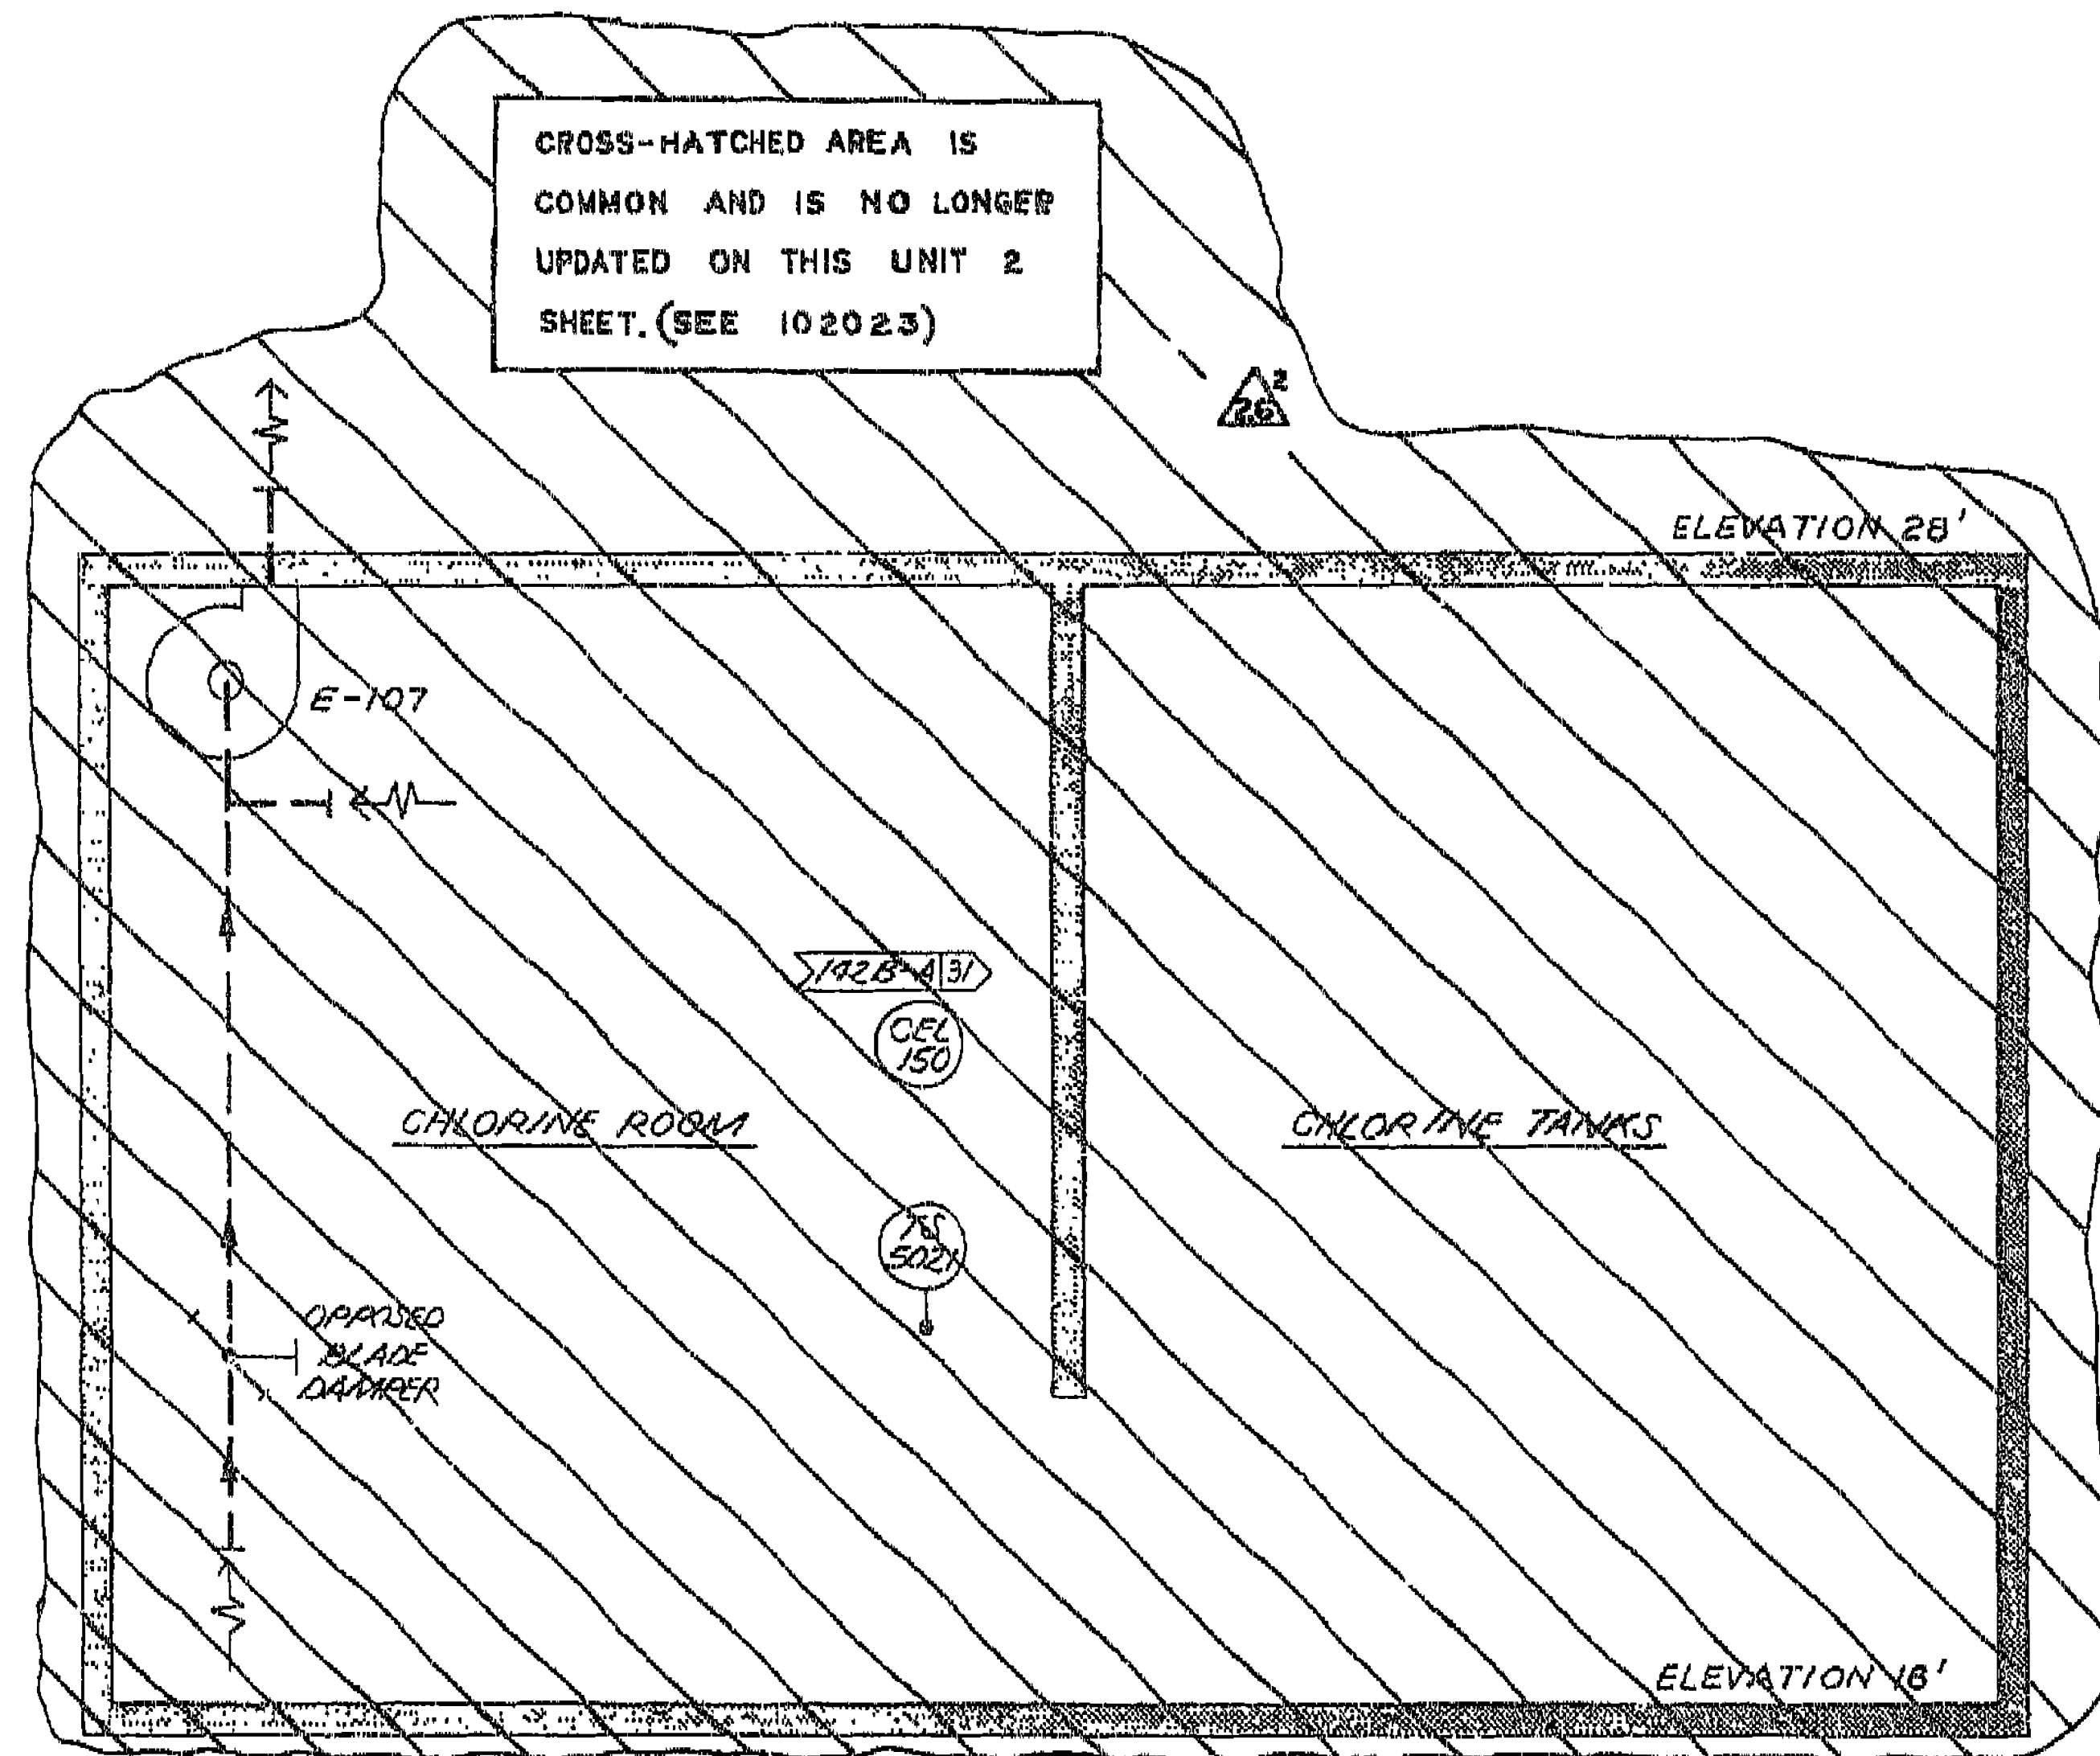


INTAKE STRUCTURE (COMMON - UNIT 1 & 2)
CHLORINATOR, EVAPORATOR, & CHLORINE TANKS ROOM
(ELEVATION 18'-0")

UNIT 2

P G & E CO.	108023	REV.
SHEET 20 OF SHEETS		69



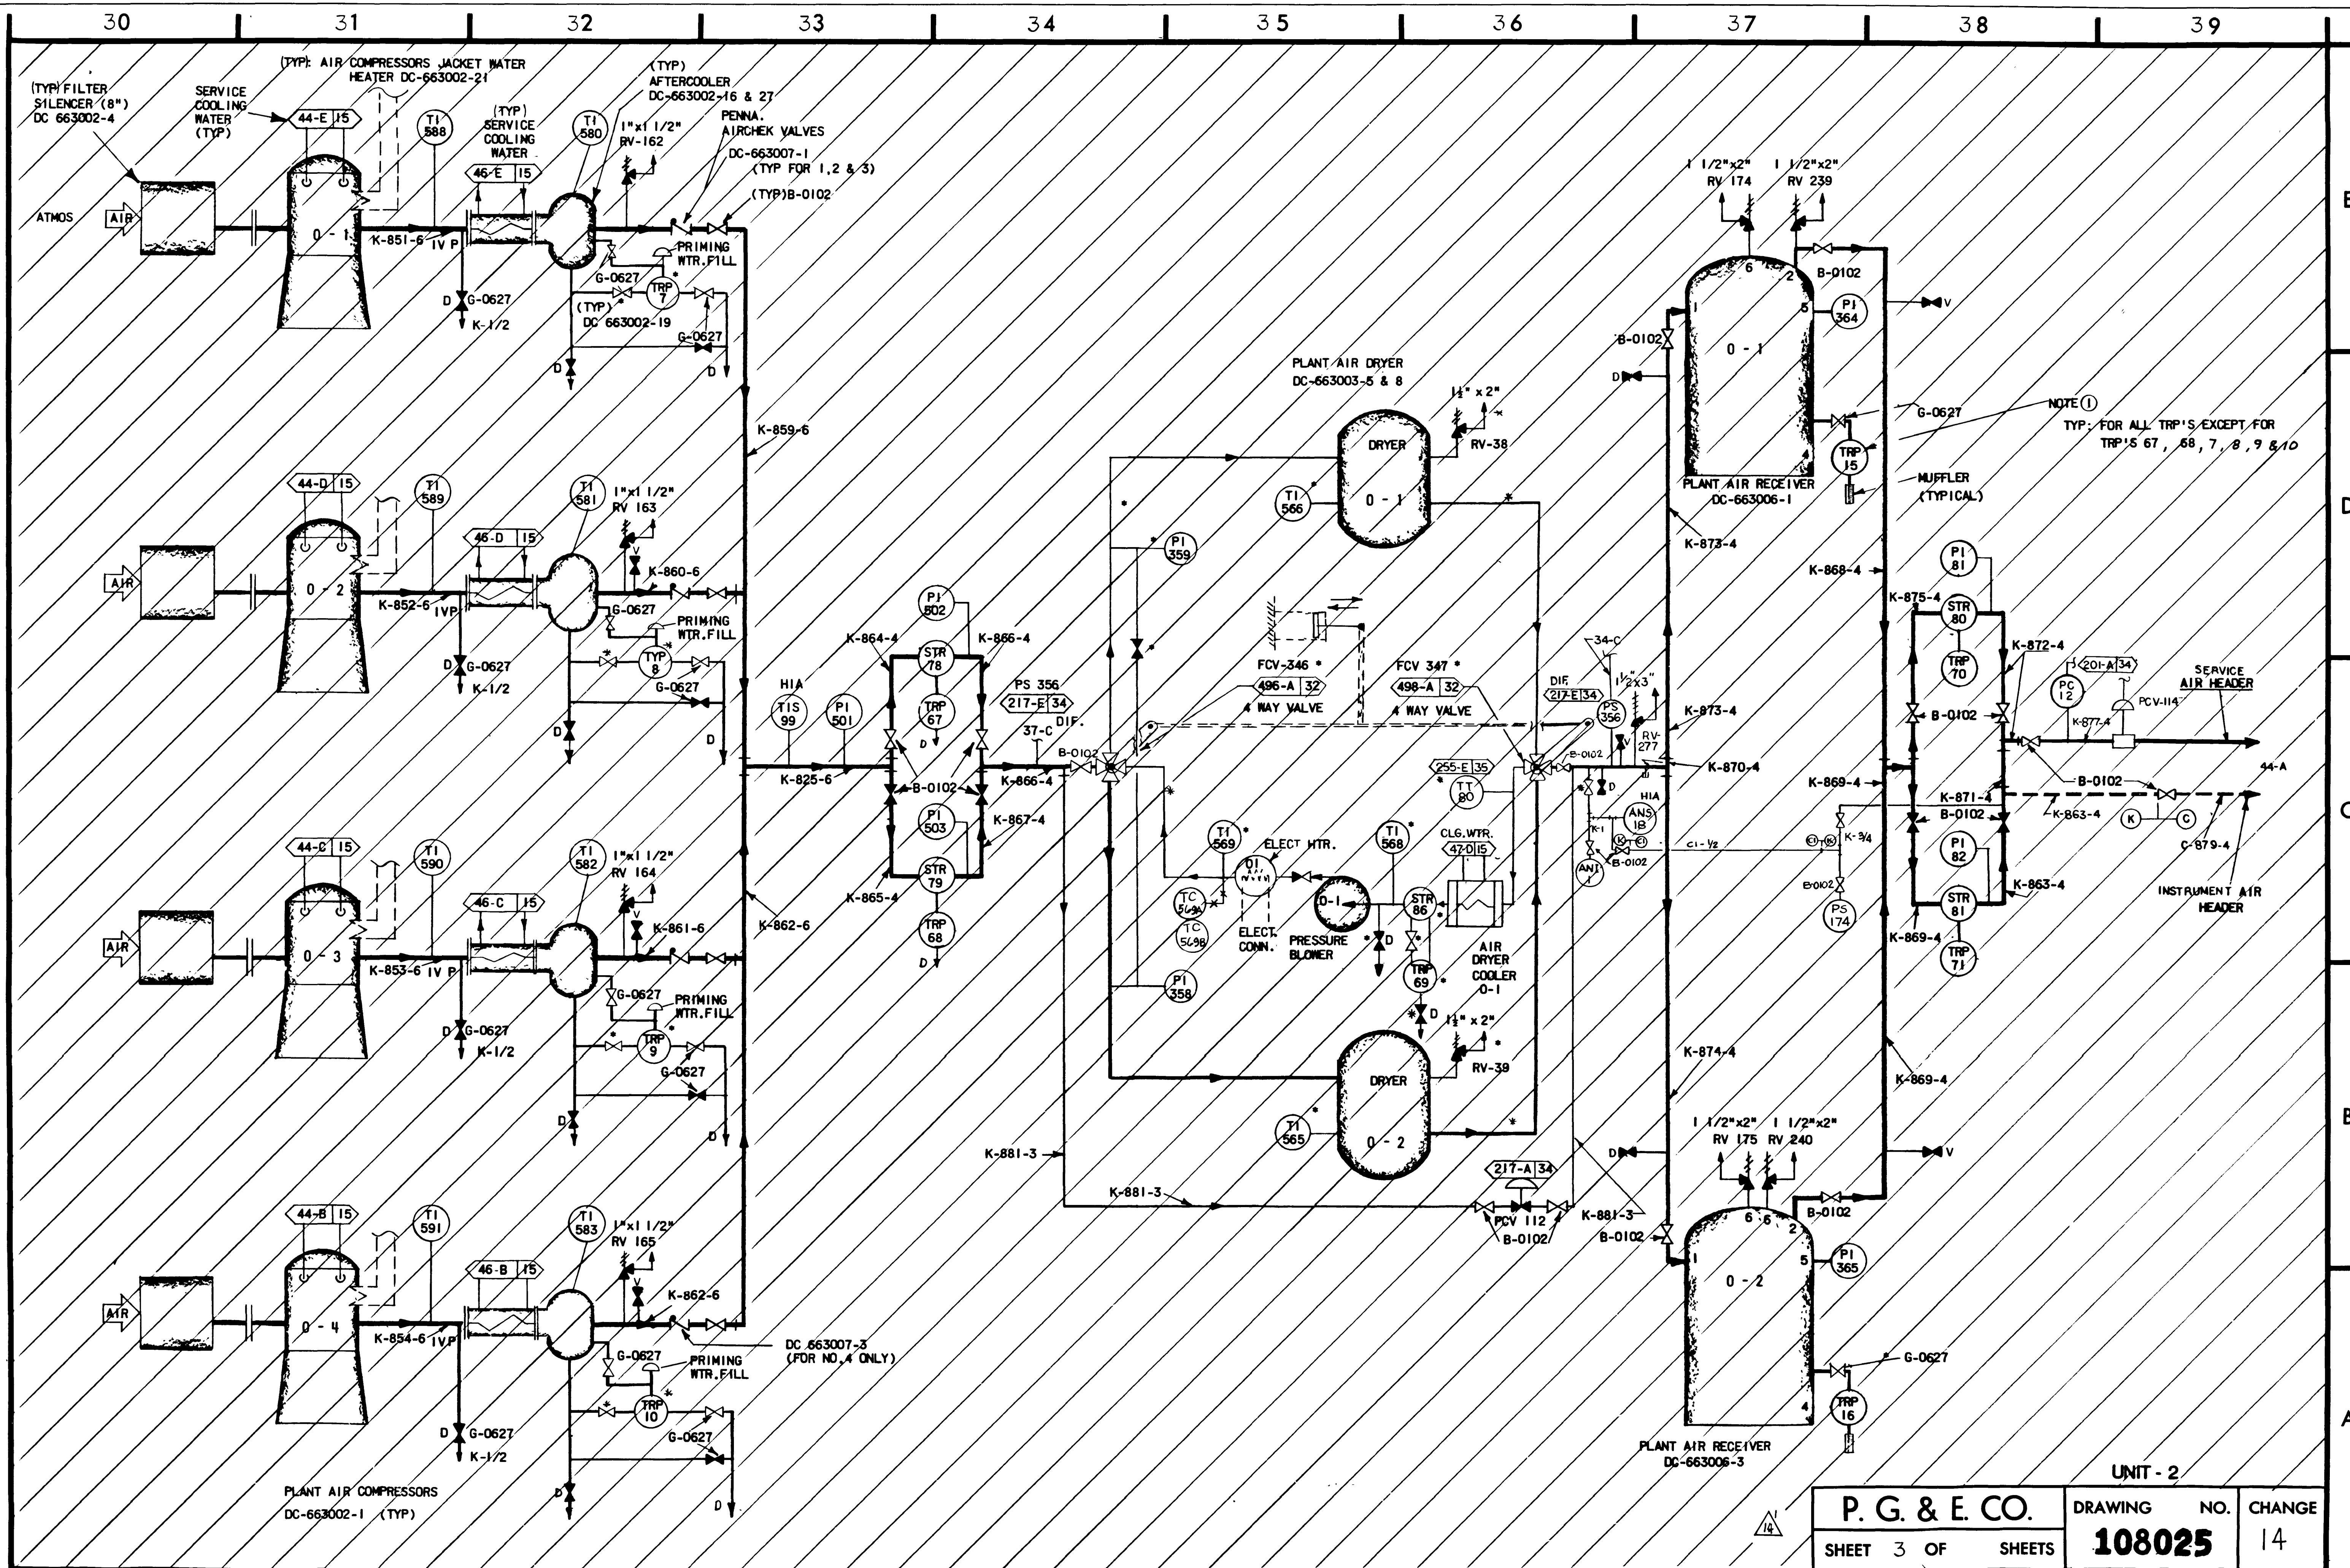


NOTE ①
TYP. FOR ALL TRP'S EXCEPT FOR
TRP'S 67, 68, 7, 8, 9 & 10


P. G. & E. CO.		DRAWING NO.	CHANGE
SHEET 3 OF SHEETS		108025	14

THIS DRAWING HAS BEEN REPRODUCED
WITHOUT CHANGE FROM ORIGINAL DRAWING
CHANGE NO. 1 DATE 4/14/54 APPROVED

35 M/M Neg 4
APPD I&C 14



RM INDEXED REV. 14
SCAN 14 IIC

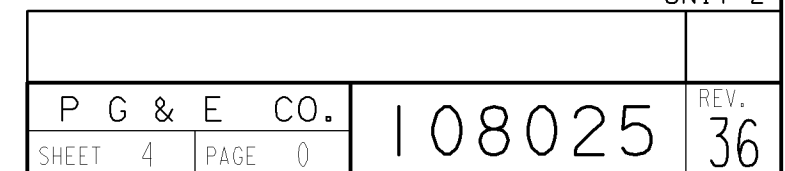

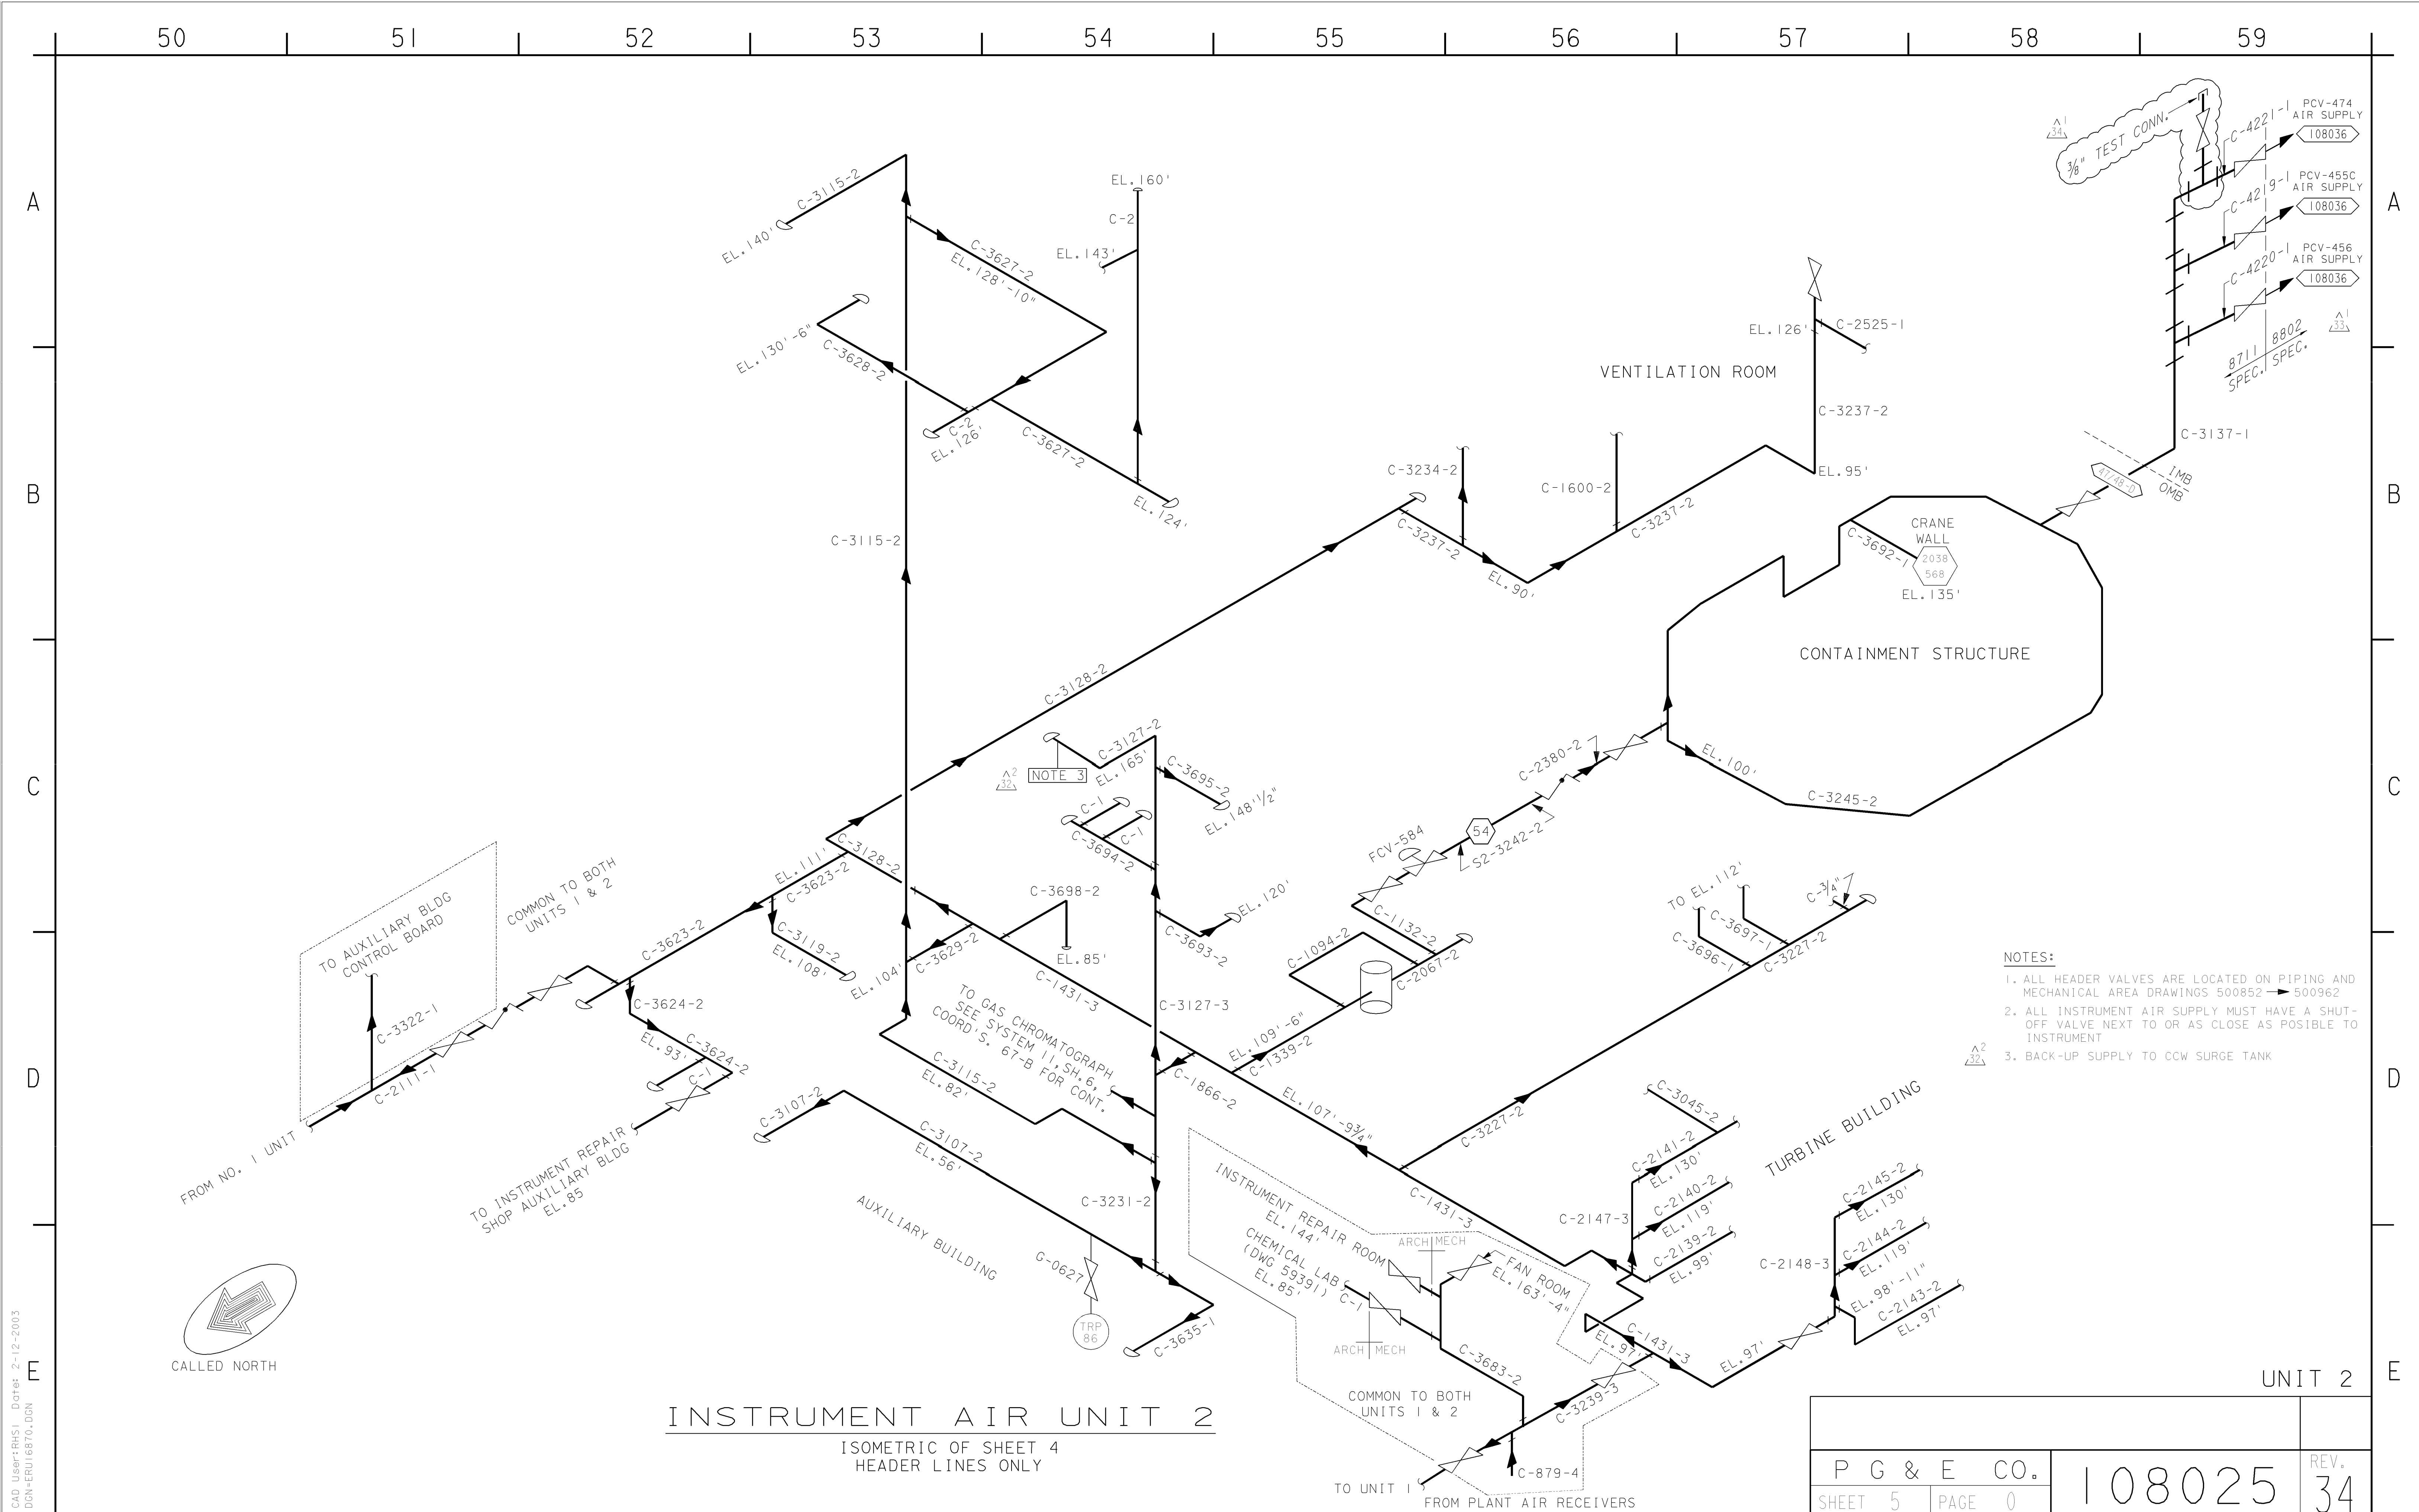

NOTES:

1. ALL PIPING ON THIS SHEET SHALL BE PG&E CLASS E EXCEPT AS NOTED
2. MANUAL VALVES:
WITH ITEM NUMBER SHALL BE UNDER SPEC. 0722
WITH PG&E MARK NUMBER SHALL BE UNDER SPEC. 8711
3. VALVES WITH THIS NOTE (PCV-150,153,154,155 & 156) SHALL BE LOCATED AS CLOSE TO THE TANKS AS POSSIBLE
4. PCV WITH THIS NOTE HAS AN INTEGRAL RELIEF VALVE (PCV-146 & 147)
5. PRESSURE GAGE INTEGRAL WITH PCVs
PRESSURE DOWNSTREAM OF PCV-146=115 PSIG
6. 4R2 BALL VALVES DWG 053479
7. SEE DWG 341001
8. CONTROMATICS 3/4" BALL VALVE 3/4-B/C-16-22-B-C-FP
9. CONTROMATICS 1" BALL VALVE 1-B/C-16-22-B-C-FP
10. DELETED
11. VALVES ARE 3/4" WHITEY SS-L63TSW12T
12. INSTRUMENT DESIGN CLASSIFICATION II; 3/4" x 0.065" WALL SS TUBING
13. 3/4" WHITEY MODEL "SS-63ES12
14. 1" SPRING LOADED CHECK VALVE,
CIRCLE SEAL 249T-8PP-6.

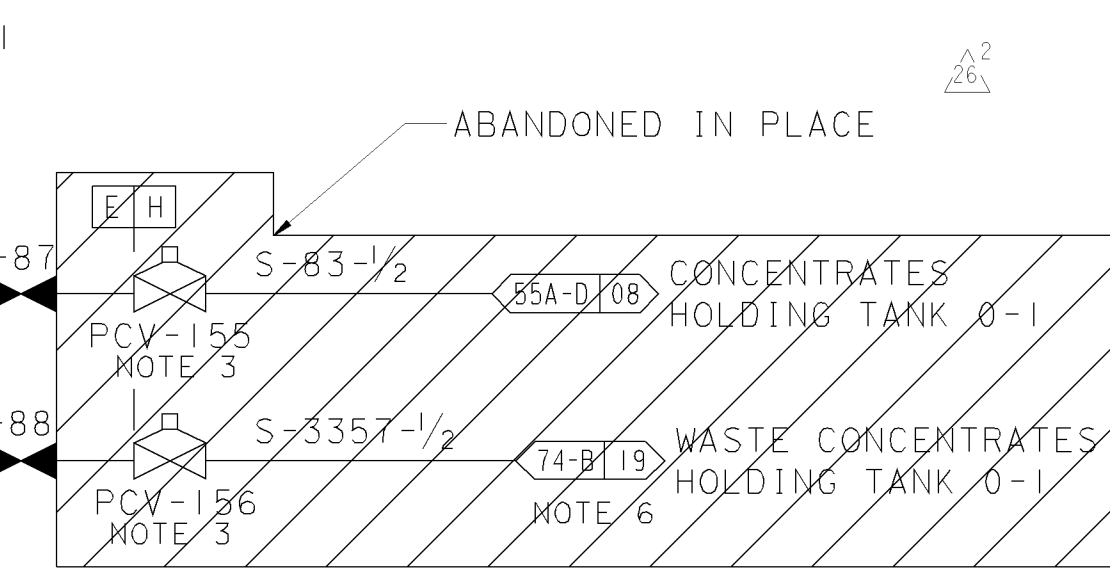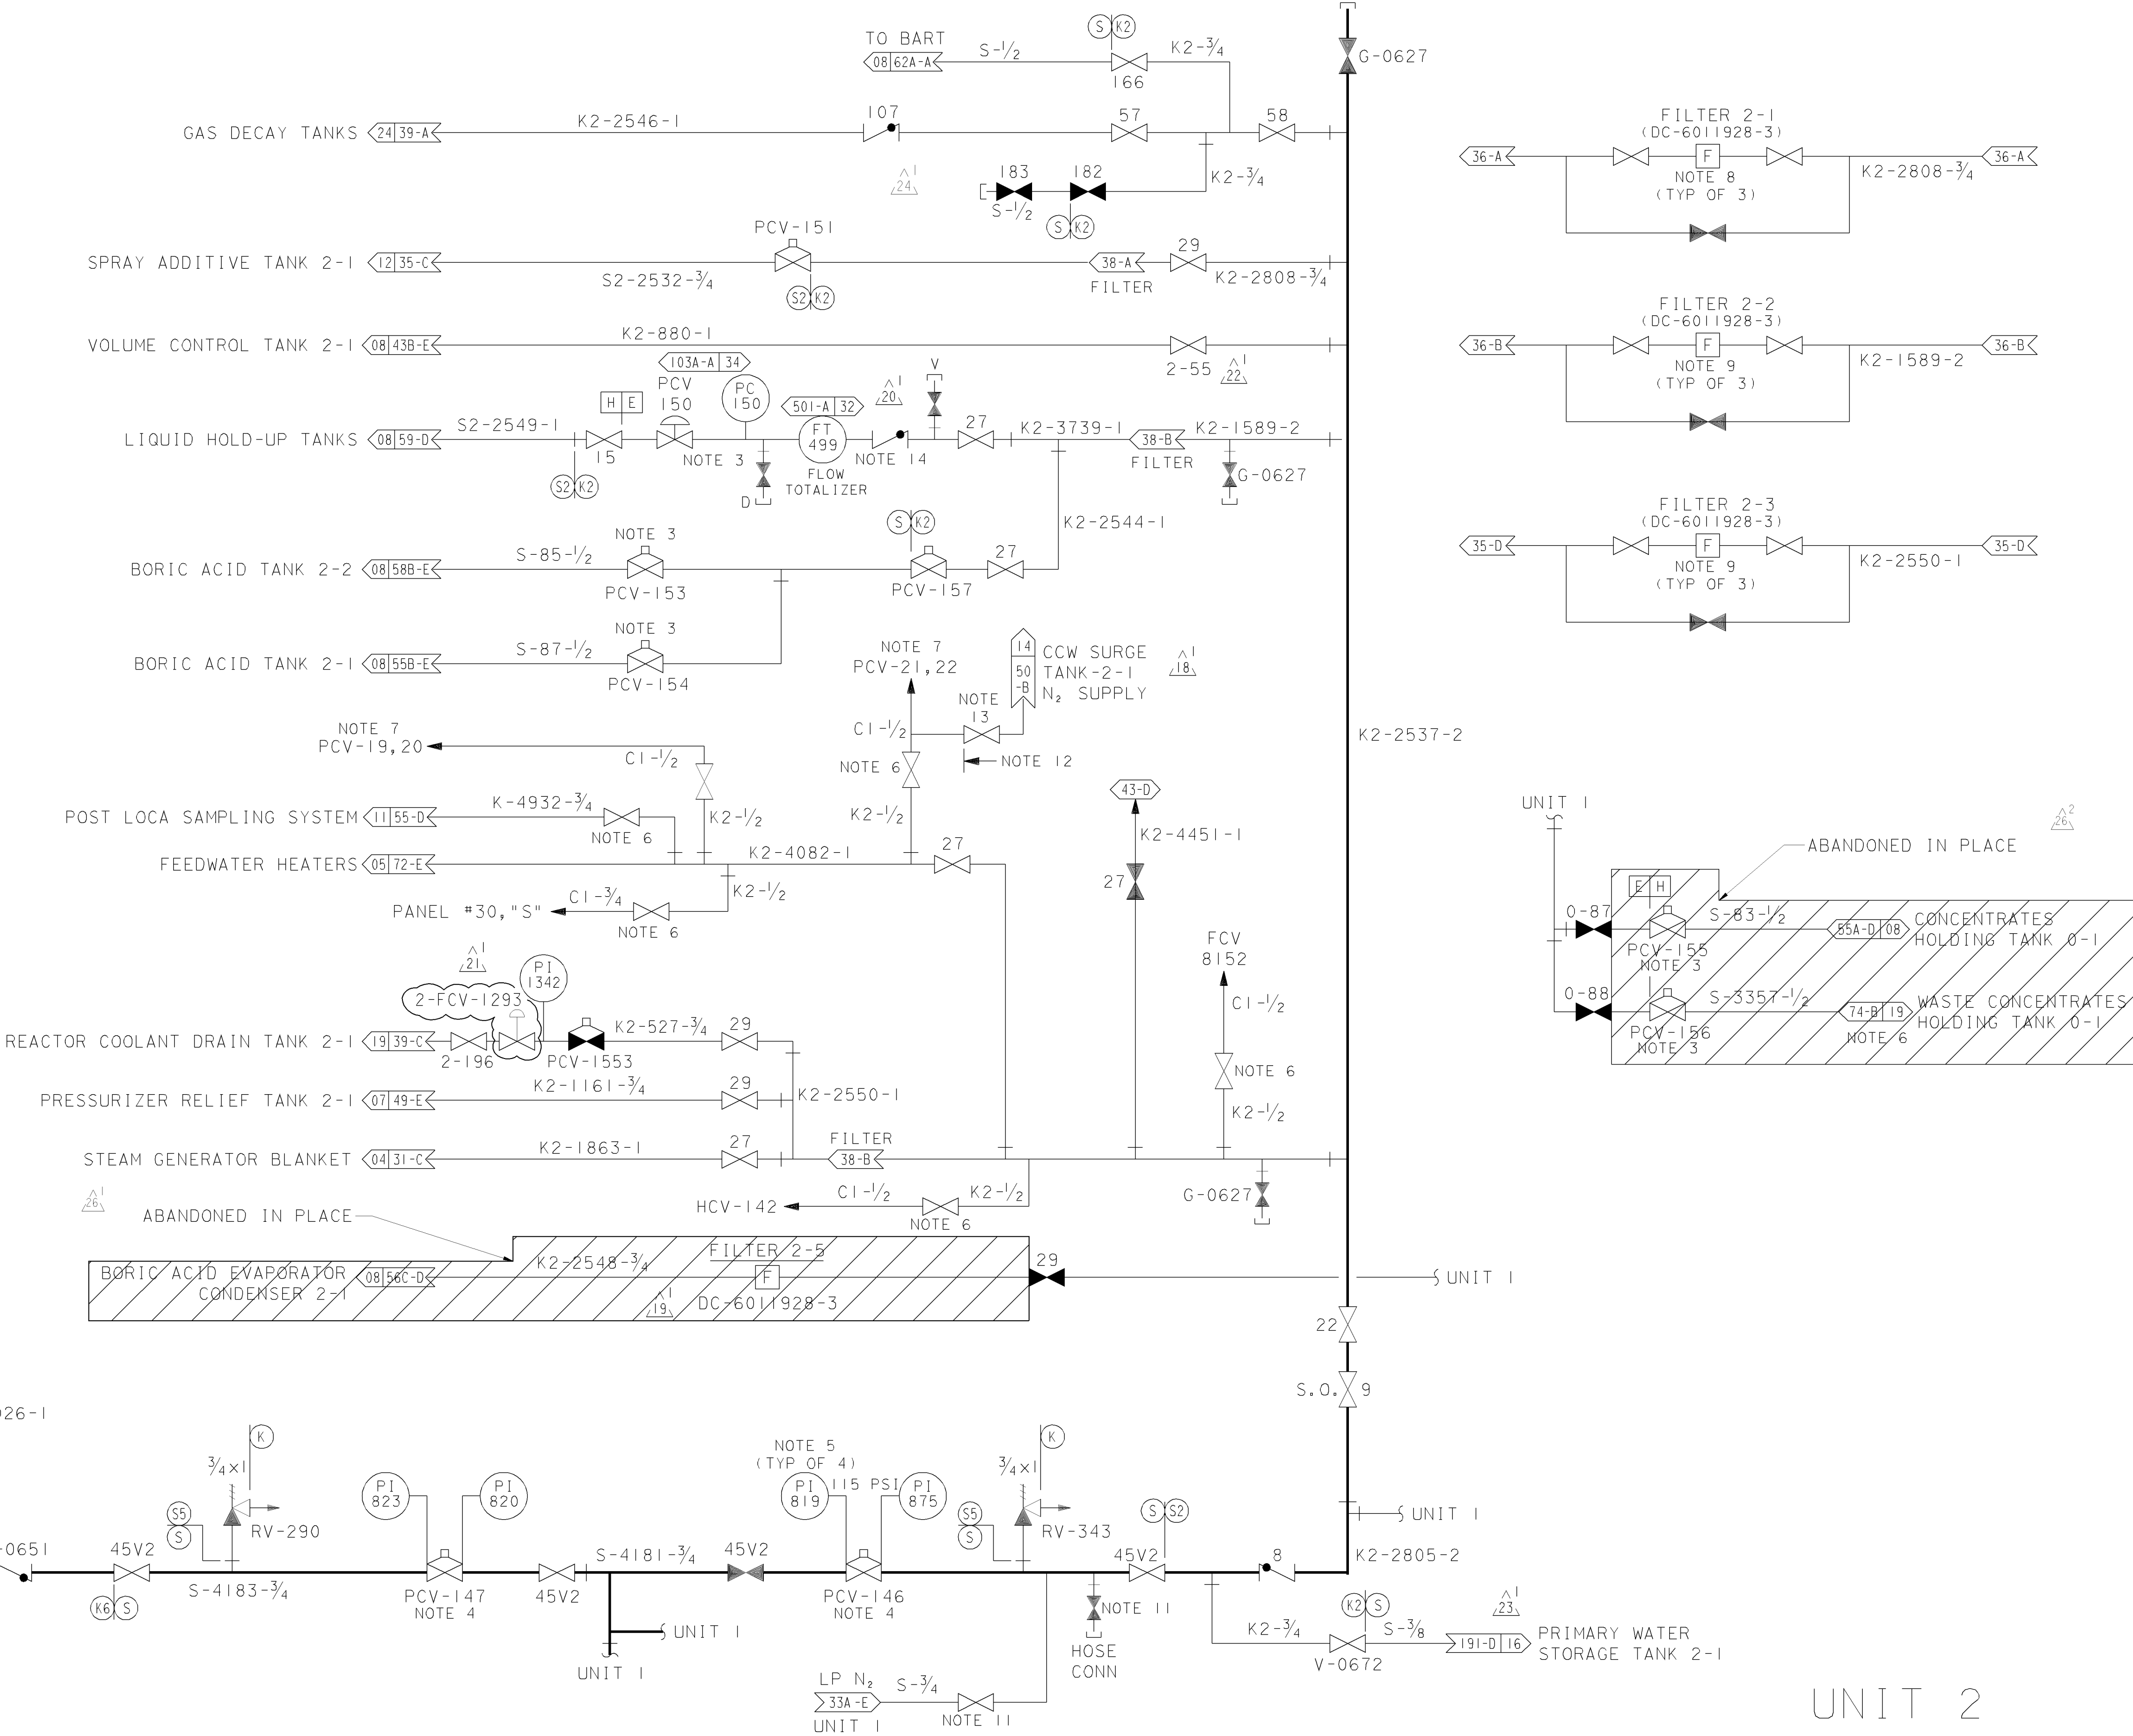

NITROGEN SUPPLY SYSTEM


UNIT 2

DIABLO CANYON POWER PLANT - PG&E CO.
NITROGEN AND HYDROGEN SYSTEMS

DRAWING	SHEET	PAGE	REV
108026	3	0	27

01-24-2013	MNRU	FxC2		KERSI J. DALAL	MECHANICAL	M 16690	3/31/2014	REVISED PER DDN-2*961
DATE	DWN	RE	IV	PROFESSIONAL ENGINEER	PE DISC.	PE#	PE EXP.	

PASTER=001e1246.DGN
DCN=001e1246.DGN
CAD User: MNRU Date: 01-24-2013

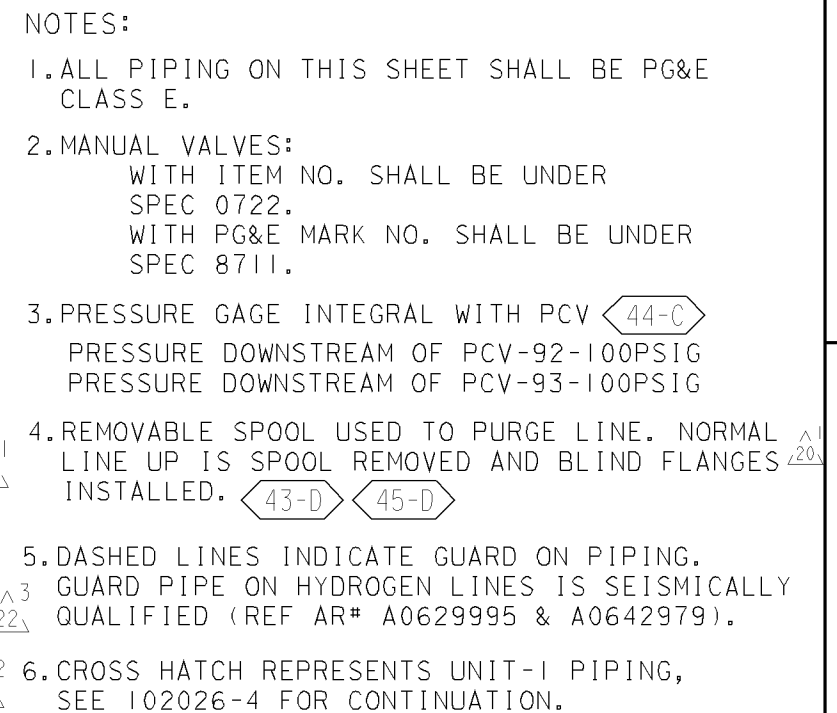

DRAWING	SHEET	PAGE	REV
108026	4	0	25

NOTES:


1. ALL PIPING ON THIS SHEET SHALL BE PG&E CLASS "E".
2. ALL PIPING TO BE "K" SPEC. UNLESS NOTED.
3. COMPONENT COOLING HEAT EXCHANGER SUMP DISCHARGE HEADER LINE 2986 TO SLOPE DOWN LIQUID RADWASTE (38-B). TO BE USED ONLY AS STANDBY (36-B).
4. CHECK VALVE LOCATED ABOVE THE HIGHEST WATER LEVEL OF THE RETENTION TANK (37-D).
5. THERE IS A SINGLE OILY WATER SEPARATOR AND REVERSE OSMOSIS SYSTEM LOCATED ON THE UNIT 1 SIDE.
6. EXPANSION JOINT, GARLOCK MODEL 204SP, S/C 78-1490.
7. 1/4" FLEX HOSE IS ALSO ACCEPTABLE. (30-D)
8. LINE 5597 HAS BEEN REPLACED WITH LINED CARBON STEEL PIPE MADE BY CRANE-RESISTOFLEX. REF. AR A0536427 (32-D)

TURBINE BUILDING SUMP
OILY WATER SEPARATOR
(MAXIMUM CAPACITY 100 GPM)

P G & E CO.		108027	REV. 11
SHEET 3	PAGE 0		

10/17/03	AJL2	CDP3	-	KERSI J. DALAL	MECHANICAL	M 16690	3/31/2004	Revised per FCT 025843
DATE	DWN	RE	IV	PROFESSIONAL ENGINEER	PE DISC.	PE#	PE EXP.	

RASTER=002c1078.dgn
 DGN=002c1078.dgn
 CAD User=AJFJ Date: 11-21-2011

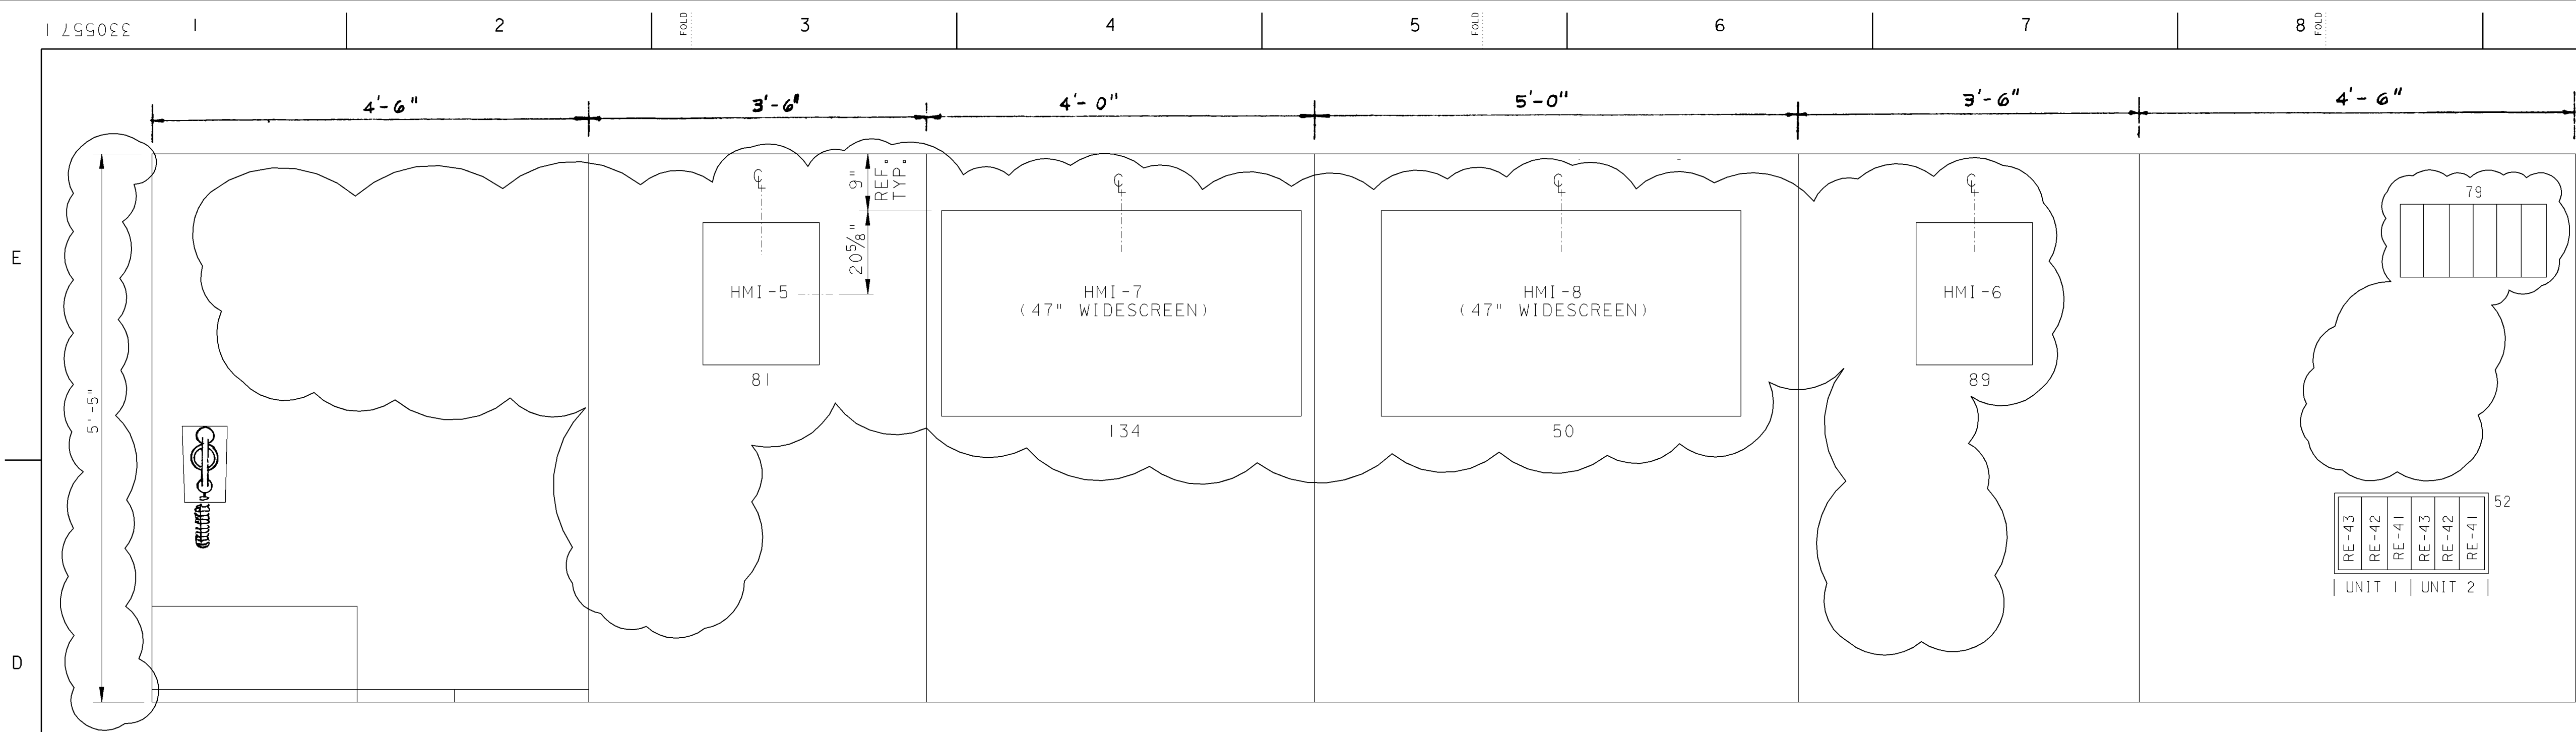

POBI
②

POCVI
CHEMICAL and VOLUME
CONTROL SYSTEM
③

POWE
④


POEC
⑤

POCV2
CHEMICAL and VOLUME
CONTROL SYSTEM
③

POB2
②

UNIT 1

UNIT 2

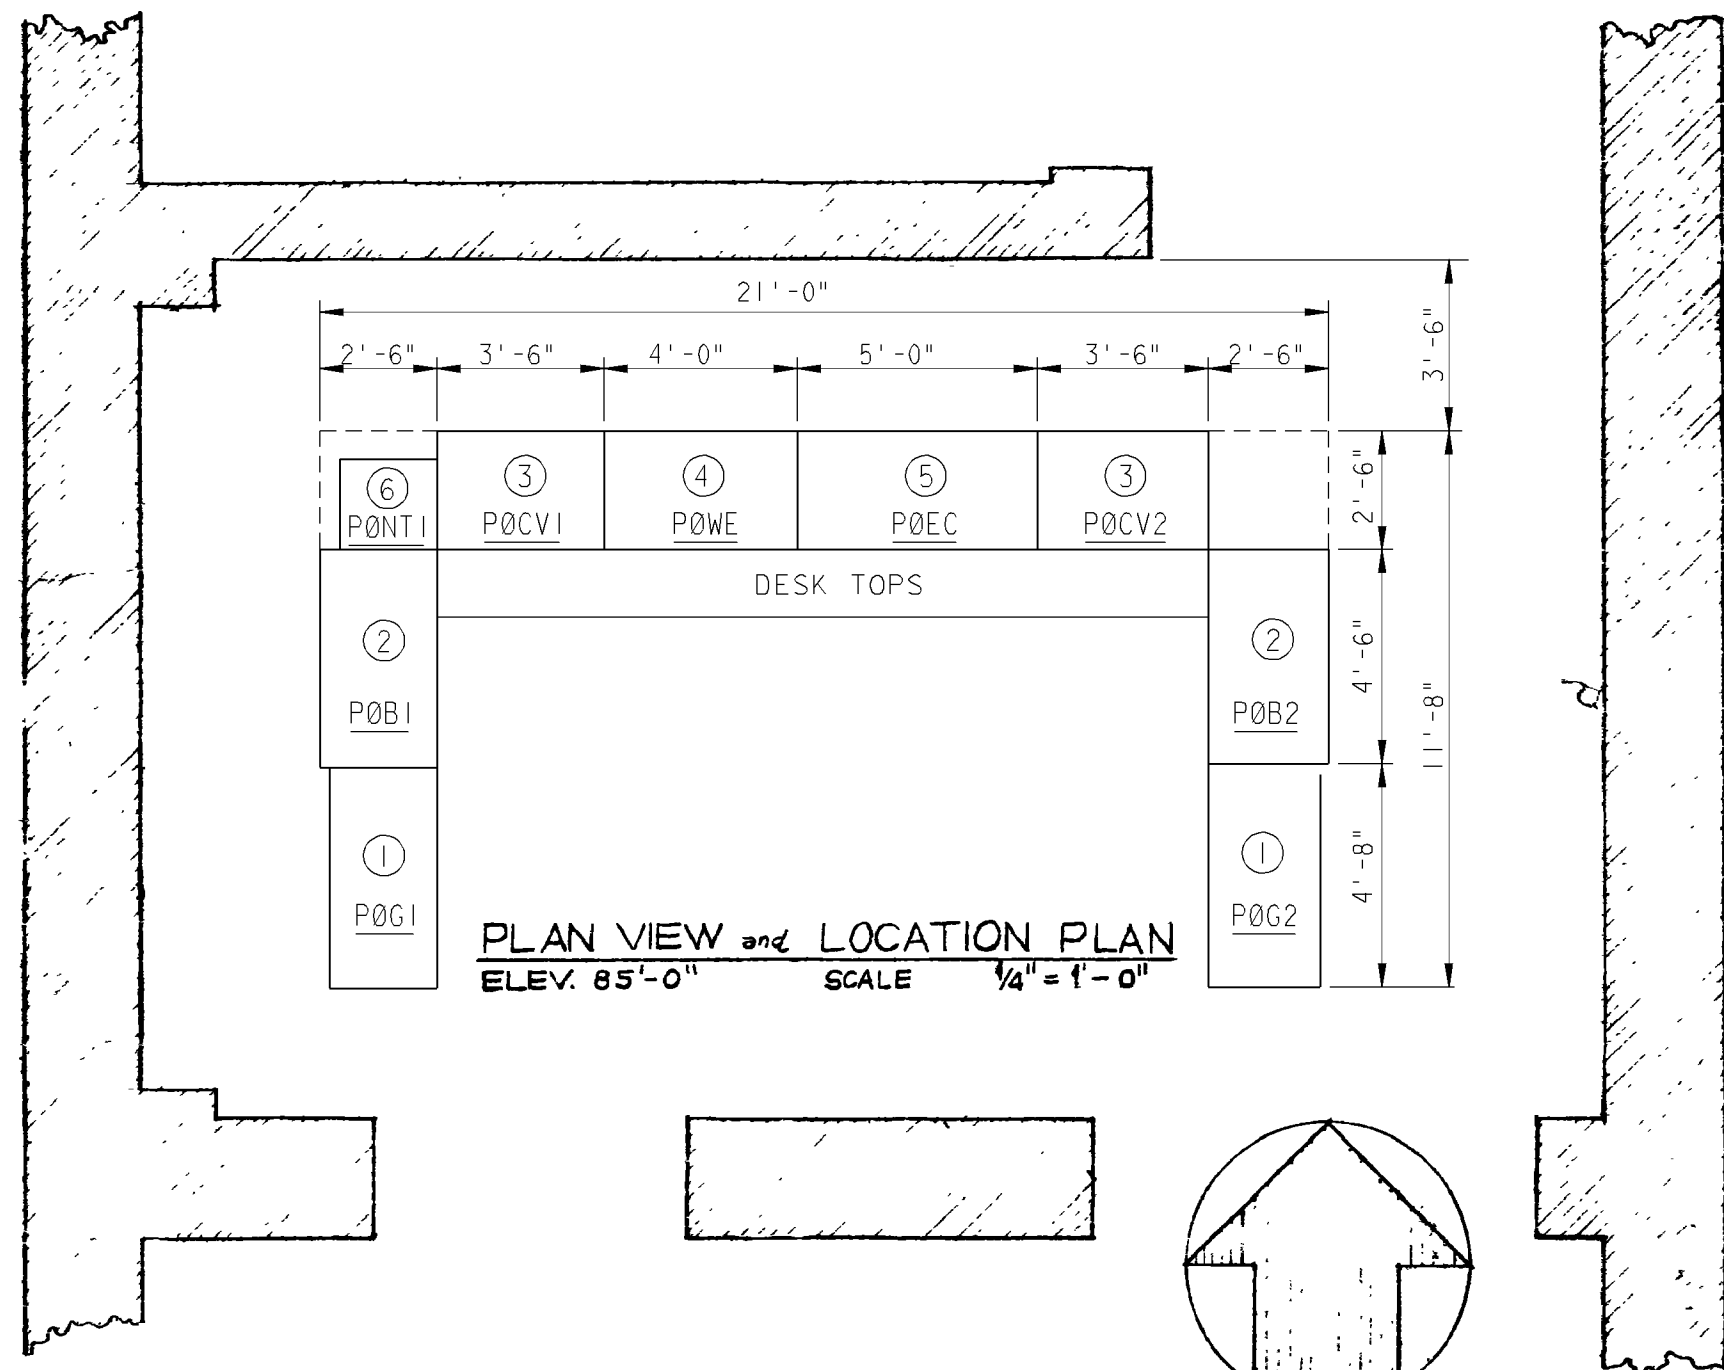

PLAN VIEW and LOCATION PLAN
ELEV. 85'-0" SCALE 1/4" = 1'-0"

PANEL CODE

- ① GAS ANALYZER
 ② MISCELLANEOUS RADWASTE (POBI & POB2)
 ③ CHEMICAL VOLUME CONTROL SYSTEM (POCVI & POCV2)
 ④ GASEOUS RADWASTE (POWE)
 ⑤ LIQUID RADWASTE (POEC)
 ⑥ HEAT TRACING CABINET

REFERENCES

1. DELETED
 2. DELETED
 3. AUXILIARY BUILDING CONTROL
 PANEL 1-2 ARRANGEMENT----- DWG# 334420
 4. AUXILIARY BUILDING CONTROL
 PANEL 2-2 ARRANGEMENT----- DWG# 334421
 5. AUXILIARY BUILDING CONTROL
 PANEL 5. CUTOUTS & DIMENSIONS- DWG# 334426
 6. AUXILIARY BUILDING CONTROL
 PANEL
 MISCELLANEOUS
 DETAILS --- DWG# 334428

KEY DWG. SECTION 13

UNIT 1 & 2

DATE	11-21-2011
D.D.	AJFJ
R.E.	FxC2
I.V.	
P.E.	AGB2



REVISION DESCRIPTION
REVISED PER DAS-6*434 & DDN-2*564

I & C
 AUXILIARY BUILDING
 CONTROL PANEL
 ARRANGEMENT
 DIABLO CANYON POWER PLANT
 PACIFIC GAS AND ELECTRIC COMPANY
 SAN FRANCISCO, CALIFORNIA

DWG SCALE:			
BILL OF MATL:			
SUPSDS:			
SUPSD BY:			
DRAWING	SHEET	PAGE	REV
330557	1	0	29


E

D

C

B

A

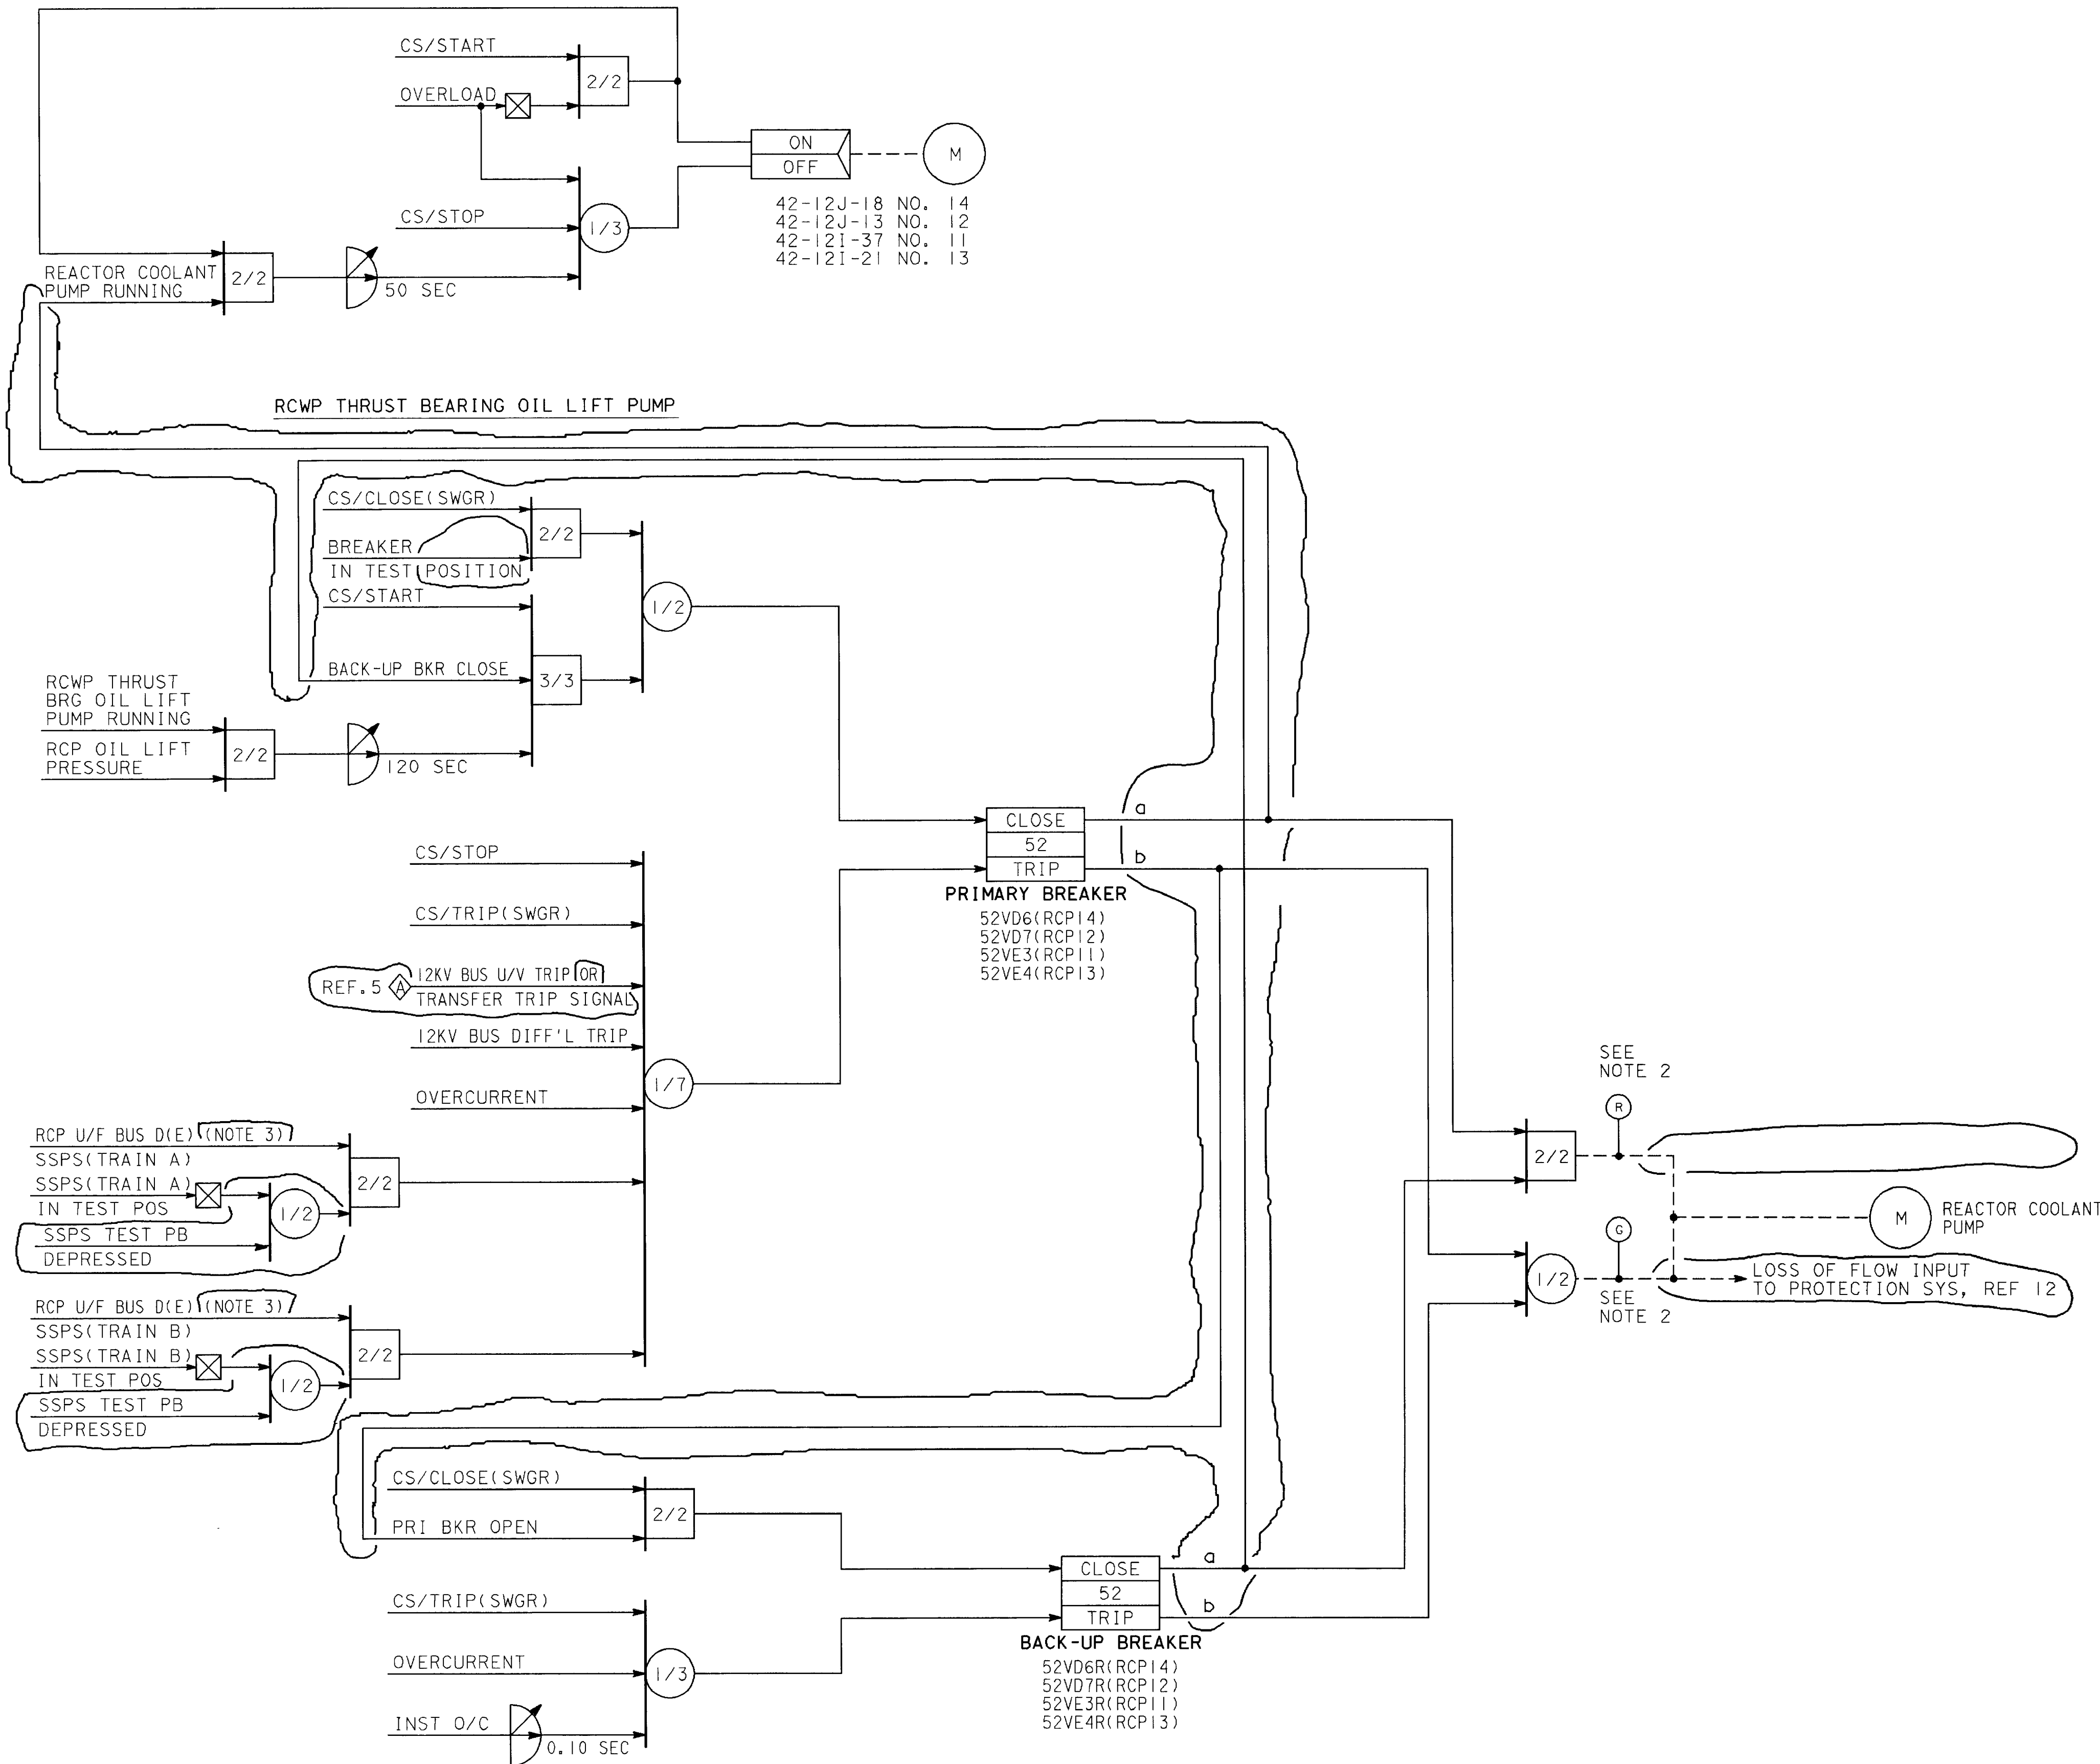

NOTES:

1. \diamond - DENOTES INTERCONNECTION TO OTHER LOGIC DIAGRAM, REF 5.
2. INDICATION LIGHTS ON MAIN CONTROL BOARD INDICATE BOTH THE PRI BREAKER & B-U BREAKER POSITIONS.
3. FOR RCP BUS UNDERFREQUENCY LOGIC SEE REF. 12.

REFERENCES:

- | | DWG NO. |
|---|---------|
| 1. LOGIC SYMBOLS | 19425 |
| 2. ELECTRICAL DEVICE LIST | 050024 |
| 3. INSTRUMENT REF | 102038 |
| 4. SLM&R 12KV BUS D&E | 437531 |
| 5. LOGIC DIAG 12KV BUS SECT D&E AUTO TRANSFER | 19423 |
| 6. SCHEMATIC DIAGRAM SSPTS TRAIN A | 501869 |
| 7. SCHEMATIC DIAGRAM SSPTS TRAIN B | 503088 |
| 8. SCHEMATIC DIAGRAM REACTOR COOLANT PUMP 11 | 477846 |
| 9. SCHEMATIC DIAGRAM REACTOR COOLANT PUMP 12 | 477847 |
| 10. SCHEMATIC DIAGRAM REACTOR COOLANT PUMP 13 | 477848 |
| 11. SCHEMATIC DIAGRAM REACTOR COOLANT PUMP 14 | 477849 |
| 12. FUNCTIONAL LOGIC DIAGRAM PRIMARY COOLANT SYSTEM TRIP SIGNAL | 495845 |

DWG TYPE	DWG SUBJECT	DRAWING TITLE	UNIT No.
4	15	REACTOR COOLANT PUMP	42

PROJECT LOCATION	INSTALLATION	DIVISION	DD CODE	MAN HOURS	CADD	DRAWING SOURCE
DIABLO	L	B	GD	55	56	C

RM INDEXED REV

REV	DESCRIPTION	DATE	SIGNATURE	CA REG NO.	EXP DATE
3	M. Baan	12/31/94			

NUCLEAR SAFETY RELATED


KEY DWG SECT 3

UNIT 1

APPROVED BY	DATE
GM 167027	
FJM	
JWC	
JRH	

LOGIC DIAGRAM
REACTOR COOLANT PUMP

DIABLO CANYON
DEPARTMENT OF ENGINEERING
PACIFIC GAS AND ELECTRIC COMPANY
SAN FRANCISCO, CALIFORNIA

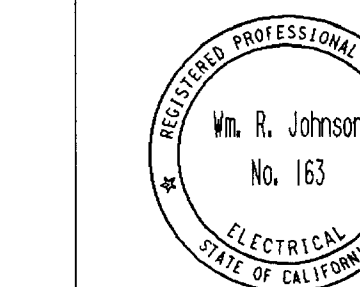

COAST VALLEY DIVISION

MICROFILM

BILL OF MATL

DWG LIST

SUPSDS 19403


SUPSD BY

SHEET NO.

338070

REV

U#2-102787

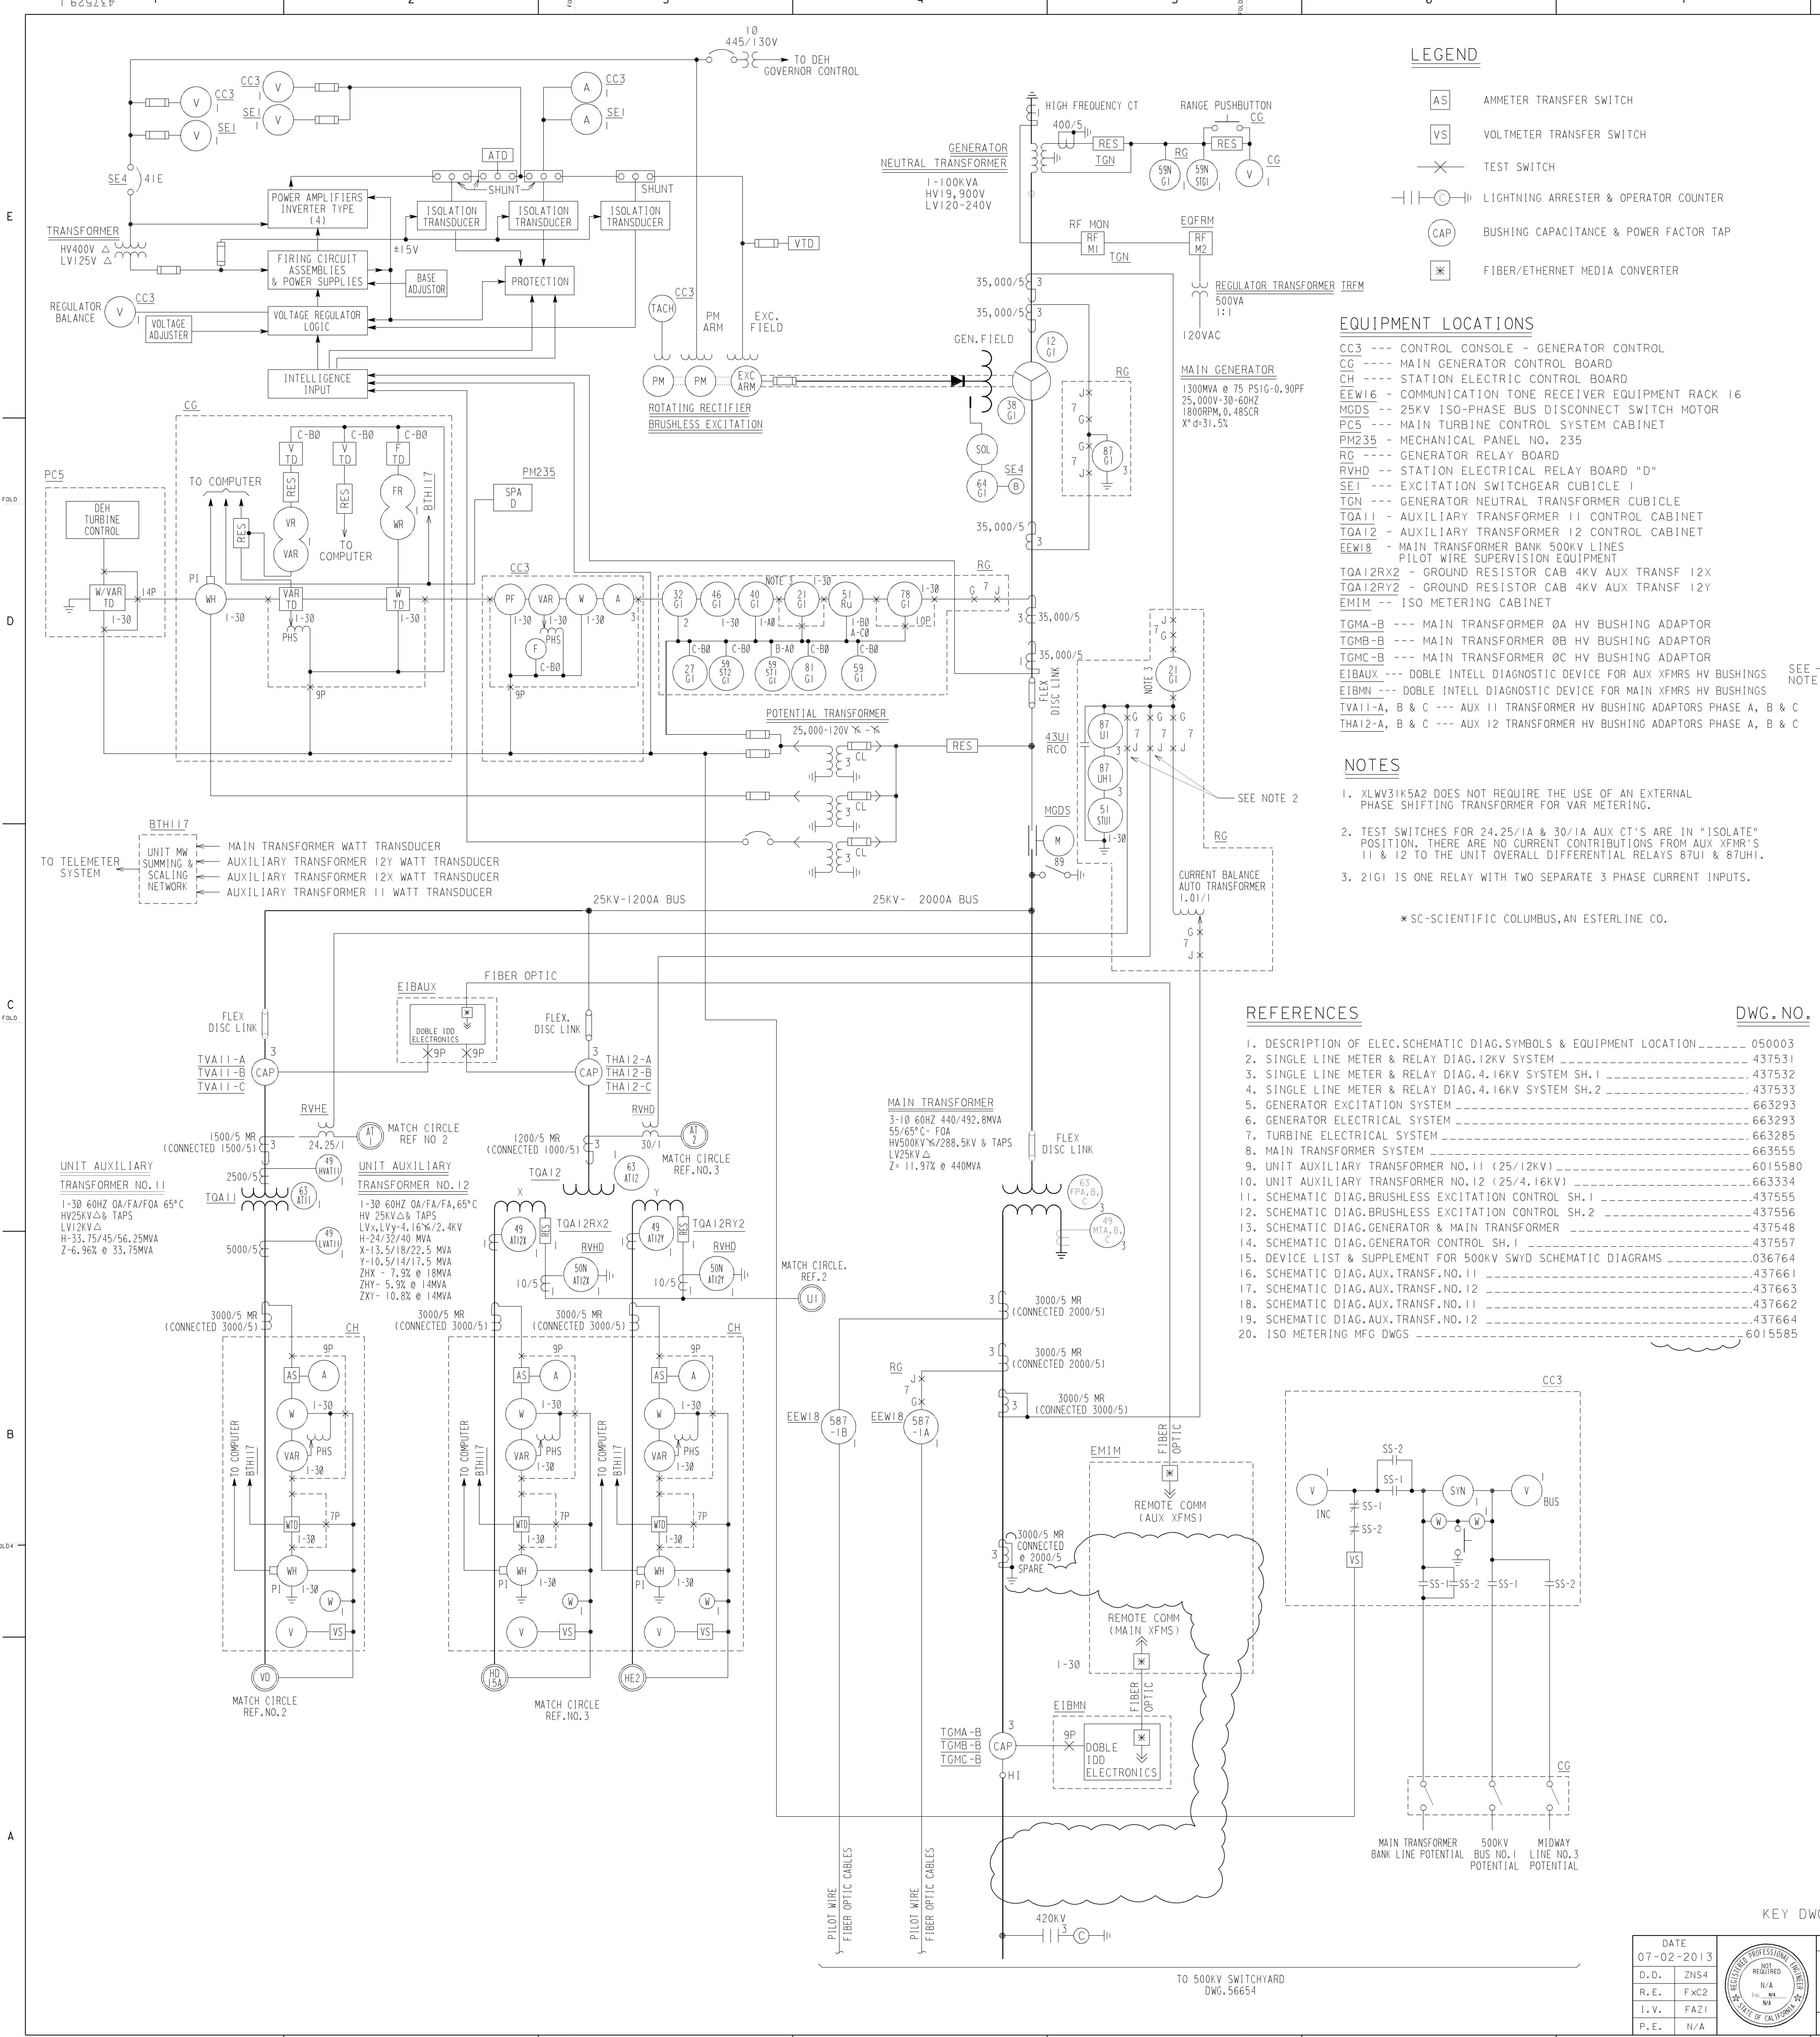

- LEGEND**
- AS AMMETER TRANSFER SWITCH
 - VS VOLTmeter TRANSFER SWITCH
 - TEST SWITCH
 - LIGHTNING ARRESTER & OPERATOR COUNTER
 - BUSHING CAPACITANCE & POWER FACTOR TAP
 - FIBER/ETHERNET MEDIA CONVERTER

EQUIPMENT LOCATIONS

- CC3 --- CONTROL CONSOLE - GENERATOR CONTROL
- CG --- MAIN GENERATOR CONTROL BOARD
- CH --- STATION ELECTRIC CONTROL BOARD
- EEM16 --- COMMUNICATION TONE RECEIVER EQUIPMENT RACK 16
- MGDS --- 25KV ISO-PHASE BUS DISCONNECT SWITCH MOTOR
- PC5 --- MAIN TURBINE CONTROL SYSTEM CABINET
- PM235 --- MECHANICAL PANEL NO. 235
- RG --- GENERATOR RELAY BOARD
- RVHD --- STATION ELECTRICAL RELAY BOARD "D"
- SE1 --- EXCITATION SWITCHGEAR CUBICLE 1
- TGNA --- GENERATOR NEUTRAL TRANSFORMER CUBICLE
- TQA11 --- AUXILIARY TRANSFORMER 11 CONTROL CABINET
- TQA12 --- AUXILIARY TRANSFORMER 12 CONTROL CABINET
- EEM18 --- MAIN TRANSFORMER BANK 500KV LINES PILOT WIRE SUPERVISION EQUIPMENT
- TQA12RX2 --- GROUND RESISTOR CAB 4KV AUX TRANSF 12X
- TQA12RY2 --- GROUND RESISTOR CAB 4KV AUX TRANSF 12Y
- EMIM --- ISO METERING CABINET
- TGMA-B --- MAIN TRANSFORMER 0A HV BUSHING ADAPTOR
- TGMB-B --- MAIN TRANSFORMER 0B HV BUSHING ADAPTOR
- TGMC-B --- MAIN TRANSFORMER 0C HV BUSHING ADAPTOR
- EIBAUX --- DOBLE INTEL DIAGNOSTIC DEVICE FOR AUX XFMS HV BUSHINGS
- EIBMN --- DOBLE INTEL DIAGNOSTIC DEVICE FOR MAIN XFMS HV BUSHINGS
- TVA11-A, B & C --- AUX 11 TRANSFORMER HV BUSHING ADAPTOR PHASE A, B & C
- THA12-A, B & C --- AUX 12 TRANSFORMER HV BUSHING ADAPTOR PHASE A, B & C

NOTES

- XLWV31K5A2 DOES NOT REQUIRE THE USE OF AN EXTERNAL PHASE SHIFTING TRANSFORMER FOR VAR METERING.
- TEST SWITCHES FOR 24.25/1A & 30/1A AUX CT'S ARE IN "ISOLATE" POSITION. THERE ARE NO CURRENT CONTRIBUTIONS FROM AUX XFMR'S 11 & 12 TO THE UNIT OVERALL DIFFERENTIAL RELAYS 87UI & 87UH1.
- 2IG1 IS ONE RELAY WITH TWO SEPARATE 3 PHASE CURRENT INPUTS.

*SC-SCIENTIFIC COLUMBUS, AN ESTERLINE CO.

REFERENCES

- DESCRIPTION OF ELEC. SCHEMATIC DIAG. SYMBOLS & EQUIPMENT LOCATION ----- 050003
- SINGLE LINE METER & RELAY DIAG. 12KV SYSTEM ----- 437531
- SINGLE LINE METER & RELAY DIAG. 4.16KV SYSTEM SH.1 ----- 437532
- SINGLE LINE METER & RELAY DIAG. 4.16KV SYSTEM SH.2 ----- 437533
- GENERATOR EXCITATION SYSTEM ----- 663293
- GENERATOR ELECTRICAL SYSTEM ----- 663293
- TURBINE ELECTRICAL SYSTEM ----- 663285
- MAIN TRANSFORMER SYSTEM ----- 663555
- UNIT AUXILIARY TRANSFORMER NO. 11 (25/12KV) ----- 6015580
- UNIT AUXILIARY TRANSFORMER NO. 12 (25/4.16KV) ----- 663334
- SCHEMATIC DIAG. BRUSHLESS EXCITATION CONTROL SH.1 ----- 437555
- SCHEMATIC DIAG. BRUSHLESS EXCITATION CONTROL SH.2 ----- 437556
- SCHEMATIC DIAG. GENERATOR & MAIN TRANSFORMER ----- 437548
- SCHEMATIC DIAG. GENERATOR CONTROL SH.1 ----- 437557
- DEVICE LIST & SUPPLEMENT FOR 500KV SWYD SCHEMATIC DIAGRAMS ----- 036764
- SCHEMATIC DIAG. AUX. TRANSF. NO. 11 ----- 437661
- SCHEMATIC DIAG. AUX. TRANSF. NO. 12 ----- 437662
- SCHEMATIC DIAG. AUX. TRANSF. NO. 12 ----- 437664
- ISO METERING MFG DWGS ----- 6015585

DWG. NO.

TABLE OF DEVICES						
DEVICE	DESCRIPTION	RATING	MFR	TYPE	CATALOG OR REF. DWG.	REMARKS
A	GENERATOR AMMETER	0-35KA	WESTINGHOUSE	KA-241	291B46A36	
A	GENERATOR EXCITATION FIELD AMMETER	0-1500A				100MV SHUNT DC
A	GENERATOR EXCITATION FIELD AMMETER	0-1500A				100MV SHUNT DC
A	AUX TRANSFORMER NO. 11 AMMETER	0-3000A				
A	AUX TRANSFORMER NO. 12 AMMETER	0-3000A				
F	UNIT POWER FACTOR METER	50-70HZ	WESTINGHOUSE	KR3-241	714B53BA10	
PF	UNIT POWER FACTOR METER	0-1-0	WESTINGHOUSE	K1-241	186A237A01	
SYN	SYNCHROSCOPE	120V-60HZ	WESTINGHOUSE	K1-241	186A235A01	
V	GENERATOR NEUTRAL VOLTmeter	0-10V, 0-100V				EXTERNAL RES AC
V	GENERATOR EXCITATION FIELD VOLTmeter	0-150				
V	GENERATOR EXCITATION FIELD VOLTmeter	0-150				
V	GENERATOR PM GENERATOR VOLTmeter	0-600V				
V	GENERATOR PM GENERATOR VOLTmeter	0-600V				
V	REGULATOR BALANCE VOLTmeter	15-0-15V				
V	SYNCHRONIZING (RUN) BUS/LINE VOLTmeter	0-150V	WESTINGHOUSE	KA-241	291B46A12	
V	SYNCHRONIZING (INCOMING) GEN VOLTmeter	0-150V	WESTINGHOUSE	KA-241	291B46A12	
V	AUX TRANSFORMER NO. 11 VOLTmeter	0-150V				
V	AUX TRANSFORMER NO. 12 VOLTmeter	0-150V				
P1	PULSE INITIATOR	120V AC	WESTINGHOUSE	CD-21	111C2B5	12 FOR AUX TRANSFORMER 221
VAR	GENERATOR VARmeter	1000-0-1000VAR	WESTINGHOUSE	KP-241	409C711A62	BUILT-IN POWER SUPPLY
VAR	AUX TRANSFORMER NO. 11 VARmeter	0-40VMVAR				2 ELEMENT, 30
VAR	AUX TRANSFORMER NO. 12 VARmeter	0-15VMVAR				2 ELEMENT, 30
W	GENERATOR WATTmeter	0-1500MW	WESTINGHOUSE	KP-241	409C711A37	2 ELEMENT, 30
W	AUX TRANSFORMER NO. 11 WATTmeter	0-60MW				2 ELEMENT, 30
W	AUX TRANSFORMER NO. 12 WATTmeter	0-25MW				2 ELEMENT, 30
WH	GENERATOR WATT HOUR METER	57.7-240V, 2.5A	ASA BROWN BOWEN	ALPHA	P3FB0100	3 ELEMENT, 4 WIRE
WH	AUX TRANSFORMER NO. 11 WATT HOUR METER	120V, 2.5A	WESTINGHOUSE	D2B-2F		2 ELEMENT, 3 WIRE
WH	AUX TRANSFORMER NO. 12 WATT HOUR METER	120V, 2.5A	WESTINGHOUSE	D2B-2F		(2 FOR AUX XFMR 22)
F & WR	UNIT FREQUENCY & WATT RECORDER					USED WITH FTD & WTD
V & VAR R	UNIT VOLT & VAR RECORDER					USED WITH VTD & WTD
PHS	PHASE SHIFTING TRANSFORMER	120V AC	WESTINGHOUSE	MV-832	292B048G09	(FOR GEN VAR METER)
PHS	PHASE SHIFTING TRANSFORMER	120V AC	WESTINGHOUSE	MV-832	292B048G09	(FOR GEN VAR METER)
SOL	BRUSH OPERATOR SOLENOID	115V AC				30 Δ-%
APT	AUXILIARY POTENTIAL TRANSFORMER	115-115/66.5V	GE	YT-1557	760X99G1	
FTD	UNIT FREQUENCY TRANSDUCER	55-65HZ	SCIENTIFIC COLUMBUS		5684	
VTD	UNIT VOLTAGE TRANSDUCER	0-150V	*		0001288 OR VT11042	1 ELEMENT
VTD	GENERATOR VOLTAGE TRANSDUCER	0-150V	*		0001288 OR VT11042	1 ELEMENT
VARTD	GENERATOR VAR TRANSDUCER	120V, 5A	*		000759 OR XLW31K5A2	2 ELEMENT, 30 WATT/VAR COMB
WTD	GENERATOR WATT TRANSDUCER	120V, 5A	*		000759 OR XLW31K5A2	2 ELEMENT, 30
WTD	AUX TRANSFORMER NO. 11 WATT TRANSDUCER	120V, 5A	*		000759 OR XLW31K5A2	2 ELEMENT, 30
WTD	AUX TRANSFORMER NO. 12 WATT TRANSDUCER	120V, 5A	*		000759 OR XLW31K5A2	2 ELEMENT, 30
VTD	EXCITATION FIELD VOLTAGE TRANSDUCER					(NOT USED)
ATD	EXCITATION FIELD CURRENT TRANSDUCER					(NOT USED)
TACH	TURBINE SHAFT SPEED	10VDC		KX-241	41168A8B03	
RES	AUX TRANSFORMER 22 GROUND RESISTOR BANK	4160V, 340Ω	WESTINGHOUSE			
W/VAR TO DEH	INPUT GENERATOR WATT/VAR TRANSDUCER	120V, 5A	MOORE INDUSTRIES	PWV	PWV120AC, SA/2-20mA/3E/120AC/SPC/5M	3 ELEMENT, 30 DWG. 6020501-54
2IG1	GENERATOR BACKUP RELAY		BECKWITH	M-3425A		
27G1	GENERATOR UNDERVOLTAGE RELAY	55-140V	WESTINGHOUSE	CV-2	1875508	SHORT TIME
43PW	MAIN TRANSFORMER TEST SWITCH		GE	SB-1	CPD110	
40G2	GENERATOR LOSS OF FIELD RELAY	2.08-56A, 0.79-180	WESTINGHOUSE	KLF-1	292B333A10	
41E	AIR CIRCUIT BREAKER EXCITER FIELD	600V, 1600A	WESTINGHOUSE	DB-50		EXCITATION CUBICLE
46G1	GENERATOR PHASE BALANCING CURRENT RELAY	3-5A	WESTINGHOUSE	COQ	3499A08A11	TRIPS UNITS 500KV BKRS
49HVA11	WINDING TEMP DETECTOR AUX TRANSFORMER 11 H.V.					REC NO. 6015580
49LVA11	WINDING TEMP DETECTOR AUX TRANSFORMER 11 L.V.					REC NO. 6015580
49AT12X,Y	WINDING TEMP DETECTOR AUX TRANSFORMER 12					REC NO. 663334
49MTA,B,C	WINDING TEMP DETECTOR MAIN TRANSFORMER					
50NAT12X	INSTRUMENT NEUTRAL OVERCURRENT RELAY	1-4A	WESTINGHOUSE	SC	1876047	AUX TRANSFORMER 12X
50NAT12Y	INSTRUMENT NEUTRAL OVERCURRENT RELAY	1-4A	WESTINGHOUSE	SC	1876047	AUX TRANSFORMER 12Y
51STU1	UNIT STARTUP OVERCURRENT RELAY	0.5-2A	WESTINGHOUSE	SC	1878393	STARTUP ONLY
59NG1	GENERATOR NEUTRAL OVERVOLTAGE RELAY	5.4-20V	WESTINGHOUSE	CV-8	183A205A15	RUNNING
59NSTG1	GENERATOR NEUTRAL OVERVOLTAGE RELAY	7-16V	WESTINGHOUSE	SV	1956708	STARTUP ONLY
59ST1G1	UNIT STARTUP OVERVOLTAGE RELAY	70-160V	WESTINGHOUSE	SV	1876094	STARTUP ONLY
59ST2G1	UNIT STARTUP V/HZ OVERVOLTAGE ALARM RELAY	120V, 2-70HZ 1.8-2.5V/HZ	GE	STV	12STV11A2A	ALARM ONLY
59G1	GENERATOR OVERVOLTAGE RELAY	55-140V 120-200V INST	WESTINGHOUSE	CV-25	290B572A22	SHORT TIME
63AT11	SUDDEN PRESSURE DEVICE		QUALITROL	900-009-01	6015580-12	AUX TRANSFORMER 11
63AT12	SUDDEN PRESSURE DEVICE					AUX TRANSFORMER 12
63FPA,B,C	SUDDEN PRESSURE DEVICE					MAIN TRANSFORMER
64G1	GENERATOR FIELD GROUND DETECTOR		WESTINGHOUSE	D-3	663293-26	
81G1	GENERATOR UNDERFREQUENCY RELAY	100/120V AC 40-70HZ	BASLER	T3E-E1J ABNOF	BE1-810/U	TRIPS UNIT'S 500KV BKRS
87G1	GENERATOR DIFFERENTIAL OVERCURRENT RELAY	5A, 60HZ	WESTINGHOUSE	SA-1	290B225A10	0.14A MIN PICKUP
87U1	UNIT OVERALL DIFFERENTIAL OVERCURRENT RELAY	0.5-2.5A TIME 10-40A INST	WESTINGHOUSE	CO-9	1875376	
87UH1	UNIT OVERALL DIFFERENTIAL OVERCURRENT HARMONIC RESTRAINT RELAY	4.0A H.R., 4-16A INST	WESTINGHOUSE	HRR	292B024A09	
89	25KV ISOPHASE BUS MOTOR OPERATED DISCONNECT SW		HKP			
51RU	UNIT RUNBACK RELAY	0-5.0A	ROCHESTER	ET-1200 LVU		PART OF GEN STATOR COOLING PROTECTION
32G1A,B	GENERATOR REVERSE POWER RELAY	120V AC	WESTINGHOUSE	CRN-1	290B038A09	0.023A MIN. PICKUP 2 TO 40 SEC. ADJ. WITH REMOTE PANEL
RFM1,2	RADIO FREQUENCY MONITOR		WESTINGHOUSE		663293-71	
38G1	TURBINE THRUST BEARING WEAR	120V AC	WESTINGHOUSE	ARD	ARD660SR	
SPA-D	STEAM PURITY ANALYZER DATA LOGGER	0-1VDC	MEMODYNE	MODEL 3243	663280-69	UNIT LOAD SIGNAL CORRESPONDING TO 0-100% GEN. LOAD
587-1A,1B	500KV TIE LINE DIFFERENTIAL RELAY		GE ALSTHOM	LFCB102 OST	663102-64	
78G1	GENERATOR OUT OF STEP RELAY		GE			
TVA11-A,B,C	AUX 11 HV BUSHING CAP TAP ADAPTOR		DOBLE		03C-1450-01	BTA GDM CONN IEEE TYPE T
THA12-A,B,C	AUX 12 HV BUSHING CAP TAP ADAPTOR		DOBLE		030-1523-01	BTA GDM CONN LAPP PRC
TGMA-B	MAIN TRANSFORMERS HV BUSHING CAP TAP ADAPTOR FOR PHASE A, B & C		DOBLE		03C-1451-01	BTA GDM CONN IEEE TYPE A
TGMB-B						
TGMC-B						

KEY DWG. SECTION IC

UNIT 1

DATE 07-02-2013	REVISION DESCRIPTION REVISED PER DFT-742242	DWG SCALE: BILL OF MATL: SUPDS: SUPSD BY: DRAWING 437529	SHEET 1	PAGE 0	REV 43
D.D. ZNS4					
R.E. Fx22					
I.V. FAZI					
P.E. N/A					
ELECTRICAL GENERATION EXCITATION MAIN & AUXILIARY TRANSFORMERS		PACIFIC GAS AND ELECTRIC COMPANY SAN FRANCISCO, CALIFORNIA			



LEGEND

- [CH] CONTROL STATION AT LOC CH
COMP. COMPUTER
[] LIGHTNING ARRESTOR
[C] COUNTER
MR MULTI-RATIO CT
[29] ISOLATION SWITCH AT SWITCHGEAR
(DISC.BKR.CONTROL FROM CONTROL ROOM)
[AS] SWITCH,AMMETER
[VS] SWITCH,VOLTMETER
[X] SWITCH,TEST
[W] LAMP INDICATING WHITE

NOTE:

1. FOR ELECTRICAL DEVICES TECH DATA AND SETPOINTS SEE PIMS COMPONENT DATABASE.
2. RELAYS 51/87UT11-1 AND 51/87UT11-2 ARE WIRED AND PROGRAMMED FOR ACB PHASE ROTATION.
3. RELAYS 51UT21 AND 87UT21 ARE WIRED AND PROGRAMMED FOR ACB PHASE ROTATION.
4. RELAYS 51/87UT11-1 AND 51UT21 ALSO HAVE AN OVERVOLTAGE (59) FUNCTION USED FOR ALARM.

KEY DWG--SECTION 1C		UNIT 1 & 2	
DATE 09-07-2012	REVISION DESCRIPTION REVISED PER DFT-7-1716	ELECTRICAL SINGLE LINE METER & RELAY DIAGRAM 12KV START-UP SYSTEM	
D.D. MRUR		DWG SCALE: BILL OF MATL: SUPDS: SUPOD BY:	
R.E. RXG2		DRAWING SHEET PAGE REV 437530 1 0 38	
I.V. R2M5		PACIFIC GAS AND ELECTRIC COMPANY SAN FRANCISCO, CALIFORNIA	

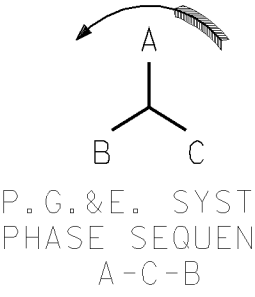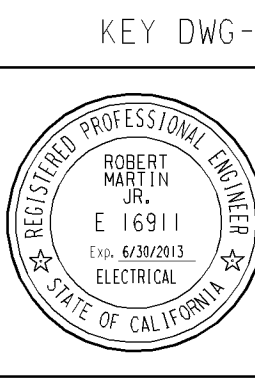

REFERENCES

1. DESCRIPTION OF ELECT SCHEM DIAG SYMBOLS & CKTS DESIG. 050003
2. SINGLE LINE METER & RELAY DIAG GEN & MAIN TRANSF. 437529
3. SINGLE LINE METER & RELAY DIAG 12KV SYSTEM,UNIT #1 437531
4. SINGLE LINE METER & RELAY DIAG 4160V SWGR BUS SECT D & E,UNIT #1 437533
5. SINGLE LINE METER & RELAY DIAG 4160V SWGR BUS SECT D & E,UNIT #1 437532
6. SCHEMATIC DIAG 12KV BUS POT & SYNCHRO START UP BUS 437611
7. SCHEMATIC DIAG AUTOMATIC TRANSFER 437623
8. SCHEMATIC DIAG BUS DIFFERENTIAL 437615
9. SCHEMATIC DIAG STAND BY START-UP TRANSF.NO.11 437618, 19 & 434100
10. SCHEMATIC DIAG STAND BY START-UP TRANSF.NO.12 437620 & 21
11. SINGLE LINE METER & RELAY DIAG,12KV SYSTEM,UNIT #2 441227
12. SINGLE LINE METER & RELAY DIAG,4160V SWGR BUS SECT D & E,UNIT #2 441228
13. DEVICE LIST AND SUPPLEMENT FOR 500KV SWID,SCHEM,DIAG. 036764
14. SCHEMATIC DIAG STAND BY START-UP TRANSF.NO.21 437659 & 60
15. LIST OF EQUIPMENT LOCATION CODES 101900
16. SINGLE LINE DIAG 12KV DISTRIBUTION SYSTEM 445387
17. SINGLE LINE DIAG FOR STATION AUXILIARIES 441220
18. SINGLE LINE DIAG FOR STATION AUXILIARIES 437518
19. ISO METERING MFR DWGS. 6016585-1 THRU 12

LOCATIONS

- CHZ CONTROL BOARD STA.ELECTRONIC UNIT #2
TOU11 ST-UP TRANSF. 11 CONT.CAB
TOU12 ST-UP TRANSF.21 CONT.CAB
EEW16 COMM.TONE REC EQUIP RACK 16
CH CONTROL BOARD STA.ELECTRIC
SVU11 START-UP SWGR CUBICLE 11
RU RELAY BOARD START-UP
TOU11G1 GROUNDING TRANSFORMER NO.11 CAB
TOU12G1 GROUNDING TRANSFORMER NO.21 CAB
TOU11GR GROUNDING RESISTOR BANK NO.11 CAB
TOU12GR GROUNDING RESISTOR BANK NO.21 CAB
TOU11GCT GROUNDING TRANSFORMER NO.11 & NO.21 CAB

EMIM ISO METERING CABINET

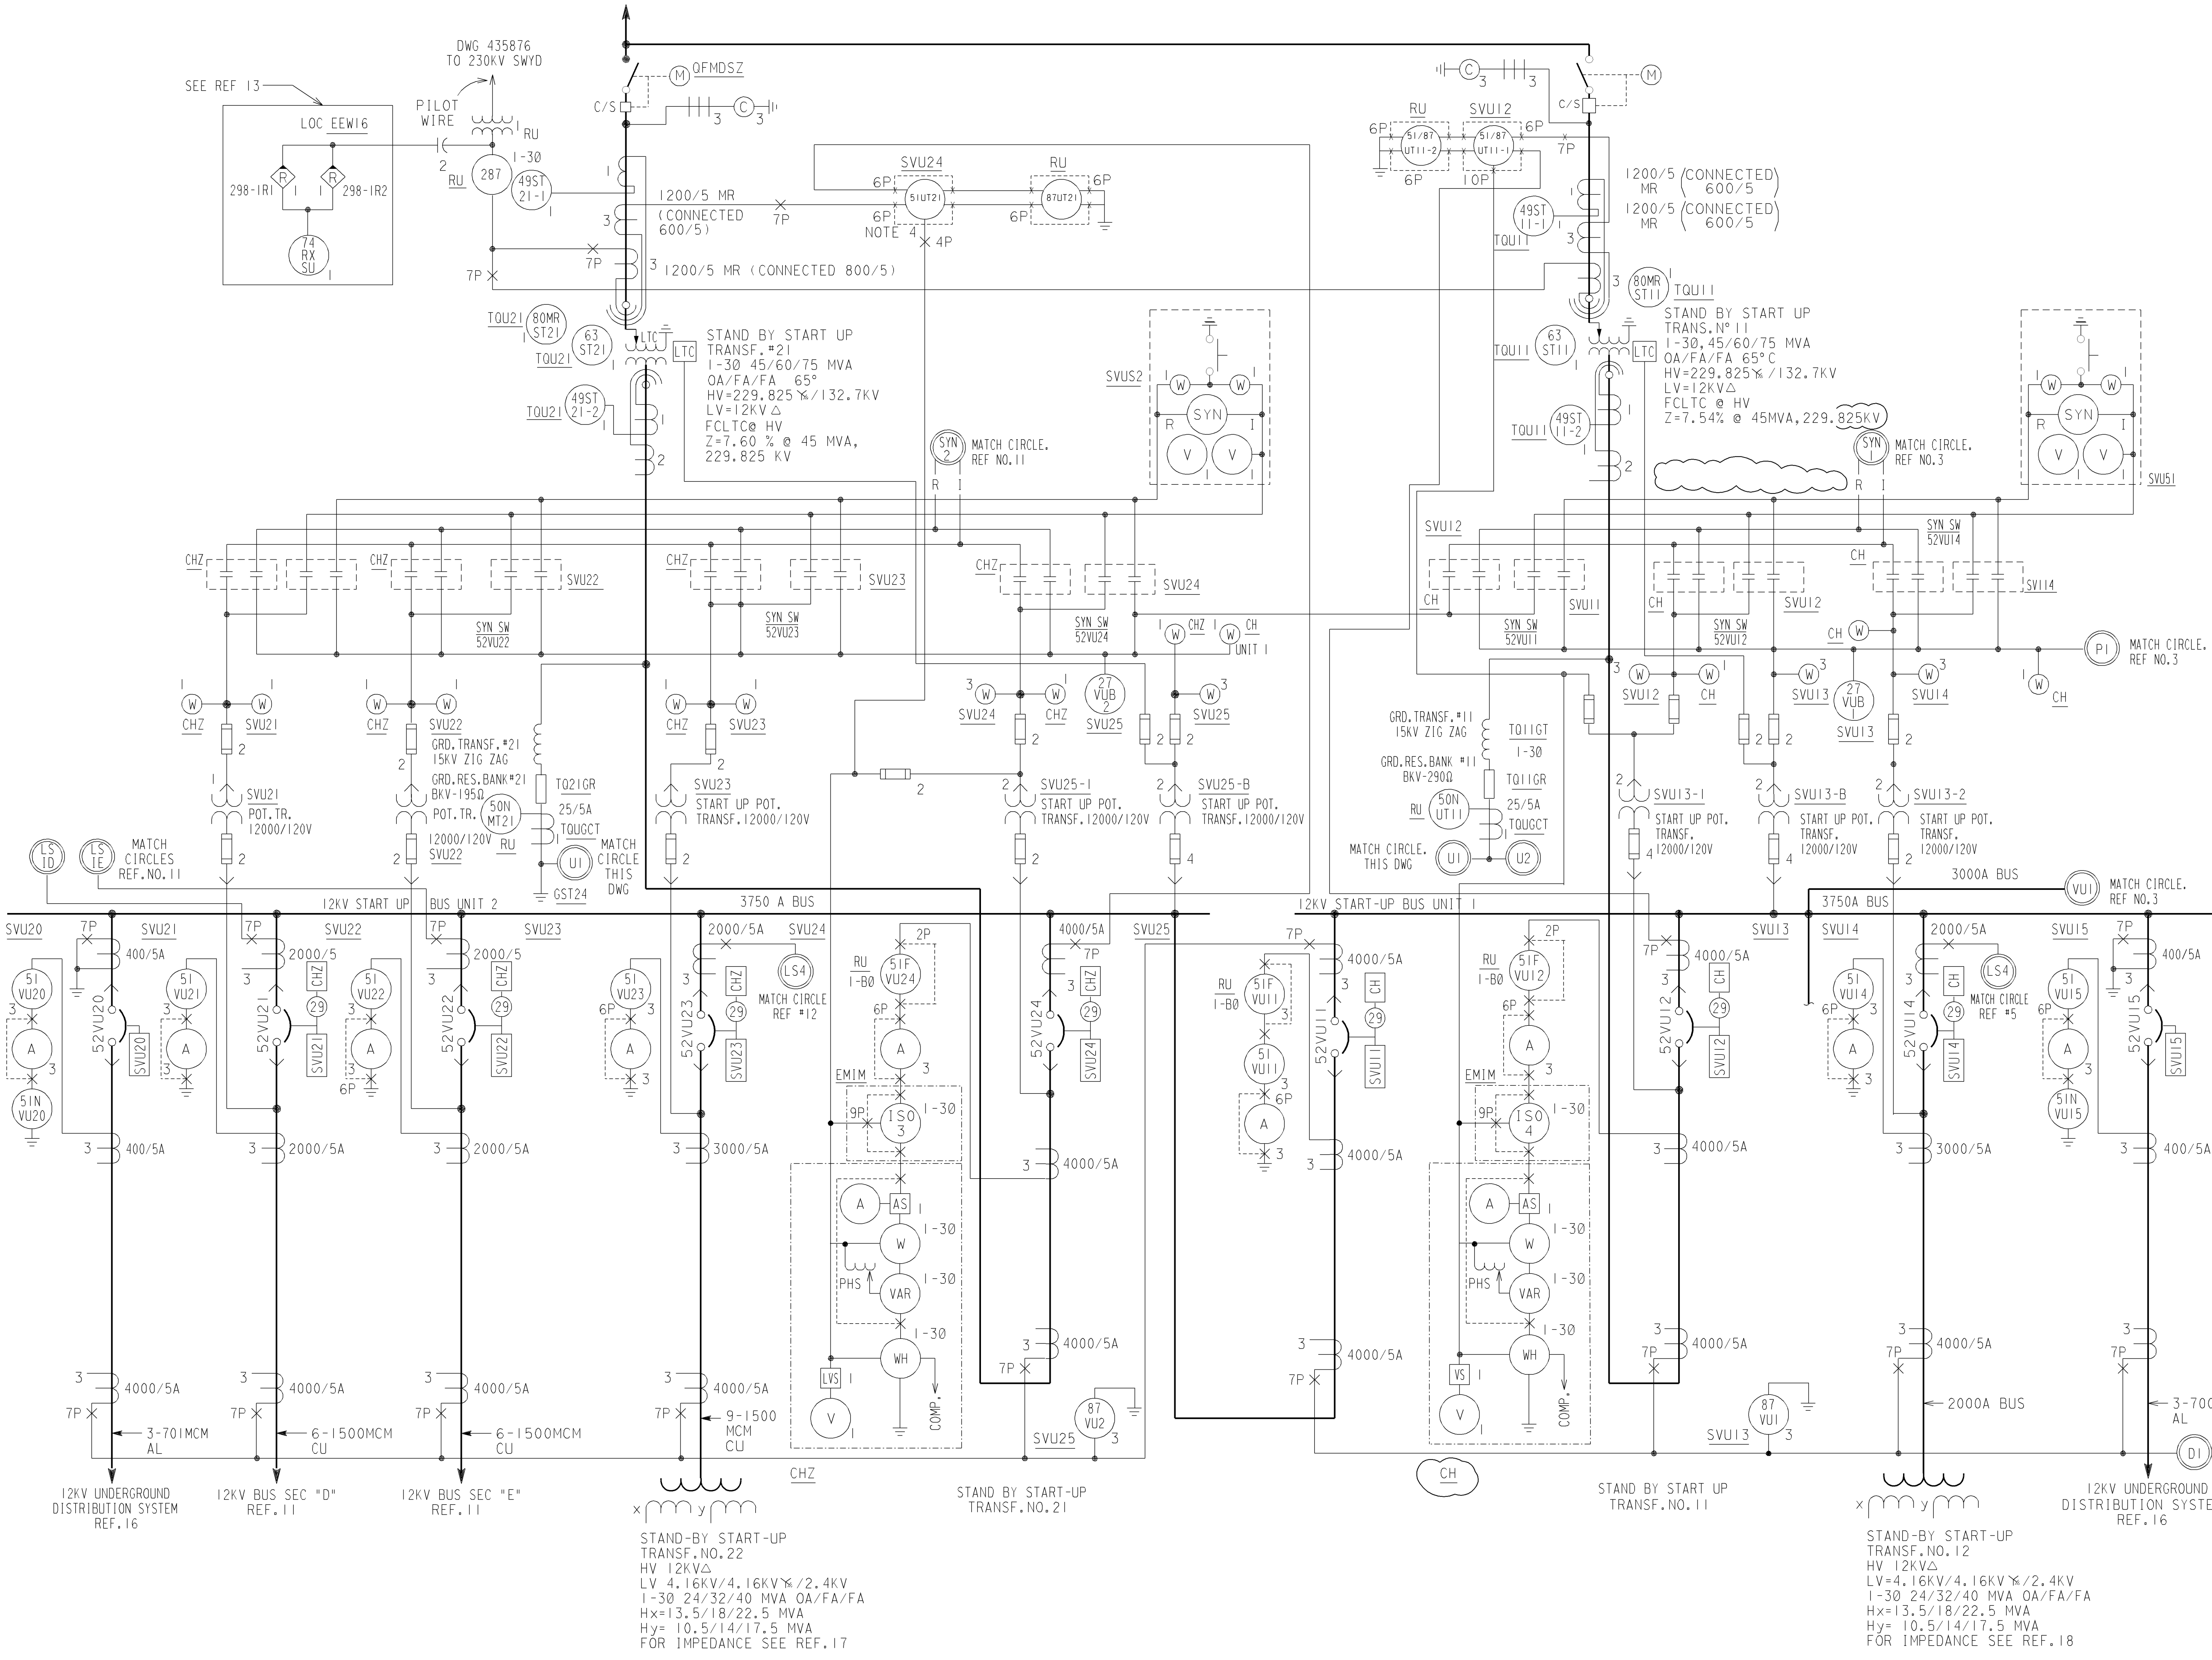


TABLE OF DEVICES									
DEVICE NO.	DESCRIPTION	RATING	RATING	MFR	TYPE	CATALOG OR REF DWG	REMARKS		
A	AMMETER CELL VU21,22	5A	0-2000A	G.E.CO.	AB-40	50103131LSTM2	AT SWGR		
A	AMMETER CELL VUI 4,23		0-3000A		AB-40	50103131LSUA2	AT STA ELECT BD		
A	AMMETER CELL VUI1,12,24		0-4000A		AB-40	50103131LSUE2	AT STA ELECT BD		
A	AMMETER CELL VUI2,24		0-4000A		AB-40	50103131LSUE2	AT STA ELECT BD		
A	AMMETER CELL VU20,15		0-4000A	G.E.CO.	AB-40	50103131LSSC2	AT SWGR		
PHS	PHASE SHIFTING TRANSF	120V		W.E.	MV-832	292B048B09	3-PHASE, 3-WIRE		
CBT	CURRENT BALANCING TRANSF	100V		W.E.	A	608A938C02	AT SWGR		
SYN	SYNCHROSCOPE	120V-60Hz		G.E.CO.	AB16	50120452AAA42	AT SWGR		
V	VOLTMETER SYNCHRONIZING	150V	0-15KV	G.E.CO.	AB16	50120021P2W22	AT SWGR		
V	VOLTMETER START-UP TRANSF								
VAR	VARMETER START-UP TRANSF #11	120V,5A	0-60MVAR	W.E.			2 ELEMENT,3 PHASE		
VAR	VARMETER START-UP TRANSF #21		0-60MVAR						
W	WATTMETER START-UP TRANSF #11		0-80MW						
W	WATTMETER START-UP TRANSF #21		0-80MW						
WH	WATTHOUR METER START-UP TRANSF #11				D2B-2F		WITH CD-21 PULSE INIT		
WH	WATTHOUR METER START-UP TRANSF #21				D2B-2F				
80MRST11,80MRST21	LTC PROTECTION RELAY	250V DC	3A	M.R.	IP54	RS 2001			
49ST11-1,49ST21-1	THERMAL RLY START-UP TRANSFORMER	0-180° C					* QUALITROL CORP		
ISO-3	ISO METER STAND BY START-UP TRANSF #21	120V,4 WIRE,30		PSI	QUAD 4 +	19			
ISO-4	ISO METER STAND BY START-UP TRANSF #11	120V,4 WIRE,30		PSI	QUAD 4 +	19			
63ST11,63ST21	SUDDEN PRESSURE RELAY						* QUALITROL CORP		
27VUB1,2	UNDERVOLTAGE RLY START-UP BUS			G.E.CO.	1AV54F	208A8215G1	SEE NOTE 1		
49ST11-2,49ST21-2	THERMAL RLY START-UP TRANSFORMER	0-180° C		*			* QUALITROL CORP		
50NUT11,21	STBY START-UP TRANSF GRD OC RELAY	1-4A		W.E.	SC	1876047			
74-RX/SU		125VDC		W.E.	AR		PILOT WIRE ALARM RELAY		
51VUI4,23	OVERCURRENT RLY START UP TRANSFORMER	1.5-6A,V.INV.		G.E.CO.	1AC53	121AC53B26A	20-80A I.T.		
51VUI1	OVERCURRENT RLY 12KV SECTIONALIZING BKR	4-16A,V.INV			1AC53	121AC53A101A	NO I.T. UNIT		
51VU20	OVERCURRENT RLY 12KV UNDERGROUND FDR	4-16A,V.INV			1AC53	121AC53B104A	20-80A I.T.		
51VU21	OVERCURRENT RLY 12KV BUS SECT "D"	4-16A,V.INV			1AC53	121AC53A101A	NO I.T. UNIT		
51VU22	OVERCURRENT RLY 12KV BUS SECT "E"	4-16A,V.INV							
51FVUI1,12 & 24	OVERCURRENT RLY FAN CONTROL	5A,60Hz			PJC	20848397	SET P/U AT 4 AMP (1-30 RLY)		
52VUI1,12	CKT BKR 12KV SWGR	3750A		CH		AM 13.8-VRI000-3750A	1.C. 1000MVA		
52VUI4	CKT BKR 12KV SWGR	2000A		CH		AM 13.8-VRI500U-2000A	1.C. 1000MVA		
52VUI5	CKT BKR 12KV SWGR	1200A		CH		AM 13.8-VRI500U-1200A	1.C. 1000MVA		
52VU20	CKT BKR 12KV SWGR	1200A		CH		AM 13.8-VRI500U-1200A	1.C. 1000MVA		
52VU21,22 & 23	CKT BKR 12KV SWGR	2000A		CH		AM 13.8-VRI500U-2000A	1.C. 1000MVA		
52VU24	CKT BKR 12KV SWGR	3750A		CH		AM 13.8-VRI000-3750A	1.C. 1000MVA		
287	230KV TIE LINE DIFFERENTIAL RELAY	5A,60Hz		G.E.CO.	CPD11	12CPD11D2A	T.D.O.MONITOR BB411A2		
87VUI, VUI2	DIFFERENTIAL START-UP BUS	4-16A,V.INV			1AC53	121AC53A101A	NO I.T. UNIT		
298-121,1R2	PILOT WIRE MONITORING SYSTEM TONE RECEIVER				I9	19AM	LOCATED IN UNIT-1 P.P.COMM.ROOM		
51VUI5	OVERCURRENT RLY 12KV UNDERGROUND FDR	1.5-12A,V.INV		G.E.CO.	1AC53	121AC53B811A	1.0-80A I.T.		
51NVU20,15	GND OC RLY 12KV UNDERGROUND FDR	0.1-0.8A INV		G.E.CO.	SFC	125FC151D1A	NO I.T. UNIT		
51/87UT11-1	OVERCURRENT/DIFFERENTIAL RLY START-UP TRANSF. 11			SEL	387E	SEL-387E	SEE NOTE 2		
51/87UT11-2	OVERCURRENT/DIFFERENTIAL RLY START-UP TRANSF. 11			G.E.CO.	T60	T60	SEE NOTE 2		
51UT21	OVERCURRENT RLY START-UP TRANSF. 21			SEL	387E	SEL-387E	SEE NOTE 3		
87UT21	DIFFERENTIAL RLY START-UP TRANSF. 21			G.E.	T60	T60	SEE NOTE 3		

DWG

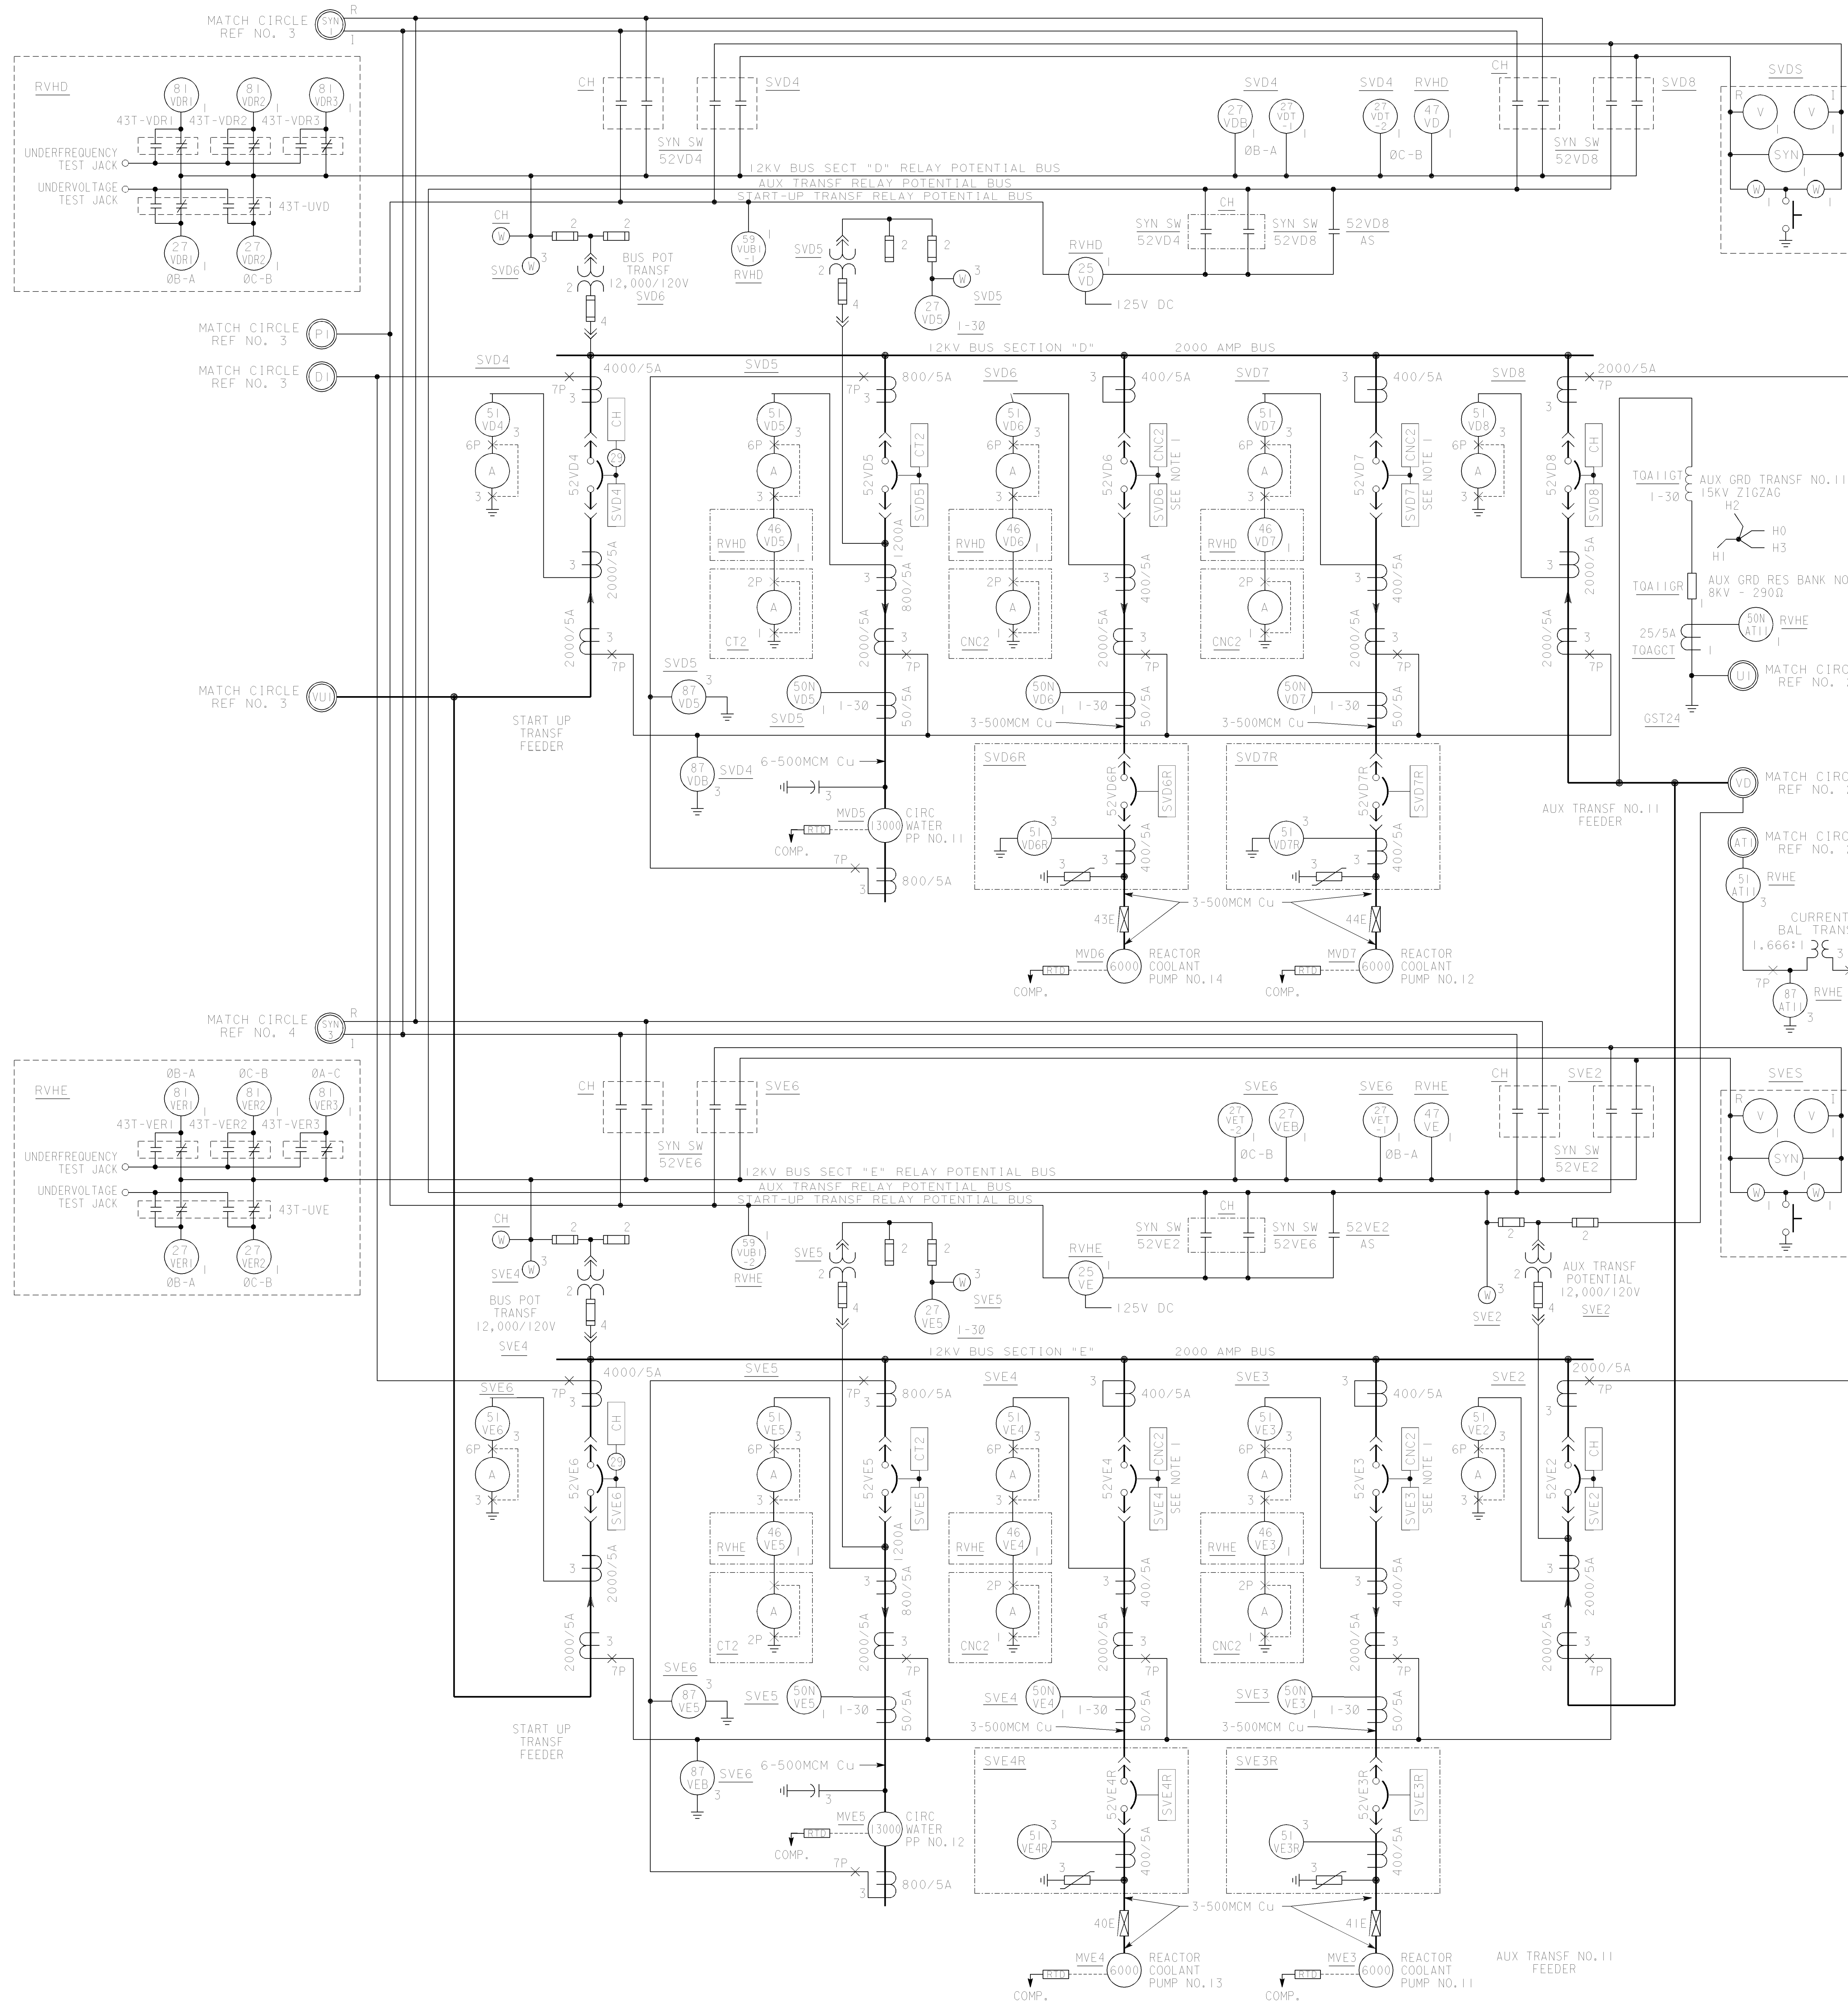


TABLE OF DEVICES

DEVICE NO.	DESCRIPTION	RATING	SCALE OR RANGE	MFR	TYPE	CATALOG NO. OR REF. DWG. NO.	REMARKS
A	AMMETER CELL VD6, VD7, VE3, VE4	5A	0-400A	GE CO	AB40	5010313ILSSC2	AT SWGR
A	AMMETER CELL VD5, VE5	5A	0-800A	GE CO	AB40	5010313ILSSN2	AT SWGR
A	AMMETER CELL VD4, VD8, VE6, VE2 (A0 & C0)	5A	0-2000A	GE CO	AB40	5010313ILSTM2	AT SWGR
A	AMMETER CELL VD6, VD7, VE3, VE4 (A0)	5A	0-400A	WE	GA-332	644B637A19	REACTOR COOLANT BD
A	AMMETER CELL VD5, VE5	5A	0-800A	WE	GA-332	644B637A22	MISC SERVICE CONT BD
A	AMMETER CELL VE2 (B0)	5A	0-2000A	YOKOGAWA	AB40	103131LS1M7	AT SWGR
A	AMMETER CELL VE4 (C0 & B0)	5A	0-400A	YOKOGAWA	AB40	103131LS5C7	AT SWGR
SYN	SYNCHROSCOPE	115V-60HZ		GE CO	AB-16	50-120452AAA	AT SWGR
V	VOLTMETER SYNCHRONIZING	150V	0-15KV	GE CO	AB-16	50-120021PZW	AT SWGR
25VD, VE	SYNCHRONISM CHECK RELAY	120V	10° - 60°	GE CO	SLJ	125LJ21A1A	30 • Ø 5 SEC
27VD2, VE2	UNDERVOLTAGE TRIP REL 12KV BUS	60-140V		WE	SSV-1	1321D79A01	
27VD8, VE8	UNDERVOLTAGE TRIP REL 12KV BUS	25-50V		GE CO	RAV	12RAV11B2A	AUTO-TRANSFER
27VD11, VE11	UNDERVOLTAGE TRIP REL 12KV BUS	55-140V		GE CO	IAV54	12IAV54F1A	
27VDRI, VDR2	UNDERVOLTAGE RLY, REACT COOL PP	55-160V		BASLER	BE1	BE1-27	STYLE 430-EIJ-WB07 SEE NOTE 21(TPT)
27VER1, VER2	UNDERVOLTAGE RLY, REACT COOL PP	55-160V		BASLER	BE1	BE1-27	STYLE 430-EIJ-WB07 SEE NOTE 21(TPT)
27VD5, VE5	UNDERVOLTAGE COND CIRC WTR PP	25-50V		GE CO	RAV	12RAV11B2A	
46VD5, VE5	PHASE BALANCE CUR RLY CWP	1A, 125X SL		WE	CM	290B960A09	ALARM ONLY
46VD6, 7, NVE3, 4	PHASE BALANCE CUR REAC COOLANT PP	1A, 125X SL		WE	CM	290B960A09	ALARM ONLY
47VD, VE	AC VOLTAGE BALANCE RELAY	55-140V		WE	CVO	290B146A09	ALARM ONLY
50NVDS, NVE5	GRD CUR SENSOR CWP	8A CONT	1-4-40A	ITE	90D	46852275	ALARM ONLY, TIMER RANGE 0.1 - 3 SEC, SET @ 0.5 SEC
50NVDS, 7, NVE3, 4	GRD CUR SENSOR REACTOR COOLANT PP	0.177A-0.2A		S. DUNN		112XAX11G10	ALARM ONLY
50NAT11	GRD OC RELAY AUX TRANSF *11	1-4A		WE	SC	1876047	ALARM ONLY
51VE3R, 4R	OVERCURRENT RELAY, RCP BACK-UP PROT			GE CO	3FC66B	(3)	
51VD6R, 7R	OVERCURRENT RELAY, RCP BACK-UP PROT			GE CO	3FC66B	(3)	
51VD4, VE6	OVERCURRENT RELAY, 12KV BUS	4-16A V. INV		GE CO	IAC53	12IAC53A101A	NO L.T. UNIT
51VD5, VE5	OVERCURRENT RELAY, COND CWP	2-6A LT		WEST	COM5	287B456A15	20-80A INST NO
51VD6, 7, VE3, 4	OVERCURRENT RELAY, REAC COOLANT PP	2-6A LT		WEST	COM5	289B456A15	30A 6 - DELAY
51VD8, VE8	OVERCURRENT RELAY, AUX TRANSF FEED	4-12A V. INV		GE CO	IAC53	12IAC53A101A	NO L.T. UNIT
51AT11	OVERCURRENT RELAY, AUX TRANSF *11	5-12A V. INV		WE	CO-9	1875383	40-160A 1.T. (2 L.T. CONT)
52VD5, 6 & 7	CKT BKR 12KV SWGR, BUS "D"	1200A		CH		AM 13.8-V87507U-1200A	1C 1000 MVA
52VE3, 4 & 5	CKT BKR 12KV SWGR, BUS "E"	1200A		CH		AM 13.8-V87507U-1200A	1C 1000 MVA
52VD4, 8	CKT BKR 12KV SWGR, BUS "D"	2000A		CH		AM 13.8-V87507U-2000A	1C 1000 MVA
52VE2, 6	CKT BKR 12KV SWGR, BUS "E"	2000A		CH		AM 13.8-V87507U-2000A	1C 1000 MVA
59VUB1-1, 2	OVERVOLTAGE RELAY ST-UP BUS	60-140V		WE	SSV-1	1321D79A01	
52VE3R, 4R	VAC CKT BKR, RCP BACK-UP OC PROT, BUS "E"	1200A		GE CO		VB 13.8-1000-3	1C 1000 MVA
52VD6R, 7R	VAC CKT BKR, RCP BACK-UP OC PROT, BUS "D"	1200A		GE CO		VB 13.8-1000-3	1C 1000 MVA
81VDRI, 2, 3	12KV BUS D REACT COOL PP UF RLY			BASLER	DIG FREQ	BE1-81 O/U	
81VERI, 2, 3	12KV BUS E REACT COOL PP UF RLY			BASLER	DIG FREQ	BE1-81 O/U	
87AT11	DIFF RELAY AUX TRANSF NO. 11	0.5 - 2.5A		WE	CO-9	1875376	10 - 40A 1.T. (2 L.T. CONT)
87VD5, VE5	DIFF RELAY COND CIRC WATER PP	5A 60HZ		GE CO	CFD	12CFD12B2A	0.2 AMP TARGET
87VDB	DIFF RELAY 12KV BUS D	4-16A V. INV		GE CO	IAC53	12IAC53A101A	NO L.T. UNIT
87VEB	DIFF RELAY 12KV BUS E	4-16A V. INV		GE CO	IAC53	12IAC53A101A	NO L.T. UNIT

LOCATIONS

- CNC2 CONTROL BOARD REACTOR COOLANT
- CT2 CONTROL BOARD TURBINE AUX
- CH CONTROL BOARD STA ELECTRIC
- SVD5 12KV SWGR BUS D CUBICLE 5
- RVHD & E RELAY BOARD STATION ELECTRIC
- TOA11GTF AUX GRD TRANSF 11 DISC SW CAB
- TOA11GCT AUX GRD TRANSF 11 CABINET
- TOAGCT GROUNDING CT 12, 14 CABINET
- TOA11GR AUX GRD RESISTOR BANK 11
- GST24 GROUNDING STATION T24
- SVD6R 12KV SWGR BUS D CUB 6R, BACK UP OC

LEGEND

- TEST SWITCH
- LAMP INDICATING WHITE
- CONTROL STATION AT LOC CH
- RESISTIVE TEMPERATURE DEVICE
- COMPUTER
- 44E CONTAINMENT PENETRATION WITH PENETRATION NUMBER
- ISOLATION SWITCH AT SWITCHGEAR (DISC BKR CONTROL FROM CONTROL ROOM)

REFERENCES

- DESCRIPTION OF ELECT SCHEM DIAGRAM SYMBOLS & EQUIP LOCATION NO'S 050003
- SINGLE LINE MTR & RLY DIAG GEN & MAINT TRANSF 437529
- SINGLE LINE MTR & RLY DIAG START-UP SYS UNITS 1 & 2 437530
- SINGLE LINE MTR & RLY DIAG 4160V SYS BUS SECT D & E 437532
- DELETED
- SCHEMATIC DIAG CIRCULATING WATER PUMPS 437565
- SCHEMATIC DIAG REACTOR COOLANT PUMP 11 477846
- SCHEMATIC DIAG REACTOR COOLANT PUMP 12 477847
- SCHEMATIC DIAG REACTOR COOLANT PUMP 13 477848
- SCHEMATIC DIAG REACTOR COOLANT PUMP 14 477849
- MAIN CONTROL BOARD MATERIAL LIST 101941
- SCHEMATIC DIAG BUS POTENTIAL & SYNCHRONIZING 12KV SYS 437612

NOTE


- BACK-UP BREAKER TO BE CLOSED BEFORE CLOSING PRIMARY BREAKER.
- FOR ELECTRICAL DEVICES TECH DATA AND SETPOINTS SEE PIMS COMPONENT DATABASE.


DWG NO.


KEY DWG. SECTION 1C

UNIT 1

DATE 6/1/04	DESCRIPTION Revised per DCI-SE-049636-00, DCI-SE-049637-00 & DCI-SE-049638-00	COORDINATION NUCLE. - MECH. - ELEC. - CIVIL - PIPING - I&C -	DWG SCALE	BILL OF MATL	SUPDS	SUPDS BY	SHEET NO. 1 OF	REV 27
DWN. MIBF								
R.E. SWS								
INDEP. VERIFIER RWB7								
P.E. RWB7								
REVISION INFORMATION			PACIFIC GAS AND ELECTRIC COMPANY SAN FRANCISCO, CALIFORNIA			437531		

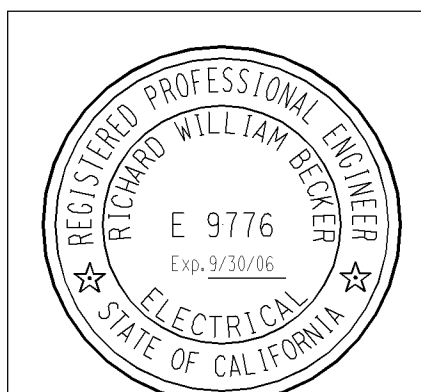

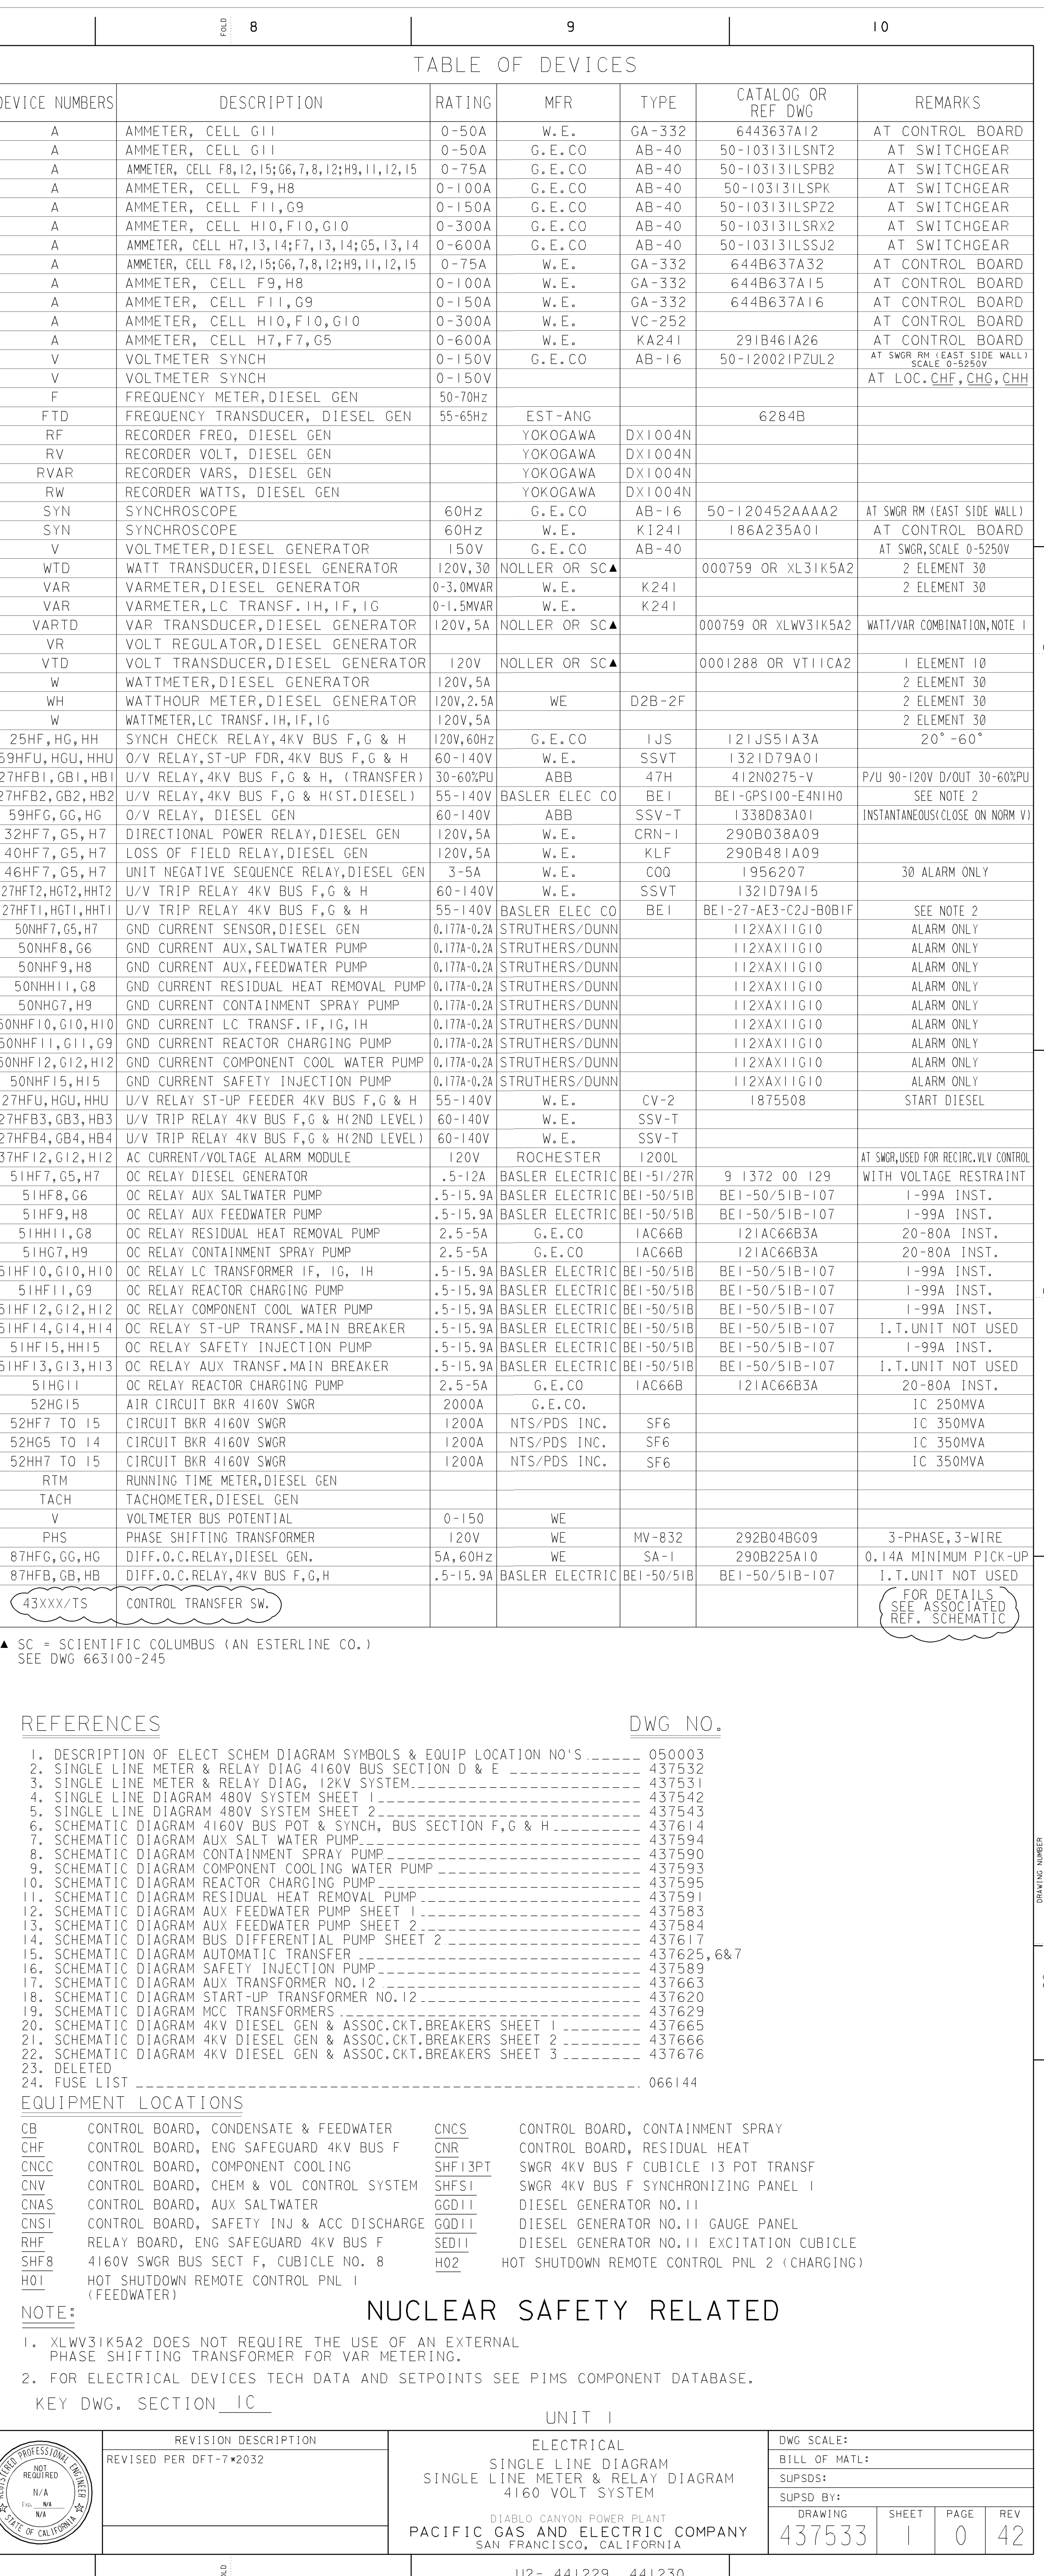

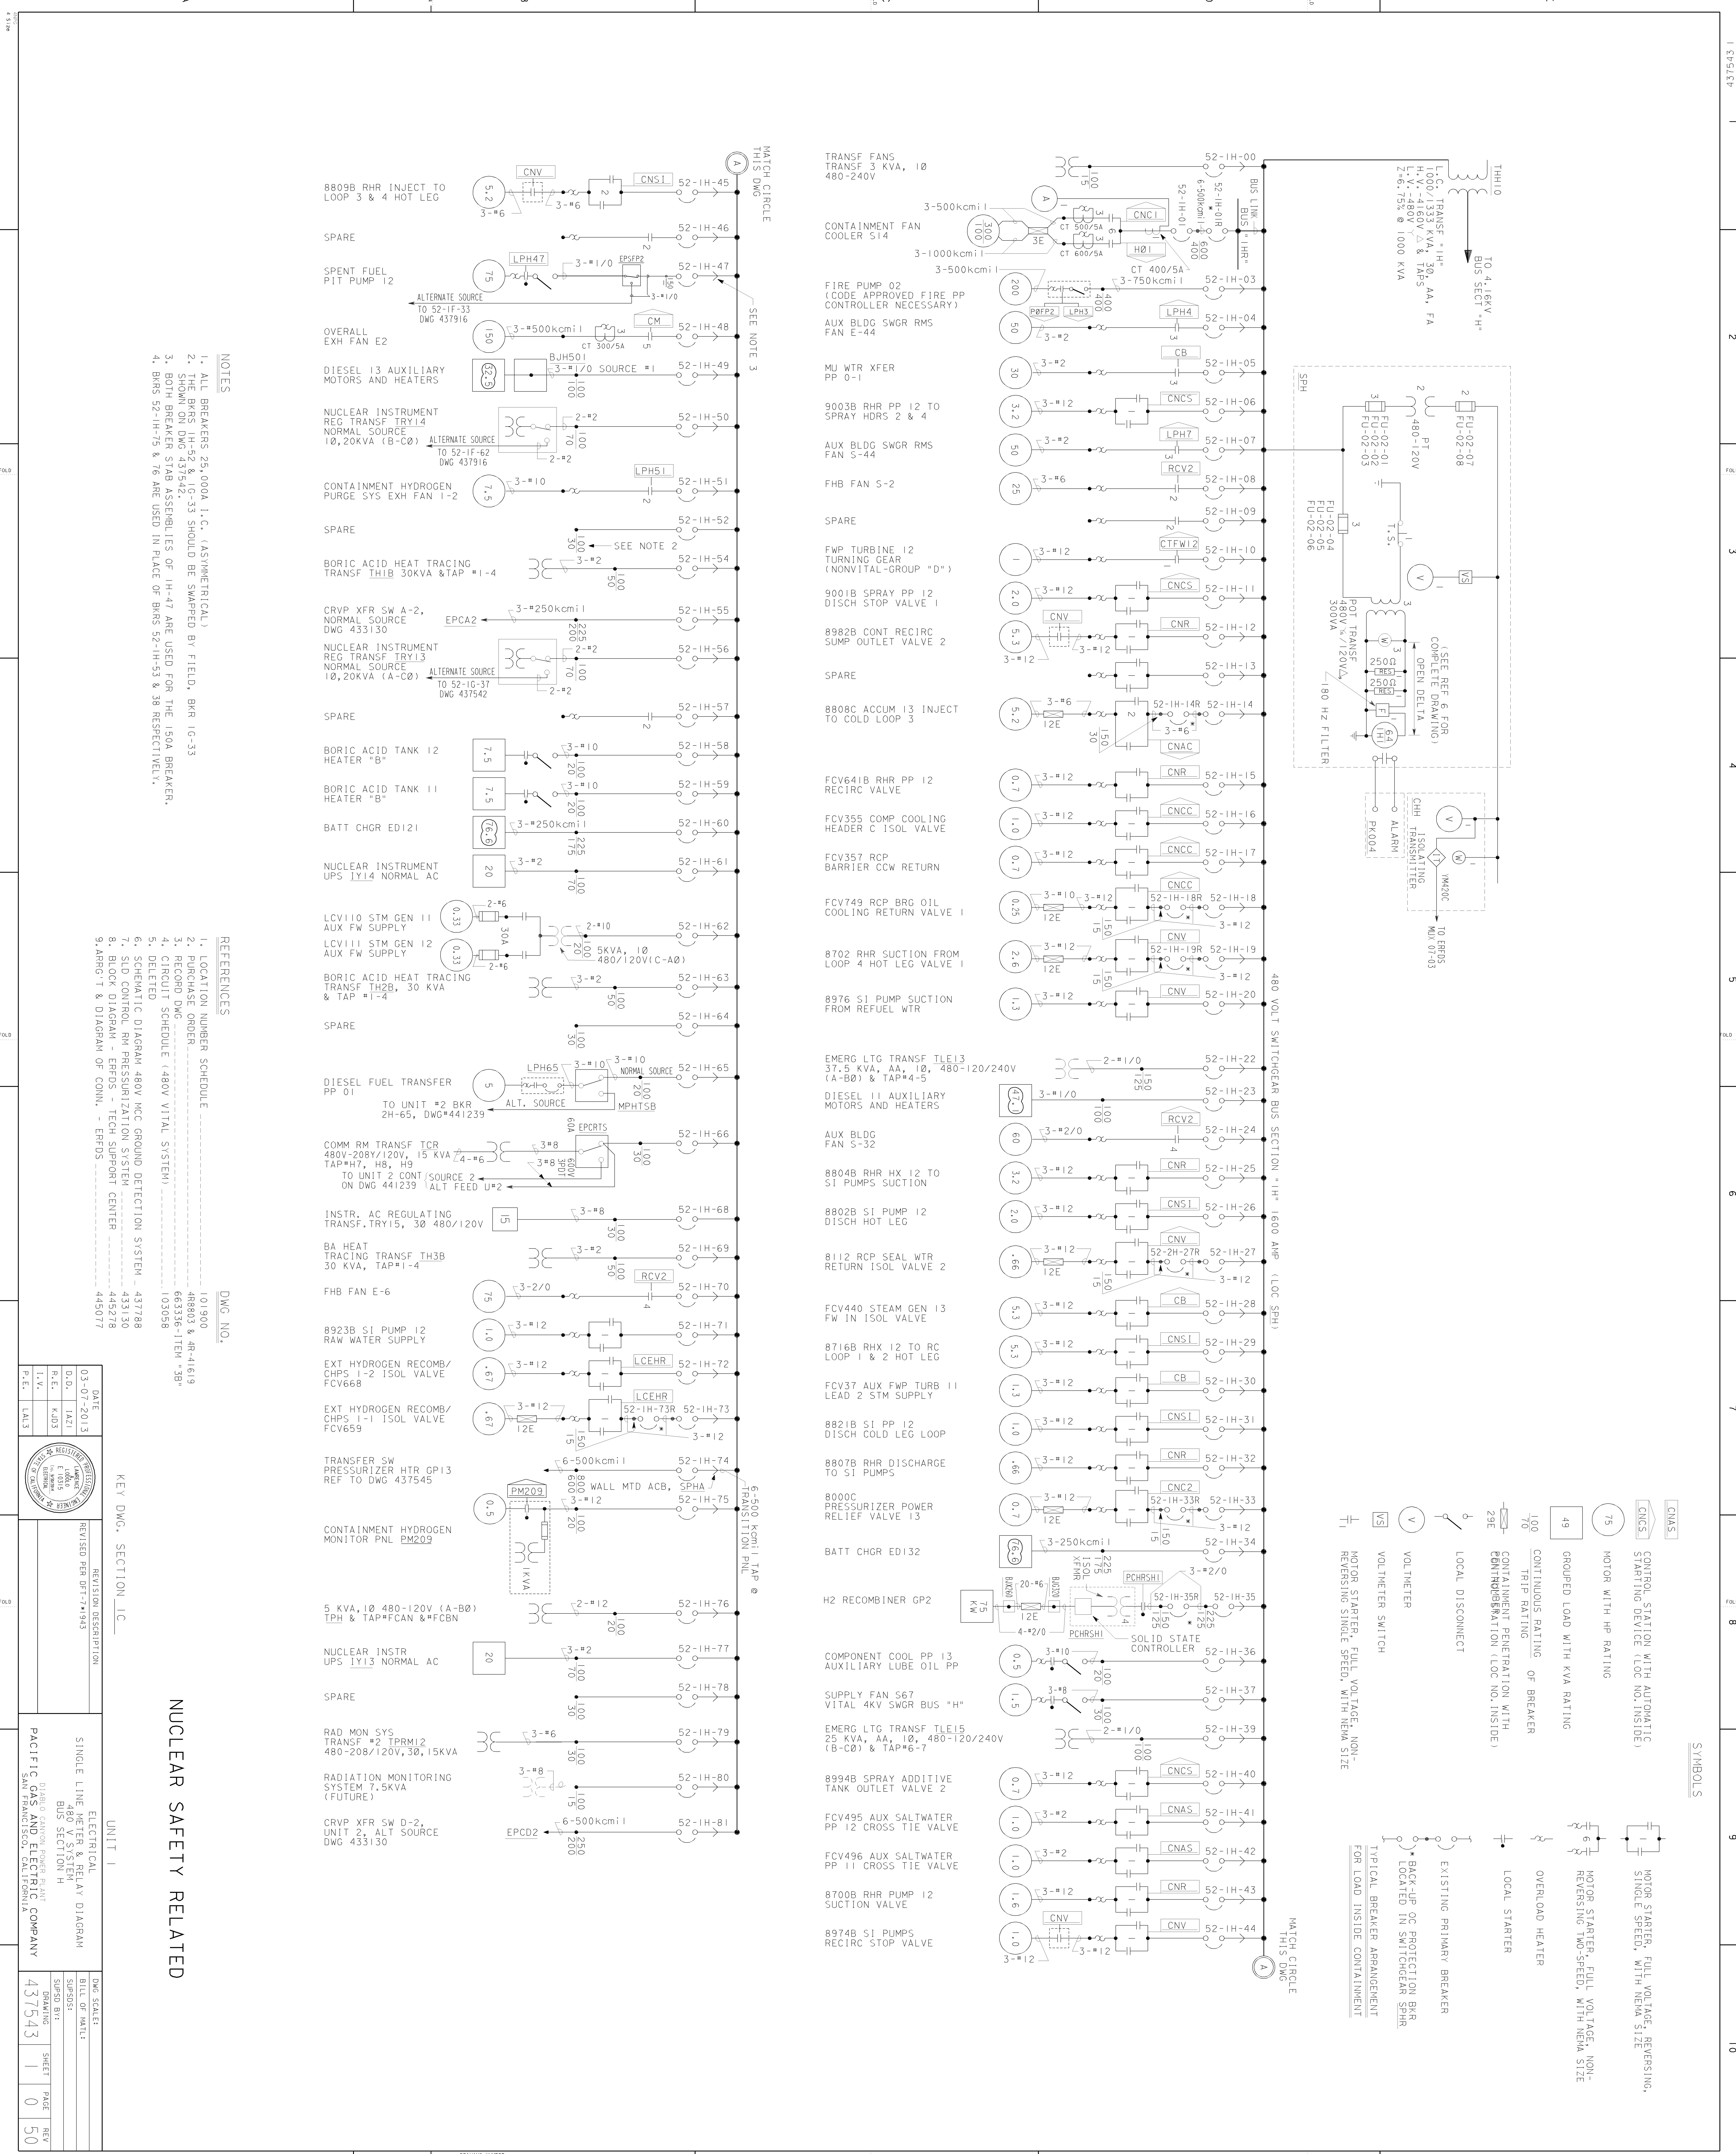

E

FOLD






D

C

B

A

CAD User: JAL2 Date: 9-10-2004
DGN: 437545.DGN

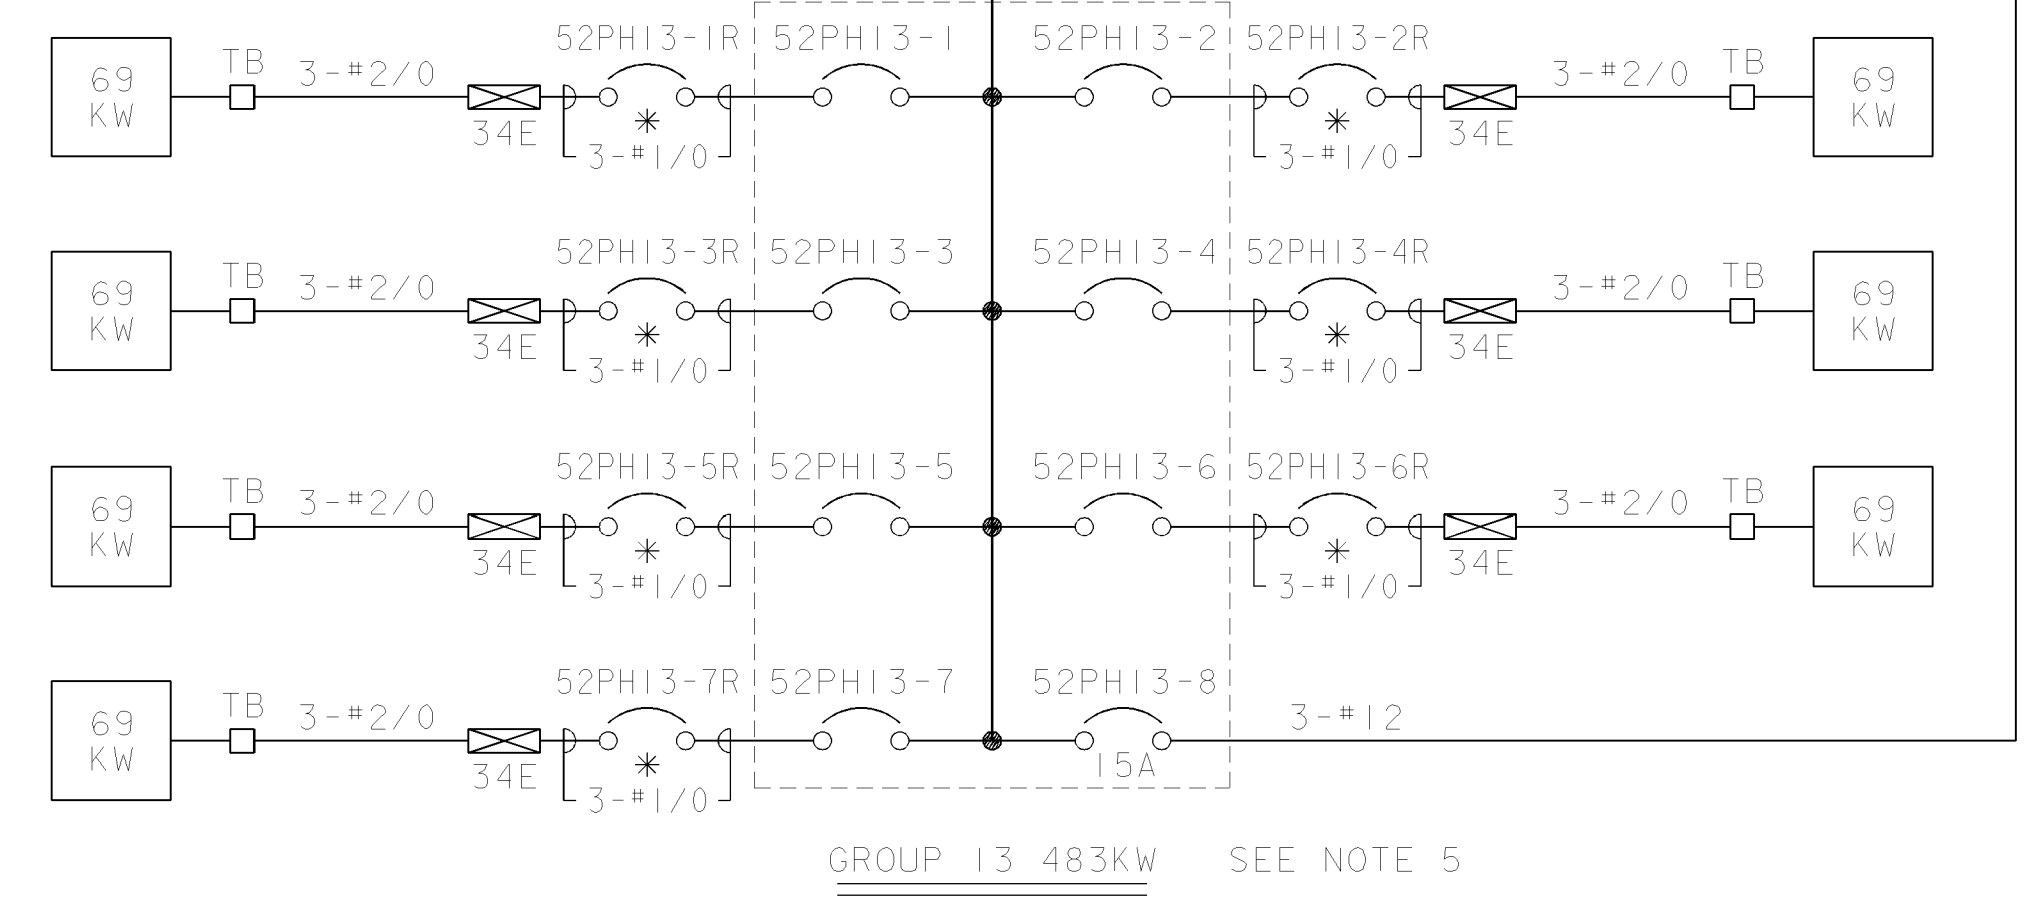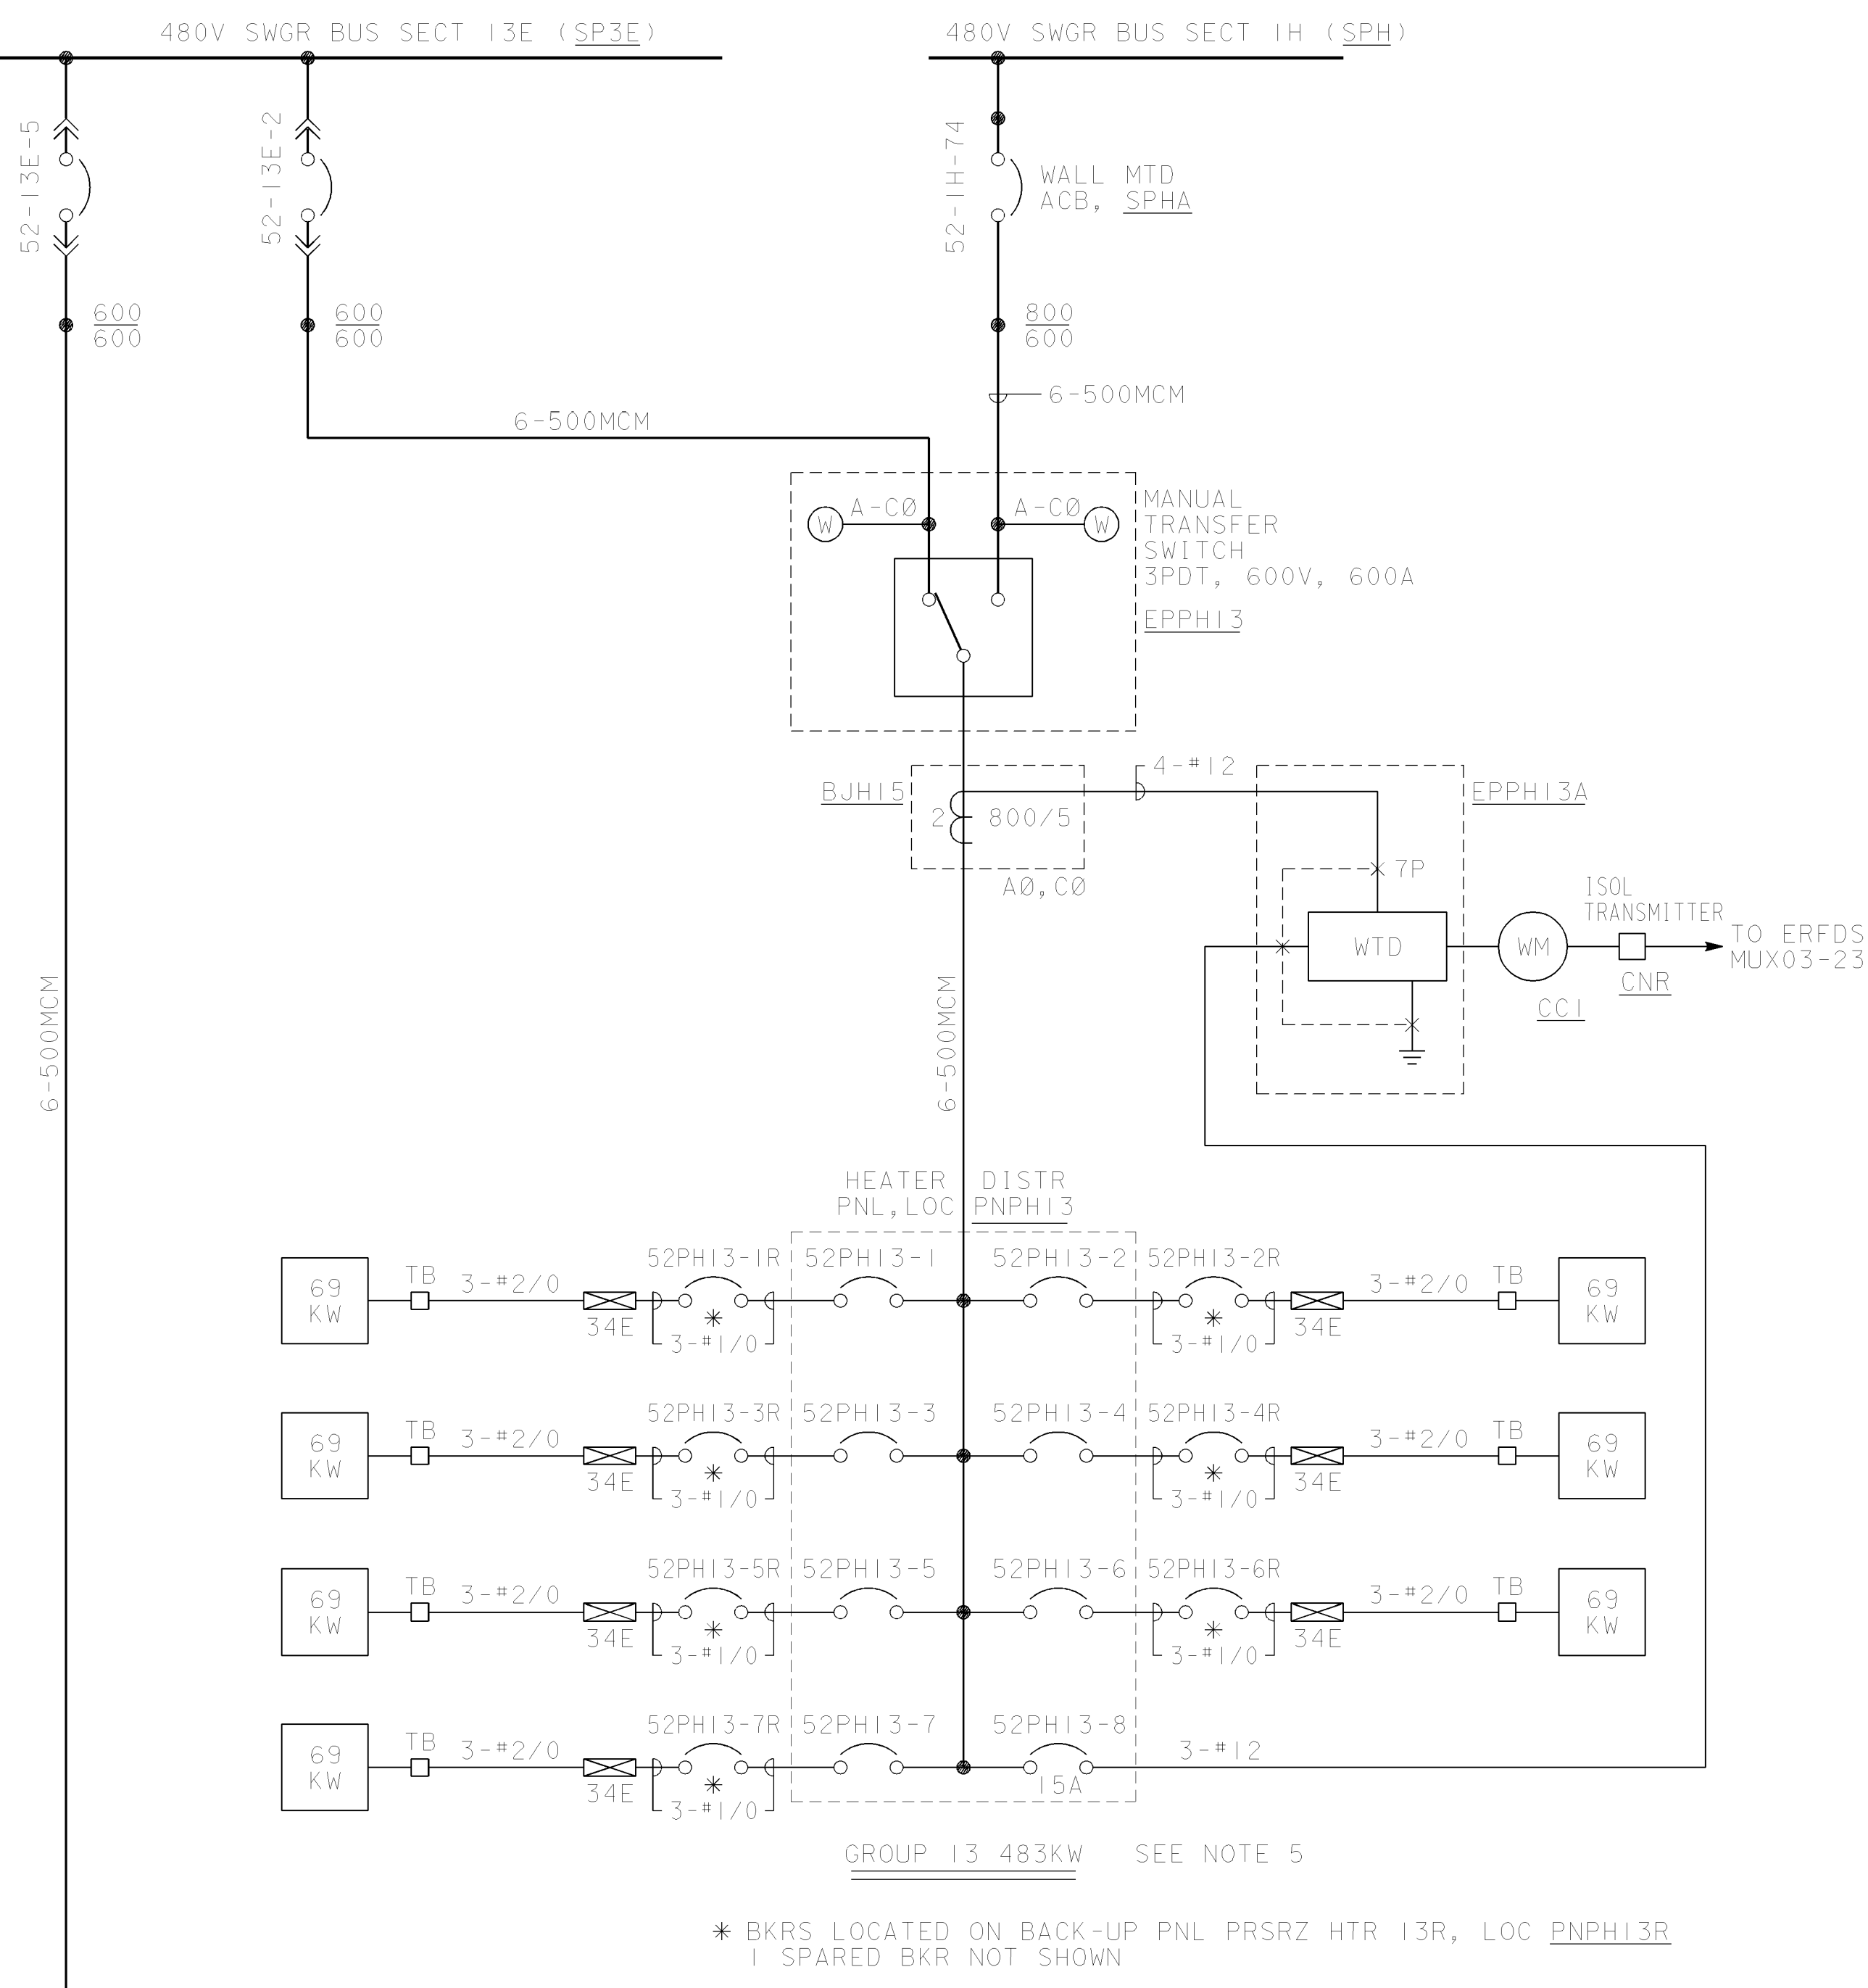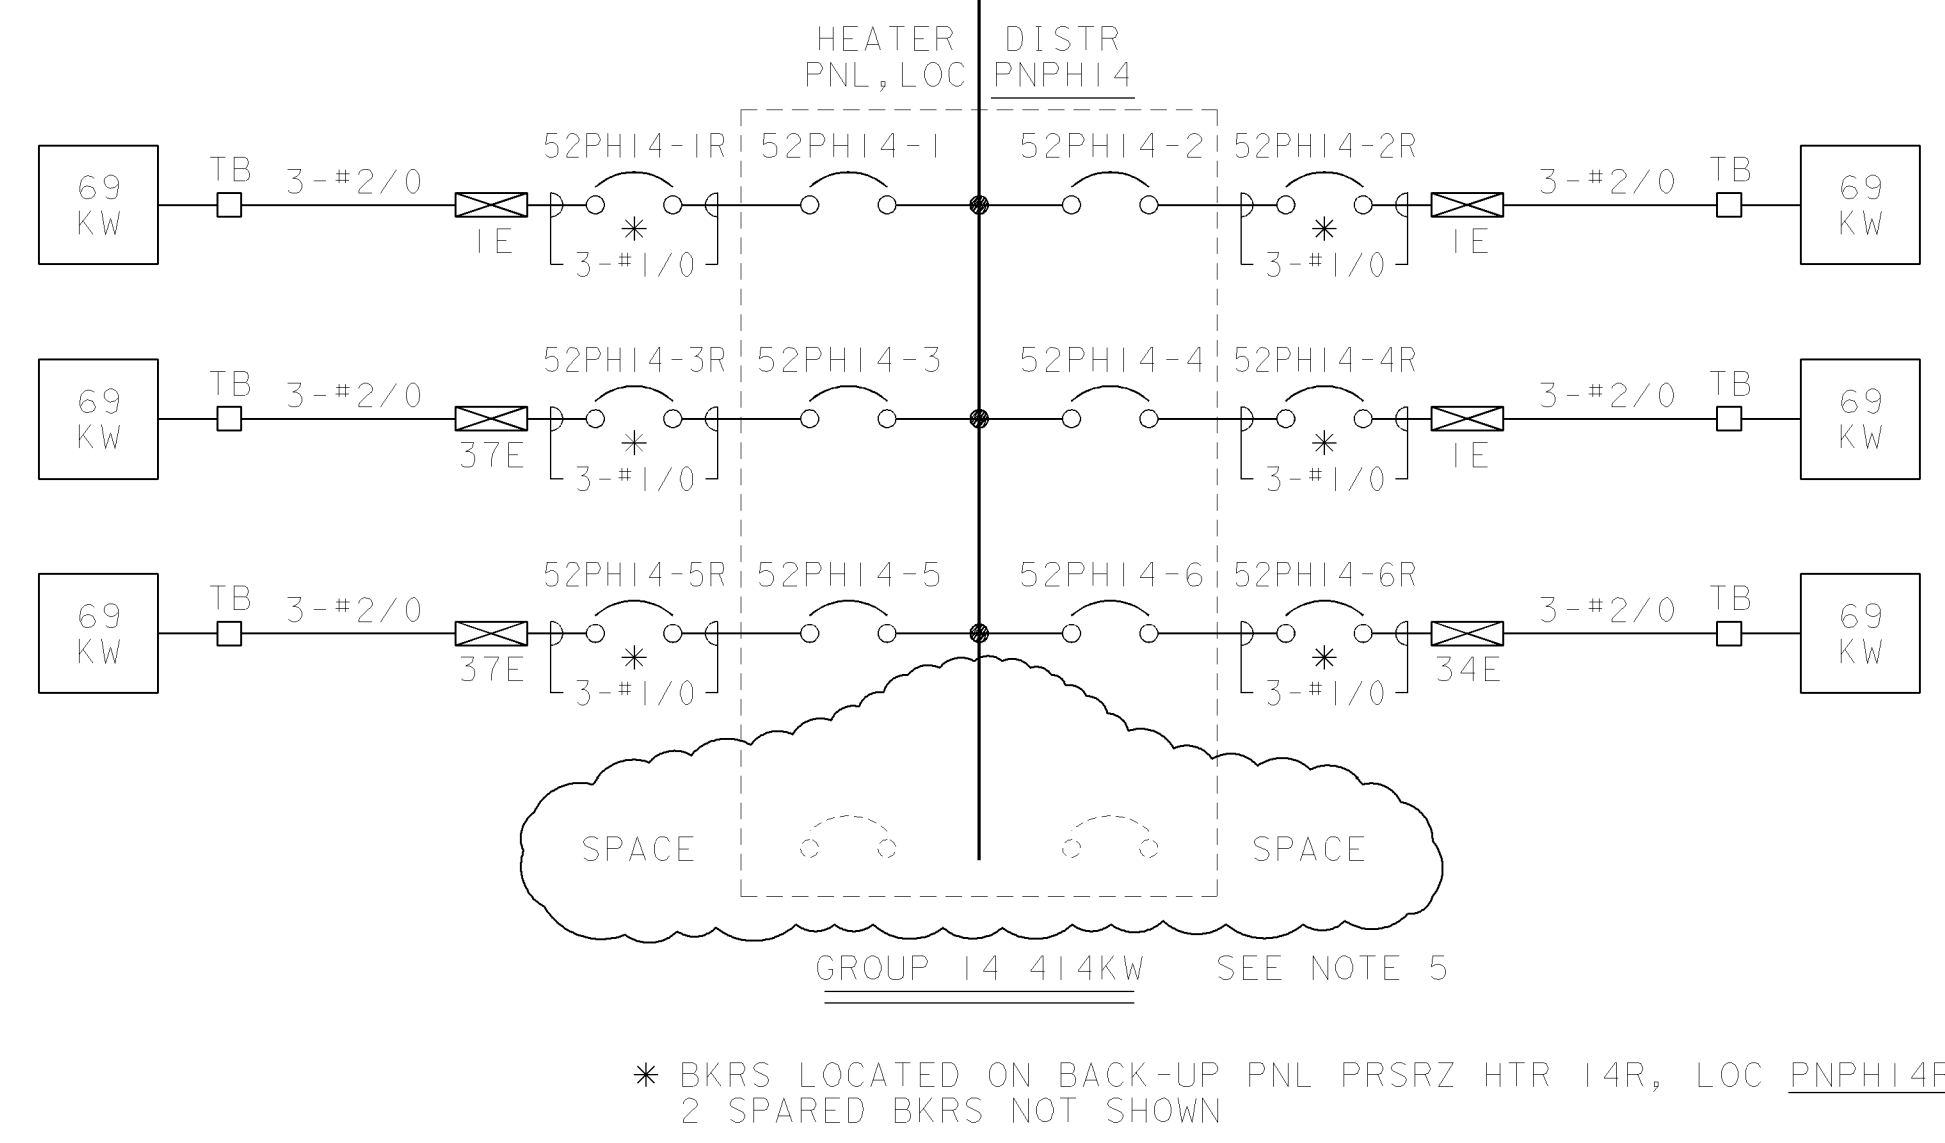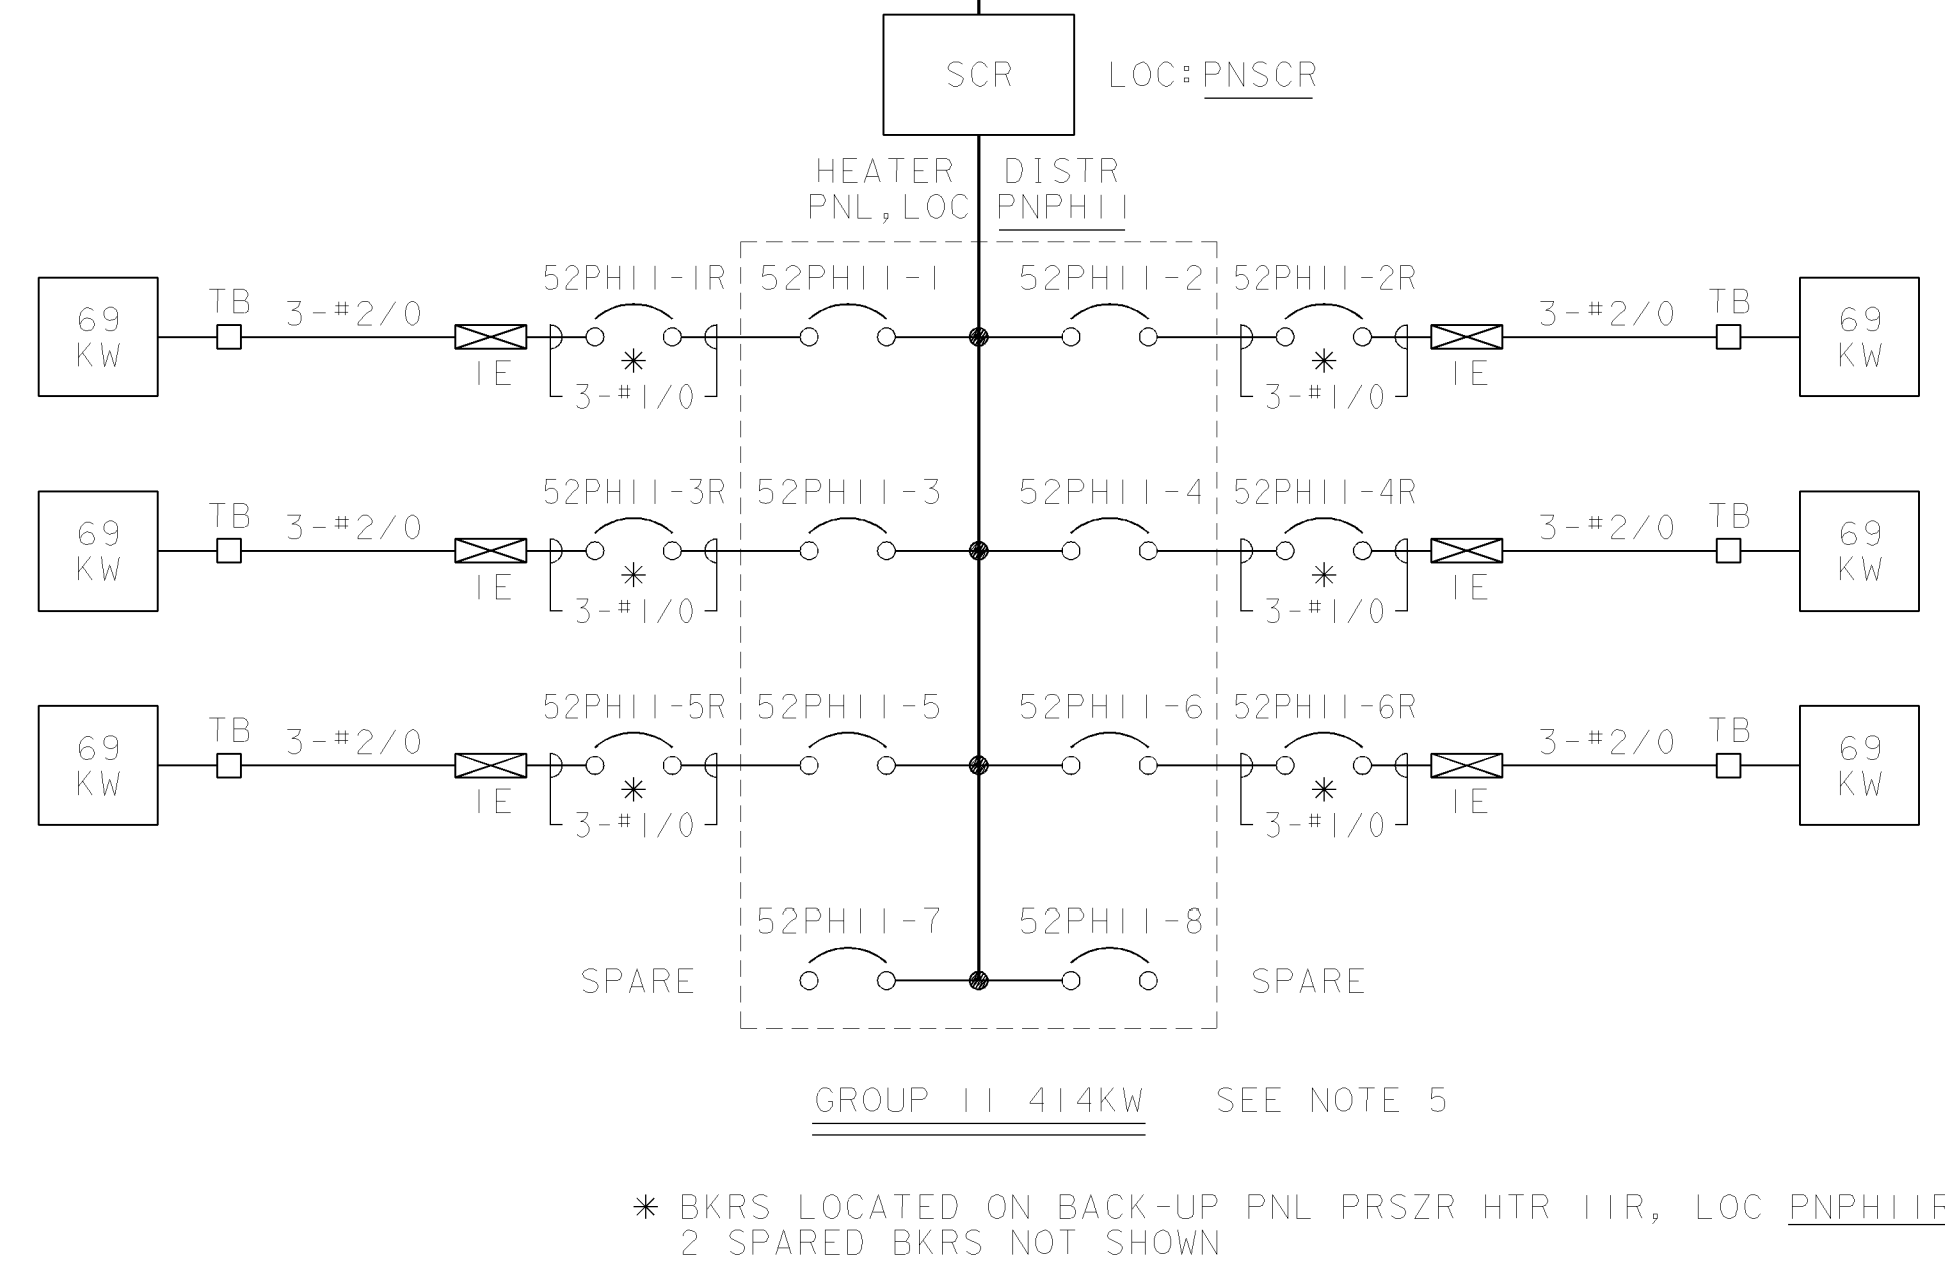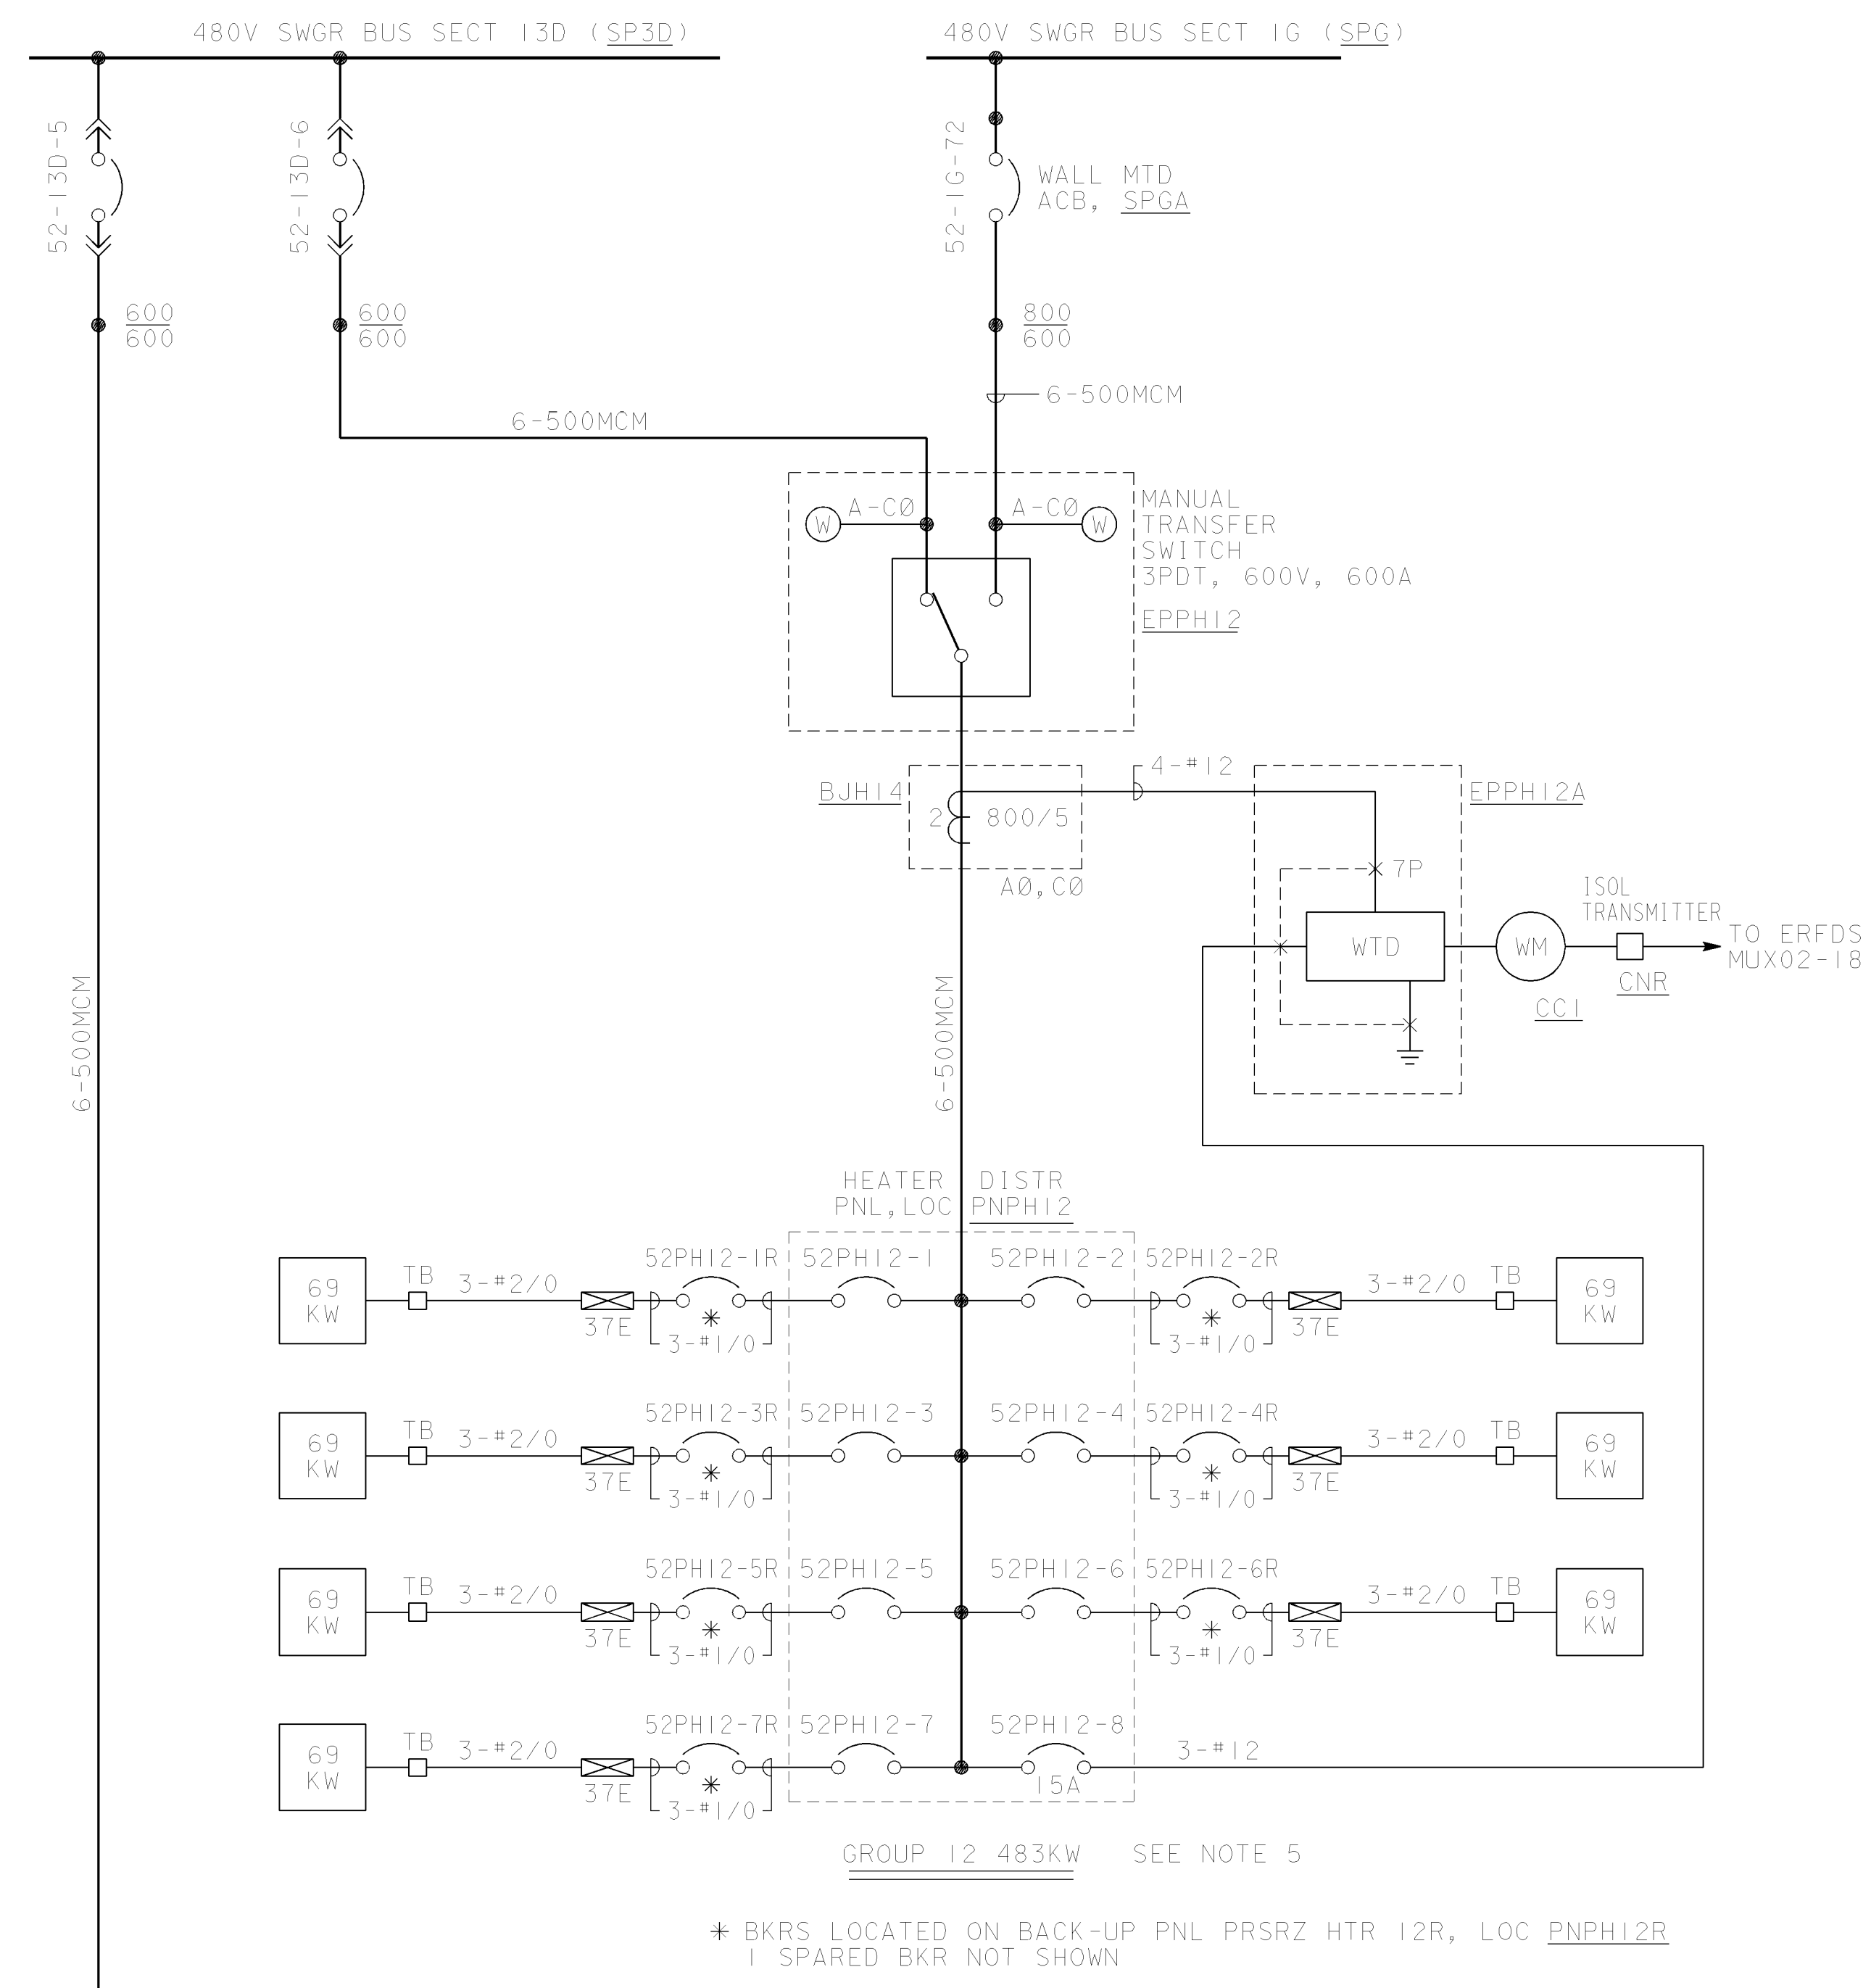

GROUP	BREAKER NO.	DISCONNECTED HEATERS	BREAKER CONNECTED LOAD	TOTAL GROUP CONNECTED LOAD
11	52PH12-1	*5	46KW	414KW
12	52PH13-1	*13	46KW	460KW
13	52PH13-7	*28	46KW	437KW
14				414KW

TABLE A
DETERMINATED HEATERS

SYMBOLS

- CURRENT & POTENTIAL TEST SWITCH
- WATTMETER
- WHITE LIGHT
- CONTINUOUS RATING OF BREAKER TRIP RATING
- SILICON CONTROLLED RECTIFIER
- CONTAINMENT PENETRATION WITH PEN. NUMBER
- TERMINAL BOX
- BACK-UP OVERCURRENT PROTECTION BREAKER

NOTES

- ALL CIRCUIT BREAKERS LOCATED AT HEATER DISTR. PNLS. & BACK-UP PANELS HAVE A 125A TRIP EXCEPT AS NOTED.
- PEN. NO. 1E HAS 9 CKTS; 6 OF GR. 11 & 3 OF GR. 14.
- PEN. NO. 37E HAS 9 CKTS; 7 OF GR. 12 & 2 OF GR. 14.
- PEN. NO. 34E HAS 8 CKTS; 7 OF GR. 13 & 1 OF GR. 14.
- THE LOAD KW (69KW) SHOWN FOR EACH BREAKER AND THE GROUP LOADS (414KW FOR GROUP 11 & 14 AND 483KW FOR GROUP 12 & 13) ARE TOTAL CAPACITY AND INCLUDE HEATERS THAT HAVE BEEN DETERMINATED. SEE TABLE A FOR DISCONNECTED HEATERS AND THE REMAINING CONNECTED LOAD.

REFERENCES

- SINGLE LINE METER & RELAY DIAG., 480V SYSTEM BUS SECT 13D, 13E, 13I & 13J 437540
- SINGLE LINE METER & RELAY DIAG., 480V SYSTEM BUS SECT 1G 437542
- SINGLE LINE METER & RELAY DIAG., 480V SYSTEM BUS SECT 1H 437543
- SCHEMATIC DIAGRAM, PRESSURIZER HEATERS 437602
- DIAGRAM OF CONNECTIONS PRESSURIZER HEATERS 437852
- DIAGRAM OF CONNECTIONS PRESSURIZER HEATERS PANEL 437853
- DIAGRAM OF CONNECTIONS BACK-UP PRESSURIZER HEATERS PANEL 429078
- LIST OF EQUIPMENT LOCATION CODES 067997
- DESCRIPTION OF ELECT. SCHEMATIC DIAGS., SYMBOLS & CKT. DESIGNATIONS 050003

DWG NO.

KEY DWG. SECTION IC

DATE	DESCRIPTION	COORDINATION	DWG SCALE
9/10/04			
DWN. A.J.L.2	Revised per PCT 029269	NUCL. -	BILL OF MATL
R.E. SMBS		MECH. -	SUPDS
INDEP. VERIFIER -		ELEC. -	SUPD BY
P.E. R2MG		CIVIL -	SHEET NO. 1 OF
		PIPING -	REV
		1&C -	
REVISION INFORMATION			
UNIT 1 ELECTRICAL SINGLE LINE DIAGRAM PRESSURIZED HEATERS			
DIABLO CANYON POWER PLANT PACIFIC GAS AND ELECTRIC COMPANY SAN FRANCISCO, CALIFORNIA			
437545			


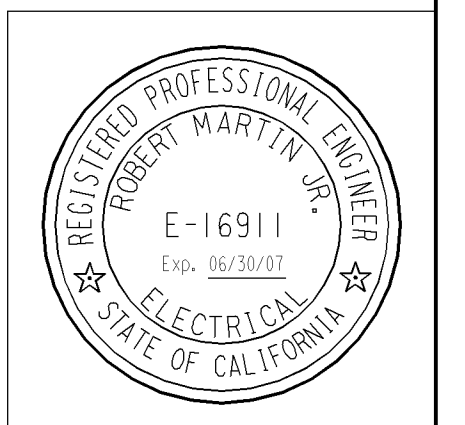


TABLE OF DEVICES					
DEVICE		DESCRIPTION	CATALOG/TYPE	CONTACT	REMARKS
(Y12)	(Y14)				
X12	X12	UPS COMMON ALARM		LATCH	COMMON ALARMS FOR X7, X13, X18, X19, X20, X203 & X404
X7	X7	OUT OF SYNC/COMMON ALARM		NON-LATCH	CONTACT CLOSURES TO ENERGIZE X12
X13	X13	UPS FAN FAILURE/COMMON ALARM		LATCH	CONTACT CLOSURES TO ENERGIZE X12
X18	X18	UPS OVER TEMP/COMMON ALARM		LATCH	CONTACT CLOSURES TO ENERGIZE X12
X19	X19	REG XFMR OVER TEMP/COM ALM		LATCH	CONTACT CLOSURES TO ENERGIZE X12
X20	X20	REG XFMR FAN FAILURE/COM ALM		LATCH	CONTACT CLOSURES TO ENERGIZE X12
X203	X203	LOSS OF BYPASS SOURCE/COM ALM		NON-LATCH	CONTACT CLOSURES TO ENERGIZE X12
X404	X404	AC INPUT/RECTIFIER FAIL/COM ALM		NON-LATCH	CONTACT CLOSURES TO ENERGIZE X12
X4	X4	DC INPUT UNDERVOLTAGE RELAY		NON-LATCH	CONTACT CLOSURES TO ENERGIZE X9
X6	X6	INVERTER OUTPUT UNDERVOLTAGE RELAY		NON-LATCH	CONTACT CLOSURES TO ENERGIZE X10
X9	X9	LOSS OF BATTERY SOURCE ALARM		LATCH	N.C. - CONTACT OPENS TO ALARM
X10	X10	INVERTER FAILURE ALARM		LATCH	N.C. - CONTACT OPENS TO ALARM
X15	X15	LOSS OF AC OUTPUT VOLTAGE ALARM		LATCH	N.C. - CONTACT IN SERIES WITH X204
X16	X16	STATIC SW TRANSFERRED ALARM		LATCH	N.C. - CONTACT IN SERIES WITH X17
X17	X17	MAN BYP SW IN BYPASS POS ALARM		NON-LATCH	N.O. - CONTACT IN SERIES WITH X16
X204	X204	AC OUTPUT UNDERVOLTAGE RELAY		NON-LATCH	N.O. - CONTACT IN SERIES WITH X15
27PY12		PY12 UNDERVOLTAGE ALARM	P&B - TYPE CSJ MODEL 3B-70010	NON-LATCH	N.C. - CONTACT CLOSURES TO ALARM
27PY14		PY14 UNDERVOLTAGE ALARM	P&B - TYPE CSJ MODEL 3B-70010	NON-LATCH	N.C. - CONTACT CLOSURES TO ALARM

TABLE OF DEVICES					
DEVICE		DESCRIPTION	CATALOG/TYPE	CONTACT	REMARKS
DE	DE				
XDCR1	XDCR1	DC INPUT CURRENT TRANSDUCER	RIS: 0 - 50mV DC		
XDCR2	XDCR2	DC INPUT VOLTAGE TRANSDUCER	RIS: 0 - 150VDC		
XDCR3	XDCR3	AC OUTPUT CURRENT TRANSDUCER	RIS: 0 - 5 AAC		
XDCR4	XDCR4	AC OUTPUT VOLTAGE TRANSDUCER	RIS: 0 - 130VAC		
72-12B1	72-14B1	DC INPUT BREAKER	G.E. TYPE TJK, 350A		
52-12B2	52-14B2	AC OUTPUT BREAKER	G.E. TYPE SE150, 100A		
52-12B3	52-14B3	AC OUTPUT BREAKER	G.E. TYPE SE150, 100A		
52-12B4	52-14B4	BYPASS SOURCE DISC SWITCH	G.E. TYPE T0D, 225A		
52-12B401	52-14B401	AC INPUT BREAKER	G.E. TYPE THED, 80A		
52-12B801	52-14B801	REG XFMR OUTPUT BREAKER	G.E. TYPE SF250, 250A		
29-12S801	29-14S801	REG XFMR TRANSFER SWITCH	600VAC, 75A, 3PDT		BREAK-BEFORE-MAKE SWITCH
F2	F2	INVERTER FUSE	250VAC, 600A		SEE DWG 066144
F204	F204	STATIC SWITCH FUSE	250VAC, 600A		SEE DWG 066144
F407	F407	RECTIFIER FUSE	250VAC, 400A		SEE DWG 066144
F408	F408	RECTIFIER FUSE	250VAC, 400A		SEE DWG 066144
F409	F409	RECTIFIER FUSE	250VAC, 400A		SEE DWG 066144

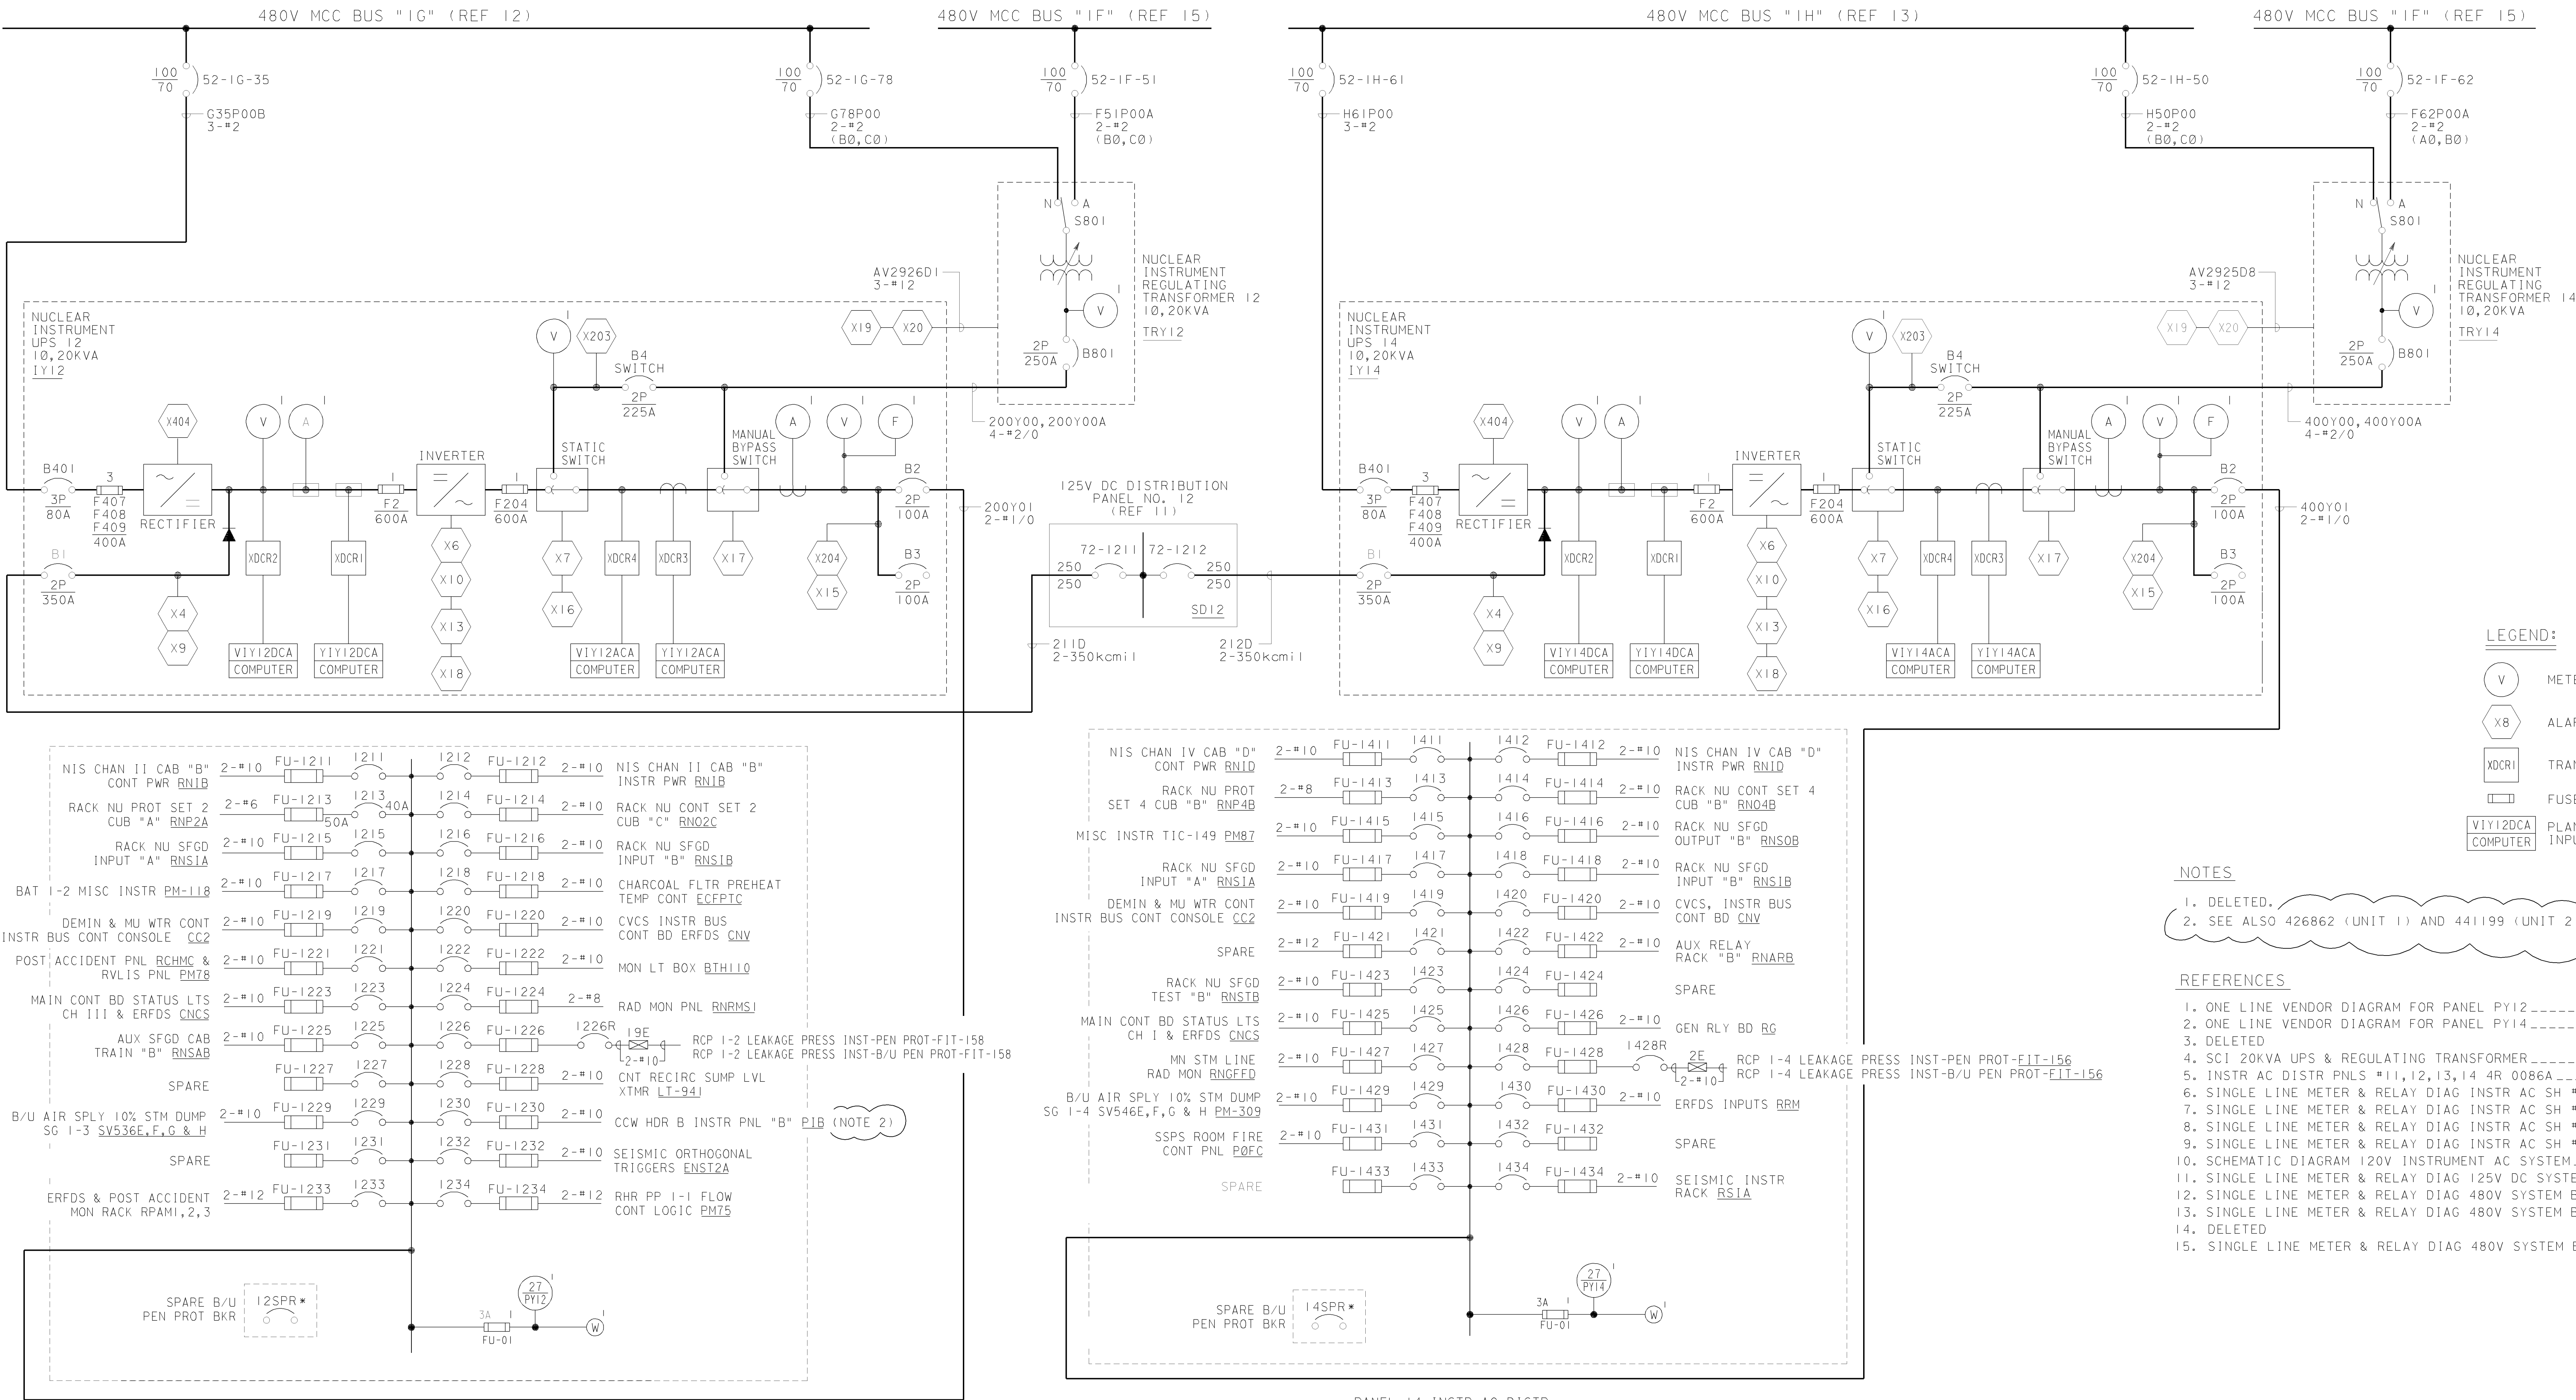

- LEGEND:
- V METER
 - X8 ALARM RELAY BOARD
 - XDCR1 TRANSDUCER
 - FUSE
 - V1Y12DCA COMPUTER INPUT NO.


- NOTES
- DELETED.
 - SEE ALSO 426862 (UNIT 1) AND 441199 (UNIT 2). <4-B>

- REFERENCES
- DWG NO.
- ONE LINE VENDOR DIAGRAM FOR PANEL PY12----- REC 6021760-117
 - ONE LINE VENDOR DIAGRAM FOR PANEL PY14----- REC 6021760-135
 - DELETED
 - SCI 20KVA UPS & REGULATING TRANSFORMER----- REC 6013738
 - INSTR AC DISTR PNLS #11,12,13,14 4R 0086A----- REC 663341
 - SINGLE LINE METER & RELAY DIAG INSTR AC SH #2----- 437549
 - SINGLE LINE METER & RELAY DIAG INSTR AC SH #3----- 445290
 - SINGLE LINE METER & RELAY DIAG INSTR AC SH #4----- 445291
 - SINGLE LINE METER & RELAY DIAG INSTR AC SH #5----- 445294
 - SCHEMATIC DIAGRAM 120V INSTRUMENT AC SYSTEM----- 4010036
 - SINGLE LINE METER & RELAY DIAG 125V DC SYSTEM SH #2----- 445075
 - SINGLE LINE METER & RELAY DIAG 480V SYSTEM BUS SECT 1G----- 437542
 - SINGLE LINE METER & RELAY DIAG 480V SYSTEM BUS SECT 1H----- 437543
 - DELETED
 - SINGLE LINE METER & RELAY DIAG 480V SYSTEM BUS SECT 1F----- 437916


NUCLEAR SAFETY RELATED

UNIT 1


DATE		REVISION DESCRIPTION		DWG SCALE:	
09-07-2012		REVISED PER DFT-71822		BILL OF MAT'L:	
D.D. MHRU				SUPDSG:	
R.E. Fxc2				SUPDSG BY:	
I.V.				DRAWING	
P.E. AGB2				SHEET	
				PAGE	
				REV	
				437547	
				1	
				0	
				43	

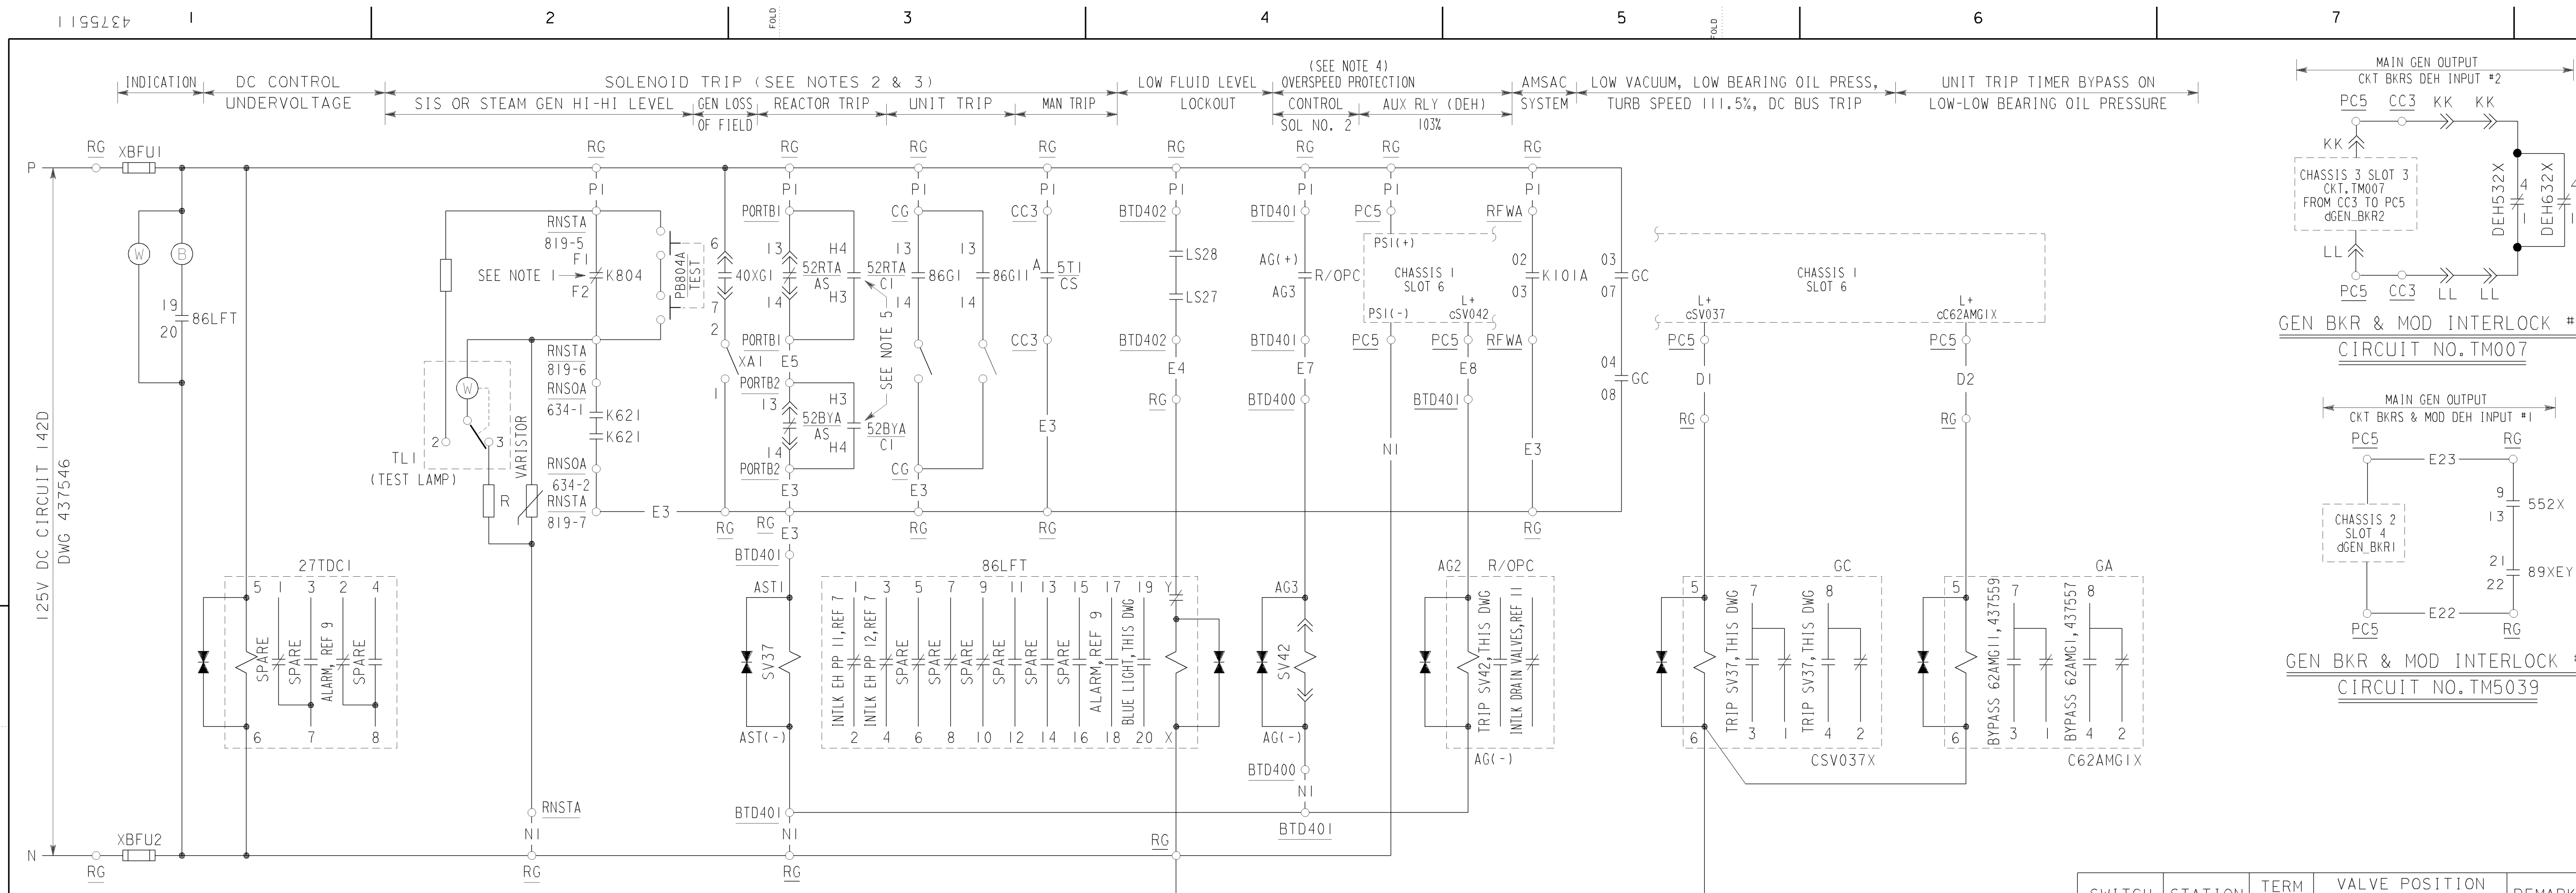

TURBINE TRIP CIRCUIT NO. TM1

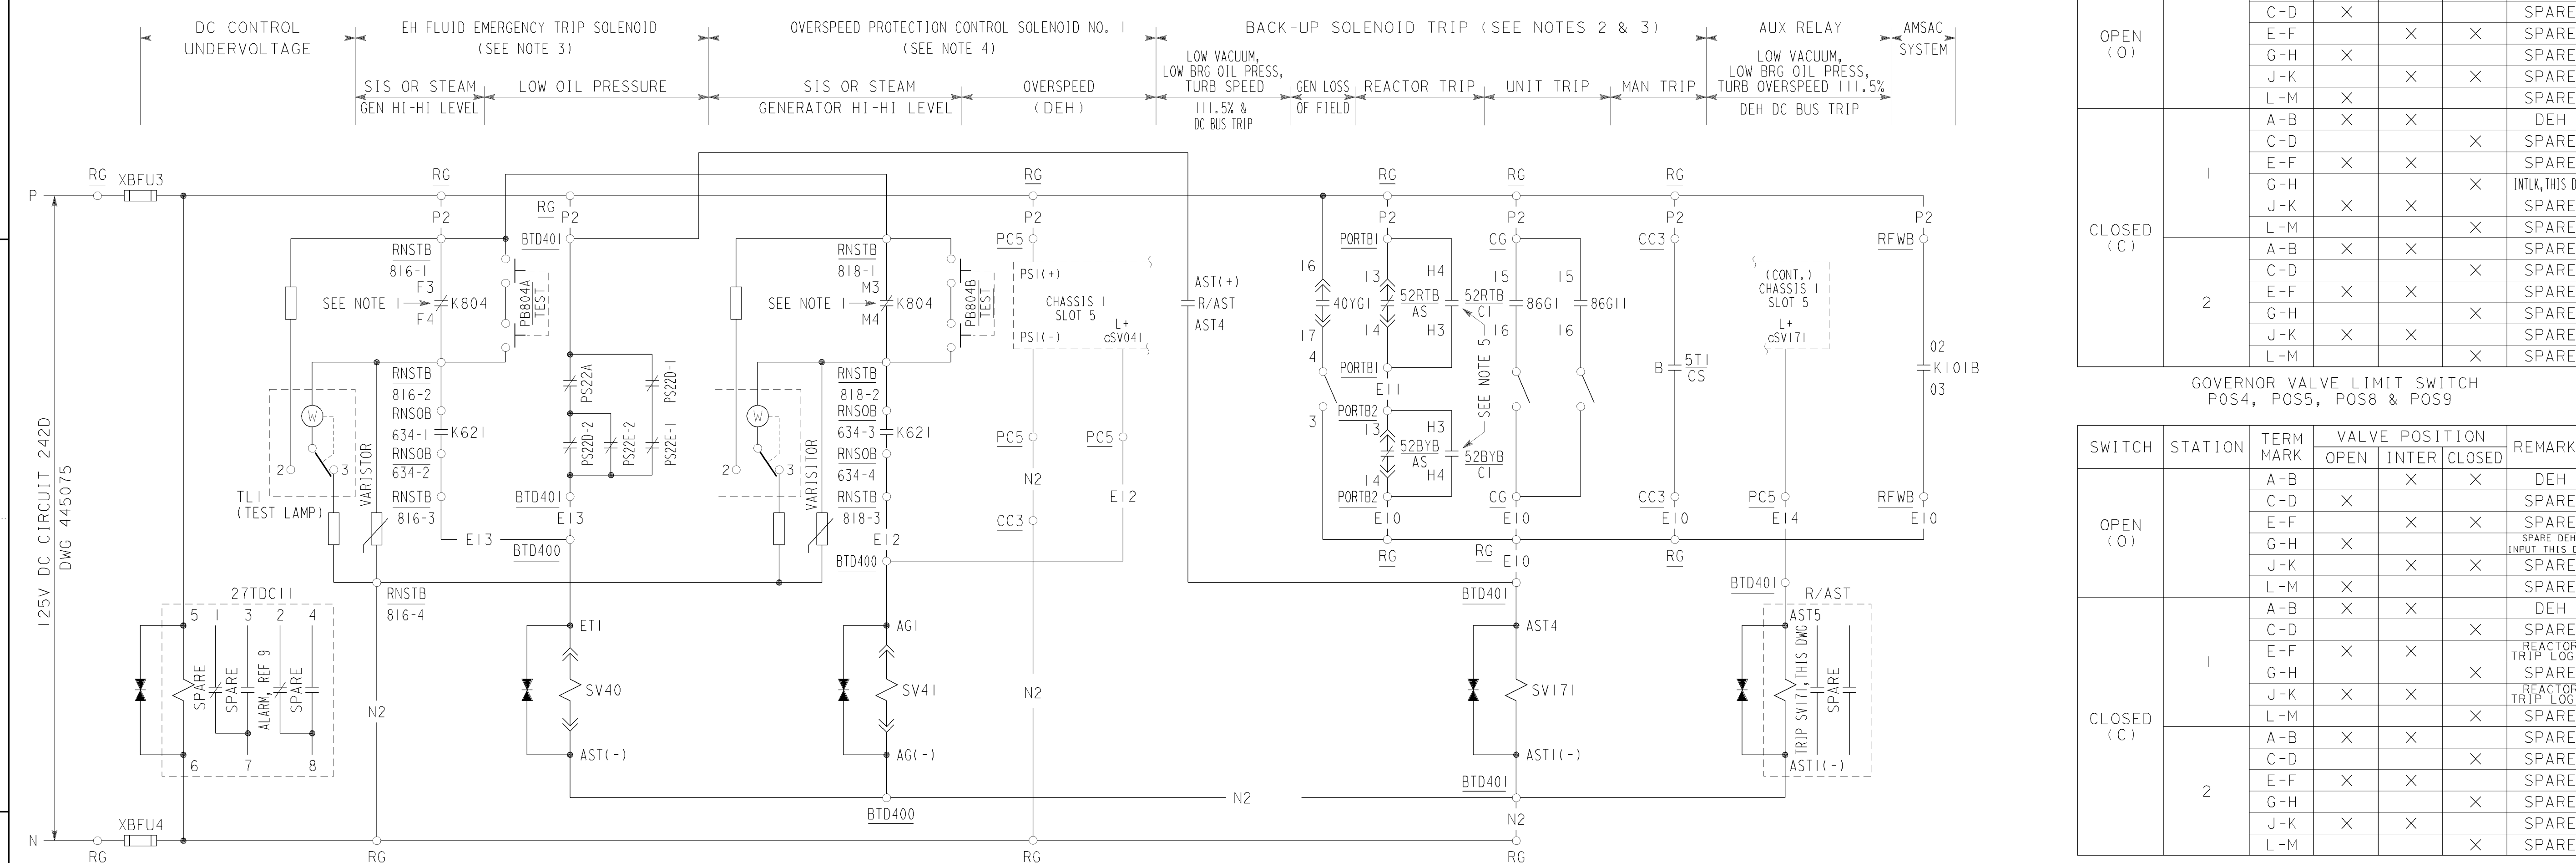


TURBINE BACK-UP TRIP CIRCUIT NO. TM2

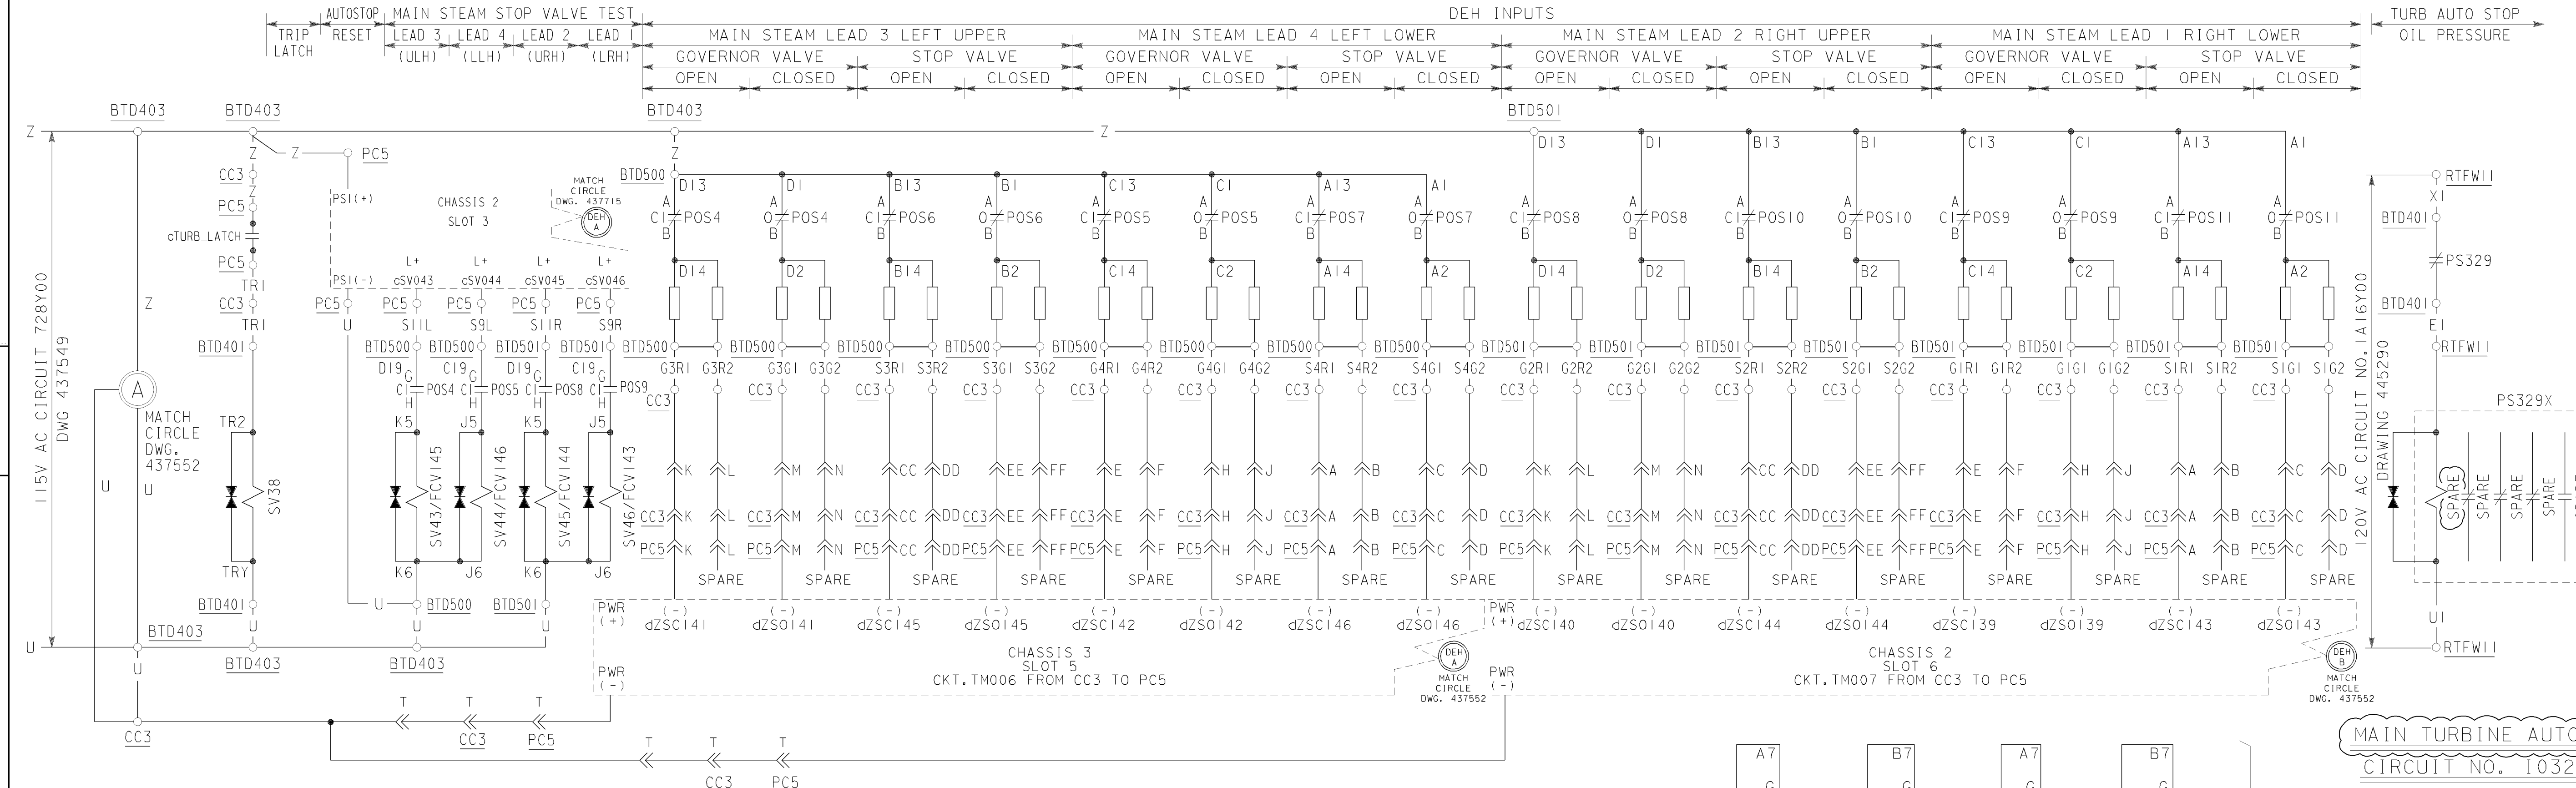


GOVERNOR AND MAIN STEAM STOP VALVES CIRCUIT NO. TM3

- NOTES
1. TEST RELAY OPEN DURING TEST.
 2. TURBINE WILL ALSO TRIP MECHANICALLY UPON OPERATION OF THE FOLLOWING PROTECTIVE DEVICES: OVERSPEED, LOW BEARING OIL PRESSURE, THRUST BEARING FAILURE.
 3. THIS SOLENOID VALVE WILL TRIP GOVERNOR, INTERCEPTOR, REHEAT STOP AND MAIN STEAM STOP VALVES.
 4. THIS SOLENOID VALVE WILL TRIP GOVERNOR & INTERCEPTOR VALVES ONLY.
 5. CELL INTERLOCK SWITCHES ARE SHOWN WITH BREAKER IN OPERATING POSITION.

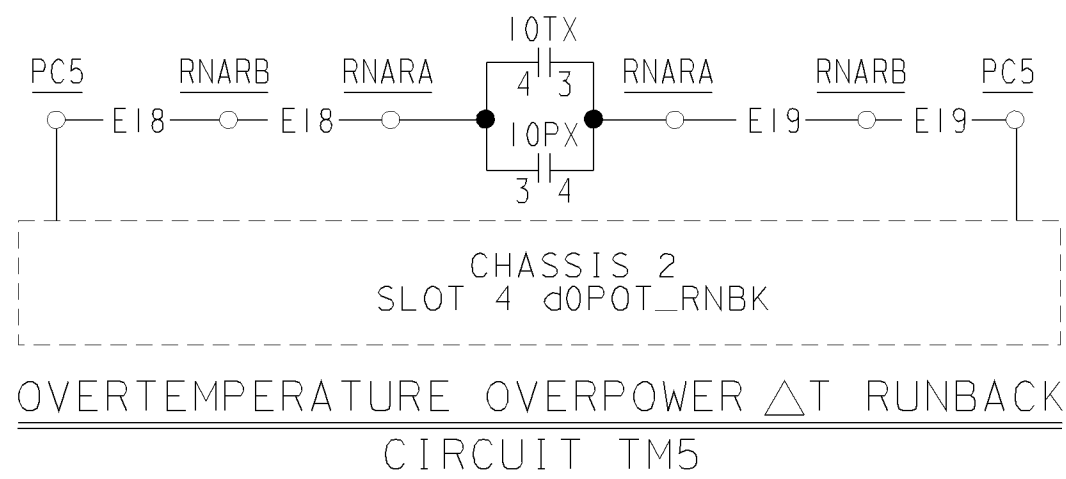


OVERTEMPERATURE OVERPOWER ΔT RUNBACK CIRCUIT TM5

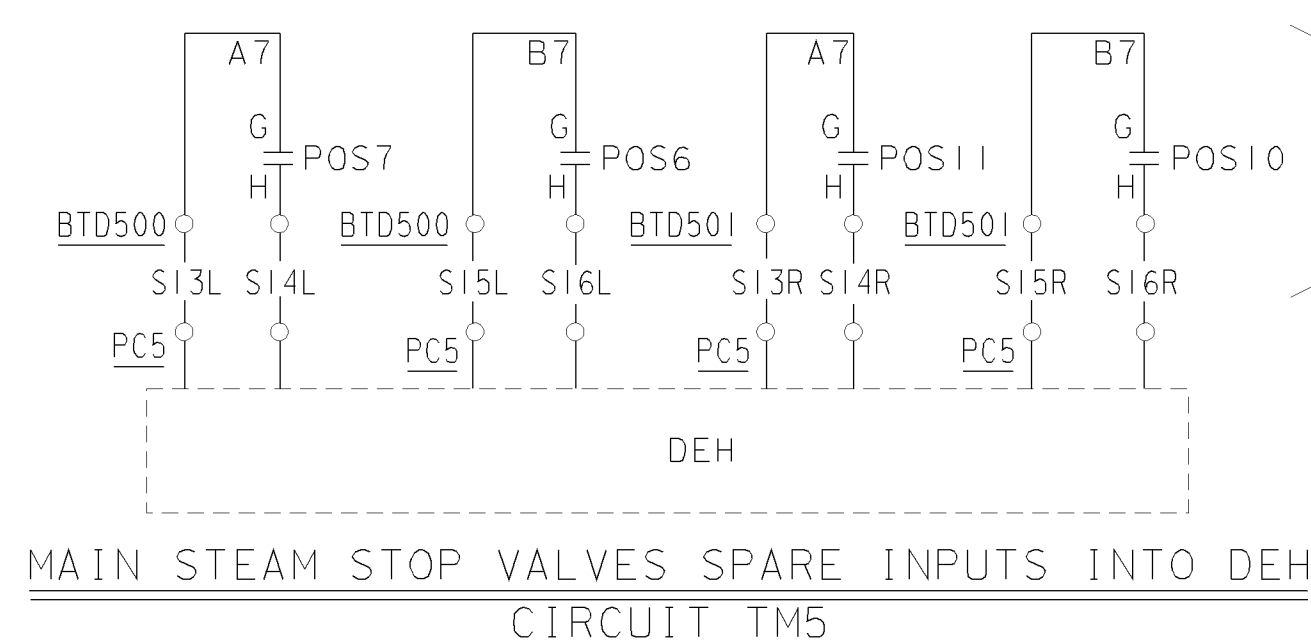

MAIN STEAM STOP VALVES SPARE INPUTS INTO DEH CIRCUIT TM5

MANUFACTURER'S EQUIVALENT		DEVICE NO.	FUNCTION	RATING	MFR	TYPE	CATALOG OR REF DWG	REMARKS
		PS329X	TURB AUTO STOP OIL TRIPPED PRESS AUX RLY	120V AC	CH	AR	D40RR33A	
		6TURB LATCH	COND. VACUUM TRIP LATCH				15,23 & 25	DEH COMPUTER
		cSV041	TURB OVERSPEED PROTECTION				15,23 & 25	DEH COMPUTER
		cSV042	TURB OVERSPEED PROTECTION				15,23 & 25	DEH COMPUTER
		cSV171	TURB OVERSPEED PROTECTION, LOW VACUUM, OR LOW BRG OIL PRESS (DEH) OR DC STOP TRIP				15,23 & 25	DEH COMPUTER
		552Y1	500KV PCB AUX RELAY				6	CONTACT CLOSING WHEN BOTH 500KV BRKS OPEN
		27TDC11	TURB CONT DC UNDERVOLTAGE	125V DC	WE	SG	1342925	
		27TDC11	TURB CONT BACK-UP DC UNDERVOLTAGE	125V DC	WE	SG	1342925	
		86G1	UNIT TRIP LOCKOUT RELAY				5	
		86G1	UNIT TRIP LOCKOUT RELAY				5	
		86LFT	EH LOW FLUID LEVEL TRIP LOCKOUT RLY	125V DC	WE	WL	4220949G65	HAND RESET
		52RTA,B	REACTOR TRIP BREAKERS				8	
		52BYA,B	REACTOR BYPASS BREAKER				8	
		cSV046	MAIN STEAM LEAD 1 STOP VALVE TEST				15,23 & 25	DEH COMPUTER
		cSV045	MAIN STEAM LEAD 2 STOP VALVE TEST				15,23 & 25	DEH COMPUTER
		cSV043	MAIN STEAM LEAD 3 STOP VALVE TEST				15,23 & 25	DEH COMPUTER
		cSV044	MAIN STEAM LEAD 4 STOP VALVE TEST				15,23 & 25	DEH COMPUTER
		33/GLU	GOVERNOR VALVE LEFT UPPER LIMIT SW				13	
		33/GLL	GOVERNOR VALVE LEFT LOWER LIMIT SW				13	
		33/SLU	GOVERNOR VALVE LEFT UPPER LIMIT SW				13	
		33/SLL	GOVERNOR VALVE LEFT LOWER LIMIT SW				13	
		33/GRU	GOVERNOR VALVE RIGHT UPPER LIMIT SW				13	
		33/GRL	GOVERNOR VALVE RIGHT LOWER LIMIT SW				13	
		33/SRU	GOVERNOR VALVE RIGHT UPPER LIMIT SW				13	
		33/SRL	GOVERNOR VALVE RIGHT LOWER LIMIT SW				13	
		R/OPC	TURB OVERSPEED PROTECTION AUX RLY	120V DC				ENERGIZED BY DEH COMPUTER
		R/AST	TURB AUTO STOP OIL TRIPPED PRESS SW	120V DC				ENERGIZED BY DEH COMPUTER
		63/AST-2	TURB OVERSPEED TRIP AUX RLY					CONTACT CLOSING
		PS22C	TURB AUTO STOP OIL TRIPPED PRESS SW					CONTACT CLOSING
		PS22C,E	TURB AUTO STOP LATCH SIGNAL					CONTACT CLOSING
		PS22B,F,G	EH RESERVOIR LOW FLUID TRIP LOCKOUT					CONTACT CLOSING
		LS27	EH RESERVOIR LOW FLUID TRIP LOCKOUT					CONTACT CLOSING
		SV37	TURB AUTO STOP TRIP SOLENOID VALVE	125V DC				CONTACT CLOSING
		SV171	TURB AUTO STOP TRIP BACK-UP SOLENOID VALVE	125V DC				CONTACT CLOSING
		SV38	TURB AUTO STOP RESET SOLENOID VALVE	115V AC				CONTACT CLOSING
		SV40	EH FLUID EMERGENCY TRIP SOLENOID VALVE	120V DC				CONTACT CLOSING
		SV41	EH FLUID AUX GOVERNOR SOLENOID VALVE	120V DC				CONTACT CLOSING
		SV42	EH FLUID AUX GOVERNOR SOLENOID VALVE	120V DC				CONTACT CLOSING
		SV43	MAIN STEAM LEAD 3 STOP VALVE SV (LH)	115V AC				CONTACT CLOSING
		SV44	MAIN STEAM LEAD 4 STOP VALVE SV (LH)	115V AC				CONTACT CLOSING
		SV45	MAIN STEAM LEAD 2 STOP VALVE SV (LH)	115V AC				CONTACT CLOSING
		SV46	MAIN STEAM LEAD 1 STOP VALVE SV (LH)	115V AC				CONTACT CLOSING
		40XG1,40V1	GENERATOR LOSS OF FIELD AUX RELAY					CONTACT CLOSING
		PS329	TURB AUTO STOP OIL TRIPPED PRESS SW					CONTACT CLOSING
		K621	SIS OR STEAM GENERATOR HI-HI LEVEL AUX RLY					CONTACT CLOSING
		DEH532X	DEH GEN. BREAKER 532 AUX RLY					CONTACT CLOSING
		DEH632X	DEH GEN. BREAKER 632 AUX RLY					CONTACT CLOSING
		K101A	AMSAC SYSTEM (TRAIN A)					CONTACT CLOSING
		K101B	AMSAC SYSTEM (TRAIN B)					CONTACT CLOSING
		LS28	EH RESERVOIR LOW FLUID TRIP LOCKOUT					CONTACT CLOSING
		552X	500KV PCB'S 532 & 632 AUX RLY					CONTACT CLOSING
		89XEY	25KV ISO PHASE DISCONNECT SW AUX RLY					CONTACT CLOSING
		10TX	OVERTEMPERATURE ΔT					CONTACT CLOSING
		10PX	OVERTEMPERATURE ΔT					CONTACT CLOSING
		cSV037	TURB OVERSPEED PROTECTION, LOW VACUUM, OR LOW BRG OIL PRESS (DEH) OR DC BUS TRIP					DEH COMPUTER
		CSV037X	TURB OVERSPEED PROTECTION, LOW VACUUM, OR LOW BRG OIL PRESS (DEH) OR DC BUS TRIP	125V DC	WE	SG	1342925	DEH COMPUTER
		C62AMG1X	UNIT TRIP TIMER BYPASS AUX RLY	125V DC	WE	SG	1342925	DEH COMPUTER
		CC62AMG1X	UNIT TRIP TIMER BYPASS					DEH COMPUTER

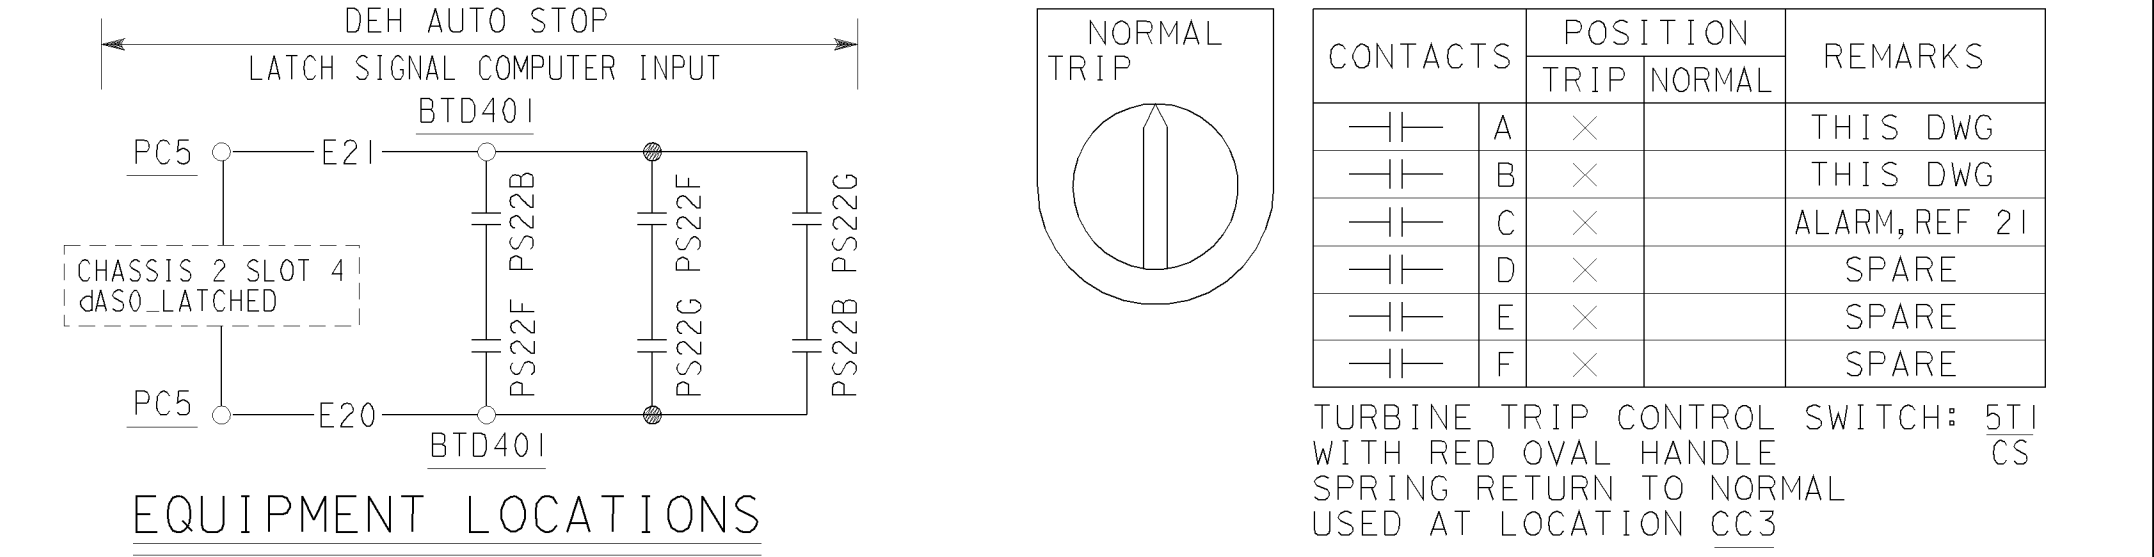


- EQUIPMENT LOCATIONS
- BTD400 - TURBINE EQUIPMENT TERMINAL BOX B
BTD401 - TURBINE EQUIPMENT TERMINAL BOX A
BTD402 - TURBINE EQUIPMENT TERMINAL BOX ER
BTD403 - TERMINAL BOX D 403
BTD500 - TURBINE EQUIPMENT TERMINAL BOX D
BTD501 - TURBINE EQUIPMENT TERMINAL BOX E
CC3 - GENERATOR CONTROL CONSOLE
CG - GENERATOR CONTROL BOARD
- PC5 - MAIN TURBINE CONTROL SYSTEM CABINET
PORTB1 - CONTROL PANEL REACTOR TRIP BREAKERS
PORTB2 - CONTROL PANEL REACTOR BYPASS BREAKERS
R - GENERATOR RELAY BOARD
RNSOA - NUCLEAR SAFEGUARD OUTPUT RACK A
RNSTA - NUCLEAR SAFEGUARD TEST RACK A
RTFW11 - FWPI1 SPEED CONTROL PANEL

- REFERENCES
1. DESCRIPTION OF ELEC SCHEM DIAG SYMBOLS & KCT DESIGNATIONS
 2. LIST OF EQUIPMENT LOCATION CODES
 3. SINGLE LINE METER & RELAY DIAG 125V DC SYSTEM
 4. SINGLE LINE METER & RELAY DIAG INSTRUMENT AC SYSTEM, SH 2
 5. SCHEM DIAG GENERATOR CONTROL, SH 1
 6. SCHEM DIAG GENERATOR CONTROL, SH 2
 7. SCHEM DIAG TURBINE LUBE OIL PUMPS, SH 1
 8. SCHEM DIAG REACTOR TRIP BREAKERS
 9. SCHEM DIAG MAIN ANNUNCIATOR
 10. DIAG OF CONN P250 COMPUTER TERMINAL
 11. SCHEM DIAG TURBINE CONTROL, SH 2
 12. SCHEM DIAG TURBINE CONTROL, SH 3
 13. INSTRUMENT REFERENCE
 14. SCHEM DIAG DDC HAND CONTROLLER MAN-AUTO STATIONS
 15. SCHEM DIAG SSPS OUTPUT RELAYS, TRAIN A
 16. SOLID STATE PROTECTION SYSTEM MANUFACTURER'S DWG
 17. FUNCTIONAL DIAGRAM MANUFACTURER'S DWG
 18. TURBINE ELECTRICAL SYSTEM MANUFACTURER'S DWG
 19. DELETED
 20. ADVANCE DIGITAL FEEDWATER SYSTEM (AMSAC)
 21. SCHEM DIAG MAIN ANNUNCIATOR
 22. SINGLE LINE METER & RELAY DIAG INSTRUMENT AC SYSTEM, SH 2
 23. SCHEM DIAG SSPS OUTPUT RELAYS, TRAIN B
 24. SCHEM DIAG MAIN ANNUNCIATOR
 25. TURBINE CONTROL SYSTEM BASIS OF DESIGN DOCUMENT MANUAL
 26. SCHEM DIAG TURBINE CONTROL
 27. SCHEM DIAG 125VDC MANUAL CONTROL & RELAY TRIP
 28. SCHEM DIAG 125VDC MANUAL CONTROL & RELAY TRIP
 29. SCHEM DIAG GENERATOR CONTROL
 30. SCHEM STEAM VALVE TEST
 31. ELEMENTARY WIRING DIAG AUX RELAYS UNITS 1 & 2

DATE	REVISION DESCRIPTION	DWG NO.
03-25-2009	REVISION DESCRIPTION	437551
D.O. R/G2	REVISED PER DDN-21199	
R.E. F/C2	DFC-3568	
I.V.		
P.E. R/W7		

DWG SCALE:	SHEET	PAGE	REV
BILL OF MAT'L	437551	1	0
SUPDSY			
SUPDSY			
DRAWING			
SHEET			
PAGE			
REV			

PACIFIC GAS AND ELECTRIC COMPANY
SAN FRANCISCO, CALIFORNIA

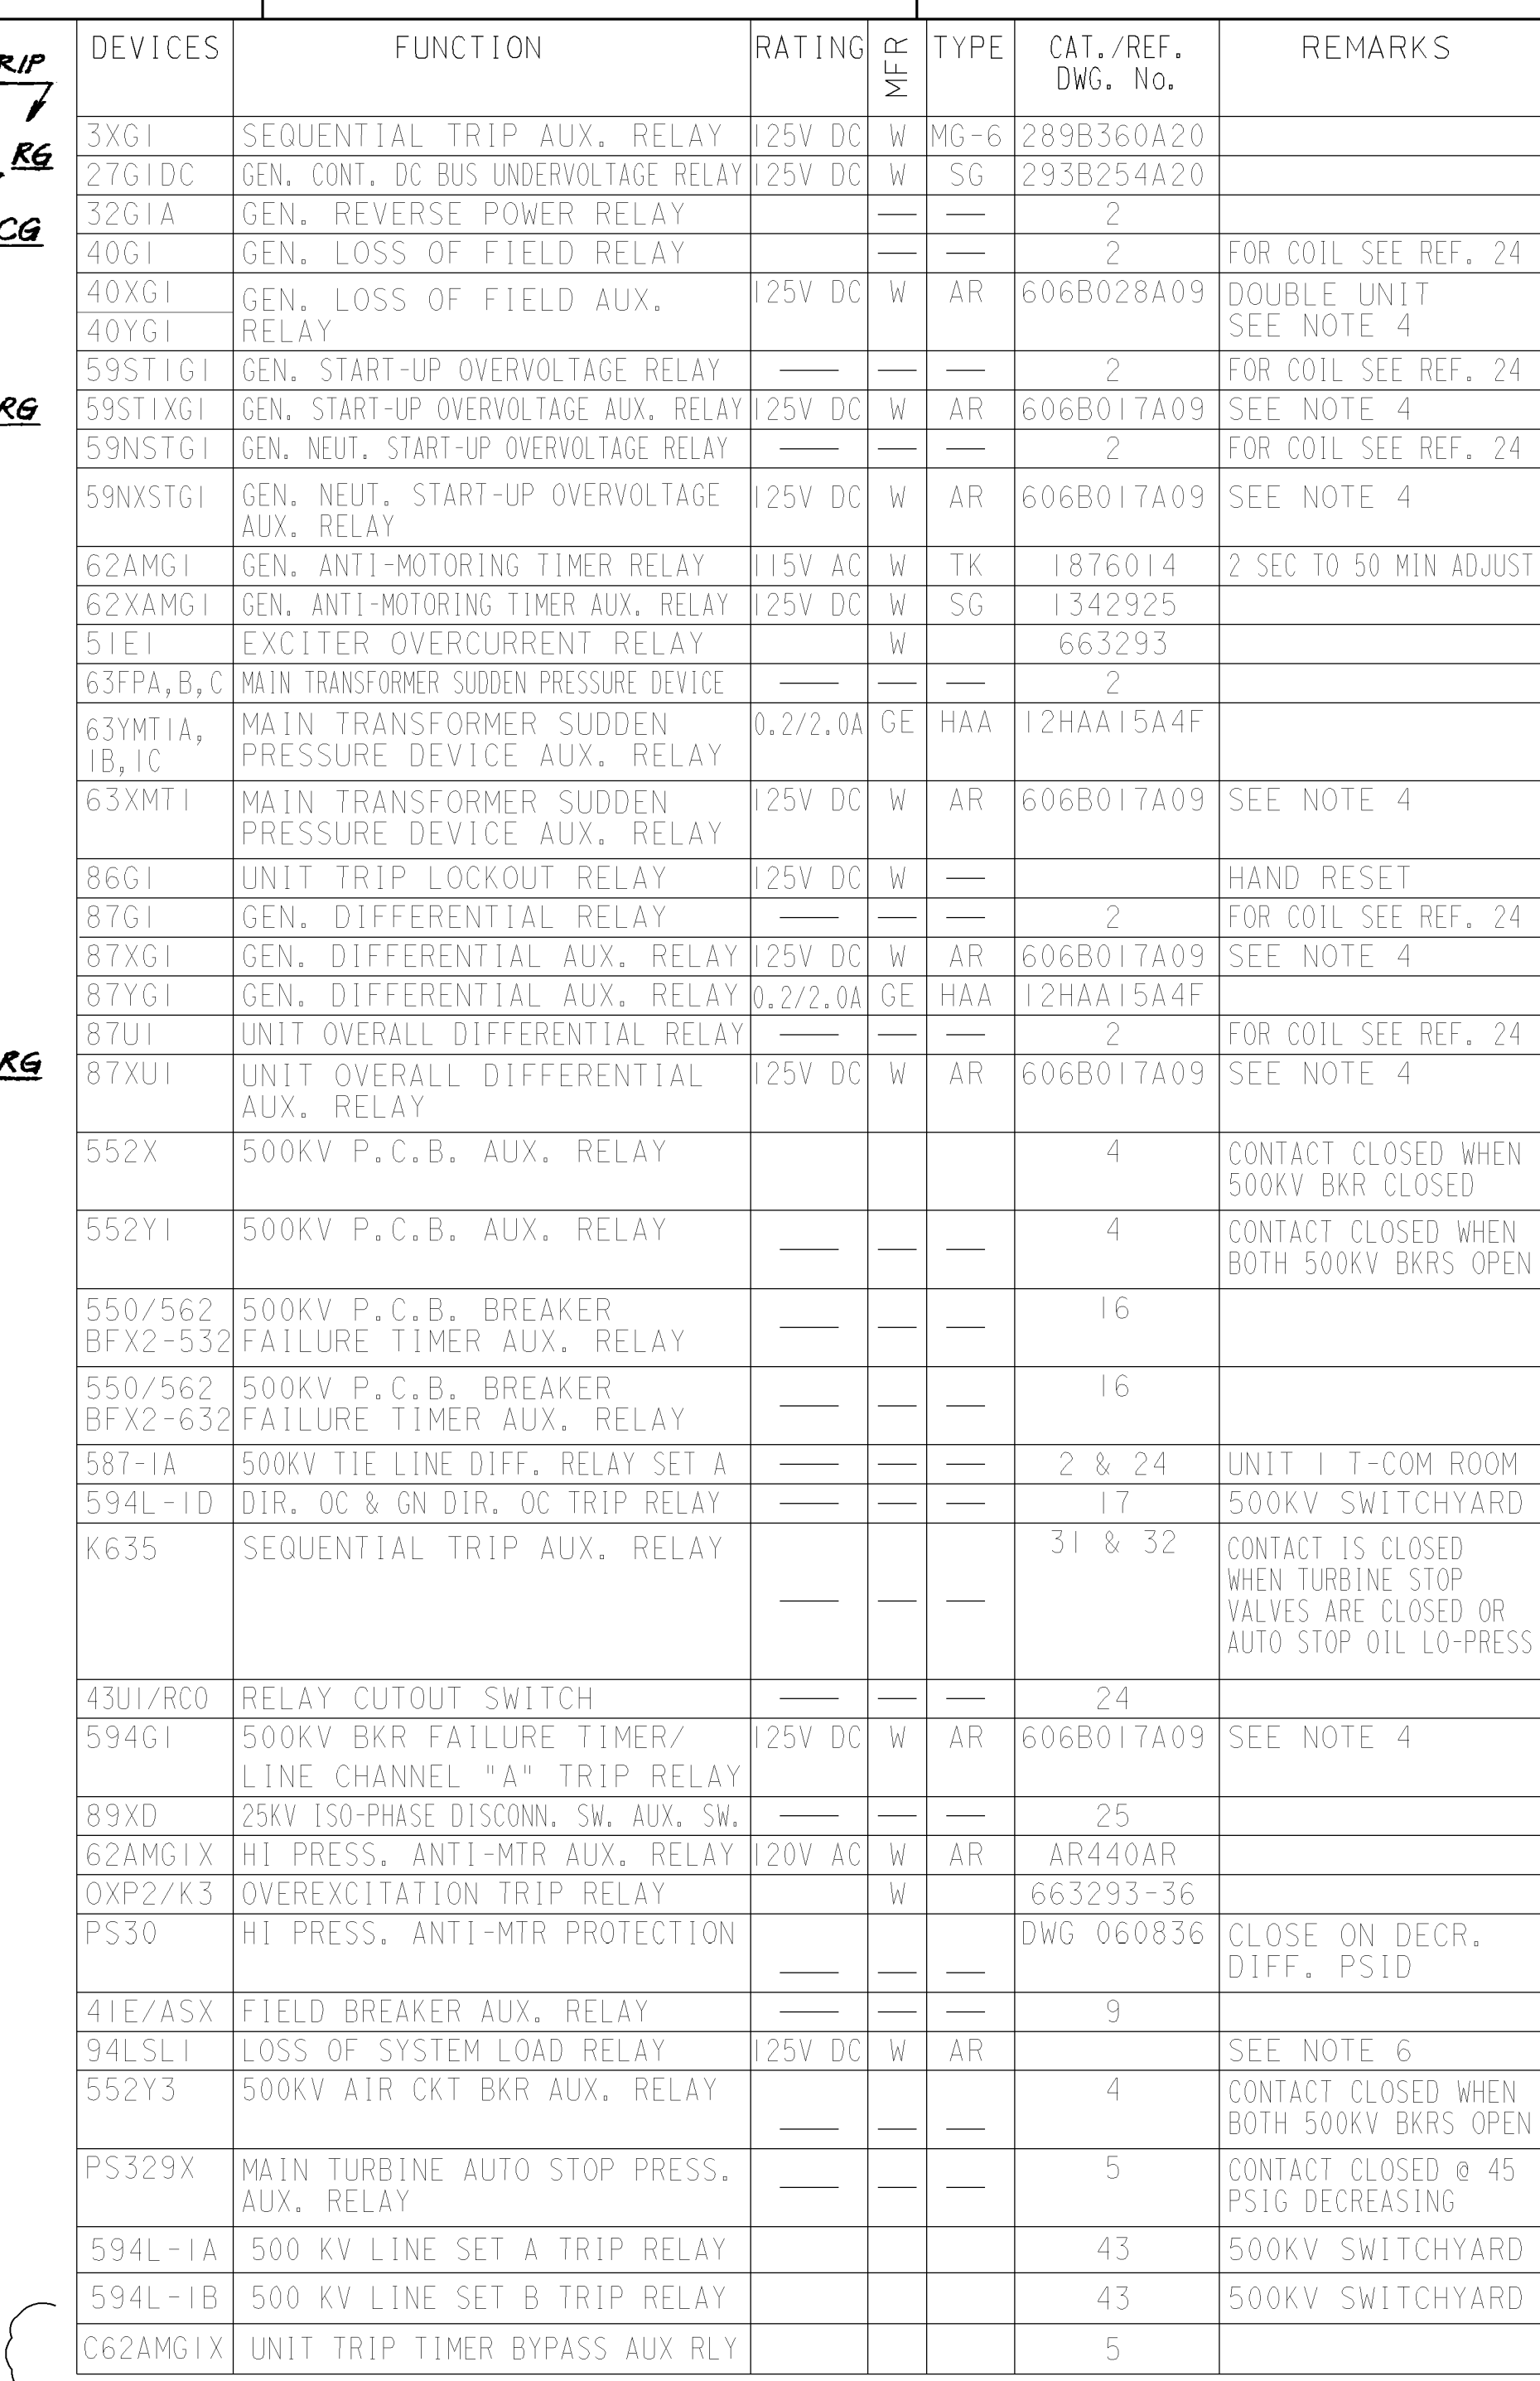


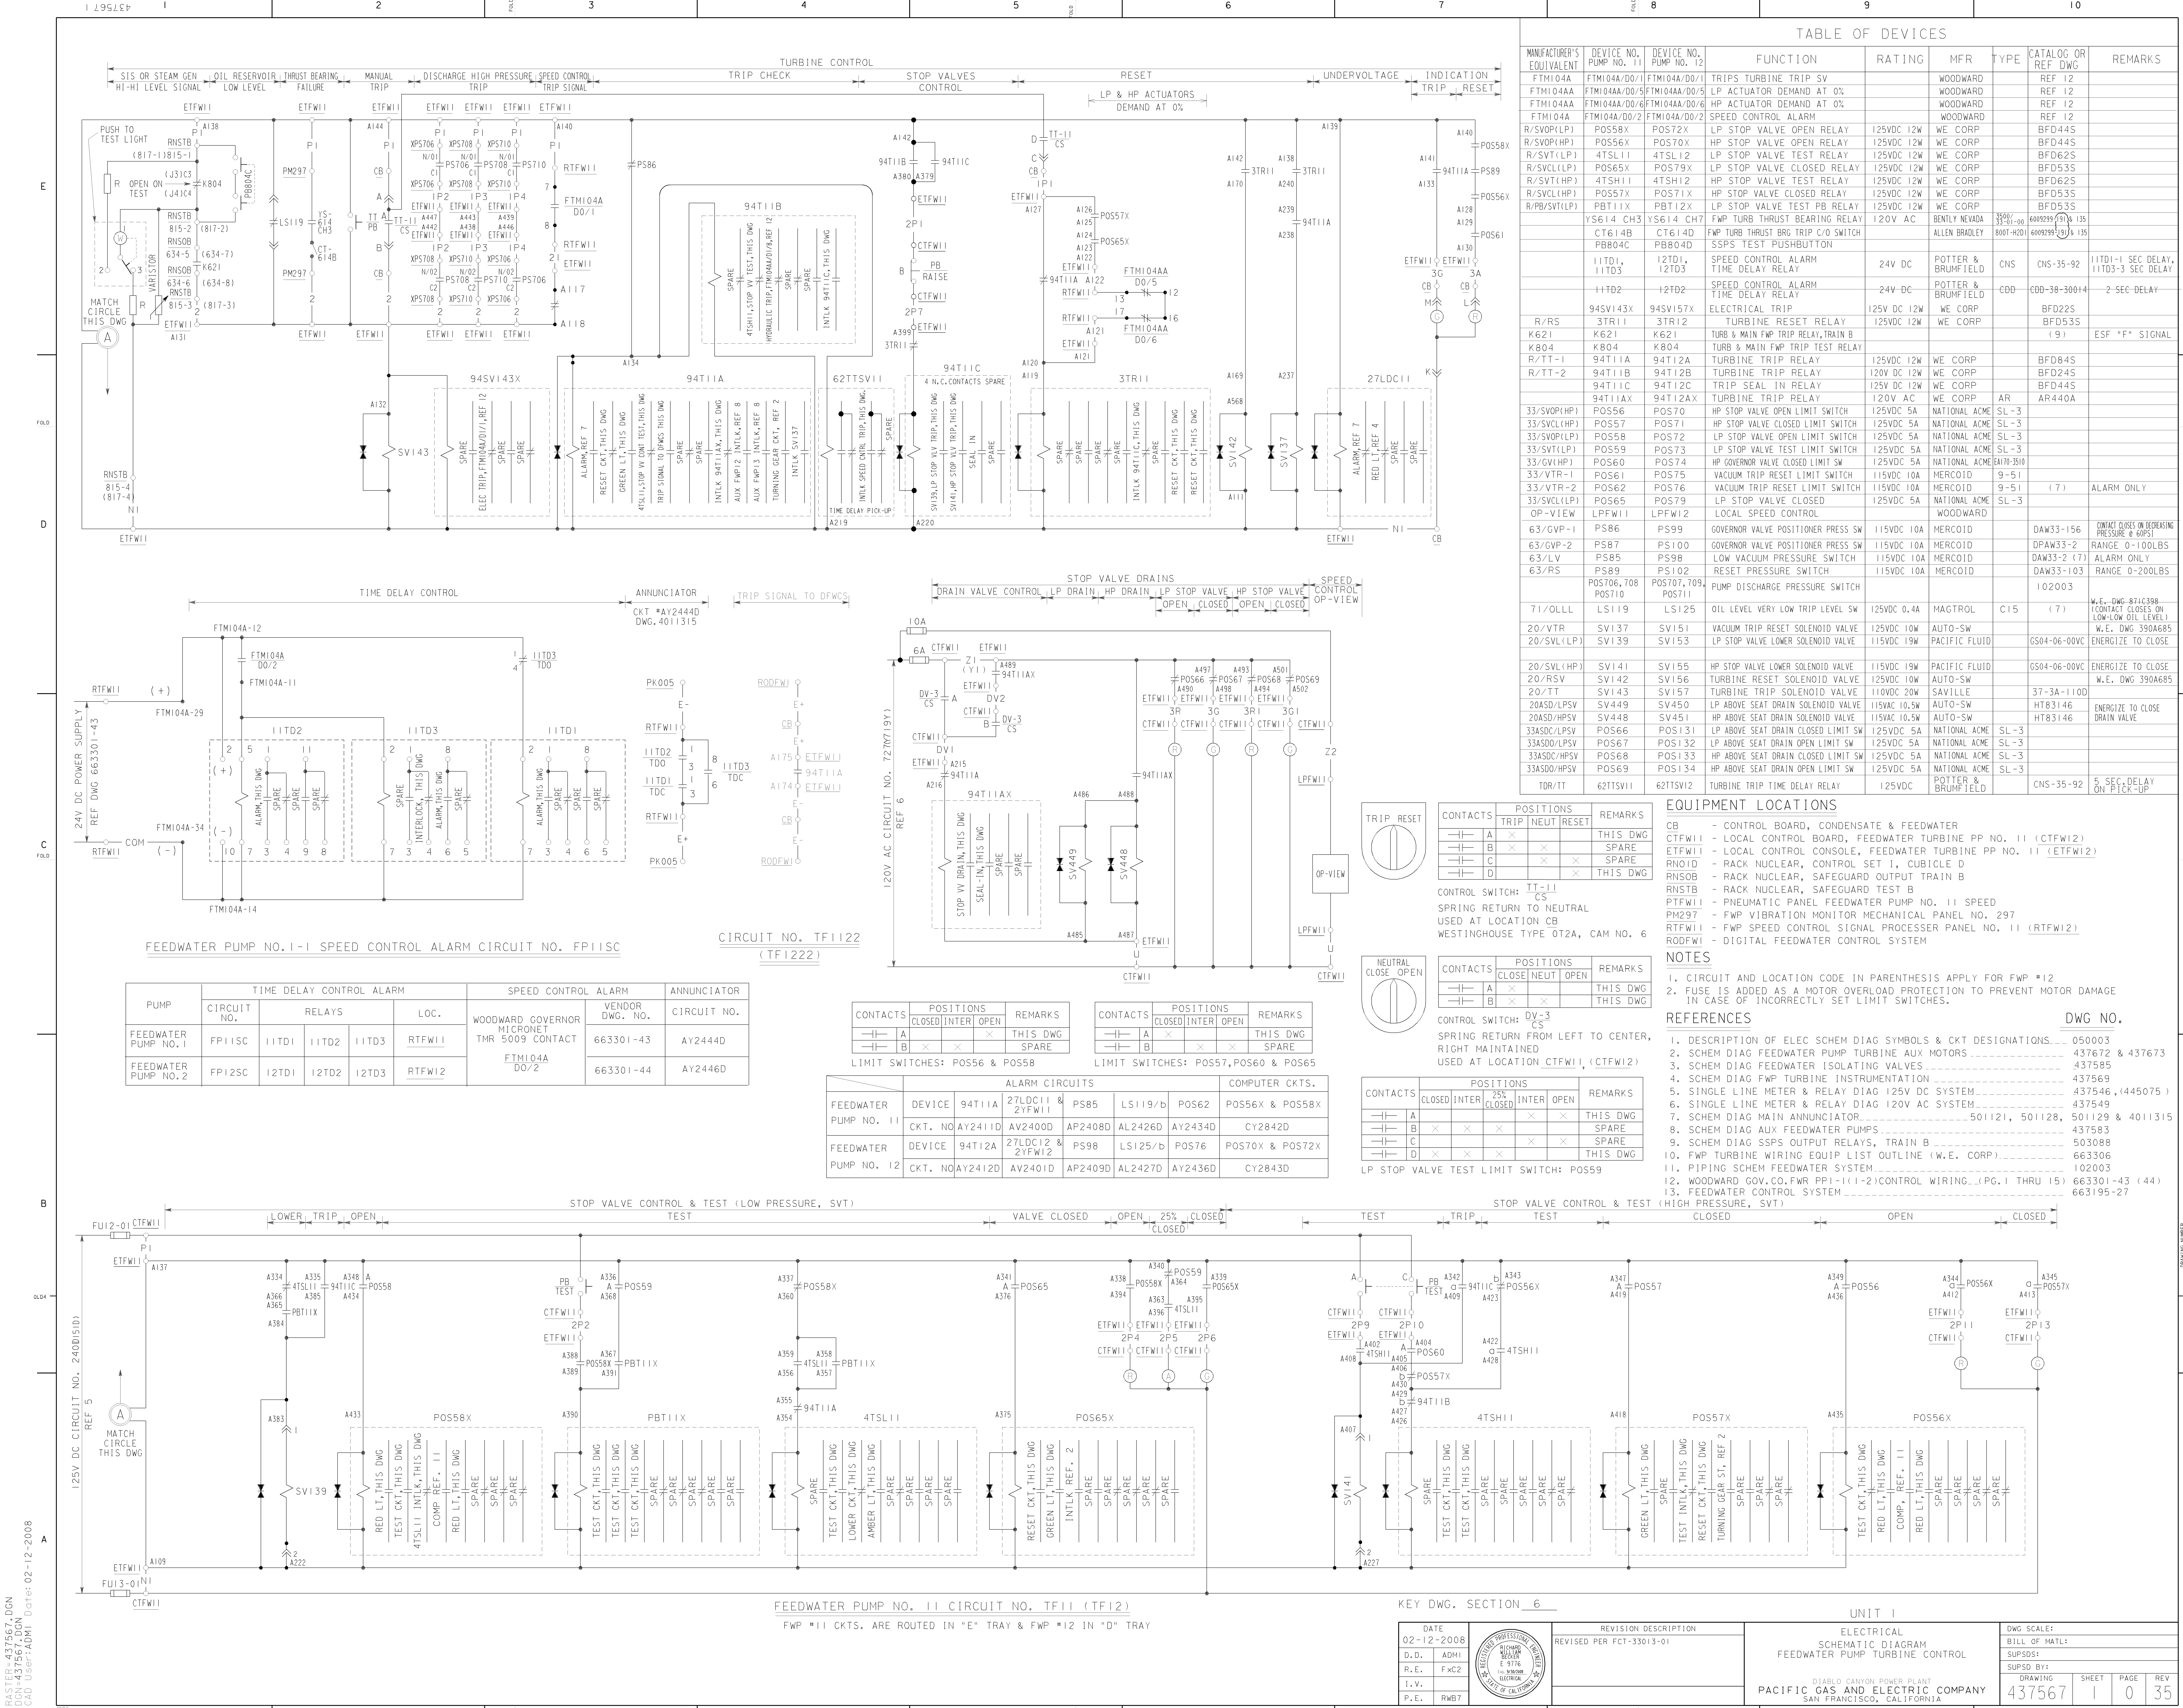
REFERENCE DWGS.:


EQUIPMENT LOCATIONS:

NOTES:

ALARMS
500KV SYSTEM

KEY DWG. SECTION <u>5</u>		UNIT 1			
DATE 12-15-2005 D.D. AJL2 R.E. SMB5 I.V. P.E. R2M5		REVISION DESCRIPTION REVISED PER DCI-SE-049665-00 ELECTRICAL SCHEMATIC DIAGRAM GENERATOR CONTROL DIABLO CANYON POWER PLANT PACIFIC GAS AND ELECTRIC COMPANY SAN FRANCISCO, CALIFORNIA		DWG SCALE: BILL OF MATL: SUPDS: SUPSD BY:	
		DRAWING 437557		SHEET 1	PAGE 0
				REV 36	



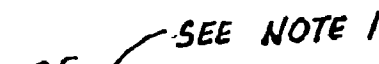

POSITIONS	
-----------	--


STOP START

(SSS)
SPRING RETURN TO NORMAL
DIESEL ENGINE CONTROL SWITCH
AT LOC. GQD11 & GQD12 $\frac{DE11}{CS}$ & $\frac{DE12}{CS}$

NOTES

- REFERENCE DWGS

- A
B C
G. & E. SYSTEM
PHASE SEQUENCE
A-C-B

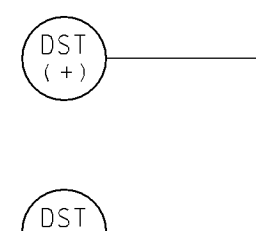

DRUOP SW $\frac{\text{CS}}{\text{CS}}$ & $\frac{\text{CS}}{\text{CS}}$ AT LOC. SED11 & SED12

SIS SIGNAL UNIT No. 1U/V AUXILIARY RELAY

MAIN ANN. ALARM CKT. TABLE

KEY DWG. SECTION 2

REVISION DESCRIPTION
REVISED PER DFT-7*2433

ELECTRICAL SCHEMATIC DIAGRAM 4KV DIESEL GENERATOR CONTROL NO. 11 & 12 DIABLO CANYON POWER PLANT PACIFIC GAS AND ELECTRIC COMPANY SAN FRANCISCO, CALIFORNIA	DWD SCALE:			
	BILL OF MATL:			
	SUPSDS:			
	SUPSD BY:			
	DRAWING	SHEET	PAGE	REV
437579	1	0	43	