

# CATEGORY 1

## REGULATORY INFORMATION DISTRIBUTION SYSTEM (RIDS)

ACCESSION NBR:9802060051      DOC.DATE: 98/01/26      NOTARIZED: NO      DOCKET #  
FACIL:50-269 Oconee Nuclear Station, Unit 1, Duke Power Co.      05000269  
AUTH.NAME      AUTHOR AFFILIATION  
MCCOLLUM,W.R.      Duke Power Co.  
RECIP.NAME      RECIPIENT AFFILIATION  
Document Control Branch (Document Control Desk)

SUBJECT: Provides response to request for addl info re results of SG  
insp,performed during Unit 1 end of Cycle 17 refueling  
outage.

DISTRIBUTION CODE: A001D      COPIES RECEIVED:LTR 1 ENCL 1      SIZE: 14  
TITLE: OR Submittal: General Distribution

### NOTES:

	RECIPIENT	COPIES		RECIPIENT	COPIES	
	ID CODE/NAME	LTTR	ENCL	ID CODE/NAME	LTTR	ENCL
	PD2-2 LA	1	1	PD2-2 PD	1	1
	LABARGE,D	1	1			
INTERNAL:	ACRS	1	1	<del>FILE CENTER</del> 01	1	1
	NRR/DE/ECGB/A	1	1	NRR/DE/EMCB	1	1
	NRR/DRCH/HICB	1	1	NRR/DSSA/SPLB	1	1
	NRR/DSSA/SRXB	1	1	NUDOCS-ABSTRACT	1	1
	OGC/HDS2	1	0			
EXTERNAL:	NOAC	1	1	NRC PDR	1	1

### NOTE TO ALL "RIDS" RECIPIENTS:

PLEASE HELP US TO REDUCE WASTE. TO HAVE YOUR NAME OR ORGANIZATION REMOVED FROM DISTRIBUTION LISTS  
OR REDUCE THE NUMBER OF COPIES RECEIVED BY YOU OR YOUR ORGANIZATION, CONTACT THE DOCUMENT CONTROL  
DESK (DCD) ON EXTENSION 415-2083

TOTAL NUMBER OF COPIES REQUIRED: LTTR 14 ENCL 13

C  
A  
T  
E  
G  
O  
R  
Y  
1  
  
D  
O  
C  
U  
M  
E  
N  
T



**Duke Power Company**  
*A Duke Energy Company*

Oconee Nuclear Site  
P.O. Box 1439  
Seneca, SC 29679

**W. R. McCollum, Jr.**  
*Vice President*

(864) 885-3107 OFFICE  
(864) 885-3564 FAX

January 26, 1998

U. S. Nuclear Regulatory Commission  
Attention: Document Control Desk  
Washington, DC 20555

Subject: Oconee Nuclear Station  
Docket No. 50-269  
Response to Request for Additional Information  
on Steam Generator Inspections

In a letter dated December 2, 1997, the NRC requested additional information regarding the results of the steam generator inspections that were performed during the Oconee Unit 1 end of cycle 17 refueling outage. Specifically, the NRC requested that Duke Energy (Duke) submit (1) an optical disk containing the eddy current inspection data for the inside diameter (ID) intergranular attack (IGA) indications in the pulled tube specimens; (2) files on the optical disk with the setup used by the analyst for examining the indications; (3) a drawing or description of the standard used to calibrate the acquisition system; (4) eddy current data from 20 randomly selected tubes that contain ID IGA indications; and (5) a listing of the dimensions of the ID IGA indications as determined from the destructive examination of the pulled tube specimens. In addition, the NRC requested that the format for the eddy current data be compatible with Eddynet95 analysis software.

In response to this request, Duke provides the attached information. Attachment 1 contains a list of over 20 randomly selected tubes which have eddy current data supplied on the optical disk. The randomly selected tubes are circled on the list. A listing of the dimensions of the ID IGA indications as determined from the destructive examination of the pulled tube specimens is contained in Attachment 2. A drawing of the standard used to calibrate the acquisition system is provided in Attachment 3. Attachment 4 contains an optical disk with the eddy current data for the randomly selected tubes and the pulled tube

9802060051 980126  
PDR ADOCK 05000269  
P PDR




U. S. Nuclear Regulatory Commission  
January 26, 1998

Page 2

specimens. The optical disk contains the setup used by the analyst for examining the tube indications and is in a format which is compatible with Eddynet95 analysis software.

If there are any questions regarding this submittal, please contact Michael Bailey at (864) 885-4390.

Very truly yours,



W. R. McCollum, Jr.  
Site Vice President  
Oconee Nuclear Station

MEB

Attachments (4)

cc w/o optical disk:

L. A. Reyes, Regional Administrator  
Region II

M. A. Scott, Senior Resident Inspector  
Oconee Nuclear Site

cc with optical disk:

D. E. LaBarge, Project Manager  
NRR

ATTACHMENT 1

LIST OF THE RANDOMLY SELECTED TUBES

\*\*\*\*\*  
 \*\*\*\*\*  
FTI TUBAN II (Version 2.4) 12/09/1997 13:21:31  
 Oconee Nuclear Station - Unit One  
 S/G B  
 09/97 RFO  
 ROLL TRANSITION, TUBE PULL REV. -MRPC

\*\*\*\*\*  
 \*\*\*\*\*  
Page 1 of 1

QRY: 12/09/1997 13:13:54

TEST TYPE	ROW	COL	IND	%TW	VOLTS	CHN	DEG	LOCATION	EXTENT1	EXTENT2	LEG	TAPE#	PROBE	COMMENTS	OPTICAL	DK
ROLL TRANSITI	88	100	SAI		2.51	P 1	26	UTE	-0.75	UTE	UTE	UTE	108	520		
ROLL TRANSITI	89	82	VOL		0.97	P 1	12	UTE	-0.67	UTE	UTE	UTE	108	520		
ROLL TRANSITI	89	86	VOL		0.91	P 1	17	UTE	-0.58	UTE	UTE	UTE	108	520		
ROLL TRANSITI	89	88	VOL		0.67	P 1	28	UTE	-0.70	UTE	UTE	UTE	108	520		
ROLL TRANSITI	91	83	VOL		0.57	P 1	9	UTE	-1.02	UTE	UTE	UTE	108	520		
ROLL TRANSITI	87	86	VOL		0.38	P 1	34	UTE	-3.41	UTE	UTE	UTE	114	520		
ROLL TRANSITI	88	100	SAI		2.39	P 1	30	UTE	-1.02	UTE	UTE	UTE	114	520		
ROLL TRANSITI	86	95	SAI		1.50	P 1	16	UTE	-1.00	UTE	UTE	UTE	117	520		
ROLL TRANSITI	86	102	VOL		0.46	S	37	UTE	-2.60	UTE	UTE	UTE	118	520		
ROLL TRANSITI	81	82	SAI		0.81	P 1	30	UTE	-1.29	UTE	UTE	UTE	157	520		
ROLL TRANSITI	79	117	VOL		0.21	P 1	30	UTE	-1.28	UTE	UTE	UTE	161	520		
ROLL TRANSITI	84	131	VOL		0.79	P 2	18	UTE	-2.06	UTE	UTE	UTE	164	520		
ROLL TRANSITI			VOL		1.10	P 2	17	UTE	-1.77	UTE	UTE	UTE	164	520		
ROLL TRANSITI			VOL		1.22	P 2	25	UTE	-1.47	UTE	UTE	UTE	164	520		
ROLL TRANSITI	55	87	SAI		1.70	P 1	35	UTE	-1.24	UTE	UTE	UTE	178	520		
ROLL TRANSITI	56	82	MAI		2.06	P 1	38	UTE	-1.09	UTE	UTE	UTE	178	520		
ROLL TRANSITI	56	94	VOL		0.61	S	24	UTE	-2.77	UTE	UTE	UTE	178	520		
ROLL TRANSITI	56	96	VOL		0.62	P 2	24	UTE	-2.37	UTE	UTE	UTE	178	520		
ROLL TRANSITI	55	110	VOL		0.33	P 1	103	UTE	-0.78	UTE	UTE	UTE	179	520		L3R
ROLL TRANSITI	58	79	SAI		1.53	1	31	UTE	-1.07	UTE	UTE	UTE	180	520		
ROLL TRANSITI	59	77	MAI		1.22	1	34	UTE	-1.61	UTE	UTE	UTE	180	520		
ROLL TRANSITI			VOL		1.22	P 2	14	UTE	-1.46	UTE	UTE	UTE	180	520		
ROLL TRANSITI	57	82	VOL		0.53	P 1	57	UTE	-2.26	UTE	UTE	UTE	181	520		
ROLL TRANSITI	59	76	VOL		1.13	P 1	21	UTE	-1.35	UTE	UTE	UTE	181	520		
ROLL TRANSITI	59	78	VOL		0.53	P 2	34	UTE	-1.51	UTE	UTE	UTE	181	520		
ROLL TRANSITI			VOL		0.92	P 2	22	UTE	-1.06	UTE	UTE	UTE	181	520		
ROLL TRANSITI	59	80	VOL		0.90	P 1	31	UTE	-1.06	UTE	UTE	UTE	181	520		
ROLL TRANSITI	59	88	VOL		1.61	P 2	30	UTE	-1.71	UTE	UTE	UTE	181	520		
ROLL TRANSITI	59	90	VOL		0.56	P 1	34	UTE	-2.58	UTE	UTE	UTE	181	520		
ROLL TRANSITI			VOL		0.97	P 1	27	UTE	-2.20	UTE	UTE	UTE	181	520		
ROLL TRANSITI	59	102	VOL		0.49	P 1	50	UTE	-1.47	UTE	UTE	UTE	181	520		
ROLL TRANSITI	59	106	VOL		0.95	P 1	27	UTE	-1.55	UTE	UTE	UTE	181	520		
ROLL TRANSITI			VOL		1.34	P 1	26	UTE	-1.23	UTE	UTE	UTE	181	520		
ROLL TRANSITI	59	110	SAI		2.05	P 1	35	UTE	-1.18	UTE	UTE	UTE	181	520		
ROLL TRANSITI			VOL		1.01	P 1	21	UTE	-1.50	UTE	UTE	UTE	181	520		
ROLL TRANSITI	59	121	VOL		0.90	P 1	18	UTE	-1.06	UTE	UTE	UTE	181	520		
ROLL TRANSITI	60	94	VOL		0.75	P 1	21	UTE	-2.59	UTE	UTE	UTE	181	520		
ROLL TRANSITI	60	96	VOL		0.65	P 1	28	UTE	-1.80	UTE	UTE	UTE	181	520		
ROLL TRANSITI	63	88	VOL		1.30	P 1	201	UTE	-1.29	UTE	UTE	UTE	182	520		
ROLL TRANSITI	63	120	MAI		0.39	P 1	52	UTE	-1.83	UTE	UTE	UTE	182	520		
ROLL TRANSITI	63	122	MAI		0.83	P 1	45	UTE	-1.56	UTE	UTE	UTE	182	520		
ROLL TRANSITI	64	97	VOL		0.80	S	193	UTE	-2.04	UTE	UTE	UTE	182	520		
ROLL TRANSITI	64	122	VOL		1.73	S	29	UTE	-1.34	UTE	UTE	UTE	182	520		
ROLL TRANSITI	63	99	VOL		3.80	1	3	UTE	-1.26	UTE	UTE	UTE	183	520		
ROLL TRANSITI	63	107	VOL		0.63	1	15	UTE	-2.10	UTE	UTE	UTE	183	520		
ROLL TRANSITI	64	100	VOL		1.19	1	22	UTE	-1.21	UTE	UTE	UTE	183	520		
ROLL TRANSITI	64	114	VOL		0.95	1	29	UTE	-1.58	UTE	UTE	UTE	183	520		
ROLL TRANSITI	64	116	VOL		1.84	1	27	UTE	-1.34	UTE	UTE	UTE	183	520		
ROLL TRANSITI	64	120	VOL		1.13	1	32	UTE	-1.20	UTE	UTE	UTE	183	520		
ROLL TRANSITI	65	113	VOL		1.11	1	31	UTE	-1.53	UTE	UTE	UTE	183	520		
ROLL TRANSITI	65	121	VOL		1.63	1	26	UTE	-1.38	UTE	UTE	UTE	183	520		
ROLL TRANSITI	73	106	VOL		0.60	1	26	UTE	-1.07	UTE	UTE	UTE	185	520		
ROLL TRANSITI	73	115	VOL		0.58	1	29	UTE	-0.65	UTE	UTE	UTE	185	520		
ROLL TRANSITI	75	96	VOL		0.88	P 1	40	UTE	-1.09	UTE	UTE	UTE	185	520		
ROLL TRANSITI	75	104	VOL		0.92	P 1	26	UTE	-1.35	UTE	UTE	UTE	185	520		
ROLL TRANSITI	75	112	VOL		1.58	P 2	34	UTE	-1.02	UTE	UTE	UTE	185	520		
ROLL TRANSITI	71	97	VOL		0.31	P 2	46	UTE	-2.33	UTE	UTE	UTE	186	520		
ROLL TRANSITI	72	113	VOL		0.40	P 1	40	UTE	-2.06	UTE	UTE	UTE	186	520		
ROLL TRANSITI	66	122	SAI		1.28	P 1	24	UTE	-1.52	UTE	UTE	UTE	188	520		
ROLL TRANSITI	63	85	VOL		2.18	P 1	27	UTE	-1.78	UTE	UTE	UTE	190	520		

Total Indications Found = 60  
 Total Tubes Found = 52  
 Total Tubes in Input File = 53

ATTACHMENT 2

LISTING OF DIMENSIONS FOR INDICATIONS  
IN THE PULLED TUBE SPECIMENS

**OCONEE-1 DEPTH DATA FOR TUBES R59T82 AND R65T111**

<b>TUBE</b>	<b>LOCATION</b>	<b>DEPTH (% throughwall)</b>	<b>LENGTH (inches)</b>	<b>WIDTH (inches)</b>
<b>R65T111</b>	<b>120°, AREA 1</b>	<b>46%</b>	<b>.20</b>	<b>.10</b>
			<b>.20</b>	<b>.13</b>
<b>R65T111</b>	<b>210°, AREA 2</b>	<b>35%</b>	<b>.04</b>	<b>.05</b>
<b>R65T111</b>	<b>330°, AREA 1</b>	<b>19%</b>	<b>.16</b>	<b>.1</b>
<b>R65T111</b>	<b>330°, AREA 2</b>	<b>32%</b>	<b>.11</b>	<b>.09</b>
<b>R59T82</b>	<b>180°, AREA 1</b>	<b>46%</b>	<b>.21</b>	<b>.14</b>
<b>R59T82</b>	<b>20°, AREA 2</b>	<b>46%</b>	<b>.18</b>	<b>.08</b>
<b>R59T82</b>	<b>10°, AREA 1</b>	<b>35%</b>	<b>.24</b>	<b>.05</b>
<b>R59T82</b>	<b>230°, AREA 2</b>	<b>22%</b>	<b>.09</b>	<b>.20</b>

**NOTE: THERE ARE TWO PATCHES OF IGA AT 120° ON TUBE R65T111, WITHIN AREA 1, WHICH BOTH DISAPPEAR AFTER 46% TW**

**PATCH CLOSEST TO THE TUBE END IS .20 X .10  
PATCH JUST BELOW IS .20 X .13**

**NOTE: THE LENGTH AND WIDTH OF THE IGA IS GIVEN AFTER APPROXIMATELY 8% TW (0.003 INCHES BELOW THE ID SURFACE)**

**NOTE: THE TWO PATCHES OF IGA AT 10° AND 20° FROM TUBE R59T82 COULD COME FROM THE SAME AREA OF DEGRADATION**

ATTACHMENT 3

DRAWING OF THE CALIBRATION STANDARD



89962971

ON DAD


FLAW LABEL	FLAW DESCRIPTION	SIDE	AXIAL LOCATION	AZIMUTHAL LOCATION	LENGTH	WIDTH OR DIAMETER	DEPTH IN INCHES	DEPTH IN %TW
A	GROOVE	ID	2.000"	ALL	.0615"	N/A	.0075"	19 %TW
B	GROOVE	OD	3.000"	ALL	.124"	N/A	.0045"	11 %TW
C	4 FBH'S	OD	4.000"	0°90°180°270°	N/A	Ø.114"	.008"	20 %TW
D	FBH	OD	4.750"	0°	N/A	Ø.093"	.0155"	39 %TW
E	FBH	OD	5.500"	0°	N/A	Ø.077"	.0235"	59 %TW
F	FBH	OD	6.250"	0°	N/A	Ø.063"	.031"	78 %TW
G	HOLE	OD	7.000"	0°	N/A	Ø.048"	THROUGH	100 %TW
H	DENT	OD	8.000"	0°	.062"	(.475")	.003"	N/A
I	NDD & BROACHED TSP	OD	9.750"	N/A	1.500"	N/A	N/A	N/A
J	WEAR & BROACHED TSP	OD	12.250"	0°	1.500"	.125"	.0095"	24 %TW
K	WEAR & BROACHED TSP	OD	12.250"	120°	1.500"	.124"	.0225"	57 %TW
L	NDD & DRILLED TSP	OD	14.375"	N/A	.750"	N/A	N/A	N/A
AA	AX EDM	OD	16.000"	0°	.312"	.006"	.008"	20 %TW
BB	CI EDM	OD	16.000"	90°	.60"	.006"	.008"	20 %TW
CC	AX EDM	ID	16.000"	180°	.312"	.005"	.008"	20 %TW
DD	CI EDM	ID	16.000"	270°	.60"	.005"	.008"	20 %TW
EE	AX EDM	OD	16.750"	0°	.312"	.006"	.015"	38 %TW
FF	CI EDM	OD	16.750"	90°	.60"	.006"	.015"	38 %TW
GG	AX EDM	ID	16.750"	180°	.312"	.005"	.016"	41 %TW
HH	CI EDM	ID	16.750"	270°	.60"	.005"	.015"	38 %TW
II	AX EDM	OD	17.500"	0°	.312"	.006"	.023"	58 %TW
JJ	CI EDM	OD	17.500"	90°	.60"	.006"	.023"	58 %TW
KK	AX EDM	ID	17.500"	180°	.312"	.005"	.023"	58 %TW
LL	CI EDM	ID	17.500"	270°	.60"	.005"	.023"	58 %TW
MM	AX EDM	OD	18.250"	0°	.312"	.006"	THROUGH	100 %TW
NN	CI EDM	OD	18.500"	240°	.60"	.006"	THROUGH	100 %TW
OO	AX EDM IN EXPANSION	OD	LEFT TRANSITION	0°	.312"	.006"	.015"	38 %TW
PP	CI EDM IN EXPANSION	OD	LEFT TRANSITION	90°	.60"	.006"	.015"	38 %TW
QQ	AX EDM IN EXPANSION	ID	RIGHT TRANSITION	180°	.312"	.006"	.015"	38 %TW
RR	CI EDM IN EXPANSION	ID	RIGHT TRANSITION	270°	.287"	.006"	.015"	38 %TW

\* AVERAGE OF FOUR HOLES

REVISIONS				R F
REV	DESCRIPTION	DATE	APPROVAL	

## NOTES:

1. THE MATERIAL HEAT NUMBER, HT 93452 LOT 5060, AND THE AS BUILT NUMBER, 1252966B, ARE ETCHED AT THE RIGHT TUBE END.
2. THIS STANDARD WAS MADE VIA PA 83-791232 REV 00 & 01, AND WORK ORDER 4986, FROM DESIGN DRAWING 1252875D-2, FOR DUKE POWER COMPANY.
3. THE AS BUILT DIMENSIONS WERE OBTAINED FROM SPIS SHOP DATA SHEETS AND QCIR 96-285.
4. EACH FLAW IS CENTERED ABOUT THE SPECIFIED AXIAL AND AZIMUTHAL LOCATIONS.
5. THE DEPTHS IN PERCENT THROUGH WALL (%TW) ARE BASED UPON THE ACTUAL MEAN WALL THICKNESS (MWT) OF THE TUBE, .0395".
6. WHEN PLACED IN HOLDER (1252876E-0), A DRILLED TSP IS CENTERED AT LOCATION L, AND BROACHED TSP'S ARE CENTERED AT LOCATIONS 'I' AND 'J,K' USING THE KEY AT THE TUBE END.
7. PER DUKE POWER, THIS STANDARD CONTAINS A HALF LENGTH DRILLED TSP, AND TRADITIONAL FBH'S WHOSE DIAMETERS ARE SOMEWHAT SMALLER THAN TYPICAL ASME CODE DIAMETERS.

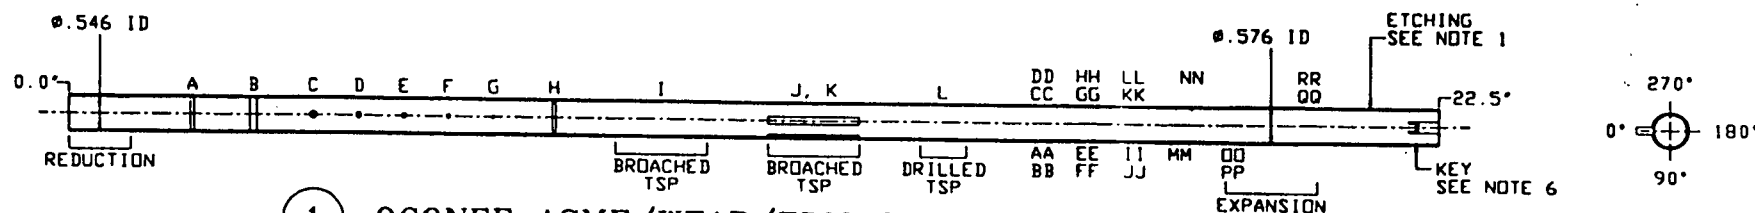

QA CONDITION 1

1

## OCONEE ASME/WEAR/EDM CALIBRATION STANDARD

MAT'L: ASME SB-183 ALLOY 800, .625" AVERAGE OD, .550" AVERAGE ID, .0395" AVERAGE WALL.

FILENAME: 1252966B.DWG  
DISK No.: OPTICAL

THIS DRAWING/DOCUMENT IS THE PROPERTY OF F11 AND IS LOANED UPON THE CONDITION THAT IT IS NOT TO BE REPRODUCED OR COPIED, IN WHOLE OR IN PART, OR USED FOR FURNISHING INFORMATION TO OTHERS, OR FOR ANY OTHER PURPOSE DETRIMENTAL TO THE INTEREST OF F11 AND IS TO BE RETURNED UPON REQUEST. DO NOT SCALE - USE DIMENSIONS ONLY.

DESIGNED BY	DATE
CHECKED BY	DATE
APPROVED BY	DATE

OCONEE ASME/WEAR/EDM CALIBRATION  
STANDARD AS BUILT DRAWING

SCALE	DATE
0.5X	04/01/96
DWG NO.	1252966B-0

22139 (11/2/95)

1268327B

ON DAD

FRAMATOME  
TECHNOLOGIES

## REVISIONS


REV	DESCRIPTION	DATE	APPROVAL

FLAW LABEL	FLAW DESCRIPTION	SURFACE OF ORIGIN	AXIAL LOCATION	AZIMUTHAL LOCATION	LENGTH - 000/1.010	WIDTH OR DIAMETER	DEPTH IN INCHES	DEPTH IN XTW
A	AX EDM	ID	1.750"	0°	.376"	.005"	.024"	63 XTW
B	AX EDM	ID	1.750"	120°	.376"	.005"	.013"	34 XTW
C	AX EDM	ID	1.750"	240°	.376"	.005"	.009"	24 XTW
D	AX EDM	OD	2.500"	0°	.375"	.005"	.021"	55 XTW
E	AX EDM	OD	2.500"	120°	.375"	.004"	.014"	37 XTW
F	AX EDM	OD	2.500"	240°	.375"	.005"	.0065"	17 XTW
G	AX EDM	OD	3.250"	0°	.375"	.005"	THROUGH	100 XTW
H	CI EDM	OD	4.002"	180°	.375"	.005"	THROUGH	100 XTW
I	CI EDM	ID	4.750"	0°	.376"	.005"	.022"	58 XTW
J	CI EDM	OD	4.750"	180°	.375"	.005"	.020"	53 XTW
K	CI EDM	ID	5.500"	0°	.376"	.005"	.0145"	38 XTW
L	CI EDM	OD	5.500"	180°	.375"	.005"	.014"	37 XTW
M	CI EDM	ID	6.250"	0°	.376"	.005"	.008"	21 XTW
N	CI EDM	OD	6.250"	180°	.375"	.004"	.007"	19 XTW
O	AX EDM IN EXPANSION	ID	7.375"	0°	.251"	.005"	.019"	40 XTW
P	CI EDM IN EXPANSION	ID	7.375"	180°	.251"	.005"	.016"	43 XTW
Q	AX EDM IN EXPANSION	OD	8.625"	0°	.250"	.004"	.014"	37 XTW
R	CI EDM IN EXPANSION	OD	8.625"	180°	.250"	.005"	.0145"	38 XTW
S	DENT	OD	12.250"	0°	.063"	.004"	N/A	N/A
T1	FBH	OD	13.251"	0°	N/A	0.115"	.0075"	20 XTW
T2	FBH	OD	13.251"	90°	N/A	0.115"	.0065"	17 XTW
T3	FBH	OD	13.251"	180°	N/A	0.115"	.007"	18 XTW
T4	FBH	OD	13.251"	270°	N/A	0.115"	.007"	18 XTW
U	FBH	OD	14.002"	0°	N/A	0.093"	.014"	37 XTW
V	FBH	OD	14.751"	0°	N/A	0.080"	.021"	55 XTW
V	FBH	OD	15.500"	0°	N/A	0.061"	.028"	74 XTW
X	FBH	OD	16.250"	0°	N/A	0.051"	THROUGH	100 XTW
AA	NDB & BROACHED TSP	N/A	N/A	N/A	N/A	N/A	N/A	N/A
BB	WEAR & BROACHED TSP	OD	19.091"	120°	.689"	.124"	.018"	26 XTW
CC	WEAR & BROACHED TSP	OD	19.091"	240°	.689"	.124"	.021"	55 XTW
DD	GROOVE	OD	20.373"	360°	.124"	N/A	.003"	8 XTW
EE	NDB & DRILLED TSP	OD	N/A	N/A	N/A	N/A	N/A	N/A
FF	GROOVE	ID	23.000"	360°	.065"	N/A	.0076"	20 XTW

## NOTES:

1. THE MATERIAL HEAT NUMBER, HT 93500 LOT 5022, AND THE AS BUILT NUMBER, 1268327B, ARE ETCHED AT THE RIGHT TUBE END.
2. THIS STANDARD WAS MADE VIA PA 83-795481-03, PA 83-795515-00 AND FTI WD 8373, FROM DESIGN DRAWING 1268313D-1, FOR DUKE POWER COMPANY.
3. THE AS BUILT DIMENSIONS WERE OBTAINED FROM FTI SHOP DATA SHEETS AND QCIR 97-00774.
4. EACH FLAW IS CENTERED ABOUT THE SPECIFIED AXIAL AND AZIMUTHAL LOCATIONS.
5. THE DEPTHS IN PERCENT THROUGH WALL (%TW) ARE BASED UPON THE ACTUAL MEAN WALL THICKNESS (MWT) OF THE TUBING, .038".
6. WHEN THE STANDARD IS PLACED IN ITS HOLDER (1268314E-1), A DRILLED TUBE SUPPORT PLATE (TSP) SIMULATOR WILL BE CENTERED NEAR LOCATION EE. BROACHED TSP'S WILL BE CENTERED NEAR LOCATIONS AA AND BB/CC. WEAR PATCHES BB AND CC WILL BE LOCATED WITH TWO LAND REGIONS OF THEIR BROACHED TSP.
7. ID FLAW DIMENSIONS ARE OBTAINED FROM MACHINING EQUIPMENT.

## PLANAR VIEW OF TUBE OD AND FLAWS

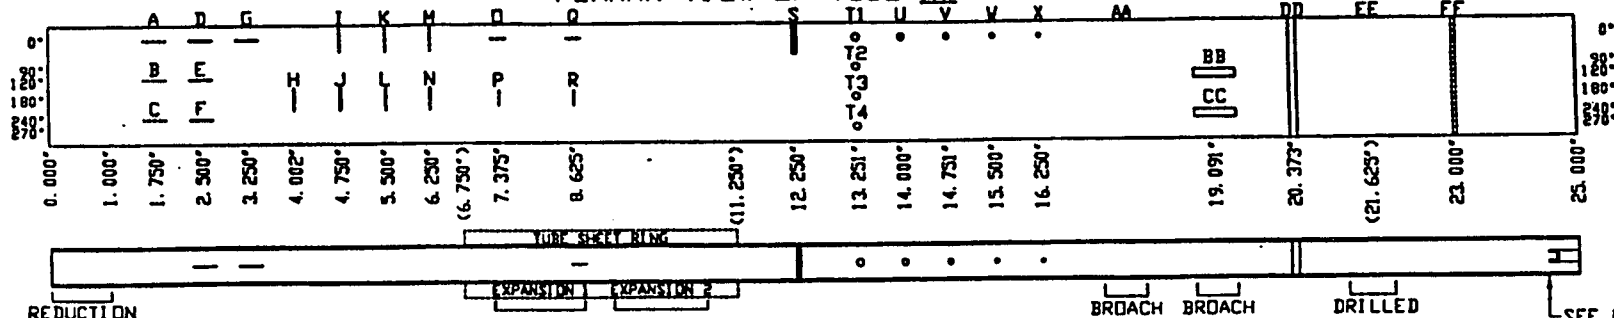

SEE NOTE 1

①

## OCONEE EDM/ASME/WEAR CALIBRATION STANDARD

MAT'L: ASME SB-163 ALLOY 600, .030" OD, .554" ID, .038" WALL

 FILENAME: 1268327B.DWG  
 DISK No.: OPTICAL

THIS DRAWING/DOCUMENT IS THE PROPERTY OF FTI AND IS LOANED UNDER THE CONDITION THAT IT IS NOT TO BE REPRODUCED IN COPIES, IN WHOLE OR IN PART, OR USED FOR FURNISHING INFORMATION TO OTHERS, OR FOR ANY OTHER PURPOSES RETRIBUTIVE TO THE INTEREST OF FTI AND IS TO BE RETURNED UPON REQUEST. DO NOT SCALE - USE DIMENSIONS ONLY.

 DRAWN BY: [Signature] CHECKED BY: [Signature]  
 DESIGNED BY: [Signature] APPR'D BY: [Signature]  
 OCONEE EDM/ASME/WEAR CALIBRATION STANDARD AS BUILT DRAWING  
 SCALE: 1/2 DATE: 09/09/97  
 DOC NO.: 1268327B-0

22159 08/93

1268326B

DN DAB

FLAW LABEL	FLAW DESCRIPTION	SURFACE OF ORIGIN	AXIAL LOCATION	AZIMUTHAL LOCATION	LENGTH - .000/.010	WIDTH OR DIAMETER	DEPTH IN INCHES	DEPTH IN XTW
A	AX EDM	ID	1.750"	0°	.376"	.005"	.024"	63 XTW
B	AX EDM	ID	1.750"	120°	.376"	.005"	.013"	34 XTW
C	AX EDM	ID	1.750"	240°	.376"	.005"	.008"	21 XTW
D	AX EDM	OD	2.500"	0°	.375"	.005"	.022"	58 XTW
E	AX EDM	OD	2.500"	120°	.376"	.005"	.014"	37 XTW
F	AX EDM	OD	2.500"	240°	.375"	.005"	.007"	18 XTW
G	AX EDM	OD	3.250"	0°	.376"	.005"	THROUGH	100 XTW
H	CI EDM	OD	4.000"	180°	.375"	.005"	THROUGH	100 XTW
I	CI EDM	ID	4.750"	0°	.376"	.005"	.022"	58 XTW
J	CI EDM	OD	4.750"	180°	.375"	.005"	.020"	53 XTW
K	CI EDM	ID	5.500"	0°	.376"	.005"	.015"	40 XTW
L	CI EDM	OD	5.500"	180°	.375"	.005"	.014"	37 XTW
M	CI EDM	ID	6.250"	0°	.376"	.005"	.009"	24 XTW
N	CI EDM	OD	6.250"	180°	.375"	.005"	.007"	18 XTW
O	AX EDM IN EXPANSION	ID	7.375"	0°	.251"	.005"	.014"	37 XTW
P	CI EDM IN EXPANSION	ID	7.375"	180°	.251"	.005"	.016"	42 XTW
Q	AX EDM IN EXPANSION	OD	8.625"	0°	.250"	.005"	.015"	40 XTW
R	CI EDM IN EXPANSION	OD	8.625"	180°	.250"	.005"	.0145"	38 XTW
S	HEAT	OD	12.250"	0°	.063"	.400"	.004"	N/A
T1	FBH	OD	13.250"	0°	N/A	0.115"	.007"	18 XTW
T2	FBH	OD	13.250"	90°	N/A	0.115"	.008"	21 XTW
T3	FBH	OD	13.250"	180°	N/A	0.116"	.007"	18 XTW
T4	FBH	OD	13.250"	270°	N/A	0.115"	.007"	18 XTW
U	FBH	OD	14.000"	0°	N/A	0.096"	.014"	37 XTW
V	FBH	OD	14.750"	0°	N/A	0.080"	.022"	58 XTW
W	FBH	OD	15.500"	0°	N/A	0.062"	.030"	79 XTW
X	MOLE	OD	16.250"	0°	N/A	0.050"	THROUGH	100 XTW
AA	NOB & BROACHED TSP	N/A	N/A	N/A	N/A	N/A	N/A	N/A
BB	WEAR & BROACHED TSP	OD	19.090"	120°	.690"	.124"	.010"	26 XTW
CC	WEAR & BROACHED TSP	OD	19.091"	240°	.125"	.124"	.020"	53 XTW
DD	GROOVE	OD	20.373"	360°	.125"	N/A	.003"	8 XTW
EE	NOB & DRILLED TSP	OD	N/A	N/A	N/A	N/A	N/A	N/A
FF	GROOVE	ID	23.000"	360°	.065"	N/A	.0076"	20 XTW


## REVISIONS

REV	DESCRIPTION	DATE	APPROVAL
-----	-------------	------	----------

## NOTES:

1. THE MATERIAL HEAT NUMBER, HT 93500 LOT 5022, AND THE AS BUILT NUMBER, 1268326B, ARE ETCHED AT THE RIGHT TUBE END.
2. THIS STANDARD WAS MADE VIA PA 83-795481-03, PA 83-795515-00 AND FTI WD 8373, FROM DESIGN DRAWING 1268313D-1, FOR DUKE POWER COMPANY.
3. THE AS BUILT DIMENSIONS WERE OBTAINED FROM FTI SHOP DATA SHEETS AND QCIR 97-00773.
4. EACH FLAW IS CENTERED ABOUT THE SPECIFIED AXIAL AND AZIMUTHAL LOCATIONS.
5. THE DEPTHS IN PERCENT THROUGH WALL (XTW) ARE BASED UPON THE ACTUAL MEAN WALL THICKNESS (MWT) OF THE TUBING, .038".
6. WHEN THE STANDARD IS PLACED IN ITS HOLDER (1268314E-1), A DRILLED TUBE SUPPORT PLATE (TSP) SIMULATOR WILL BE CENTERED NEAR LOCATION EE. BROACHED TSP'S WILL BE CENTERED NEAR LOCATIONS AA AND BB/CC. WEAR PATCHES BB AND CC WILL BE LOCATED WITH TWO LAND REGIONS OF THEIR BROACHED TSP.
7. ID FLAW DIMENSIONS ARE OBTAINED FROM MACHINING EQUIPMENT.

## PLANAR VIEW OF TUBE OD AND FLAWS

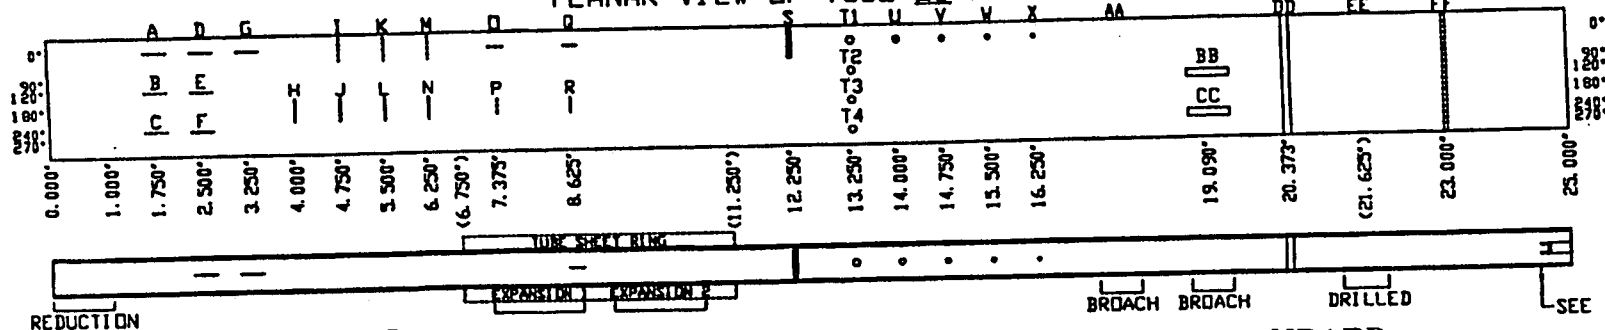

# 1 OCONEE EDM/ASME/WEAR CALIBRATION STANDARD

MAT'L: ASME SB-163 ALLOY 600, .629" OD, .554" ID, .038" WALL

FILENAME: 1268326B.DWG  
DISK No.: OPTICAL

THIS DRAWING/DOCUMENT IS THE PROPERTY OF FTI AND IS LOANED UPON THE CONDITION THAT IT IS NOT TO BE REPRODUCED OR COPIED, IN WHOLE OR IN PART, OR USED FOR FURNISHING INFORMATION TO OTHERS, OR FOR ANY OTHER PURPOSES WITHOUT THE WRITTEN PERMISSION OF FTI AND IS TO BE RETURNED UPON REQUEST. DO NOT SCALE - USE DIMENSIONS ONLY.

DATE: 09/09/97  
SCALE: 1/2  
STANDARD AS BUILT DRAWING  
1268326B-0  
82159 02/95

1268321B ON DAO




FLAW LABEL	FLAW DESCRIPTION	SURFACE OF ORIGIN	AXIAL LOCATION	AZIMUTHAL LOCATION	LENGTH ±.000/±.010	WIDTH OR DIAMETER	DEPTH IN INCHES	DEPTH IN %TW
A	AX EDM	ID	1.750"	0°	.375"	.006"	.022"	60 %TW
B	AX EDM	ID	1.750"	120°	.375"	.005"	.015"	41 %TW
C	AX EDM	ID	1.750"	240°	.375"	.005"	.0075"	20 %TW
D	AX EDM	OD	2.500"	0°	.375"	.005"	.021"	57 %TW
E	AX EDM	OD	2.500"	120°	.375"	.005"	.015"	41 %TW
F	AX EDM	OD	2.500"	240°	.375"	.006"	.007"	19 %TW
G	AX EDM	OD	3.250"	0°	.375"	.006"	THROUGH	100 %TW
H	CI EDM	OD	4.000"	180°	.375"	.006"	THROUGH	100 %TW
I	CI EDM	ID	4.750"	0°	.375"	.006"	.022"	60 %TW
J	CI EDM	OD	4.750"	180°	.375"	.005"	.021"	57 %TW
K	CI EDM	ID	5.500"	0°	.375"	.005"	.015"	41 %TW
L	CI EDM	OD	5.500"	180°	.375"	.005"	.014"	38 %TW
M	CI EDM	ID	6.250"	0°	.375"	.005"	.0075"	20 %TW
N	CI EDM	OD	6.250"	180°	.375"	.006"	.007"	19 %TW
O	AX EDM IN EXPANSION	ID	7.375"	0°	.250"	.005"	.015"	41 %TW
P	CI EDM IN EXPANSION	ID	7.375"	180°	.250"	.005"	.015"	41 %TW
Q	AX EDM IN EXPANSION	OD	8.625"	0°	.250"	.005"	.014"	38 %TW
R	CI EDM IN EXPANSION	OD	8.625"	180°	.250"	.005"	.014"	38 %TW
S	DENT	OD	12.250"	0°	.063"	.420"	.003"	8 %TW
T1	FBH	OD	13.250"	0°	N/A	Ø.015"	.007"	19 %TW
T2	FBH	OD	13.250"	90°	N/A	Ø.016"	.008"	22 %TW
T3	FBH	OD	13.250"	180°	N/A	Ø.015"	.007"	19 %TW
T4	FBH	OD	13.250"	270°	N/A	Ø.015"	.007"	19 %TW
U	FBH	OD	14.000"	0°	N/A	Ø.093"	.014"	38 %TW
V	FBH	OD	14.750"	0°	N/A	Ø.080"	.021"	57 %TW
W	FBH	OD	15.500"	0°	N/A	Ø.063"	.028"	76 %TW
X	HOLE	OD	16.250"	0°	N/A	Ø.050"	THROUGH	100 %TW
AA	N/A	N/A	N/A	N/A	N/A	N/A	N/A	N/A
BB	WEAR & BROACHED TSP	OD	19.095"	120°	.690"	.124"	.010"	27 %TW
CC	WEAR & BROACHED TSP	OD	19.095"	240°	.690"	.124"	.021"	57 %TW
DD	GROOVE	OD	20.375"	ALL	.125"	N/A	.003"	8 %TW
EE	N/A	OD	N/A	N/A	N/A	N/A	N/A	N/A
FF	GROOVE	ID	23.000"	360°	.062"	N/A	.0075"	20 %TW

## NOTES:

1. THE MATERIAL HEAT NUMBER, HT 93500 LOT 5022, AND THE AS BUILT NUMBER, 1268321B, ARE ETCHED AT THE RIGHT TUBE END.
2. THIS STANDARD WAS MADE VIA PA 83-795437-02 AND FTI WD 8285, FROM DESIGN DRAWING 1268313D-1, FOR DUKE POWER COMPANY.
3. THE AS BUILT DIMENSIONS WERE OBTAINED FROM FTI SHOP DATA SHEETS AND QCIR 97-00769.
4. EACH FLAW IS CENTERED ABOUT THE SPECIFIED AXIAL AND AZIMUTHAL LOCATIONS.
5. THE DEPTHS IN PERCENT THROUGH WALL (%TW) ARE BASED UPON THE ACTUAL MEAN WALL THICKNESS (MWT) OF THE TUBING, .037".
6. WHEN THE STANDARD IS PLACED IN ITS HOLDER (1268314E-1), A DRILLED TUBE SUPPORT PLATE (TSP) SIMULATOR WILL BE CENTERED NEAR LOCATION EE. BROACHED TSP'S WILL BE CENTERED NEAR LOCATIONS AA AND BB/CC. WEAR PATCHES BB AND CC WILL BE LOCATED WITH TWO LAND REGIONS OF THEIR BROACHED TSP.

## PLANAR VIEW OF TUBE OD AND FLAWS

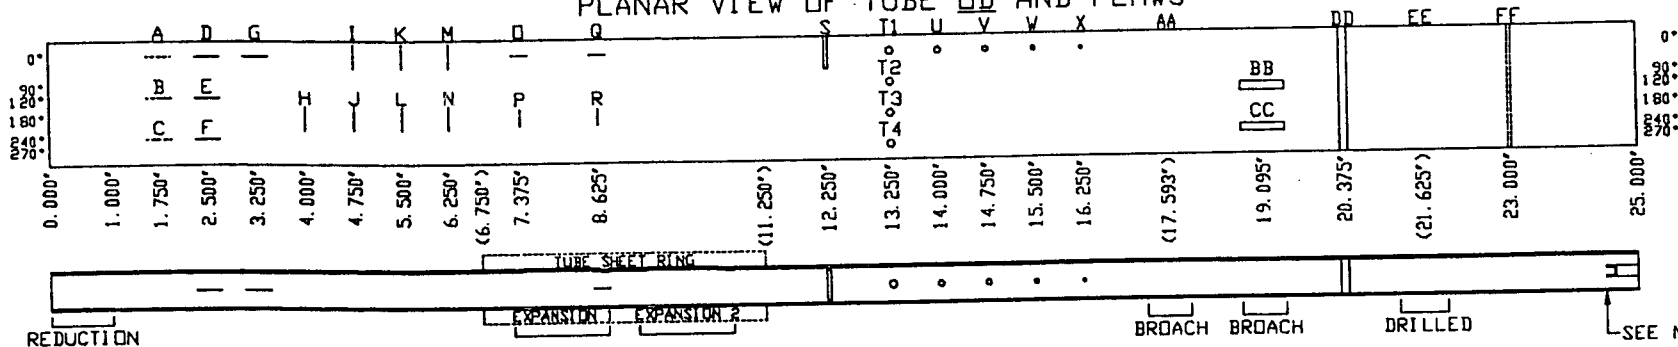

# 1 OCONEE EDM/ASME/WEAR CALIBRATION STANDARD

MAT'L: ASME SB-163 ALLOY 800, .629" OD, .564" ID, .037" WALL.

FILENAME: 1268321B.DWG  
DISK No.: OPTICAL

THIS DRAWING/DOCUMENT IS THE PROPERTY OF FTI AND IS LOANED UPON THE CONDITION THAT IT IS NOT TO BE REPRODUCED OR COPIED IN WHOLE OR IN PART, OR USED FOR FURNISHING INFORMATION TO OTHERS, OR FOR ANY OTHER PURPOSE DETRIMENTAL TO THE INTEREST OF FTI AND IS TO BE RETURNED UPON REQUEST. DO NOT SCALE - USE DIMENSIONS ONLY.

OWN BY: *Valmer*  
PASS BY: *Valmer*  
DATE: *09/09/97*

OCONEE EDM/ASME/WEAR CALIBRATION  
STANDARD AS BUILT DRAWING

SCALE: 1/2  
DATE: 09/09/97  
JOB NO.: 1268321B-0

82159 (12/95)

## REVISIONS


REV	DESCRIPTION	DATE	APPROVAL

FLAW LABEL	FLAW DESCRIPTION	SURFACE OF ORIGIN	AXIAL LOCATION	AZIMUTHAL LOCATION	LENGTH - .000/+ .010	WIDTH OR DIAMETER	DEPTH IN INCHES	DEPTH IN %TW
A	AX EDM	ID	1.750"	0°	.375"	.005"	.022"	60 %TW
B	AX EDM	ID	1.750"	120°	.375"	.005"	.015"	41 %TW
C	AX EDM	ID	1.750"	240°	.375"	.005"	.0075"	20 %TW
D	AX EDM	OD	2.500"	0°	.375"	.005"	.021"	57 %TW
E	AX EDM	OD	2.500"	120°	.375"	.005"	.014"	38 %TW
F	AX EDM	OD	2.500"	240°	.375"	.005"	.007"	19 %TW
G	AX EDM	OD	3.250"	0°	.375"	.006"	THROUGH	100 %TW
H	CI EDM	OD	4.000"	180°	.375"	.005"	THROUGH	100 %TW
I	CI EDM	ID	4.750"	0°	.375"	.006"	.022"	60 %TW
J	CI EDM	OD	4.750"	180°	.375"	.005"	.014"	38 %TW
K	CI EDM	ID	5.500"	0°	.375"	.005"	.015"	41 %TW
L	CI EDM	OD	5.500"	180°	.375"	.005"	.015"	41 %TW
M	CI EDM	ID	6.250"	0°	.375"	.005"	.0075"	20 %TW
N	CI EDM	OD	6.250"	180°	.375"	.005"	.007"	19 %TW
O	AX EDM IN EXPANSION	ID	7.375"	0°	.250"	.005"	.015"	41 %TW
P	CI EDM IN EXPANSION	ID	7.375"	180°	.250"	.005"	.015"	41 %TW
Q	AX EDM IN EXPANSION	OD	8.625"	0°	.250"	.004"	.014"	38 %TW
R	CI EDM IN EXPANSION	OD	8.625"	180°	.250"	.006"	.015"	41 %TW
S	DENT	OD	12.250"	0°	.062"	.400"	.004"	11 %TW
T1	FBH	OD	13.250"	0°	N/A	Ø .015"	.007"	19 %TW
T2	FBH	OD	13.250"	90°	N/A	Ø .016"	.007"	19 %TW
T3	FBH	OD	13.250"	180°	N/A	Ø .015"	.007"	19 %TW
T4	FBH	OD	13.250"	270°	N/A	Ø .015"	.006"	16 %TW
U	FBH	OD	14.000"	0°	N/A	Ø .093"	.014"	38 %TW
V	FBH	OD	14.750"	0°	N/A	Ø .079"	.021"	57 %TW
W	FBH	OD	15.500"	0°	N/A	Ø .061"	.028"	76 %TW
X	HOLE	OD	16.250"	0°	N/A	Ø .050"	THROUGH	100 %TW
AA	N/A	N/A	N/A	N/A	N/A	N/A	N/A	N/A
BB	WEAR & BROACHED TSP	OD	19.093"	120°	.689"	.125"	.010"	27 %TW
CC	WEAR & BROACHED TSP	OD	19.093"	240°	.691"	.125"	.023"	62 %TW
DD	GROOVE	OD	20.380"	ALL	.124"	N/A	.003"	8 %TW
EE	N/A	OD	N/A	N/A	N/A	N/A	N/A	N/A
FF	GROOVE	ID	23.000"	360°	.062"	N/A	.0075"	20 %TW

## NOTES:

1. THE MATERIAL HEAT NUMBER, HT 93500 LOT 5022, AND THE AS BUILT NUMBER, 1268319B, ARE ETCHED AT THE RIGHT TUBE END.
2. THIS STANDARD WAS MADE VIA PA 83-795437-02 AND FTI WD 8285, FROM DESIGN DRAWING 1268313D-1, FOR DUKE POWER COMPANY.
3. THE AS BUILT DIMENSIONS WERE OBTAINED FROM FTI SHOP DATA SHEETS AND QCIR 97-00769.
4. EACH FLAW IS CENTERED ABOUT THE SPECIFIED AXIAL AND AZIMUTHAL LOCATIONS.
5. THE DEPTHS IN PERCENT THROUGH WALL (%TW) ARE BASED UPON THE ACTUAL MEAN WALL THICKNESS (MWT) OF THE TUBING, .037".
6. WHEN THE STANDARD IS PLACED IN ITS HOLDER (1268314E-1), A DRILLED TUBE SUPPORT PLATE (TSP) SIMULATOR WILL BE CENTERED NEAR LOCATION EE. BROACHED TSP'S WILL BE CENTERED NEAR LOCATIONS AA AND BB/CC. WEAR PATCHES BB AND CC WILL BE LOCATED WITH TWO LAND REGIONS OF THEIR BROACHED TSP.

## PLANAR VIEW OF TUBE OD AND FLAWS

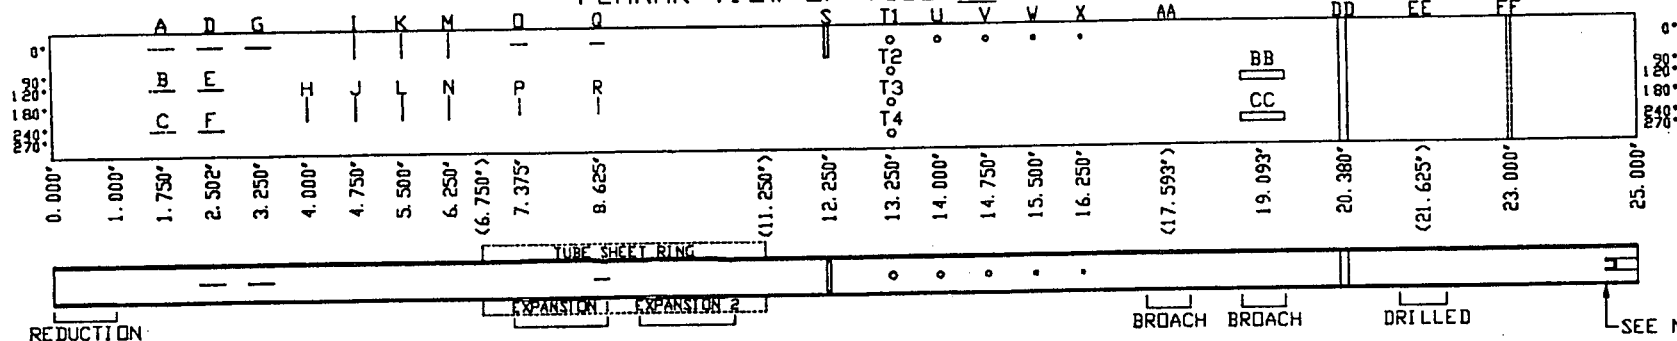

1

# OCONEE EDM/ASME/WEAR CALIBRATION STANDARD

MAT'L: ASME SB-163 ALLOY 600, .630" OD, .554" ID, .037" WALL.

FILENAME: 1268319B.DWG  
DISK No.: OPTICAL

THIS DRAWING/DOCUMENT IS THE PROPERTY OF FTI AND IS LOANED UPON THE CONDITION THAT IT IS NOT TO BE REPRODUCED OR COPIED, IN WHOLE OR IN PART, OR USED FOR FURNISHING INFORMATION TO OTHERS, OR FOR ANY OTHER PURPOSE, DETRIMENTAL TO THE INTEREST OF FTI AND IS TO BE RETURNED UPON REQUEST. DO NOT SCALE - USE DIMENSIONS ONLY.

OWN BY: *William J. CME*  
PASSED BY: *William J. CME*  
DATE: *12/1/97*

OCONEE EDM/ASME/WEAR CALIBRATION  
STANDARD AS BUILT DRAWING

SCALE: 1/2  
DATE: 09/09/97  
DWG NO.: 1268319B-0



NOTES:

1. THE MATERIAL HEAT NUMBER, HT 93500 LOT 5022, AND THE AS BUILT NUMBER, 1268320B, ARE ETCHED AT THE RIGHT TUBE END.
2. THIS STANDARD WAS MADE VIA PA 83-795437-02 AND FTI WD 8285 FROM DESIGN DRAWING 1268313D-1, FOR DUKE POWER COMPANY.
3. THE AS BUILT DIMENSIONS WERE OBTAINED FROM FTI SHOP DATA SHEETS AND QCIR 97-00769.
4. EACH FLAW IS CENTERED ABOUT THE SPECIFIED AXIAL AND AZIMUTHAL LOCATIONS.
5. THE DEPTHS IN PERCENT THROUGH WALL (%TW) ARE BASED UPON THE ACTUAL MEAN WALL THICKNESS (MWT) OF THE TUBING, .037".
6. WHEN THE STANDARD IS PLACED IN ITS HOLDER (1268314E-1), A DRILLED TUBE SUPPORT PLATE (TSP) SIMULATOR WILL BE CENTERED NEAR LOCATION EE. BROACHED TSP'S WILL BE CENTERED NEAR LOCATIONS AA AND BB/CC. WEAR PATCHES BB AND CC WILL BE LOCATED WITH TWO LAND REGIONS OF THEIR BROACHED TSP.

FIG. 1

0.000" 1.000" 1.750" 2.500" 3.250" 4.000" 4.750" 5.500" 6.250" (6.750") 7.375" 8.625" (11.250") 12.250" 13.250" 14.002" 14.750" 15.500" 16.252" (17.250") (17.593") (17.937") 19.095" 20.375" (21.625") 23.000" 25.000"

0° 120° 180° 240° 300°

A B C D E F G H I J K L M N P Q R S T U V W X AA BB CC DD EE FF

REDUCTION EXPANSION 1 EXPANSION 2 BRANCH BRANCH DRILLED

↳ SEE NOTE 1

# 1) OCONEE EDM/ASME/WEAR CALIBRATION STANDARD

MAT'L: ASME SB-163 ALLOY 600, .629" OD, .555" ID, .037" WALL.

FILENAME: 1268320B.DWG  
DISK No.: OPTICAL

THIS DRAWING/DOCUMENT IS THE PROPERTY OF FII AND IS LOANED UPON THE CONDITION THAT IT IS NOT TO BE REPRODUCED OR COPIED, IN WHOLE OR IN PART, OR USED FOR FURNISHING INFORMATION TO OTHERS, OR FOR ANY OTHER PURPOSE DETRIMENTAL TO THE INTERESTS OF FII AND IS TO BE RETURNED UPON REQUEST. DO NOT SCALE - USE DIMENSIONS ONLY.

DOWN BY <i>REMOVED</i>	CHK'D BY <i>Palmer</i>
C.M. FIELDS	C. D. PALMER
PASSED BY <i>REMOVED</i>	APP'D BY <i>REMOVED</i>
A. A. HARRIS	RA. COE

OCONEE EDM/ASME/WEAR CALIBRATION  
STANDARD AS BUILT DRAWING

SCALE	1/2	DATE	09/09/97
DWG NO.	1268320		B-0

ATTACHMENT 4

OPTICAL DISK WITH EDDY CURRENT DATA



**Duke Power Company**  
*A Duke Energy Company*  
Oconee Nuclear Site  
P.O. Box 1439  
Seneca, SC 29679

W. R. McCollum, Jr.  
Vice President

(864) 885-3107 OFFICE  
(864) 885-3564 FAX

January 26, 1998

U. S. Nuclear Regulatory Commission  
Attention: Document Control Desk  
Washington, DC 20555

Subject: Oconee Nuclear Station  
Docket No. 50-269  
Response to Request for Additional Information  
on Steam Generator Inspections

In a letter dated December 2, 1997, the NRC requested additional information regarding the results of the steam generator inspections that were performed during the Oconee Unit 1 end of cycle 17 refueling outage. Specifically, the NRC requested that Duke Energy (Duke) submit (1) an optical disk containing the eddy current inspection data for the inside diameter (ID) intergranular attack (IGA) indications in the pulled tube specimens; (2) files on the optical disk with the setup used by the analyst for examining the indications; (3) a drawing or description of the standard used to calibrate the acquisition system; (4) eddy current data from 20 randomly selected tubes that contain ID IGA indications; and (5) a listing of the dimensions of the ID IGA indications as determined from the destructive examination of the pulled tube specimens. In addition, the NRC requested that the format for the eddy current data be compatible with Eddynet95 analysis software.

In response to this request, Duke provides the attached information. Attachment 1 contains a list of over 20 randomly selected tubes which have eddy current data supplied on the optical disk. The randomly selected tubes are circled on the list. A listing of the dimensions of the ID IGA indications as determined from the destructive examination of the pulled tube specimens is contained in Attachment 2. A drawing of the standard used to calibrate the acquisition system is provided in Attachment 3. Attachment 4 contains an optical disk with the eddy current data for the randomly selected tubes and the pulled tube

940206 00 51



U. S. Nuclear Regulatory Commission  
January 26, 1998

Page 3

bcc:

B. L. Peele  
M. K. Nazar  
W. W. Foster  
J. E. Burchfield  
M. T. Cash  
M. S. Kitlan  
R. L. Gill  
L. A. Keller  
M. E. Bailey  
B. B. Lowery  
P. R. Newton  
T. J. Pettit  
W. M. Sample  
J. H. Batton  
D. B. Mayes  
NSRB  
ELL

U. S. Nuclear Regulatory Commission  
January 26, 1998

Page 2

specimens. The optical disk contains the setup used by the analyst for examining the tube indications and is in a format which is compatible with Eddynet95 analysis software.

If there are any questions regarding this submittal, please contact Michael Bailey at (864) 885-4390.

Very truly yours,



W. R. McCollum, Jr.  
Site Vice President  
Oconee Nuclear Station

MEB

Attachments (4)

cc w/o optical disk:

L. A. Reyes, Regional Administrator  
Region II

M. A. Scott, Senior Resident Inspector  
Oconee Nuclear Site

cc with optical disk:

D. E. LaBarge, Project Manager  
NRR

ATTACHMENT 1

LIST OF THE RANDOMLY SELECTED TUBES

\*\*\*\*\*  
 \*\*\*\*\*  
FTI TUBAN II (Version 2.4) 12/09/1997 13:21:31  
 Oconee Nuclear Station - Unit One  
 S/G B  
 09/97 RFO  
 ROLL TRANSITION, TUBE PULL REV. -MRPC

\*\*\*\*\*  
 \*\*\*\*\*  
Page 1 of 1

QRY: 12/09/1997 13:13:54

TEST TYPE	ROW	COL	IND	%TW	VOLTS	CHN	DEG	LOCATION	EXTENT1	EXTENT2	LEG	TAPE#	PROBE	COMMENTS	OPTICAL	DK
ROLL TRANSITI	88	100	SAI		2.51	P 1	26	UTE	-0.75	UTE	UTE	UTE	108	520		
ROLL TRANSITI	89	82	VOL		0.97	P 1	12	UTE	-0.67	UTE	UTE	UTE	108	520		
ROLL TRANSITI	89	86	VOL		0.91	P 1	17	UTE	-0.58	UTE	UTE	UTE	108	520		
ROLL TRANSITI	89	88	VOL		0.67	P 1	28	UTE	-0.70	UTE	UTE	UTE	108	520		
ROLL TRANSITI	91	83	VOL		0.57	P 1	9	UTE	-1.02	UTE	UTE	UTE	108	520		
ROLL TRANSITI	87	86	VOL		0.38	P 1	34	UTE	-3.41	UTE	UTE	UTE	114	520		
ROLL TRANSITI	88	100	SAI		2.39	P 1	30	UTE	-1.02	UTE	UTE	UTE	114	520		
ROLL TRANSITI	86	95	SAI		1.50	P 1	16	UTE	-1.00	UTE	UTE	UTE	117	520		
ROLL TRANSITI	86	102	VOL		0.46	5	37	UTE	-2.60	UTE	UTE	UTE	118	520		
ROLL TRANSITI	81	82	SAI		0.81	P 1	30	UTE	-1.29	UTE	UTE	UTE	157	520		
ROLL TRANSITI	79	117	VOL		0.21	P 1	30	UTE	-1.28	UTE	UTE	UTE	161	520		
ROLL TRANSITI	84	131	VOL		0.79	P 2	18	UTE	-2.06	UTE	UTE	UTE	164	520		
ROLL TRANSITI			VOL		1.10	P 2	17	UTE	-1.77	UTE	UTE	UTE	164	520		
ROLL TRANSITI			VOL		1.22	P 2	25	UTE	-1.47	UTE	UTE	UTE	164	520		
ROLL TRANSITI	55	87	SAI		1.70	P 1	35	UTE	-1.24	UTE	UTE	UTE	178	520		
ROLL TRANSITI	56	82	MAI		2.06	P 1	38	UTE	-1.09	UTE	UTE	UTE	178	520		
ROLL TRANSITI	56	94	VOL		0.61	5	24	UTE	-2.77	UTE	UTE	UTE	178	520		
ROLL TRANSITI	56	96	VOL		0.62	P 2	24	UTE	-2.37	UTE	UTE	UTE	178	520		
ROLL TRANSITI	55	110	VOL		0.33	P 1	103	UTE	-0.78	UTE	UTE	UTE	179	520		L3R
ROLL TRANSITI	58	79	SAI		1.53	1	31	UTE	-1.07	UTE	UTE	UTE	180	520		
ROLL TRANSITI	59	77	MAI		1.22	1	34	UTE	-1.61	UTE	UTE	UTE	180	520		
ROLL TRANSITI			VOL		1.22	P 2	14	UTE	-1.46	UTE	UTE	UTE	180	520		
ROLL TRANSITI	57	82	VOL		0.53	P 1	57	UTE	-2.26	UTE	UTE	UTE	181	520		
ROLL TRANSITI	59	76	VOL		1.13	P 1	21	UTE	-1.35	UTE	UTE	UTE	181	520		
ROLL TRANSITI	59	78	VOL		0.53	P 2	34	UTE	-1.51	UTE	UTE	UTE	181	520		
ROLL TRANSITI			VOL		0.92	P 2	22	UTE	-1.06	UTE	UTE	UTE	181	520		
ROLL TRANSITI	59	80	VOL		0.90	P 1	31	UTE	-1.06	UTE	UTE	UTE	181	520		
ROLL TRANSITI	59	88	VOL		1.61	P 2	30	UTE	-1.71	UTE	UTE	UTE	181	520		
ROLL TRANSITI	59	90	VOL		0.56	P 1	34	UTE	-2.58	UTE	UTE	UTE	181	520		
ROLL TRANSITI			VOL		0.97	P 1	27	UTE	-2.20	UTE	UTE	UTE	181	520		
ROLL TRANSITI	59	102	VOL		0.49	P 1	50	UTE	-1.47	UTE	UTE	UTE	181	520		
ROLL TRANSITI	59	106	VOL		0.95	P 1	27	UTE	-1.55	UTE	UTE	UTE	181	520		
ROLL TRANSITI			VOL		1.34	P 1	26	UTE	-1.23	UTE	UTE	UTE	181	520		
ROLL TRANSITI	59	110	SAI		2.05	P 1	35	UTE	-1.18	UTE	UTE	UTE	181	520		
ROLL TRANSITI			VOL		1.01	P 1	21	UTE	-1.50	UTE	UTE	UTE	181	520		
ROLL TRANSITI	59	121	VOL		0.90	P 1	18	UTE	-1.06	UTE	UTE	UTE	181	520		
ROLL TRANSITI	60	94	VOL		0.75	P 1	21	UTE	-2.59	UTE	UTE	UTE	181	520		
ROLL TRANSITI	60	96	VOL		0.65	P 1	28	UTE	-1.80	UTE	UTE	UTE	181	520		
ROLL TRANSITI	63	88	VOL		1.30	P 1	201	UTE	-1.29	UTE	UTE	UTE	182	520		
ROLL TRANSITI	63	120	MAI		0.39	P 1	52	UTE	-1.83	UTE	UTE	UTE	182	520		
ROLL TRANSITI	63	122	MAI		0.83	P 1	45	UTE	-1.56	UTE	UTE	UTE	182	520		
ROLL TRANSITI	64	97	VOL		0.80	5	193	UTE	-2.04	UTE	UTE	UTE	182	520		
ROLL TRANSITI	64	122	VOL		1.73	5	29	UTE	-1.34	UTE	UTE	UTE	182	520		
ROLL TRANSITI	63	99	VOL		3.80	1	3	UTE	-1.26	UTE	UTE	UTE	183	520		
ROLL TRANSITI	63	107	VOL		0.63	1	15	UTE	-2.10	UTE	UTE	UTE	183	520		
ROLL TRANSITI	64	100	VOL		1.19	1	22	UTE	-1.21	UTE	UTE	UTE	183	520		
ROLL TRANSITI	64	114	VOL		0.95	1	29	UTE	-1.58	UTE	UTE	UTE	183	520		
ROLL TRANSITI	64	116	VOL		1.84	1	27	UTE	-1.34	UTE	UTE	UTE	183	520		
ROLL TRANSITI	64	120	VOL		1.13	1	32	UTE	-1.20	UTE	UTE	UTE	183	520		
ROLL TRANSITI	65	113	VOL		1.11	1	31	UTE	-1.53	UTE	UTE	UTE	183	520		
ROLL TRANSITI	65	121	VOL		1.63	1	26	UTE	-1.38	UTE	UTE	UTE	183	520		
ROLL TRANSITI	73	106	VOL		0.60	1	26	UTE	-1.07	UTE	UTE	UTE	185	520		
ROLL TRANSITI	73	115	VOL		0.58	1	29	UTE	-0.65	UTE	UTE	UTE	185	520		
ROLL TRANSITI	75	96	VOL		0.88	P 1	40	UTE	-1.09	UTE	UTE	UTE	185	520		
ROLL TRANSITI	75	104	VOL		0.92	P 1	26	UTE	-1.35	UTE	UTE	UTE	185	520		
ROLL TRANSITI	75	112	VOL		1.58	P 2	34	UTE	-1.02	UTE	UTE	UTE	185	520		
ROLL TRANSITI	71	97	VOL		0.31	P 2	46	UTE	-2.33	UTE	UTE	UTE	186	520		
ROLL TRANSITI	72	113	VOL		0.40	P 1	40	UTE	-2.06	UTE	UTE	UTE	186	520		
ROLL TRANSITI	66	122	SAI		1.28	P 1	24	UTE	-1.52	UTE	UTE	UTE	188	520		
ROLL TRANSITI	63	85	VOL		2.18	P 1	27	UTE	-1.78	UTE	UTE	UTE	190	520		

Total Indications Found = 60  
 Total Tubes Found = 52  
 Total Tubes in Input File = 53

ATTACHMENT 2

LISTING OF DIMENSIONS FOR INDICATIONS  
IN THE PULLED TUBE SPECIMENS

**OCONEE-1 DEPTH DATA FOR TUBES R59T82 AND R65T111**

TUBE	LOCATION	DEPTH (% throughwall)	LENGTH (inches)	WIDTH (inches)
R65T111	120°, AREA 1	46%	.20	.10
			.20	.13
R65T111	210°, AREA 2	35%	.04	.05
R65T111	330°, AREA 1	19%	.16	.1
R65T111	330°, AREA 2	32%	.11	.09
R59T82	180°, AREA 1	46%	.21	.14
R59T82	20°, AREA 2	46%	.18	.08
R59T82	10°, AREA 1	35%	.24	.05
R59T82	230°, AREA 2	22%	.09	.20

**NOTE: THERE ARE TWO PATCHES OF IGA AT 120° ON TUBE R65T111, WITHIN AREA 1, WHICH BOTH DISAPPEAR AFTER 46% TW**

**PATCH CLOSEST TO THE TUBE END IS .20 X .10  
PATCH JUST BELOW IS .20 X .13**

**NOTE: THE LENGTH AND WIDTH OF THE IGA IS GIVEN AFTER APPROXIMATELY 8% TW (0.003 INCHES BELOW THE ID SURFACE)**

**NOTE: THE TWO PATCHES OF IGA AT 10° AND 20° FROM TUBE R59T82 COULD COME FROM THE SAME AREA OF DEGRADATION**

ATTACHMENT 3

DRAWING OF THE CALIBRATION STANDARD

8996Z9Z1

ON SAG


FLAW LABEL	FLAW DESCRIPTION	SIDE	AXIAL LOCATION	AZIMUTHAL LOCATION	LENGTH	WIDTH OR DIAMETER	DEPTH IN INCHES	DEPTH IN %TW
A	GROOVE	ID	2.000°	ALL	.0615°	N/A	.0075°	19 %TW
B	GROOVE	OD	3.000°	ALL	.124°	N/A	.0045°	11 %TW
C	4 FBH'S	OD	4.000°	0°90°180°270°	N/A	Ø.114°	Ø.008°	20 %TW
D	FBH	OD	4.750°	0°	N/A	Ø.093°	.0155°	39 %TW
E	FBH	OD	5.500°	0°	N/A	Ø.077°	.0235°	59 %TW
F	FBH	OD	6.250°	0°	N/A	Ø.063°	.031°	78 %TW
G	HOLE	OD	7.000°	0°	N/A	Ø.048°	THROUGH	100 %TW
H	DENT	OD	8.000°	0°	.062°	(.475°)	.003°	N/A
I	NDD & BROACHED TSP	OD	9.750°	N/A	1.500°	N/A	N/A	N/A
J	WEAR & BROACHED TSP	OD	12.250°	0°	1.500°	.125°	.0095°	24 %TW
K	WEAR & BROACHED TSP	OD	12.250°	120°	1.500°	.124°	.0225°	57 %TW
L	NDD & DRILLED TSP	OD	14.375°	N/A	.750°	N/A	N/A	N/A
AA	AX EDM	OD	16.000°	0°	.312°	.006°	.008°	20 %TW
BB	CI EDM	OD	16.000°	90°	.60°	.006°	.008°	20 %TW
CC	AX EDM	ID	16.000°	180°	.312°	.005°	.008°	20 %TW
DD	CI EDM	ID	16.000°	270°	.60°	.005°	.008°	20 %TW
EE	AX EDM	OD	16.750°	0°	.312°	.006°	.015°	38 %TW
FF	CI EDM	OD	16.750°	90°	.60°	.006°	.015°	38 %TW
GG	AX EDM	ID	16.750°	180°	.312°	.005°	.016°	41 %TW
HH	CI EDM	ID	16.750°	270°	.60°	.005°	.015°	38 %TW
II	AX EDM	OD	17.500°	0°	.312°	.006°	.023°	58 %TW
JJ	CI EDM	OD	17.500°	90°	.60°	.006°	.023°	58 %TW
KK	AX EDM	ID	17.500°	180°	.312°	.005°	.023°	58 %TW
LL	CI EDM	ID	17.500°	270°	.60°	.005°	.023°	58 %TW
MM	AX EDM	OD	18.250°	0°	.312°	.006°	THROUGH	100 %TW
NN	CI EDM	OD	18.500°	240°	.60°	.006°	THROUGH	100 %TW
OO	AX EDM IN EXPANSION	OD	LEFT TRANSITION	0°	.312°	.006°	.015°	38 %TW
PP	CI EDM IN EXPANSION	OD	LEFT TRANSITION	90°	.60°	.006°	.015°	38 %TW
QQ	AX EDM IN EXPANSION	ID	RIGHT TRANSITION	180°	.312°	.006°	.015°	38 %TW
RR	CI EDM IN EXPANSION	ID	RIGHT TRANSITION	270°	.287°	.006°	.015°	38 %TW

\* AVERAGE OF FOUR HOLES

REVISIONS			
REV	DESCRIPTION	DATE	APPROVAL

## NOTES:

1. THE MATERIAL HEAT NUMBER, HT 93452 LOT 5060, AND THE AS BUILT NUMBER, 1252966B, ARE ETCHED AT THE RIGHT TUBE END.
2. THIS STANDARD WAS MADE VIA PA 83-791232 REV 00 & 01, AND WORK ORDER 4986, FROM DESIGN DRAWING 1252875D-2, FOR DUKE POWER COMPANY.
3. THE AS BUILT DIMENSIONS WERE OBTAINED FROM SPIS SHOP DATA SHEETS AND QCIR 96-285.
4. EACH FLAW IS CENTERED ABOUT THE SPECIFIED AXIAL AND AZIMUTHAL LOCATIONS.
5. THE DEPTHS IN PERCENT THROUGH WALL (%TW) ARE BASED UPON THE ACTUAL MEAN WALL THICKNESS (MWT) OF THE TUBE, .0395°.
6. WHEN PLACED IN HOLDER (1252876E-0), A DRILLED TSP IS CENTERED AT LOCATION L, AND BROACHED TSP'S ARE CENTERED AT LOCATIONS 'I' AND 'J,K' USING THE KEY AT THE TUBE END.
7. PER DUKE POWER, THIS STANDARD CONTAINS A HALF LENGTH DRILLED TSP, AND TRADITIONAL FBH'S WHOSE DIAMETERS ARE SOMEWHAT SMALLER THAN TYPICAL ASME CODE DIAMETERS.

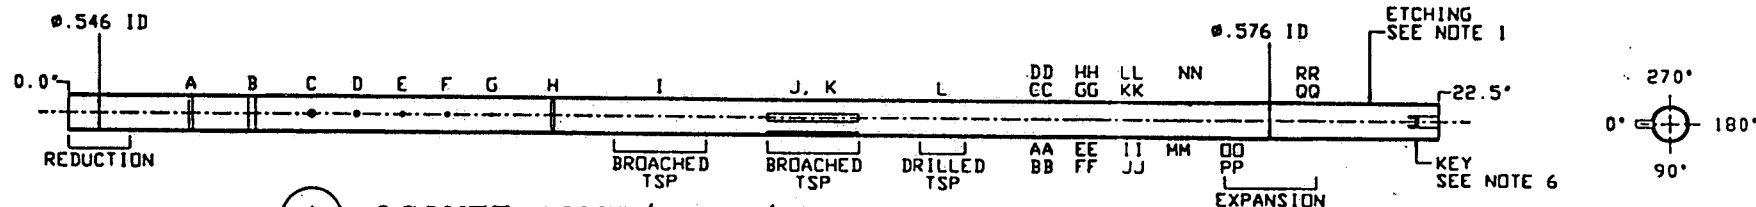

QA CONDITION 1

1

OCONEE ASME/WEAR/EDM CALIBRATION STANDARD

MAT'L: ASME SB-163 ALLOY 600, .029° AVERAGE OD, .550° AVERAGE ID, .0395° AVERAGE WALL.

 FILENAME: 1252966B.DWG  
 DISK No.: OPTICAL

THIS DRAWING/DOCUMENT IS THE PROPERTY OF FFI AND IS LOANED UNDER THE CONDITION THAT IT IS NOT TO BE REPRODUCED OR COPIED IN WHOLE OR IN PART, OR USED FOR FURNISHING INFORMATION TO OTHERS, OR FOR ANY OTHER PURPOSE DETRIMENTAL TO THE INTEREST OF FFI AND IS TO BE RETURNED UPON REQUEST. DO NOT SCALE - USE DIMENSIONS ONLY.

 DESIGNED BY: *[Signature]*  
 CHECKED BY: *[Signature]*  
 APPROVED BY: *[Signature]*  
 PASSED BY: *[Signature]*

 Ocone ASME/WEAR/EDM CALIBRATION STANDARD AS BUILT DRAWING  
 SCALE: 0.5X  
 DATE: 04/01/96  
 DISK No.: 1252966B-0

22159 (12/95)



1268327B

DN 048

FRAMATOME  
TECHNOLOGIES


FLAW LABEL	FLAW DESCRIPTION	SURFACE OF ORIGIN	AXIAL LOCATION	AZIMUTHAL LOCATION	LENGTH IN INCHES	WIDTH OR DIAMETER IN INCHES	DEPTH IN INCHES	DEPTH IN %TW
A	AX EDM	ID	1.750"	0°	.376"	.003"	.024"	63 %TW
B	AX EDM	ID	1.750"	120°	.376"	.003"	.013"	34 %TW
C	AX EDM	ID	1.750"	240°	.376"	.003"	.009"	24 %TW
D	AX EDM	OD	2.500"	0°	.375"	.003"	.021"	55 %TW
E	AX EDM	OD	2.500"	120°	.375"	.004"	.014"	37 %TW
F	AX EDM	OD	2.500"	240°	.375"	.003"	.0065"	17 %TW
G	AX EDM	OD	3.250"	0°	.375"	.003"	THROUGH	100 %TW
H	CI EDM	OD	4.000"	180°	.375"	.003"	THROUGH	100 %TW
I	CI EDM	ID	4.750"	0°	.376"	.003"	.022"	50 %TW
J	CI EDM	OD	4.750"	180°	.375"	.003"	.020"	53 %TW
K	CI EDM	ID	5.500"	0°	.376"	.003"	.0145"	38 %TW
L	CI EDM	OD	5.500"	180°	.375"	.003"	.014"	37 %TW
M	CI EDM	ID	6.250"	0°	.376"	.003"	.008"	21 %TW
N	CI EDM	OD	6.250"	180°	.375"	.004"	.007"	18 %TW
O	AX EDM IN EXPANSION	ID	7.375"	0°	.251"	.003"	.015"	40 %TW
P	CI EDM IN EXPANSION	ID	7.375"	180°	.251"	.003"	.016"	43 %TW
Q	AX EDM IN EXPANSION	OD	8.625"	0°	.250"	.004"	.014"	37 %TW
R	CI EDM IN EXPANSION	OD	8.625"	180°	.250"	.003"	.0145"	38 %TW
S	DENT	OD	12.250"	0°	.063"	.400"	.004"	N/A
T1	FBH	OD	13.251"	0°	N/A	.115"	.0075"	20 %TW
T2	FBH	OD	13.251"	90°	N/A	.115"	.0065"	17 %TW
T3	FBH	OD	13.251"	180°	N/A	.115"	.007"	18 %TW
T4	FBH	OD	13.251"	270°	N/A	.115"	.007"	18 %TW
U	FBH	OD	14.002"	0°	N/A	.093"	.014"	37 %TW
V	FBH	OD	14.751"	0°	N/A	.080"	.021"	55 %TW
W	FBH	OD	15.500"	0°	N/A	.061"	.028"	74 %TW
X	HOLE	OD	16.250"	0°	N/A	.051"	THROUGH	100 %TW
AA	WEL & BROACHED TSP	N/A	N/A	N/A	N/A	N/A	N/A	N/A
BB	WEAR & BROACHED TSP	OD	19.091"	120°	.689"	.124"	.010"	26 %TW
CC	WEAR & BROACHED TSP	OD	19.091"	240°	.689"	.124"	.021"	55 %TW
DD	GROOVE	OD	20.373"	360°	.124"	N/A	.003"	8 %TW
EE	WEL & DRILLED TSP	OD	N/A	N/A	N/A	N/A	N/A	N/A
FF	GROOVE	ID	23.000"	360°	.065"	N/A	.0076"	20 %TW

REVISIONS				H	P
REV	DESCRIPTION	DATE	APPROVAL		

## NOTES:

1. THE MATERIAL HEAT NUMBER, HT 93500 LOT 5022, AND THE AS BUILT NUMBER, 1268327B, ARE ETCHED AT THE RIGHT TUBE END.
2. THIS STANDARD WAS MADE VIA PA 83-795481-03, PA 83-795515-00 AND FTI WD 8373, FROM DESIGN DRAWING 1268313D-1, FOR DUKE POWER COMPANY.
3. THE AS BUILT DIMENSIONS WERE OBTAINED FROM FTI SHOP DATA SHEETS AND QCIR 97-00774.
4. EACH FLAW IS CENTERED ABOUT THE SPECIFIED AXIAL AND AZIMUTHAL LOCATIONS.
5. THE DEPTHS IN PERCENT THROUGH WALL (%TW) ARE BASED UPON THE ACTUAL MEAN WALL THICKNESS (MWT) OF THE TUBING, .038".
6. WHEN THE STANDARD IS PLACED IN ITS HOLDER (1268314E-1), A DRILLED TUBE SUPPORT PLATE (TSP) SIMULATOR WILL BE CENTERED NEAR LOCATION EE. BROACHED TSP'S WILL BE CENTERED NEAR LOCATIONS AA AND BB/CC. WEAR PATCHES BB AND CC WILL BE LOCATED WITH TWO LAND REGIONS OF THEIR BROACHED TSP.
7. ID FLAW DIMENSIONS ARE OBTAINED FROM MACHINING EQUIPMENT.

## PLANAR VIEW OF TUBE DD AND FLAWS

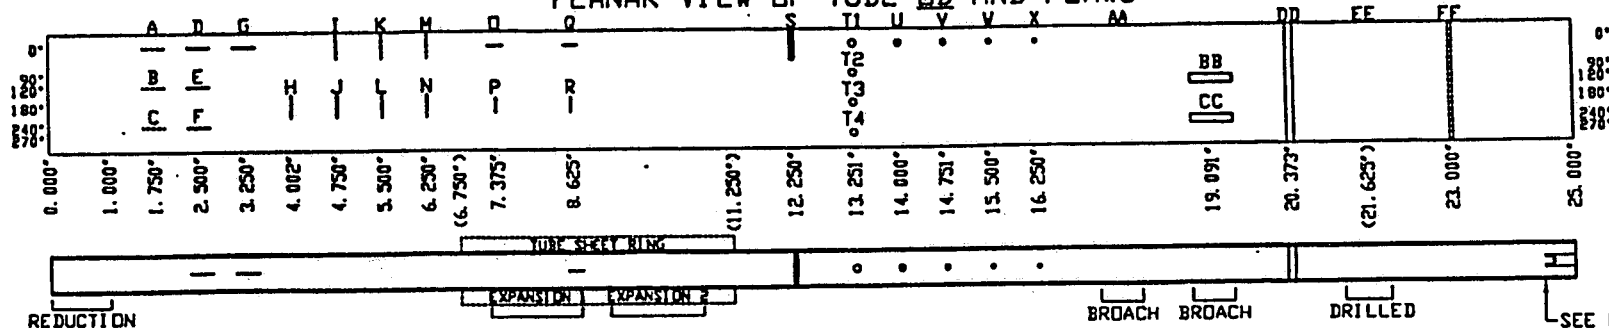

1

OCONEE EDM/ASME/WEAR CALIBRATION STANDARD  
MAT'L: ASME SB-163 ALLOY 600, .630" OD, .554" ID, .038" WALL

FILENAME: 1268327B.DWG  
DISK No.: OPTICAL

THIS DRAWING/DOCUMENT IS THE PROPERTY OF FTI AND IS LOANED UNDER THE CONDITION THAT IT IS NOT TO BE REPRODUCED OR COPIED, IN WHOLE OR IN PART, OR USED FOR FURTHER INFORMATION TO OTHERS, OR FOR ANY OTHER PURPOSE, WITHOUT THE WRITTEN PERMISSION OF FTI AND IS TO BE RETURNED UPON REQUEST. DO NOT SCALE - USE DIMENSIONS ONLY.

OWN BY: [Signature]  
DESIGNED BY: [Signature]  
CHECKED BY: [Signature]  
DATE: 09/09/97

OCONEE EDM/ASME/WEAR CALIBRATION  
STANDARD AS BUILT DRAWING

SCALE: 1/2  
DATE: 09/09/97  
DOC NO.: 1268327B-0

22159 GB/93

1268326B

DN BAS

FLAW LABEL	FLAW DESCRIPTION	SURFACE OF ORIGIN	AXIAL LOCATION	AZIMUTHAL LOCATION	LENGTH - .000" / .010"	WIDTH OR DIAMETER	DEPTH IN INCHES	DEPTH IN %TW
A	AX EDM	ID	1.750"	0°	.376"	.005"	.024"	63 %TW
B	AX EDM	ID	1.750"	120°	.376"	.005"	.013"	34 %TW
C	AX EDM	ID	1.750"	240°	.376"	.005"	.008"	21 %TW
D	AX EDM	OD	2.500"	0°	.375"	.005"	.022"	58 %TW
E	AX EDM	OD	2.500"	120°	.376"	.005"	.014"	37 %TW
F	AX EDM	OD	2.500"	240°	.375"	.005"	.007"	18 %TW
G	AX EDM	OD	3.250"	0°	.376"	.005"	THROUGH	100 %TW
H	CI EDM	OD	4.000"	180°	.375"	.005"	THROUGH	100 %TW
I	CI EDM	ID	4.750"	0°	.376"	.005"	.022"	58 %TW
J	CI EDM	OD	4.750"	180°	.375"	.005"	.020"	53 %TW
K	CI EDM	ID	5.500"	0°	.376"	.005"	.015"	40 %TW
L	CI EDM	OD	5.500"	180°	.375"	.005"	.014"	37 %TW
M	CI EDM	ID	6.250"	0°	.376"	.005"	.009"	24 %TW
N	CI EDM	OD	6.250"	180°	.375"	.005"	.007"	18 %TW
O	AX EDM IN EXPANSION	ID	7.375"	0°	.251"	.005"	.014"	37 %TW
P	CI EDM IN EXPANSION	ID	7.375"	180°	.251"	.005"	.016"	42 %TW
Q	AX EDM IN EXPANSION	OD	8.625"	0°	.250"	.005"	.015"	40 %TW
R	CI EDM IN EXPANSION	OD	8.625"	180°	.250"	.005"	.0145"	38 %TW
S	DENT	OD	12.250"	0°	.063"	.400"	.004"	N/A
T1	FBH	OD	13.250"	0°	N/A	0.115"	.007"	18 %TW
T2	FBH	OD	13.250"	90°	N/A	0.115"	.008"	21 %TW
T3	FBH	OD	13.250"	180°	N/A	0.115"	.007"	18 %TW
T4	FBH	OD	13.250"	270°	N/A	0.115"	.007"	18 %TW
U	FBH	OD	14.000"	0°	N/A	0.096"	.014"	37 %TW
V	FBH	OD	14.750"	0°	N/A	0.089"	.022"	58 %TW
W	FBH	OD	15.500"	0°	N/A	0.062"	.030"	79 %TW
X	HOLE	OD	16.250"	0°	N/A	0.056"	THROUGH	100 %TW
AA	RBD & BROACHED TSP	N/A	N/A	N/A	N/A	N/A	N/A	N/A
BB	WEAR & BROACHED TSP	OD	19.090"	120°	.690"	.124"	.010"	26 %TW
CC	WEAR & BROACHED TSP	OD	19.091"	240°	.125"	.124"	.020"	53 %TW
DD	GROOVE	OD	20.373"	360°	.125"	N/A	.053"	8 %TW
EE	RBD & DRILLED TSP	OD	N/A	N/A	N/A	N/A	N/A	N/A
FF	GROOVE	ID	23.000"	360°	.665"	N/A	.0076"	20 %TW


## REVISIONS

REV	DESCRIPTION	DATE	APPROVAL
-----	-------------	------	----------

## NOTES:

1. THE MATERIAL HEAT NUMBER, HT 93500 LOT 5022, AND THE AS BUILT NUMBER, 1268326B, ARE ETCHED AT THE RIGHT TUBE END.
2. THIS STANDARD WAS MADE VIA PA 83-795481-03, PA 83-795515-00 AND FTI WD 8373, FROM DESIGN DRAWING 1268313D-1, FOR DUKE POWER COMPANY.
3. THE AS BUILT DIMENSIONS WERE OBTAINED FROM FTI SHOP DATA SHEETS AND QCIR 97-00773.
4. EACH FLAW IS CENTERED ABOUT THE SPECIFIED AXIAL AND AZIMUTHAL LOCATIONS.
5. THE DEPTHS IN PERCENT THROUGH WALL (%TW) ARE BASED UPON THE ACTUAL MEAN WALL THICKNESS (MWT) OF THE TUBING, .038".
6. WHEN THE STANDARD IS PLACED IN ITS HOLDER (1268314E-1), A DRILLED TUBE SUPPORT PLATE (TSP) SIMULATOR WILL BE CENTERED NEAR LOCATION EE. BROACHED TSP'S WILL BE CENTERED NEAR LOCATIONS AA AND BB/CC. WEAR PATCHES BB AND CC WILL BE LOCATED WITH TWO LAND REGIONS OF THEIR BROACHED TSP.
7. ID FLAW DIMENSIONS ARE OBTAINED FROM MACHINING EQUIPMENT.

## PLANAR VIEW OF TUBE DD AND FLAWS

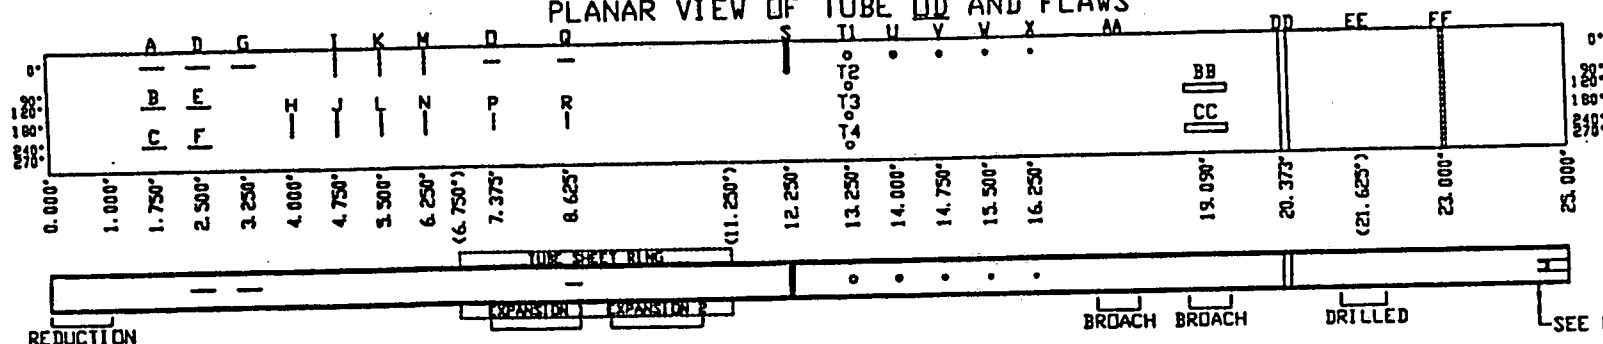

SEE NOTE 1

①

## OCONEE EDM/ASME/WEAR CALIBRATION STANDARD

MAT'L: ASME SB-163 ALLOY 600, .629" OD, .554" ID, .038" WALL

 FILENAME: 1268326B.DWG  
 DISK No.: OPTICAL

THIS DRAWING/REVISION IS THE PROPERTY OF FTI AND IS LOANED UNDER THE CONDITION THAT IT IS NOT TO BE REPRODUCED OR COPIED, IN WHOLE OR IN PART, OR USED FOR FURNISHING INFORMATION TO OTHERS, OR FOR ANY OTHER PURPOSES WITHOUT THE WRITTEN PERMISSION OF FTI AND IS TO BE RETURNED UPON REQUEST. NO USE SHALL BE MADE WITHOUT THE WRITTEN PERMISSION OF FTI.

 OCONEE EDM/ASME/WEAR CALIBRATION STANDARD AS BUILT DRAWING  
 SCALE: 1/2  
 DATE: 09/09/97  
 1268326B-0

22159 02/93

1268321B

DM DAD



## REVISIONS


REV	DESCRIPTION	DATE	APPROVAL
-----	-------------	------	----------

FLAW LABEL	FLAW DESCRIPTION	SURFACE OF ORIGIN	AXIAL LOCATION	AZIMUTHAL LOCATION	LENGTH - .000/.010	WIDTH OR DIAMETER	DEPTH IN INCHES	DEPTH IN %TW
A	AX EDM	ID	1.750"	0°	.375"	.006"	.022"	60 %TW
B	AX EDM	ID	1.750"	120°	.375"	.005"	.015"	41 %TW
C	AX EDM	ID	1.750"	240°	.375"	.005"	.0075"	20 %TW
D	AX EDM	OD	2.500"	0°	.375"	.005"	.021"	57 %TW
E	AX EDM	OD	2.500"	120°	.375"	.005"	.015"	41 %TW
F	AX EDM	OD	2.500"	240°	.375"	.006"	.007"	19 %TW
G	AX EDM	OD	3.250"	0°	.375"	.006"	THROUGH	100 %TW
H	CI EDM	OD	4.000"	180°	.375"	.006"	THROUGH	100 %TW
I	CI EDM	ID	4.750"	0°	.375"	.006"	.022"	60 %TW
J	CI EDM	OD	4.750"	180°	.375"	.005"	.021"	57 %TW
K	CI EDM	ID	5.500"	0°	.375"	.005"	.015"	41 %TW
L	CI EDM	OD	5.500"	180°	.375"	.005"	.014"	38 %TW
M	CI EDM	ID	6.250"	0°	.375"	.005"	.0075"	20 %TW
N	CI EDM	OD	6.250"	180°	.375"	.006"	.007"	19 %TW
O	AX EDM IN EXPANSION	ID	7.375"	0°	.250"	.005"	.015"	41 %TW
P	CI EDM IN EXPANSION	ID	7.375"	180°	.250"	.005"	.015"	41 %TW
Q	AX EDM IN EXPANSION	OD	8.625"	0°	.250"	.005"	.014"	38 %TW
R	CI EDM IN EXPANSION	OD	8.625"	180°	.250"	.005"	.014"	38 %TW
S	DENT	OD	12.250"	0°	.063"	.420"	.003"	8 %TW
T1	FBH	OD	13.250"	0°	N/A	Ø.015"	.007"	19 %TW
T2	FBH	OD	13.250"	90°	N/A	Ø.016"	.008"	22 %TW
T3	FBH	OD	13.250"	180°	N/A	Ø.015"	.007"	19 %TW
T4	FBH	OD	13.250"	270°	N/A	Ø.015"	.007"	19 %TW
U	FBH	OD	14.000"	0°	N/A	Ø.093"	.014"	38 %TW
V	FBH	OD	14.750"	0°	N/A	Ø.080"	.021"	57 %TW
W	FBH	OD	15.500"	0°	N/A	Ø.063"	.028"	76 %TW
X	HOLE	OD	16.250"	0°	N/A	Ø.050"	THROUGH	100 %TW
AA	N/A	N/A	N/A	N/A	N/A	N/A	N/A	N/A
BB	WEAR & BROACHED TSP	OD	19.095"	120°	.690"	.124"	.010"	27 %TW
CC	WEAR & BROACHED TSP	OD	19.095"	240°	.690"	.124"	.021"	57 %TW
DD	GROOVE	OD	20.375"	ALL	.125"	N/A	.003"	8 %TW
EE	N/A	OD	N/A	N/A	N/A	N/A	N/A	N/A
FF	GROOVE	ID	23.000"	360°	.062"	N/A	.0075"	20 %TW

## NOTES:

1. THE MATERIAL HEAT NUMBER, HT 93500 LOT 5022, AND THE AS BUILT NUMBER, 1268321B, ARE ETCHED AT THE RIGHT TUBE END.
2. THIS STANDARD WAS MADE VIA PA 83-795437-02 AND FTI WO 8285, FROM DESIGN DRAWING 1268313D-1, FOR DUKE POWER COMPANY.
3. THE AS BUILT DIMENSIONS WERE OBTAINED FROM FTI SHOP DATA SHEETS AND QCIR 97-00769.
4. EACH FLAW IS CENTERED ABOUT THE SPECIFIED AXIAL AND AZIMUTHAL LOCATIONS.
5. THE DEPTHS IN PERCENT THROUGH WALL (%TW) ARE BASED UPON THE ACTUAL MEAN WALL THICKNESS (MWT) OF THE TUBING, .037".
6. WHEN THE STANDARD IS PLACED IN ITS HOLDER (1268314E-1), A DRILLED TUBE SUPPORT PLATE (TSP) SIMULATOR WILL BE CENTERED NEAR LOCATION EE. BROACHED TSP'S WILL BE CENTERED NEAR LOCATIONS AA AND BB/CC. WEAR PATCHES BB AND CC WILL BE LOCATED WITH TWO LAND REGIONS OF THEIR BROACHED TSP.

## PLANAR VIEW OF TUBE OD AND FLAWS

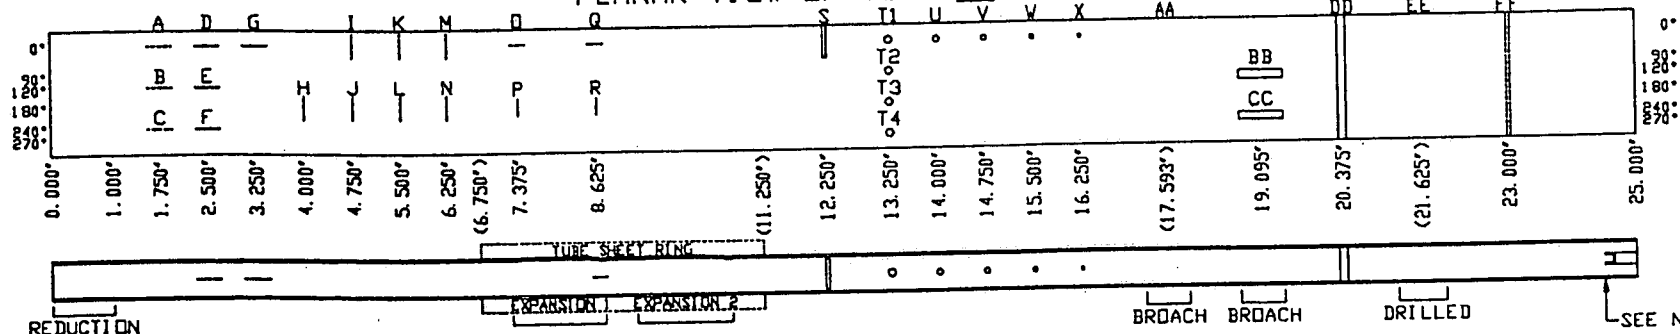

1

# OCONEE EDM/ASME/WEAR CALIBRATION STANDARD MAT'L: ASME SB-163 ALLOY 600, .629" OD, .554" ID, .037" WALL.

FILENAME: 1268321B.DWG  
 DISK No.: OPTICAL

THIS DRAWING/DOCUMENT IS THE PROPERTY OF FTI AND IS LOANED UPON THE CONDITION THAT IT IS NOT TO BE REPRODUCED OR COPIED, IN WHOLE OR IN PART, OR USED FOR FURNISHING INFORMATION TO OTHERS, OR FOR ANY OTHER PURPOSE DETRIMENTAL TO THE INTEREST OF FTI AND IS TO BE RETURNED UPON REQUEST. DO NOT SCALE - USE DIMENSIONS ONLY.

DESIGNED BY: [Signature]  
 CHECKED BY: [Signature]  
 APPROVED BY: [Signature]

OCONEE EDM/ASME/WEAR CALIBRATION  
 STANDARD AS BUILT DRAWING

SCALE: 1/2  
 DATE: 08/09/97  
 DOC NO.: 1268321B-0

22139 (12/95)

1268319B

DN 9A0

FRAMATOME  
TECHNOLOGIES

REVISIONS


REV DESCRIPTION DATE APPROVAL

FLAW LABEL	FLAW DESCRIPTION	SURFACE OF ORIGIN	AXIAL LOCATION	AZIMUTHAL LOCATION	LENGTH ±.000/±.010	WIDTH OR DIAMETER	DEPTH IN INCHES	DEPTH IN %TW
A	AX EDM	ID	1.750"	0°	.375"	.005"	.022"	60 %TW
B	AX EDM	ID	1.750"	120°	.375"	.005"	.015"	41 %TW
C	AX EDM	ID	1.750"	240°	.375"	.005"	.0075"	20 %TW
D	AX EDM	OD	2.500"	0°	.375"	.005"	.021"	57 %TW
E	AX EDM	OD	2.500"	120°	.375"	.005"	.014"	38 %TW
F	AX EDM	OD	2.500"	240°	.375"	.005"	.007"	19 %TW
G	AX EDM	OD	3.250"	0°	.375"	.006"	THROUGH	100 %TW
H	CI EDM	OD	4.000"	180°	.375"	.005"	THROUGH	100 %TW
I	CI EDM	ID	4.750"	0°	.375"	.006"	.022"	60 %TW
J	CI EDM	OD	4.750"	180°	.375"	.005"	.014"	38 %TW
K	CI EDM	ID	5.500"	0°	.375"	.005"	.015"	41 %TW
L	CI EDM	OD	5.500"	180°	.375"	.005"	.015"	41 %TW
M	CI EDM	ID	6.250"	0°	.375"	.005"	.0075"	20 %TW
N	CI EDM	OD	6.250"	180°	.375"	.005"	.0075"	19 %TW
O	AX EDM IN EXPANSION	ID	7.375"	0°	.250"	.005"	.015"	41 %TW
P	CI EDM IN EXPANSION	ID	7.375"	180°	.250"	.005"	.015"	41 %TW
Q	AX EDM IN EXPANSION	OD	8.625"	0°	.250"	.004"	.014"	38 %TW
R	CI EDM IN EXPANSION	OD	8.625"	180°	.250"	.006"	.015"	41 %TW
S	DENT	OD	12.250"	0°	.062"	.400"	.004"	11 %TW
T1	FBH	OD	13.250"	0°	N/A	Ø.015"	.007"	19 %TW
T2	FBH	OD	13.250"	90°	N/A	Ø.016"	.007"	19 %TW
T3	FBH	OD	13.250"	180°	N/A	Ø.015"	.007"	19 %TW
T4	FBH	OD	13.250"	270°	N/A	Ø.015"	.006"	16 %TW
U	FBH	OD	14.000"	0°	N/A	Ø.093"	.014"	38 %TW
V	FBH	OD	14.750"	0°	N/A	Ø.079"	.021"	57 %TW
W	FBH	OD	15.500"	0°	N/A	Ø.061"	.028"	76 %TW
X	HOLE	OD	16.250"	0°	N/A	Ø.050"	THROUGH	100 %TW
AA	N/A	N/A	N/A	N/A	N/A	N/A	N/A	N/A
BB	WEAR & BROACHED TSP	OD	19.093"	120°	.689"	.125"	.010"	27 %TW
CC	WEAR & BROACHED TSP	OD	19.093"	240°	.691"	.125"	.023"	62 %TW
DD	GROOVE	OD	20.380"	ALL	.124"	N/A	.003"	8 %TW
EE	N/A	OD	N/A	N/A	N/A	N/A	N/A	N/A
FF	GROOVE	ID	23.000"	360°	.062"	N/A	.0075"	20 %TW

## NOTES:

1. THE MATERIAL HEAT NUMBER, HT 93500 LOT 5022, AND THE AS BUILT NUMBER, 1268319B, ARE ETCHED AT THE RIGHT TUBE END.
2. THIS STANDARD WAS MADE VIA PA 83-795437-02 AND FTI WD 8285, FROM DESIGN DRAWING 1268313D-1, FOR DUKE POWER COMPANY.
3. THE AS BUILT DIMENSIONS WERE OBTAINED FROM FTI SHOP DATA SHEETS AND QCIR 97-00769.
4. EACH FLAW IS CENTERED ABOUT THE SPECIFIED AXIAL AND AZIMUTHAL LOCATIONS.
5. THE DEPTHS IN PERCENT THROUGH WALL (%TW) ARE BASED UPON THE ACTUAL MEAN WALL THICKNESS (MWT) OF THE TUBING, .037".
6. WHEN THE STANDARD IS PLACED IN ITS HOLDER (1268314E-1), A DRILLED TUBE SUPPORT PLATE (TSP) SIMULATOR WILL BE CENTERED NEAR LOCATION EE. BROACHED TSP'S WILL BE CENTERED NEAR LOCATIONS AA AND BB/CC. WEAR PATCHES BB AND CC WILL BE LOCATED WITH TWO LAND REGIONS OF THEIR BROACHED TSP.

## PLANAR VIEW OF TUBE OD AND FLAWS

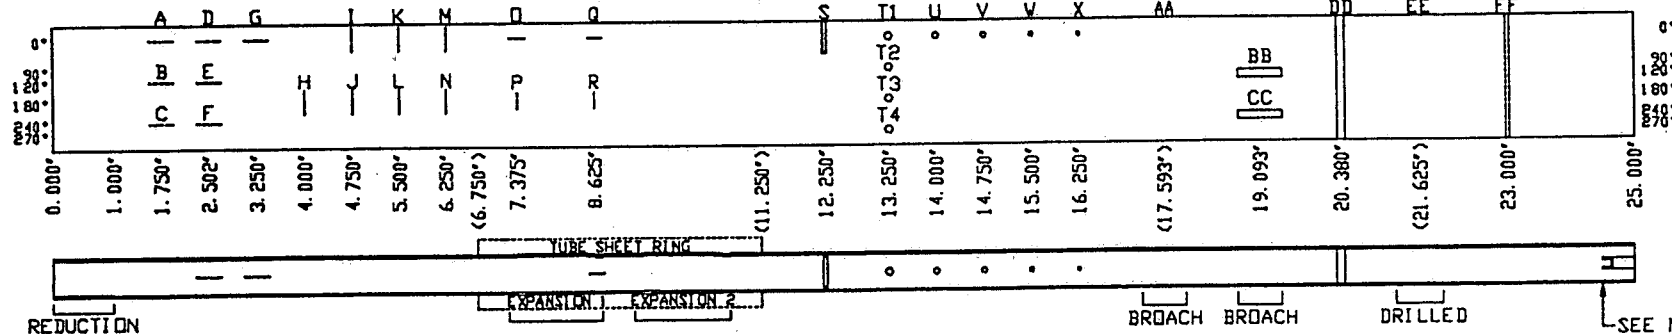

1

OCONEE EDM/ASME/WEAR CALIBRATION STANDARD  
MAT'L: ASME SB-163 ALLOY 600, .630" OD, .554" ID, .037" WALL.FILENAME: 1268319B.DWG  
DISK No.: OPTICAL

THIS DRAWING/DOCUMENT IS THE PROPERTY OF FTI AND IS LOANED UPON THE CONDITION THAT IT IS NOT TO BE REPRODUCED OR COPIED, IN WHOLE OR IN PART, OR USED FOR FURNISHING INFORMATION TO OTHERS, OR FOR ANY OTHER PURPOSE RETRIBUTAL TO THE INTEREST OF FTI AND IS TO BE RETURNED UPON REQUEST. DO NOT SCALE - USE DIMENSIONS ONLY.

DRAWN BY: [Signature] CHECKED BY: [Signature]  
PASSED BY: [Signature] APPROVED BY: [Signature]OCONEE EDM/ASME/WEAR CALIBRATION  
STANDARD AS BUILT DRAWINGSCALE: 1/2 DATE: 09/09/97  
DWG NO: 1268319B-0

22159 (12/95)

1268320B

DN 048



## REVISIONS


REV	DESCRIPTION	DATE	APPROVAL

FLAW LABEL	FLAW DESCRIPTION	SURFACE OF ORIGIN	AXIAL LOCATION	AZIMUTHAL LOCATION	LENGTH IN. 0.001 IN. 0.010	WIDTH OR DIAMETER	DEPTH IN INCHES	DEPTH IN %TW
A	AX EDM	ID	1.750°	0°	.375°	.006°	.022°	60 %TW
B	AX EDM	ID	1.750°	120°	.375°	.005°	.015°	41 %TW
C	AX EDM	ID	1.750°	240°	.375°	.005°	.0075°	20 %TW
D	AX EDM	OD	2.500°	0°	.375°	.005°	.022°	60 %TW
E	AX EDM	OD	2.500°	120°	.375°	.005°	.015°	41 %TW
F	AX EDM	OD	2.500°	240°	.375°	.004°	.007°	19 %TW
G	AX EDM	OD	3.250°	0°	.375°	.005°	THROUGH	100 %TW
H	CI EDM	OD	4.000°	180°	.375°	.006°	THROUGH	100 %TW
I	CI EDM	ID	4.750°	0°	.375°	.006°	.022°	60 %TW
J	CI EDM	OD	4.750°	180°	.375°	.005°	.0205°	55 %TW
K	CI EDM	ID	5.500°	0°	.375°	.005°	.015°	41 %TW
L	CI EDM	OD	5.500°	180°	.375°	.005°	.014°	38 %TW
M	CI EDM	ID	6.250°	0°	.375°	.005°	.0075°	20 %TW
N	CI EDM	OD	6.250°	180°	.375°	.004°	.007°	19 %TW
O	AX EDM IN EXPANSION	ID	7.375°	0°	.250°	.005°	.015°	41 %TW
P	CI EDM IN EXPANSION	ID	7.375°	180°	.250°	.005°	.015°	41 %TW
Q	AX EDM IN EXPANSION	OD	8.625°	0°	.250°	.004°	.013°	35 %TW
R	CI EDM IN EXPANSION	OD	8.625°	180°	.250°	.005°	.014°	38 %TW
S	DENT	OD	12.250°	0°	.062°	.400°	.003°	N/A
T1	FBH	OD	13.250°	0°	N/A	Ø.115°	.007°	19 %TW
T2	FBH	OD	13.250°	90°	N/A	Ø.116°	.007°	19 %TW
T3	FBH	OD	13.250°	180°	N/A	Ø.115°	.007°	19 %TW
T4	FBH	OD	13.250°	270°	N/A	Ø.115°	.007°	19 %TW
U	FBH	OD	14.002°	0°	N/A	Ø.092°	.014°	38 %TW
V	FBH	OD	14.750°	0°	N/A	Ø.077°	.022°	60 %TW
W	FBH	OD	15.500°	0°	N/A	Ø.061°	.028°	76 %TW
X	HOLE	OD	16.252°	0°	N/A	Ø.050°	THROUGH	100 %TW
AA	N/A	N/A	N/A	N/A	N/A	N/A	N/A	N/A
BB	WEAR & BROACHED TSP	OD	19.095°	120°	.689°	.125°	.012°	32 %TW
CC	WEAR & BROACHED TSP	OD	19.095°	240°	.690°	.125°	.023°	62 %TW
DD	GROOVE	OD	20.375°	ALL	.125°	.125°	N/A	8 %TW
EE	N/A	OD	N/A	N/A	N/A	N/A	N/A	N/A
FF	GROOVE	ID	23.000°	360°	.062°	N/A	.0075°	20 %TW

## NOTES:

1. THE MATERIAL HEAT NUMBER, HT 93500 LOT 5022, AND THE AS BUILT NUMBER, 1268320B, ARE ETCHED AT THE RIGHT TUBE END.
2. THIS STANDARD WAS MADE VIA PA 83-795437-02 AND FTI WD 8285, FROM DESIGN DRAWING 1268313D-1, FOR DUKE POWER COMPANY.
3. THE AS BUILT DIMENSIONS WERE OBTAINED FROM FTI SHOP DATA SHEETS AND QCIR 97-00769.
4. EACH FLAW IS CENTERED ABOUT THE SPECIFIED AXIAL AND AZIMUTHAL LOCATIONS.
5. THE DEPTHS IN PERCENT THROUGH WALL (%TW) ARE BASED UPON THE ACTUAL MEAN WALL THICKNESS (MWT) OF THE TUBING, .037".
6. WHEN THE STANDARD IS PLACED IN ITS HOLDER (1268314E-1), A DRILLED TUBE SUPPORT PLATE (TSP) SIMULATOR WILL BE CENTERED NEAR LOCATION EE. BROACHED TSP'S WILL BE CENTERED NEAR LOCATIONS AA AND BB/CC. WEAR PATCHES BB AND CC WILL BE LOCATED WITH TWO LAND REGIONS OF THEIR BROACHED TSP.

## PLANAR VIEW OF TUBE OD AND FLAWS

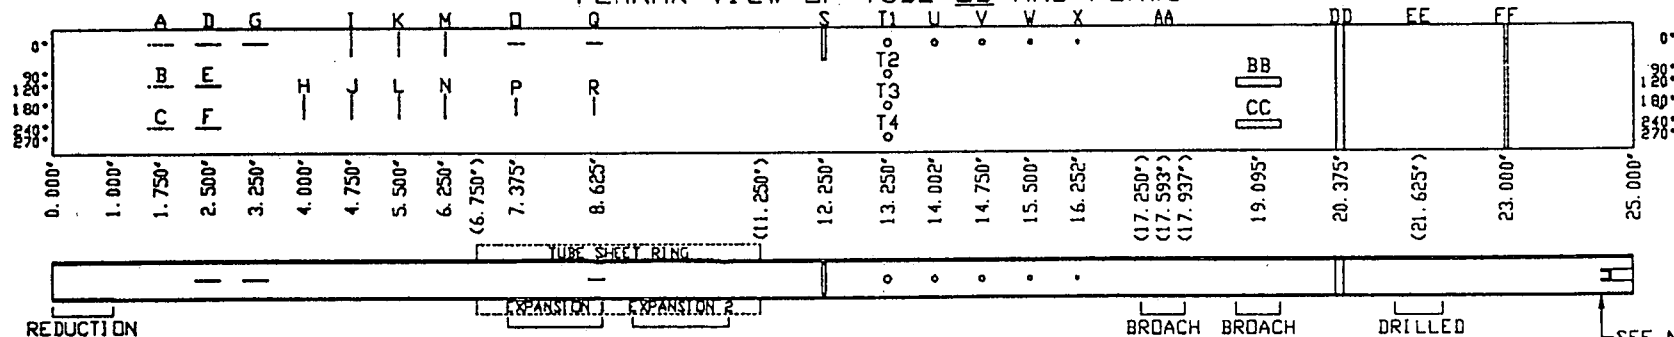

SEE NOTE 1

1

## OCONEE EDM/ASME/WEAR CALIBRATION STANDARD

MAT'L: ASME SB-103 ALLOY 600, .620" OD, .555" ID, .037" WALL.

 FILENAME: 1268320B.DWG  
 DISK No.: OPTICAL

THIS DRAWING/DOCUMENT IS THE PROPERTY OF FTI AND IS LOANED UPON THE CONDITION THAT IT IS NOT TO BE REPRODUCED OR COPIED, IN WHOLE OR IN PART, OR USED FOR FURNISHING INFORMATION TO OTHERS, OR FOR ANY OTHER PURPOSES, WITHOUT THE WRITTEN PERMISSION OF FTI. IT IS TO BE RETURNED UPON REQUEST. DO NOT SCALE - USE DIMENSIONS ONLY.

 DRAWN BY: J. H. HARRIS  
 CHECKED BY: J. H. HARRIS  
 PASSED BY: J. H. HARRIS  
 DATE: 09/09/97

 OCONEE EDM/ASME/WEAR CALIBRATION  
 STANDARD AS BUILT DRAWING

 SCALE: 1/2  
 DATE: 09/09/97  
 DWG NO: 1268320B-0

82159 (12/93)

ATTACHMENT 4

OPTICAL DISK WITH EDDY CURRENT DATA