


# SRM/IRM COMPUTER OUTPUTS

GENERAL ELECTRIC  
START UP RANGE NEUTRON MON. SYS.

## COMPUTER INPUTS

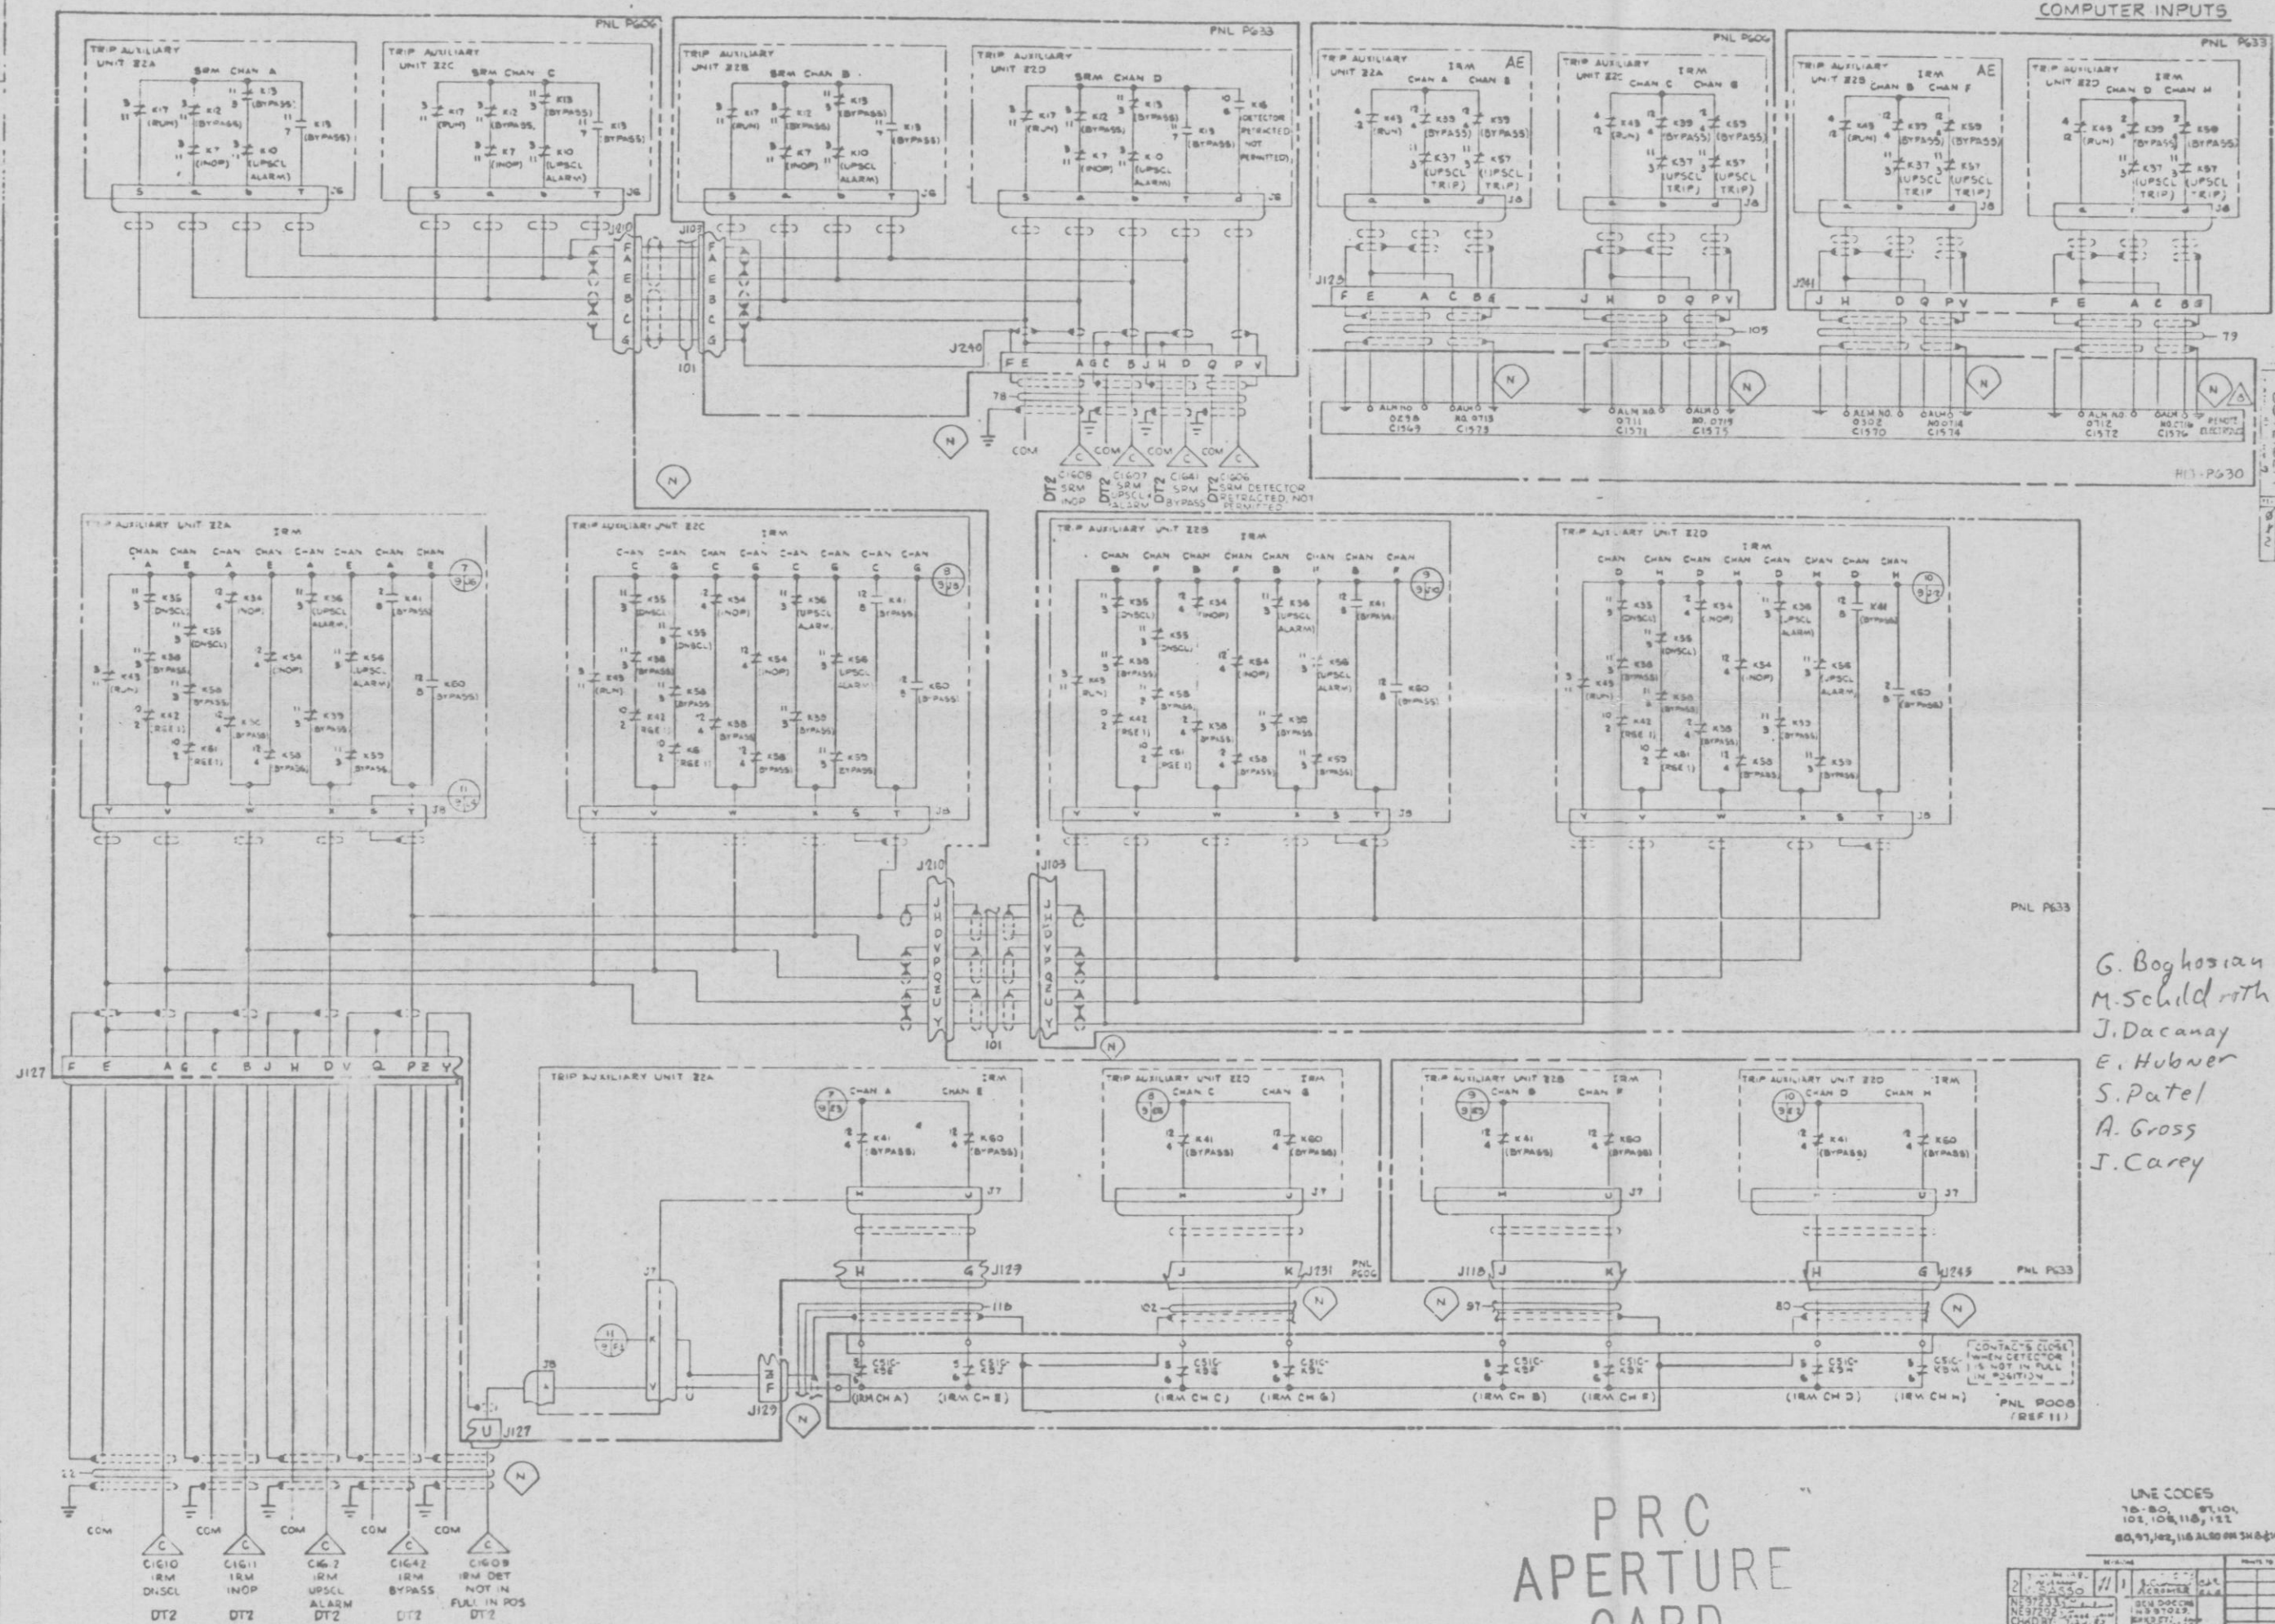

PRC  
APERTURE  
CARD

G. Boghosian  
M. Schilder  
J. Dacanay  
E. Hubner  
S. Patel  
A. Gross  
J. Carey

STONE & WEBSTER ENGINEERING CORPORATION		MANUFACTURER'S DRAWING DATA FORM	
NINE MILE POINT NUCLEAR STATION - UNIT 2 NIAGARA MOHAWK POWER CORPORATION		RESP. ENG. J. CAREY (E1)	
INSTRUCTIONS TO SUPPLIER (E2)		RESP. DES. ENG. C. LANE (E1)	
APPROVED AS NOTED		APPROVED AS DEFINED IN SPECIFICATION	
APPROVED AS REVISED		RELEASED FOR FABRICATION	
RELEASED FOR MATERIAL PURCHASE		INSTRUCTIONS TO DESIGN (E1)	
SUPPLIER TO RESUBMIT		I-O INFORMATION ONLY	
REVISED PRINTS		P-L PRELIMINARY LAYOUT	
REVISED MICROFILM		P-S PRODUCTION STUDIES	
APERTURE CARDS		R-C REVIEW AND COMMENT	
FOR REVIEW		F-D FINAL DETAILS	
FOR RECORD		NEW NEW	
NONE REQUIRED		REV REVISED	
NOTES:		DATE TO DESIGN (C) 2-27-81	
(E1) FOR INFORMATION ONLY		REQUIRED RETURN DATE (E1)	
RETURN TO SUPPLIER NOT REQUIRED		DESIGN ENGINEER'S DATE STAMP (D)	
INSTRUCTIONS TO DESIGN (CONCISELY)		IN: NOTED MAR 3 1981 C.A. LANE	
DESIGN ENGINEER'S DATE STAMP (D)		DESIGN GROUP ROUTING (D)	
OUT: NOTED APR 2 6 1981 J.D. CAREY		ROUTE	
INITIALS OF SELECTED REVIEWERS		REQUIRED PRINT MAC **	
RESPONSIBLE ENGINEER'S DATE STAMP (E2)		ARCHITECTURE	
NOTED APR 2 6 1981 J.D. CAREY		CIVIL	
SUPERSEDES S&W FILE NO. (E1) 120-341 (120-341)		CONCRETE	
REMARKS (C) (LIMIT TO 20 CHARACTERS & BLANKS) (53-74)		STEEL	
T-1076		BUILDING SERVICE	
S&W EQUIP. ID. CODE (E1) 120-341 (120-341)		INSTRUMENT	
AREA DESIGNATION CODES (E1) 75-80		MECHANICAL	
2NMS1		PIPE SUPPORT	
MFR'S. DWG. NO. (C) (LIMIT TO 24 CHARACTERS & BLANKS) (27-60)		STRESS	
BOTEIG2TY SH 9		MACHINE DESIGN/VESSEL	
MFR'S. NAME (C) (LIMIT TO 20 CHARACTERS & BLANKS) (81-80)		ELECTRICAL	
GENERAL ELECTRIC		LIGHTING	
DATE MONTH DAY YEAR (1981-2000) (21-24)		MODEL SHOP	
NOTED MAR 3 1981 C.A. LANE		EXTENSION OFFICE	
FUNCTIONAL TITLE (E1) (LIMIT TO 30 CHARACTERS & BLANKS) (81-80)		CONTROL	
START UP RANGE NEUTRON MON. SYS. REV. 2		(C) PROJECT CLERK	
S&W FILE NO. (E1) (11-20) (21-24)		(C) RESP. DESIGN ENGINEER	
12177 100		(E1) RESP. ENGINEER - ON DWS RECEIPT	
JOB ORDER NO. 12177 100		(E2) RESP. ENGINEER - AFTER DWS REVIEW	
		MAC-MICROFILM APERTURE CARD	
		R&W-REVIEWER INITIALS	

ATTACH TO MFR'S. DRAWING