



POOR ORIGINAL

A TRAIN

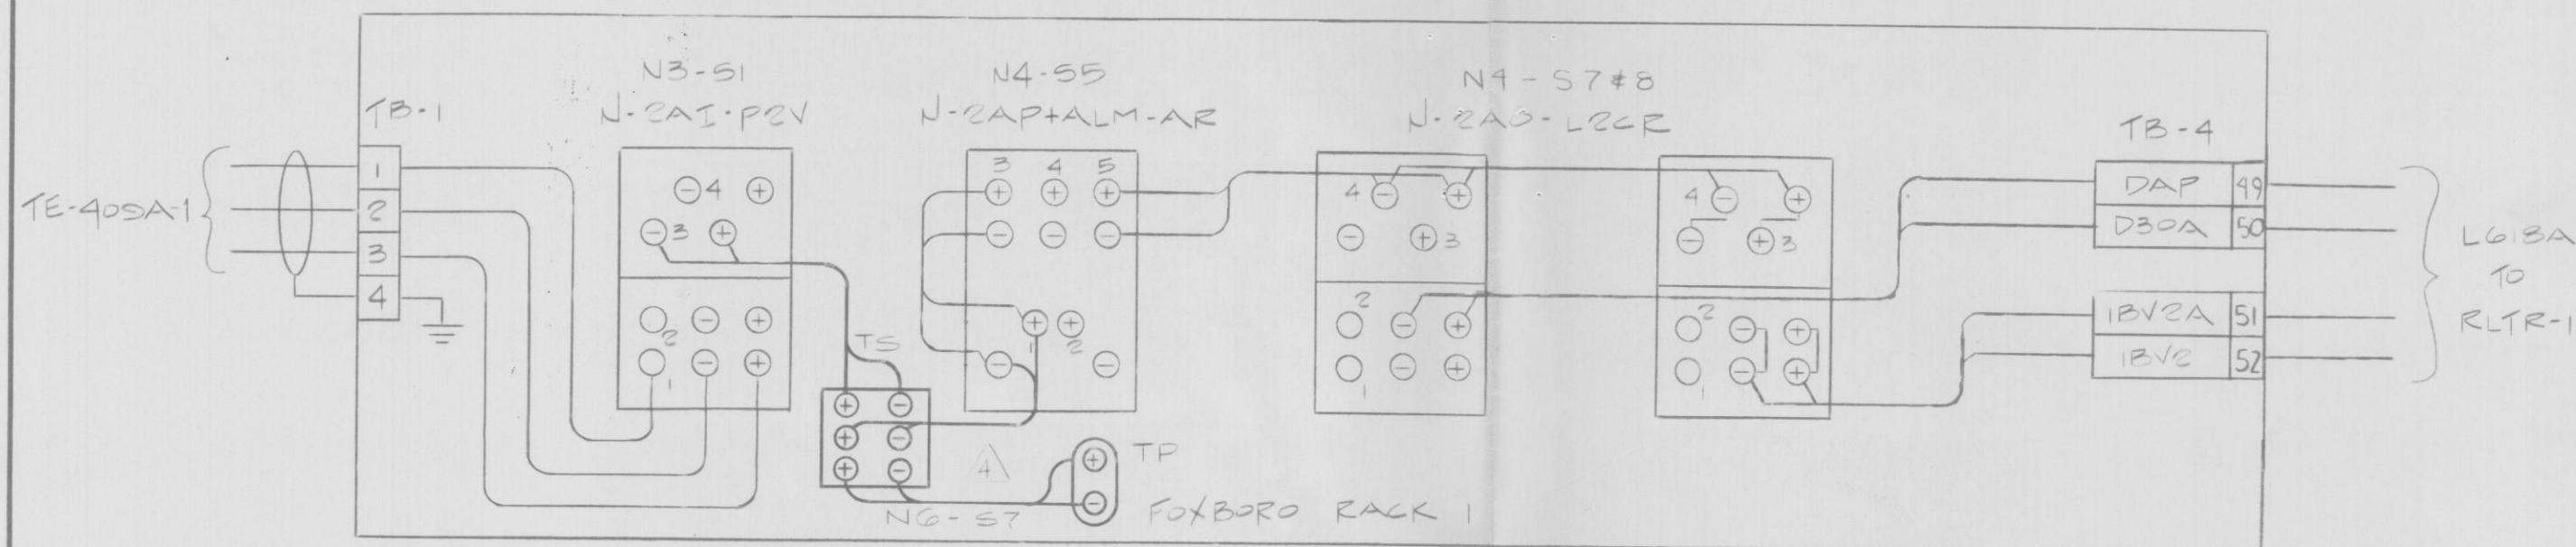

B TRAIN

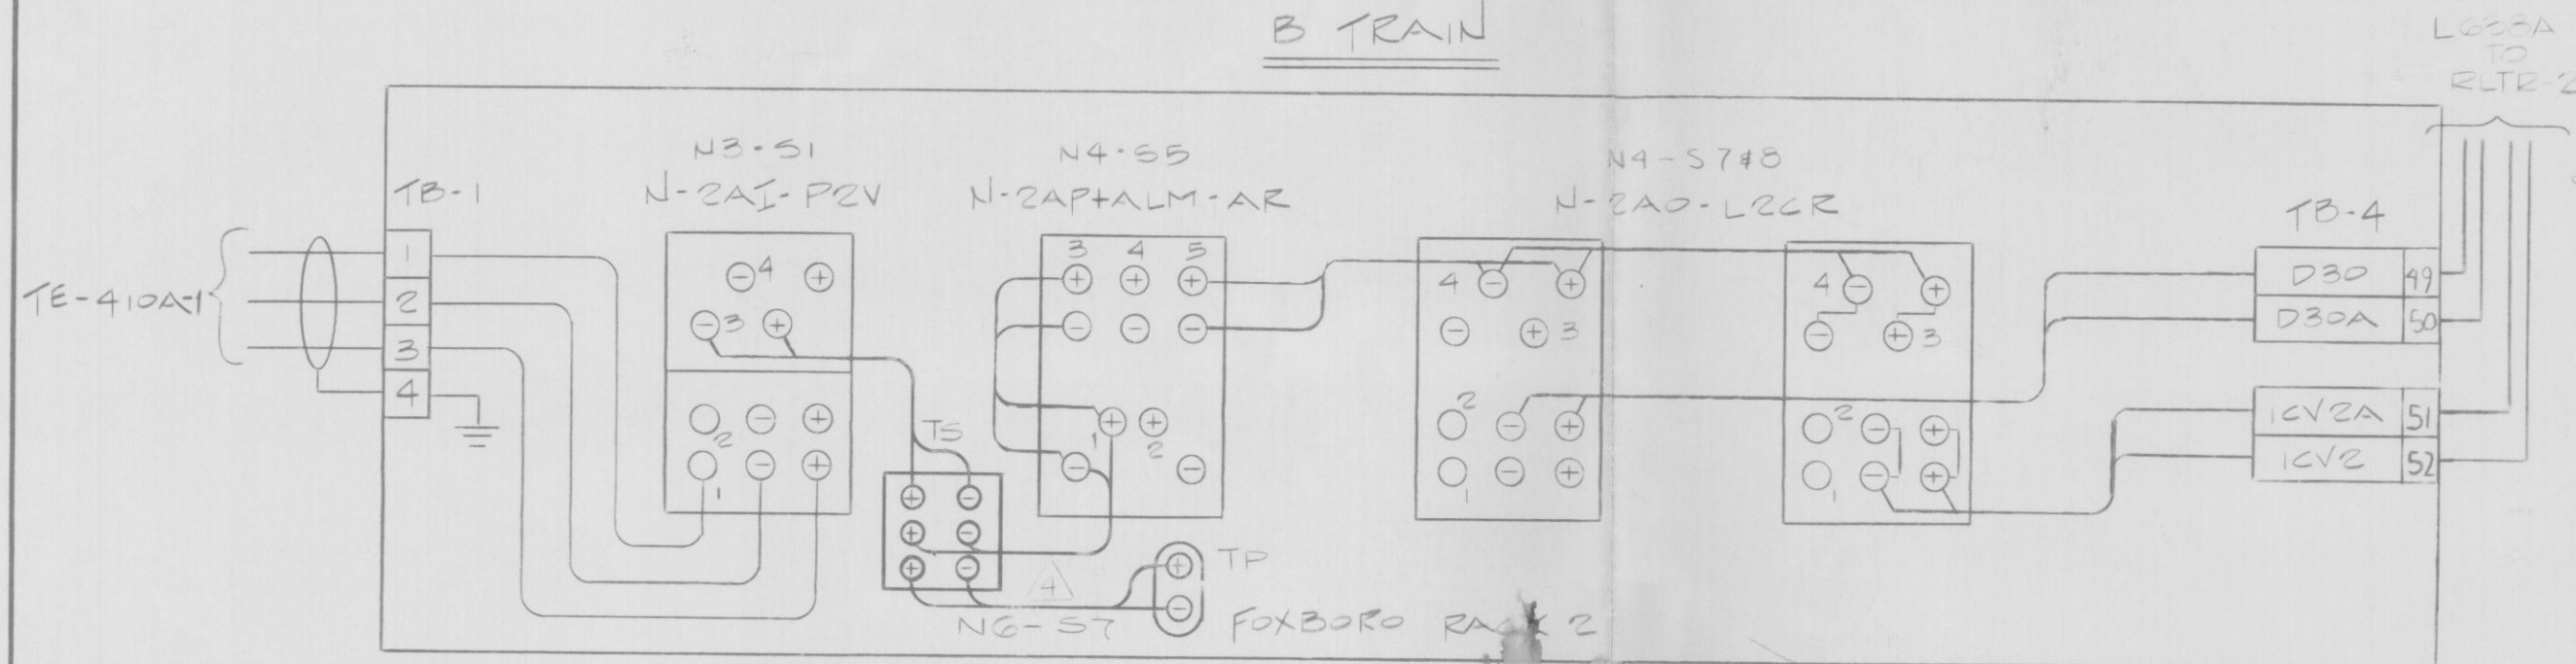

TS - TEST SWITCH  
TP - TEST POINT

NOTE

JUST N-2AP+ALM-AR  
(S) TO 500 OF

Docket # 86-244  
Control # 8605210230  
Date 5/15/86 of Document  
REGULATORY DOCKET FILE

TI  
APERTURE  
CARD

8605210230

ZIRCONIUM GUIDE TUBE INTERLOCK  
INTERNAL WIRING DETAIL

FACILITY	GINNA STATION	ROCHESTER GAS & ELECTRIC CORP. ROCHESTER, NEW YORK
	SCALE	
NONE		
JOB NO.	DRAWING NO.	REV.
EWR 2709	10904-205	5

GENERAL REVISION	DATE	INITIAL	REVISION	NUMBER
ADDED TEST SWITCHES & RECER (EWR 3698)	3/4/86	3-6-86		5
EWR 2707-AS NOTED	DGS	7/12/83		4
AS BUILT - EWR 2709	12-2-85	7-4-86		3
GEN. REVISION	RAB	7/12/83		2
ORIGINAL	DEL	4-2-81		1
	4/2/81	4-2-81		0