

CALCULATION LEAD SHEET

Lead Sheet, 1 of 2

PURPOSE

The purpose of the calculation is to demonstrate the structural adequacy of the subject against the given support loads.

REFERENCES

- 1.) LOADS ARE PER MEB-50 PHASE II PIPE ANALYSIS FOR ANCHOR GROUP 37 CALC. # 8.14.127C
- 2.) BURNS and ROE REFERENCE DRAWINGS, M200-105, 110, 117, 118 RHR-597, 975N, 238, 970N, 958N, 410 AND RCIC-912N HANGER DETAILS.

DESIGN REQUIREMENTS

The basic design requirements is that the support should comply with all the applicable requirements of the Project Criteria Document, Section I, and Specification 215, Section 15B, 15R and Contract drawing No. H-501 with one permissible deviation. Whenever necessary, it is allowed to exceed the stress limitations of Criteria Document as long as the corresponding stress limits imposed by the applicable Code are not violated.

CALC. PURPOSE

TO VERIFY THAT PIPE SUPPORTS ARE WITHIN DESIGN REQUIREMENTS FOR SUPPORT LOADS AS CALCULATED BY THE MEB-50 PIPE ANALYSIS. THE MEB-50 LOAD CASE IS FOR FAULTED DYNAMIC ADDED TO DEADWEIGHT AND THERMAL LOADS WHICH IS NOT A NORMALLY USED LOAD SUMMATION.

ASSUMPTIONS

None.

PROCEDURE

In general, the design evaluation of the support structure for the normal conditions is done using the basic theories of Engineering Mechanics.

8311080161 831028
PDR ADCK 05000397
E PDR

0-	Original Issue	FINAL	Ed Rando 10/20/83	W. H. Hodge 11/29/83	W. H. Hodge 11/27/82
Rev. No.	Description of Revision	Type (Prelim Design, Final Design, Study)	Originator Signature/Date	Checker Signature/Date	Approver Signature/Date

BURNS AND ROE, INC.
Headquarters Office—Oradell, N.J.

W.O. No. 3900-76 Date 10/20/83 Book No. 8.16.5012 Page No. _____
Drawing No. NONE Calc. No. 8.16.5037 Sheet 2 Cont. on Sheet 3
By Ed Kammor Checked T. L. L. L. Approved T. L. L. L.
Title MEB-50 PHASE II STUDY

Lead Sheet 2 of 2

employing computer programs whenever the complexity of the design warrants their use. The exact procedure adopted for the subject support is self-explanatory from the appended calculations.

COMPUTER INPUT/OUTPUT

The computer input/output sheets for this calculation are *included*.
as attachments to this calculation.

CONTENT**

- (a) Total number of pages in current calculation level 0. 89
(b) Total number of attachments in current calc. level 0. 7

CONCLUSIONS*

*ALL PIPE SUPPORTS WERE FOUND TO BE
WITHIN ACCEPTABLE DESIGN ALLOWABLES AND
REQUIREMENTS AS DESIGNED UNDER EXISTING
LOADS.*

W.O. No. 3900-76 Date 10/20/83 Book No. 816.507 Page No. _____
Drawing No. PLANE Calc. No. 816.5037 Sheet 3 Cont. on Sheet 4
By Ed Parnot Checked _____ Approved _____
Title MEB-50 STUDY

INDEX

PAGE(S)

ATTACHMENT(S)

RHR-597

4 to 8

RHR-238

9 to 26

'A'

RHR-958N

27 to 53

'C' PART I & II

RHR-410

54 to 69

'B'

RHR-970N

70 to 80

'D'

RHR-975N

81 to 85

'E'

RCIC-912N

86 to 89

'F'

BURNS AND ROE, INC.

Headquarters Office—Oradell, N.J.

W.O. No. 3900-76 Date 10/15/83 Book No. 8.16.2012 Page No.
 Drawing No. PHR-597 Calc. No. 8.16.5037 Sheer 4 Cont. on Sheet 5
 By Checked Approved
 Title WPPSS NP2 PIPE SUPPORT REVIEW/REDESIGN ~~PS MARK NO.~~

MEB-50 PHASE II
LOADS

LOAD CONDITIONS:

LOAD TYPE		POUNDS			POUNDS-FT.		
		Fx	Fy	Fz	Mx	My	Mz
Thermal							
Dead Wt.							
Misc.							
DYNAMIC LOADS	Normal						
	Emerg.						
	Faulted						
TOTAL LOADS	Normal						
	Emerg.						
	Faulted	±7630					
ORIGINAL SUPPORT DESIGN LOADS PER 8.16.2057 REV. 3	Normal	+5154 -4757					
	Emerg.	+5154 -4757					
	Faulted	+2969 -6635					

W.O. No. 3900-16 Date 10/6/73 Book No. 8.16.5017 Page No. 5
Drawing No. RHR-597 Calc. No. 8.16.5037 Sheet 5 Cont. on Sheet 6
By J. H. Rogers Checked H. K. Kuan 10/11/73 Approved _____
Title MEB-50 STUDY

THE MEB-50 ' STUDY CALCULATIONS ARE FOR A FAULTED LOAD CONDITION FOR WHICH STRUCTURAL OUT OF LOAD-PLANE FRAME ANALYSIS IS NOT REQUIRED. THIS BEING SO, THIS SUPPORT IS THEN A COLUMN ANALYSIS FOR THE SUPPORT LOAD AND THE OTHER MEMBER ARE ASSUMED NOT TO TAKE PRIMARY PIPE LOADING. THESE ARE THEN SECONDARY MEMBERS USED ONLY TO MAINTAIN FRAME STABILITY.

CONCLUSION: PER. THE CALCULATION PRESENTED HERE RHR-597 IS ACCEPTABLE FOR THE PHASE II FAULTED LOADS.

SUPPORT HARDWARE

Item 1 CLAMP 18" ϕ FIG 135A STOCK SIZE 1"x6"
C-C=2'8" W/1 1/8" ϕ BOLTS

$$D = \frac{C-C - \text{PIPE } \phi}{2} = \frac{32-18}{2} = 7"$$

PER CHART 'A' CLAMP IS ACCEPTABLE FOR 7900# NORMAL WITH A 1.8 FACTOR FOR FAULTED. $7.6 < 7.9(1.8)$ KIP

Item 3 FIG 350 SIZE 20 RIGID STRUT.

W.O. No. 3900-76 Date 11/5/83 Book No. 8.16.5037 Page No. 6
 Drawing No. RHP-597 Cont. No. 8.16.5037 Sheet 6 Cont. on Sheet 7
 By H.A. R. R. R. Checked 10/11/83 Approved _____
 Title NER-50 STUDY

PER. DESIGN GUIDE SECTION 411-196
 RIGID HAS MAX FAULTED LOAD OF
 12 KIPS AT A LENGTH OF 54" OR LESS.

$$12 \text{ KIP} > 7.6 \text{ KIP} / 2$$

AS THE RIGIDS ARE ON HORIZONTAL PIPE
 AND THERE IS TWO RIGIDS ONE ON EACH
 SIDE ASSUME EACH HAS HALF THE SUPPORT LOAD

STRESS CHECK

CHECK WELD BEAM BRACKETS FOR RIGID STRUT
 IECM 3 to 7 AND 8

2 9/16"
 2 1/2"

$$A_w = 2(2 1/2) = 5" \text{ LENGTH OF WELD.}$$

$$P = 7630 \# / 2 = 3815 \#$$

$$f_t = \frac{P}{A_w} = \frac{3815}{5} = 763 \# / \text{in}$$

$$w = \frac{f_t}{f_{fil}} = \frac{763}{0.87(27000)} = 0.040" < 1/4" \text{ WELD LEG}$$


↑ FOR EFFECTIVE THROAT OF FILLET WELD

∴ WELD IS ACCEPTABLE

W.O. No. 3900-76 Date 1/15/83 Book No. 8.16.5037 Page No. 7
Drawing No. RHR-597 Calc. No. 8.16.5037 Sheet 7 Cont. on Sheet 8
By J. A. [signature] Checked [signature] 1/11/83 Approved _____
Title MEB-50 STUDY

AS ALL OTHER WELDS IN COLUMNS HAVE
EQUAL OR GREATER WELDS LENGTHS ALL
WELDS ARE ACCEPTABLE.

MEMBERS

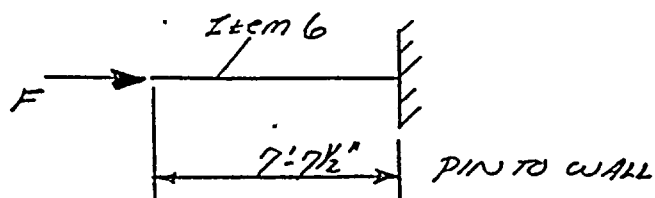

M4X13 $r = 0.939$ in

$A = 3.81$

$$\sigma_L = \frac{P}{A} = \frac{3815}{3.81}$$

$= 10 \text{ KSI}$

@ $KL/r = 200$

$F_a = 3.93 \text{ KSI} >> 1. \text{ KSI}$

\therefore ACCEPTABLE

$$\frac{KL}{r} = \frac{2.1(91.5)}{0.939}$$

$= 205 > 200$

THIS IS OVER 200
BUT AS THE BRACING OF
THIS SUPPORT (SECONDARY
MEMBER) WOULD CUT THE
UNBRACED LENGTH DOWN
TO 5' AND AS MEMBER
IS ACCEPTABLE FOR KL/r
OF 200 NO FURTHER
CALCULATIONS ARE REQUIRED

LUG CALCULATIONS

THERE IS FOUR LUGS PER SIDE OF
CLAMP \therefore LOAD PER LUG IS:

$$\frac{7630}{4} = 1910 \text{ \# per LUG}$$

RHR-(20)-2. SCH. 30 PIPE SA106

BURNS AND ROE, INC.

Headquarters Office—Oradell, N.J.

W.O. No. 3900-76 Date 10/5/83 Book No. 8-16-5012 Page No.
 Drawing No. KHP-597 Calc. No. 8-16-5037 Sheet 8 Cont. on Sheet 9
 By Checked 10/11/83 Approved
 Title WPPSS NP-2 Pipe Support Review/Redesign


TYPICAL BASEPLATE CALCULATION FORM

Baseplate Item No. 4 ☐ New Baseplate
 STRUDL Joint No. N/A ☒ As-Built Baseplate
☐ Field Modified Baseplate
 Baseplate Size R 3/4 x 9" x 9" Stiffener Size N/A
 Size of Attachment and Eccentricity M 4 x 12 N/A
 Number, Size and Type of Anchor Bolts (4) 3/4" x 4-1/2"

Maximum Support Loading

Normal, Faulted } Circle
 Emergency, Hydro } One

Fx 0 Mx 0
 Fy 0 My 0
 Fz 3.815 (Pullout) Mz 0 (Torsion)

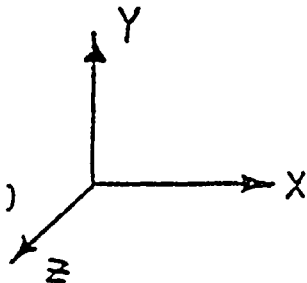

Comparison is made to Typical Baseplate ST 412

$$I_t = \left\{ \left[\frac{3.82}{8.4} \right] + \left[\text{---} \right] + \left[\text{---} \right] \right\} = 0.45$$

$$I_s = \sqrt{\left[\text{---} + \text{---} \right]^2 + \left[\text{---} + \text{---} \right]^2} = \text{---}$$

$$I_{\text{Total}} = \left[I_t^{4/3} + I_s^{4/3} \right]^{3/4} = 0.45 \leq 0.9 \text{ or } \leq 0.75 \text{ New plate with HDI}$$

Comments:

☒ Baseplate is Qualified

W.O. No. 3900-76 Date 10/20/83 Book No. 8, 105012 Page No. 10
Drawing No. RHP-238 Calc No. 8.16.5037 Sheet 89 Cont. on Sheet 10
By L.A. Pines Checked E. Kames Approved _____
Title MEB-50 STUDY PHASE II PS-MARS-NO.

LOAD CONDITIONS:

DESIGN LOADS

LOAD TYPE		POUNDS			POUNDS-FT.		
		Fx	Fy	Fz	Mx	My	Mz
Thermal	+	880	510	2079	9883	634	2567
	-	-118	-421	-3492	-25419	-585	-1902
Dead Wt.		-111	3977	241	-3561	-394	315
Misc.							
DYNAMIC LOADS	Normal	±2880	±4515	±3455	±25916	±5867	±20621
	Emerg.	±2883	±4515	±3456	±25916	±5871	±20030
	Faulted	±5702	±8935	±6869	±51494	±11636	±39761
TOTAL LOADS	Normal	EACH LOAD CASE FOR ANCHORS IS INPUTED SEPERATELY INTO THE STRUDL COMPUTER PROGRAM AND THEN THE REACTIONS ARE TOTALED DUE TO THE COMPLEXITY OF LOAD CONDITIONS AND SUPPORT STRUCTURES					
	Emerg.						
	Faulted						


W.O. No. 3900-76 Date 7-6-63 Book No. 8.16.012 Page No.
Drawing No. RHR-238 Calc. No. 8.16.5077 Sheet 10 Cont. on Sheet 11
By E. Kamo Checked SAK. Green Approved
Title WDPSS WP2 PIPE SUPPORT REVIEW/REDESIGN PS-MARK No.

LOAD CONDITIONS: * MEB-50 PHASE II LOADS.

LOAD TYPE		POUNDS			POUNDS-FT.		
		Fx	Fy	Fz	Mx	My	Mz
Thermal							
Dead Wt.							
Misc.							
DYNAMIC LOADS	Normal						
	Emerg.						
	Faulted						
TOTAL LOADS	Normal						
	Emerg.						
	* Faulted	4981	13288	8349	55599	7631	37257
ORIGINAL SUPPORT DESIGN LOADS	Normal						
	Emerg.						
	Faulted						

W.O. No. 3900-76 Date 11-83 Book No. 8.16.501 Page No.
Drawing No. RHR-238 Calc. No. 8.16.5037 Sheet 11 Cont. on Sheet 12
By Edmond Checked St. Rodgers Approved
Title HEB-50 STUDY

COMPUTER MODEL

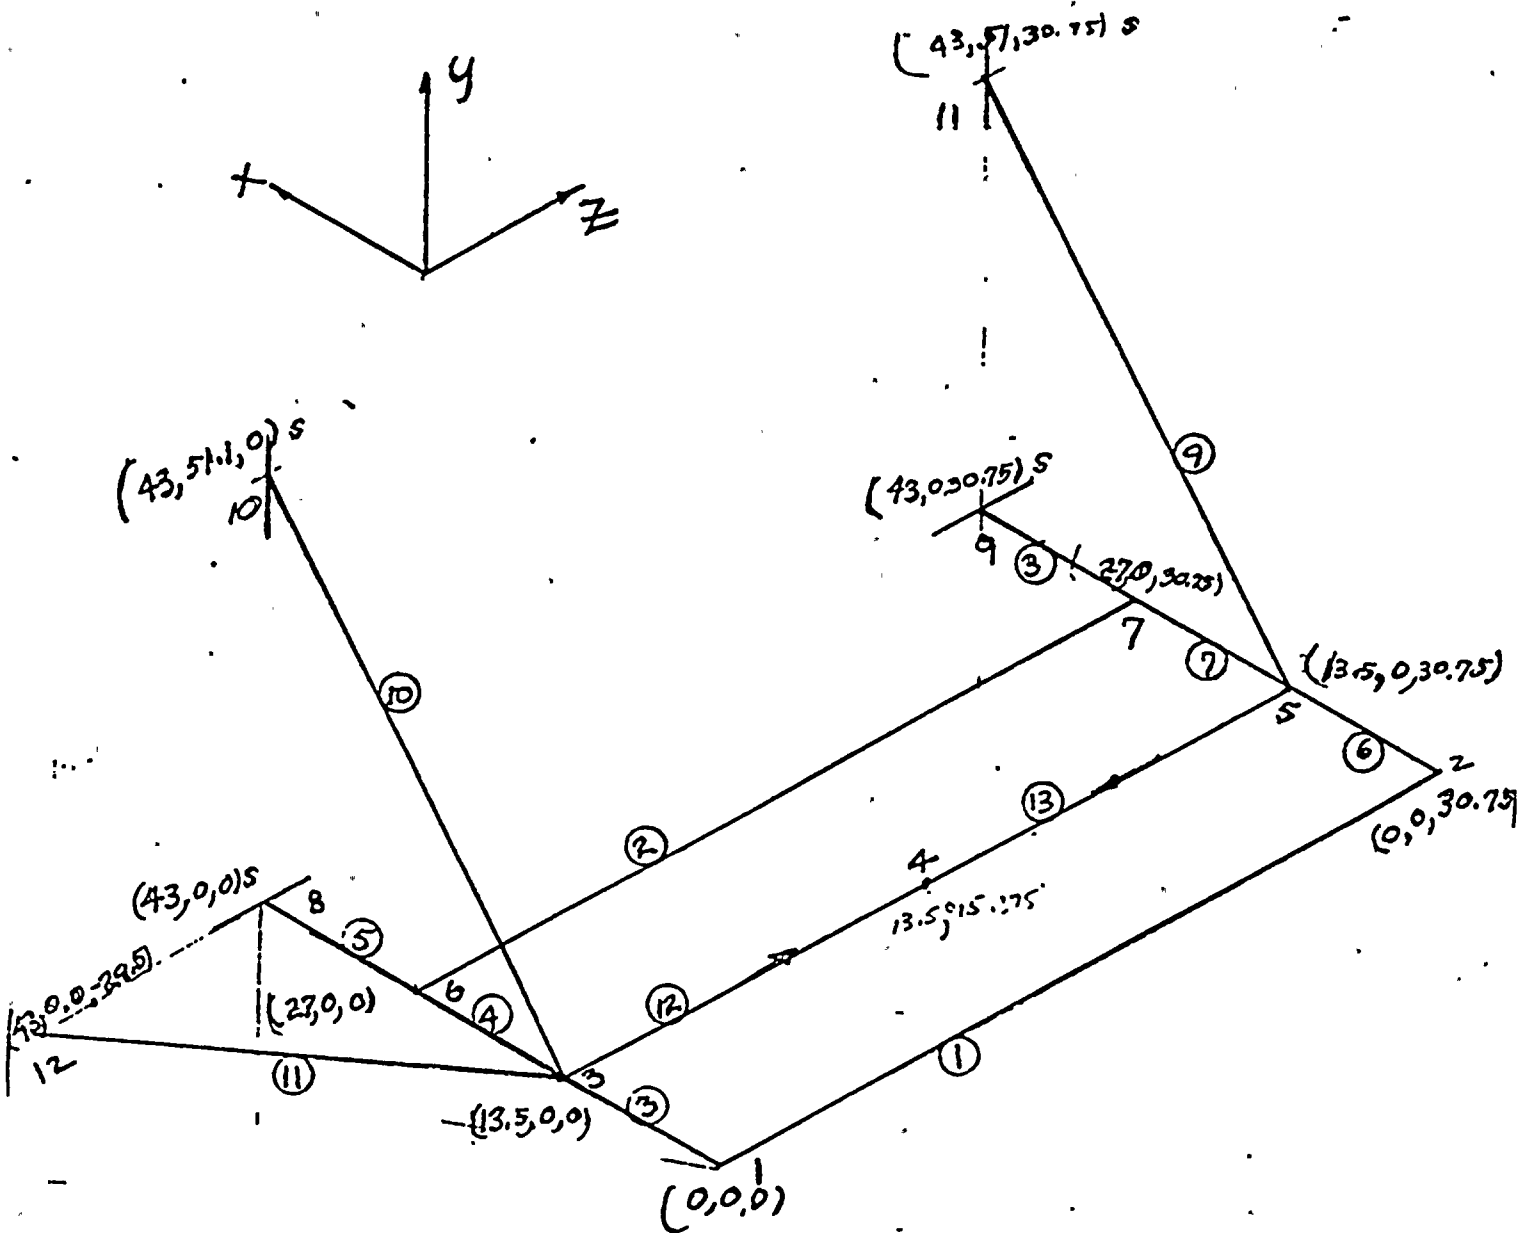

REFERENCE STRUDL RUN NO. 664 DATED 10-11-83
 SEE ATTACH. 'A'

MAXIMUM ABSOLUTE SUMMATIONS OF MEB-50 PHASE
 II LOADS ARE PERFORMED BY STRUDL COMMAND -
 GENERATE 'PKMEB50'.

MEMBER STRESSES:

BY INSPECTION OF STRUDL OUTPUT PAGES 27 TO 31,
 MAXIMUM NORMAL MEMBER STRESS OCCURS IN STRUDL
 MEMBER NO. 7 AT JOINT NO. 5.

$$\sigma_{max.} = 30,400 \text{ PSI}$$

$$\sigma_{allow.} = 40,600 \text{ PSI (PER DESIGN GUIDE M402, PG. 3)}$$

CHECK CRITICAL BUCKLING:

BY INSPECTION OF STRUDL PAGES 4 & 5, CRITICAL
 MEMBER LENGTHS ARE FOR MEMBERS NO.
 9, 10 & 11.

BY COMPARISON OF MEMBER LENGTHS, SIZES
 AND AXIAL FORCES (PER STRUDL OUTPUT PAGES
 NO. 22 & 23), MEMBER NO. 10 IS CRITICAL.

$$\text{SLENDERNESS RATIO: } \frac{KL}{r} = \frac{1.2(56.85)}{1.45} = 47$$

ALLOWABLE COMPRESSIVE STRESS: $F_a = 21.33 \text{ KSI}$,
 (PER AISC APPENDIX A, PAGE 5-85, TABLE 1-42)
 THIS IS NORMAL ALLOWABLE STRESS AND IS CONSERVATIVE.
 MAXIMUM AXIAL FORCE = 37,662 # (STRUDL PG. 23)
 MEMBER SIZE = TS4x4x.375 $\Rightarrow A = 5.08 \text{ in}^2$
 $f_a = \frac{37662 \#}{5.08 \text{ in}^2} = 7414 \text{ PSI}$

$$\frac{f_a}{F_a} = \frac{7414}{21330} = 0.35 > 0.15$$

W.O. No. 3900-76 Date 11-83 Book No. 8.16.5012 Page No. 13
Drawing No. RHR-238 Calc. No. 8.16.5037 Sheet 13 Cont. on Sheet 14
By Ed. Pando Checked RAH Approved _____
Title: MEB-50 STUDY

MEMBER STRESSES: (CONT'D)

USE FORMULAS 1.6-12 & 1.6-16 FROM AISC MANUAL, PG. 5-22.

$$\text{FORMULA 1.6-12: } \frac{f_a}{F_a} + \frac{C_{mx} f_{bx}}{\left(1 - \frac{f_a}{F'_{ex}}\right) F_{bx}} + \frac{C_{my} f_{by}}{\left(1 - \frac{f_a}{F'_{ey}}\right) F_{by}} \leq 1.0$$

$$F'_{ex} = F'_{ey} = \frac{12\pi^2 E}{23(47)} = 3177264$$

Conservatively use: $C_{mx} = C_{my} = 0.85$

$$.35 + \frac{0.85(8117 \text{ in-lb} / 5.35 \text{ in}^3)}{\left(1 - \frac{7414}{3177264}\right)(40600)} + \frac{0.85(24569 \text{ in-lb} / 5.35 \text{ in}^3)}{\left(1 - \frac{7414}{3177264}\right)(40600)} = 0.48$$

$0.48 < 1.0$ \therefore Formula 1.6-12 is satisfied.

$$\text{FORMULA 1.6-16: } \frac{f_a}{.6 F_y} + \frac{f_{bx}}{F_{bx}} + \frac{f_{by}}{F_{by}} \leq 1.0$$

$$\frac{7414}{.6(42000)} + \frac{(8117 + 24569) / 5.35}{40600} = 0.44 < 1.0$$

\therefore Formula 1.6-16 is satisfied

MEMBER No. 10 IS ADEQUATE FOR BUCKLING.

ALL OTHER MEMBERS ARE ADEQUATE IN BENDING & BUCKLING BY COMPARISON TO ABOVE CALCULATIONS.

CHECK CRITICAL SHEAR STRESS:

BY INSPECTION OF STRUDL OUTPUT PAGES 19 TO 23,
CRITICAL TUBE STEEL SECTION IS STRUDL MEMBER
No. 7 (TS 5x5x0.375)

PER STRUDL OUTPUT PAGE 21,

$$\text{TORSION} = 10,720 \text{ #-IN}$$

$$F_y = 10941 \text{ \#}$$

$$F_z = 2705 \text{ \#}$$

W.O. No. 3900-76 Date 11-83 Book No. 8,16,712 Page No.
 Drawing No. RHR-238 Calc. No. 8,16,5037 Sheet 14 Cont. on Sheet 15
 By ELP Checked ELP Approved
 Title MEB-50 STUDY

MEMBER STRESSES: (CONT'D.)

TORSIONAL SHEAR STRESS:

(REF. BLODGETT "DESIGN OF WELDED STRUCTURES", SECTION 2.10)

$$\text{TORSIONAL SHEAR STRESS: } \tau = \frac{T}{2[A]t}$$

$$\tau = \frac{10720 \text{ #-IN}}{2[5 \times 0.375"]^2 \cdot 0.375"} = 668 \text{ PSI}$$

$$\tau = 668 \text{ PSI} < 27000 \text{ PSI}$$

∴ MEMBER IS ADEQUATE IN TORSION.

NORMAL SHEAR STRESS: (TS 5X5X.375; A=6.45 IN²)

$$\tau_{VY} = \frac{10941 \text{ #}(2)}{6.45 \text{ IN}^2} = 3393 \text{ PSI}$$

$$\tau_{VZ} = \frac{2705 \text{ #}(2)}{6.45 \text{ IN}^2} = 839 \text{ PSI}$$

ALLOWABLE SHEAR STRESS >> ACTUAL SHEAR STRESS
(27000 PSI)

CHECK PIPE TRUNNION SHEAR STRESS:

MATERIAL: A106 GR. B, 14" Ø SCH. 40 PIPE

$$S_y = 27.1 \text{ KSI (NORMAL)}$$

SECTION PROPERTIES:

$$A = 18.662 \text{ IN}^2$$

$$J = 61.356 \text{ IN}^4$$

$$\text{thickness of wall} = 0.438" = t$$

$$\text{Torsional Resistance} = R = 2\pi r^3 t = 2\pi (6.562")^3 (0.438") = 778 \text{ IN}^4$$

REF. STRUDL OUTPUT PAGES 23 & 24, MEMBERS #12 & 13.
 BY INSPECTION OF MEMBER FORCES, MEMBER 12
 AT JOINT 4 IS CRITICAL.

MEMBER STRESSES: (CONT'D.)

REF. STRUDL OUTPUT PG. 23, MEM 12, JOINT 4

$$TORSION = 266915 \text{ #-IN}$$

$$F_Y = 27233 \text{ #}$$

$$F_Z = 7094 \text{ #}$$

TORSIONAL SHEAR STRESS:

$$\tau = \frac{TC}{R} = \frac{266915 \text{ #-IN} (7 \text{ IN})}{944 \text{ IN}^4} = 1979 \text{ PSI}$$

TOTAL SHEAR STRESS:

$$\sigma_v = \tau + \frac{[F_Y^2 + F_Z^2]^{1/2}}{A}$$

$$\sigma_v = 1979 \text{ PSI} + \frac{[(27233 \text{ #})^2 + (7094 \text{ #})^2]^{1/2}}{18.662 \text{ IN}^2}$$

$$\sigma_v = 4995 \text{ PSI} < .4 S_y = (.4 (27100 \text{ PSI})) = 10840 \text{ PSI}$$

∴ PIPE TRUNNIONS ARE ADEQUATE.

WELD ANALYSIS:

CHECK WELD AT MEMBER 11 JOINT 12

PER STRUDL OUTPUT PG. 25, JOINT 12:

$$F_X = 7987 \text{ #}$$

$$M_X = 34125 \text{ #-IN}$$

$$F_Y = 2996 \text{ #}$$


$$M_Y = 9824 \text{ #-IN}$$

$$F_Z = 7713 \text{ #}$$

$$M_Z = 27391 \text{ #-IN}$$

WELD PROPERTIES:

REF. RFI-C0500-AB1464

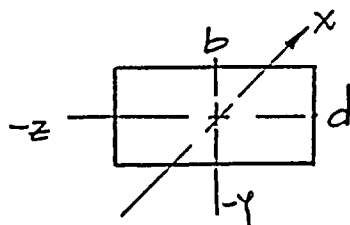

TS-4x4x.375 AT 45°

$$b = \sqrt{2} (4") = 5.657" ; d = 4"$$

$$S_{wy} = \frac{5.657"}{3} [5.657" + 3(4")] = 33.295 \text{ IN}^2$$

$$A_w = 2 (4" + 5.657") = 19.314 \text{ IN}$$

$$S_{wz} = \frac{4"}{3} (3(5.657") + (4")) = 27.961 \text{ IN}^2$$

$$J_w = [4" + 5.657"]^3 / 6 = 150.098 \text{ IN}^3$$

WELD OF MEMBER 11, JOINT 12: (CONT'D)

WELD FORCE: (#/IN)

$$f_w = \left[\left(\frac{F_x}{A_w} + \frac{M_y}{S_y} + \frac{M_z}{S_z} \right)^2 + \left(\frac{F_y}{A_w} + \frac{b/2(M_x)}{J_w} \right)^2 + \left(\frac{F_z}{A_w} + \frac{d/2(M_x)}{J_w} \right)^2 \right]^{1/2}$$

$$f_w = \left[\left(\frac{7987}{19.514} + \frac{9824}{33.225} + \frac{27391}{27.961} \right)^2 + \left(\frac{2996}{19.34} + \frac{(5.657)(34125)}{150.098} \right)^2 + \left(\frac{7713}{19.514} + \frac{2(34125)}{150.098} \right)^2 \right]^{1/2}$$

$$f_w = 2053 \text{ \#/IN}$$

MINIMUM EFFECTIVE THROAT OF WELD REQUIRED:


$$w_{\text{req'd.}} = \frac{2053 \text{ \#/IN}}{27000 \text{ PSI}} = 0.08''$$

REF. RFI-C0500-AB1464

MINIMUM EXISTING EFFECTIVE THROAT:

$$w = \frac{a \cdot b}{[a^2 + b^2 - 2ab \cos \theta]^{1/2}}$$

$$\text{EXIST. } w_{\text{min}} = \frac{(1/8)(1/4)}{[(1/8)^2 + (1/4)^2 - 2(1/8)(1/4)\cos 135^\circ]^{1/2}}$$

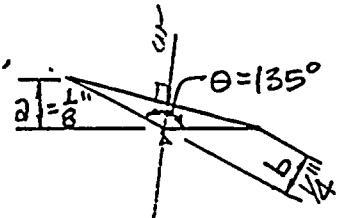

$$\text{EXIST. } w_{\text{min}} = 0.089'' > 0.08'' (\text{REQ'D.})$$

∴ EXISTING WELD AT JOINT 12 IS ADEQUATE.

CHECK WELD AT MEMBER 11, JOINT 3

FROM STRUPL OUTPUT PG. 23, MEM 11, JOINT 3

AXIAL = 11102 #

TORSION = 11074 #-IN

FY = 2987. #

MY = 11561 #-IN

FZ = 560 #


MZ = 70116 #-IN

WELD PROPERTIES & ORIENTATION:

SAME AS FOR MEMBER 11, JOINT 12
(ABOVE CALC.)

WELD ANALYSIS: (CONT'D.)

RESOLVE FORCES INTO PLANE OF WELD:

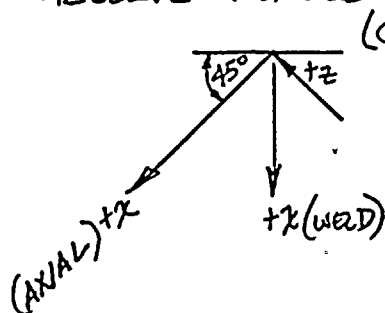

(CONSERVATIVELY ADD ALL RESOLVED FORCES)

$$F_x = 111.02^* (.7071) + (.7071)(560^*) = 8246 \#$$

$$F_z = F_x = 8246 \#$$

$$F_y = 2987 \#$$

$$M_x = 11074 \# \cdot \text{IN} (.7071) + (.7071)(70116 \# \cdot \text{IN}) = 57410 \# \cdot \text{IN}$$

$$M_z = M_x = 57410 \# \cdot \text{IN}$$

$$M_y = 11561 \# \cdot \text{IN}$$

WELD FORCE: (#/IN)

$$f_w = \sqrt{\left(\frac{8246}{19.314} + \frac{57410}{27.961} + \frac{11561}{33.295}\right)^2 + \left(\frac{2987}{19.314} + \frac{(6.451)(57410)}{150.098}\right)^2 + \left(\frac{8246}{19.314} + \frac{2(57410)}{150.098}\right)^2}^{\frac{1}{2}}$$

$$f_w = 3308 \#/\text{IN}$$

REQUIRED EFFECTIVE THROAT OF WELD:

$$W_{\text{req'd}} = \frac{3308 \#/\text{IN}}{27000 \text{ PSI}} = 0.123 \text{ ''}$$

MINIMUM EXISTING EFFECTIVE THROAT PER
 RFI-C0500-AB1464: REF. PREVIOUS WELD CALC. ($a=b=\frac{7}{16}$; $\theta=135^\circ$)

$$W_{\text{EXIST.}} = \frac{(\frac{7}{16})(\frac{7}{16})}{\left[\left(\frac{7}{16}\right)^2 + \left(\frac{7}{16}\right)^2 - 2\left(\frac{7}{16}\right)\left(\frac{7}{16}\right)\cos 135^\circ\right]^{\frac{1}{2}}} = 0.237 \text{ ''} \quad (\text{SKEWED WELD})$$

$$\text{EXISTING } W = \frac{3}{16} \left(\frac{1}{\sqrt{2}}\right) = 0.133 \text{ ''} \quad (\frac{3}{16} \text{ '' FILLET WELD})$$

$$W_{\text{min}} = 0.133 \text{ ''} > 0.123 \text{ ''} \quad (\text{REQUIRED})$$

\therefore EXISTING WELD AT STRUDL JOINT 3 IS ADEQUATE.

WELD ANALYSIS: (CONT'D.)


CHECK AT STRUDL JOINT 10 & 11

BY INSPECTION OF OUTPUT LOADS JOINT 10 IS CRITICAL
REF. STRUDL OUTPUT PG'S 24 & 25

$$\begin{aligned} FX &= 20420 \# & MX &= 6154 \#-IN \\ FY &= 31662 \# & MY &= 5596 \#-IN \\ FZ &= 390 \# & MZ &= 24569 \#-IN \end{aligned}$$

THE FOLLOWING WELD CONFIGURATION & PROPERTIES
WILL BE ANALYZED AS IT IS ASSURED TO EXIST
PER RFI-C0500-AB1464.

WELDING EXISTS BETWEEN STIFFENER PLATES
AND EMBEDDED PLATE.

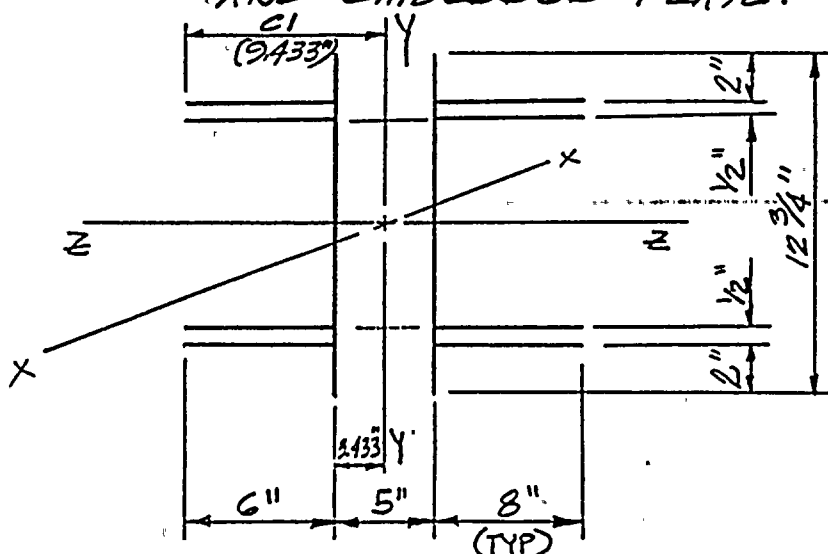

WELD PROPERTIES:

$$A_w = 2(12.75") + 4(8" + 6") = 81.5"$$

$$C_1 = \left[4(6")(3") + 12.75(6" + 11") + 4(8")(15") \right] \div (81.5") = 9.433"$$

$$I_z = 2 \left(\frac{(12.75")^3}{12} \right) + 4(6")(4.13")^2 + 4(8")(4.13")^2 = 1300.63 \text{ IN}^3$$

$$I_y = 12.75 \left[(3.433")^2 + (1.567")^2 \right] + 4(6")(6.433")^2 + 4(8")(5.567")^2 + \left(\frac{16^3}{12} + \frac{8^3}{12} \right) 4$$

$$I_y = 2409.170 \text{ IN}^3$$

W.O. No. 3900-76 Date 1-12-83 Book No. 8.16.5037 Page No. 19
Drawing No. RHR-238 Calc. No. 8.16.5037 Sheet 19 Cont. on Sheet 20
By ELK Checked ELK Approved _____
Title MEB-50 STUDY

WELD ANALYSIS: (CONT'D.)

$$S_{Z_w} = I_z / 6.375" = \frac{1300.63 \text{ IN}^3}{6.375 \text{ IN}} = 204.02 \text{ IN}^2$$

$$S_{Y_wR} = I_y / 9.567" = \frac{2409.170 \text{ IN}^3}{9.567 \text{ IN}} = 251.821 \text{ IN}^2$$

$$S_{Y_wL} = I_y / 9.433" = \frac{2409.170 \text{ IN}^3}{9.433 \text{ IN}} = 255.398 \text{ IN}^2$$

$$J_w = I_z + I_y = 1300.63 \text{ IN}^3 + 2409.170 \text{ IN}^3 = 3709.8 \text{ IN}^3$$

WELD FORCE: (#/IN)

$$f_w = \left[\left(\frac{20420}{81.5} + \frac{5596}{255.398} + \frac{24569}{204.02} \right)^2 + \left(\frac{31662}{81.5} + \frac{2567(6.154)}{3709.8} \right)^2 + \left(\frac{390}{81.5} + \frac{6.375(6.154)}{3709.8} \right)^2 \right]^{\frac{1}{2}}$$

$$f_w = 564 \text{ \#/IN}$$

REQUIRED WELD SIZE: (FILLET WELD)

$$w_{req'd} = 564 \text{ \#/IN} \sqrt{2} / 27000 \text{ PSI} = 0.03"$$

EXISTING MINIMUM FILLET WELD SIZE:

$$w_{exist.} = 0.25" > 0.03" \text{ (REQUIRED)}$$

∴ EXISTING WELD IS ADEQUATE.

W.O. No. 3900-76 Date 12-83 Book No. 2116.5037 Page No. 20
Drawing No. RHR-238 Calc. No. 8116.5037 Sheet 20 Cont. on Sheet 21
By Edwards Checked TH Approved _____
Title MEB-50 STUDY

WELD ANALYSIS: (CONT'D.)

CHECK WELD AT MEMBER 13, JOINT 5 & MEMBER 12, JOINT 3.


BY INSPECTION OF OUTPUT LOADS, JOINT 3 OF MEMBER 12 IS CRITICAL PER STRUDL OUTPUT PG.'S 23 & 24:

AXIAL = 7982 #
FY = 27233 #
FZ = 7094 #

TORSION = 266915 #-IN
MY = 48092 #-IN
MZ = 135535 #-IN

WELD PROPERTIES & CONFIGURATION:

CRITICAL WELD IS BETWEEN HANGER DETAIL ITEM # 5 & ITEM # 2.

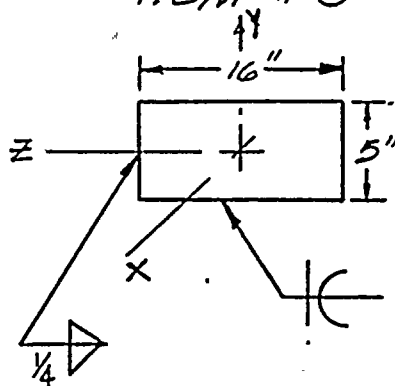

$$A_w = 2(5" + 16") = 42 \text{ in}$$

$$S_{wy} = \frac{16"}{3} (16" + 3(5")) = 165.33$$

$$S_{wz} = \frac{5"}{3} (5" + 3(16")) = 88.33$$

$$J_w = \frac{(16" + 5")^3}{6} = 1543.5$$

WELD FORCES: (#/IN)

$$f_w = \left[\left(\frac{7982}{42} + \frac{48092}{165.33} + \frac{135535}{88.33} \right)^2 + \left(\frac{27233}{42} + \frac{266915(8)}{1543.5} \right)^2 + \left(\frac{7094}{42} + \frac{266915(2.5)}{1543.5} \right)^2 \right]^{1/2}$$

$$f_w = 2924 \text{ #/IN}$$

WELD STRESS:

DETERMINE MINIMUM EXISTING EFFECTIVE THROAT

OF WELD: $\frac{1}{4}$ " FILLET WELD $\Rightarrow w = .7071(25") = .177"$

$\frac{3}{4}$ " RAD. FLARE-BEVEL WELD $\Rightarrow w = \frac{5}{16}(.75") = .234"$

$\frac{1}{4}$ " FILLET WELD IS CRITICAL:

$$\sigma_w = \frac{2924 \text{ #/IN}}{0.177 \text{ in}} = 16521 \text{ PSI} < 27000 \text{ PSI} \therefore \text{OK}$$

W.O. No. 3900-76 Date -12-83 Book No. 8.16.5012 Page No. 21
Drawing No. RHR-238 Calc. No. 8.16.5037 Sheet 21 Cont. on Sheet 22
By ERamos Checked LAH Approved _____
Title MEB-50 STUDY

WELD ANALYSIS: (CONT'D.)


CHECK WELDS AT STRUDL MEMBER 5, JOINT 8 AND
MEMBER 8, JOINT 9.

BY INSPECTION OF STRUDL OUTPUT PAGE 24, JOINT 9
IS CRITICAL.

$$\begin{array}{ll} F_x = 25360 \# & M_x = 10640 \#-IN \\ F_y = 10969 \# & M_y = 27710 \#-IN \\ F_z = 2646 \# & M_z = 114023 \#-IN \end{array}$$

WELD PROPERTIES & CONFIGURATION:

(CONSERVATIVELY, NEGLECT STIFFENER PLATE WELDS)

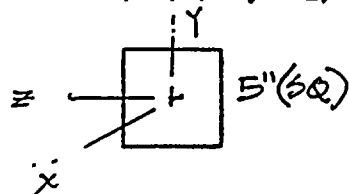

$$A_w = 4(5") = 20"$$

$$S_{w_y} = S_{w_z} = \frac{5}{3} (4(5")) = 33.33 \text{ IN}^2$$

$$J_w = \frac{(2(5"))^3}{6} = 166.67 \text{ IN}^3$$

WELD FORCE: (#/IN)

$$f_w = \sqrt{\left(\frac{25360}{20} + \frac{27710}{33.33}\right)^2 + \left(\frac{10969}{20} + \frac{2.5(10640)}{166.67}\right)^2 + \left(\frac{2646}{20} + \frac{2.5(114023)}{166.67}\right)^2}^{\frac{1}{2}}$$

$$f_w = 5573 \#/IN$$

WELD STRESS: (3/8" FILLET WELD)

$$\sigma_w = \frac{5573 \#/IN (\sqrt{2})}{0.375"} = 21018 \text{ PSI} < 27000 \text{ PSI}$$

\therefore 3/8" FILLET WELD IS ADEQUATE

W.O. No. 3900-76 Date 12-83 Book No. 816.112 Page No. 22
Drawing No. RHR-238 Calc. No. 816.5037 Sheet 22 Cont. on Sheet 23
By Ed Ramo Checked BAH Approved _____
Title MEB-50 STUDY

WELD ANALYSIS: (CONT'D)

CHECK WELD AT STRUDL MEMBER 2, JOINT 6 AND MEMBER 2, JOINT 7.

BY INSPECTION OUTPUT LOADS MEMBER 2 JOINT 7 IS CRITICAL.

REF. STRUDL PG'S. 19 & 20:

$$AXIAL = 59. \#$$

$$FY = 23. \#$$


$$FZ = 1257 \#$$

$$TORSION = 6851 \#-IN$$

$$MY = 16201 \#-IN$$

$$MZ = 254 \#-IN$$

WELD PROPERTIES & CONFIGURATION:

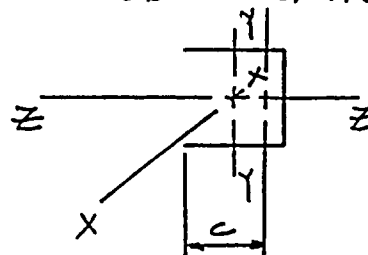

$$c = \frac{2(4)(2) + 4(4)}{12} = 2.67"$$

TS 4x4x.375

$$A_w = 3(4") = 12 \text{ IN}$$

$$S_{WZ} = \frac{1}{6}(7(4")) = 18.67 \text{ IN}^2$$

$$S_{WY} = \frac{1}{3}(3(4")) = 16 \text{ IN}^2$$

$$S_{WY_L} = \frac{4^2}{3} \left(\frac{3(4")}{2(4")} \right) = 8 \text{ IN}^2$$

$$J_w = \frac{4^3}{3} \left(\frac{3(4")}{3(4")} \right) + \frac{4^{1/2}}{12} (7(4")) = 58.67$$

WELD FORCE: (#/IN)

$$f_w = \left[\left(\frac{59}{12} + \frac{16201}{8} + \frac{254}{18.67} \right)^2 + \left(\frac{23}{12} + \frac{6851(2.67)}{58.67} \right)^2 + \left(\frac{1257}{12} + \frac{6851(2)}{58.67} \right)^2 \right]^{1/2}$$

$$f_w = 2095 \#/\text{IN}$$

WELD STRESS: ($\frac{1}{4}$ " FILLET WELD)

$$\sigma_w = 2095 \#/\text{IN} (\sqrt{2}) / .25" = 11852 \text{ PSI} < 27000 \text{ PSI}$$

$\therefore \frac{1}{4}$ " FILLET WELD IS ADEQUATE.

W.O. No. 3900-76 Date 10/12-83 Book No. 8116.5012 Page No.
 Drawing No. RHR-238 Calc. No. 8116.5037 Sheet 23 Cont. on Sheet 24
 By Ed Rando Checked JAR Approved
 Title MFB-50 STUDY

WELD ANALYSIS: (CONT'D)

CHECK WELDS AT STRUDL MEMBERS 9 & 10, JOINTS 5 & 3, RESPECTIVELY.

BY INSPECTION OF FORCES ON STRUDL OUTPUT PAGES 22 & 23, MEMBER 9 JOINT 5 IS CRITICAL.

$$AXIAL = 34833 \#$$

$$TORSION = 1762 \#-IN$$


$$FY = 1345 \#$$

$$MY = 13751 \#-IN$$

$$FZ = 382 \#$$

$$MZ = 48531 \#-IN$$

RESOLVING FORCES IN PLANE OF WELD:

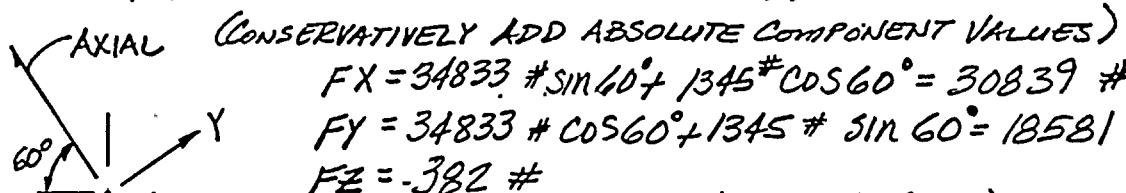

$$FX = 34833 \# \sin 60^\circ + 1345 \# \cos 60^\circ = 30839 \#$$

$$FY = 34833 \# \cos 60^\circ + 1345 \# \sin 60^\circ = 18581 \#$$


$$FZ = -382 \#$$

$$TORSION = 1762 \#-IN (\sin 60^\circ) + 13751 \#-IN (\cos 60^\circ) = 8401 \#-IN$$

$$MY = 1762 \#-IN (\cos 60^\circ) + 13751 \#-IN (\sin 60^\circ) = 12790 \#-IN$$


$$MZ = 48531 \#-IN$$

WELD PROPERTIES & CONFIGURATION:

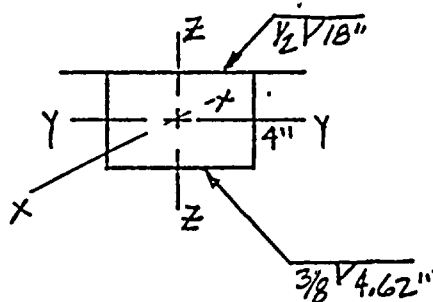

EXISTING WELD

CONSERVATIVELY EVALUATE THE FOLLOWING WELD CONFIGURATION:

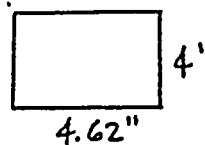

$$AW = 2(4.62 + 4) = 17.24$$

$$SW_Z = \frac{4.62}{3} (4.62 + 3(4)) = 25.6 \text{ IN}^2$$

$$SW_Y = \frac{4}{3} (4 + 3(4.62)) = 23.8 \text{ IN}^2$$

$$J_W = \frac{(4 + 4.62)^3}{6} = 106.8 \text{ IN}^3$$

MINIMUM EXISTING EFFECTIVE THROAT OF WELDS:

$\frac{1}{4} \times \frac{5}{16}$ @ 120° ANGLE:

$$\text{EFFECTIVE THROAT} = \frac{(0.25)(0.3125)}{\sqrt{(0.25)^2 + (0.3125)^2 - 2(0.25)(0.3125)\cos 120^\circ}} = 0.16$$

WELD ANALYSIS: (CONT'D)

WELD STRESS: (BASED ON MINIMUM EFFECTIVE THROAT)

$$\sigma_w = \sqrt{\left(\frac{30839}{17.24} + \frac{12790}{23.8} + \frac{48531}{25.6}\right)^2 + \left(\frac{18581}{17.24} + \frac{2(8401)}{106.8}\right)^2 + \left(\frac{382}{17.24} + \frac{2.31(8401)}{106.8}\right)^2} \cdot \frac{1}{.16} = 27523 \text{ PSI}$$

$$\sigma_w = 27523 \text{ PSI} > 27000 \text{ PSI}$$

SINCE THE WELD CONFIGURATION AND PROPERTIES USED TO ARRIVE AT "OVERSTRESS" RESULT, ABOVE, TRY SUBSTITUTING ONLY THE ACTUAL WELD AREA (LENGTH) INTO THE ABOVE EQUATION.

$$* \text{ACTUAL } A_w = 17.24" + (18" - 4.62") = 30.62 \text{ IN}$$

$$\sigma_w = \sqrt{\left(\frac{30839}{30.62} + \frac{12790}{23.8} + \frac{48531}{25.6}\right)^2 + \left(\frac{18581}{30.62} + \frac{2(8401)}{106.8}\right)^2 + \left(\frac{382}{30.62} + \frac{2.31(8401)}{106.8}\right)^2} \cdot \frac{1}{.16} = 22059 \text{ PSI}$$

$$\sigma_w = 22059 \text{ PSI} < 27000 \text{ PSI}$$

∴ EXISTING WELDS AT JOINTS 3 & 5 ARE ADEQUATE.

* THIS NOW INCLUDES THE WELD OF ITEM 11 TO ITEM 2

1710 K - 10
 INFORMATION FORM -- EMBEDDED PLATE

CHG. 7/10, 2011
 NO. # 3920-76
 P 25 CONT. 26

A. HANGER MARK NO. RHR-238 S/U No. 9.0 REV No. 3



PLATE SIZE: 9" Strip 13"x21" ☒ 12"x12" Other

SIZE OF ATTACHMENT (e.g. TS4x4, W8x24, End Brkt. 5"x5", etc.) TS 4x4x.375 @ 30°

B. IS SUPPORT INSTALLED? Yes ☒ No Location:

C. ~~OTHER ATTACHMENTS (Identify Contractor & Mark No. & Locate on Plate Sketch Below)~~

D. SKETCH (Plate & Attachment Location on Plate)

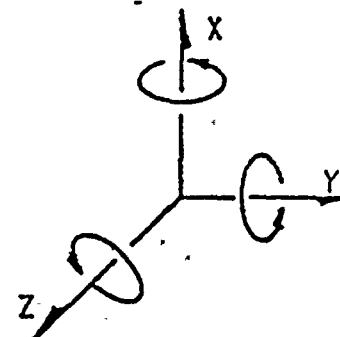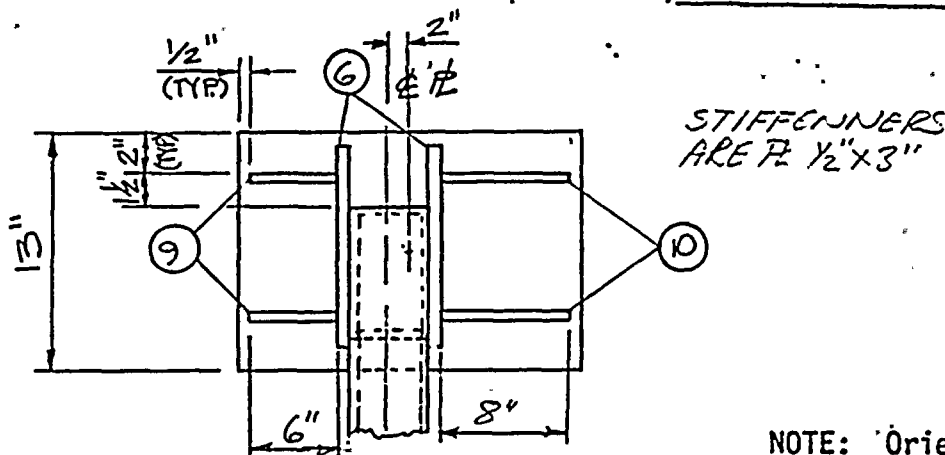

NOTE: Orientation of Forces Shown is Positive

E. LOAD TABLE FOR STRUDL JOINT 11

Type of Loading	ATTACHMENT LOAD AT PLATE					
	Fx (KIPS)	Fy (KIPS)	Fz (KIPS) PULLOUT	Mx (IN-K)	My (IN-K)	Mz (IN-K) TORSION
Normal/Upset						
Emergency						
Faulted	29.34	0.38	18.93	6.05	27.2	5.5

LOADS ±

SOURCE OF INFORMATION: STRUDL RUN # 664 (10-11-83)

GROUP: HANGERS SIGNED/DATED: Ed Ramo 10-11-83

F. COMMENTS BY BURNS & ROE COGNIZANT GROUP: CHECKED: [Signature] 10/11/83

- ☐ APPROVED PER _____
- ☐ CALC. NO. _____ CALC. BOOK NO. _____
- ☒ APPROVAL BASED ON LOAD PER TABLE SHOWN ABOVE.
- ☐ APPROVAL BASED ON REDUCED LOADS (Source) _____
- ☐ APPROVED AS NOTED (MARK-UP DETAIL ETC.) _____
- ☐ NOT APPROVED. COMMENTS, ETC. _____

REVIEWED BY: [Signature] DATED: 10/12/83

CHECKED BY: [Signature] DATED: 10/13/83

A. HANGER MARK NO. RHR-238 S/U No. 9.0 REV No. 3


PLATE SIZE: 9" Strip _____ 13"x21" ✓ 12"x12" _____ Other _____

SIZE OF ATTACHMENT (e.g. TS4x4, W8x24, End Brkt. 5"x5", etc.) TS4x4x.375 @ 30°


B. IS SUPPORT INSTALLED? Yes ✓ No _____ Location: _____

C. ~~OTHER ATTACHMENTS (Identify Contractor & Mark No. & Locate on Plate Sketch Below)~~

D. SKETCH (Plate & Attachment Location on Plate) _____

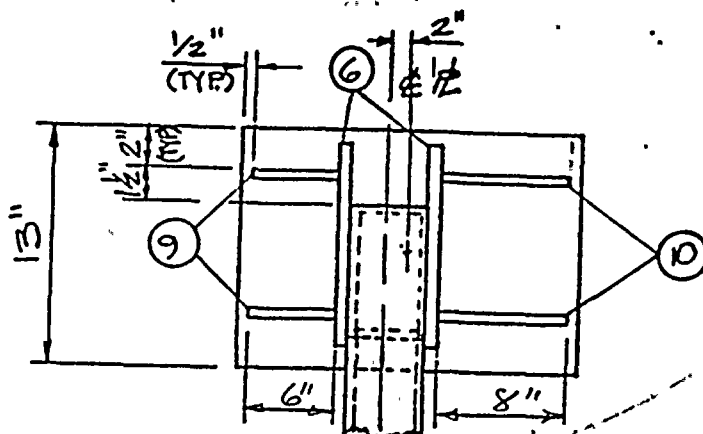

STIFFENERS
ARE $2 \times \frac{1}{2} \times 3$

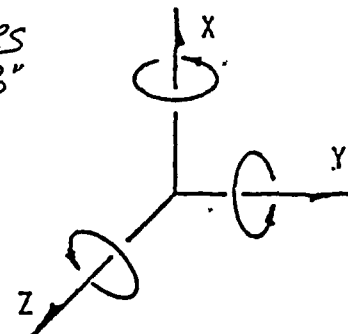

FOR STRUDL
JOINT 1.0

NOTE: Orientation of Forces
Shown is Positive

E. LOAD TABLE

Type of Loading	ATTACHMENT LOAD AT PLATE					
	Fx (KIPS)	Fy (KIPS)	Fz (KIPS)	Mx (IN-K)	My (IN-K)	Mz (IN-K)
Normal/Upset						
Emergency						
Faulted	31.7	0.39	20.4	5.6	24.6	6.15

LOADS \pm

SOURCE OF INFORMATION: STRUDL #664 (10/11/82)

GROUP: HANGERS SIGNED/DATED: Ed Ramos

F. COMMENTS BY BURNS & ROE COGNIZANT GROUP: CHECKED: J. Progers 10/11/83

☐ APPROVED PER _____

☐ CALC. NO. _____ CALC. BOOK NO. _____

☒ APPROVAL BASED ON LOAD PER TABLE SHOWN ABOVE.

☐ APPROVAL BASED ON REDUCED LOADS (Source) _____

☐ APPROVED AS NOTED (MARK-UP DETAIL ETC.) _____

☐ NOT APPROVED. COMMENTS, ETC. _____

REVIEWED BY: McClark DATED: 10/12/83

CHECKED BY: Amshah DATED: 10/13/83

W.O. No. 3900-76 Date 10/20/83 Book No. 8, 16, 5012 Page No. 701
Drawing No. RHR-970N Calc. No. 8, 16, 5037 Sheet 701 Cont. on Sheet 71
By L. H. Rogers Checked E. L. Amos Approved _____
Title MEB-50 STUDY PHASE II ~~DE MARK NO.~~

LOAD CONDITIONS:

DESIGN LOADS

LOAD TYPE		POUNDS			POUNDS-FT.		
		Fx	Fy	Fz	Mx	My	Mz
Thermal		-63	378	-167	-822	705	515
Dead Wt.		106	-10025	39	328	494	-631
Misc.							
DYNAMIC LOADS	Normal	± 3810	± 13327	± 1753	± 17265	± 5358	± 34916
	Emerg.	± 3810	± 13327	± 1753	± 17265	± 5358	± 34916
	Faulted	± 7019	± 26653	± 3506	± 34530	± 10717	± 69833
TOTAL LOADS	Normal	EACH LOAD CASE FOR ANCHORS IS INPUTED SEPERATELY INTO THE STRUDL COMPUTER PROGRAM AND THEN THE REACTIONS ARE TOTALLED DUE TO THE COMPLEXITY OF LOAD CONDITIONS AND SUPPORT STRUCTURES					
	Emerg.						
	Faulted						

BURNS AND ROE, INC.

Headquarters Office—Oradell, N.J.

W.O. No. 3900-76 Date 10/14/83 Book No. 8.16.2012 Page No.
 Drawing No. PHR-970A1 Calc. No. 8.16.5037 Sheet 71/8 Cont. on Sheet 72
 By SA Bridge Checked Ed Pando Approved
 Title WPBSS NP2 PIPE SUPPORT REVIEW/REDESIGN PS MARK No.

LOAD CONDITIONS:*MEB-50 PHASE II LOADS*

LOAD TYPE		POUNDS			POUNDS-FT.		
		Fx	Fy	Fz	Mx	My	Mz
Thermal	<i>CASE D</i>	<i>317</i>	<i>-3626</i>	<i>1483</i>	<i>6569</i>	<i>-4622</i>	<i>-2139</i>
	<i>CASE E</i>	<i>133</i>	<i>-3688</i>	<i>666</i>	<i>-813</i>	<i>-5214</i>	<i>-400</i>
	<i>CASE F</i>	<i>166</i>	<i>2614</i>	<i>624</i>	<i>-1189</i>	<i>-5444</i>	<i>-711</i>
Dead Wt.		<i>106</i>	<i>-10025</i>	<i>39</i>	<i>328</i>	<i>494</i>	<i>-631</i>
Misc.							
DYNAMIC LOADS	Normal						
	Emerg.						
	Faulted <i>MEB-50</i>	<i>3810</i>	<i>13327</i>	<i>1753</i>	<i>17265</i>	<i>5358</i>	<i>34916</i>
TOTAL LOADS	Normal						
	Emerg.						
	Faulted	<i>SEE STRUDL RUN</i>					
ORIGINAL SUPPORT DESIGN LOADS	Normal						
	Emerg.						
	Faulted						

FOR
THE MER-50 CALCULATION IS A LOAD CASE WHERE DEADWEIGHT (DW), THERMAL (TH) AND FAULTED (FD) (OR SSE) ARE ADDED TOGETHER. THIS LOAD CASE IS THEN USED TO VERIFY RHR-970N MEMBERS AND WELDS ARE WITHIN STRESS ALLOWABLES.

STRUDL RUN #1342 DATED 10/13/83 IS USED TO FIND REACTIONS AND FORCE MOMENTS IN RHR-970N STRUCTURAL MEMBERS. THE LOADING INPUT IS FOR THREE THERMAL CASES (D, E & F), ONE DEAD WEIGHT AND EACH OF THE SIX FAULTED LOADS. LOADED INDIVIDUALLY. THE THREE THERMAL CASE'S RESULTS ARE ADDED TOGETHER WITH THE DW. THE FAULTED LOADS ARE 'PEAKED'; THIS ADDITION IS BY 'ABS' ABSOLUTE VALUE. TO GIVE WORST CASE ADDITION. THE FINAL TOTAL LOAD IS THE SUMMATION OF THE PEAKED FAULTED CASE 'PKN' WITH EACH OF THE ADDED THERMAL CASES, THESE ARE 'PEAKED' LOAD CASES AND THEREFORE WORST CASE ('ABS') SUMMATIONS FOR STRUDL RUN #1342 SEE ATTACH, 'D'

- 1.) a) THE REACTIONS AT BASE R'S FOR JOINTS 3, 4 AND 5 ARE LOWER FOR THE BASE R'S THAN THOSE USED IN DESIGN ANALYSIS CALC. # 8.15.658 BOOK 8.15.14 4 AND THEREFORE NO FURTHER ANALYSIS OF BASE R REQUIRED
- b.) THE REACTIONS AT BASE R FOR JOINT 6 ARE HIGHER AND ARE WITHIN ALLOWABLES SEE NEXT SH. FOR BASE R ACCEPTANCE.

NOTE MEMBERS 6 AND 7 ARE DUMMY MEMBERS WITH HIGH STIFFNESS TO MODEL THE PIPE INTO COMPUTER MODEL

BASEPLATE INFORMATION FORM

CAL 8.16.5037 300R8.16.5012
 C.O. # 3900-76 SHT 73Cm9 7.4

HANGER MARK NO. RHR-900N S/U NO. 9.0 REC NO. 2

BASEPLATE SIZE 1" x 24" x 24" SIZE OF STIFFENERS 3/4" x 4"


SIZE & LOCATION OF ATTACH. (e.g., W8x24, End Brkt. 5"x5", etc.) TS 10 x 10

BASEPLATE DETAIL NO. OR ITEM NO. DWG Item (4) (As-Built) "Studd" joint. 6

NEW PLATE ☐ AS-BUILT PLATE ☒ FIELD MODIFIED PLATE ☐

TYPE, SIZE & LOCATION OF BOLTS (12) 3/4" ϕ HDI

Center of Attachment moved
 1 1/2" from ϕ in Z-direction
 (See Attached.)

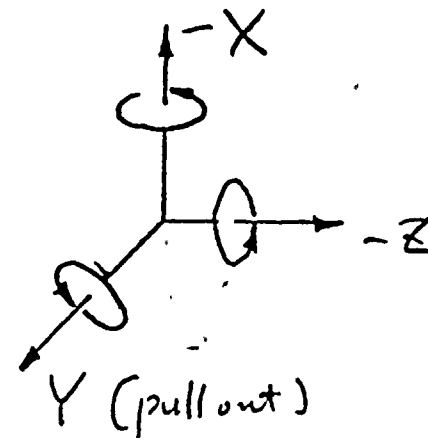

NOTE: Orientation of Forces
 Shown is Positive

LOAD
 TABLE

Type of Loading	Fx (KIPS)	Fy (KIPS)	Fz (KIPS)	Mx (K-INS)	My (K-INS)	Mz (K-INS)
Normal/Emergency						
Faulted *	4.822	21.678	9.109	60.757	20.953	47.086
Hydro						

* Loads from "Studd"
 Run # 1342, Joint 6
 "PKDIMEB"

IE Bulletin 79-02 Comments

INFORMATION SUPPLIED BY: Hang Kuan 10/13/83

CHECKED BY: [Signature]

DATED: 10/13/83



Approved



Comparison with Typicals



Finite Element Calc. No. 8.16.6550 Calc. Book No. 8.16.6000



Approved Based on Reduced Loads



Approved as Noted (MARK-UP DETAIL ETC)



Not Approved. (COMMENTS ETC)


REVIEWED BY: K.A.J. DATED: 10/14/83

CHECKED BY: MD [Signature] DATED: 10/14/83

1	✓	3/4" X 0'-10" LG SCH 30 PIPE (CUT TO SUIT)	A-106B	50
2	✓	TS 10" X 10" X .500 X 5'-8 1/2"	A-500B	342
3	✓	TS 10" X 10" X .500 X 3'-3 1/4"	A-500B	109
4	✓	2" X 24" X 2'-0"	A-36	306
5	✓	R 1" X 15" X 1'-6"	A-36	52
6	✓	1" 3/8" X 32" X 2'-8" (PAD) (CUT FROM 18" STD SCH PIPE)	A-106B	109
7	✓	15 3/4" X 2 3/8" LG HVY HEX MACH BOLT W/LW	A-307B	9
8	✓	R 1" X 19" X 2'-0" (SEE DETAIL B)	A-36	129
38	✓	1 1/2" X (6'-6" LG) 5-8 SCH 30 PIPE (CUT TO SUIT)		
39		(DELETED)		
40	✓	10" 1 1/2" HSK 13 1/8" ENB. (Z)		
41	✓	4" R 3/4" X 4" (6 LG) (CUT TO SUIT) SEE SECT. X-X		
42	✓	1" R 3/8" X 20" X 2'-8" (PAD) (BEND TO RAD OF 18" PIPE)	A-106B	3
43	✓	1" R 1" X 2'-7" X 3'-11"	A-36	
44	✓	2" 3/4" X 4" X 2'-3" LG. STIFF. R.	A-36	

* CANNOT VERIFY DUE TO INSULATION

ACCEPT "CUT TO SUIT"
S. J. Antine
 5/4/83

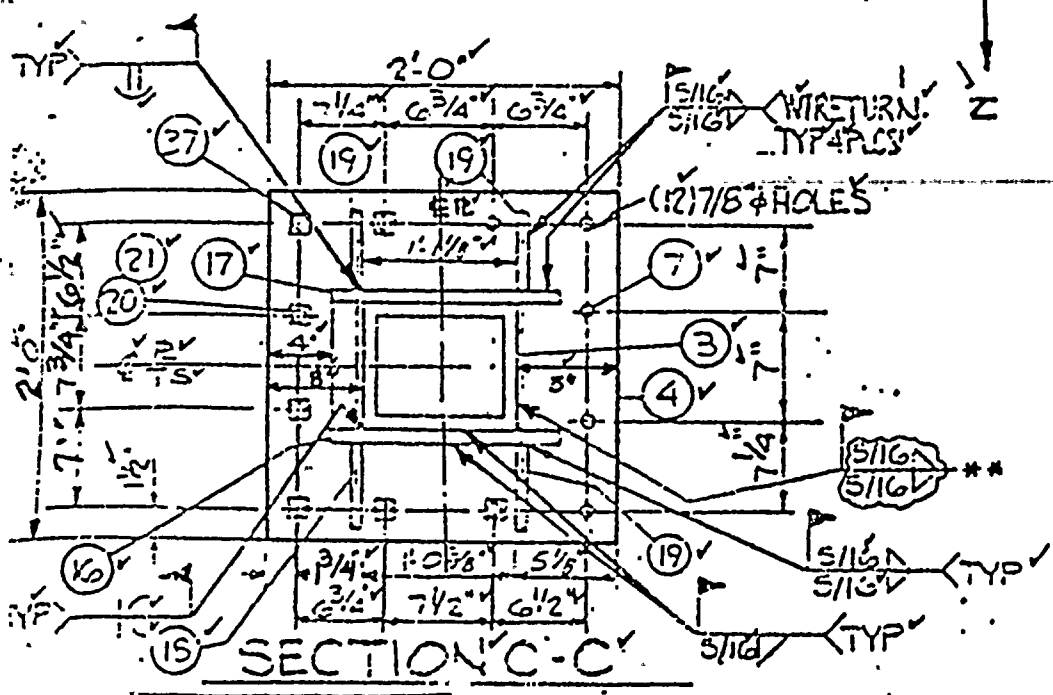


** SEE SKEWED WELDS @ SHT. 4 OF 6

5.2.83

MOMENTS FT.-LBS.		
M ₁	M ₂	M ₃
THERM: 622	705	515
DEW: 328	494	631
SEISMIC: 1728	5006	124916

LOCATION PLAN FOR
 REFERENCE ONLY!
 USE FAB. ISO. FOR
 CONSTRUCTION

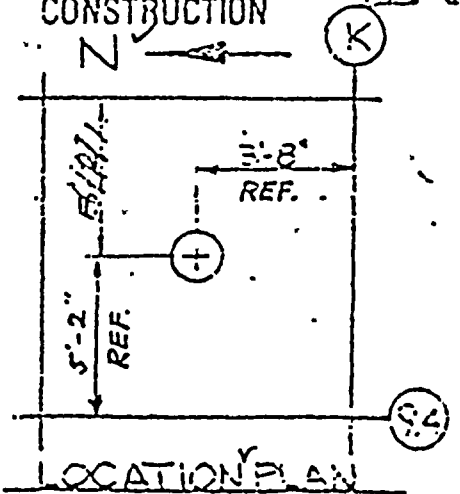

3	REVISED IN ACCORDANCE	83	W/SWP/P-P-6
REV. NO.	REVISION	DATE	BY
			CHK

CAL 8.16.5037
 BOOK 8.16.5012
 W.O. # 3900-76 SHT 74 OF 75

WPPSS NUCLEAR PROJECT NO. 2

BURNS AND ROE, INC.

REVISED SECTION PAGE PARA


DATE 1/11/84 REVIEWED DATE TITLE: RHR-970N

W.O. No. 3900-76 Date 10/5/83 Book No. 816.5039 Page No. 76

Drawing No. PER-52012 Calc. No. Edgemo7 Sheet 15 Cont. on Sheet 76

By Edgemo7 Checked Edgemo7 Approved _____

Title PER-50 STUDY

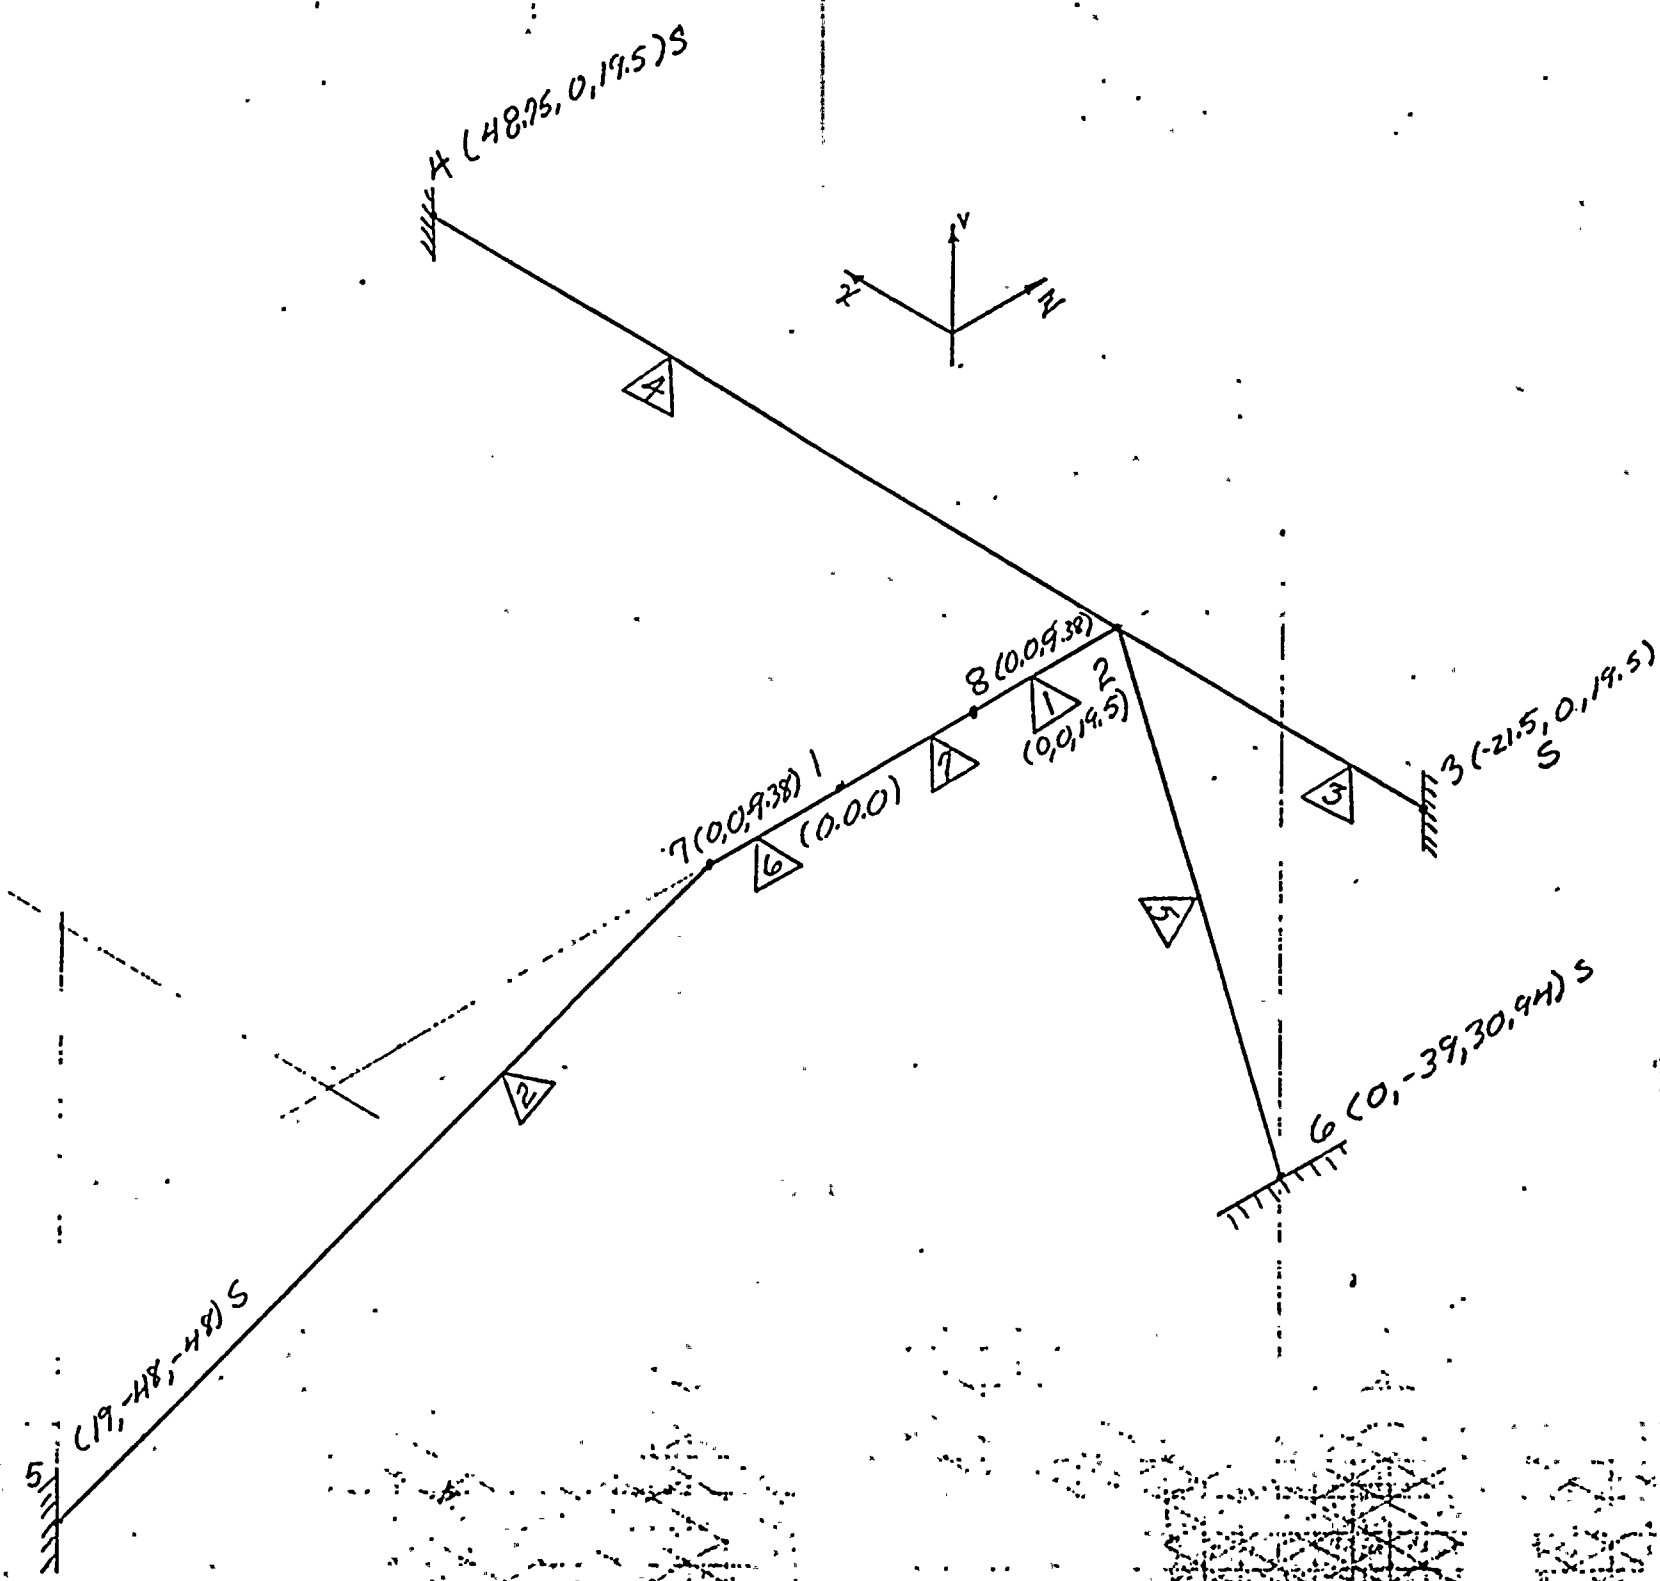

W.O. No. 3900-76 Date 10/4/83 Book No. 8.16.50 Page No. _____
 Drawing No. RHR-970N Calc. No. 8.16.50.37 Sheet 76 Cont. on Sheet 27
 By [Signature] Checked [Signature] Approved _____
 Title U MFB-50 STUDY

2. MEMBER STRESS

PER STRUDL RUN PAGES 34 to 38 THE MAX.
NORMAL STRESS IS IN MEMBER 5 AT JOINT 2
ON PAGE 37

$$6.1 \text{ KSI} \ll 40.6 \text{ KSI}$$

∴ ALL MEMBERS ARE ACCEPTABLE IN
TENSION/COMPRESSIONAL STRESS.

SHEAR STRESSES

THERE ARE TWO MEMBER SIZES USED IN
RHR-970N. CHECK WORST CASE FOR EACH.

MEMBERS 3, 4 & 5 ARE 7510X10X1/2

A REVIEW OF STRUDL PAGES 26 to 28
MEM. 3 & 2 HAS WORST CASE SHEAR
FORCES. PAGE 26. LOAD CASE 'PKMEMB' IS USED:

$$F_1 = 8700 \text{ lb} \quad M_{TOR} = 39991 \text{ lb-in}$$

$$F_2 = 6596 \text{ lb}$$

$$\tau_s = \left[\frac{F \left(\frac{P}{A'} + \frac{M_{TOR}}{2[A]t} \right)^2}{\text{SHEAR AREA PER STRUDL}} \right]^{1/2}$$

PER DESIGN OF WELDED STRUCTURES BY BLODGETT 2.10-4
 AZ = 10 in² SMALL AREA CONSERVATIVE)

$$\tau_s = \left[\left(\frac{8700}{10} + \frac{39991}{2(9.5 \times 9.5)15} \right)^2 + \left(\frac{6596}{10} + \frac{39991}{2(9.5 \times 9.5)} \right)^2 \right]^{1/2}$$

$$= 1.7 \text{ KSI} \ll 27.00 \text{ KSI}$$

MEMBERS 1 & 2 ARE 16" Ø SCH 30 PIPE

A REVIEW OF SHEAR LOADS PAGES 24 & 25 OF STIRCOIL SHOWS MEM 1 JO 8 PAGE 24 IS WORSE CASE. LOAD CASE PKDMEB USED:

$$F_y = 25182 \text{ lb} \quad M_{TOR} = 330940 \text{ lb-in}$$

$$F_z = 9968 \text{ lb}$$

$$\tau_s = \frac{(F_y^2 + F_z^2)^{1/2}}{A} + \frac{M_{TOR} R}{J}$$

PER PAGE 7
STIRCOIL

$$= \frac{[25182^2 + 9968^2]^{1/2}}{9.213} + \frac{330940 (8)}{1124}$$


$$= 5.3 \text{ KSI} \ll 27.0 \text{ KSI}$$

∴ ALL MEMBER STRESS ARE LOW AND ACCEPTABLE.

3. WELD STRESS

FOR MEMBERS 3, 4 & 5 MEM. 5 JO 2 HAS THE WORST CASE, WITH HIGH REACTION LOADS AND MINIMAL WELD

LOAD CASE PKDMEB PAGE 28

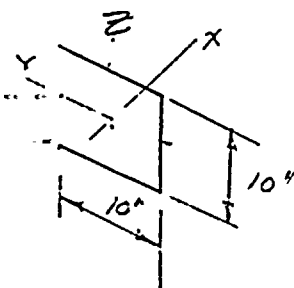


$$P_A = 23153 \text{ lb} \quad M_T = 12910 \text{ lb-in}$$

$$P_Y = 5026 \text{ lb} \quad M_Y = 127657 \text{ lb-in}$$

$$P_Z = 4822 \text{ lb} \quad M_Z = 123153 \text{ lb-in}$$

W.O. No. 39M-76 Date 10/14/83 Book No. 816.5012 Page No. 28
 Drawing No. RHP-920N No. 816.5037 Cont. on Sheet 29
 By J.A. [signature] Checked [signature] Approved [signature]
 Title MEB-50 STUDY

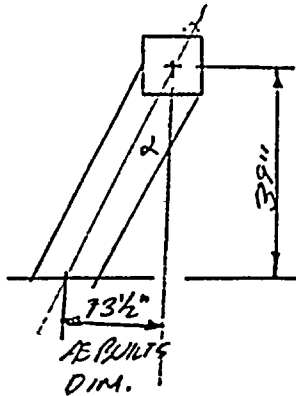

$$\alpha = \tan^{-1} \frac{a}{b} = \tan^{-1} \frac{13\frac{1}{2}}{39} = 19.09^\circ$$

ROTATE LOAD IN WORST CASE
 SUMMATION ABS

$$F_x = 23153 \cos 19^\circ + 5026 \sin 19^\circ = 23528 \text{ lb}$$

$$F_y = 23153 \sin 19^\circ + 5026 \cos 19^\circ = 12290 \text{ lb}$$

$$F_z = 4822 \text{ lb}$$

$$M_x = 12910 \cos 19^\circ + 127657 \sin 19^\circ = 53767 \text{ lb-in}$$

$$M_y = 12910 \sin 19^\circ + 127657 \cos 19^\circ = 124905 \text{ lb-in}$$

$$M_z = 123153 \text{ lb-in}$$

$$A_w = 10(3) = 30 \text{ in}$$

WELD

TREATED
 AS A
 LINE

$$S_w = bd + \frac{d^2}{6} = 10(10) + \frac{10^2}{6} = 116.6 \text{ in}^2$$

$$S_{wy} = \frac{d^2(2b+d)}{3(b+d)} = \frac{10^2(2 \cdot 10 + 10)}{3(10 + 10)} = 50 \text{ in}^2$$

$$J_w = \frac{(b+d)^3}{12} - \frac{d^2(b+d)^2}{(b+2d)} = \frac{(10+20)^3}{12} - \frac{10^2(10+10)^2}{(10+20)}$$

$$= 916.66$$

$$c_y = d - \frac{d^2}{2b+d} = 10 - \frac{10^2}{30} = 6.67 \text{ in} \quad c_z = 5 \text{ in}$$

$$f_R = \left[\left(\frac{P_x}{A_w} + \frac{M_z}{S_z} + \frac{M_y}{S_{wy}} \right)^2 + \left(\frac{P_y}{A_w} + \frac{M_x}{S_x} \right)^2 + \left(\frac{P_z}{A_w} + \frac{M_z}{J_w} \right)^2 \right]^{1/2}$$

$$= \left[\left(\frac{23528}{30} + \frac{123153}{116.6} + \frac{124905}{50} \right)^2 + \left(\frac{12290}{30} + \frac{53767(5)}{916.66} \right)^2 + \left(\frac{4822}{30} + \frac{53767(6.67)}{916.66} \right)^2 \right]^{1/2}$$


$$= 4430 \text{ lb/in}$$

$$WELD \cdot LEG. \quad w = \frac{f_R}{f_{all}} = \frac{4430}{0.77(27000)} = 0.232" < \frac{7}{16} (438")$$

W.O. No. 39M-76 Date 10/4/23 Book No. 8.16.50 Page No. 79
 Drawing No. RHE-970N Calc. No. 8.16.5037 Sheet 79 Cont. on Sheet 80
 By Ed Ramon Checked Ed Ramon Approved _____
 Title MEB-50 STUDY

WELD STRESS IS VERY LOW \therefore WELD IS ACCEPTABLE
 THE OTHER WELDS MEM 4 J&4 AND MEM. 3 J&3
 ARE ACCEPTABLE BY COMPARISON.

FOR MEMBERS 1&2 WELD AT MEMBER 1 J&2
 IS DONE FOR AN EXAMPLE. IT HAS BOTH HIGH
 LOAD REACTIONS AND THE SMALLEST WELD AREA.

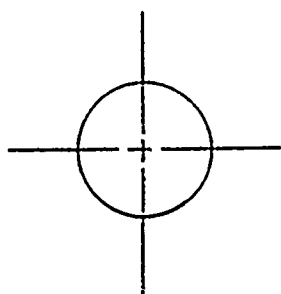

16" ϕ PIPE

$$A_w = 2\pi r = 2\pi \cdot 8 = 50.3 \text{ in}$$

$$S_w = \frac{\pi d^2}{4} = \frac{\pi 16^2}{4} = 201 \text{ in}^2$$

$$J_w = \frac{\pi d^3}{4} = \frac{\pi 16^3}{4} = 3216.99$$

LOAD CASE 'PKFMEB' PAGE 25

$$\begin{aligned} F_A &= 12011 \text{ lb} & M_T &= 321931 \text{ lb-in} \\ F_1 &= 19852 \text{ lb} & M_1 &= 200083 \text{ lb-in} \\ F_2 &= 9981 \text{ lb} & M_2 &= 154689 \text{ lb-in} \end{aligned}$$

$$f_r = \left[\left(\frac{F_A}{A_w} + \frac{M_1 + M_2}{S_w} \right)^2 + \left(\frac{(F_1^2 + F_2^2)^{1/2}}{A_w} \right)^2 + \left(\frac{M_T}{J_w} \right)^2 \right]^{1/2}$$

$$\begin{aligned} &= \left[\left(\frac{12011}{50.3} + \frac{200083 + 154689}{201} \right)^2 + \left(\frac{(19852^2 + 9981^2)^{1/2}}{50.3} \right)^2 + \left(\frac{321931(8)}{321699} \right)^2 \right]^{1/2} \\ &= 2103 \text{ lb/in} \end{aligned}$$

$$\text{WELD LEG } \omega = \frac{f_r}{f_{all}} = \frac{2103}{0.707(27000)} = 0.11 \text{ in} < 5/16" (0.313)$$

W.O. No. 3900-76 Date 10/14/83 Book No. 8.16.5037 Page No. 80
Drawing No. RHE-9102N Calc. No. 8.16.5037 Sheet 80 Cont. on Sheet 81
By Ed Ramon Checked Ed Ramon Approved _____
Title MEB-50 STUDY

WELD STRESS IS VERY LOW \therefore WELD IS
ACCEPTABLE.

THE OTHER WELDS ON MEM. 1 Jt 8 AND
MEM. 2 Jt 7 AND 5 ARE ACCEPTABLE BY COMPARISON

\therefore SUPPORT IS ACCEPTABLE

