
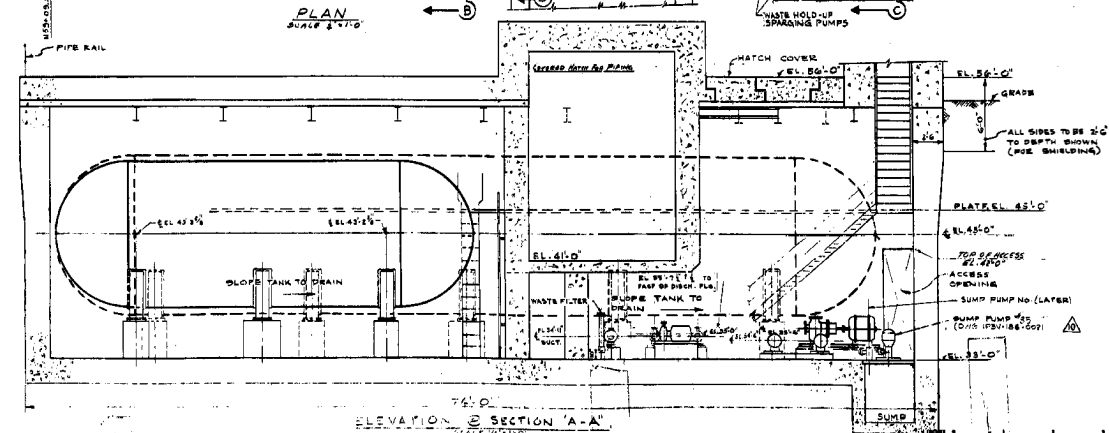
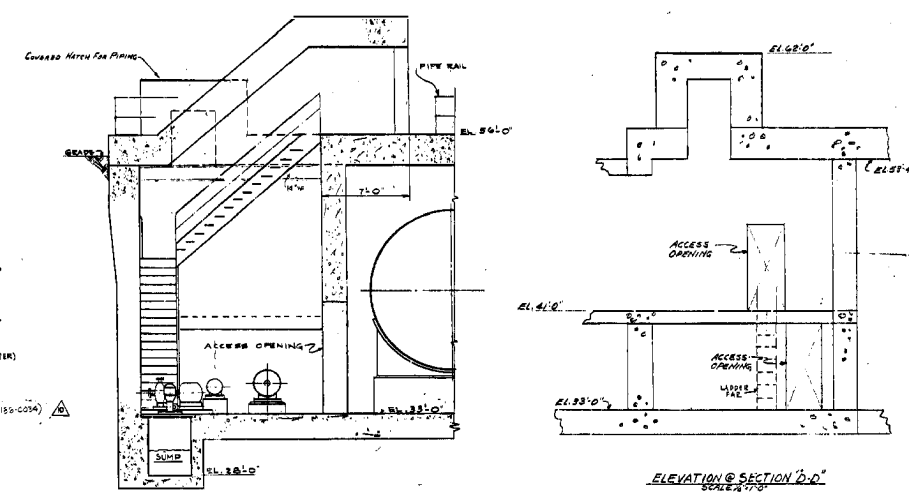
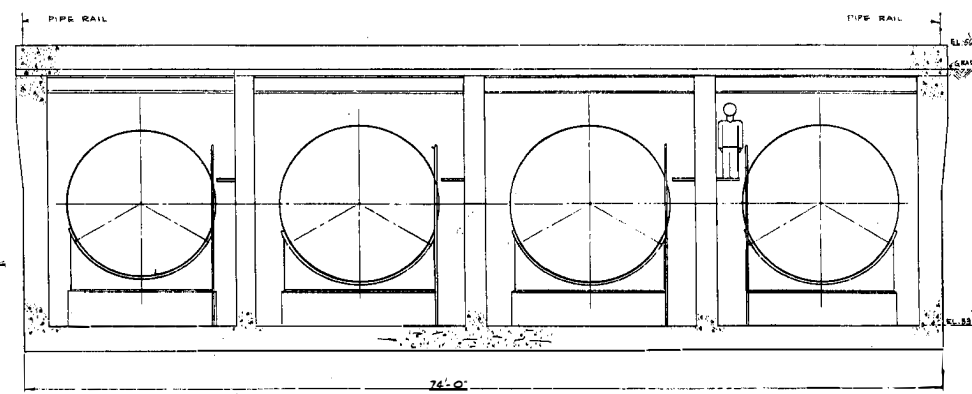


PLANT NORTH

1/4" = 1'-0"

1/4" = 1'-0"

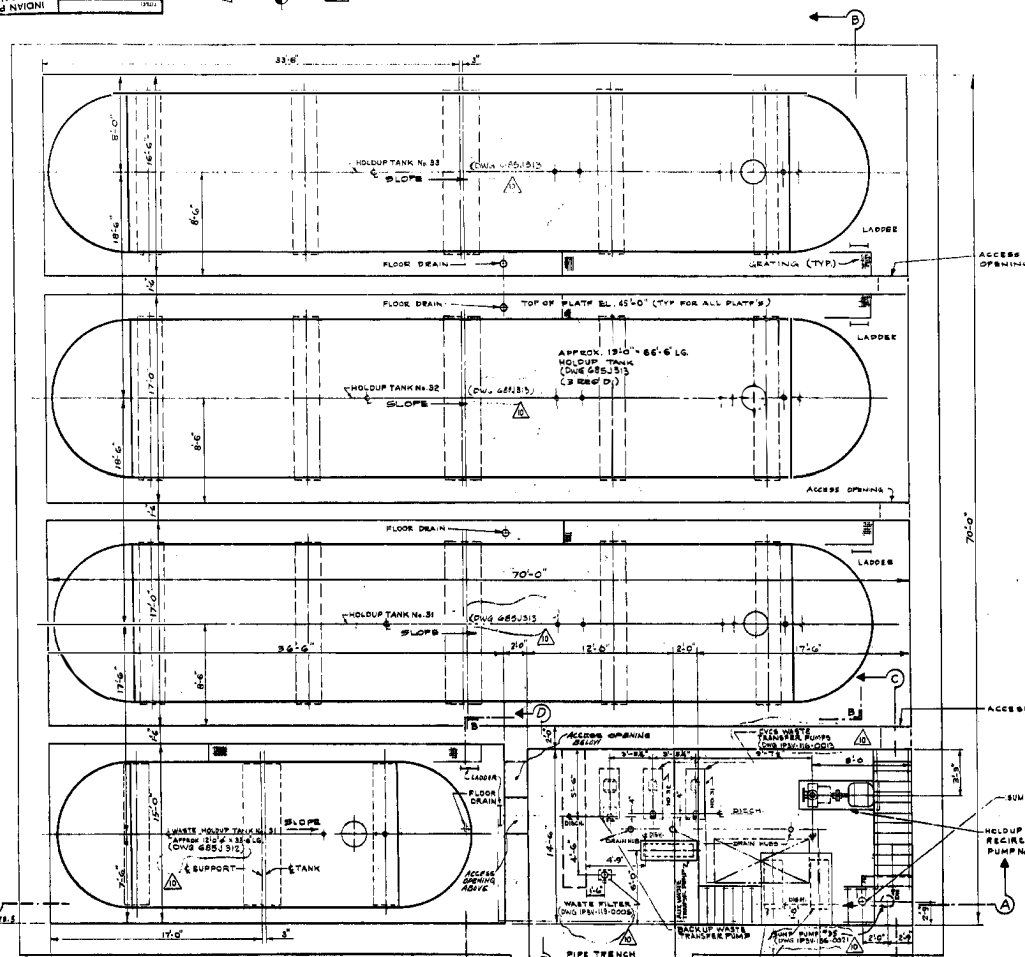

REFERENCE DRAWINGS

PLOT PLAN 9321-F-1002.3
 PUMP, AUX. BLDG. GEN. ASST. PLANS 9321-F-2010.3
 WASTE HOLDUP TANK PIT CONCRETE DETAILS SHT. 1 9321-F-1100.3

10	AS BUILT PER	DCR 1000-1507.4	3/1/76
9	WASTE HOLDUP TANK PIT	DCR 1000-28176	3/1/76
8	WASTE HOLDUP TANK PIT	DCR 1000-28176	3/1/76
7	WASTE HOLDUP TANK PIT	DCR 1000-28176	3/1/76
6	WASTE HOLDUP TANK PIT	DCR 1000-28176	3/1/76
5	WASTE HOLDUP TANK PIT	DCR 1000-28176	3/1/76
4	WASTE HOLDUP TANK PIT	DCR 1000-28176	3/1/76
3	WASTE HOLDUP TANK PIT	DCR 1000-28176	3/1/76
2	WASTE HOLDUP TANK PIT	DCR 1000-28176	3/1/76
1	WASTE HOLDUP TANK PIT	DCR 1000-28176	3/1/76

WESTINGHOUSE ELECTRIC CORPORATION
 WASTE HOLDUP TANK PIT
 GENERAL ARRANGEMENT
 PLAN & ELEVATIONS
 FOR
 CONSOLIDATED EDISON COMPANY
 INDIAN POINT GENERATING STATION
 UNIT NO. 3
 9321-F-25173-10 4205033