

A006

REGULATORY INFORMATION DISTRIBUTION SYSTEM

DOCKET NBR: 50-220 NINE MILE PT 1
 RECIPIENT: IPPOLITO, T.A.
 ORIGINATOR: DISE, D.P.
 COMPANY: NIAGARA MOHAWK
 SUBJECT:

DOC DATE: 781117
 ACCESSION NBR: 7811290192
 COPIES RECEIVED:
 LTR 1 ENCL 0
 SIZE: 41

Forwards requested info: Fire Pump Test Curves, Fire Main Connections, Floor Drain Sys
Drawings (27) Test Plan & Specs for Pipe & Cable Penetration Fire Stop Qual Tests.
Oversized drawings available in Central Files.

✓ FOR DRAWINGS SEE SELF
Docket FILES RECD 26 XEROX sheets of oversized.

DISTRIBUTION CODE: A006

DISTRIBUTION TITLE:

FIRE PROTECTION INFORMATION (AFTER ISSUANCE OF DL).

NOTARIZED

NAME

ENCL?

FOR ACTION

BR CHIEF
REG FILE
 NRC PDR
 I & E
 OELD
 AUXILIARY SYS BR
 AD FOR SYS & PROJ
 PLANT SYSTEMS BR
 WAMBACH
 R MURANAKA
 HANAUER
 LPDR
 TERA
 NSIC
 ACRS

W/4 ENCL
 W/ENCL
 W/ENCL
 W/2 ENCL
 LTR ONLY
 W/2 ENCL
 W/ENCL
 W/5 ENCL
 W/ENCL
 W/ENCL
 W/16 ENCL

• ORB#3 BC

TOTAL NUMBER OF COPIES REQUIRED:

5 DRWGS

LTR 39
 ENCL 38

REG FILE -
 I & E (1)
 PLANT SYS BR (3)

NOV 30 1978

NOTES:

TIA
CCP



23
1 2 3 100



UNITED STATES
NUCLEAR REGULATORY COMMISSION
WASHINGTON, D. C. 20555

MEMORANDUM FOR: TERA Corp.

FROM: US NRC/TIDC/Distribution Services Branch

SUBJECT: Special Document Handling Requirements

- ☒ 1. Please use the following special distribution list for the attached document.

LTR
A006

5 DRWGS
REG FILE
1 & E (1)
PLANT SYS BR (3)

- ☒ 2. The attached document requires the following special considerations:

- ☒ Do not send oversize enclosure to the NRC PDR. OR TERA
- ☐ Only one oversize enclosure was received - please return for Regulatory File storage.
- ☐ Proprietary information - send affidavit only to the NRC PDR
- ☐ Other: (specify)

REGULATORY DOCKET FILE COPY

cc: DSB Files

Michael Allie
TIDC/DSB Authorized Signature

NIAGARA MOHAWK POWER CORPORATION

NIAGARA  MOHAWK

300 ERIE BOULEVARD, WEST
SYRACUSE, N. Y. 13202

November 17, 1978

Director of Nuclear Reactor Regulation
Attn: Mr. Thomas Ippolito, Chief
Operating Reactors/Branch #3
U. S. Nuclear Regulatory Commission
Washington, D. C. 20555

Dear Mr. Ippolito:

Enclosed is additional information requested during the Nine Mile Point Unit 1 Fire Protection site visit during the week of October 16, 1978. Five copies of the following are provided:


1. Fire Pump Test Curves
2. Fire Main Connections between Unit 1 and Unit 2
3. Drawings of the Floor Drain System
4. Test Plan and Specification for Pipe and Cable Penetration Fire Stop Qualification Tests

This completes our response to requests received to date.

Very truly yours,

NIAGARA MOHAWK POWER CORPORATION

7811290192

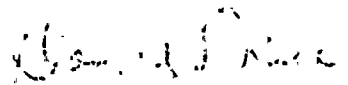
Donald P. Dize
Vice President-Engineering

NLR/szd

Enclosures

220F

*Approved
3/30
500005 TO
LIST*

ANNUAL FIRE PUMP TEST SHEET

MAKE Fairbanks Morse Model or type 16A-C6-922F Serial No. K2A20186-97
 Rated Capacity 2500 gpm. at rated head 125 psi., ft. at rated speed 1750 rpm.
 Net pressure at shutoff 161 psi. Net pressure at 150% rated capacity 94 psi.
 Brake horsepower at rated conditions 274 Max. brake H.P. at rated speed at any capacity 291
 Horizontal, vertical, turbine 3 stages impeller dia. 11 13/16 inches.

SUCTION FROM: Screen Well Capacity Unlimited Gals.

Lift 3 1/2 ft.
Head _____ ft., psi.

Vertical Turbine Discharge Head to Water Level 11 Ft.
Vertical Turbine Lowest Impeller to Water Level _____ Ft.

JOCKEY OR MAKE-UP PUMP: Make Ing Rand Type CMR11N Rated Capacity 30 gpm.
Rated Head 123 psi., ft. Cut-in _____ psi., Cut-out _____ psi.
Centrifugal or Positive Displacement Type. Relief Valve Setting _____ psi.

SPECIAL COMMENTS Make sure relief valve isn't discharging during test

Check engine tachometer against Insp. Speed Counter. Plot test points on N-15-H Sheet 2

Electric


00172


11013

Spot Annual Discharge Test Points Against Manufacturer's Characteristic Curve:

For Booster Pump, Spot Suction Readings.

rated
shutoff

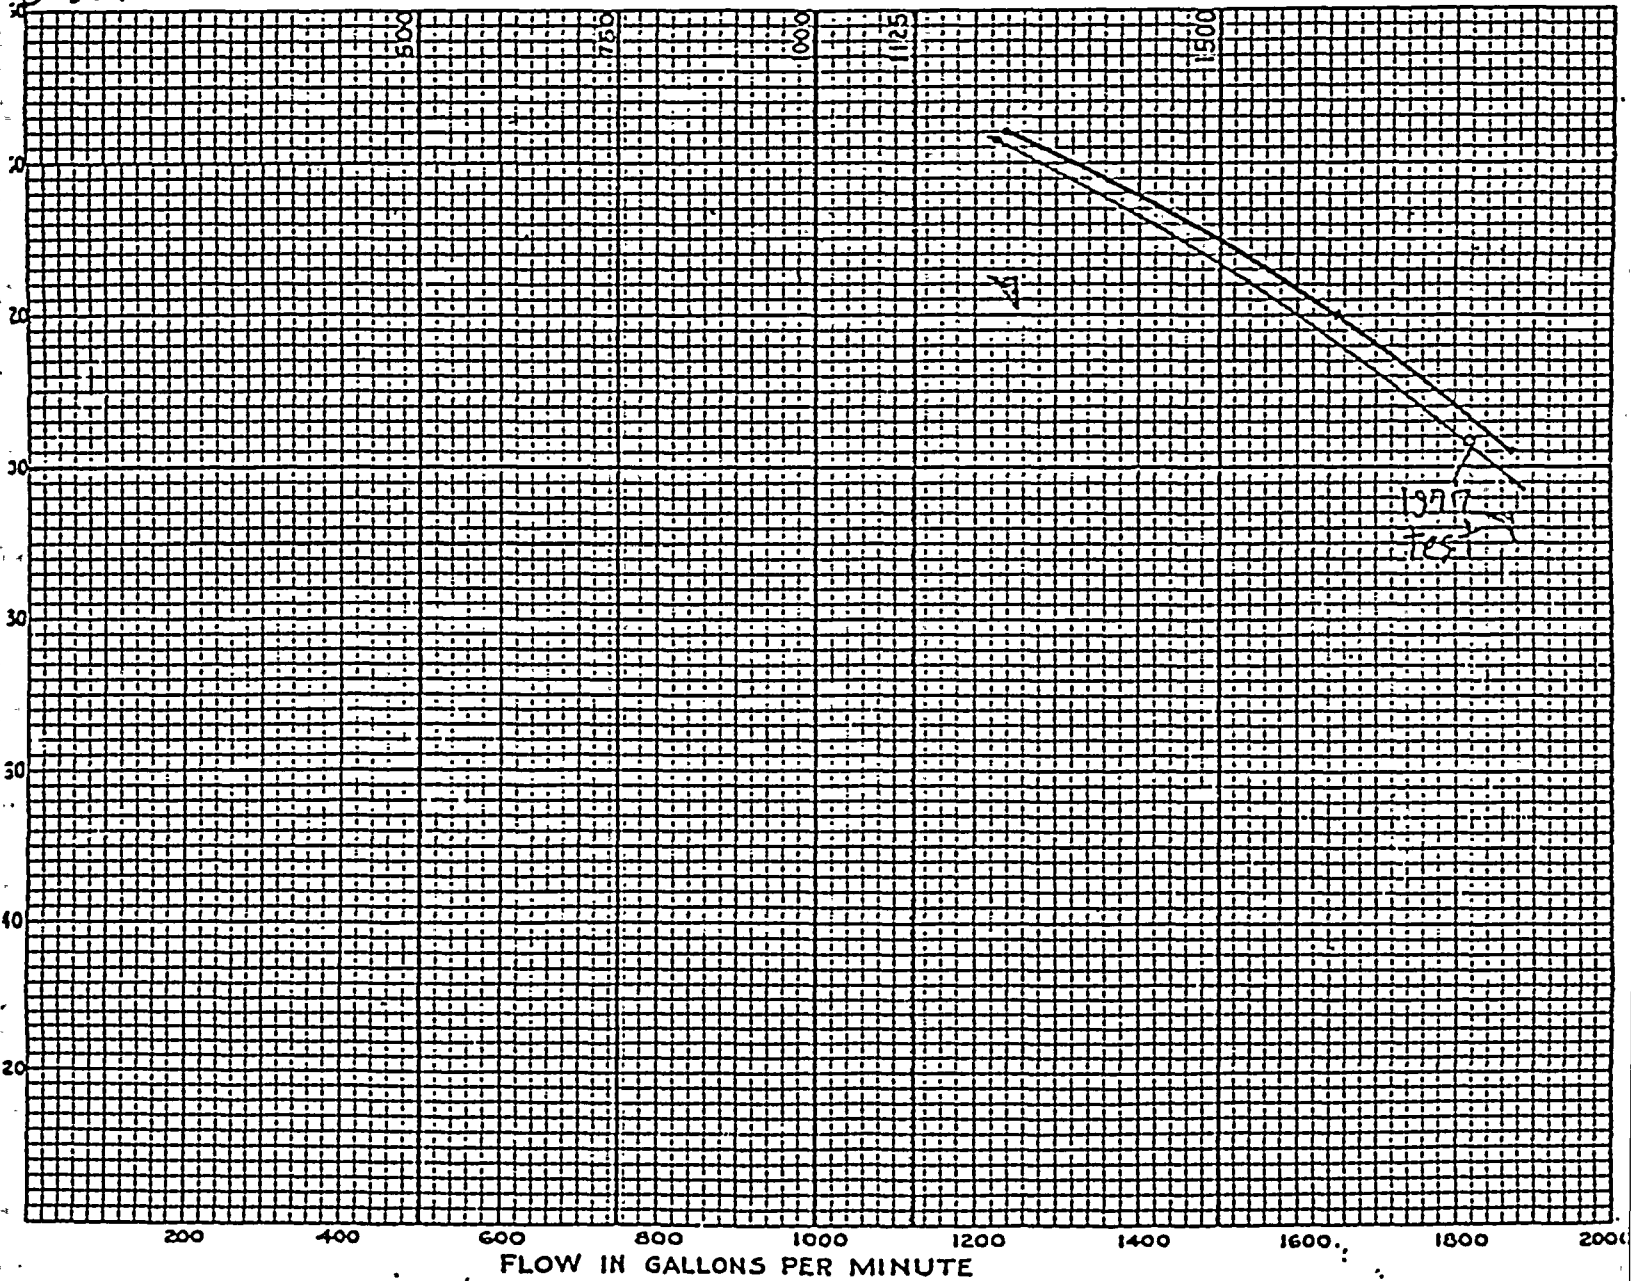

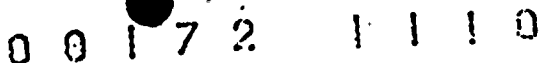

MAKE Worthington Model or type 15HH410WF Serial No. VTP15214
 Rated Capacity 2500 gpm. at rated head 125 psi., ft. at rated speed 1770 rpm.
 Net pressure at shutoff 181 psi. Net pressure at 150% rated capacity 98 psi.
 Brake horsepower at rated conditions 260 Max. brake H. P. at rated speed at any capacity 270
 Horizontal, vertical, turbine 4 stages impeller dia. 9 3/16 inches.

DRIVEN BY: Electric motor, steam, turbine, gasoline, diesel, engine, water wheel, no clutch. JRC wants both cut-ins the same.

Lift 14 ft. Vertical Turbine Discharge Head to Water Level 11 Ft.
Head ft., psi. Vertical Turbine Lowest Impeller to Water Level Ft.


JOCKEY OR MAKE-UP PUMP: *Same as electric fire pump*
 Make _____ Type _____ Rated Capacity _____ gpm.
 Rated Head _____ psi., ft. Cut-in _____ psi., Cut-out _____ psi.
 Centrifugal or Positive Displacement Type. Relief Valve Setting _____ psi.

SPECIAL COMMENTS Make sure relief valve isn't discharging during test


Check engine tachometer against Insp. Speed Counter. Plot test points on N-15-H Sheet 2.

00172 1111

Spot Annual Discharge Test Points Against Manufacturer's Characteristic Curve:
For Booster Pump, Spot Suction Readings.

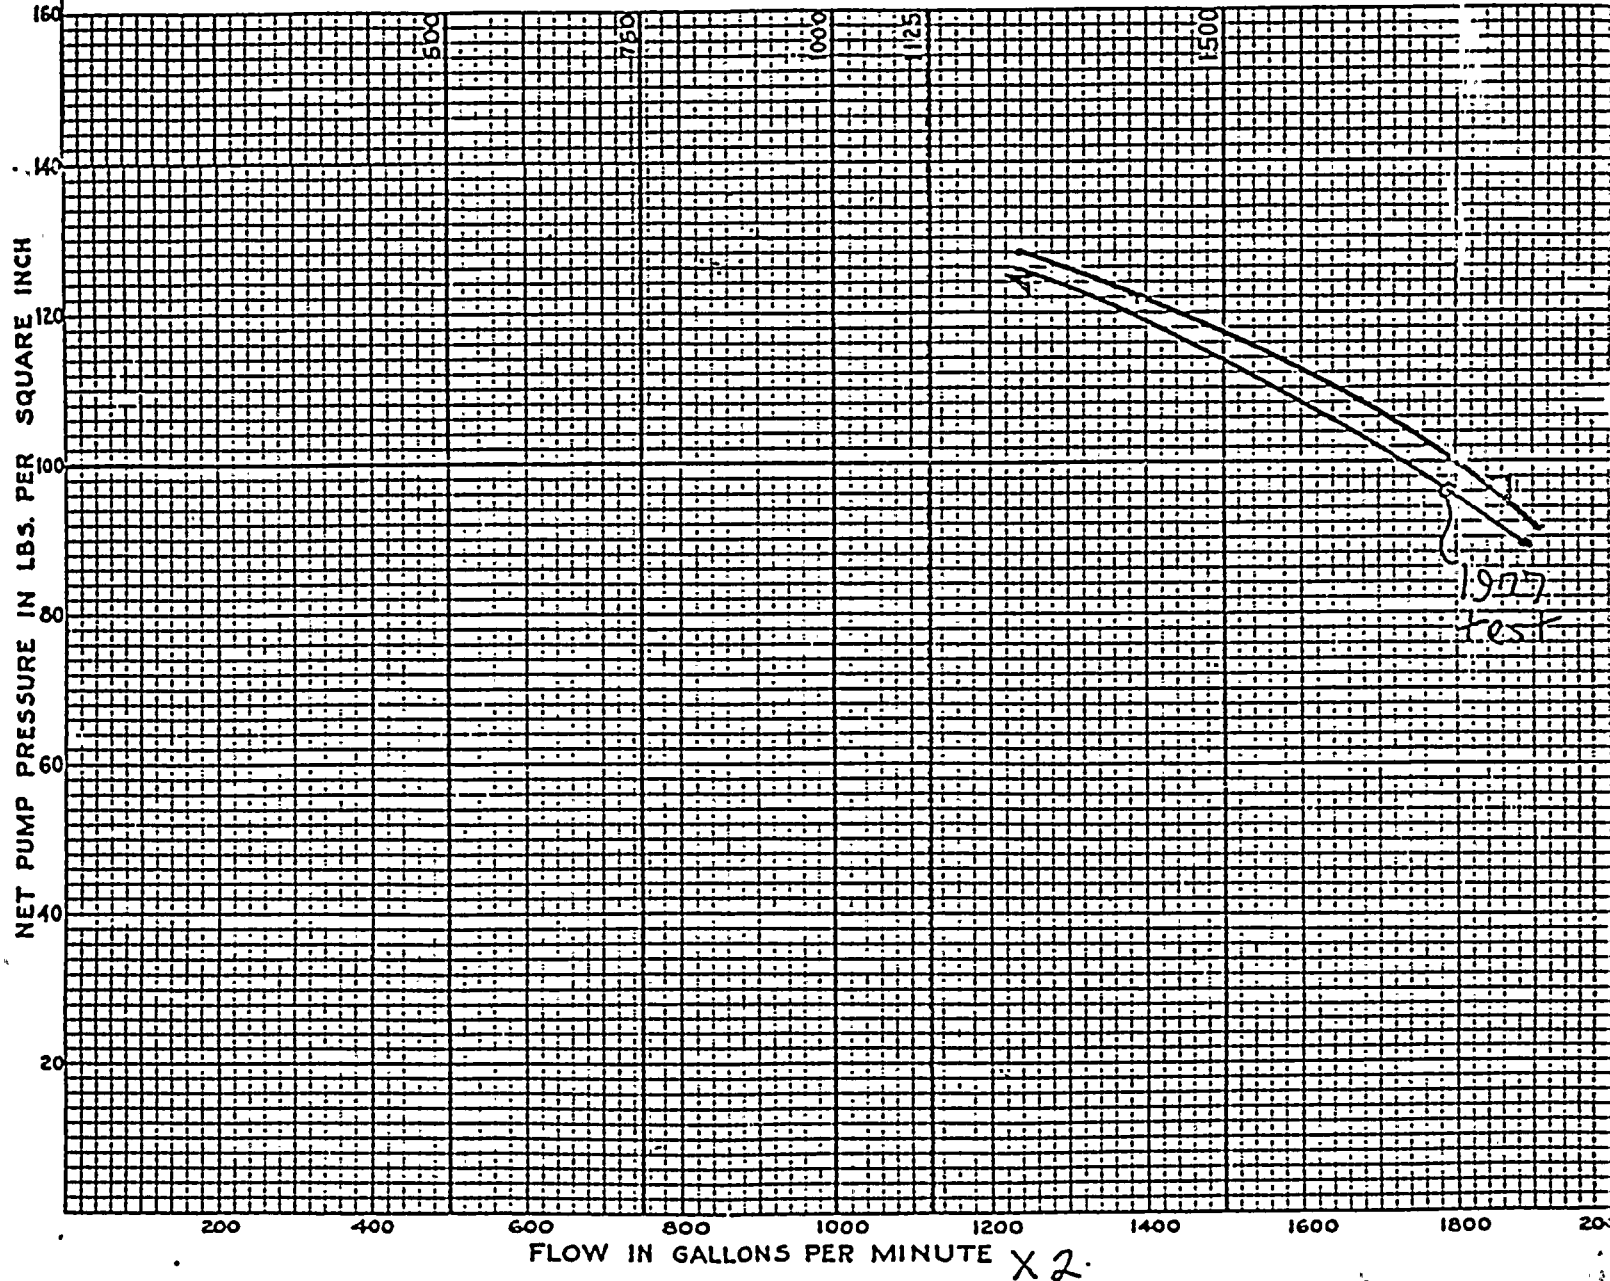


X 2.

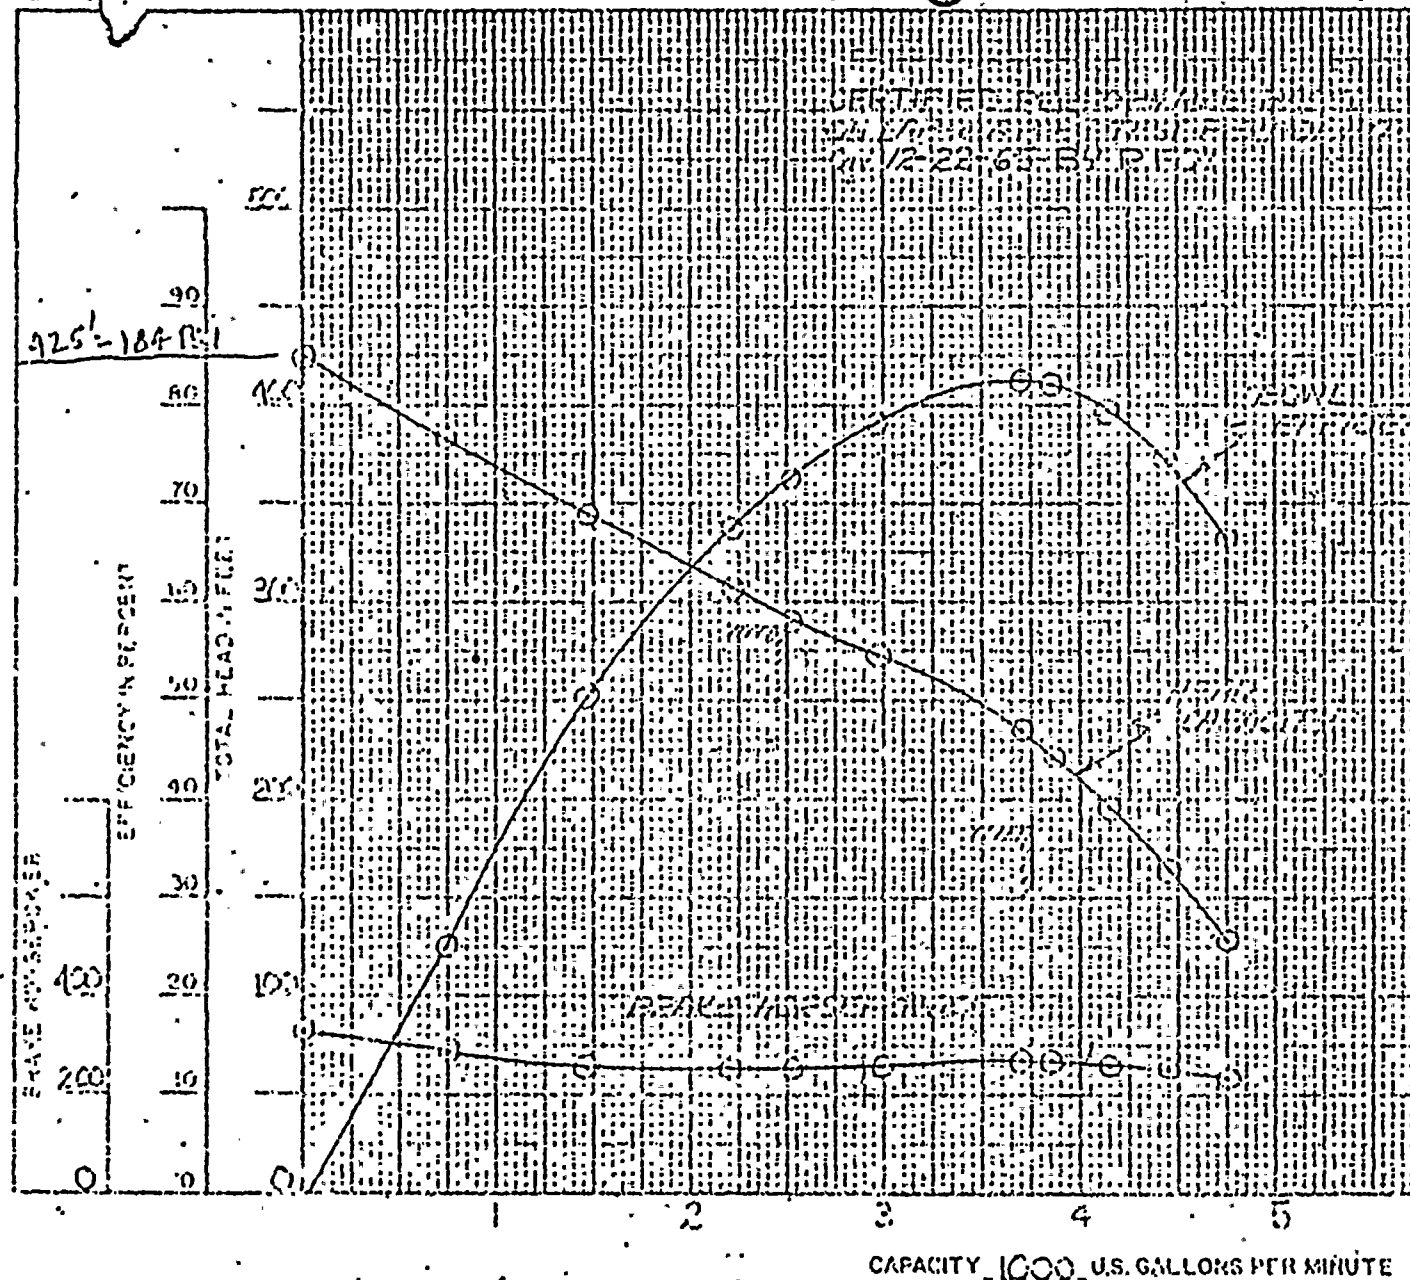

THIS PUMP IS DESIGNED FOR 2500 GPM AT
 250 FEET TOTAL HEAD AT 1770 RPM
 72% BOWL EFFICIENCY
 FOR FIELD PERFORMANCE DEDUCT 3 FEET
 FROM TOTAL HEAD AT DESIGN CAPACITY FOR
 COLUMN FRICTION
 ADD 10 FEET FOR IN-SHAFT FRICTION
 THIS CURVE ALSO SHOWS APPROXIMATE PER-
 FORMANCE AT OTHER THAN DESIGN CONDITIONS

2500 GPM
 Distribute
 1-21-67

Diesel-Fire

FRONZ DESIGNER	C.J. Elmer BOWL	LEHMAN PUMP		WORTHINGTON CORPORATION	12-22-66 DATE	VTP-15211 SERIAL NO.
9.25' x 11.5' x 11.5' O.D. DIA.	2500 H.P. PER STAGE CIVIL	4 NO. OF STAGES			CUST. NO.	VTP-25562 ORDER NO.
11.5' x 11.5' x 11.5' I.D. DIA.	1770 RPM	RF DRAWN BY	VERTICAL PUMP DIVISION DENVER, COLORADO, U.S.A. ALHAMBRA, CALIFORNIA, U.S.A.		QUOTE NO.	CURVE NO.

SO. 425' JRG.

DIFFERENTIAL PUMP

100-02

PUMP NO. *KEJ2-3657*

STAGES *3*

SIZE-FIGURE *16 HC 6225F*

TESTED *WILSON-ANDERSON*

REFERENCE *FRANKE*

IMPELLER *31264*

PLOTTED *LWH 2/66*


DRIVER *DYNMO 300 HP*

IMP. DIA. *11 13/16"*

TOTAL SUCTION FT.

MAXIMUM ON TEST

RPM *1750*

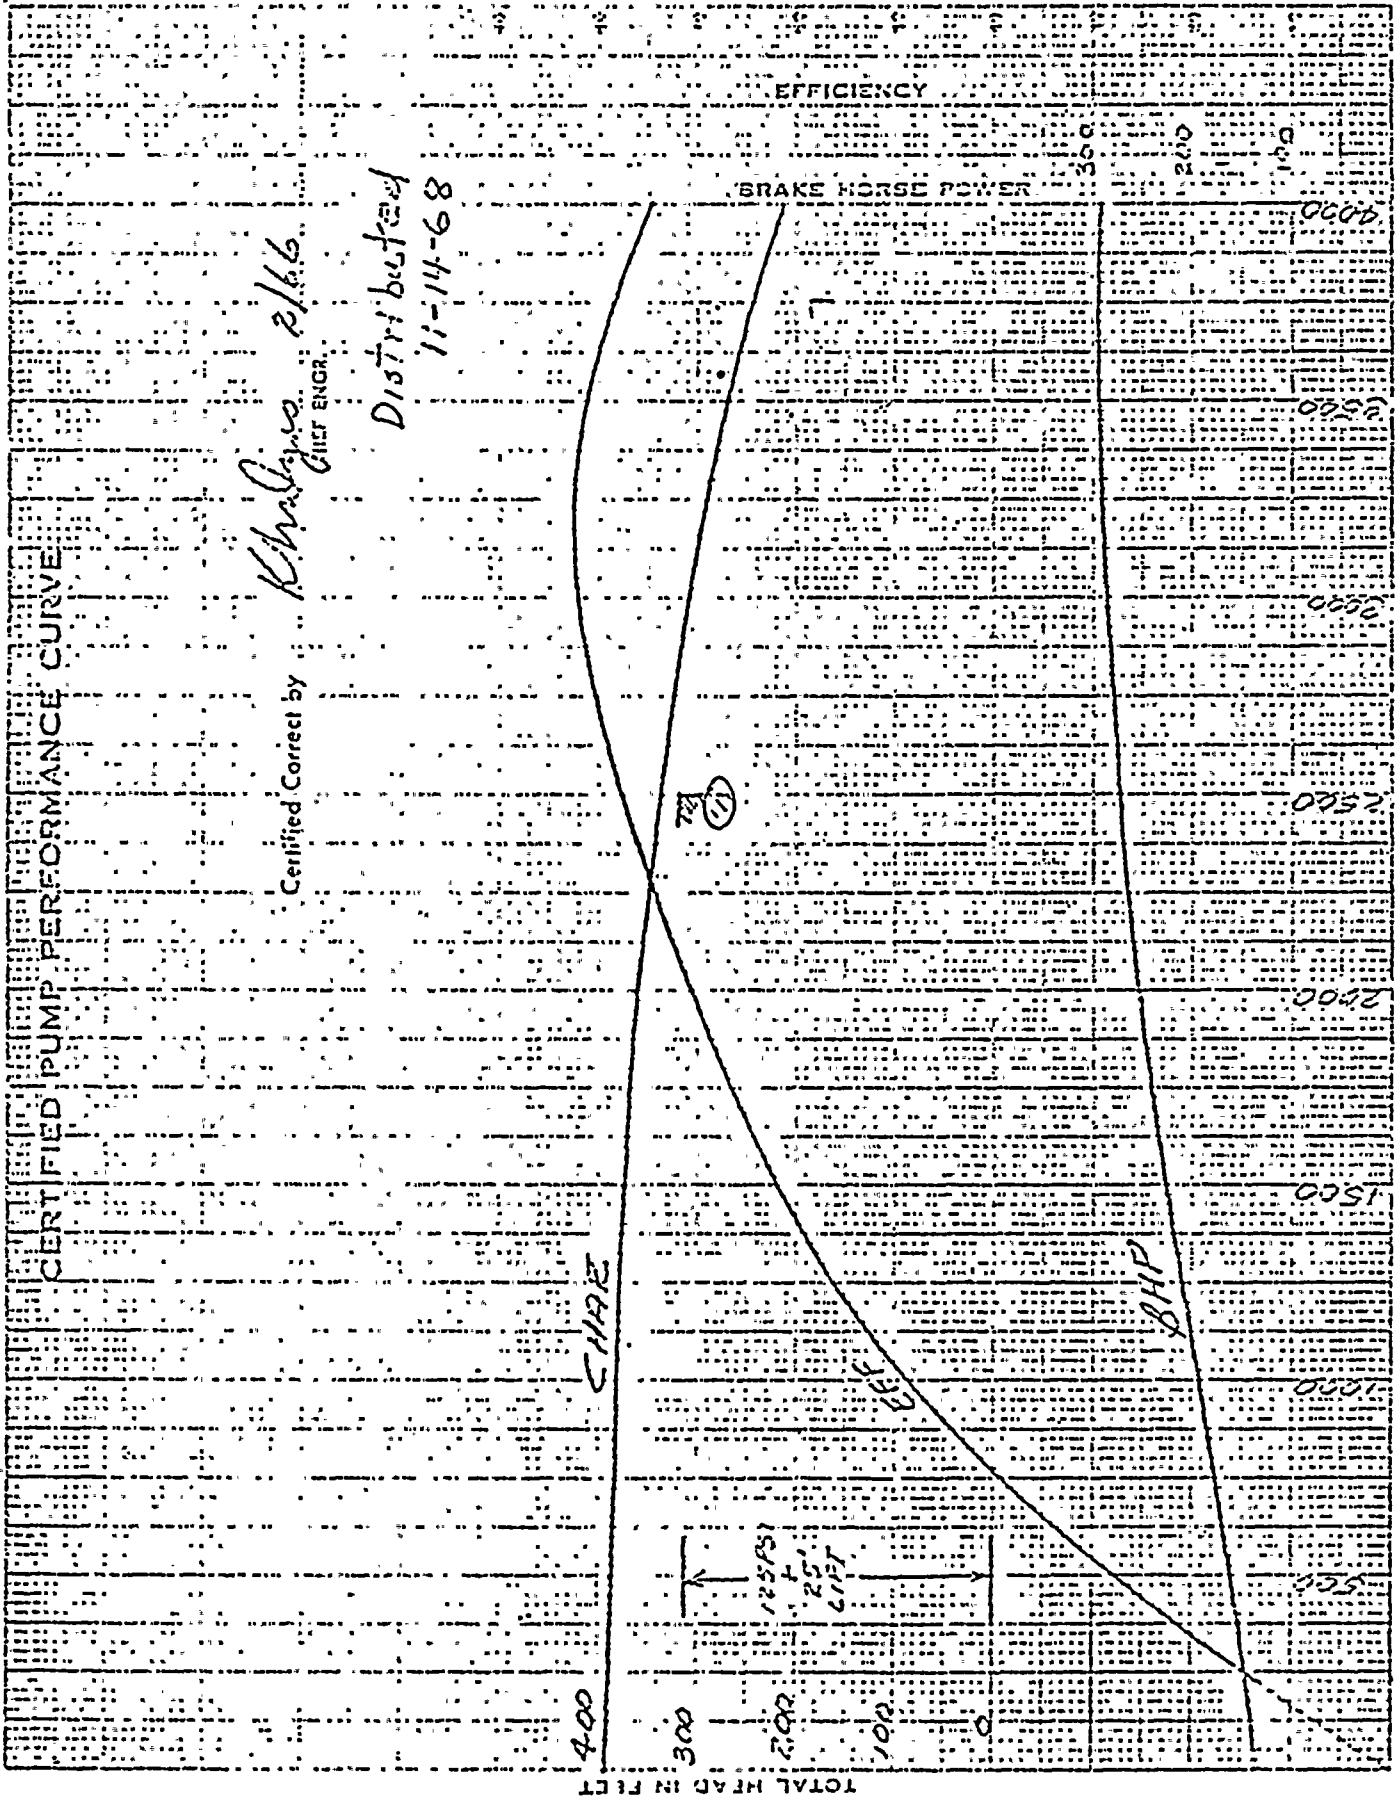

Khalyso 2/66
CHIEF ENGR.
Distributed
11-14-68

Certified Correct by

TEST PLAN AND SPECIFICATION FOR
PIPE AND CABLE PENETRATION FIRE STOP
QUALIFICATION TESTS
FOR
EXISTING OR PROPOSED PIPE AND CABLE PENETRATION FIRE STOPS

Prepared By

D. E. Sandwick
D. E. Sandwick

10-16-78
Date

Reviewed By

A. P. Baleno
A. P. Baleno

10/17/78
Date

Approved By

J. R. Corcoran
J. R. Corcoran

10/20/78
Date

C. V. Mangab
C. V. Mangab

10/20/78
Date

Concurrence

P.N. Castonguay-QC
P.N. Castonguay-QC

10-17-78
Date

1.0 PURPOSE

The purpose of this test program is to establish the fire rating of various cable penetration fire stops and pipe penetrations in accordance with IEEE Standard 634-1978 "IEEE Standard Cable Penetration Fire Stop Qualification Test."

2.0 SCOPE

This test program involves a floor (horizontal) test and wall (vertical) test of various selected cable and pipe penetration fire stops that are either currently installed at Nine Mile Point Nuclear Station Unit 1 or under consideration for future installation.

3.0 CABLE PENETRATION FIRE STOPS TO BE TESTED

The cable penetration fire stops detailed on drawings LMP 101178A and LMP 101178B shall be tested. The specified test slab size or arrangement of the cable penetration fire stops on the wall or slab may be modified by the testing laboratory. Any proposed changes or modifications to the slab or cable penetration fire stop arrangement shall be delineated in a specific section of the bid proposal and identified as exceptions.

4.0 MATERIALS TO BE SUPPLIED

All cables, trays, fire stop materials and penetration internal or external sleeves, plates, or other materials to be tested will be furnished by Niagara Mohawk Power Corporation. All materials required for the construction of the wall and floor slab, instrumentation to monitor the test parameters, and materials required to perform the test shall be provided by the successful bidder.

5.0 PREPARATION OF TEST SLAB AND INSTALLATION OF PENETRATIONS AND CABLE

The construction and assembly of the test slabs shall be the responsibility of the testing laboratory. Installation of raceway, cables and fire stop material shall be the responsibility of either the testing laboratory or Niagara Mohawk Power Corporation. Bidders shall provide alternate proposals for the test program with and without penetration, cable and raceway installation.

All bidder's proposals shall detail the proposed size and construction of the wall and floor slab.

6.0 TEST INSTRUMENTATION

- 6.1 Exposed flame side instrumentation shall include a minimum of three thermocouples symmetrically distributed on each cable and pipe penetration fire stop. The thermocouples shall be enclosed in sealed porcelain tubes 3/4 inch (19 mm) in outside diameter and 1/8 inch (3 mm) in wall thickness or in sealed, standard weight, 1/2 inch (13 mm) black wrought steel or iron pipe for base metal thermocouples. The exposed length of the pyrometer tube and thermocouple in the flame area shall not be less than 12 inches.

The thermocouple junction shall be placed 12 inches away from the exposed face of the floor slab cable penetrations and 6 inches away from the exposed face of the wall. Thermocouples shall not touch the test penetrations during the test in the event of deflection.

Exposed side temperature measurements shall be recorded on continuous pen or multipoint recorder(s).

- 6.2 Unexposed (cold) side instrumentation for cable penetration fire stops shall include a minimum of three thermocouples for each fire stop. As a minimum, temperature shall be measured at the cable jacket, cable penetration fire stop interface; the interface between the fire stop, and through metallic components, other than the insulated cable conductor; and on the surface of the fire stop material.
- 6.3 Unexposed (cold) side instrumentation for pipe penetrations shall include one thermocouple on the face of each penetration at least 1/2 inch away from through metallic components. Pipe penetration unexposed side temperatures shall be recorded for information only.
- 6.4 Unexposed side temperatures for pipe and cable penetration fire stops shall be recorded on continuous pen or multipoint strip chart recorders.

7.0 PRE-TEST INSPECTION AND DOCUMENTATION

- 7.1 Upon complete assembly of the wall and floor slabs, installation of the pipe and cable penetration fire stops and placement of the thermocouples, the laboratory shall inspect the slabs, penetrations and thermocouple placement to determine compliance to this specification, drawings LMP101178 and LMP101178B and IEEE Standard 634-1978. Any deviations noted shall be corrected to comply with requirements or reported to the Niagara Mohawk Engineer for resolution.
- 7.2 Photographs shall be taken of both sides of the slabs and each penetration prior to placement in the oven.

8.0 CONDUCTING THE TEST

- 8.1 Upon initiation of the test, the time temperature curve specified in Appendix I of the IEEE Standard 634-1978 shall be followed. Flame source temperature accuracy shall be monitored throughout the test.

The accuracy of flame source shall be calculated by averaging the results of the pyrometer readings such that the area under the time-temperature curve is within the following tolerance:

0-1 Hour	10 %
1-2 Hours	7.5%
2-3 Hours	5 %

Any variances exceeding the acceptable tolerance should be explained in the issued final test report.

- 8.2 The fire test shall be terminated at 3 hours. Any penetrations that burn through prior to three hours shall be photographed and suitably filled with ceramic fiber to continue the fire test. The elapsed test time shall be recorded for any penetrations that burn through prior to three hours.

- 8.3 Upon completion of the three hour test, each slab shall be photographed and immediately positioned for a hose stream test. A 1-1/2 inch hose discharging through a nozzle approved for use on fires in electrical equipment producing a long-range-narrow-angle (30-90 degrees set at 30 degrees included angle) high velocity spray only be used. The following criteria shall be applied for the hose stream test (both wall and floor slabs):

Hose Nozzle Placement - 10 ft. from center of exposed surface
Calculated Water Pressure - 75 lbs/sq. inch (at base of nozzle)
Water Flow - 75 gallons/minute
Duration of Application - 2-1/2 minutes/100 sq. ft. of test slab

- 8.4 Photographs shall be taken of both sides of each test slab after completion of the hose stream test.

9.0 ACCEPTANCE CRITERIA

- 9.1 Cable penetration fire stops that have endured the three house test shall be considered qualified for three hour fire rated use if the following conditions are met.

- A. The cable penetration fire stop has withstood the fire endurance test without the passage of flame or gases hot enough to ignite the cable or other fire stop materials on the unexposed side.
- B. Transmission of heat through the cable penetration fire stop does not cause the unexposed side temperature to exceed 700 degrees F as measured by the unexposed side thermocouples.

- C. The fire stop withstands the hose stream test without the hose stream causing an opening through the test specimen.

9.2 Pipe penetration that have endured the three hour test shall be considered qualified for three hour rated use if the pipe penetration fire stop has:

- A. Withstood the fire endurance test without the passage of flame.
- B. Withstood the hose stream test without the hose stream causing an opening through the test specimen.

9.3 In the event that the Niagara Mohawk Power Corporation Engineer elects to terminate either test prior to three hours, in accordance with Section 10.1 of this specification, the remaining cable penetrations shall be considered qualified for the test period time duration providing that the criteria delineated in Section 9.1 A, B, & C are satisfied. Pipe penetration can be considered qualified for the elapsed test time period until termination if the criteria delineated in Section 9.2 A, B are satisfied.

10.0 CHANGES IN TEST PLAN

10.1 The Niagara Mohawk Power Corporation Engineer may elect to terminate the test prior to three hours. In this event, the time of termination shall be recorded, the oven burners turned off, photographs of the entire slab and each penetration taken and a hose stream test applied in accordance with Section 8.3 of this specification. See Section 9.3 for acceptance criteria.

10.2 Penetrations that burn through prior to the termination of the test shall be handled as described in Section 8.2

11.0 REQUIRED DOCUMENTATION

11.1 A test report shall be completed by the test laboratory upon completion of the test program. The test report shall describe the test set-up, measurement instruments, the test procedure, any irregularities, and the results of the tests. The test report shall contain a forward, summary of conclusions and a discussion section. The text of the test report shall be supplemented with applicable photographs.

11.2 Documentation to be supplied by Niagara Mohawk Power Corporation for inclusion in the test report:

- A. Description of cable materials and construction.
- B. Description of cable penetration fire stop design.
- C. Description of fire stop materials.
- D. Test program requirements (this specification).

- 11.3 Documentation to be supplied by the test laboratory for inclusion in the test report.
- A. Description of slab construction.
 - B. Description of test furnace.
 - C. Description and calibration records of measurement records.
 - D. Any applicable personnel qualification records.
 - E. Description of fire test performance and hose stream test.
- 11.4 The following records or copies of records shall be transmitted to Niagara Mohawk following the test program.
- A. Test data sheets.
 - B. All test photographs and negatives.
 - C. Measurement instrument calibration records.
 - D. Temperature strip chart recordings.
- 11.5 All test reports, records, data and photographs shall be the sole property of Niagara Mohawk Power Corporation at the termination of the test program. None of this material shall be released to anyone without prior written approval of an authorized Niagara Mohawk Power Corporation Officer.

12.0 QUALITY ASSURANCE

- 12.1. Measures shall be implemented to assure that test tools, gauges, instruments and other measuring and testing devices which may affect the test program are properly calibrated and adjusted at specified periods to maintain accuracy within necessary limits. All calibration shall be traceable to the National Bureau of Standards.
- 12.2 A suitable procedure or test plan and checklist shall be developed by the testing laboratory to assure compliance to this specification and applicable sections of IEEE Standard 634-1978 "IEEE Standard Cable Penetration Fire Stop Qualification Test".
- 12.3 Niagara Mohawk Power Corporation reserves the right to audit the calibration program for measuring and test equipment applicable to this test program and the procedures, test plans and checklist developed to assure compliance to this specification. Audits may be performed to verify the acceptability of these quality assurance documents or to verify the implementation of the established requirements. The testing laboratories shall grant Niagara Mohawk Power Corporation representatives free access to all documents and work areas deemed necessary to perform thorough and meaningful audits, limited to areas and documents appropriate to this project. Furthermore, the test laboratory shall act promptly to obtain Niagara Mohawk Power Corporation acceptance or remedial or corrective action by non-conformances and shall implement the same promptly after receipt of Niagara Mohawk Power Corporation acceptance.

12.4


Niagara Mohawk Power Corporation Engineers or Inspectors shall have the right at any time to witness tests and inspect test equipment used or to be used in connection with the test program.

12.5

Documentation shall be provided by the testing laboratory which verifies that the fire test room or area meets the minimum requirements defined in American National Standard A2.1-1972, Section 10.1.

7811290192 -01

D

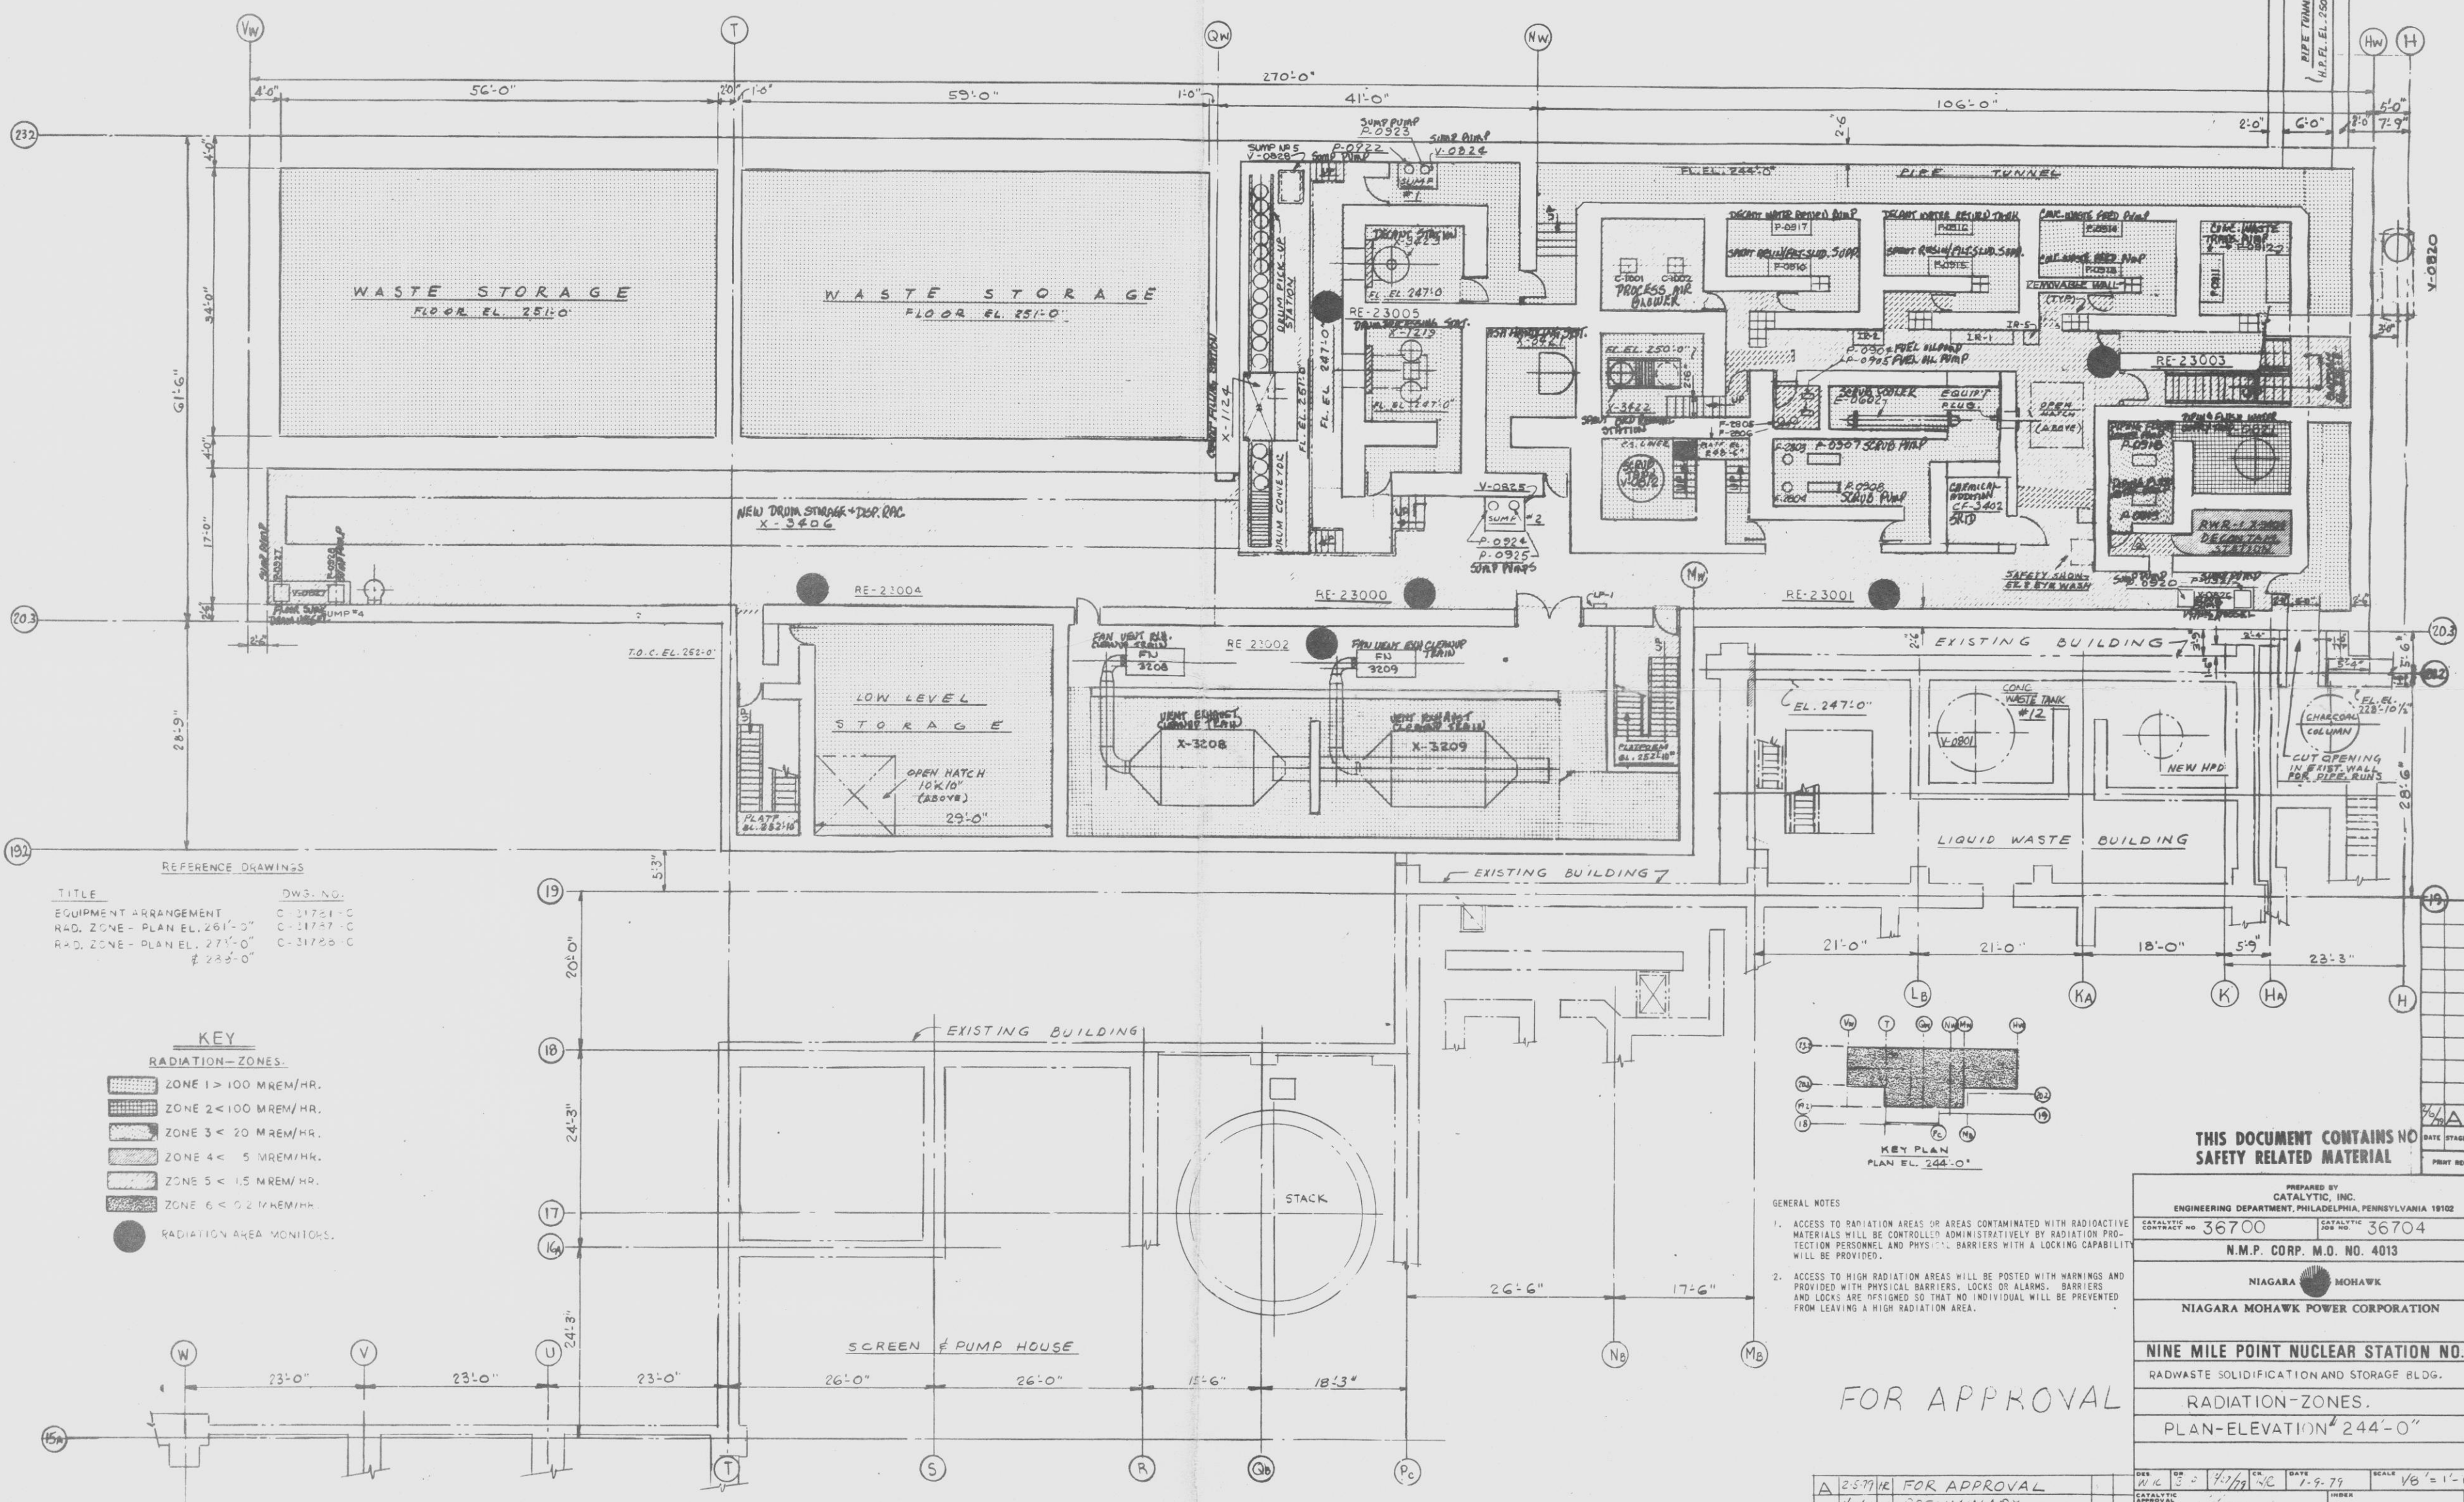

TITLE
EQUIPMENT ARRANGEMENT
RAD. ZONE - PLAN EL. 261'-0"
RAD. ZONE - PLAN EL. 271'-0"
RAD. ZONE - PLAN EL. 281'-0"

DWS. NO.
C-31721-C
C-31727-C
C-31728-C

- KEY
- RADIATION ZONES:
- ZONE 1 > 100 MREM/HR.
 - ZONE 2 < 100 MREM/HR.
 - ZONE 3 < 20 MREM/HR.
 - ZONE 4 < 5 MREM/HR.
 - ZONE 5 < 1.5 MREM/HR.
 - ZONE 6 < 0.2 MREM/HR.
- RADIATION AREA MONITORS.

- GENERAL NOTES
- ACCESS TO RADIATION AREAS OR AREAS CONTAMINATED WITH RADIOACTIVE MATERIALS WILL BE CONTROLLED ADMINISTRATIVELY BY RADIATION PROTECTION PERSONNEL AND PHYSICAL BARRIERS WITH A LOCKING CAPABILITY WILL BE PROVIDED.
 - ACCESS TO HIGH RADIATION AREAS WILL BE POSTED WITH WARNINGS AND PROVIDED WITH PHYSICAL BARRIERS, LOCKS OR ALARMS. BARRIERS AND LOCKS ARE DESIGNED SO THAT NO INDIVIDUAL WILL BE PREVENTED FROM LEAVING A HIGH RADIATION AREA.


FOR APPROVAL


THIS DOCUMENT CONTAINS NO
SAFETY RELATED MATERIAL


PREPARED BY CATALYTIC, INC. ENGINEERING DEPARTMENT, PHILADELPHIA, PENNSYLVANIA 19102	
CATALYTIC CONTRACT NO. 36700	CATALYTIC JOB NO. 36704
N.M.P. CORP. M.O. NO. 4013	
NIAGARA MOHAWK NIAGARA MOHAWK POWER CORPORATION	
NINE MILE POINT NUCLEAR STATION NO. 1 RADWASTE SOLIDIFICATION AND STORAGE BLDG.	
RADIATION ZONES. PLAN-ELEVATION 244'-0"	

DESIGNED BY	W.K.	DATE	1-9-79	SCALE	1/8" = 1'-0"
DRAWN BY	J.H.	DATE	1-9-79	INDEX	
CHECKED BY		DATE		REV.	
APPROVED BY		DATE		NO.	C-31786-C

D

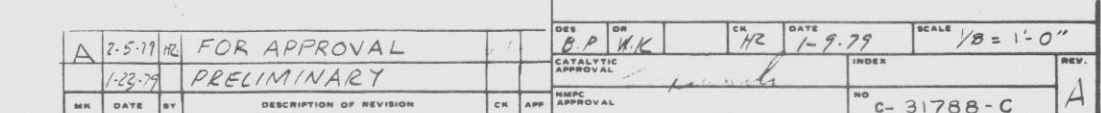


SAFETY RELATED MATERIAL	
PREPARED BY CATALYTIC, INC. ENGINEERING DEPARTMENT, PHILADELPHIA, PENNSYLVANIA 19102	
CATALYTIC CONTRACT NO.	36700
CATALYTIC JOB NO.	36704
N.M.P. CORP. M.O. NO. 4013	
NIAGARA  MOHAWK	
NIAGARA MOHAWK POWER CORPORATION	
NINE MILE POINT NUCLEAR STATION NO. 1	
RADWASTE SOLIDIFICATION AND STORAGE BLDG.	
RADIATION-ZONES	
PLAN - EL.273'-0" & EL.289'-0"	

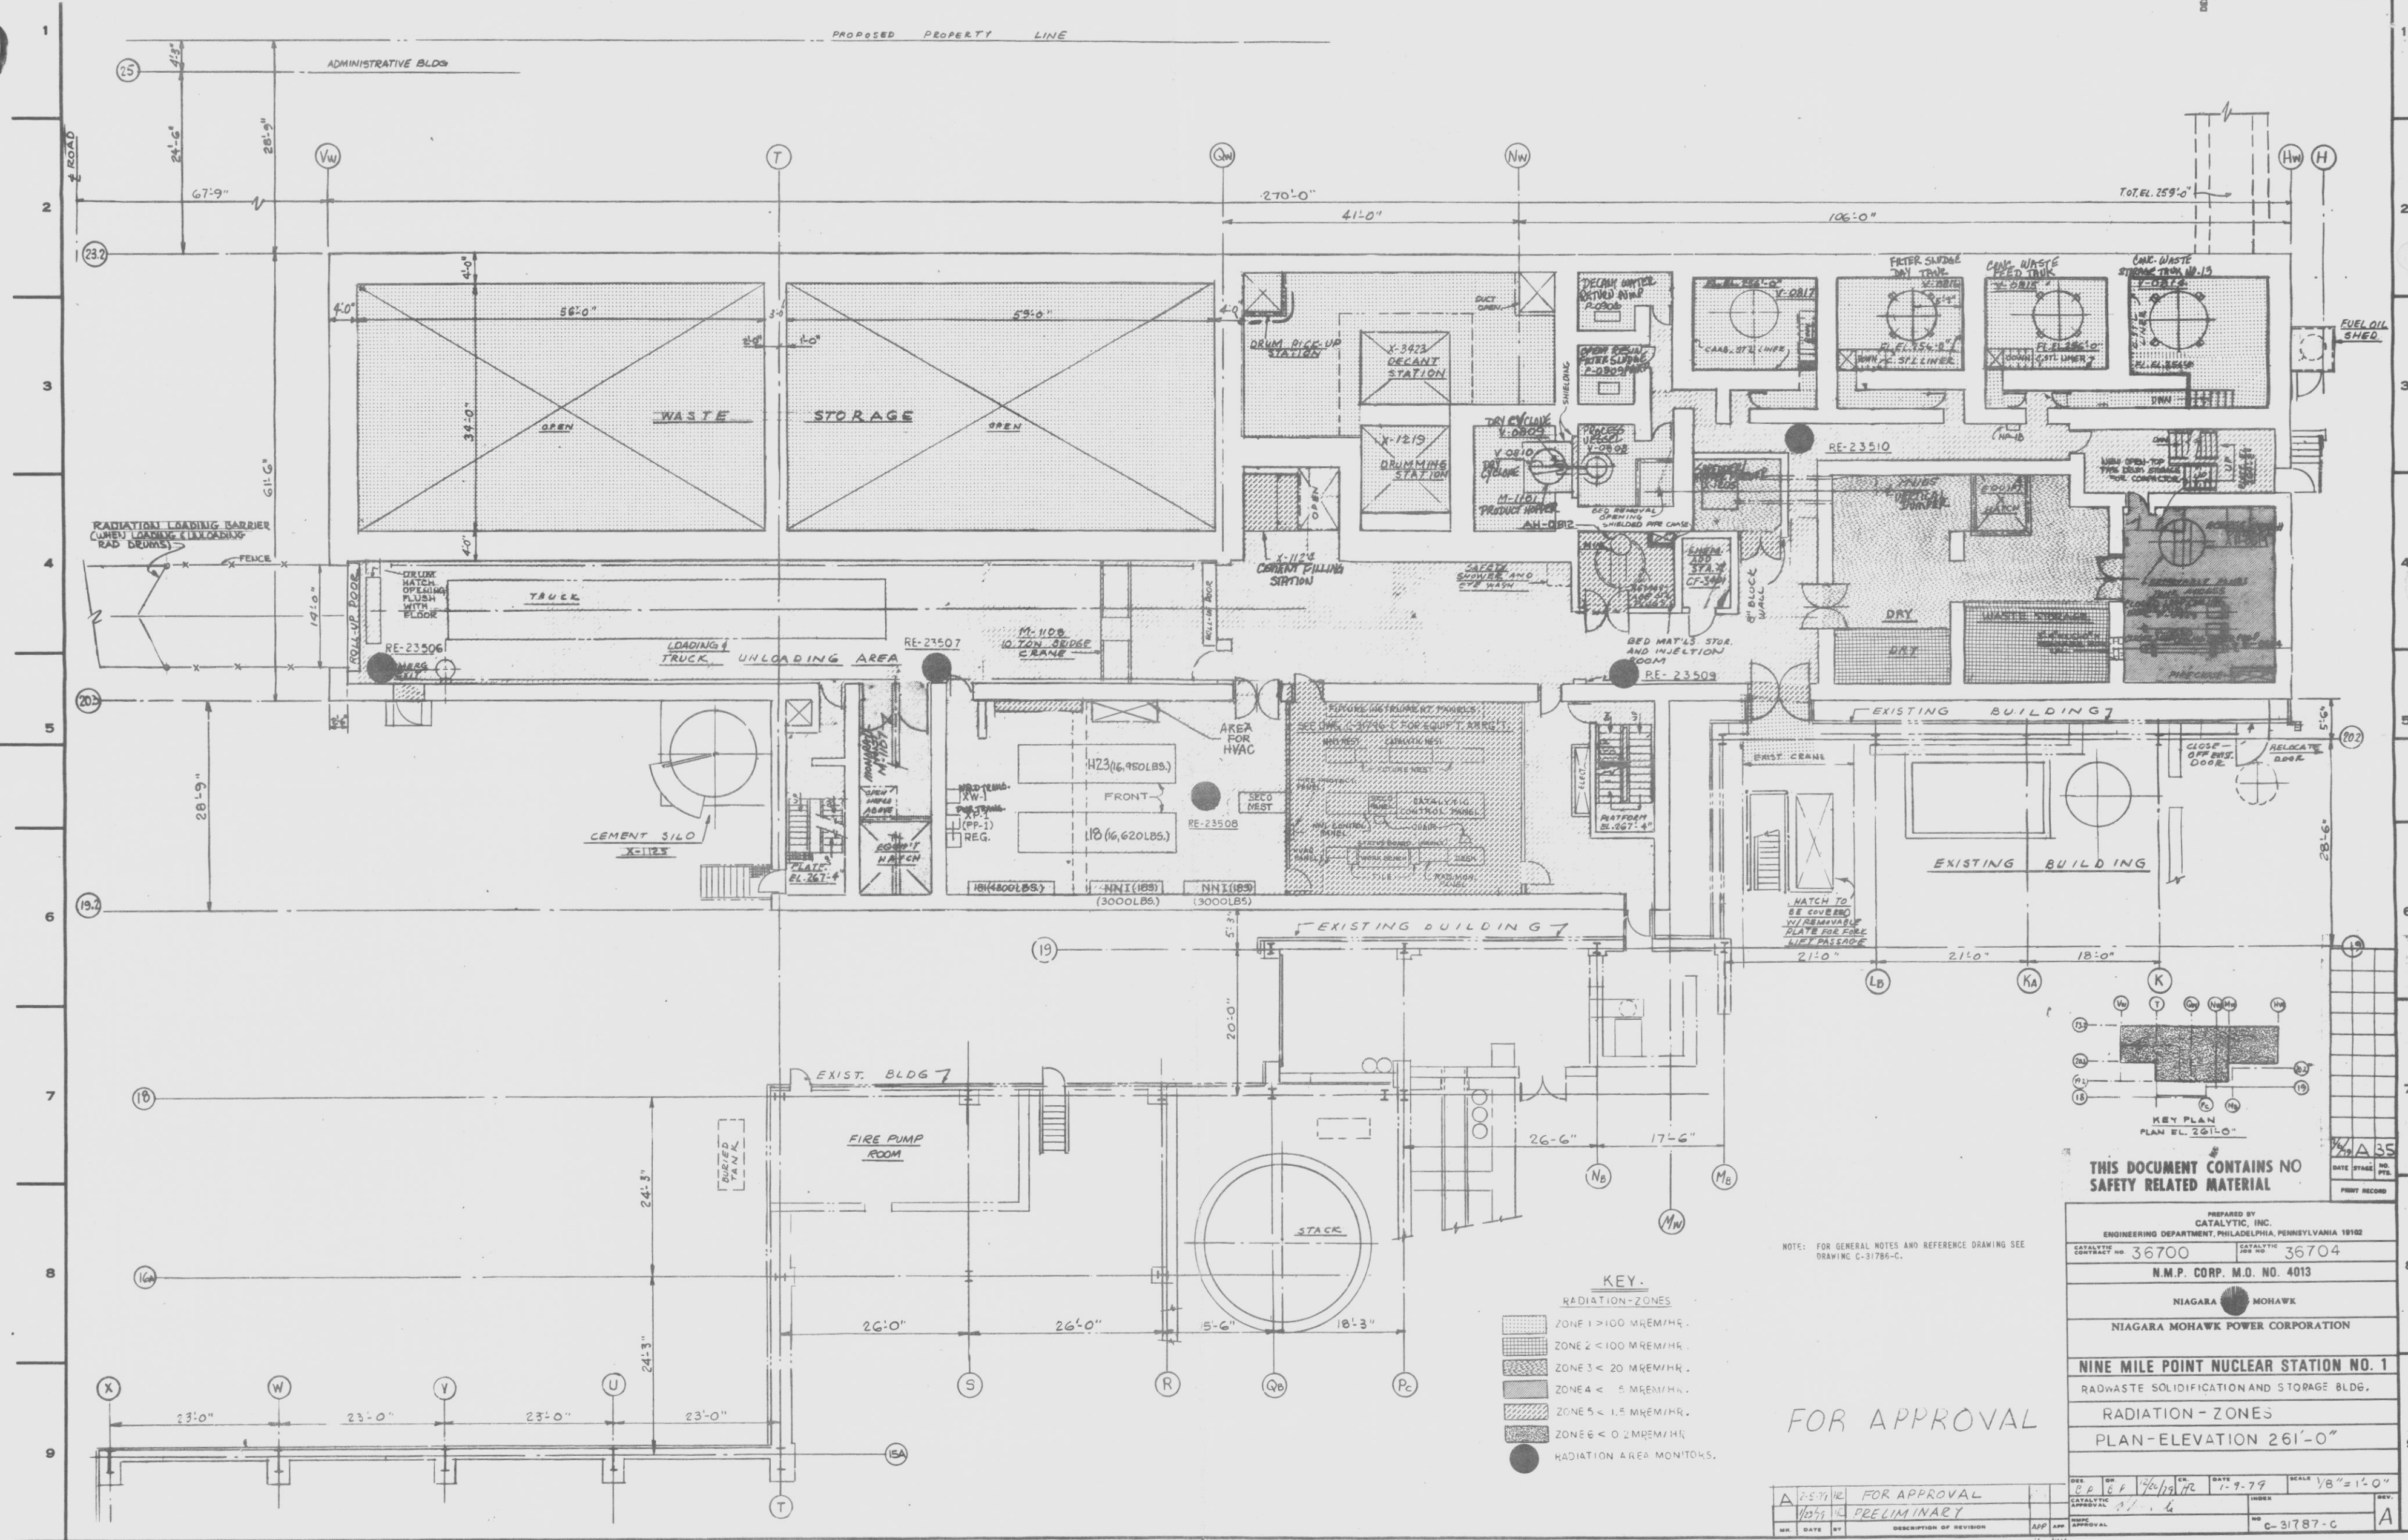

NOTE: FOR GENERAL NOTES AND REFERENCE DRAWING SEE
DRAWING C-31786-C.


FOR APPROVAL

**THIS DOCUMENT CONTAINS NO
SAFETY RELATED MATERIAL**

PREPARED BY CATALYTIC, INC. ENGINEERING DEPARTMENT, PHILADELPHIA, PENNSYLVANIA 19102	
CATALYTIC CONTRACT NO.	CATALYTIC JOB NO.
36700	36704
N.M.P. CORP. M.O. NO. 4013	
NIAGARA	 MOHAWK
NIAGARA MOHAWK POWER CORPORATION	
NINE MILE POINT NUCLEAR STATION NO.	
RADWASTE SOLIDIFICATION AND STORAGE BLDG.	
RADIATION - ZONES	
PLAN-ELEVATION 261'-0"	

A	DES.	OP	GR	$\frac{1}{2}$	CR	DATE	1-9-79	SCALE	$\frac{1}{8}'' = 1'-0''$
							CATALYTIC APPROVAL	INDEX	REV.
12571	FOR APPROVAL								
12571	PRELIMINARY								
MR.	DATE	BY	DESCRIPTION OF REVISION	APP	APP	NO	C-31787-C		A

C-18506-C

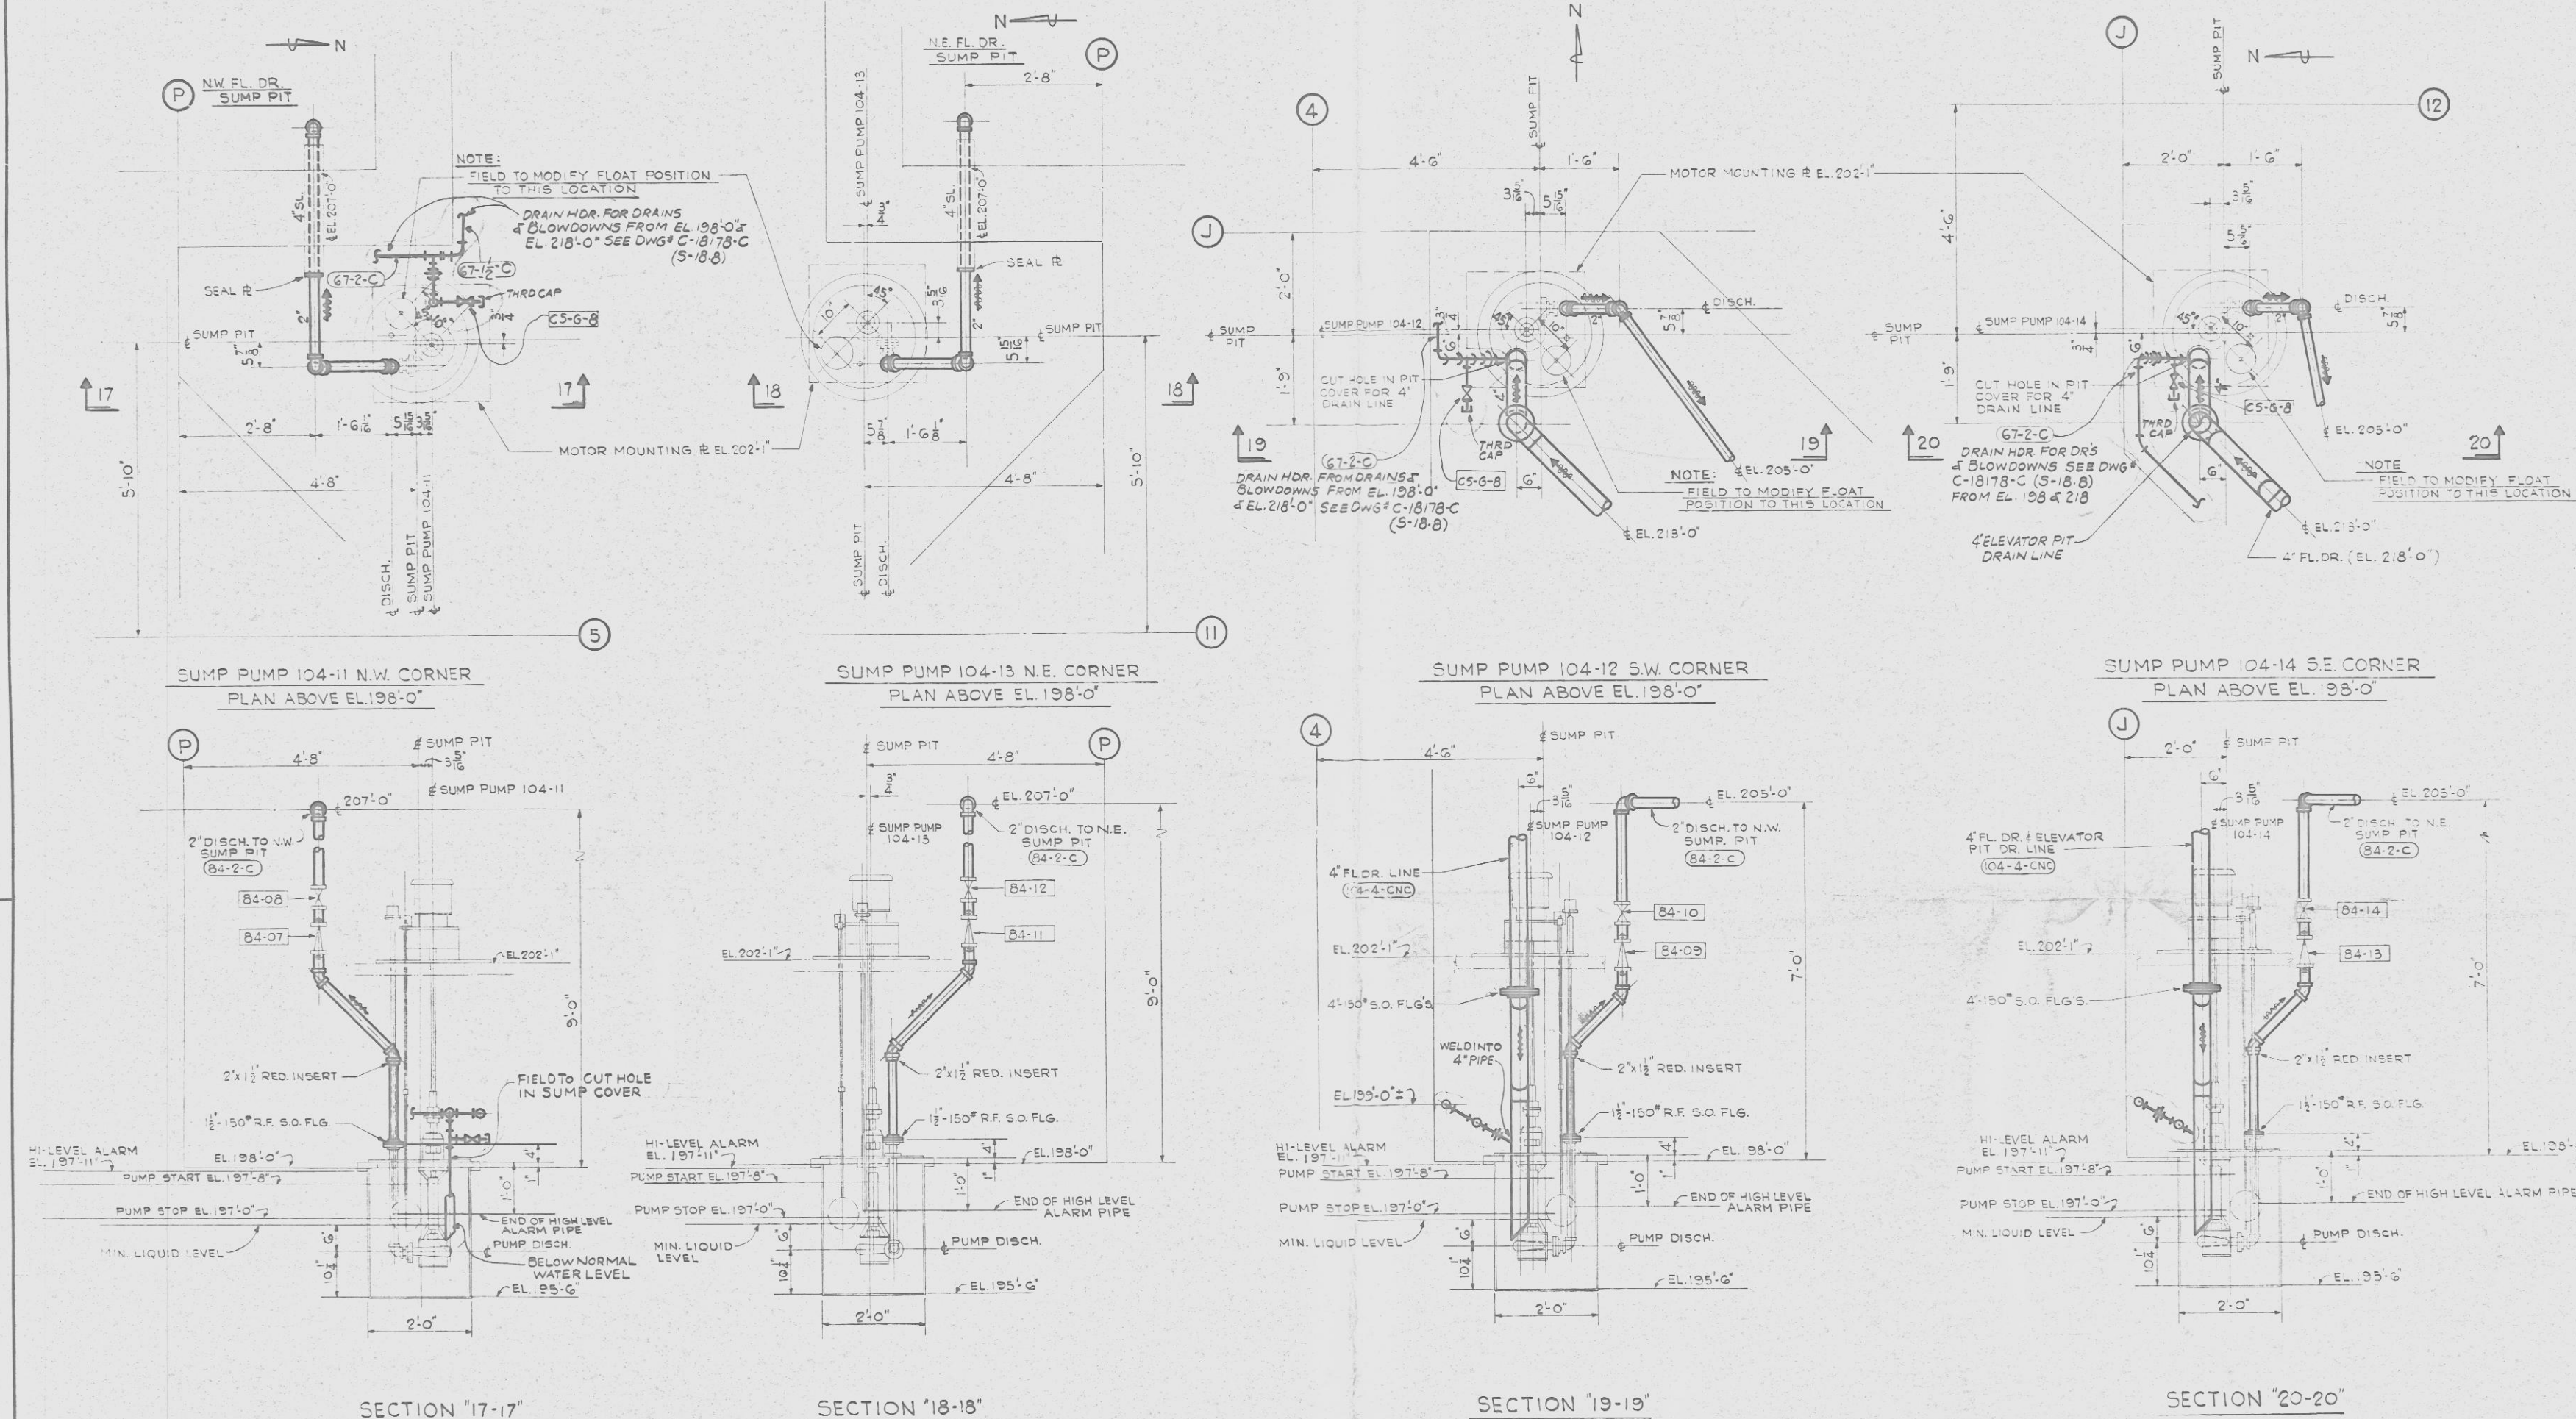


FOR MAIN BLDG SUMP PUMPS SEE
DWG. # C-18503-C & C-18504-C (S-15)
FOR GENERAL NOTES & REFERENCE DWGS. SEE
DWG. # C-18505-C

SYSTEM # 84, 104

NIAGARA MOHAWK	RECORD
NIAGARA MOHAWK POWER CORPORATION	
NINE MILE POINT NUCLEAR STATION	
REACTOR BLDG.	
FLOOR DRAINAGE PIPING	
SUMP PUMP DETAILS	
LOWER CORNERS OF BLDG.	
DATE	7-11-67
BY	Red
APP	Red
NO.	3-N2-S15
NO.	C-18506-C

47 11-17-78
#7811290192
50-220
D
RETURN TO REACTOR DOCKET
FILES

MICRO 7-30-X



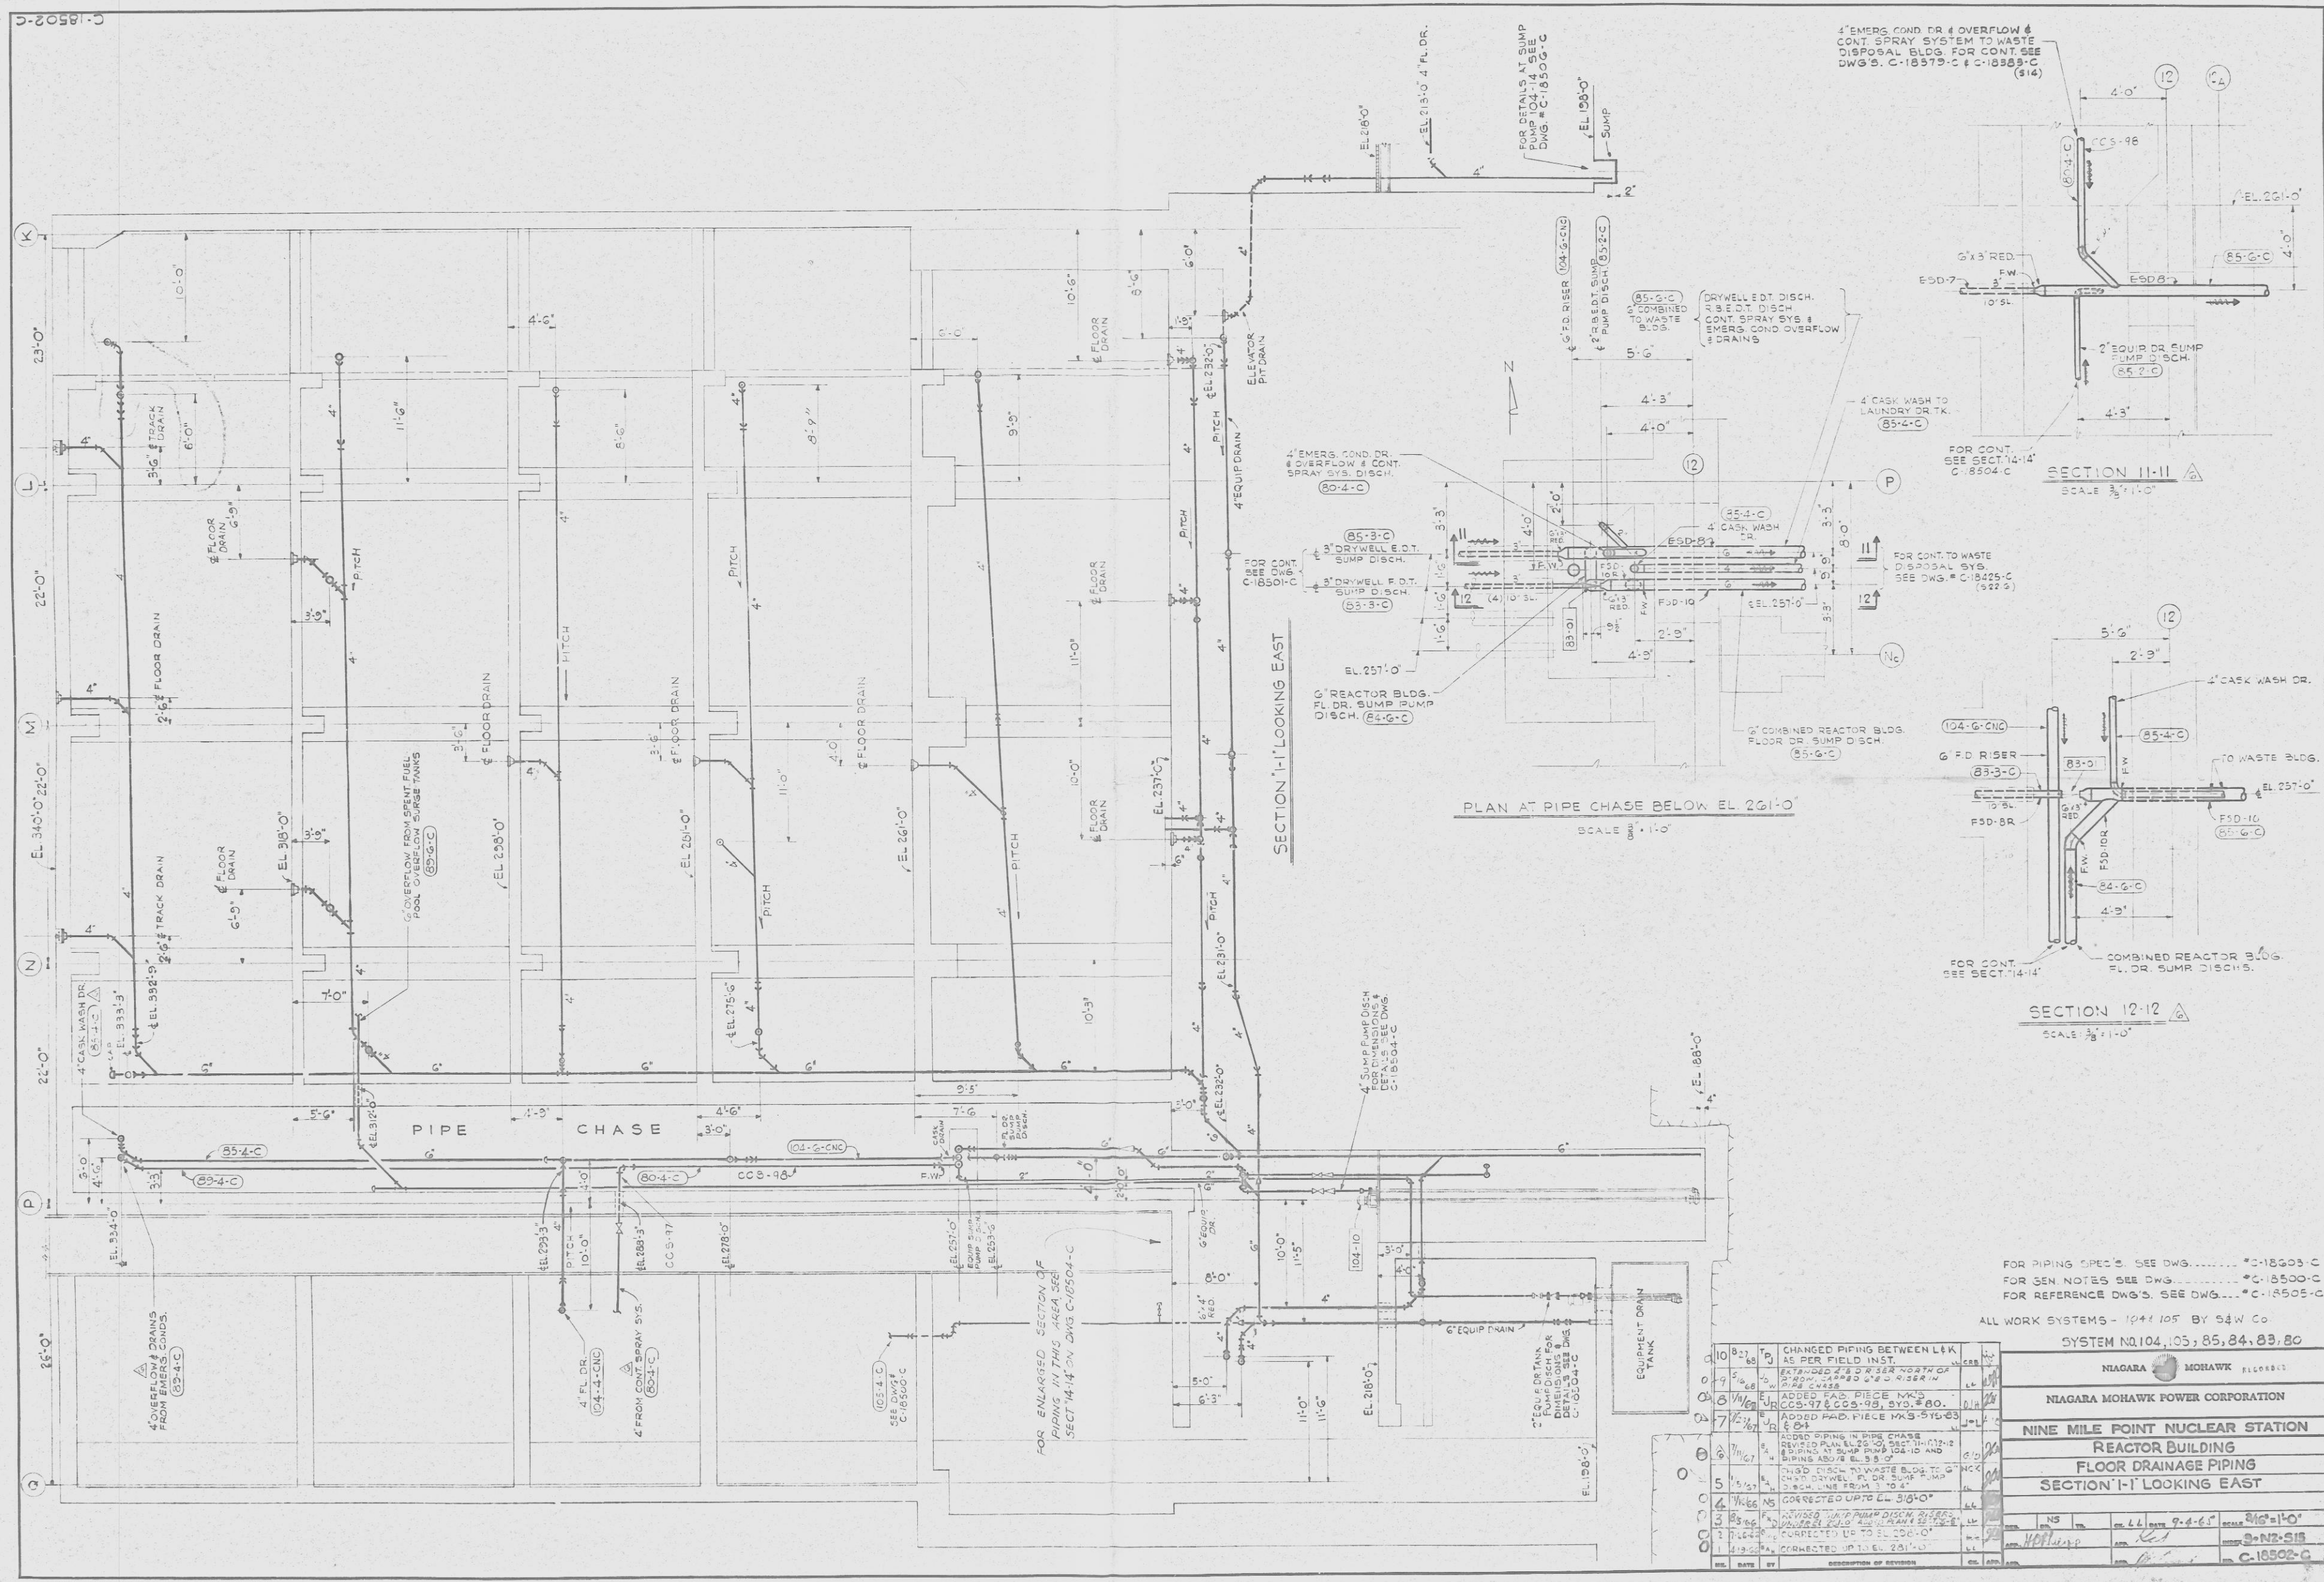


RETURN TO REACTOR DOCKET
FILES

LH 11-17-78
7811 290192
50-220

D

MICRO AT 30-X

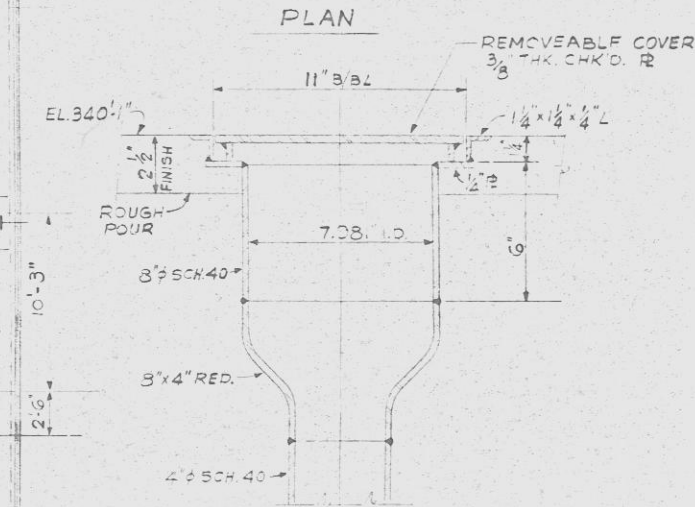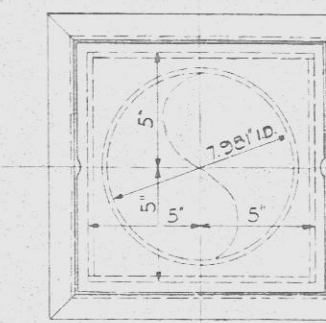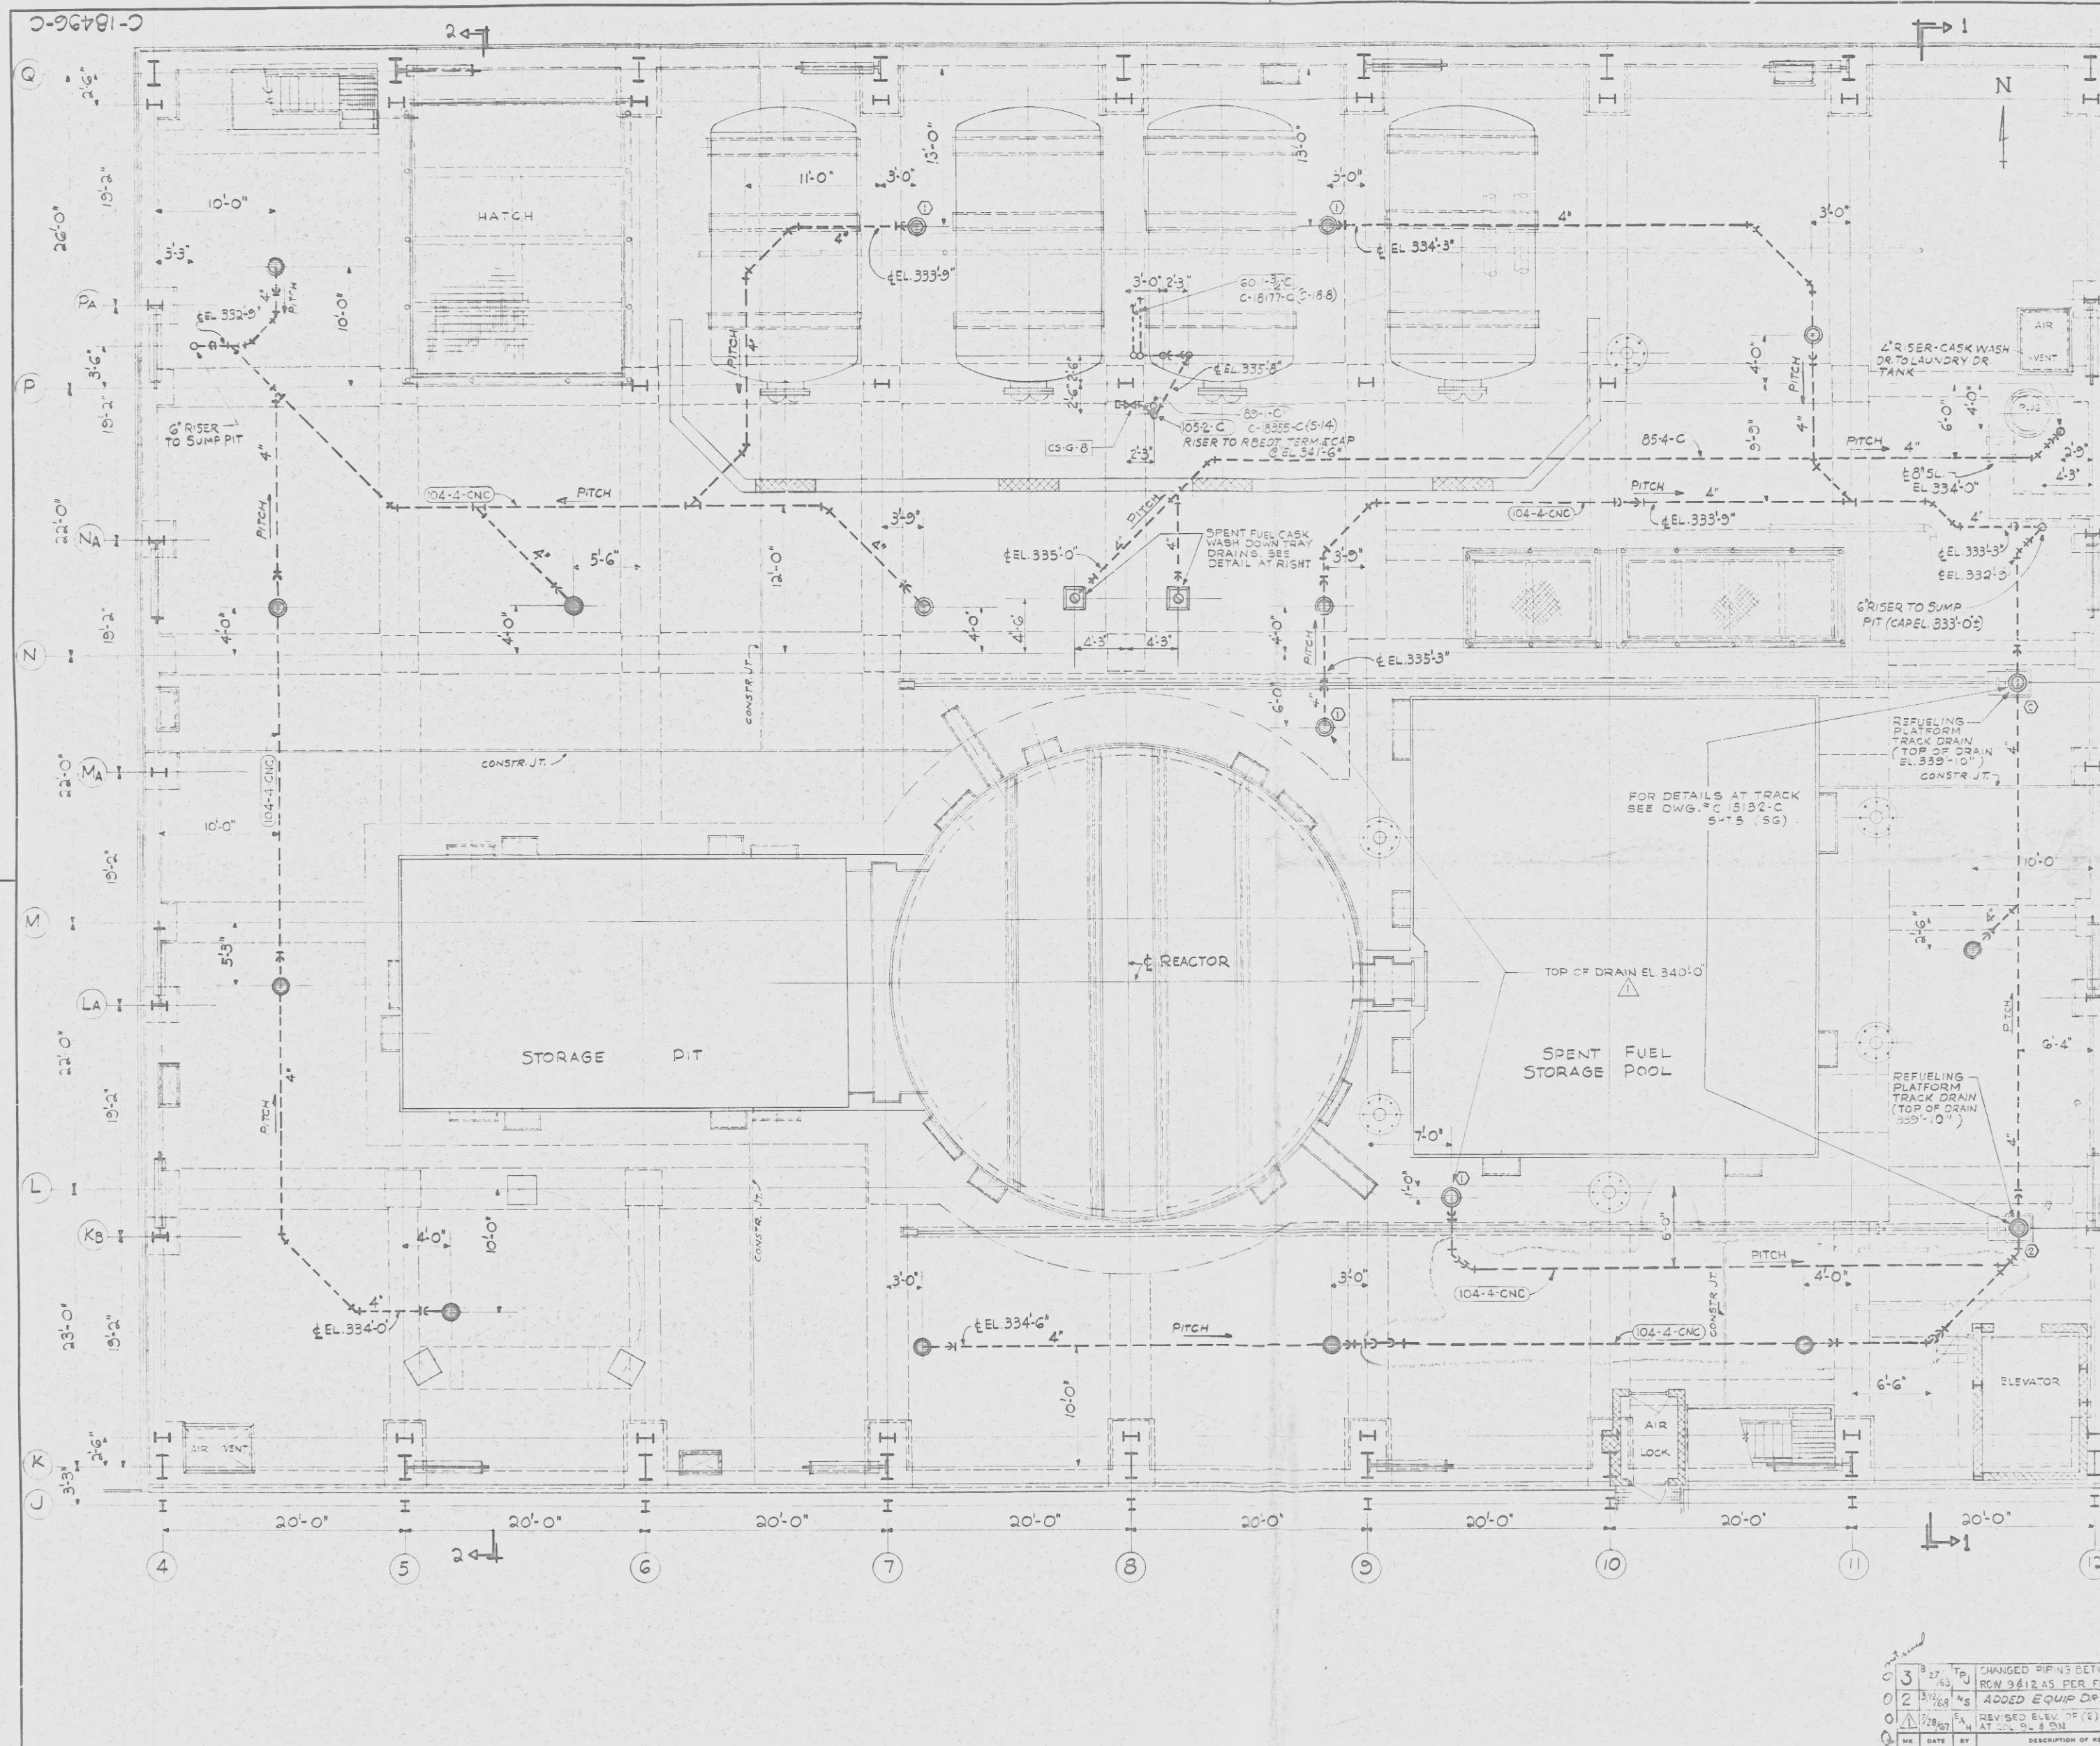

DETAIL OF SPENT FUEL CASK WASH DOWN TRAY DRAINS
SCALE 3/8" = 1'-0"



- GENERAL NOTES
- TOP OF FLOOR DRAINS TO BE SET AT EL. 339'-0" (EXCEPTIONS NOTED)
 - ① ZURN # 500 FL DR SCREWED OUTLET OR EQUAL
 - ② ZURN # 516 FL DR SCREWED OUTLET OR EQUAL
 - FOR PIPE SPEC'S SEE DWG. C-18503-C
 - FOR FLOOR DRAIN SETTING DETAIL SEE DWG. C-18504-C
 - ALL FLOOR DRAIN PIPING TO BE 4" (EXCEPT WHERE NOTED) WITH BENDS OR BUTT WELD FITTINGS TO BE USED AT DISCRETION OF FIELD
 - ALL FLOOR DRAINS TO BE PITCHED APPROX. TO ELEV. SHOWN WITH A CONTINUOUS PITCH AND NO POCKETS IN RUNS
 - ③ ZURN # 507 FL DR SCREWED OUTLET OR EQUAL (2 REQ'D FOR REFUELING PLATFORM TRACK DRAINS ONLY)

FOR REFERENCE DWG'S SEE DWG. C-18503-C
ALL SYSTEM #104 WORK & MATERIAL BY SEW. CO.


NIAGARA MOHAWK POWER CORPORATION
NINE MILE POINT NUCLEAR STATION
REACTOR BUILDING
FLOOR DRAINAGE PIPING
PLAN AT ELEV. 340'-0"

NO.	DATE	BY	DESCRIPTION OF REVISION	CR	APP	APP
1	3/16/67	WJ	CHANGED PIPES BETWEEN L&K			
2	3/16/67	WJ	RCN 9412 AS PER FIELD INST.			
3	3/16/67	WJ	ADDED EQUIP DRAINS			
4	3/16/67	WJ	REVISED ELEV. OF (2) F. DRAINS			


RETURN TO REACTOR DOCKET
FILES
14-JH
11-17-78
7811290192
50-220
D

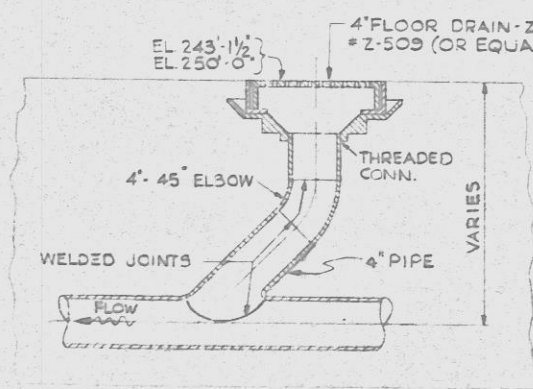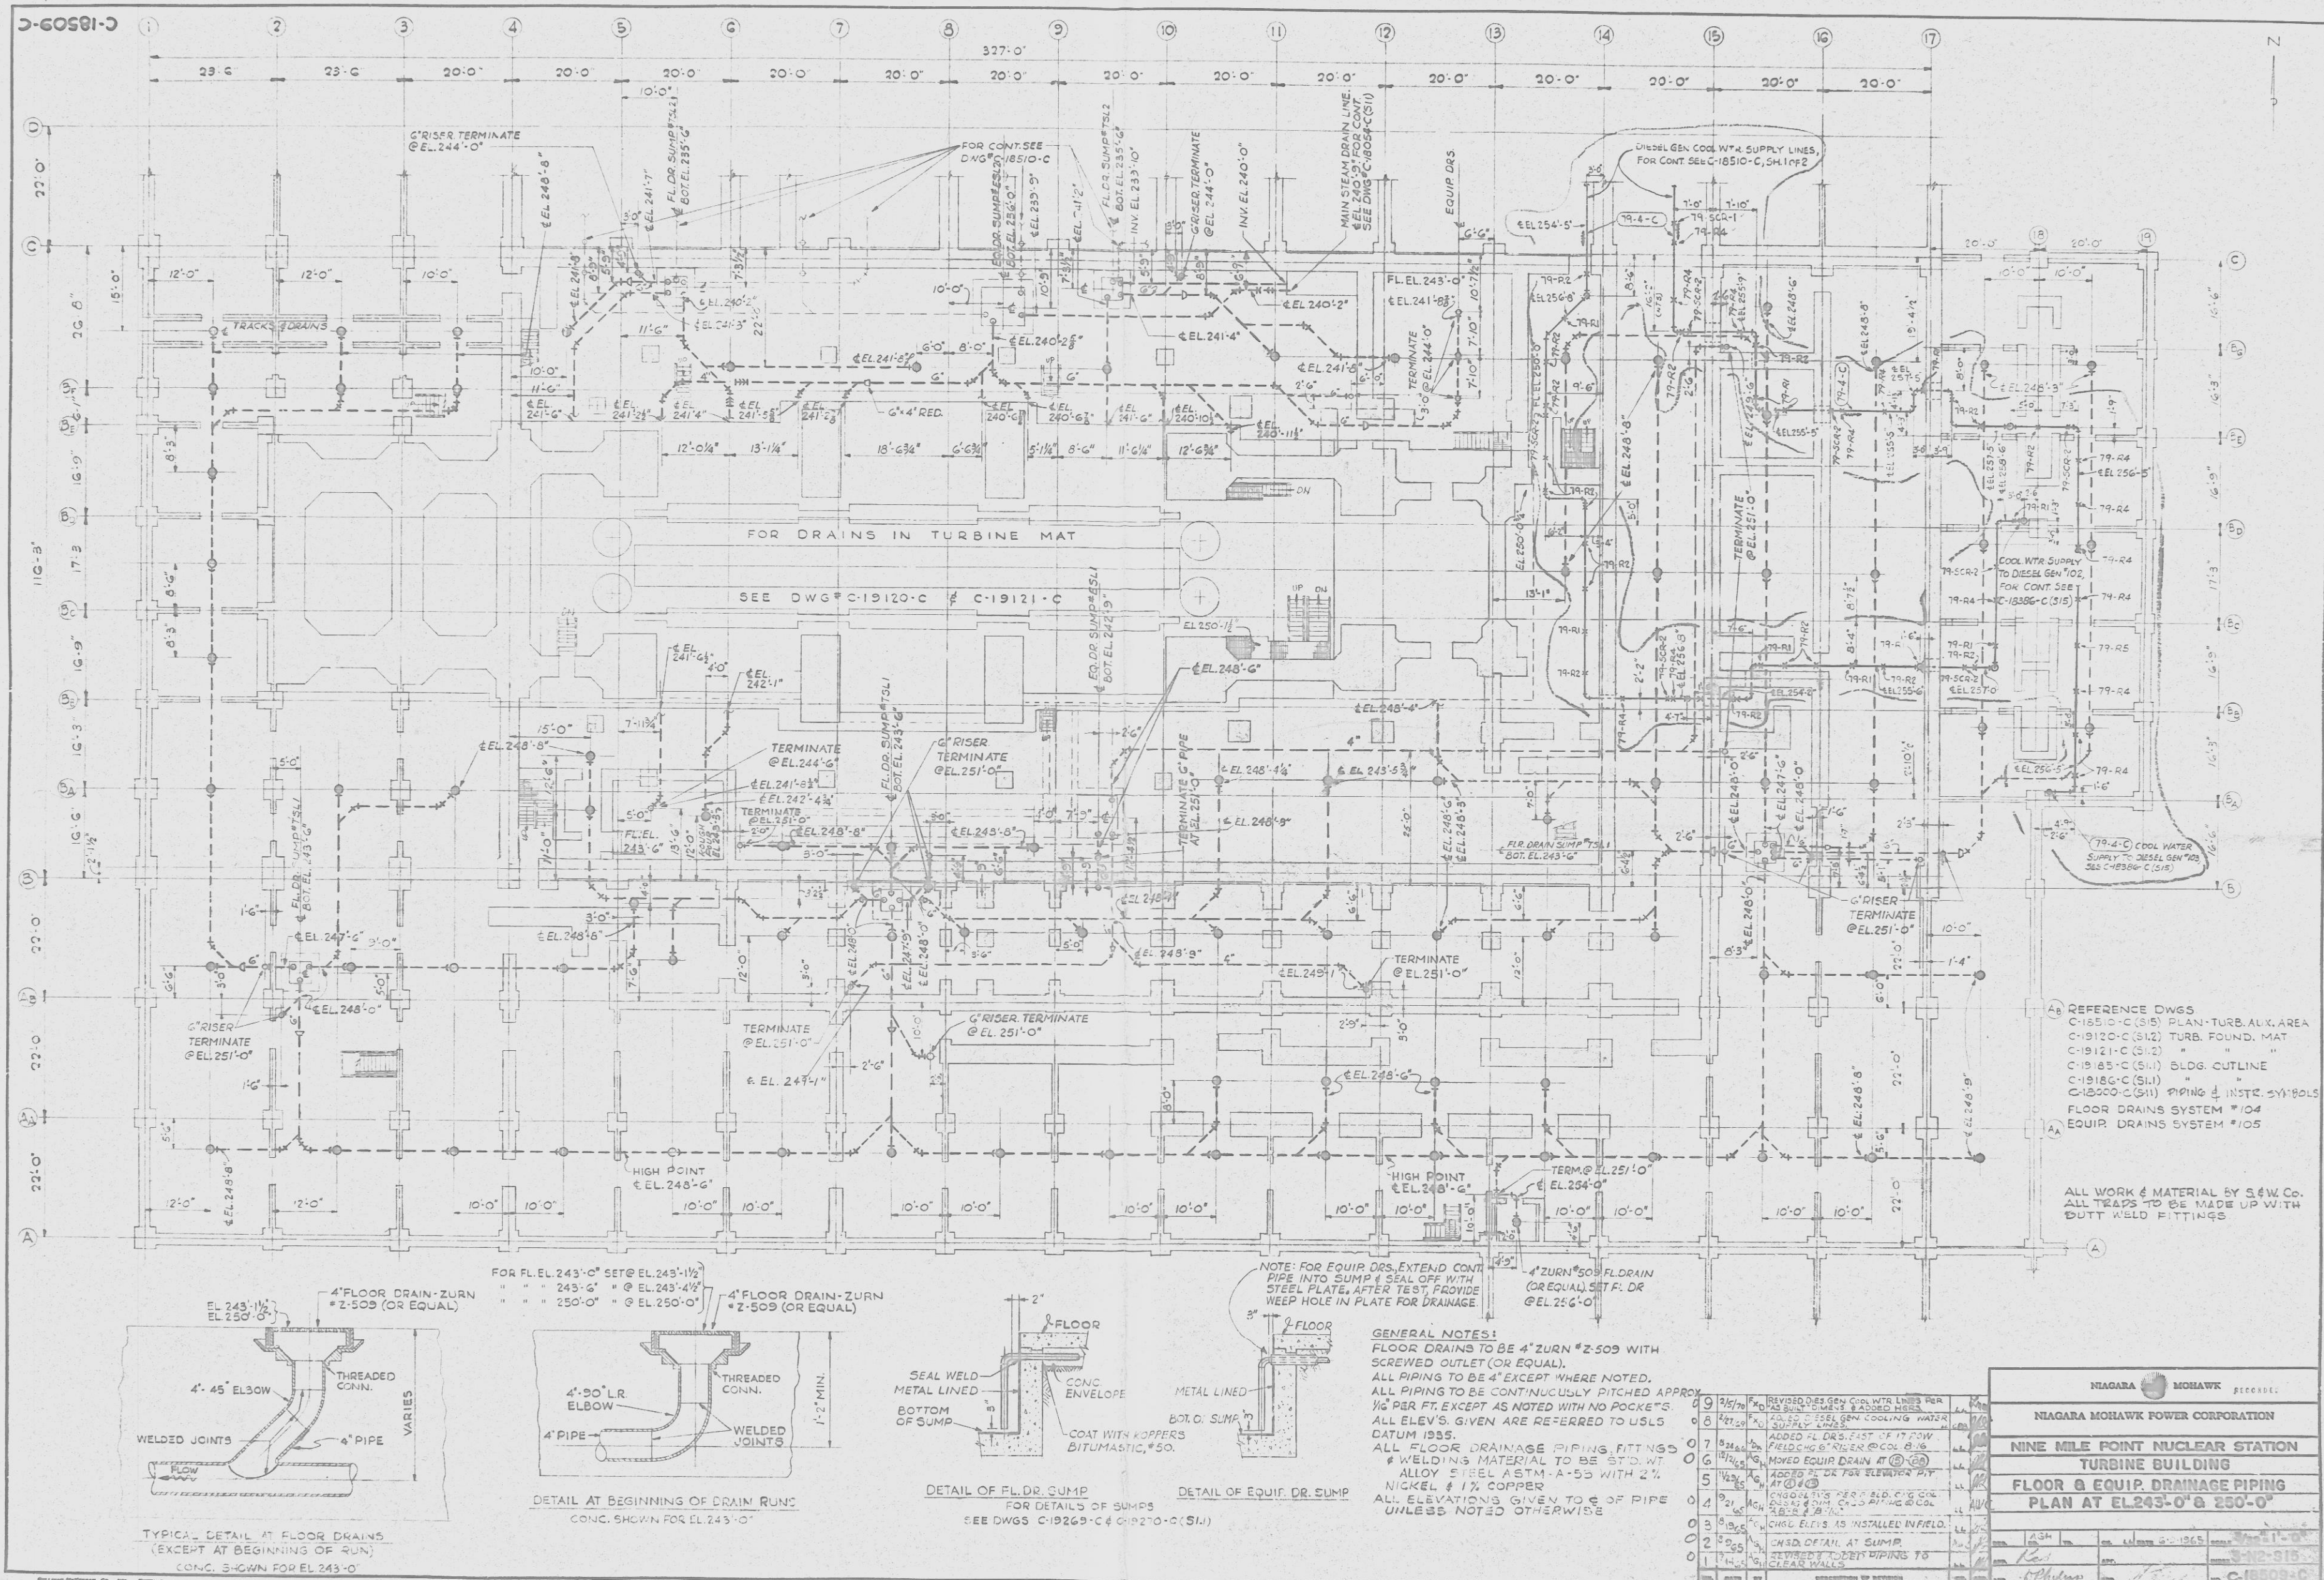

TYPICAL DETAIL AT FLOOR DRAINS
(EXCEPT AT BEGINNING OF RUN)
CONC. SHOWN FOR EL 243'-0"

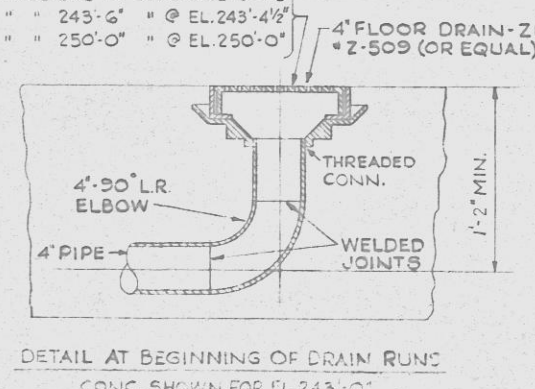

DETAIL AT BEGINNING OF DRAIN RUN
CONC. SHOWN FOR EL 243'-0"

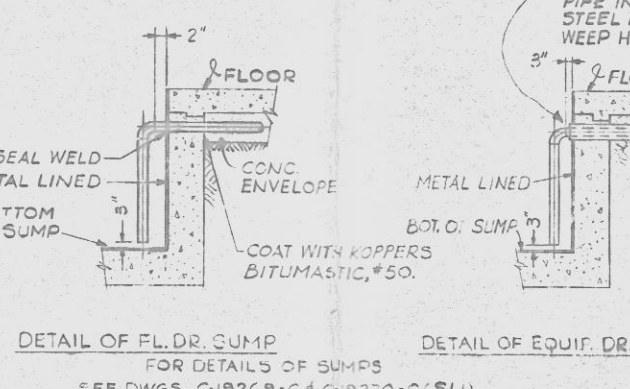

DETAIL OF EQUIP. DR. SUMP
FOR DETAILS OF SUMPS
SEE DWGS C-19269-C & C-19270-C (S11)


GENERAL NOTES:
FLOOR DRAINS TO BE 4" ZURN #2-503 WITH
SCREWED OUTLET (OR EQUAL).
ALL PIPING TO BE 4" EXCEPT WHERE NOTED.
ALL PIPING TO BE CONTINUOUSLY DITCHED APPROX
1/8" PER FT. EXCEPT AS NOTED WITH NO POCKETS.
ALL ELEV'S. GIVEN ARE REFERRED TO U.S.
DATUM 1985.
ALL FLOOR DRAINAGE PIPING, FITTINGS
& WELDING MATERIAL TO BE STD. WT.
ALLOY #161 ASTM A-53 WITH 2%
NICKEL & 1% COPPER
ALL ELEVATIONS GIVEN TO C OF PIPE
UNLESS NOTED OTHERWISE



9	25/76	REVISED DES. GEN. COOL. WTR. LINES FOR
8	24/76	ADD. 1/2" STEEL GEN. COOLING WATER
7	24/76	ADD. 1/2" STEEL GEN. COOLING WATER
6	24/76	ADD. 1/2" STEEL GEN. COOLING WATER
5	24/76	ADD. 1/2" STEEL GEN. COOLING WATER
4	24/76	ADD. 1/2" STEEL GEN. COOLING WATER
3	24/76	ADD. 1/2" STEEL GEN. COOLING WATER
2	24/76	ADD. 1/2" STEEL GEN. COOLING WATER
1	24/76	ADD. 1/2" STEEL GEN. COOLING WATER

NIAHARA MOHAWK POWER CORPORATION	
NINE MILE POINT NUCLEAR STATION	
TURBINE BUILDING	
FLOOR & EQUIP. DRAINAGE PIPING	
PLAN AT EL 243'-0" & 250'-0"	
DATE	DESCRIPTION OF REVISION
2/25/76	REVISED DES. GEN. COOL. WTR. LINES FOR
2/25/76	ADD. 1/2" STEEL GEN. COOLING WATER
2/25/76	ADD. 1/2" STEEL GEN. COOLING WATER
11-17-78
7811290192
50-220
D

RETURN TO RECTOR DOCKET
FILES

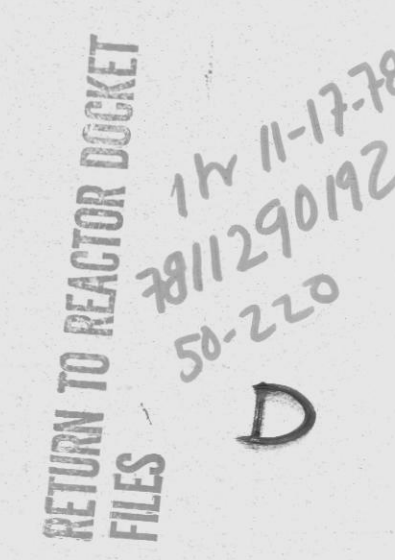

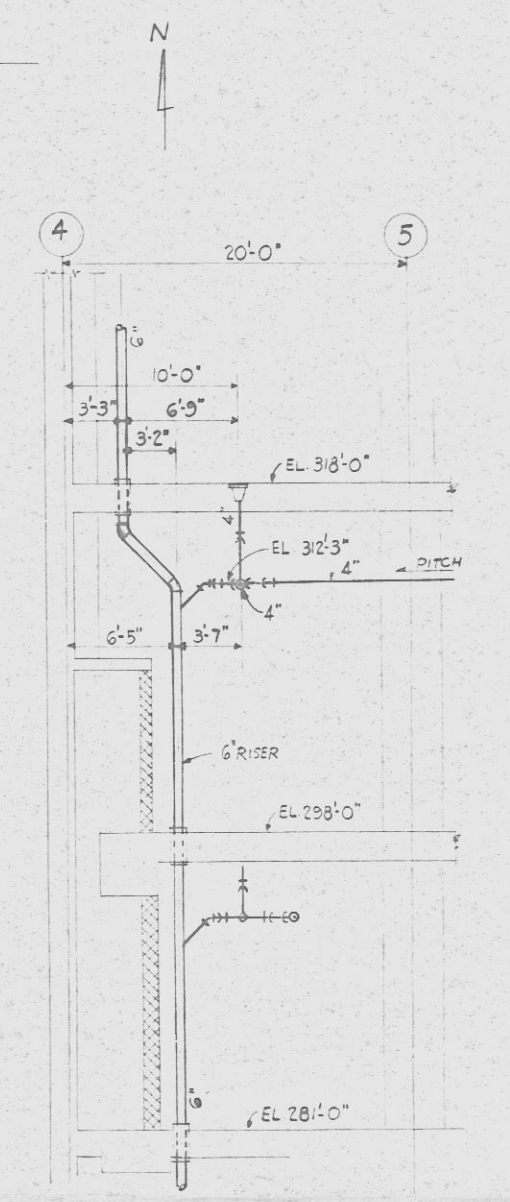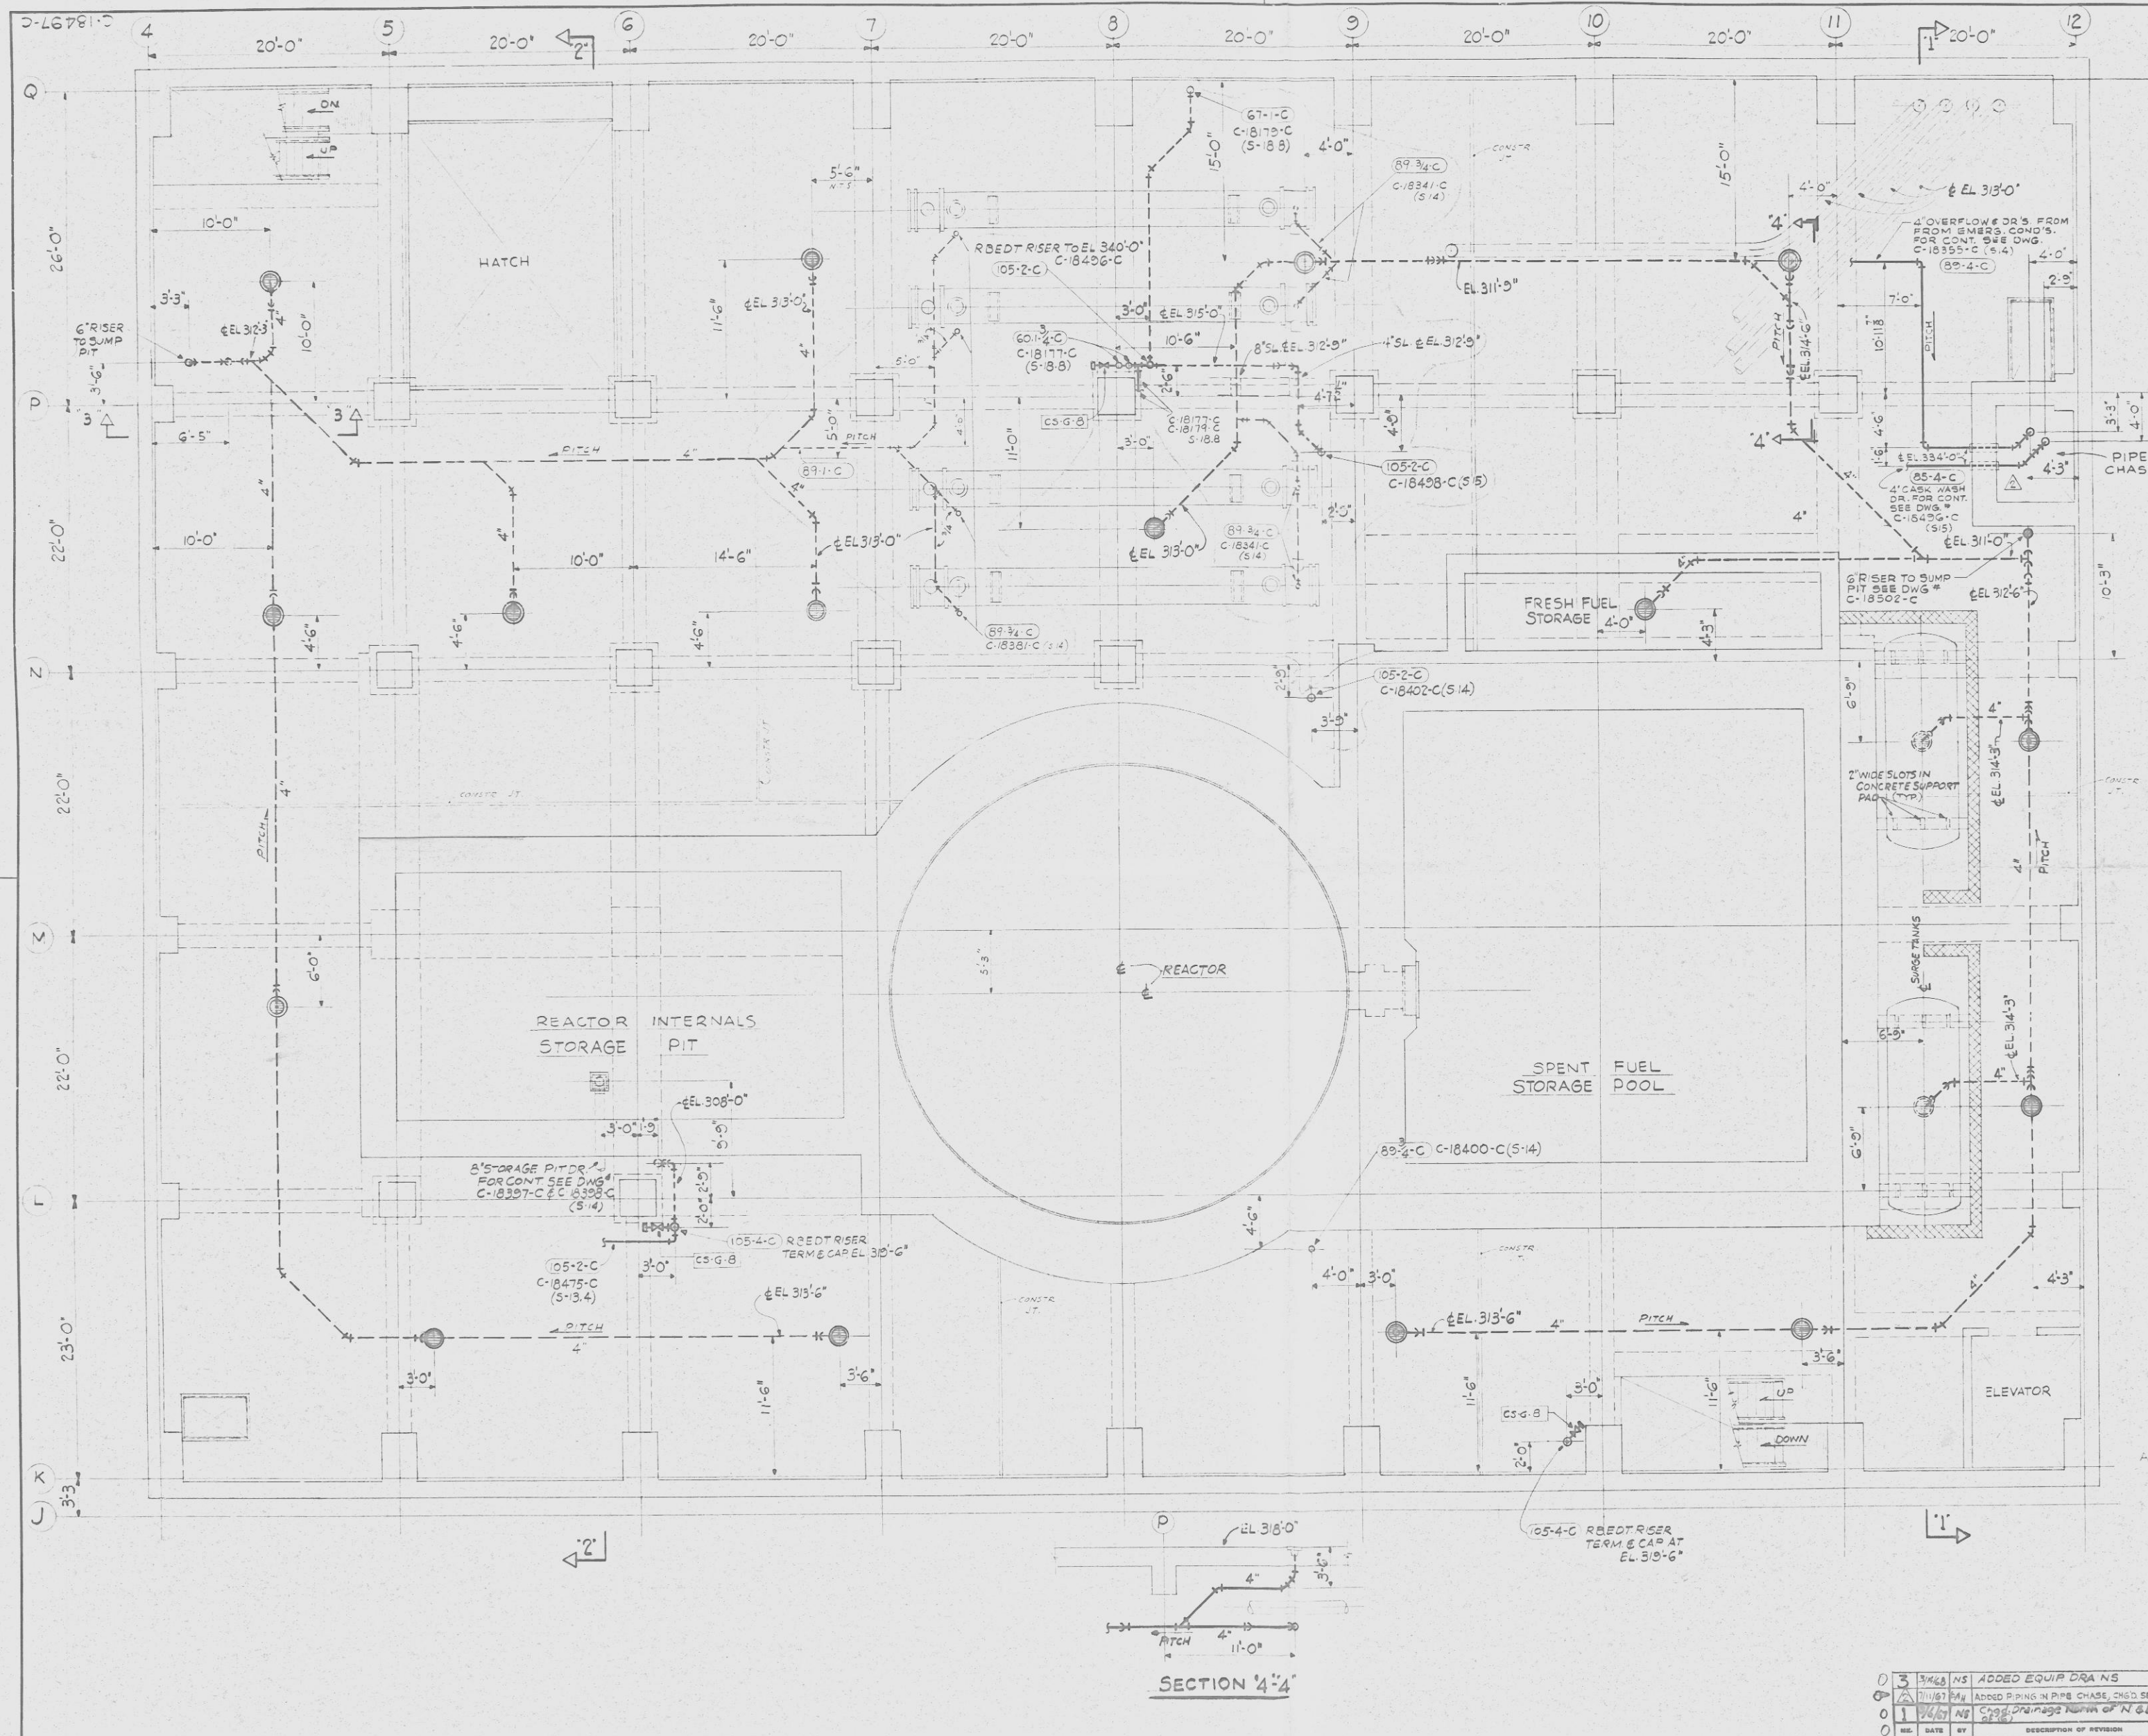

NOTES:
 TOP OF FLOOR DRAINS TO BE SET AT EL. 317'-1 1/2"
 ALL FLOOR DRAINS ON THIS DWG. TO BE ZURN Z-500
 1/2" RIGID OUTLETS, OR EQUAL
 FOR PIPE SPECS SEE DWG. C-16603-C
 FOR FLOOR DRAIN SETTING DETAIL SEE DWG. C-
 ALL FLOOR DRAIN PIPING TO BE 4" (EXCEPT WHERE NOTED)
 WITH BENDS OR BUTT WELD FITTINGS TO BE USED AT
 DISCRETION OF FIELD
 ALL FLOOR DRAINS TO BE PITCHED APPROX. TO ELEV'S
 SHOWN WITH A CONTINUOUS PITCH AND NO POCKETS
 IN RUNS

FOR REFERENCE DWGS. SEE DWG. C-13505-C
 ALL SYSTEM #104 WORK & MATERIAL BY S&W Co.
 SYSTEM # 67-85-89-104-105


NIAGARA MOHAWK POWER CORPORATION	
NINE MILE POINT NUCLEAR STATION	
REACTOR BLDG.	
FLOOR DRAINAGE SYSTEM	
PLAN AT ELEV. 315'-0"	
3	3/16/68 NS ADDED EQUIP DRAINS
1	7/11/67 NS ADDED PIPING IN PIPE CHASE, CHAS. SECT. 3-3
1	1/16/67 NS Crawl Drainage North of N. Bldg.
0	REV. DATE BY DESCRIPTION OF REVISION
0	REV. DATE BY DESCRIPTION OF REVISION

SECTION 4-4

MICRO AT 30-X

RETURN TO REACTOR DOCKET
 FILES
 80-220
 L4 dtd
 11-17-78
 7811290192
 D



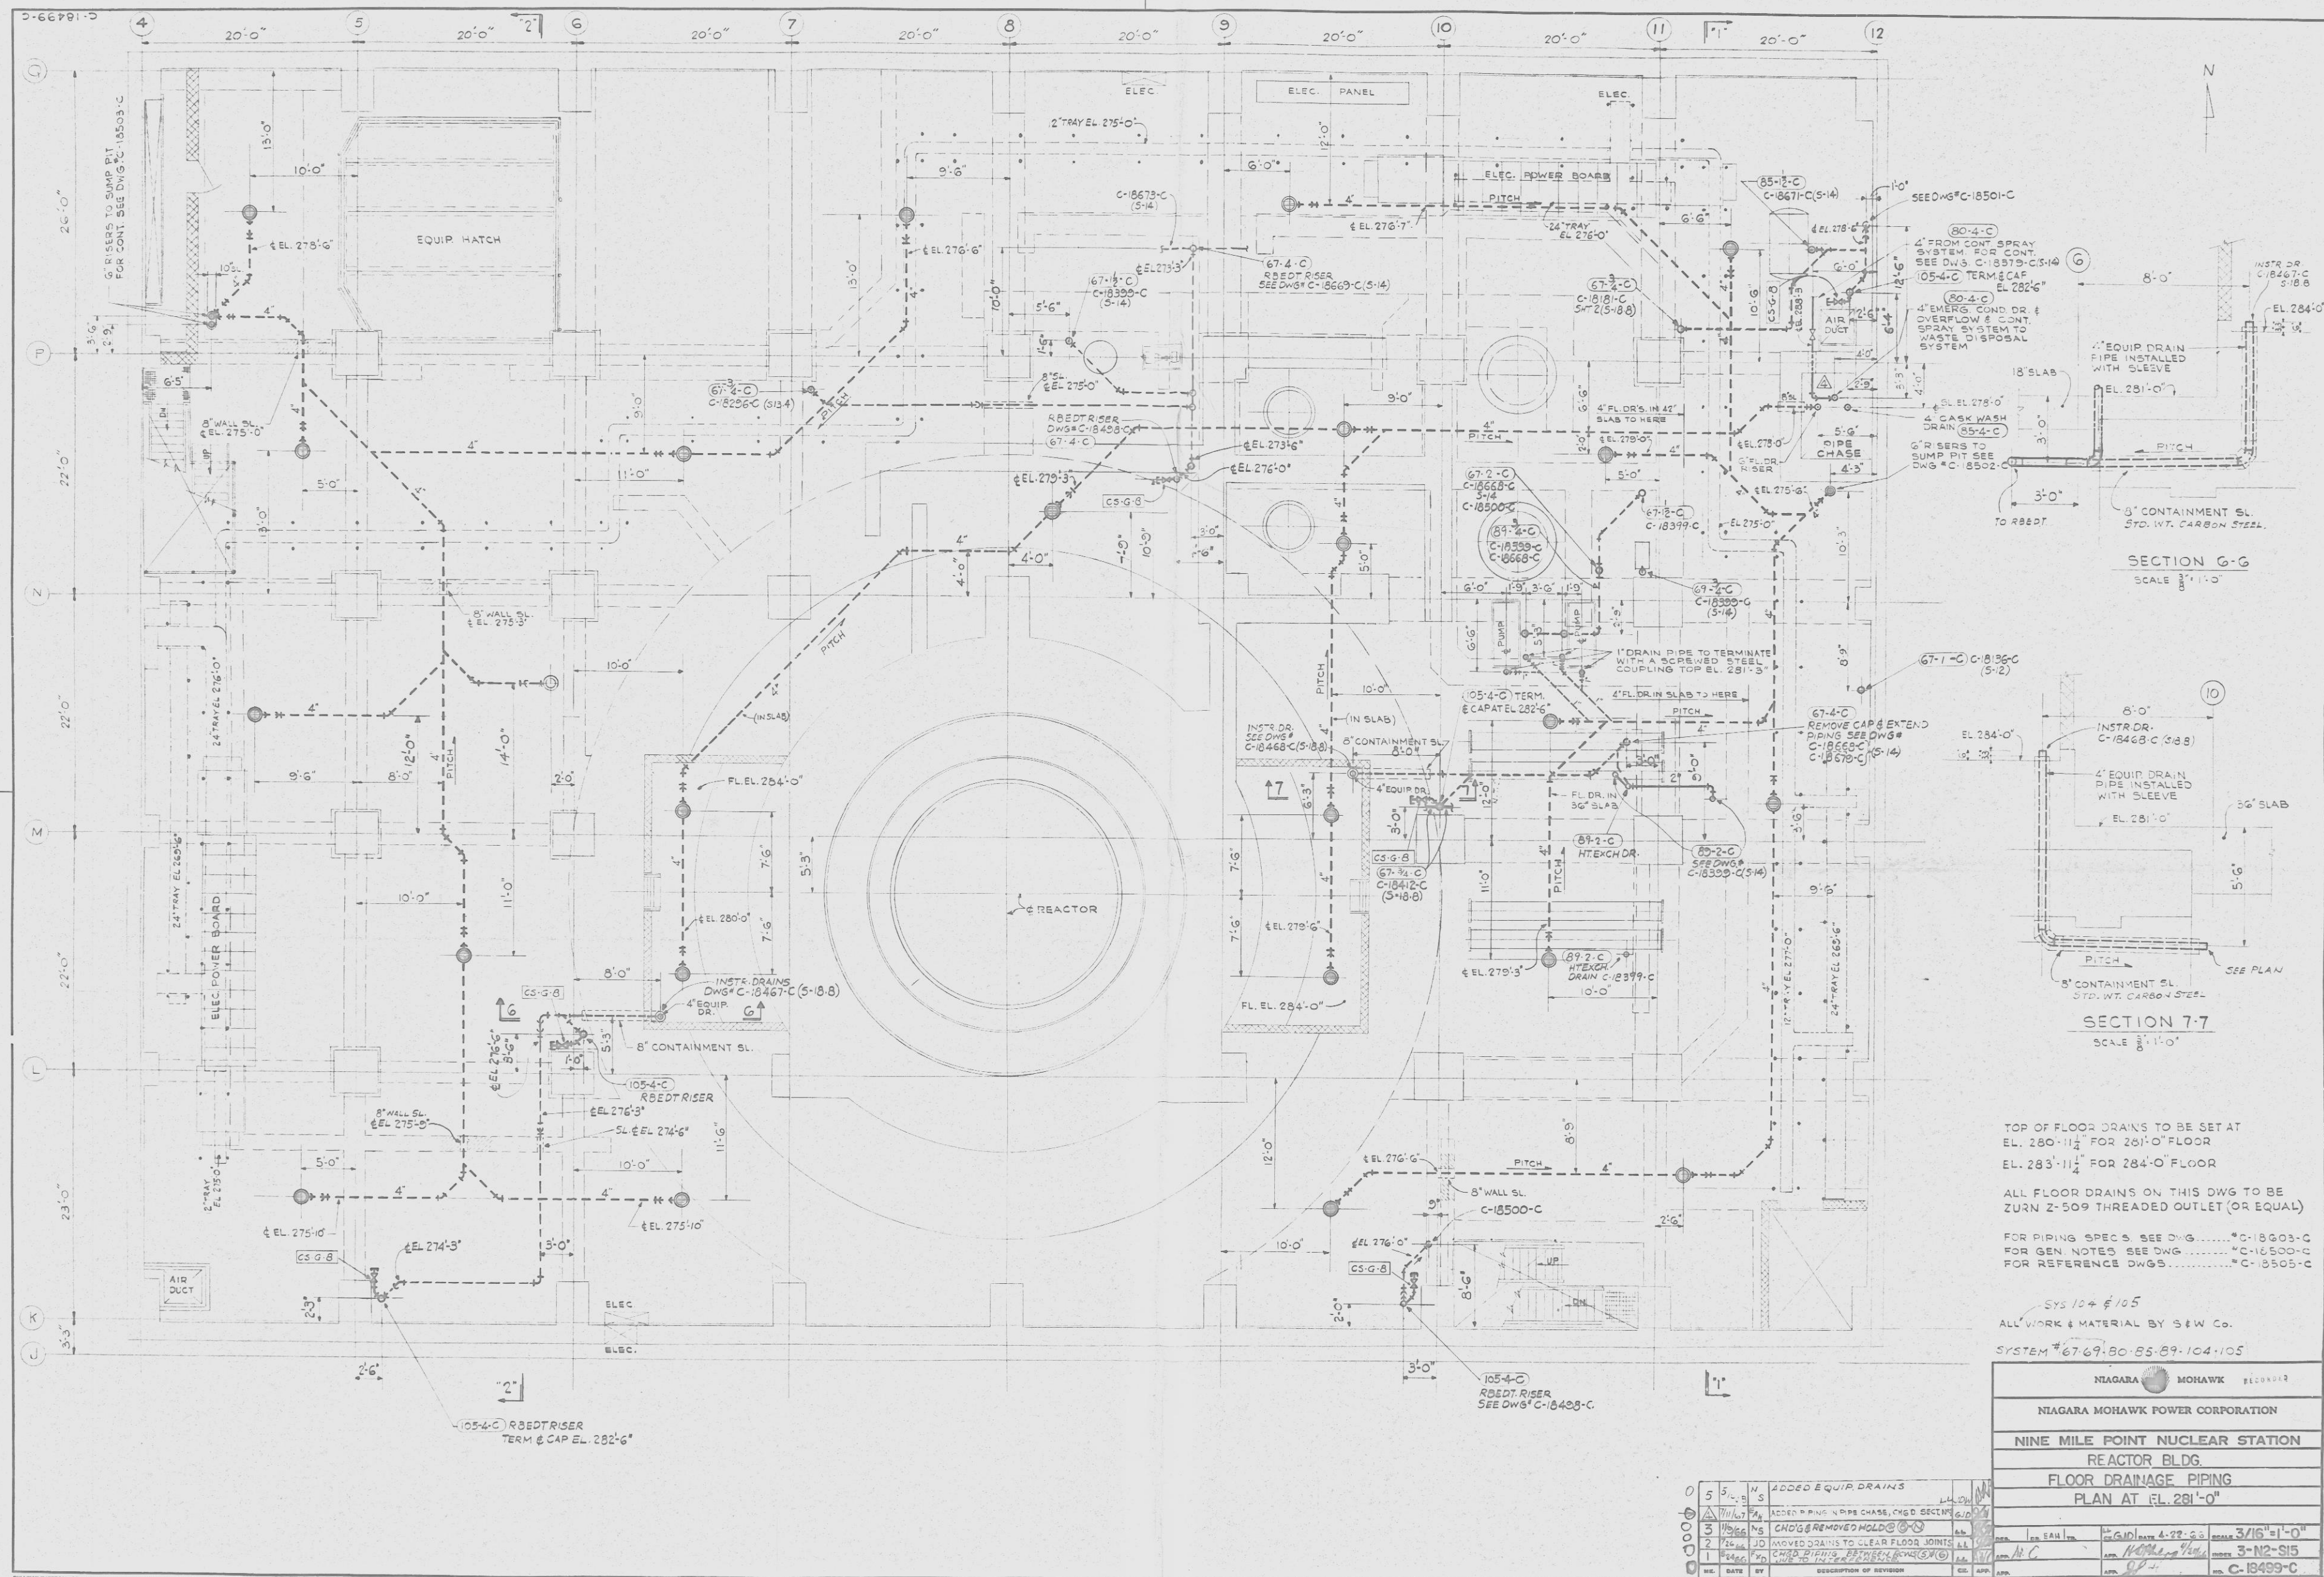


RETURN TO REACTOR DOCKET
FILES

11-17-78
7811290192
D
50-220


MICRO AT 30-X




11-17-78
7811290192
50-220
D

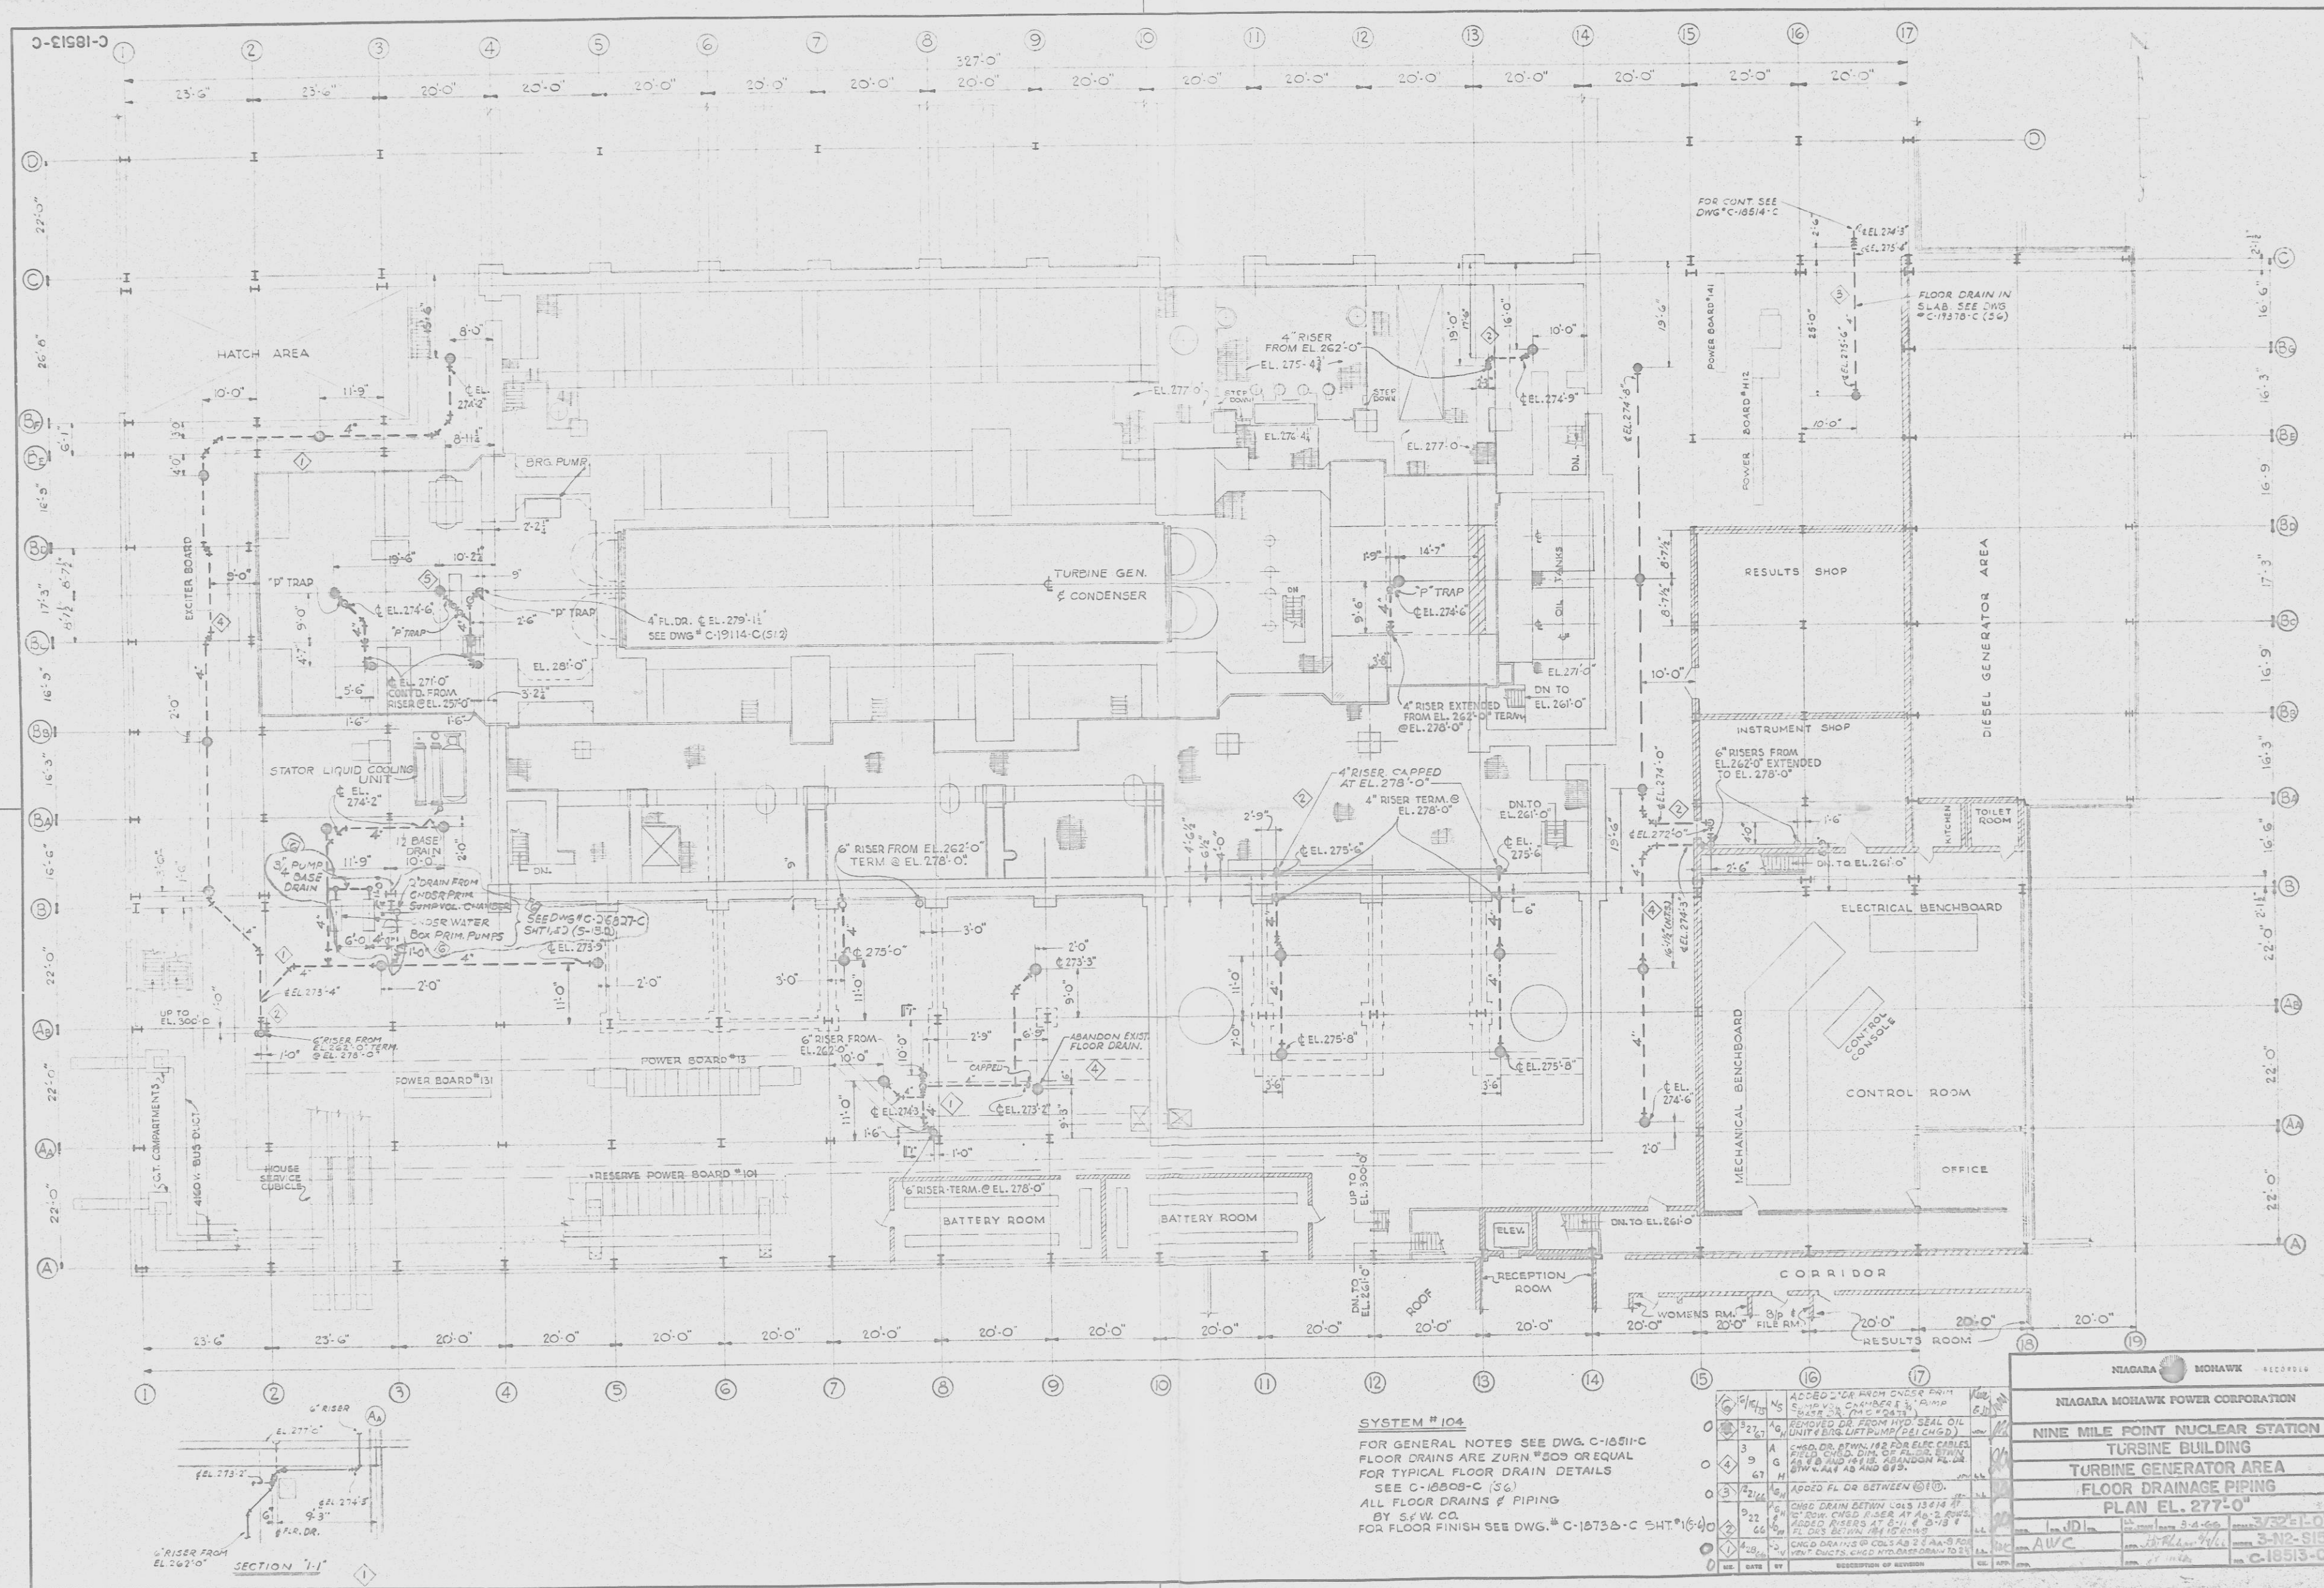

11-11-78
 17811290192
 50-220
 D
 RETURN TO REACTOR DOCKET
 FILES

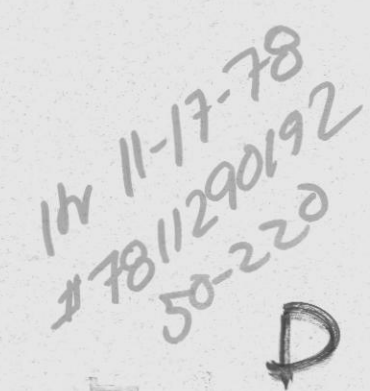

RETURN TO REACTOR DOCKET
FILES

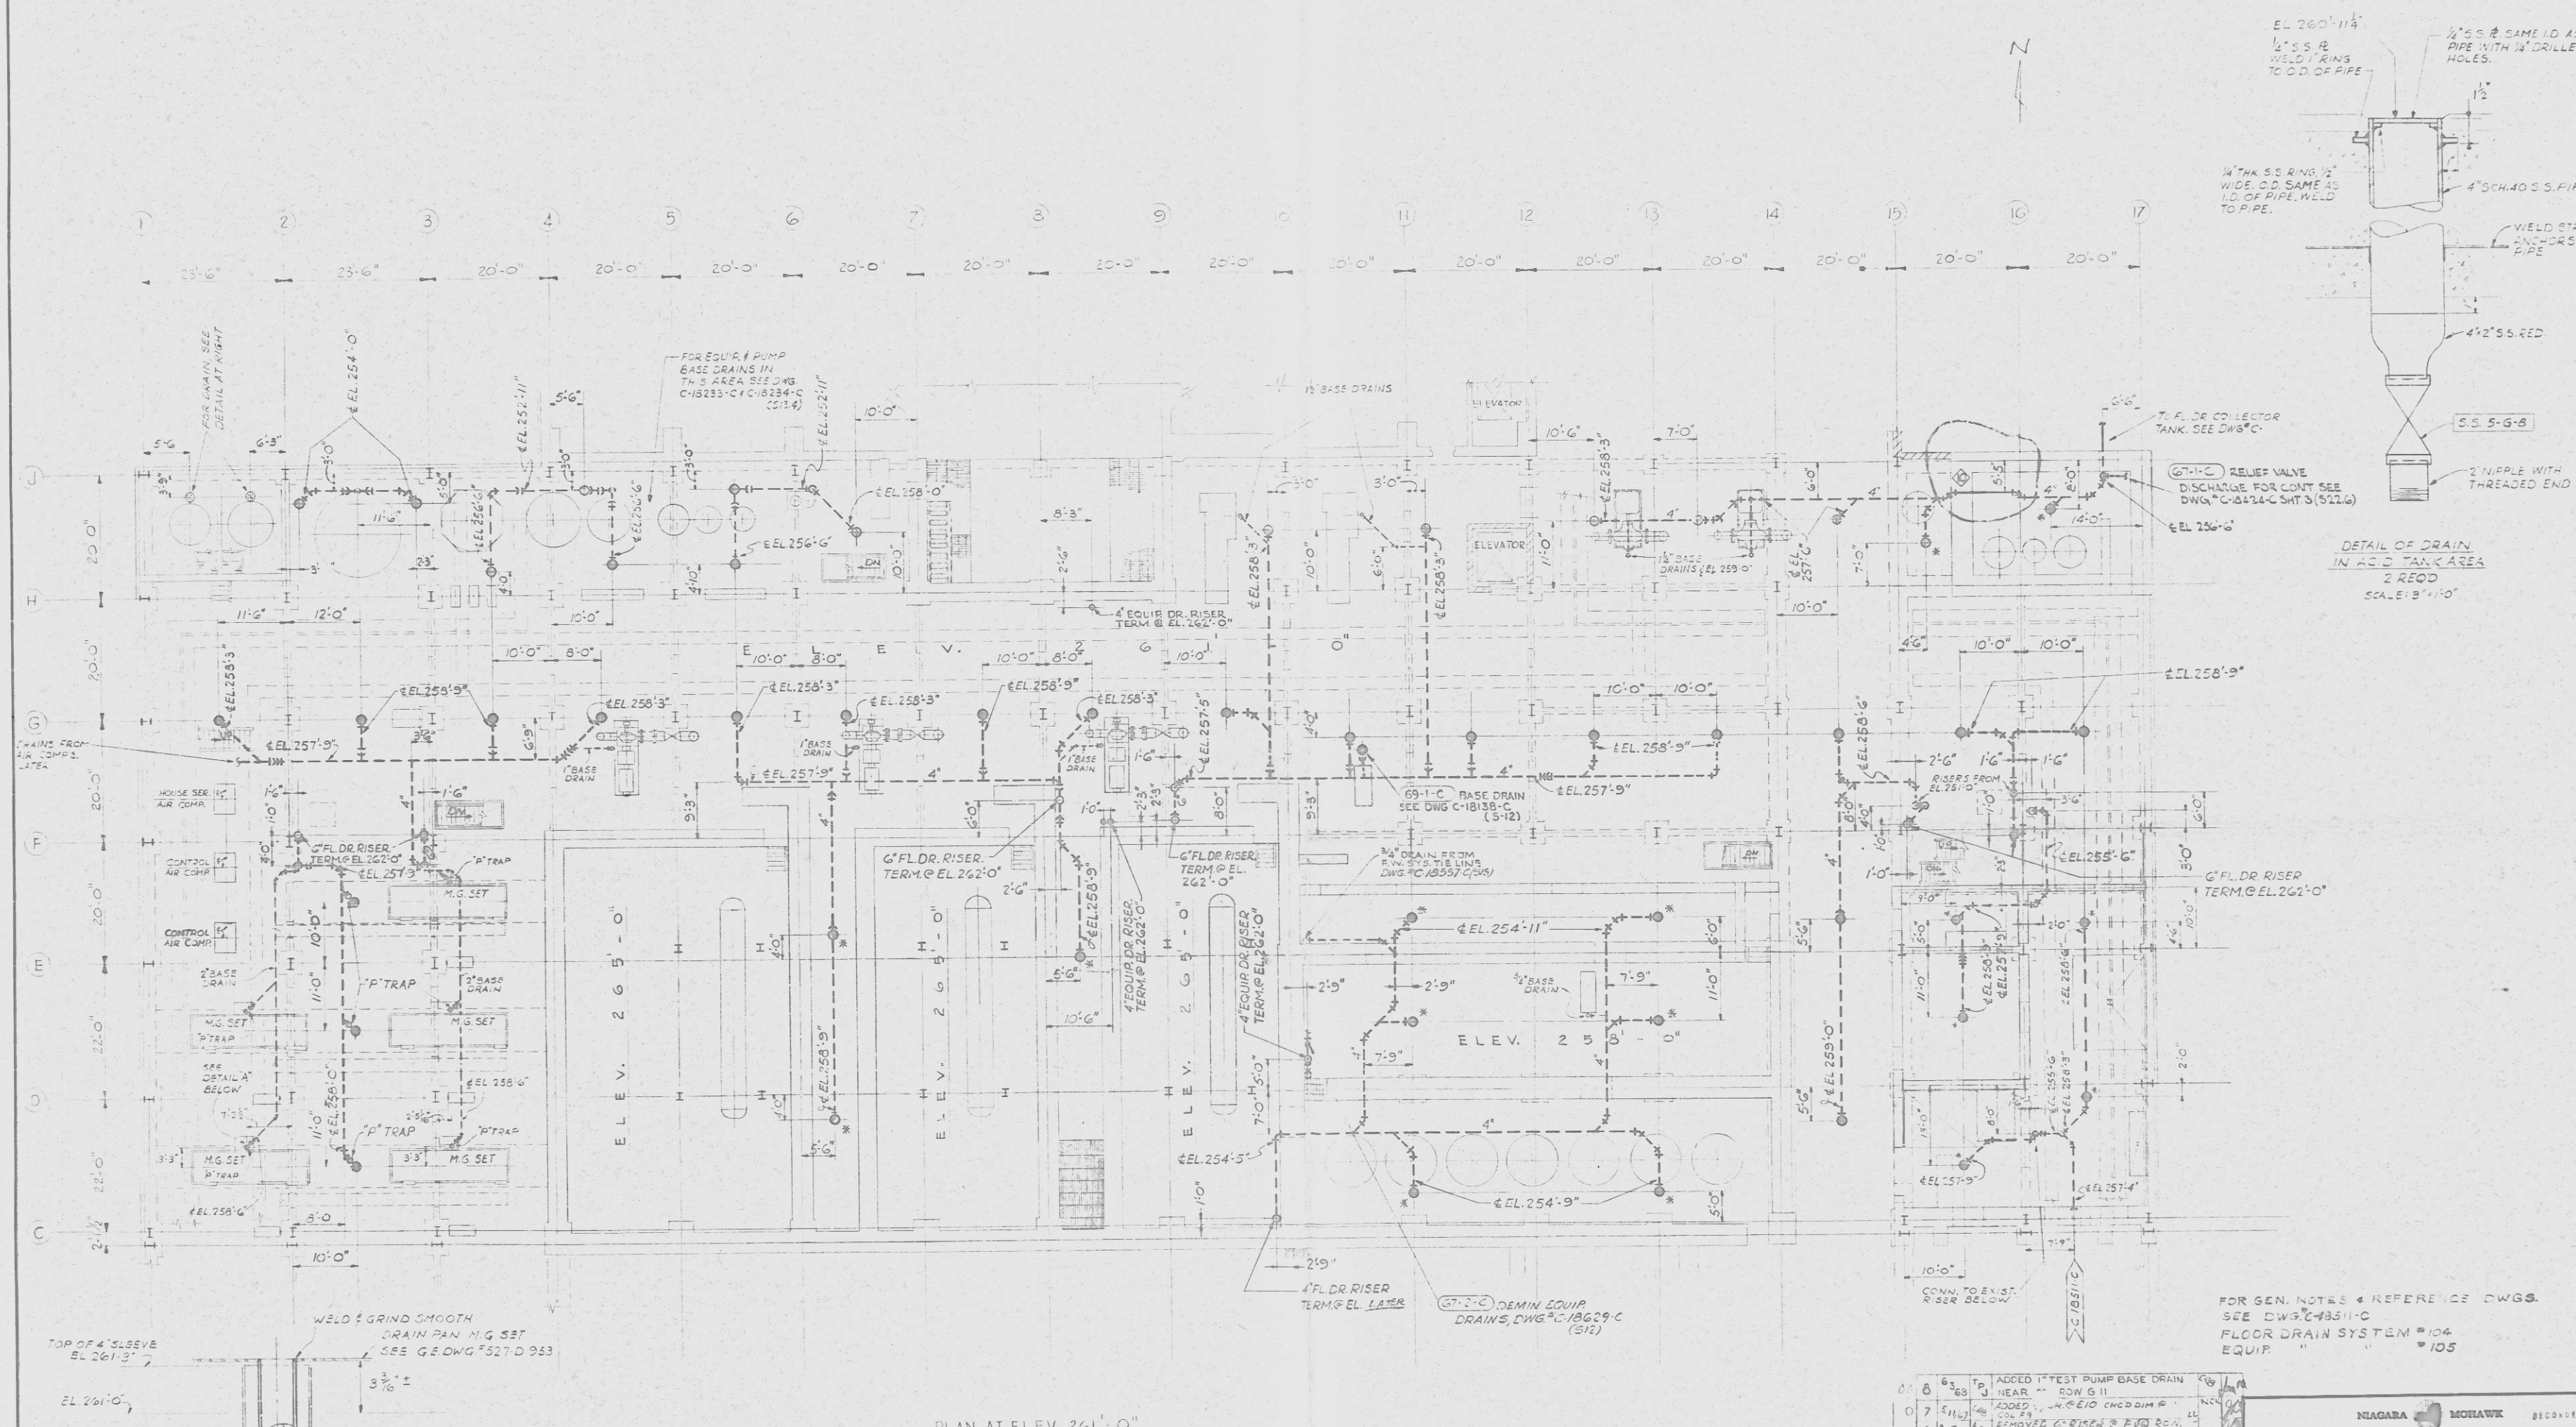

PLAN AT ELEV. 261'-0"




DETAIL "A" AT MG SETS

[illegible]

NIAGARA		MOHAWK		RECD 04	
NIAGARA MOHAWK POWER CORPORATION					
NINE MILE POINT NUCLEAR STATION					
TURBINE BLDG.					
TURBINE AUX AREA					
FLOOR DRAINAGE PIPING					
PLAN-EL. 2 nd F.					
DATE	REV.	BY	DATE	REVISION	
1/24/65				3-732-110	
1/24/65				3-N2-S15	
1/24/65				3-1512-C	
				SHEET 1 OF 2	

RETURN TO REACTOR DOCKET
FILES

2' NS 3'-0" S151-C

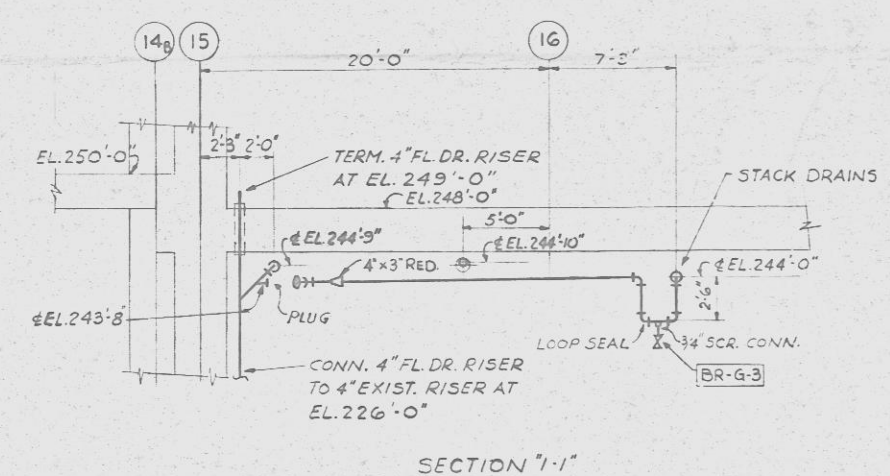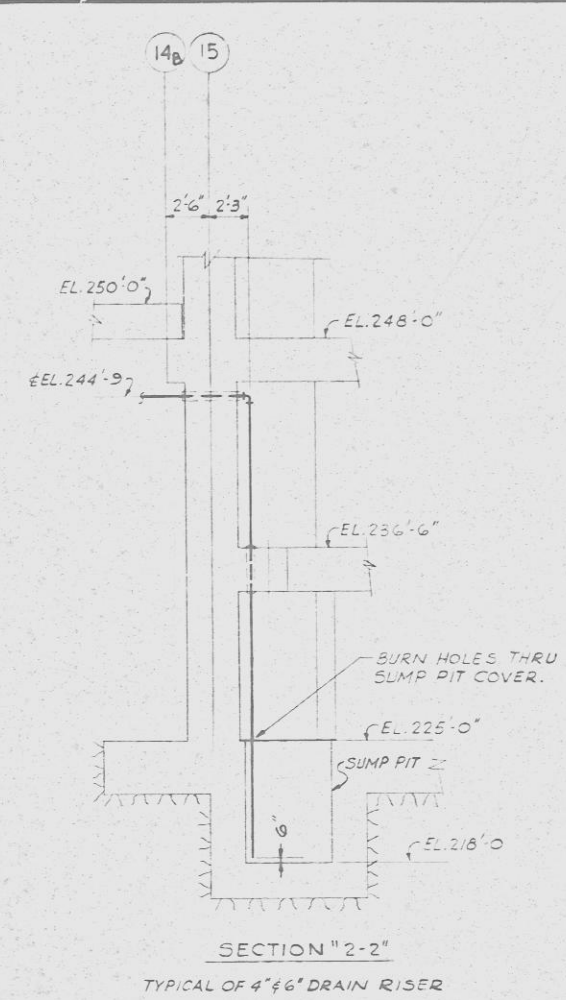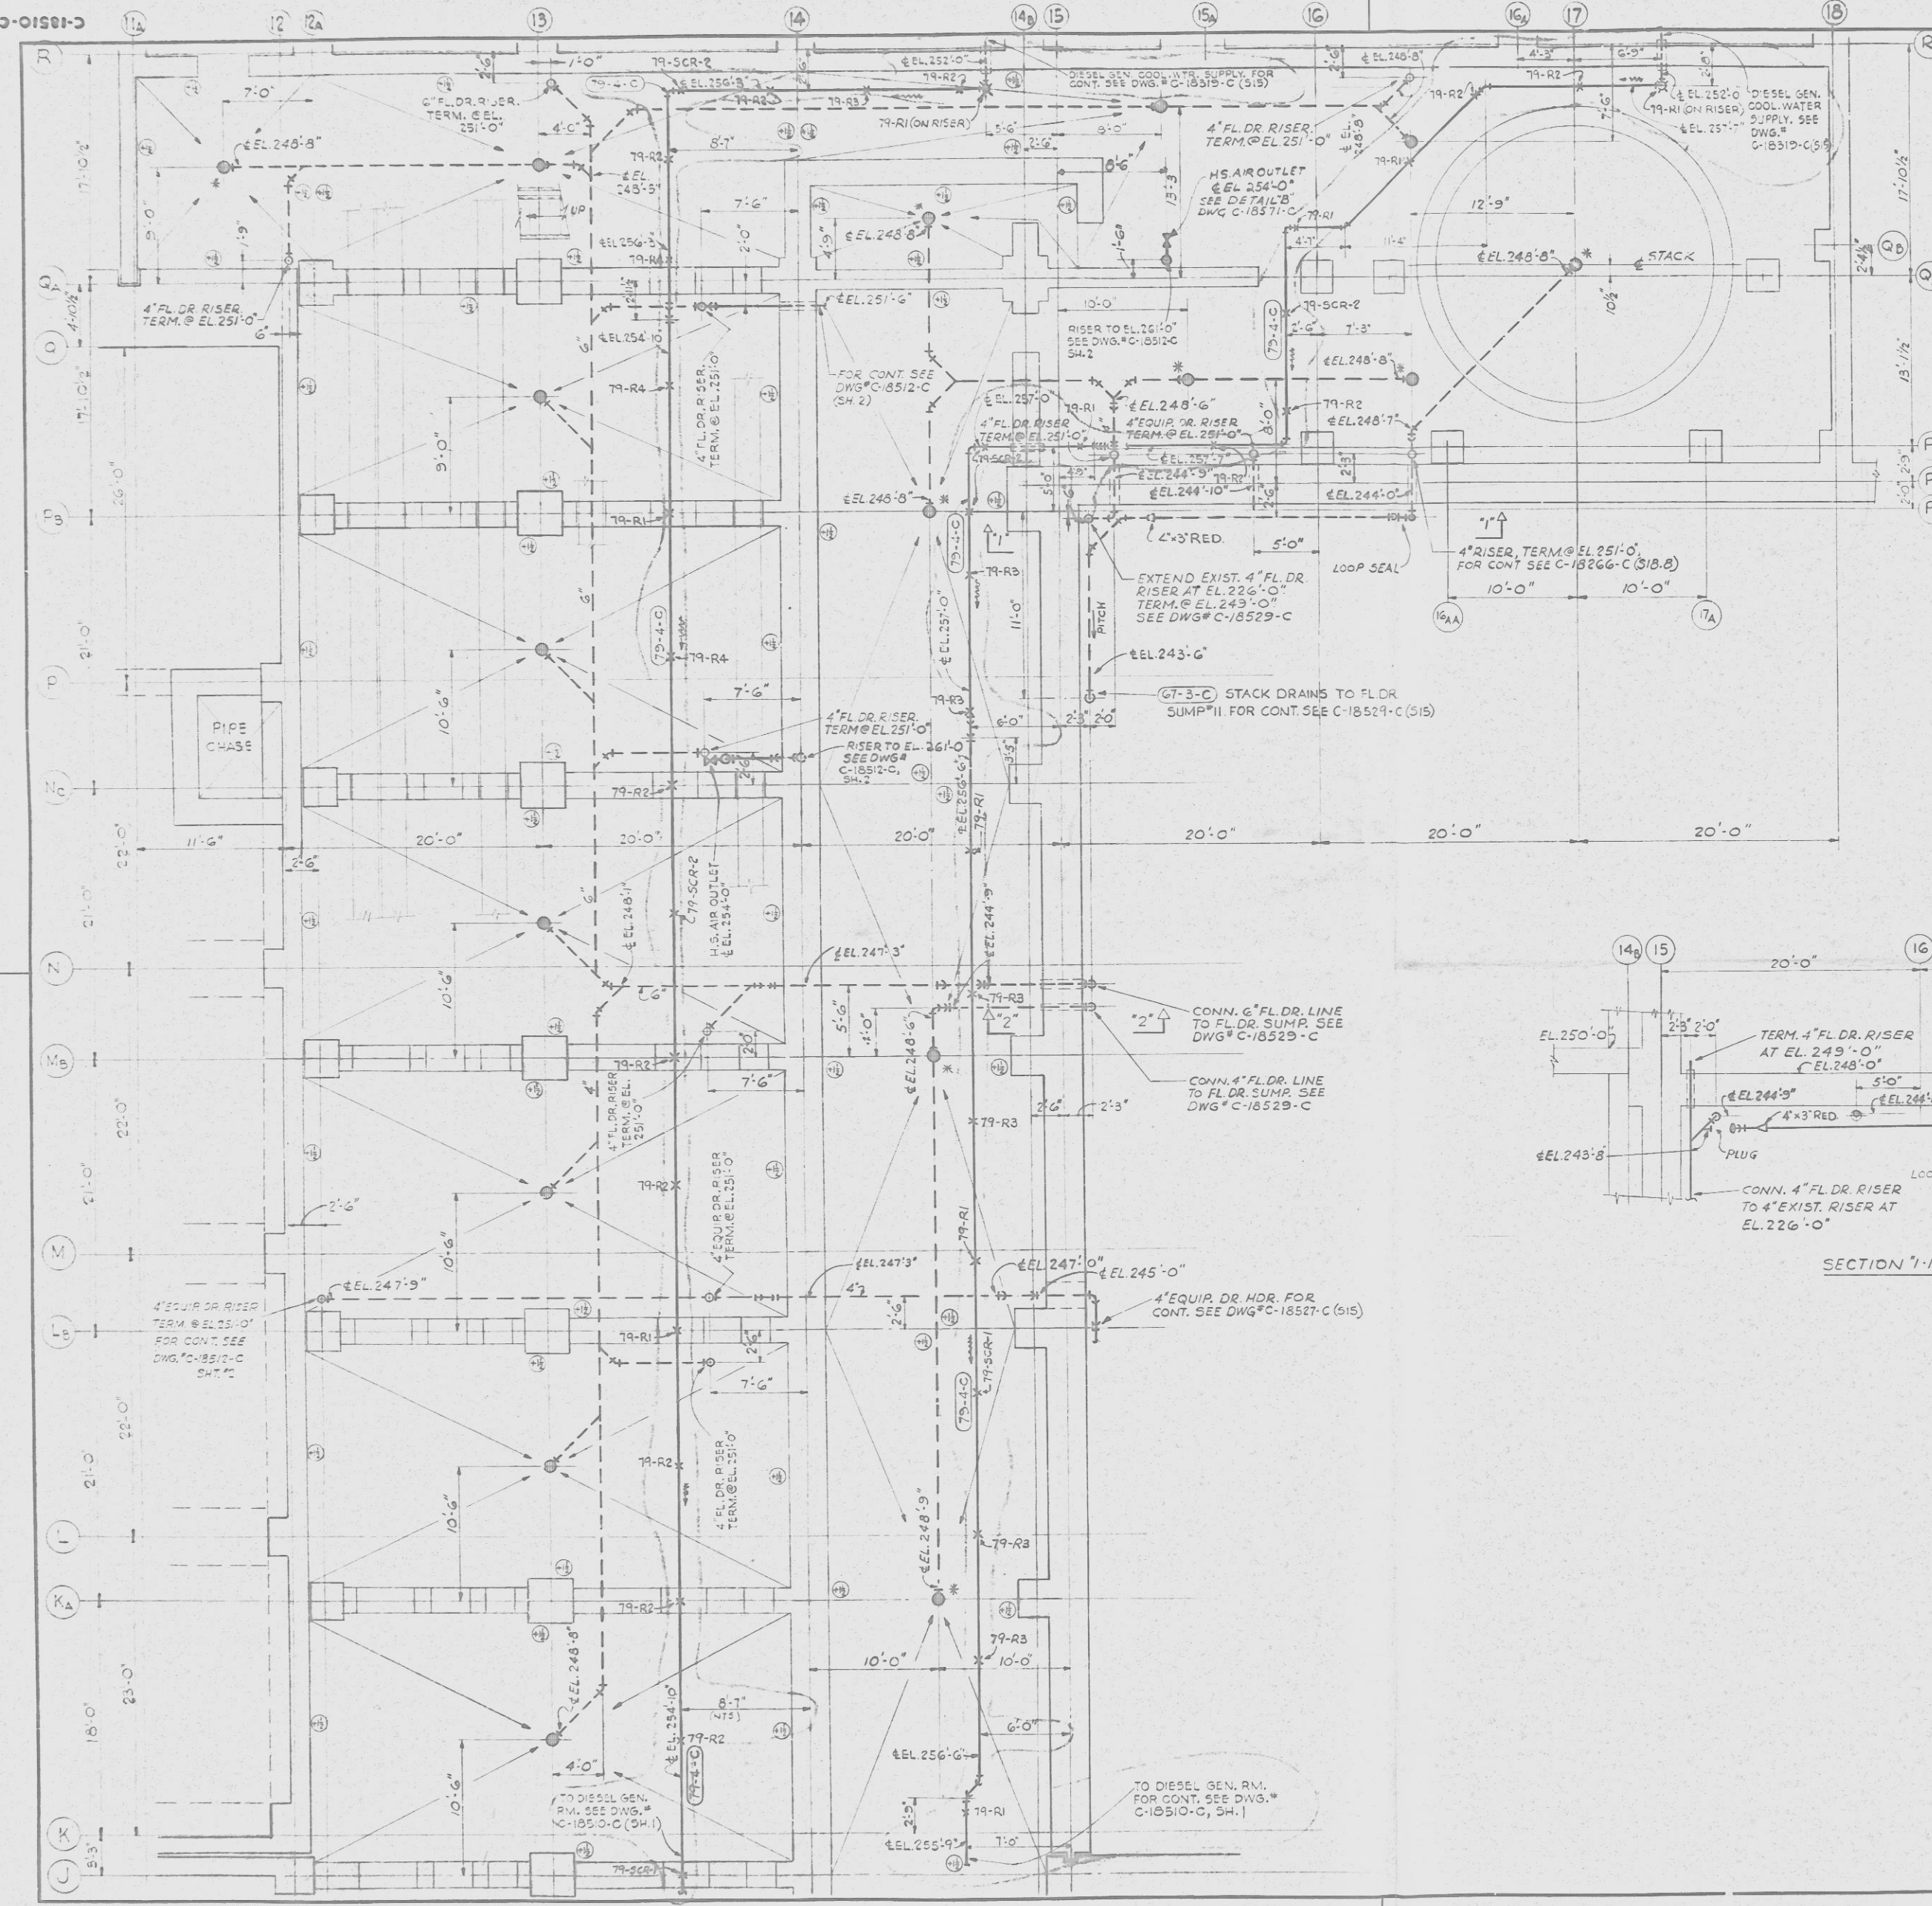

NOTE: (S) INDICATES ELEV. OF RIDGE LINES WITH RELATION TO ELEV. 250'-0" FOR FL. ELEV. 250'-0" SET FL. DR. AT ELEV. 250'-0" (EXCEPT AS NOTED)

FOR DETAIL OF SETTING FLOOR DRAIN SEE DWG # C-18509-C

* ZURN #509 WITH SCR. OUTLET OR EQUAL

Ø ZURN #516 WITH SCR. OUTLET OR EQUAL

FOR COND. ENVELOPE AT FLOOR DRAINS SEE DWG # C-18510-C

FOR EQUIP. DRAIN CONTAINMENT PIPE SEE DWG # C-15510-C

FOR GENERAL NOTES SEE DWG # C-18509-C

ALL WORK & MATERIAL BY S & W. CO.

DIESEL GEN. COOL. WATER SYSTEM #79

FLOOD DRAINS SYSTEM #104

EQUIP. DRAINS SYSTEM #105

HOUSE SERVICE AIR SYS # 05

6	18510	FD	REVISED DIESEL GEN. COOL. WATER LINES PER AS BUILT DIMS. & ASSESS. HOS.	1/20	1/20
5	18510	FD	ADD DRAIN NEW COOL. WATER SUPPLY - NES	1/20	1/20
4	18510	NO	REVISED STACK DRAIN	1/20	1/20
3	18510	NS	ADD HOUSE SERVICE AIR RELATIVE WITH FLOOD DRAIN	1/20	1/20
2	18510	NS	CHGD AREA EAST OF 15 ROW	1/20	1/20
1	18510	NS	CHGD ELEV. OF RIDGE THRU 15 ROW	1/20	1/20
0	18510	NS	CHGD ELEV. OF RIDGE THRU 15 ROW	1/20	1/20


NO.	DATE	BY	DESCRIPTION OF REVISION	CHK.	APP.
1	1/20	NS	CHGD ELEV. OF RIDGE THRU 15 ROW		


11-17-78 LK
#7811290142
50-220
D

RETURN TO REACTOR DOCKET
FILES

RETURN TO REACTION DOCKET
FILES


87-11-11 41
261062118L #
022-05
D

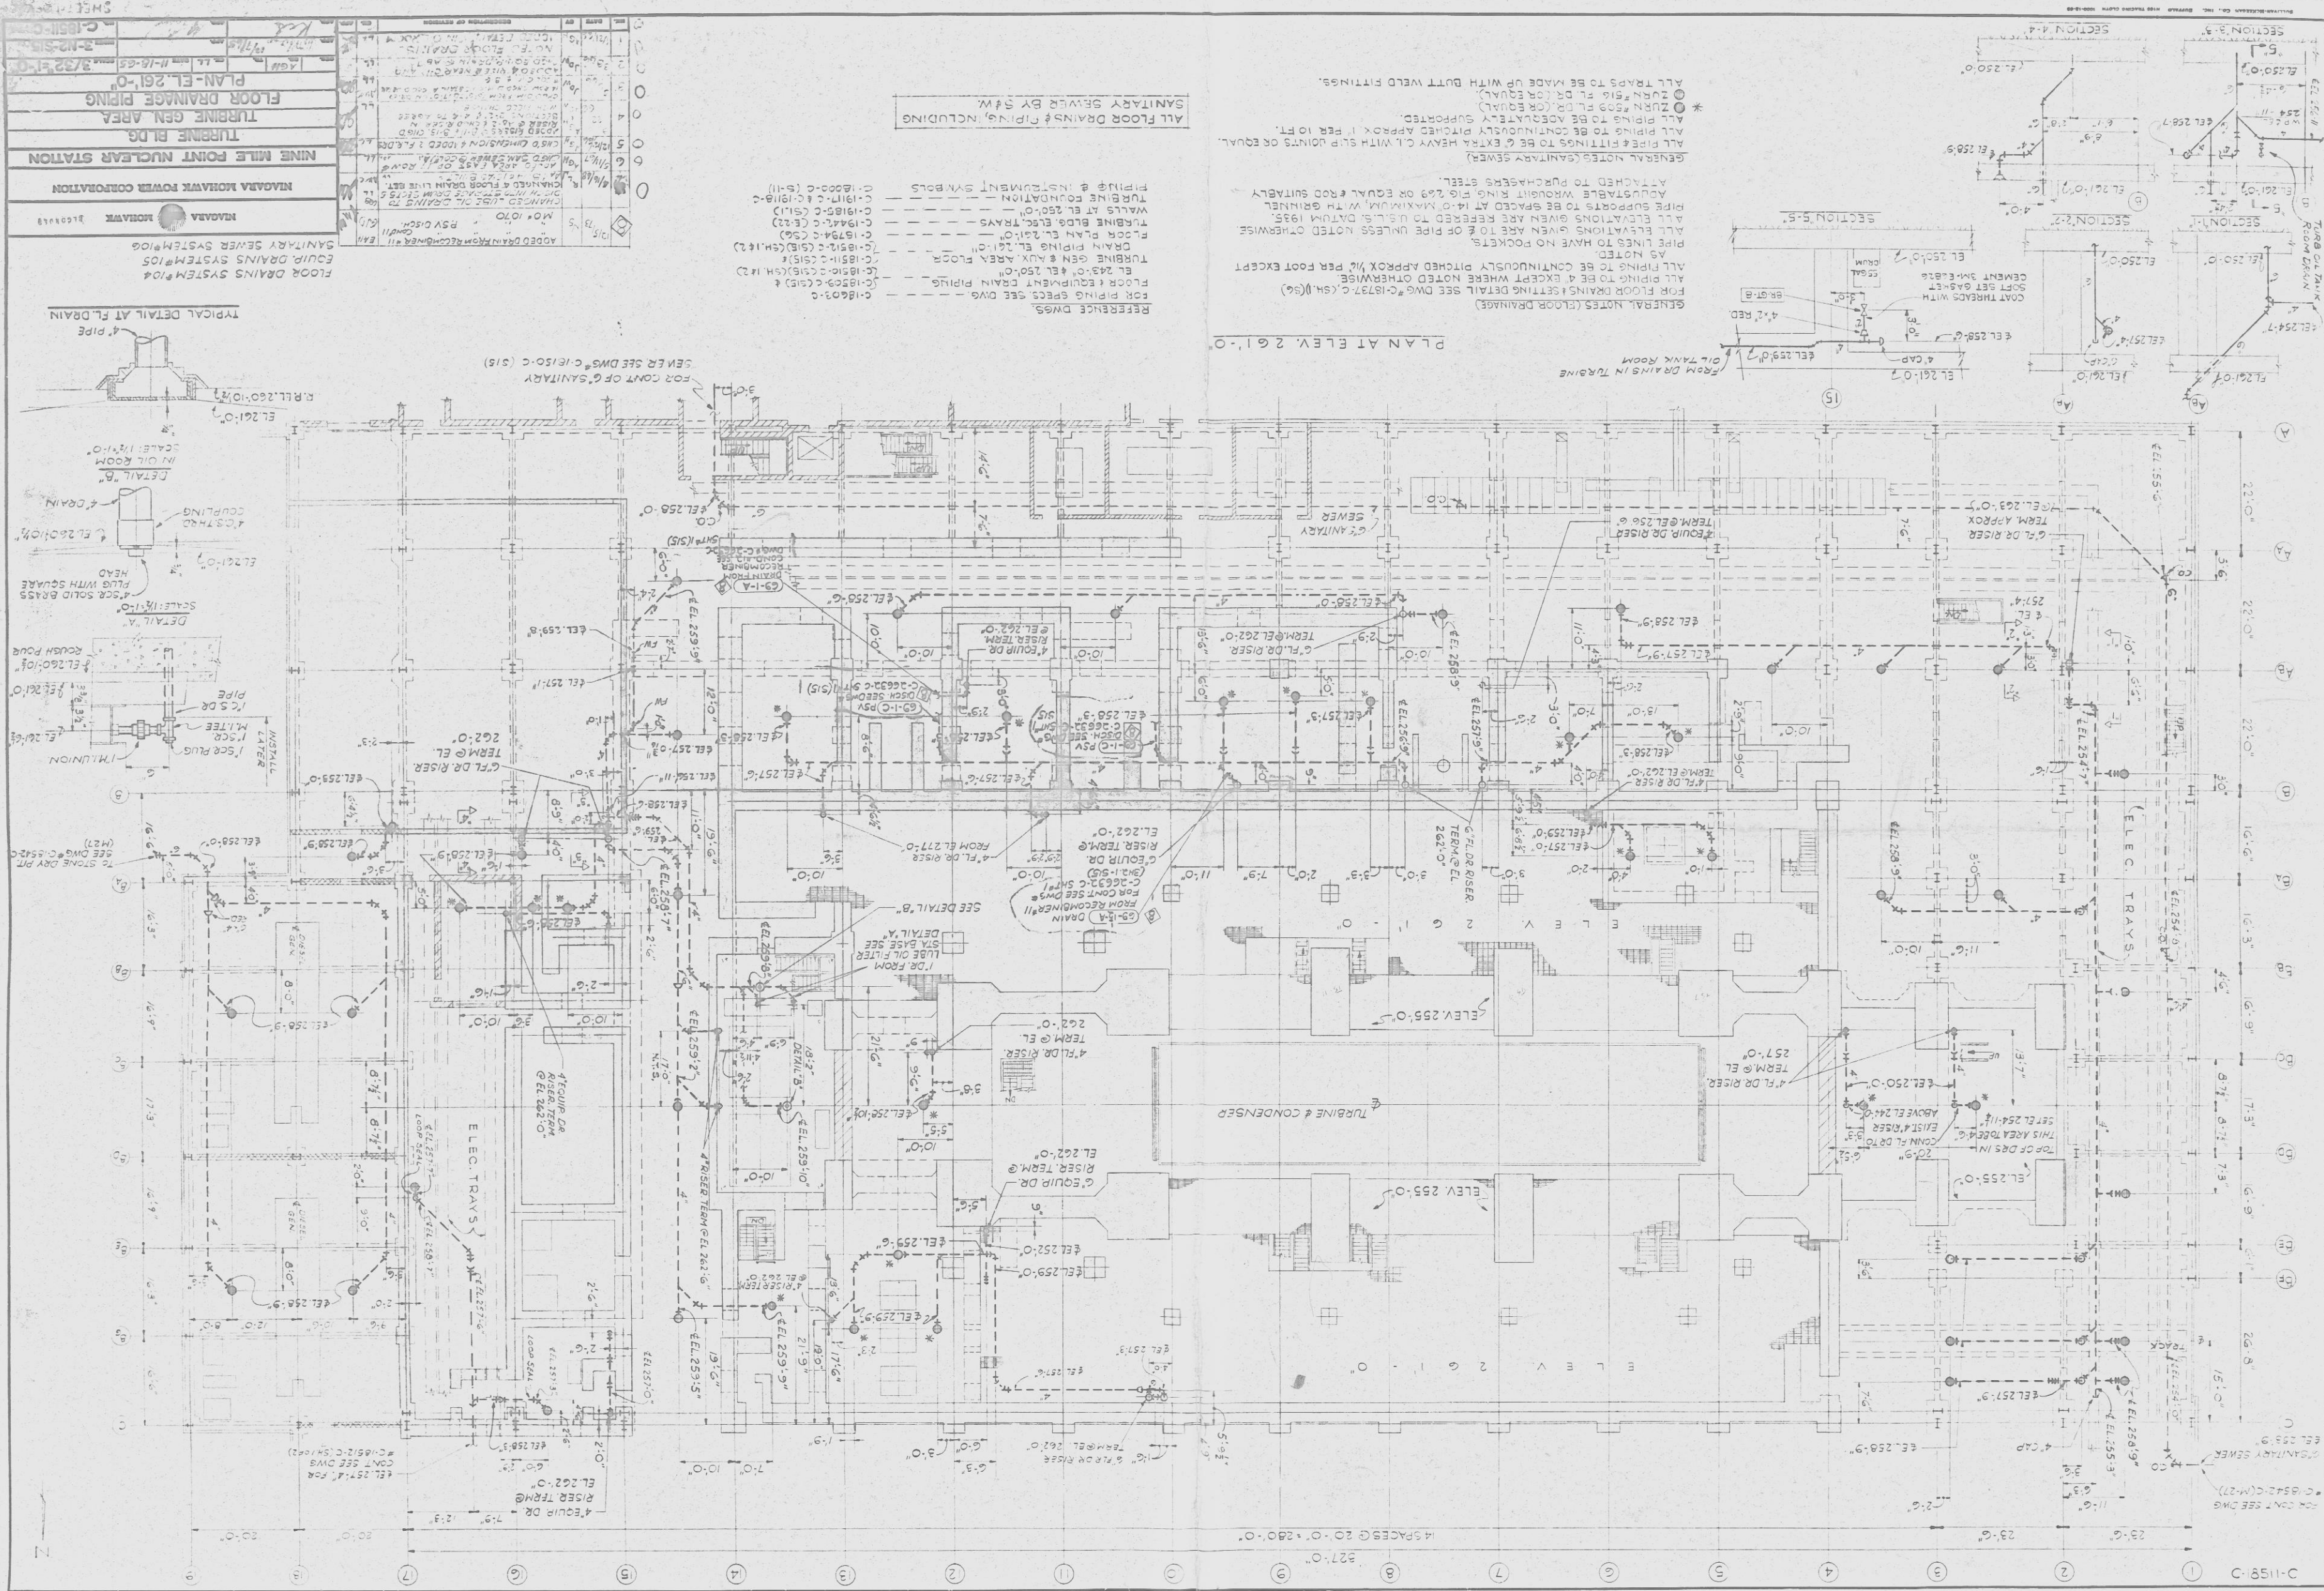

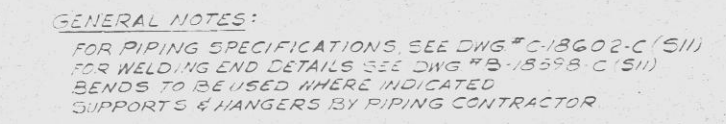


REFERENCE DWGS.

GERINWASTE TREATMENT PLANT PFI DIA. - SEE DWG/H8725 SH/125220
FLOOR PLAN EL 225'-0" & EL 229'-0" - (U)5725-C (S)23
EL 247'-0" & EL 248'-0" - (U)5727-C (S)23
PUMP PIT LINERS - (U)5728-C (S)23/24 (S)23
FL DR SUMP #1 - BUFFALO RUMP DWG #4060 XC (S)679
" #2 " " " #4060 X5
" #3 " " " #4060 XF
EQUIP DRAIN SUMP #1 " " " CD17109X

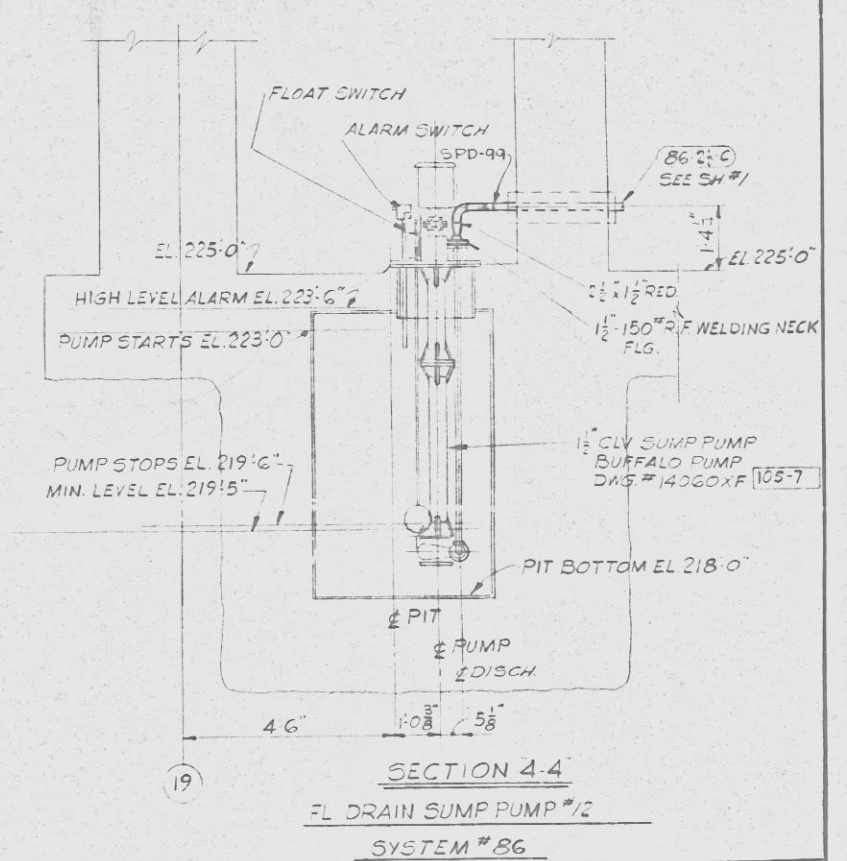[illegible]

RETURN TO REACTOR DOCKET
FILES


7811290192
1K 11-17-78
50-220
D

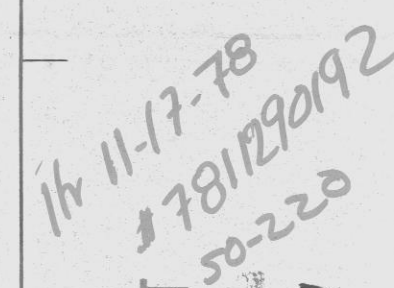


RETURN TO REACTOR DOCKET
FILES

D


MICRO AT 30-X

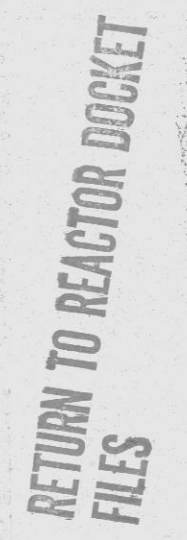

44
11-17-78
7811290192
50-220
D

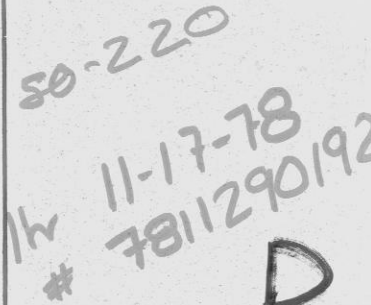

GOING TO REACTOR DOCKET

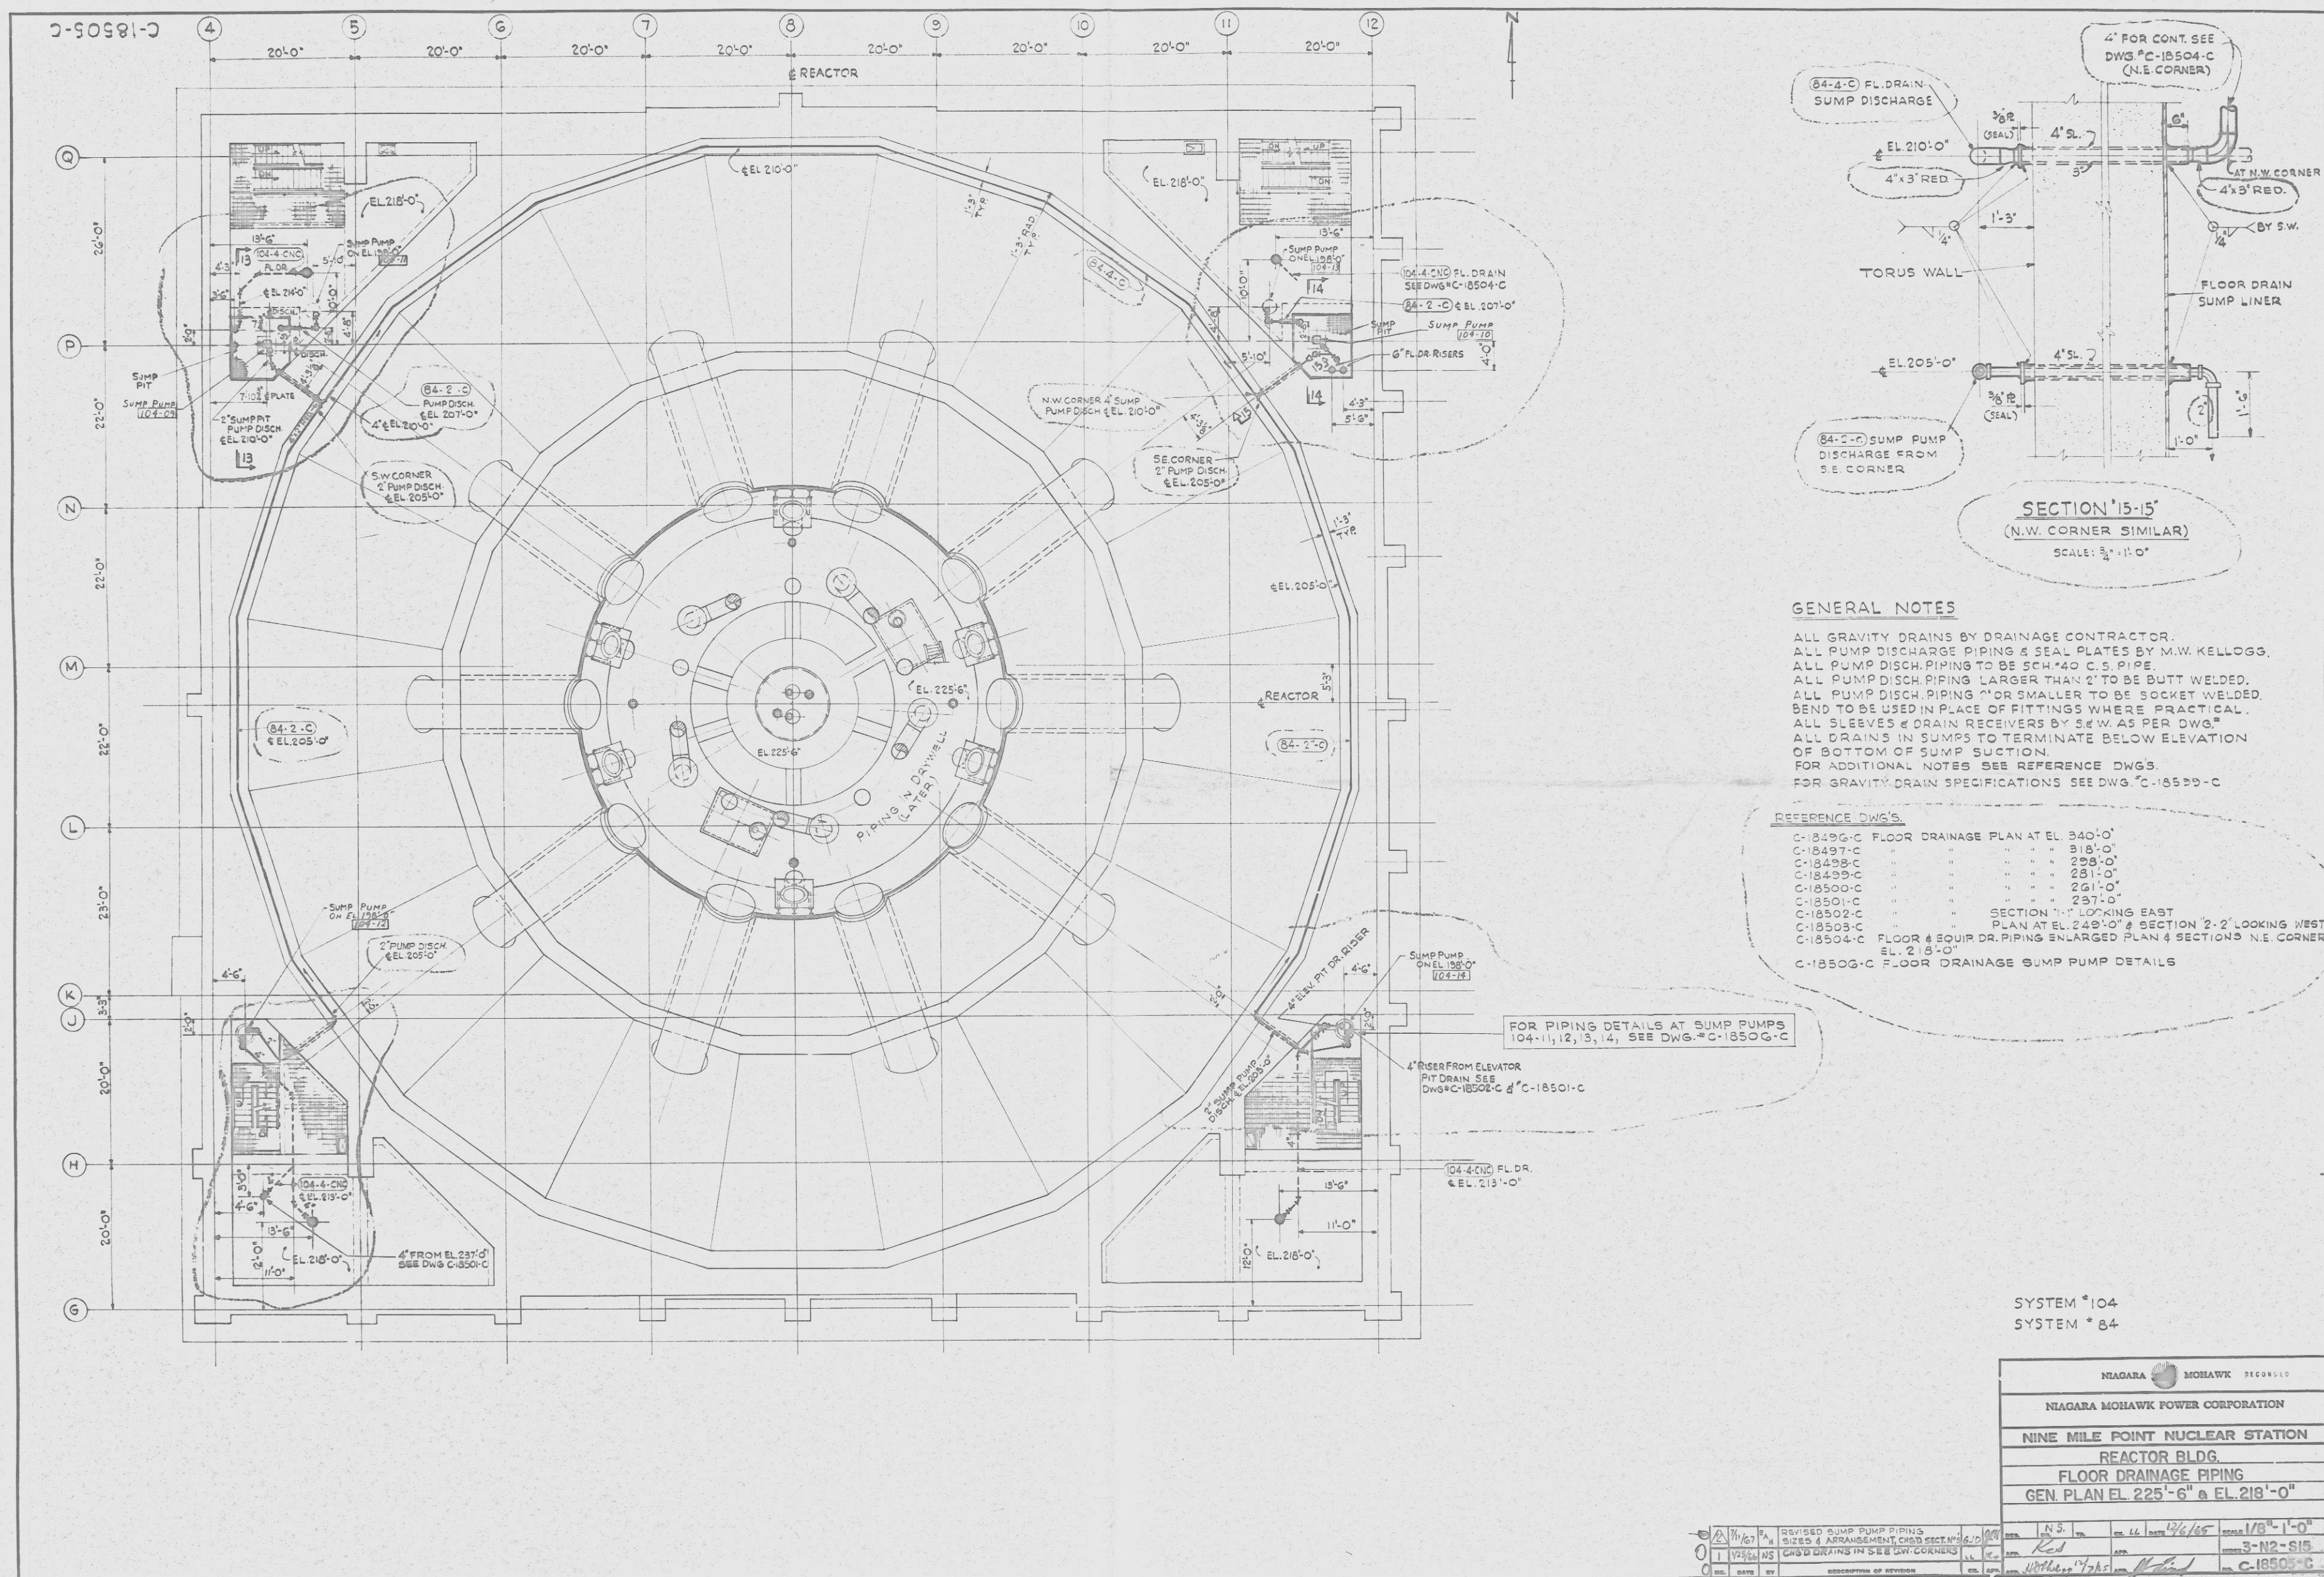

1/4 11-17-78
7811290192
50-220
D


C-18510-C (5-7) NOTES FOR FLOOR DRAIN CONC. ENVELOPE
EQUIP. DRAIN CONTAINMENT PIPES
ALL BURIED FLOOR DRAIN PIPING & EQUIP.
DRAINS ONLY THOSE OF LOW TEMPERATURE
FLOW (RADIOACTIVITY) WHICH ARE CONNECTED
TO THE FLOOR DRAIN SYSTEM ARE TO
BE ENCASED IN A MINIMUM OF SIX (6)
INCHES OF CONC. ENVELOPE AS SHOWN
ON DETAIL.
ALL EQUIP. DRAINS EXCEPT THOSE NOTED
ABOVE ARE TO BE ENCASED IN A CONTAINMENT
PIPE. SEE DETAIL.

CONTAINMENT PIPE SHALL BE SCH. 10.
ALL OUTSIDE SURFACES OF BURIED
CONT. PIPES EXCEPT WHEN ENCASED
IN CONC. SHALL BE GIVEN TWO (2) HEAVY
COATINGS OF KOPPEL'S SUPER SERVICE
BLACK OR EQUAL BITUMASTIC COATING.
CONTAINMENT PIPE SHALL PROVIDE ADEQUATE
INTERNAL CLEARANCES FOR THERMAL
EXPANSION OF DRAIN PIPE AT 220 F.
MAX. TEMPERATURE.



BEFORE INSTALLING CONC. ENVELOPE OR
CONT. PIPE CLOSURES, ALL DRAIN PIPES
SHALL BE AIR TESTED AT 15 P.S.I. ALL WELDS
SHALL BE CHECKED WITH SOAP SUDS AND
REPAIRED WHERE NECESSARY AND RETESTED.
CONTAINMENT PIPES SHALL ALSO BE
AIR TESTED IN THE SAME MANNER DESCRIBED
ABOVE.
EACH SUMP SHALL BE CONNECTED
TO A #9 STRANDED COPPER SINGLE CONDUCTOR
TYPE T.W. RED TEST WIRE BY A
THERMIT OR OTHER APPROVED WELDING
PROCEDURE.

WIRE TO BE RUN TO JUNCTION
BOX LOCATED 14"
ABOVE FL. ELEV. AT COLUMNS
A-5, C-5, C-8, C-9, B-7, B-9,
B-10, F-2, F-9 & F-10.


CONT. PIPE TO
TERMINATE APPROX
3" ABOVE FLOOR.
SEAL WITH WELDED
PLATE.

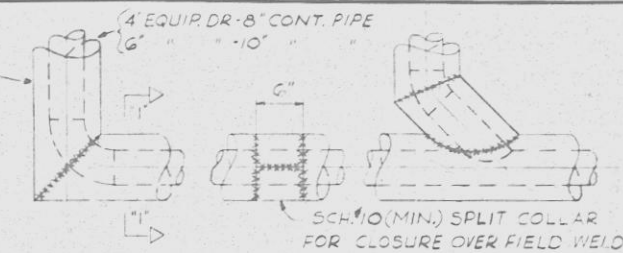


1/8" SUPPORT FINS SPACED NOT
MORE THAN 14" ALONG PIPE RUN.
INSIDE RADIUS OF CONT. PIPE
- 1/16". CONT. PIPE TO BE AT
LEAST SCH. 10.
SECTION "I-I"

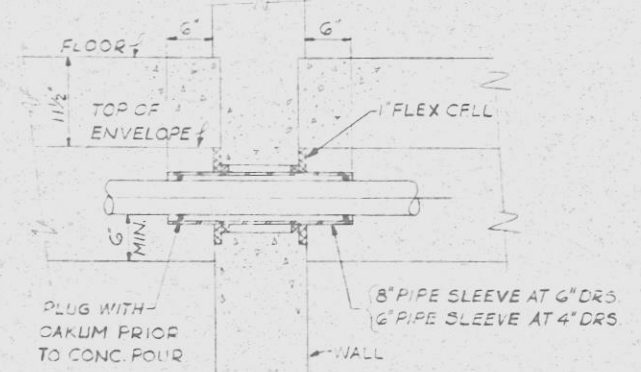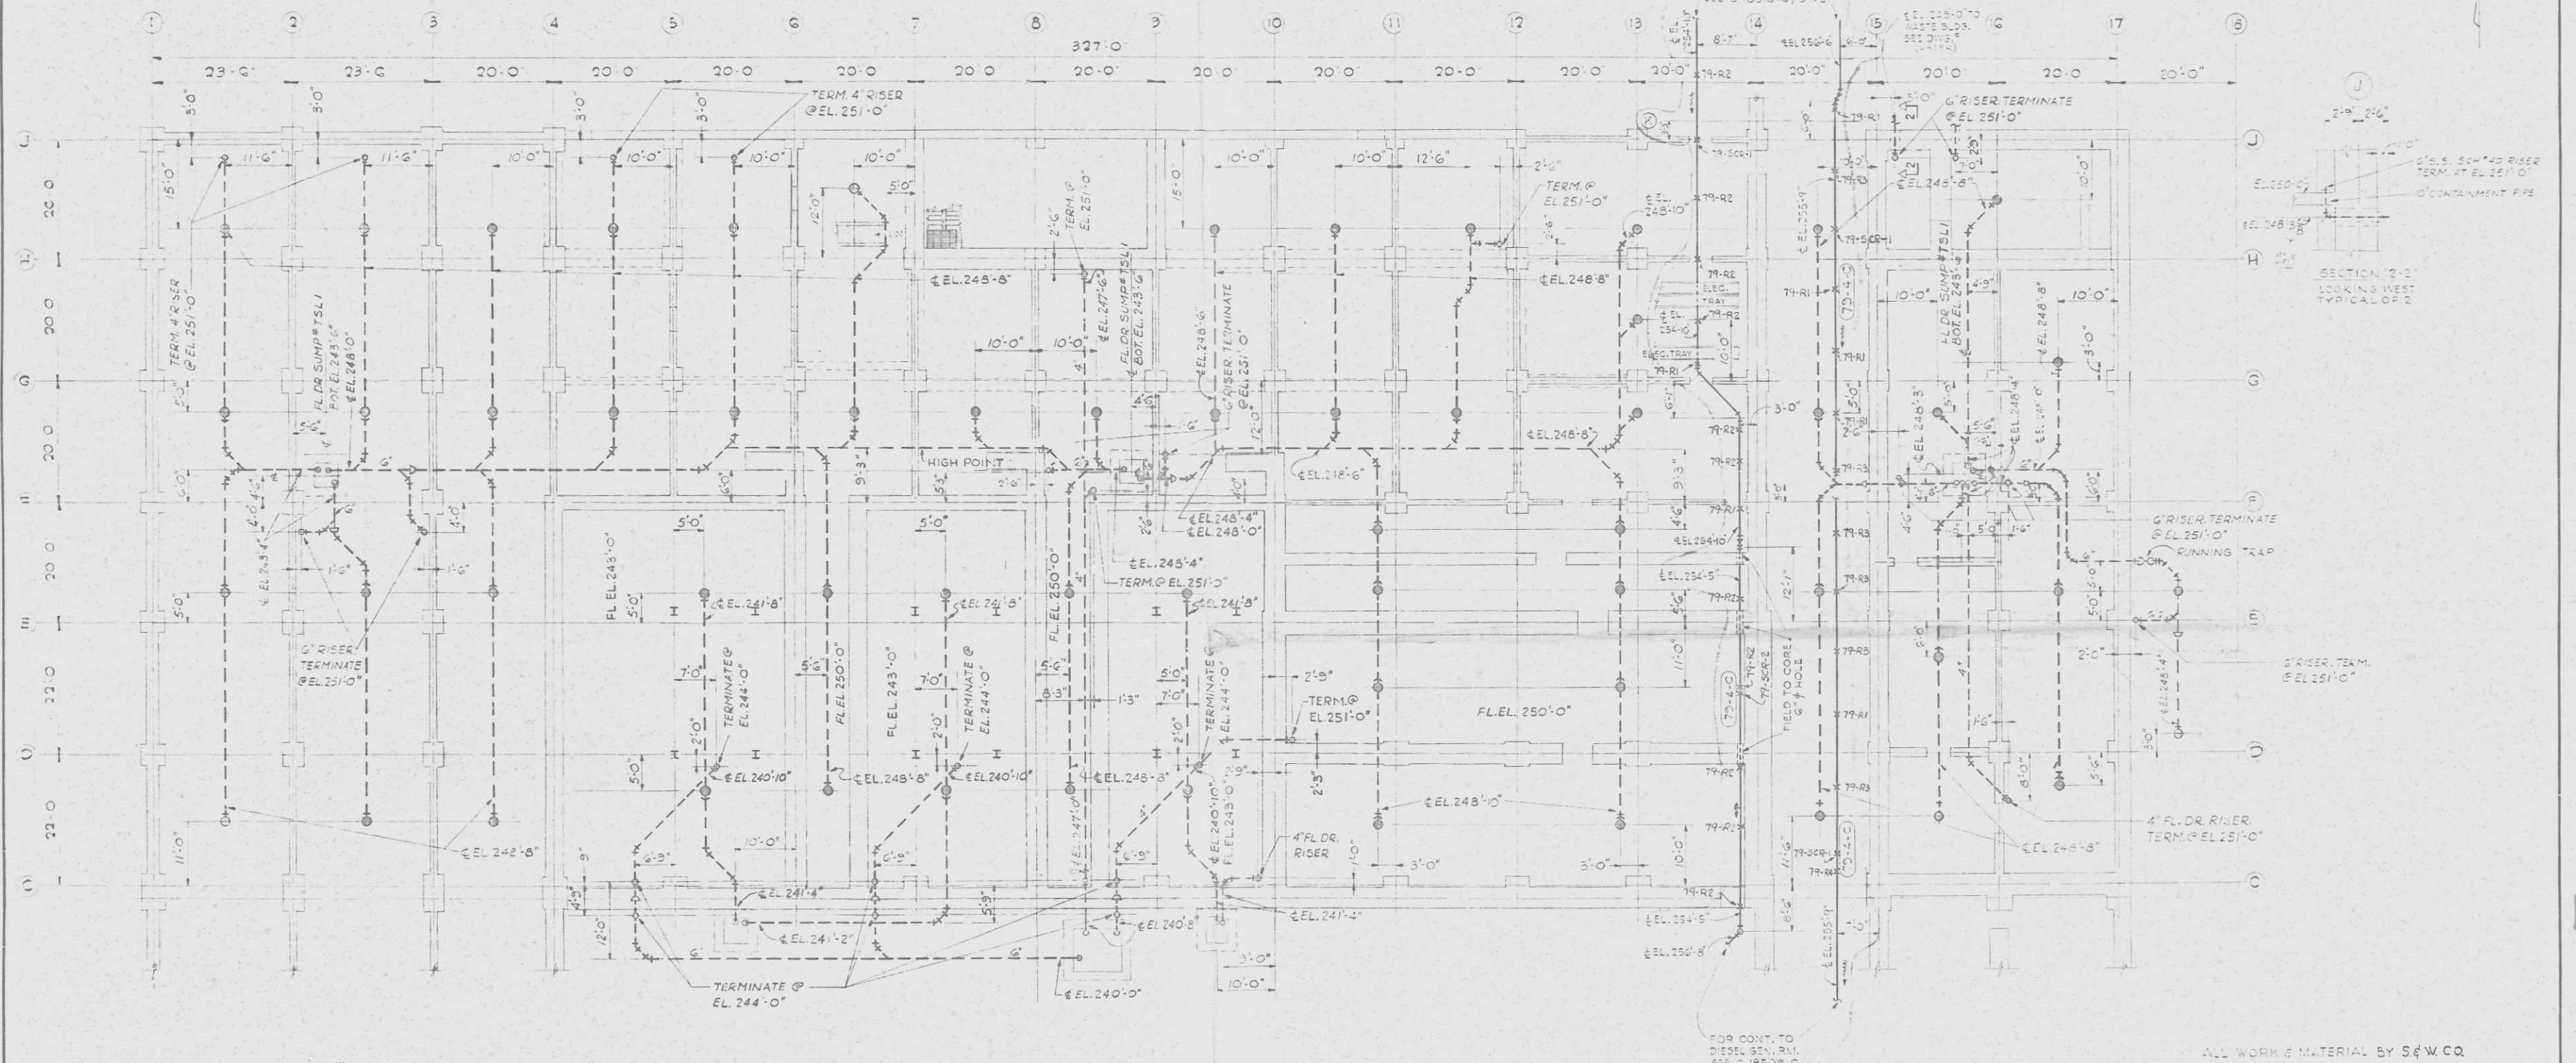

TYPICAL DETAIL AT WALLS
FOR FLOOR DRAINS

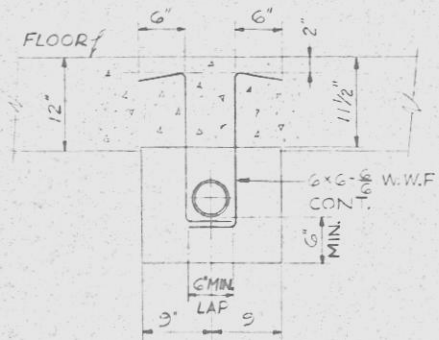

TYPICAL DETAIL OF CONC.
ENVELOPE FOR FLOOR DRAINS
WHERE ROCK IS 6" OR MORE BELOW
BOTTOM OF ENVELOPE

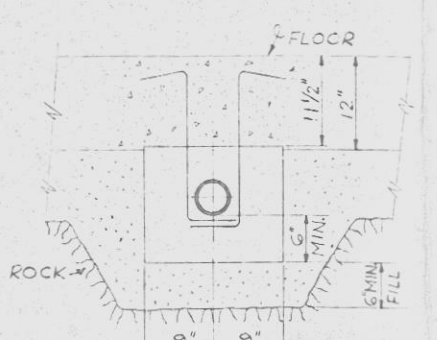

TYPICAL DETAIL OF CONC.
ENVELOPE FOR FLOOR DRAINS
WHERE ROCK IS NOT BELOW ENVELOPE

NOTE:
WHERE FLOOR SLAB REST ON
ROCK, NO FILL IS REQD. UNDER
CONCRETE ENVELOPE.

ALL WORK & MATERIAL BY S&W CO.

FOR GENERAL NOTES & REFERENCE DWGS. SEE
DWG. C-18509-C

012	2/8/74	DESIGN, CONCL. WTR. LINES FOR TURBINE BLDG. & EQUIP. AREA	SYSTEM #104
011	1/25/74	DESIGN, CONCL. WTR. LINES FOR TURBINE BLDG. & EQUIP. AREA	SYSTEM #105
010	1/25/74	DESIGN, CONCL. WTR. LINES FOR TURBINE BLDG. & EQUIP. AREA	SYSTEM #106
009	1/25/74	DESIGN, CONCL. WTR. LINES FOR TURBINE BLDG. & EQUIP. AREA	SYSTEM #107
008	1/25/74	DESIGN, CONCL. WTR. LINES FOR TURBINE BLDG. & EQUIP. AREA	SYSTEM #108
007	1/25/74	DESIGN, CONCL. WTR. LINES FOR TURBINE BLDG. & EQUIP. AREA	SYSTEM #109
006	1/25/74	DESIGN, CONCL. WTR. LINES FOR TURBINE BLDG. & EQUIP. AREA	SYSTEM #110
005	1/25/74	DESIGN, CONCL. WTR. LINES FOR TURBINE BLDG. & EQUIP. AREA	SYSTEM #111
004	1/25/74	DESIGN, CONCL. WTR. LINES FOR TURBINE BLDG. & EQUIP. AREA	SYSTEM #112
003	1/25/74	DESIGN, CONCL. WTR. LINES FOR TURBINE BLDG. & EQUIP. AREA	SYSTEM #113
002	1/25/74	DESIGN, CONCL. WTR. LINES FOR TURBINE BLDG. & EQUIP. AREA	SYSTEM #114
001	1/25/74	DESIGN, CONCL. WTR. LINES FOR TURBINE BLDG. & EQUIP. AREA	SYSTEM #115

NIAGARA MOHAWK POWER CORPORATION

NIAGARA MOHAWK POWER CORPORATION


NIAGARA MOHAWK POWER CORPORATION

11-17-78
#7811290192
50-220
D


RETURN TO REACTOR DOCKET
FILES

MICRO AT 30-X

C-18529-C

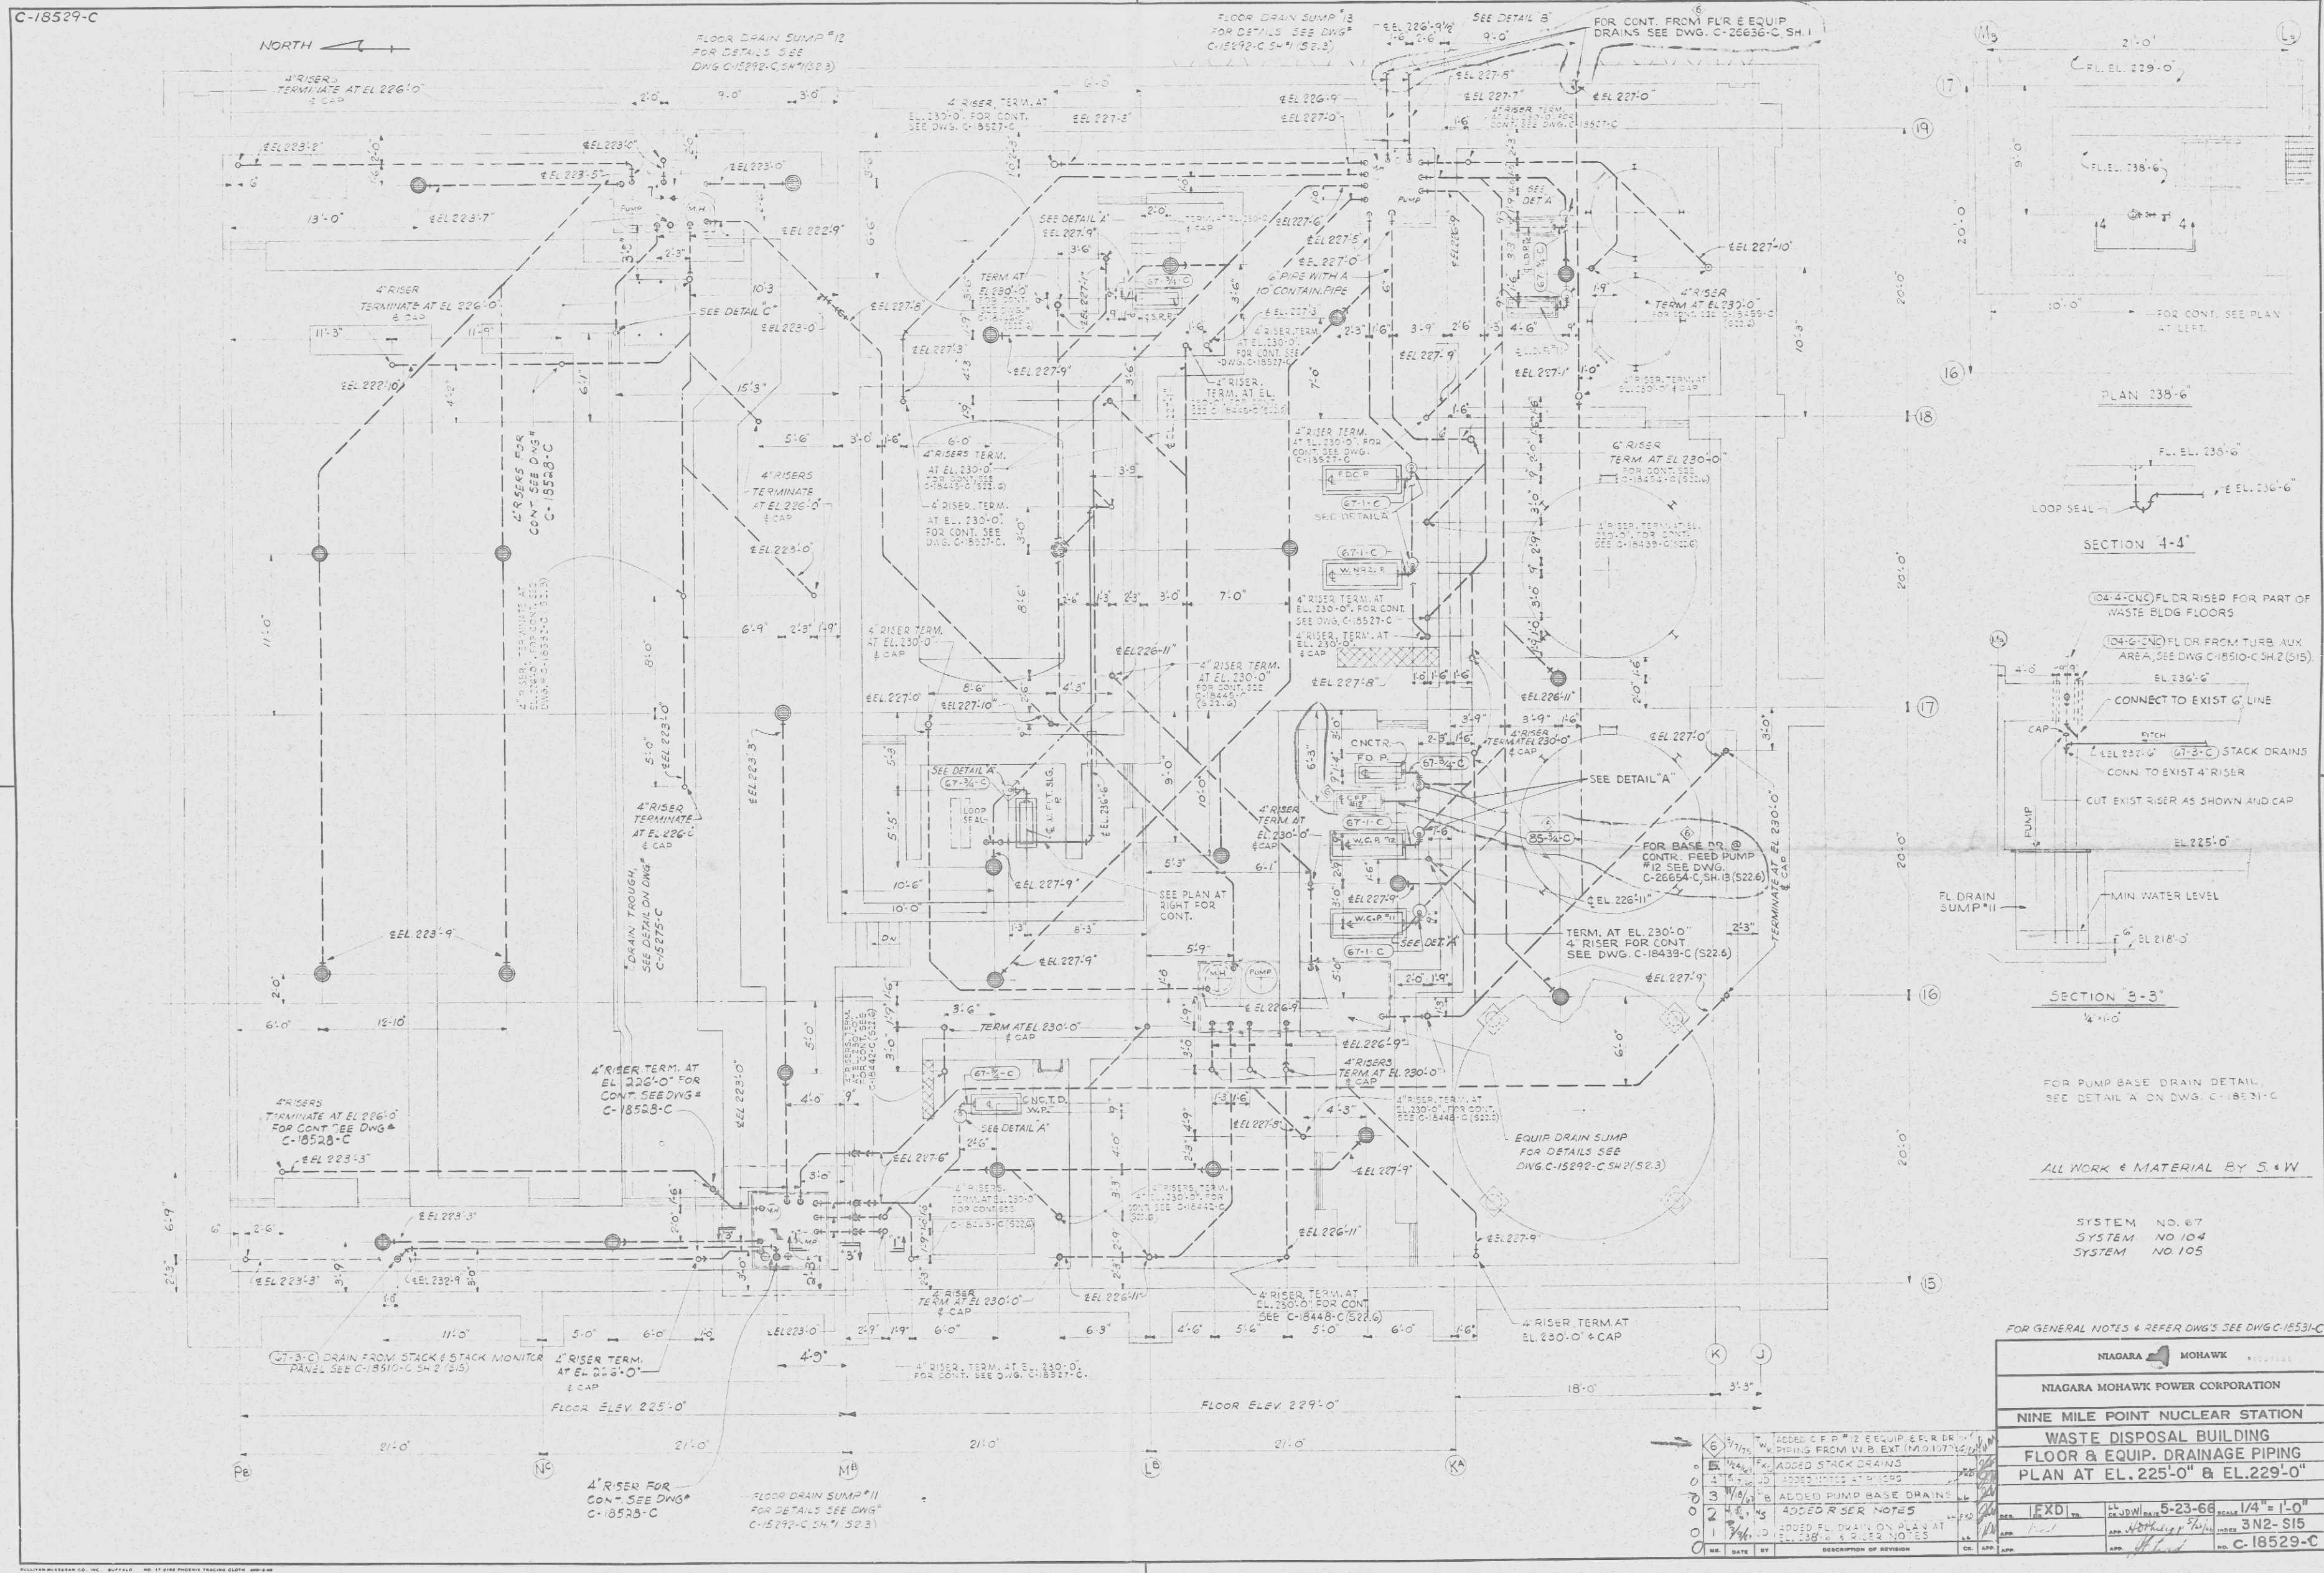

C-18526-C

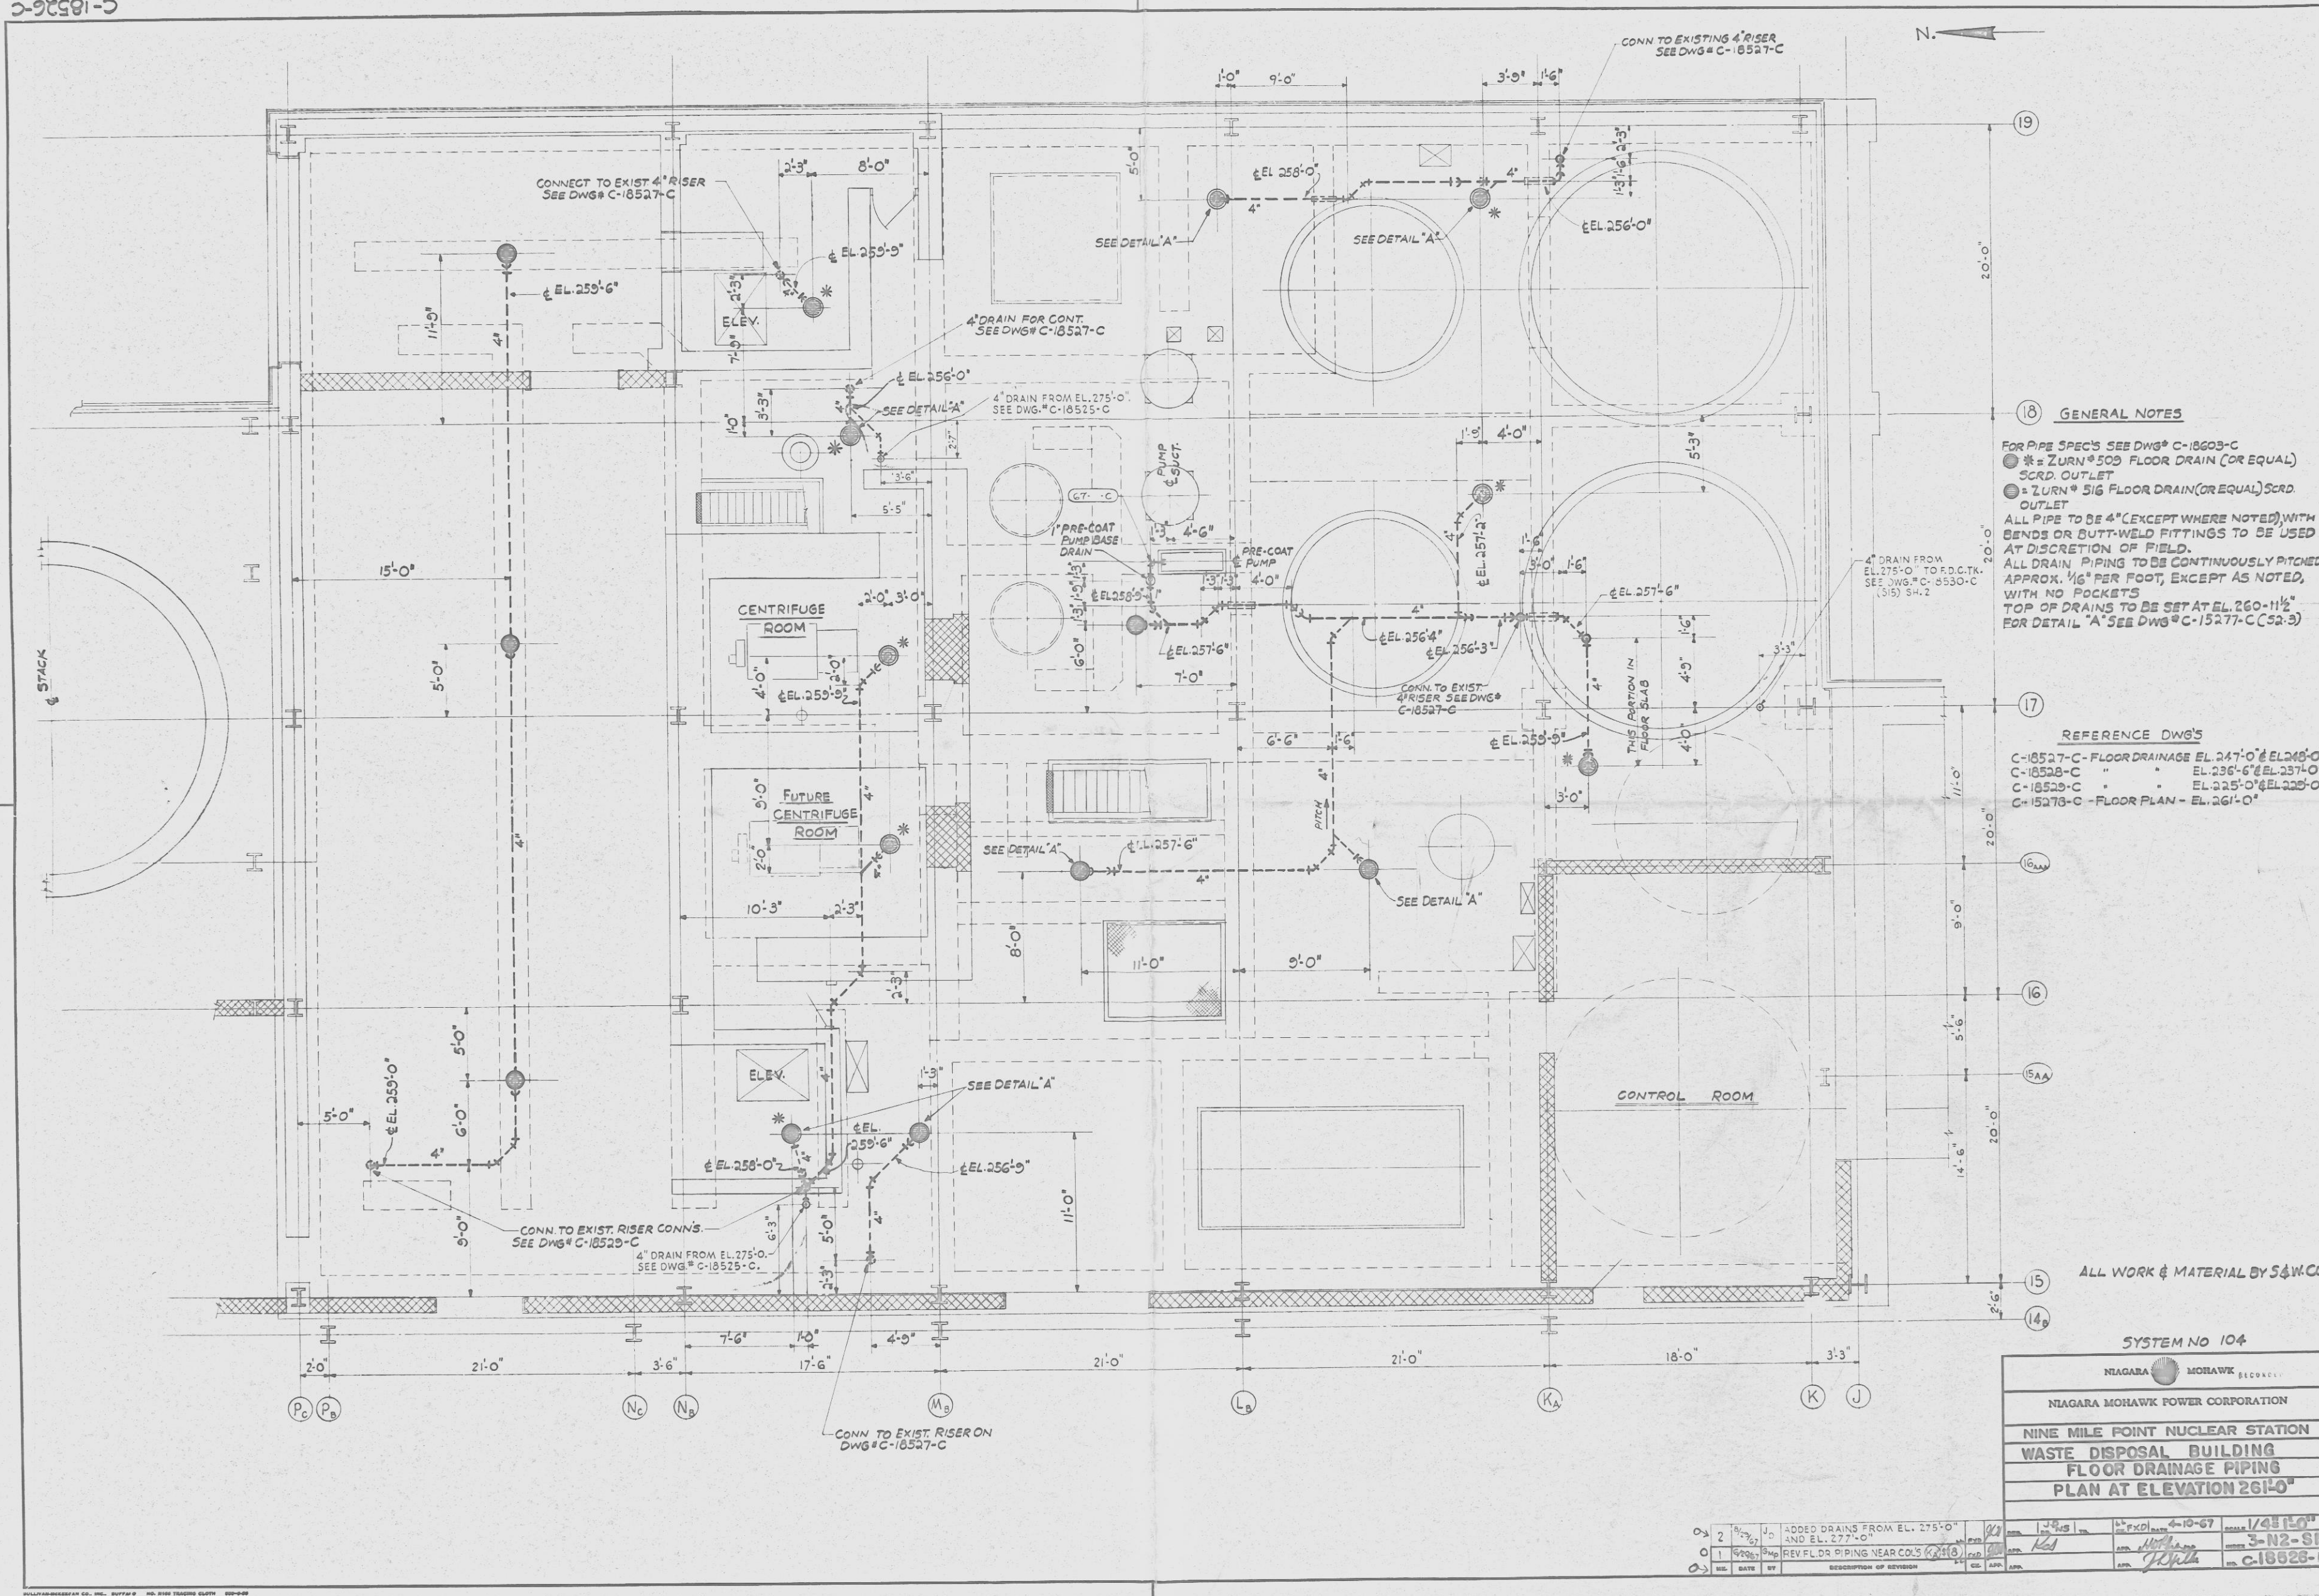

18 GENERAL NOTES

FOR PIPE SPEC'S SEE DWG# C-18603-C
 * = ZURN #500 FLOOR DRAIN (OR EQUAL)
 SCRD. OUTLET
 * = ZURN # 516 FLOOR DRAIN (OR EQUAL) SCRD. OUTLET
 ALL PIPE TO BE 4" (EXCEPT WHERE NOTED) WITH BENDS OR BUTT-WELD FITTINGS TO BE USED AT DISCRETION OF FIELD.
 ALL DRAIN PIPING TO BE CONTINUOUSLY PITCHED APPROX. 1/16" PER FOOT, EXCEPT AS NOTED, WITH NO POCKETS.
 TOP OF DRAINS TO BE SET AT EL. 260'-11 1/2" FOR DETAIL "A" SEE DWG# C-15277-C (52.3)

17 REFERENCE DWGS

C-18527-C - FLOOR DRAINAGE EL. 247'-0" & EL. 248'-0"
 C-18528-C " " " EL. 236'-6" & EL. 237'-0"
 C-18529-C " " " EL. 225'-0" & EL. 226'-0"
 C-15278-C - FLOOR PLAN - EL. 261'-0"

ALL WORK & MATERIAL BY S&W CO.

SYSTEM NO 104


NIAGARA MOHAWK POWER CORPORATION
 NIAGARA MOHAWK POWER CORPORATION
 NINE MILE POINT NUCLEAR STATION
 WASTE DISPOSAL BUILDING
 FLOOR DRAINAGE PIPING
 PLAN AT ELEVATION 261'-0"

NO.	DATE	BY	DESCRIPTION OF REVISION	CHKD.	APP'D.
2	11-17-78	U.D.	ADDED DRAINS FROM EL. 275'-0" AND EL. 277'-0"		
1	9-20-78	U.D.	REV FLOOR PIPING NEAR COL'S (K) & (L)		

RETURN TO
 FILES





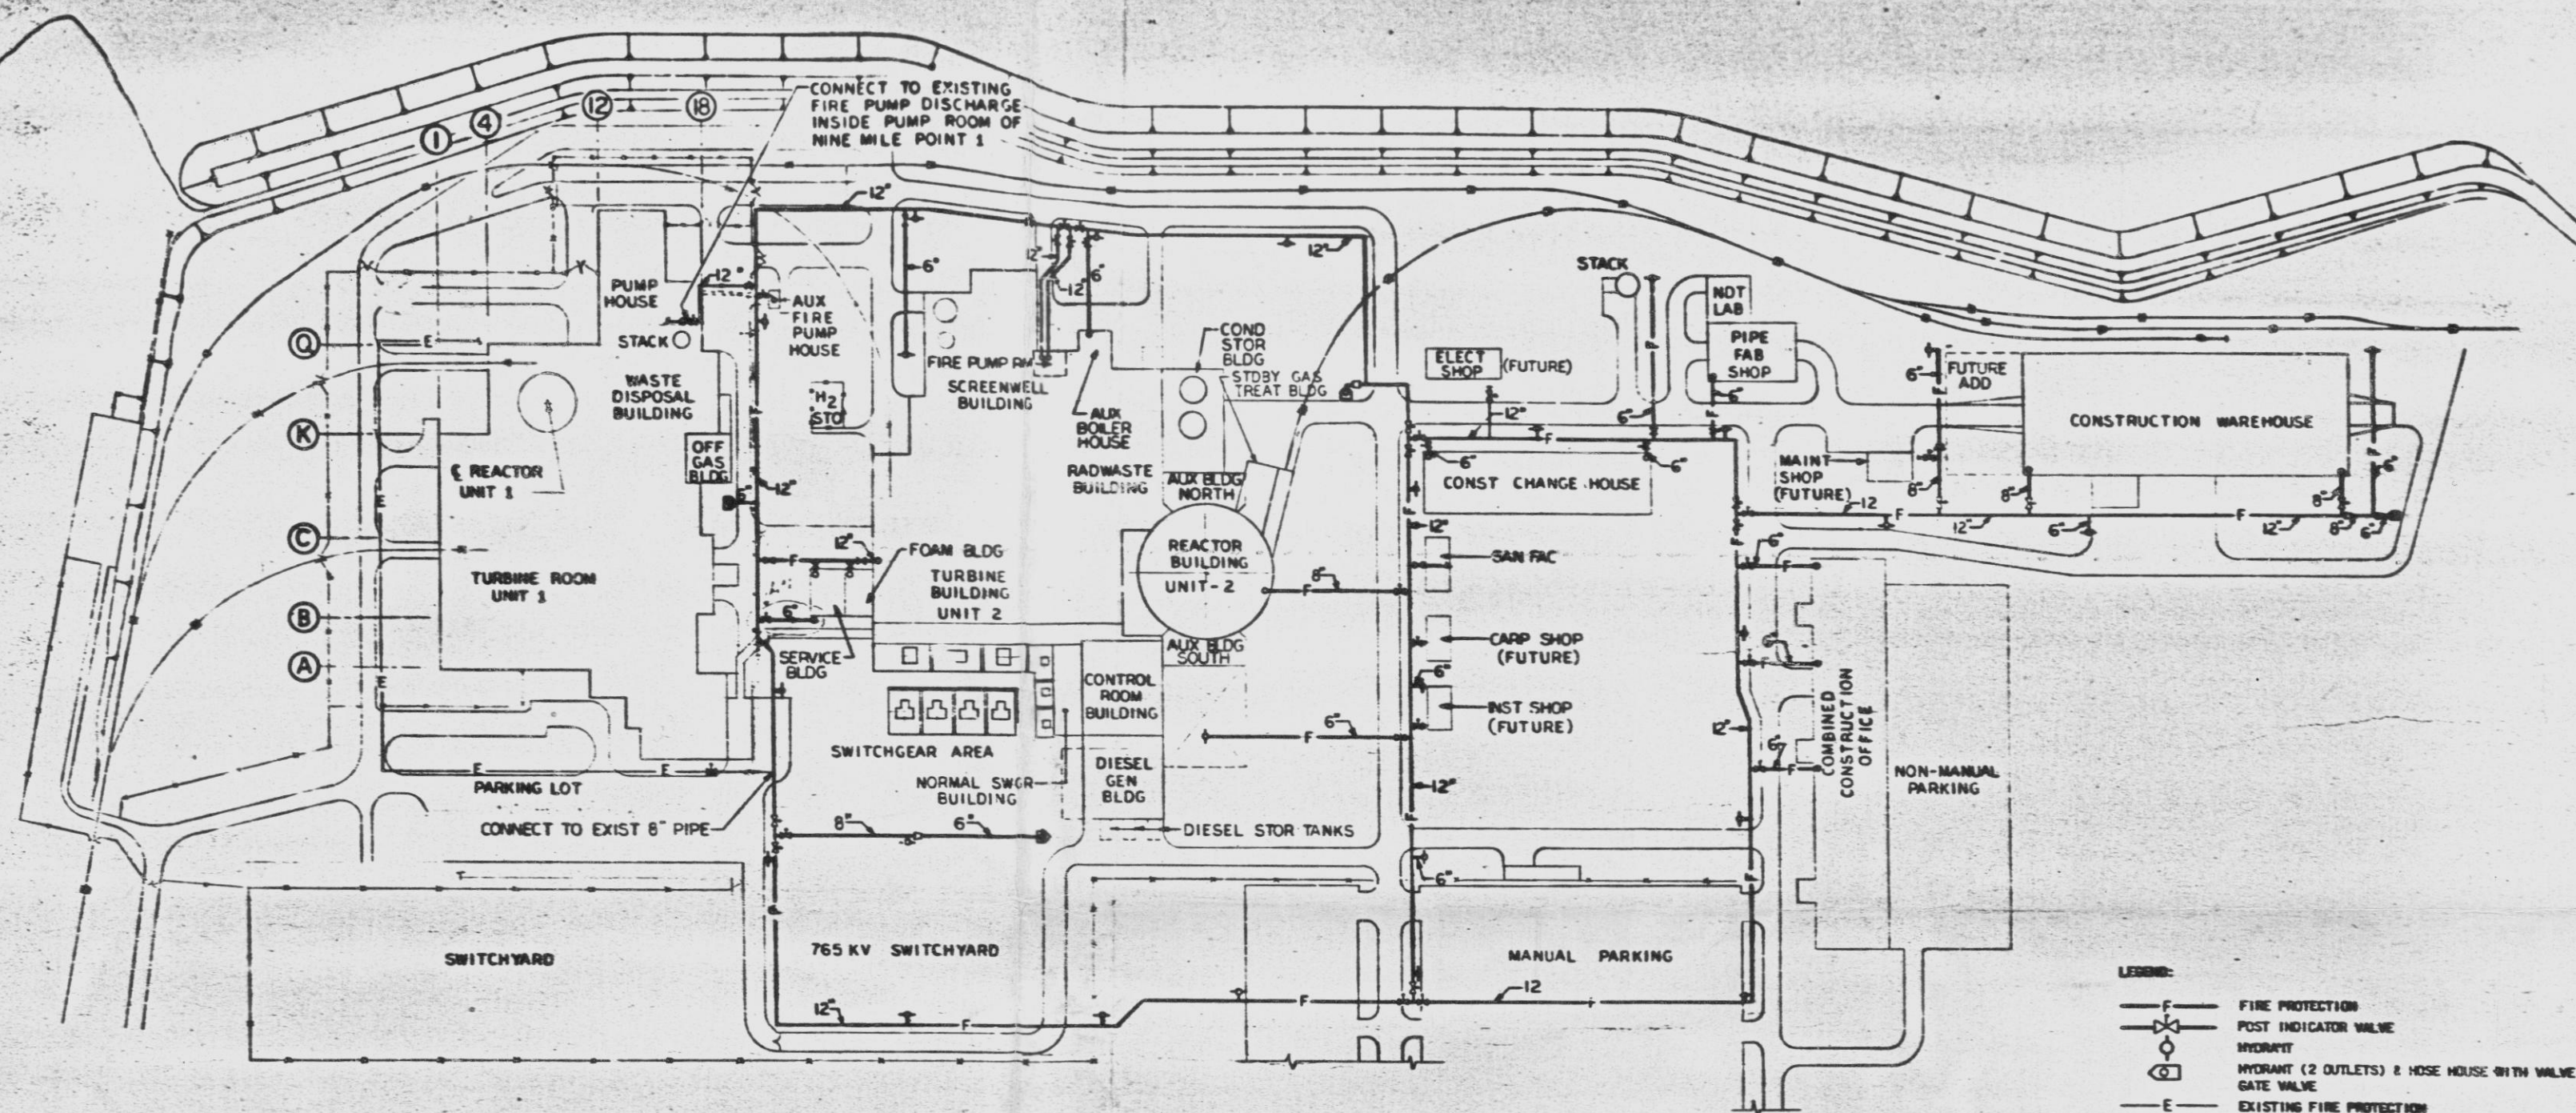

11-11-78
 #7811290192
 50-220
 D

LAKE ONTARIO



PLAN

LEGEND:

	FIRE PROTECTION
	POST INDICATOR VALVE
	HYDRANT
	HYDRANT (2 OUTLETS) & HOSE HOUSE WITH VALVE BOX
	GATE VALVE
	EXISTING FIRE PROTECTION

NOTES:

1. NO SCALE.

REFERENCES:

YARD WATER & FIRE PROTECTION PIPING EN-2

RETURN TO REACTOR DOCKET
FILES
Ltr dtd 11-17-78
781129019Z
50-220

VOID-DO NOT USE

YARD - FIRE PROTECTION
ARRANGEMENT

NINE MILE POINT NUCLEAR STATION - UNIT 2
NIAGARA MOHAWK POWER CORPORATION

STONE & WEBSTER ENGINEERING CORPORATION
BOSTON, MASS.

THE INFORMATION ON THIS DRAWING MAY NOT BE
COPIED OR USED FOR OTHER THAN THE CONSTRUCTION
MAINTENANCE OR REPAIR OF THE PLANT FACILITY
DESCRIBED IN THE TITLE BLOCK.

0										1										2										100									
1										2										3										100																			
1										2										3										100																			
1										2										