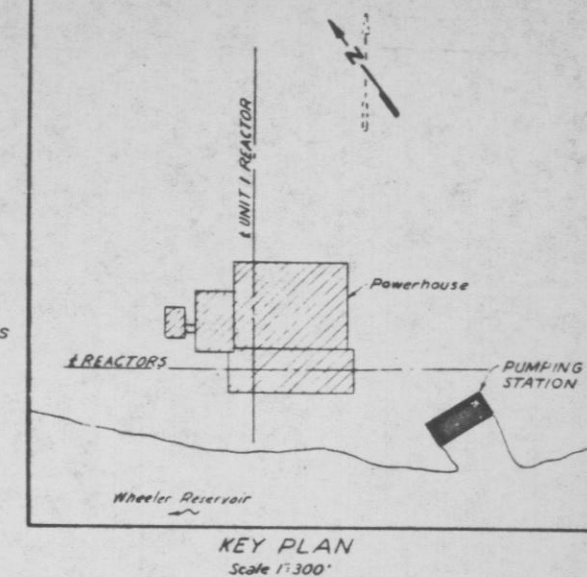
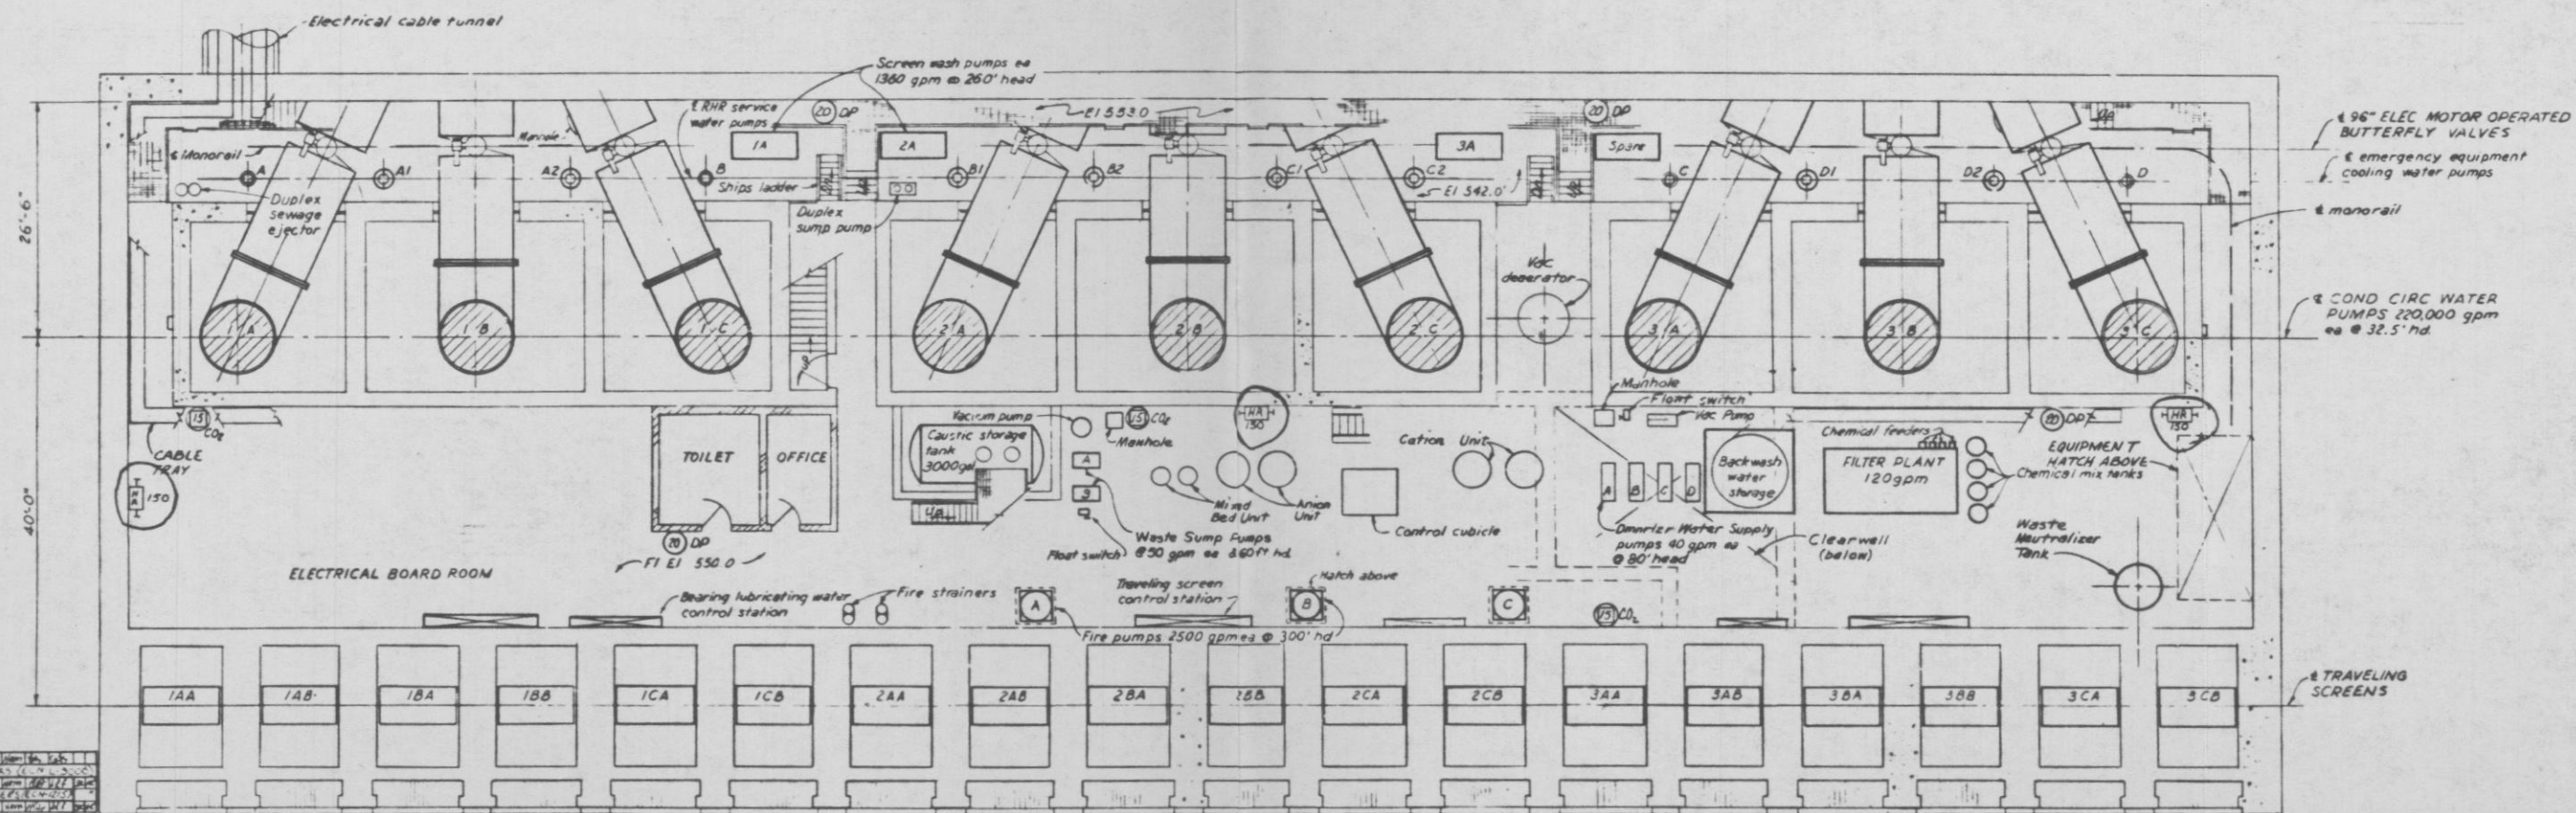


PLAN EL 565.0

KEY PLAN  
Scale 1"=300'

PLAN EL 550.0

NOTES:  
1. These drawings are not to be used for construction.  
2. For fire protection symbols see dwg 47W200-2

Scale 1"=1'-0"

WATER SUPPLY UNITS 1-3  
PUMPING STATION & WATER TREATMENTMECHANICAL  
EQUIPMENTBROWNS FERRY NUCLEAR PLANT  
TENNESSEE VALLEY AUTHORITY  
DIVISION OF ENGINEERING DESIGN

REVISION RI FIGURE 5.3-7

KNOXVILLE

COMPANION DRAWING: 37W200-2

REV	DATE	BY	CHKD	DESCRIPTION
1	10/1/68	J. H. H.	J. H. H.	AS BUILT
2	10/1/68	J. H. H.	J. H. H.	ADD FLOOD PROTECTION WALL & RELATED EQUIPMENT (ECN 1129) & FOUR RHR SW PUMPS WITH PIPING (ECN 1129) & MINOR REVISIONS
3	10/1/68	J. H. H.	J. H. H.	ADD NEUTRALIZER TANK & UPDATED EQUIP. LOCATION (ECN 1129)

NOTE A:  
Added Flood protection wall & related equipment (ECN 1129) & four RHR SW pumps with piping (ECN 1129) & minor revisions.

NOTE B:  
Added Neutralizer Tank & Updated Equip. Location (ECN 1129)