



FOR PREVIOUS REVISIONS, SEE SUPERSEDED CARDS		SUBMITTANT NUMBER		1		2		3		4		5		6		DRAWN DATE		07/07/94	
NO. OF REVISIONS BY THIS REVISION		DATE		1		2		3		4		5		6		CHECKED DATE		10-14-94	
DATE OF REVISION		DATE		1		2		3		4		5		6		APPROVED DATE		10-21-94	
DATE OF REVISION		DATE		1		2		3		4		5		6		FILMED		3007 SH 6	
DATE OF REVISION		DATE		1		2		3		4		5		6		FILMED		3007 SH 6	
DATE OF REVISION		DATE		1		2		3		4		5		6		FILMED			



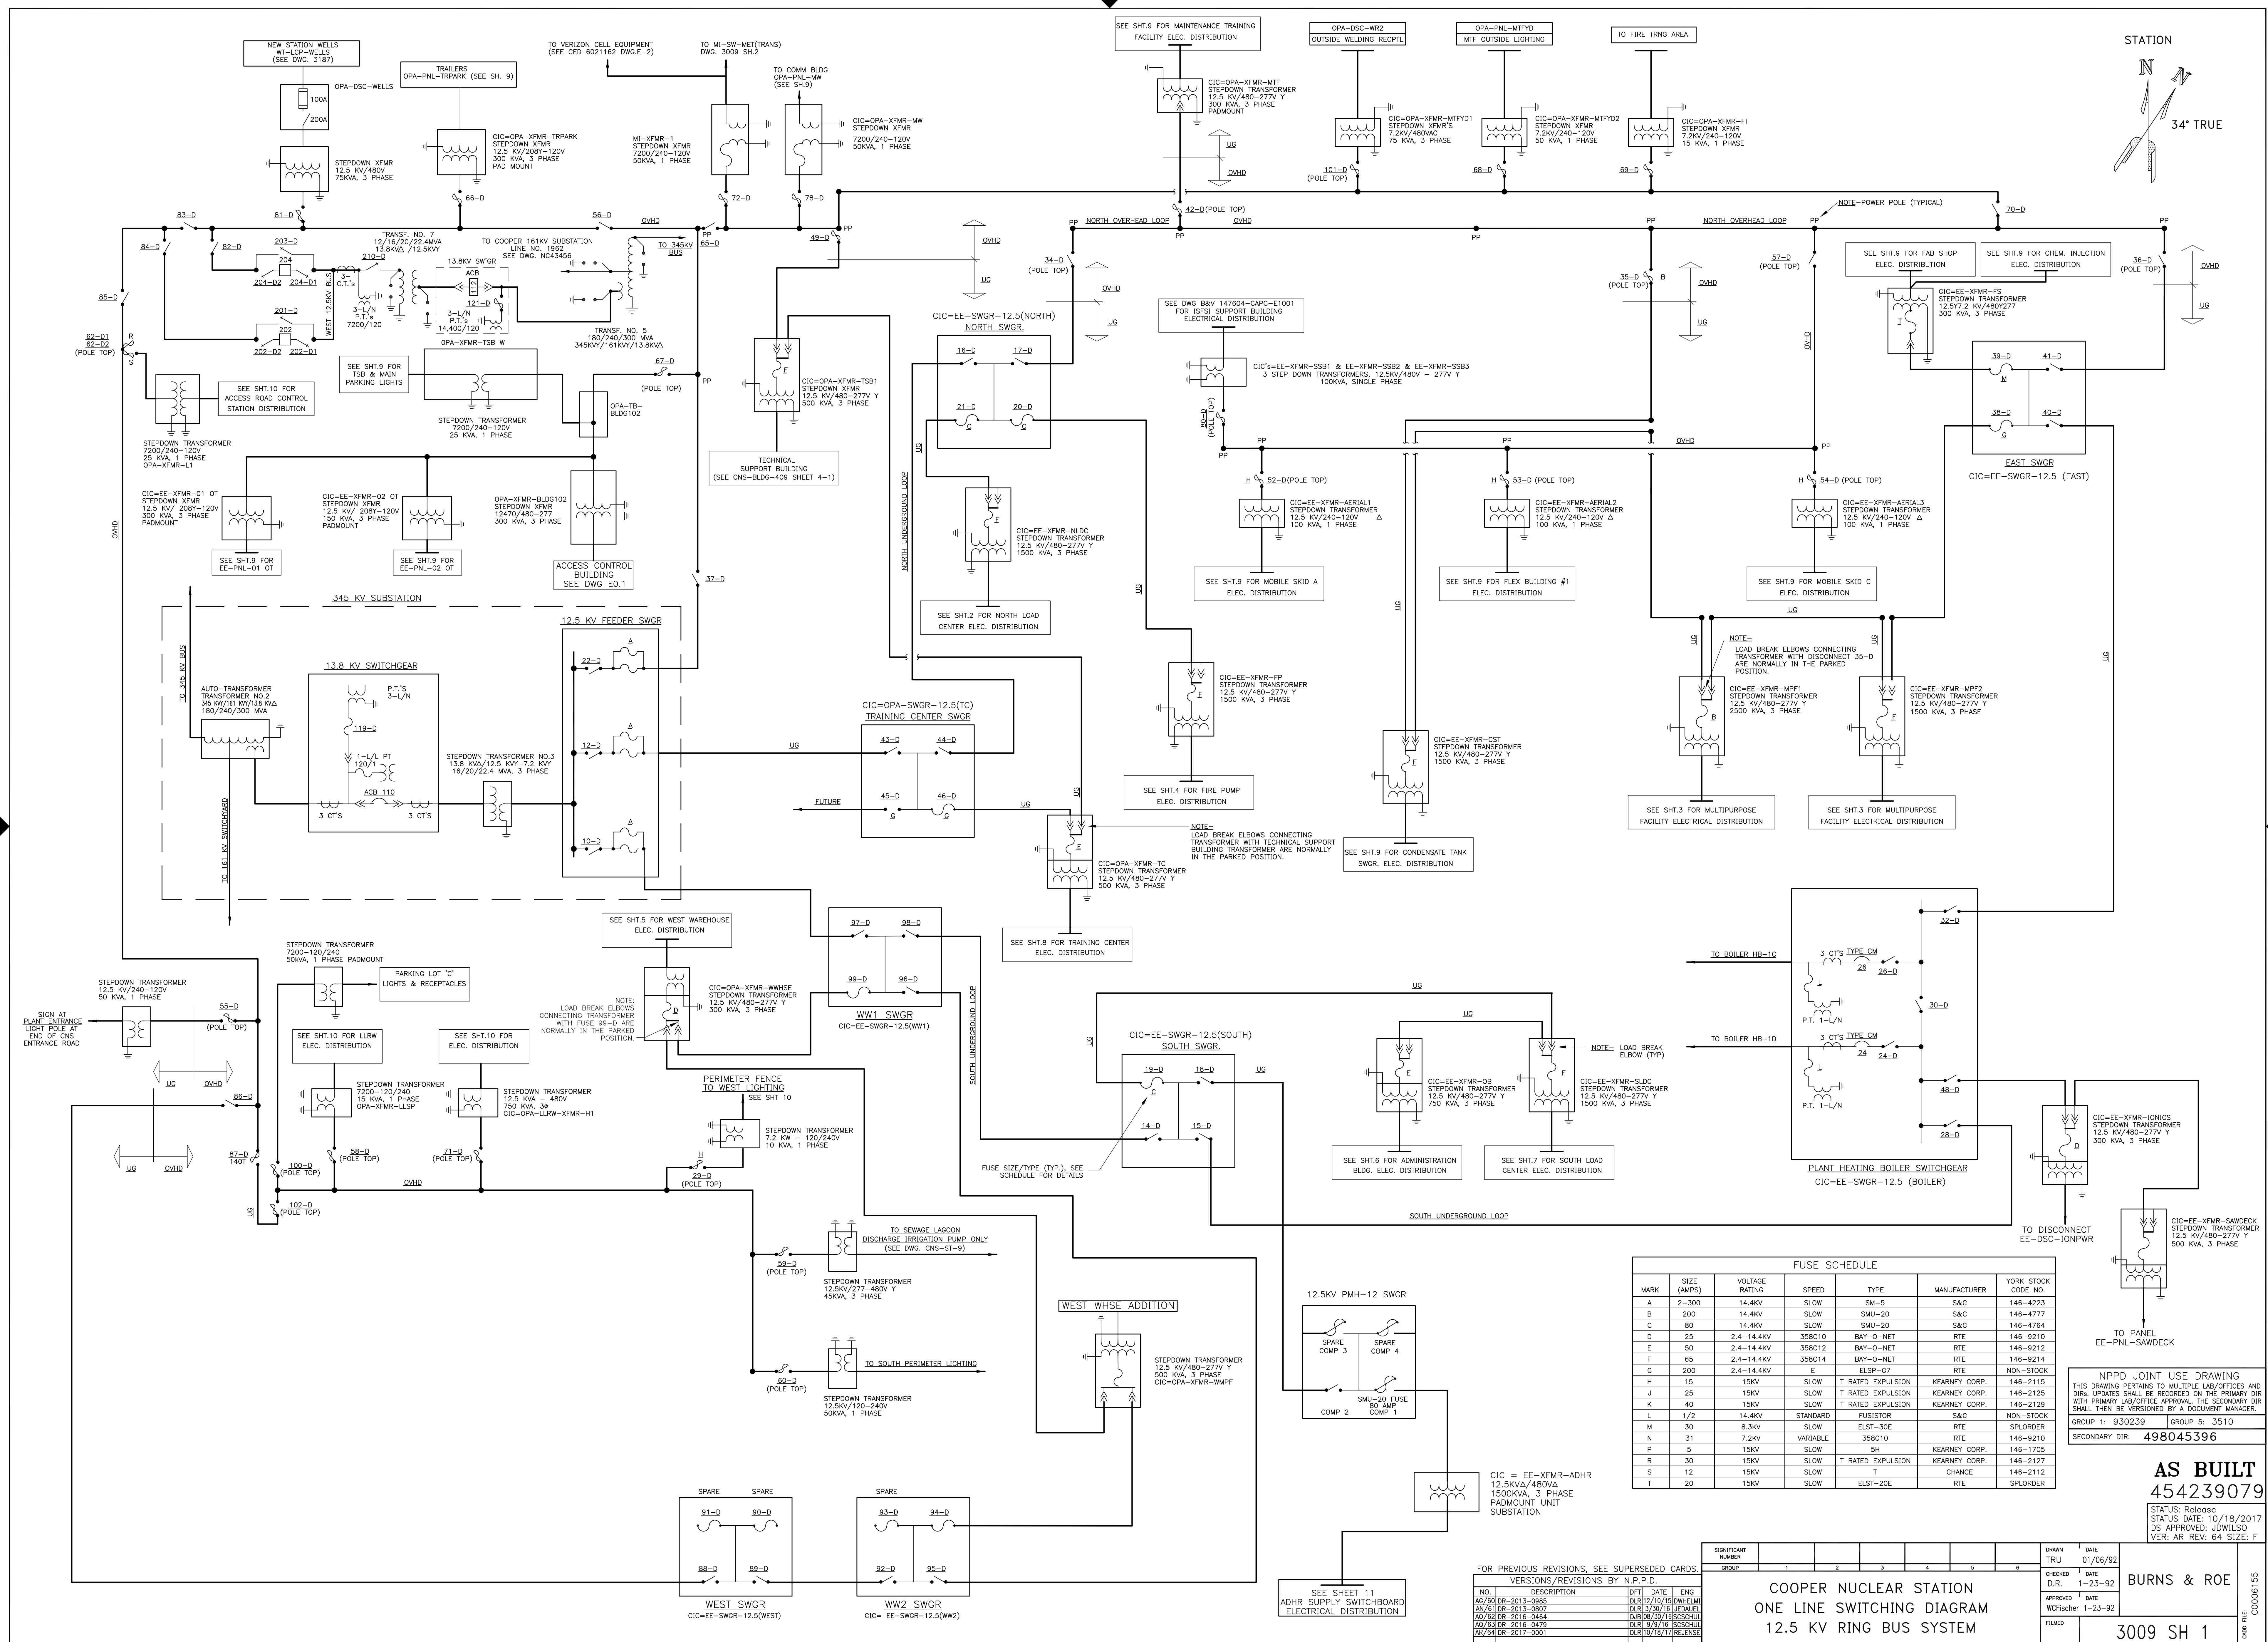

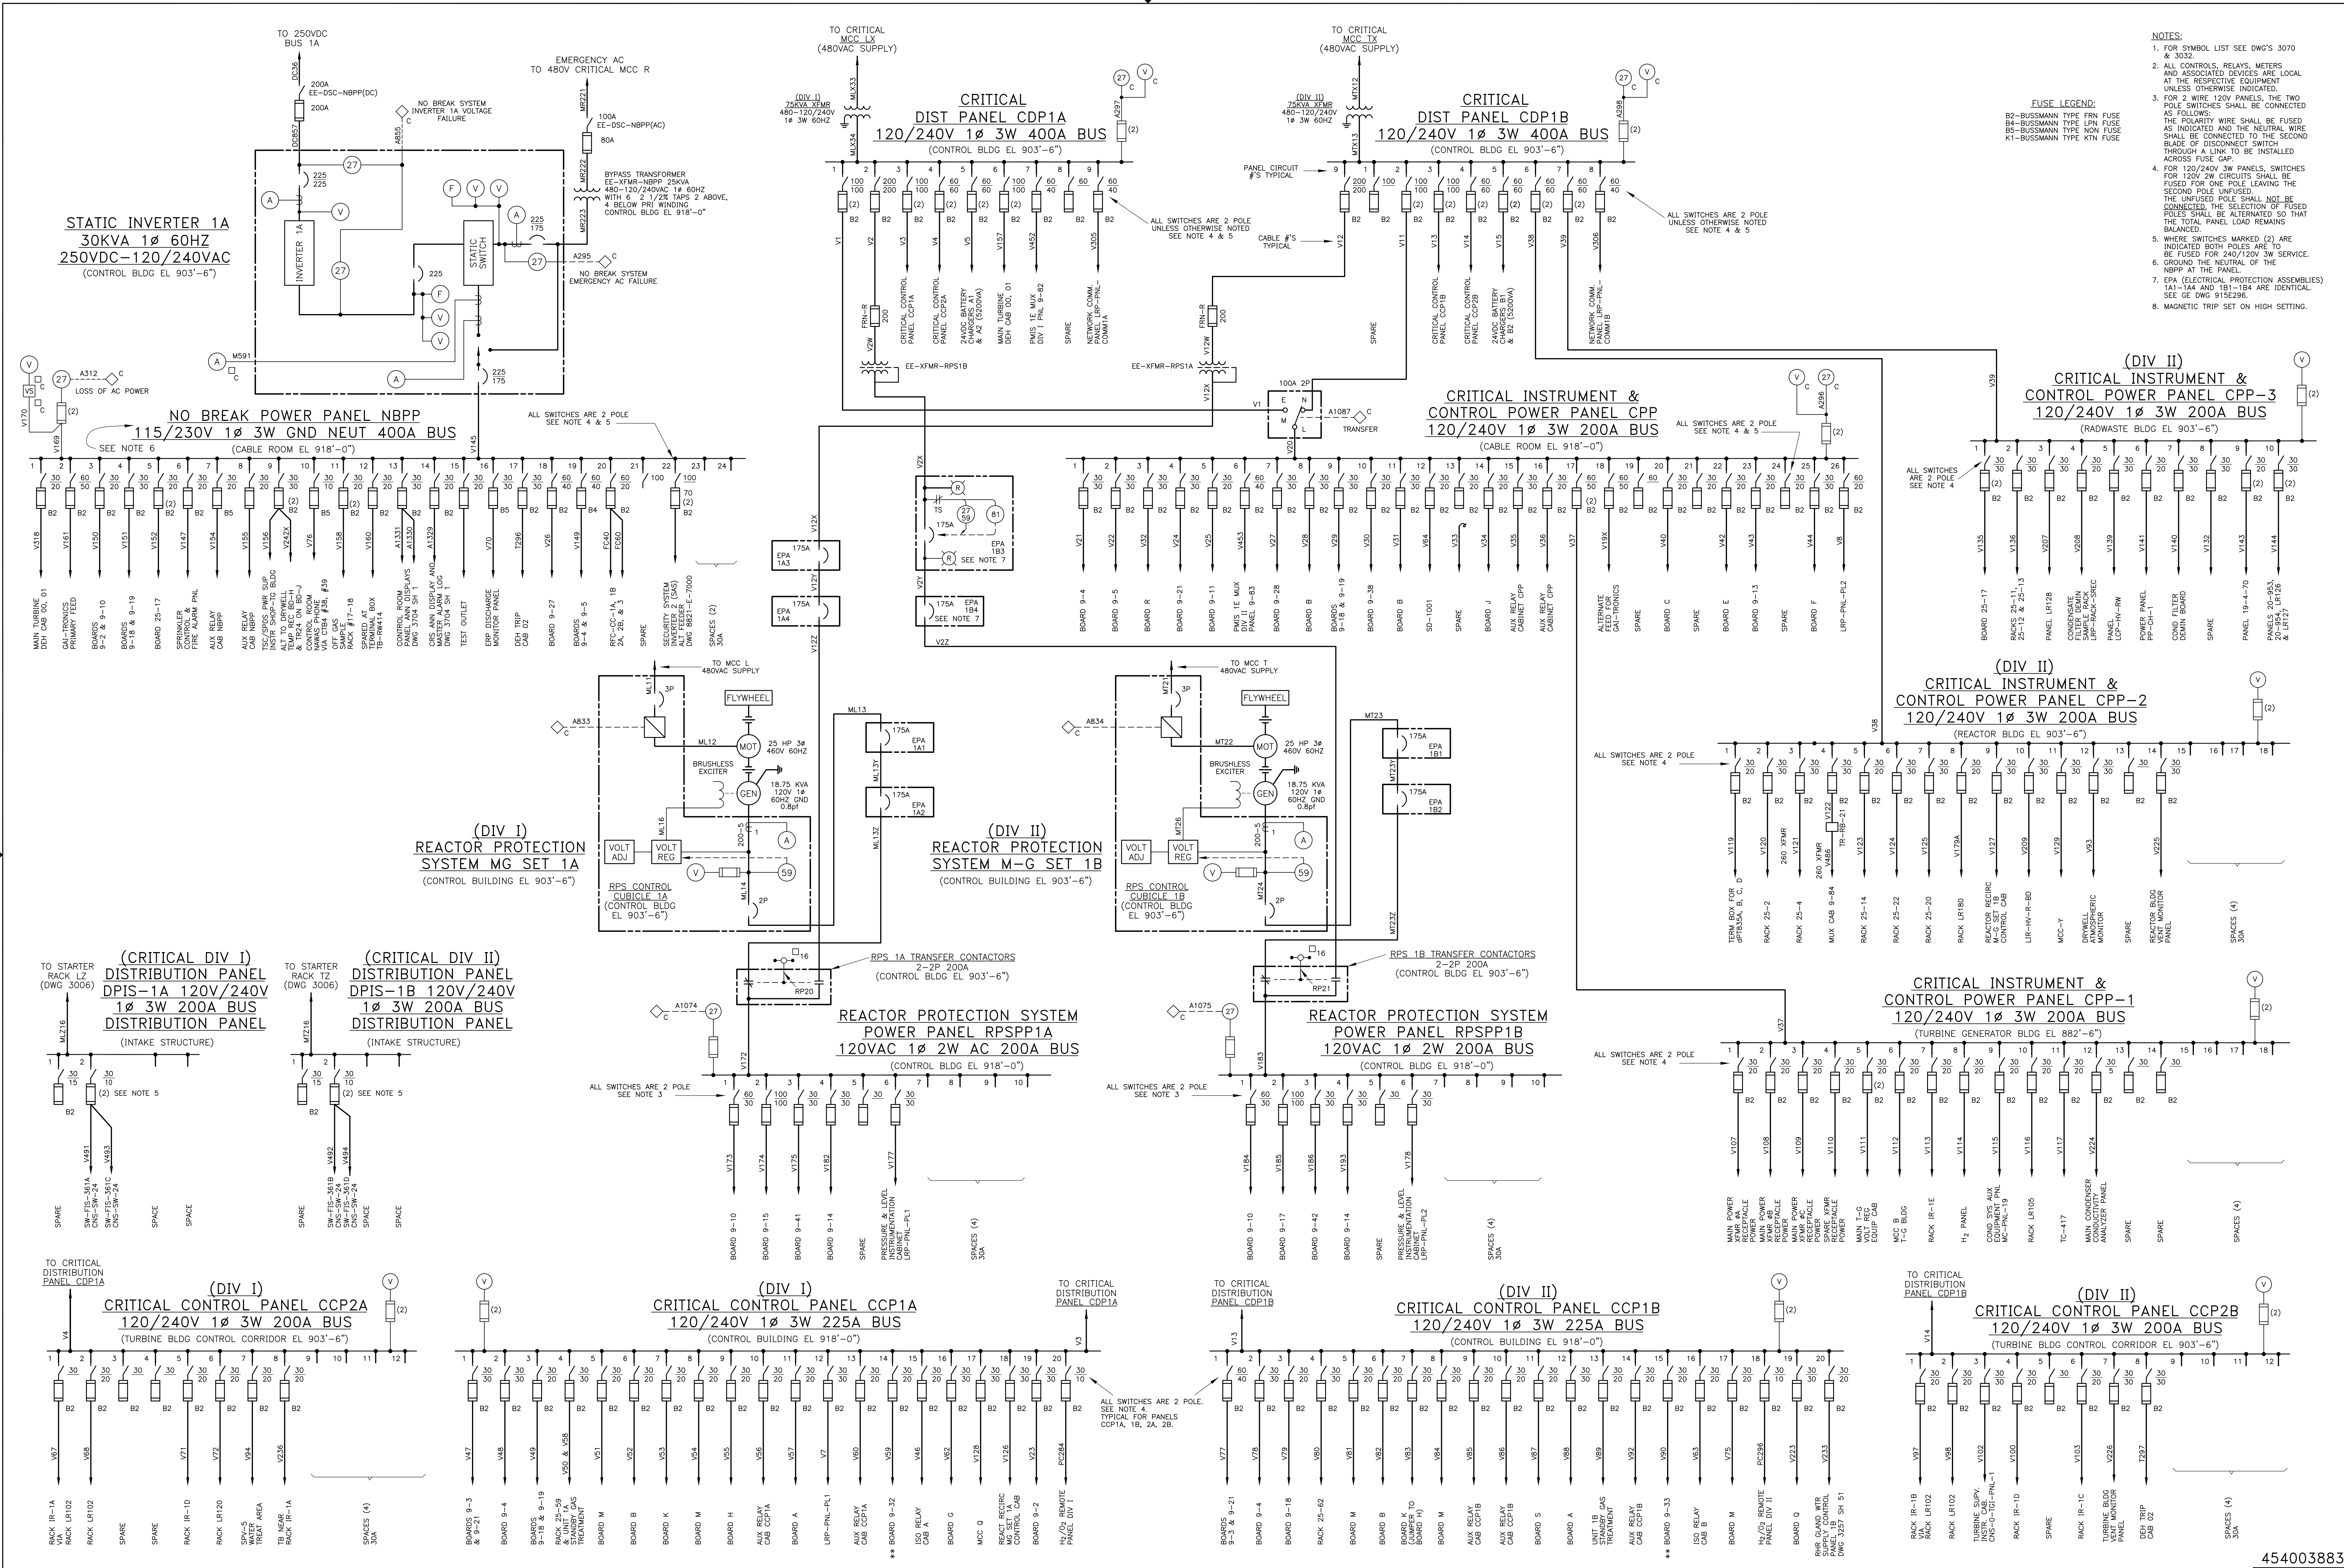

- NOTES:
1. FOR SYMBOL LIST SEE DWG'S 3070 & 3032.
  2. ALL CONTROLS, RELAYS, METERS AND ASSOCIATED DEVICES ARE LOCAL AT THE RESPECTIVE EQUIPMENT UNLESS OTHERWISE INDICATED.
  3. FOR 2 WIRE 120V PANELS, THE TWO POLE SWITCHES SHALL BE CONNECTED AS FOLLOWS:  
THE POLARITY WIRE SHALL BE FUSED AS INDICATED AND THE NEUTRAL WIRE SHALL BE CONNECTED TO THE SECOND BLACK OF DISCONNECT SWITCH THROUGH A LINK TO BE INSTALLED ACROSS FUSE GIVE.
  4. FOR 120/240V 3W PANELS, SWITCHES FOR 120V 2W CIRCUITS SHALL BE FUSED FOR ONE POLE LEAVING THE SECOND POLE UNFUSED.  
THE UNFUSED POLE SHALL NOT BE CONNECTED. THE SELECTION OF FUSED POLES SHALL BE ALTERNATED SO THAT THE TOTAL PANEL LOAD REMAINS BALANCED.
  5. WHERE SWITCHES MARKED (2) ARE INDICATED BOTH POLES ARE TO BE FUSED FOR 240/120V 3W SERVICE.
  6. GROUND THE NEUTRAL OF THE NBPP AT THE PANEL.
  7. EPA (ELECTRICAL PROTECTION ASSEMBLIES) 1A1-1A4 AND 1B1-1B4 ARE IDENTICAL. SEE DWG 915E296.
  8. MAGNETIC TRIP SET ON HIGH SETTING.
- FUSE LEGEND:
- B2-BUSSMANN TYPE FRN FUSE
  - B4-BUSSMANN TYPE LPN FUSE
  - B5-BUSSMANN TYPE NON FUSE
  - K1-BUSSMANN TYPE KTN FUSE

\*\* NOTE: RHR STEAM CONDENSING IS NO LONGER AN OPERATIONAL MODE.

FOR PREVIOUS REVISIONS, SEE SUPERSEDED CARDS.

VERSIONS/REVISIONS BY N.P.P.D.			
NO.	DESCRIPTION	DATE	ENG
AL/84	DR-2016-0058 (REMOVE TCC 5100779)	06/10/15	BSCHUL
AK/85	DR-2016-0498	06/10/17	BSCHUL



COOPER NUCLEAR STATION  
VITAL ONE LINE DIAGRAM

INFORMATION ONLY

							DRAWN		DATE		VER: AK, REV: QS, SLE: P	
SIGNIFICANT NUMBER							J.I.		10-29-68		BURNS & ROE	
GROUP							CHECKED		DATE			
							J.C.		10-29-68			
							APPROVED		DATE			
COOPER NUCLEAR STATION VITAL ONE LINE DIAGRAM							SEE DISCREPANCY		BURNS		3010 SH 1	
							FILMED					
											CARD NO. C0015093	

454003883

STATUS: Release FTO  
STATUS DATE: 11/17/2016  
DS APPROVED: REUSE  
VER: AK REV: 85 SIZE: F

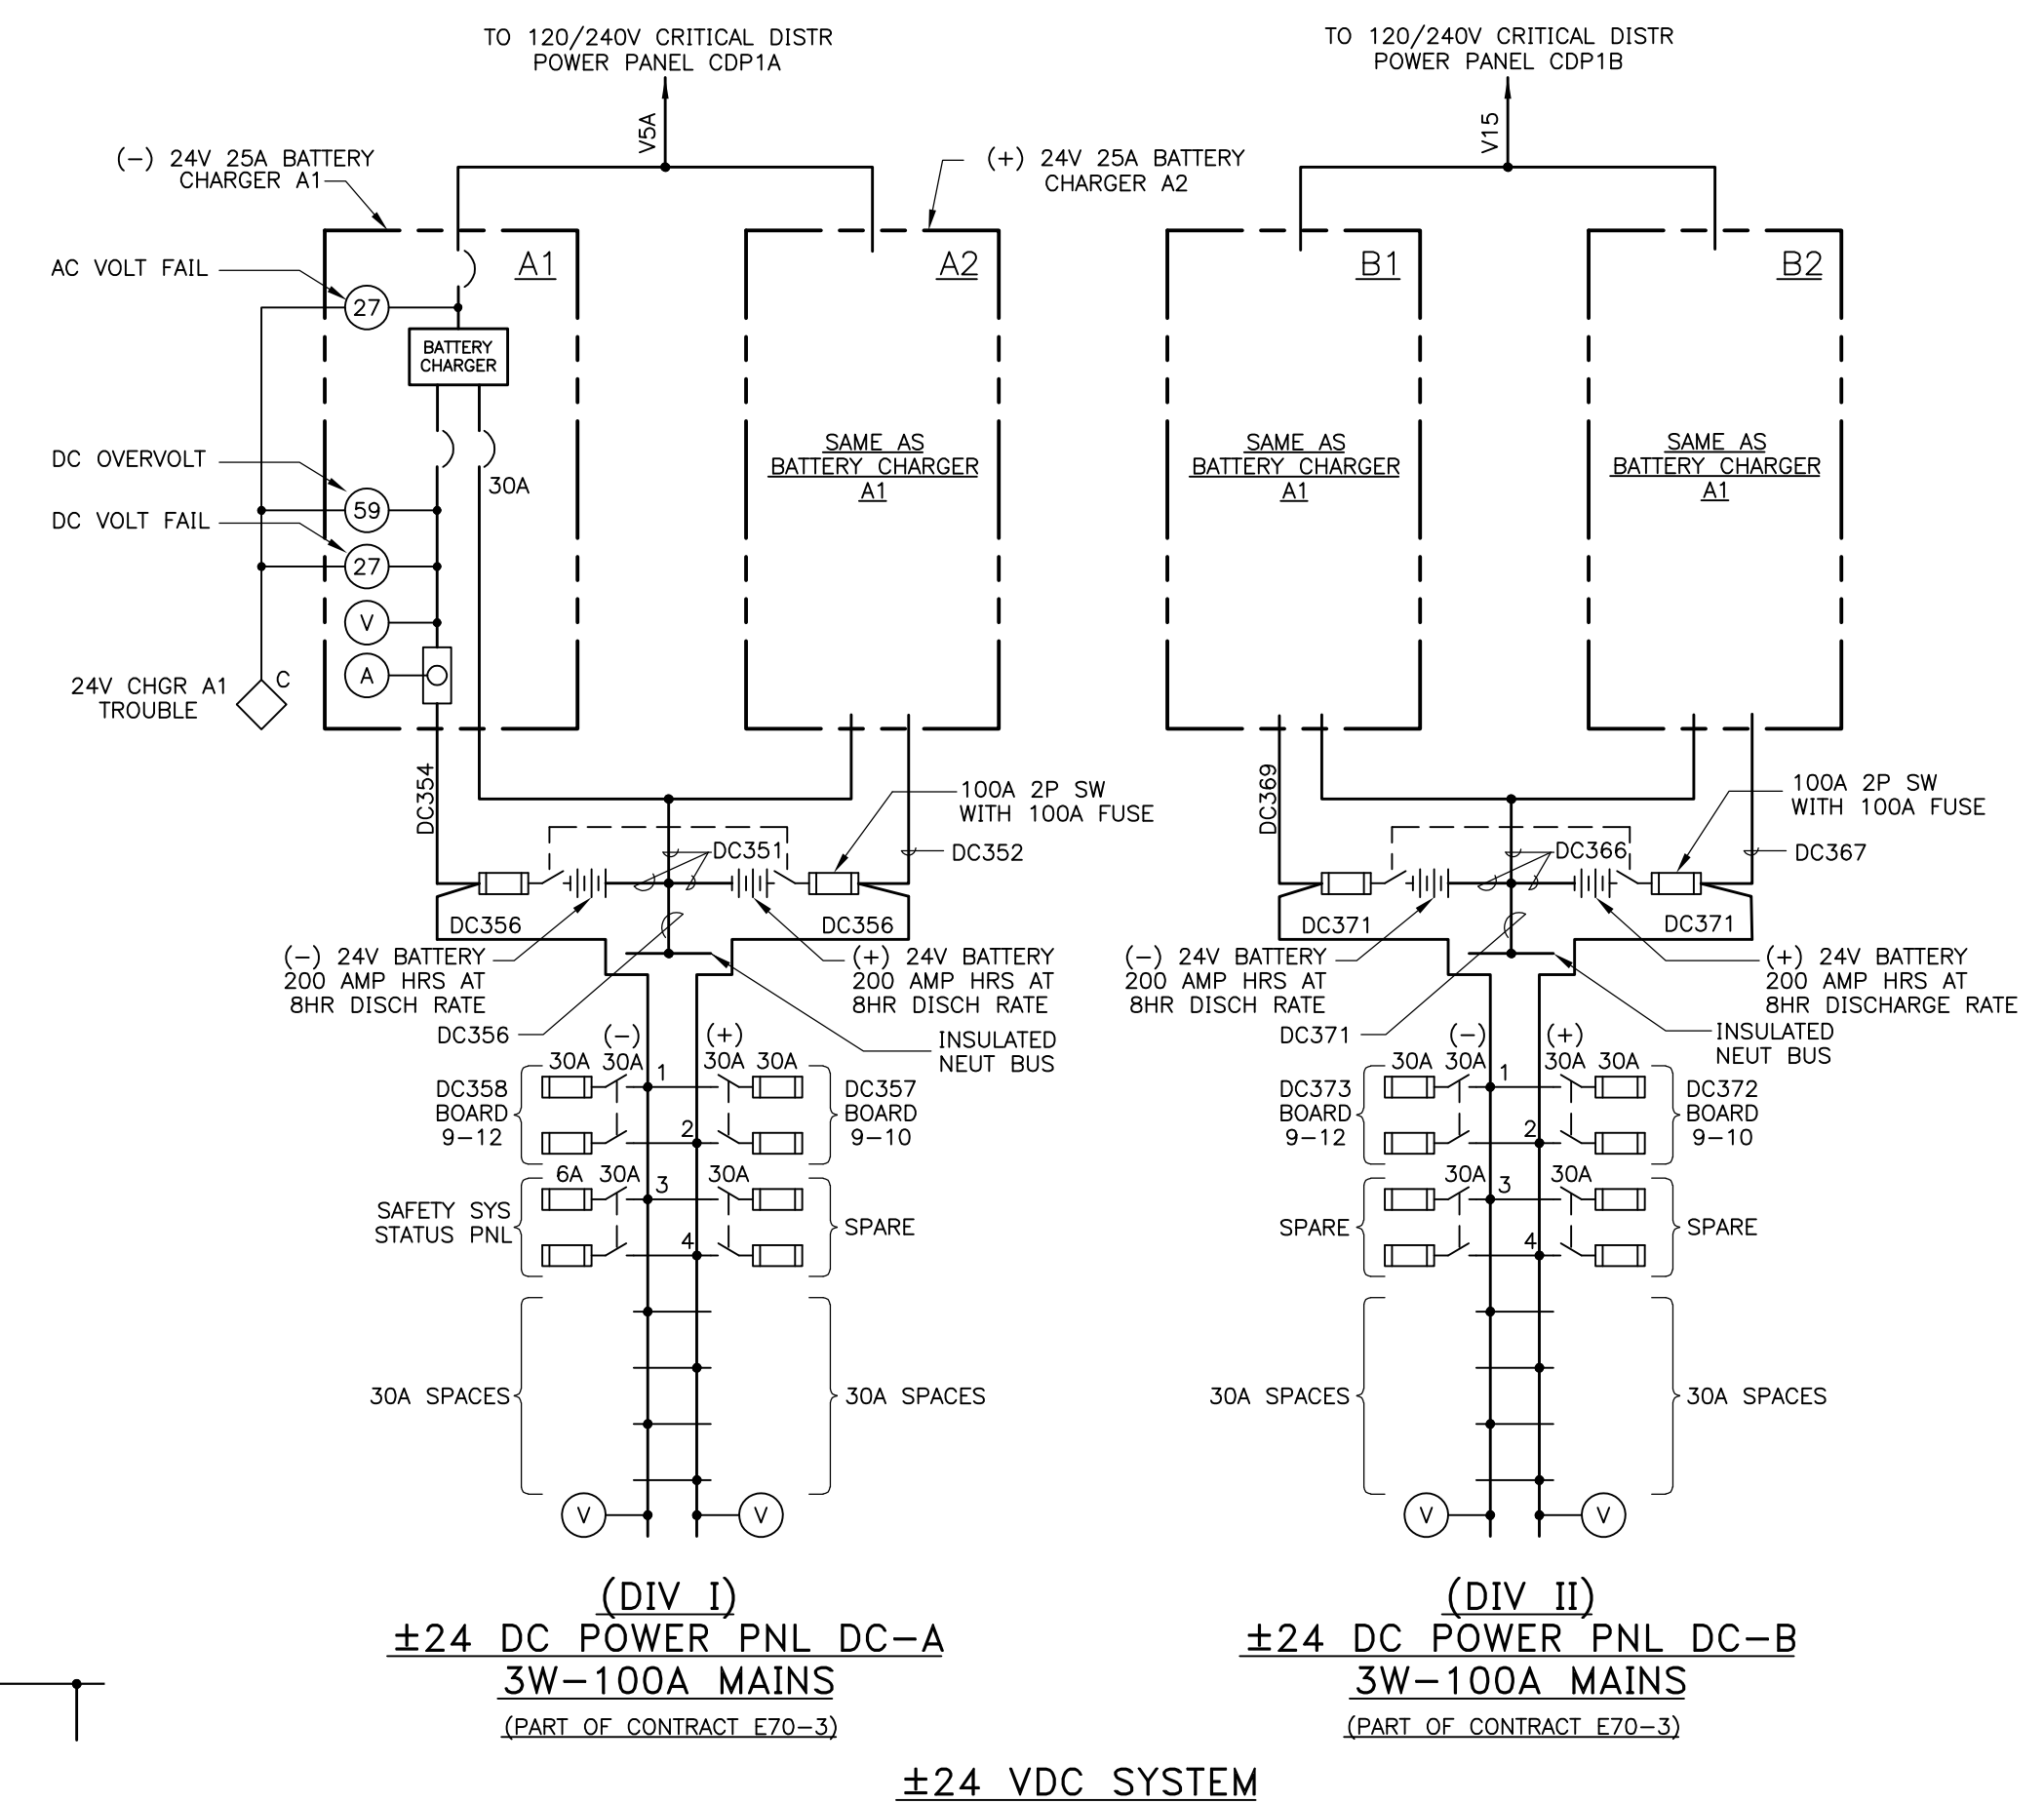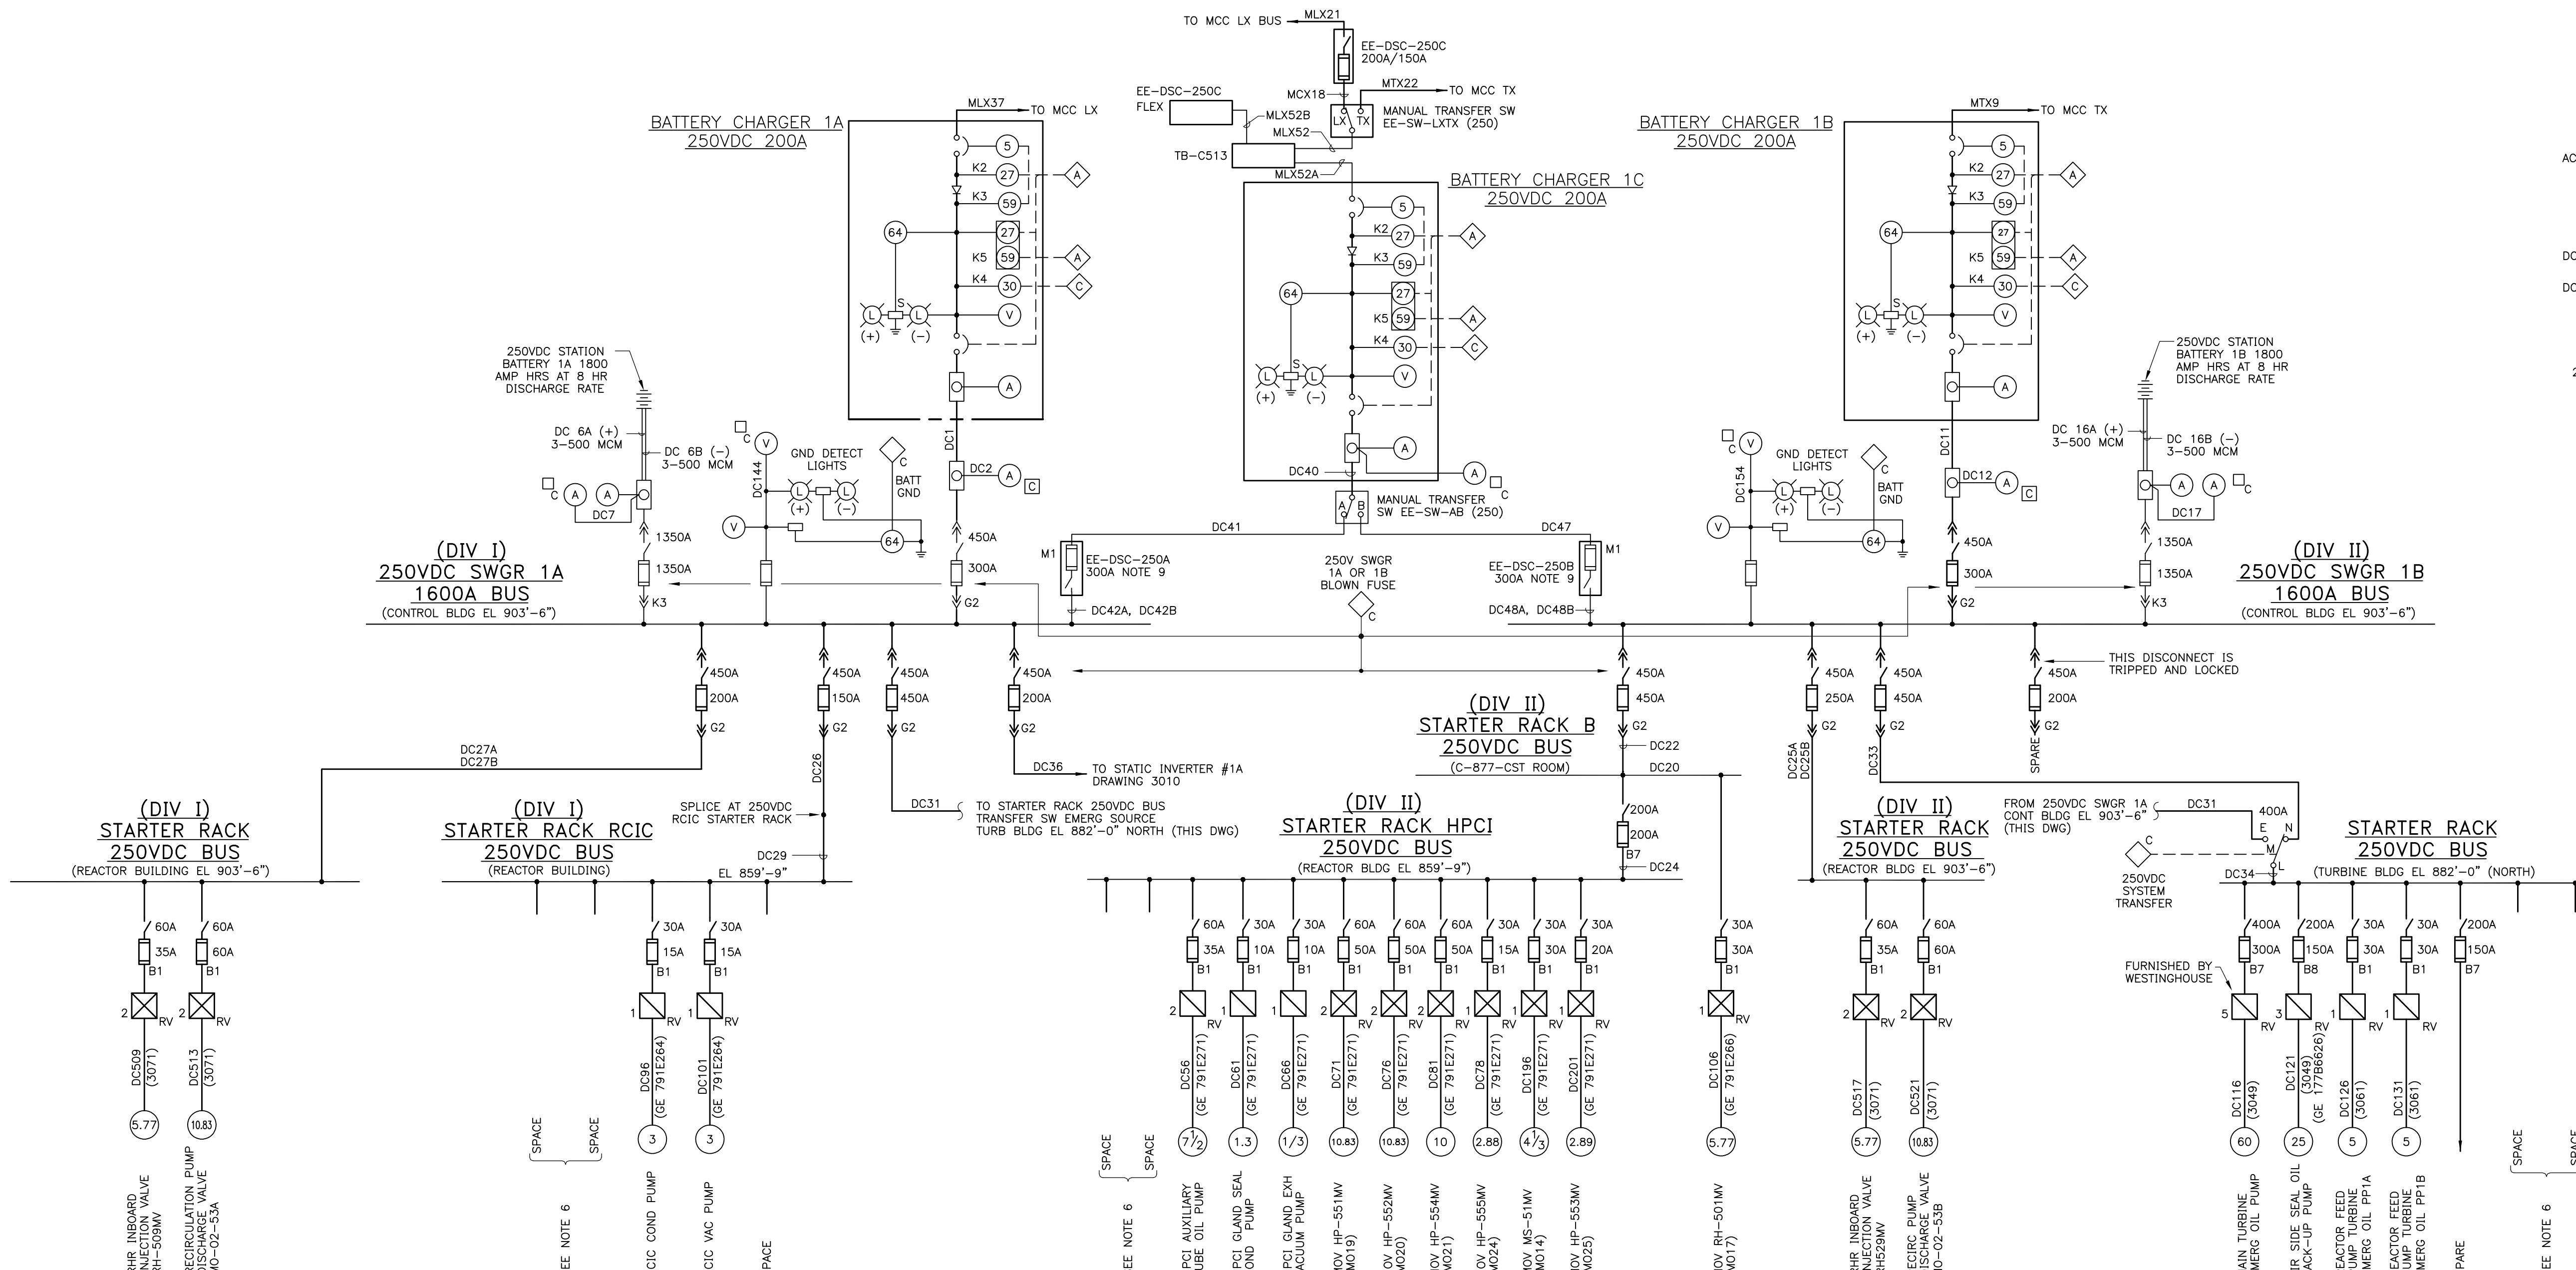


NOTES:

- FOR SYMBOL LIST SEE DWG 3070 AND 3032.
- FOR MOTOR CONTROLS AND THEIR OPERATIONAL FUNCTION SEE RELATED ELEMENTARY DIAGRAMS.
- ALL SWITCHES SHALL BE TWO (2) POLE UNLESS OTHERWISE INDICATED.
- HPCI AND RCIC CONTROLS SHALL BE NORMALLY FED FROM SEPARATE BATTERIES.
- ALL METERS, RELAYS AND ASSOCIATED DEVICES ARE LOCATED IN SWITCHGEAR UNLESS OTHERWISE INDICATED.
- STARTER RACKS AS INDICATED, SHALL BE CONSTRUCTED TO PROVIDE SPACE FOR FUTURE ADDITION OF TWO (2) STARTERS.
- ± 24 VDC SYSTEMS ARE GROUNDED AT ONE POINT ONLY AT GE BOARD 9-12 PER GE DWG 791E258 SH 1.
- RAYCHEM SPLICE LOCATED IN TERMINAL BOX TB-C135 CONTROL BLDG MANHOLE P2.
- TRIPPED AND LOCKED DURING NORMAL OPERATION.
- RAYCHEM SPLICE LOCATED IN TERMINAL BOX TB-1220, REACTOR BUILDING SW QUAD 859.

FUSE LEGEND

- B1 - BUSSMANN TYPE FRS FUSE  
B2 - BUSSMANN TYPE FRN FUSE  
B3 - BUSSMANN TYPE LPS FUSE  
B4 - BUSSMANN TYPE LPN FUSE  
B7 - BUSSMANN TYPE LPS-RK FUSE  
B8 - BUSSMANN TYPE LPN-RK FUSE  
G1 - GOLD TYPE TRS FUSE  
G2 - GOLD TYPE AUT FUSE  
J - BUSSMANN TYPE JAC FUSE  
K3 - BUSSMANN TYPE KRP FUSE  
M1 - MERSEN TYPE A60-R FUSE

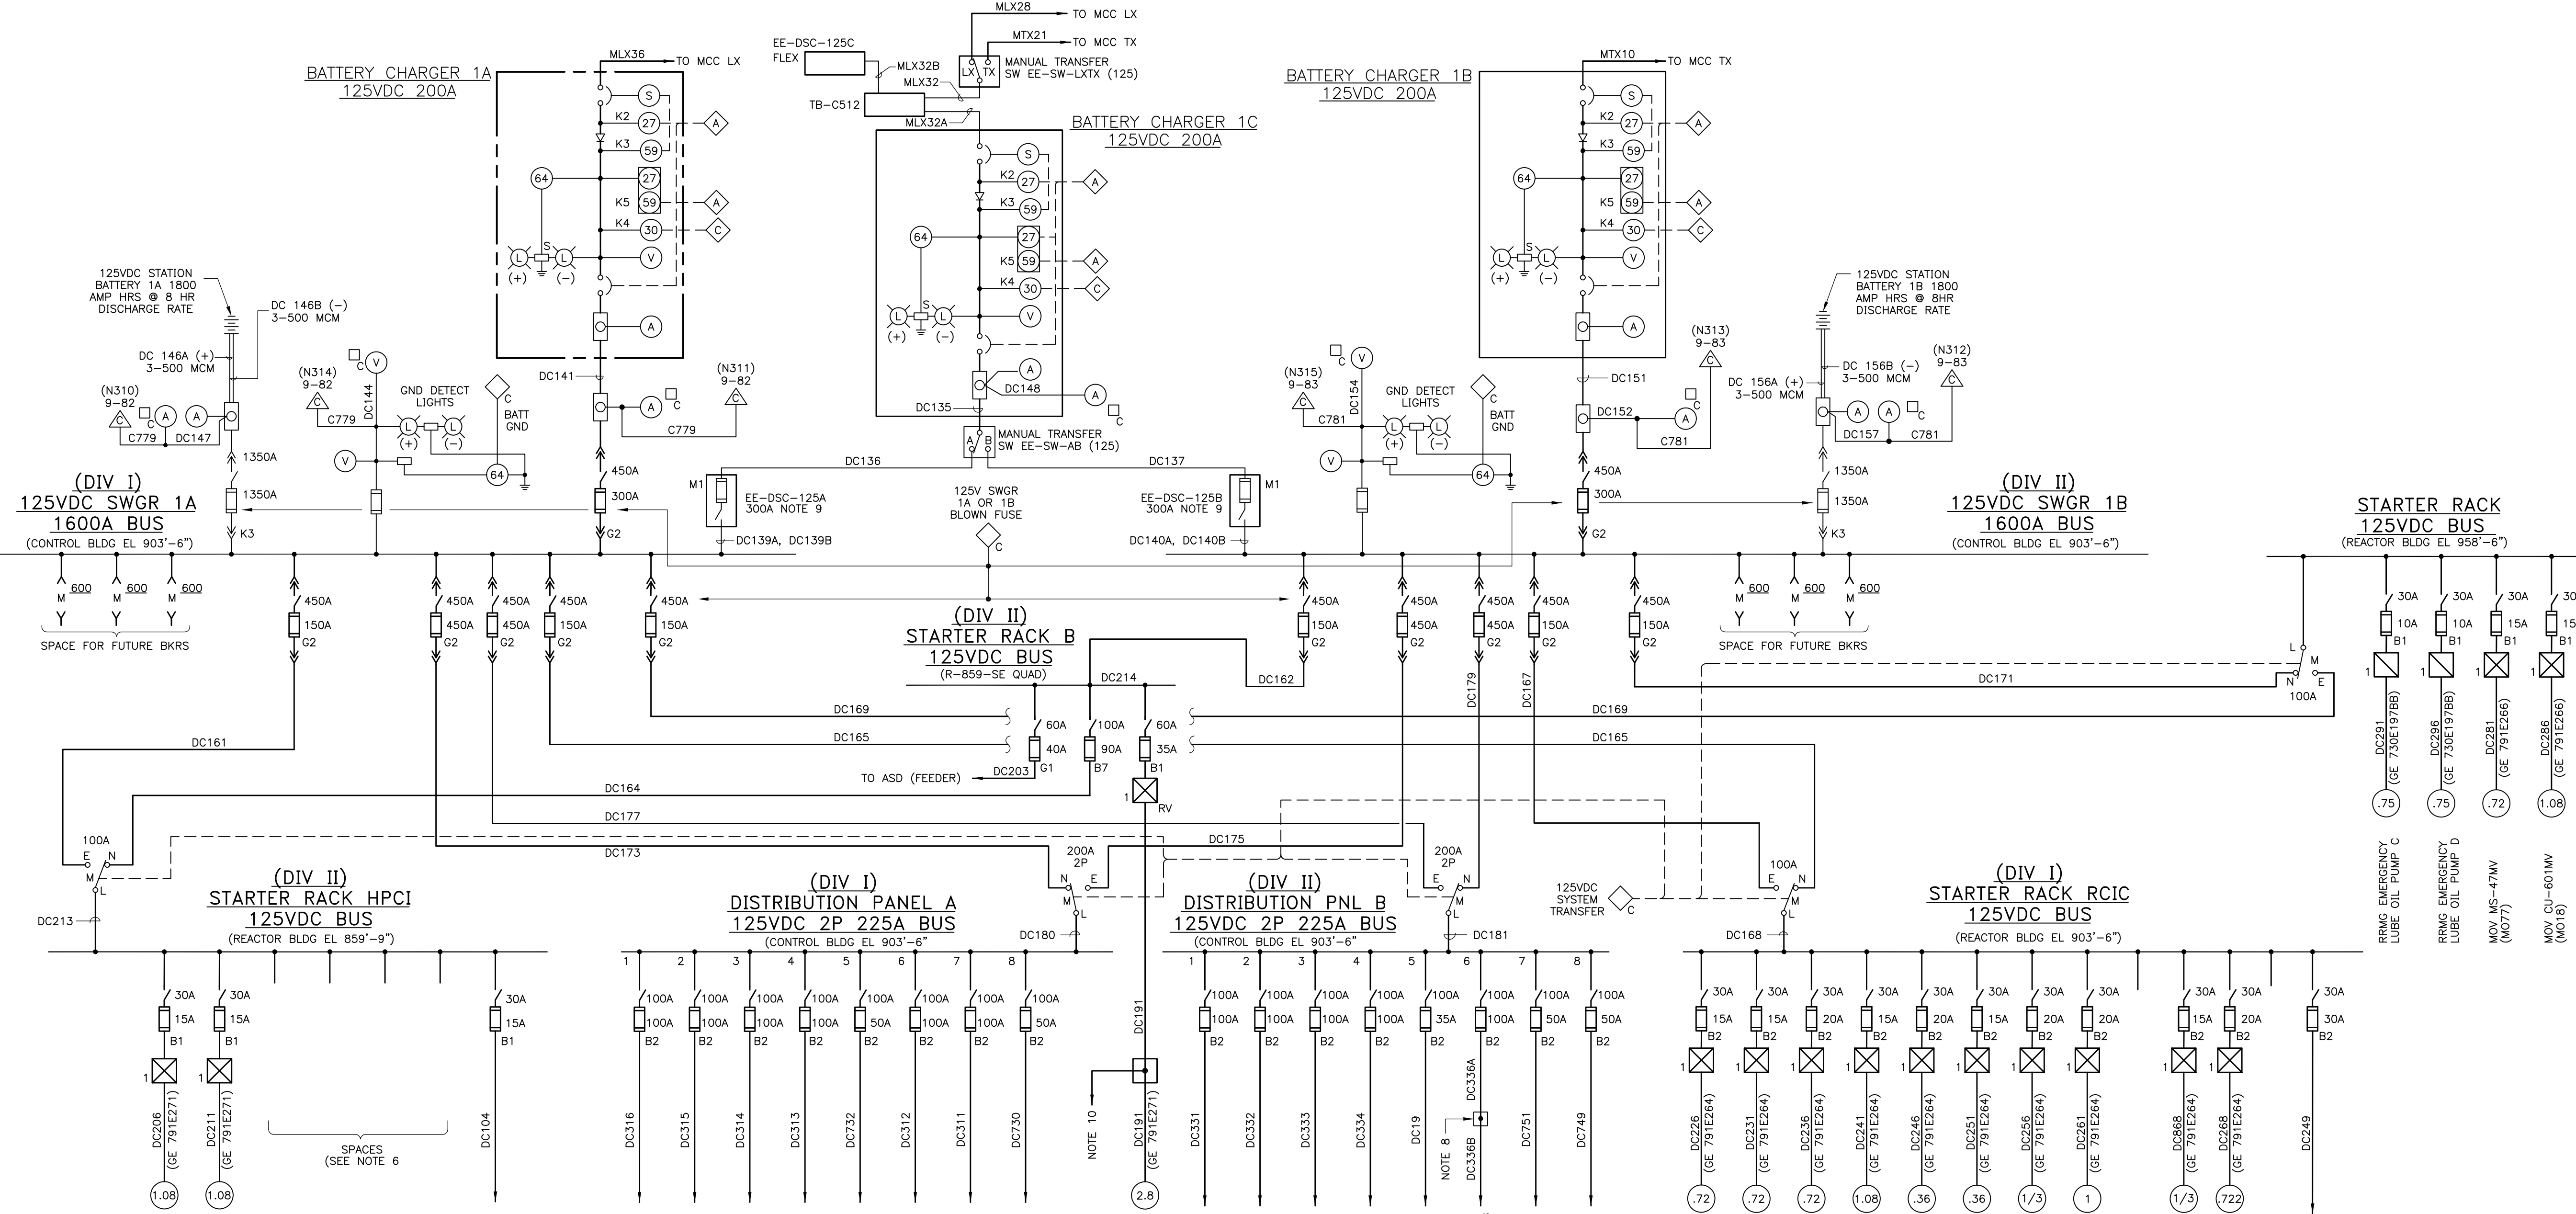

SIGNIFICANT NUMBER		DATE	
1	2	3	4
GROUP		C.A.	
CHECKED		DATE	
APPROVED		DATE	
FILMED		DATE	
BURNS & ROE			
3058			

COOPER NUCLEAR STATION  
DC ONE LINE DIAGRAM

AS BUILT  
454003939  
STATUS: Release  
STATUS DATE: 10/15/2016  
DS APPROVED: SC SCHUL  
VER: AH REV: 68 SIZE: F

FOR PREVIOUS REVISIONS, SEE SUPERSEDED CARDS.  
VERSIONS/REVISIONS BY N.P.P.D.

NO.	DESCRIPTION	DFT	DATE	ENG
A2/64/DR-2014-0177	TCN 08-0214	DFT	2/19/14	WDC
A7/65/DR-2015-0298	TCN 08-0214	DFT	11/17/15	WDC
A7/66/DR-2015-0298	TCN 08-0214	DFT	11/17/15	WDC
A2/67/DR-2016-0058	TCN 08-0214	DFT	10/13/16	WDC
A7/68/DR-2016-0058	TCN 08-0214	DFT	10/13/16	WDC






















SECURITY-RELATED INFORMATION -  
WITHHOLD UNDER 10 CFR 2.390

DRAWING 4003  
OVERALL SITE AND VICINITY PLAN

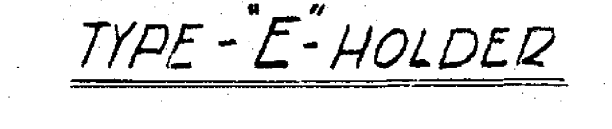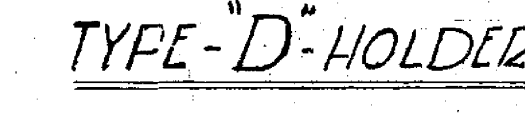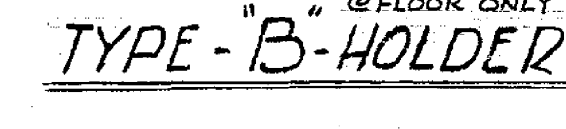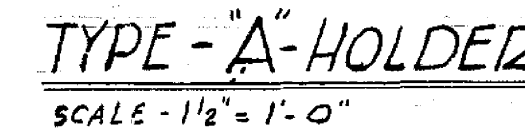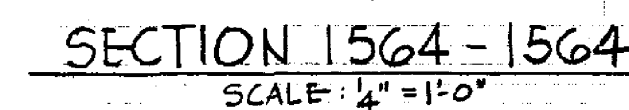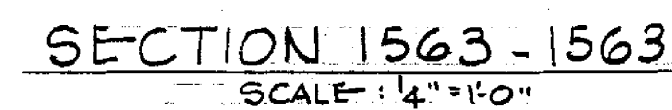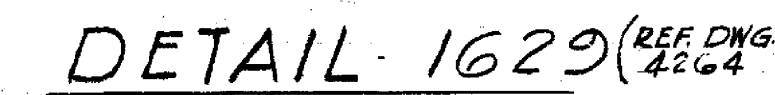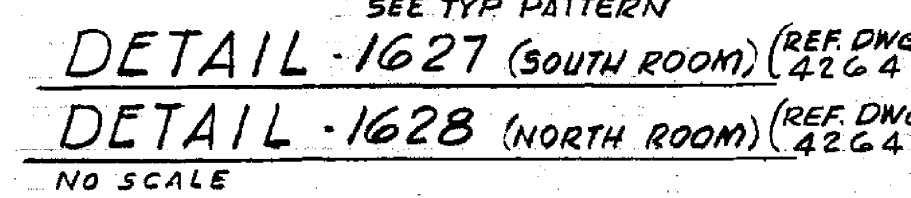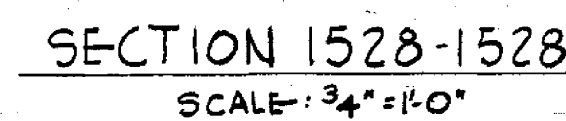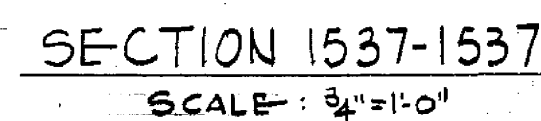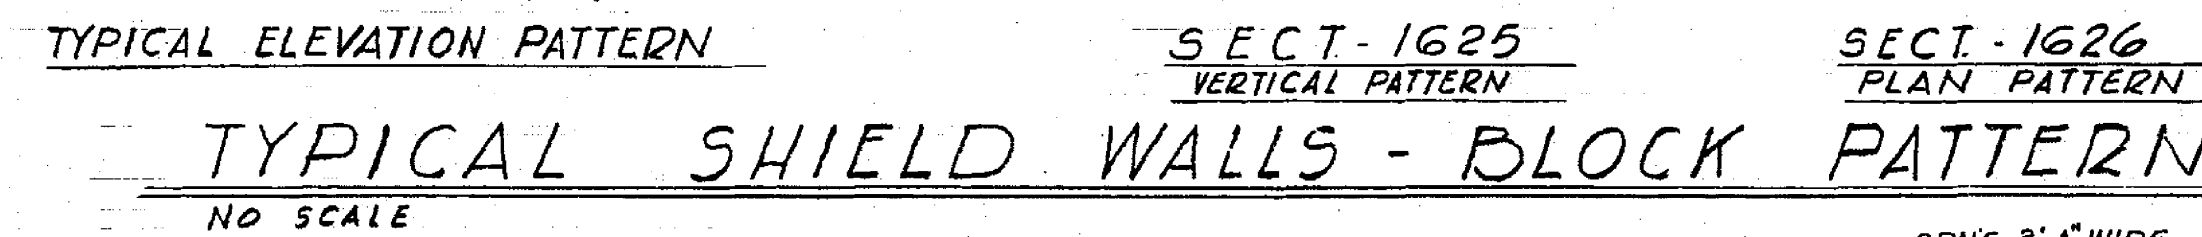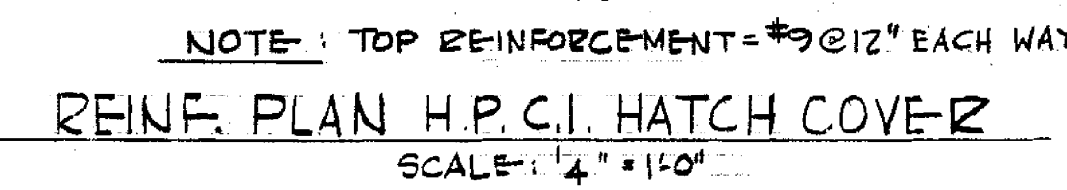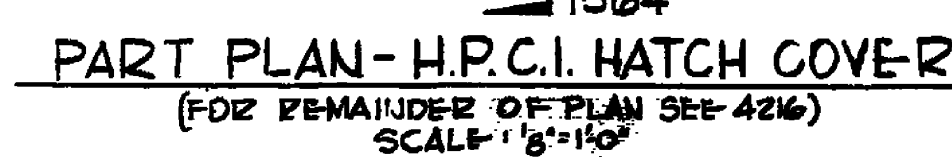

3" WAGON STEEL DECK  
SECTION # 290 - 5 EACH  
FACE 18 x 18 GAGE OR  
APPROVED EQUIV

TYPE - B - HOLDER  
TOP SUPPORT

TYPE - A - HOLDER  
NORTH & SOUTH FACE

TYPE - B - HOLDER  
FLOOR SUPPORT







SHIELD BLOCKS  
SEE TYP. PATTERN

DETAIL - 1634 (REF. DWG. 4263)

DETAIL - 1634 (REF. DWG. 4263)  
NO SCALE  
SEE DETAIL 595a, DWG. 4241 FOR  
ADDITIONAL DETAILS.

FOR PREVIOUS REVISIONS, SEE SUPERSEDED CARDS.								SIGNATURE NUMBER						ORIGIN	DATE	BURNS & ROE	C0103894	
REVISIONS BY N.P.D.								GROUP	1	2	3	4	5	6	CHECKED			DATE
NO.	REVISED							DFT	KCD	APP	DATE		APPROVED	DATE SEE SUPERSEDED CHANGES				
N03	CED	603J644	(CON 12-0125)	RAC	KPB	GJB	17-2413											
COOPER NUCLEAR STATION REACTOR BUILDING STRUCTURAL SHIELDING BLOCKS (HPCI HATCH)													FILMED	4215	REVISION N03			



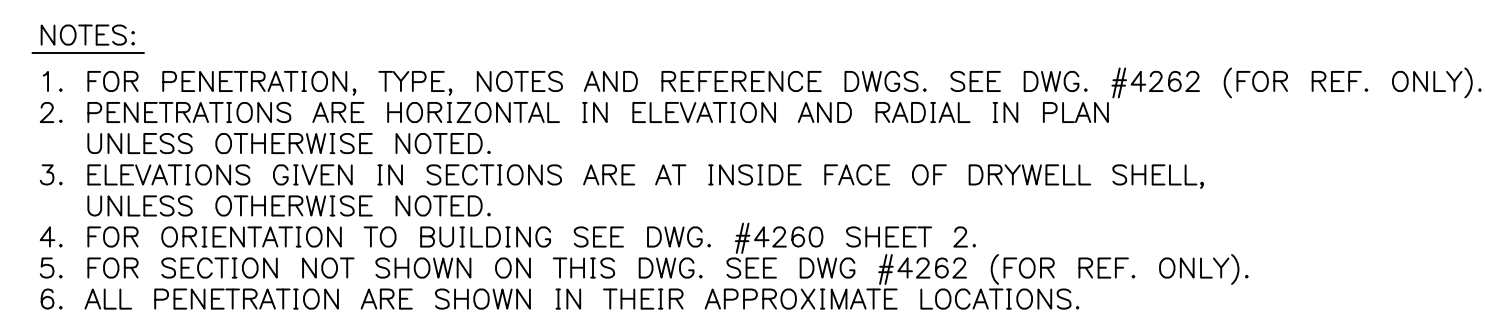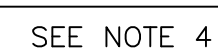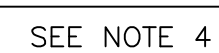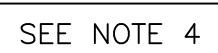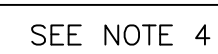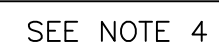

THIS DRAWING IS NOT TO SCALE

AS BUILT

CADD DRAWING

FOR PREVIOUS REVISIONS, SEE SUPERSEDED CARDS.

REVISIONS BY N.P.P.D.					
NO.	REVISIONS	DFT	CKD	APP	DATE
N10	REDRAWN PER CR96-0160 (DCN 97-0094)	SPB	JFH	JRF	1-31-97

SIGNIFICANT NUMBER						
GROUP	1	2	3	4	5	6
CONTAINMENT VESSEL PENETRATION LOCATION SHEET 1						

BURNS &amp; ROE

4259

ROE	E: C0012748
-----	-------------

CONTAINMENT PENETRATION	PENETRATION SIZE	LOCATION		LINE SIZE	QTY.	LINE DESCRIPTION	REMARKS	TYPE "B" TESTABLE PENETR.	TYPE "C" TESTABLE ISOLATION VALVES (INBOARD, OUTBOARD)
		ELEVATION	AZIMUTH						
X-1A	10"-0" I.D.	907'-3"	135'	-	1	EQUIPMENT HATCH	SEE SECTION 33 DWG. 4262 (REF. ONLY)	DOUBLE O-RING	
X-1B	10"-0" I.D.	907'-3"	315'	-	1	EQUIPMENT HATCH	SEE SECTION 33 DWG. 4262 (REF. ONLY)	DOUBLE O-RING	
X-2	8'-6" I.D.	907'-11"	0'	-	1	PERSONNEL ACCESS AIR LOCK	SEE SECTION 21 DWG. 4262 (REF. ONLY)	DOUBLE O-RING	
X-4	24" I.D.	DRYWELL HEAD	135'	5'-10" I.D.	1	DRYWELL HEAD ACCESS HATCH	10'-0" R FROM Q DRYWELL HEAD	DOUBLE O-RING	
X-5A	6'-11 1/2"	892'-5"	25'	5'-10" I.D.	1	VENT LINE DRYWELL TO TORUS	TYPE "A" TESTED		
X-5B	6'-11 1/2"	892'-5"	70'	5'-10" I.D.	1	VENT LINE DRYWELL TO TORUS	TYPE "A" TESTED		
X-5C	6'-11 1/2"	892'-5"	115'	5'-10" I.D.	1	VENT LINE DRYWELL TO TORUS	TYPE "A" TESTED		
X-5D	6'-11 1/2"	892'-5"	160'	5'-10" I.D.	1	VENT LINE DRYWELL TO TORUS	TYPE "A" TESTED		
X-5E	6'-11 1/2"	892'-5"	200'	5'-10" I.D.	1	VENT LINE DRYWELL TO TORUS	TYPE "A" TESTED		
X-5F	6'-11 1/2"	892'-5"	245'	5'-10" I.D.	1	VENT LINE DRYWELL TO TORUS	TYPE "A" TESTED		
X-5G	6'-11 1/2"	892'-5"	290'	5'-10" I.D.	1	VENT LINE DRYWELL TO TORUS	TYPE "A" TESTED		
X-5H	6'-11 1/2"	892'-5"	335'	5'-10" I.D.	1	VENT LINE DRYWELL TO TORUS	TYPE "A" TESTED		
X-6	24"	905'-3"	37'	-	1	CRD REMOVAL HATCH		DOUBLE O-RING	
X-7A	42"	908'-4"	160'	24"	1	MS TO TURBINE	SEE SECTION 4-4	BELLOWS	MS-A080A, MS-A086A
X-7B	42"	908'-4"	175'	24"	1	MS TO TURBINE	SEE SECTION 4-4	BELLOWS	MS-A080B, MS-A086B
X-7C	42"	908'-4"	185'	24"	1	MS TO TURBINE	SEE SECTION 4-4	BELLOWS	MS-A080C, MS-A086C
X-7D	42"	908'-4"	200'	24"	1	MS TO TURBINE	SEE SECTION 4-4	BELLOWS	MS-A080D, MS-A086D
X-8	18"	904'-10"	180'	3"	1	CONDENSATE DRAIN (MAIN STEAM)			MS-M074, MS-M077
X-9A	34"	913'-7"	170'	18"	1	FW WITH RWCU AND RCIC INJECTION LINES	SEE SECTION 4-4	BELLOWS	RF-16CV, RF-15CV FOR FW RF-16CV, RCIC-26CV FOR RCIC RF-16CV, RWCU-15CV FOR RWCU
X-9B	34"	913'-7"	190'	18"	1	FW WITH HPCI INJECTION LINES	SEE SECTION 4-4	BELLOWS	RF-14CV, RF-13CV FOR FW RF-14CV, HPCI-29CV FOR HPCI
X-10	18"	920'-10"	190'	3"	1	RCIC STEAM			RCIC-M015, RCIC-M016
X-11	26"	906'-6"	335'	10"	1	HPCI STEAM	SEE SECTION 5-5, PITCH DOWN 5' FROM FACE OF DRYWELL		HPCI-M015, HPCI-M016
X-12	36"	907'-0"	20'	20"	1	SHUTDOWN SUPPLY TO RHR PUMPS	SEE SECTION 5-5 (SEE NOTE 7)		RHR-M017
X-13A	42"	912'-2 7/16"	25'	24"	1	RHR INJECTION	(SEE NOTE 7)		RHR-M025A
X-13B	42"	912'-2 7/16"	340'	24"	1	RHR INJECTION	(SEE NOTE 7)		RHR-M025B
X-14	22"	946'-0"	20'	6"	1	RWCU FROM RECIRC PUMPS			RWCU-M015, RWCU-M018
X-15	20"	947'-6"	340'	-	1	SPARE	TYPE "A" TESTED		
X-16A	26"	946'-3"	100'	10"	1	CS A PUMP DISCHARGE	(SEE NOTE 7)		CS-M012A
X-16B	26"	946'-3"	260'	10"	1	CS B PUMP DISCHARGE	(SEE NOTE 7)		CS-M012B
X-17	22"	967'-6"	337'	6"	1	SPARE	TYPE "A" TESTED		
X-18	6"	898'-9"	32'	3"	1	DRYWELL EQUIPMENT DRAIN PUMP DISCHARGE	(SEE NOTE 1)		RW-A094, RW-A095
X-19	4"	898'-9"	28'	3"	1	DRYWELL FLOOR DRAIN PUMP DISCHARGE	(SEE NOTE 1)		RW-A082, RW-A083
X-20	8"	920'-10"	55'	4"	1	DRYWELL DEMINERALIZED WATER SUPPLY	SEE SECTION 6-6		DW-219, DW-133
X-21	3"	922'-6"	235'	1"	1	SERVICE AIR	SEE SECTION 7-7 (SEE NOTE 1)		SA-649, SA-648
X-22	3"	922'-6"	232'	1"	1	INSTRUMENT AIR	SEE SECTION 7-7 (SEE NOTE 1)		IA-65CV, IA-78CV
X-23	12"	946'-0"	350'	8"	1	CLOSED COOLING WATER DRYWELL SUPPLY	(SEE NOTE 2)		REC-702MV
X-24	12"	946'-0"	10'	8"	1	CLOSED COOLING WATER DRYWELL RETURN	(SEE NOTE 2)		REC-709MV
X-25	20"	896'-0"	235'	20"	1	VENT TO DRYWELL	(SEE NOTE 1 & 5)	DOUBLE O-RING FOR INBOARD FLANGE ON PC-232	PC-232MV, PC-238AV FOR PURGE & VENT PC-1306MV, PC-1305MV FOR SBNI
X-26	20"	966'-6"	157'	20"	1	VENT FROM DRYWELL (PC PURGE AND VENT)	SEE DWG. GE 11703303 SHT. 5 (REF. ONLY) (SEE NOTE 1, 4 & 6)	DOUBLE O-RING FOR INBOARD FLANGE ON PC-232	PC-231MV, PC-246AV FOR LARGE BORE SBT PC-306MV, PC-1310MV FOR SMALL BORE SBT
X-27	10"	918'-6"	55'	1"	6	X-27(A-D) 1" INSTRUMENT TO BCV X27(E & F) SPARE	SEE SECTION 6-6 TYPE "A" TESTED		
X-28	10"	946'-0"	38'	1"	6	X-28(A-E) 1" INSTRUMENT TO BCV X-28(F) FLANGE LEAK DETECTION			
X-29	10"	946'-0"	235'	1"	6	X-29(A-D) 1" INSTRUMENT TO BCV X-29(E) IA TO RR-741AV X-29(F) DRYWELL PRESSURE INDICATION	SEE SECTION 3-3, SEE DWG. GE 11703303 SHT. 4 (REF. ONLY) (SEE NOTE 4 & 6)		PC-33CV, PC-34CV (SEE NOTE 1)
X-30	10"	911'-6"	265'	1"	6	X-30(A-D) 1" INSTRUMENT TO BCV X-30(E) IA TO NBI-737AV X-30(F) IA TO MS-739AV	SEE SECTION 1-1 (SEE NOTE 1) (SEE NOTE 1)		NBI-559, NBI-560 NBI-561, NBI-562
X-31	10"	898'-9"	55'	1"	6	X-31(A-D) INSTRUMENT TO CV OR BCV	SEE SECTION 2-2		
X-32	10"	898'-9"	58'	1"	6	X-32(A-F) INSTRUMENT TO CV OR BCV	SEE SECTION 2-2		
X-33	10"	898'-9"	65'	1"	6	X-33(A-D) INSTRUMENT TO CV OR BCV X-33(E) IA TO MS-738AV X-33(F) IA TO NBI-736AV	SEE SECTION 2-2		NBI-563, NBI-564 (SEE NOTE 1) NBI-565, NBI-566 (SEE NOTE 1)
X-34	10"	911'-6"	260'	1"	6	X-34(A-D) INSTRUMENT TO CV OR BCV X-34(E-F) SPARE	SEE SECTION 1-1 TYPE "A" TESTED		
X-35A	1 1/2"	900'-11"	206'	3/8"	1	TIP	SEE SECTION 1-1	DOUBLE O-RING	NMT-NVA-104A (SEE NOTE 2)
X-35B	1 1/2"	900'-11"	210'	3/8"	1	TIP	SEE SECTION 1-1	DOUBLE O-RING	NMT-NVA-104B (SEE NOTE 2)
X-35C	1 1/2"	900'-11"	214'	3/8"	1	TIP	SEE SECTION 1-1	DOUBLE O-RING	NMT-NVA-104C (SEE NOTE 2)
X-35D	1 1/2"	900'-11"	218'	3/8"	1	TIP	SEE SECTION 1-1	DOUBLE O-RING	NMT-NVA-104D (SEE NOTE 2)
X-35E	1 1/2"	900'-11"	222'	3/8"	1	TIP N <sub>2</sub> PURGE	SEE SECTION 1-1	DOUBLE O-RING	NM-CV4, NM-CV2 (SEE NOTE 1)

CONTAINMENT PENETRATION	PENETRATION SIZE	LOCATION		LINE SIZE	QTY.	LINE DESCRIPTION	REMARKS	TYPE "B" TESTABLE PENETR.	TYPE "C" TESTABLE ISOLATION VALVES (INBOARD, OUTBOARD)
		ELEVATION	AZIMUTH						
X-36	6"	950'-0"	175'	3"	1	H <sub>2</sub> O <sub>2</sub> MONITORING	SAMPLE LINES (SEE NOTE 4 & 6)	IF MODIFIED	
X-37A	3'-9"W x 2'-6"H	918'-10"	75'	1"	32	31 CRD WATER INSERT, 1 SPARE	SEE DETAIL 28 & 30, DWG. 4262 (REF. ONLY)		
X-37B	4'-7"W x 2'-6"H	918'-10"	105'	1"	38	37 CRD WATER INSERT, 1 SPARE	SEE DETAIL 28 & 30, DWG. 4262 (REF. ONLY)		
X-37C	4'-7"W x 2'-6"H	918'-10"	255'	1"	39	38 CRD WATER INSERT, CRD MINI PURGE	SEE DETAIL 28 & 30, DWG. 4262 (REF. ONLY)		CRD-14CV, CRD-13CV
X-37D	3'-9"W x 2'-6"H	918'-10"	285'	1"	32	31 CRD WATER INSERT, 1 SPARE	SEE DETAIL 28 & 30, DWG. 4262 (REF. ONLY)		
X-38A	3'-9"W x 2'-6"H	918'-10"	75'	1"	32	31 CRD WATER WITHDRAWAL, 1 SPARE	SEE DETAIL 28 & 30, DWG. 4262 (REF. ONLY)		
X-38B	4'-7"W x 2'-6"H	918'-10"	105'	1"	38	37 CRD WATER WITHDRAWAL, 1 SPARE	SEE DETAIL 28 & 30, DWG. 4262 (REF. ONLY)		
X-38C	4'-7"W x 2'-6"H	918'-10"	255'	1"	39	38 CRD WATER WITHDRAWAL, CRD MINI PURGE	SEE DETAIL 28 & 30, DWG. 4262 (REF. ONLY)		CRD-16CV, CRD-15CV
X-38D	3'-9"W x 2'-6"H	918'-10"	285'	1"	32	31 CRD WATER WITHDRAWAL, 1 SPARE	SEE DETAIL 28 & 30, DWG. 4262 (REF. ONLY)		
X-39A	12"	934'-6"	40'	12"	1	RHR DRYWELL SPRAY LOOP A	(SEE NOTE 1 & 7)		RHR-M031A
X-39B	12"	920'-10"	299'	12"	1	RHR DRYWELL SPRAY LOOP B	(SEE NOTE 1, 5 & 7)		RHR-M031B FOR RHR PC-1311MV, PC-1312MV FOR SBNI
X-40A	10"	920'-10"	49'	1"	7	X-40A(a-f) JET PUMP INSTR. TO BCV X-40A COUPLING PC PRESSURE INSTR.	SEE SECTION 6-6 (SEE NOTE 4 & 6)		
X-40B	10"	920'-10"	53'	1"	7	X-40B(a-f) JET PUMP INSTR. TO BCV X-40B COUPLING PC PRESSURE INSTR.	SEE SECTION 6-6 (SEE NOTE 4 & 6)		
X-40C	10"	919'-1"	239'	1"	7	X-40C(a-f) JET PUMP INSTR. TO BCV X-40C COUPLING PC PRESSURE INSTR.	SEE SECTION 7-7 (SEE NOTE 4 & 6)		
X-40D	10"	919'-1"	244'	1"	7	X-40D(a-f) JET PUMP INSTR. TO BCV X-40D COUPLING PC PRESSURE INSTR.	SEE SECTION 7-7 (SEE NOTE 4 & 6)		
X-41	6"	967'-6"	345'	1"	1	REACTOR WATER SAMPLE			RR-741AV, RR-740AV
X-42	4"	962'-6"	150'	1 1/2"	1	SLC INJECTION			SLC-13CV, SLC-12CV
X-43	18"	920'-6"	115'	4"	1	RR PUMP FLUSHING & ILRT TEST CONN.	SEE SECTION 7-7	DOUBLE O-RING	
X-44	18"	920'-6"	125'	4"	1	RR PUMP FLUSHING & ILRT TEST CONN.	SEE SECTION 7-7	DOUBLE O-RING	
X-45	12"	920'-10 1/2"	245'	<sup>2-1 1/2</sup> 1-1 1/2"	6	X-45(A,B,E & F) SPARE	SEE SECTION 7-7, TYPE "A" TESTED (SEE NOTE 1)		RMV-12AV, RMV-13AV PC-35CV, PC-36CV
X-46	10"	920'-10"	155'	1"	6	X-46(A-F) SPARE	SEE SECTION 7-7, TYPE "A" TESTED		
X-47	10"	920'-10"	160'	1"	6	X-47(A,C-F) SPARE X-47(B) INSTRUMENT LINE TO CV OR BCV	SEE SECTION 7-7, TYPE "A" TESTED (SEE NOTE 6)		
X-48	10"	898'-9"	166'	10"	1	SPARE	TYPE "A" TESTED		
X-49	10"	918'-6"	55'	1"	6	X-49(A,B & E,F) SPARE	SEE SECTION 6-6, TYPE "A" TESTED		
X-50	10"	920'-10"	235'	1"	6	X-50(A,B) ELECTRICAL PEN. X-50(C,D) SPARE X-50(E,F) INSTR. LINE TO CV OR BCV	SEE SECTION 7-7 TYPE "A" TESTED	ELEC. PENETR. ELEC. PENETR.	
X-51	10"	919'-1"	235'	1"	6	X-51(A) INSTRUMENT LINE TO BCV X-51(B) SOV TO DRYWELL AIR EXHAUST X-51(C,D) SPARE X-51(E) DRYWELL VENT MONITOR X-51(F) PAS CONT. ATM. SAMPLE	SEE SECTION 7-7 TYPE "A" TESTED (SEE NOTE 1) (SEE NOTE 1)		RMV-10AV, RMV-11AV PC-247AV, PC-248AV
X-52	10"	920'-10"	45'	1"	6	X-52(A-D) 1" INSTR. LINE TO CV OR BCV X-52(E,F) SPARE	SEE SECTION 6-6 TYPE "A" TESTED		
X-53	6"	911'-0"	42'	6"	1	SPARE	TYPE "A" TESTED		
X-100A	12"	919'-5"	5'	12"	1	LOW VOLTAGE INSTR. & CONTROL	SEE SECTION 7-7	ELEC. PENETR.	
X-100B	12"	918'-6"	40'	12"	1	SPARE	SEE SECTION 6-6, TYPE "A" TESTED		
X-100C	12"	918'-6"	49'	12"	1	SPARE	SEE SECTION 6-6, TYPE "A" TESTED		
X-100D	12"	918'-6"	53'	12"	1	SPARE	SEE SECTION 6-6, TYPE "A" TESTED		
X-100E	12"	920'-10"	225'	12"	1	THERMOCOUPLES	SEE SECTION 7-7	ELEC. PENETR.	
X-100F	12"	919'-1"	221'	12"	1	NEUTRON MONITORING	SEE SECTION 7-7	ELEC. PENETR.	
X-100G	12"	920'-10"	218'	12"	1	LOW VOLTAGE INSTR. & CONTROL	SEE SECTION 7-7	ELEC. PENETR.	
X-100H	12"	919'-10"	215'	12"	1	LOW VOLTAGE INSTR. & CONTROL	SEE SECTION 7-7	ELEC. PENETR.	
X-101A	12"	920'-10"	20'	12"	1	MEDIUM VOLTAGE POWER	SEE SECTION 6-6	ELEC. PENETR.	
X-101B	12"	919'-5"	24'	12"	1	NEUTRON MONITORING	SEE SECTION 6-6	ELEC. PENETR.	
X-101C	12"	920'-10"	28'	12"	1	MEDIUM VOLTAGE POWER	SEE SECTION 6-6	ELEC. PENETR.	
X-101D	12"	920'-10"	335'	12"	1	MEDIUM VOLTAGE POWER	SEE SECTION 7-7	ELEC. PENETR.	
X-101E	12"	920'-10"	337'	12"	1	LOW VOLTAGE INSTR. & CONTROL	SEE SECTION 7-7	ELEC. PENETR.	
X-101F	12"	920'-10"	340'	12"	1	MEDIUM VOLTAGE POWER	SEE SECTION 7-7	ELEC. PENETR.	
X-102	12"	920'-10"	3'	12"	1	LOW VOLTAGE INSTR. & CONTROL	SEE SECTION 7-7	ELEC. PENETR.	
X-103	12"	919'-1"	223'	12"	1	NEUTRON MONITORING	SEE SECTION 7-7	ELEC. PENETR.	
X-104A	12"	920'-10"	215'	12"	1	CONTROL ROD POSITION INDICATOR	SEE SECTION 7-7	ELEC. PENETR.	
X-104B	12"	919'-1"	218'	12"	1	CONTROL ROD POSITION INDICATOR	SEE SECTION 7-7	ELEC. PENETR.	
X-104C	12"	920'-10"	220'	12"	1	SPARE	SEE SECTION 7-7, TYPE "A" TESTED		
X-104D	12"	919'-5"	350'	12"	1	CONTROL ROD POSITION INDICATOR	SEE SECTION 7-7	ELEC. PENETR.	
X-104E	12"	920'-10"	355'	12"	1	CONTROL ROD POSITION INDICATOR	SEE SECTION 7-7	ELEC. PENETR.	
X-105A	12"	919'-5"	12'	12"	1	POWER	SEE SECTION 6-6	ELEC. PENETR.	
X-105B	12"	920'-10"	17'	12"	1	SPARE	SEE SECTION 6-6, TYPE "A" TESTED		
X-105C	12"	919'-5"	20'	12"	1	SPARE	SEE SECTION 6-6, TYPE "A" TESTED		
X-105D	12"	920'-10"	347'	12"	1	POWER	SEE SECTION 7-7	ELEC. PENETR.	
X-106	12"	919'-5"	0'	12"	1	NEUTRON MONITORING	SEE SECTION 7-7	ELEC. PENETR.	
SIP1	16"	961'-10 3/4"	0'	-	1	INSPECTION HATCH		DOUBLE O-RING	
SIP2	16"	961'-10 3/4"	45'	-	1	INSPECTION HATCH		DOUBLE O-RING	
SIP3	16"	961'-10 3/4"	90'	-	1	INSPECTION HATCH		DOUBLE O-RING	
SIP4	16"	961'-10 3/4"	135'	-	1	INSPECTION HATCH		DOUBLE O-RING	
SIP5	16"	961'-10 3/4"	180'	-	1	INSPECTION HATCH		DOUBLE O-RING	
SIP6	16"	961'-10 3/4"	225'	-	1	INSPECTION HATCH		DOUBLE O-RING	
SIP7	16"	961'-10 3/4"	270'	-	1	INSPECTION HATCH		DOUBLE O-RING	
SIP8	16"	961'-10 3/4"	315'	-	1	INSPECTION HATCH		DOUBLE O-RING	


NOTE:

- BOTH ISOLATION VALVES ARE OUTBOARD OF DRYWELL CONTAINMENT.
- ONLY ONE ISOLATION VALVE EXISTS.
- ALL PENETRATION LOCATIONS SHOWN IN THE SCHEDULE ARE APPROXIMATE.
- COMPONENTS ARE SUBJECT TO TESTING UNDER 10CFR50, APPENDIX J TYPE "B" REQUIREMENTS IF MAINTENANCE OR A MODIFICATION IS MADE.
- IN-LINE MANUAL VALVES ARE NOT SUBJECT TO TYPE "C" TESTING.
- INSTRUMENT PORTION IS AN EXTENSION OF CONTAINMENT.
- CLOSED LOOP PROVIDES THE SECOND BARRIER.


NO.	REVISIONS

REVISIONS BY N.P.P.D.							
NO.	REVISIONS			DFT	CKD	APP	DATE
N00	CR96-0160 (DCN 97-0095)			SPB	JEH	JRF	1-31-97
N01	UCR BINDER 22A (DCN 00-0645)			DLR	TMB	KG	8/2/00
N02	PIR 2-21154 (DCN 99-0315)			KG	DLR	RGA	8/16/01
N03	EE 10-073 (DCN 11-0097)			KZ	KZ	DJB	2/9/12



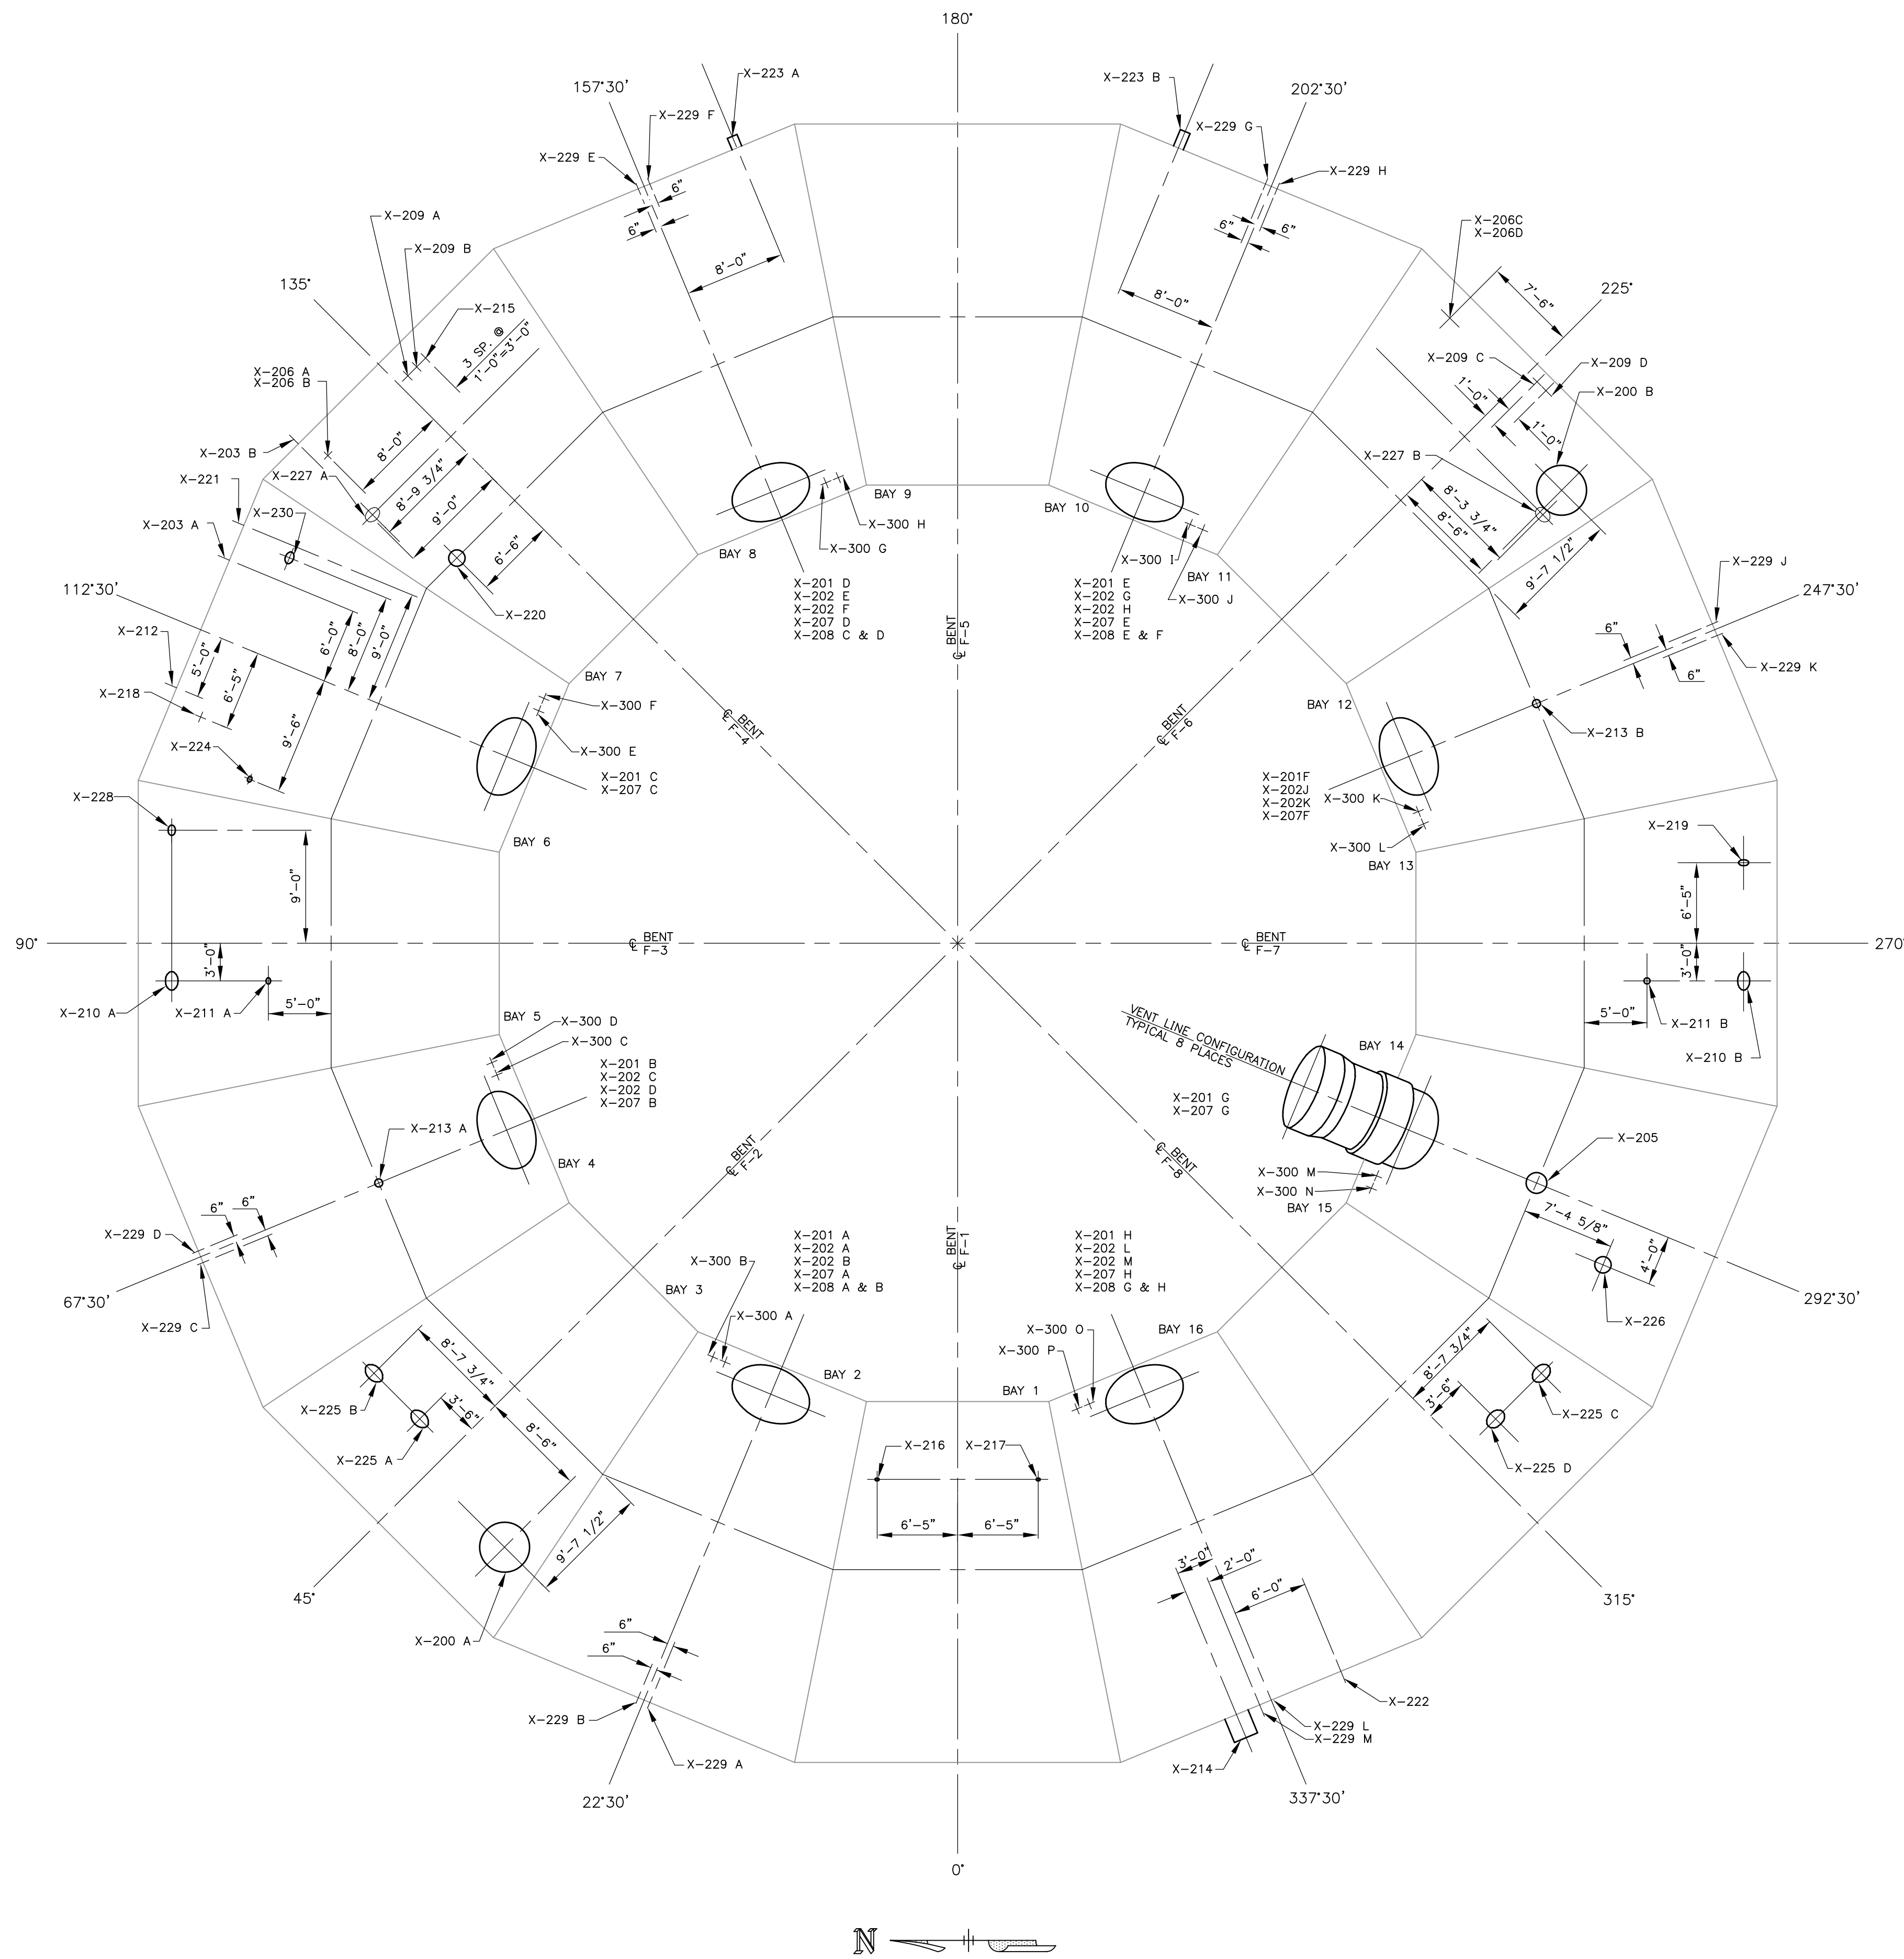

PLAN VIEW SUPPRESSION CHAMBER

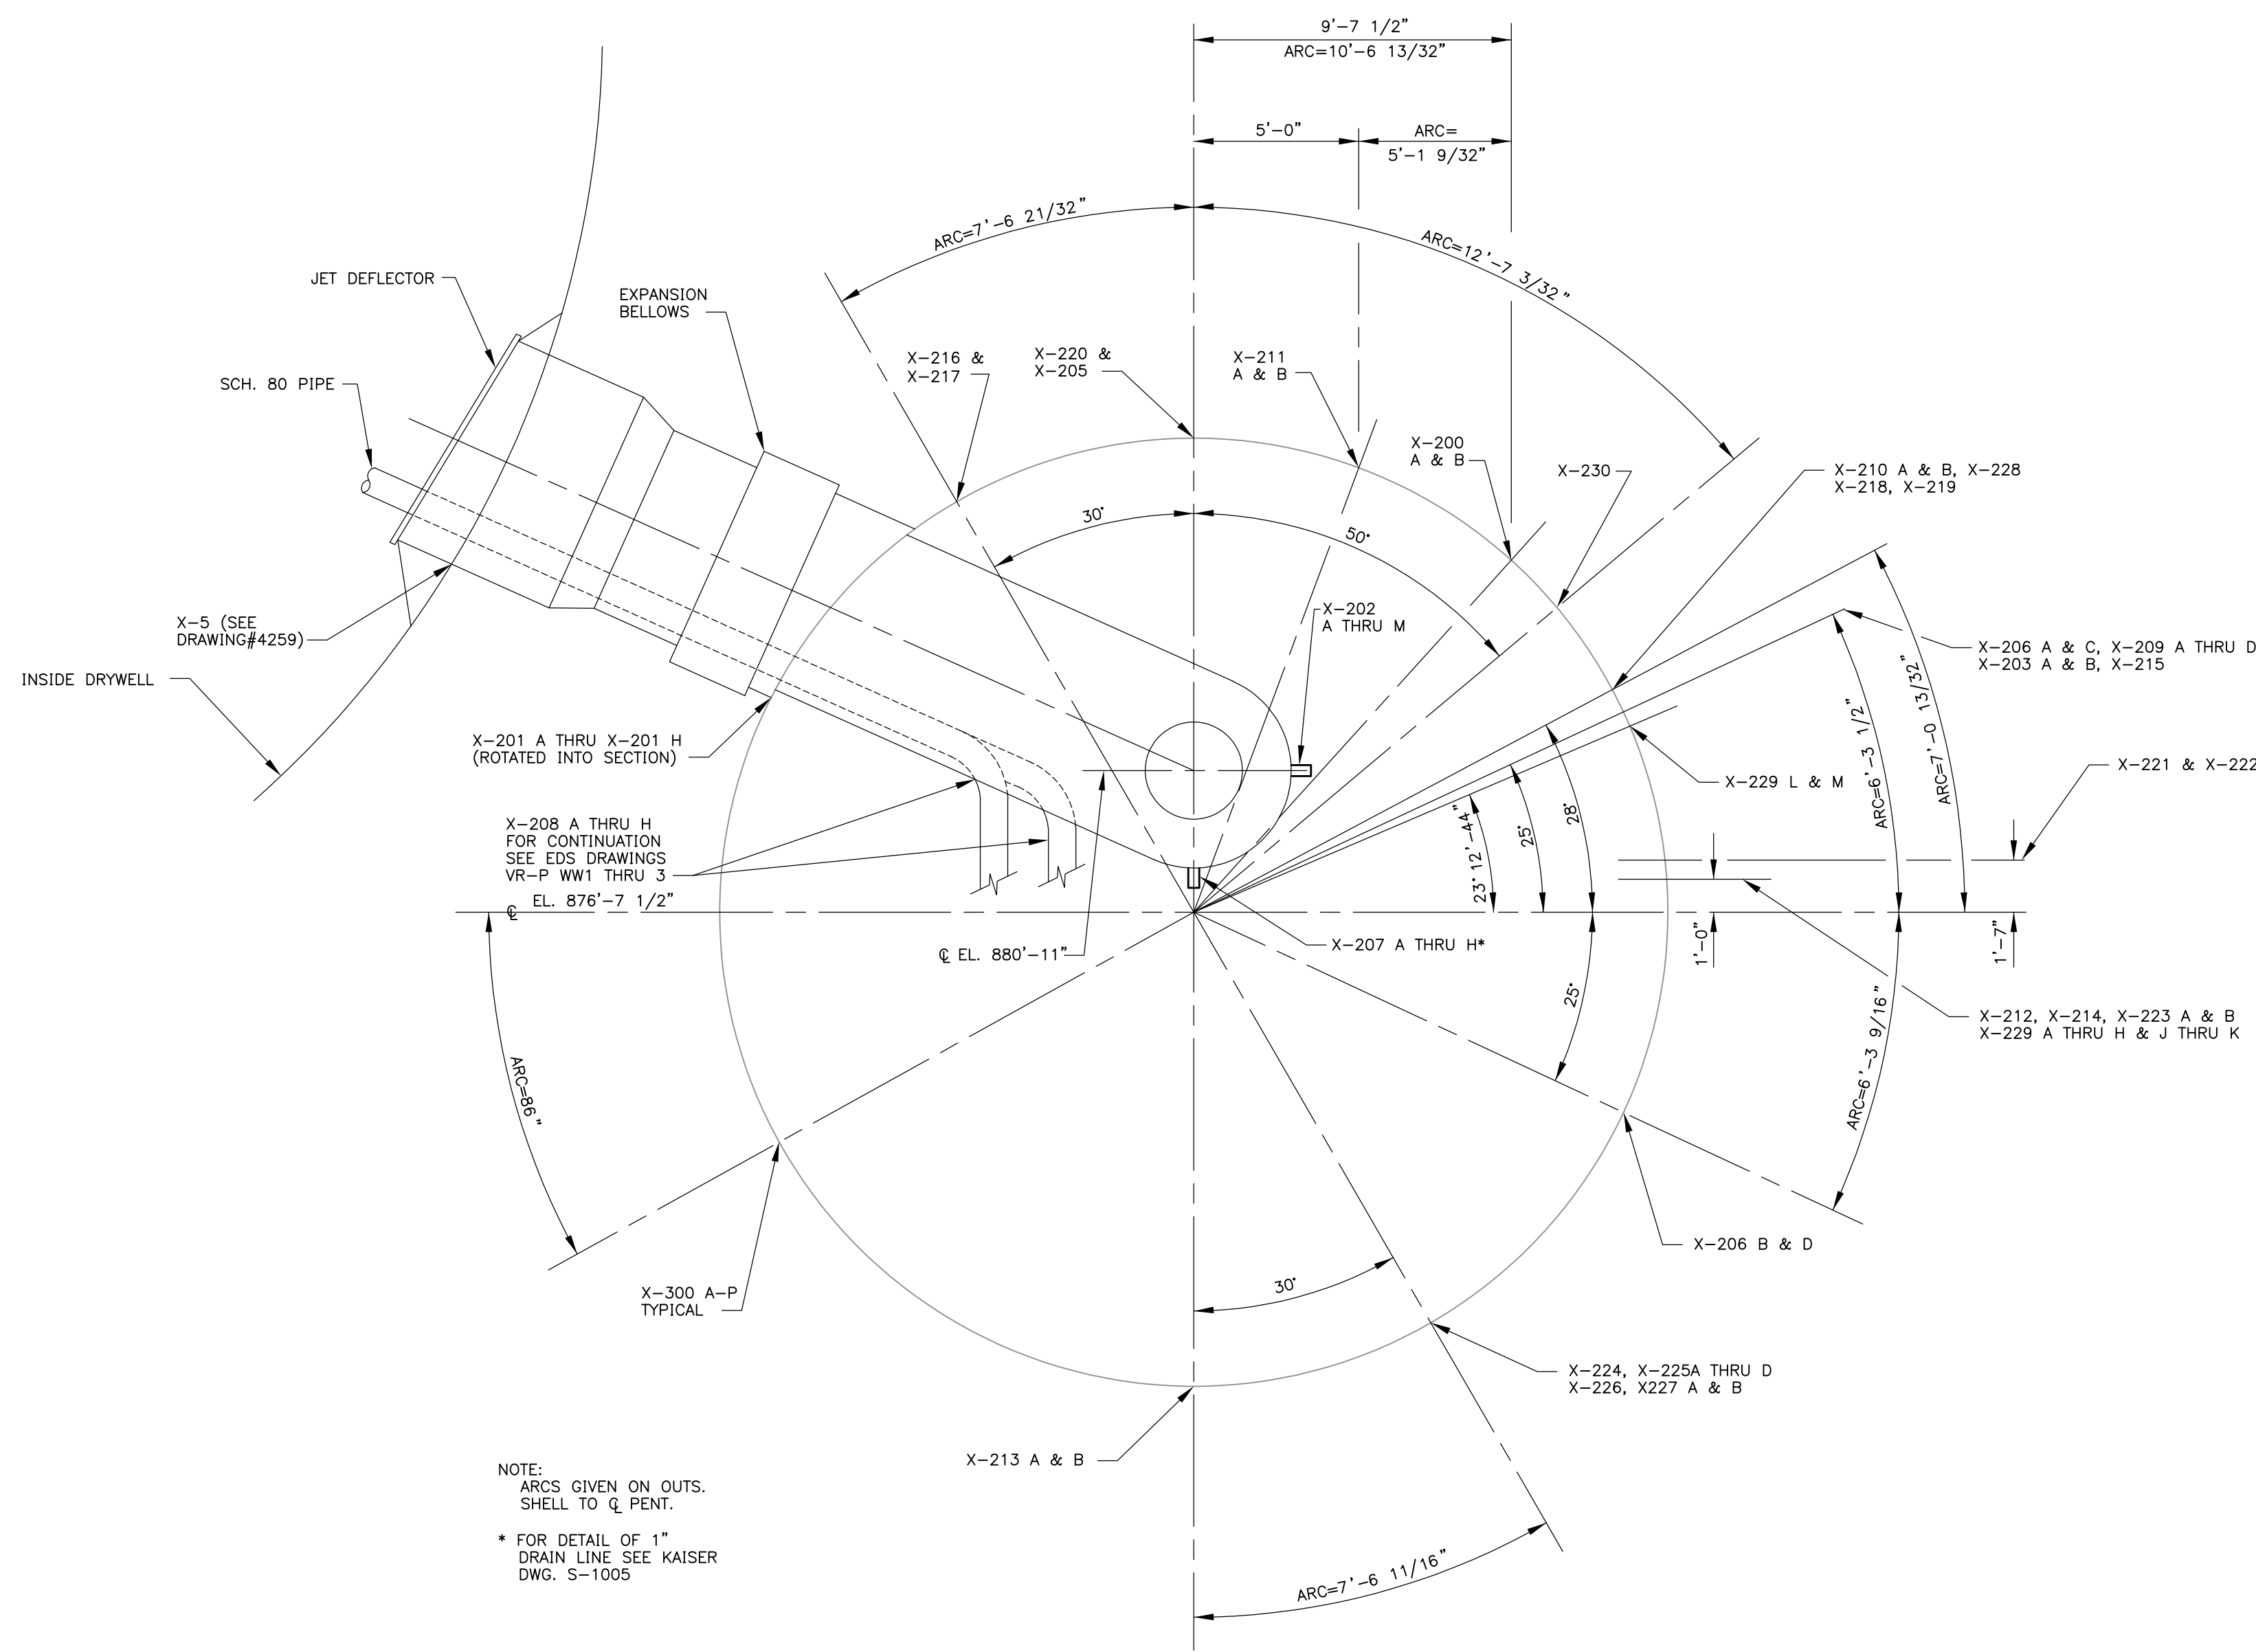

COMPOSITION SECTION

ROTATE COUNTER CLOCKWISE

NOTES:

1. ALL PENETRATIONS ARE SHOWN IN THEIR APPROXIMATE LOCATIONS. LOCATIONS WERE TAKEN FROM BURNS AND ROE DRAWING 4260 SHT. 2 AND CHICAGO BRIDGE AND IRON COMPANY DRAWING # 5.

454243227  
AS BUILT


CADD DRAWING

\* THIS DRAWING GENERATED BY NPPD


SIGNIFICANT NUMBER										DRAWN		DATE		BURNS & ROE*		CAD FILE: 000-07-71			
GROUP										SPB		3/22/96							
1		2		3		4		5		6		CHECKED						DATE	
7		8		9		10		11		12		JEH						1/31/97	
CONTAINMENT SUPPRESSION CHAMBER PENETRATION LOCATION SHEET 2A										APPROVED		DATE		4260		REVISION N000			
										JRF		1/31/97							
										FILMED									
REVISIONS BY N.P.D.																			
NO.		REVISIONS		DTT		CKD		APP		DATE									
N000		CR96-0160 (OCN 97-0097)		SPB		JEH		JRF		1-31-97									

CONTAINMENT PENETRATION	PENETRATION SIZE	LOCATION		LINE SIZE	QTY.	LINE DESCRIPTION	REMARKS	TYPE "B" TESTABLE PENETR.	TYPE "C" TESTABLE ISOLATION VALVES (INBOARD, OUTBOARD)	CONTAINMENT PENETRATION	PENETRATION SIZE	LOCATION		LINE SIZE	QTY.	LINE DESCRIPTION	REMARKS	TYPE "B" TESTABLE PENETR.	TYPE "C" TESTABLE ISOLATION VALVES (INBOARD, OUTBOARD)		
		ELEVATION	AZIMUTH							ELEVATION	AZIMUTH										
X-200A	4'-0" I.D.	893'-0"	8'-6" FROM 45'	-	1	ACCESS HATCH		DOUBLE O-RING		X-212	12"	877'-7 1/2"	5' FROM 112'30'	12"	1	RCIC TURBINE EXHAUST		DOUBLE O-RING	RCIC-37, RCIC-15CV		
X-200B	4'-0" I.D.	893'-0"	8'-6" FROM 225'	-	1	ACCESS HATCH		DOUBLE O-RING		X-213A	8"	862'-4 1/2"	67'30'	8"	1	TORUS DRAIN	FLANGED (SEE NOTE 2)				
X-201A	5'-11"	885'-10"	22'30'	5'-11"	1	VENT LINE	TYPE "A" TESTED														
X-201B	5'-11"	885'-10"	67'30'	5'-11"	1	VENT LINE	TYPE "A" TESTED														
X-201C	5'-11"	885'-10"	112'30'	5'-11"	1	VENT LINE	TYPE "A" TESTED			X-213B	8"	862'-4 1/2"	247'30'	8"	1	TORUS DRAIN	FLANGED (SEE NOTE 2)	DOUBLE O-RING	HPCI-44, HPCI-15CV FOR HPCI TURBINE		
X-201D	5'-11"	885'-10"	157'30'	5'-11"	1	VENT LINE	TYPE "A" TESTED			X-214	24"	877'-7 1/2"	340'	24"	1	HPCI TURBINE EXHAUST (SEE NOTE 5)		APPLICABLE ONLY	EXHAUST; RHR-MO167A, RHR-MO166A FOR		
X-201E	5'-11"	885'-10"	202'30'	5'-11"	1	VENT LINE	TYPE "A" TESTED											FOR RHR-FLG	RHR HX A VENT; RHR-MO167B, RHR-		
X-201F	5'-11"	885'-10"	247'30'	5'-11"	1	VENT LINE	TYPE "A" TESTED											-18, 19,	MO-166B FOR RHR HX B VENT; HPCI-AO70,		
X-201G	5'-11"	885'-10"	292'30'	5'-11"	1	VENT LINE	TYPE "A" TESTED											20RV & 21RV	HPCI-AO71 FOR HPCI TURBINE EXHAUST		
X-201H	5'-11"	885'-10"	337'30'	5'-11"	1	VENT LINE	TYPE "A" TESTED														
X-202A	18"	880'-10 1/2"	22'30'	18"	1	VACUUM BREAKER	TYPE "A" TESTED												HX A SHELL SIDE RV DISCHARGE;		
X-202B	18"	880'-10 1/2"	22'30'	18"	1	VACUUM BREAKER	TYPE "A" TESTED												RHR-RV-21RV FOR RHR HX B SHELL SIDE		
X-202C	18"	880'-10 1/2"	67'30'	18"	1	VACUUM BREAKER	TYPE "A" TESTED												RV DISCHARGE		
X-202D	18"	880'-10 1/2"	67'30'	18"	1	VACUUM BREAKER	TYPE "A" TESTED														
X-202E	18"	880'-10 1/2"	157'30'	18"	1	VACUUM BREAKER	TYPE "A" TESTED														
X-202F	18"	880'-10 1/2"	157'30'	18"	1	VACUUM BREAKER	TYPE "A" TESTED														
X-202G	18"	880'-10 1/2"	202'30'	18"	1	VACUUM BREAKER	TYPE "A" TESTED			X-215	1"	882'-8"	135'	1"	1	ATMOSPHERIC PRESSURE INSTRUMENTATION	(SEE NOTE 5)				
X-202H	18"	880'-10 1/2"	202'30'	18"	1	VACUUM BREAKER	TYPE "A" TESTED			X-216	4"	888'-11"	6'-5" FROM 0'	4"	1	SPARE	TYPE "A" TESTED				
X-202J	18"	880'-10 1/2"	247'30'	18"	1	VACUUM BREAKER	TYPE "A" TESTED			X-217	4"	888'-11"	6'-5" FROM 0'	4"	1	SPARE	TYPE "A" TESTED				
X-202K	18"	880'-10 1/2"	247'30'	18"	1	VACUUM BREAKER	TYPE "A" TESTED			X-218	2"	883'-4"	6'-5" FROM 112'30'	2"	1	SPARE	TYPE "A" TESTED				
X-202L	18"	880'-10 1/2"	337'30'	18"	1	VACUUM BREAKER	TYPE "A" TESTED			X-219	10"	883'-4"	6'-5" FROM 270'	10"	1	SPARE	TYPE "A" TESTED				
X-202M	18"	880'-10 1/2"	337'30'	18"	1	VACUUM BREAKER	TYPE "A" TESTED			X-220	16"	890'-10 1/2"	6'-6" FROM 135'	16"	1	VENT PURGE OUTLET	TOP REF. LEG OF PC-3B-2 0-30' TORUS LEVEL	DOUBLE O-RING	PC-230MV, PC-245AV FOR PURGE & VENT		
X-203A	1"	882'-8"	6' FROM 112'30'	1"	1	HYDROGEN/OXYGEN ANALYZER	TYPE "A" TESTED (SEE NOTE 5)	IF MODIFIED										FOR INBOARD	EXHAUST; PC-305MV, PC-1308MV FOR		
X-203B	1"	882'-8"	9' FROM 135'	1"	1	HYDROGEN/OXYGEN ANALYZER	TYPE "A" TESTED (SEE NOTE 5)	IF MODIFIED		X-221	2"	878'-2 1/2"	9' FROM 112'30'	2"	1	RCIC VACUUM PUMP DISCHARGE	(SEE NOTE 2)	FLANGE ON PC-230	BYPASS TO PC-230MV		
X-205	20"	890'-10 1/2"	292'30'	20"	1	VACUUM RELIEF FROM BLDG. VENT PURGE INLET	FOR REF. LEG OF PC-3B-1 0-30' TORUS LEVEL	DOUBLE O-RING	PC-233MV, PC-237MV FOR PURGE & VENT	X-222	2"	878'-2 1/2"	6' FROM 337'30'	2"	1	HPCI TURBINE DRAIN TO TORUS	(SEE NOTE 2)		RCIC-16CV, RCIC-12CV		
								FLANGE ON	PC-244AV, PC-14CV FOR VACUUM RELIEF	X-223A	10"	877'-7 1/2"	8' FROM 157'30'	10"	1	CORE SPRAY PUMP A TEST LINE	(SEE NOTE 2)		HPCI-50, HPCI-16CV		
								VALVES PC-233, 243 & 244	PC-1304MV, PC-1303MV DILUTION SUPPLY FOR LOOP A FROM SBNI									DOUBLE O-RING	CS-MO26A FOR CS A TEST LINE; CS-MO5A		
										X-223B	10"	877'-7 1/2"	8' FROM 202'30'	10"	1	CORE SPRAY PUMP B TEST LINE	(SEE NOTE 2)		APPLICABLE ONLY	FOR CS A MIN. FLOW; CS-RV-11RV FOR	
X-206A	1"	882'-8"	8' FROM 135'	1"	1	LIQUID LEVEL INDICATOR	TYPE "A" TESTED (SEE NOTE 5)												FOR CS-FLG-11RV	CS PUMP A RV DISCHARGE	
X-206B	1"	870'-7"	8' FROM 135'	1"	1	LIQUID LEVEL INDICATOR	TYPE "A" TESTED (SEE NOTE 5)												DOUBLE O-RING	CS-MO26B FOR CS B TEST LINE; CS-MO5B	
X-206C	1"	882'-8"	7'-6" FROM 225'	1"	1	LIQUID LEVEL INDICATOR	TYPE "A" TESTED (SEE NOTE 5)			X-224	6"	864'-2 1/2"	9'-6" FROM 112'30'	6"	1	RCIC PUMP SUCTION	(SEE NOTE 2)		APPLICABLE ONLY	FOR CS B MIN. FLOW; CS-RV-13RV FOR	
X-206D	1"	870'-7"	7'-6" FROM 225'	1"	1	LIQUID LEVEL INDICATOR	TYPE "A" TESTED (SEE NOTE 5)			X-225A	20"	864'-2 1/2"	3'-6" FROM 45'	20"	1	RHR SYSTEM PUMP 1-A SUCTION	(SEE NOTE 2)		FOR CS-FLG-13RV	CS PUMP B RV DISCHARGE	
X-207A	1"	878'-0"	22'30'	1"	1	VENT LINE DRAIN	LOCATED AT LOW POINT OF EACH VENT LINE														
X-207B	1"	878'-0"	67'30'	1"	1	VENT LINE DRAIN	LOCATED AT LOW POINT OF EACH VENT LINE														
X-207C	1"	878'-0"	112'30'	1"	1	VENT LINE DRAIN	LOCATED AT LOW POINT OF EACH VENT LINE			X-225B	20"	864'-2 1/2"	8'-7 3/4" FROM 45'	20"	1	RHR SYSTEM PUMP 1-C SUCTION	(SEE NOTE 2)		DOUBLE O-RING	RHR-MO13C; RHR-RV-12RV FOR RHR PUMP	
X-207D	1"	878'-0"	157'30'	1"	1	VENT LINE DRAIN	LOCATED AT LOW POINT OF EACH VENT LINE												APPLICABLE ONLY	1-C RV DISCHARGE	
X-207E	1"	878'-0"	202'30'	1"	1	VENT LINE DRAIN	LOCATED AT LOW POINT OF EACH VENT LINE														
X-207F	1"	878'-0"	247'30'	1"	1	VENT LINE DRAIN	LOCATED AT LOW POINT OF EACH VENT LINE			X-225C	20"	864'-2 1/2"	8'-7 3/4" FROM 315'	20"	1	RHR SYSTEM PUMP 1-B SUCTION	(SEE NOTE 2)		FOR RHR-FLG-12RV	DOUBLE O-RING	RHR-MO13B; RHR-RV-11RV FOR RHR PUMP
X-207G	1"	878'-0"	292'30'	1"	1	VENT LINE DRAIN	LOCATED AT LOW POINT OF EACH VENT LINE												APPLICABLE ONLY	1-B RV DISCHARGE	
X-207H	1"	878'-0"	337'30'	1"	1	VENT LINE DRAIN	LOCATED AT LOW POINT OF EACH VENT LINE														
X-208A	10"	879'-11 1/2"	22'30'	10"	1	RELIEF VALVE DISCHARGE FROM MAIN STEAM HEADER				X-225D	20"	864'-2 1/2"	3'-6" FROM 315'	20"	1	RHR SYSTEM PUMP 1-D SUCTION	(SEE NOTE 2)		DOUBLE O-RING	RHR-MO13D; RHR-RV-13RV FOR RHR PUMP	
X-208B	10"	879'-11 1/2"	22'30'	10"	1	RELIEF VALVE DISCHARGE FROM MAIN STEAM HEADER													APPLICABLE ONLY	1-D RV DISCHARGE	
X-208C	10"	879'-11 1/2"	157'30'	10"	1	RELIEF VALVE DISCHARGE FROM MAIN STEAM HEADER															
X-208D	10"	879'-11 1/2"	157'30'	10"	1	RELIEF VALVE DISCHARGE FROM MAIN STEAM HEADER				X-226	16"	864'-2 1/2"	4' FROM 292'30'	16"	1	HPCI PUMP SUCTION	(SEE NOTE 2)		DOUBLE O-RING	HPCI-MO58	
X-208E	10"	879'-11 1/2"	202'30'	10"	1	RELIEF VALVE DISCHARGE FROM MAIN STEAM HEADER				X-227A	16"	864'-2 1/2"	8'-9 3/4" FROM 135'	16"	1	CORE SPRAY PUMP SUCTION	(SEE NOTE 2)		APPLICABLE ONLY	FOR RHR-FLG-11RV	
X-208F	10"	879'-11 1/2"	202'30'	10"	1	RELIEF VALVE DISCHARGE FROM MAIN STEAM HEADER															
X-208G	10"	879'-11 1/2"	337'30'	10"	1	RELIEF VALVE DISCHARGE FROM MAIN STEAM HEADER															
X-208H	10"	879'-11 1/2"	337'30'	10"	1	RELIEF VALVE DISCHARGE FROM MAIN STEAM HEADER				X-227B	16"	864'-2 1/2"	8'-9 3/4" FROM 225'	16"	1	CORE SPRAY PUMP SUCTION	(SEE NOTE 2)		DOUBLE O-RING	CS-MO7A; CS-RV-10RV FOR CS PUMP A	
X-209A	1"	882'-8"	1' FROM 135'	1"	1	AIR TEMPERATURE		DOUBLE O-RING & TEMP. ELEMENT											APPLICABLE ONLY	SUPPLY RV DISCHARGE	
X-209B	1"	882'-8"	2' FROM 135'	1"	1	SPARE	TYPE "A" TESTED														
X-209C	1"	882'-8"	1' FROM 225'	1"	1	AIR TEMPERATURE		DOUBLE O-RING & TEMP. ELEMENT		X-228	10"	883'-4"	9' FROM 90'	10"	1	SPARE	TYPE "A" TESTED		FOR CS-FLG-12RV		
X-209D	1"	882'-8"	2' FROM 225'	1"	1	SPARE	TYPE "A" TESTED			X-229A	1"	877'-7 1/2"	6" FROM 22'30'	1"	1	VACUUM BREAKER ACTIVATING AIR				PC-569, PC-570 FOR PC-AO-NRV21	
X-210A	18"	883'-4"	3' FROM 90'	18"	1	RHR LOOP A SYSTEM PUMP TEST LINE				X-229B	1"	877'-7 1/2"	6" FROM 22'30'	1"	1	VACUUM BREAKER ACTIVATING AIR				PC-571, PC-572 FOR PC-AO-NRV20	
										X-229C	1"	877'-7 1/2"	6" FROM 67'30'	1"	1	VACUUM BREAKER ACTIVATING AIR				PC-573, PC-574 FOR PC-AO-NRV23	
										X-229D	1"	877'-7 1/2"	6" FROM 67'30'	1"	1	VACUUM BREAKER ACTIVATING AIR				PC-575, PC-576 FOR PC-AO-NRV22	
										X-229E	1"	877'-7 1/2"	6" FROM 157'30'	1"	1	VACUUM BREAKER ACTIVATING AIR				PC-577, PC-578 FOR PC-AO-NRV25	
										X-229F	1"	877'-7 1/2"	6" FROM 157'30'	1"	1	VACUUM BREAKER ACTIVATING AIR				PC-579, PC-580 FOR PC-AO-NRV24	
										X-229G	1"	877'-7 1/2"	6" FROM 202'30'	1"	1	VACUUM BREAKER ACTIVATING AIR				PC-581, PC-582 FOR PC-AO-NRV27	
										X-229H	1"	877'-7 1/2"	6" FROM 202'30'	1"	1	VACUUM BREAKER ACTIVATING AIR				PC-583, PC-584 FOR PC-AO-NRV26	
										X-229J	1"	877'-7 1/2"	6" FROM 247'30'	1"	1	VACUUM BREAKER ACTIVATING AIR				PC-585, PC-586 FOR PC-AO-NRV29	
										X-229K	1"	877'-7 1/2"	6" FROM 247'30'	1"	1	VACUUM BREAKER ACTIVATING AIR				PC-587, PC-588 FOR PC-AO-NRV28	
										X-229L	1"	877'-7 1/2"	337'30'	1"	1	VACUUM BREAKER ACTIVATING AIR				PC-589, PC-590 FOR PC-AO-NRV30 &	
																				PC-AO-NRV31	
										X-229M	1"	877'-7 1/2"	1' FROM 337'30'	1"	1	SPARE	TYPE "A" TESTED				
										X-230	12"	885'-7 1/2"	8' FROM 112'30'	12"	1	LOW VOLTAGE POWER TO TORUS		ELEC. PENETR.			
										X-300A	1 1/4"	869'-8 1/2"	4'-3" FROM 22'30'	1 1/4"	1	TORUS TEMP. MONITORING					
										X-300B	1 1/4"	869'-8 1/2"	5'-3" FROM 22'30'	1 1/4"	1	TORUS TEMP. MONITORING					
										X-300C	1 1/4"	869'-8 1/2"	4'-3" FROM 67'30'	1 1/4"	1	TORUS TEMP. MONITORING					
										X-300D	1 1/4"	869'-8 1/2"	5'-3" FROM 67'30'	1 1/4"	1	TORUS TEMP. MONITORING					
										X-300E	1 1/4"	869'-8 1/2"	4'-3" FROM 112'30'	1 1/4"	1	TORUS TEMP. MONITORING					
										X-300F	1 1/4"	869'-8 1/2"	5'-3" FROM 112'30'	1 1/4"	1	TORUS TEMP. MONITORING					
										X-300G	1 1/4"	869'-8 1/2"	4'-3" FROM 157'30'	1 1/4"	1	TORUS TEMP. MONITORING					
										X-300H	1 1/4"	869'-8 1/2"	5'-3" FROM 157'30'	1 1/4"	1	TORUS TEMP. MONITORING					
										X-300I	1 1/4"	869'-8 1/2"	4'-3" FROM 202'30'	1 1/4"	1	TORUS TEMP. MONITORING					
										X-300J	1 1/4"	869'-8 1/2"	5'-3" FROM 202'30'	1 1/4"	1	TORUS TEMP. MONITORING					
										X-300K	1 1/4"	869'-8 1/2"	4'-3" FROM 247'30'	1 1/4"	1	TORUS					




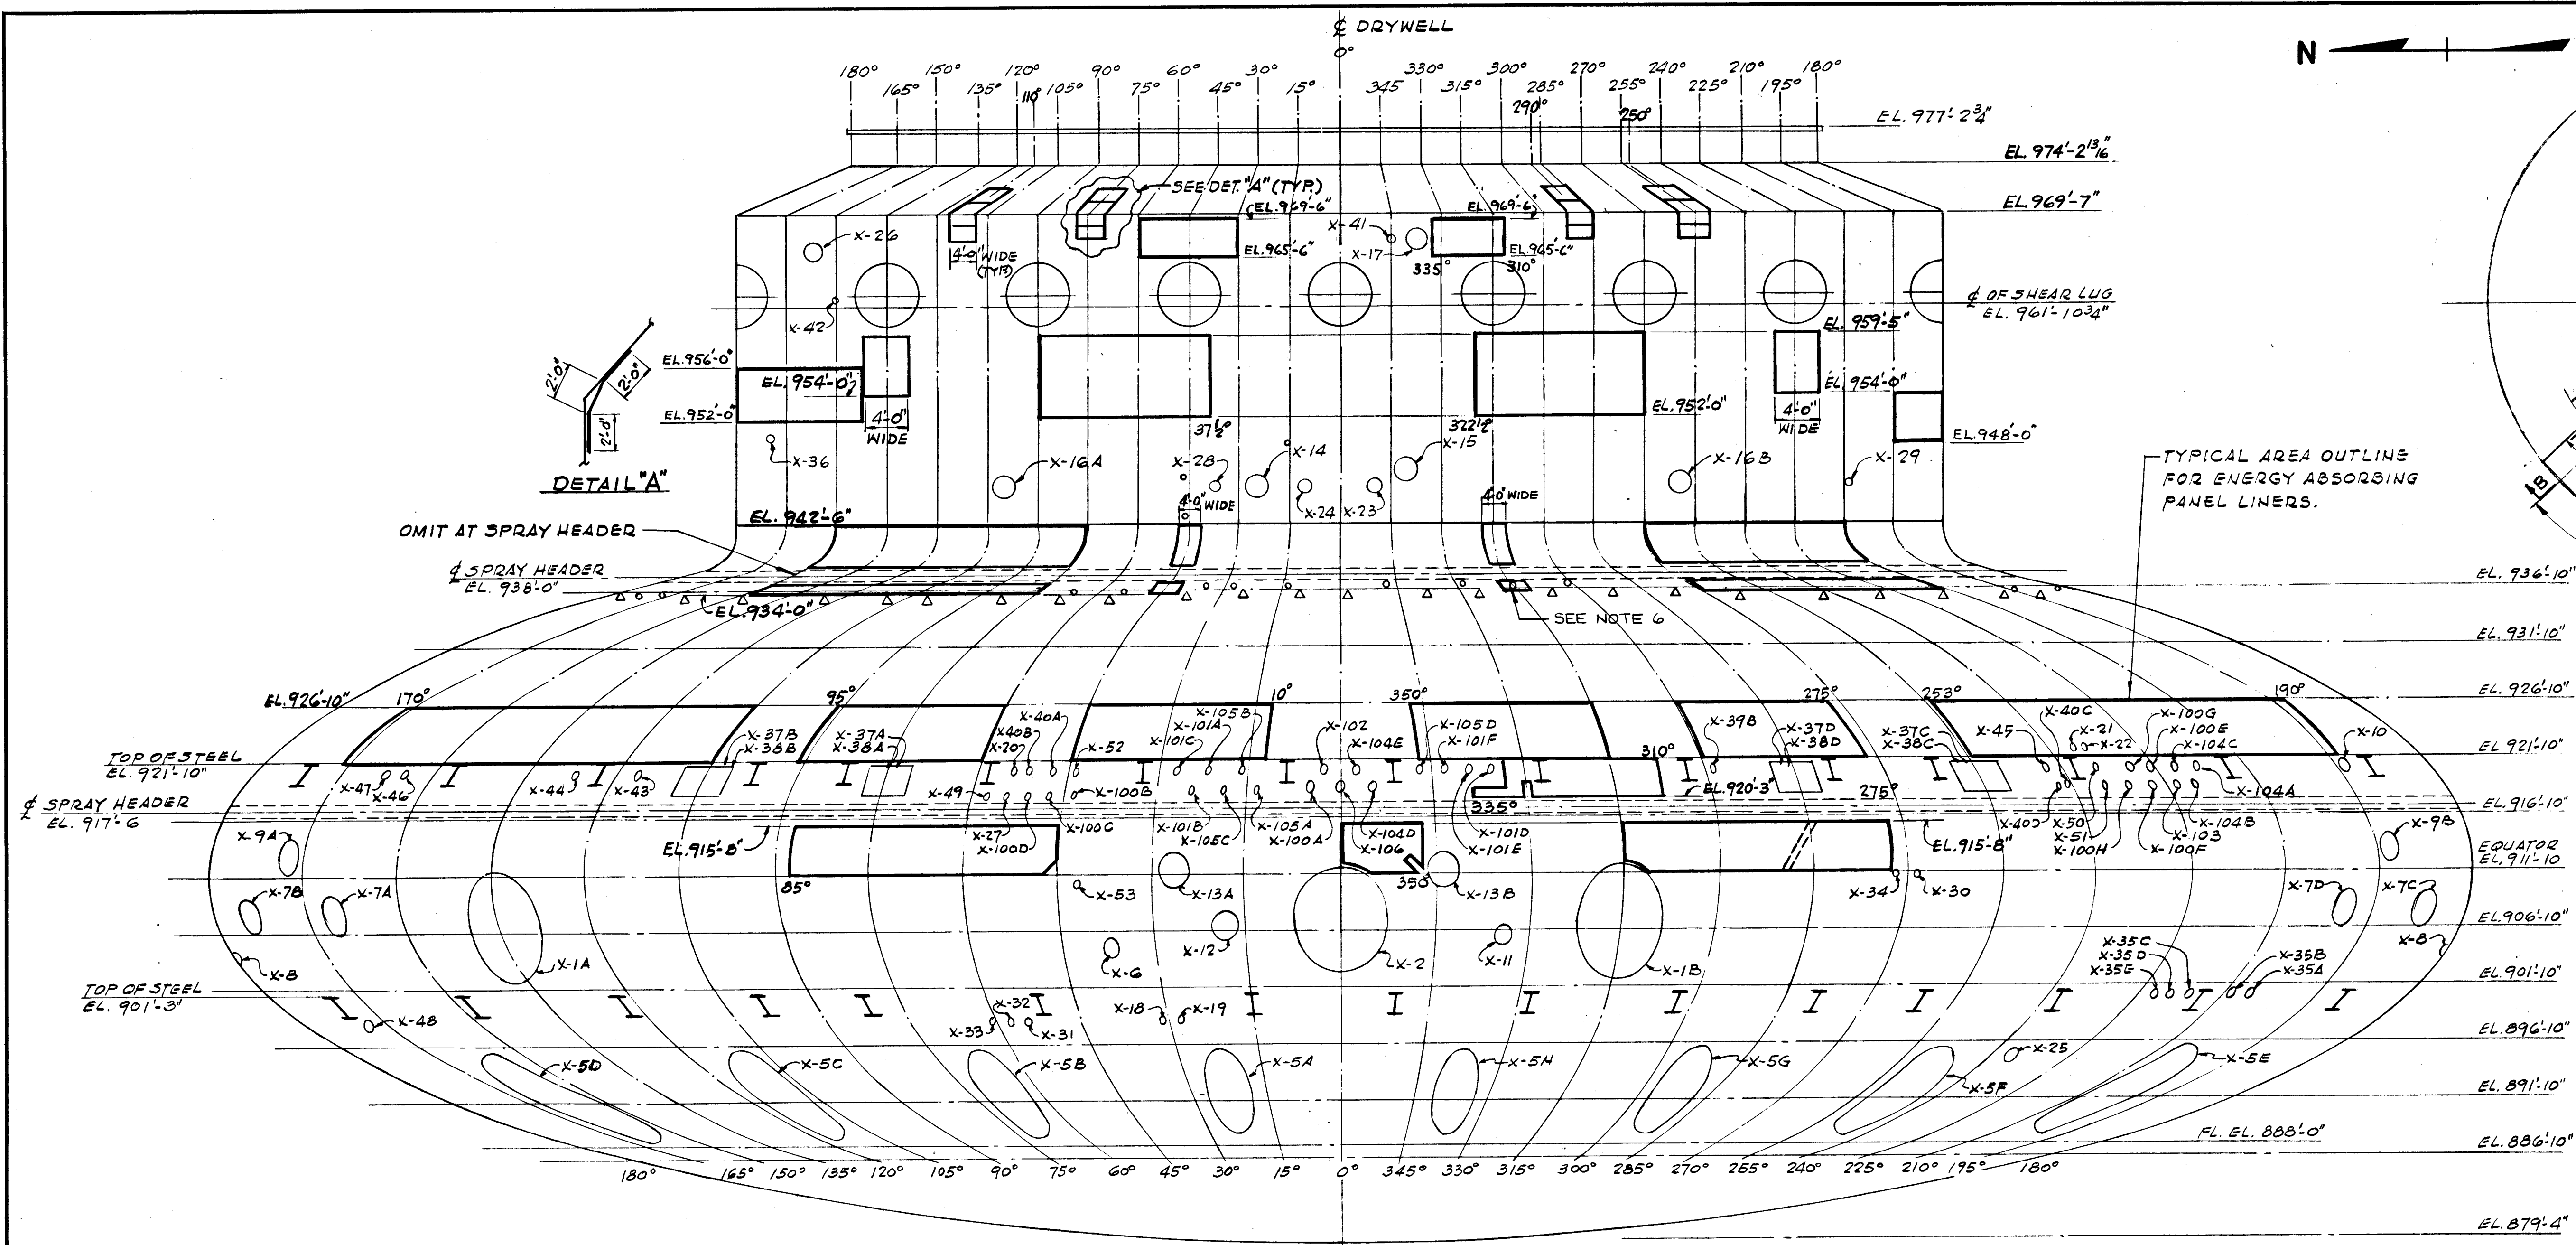


STRETCHOUT VIEW OF OUTSIDE OF DRYWELL

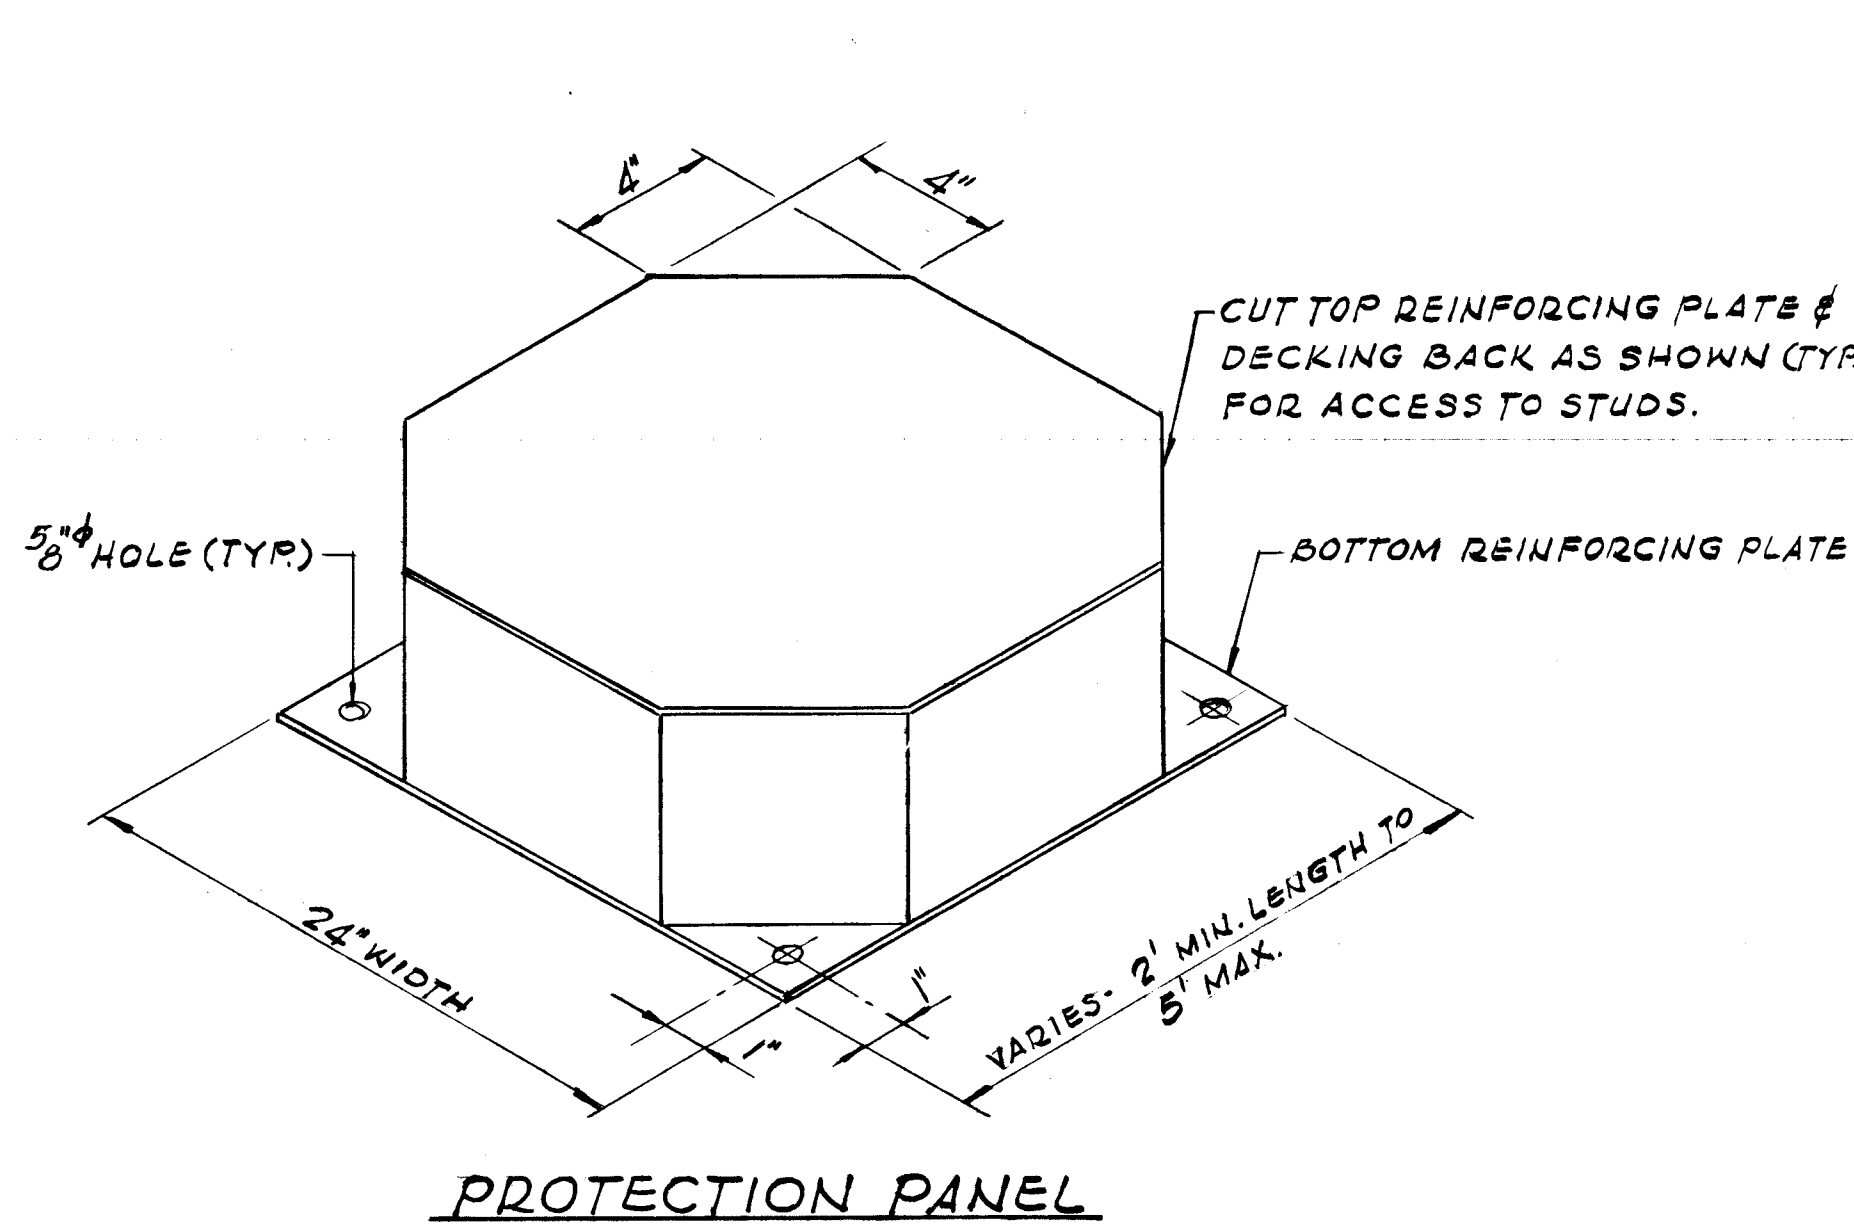


PROTECTION PANEL

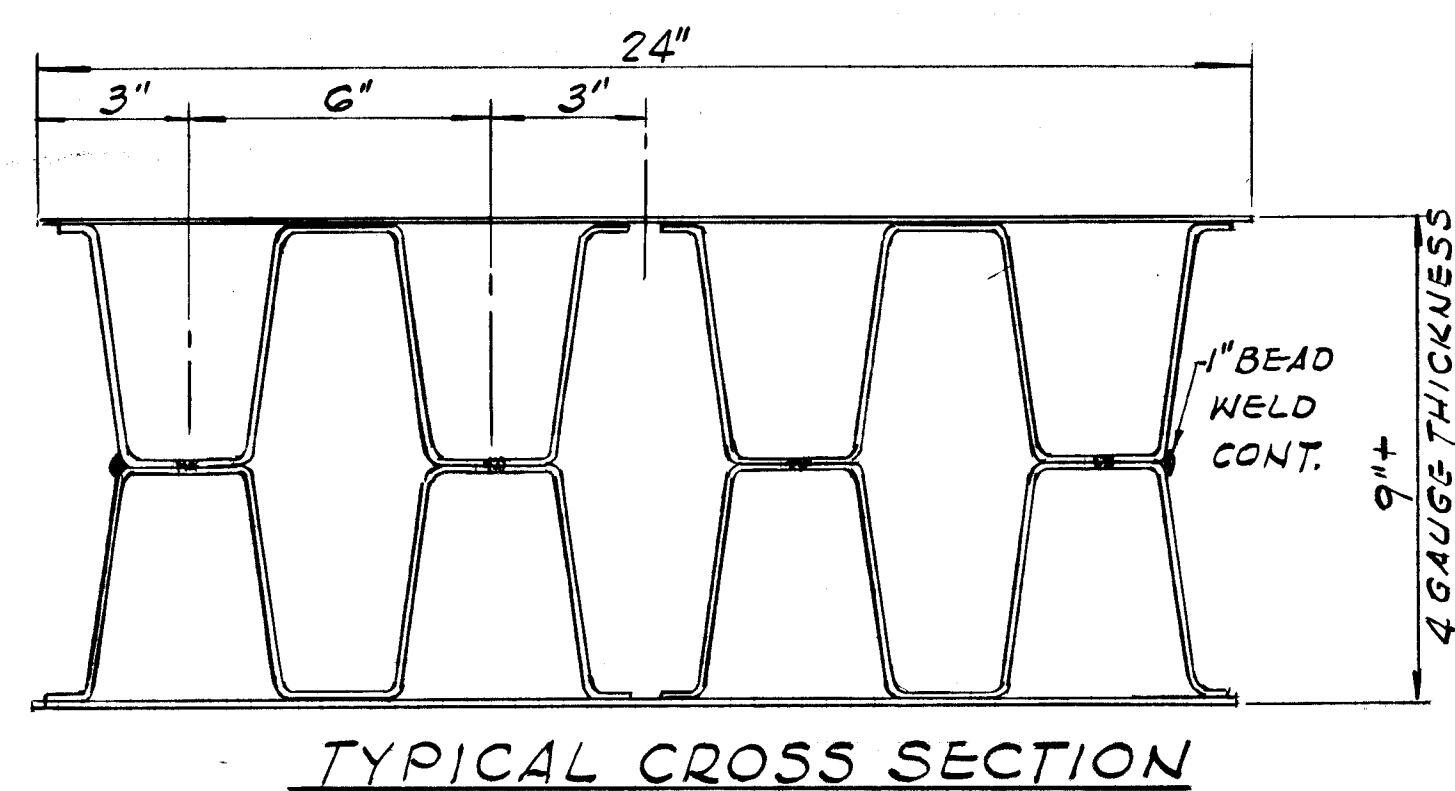


TYPICAL CROSS SECTION

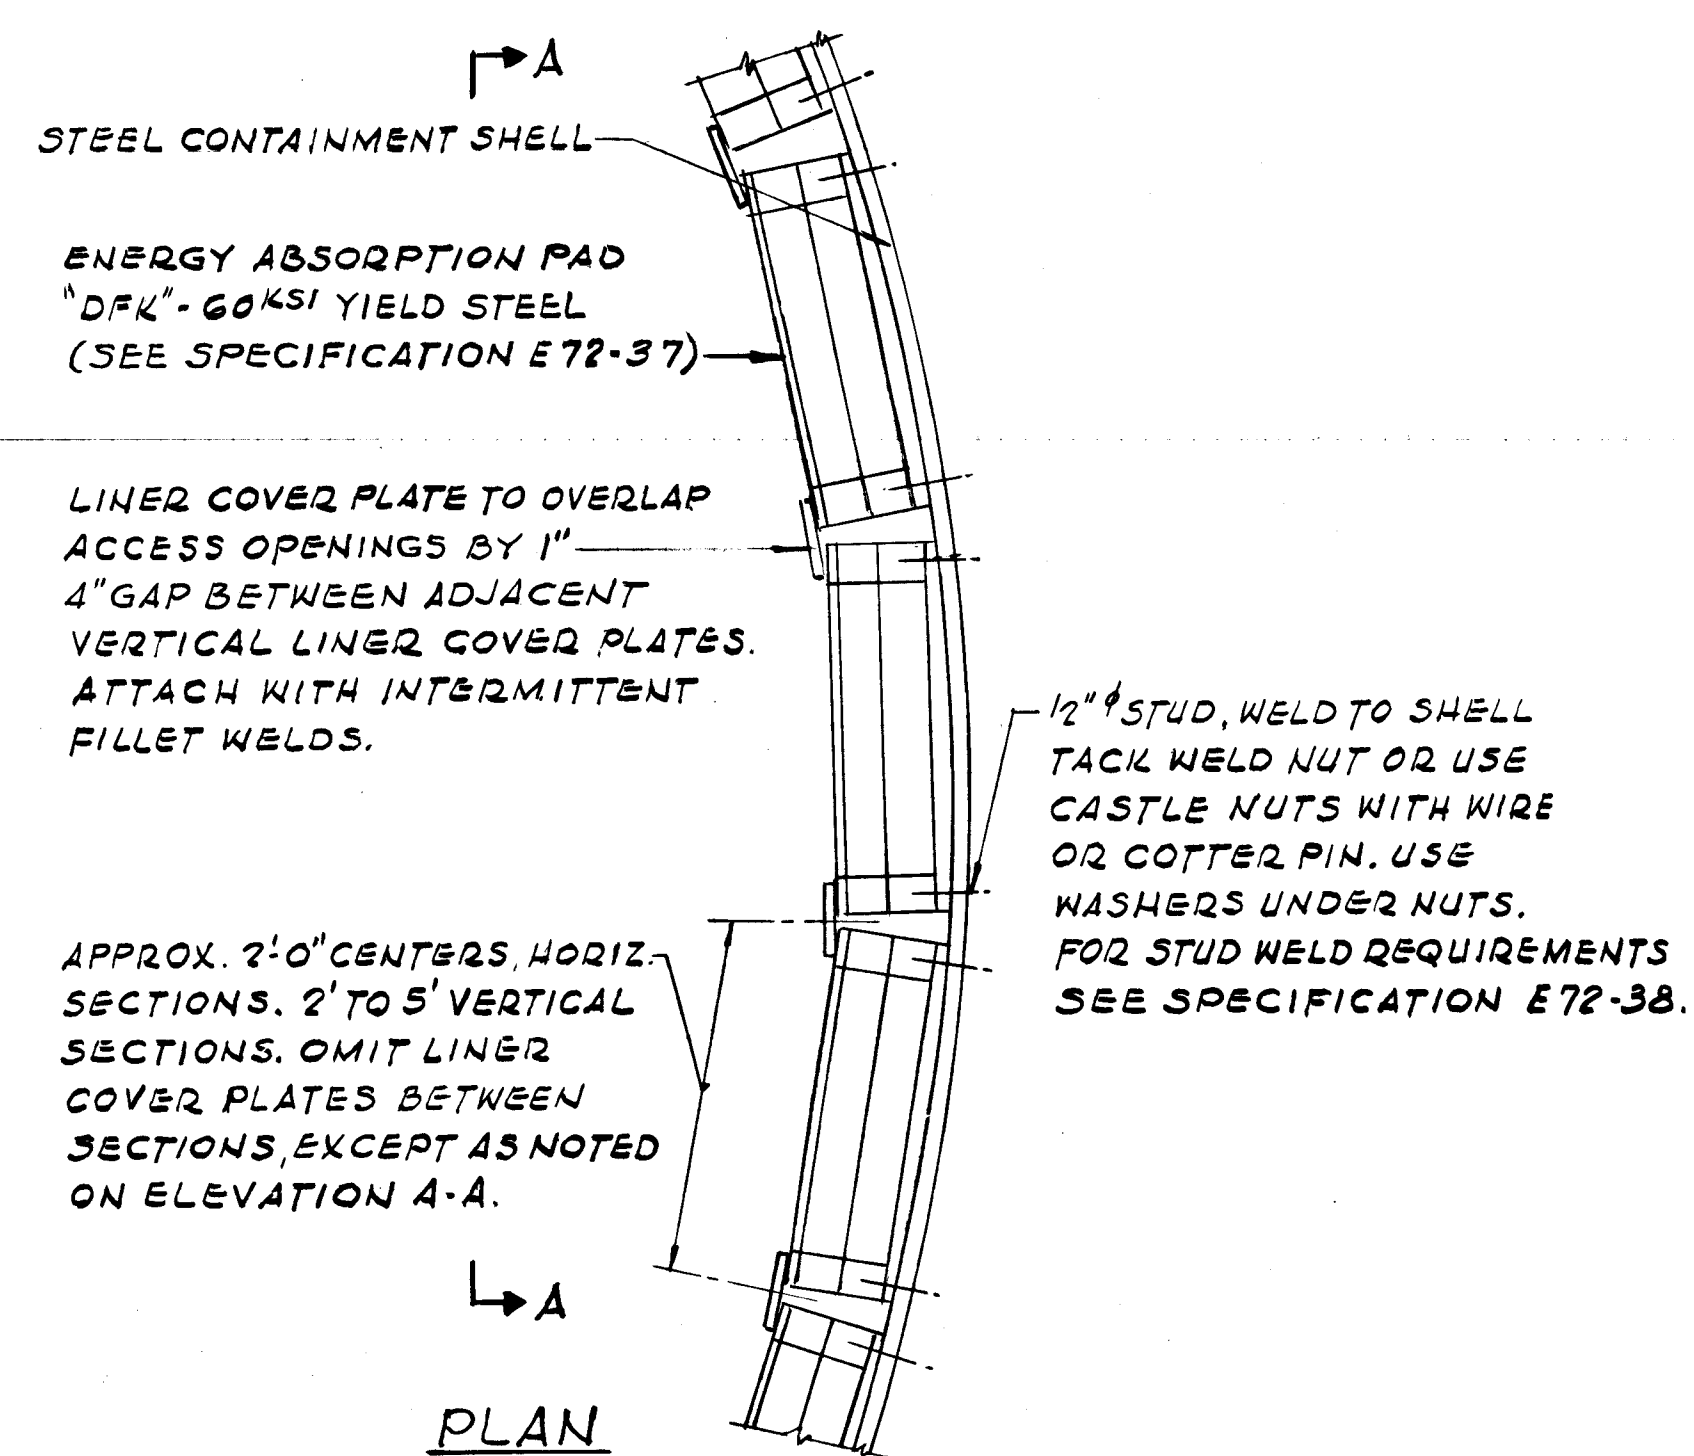


SUGGESTED SECTION THRU SPHERE SEGMENT OF CONTAINMENT VESSEL

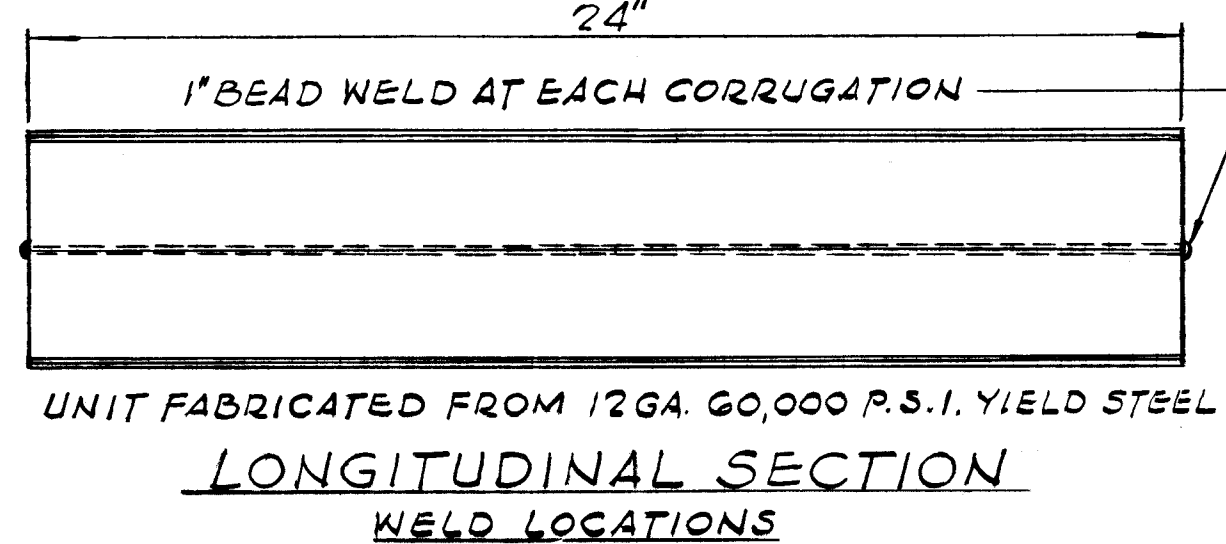


LONGITUDINAL SECTION WELD LOCATIONS

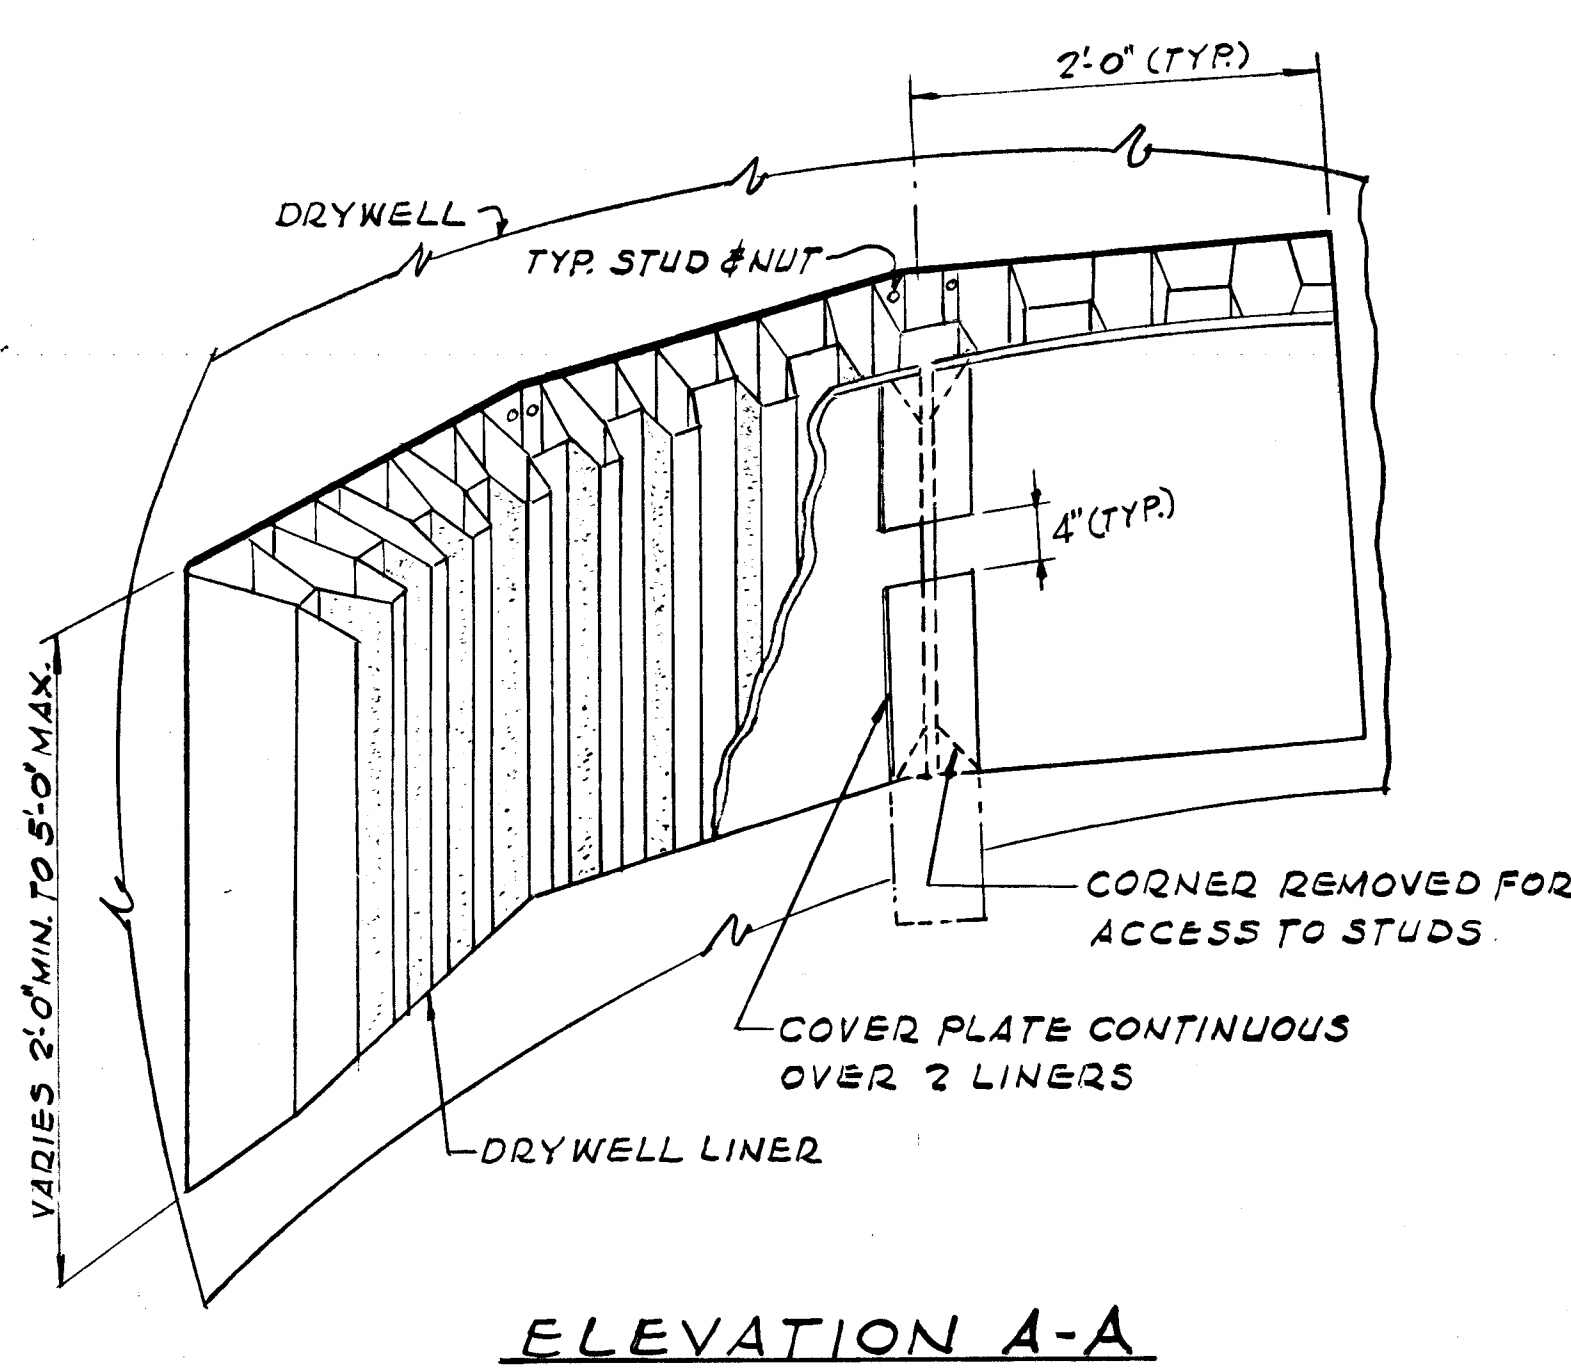

ELEVATION A-A

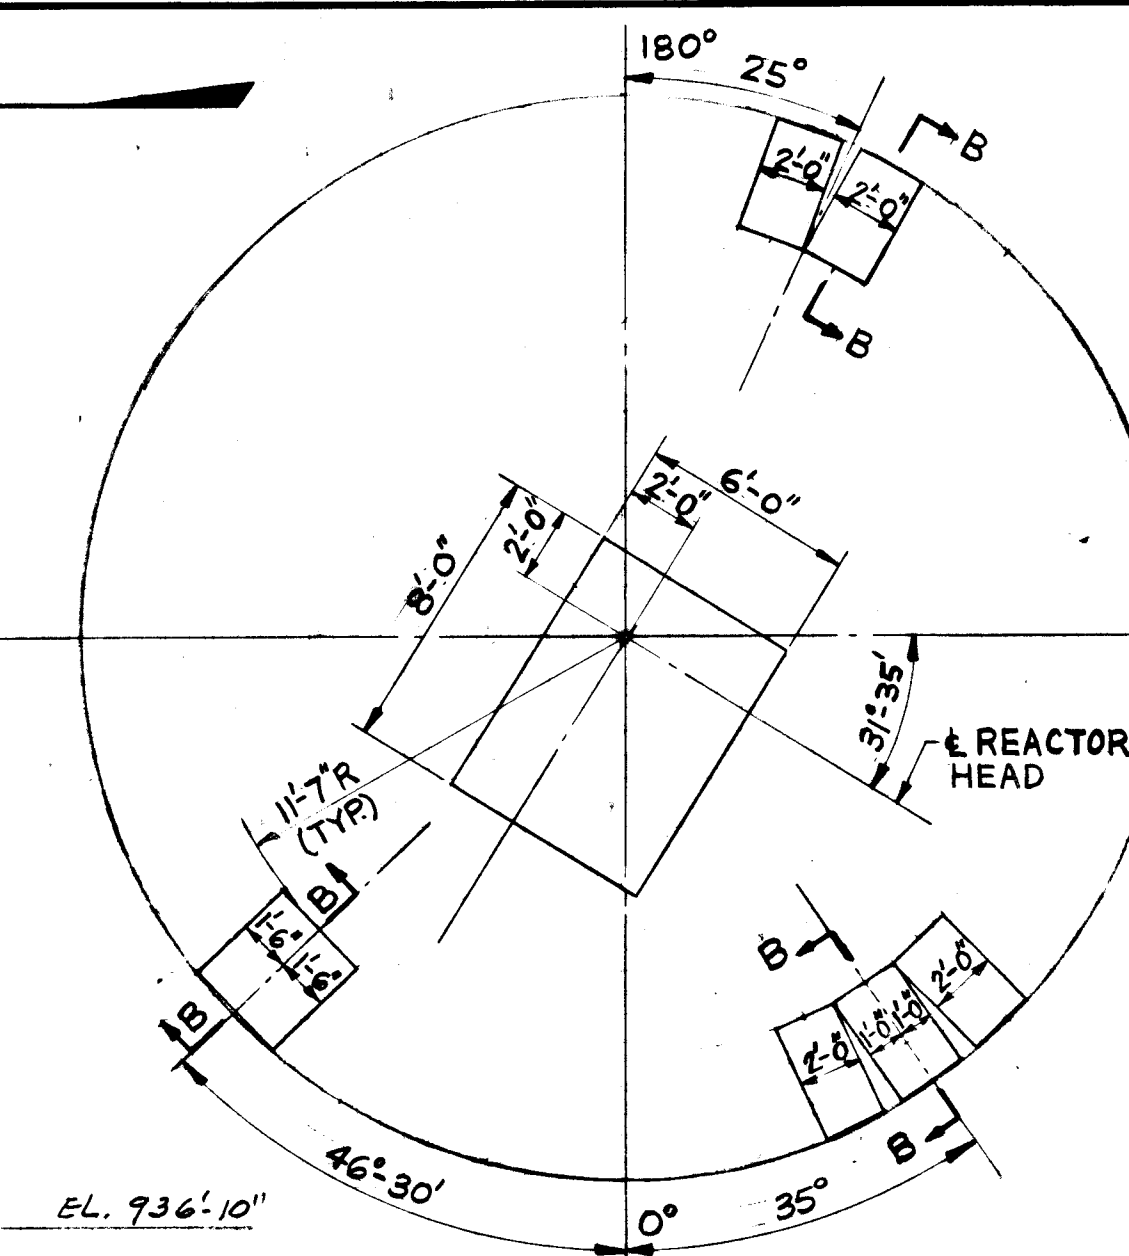

DRYWELL HEAD ADDITIONAL PANELS

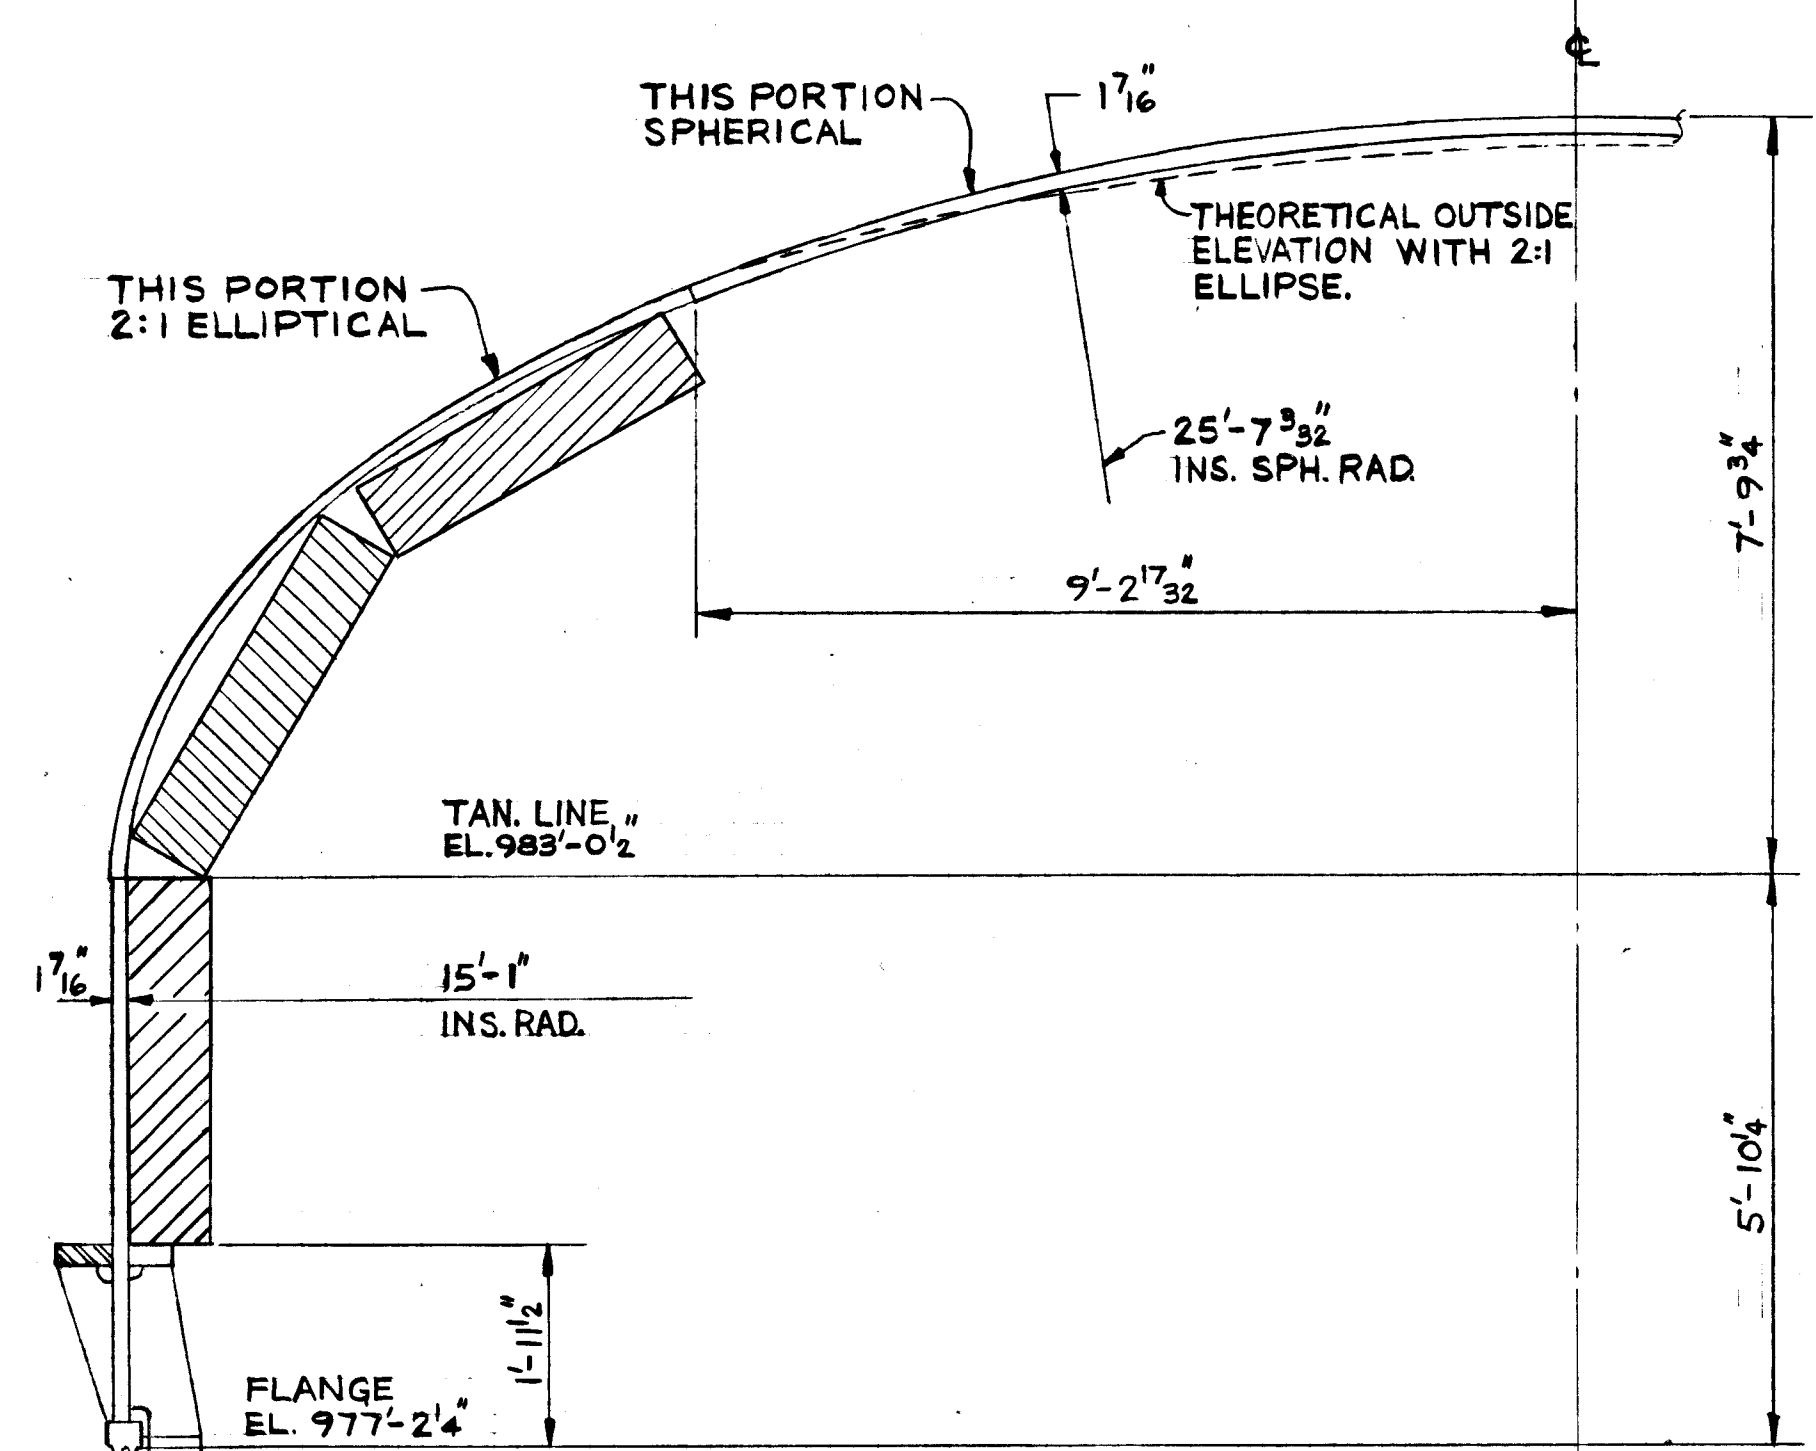

SECTION B-B

- NOTES:
1. LOCAL PANEL INTERFERENCES WITH PIPING, DUCTWORK, STRUCTURAL STEEL AND ELECTRICAL CONDUIT HAVE NOT BEEN NOTED ON DRAWING. CONTRACTOR SHALL FOLLOW REQUIREMENTS OUTLINED IN SPECIFICATION E72-37 PARAGRAPH 3.1 RELATIVE TO THIS MATTER.
  2. PANELS REQUIRED TO BE CUT IN FIELD SHALL BE REPAIRED TO RE-ESTABLISH ITS STRUCTURAL INTEGRITY.
  3. PANELS NOTCHED TO ALLOW FOR S/RV SUPPORTS AS SHOWN ON STRETCHOUT VIEW AT AZIMUTH 50°, ELEVATION 912'-0", AZIMUTH 350°, ELEVATION 920'-0" AND AZIMUTH 350°, ELEV. 912'-0". S/RV SUPPORTS AT AZIMUTH 85°, ELEV. 915'-8" AND AZIMUTH 50° ELEV. 912'-0".
  4. PANEL CORRUPTION REMOVED AS SHOWN AT AZIMUTH 290° ELEVATION 912'-0", COVER PLATE REMAINS.
  5. HOLE CUT IN ENERGY ABSORBING PANEL FOR RIGGING PAD. SEE CBI DRAWING NO. 106A2-1.
  6. ENERGY ABSORBER FRAMES HAVE BEEN TRIMMED FOR TWO (VR) PIPING SUPPORTS. SEE VR-H50 AND VR-H59 SUPPORT DRAWINGS FOR DETAILS.

SPHERICAL DIAMETER = 65'-0"  
CYLINDRICAL DIAMETER = 35'-7"  
DIAMETER @ EL. 977'-2 3/4" = 30'-2"

- SEE CBI ER 94, ER 95, ER 96 PAD ON INSIDE OF CONTAINMENT FOR RIGGING.
- SEE CBI CONTRACT DWG. 3 PAD ON INSIDE OF CONTAINMENT FOR SCAFFOLD.

FOR CONSTRUCTION



BURNS AND ROE, INC.  
ENGINEERS AND CONSTRUCTORS  
ORADELL, N. J. HEMPSTEAD, N. Y. LOS ANGELES, CALIF.

ENERGY ABSORBING  
PANEL LINER LOCATIONS  
CONSUMERS PUBLIC POWER DISTRICT  
COOPER NUCLEAR STATION


DRAWN BY J. M. W. CHECKED BY R. C. WOOD  
DATE 7-21-73 SCALE 1/4" = 1'-0"  
APPROVED FOR CONSTRUCTION  
W. O. 2520  
FOR CHIEF CIVIL ENGINEER DWG. 4286

454004654


REV.	DATE	BY	CHKD.	APP.	DATE
1	1/5/73	R. C. W.	R. C. W.		2/1/73
2	12/1/72	R. C. W.	R. C. W.		12/1/72

NO.	REVISIONS	BY	CHKD.	DATE
1	DCN REVISIONS BY N.P.P.D.			

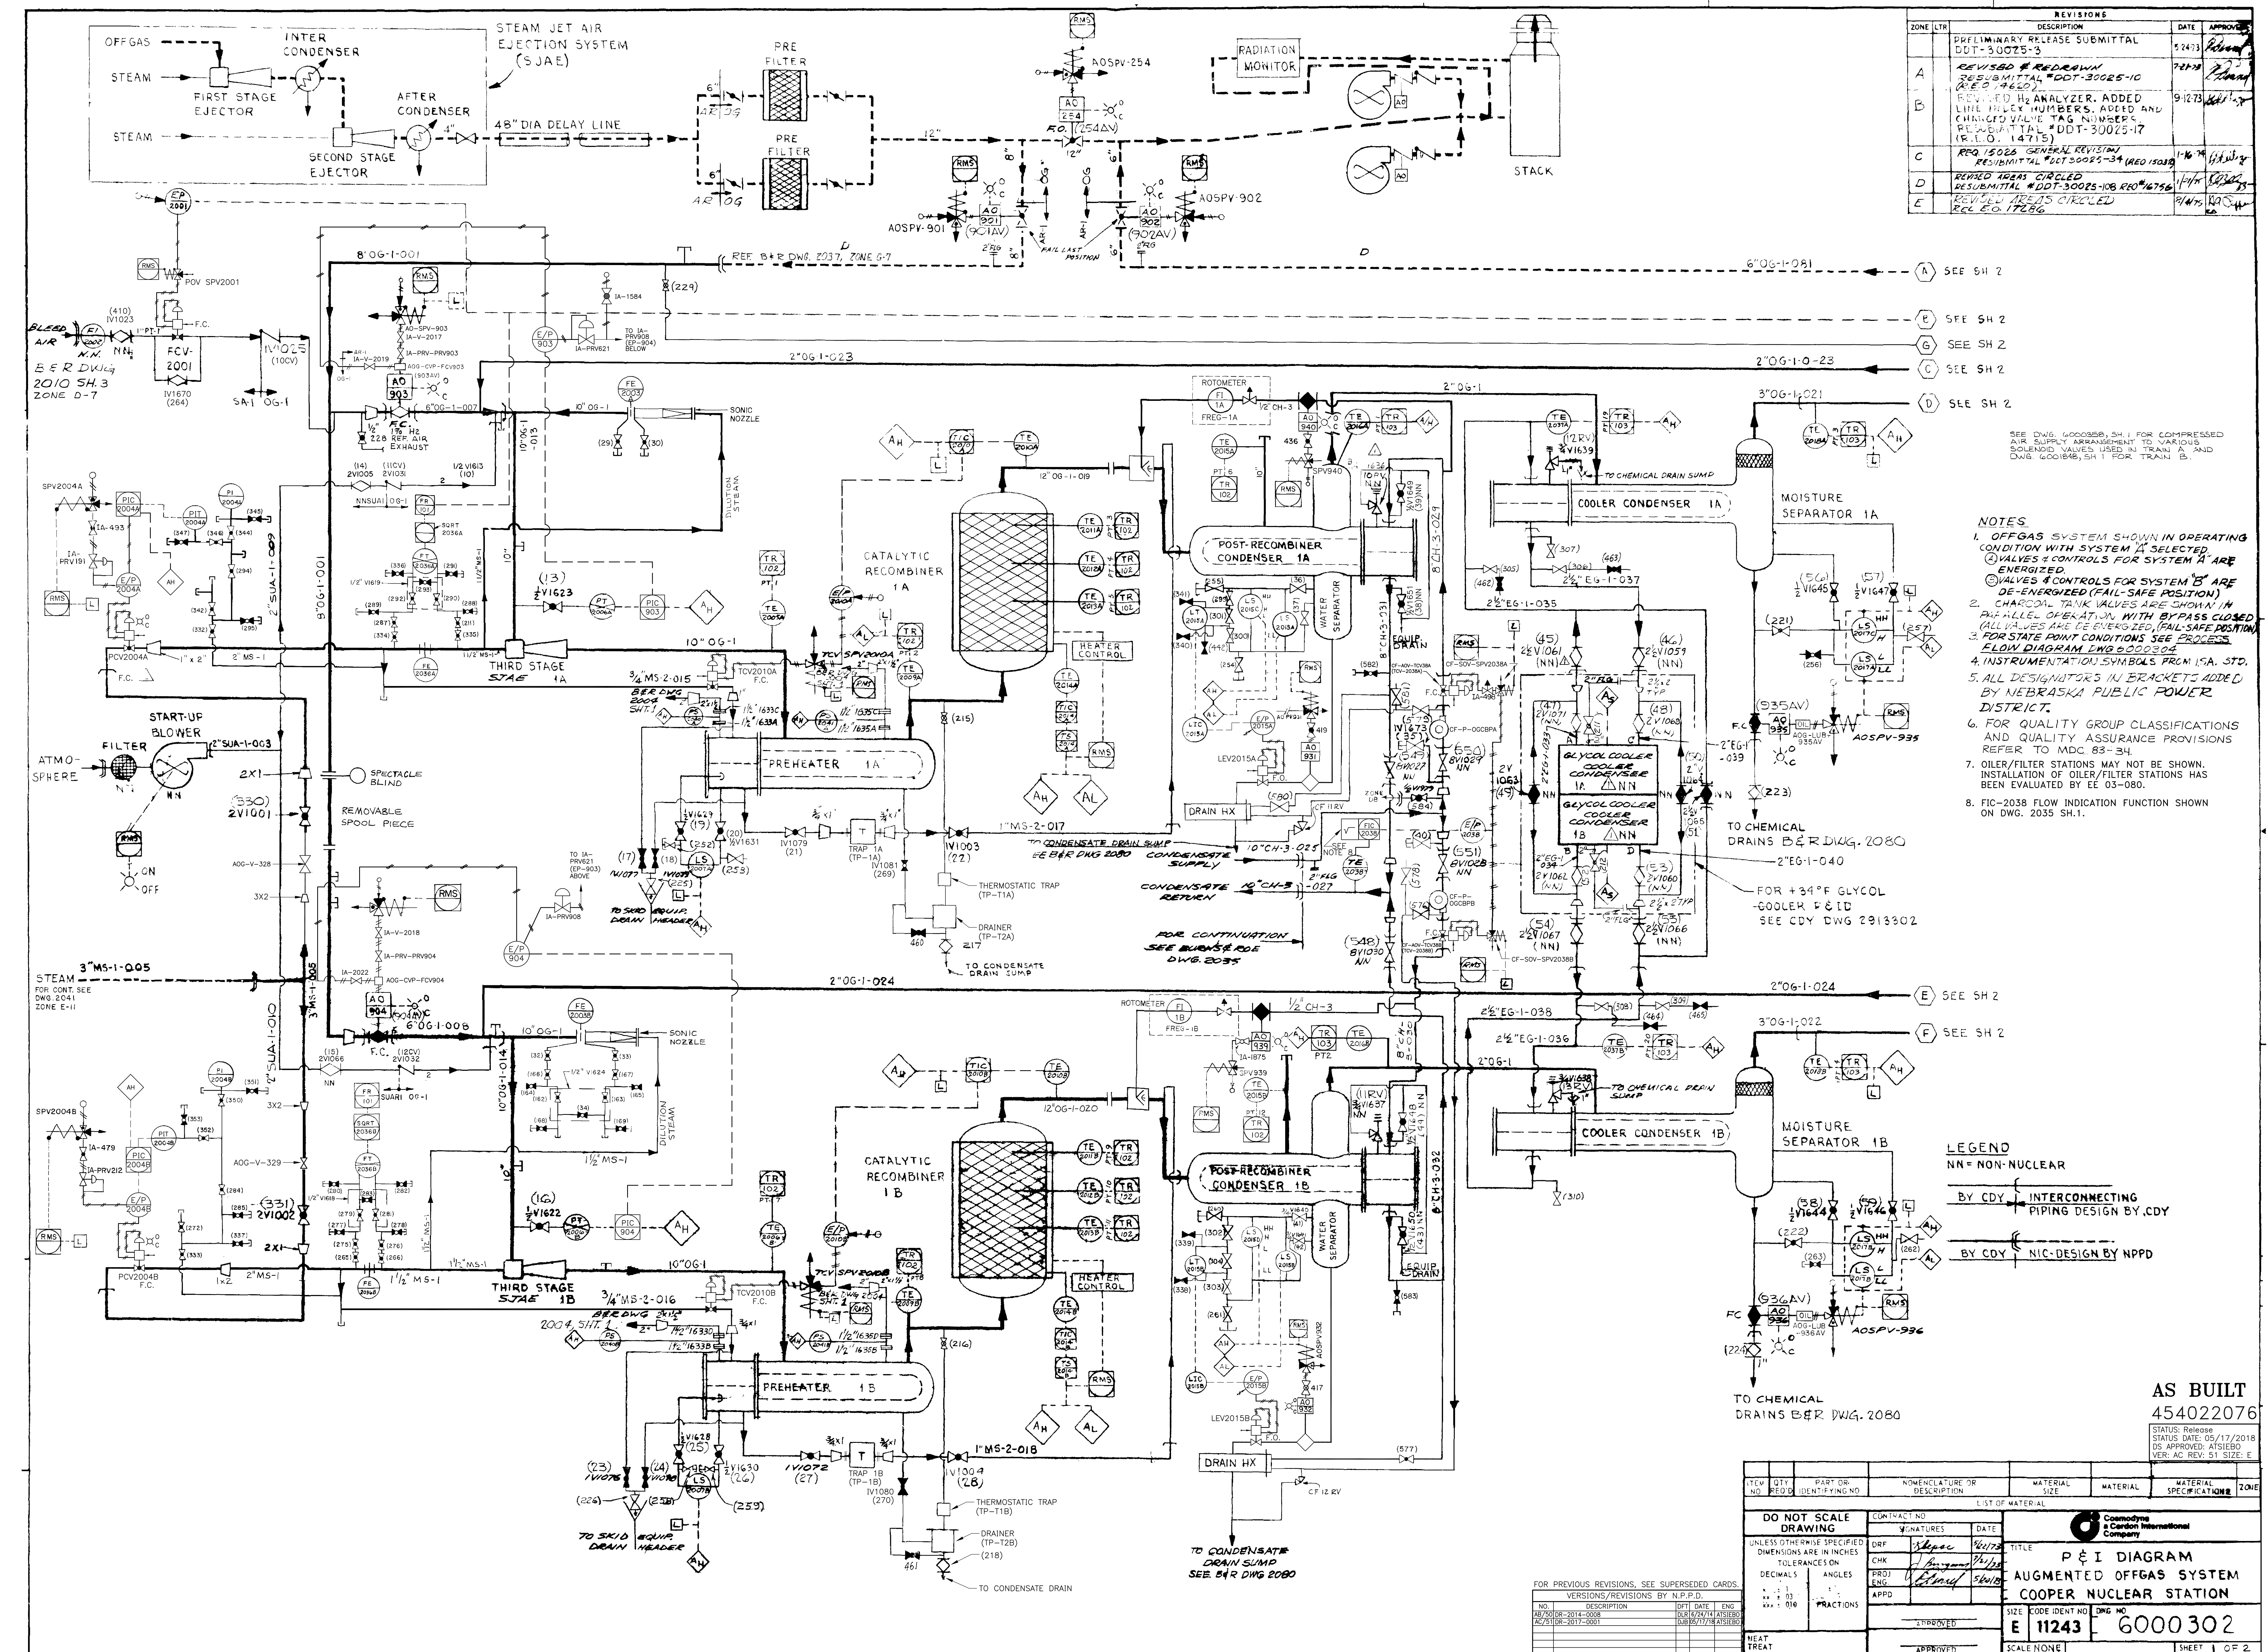




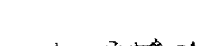




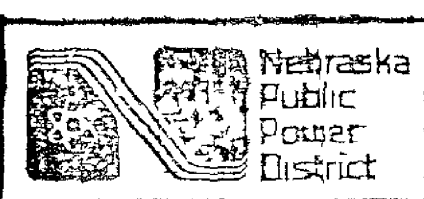




SCAN/CADD DWG
DO NOT REVISE MANUALLY
CADD FILE: C0036840

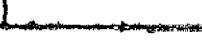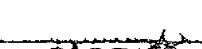						GARD FILE: C0036840		
ITEM NO.	QTY REQ'D	PART OR IDENTIFYING NO.	NOMENCLATURE OR DESCRIPTION	MATERIAL SIZE	MATERIAL	MATERIAL SPECIFICATION	QTY REQ'D	
LIST OF MATERIAL								
DO NOT SCALE DRAWING			CONTRACT NO. E-72-17A		 Crescentine Corporation International Company			
UNLESS OTHERWISE SPECIFIED DIMENSIONS ARE IN INCHES			SIGNATURES		DATE		TITLE	
TOLERANCES ON			DRF		11/2/73		P & I DIAGRAM	
DECIMALS			CHK		7/1/74		AUGMENTED OFFGAS SYSTEM	
ANGLES			PROJ		5/20/74		COOPER NUCLEAR STATION	
FRACTIONS			ENG					
X = .001 Y = .002 Z = .003 XXX = .010			APP'D					
								
								
								
								
								
								


---

---








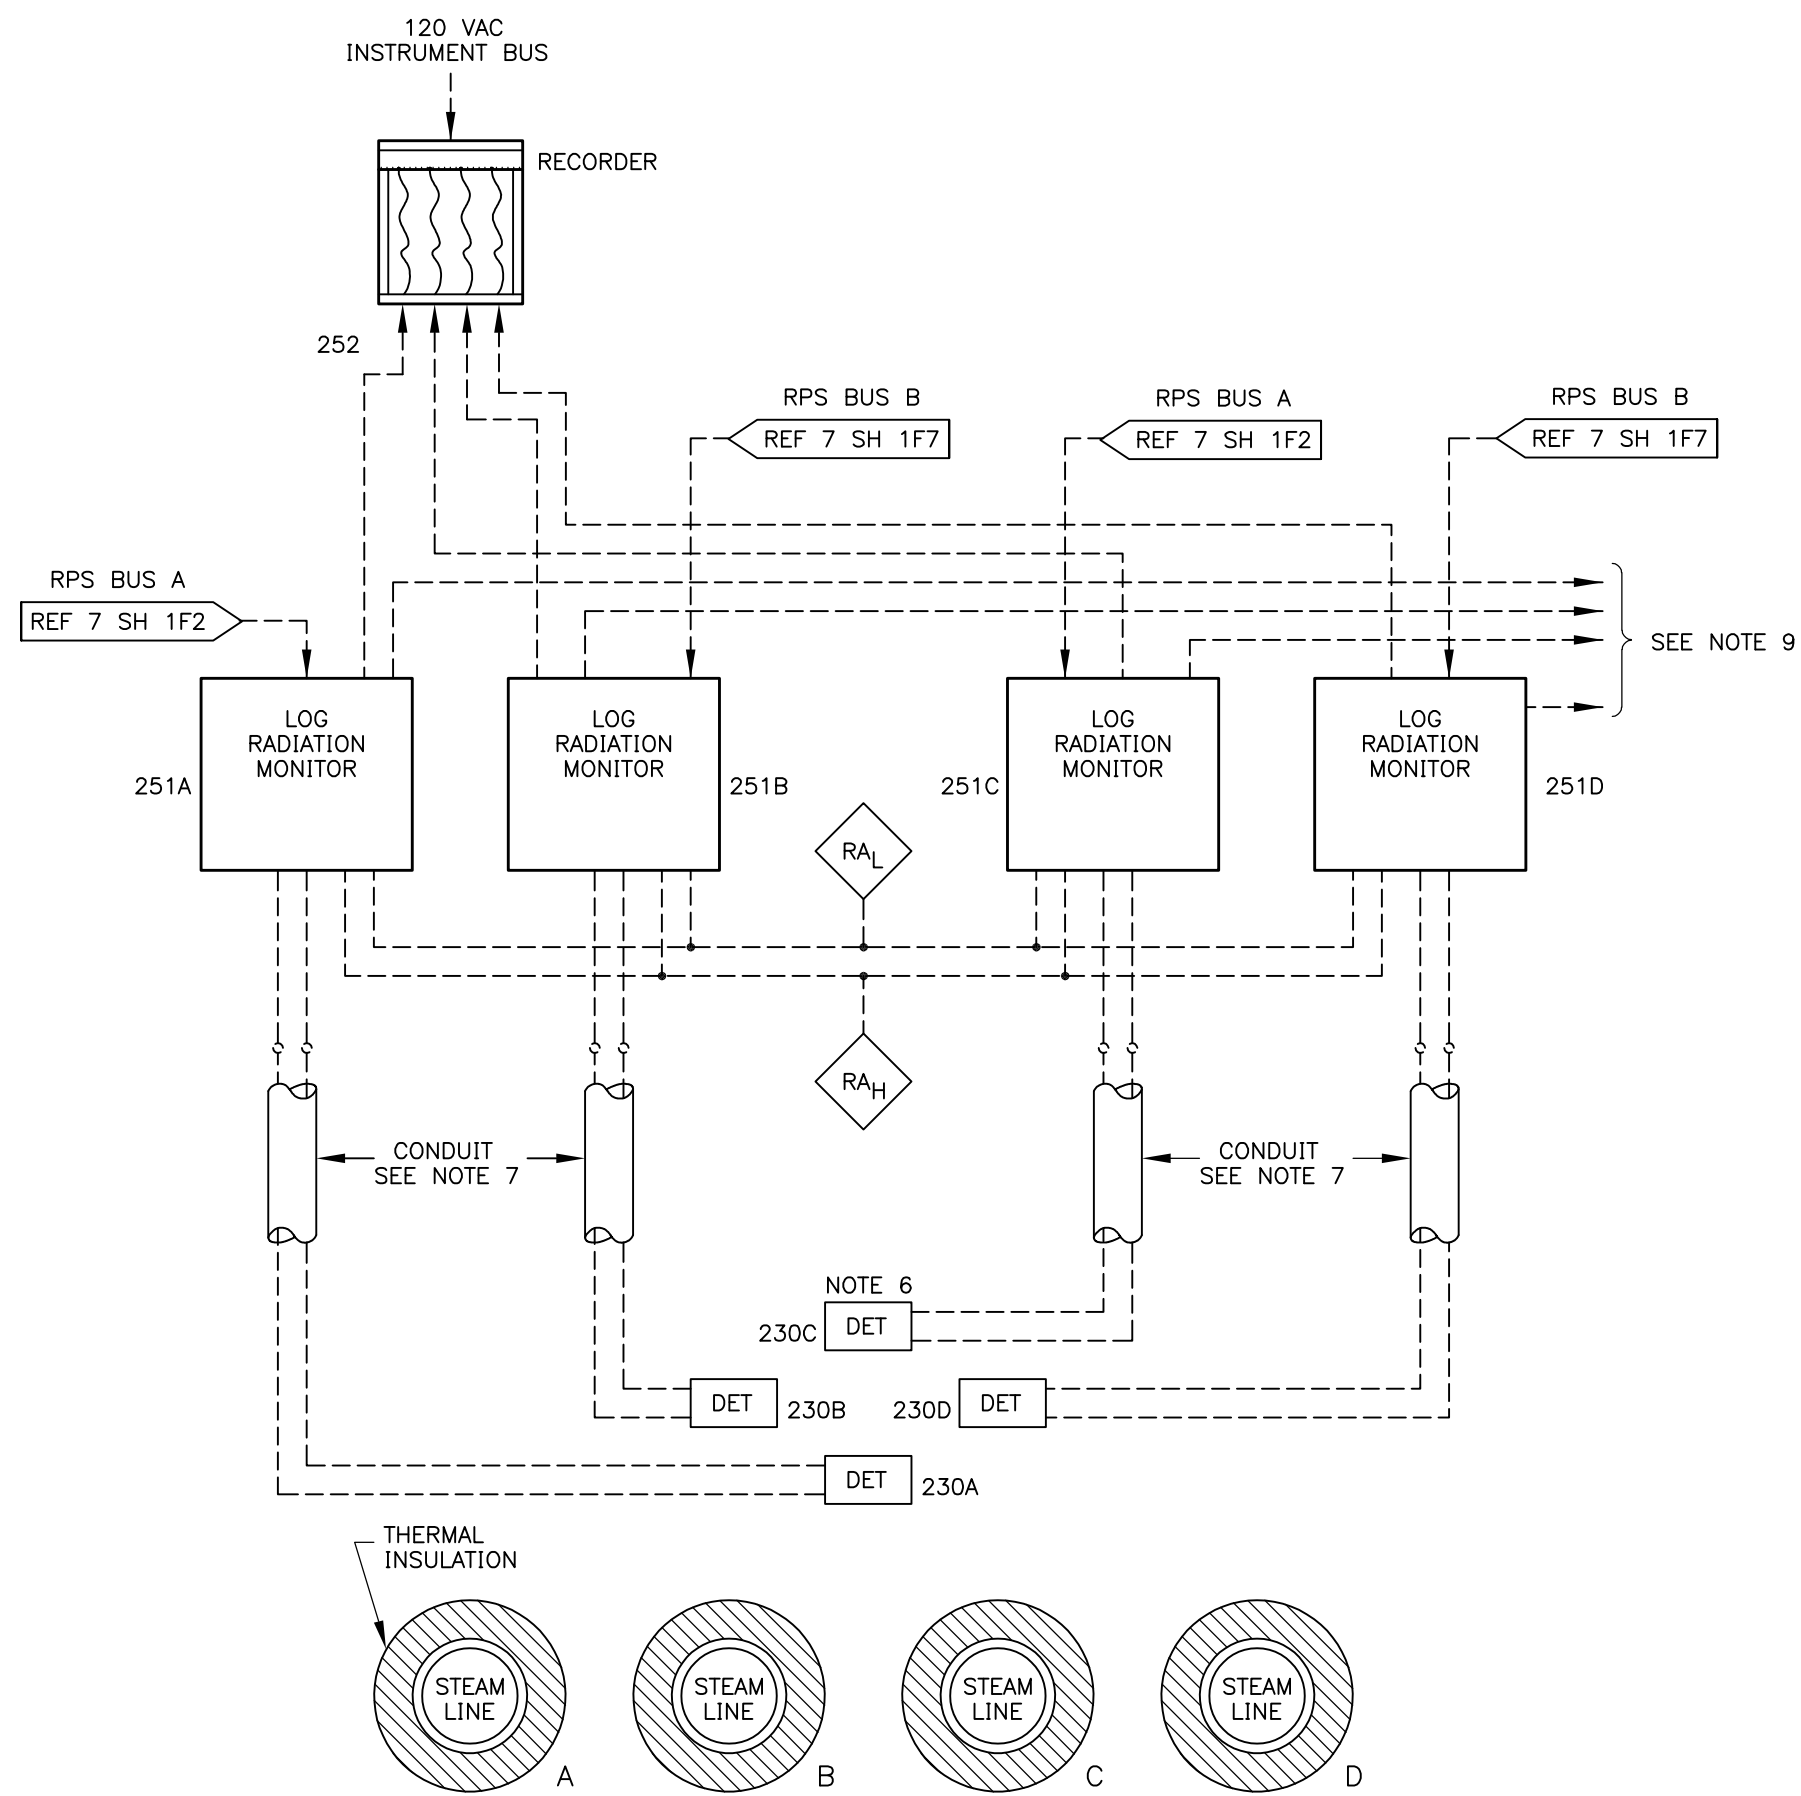


MAIN STEAM LINE RADIATION MONITORS

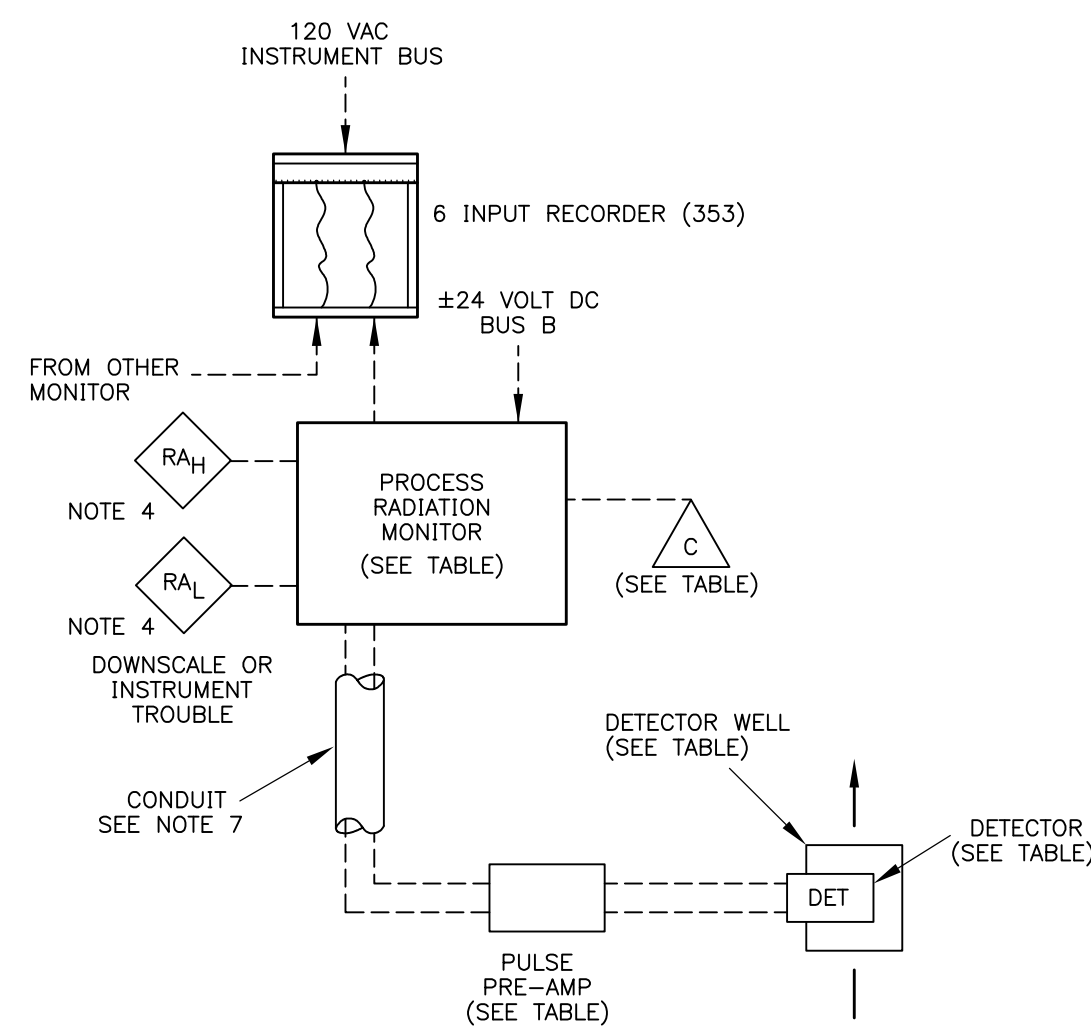


PART DESCRIPTION	REACTOR BUILDING CLOSED COOLING EFFLUENT MONITOR	LOCATION
DETECTOR WELL	302	PROCESS PIPE
DETECTOR	334	PROCESS PIPE
PULSE PRE-AMP	335	LOCAL AREA
PROCESS RAD MONITOR	352	MAIN CONTROL ROOM
RECORDER	353	MAIN CONTROL ROOM
PMIS POINT	N400	MUX CAB 9-80

REACTOR BUILDING CLOSED COOLING LIQUID PROCESS RADIATION MONITOR

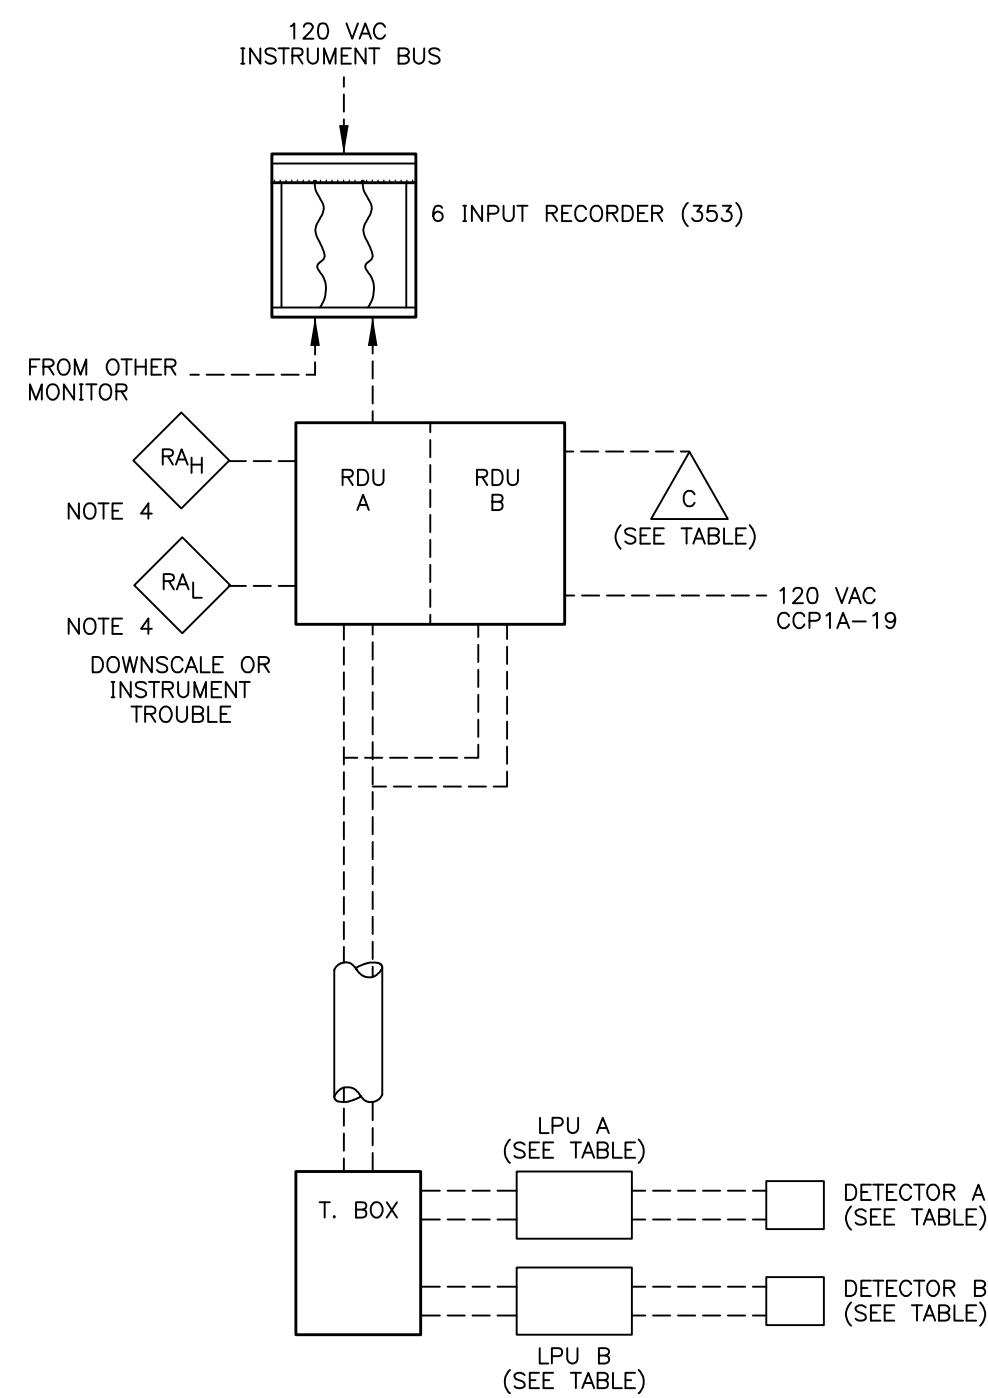

PART DESCRIPTION	SERVICE WATER EFFLUENT MONITOR	LOCATION
DETECTOR	332A, 332B	PROCESS PIPE
LPU	332A, 332B	LOCAL AREA
RDU	351A, 351B	MAIN CONTROL ROOM
RECORDER	353	MAIN CONTROL ROOM
PMIS POINT	N056, N057	MUX CAB 9-80


SERVICE WATER LIQUID PROCESS RADIATION MONITOR

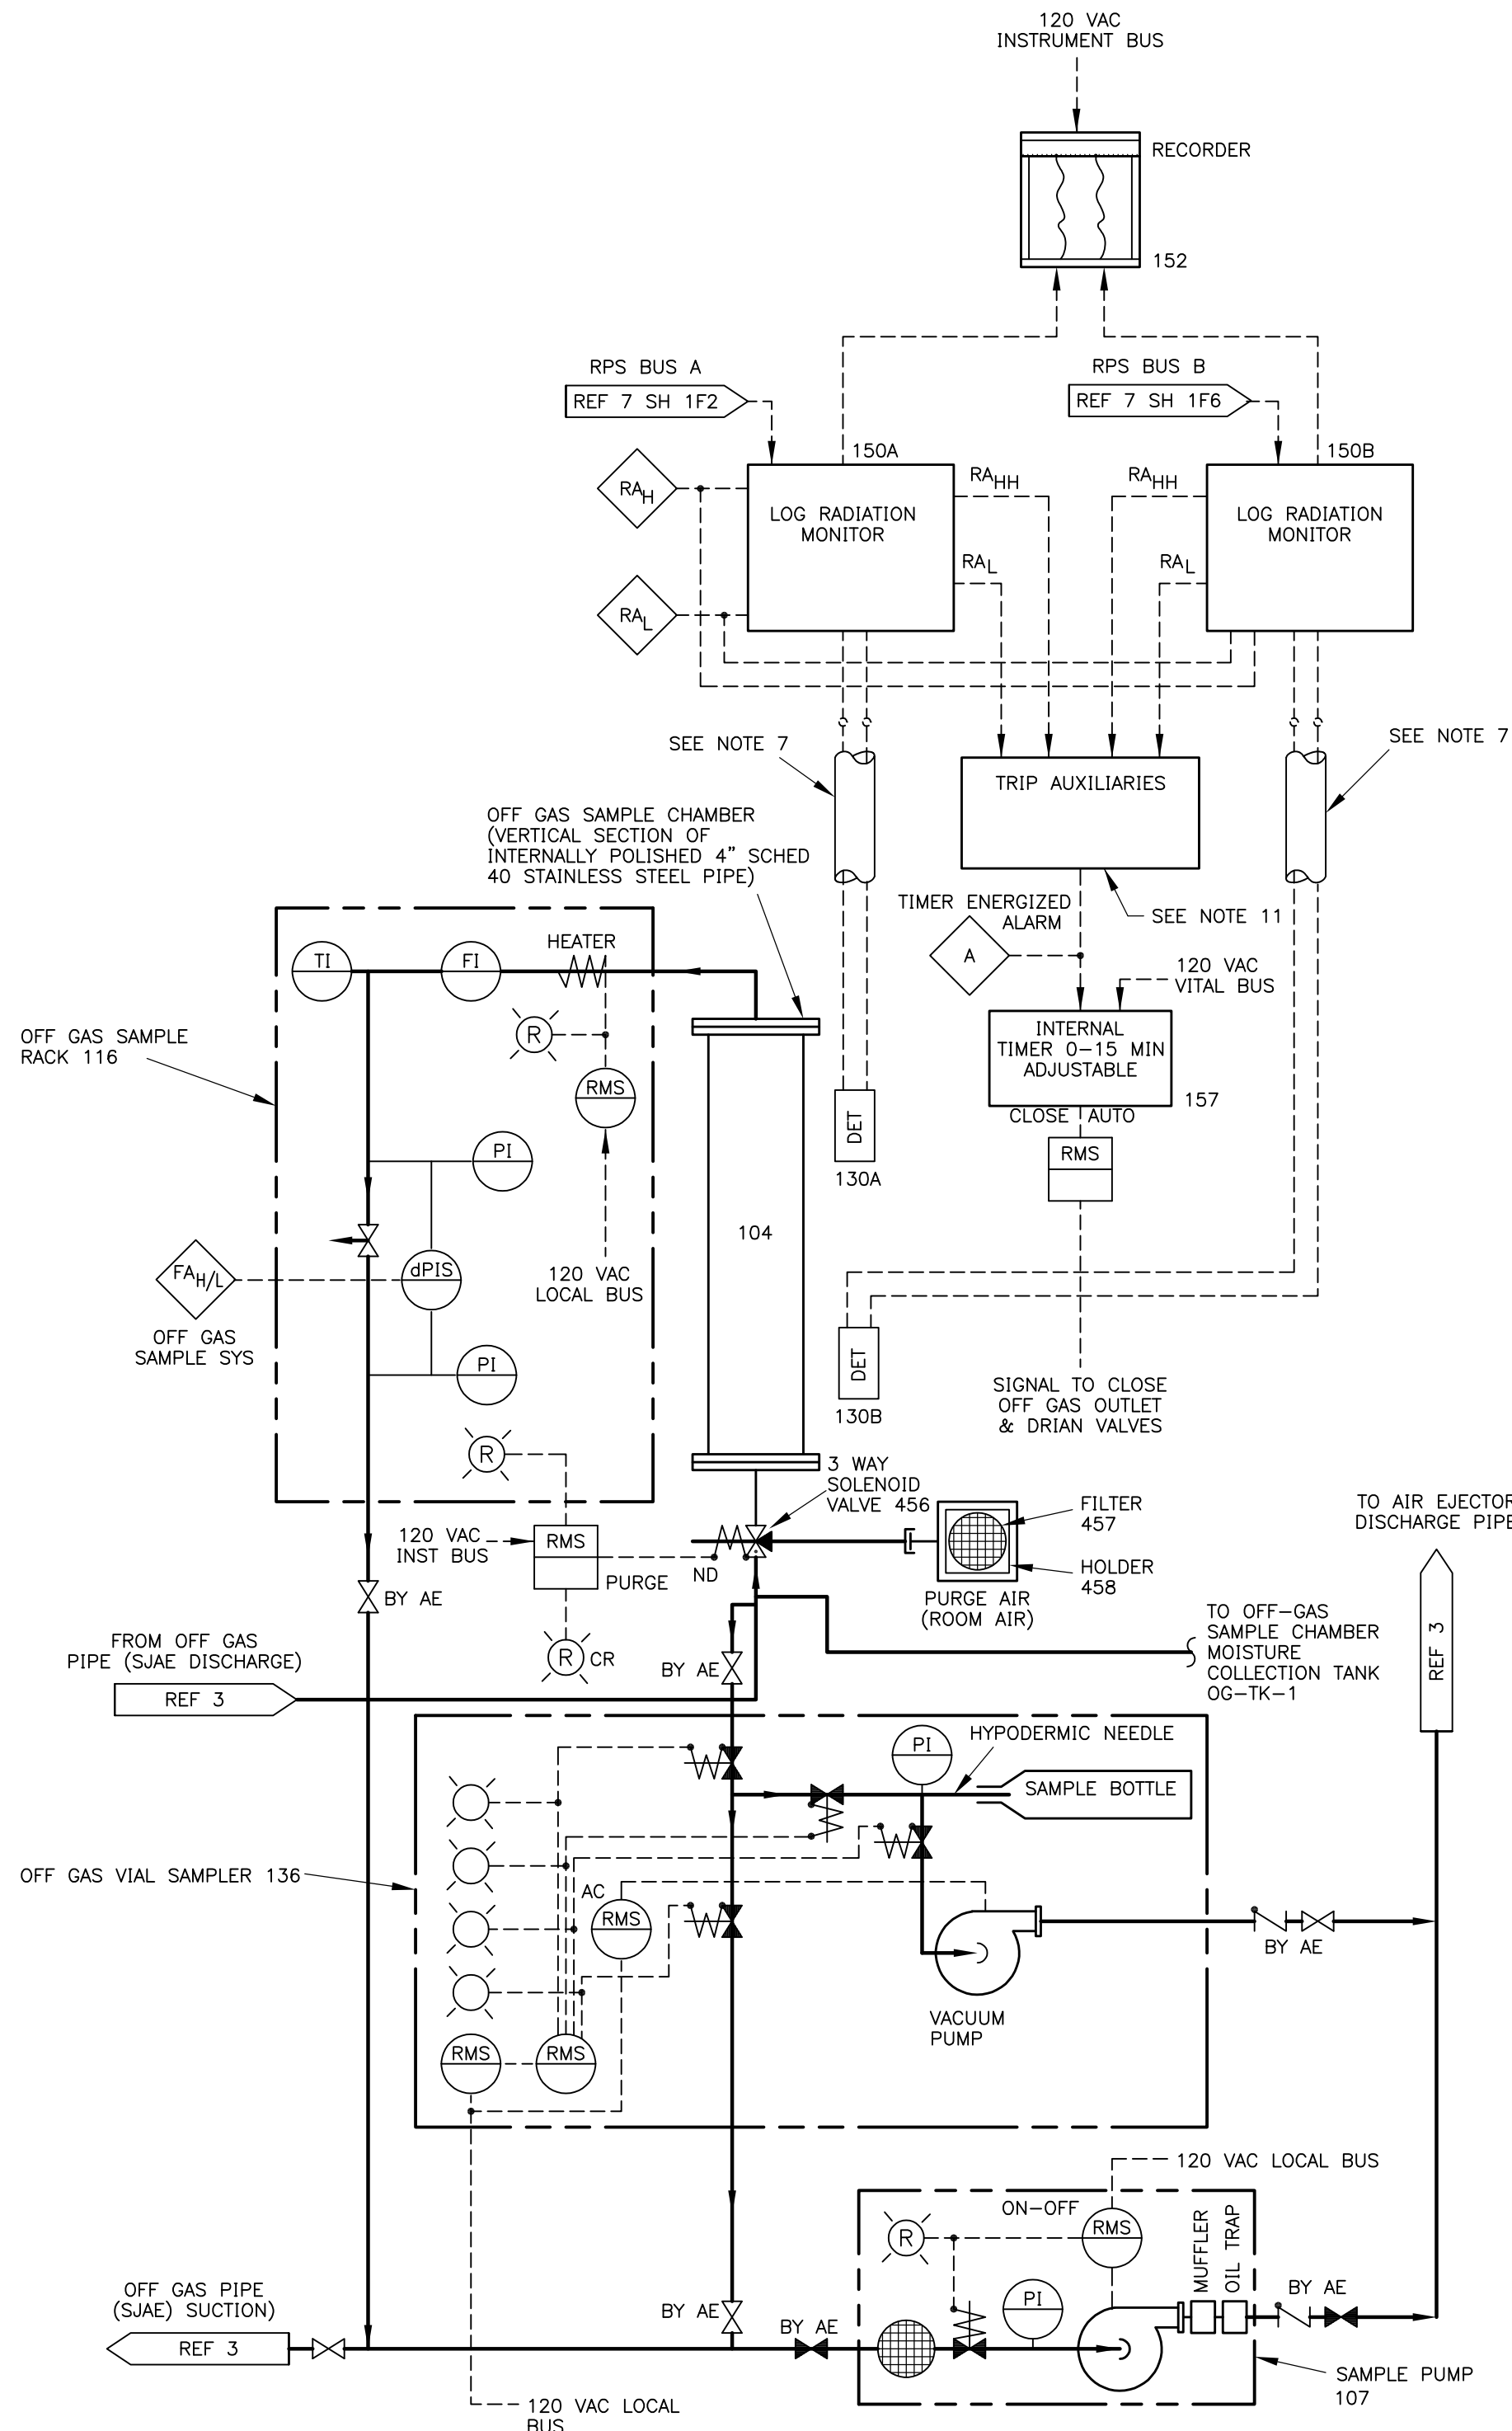

OFF GAS RADIATION MONITORS & SAMPLERS

- NOTES:
- THE OFF GAS VENT PIPE GAS SAMPLE LINE BY AE SHALL BE 1" X 0.058" WALL THICKNESS SEAMLESS STAINLESS STEEL TUBING. THE TUBING MINIMUM BEND RADIUS SHALL BE 20". THE TUBING LENGTH SHALL BE JOINED WITH SWAGelok TYPE 1610-6-316 UNIONS. THE TUBING SHALL SLOPE SO THAT CONDENSATE WILL RUN TO DRAIN TEE.
  - REMOVABLE SECTION SHALL BE PROVIDED NEAR THE ISOKINETIC PROBE FOR THE INSERTION OF A CHARCOAL FILTER HOLDER. THE FITTINGS ETC. SHALL PROVIDE SMOOTH TRANSITIONS WITHOUT DISCONTINUITIES OR REDUCING THE CROSS-SECTIONAL AREA OF THE FLOW STREAM.
  - UNION TEE SWAGelok TYPE 1610-6-316.
  - ALARMS ARE ACTUATED BY RELAYS IN TRIP AUX UNIT PART 355.
  - ALL EQUIP AND INSTRUMENTS ARE PREFIXED BY 17 WHICH IS PART 17 ON THE MASTER PARTS LIST.
  - THE DETECTORS (230) SHALL BE LOCATED AS CLOSE AS PRACTICAL TO THE PRIMARY CONTAINMENT. THE DETECTORS SHALL BE ARRANGED SUCH THAT EACH DETECTOR WILL VIEW ALL STEAM LINES WITH APPROXIMATELY THE SAME RESPONSE. THE DETECTOR OR DETECTOR ASSEMBLY MAY BE FASTENED TO A ROD OR A PIPE AND INSERTED INTO SEALED PIPE WELLS FROM OUTSIDE THE STEAM TUNNEL. CAREFULLY ROUTE CABLES TO MINIMIZE HEAT EXPOSURE. NO LEAD SHIELDING IS REQUIRED.
  - ALL CABLE SHALL COMPLY WITH GE ENGR SPEC REF A.
  - FOR LOCATION AND IDENTIFICATION OF INSTRUMENTS, SEE INSTRUMENT DATA SHEET LISTED IN MPL FOR EACH INSTRUMENT.
  - ONE HIGH RADIATION OR INOPERATIVE TRIP OUT OF TWO IN TRIP SYSTEM "A" AND ONE HIGH RADIATION OR INOPERATIVE TRIP OUT OF TWO IN THIS SYSTEM "B" SHALL TURN OFF MECHANICAL VACUUM PUMP AND CLOSE MECHANICAL LINE VALVE (REF 3). ANY ONE HIGH RADIATION SHALL ALARM (RA<sub>HH</sub>).
  - IN EACH DIVISION, THE SIGNAL FROM ONE UPSCALE TRIP OR TWO DOWNSCALE TRIPS SHALL TRIP THAT DIVISION. TRIPPING OF BOTH DIVISIONS SHALL:
    - SHUTDOWN REACTOR BUILDING VENTILATION SYSTEM AND VALVE OFF REACTOR BUILDING.
    - INITIATE STANDBY GAS TREATMENT SYSTEM.
    - CLOSE PRIMARY CONTAINMENT PURGE AND VENT VALVES.ANY ONE UPSCALE TRIP SHALL ALARM (RA<sub>HH</sub>). ANY ONE DOWNSCALE TRIP SHALL ALARM (RA<sub>L</sub>). UPSCALE TRIPS SHALL BE IN ACCORDANCE WITH THE REQUIREMENTS OF THE PRIMARY CONTAINMENT ISOLATION SYSTEM.
  - IF A HIGH-HIGH OR DOWNSCALE OR INOP TRIP OCCURS IN EACH OF THE TWO CHANNELS, THE OFFGAS TIMER WILL INITIATE AND A CONTROL ROOM ANNUNCIATOR WILL ACTIVATE. THE TIMER WILL IN TURN INITIATE AN OFFGAS ISOLATION. ANY ONE HIGH, DOWNSCALE OR INOP TRIP WILL GIVE AN ALARM IN THE CONTROL ROOM.

REACTOR BUILDING VENTILATION EXHAUST PLENUM RADIATION MONITOR

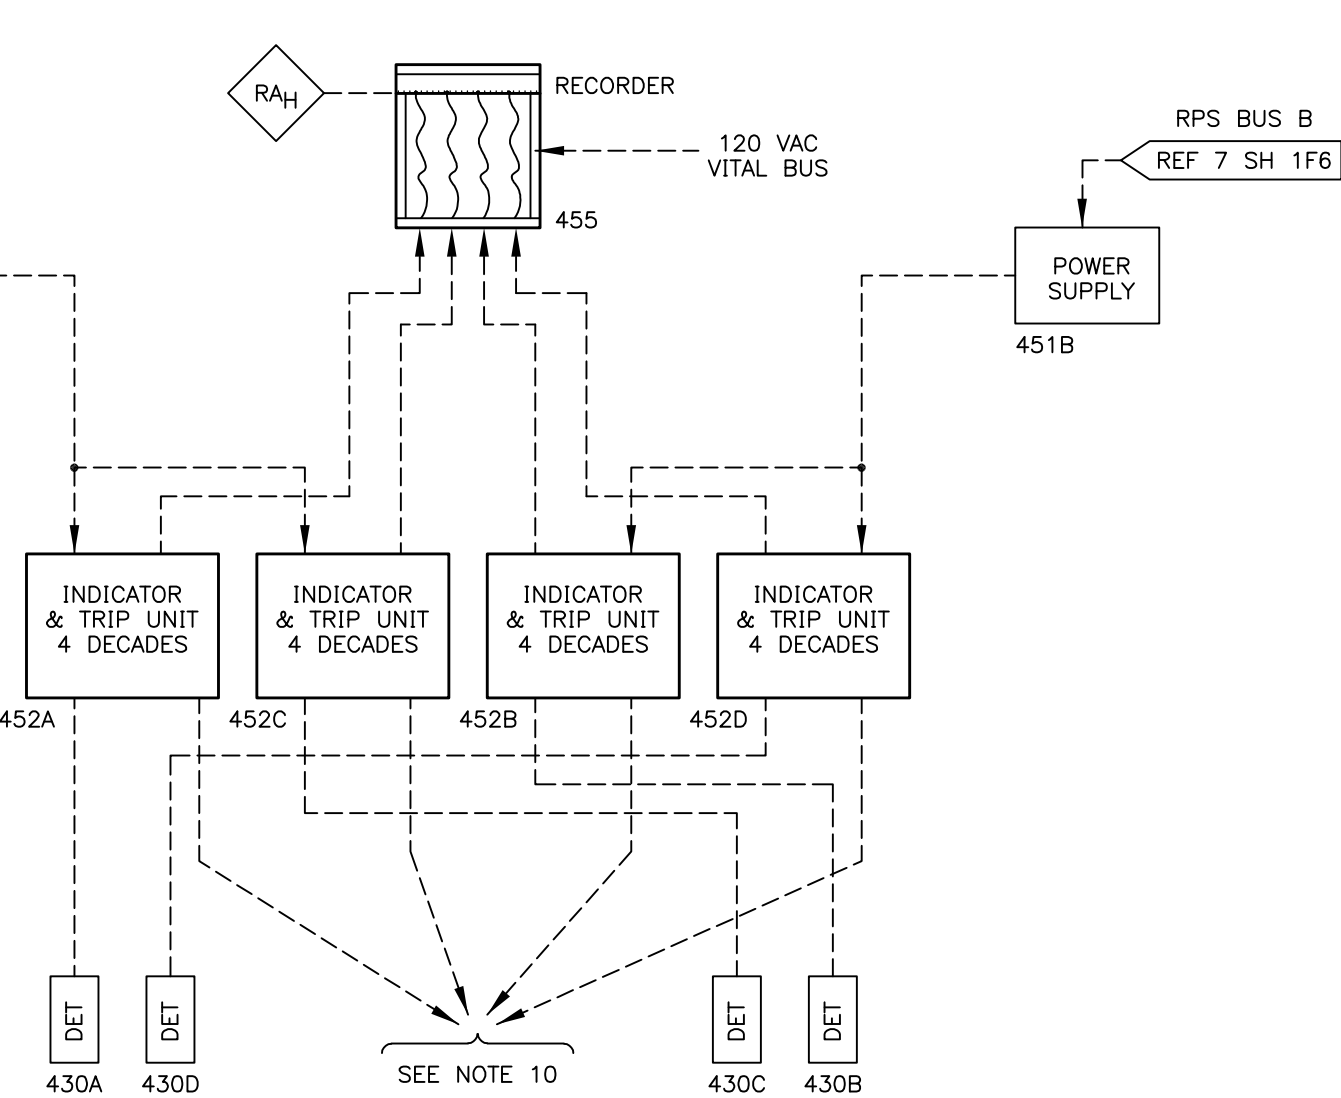

- REFERENCE ENG SPECS:
- |    |           |  |
|----|-----------|--|
| A. | MPL 1-11  | DESIGN SPECIFICATION FOR INSTRUMENT WIRE AND CABLE.                    |
| B. | MPL 17-1  | DESIGN SPECIFICATION RADIATION MONITORING OF PROCESS FLUIDS AND GASES. |
| C. | MPL 1-112 | DESIGN SPECIFICATION, SAMPLING OF PROCESS FLUIDS AND GASES.            |
- REFERENCE DRAWINGS:
- |    |   |         |
|----|---|---------|
| 1. | PIPING AND INSTRUMENT SYMBOLS                 | 104R900 |
| 2. | PLANT DC AND INST. AC/DC SYS ONE LINE DIAG.   | 1-63    |
| 3. | FLOW DIAGRAM OFF GAS SYSTEM HOLDUP            | 1-107-1 |
| 4. | P & ID RADWASTE SYSTEM                        | 20-0    |
| 5. | FCD NUCLEAR BOILER MISC SYSTEM                | 2-203   |
| 6. | P & ID REACTOR BLDG. CLOSE COOLING WATER SYS. | BY AE   |
| 7. | REACTOR PROTECTION SYSTEM IED                 | 5-0     |
- LEGEND:
- |      |                           |
|------|---------------------------|
| SJAE | STEAM JET AIR EJECTOR     |
| DET  | ALARM DETECTOR            |
| FC   | FAIL CLOSE                |
| RAH  | RADIATION ALARM HIGH      |
| RAH  | INSTRUMENT TROUBLE        |
| RAHH | RADIATION ALARM HIGH HIGH |

INFORMATION ONLY

453011518  
CADD DRAWING  
DO NOT REVISE MANUALLY

COOPER NUCLEAR STATION  
PROCESS RADIATION  
MONITORING SYSTEM

DRAWN TRU  
DATE 4/5-94  
CHECKED JAC  
DATE 6-14-94  
APPROVED WCF  
DATE 6-14-94  
FILMED

GENERAL  
ELECTRIC

719E479BB SH 1  
REVISION N13

CADD FILE: C0014050

FOR PREVIOUS REVISIONS, SEE SUPERSEDED CARDS.						
REVISIONS BY N.P.P.D.						
NO.	REVISIONS	DFT	CKD	APP	DATE	
N08	CED 6005412 (DCN 01-0906)	RAC	RHG	KG	11-2-02	
N09	CED 600680 (DCN 02-0683)	RAC	RHG	KG	1-20-03	
N10	CED 6010281 (DCN 03-0605)	RAC	RHG	KG	4-23-04	
N11	CED 6010281 (DCN 03-0784)	RAC	RHG	KG	4-23-04	
N12	CED 6005412 (DCN 03-1579)	JSC	RHG	KG	4-23-04	
N13	CED 6005412 (DCN 04-0643)	RAC	RHG	KG	10-20-04	











RELEASED FOR FABRICATION  
SUBJECT: REACTOR PROTECTION SYSTEM

RESPONSIBLE ENGINEER: [blank]  
SECTION: [blank]

BULL H. [blank] INC.  
NOV 1978  
NOV 1978

EXAMINED BY: J.J.B.

GENERAL ELECTRIC 729E222 BB

REACTOR PROTECTION SYSTEM

FCF 238X100 BB (5)  
PL ISSUED

NOTES:


1. DEVICES USED IN TRIP SYSTEM ARE IDENTIFIED BY LETTERS A, C, E, G, ETC. THOSE USED IN TRIP SYSTEM ARE A, D, F, H, ETC.
2. SYSTEM SHALL BE ARRANGED SO THAT THE TRIP CANNOT BE DISARMED FROM THE M/G SET AND ALTERNATE START AT THE SAME TIME.
3. ONE SWITCH SHALL BE USED FOR BOTH TRIP SYSTEMS A AND B AND SO ARRANGED THAT THE ACTUATION OF THE SWITCH WILL RESET ALL SCRAM PILOT VALVES (A AND B) IN GROUP 1 ROD GROUP 4 AS WELL AS BACK-UP SCRAM VALVE A. A DIFFERENT ACTUATION OF THE SWITCH WILL RESET ALL SCRAM PILOT VALVES (A AND B) IN GROUP 2 AND GROUP 3 AS WELL AS BACK-UP SCRAM VALVE B.
4. MAIN STEAM LINE ISOLATION VALVE CLOSURE TRIP SHALL BE ARRANGED SO THAT ANY ONE STEAMLINE MAY BE ISOLATED BY FULL CLOSURE OF ITS ISOLATION VALVE AND THE ISOLATION VALVE FOR ANY ONE OTHER STEAMLINE CAN BE CLOSED (MORE THAN 10S) WITHOUT CAUSING A RPS TRIP.
5. LOGIC FOR THE "TURBINE STOP VALVE CLOSURE" TRIP SHALL BE ARRANGED SO THAT CLOSURE OF 3 OUT OF 4 STOP VALVES WILL CAUSE A RPS TRIP. PROVISION SHALL BE MADE TO ALLOW CLOSURE OF ONE STOP VALVE (FOR TEST PURPOSES) WITHOUT CAUSING A TRIP OF EITHER TRIP SYSTEM A OR B.
6. TRIP CHANNELS FOR THE "TURBINE CONTROL VALVE FAST CLOSURE" TRIP SHALL BE DERIVED FROM THOSE EVENTS CAUSING FAST CLOSURE OF THE CONTROL VALVES.
7. EQUIPMENT RATINGS ARE ESTIMATED AND PRELIMINARY. ACTUAL VALUES TO BE DETERMINED AT TIME OF EQUIPMENT PROCUREMENT.
8. THIS SIGNAL, WHEN ABSENT, DE-ENERGIZES THE SCRAM CONTACTOR.
9. FOR LOCATION AND IDENTIFICATION OF INSTRUMENTS SEE INSTRUMENT DATA SHEET LISTED IN M/G SET FOR EACH INSTRUMENT.
10. SEVEN INJECTION REPRESENTATIONS (IN PARENTHESIS) ONLY ARE USED TO SUPPRESS ELECTRICAL PULSES OF SCRAM REPRESENTATIONS.

LEGEND:



\* - SWITCH/GEAR DEVICE FUNCTION NUMBER USAS SPEC. C37.2.

REFERENCES:

- |  |          |
|--|----------|
| 1. DESIGN SPEC. REACTOR PROTECTION SYSTEM          | 1-133    |
| 2. DESIGN SPEC. TURBINE & GEN. STEAM BYPASS SYSTEM | 1-133    |
| 3. IED PROCESS RADIATION MONITORING                | 1-133    |
| 4. IED NEUTRON MONITORING SYSTEM                   | 1-133    |
| 5. IED NEUTRON MONITORING SYSTEM                   | 1-133    |
| 6. IED NEUTRON MONITORING SYSTEM                   | 1-133    |
| 7. PAID NUCLEAR BOILER VESSEL INSTRUMENTATION      | 1-133    |
| 8. IED CONTROL ROD DRIVE HYDRAULIC SYSTEM          | 1-133    |
| 9. PAID CONTROL ROD DRIVE HYDRAULIC SYSTEM         | 1-133    |
| 10. PAID NUCLEAR BOILER                            | 1-133    |
| 11. PAID RESIDUAL HEAT REMOVAL                     | 1-133    |
| 12. PIPING & INSTRUMENT SYMBOLS                    | 1049900  |
| 13. LOGIC SYMBOLS                                  | 709A1155 |

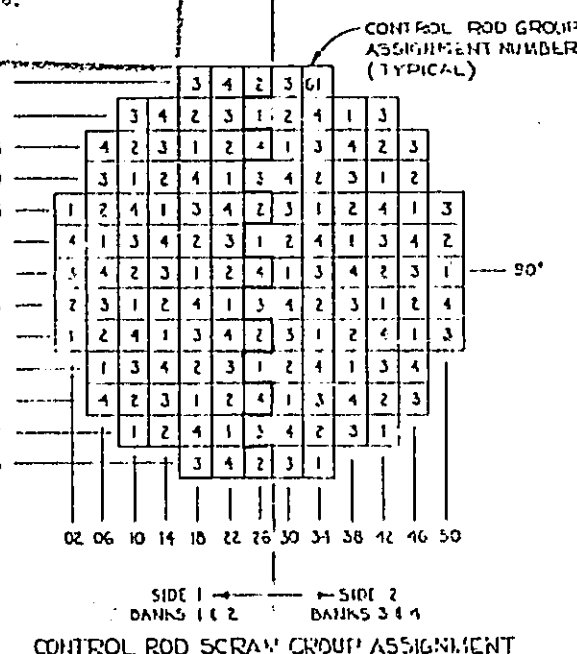

PARTS SHOWN INSIDE THIS BOUNDARY EXCEPT FUSE PANEL PART 5-7 ARE FOR REFERENCE AND ARE SHOWN ONLY TO CLARIFY THE REACTOR PROTECTION SYSTEM.

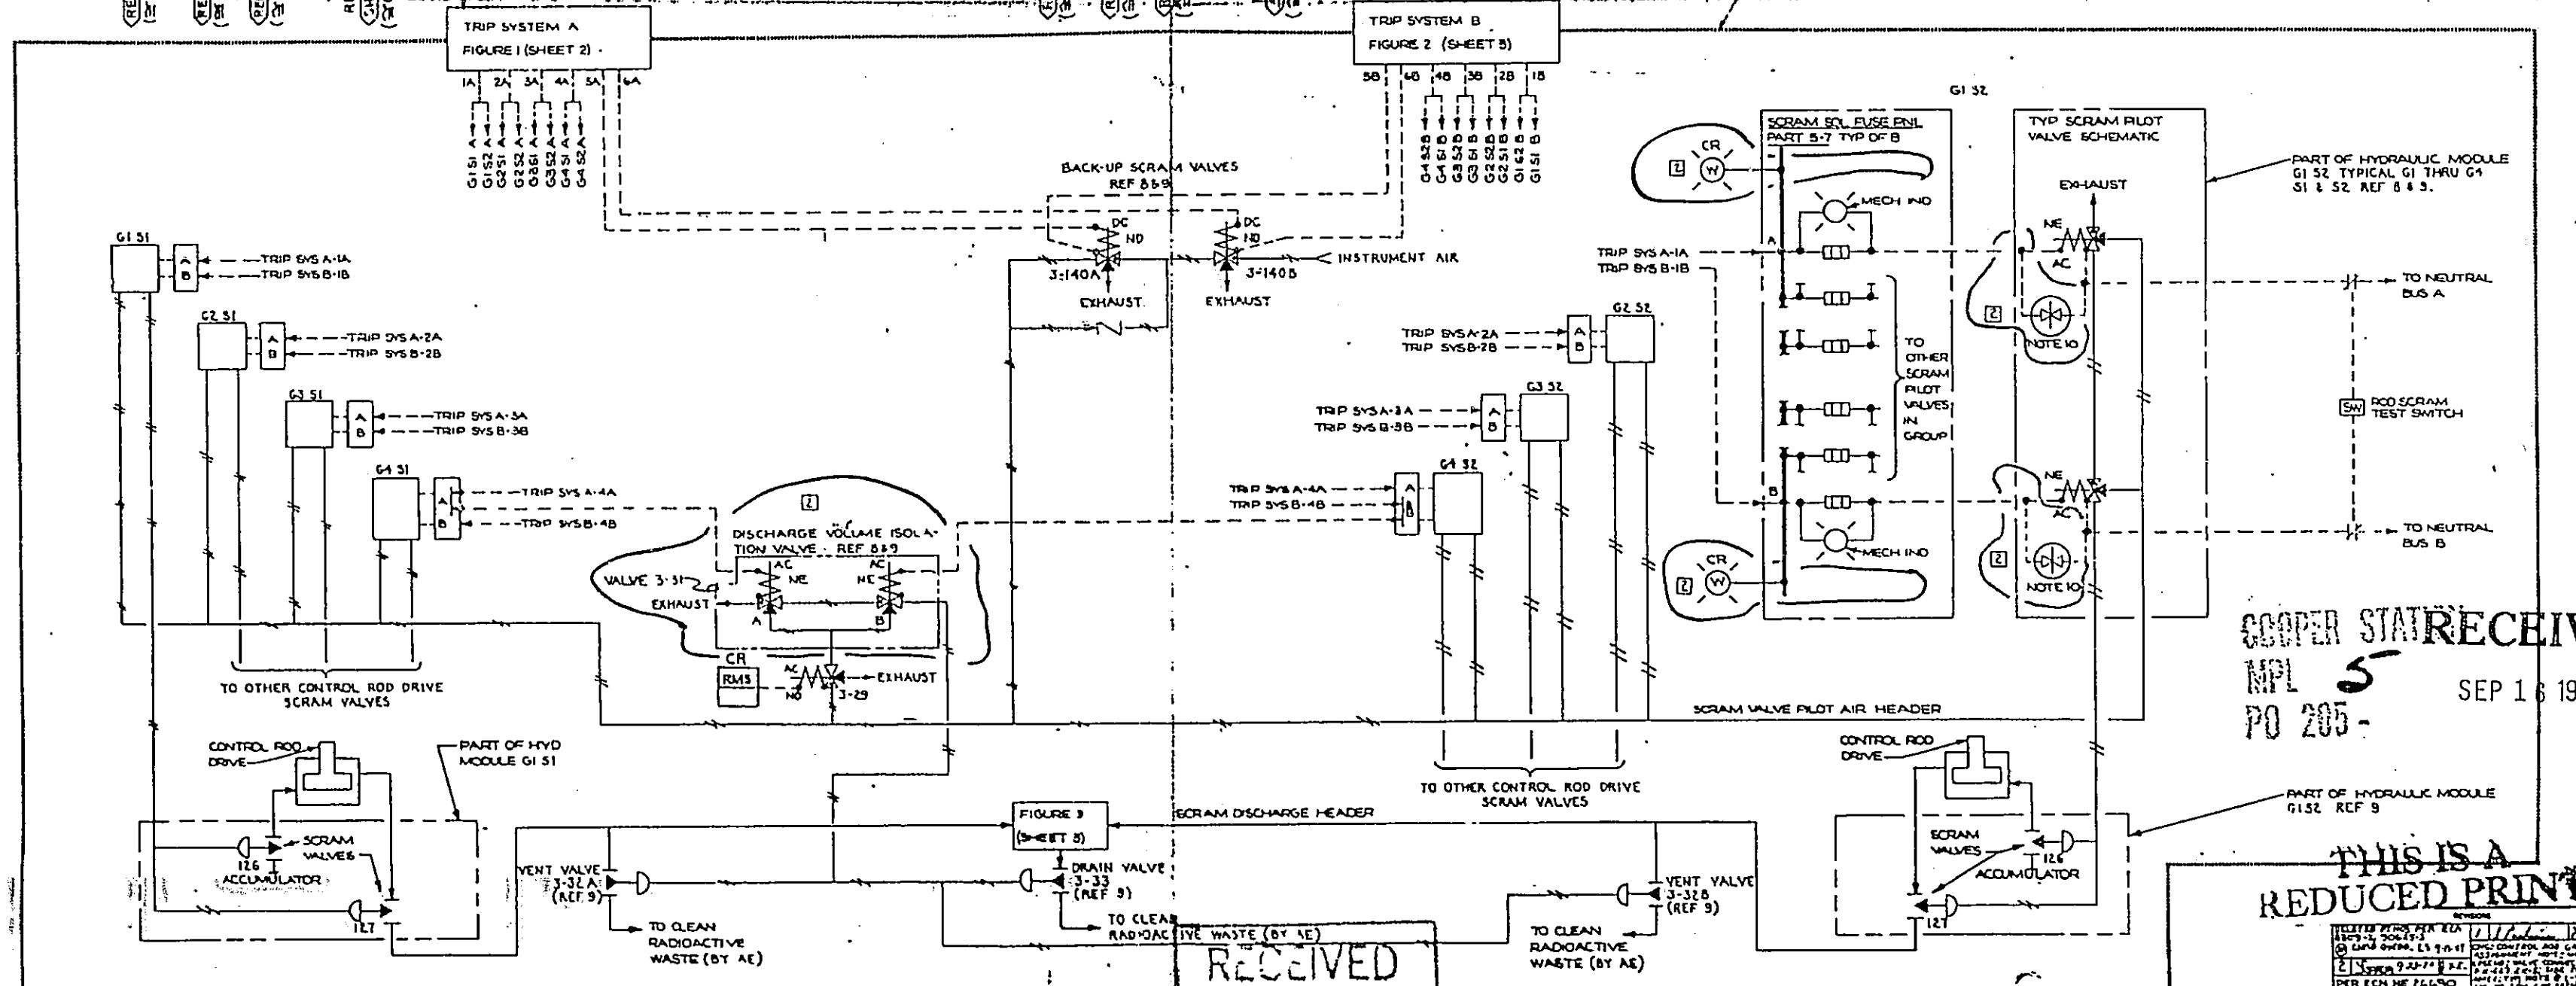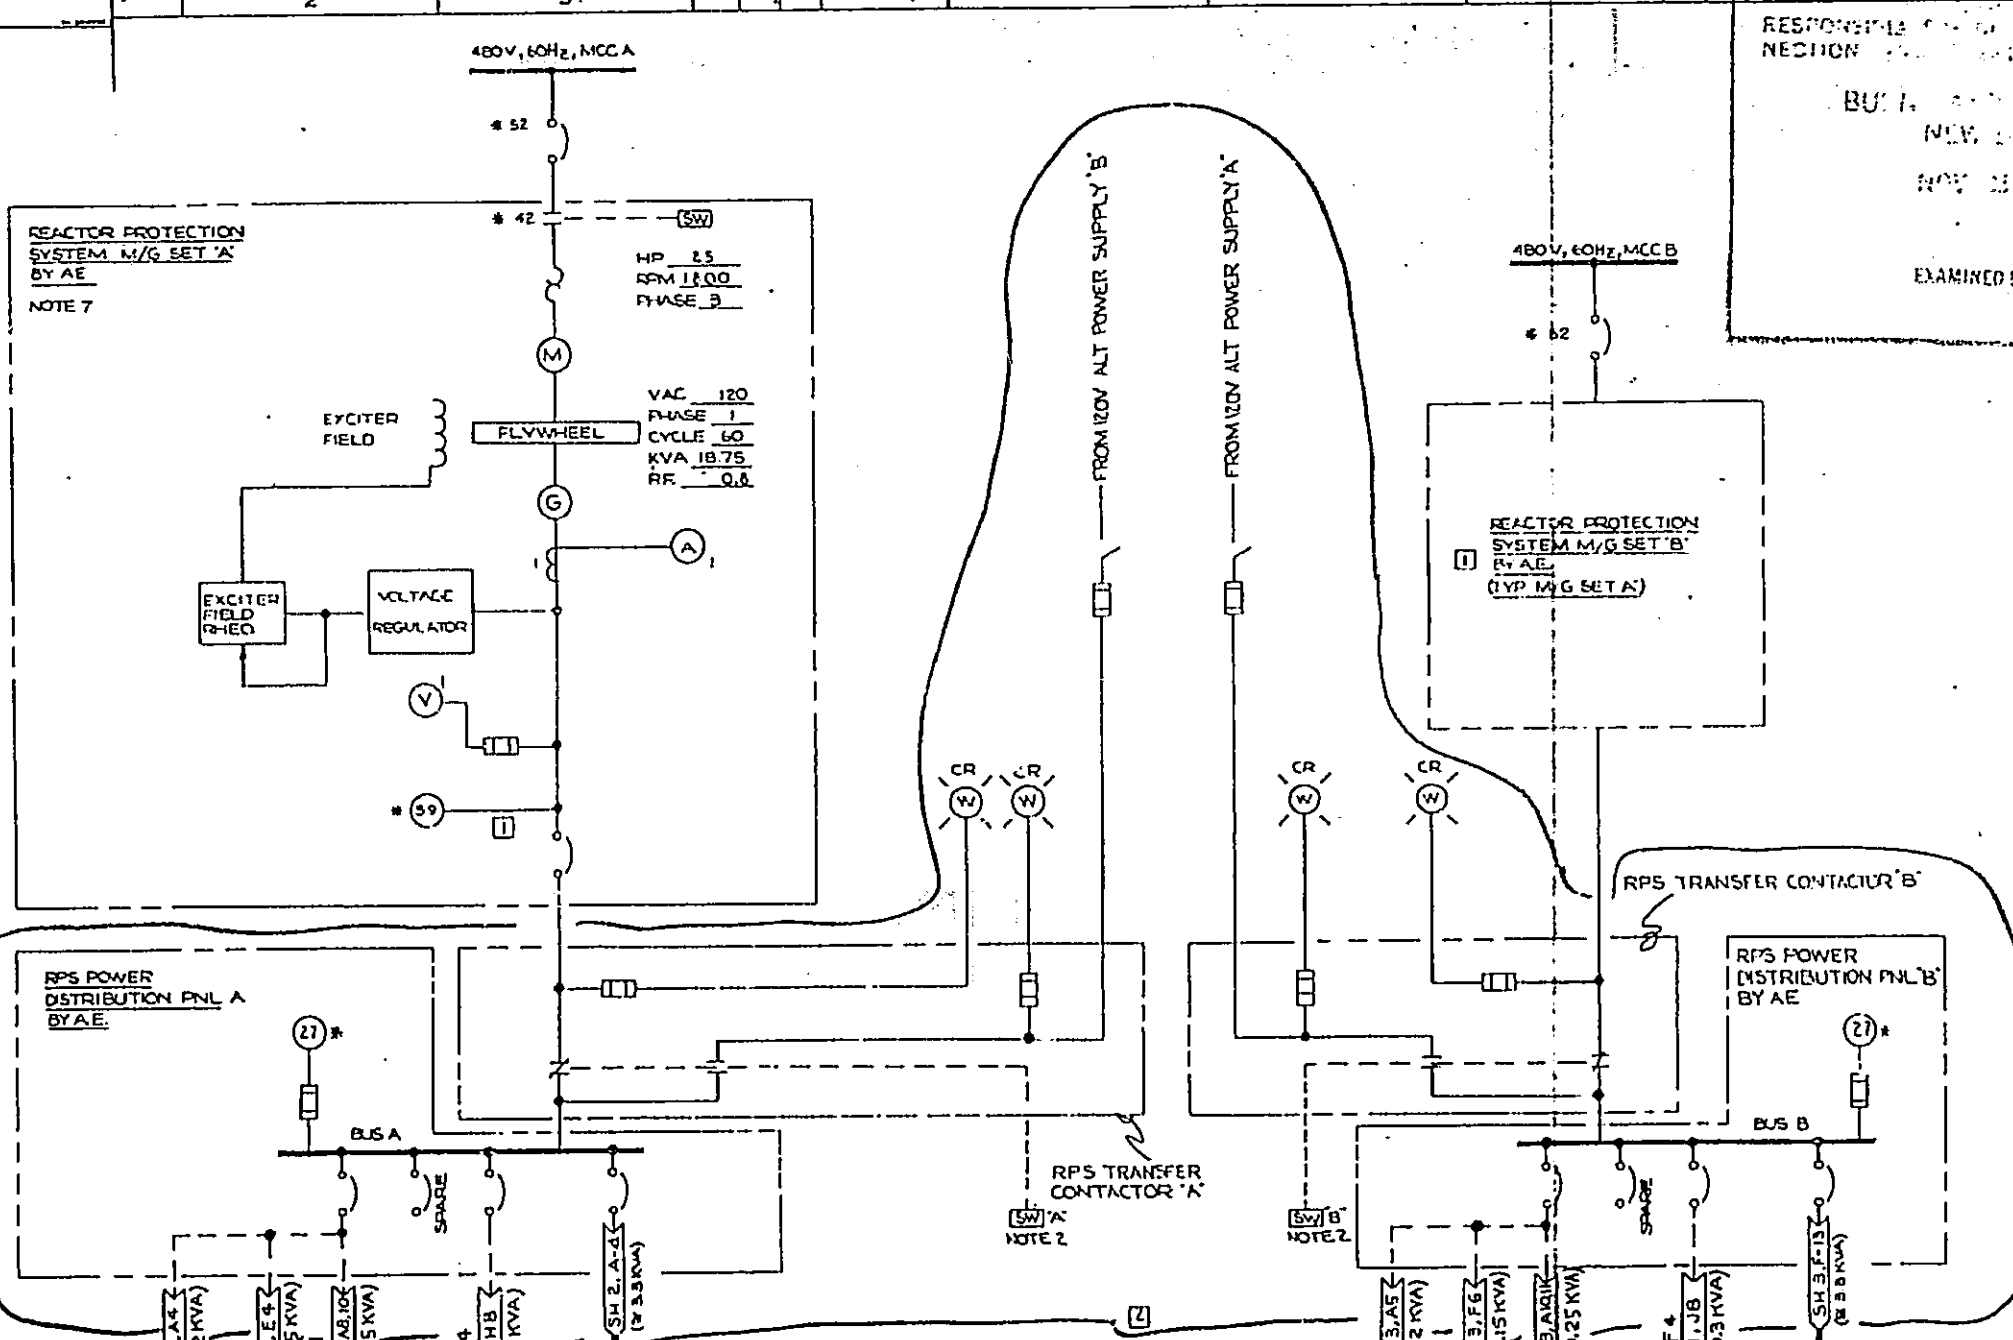

COOPER STATE RECEIVED  
NPL 5  
PO 205  
SEP 1 1980


THIS IS A  
REDUCED PRINT

452005046

729E222 BB  
SAN JOSE

A  
B  
C  
D  
E  
F  
G  
H  
J

A  
B  
C  
D  
E  
F  
G  
H  
J

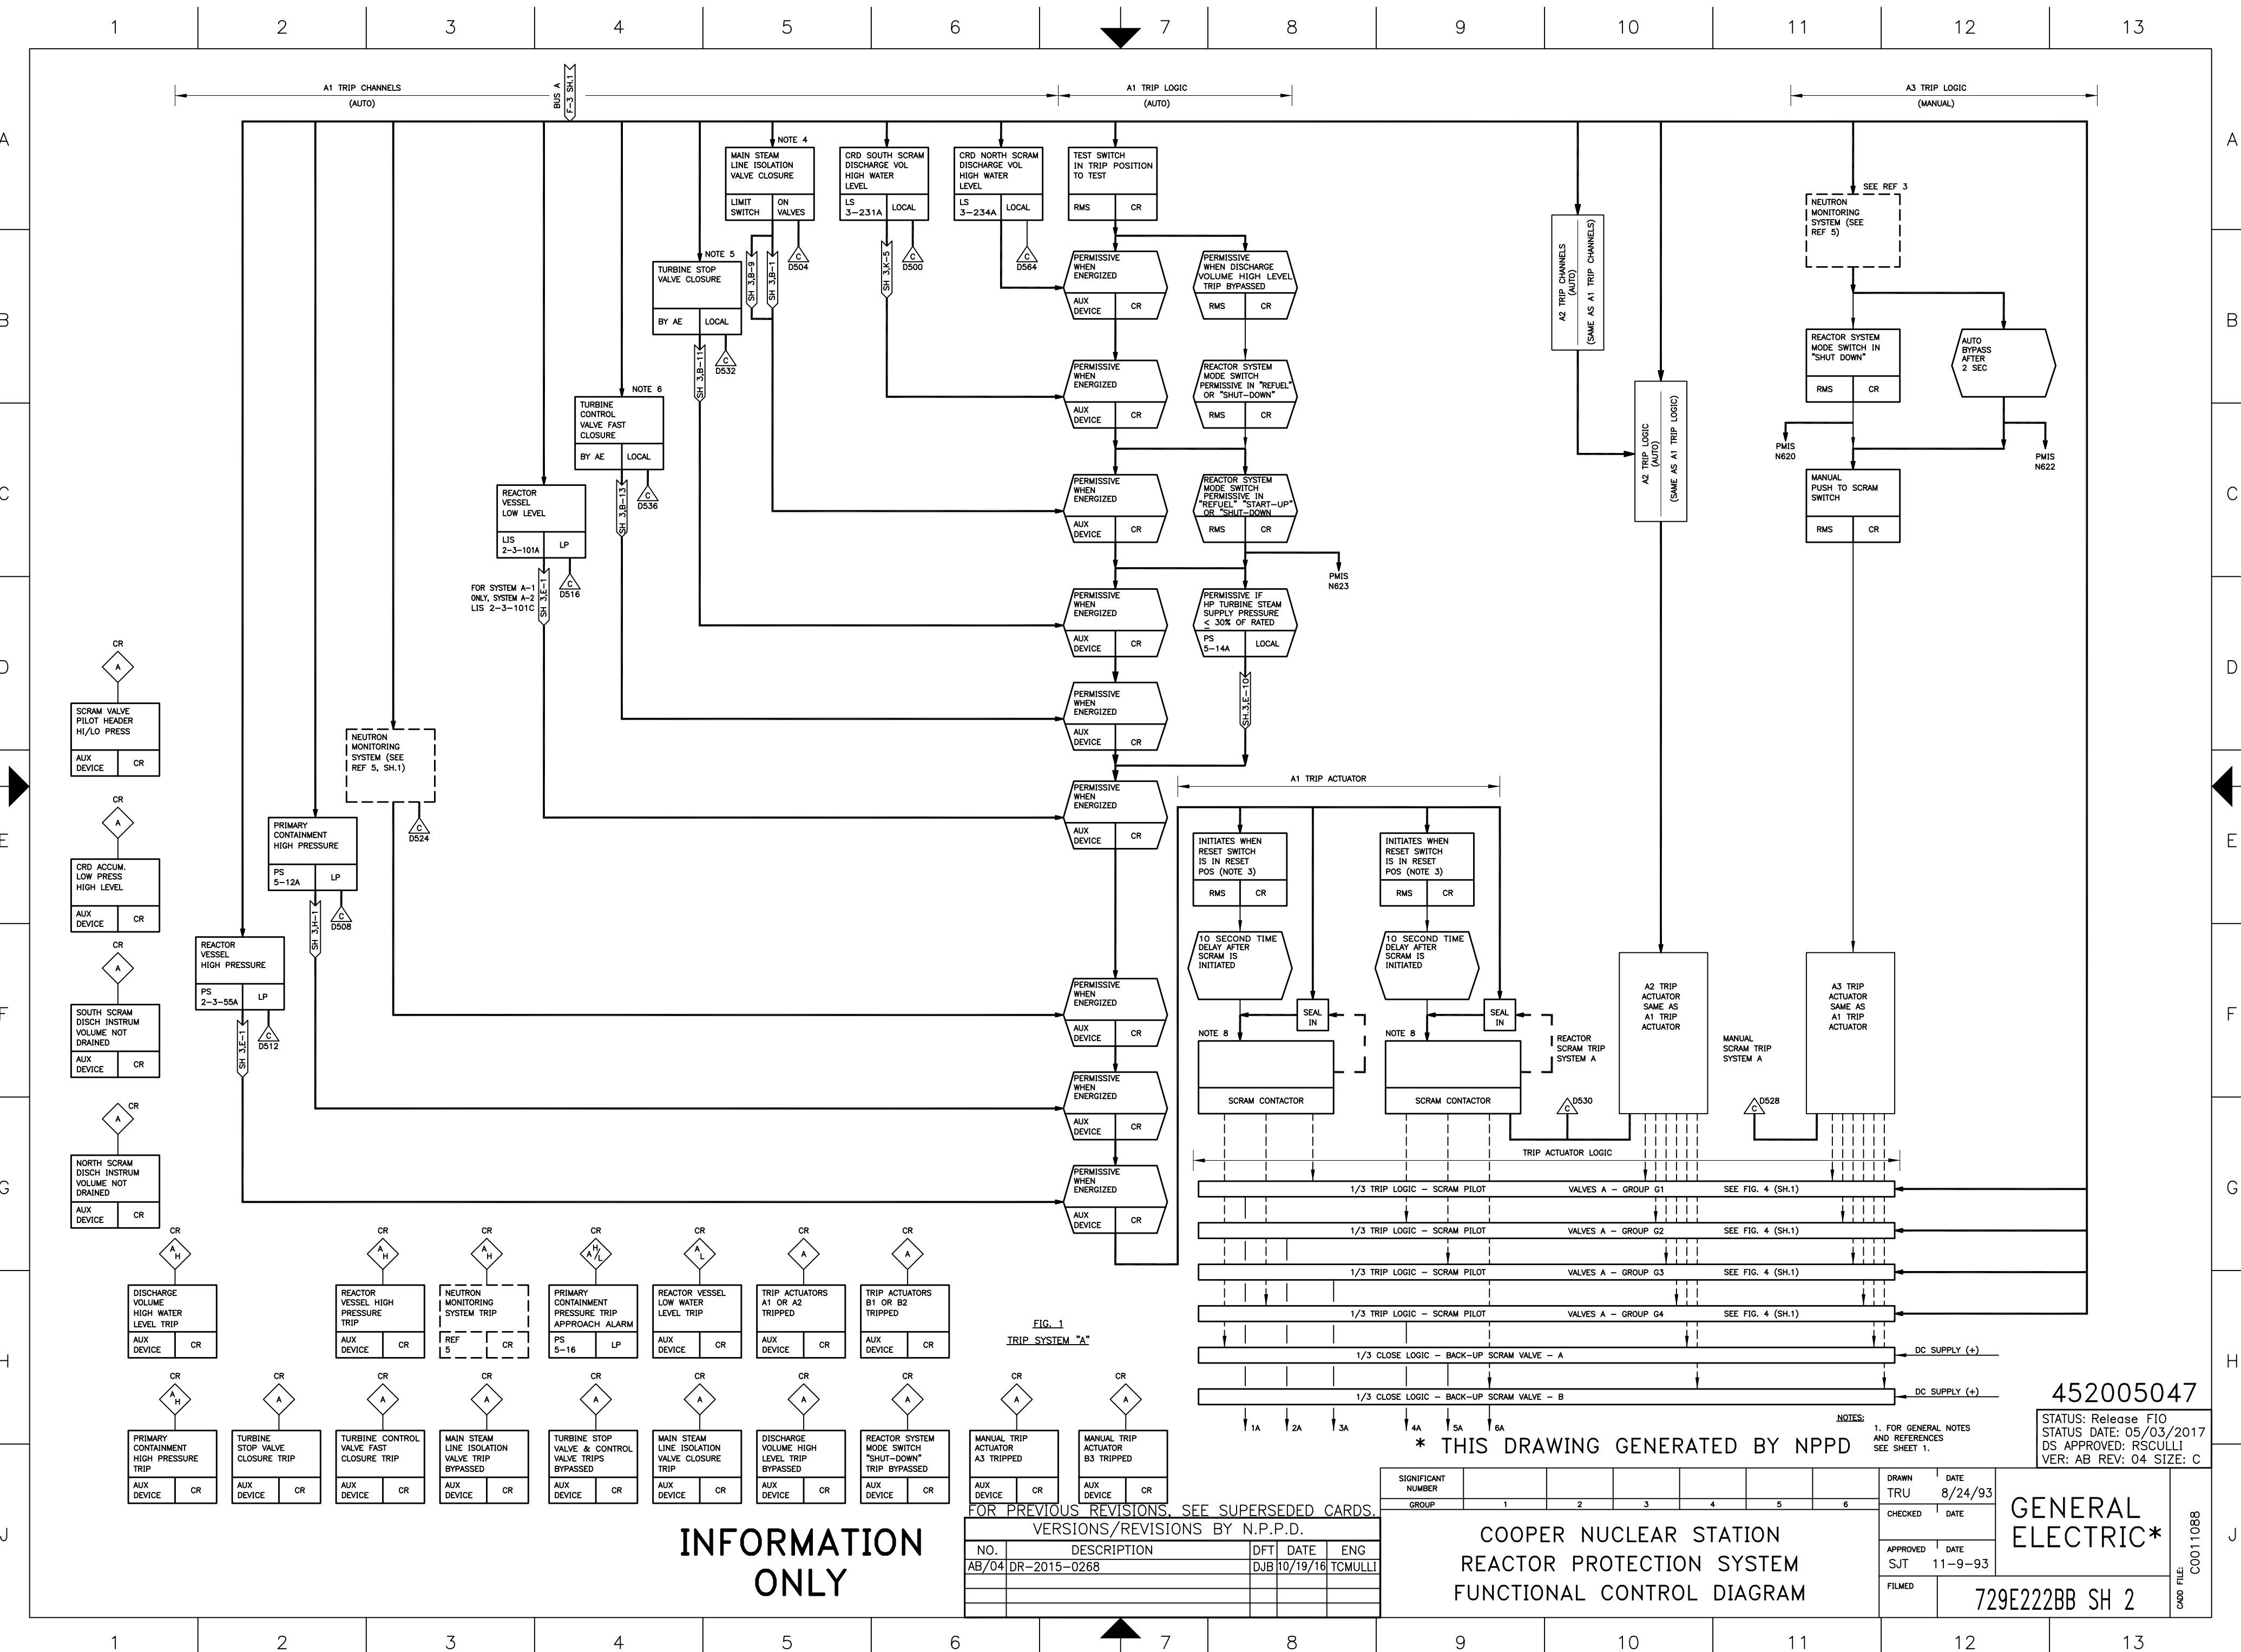

INFORMATION  
ONLY



	1	2	3	4	5	6	7	8	9	10	11	12	13	14
--	---	---	---	---	---	---	---	---	---	----	----	----	----	----

A

B

C

D

E



F


H

J


K

L

M

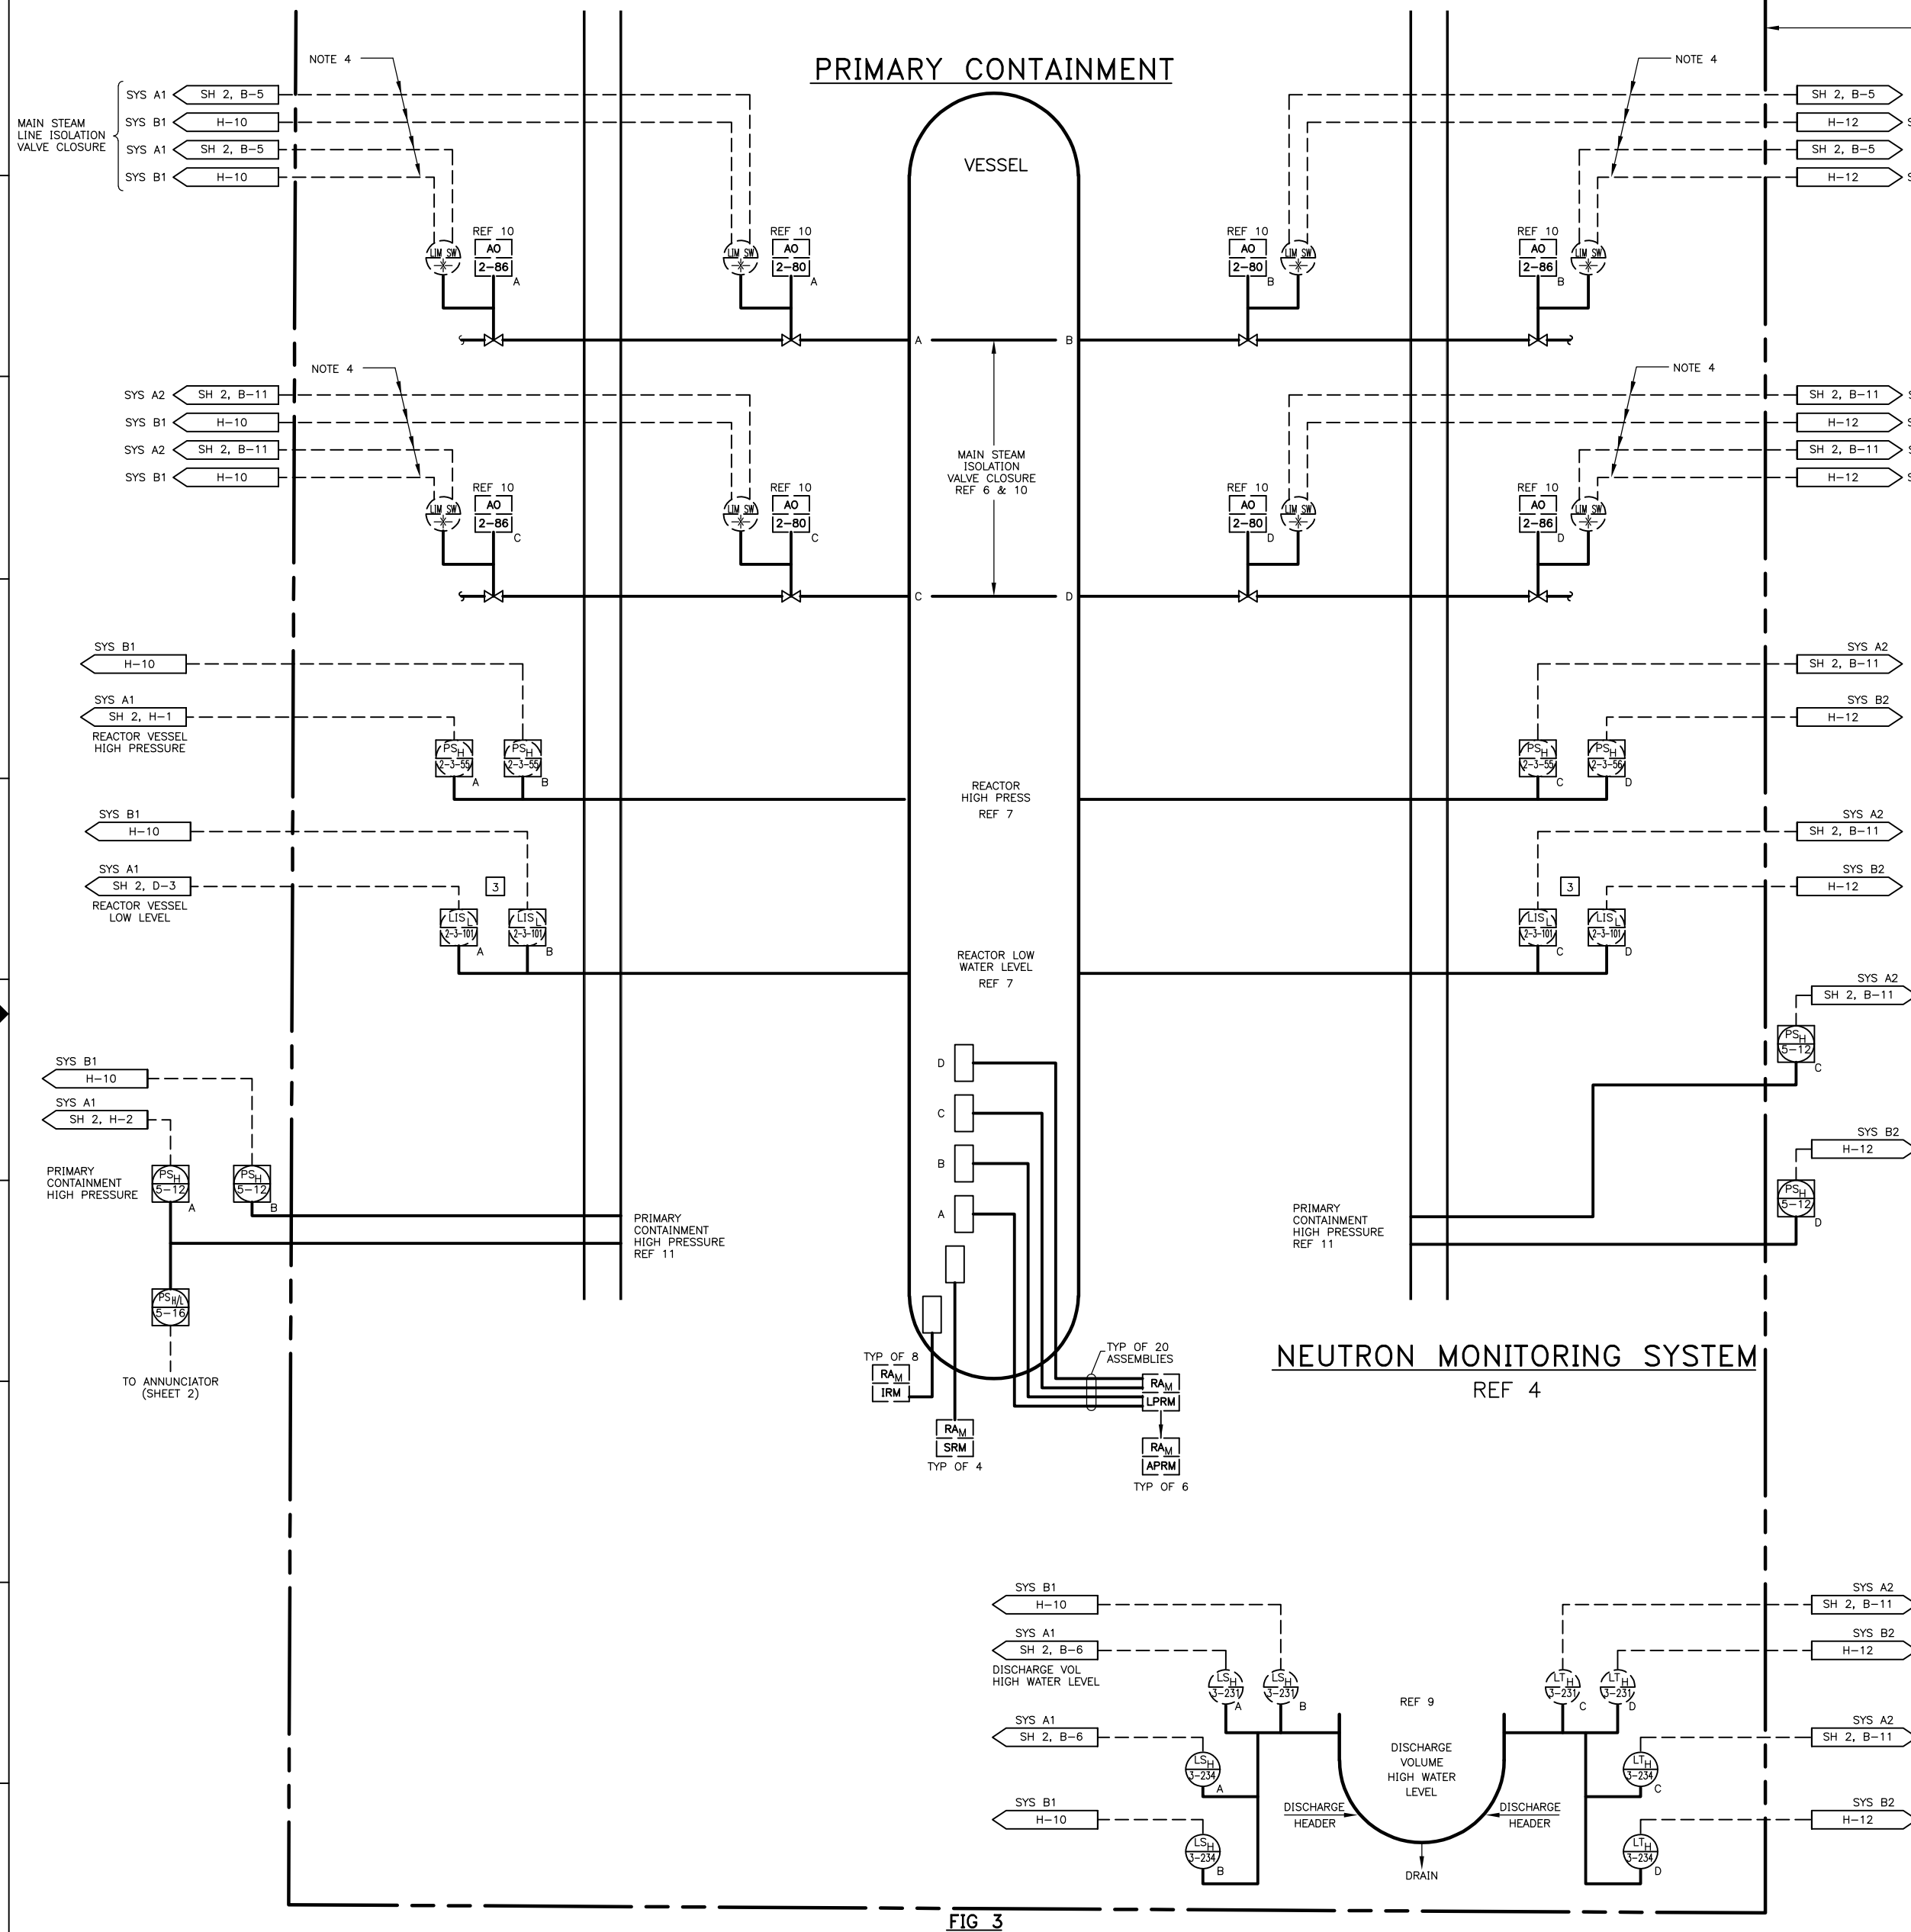

PARTS SHOWN INSIDE THIS BOUNDARY ARE FOR REF AND ARE SHOWN ONLY TO CLARIFY THE REACTOR PROTECTION SYSTEM.

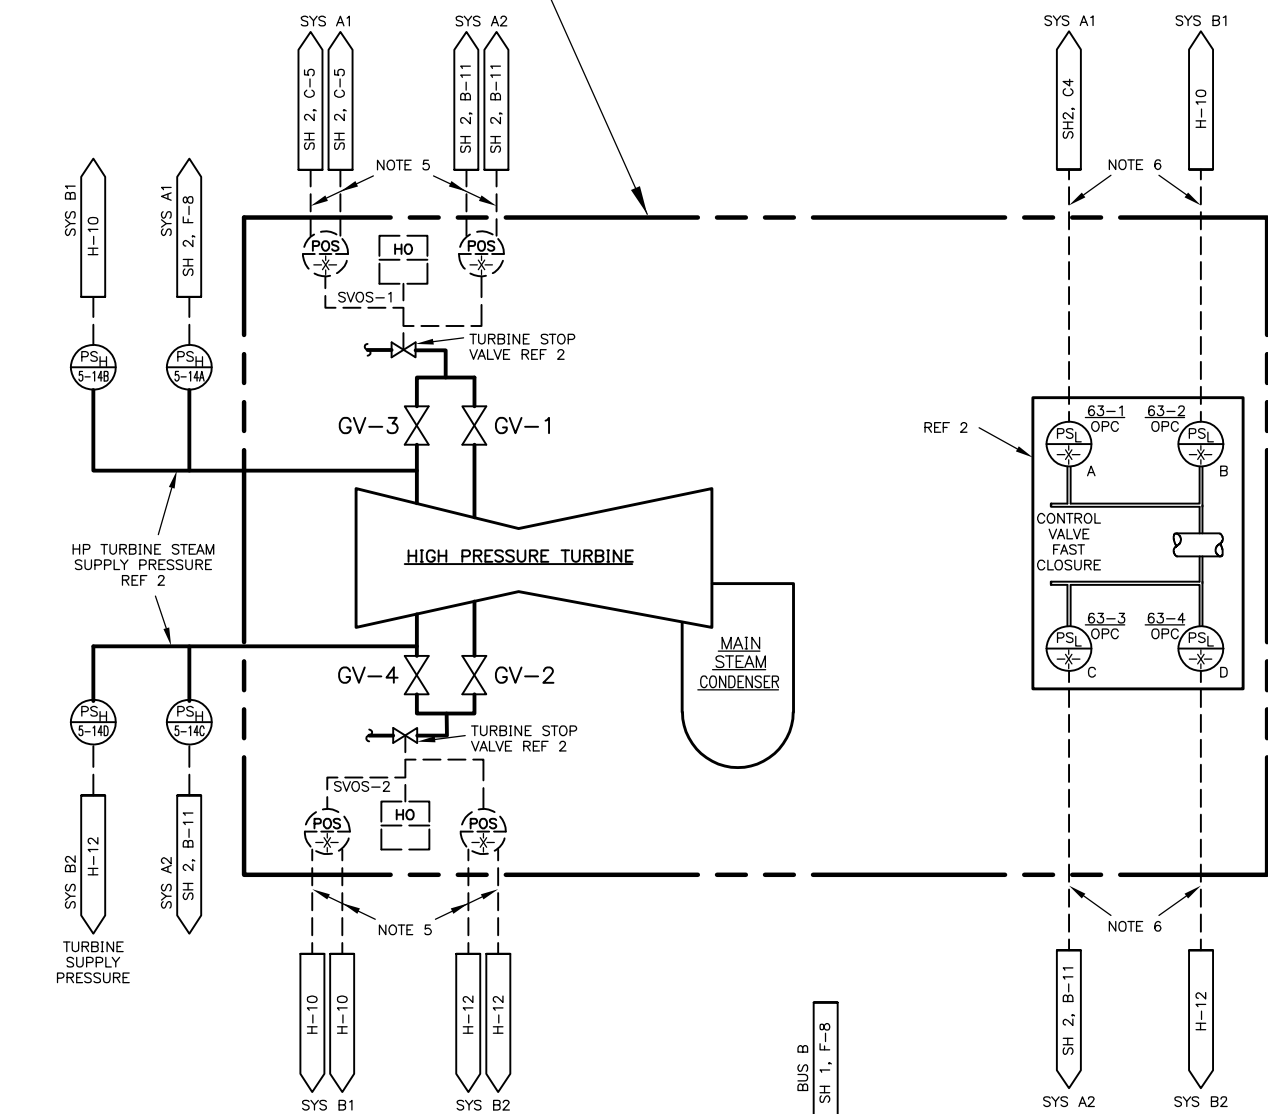

\* THIS DRAWING GENERATED BY NPPD

VERSIONS/REVISIONS BY N.P.P.D.				
NO.	DESCRIPTION	DFT	DATE	ENG
AB/04	DR-2015-0268	DJB	01/23/17	RSCULLI

SIGNIFICANT NUMBER	1	2	3	4	5	6
GROUP						
COOPER NUCLEAR STATION						
REACTOR PROTECTION SYSTEM						
SHEET 3						

DRAWN	DATE	GENERAL ELECTRIC*	C0014085
TRU	8/24/94		
CHECKED	DATE		
JAC	8-25-94		
APPROVED	DATE	729E222BB	
WCF	9-3-94		
FILMED			


452005048

STATUS: Release

STATUS DATE: 05/03/2017

DS APPROVED: RSCULLI

VER: AB REV: 04 SIZE: C

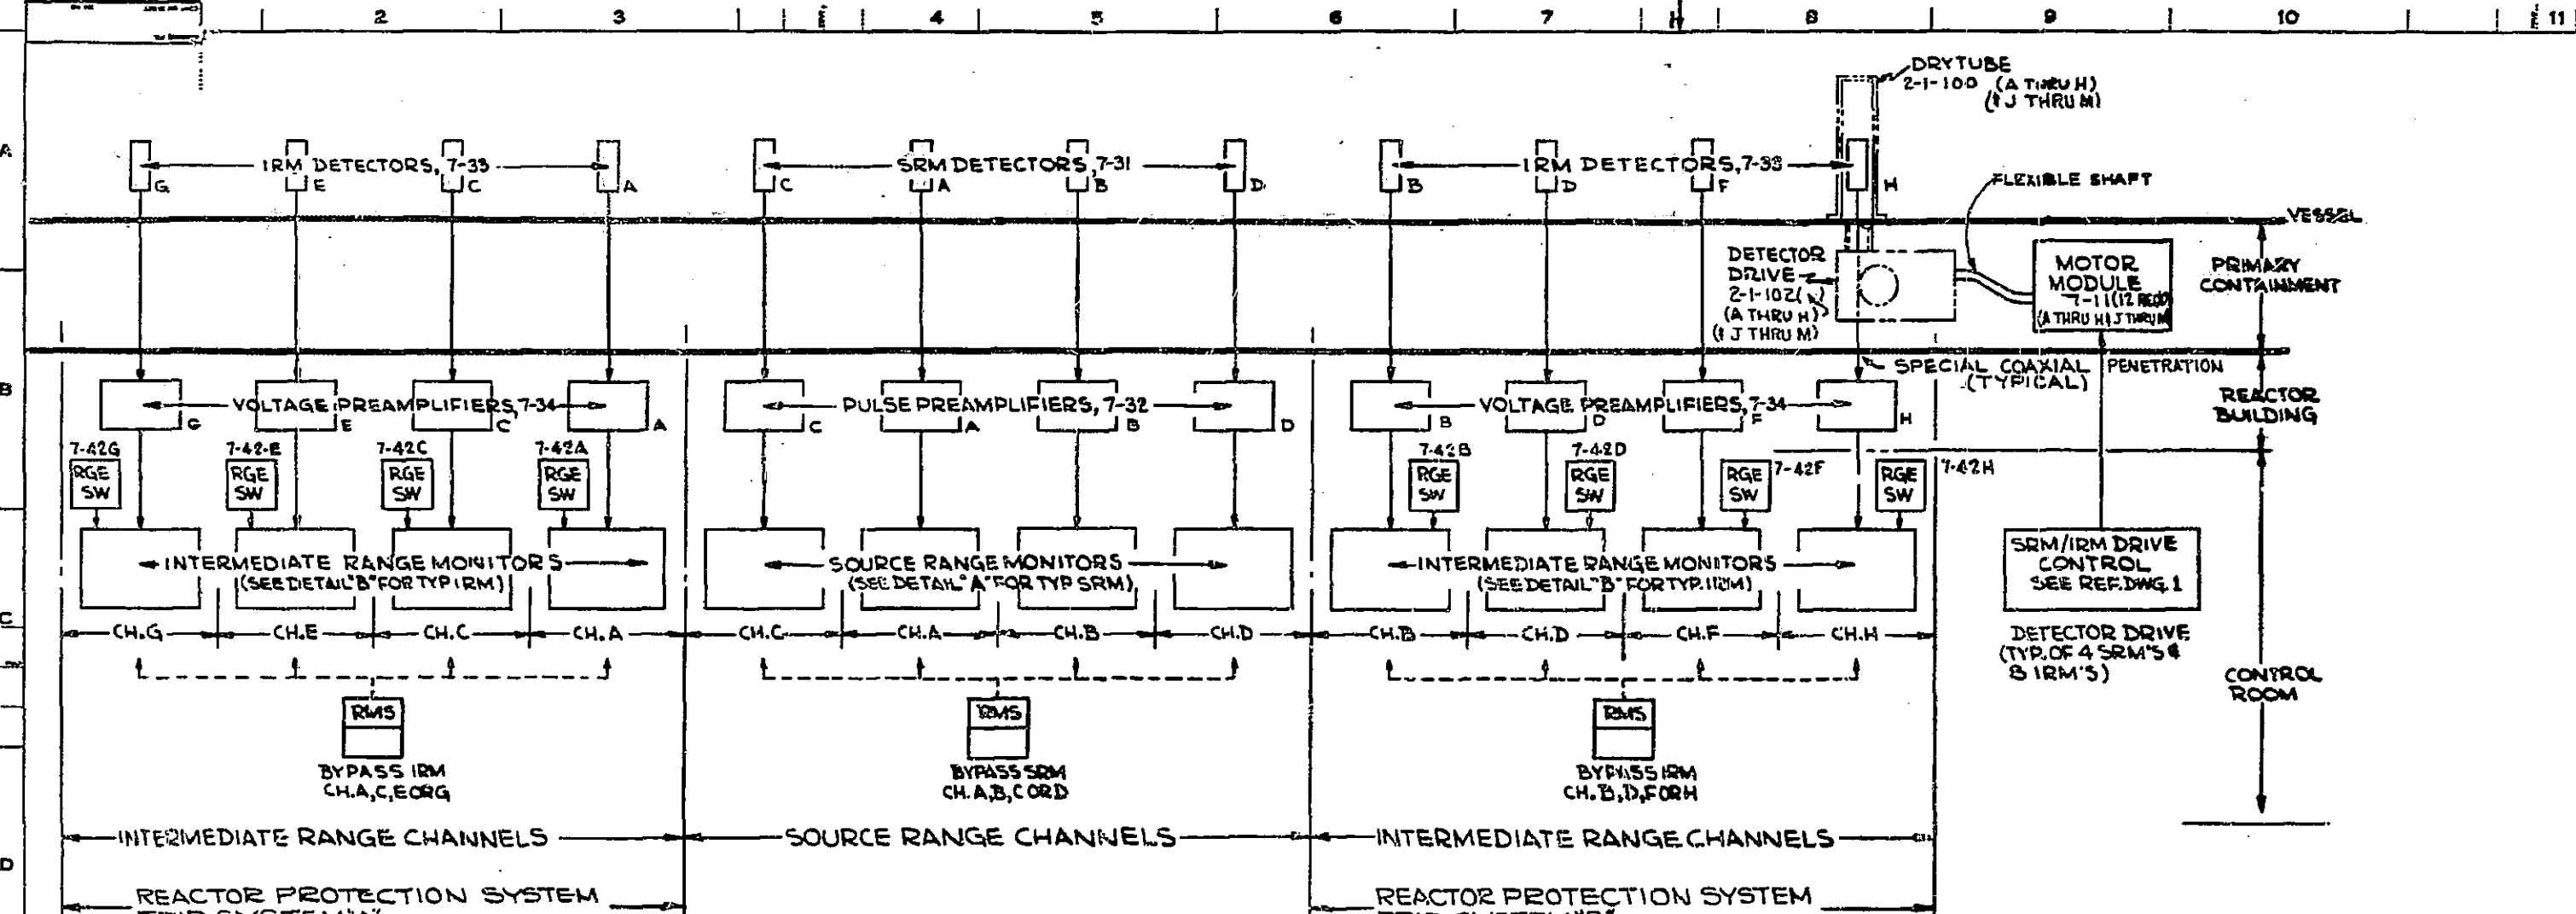

GENERAL ELECTRIC 729E22388

NEUTRON MONITORING SYSTEM




OVERALL REVISION 4

SUMMARY SHEET REV 1, 2, 3, 4

FCF 234221 88-7

NOTES

- PARTS MARKED \* ARE LOCATED ADJACENT TO OR ON THE SIGNAL CONDITIONING EQUIPMENT PERFORMING THE FUNCTION INDICATED.
- PARTS MARKED \*\* ARE LOCATED ON THE MAIN CONTROL PANEL.
- POSITION INFORMATION IS INPUT EVERY 1 INCH. FLUX LEVEL INFORMATION IS INPUT EVERY 3 INCHES ON WITHDRAWAL.
- FOR LOCATION AND IDENTIFICATION OF INSTRUMENTS SEE INSTRUMENT DATA SHEET LISTED IN MPL FOR EACH INSTRUMENT.
- FLOW UNIT INCLUDES FLOW SUMMER, POWER SUPPLY, SQUARE ROOT FUNCTIONS AS SHOWN ON REF DWG 2.

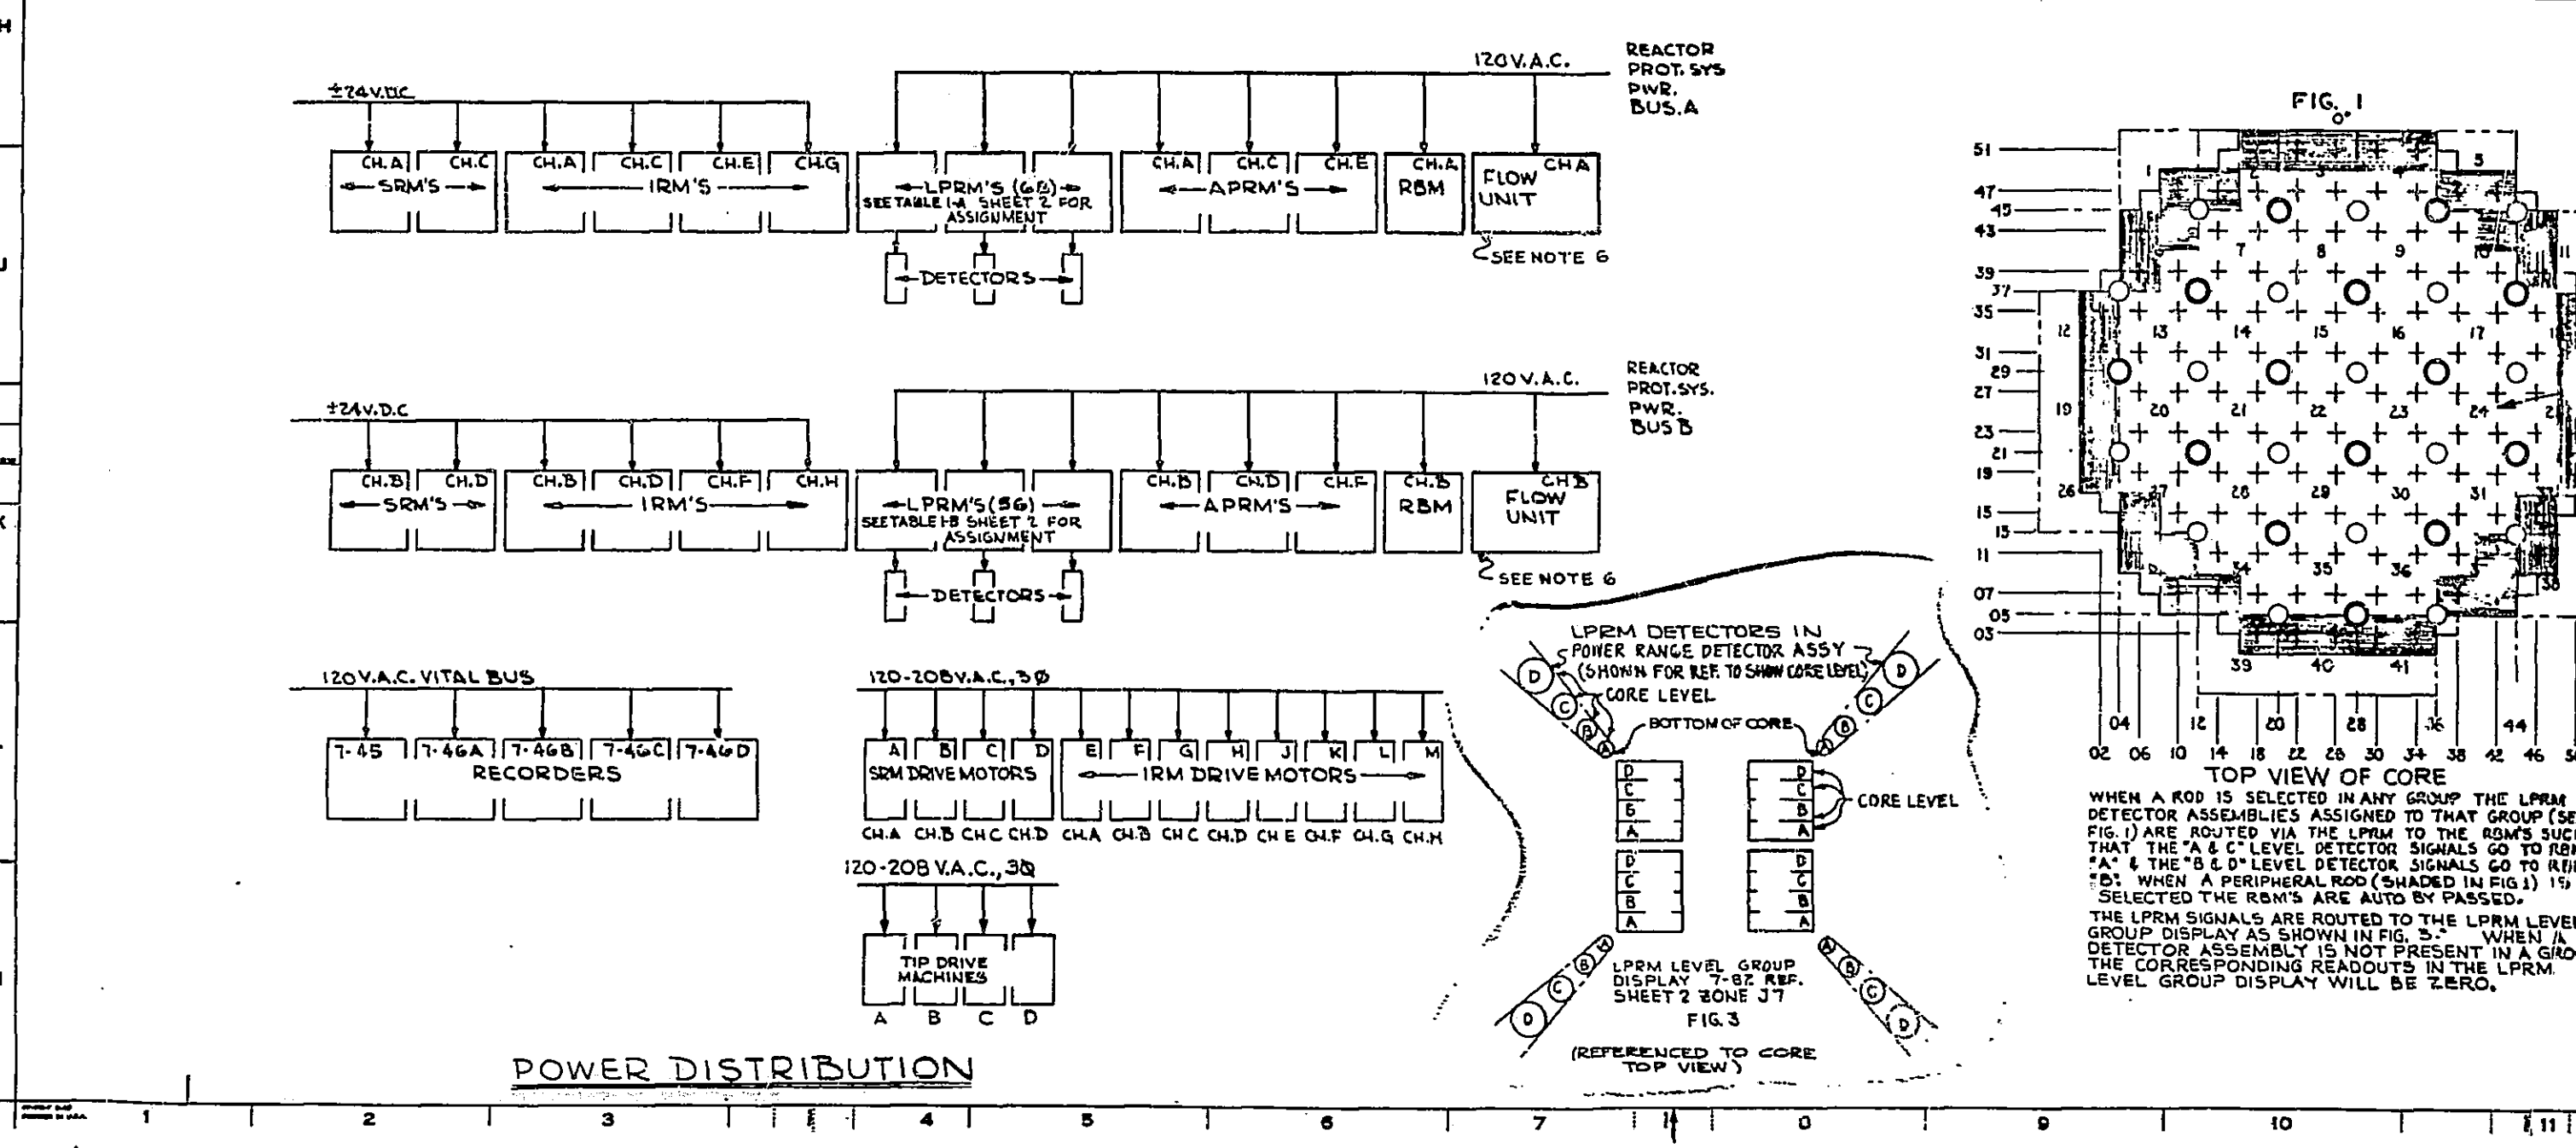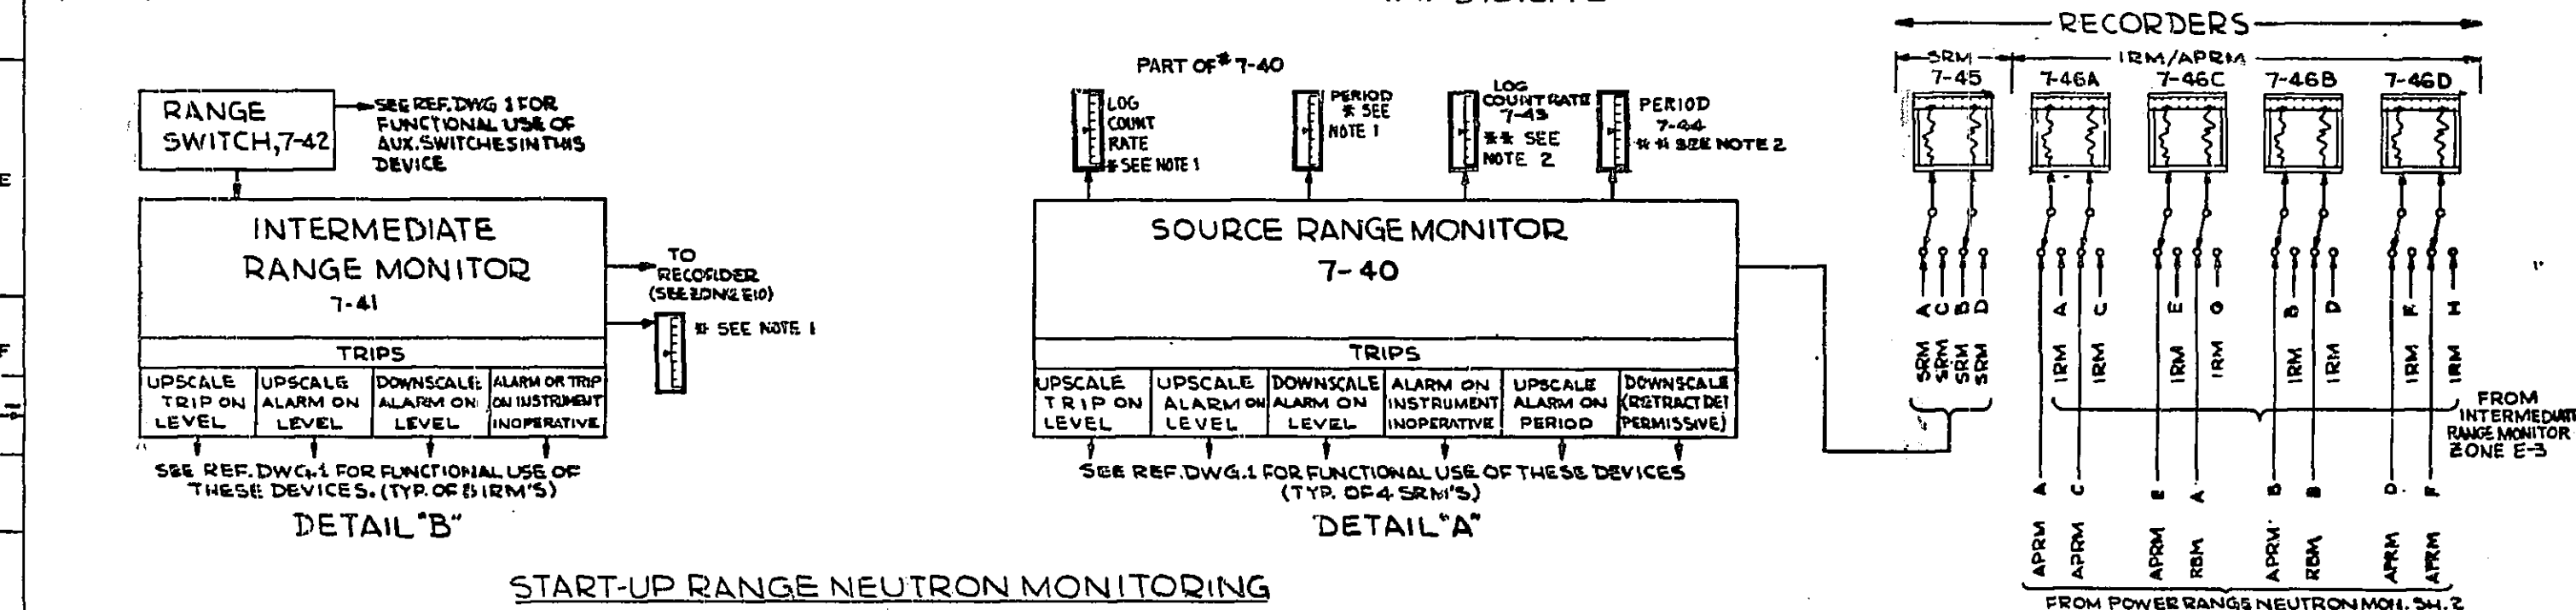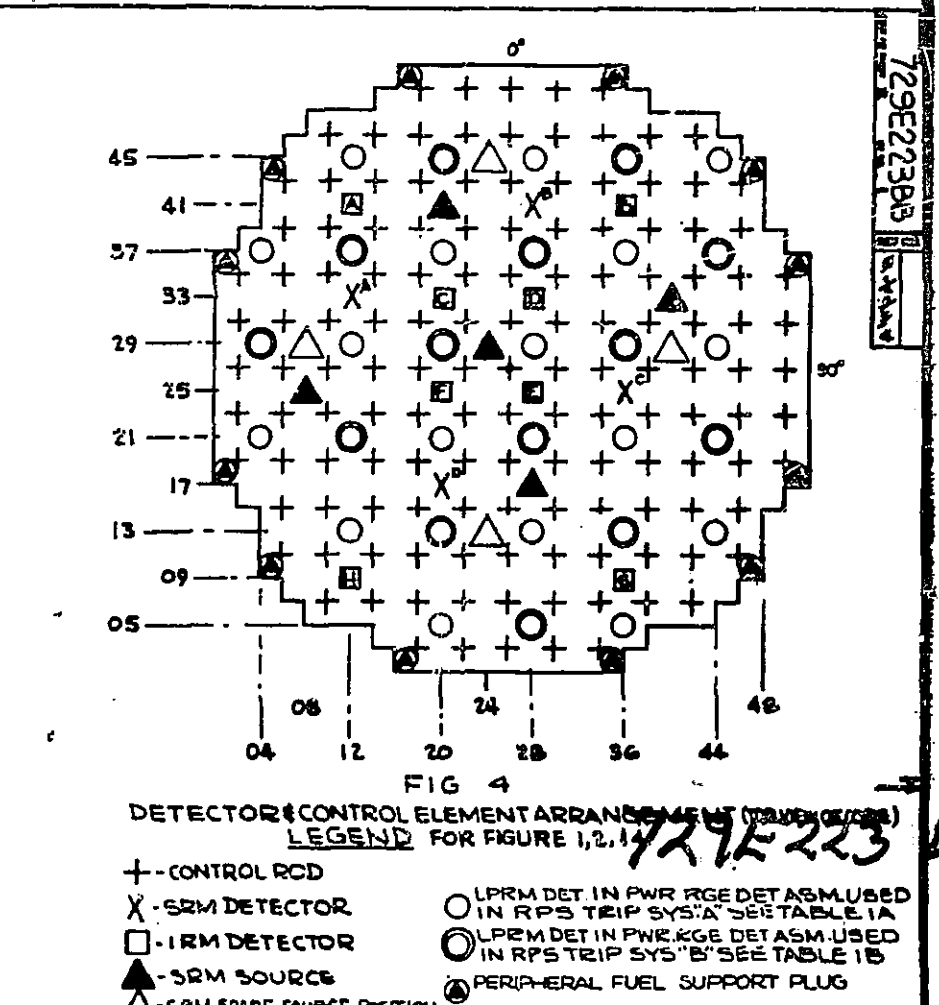

COOPER STATION

MPL # 7

452005383

REFERENCE DWGS

- MPL 7-2 FUNCTIONAL CONTROL DIAGRAM, NEUTRON MONITORING SYSTEM
- MPL -2 PID NUCLEAR BOILER
- MPL 3-7 FCD CONTROL ROD DRIVE HYDRAULIC SYSTEM
- 921D280 INSTRUMENT SYMBOLS
- 107R567 PIPING & INSTRUMENT SYMBOLS
- MPL 2-1 REACTOR VESSEL
- 730E100 ARCT DWG. - NEUTRON MONITORING SYS.

REFERENCE ENGINEERING SPECIFICATIONS

A. MPL-1 DESIGN SPECIFICATION NEUTRON MONITORING SYSTEM.

REVISIONS

DATE

BY

CHKD

APP'D








729E22388

13



TABLE 1A


TABLE 1B

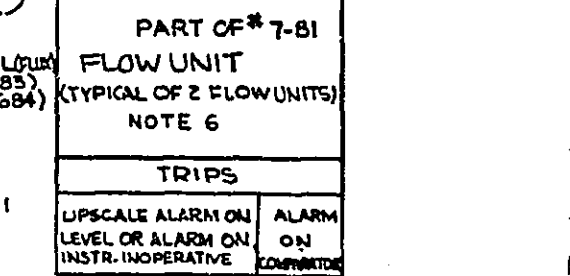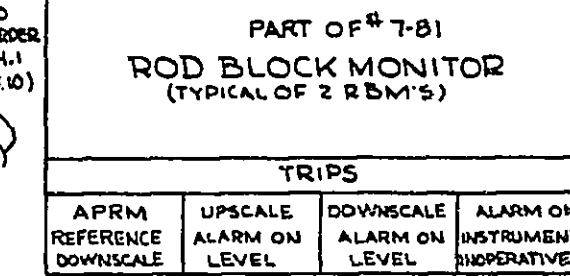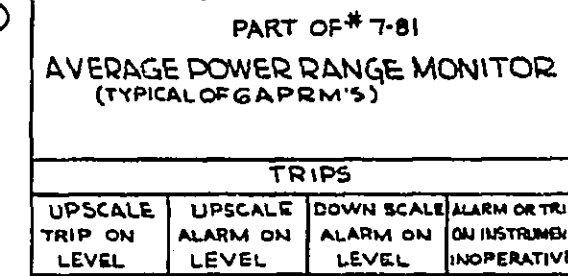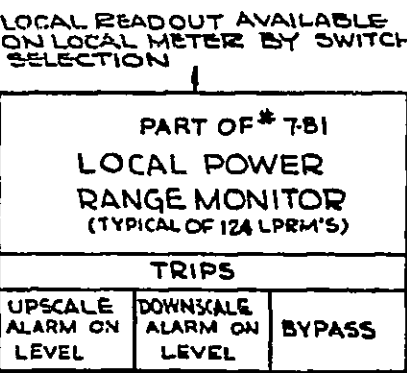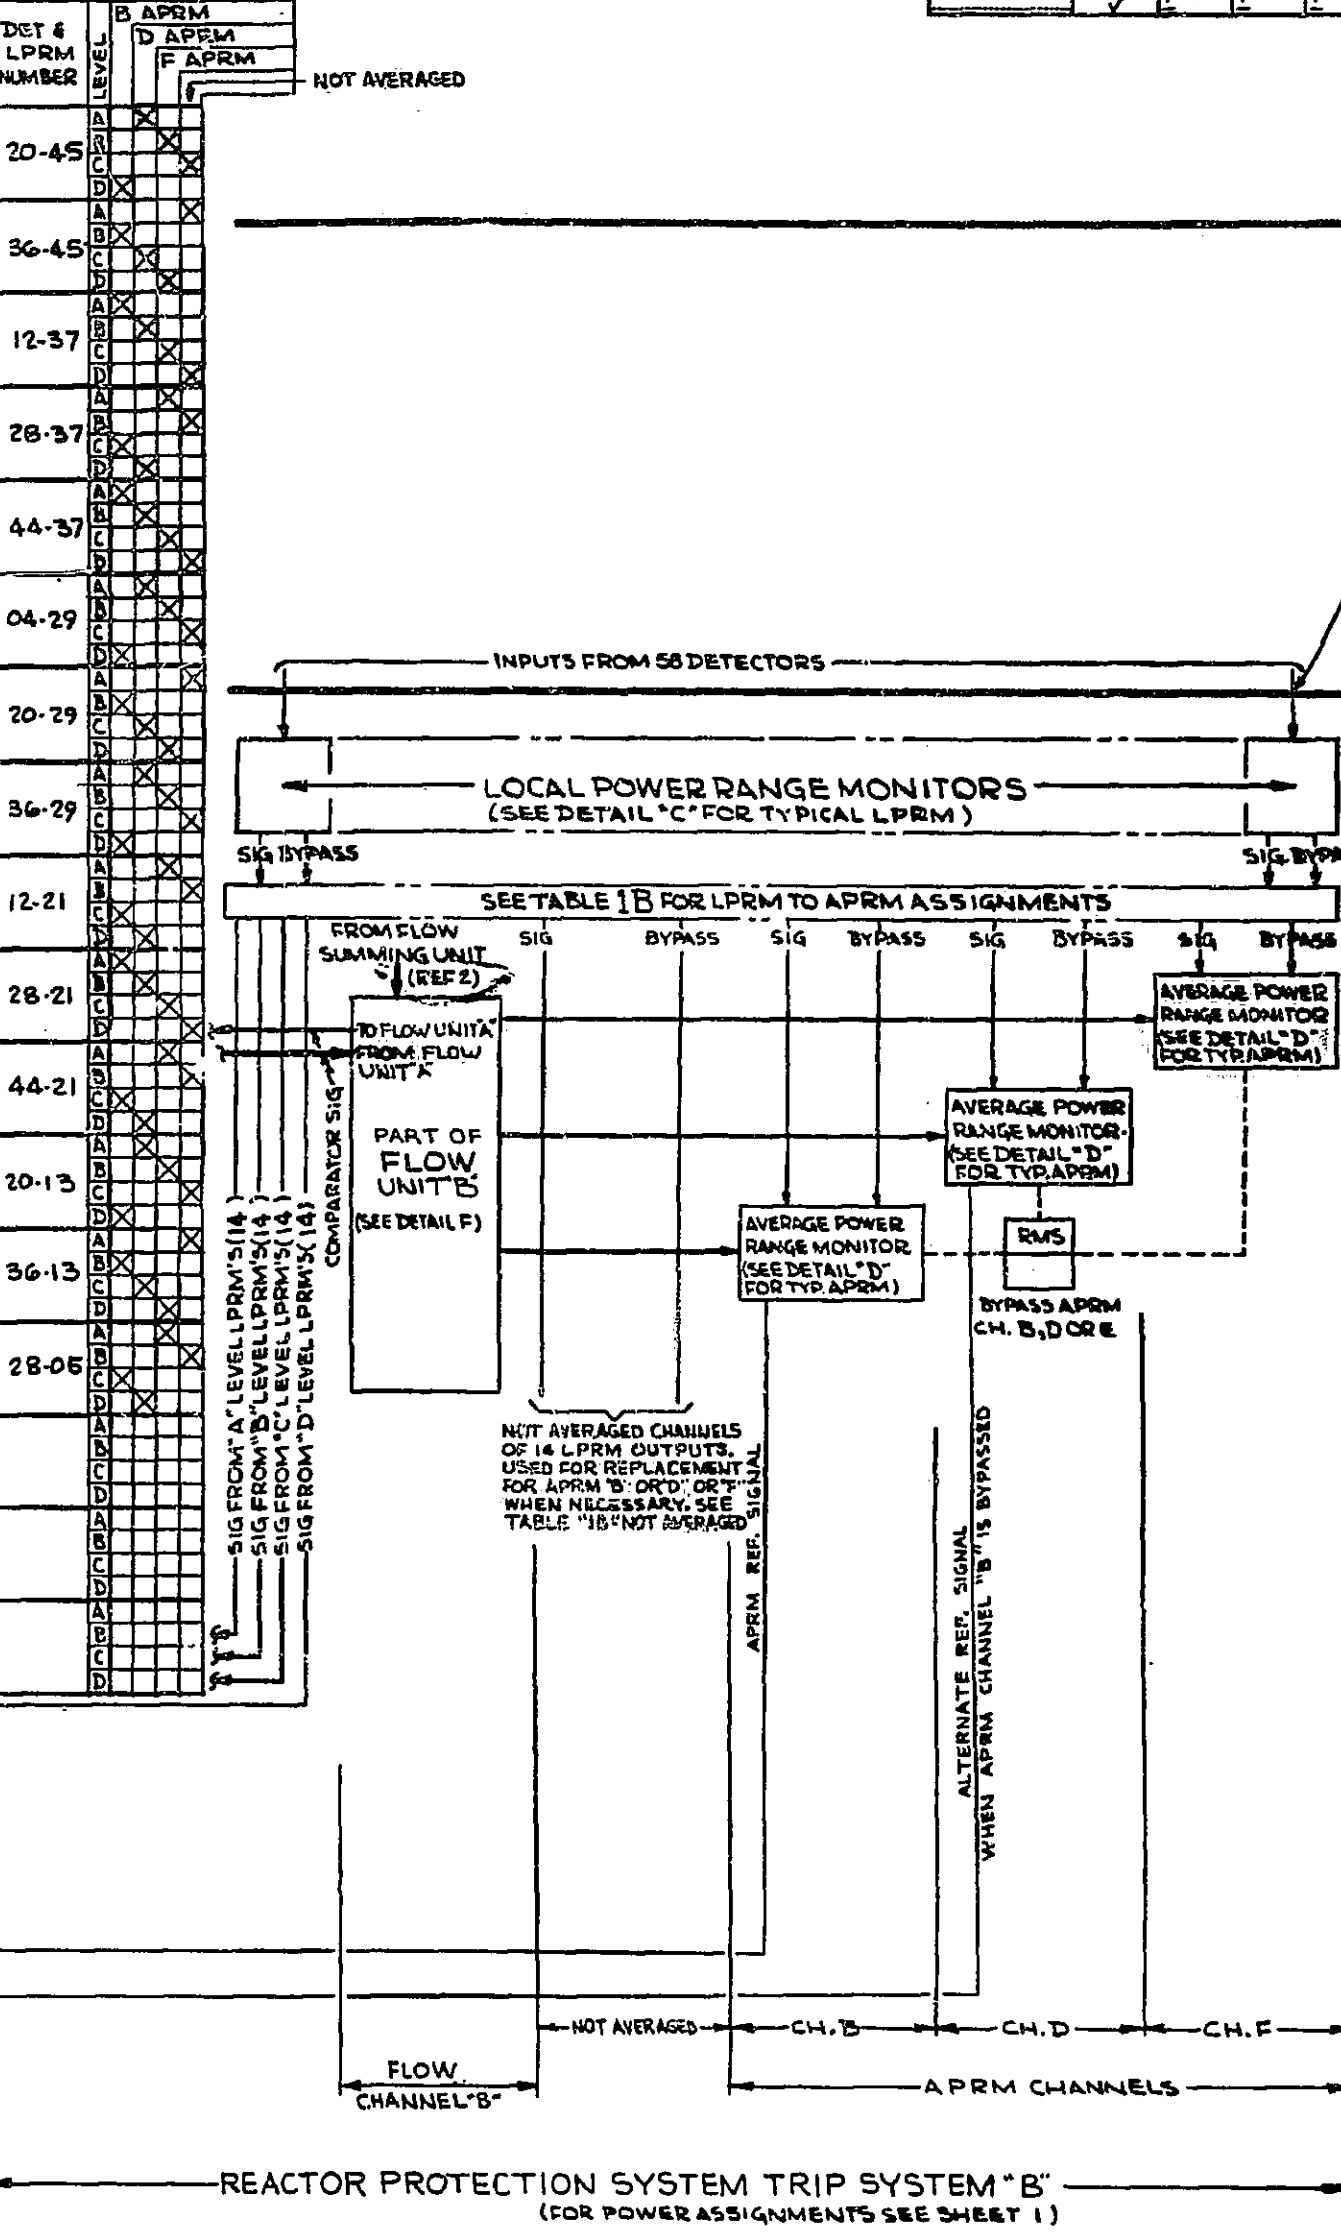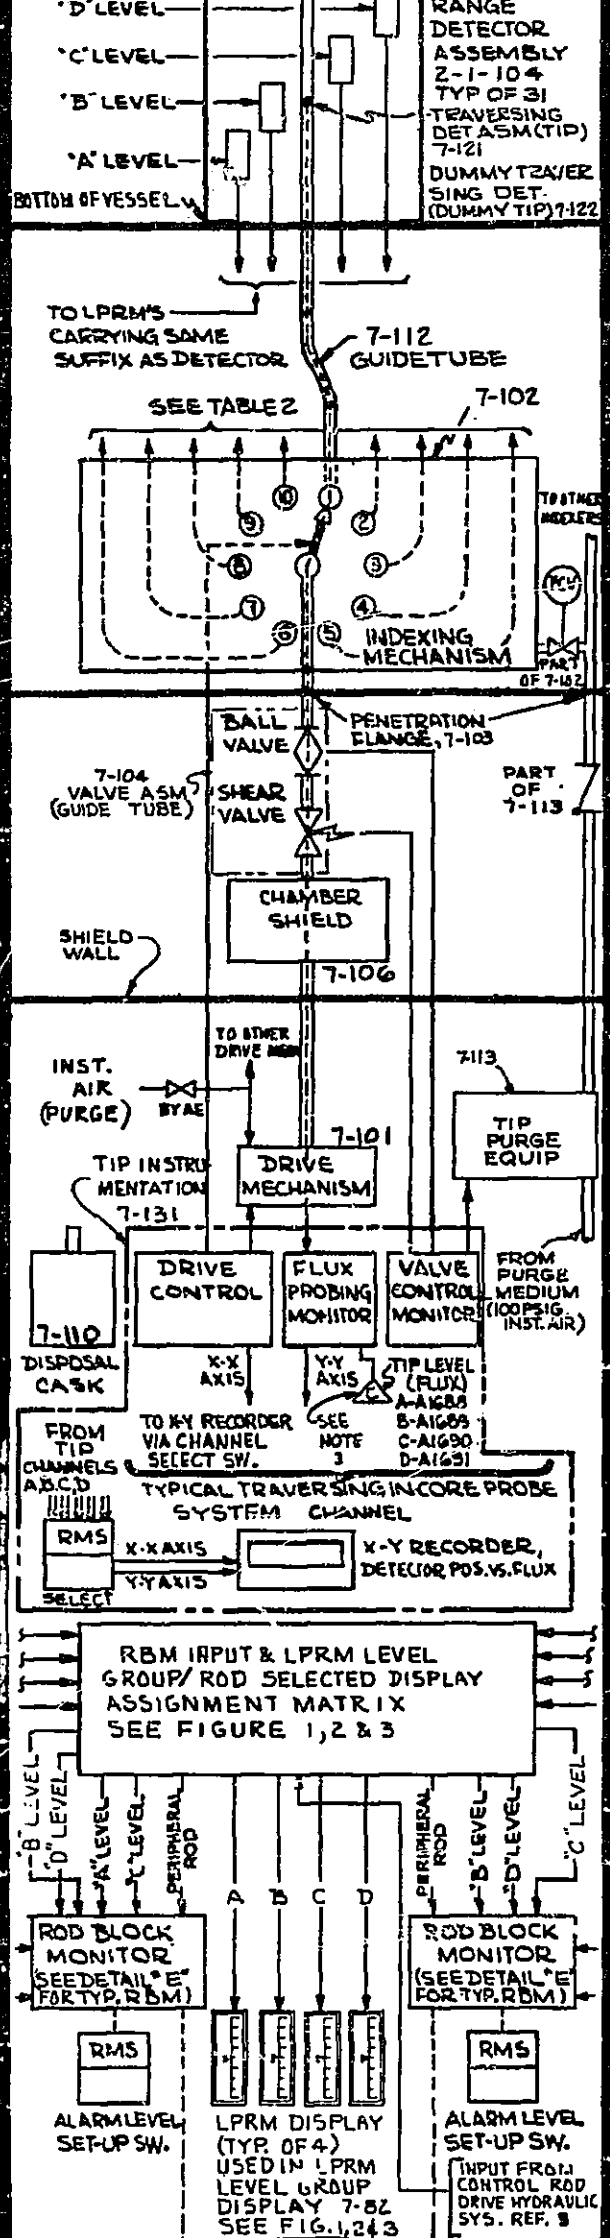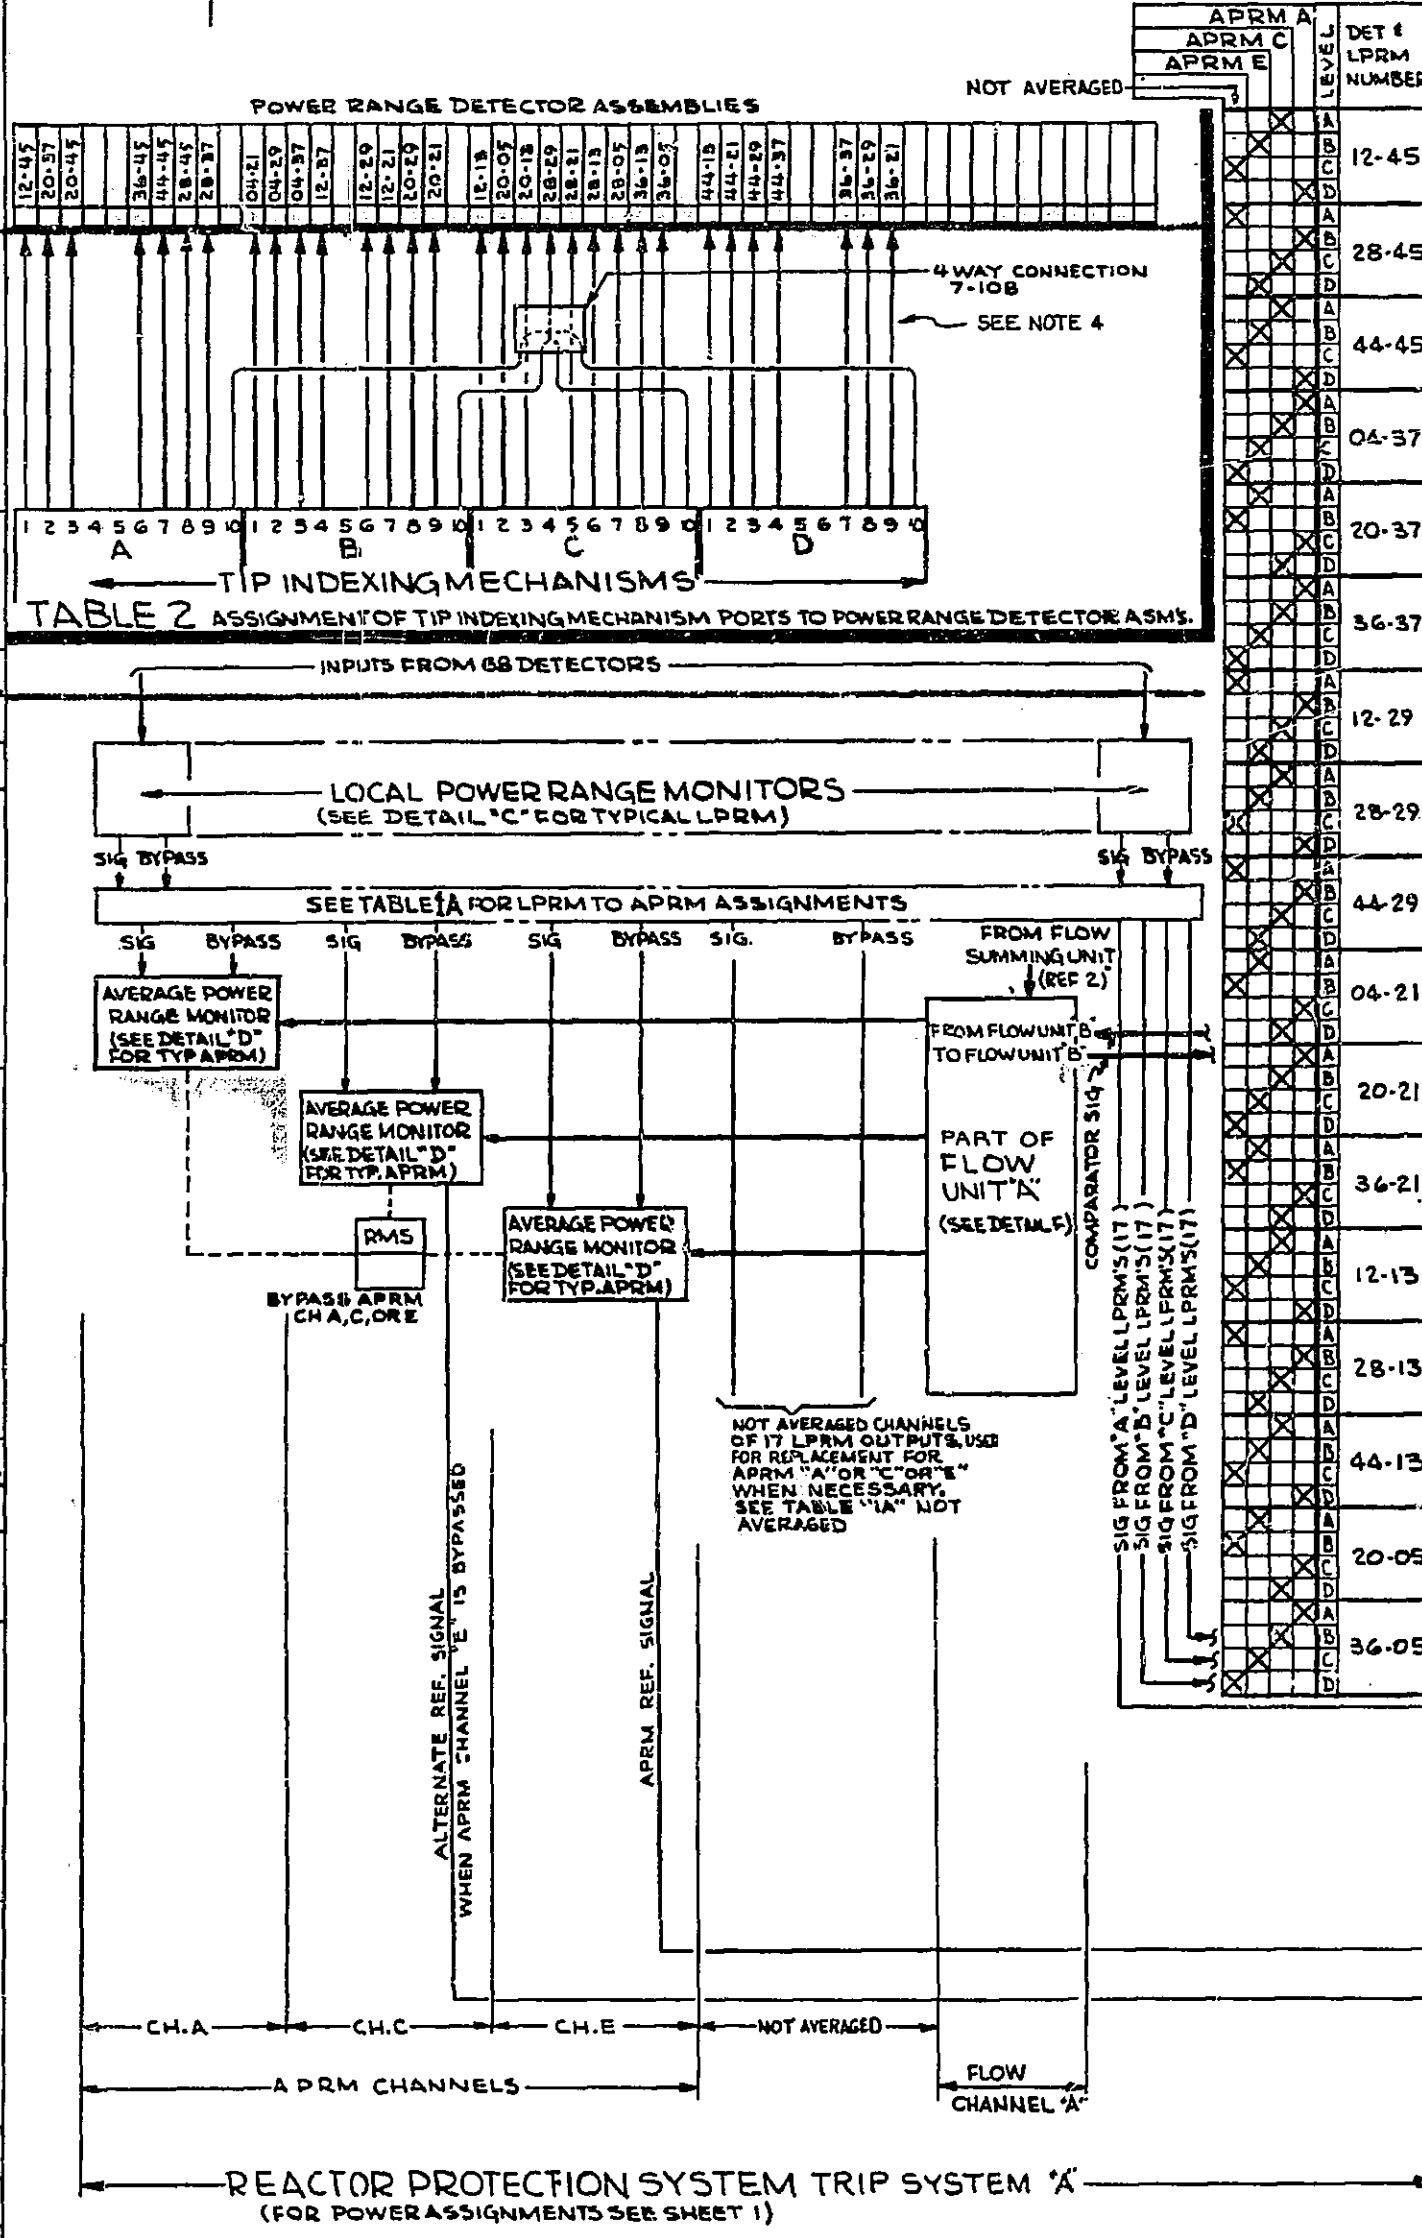


INFORMATION ONLY


FOR INFORMATION ONLY  
Note: This drawing will not be updated  
refer to B & R drawings for current status  
NPPD Records Administrator

NO.	REV.	PER	DATE	BY	CHK	APP	DATE
1	1	1	1	1	1	1	1
2	1	1	1	1	1	1	1
3	1	1	1	1	1	1	1
4	1	1	1	1	1	1	1
5	1	1	1	1	1	1	1
6	1	1	1	1	1	1	1
7	1	1	1	1	1	1	1
8	1	1	1	1	1	1	1
9	1	1	1	1	1	1	1
10	1	1	1	1	1	1	1
11	1	1	1	1	1	1	1
12	1	1	1	1	1	1	1

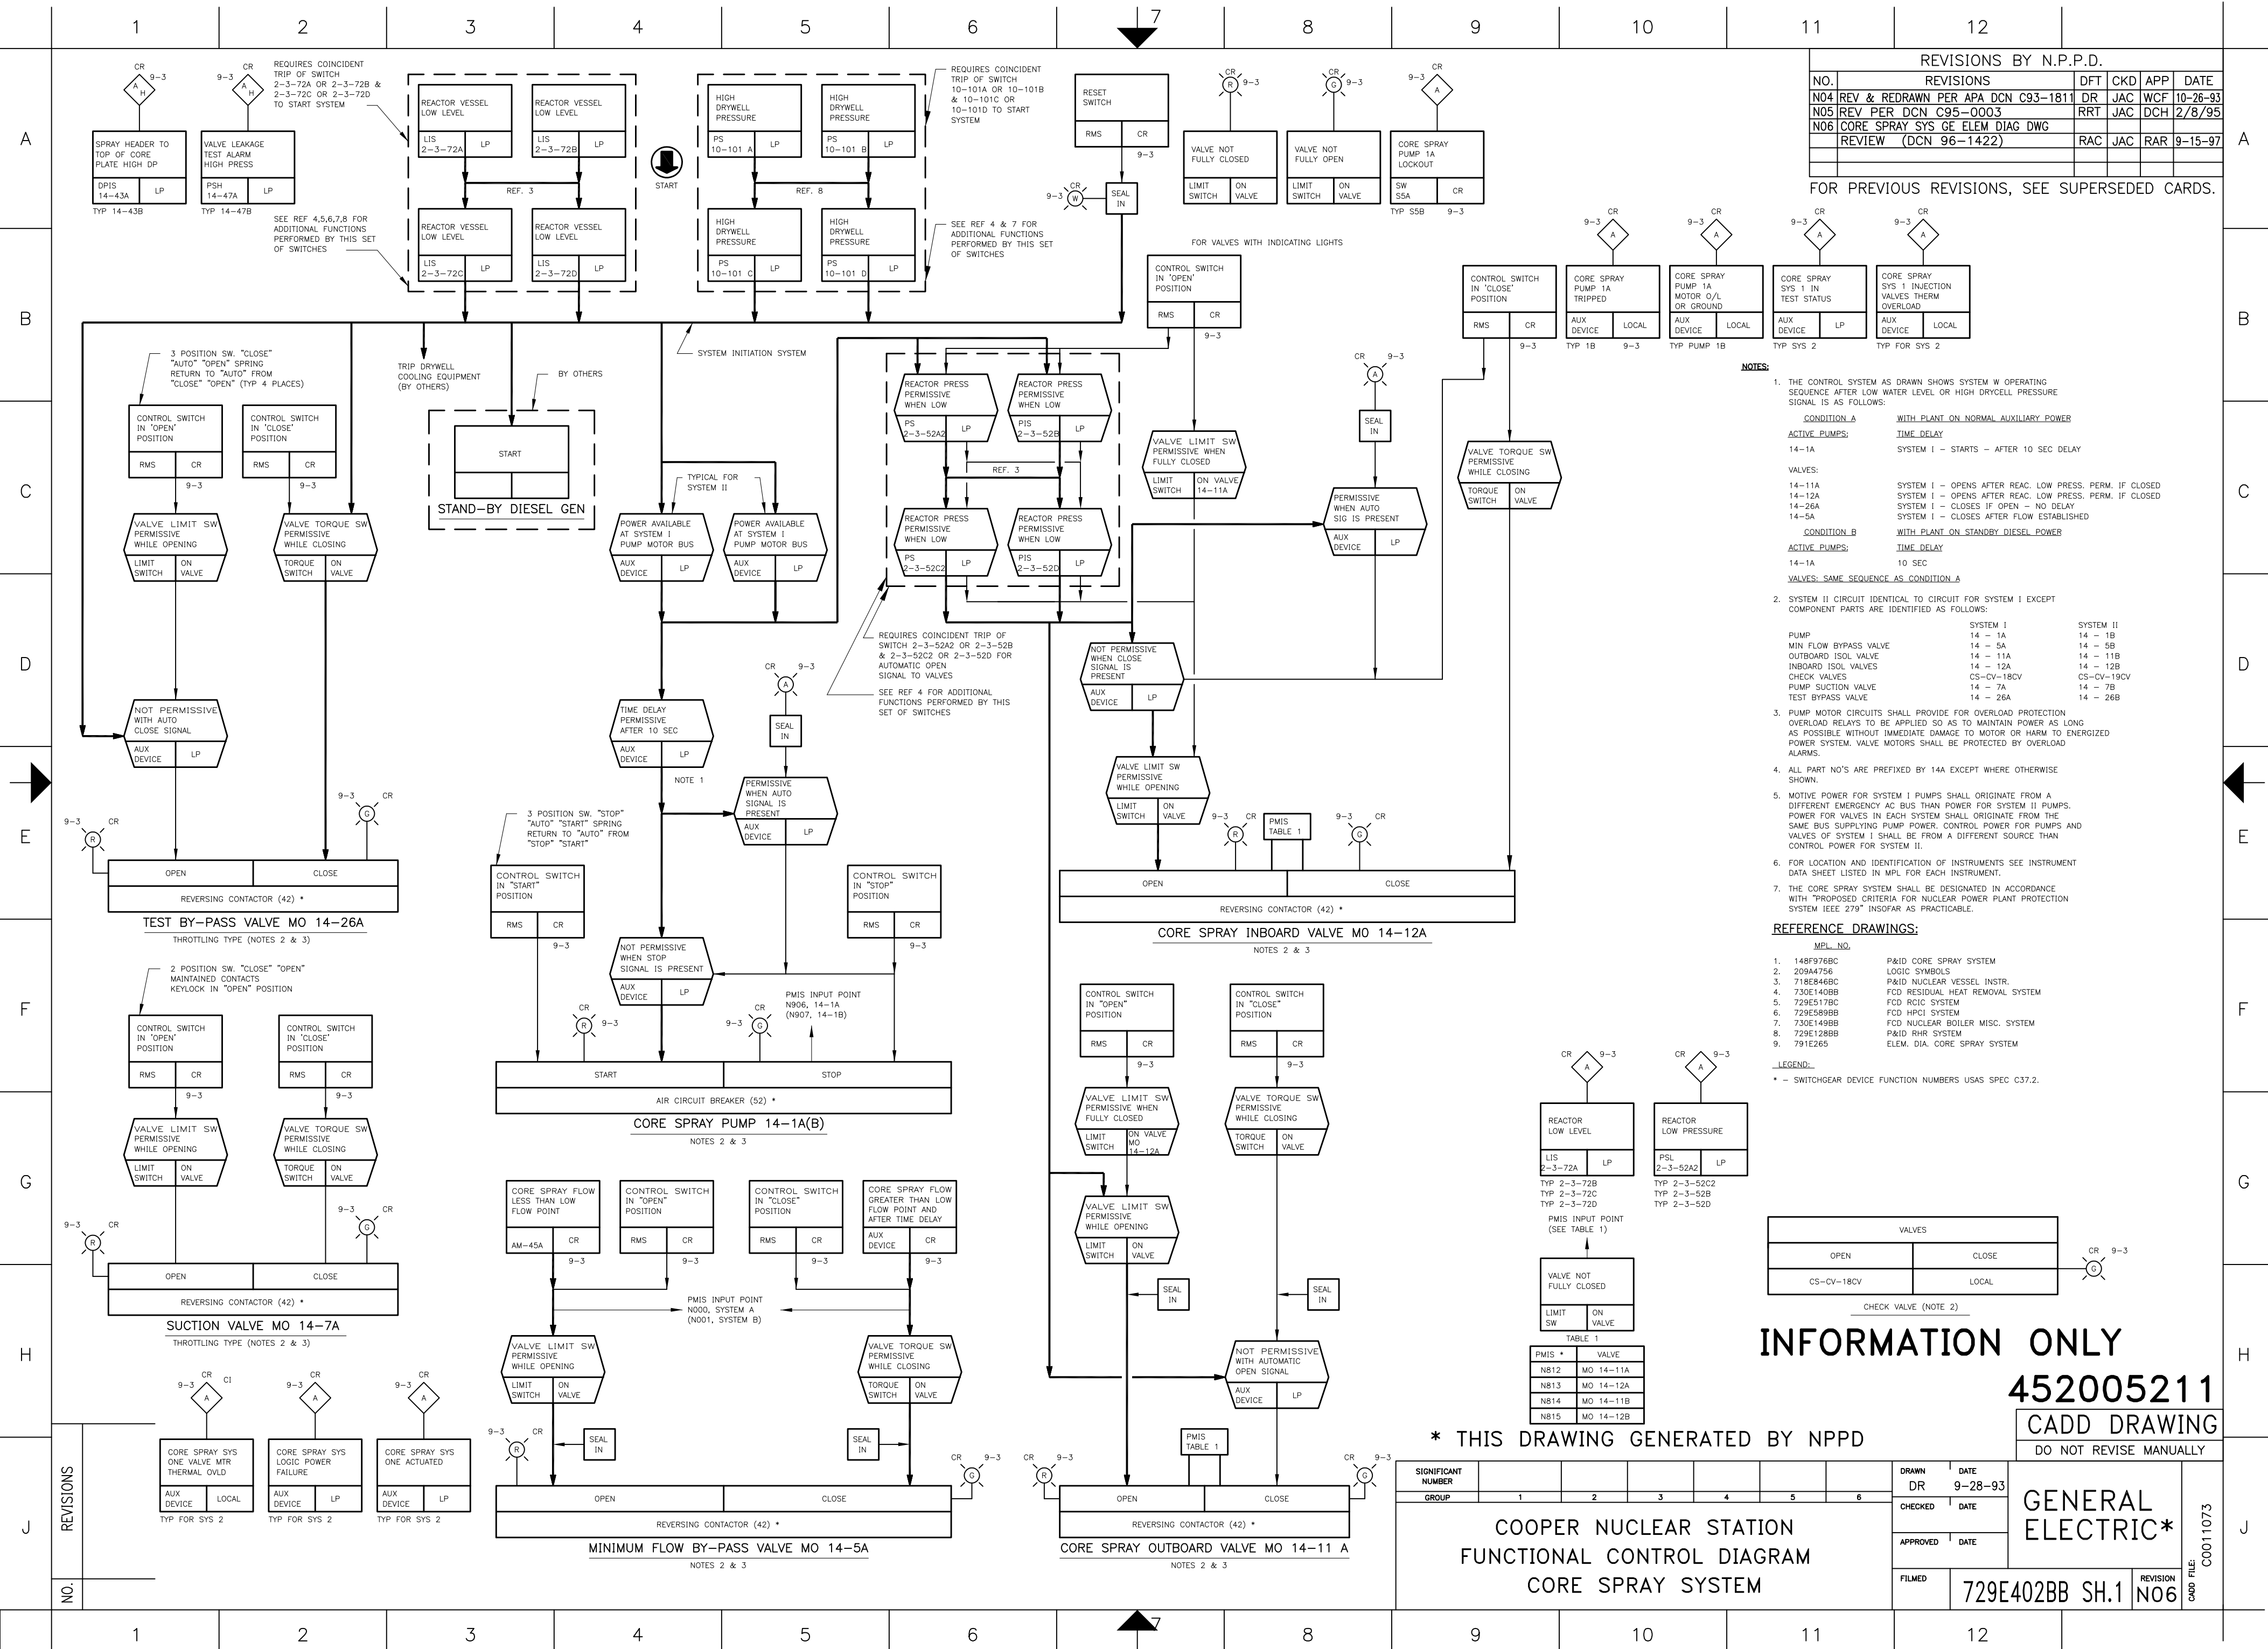



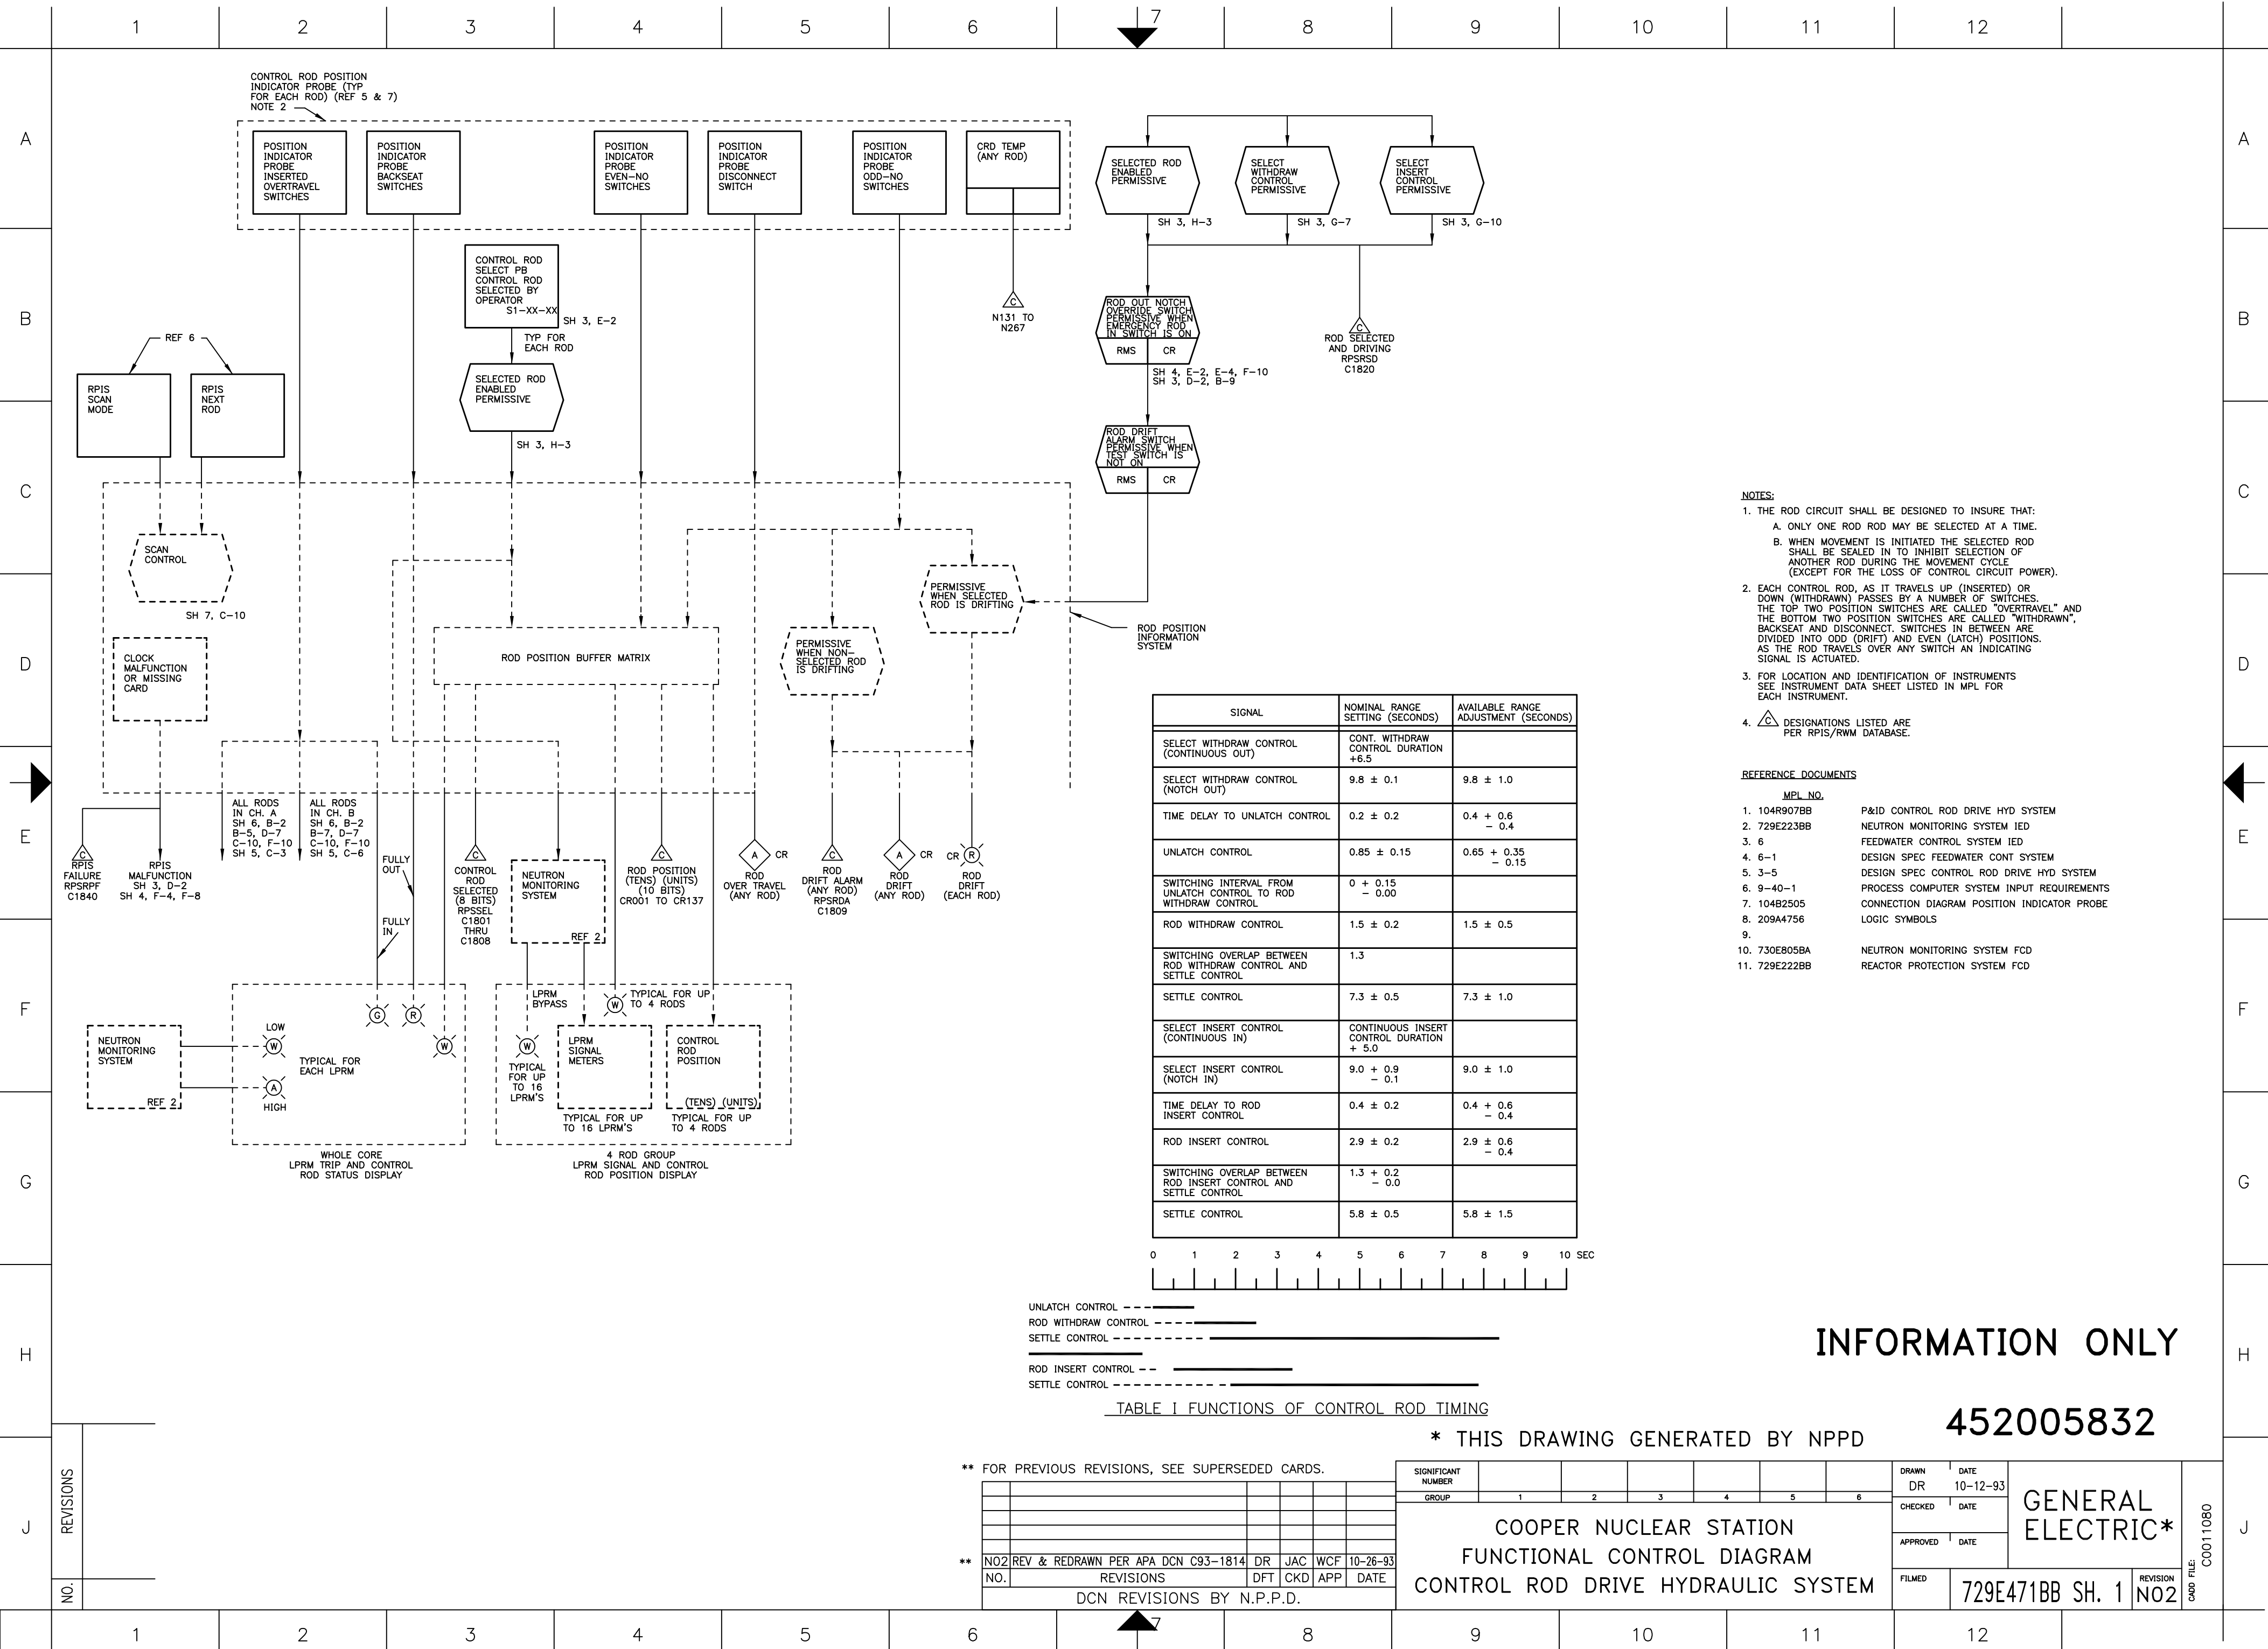

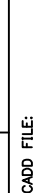



A

B

C

D

E

F

G

H

J

A

B

C

D


E

F

G

H

J

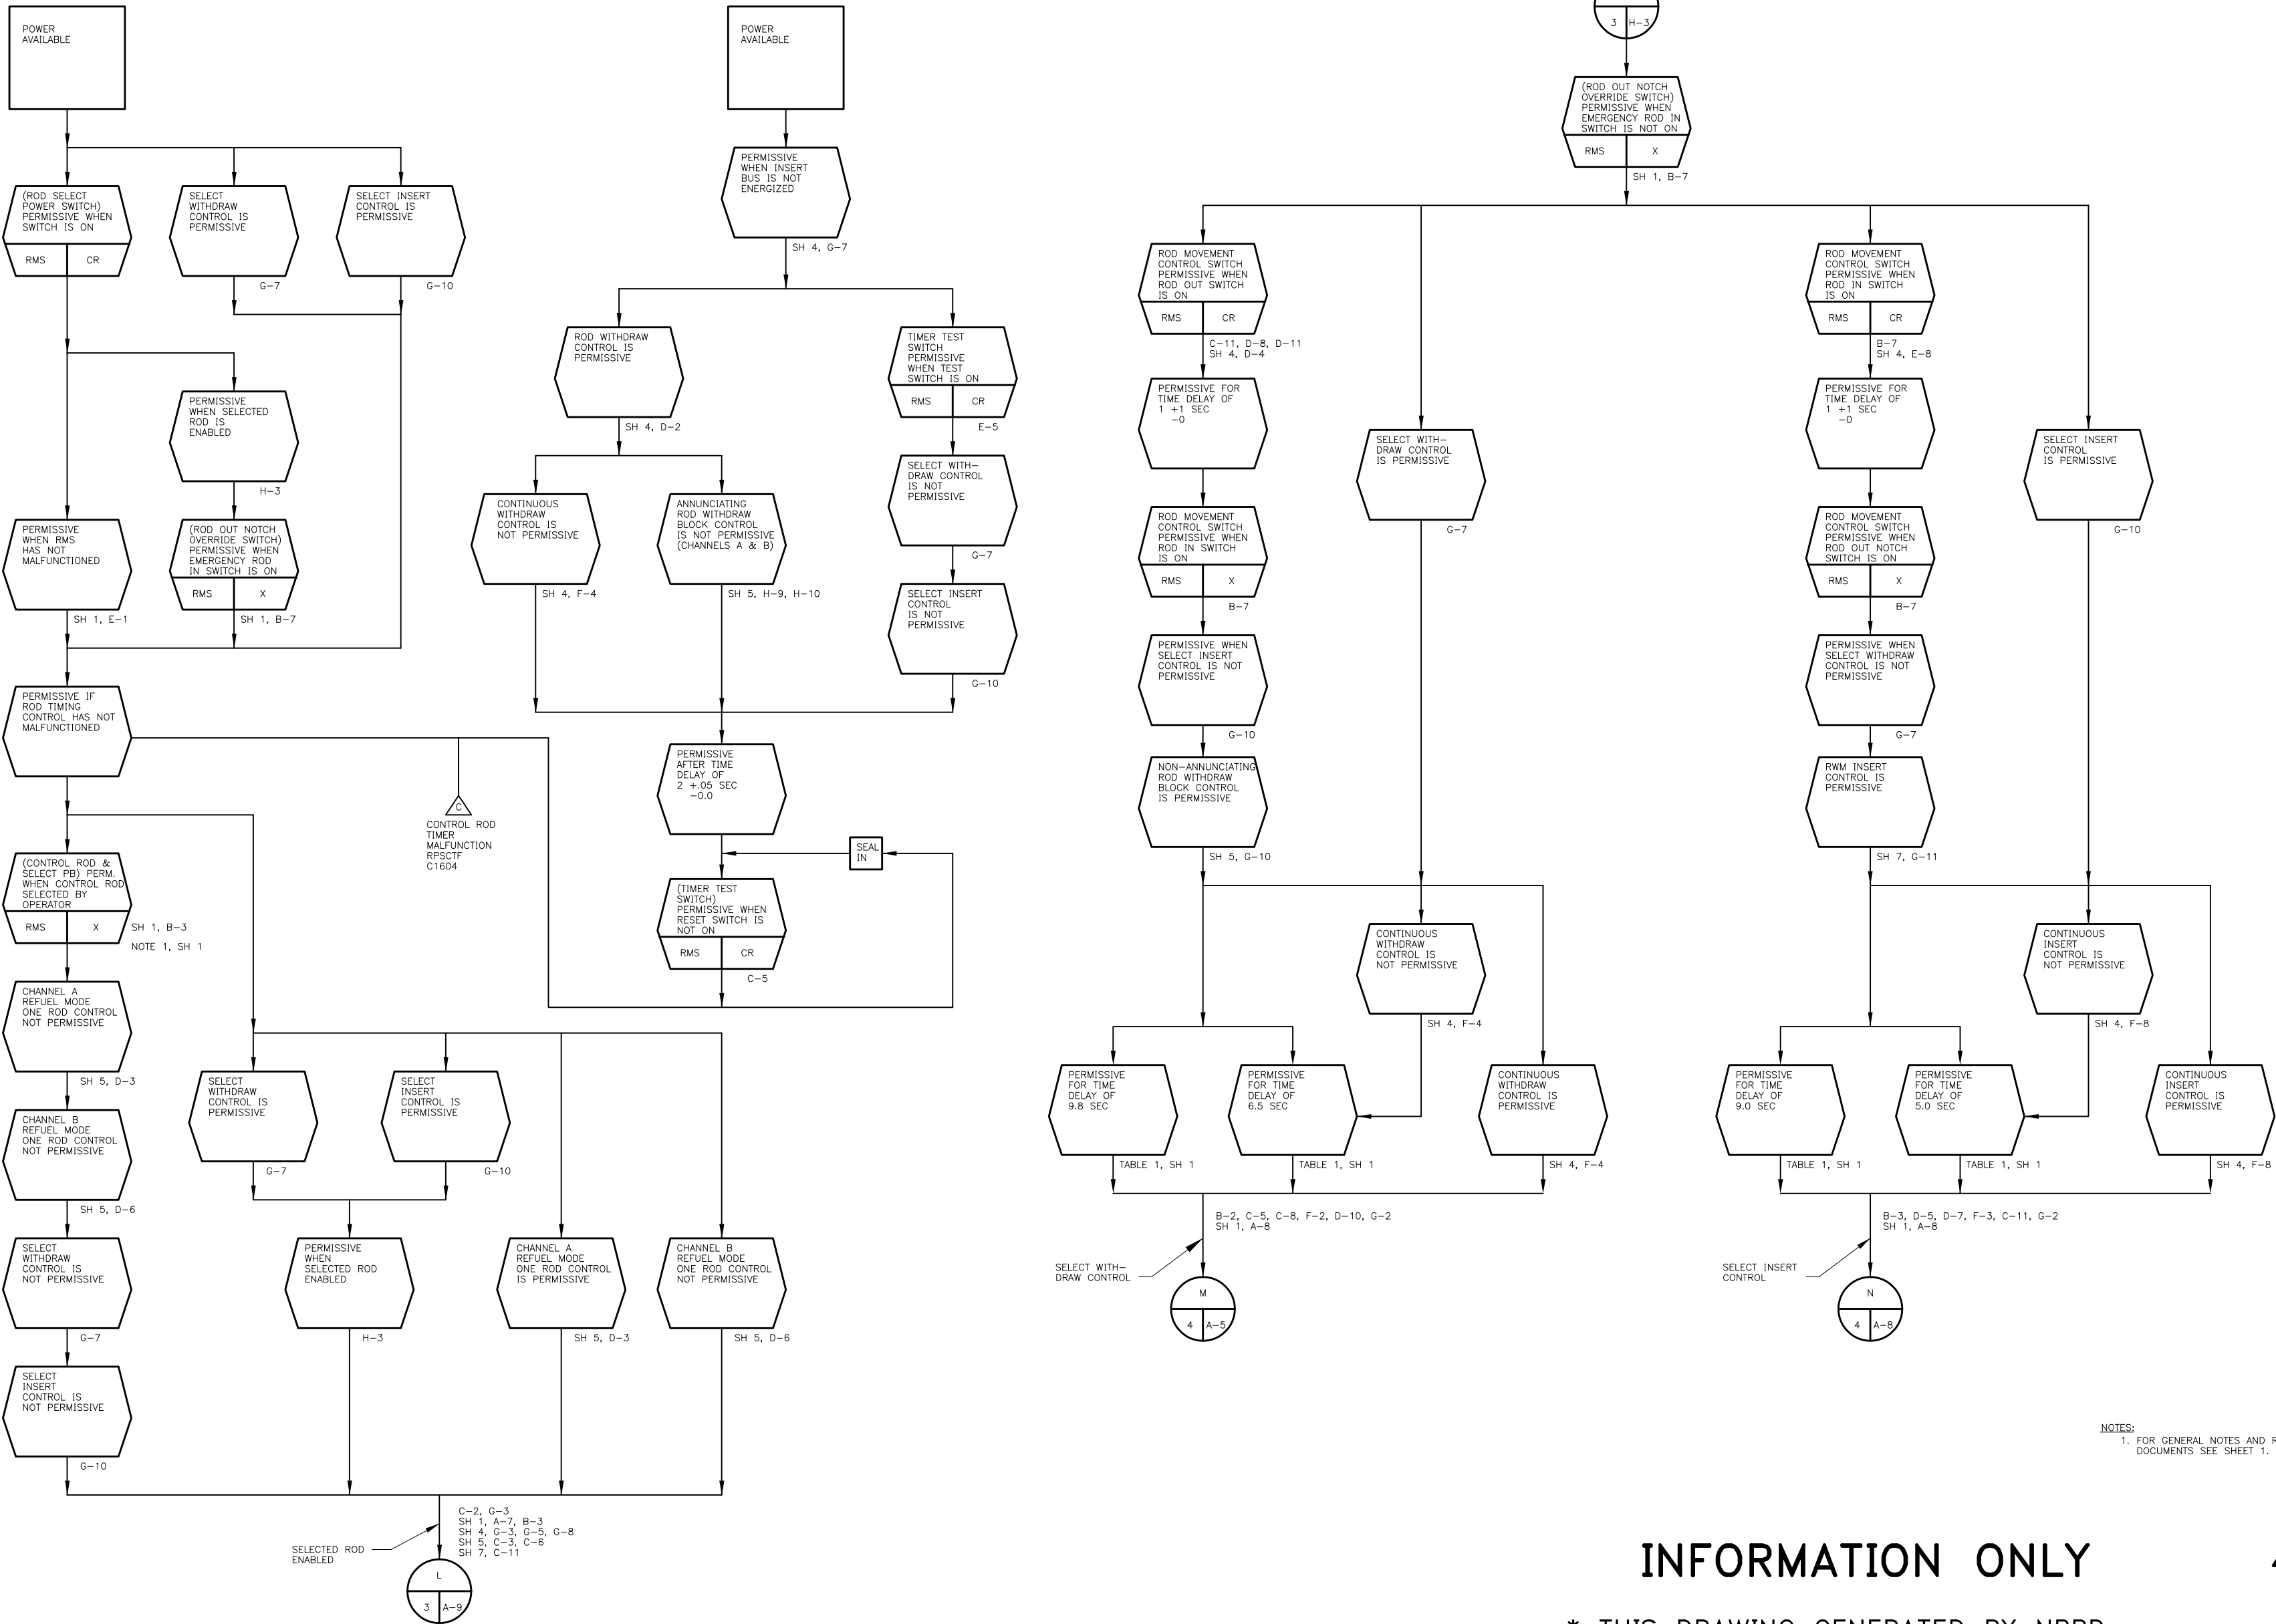

NOTES:  
1. FOR GENERAL NOTES AND REFERENCE DOCUMENTS SEE SHEET 1.

INFORMATION ONLY 452005834

\* THIS DRAWING GENERATED BY NPPD

CADD DRAWING  
DO NOT REVISE MANUALLY

\*\* FOR PREVIOUS REVISIONS, SEE SUPERSEDED CARDS.

NO.	REVISIONS	DR	JAC	AGB	11-23-93
NO2	REVISED AND REDRAWN PER APA DCN C93-1816	DR	JAC	AGB	11-23-93
DCN REVISIONS BY N.P.P.D.					

SIGNIFICANT NUMBER	1	2	3	4	5	6
GROUP	1	2	3	4	5	6
COOPER NUCLEAR STATION FUNCTIONAL CONTROL DIAGRAM CONTROL ROD DRIVE HYDRAULIC SYSTEM						

DRAWN DR	DATE 10-29-93
CHECKED JAC	DATE 11-9-93
APPROVED AGB	DATE 11-23-93
FILMED	729E471BB SH. 3
REVISION NO2	CADD FILE: CO011082

REVISIONS

NO.

1

2

3

4

5

6

8

9


10

11

12





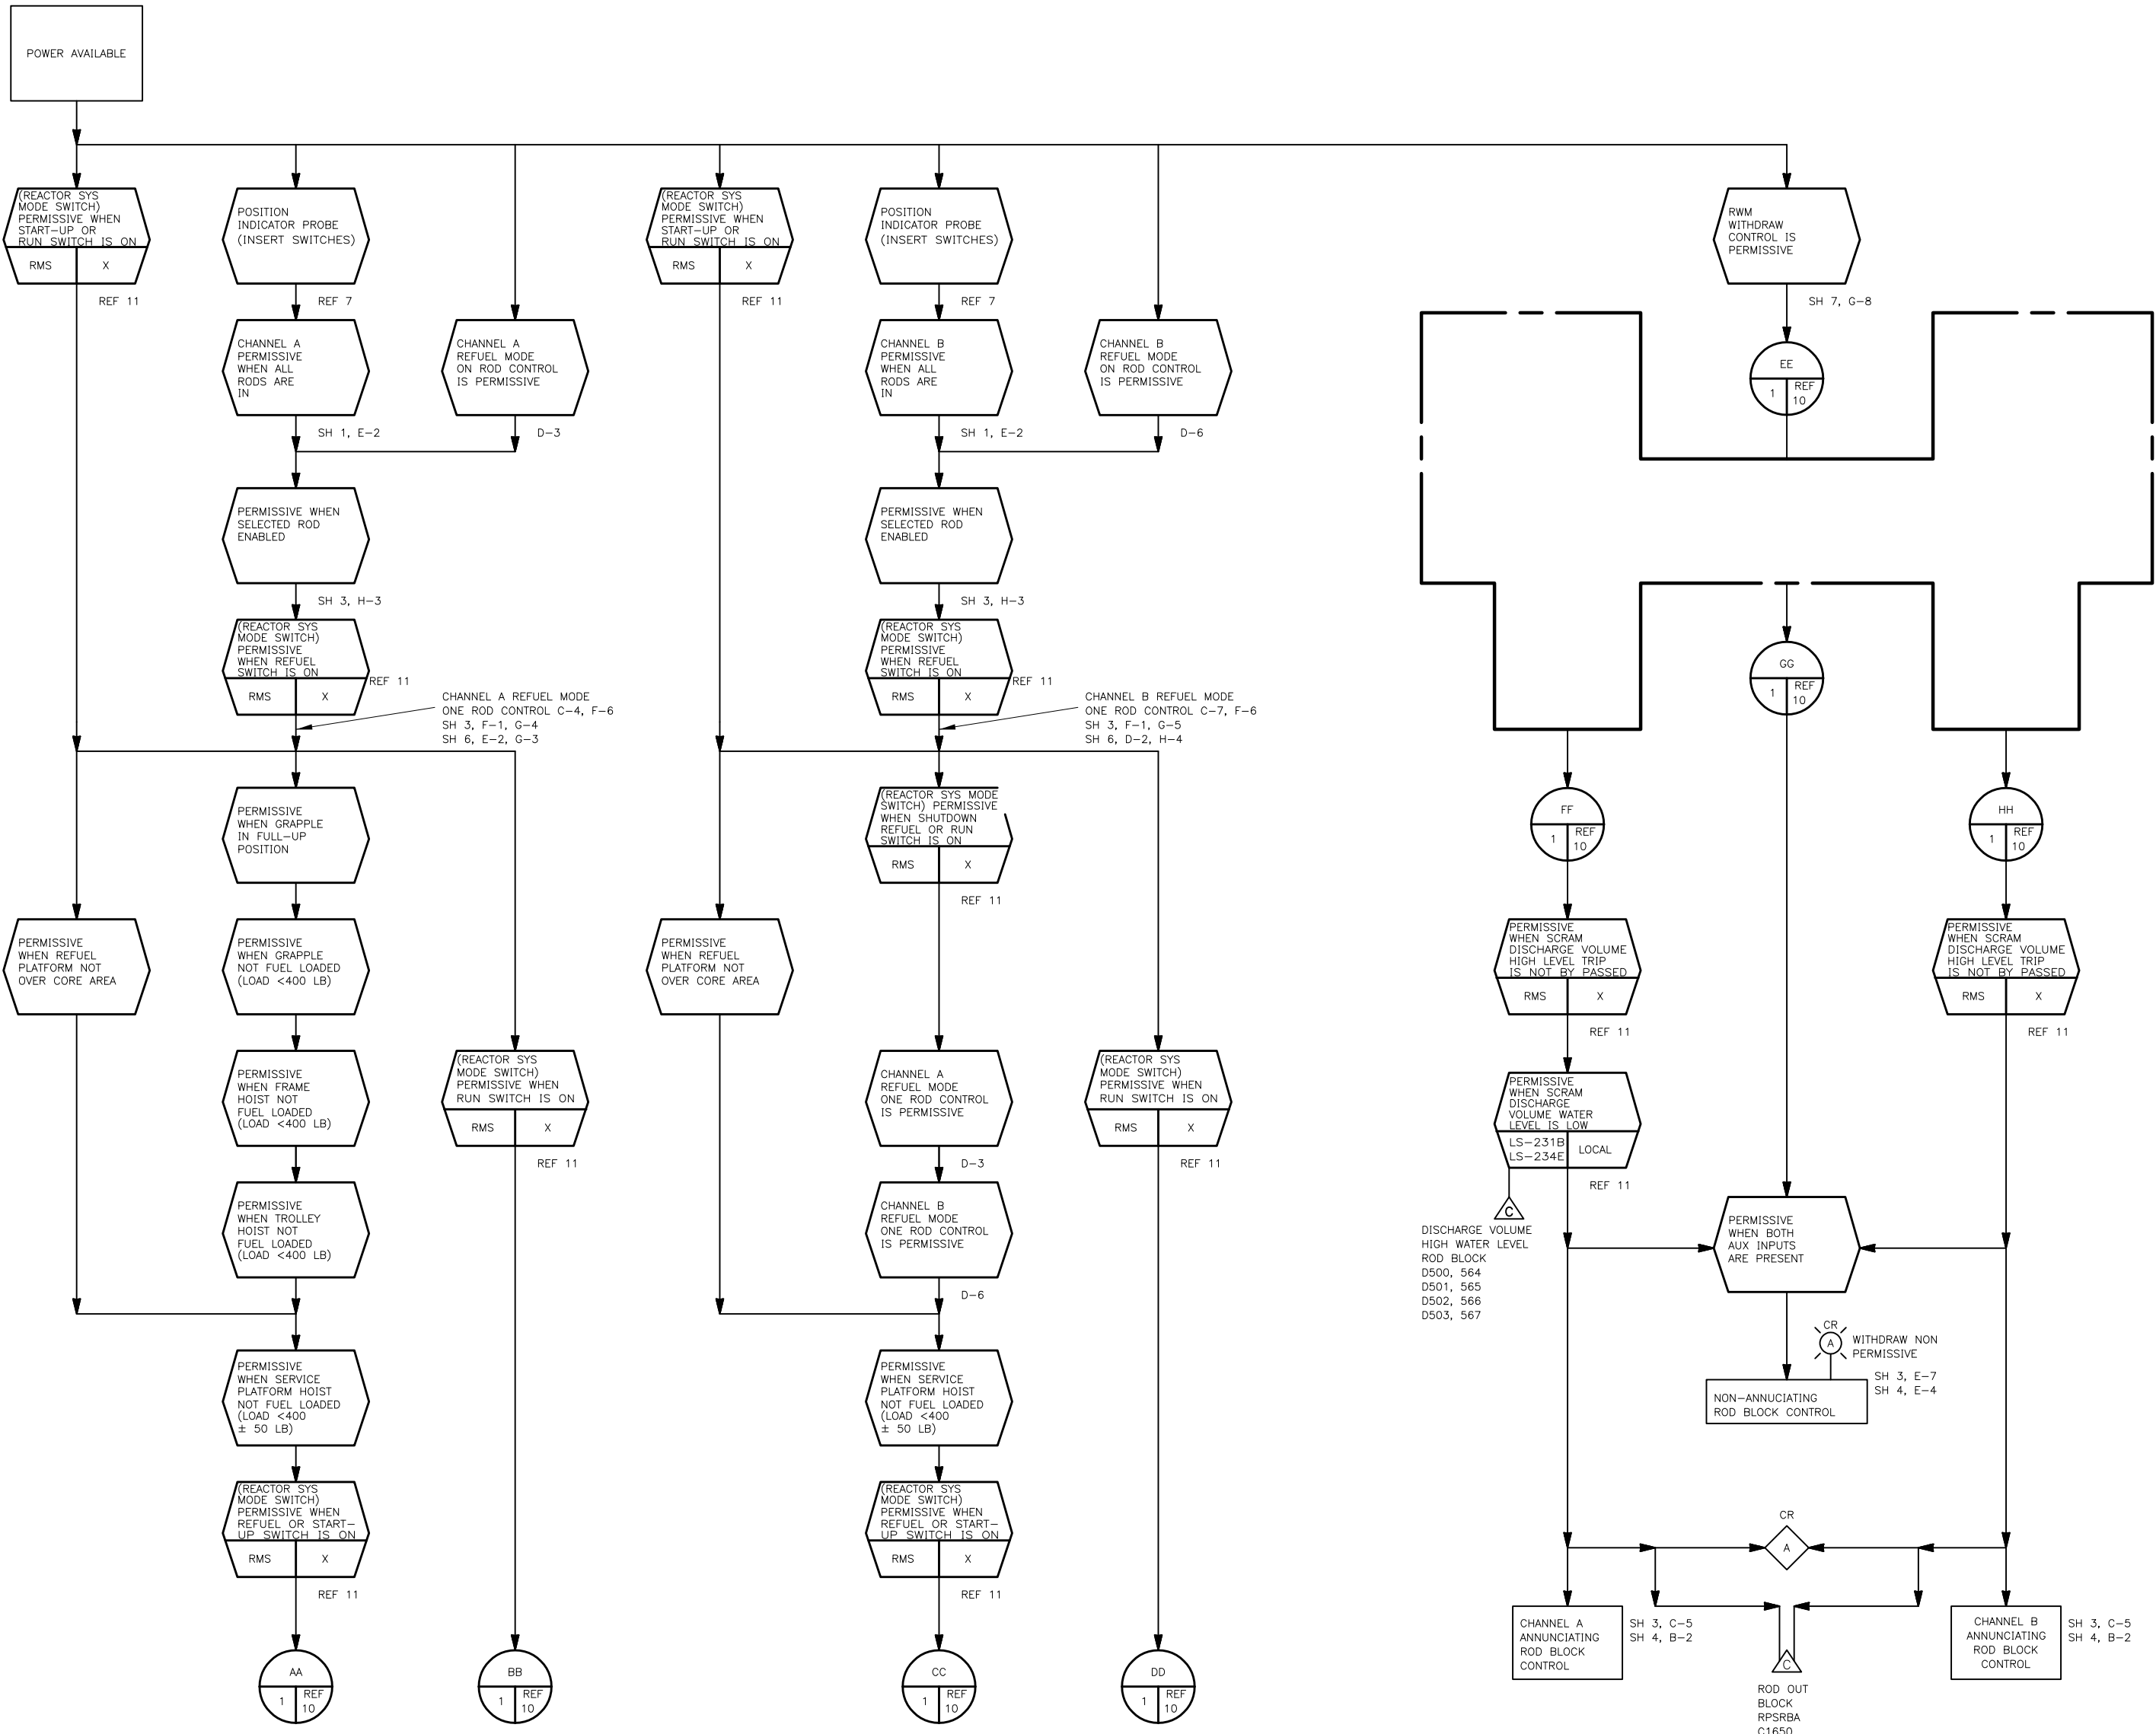

INFORMATION ONLY

NOTES:  
1. FOR GENERAL NOTES AND REFERENCE DOCUMENTS SEE SHEET 1.

\* THIS DRAWING GENERATED BY NPPD

452005836


\*\* FOR PREVIOUS REVISIONS, SEE SUPERSEDED CARDS.

NO.	REV & REDRAWN PER APA DCN C93-1577	DR	JAC	SJT	11-16-93
NO.	REVISIONS	DFT	CKD	APP	DATE
DCN REVISIONS BY N.P.P.D.					

SIGNIFICANT NUMBER	1	2	3	4	5	6
GROUP	1	2	3	4	5	6
COOPER NUCLEAR STATION FUNCTIONAL CONTROL DIAGRAM CONTROL ROD DRIVE HYDRAULIC SYSTEM						

DRAWN DR	DATE 10-18-93
CHECKED	DATE
APPROVED SJT	DATE 11-16-93
FILMED	729E471BB SH. 5
REVISION NO2	

CAD FILE: C0011084

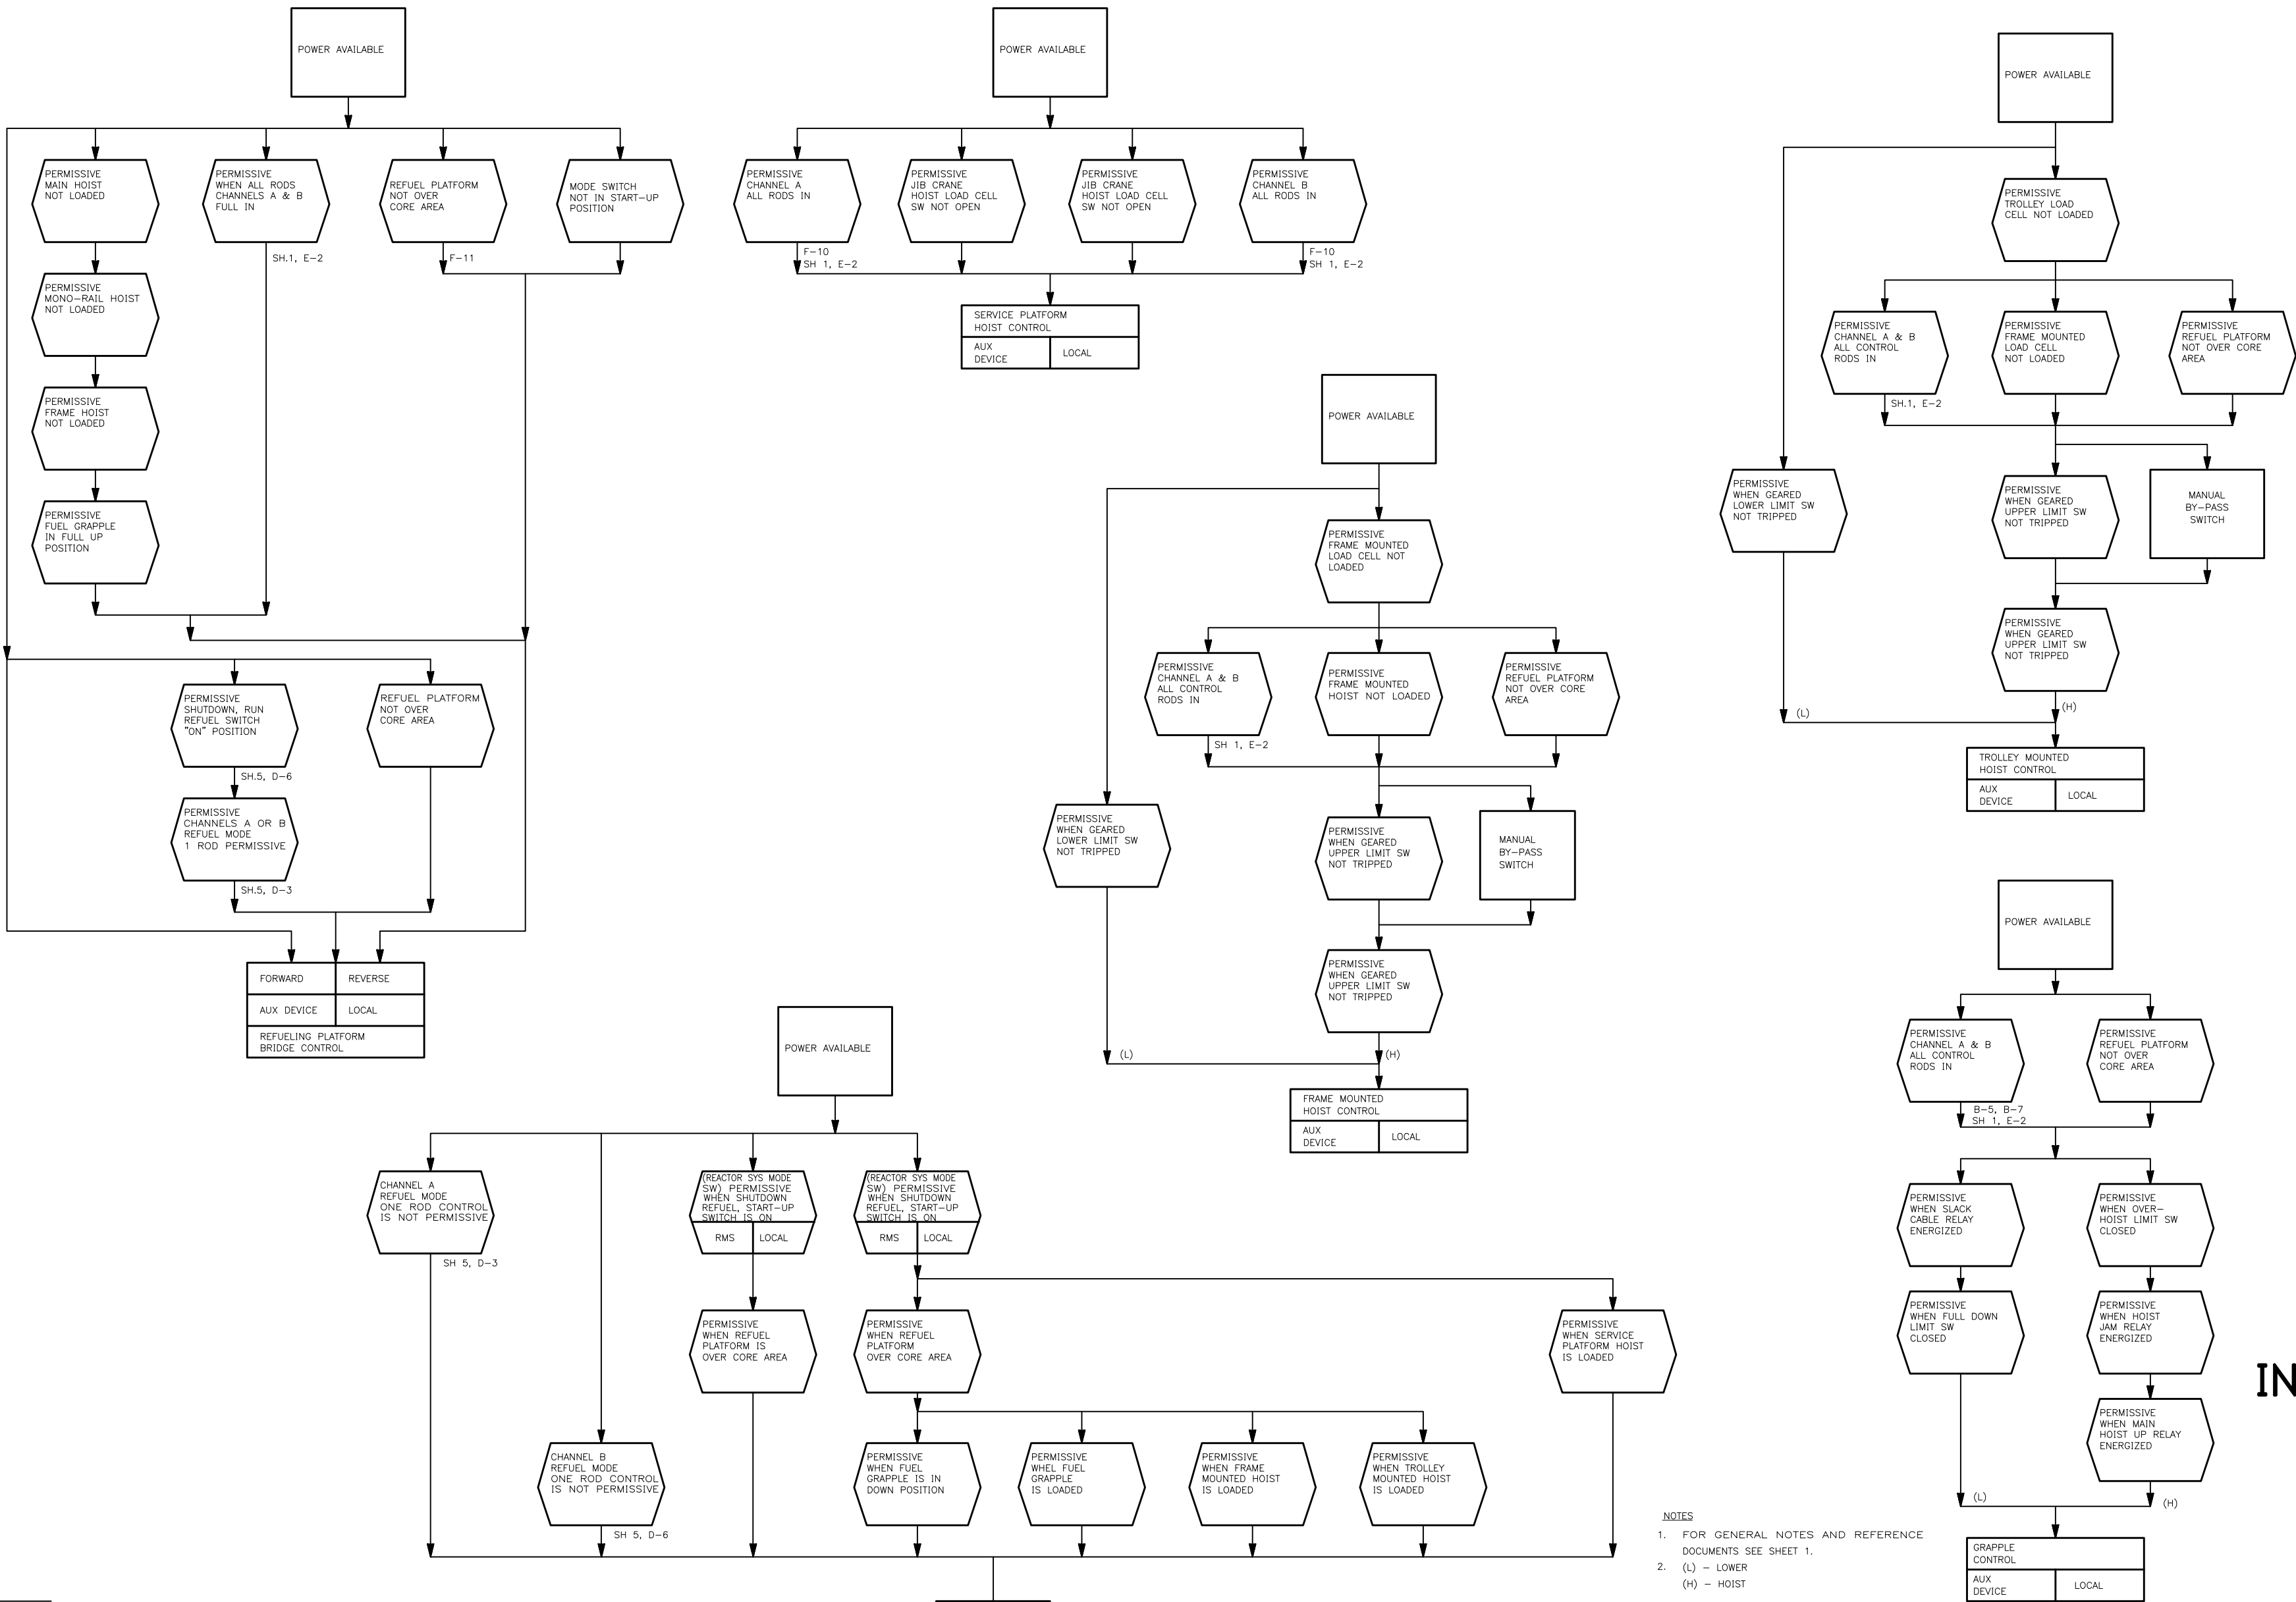

- NOTES
- 1. FOR GENERAL NOTES AND REFERENCE DOCUMENTS SEE SHEET 1.
  - 2. (L) - LOWER
  - (H) - HOIST

\* THIS DRAWING GENERATED BY NPPD

** FOR PERVIOUS REVISIONS SEE SUPERSEDED CARDS							
**	NO1	REVISED AND REDRAWN PER APA DCN C93-1578	TRU	JAC	SJT	11-16-93	
	NO.	REVISIONS	DFT	CKD	APP	DATE	
DCN REVISIONS BY N.P.P.D.							

SIGNIFICANT NUMBER

GROUP	1	2	3	4	5	6
-------	---	---	---	---	---	---

COOPER NUCLEAR STATION  
FUNCTIONAL CONTROL DIAGRAM  
CONTROL ROD DRIVE HYDRAULIC SYSTEM

DRAWN	TRU	DATE	10-14-93
CHECKED		DATE	
APPROVED	SJT	DATE	11-16-93
FILMED	729E471BB SH. 6		REVISION NO1

GENERAL ELECTRIC\*

CADD FILE: C0011085

INFORMATION ONLY


452005837

CADD DRAWING

DO NOT REVISE MANUALLY

REVISIONS	
NO.	



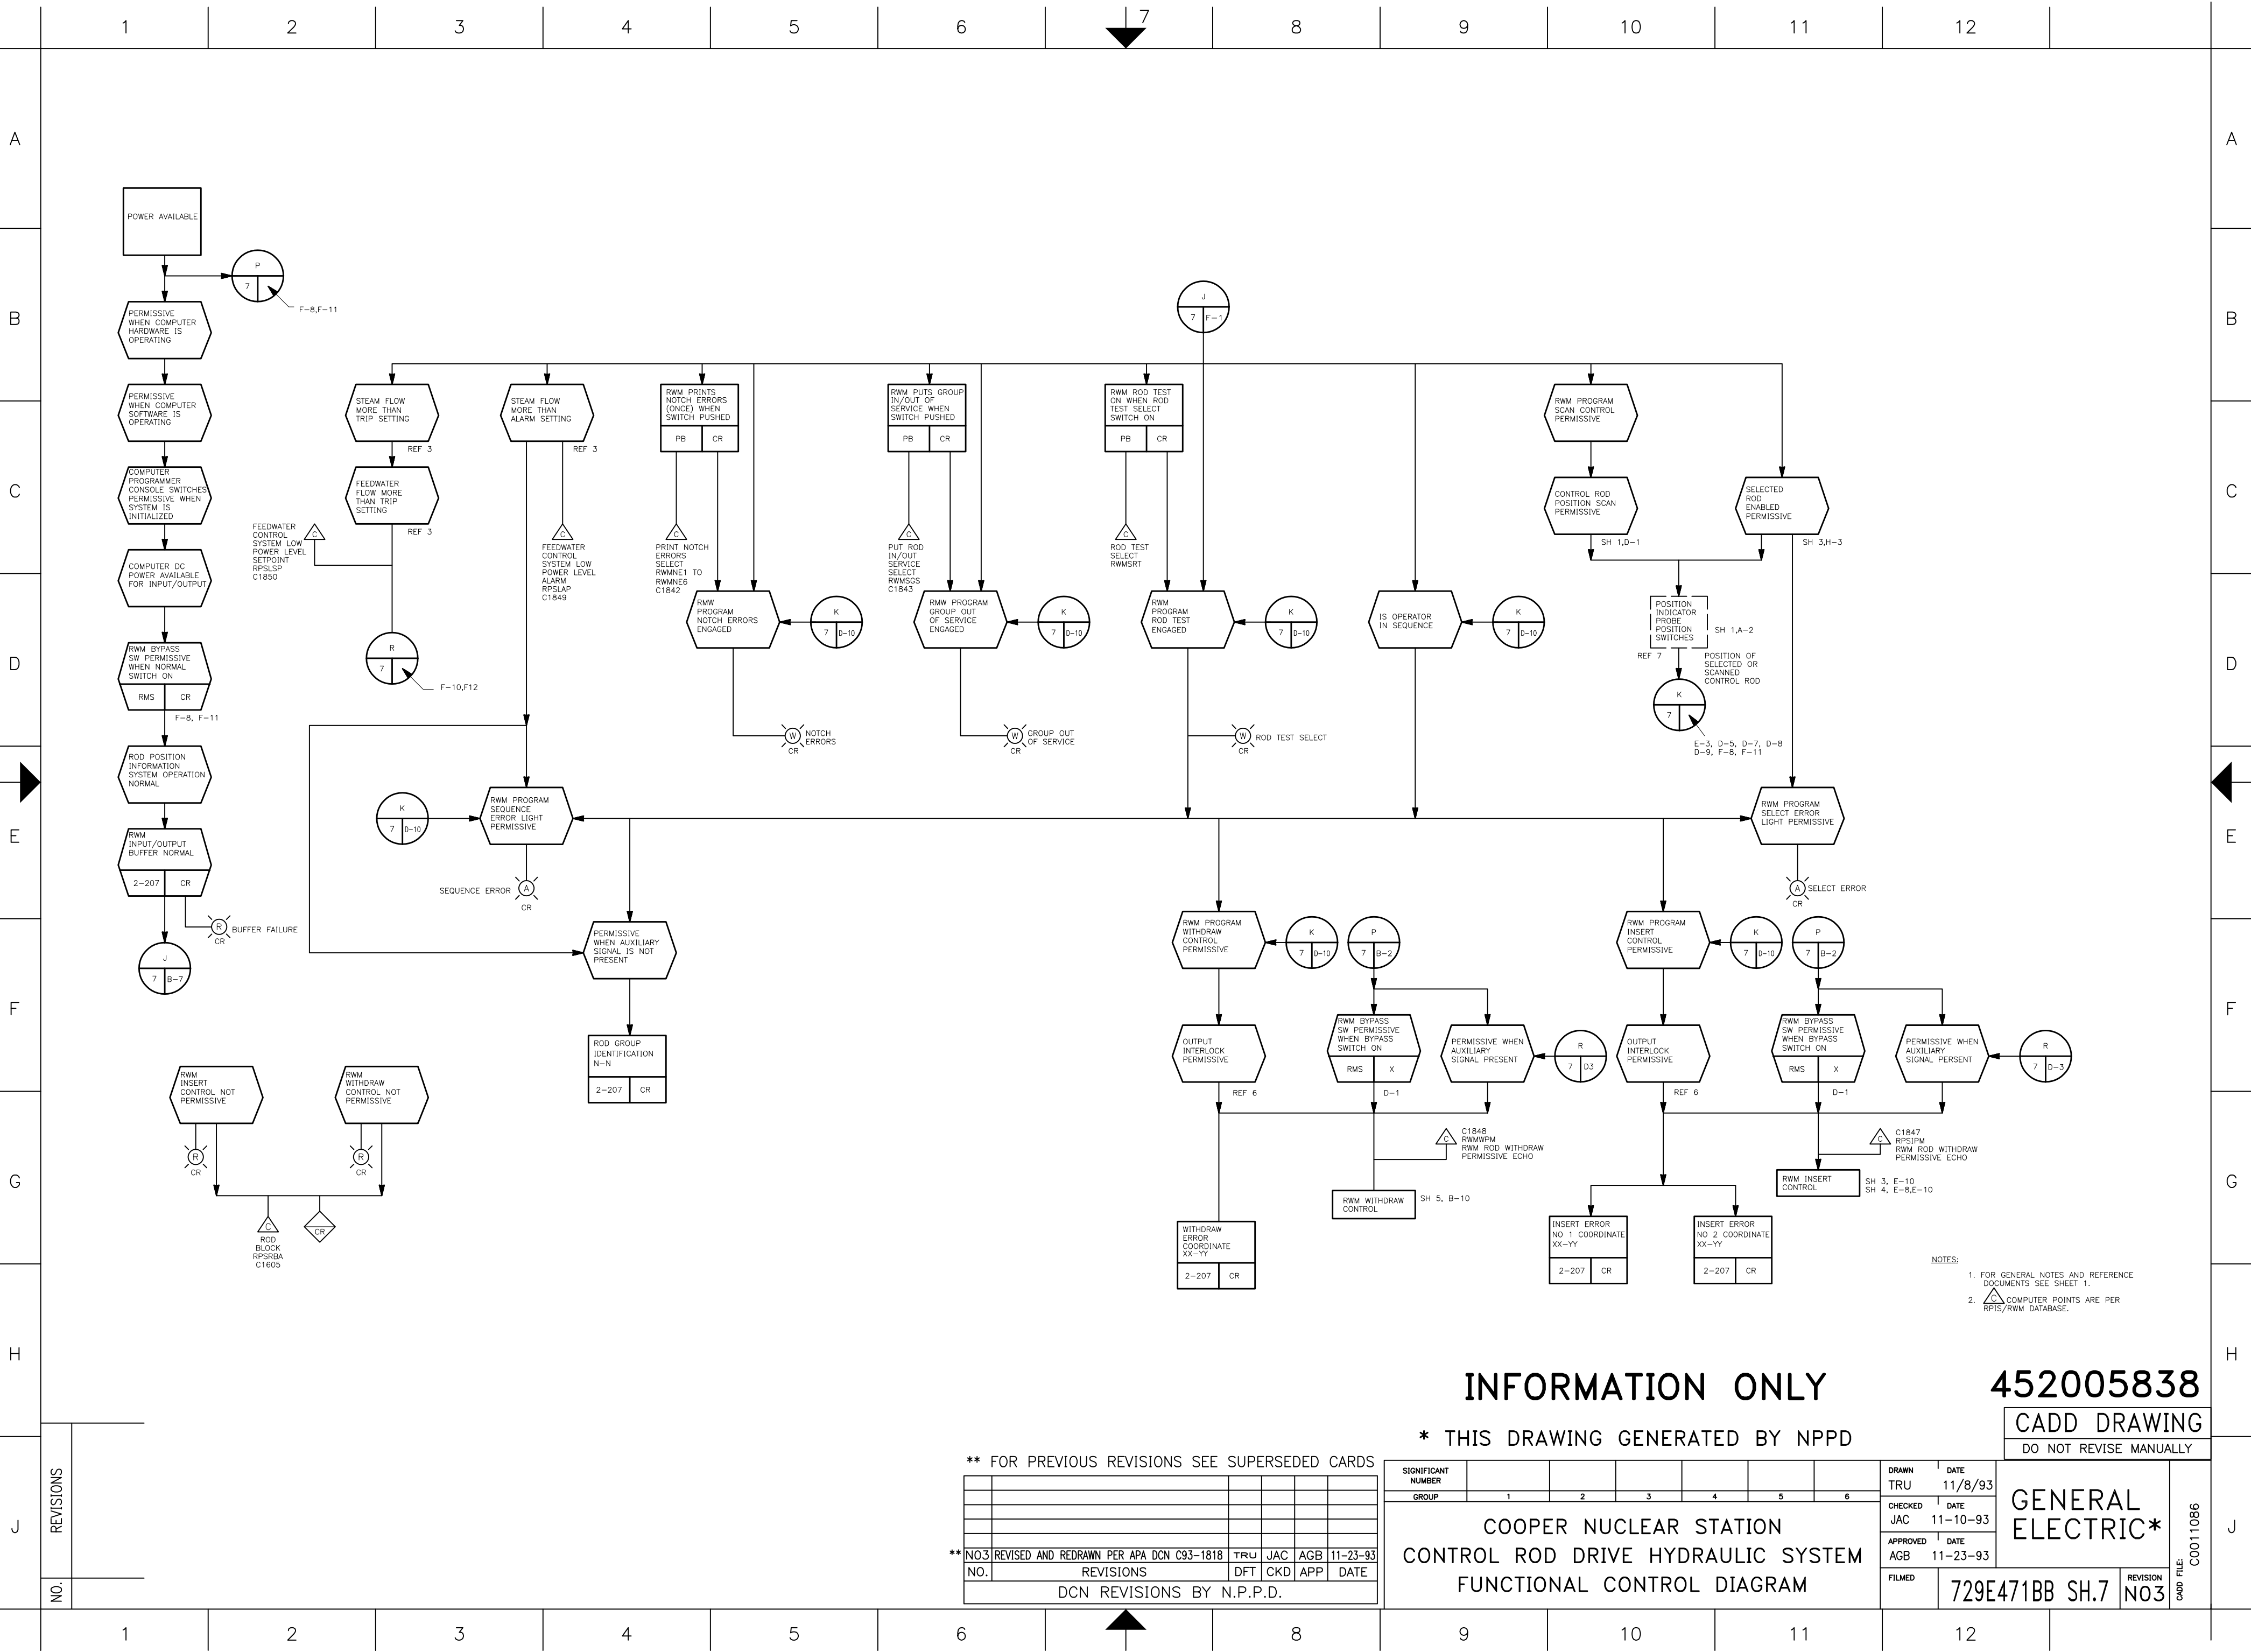

INFORMATION ONLY

452005838

CADD DRAWING  
DO NOT REVISE MANUALLY

\* THIS DRAWING GENERATED BY NPPD

NO.3 REVISD AND REDRAWN PER APA DCN C93-1818

NO.	REVISIONS	DFT	CKD	APP	DATE
1					
2					
3					
4					
5					
6					
7					
8					
9					
10					
11					
12					

DCN REVISIONS BY N.P.P.D.

SIGNIFICANT NUMBER	1	2	3	4	5	6
GROUP						
COOPER NUCLEAR STATION CONTROL ROD DRIVE HYDRAULIC SYSTEM FUNCTIONAL CONTROL DIAGRAM						

DRAWN TRU	DATE 11/8/93
CHECKED JAC	DATE 11-10-93
APPROVED AGB	DATE 11-23-93
FILMED	729E471BB SH.7
REVISION NO3	CADD FILE: CO011086


GENERAL ELECTRIC\*

- NOTES:
- FOR GENERAL NOTES AND REFERENCE DOCUMENTS SEE SHEET 1.
  - COMPUTER POINTS ARE PER RPTS/RWM DATABASE.

N04	REV	DCN	96-0118	RAC	JAC	KG	4-19-99
N03	REV	PER	DCN 97-0815	RRT	JAC	ACG	8-12-97
N02	REV & REDRAWN	PER	APA DCN C93-1784	DR	JAC	BAM	12/01/93
NO.	REVISIONS			DFT	CKD	APP	DATE

DCN REVISIONS BY N.P.P.D.

FOR PREVIOUS REVISIONS, SEE SUPERSEDED CARDS.

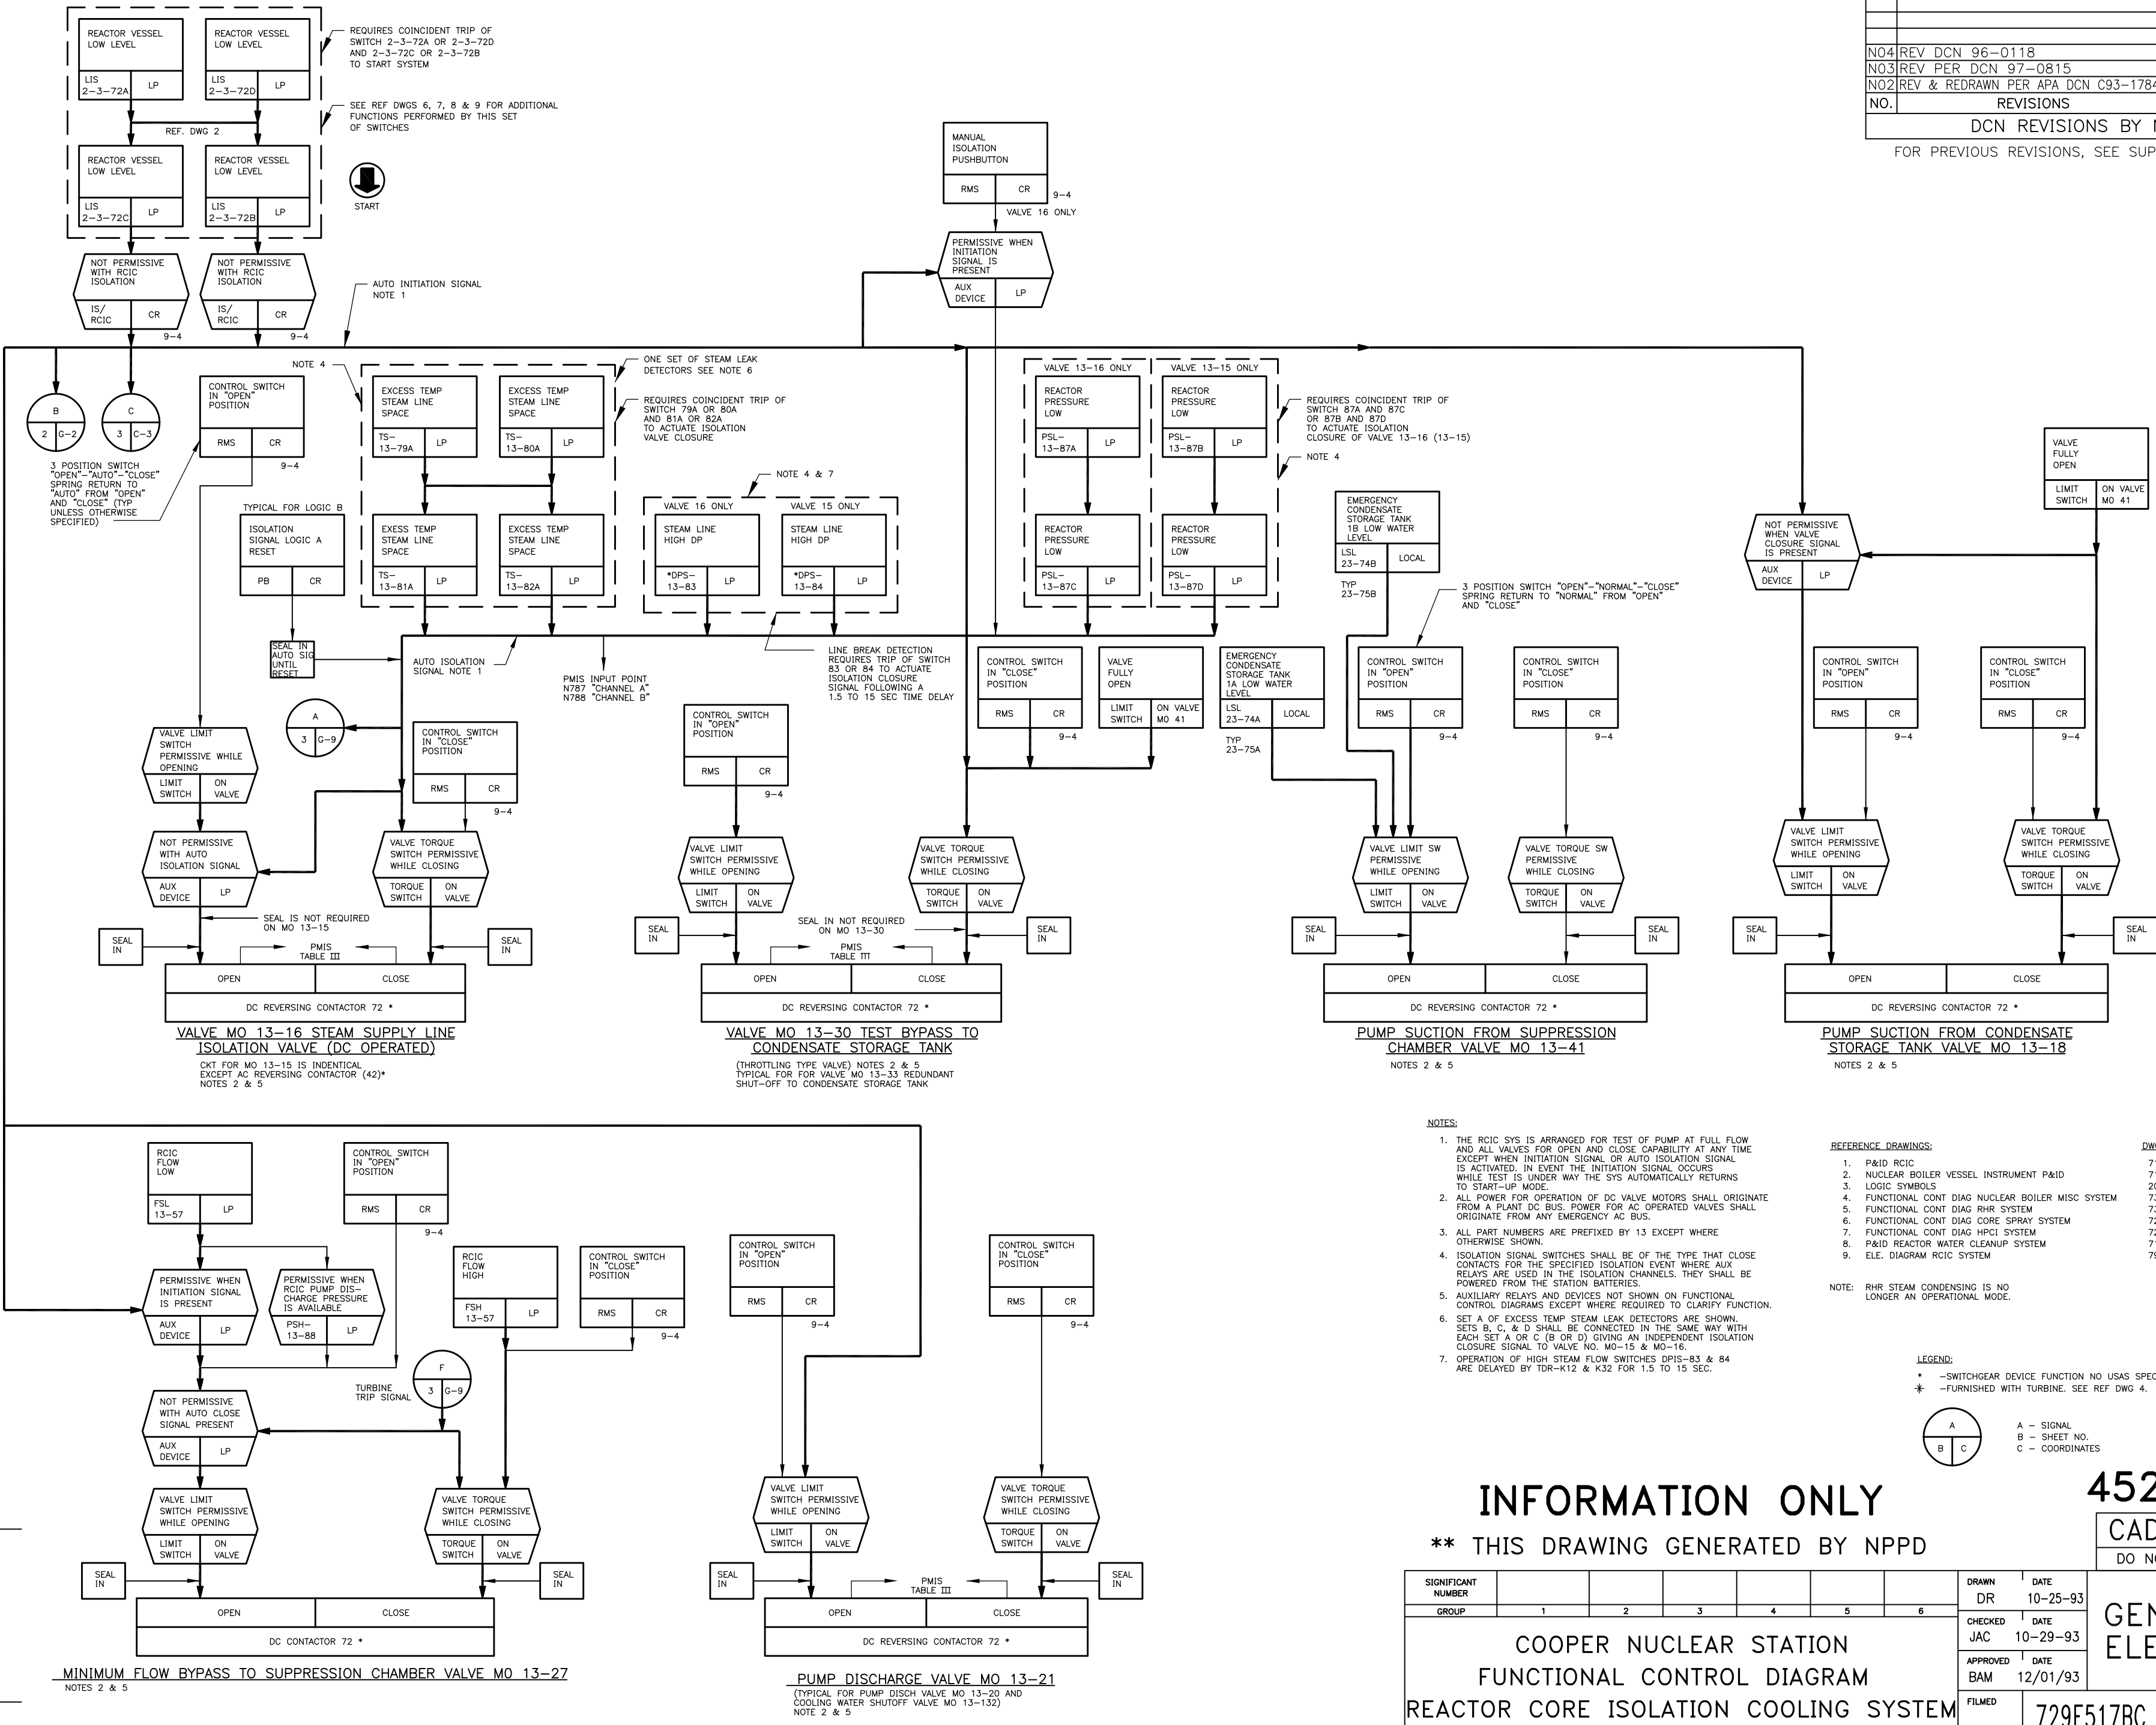

- NOTES:**
- THE RCIC SYS IS ARRANGED FOR TEST OF PUMP AT FULL FLOW AND ALL VALVES FOR OPEN AND CLOSE CAPABILITY AT ANY TIME EXCEPT WHEN INITIATION SIGNAL OR AUTO ISOLATION SIGNAL IS ACTIVATED. IN EVENT THE INITIATION SIGNAL OCCURS WHILE TEST IS UNDER WAY THE SYS AUTOMATICALLY RETURNS TO START-UP MODE.
  - ALL POWER FOR OPERATION OF DC VALVE MOTORS SHALL ORIGINATE FROM A PLANT DC BUS. POWER FOR AC OPERATED VALVES SHALL ORIGINATE FROM ANY EMERGENCY AC BUS.
  - ALL PART NUMBERS ARE PREFIXED BY 13 EXCEPT WHERE OTHERWISE SHOWN.
  - ISOLATION SIGNAL SWITCHES SHALL BE OF THE TYPE THAT CLOSE CONTACTS FOR THE SPECIFIED ISOLATION EVENT WHERE AUX RELAYS ARE USED IN THE ISOLATION CHANNELS. THEY SHALL BE POWERED FROM THE STATION BATTERIES.
  - AUXILIARY RELAYS AND DEVICES NOT SHOWN ON FUNCTIONAL CONTROL DIAGRAMS EXCEPT WHERE REQUIRED TO CLARIFY FUNCTION.
  - SET A OF EXCESS TEMP STEAM LEAK DETECTORS ARE SHOWN. SETS B, C, & D SHALL BE CONNECTED IN THE SAME WAY WITH EACH SET A OR C (B OR D) GIVING AN INDEPENDENT ISOLATION CLOSURE SIGNAL TO VALVE NO. MO-15 & MO-16.
  - OPERATION OF HIGH STEAM FLOW SWITCHES DPS-83 & 84 ARE DELAYED BY TDR-K12 & K32 FOR 1.5 TO 15 SEC.
- REFERENCE DRAWINGS:**
- |  |           |
|--|-----------|
| 1. P&ID RCIC                                       | 718E961BC |
| 2. NUCLEAR BOILER VESSEL INSTRUMENT P&ID           | 718E946BC |
| 3. LOGIC SYMBOLS                                   | 209A473B  |
| 4. FUNCTIONAL CONT DIAG NUCLEAR BOILER MISC SYSTEM | 730E149BB |
| 5. FUNCTIONAL CONT DIAG RHR SYSTEM                 | 730E140BB |
| 6. FUNCTIONAL CONT DIAG CORE SPRAY SYSTEM          | 729E402BB |
| 7. FUNCTIONAL CONT DIAG HPCI SYSTEM                | 729E569BB |
| 8. P&ID REACTOR WATER CLEANUP SYSTEM               | 718E833BA |
| 9. ELE. DIAGRAM RCIC SYSTEM                        | 791E264   |
- NOTE:** RHR STEAM CONDENSING IS NO LONGER AN OPERATIONAL MODE.
- LEGEND:**
- \* - SWITCHGEAR DEVICE FUNCTION NO USAS SPEC C37.2
  - \* - FURNISHED WITH TURBINE. SEE REF DWG 4.
- SYMBOLS:**
- A - SIGNAL
  - B - SHEET NO.
  - C - COORDINATES

**INFORMATION ONLY**

**\*\* THIS DRAWING GENERATED BY NPPD**

**452005358**

**CADD DRAWING**

DO NOT REVISE MANUALLY

SIGNIFICANT NUMBER	1	2	3	4	5	6	DATE	10-25-93
GROUP	1	2	3	4	5	6	DATE	10-29-93
CHECKED	JAC						DATE	10-29-93
APPROVED	BAM						DATE	12/01/93
FILMED							DATE	12/01/93
COOPER NUCLEAR STATION							729E517BC SH. 1	
FUNCTIONAL CONTROL DIAGRAM							N04	
REACTOR CORE ISOLATION COOLING SYSTEM							REVISION	



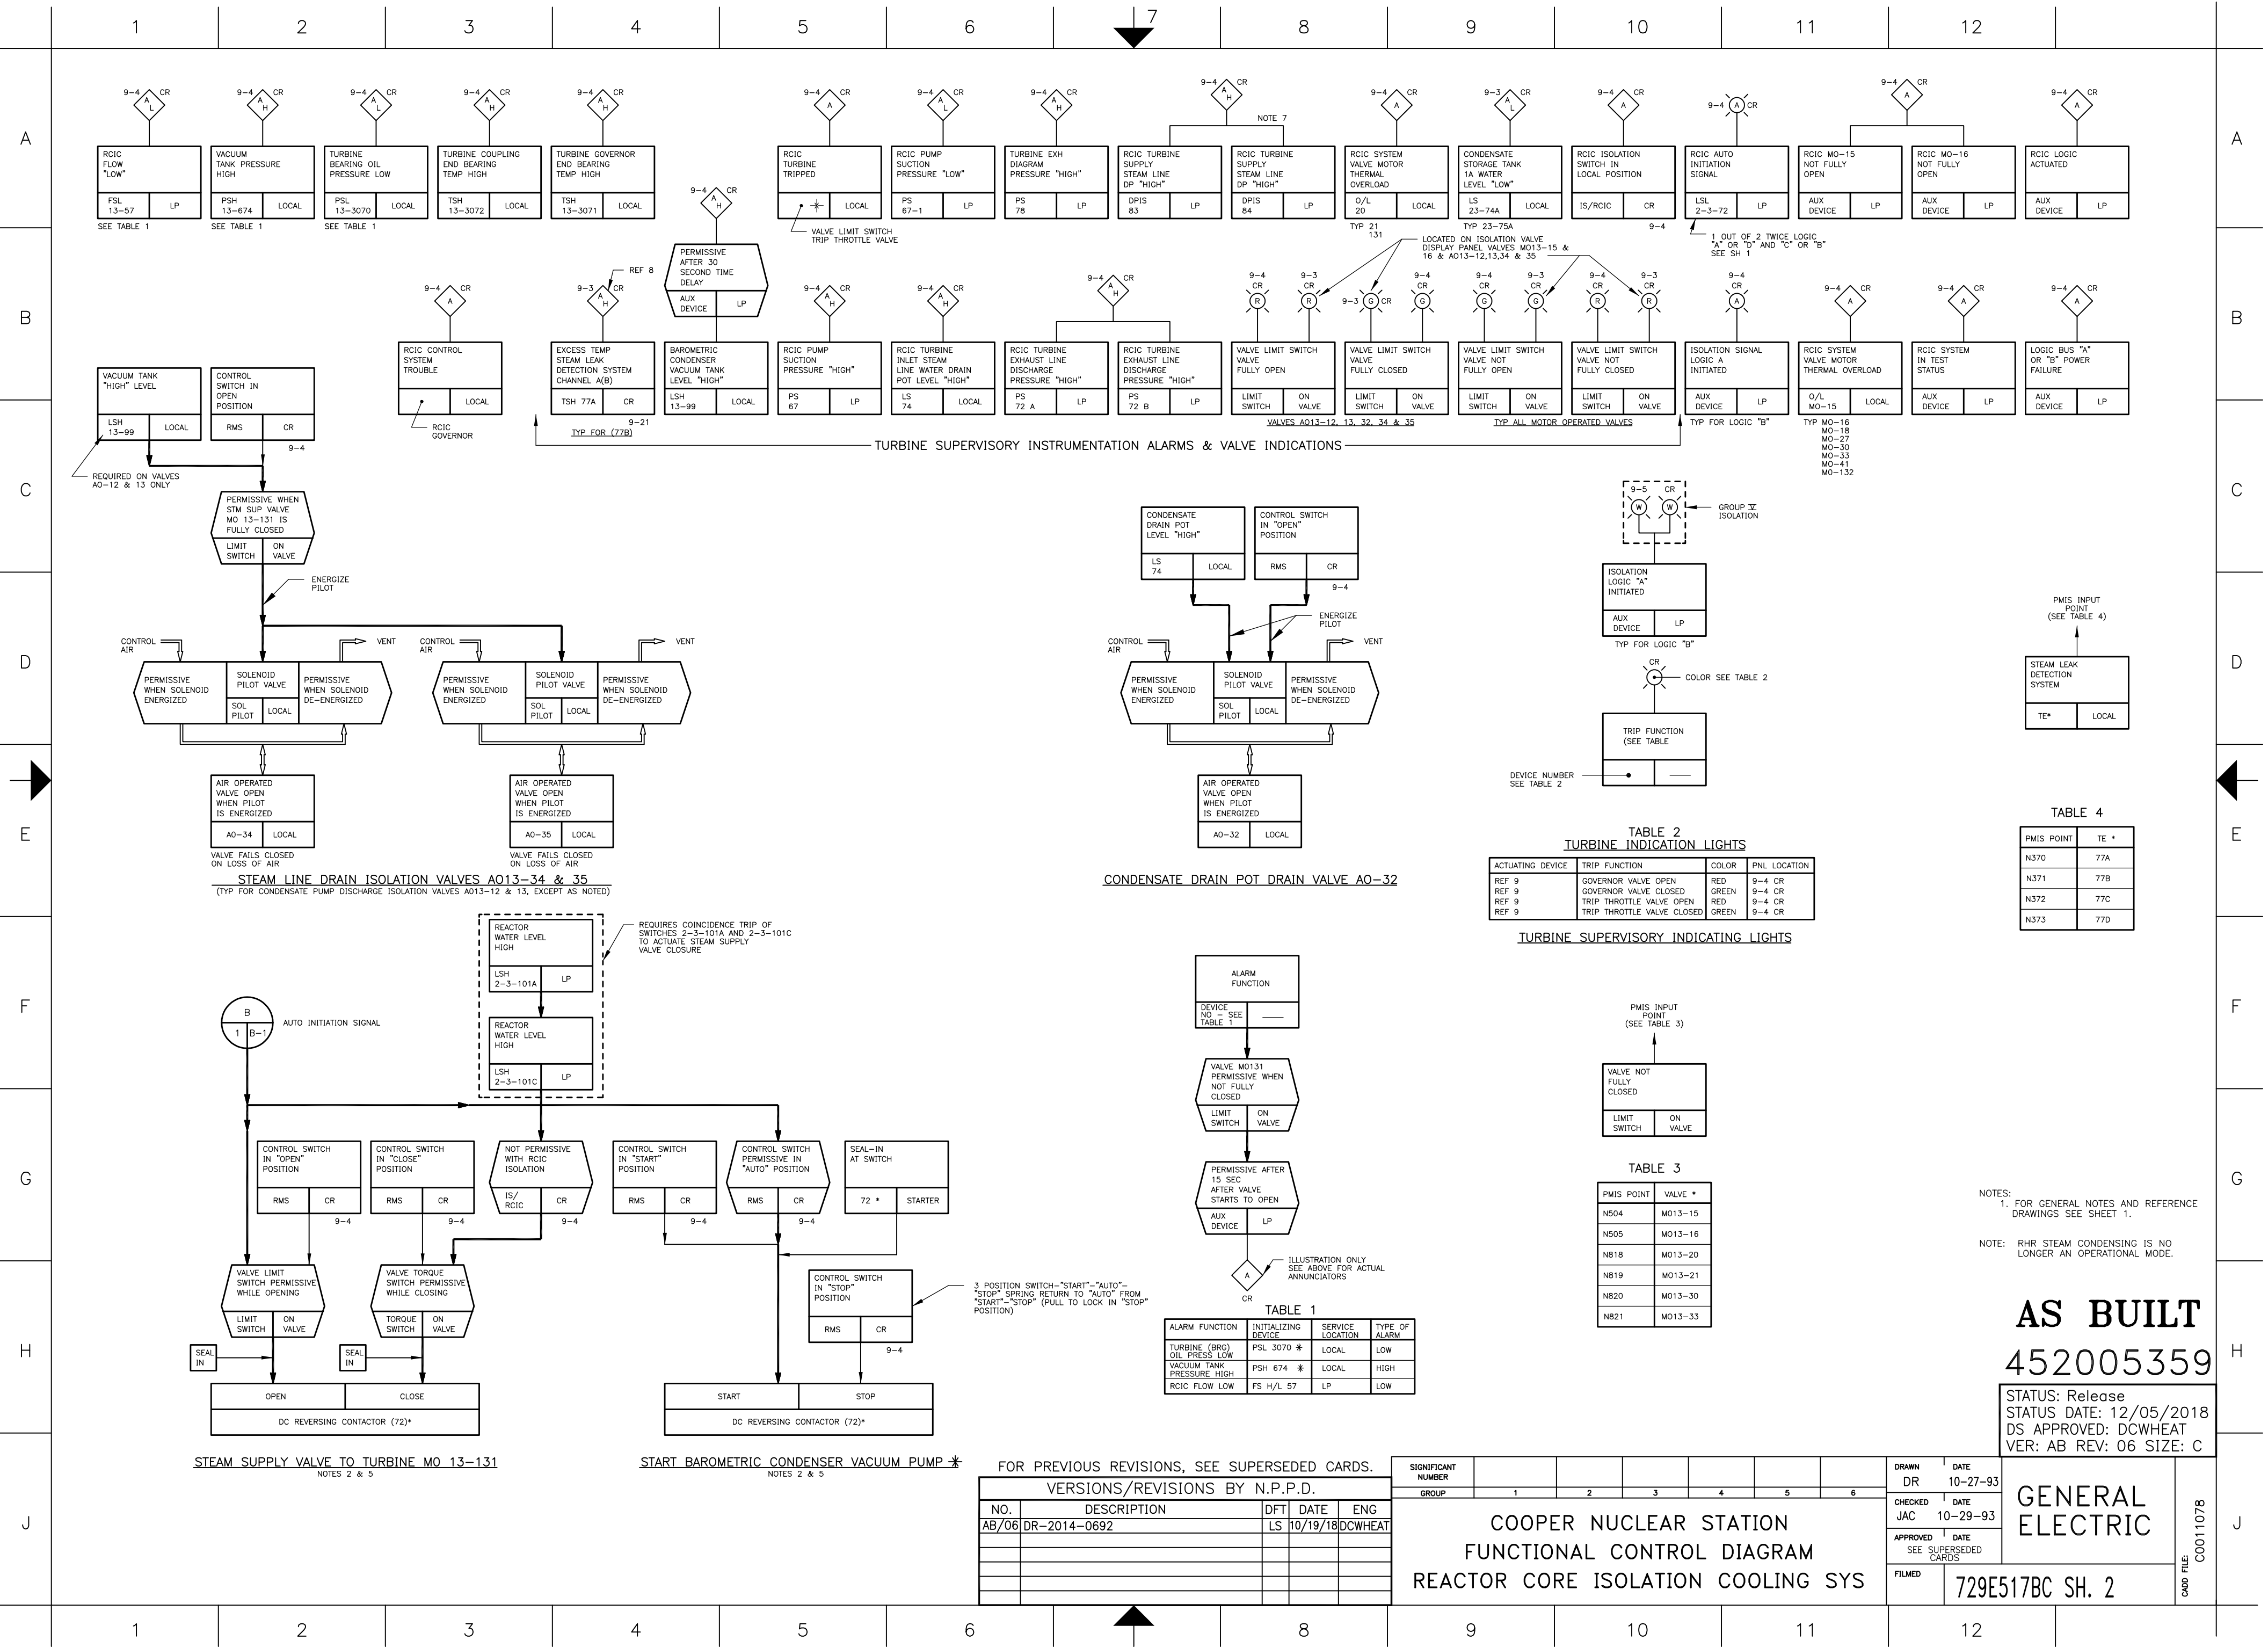


TABLE 2  
TURBINE INDICATION LIGHTS

ACTUATING DEVICE	TRIP FUNCTION	COLOR	PNL LOCATION
REF 9	GOVERNOR VALVE OPEN	RED	9-4 CR
REF 9	GOVERNOR VALVE CLOSED	RED	9-4 CR
REF 9	TRIP THROTTLE VALVE OPEN	RED	9-4 CR
REF 9	TRIP THROTTLE VALVE CLOSED	RED	9-4 CR

TURBINE SUPERVISORY INDICATING LIGHTS

TABLE 4

PMIS POINT	TE *
N370	77A
N371	77B
N372	77C
N373	77D

TABLE 3

PMIS POINT	VALVE *
N504	MO13-15
N505	MO13-16
N818	MO13-20
N819	MO13-21
N820	MO13-30
N821	MO13-33

NOTES:  
1. FOR GENERAL NOTES AND REFERENCE DRAWINGS SEE SHEET 1.  
NOTE: RHR STEAM CONDENSING IS NO LONGER AN OPERATIONAL MODE.

AS BUILT  
452005359





STATUS: Release  
STATUS DATE: 12/05/2018  
DS APPROVED: DCWHEAT  
VER: AB REV: 06 SIZE: C

FOR PREVIOUS REVISIONS, SEE SUPERSEDED CARDS.

VERSIONS/REVISIONS BY N.P.P.D.				
NO.	DESCRIPTION	DFT	DATE	ENG
AB/06	DR-2014-0692	LS	10/19/18	DCWHEAT

SIGNIFICANT NUMBER	1	2	3	4	5	6
GROUP						
COOPER NUCLEAR STATION FUNCTIONAL CONTROL DIAGRAM REACTOR CORE ISOLATION COOLING SYS						

DRAWN DR	DATE 10-27-93
CHECKED JAC	DATE 10-29-93
APPROVED 	DATE 
FILMED	729E517BC SH. 2
GENERAL ELECTRIC	
CADD FILE: C0011078	

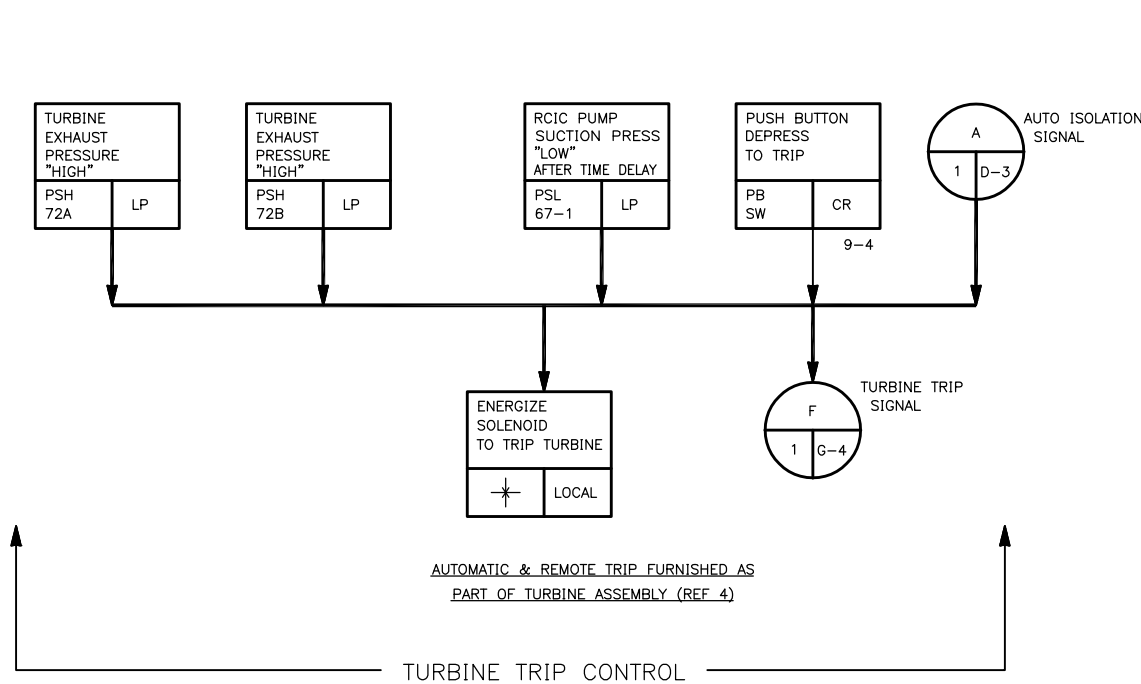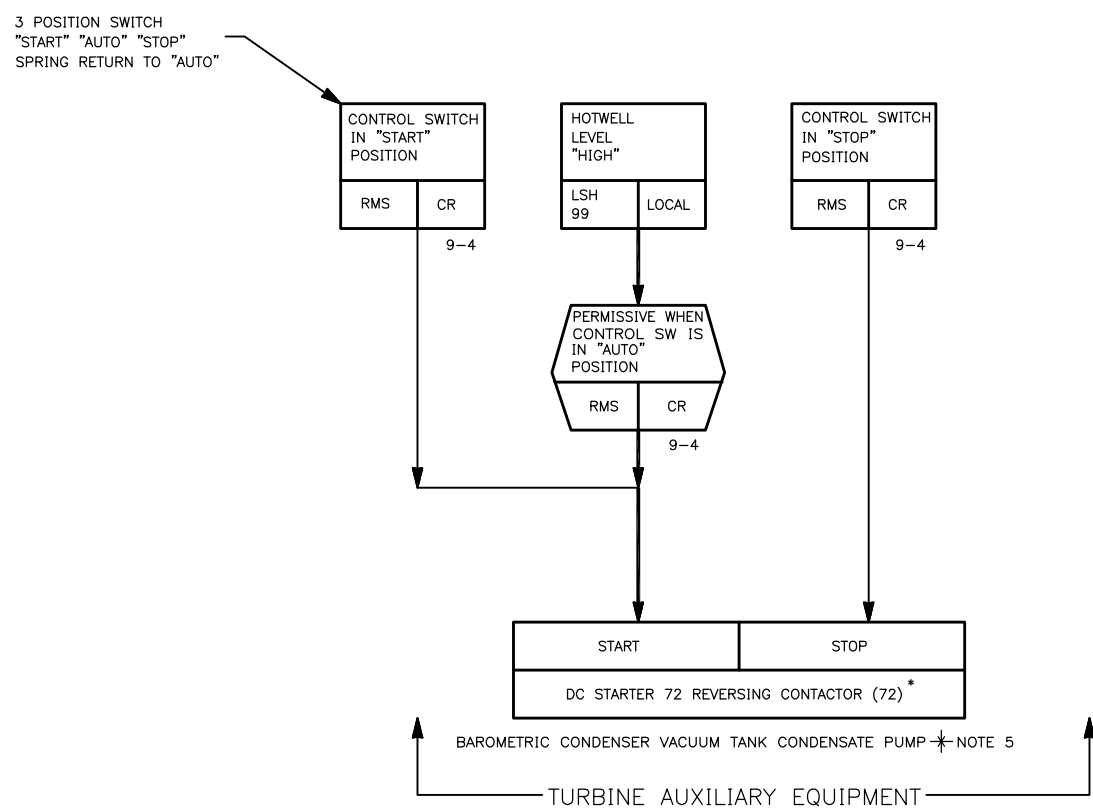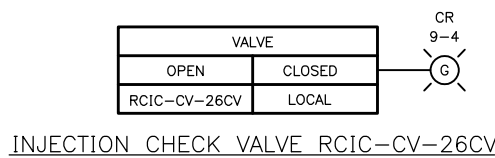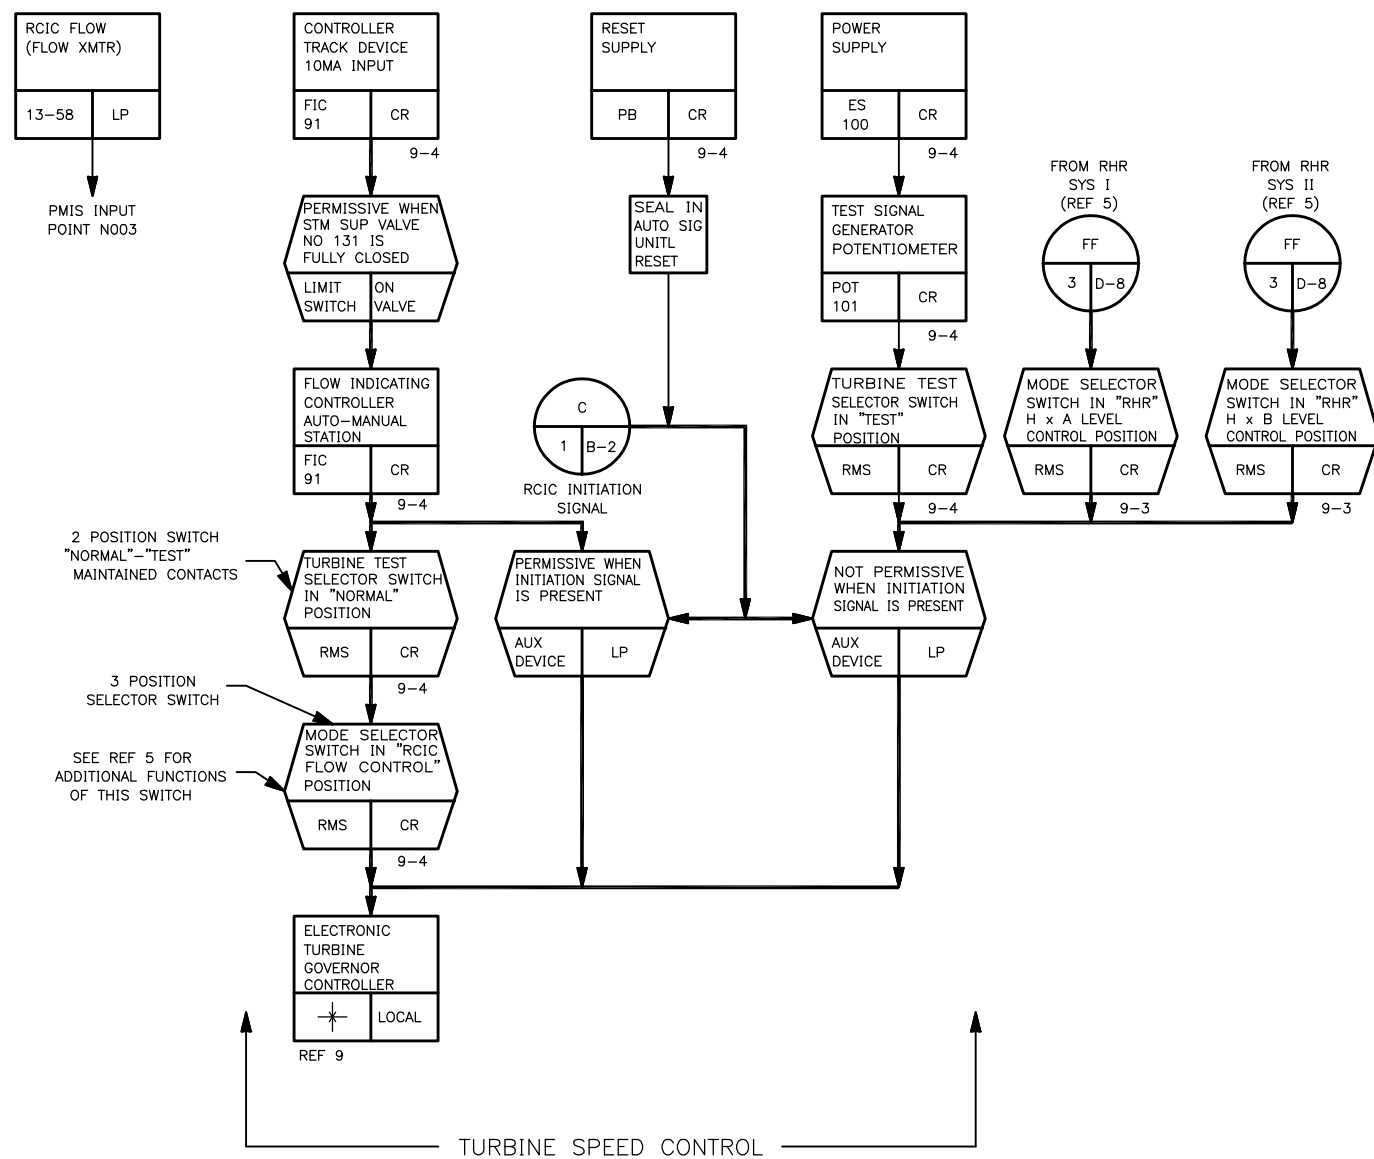

NOTES:  
1. FOR GENERAL NOTES AND REFERENCE DRAWINGS SEE SHEET 1.  
NOTE: RHR STEAM CONDENSING IS NO LONGER AN OPERATIONAL MODE.

INFORMATION ONLY  
452005360

FOR PREVIOUS REVISIONS SEE SUPERSEDED CARDS

REVISIONS BY N.P.P.D.					
NO.	REVISIONS	DFT	CKD	APP	DATE
NO3	REVISED AND REDRAWN PER APA DCN C93-1812	TRU	JAC	AGB	11-23-93
NO4	REVISED PER DCN 97-0813	RRT	JAC	KG	9/20/97
NO5	REV DCN 96-1423	CRW	JAC	KG	9/20/97
NO6	CED 6029441 (DCN 09-1944)	DLR	SMH	KZ	11-3-10

SIGNIFICANT NUMBER	1	2	3	4	5	6
GROUP	1	2	3	4	5	6
COOPER NUCLEAR STATION REACTOR CORE ISOLATION COOLING SYS FUNCTIONAL CONTROL DIAGRAM						


DRAWN TRU	DATE 10/01/93	GENERAL	C0011079
CHECKED JAC	DATE 11-23-93		
APPROVED AGB	DATE 11-23-93		
FILMED	729E517BC SH 3	REVISION NO6	

REVISIONS

NO.



N06	REV	DCN	96-0112		RAC	JAC	KG	4-19-99	
N05	REV	PER	DCN	97-0819		RAC	JAC	ACG	8/20/97
N04	REV	PER	DCN	96-1532		CRW	JAC	JRF	10/9/96
N03	REV & REDRAWN	PER	APA	DCN C93-1781		DR	JAC	BAM	12/01/03
NO.	REVISIONS				DFT	CKD	APP	DATE	
DCN REVISIONS BY N.P.P.D.									
FOR PREVIOUS REVISIONS, SEE SUPERSEDED CARDS.									

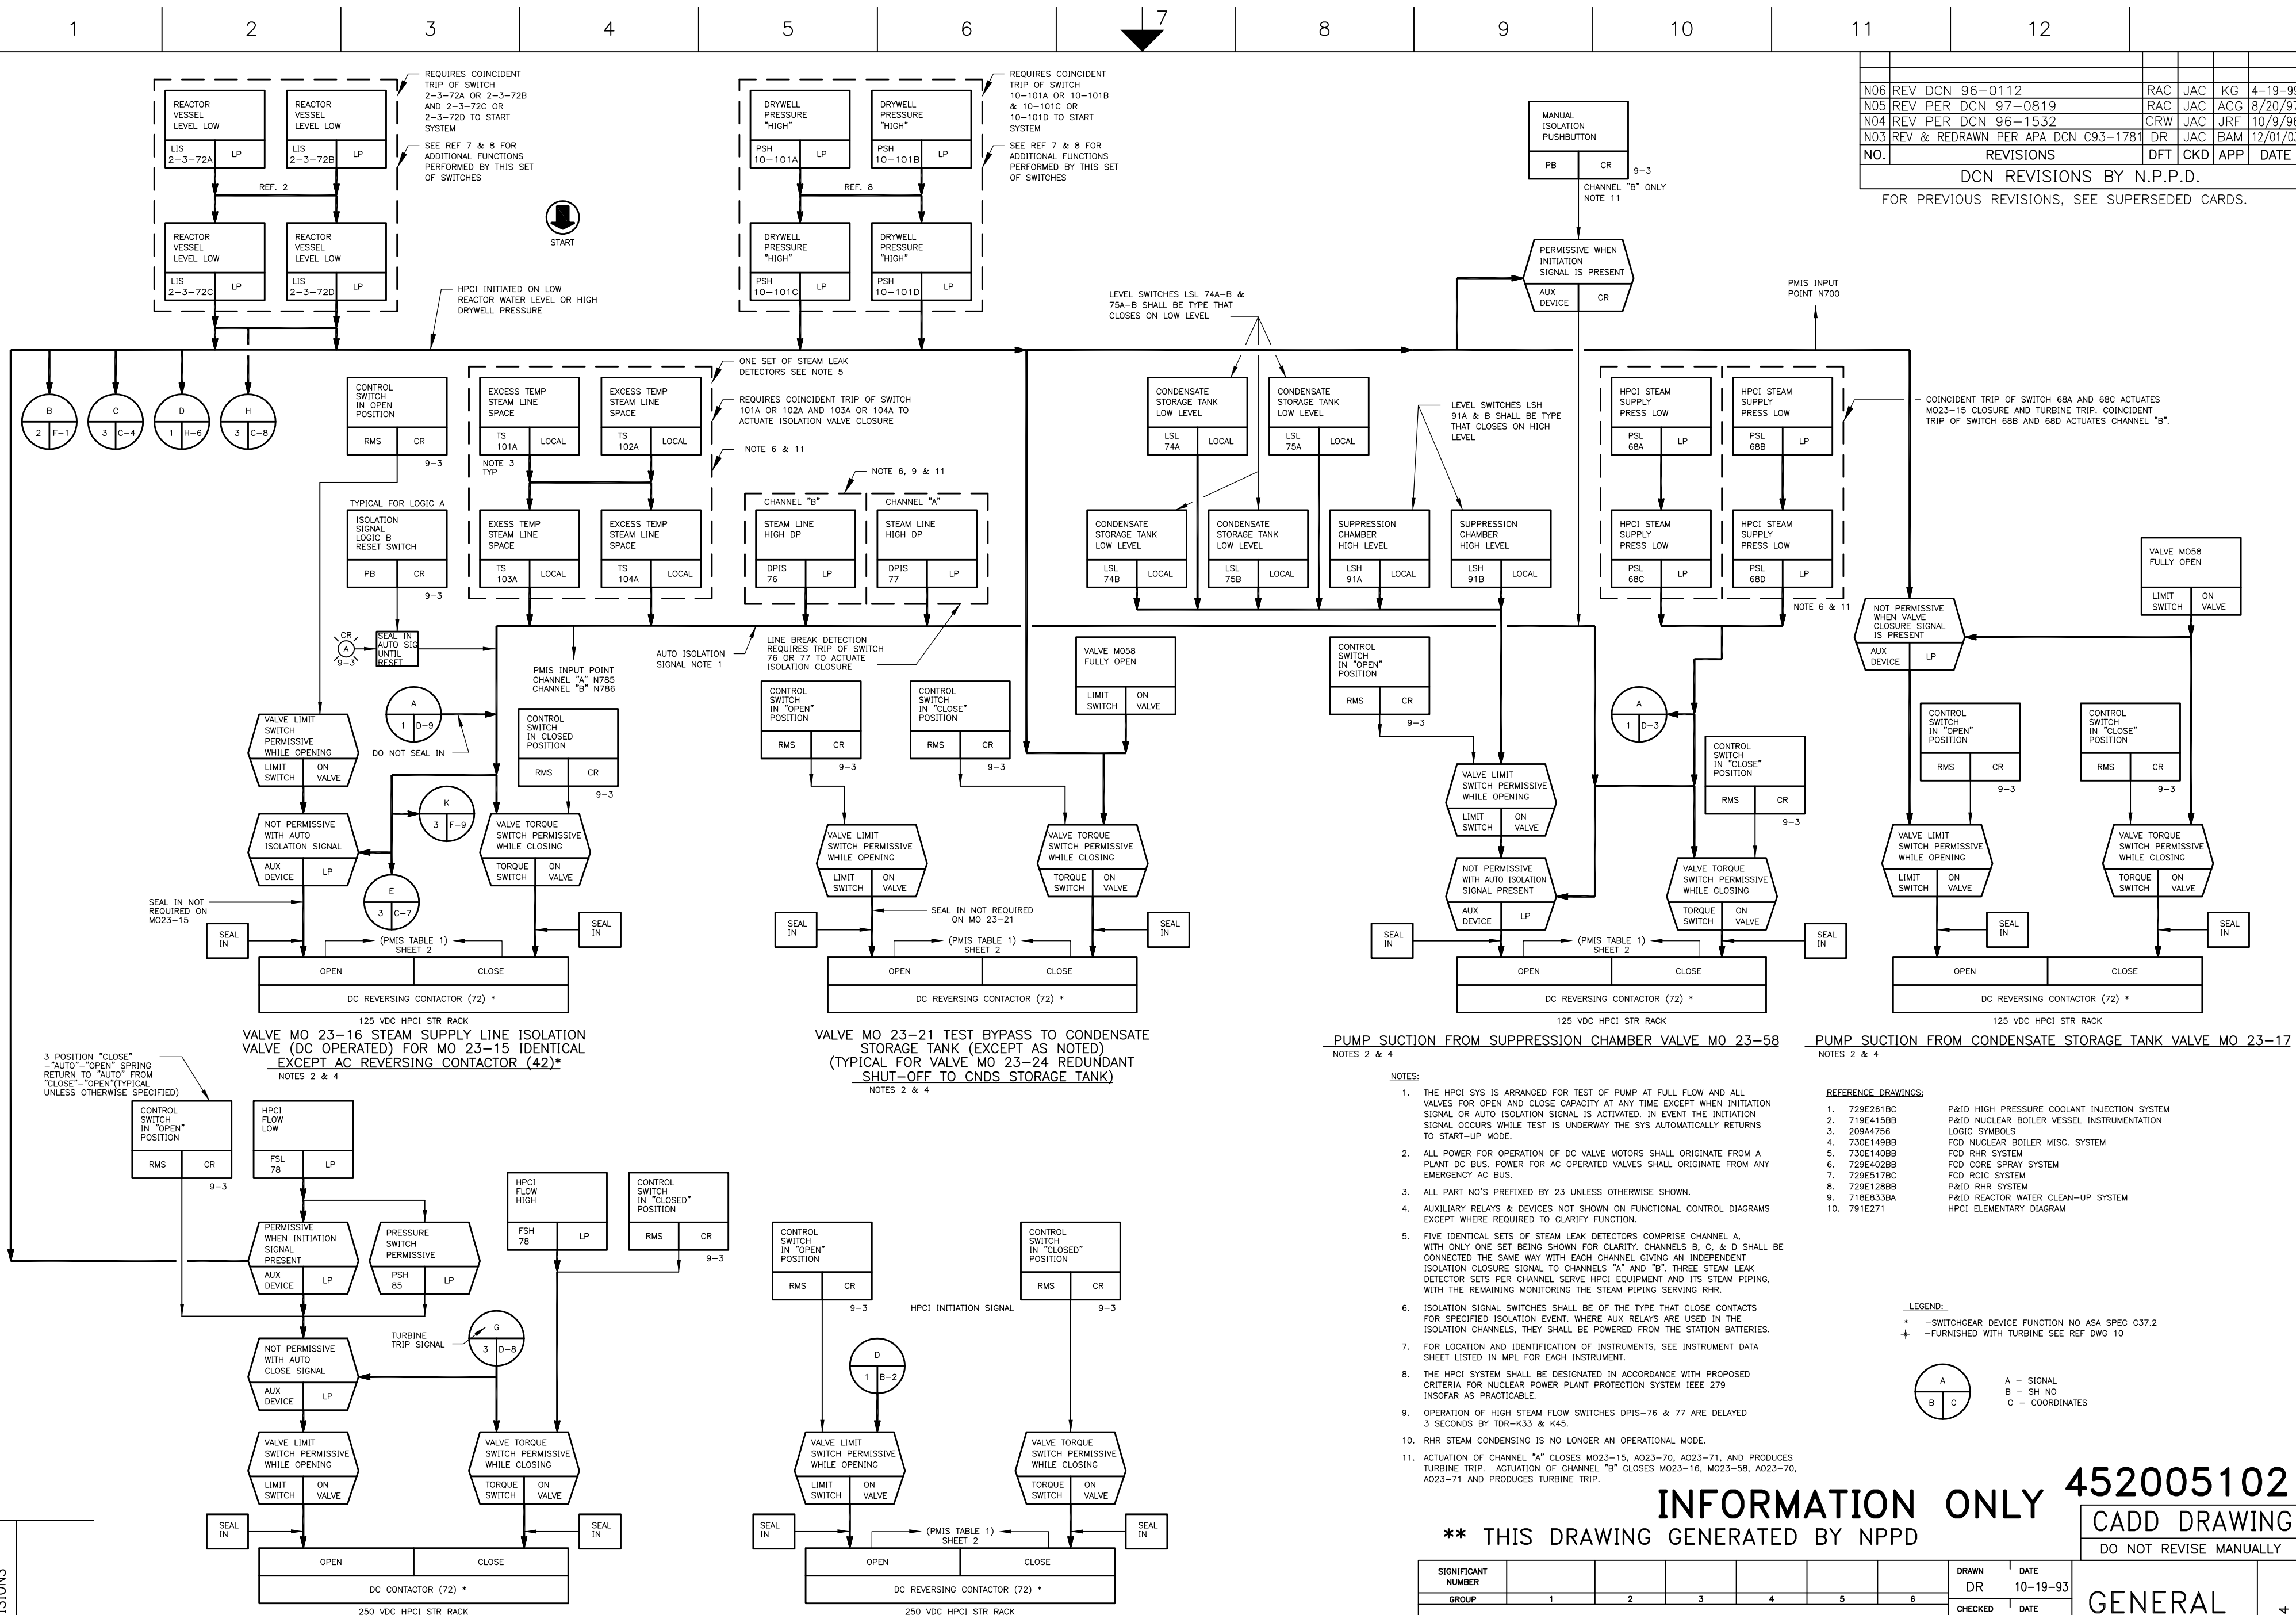


PUMP SUCTION FROM SUPPRESSION CHAMBER VALVE MO 23-58  
NOTES 2 & 4

PUMP SUCTION FROM CONDENSATE STORAGE TANK VALVE MO 23-17  
NOTES 2 & 4

- NOTES:
1. THE HPCI SYS IS ARRANGED FOR TEST OF PUMP AT FULL FLOW AND ALL VALVES FOR OPEN AND CLOSE CAPACITY AT ANY TIME EXCEPT WHEN INITIATION SIGNAL OR AUTO ISOLATION SIGNAL IS ACTIVATED. IN EVENT THE INITIATION SIGNAL OCCURS WHILE TEST IS UNDERWAY THE SYS AUTOMATICALLY RETURNS TO START-UP MODE.
  2. ALL POWER FOR OPERATION OF DC VALVE MOTORS SHALL ORIGINATE FROM A PLANT DC BUS. POWER FOR AC OPERATED VALVES SHALL ORIGINATE FROM ANY EMERGENCY AC BUS.
  3. ALL PART NO'S PREFIXED BY 23 UNLESS OTHERWISE SHOWN.
  4. AUXILIARY RELAYS & DEVICES NOT SHOWN ON FUNCTIONAL CONTROL DIAGRAMS EXCEPT WHERE REQUIRED TO CLARIFY FUNCTION.
  5. FIVE IDENTICAL SETS OF STEAM LEAK DETECTORS COMPRISE CHANNEL A, WITH ONLY ONE SET BEING SHOWN FOR CLARITY. CHANNELS B, C, & D SHALL BE CONNECTED THE SAME WAY WITH EACH CHANNEL GIVING AN INDEPENDENT ISOLATION CLOSURE SIGNAL TO CHANNELS "A" AND "B". THREE STEAM LEAK DETECTOR SETS PER CHANNEL SERVE HPCI EQUIPMENT AND ITS STEAM PIPING, WITH THE REMAINING MONITORING THE STEAM PIPING SERVING RHR.
  6. ISOLATION SIGNAL SWITCHES SHALL BE OF THE TYPE THAT CLOSE CONTACTS FOR SPECIFIED ISOLATION EVENT. WHERE AUX RELAYS ARE USED IN THE ISOLATION CHANNELS, THEY SHALL BE POWERED FROM THE STATION BATTERIES.
  7. FOR LOCATION AND IDENTIFICATION OF INSTRUMENTS, SEE INSTRUMENT DATA SHEET LISTED IN MPL FOR EACH INSTRUMENT.
  8. THE HPCI SYSTEM SHALL BE DESIGNATED IN ACCORDANCE WITH PROPOSED CRITERIA FOR NUCLEAR POWER PLANT PROTECTION SYSTEM IEEE 279 INsofar AS PRACTICABLE.
  9. OPERATION OF HIGH STEAM FLOW SWITCHES DPIS-76 & 77 ARE DELAYED 3 SECONDS BY TDR-K33 & K45.
  10. RHR STEAM CONDENSING IS NO LONGER AN OPERATIONAL MODE.
  11. ACTUATION OF CHANNEL "A" CLOSURES MO23-15, AO23-70, AO23-71, AND PRODUCES TURBINE TRIP. ACTUATION OF CHANNEL "B" CLOSURES MO23-16, MO23-58, AO23-70, AO23-71 AND PRODUCES TURBINE TRIP.

- REFERENCE DRAWINGS:
1. 729E2618C
  2. 719E4158B
  3. 209A4756
  4. 730E1498B
  5. 730E14098B
  6. 729E4028B
  7. 729E5178C
  8. 729E1288B
  9. 718E833BA
  10. 791E271
- P&ID HIGH PRESSURE COOLANT INJECTION SYSTEM  
P&ID NUCLEAR BOILER VESSEL INSTRUMENTATION  
LOGIC SYMBOLS  
FCD NUCLEAR BOILER MISC. SYSTEM  
FCD RHR SYSTEM  
FCD CORE SPRAY SYSTEM  
FCD RCIC SYSTEM  
P&ID RHR SYSTEM  
P&ID REACTOR WATER CLEAN-UP SYSTEM  
HPCI ELEMENTARY DIAGRAM

LEGEND:  
\* - SWITCHGEAR DEVICE FUNCTION NO ASA SPEC C37.2  
+ - FURNISHED WITH TURBINE SEE REF DWG 10

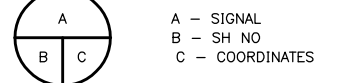

INFORMATION ONLY 452005102  
\*\* THIS DRAWING GENERATED BY NPPD  
CADD DRAWING  
DO NOT REVISE MANUALLY

SIGNIFICANT NUMBER	1	2	3	4	5	6	DRAWN	DATE	10-19-93
GROUP	1	2	3	4	5	6	CHECKED	DATE	10-29-93
COOPER NUCLEAR STATION FUNCTIONAL CONTROL DIAGRAM HIGH PRESSURE COOLANT INJECTION SYS							APPROVED	DATE	12/01/93
							FILMED	729E589BB SH. 1	REVISION N06
							GENERAL ELECTRIC*		
							CADD FILE: C0011074		



A

B

C

D

E

F

G

H

J

REVISIONS

NO.

1

2

3

4

5

6

7

8

9

10

11

12

A

B

C

D





E

F

G

H

J

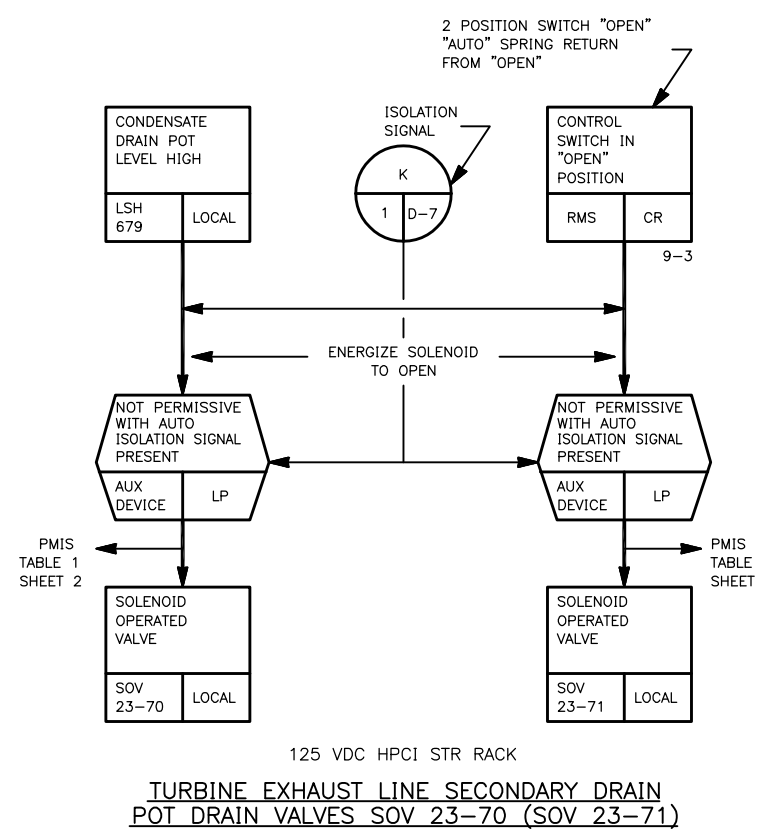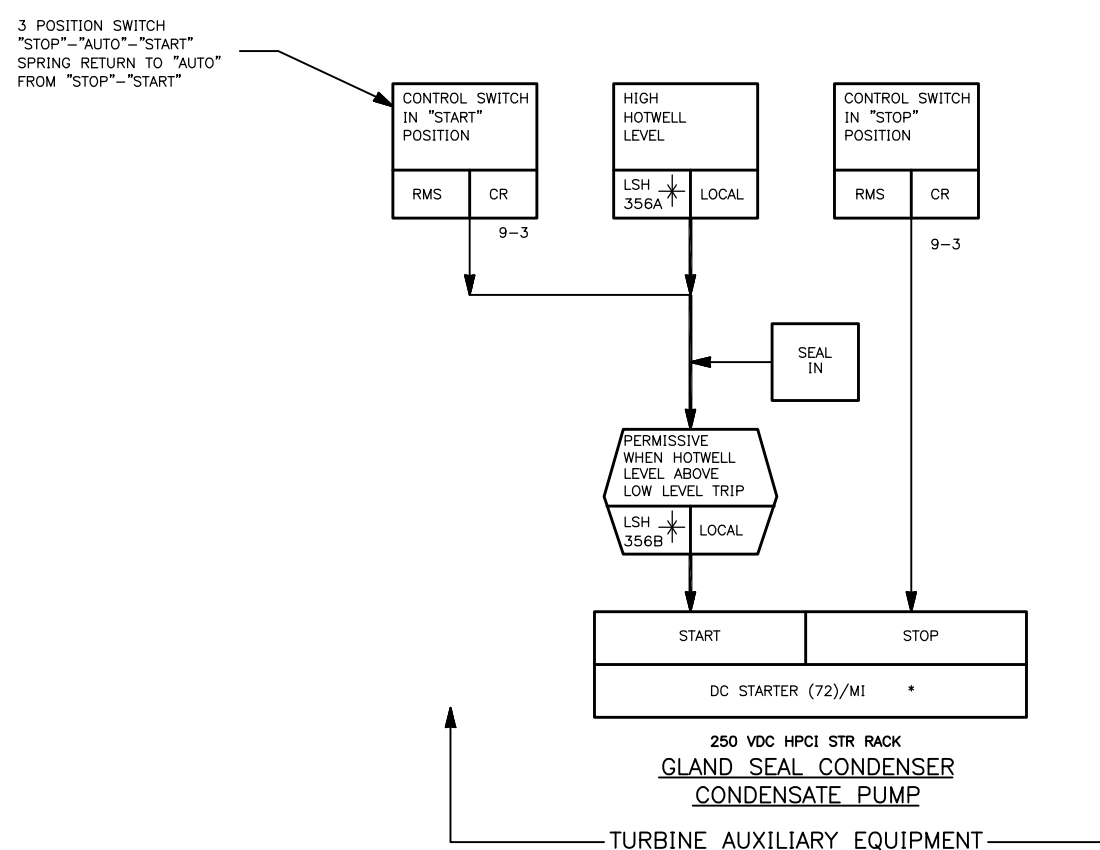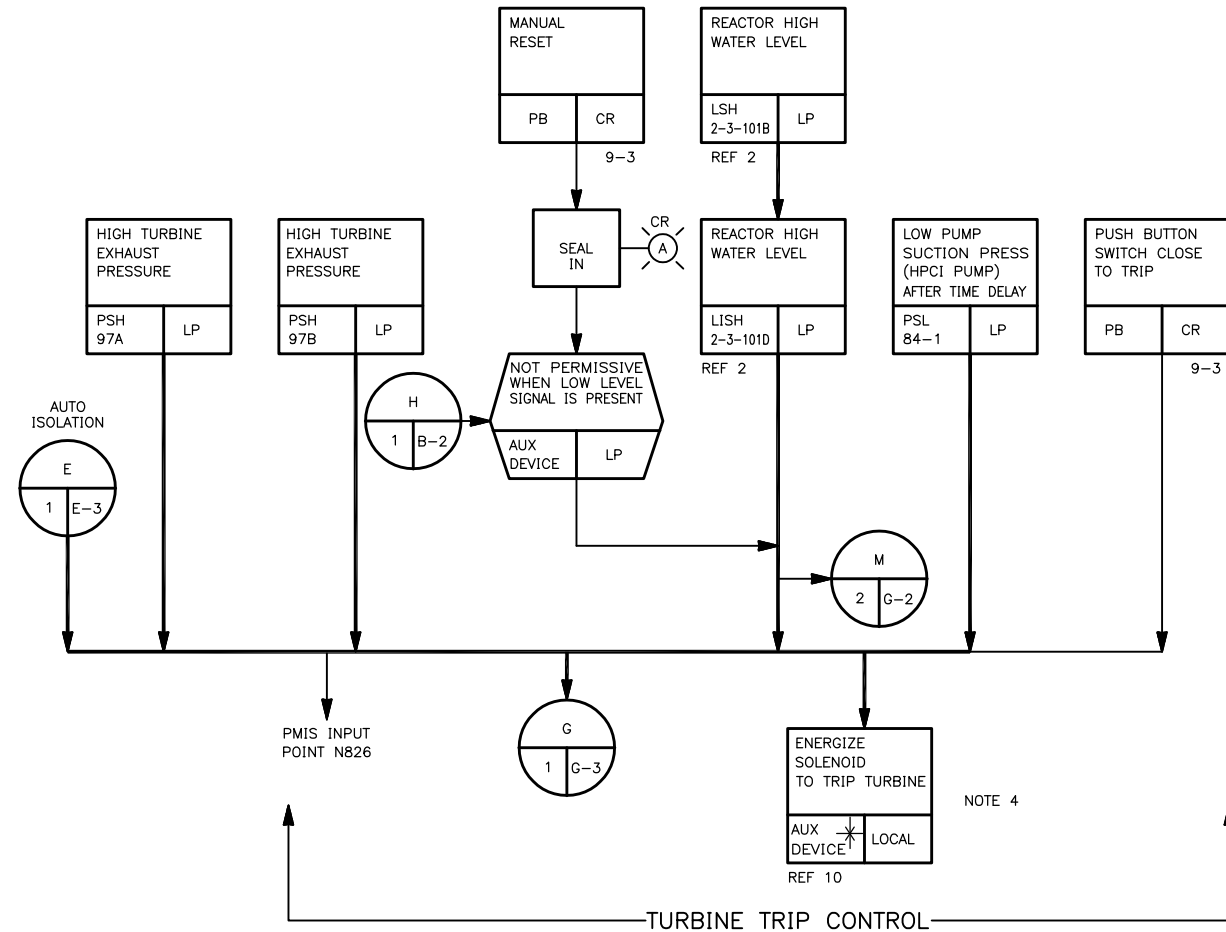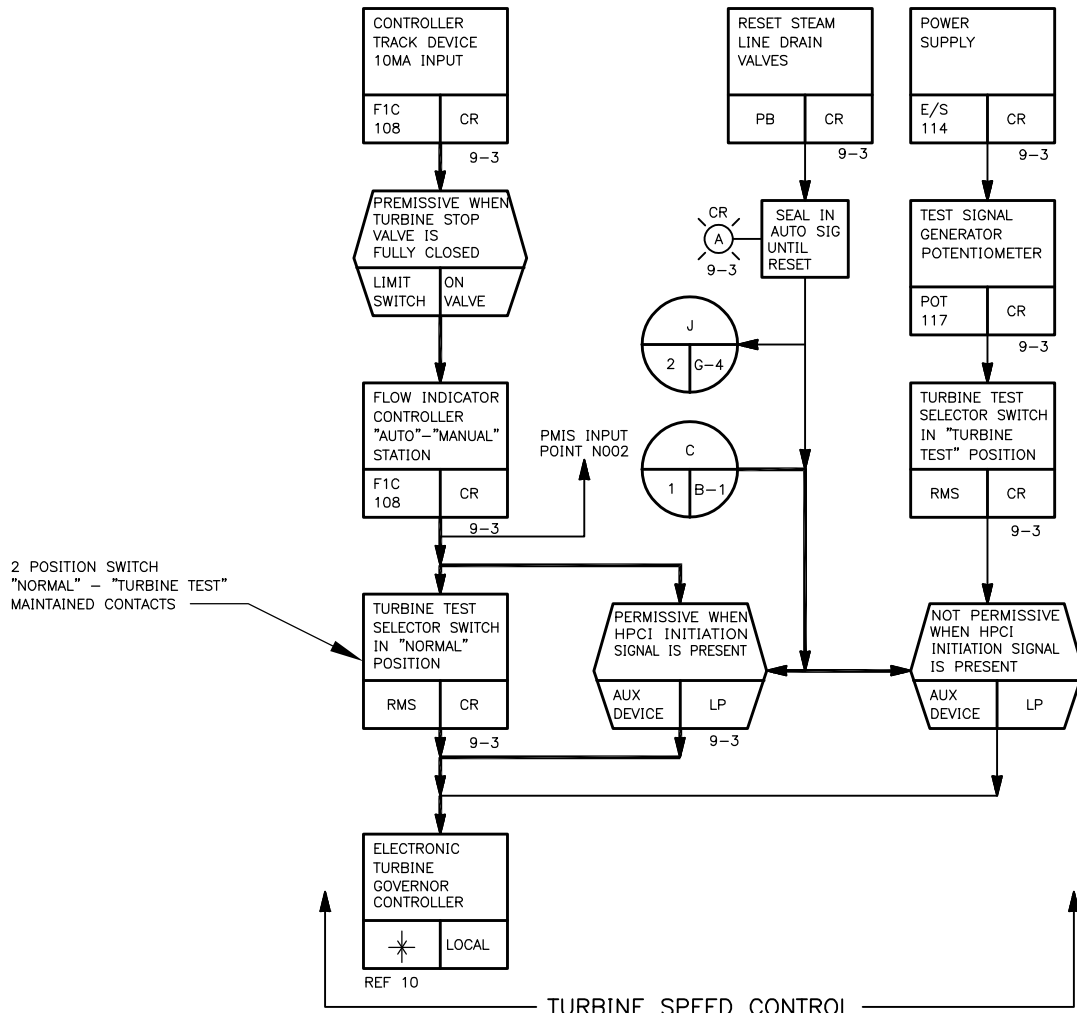

- NOTES:
- 1. FOR GENERAL NOTES AND REFERENCE DRAWINGS SEE SHEET 1.
  - 2. RHR STEAM CONDENSING IS NO LONGER AN OPERATIONAL MODE.

INFORMATION ONLY  
452005104

FOR PREVIOUS REVISIONS, SEE SUPERSEDED CARDS.

REVISIONS BY N.P.P.D.				
NO.	REVISIONS	DFT	CKD	APP
N04	HPCI SYS GE ELEM DIAG DWG REVIEW (DCN 96-1438)	RAC	JAC	RAR
N05	DCD 01 HP-018 (DCN 96-0330)	JAC	RHG	KG
N06	CED 6029441 (DCN 09-1940)	DLR	SMH	KZ

SIGNIFICANT NUMBER	1	2	3	4	5	6
GROUP	1	2	3	4	5	6
COOPER NUCLEAR STATION HIGH PRESSURE COOLANT INJECTION SYS FUNCTIONAL CONTROL DIAGRAM						

DRAWN TRU	DATE 9/24/93	GENERAL ELECTRIC	REVISION N06
CHECKED JAC	DATE 10-28-93		
APPROVED	DATE		
FILMED	729E589BB SH 3		

C0011076



FCF: 238X100BB 13-111

- NOTES:
1. ATMOSPHERIC PRESSURE OF 14.7 PSIA WAS USED IN CALCULATIONS.
  2. WATER FLOWS ARE SHOWN IN GPM, STEAM FLOWS IN 1000 LB/HR.
  3. THE MAXIMUM POOL WATER TEMPERATURE FOR CONTINUOUS SYSTEM OPERATION WILL NOT EXCEED 140°F, HOWEVER, DUE TO POTENTIAL SHORT TERM OPERATION AT HIGHER TEMPERATURES, PIPING EXPANSION SHALL BE BASED ON 170°F.
  4. THE UNRECOVERED FLOW NOZZLE PRESSURE DROP OF 4.5 PSI IS A FIXED LOSS BETWEEN LOCATIONS (3) AND (4).
  5. THE LINE OIL COOLER PRESSURE DROP OF 5.0 PSI IS A FIXED LOSS BETWEEN LOCATIONS (13) AND (14).
  6. THE CONTROLLING MODES FOR LINE SIZING AND ARRANGEMENT ARE:  
 SUCTION FROM COND. STORAGE . . . . . MODE A  
 SUCTION FROM SUPPRESSION POOL . . . . . MODE C  
 PUMP DISCHARGE . . . . . MODE C  
 STEAM SUPPLY . . . . . MODE A & B  
 TURBINE EXHAUST . . . . . MODE A, C & D  
 TEST LINE . . . . . MODE E  
 COOLING SYSTEM . . . . . MODE A
  7. OTHER MODES OF OPERATION EXIST WHICH DO NOT EFFECT LINE SIZE OR OPERATING CONDITIONS. AMONG THESE ARE THE FOLLOWING:  
 A. SUCTION FROM EMERGENCY CONDENSATE STORAGE SUPPRESSION POOL AT LOW PRESSURE, REACTOR AT LOW PRESSURE.  
 B. SUCTION FROM SUPPRESSION POOL, SUPPRESSION POOL AT HIGH PRESSURE, REACTOR AT HIGH OR LOW PRESSURE.  
 C. ANY INTERMEDIATE REACTOR PRESSURE OR SUPPRESSION POOL PRESSURE.  
 D. SUCTION FROM RHR HEAT EXCHANGERS, REACTOR AT HIGH OR LOW PRESSURE.
  8. PUMP MINIMUM FLOW REQUIREMENTS MAY OCCUR DURING ANY OPERATING MODE. FLOW REQUIREMENT IS 50 GPM MINIMUM.
  9. MAXIMUM PROCESS TEMPERATURES ARE SHOWN.
  10. THIS DRAWING REFLECTS THE AS-BUILT CONFIGURATION PER BURNS & ROE RCIC P&ID, DRAWING NO. 2043, REV 14.
- NOTE:  
RHR STEAM CONDENSING IS NO LONGER AN OPERATIONAL MODE.

MODE A SUCTION FROM CONDENSATE STORAGE, REACTOR AT HIGH PRESSURE, SUPPRESSION POOL AT HIGH PRESS.

LOCATION	1	2	3	4	5	6	7	8	9	10	11	12	13	14	15	16	17	18	19	20
FLOW - SEE NOTE 2	400	416	400	—	—	0	—	16.4	16.25	16.25	16	16	16	0.23	—	0.01	16*	—	0	—
PRESSURE - PSIA	14.7	*	*	114.0	18	—	—	113.5	*	*	19.8	7.5	*	4.5	*	9.8	*	*	*	—
TEMPERATURE °F	100	100	100	100	140	—	—	56.0	SAT	SAT	278	100	100	100	298	120	120	120	100	—

MODE B SUCTION FROM CONDENSATE STORAGE, REACTOR AT LOW PRESSURE, SUPPRESSION POOL AT HIGH PRESS.

LOCATION	1	2	3	4	5	6	7	8	9	10	11	12	13	14	15	16	17	18	19	20
FLOW - SEE NOTE 2	400	416	400	—	—	0	—	6	5.85	5.85	16	16	16	0.23	—	0.01	16*	—	0	—
PRESSURE - PSIA	14.7	*	*	170	18	—	—	16.5	*	*	19.8	7.5	*	4.5	*	9.8	*	*	*	—
TEMPERATURE °F	100	100	100	100	140	—	—	36.6	SAT	SAT	228	100	100	100	298	120	120	120	100	—

MODE C SUCTION FROM SUPPRESSION POOL, REACTOR AT HIGH PRESSURE, SUPPRESSION POOL AT LOW PRESS.

LOCATION	1	2	3	4	5	6	7	8	9	10	11	12	13	14	15	16	17	18	19	20
FLOW - SEE NOTE 2	400	416	400	—	—	400	—	15.3	15.35	15.35	16	16	16	0.23	—	0.01	16*	—	0	—
PRESSURE - PSIA	*	*	114.0	14.7	17.7	17.3	113.5	*	*	16.6	7.5	*	4.5	*	9.8	*	*	*	*	—
TEMPERATURE °F	140	140	140	140	140	140	56.0	SAT	SAT	218	140	140	140	298	160	160	160	160	140	—

MODE D SUCTION FROM SUPPRESSION POOL, REACTOR AT LOW PRESSURE, SUPPRESSION POOL AT LOW PRESS.

LOCATION	1	2	3	4	5	6	7	8	9	10	11	12	13	14	15	16	17	18	19	20
FLOW - SEE NOTE 2	400	416	400	—	—	400	—	5.5	5.35	5.35	16	16	16	0.23	—	0.01	16*	—	0	—
PRESSURE - PSIA	*	*	170	14.7	17.7	17.3	16.5	*	*	16.5	7.5	*	4.5	*	9.8	*	*	*	*	—
TEMPERATURE °F	140	140	140	140	140	140	36.6	SAT	SAT	218	140	140	140	298	160	160	160	160	140	—

MODE E TEST MODE: SUCTION FROM CONDENSATE STORAGE, REACTOR AT HIGH PRESSURE, SUPPRESSION POOL AT LOW PRESS.

LOCATION	1	2	3	4	5	6	7	8	9	10	11	12	13	14	15	16	17	18	19	20
FLOW - SEE NOTE 2	400	416	0	—	—	0	—	13.7	13.55	13.55	16	16	16	0.23	—	0.01	16*	—	400	—
PRESSURE - PSIA	14.7	*	*	—	14.7	—	—	100.0	*	*	16.6	7.5	*	4.5	*	9.8	*	*	*	—
TEMPERATURE °F	100	100	100	—	100	—	—	54.3	SAT	SAT	218	100	100	100	298	120	120	120	100	100

\* THE PRESSURE AT THIS LOCATION DEPENDS ON PIPING ARRANGEMENT AND MAY BE VARIED WITHIN THE FOLLOWING LIMITS.

- LOCATION
- (2) MINIMUM NPSH AT PUMP SUCTION = 20 FEET
  - (3) MAXIMUM PRESSURE RISE ACROSS PUMP: 2800 FEET FOR MODES A & C; 525 FEET FOR MODES B & D
  - (9) MAXIMUM PRESSURE DROP BETWEEN LOCATION (8) AND (9) = 15 PSI
  - (10) MAXIMUM PRESSURE ALLOWED = 64.7 PSIA
  - (13) MAXIMUM PRESSURE ALLOWED = 75 PSIA
  - (15) SUFFICIENT VACUUM TO PREVENT TURBINE SHAFT-OUT-LEAKAGE, TO BE SPECIFIED ON TURBINE VENDOR DRAWINGS.
  - (17) MAXIMUM PRESSURE AVAILABLE = 25 PSIA
  - (18) MAXIMUM PRESSURE AVAILABLE = 50 PSIA
  - (19) SUFFICIENT PRESSURE TO RETURN TO SUPPRESSION POOL
  - (20) SUFFICIENT PRESSURE TO RETURN TO COND. STORAGE.

THIS DWG SUPERCEDES DWG 729E 719BA REV 0.  
FOR COOPER CHGS ARE DENOTED BY ENCIRCLEMENT PER ECA 90715-2 (DF)  
7-29-69 G.W. Williams

INFORMATION ONLY

FOR PREVIOUS REVISIONS, SEE SUPERSSEDED CARDS.

NO.	DESCRIPTION	DATE	ENG
1	REVISION	10/13/10	RS/CLL
2			
3			
4			
5			

454004895

STATUS: Release FIO  
DATE: 06/05/2015  
IS APPROVED: RAREXRO  
VER: AB REV. 03 SIZE: F

NEBO  
SAN JOSE, CALIFORNIA

729E719BC

00170597

R DPH

FCF 238 X100 B (23-121)

- NOTES:
1. ATMOSPHERIC PRESSURE OF 14.7 PSIA WAS USED IN CALCULATIONS.
  2. WATER FLOWS ARE SHOWN IN GPM, STEAM FLOWS IN 1000 LB/HR.
  3. THE MAXIMUM POOL WATER TEMPERATURE FOR CONTINUOUS SYSTEM OPERATION WILL NOT EXCEED 140°F. HOWEVER, DUE TO POTENTIAL SHORT TERM OPERATION AT HIGHER TEMPERATURES, PIPING EXPANSION SHALL BE BASED ON 170°F. SHORT TERM OPERATION AT ELEVATED TEMPERATURES HAS BEEN EVALUATED IN CALCULATIONS NEDC 01-028A, B, C AND NEDC 97-0448, C.
  4. THE FOLLOWING ADDITIONAL ACCIDENT OPERATING MODES ARE POSSIBLE:  
SUCTION FROM CONDENSATE STORAGE, SUPPRESSION POOL AT LOW PRESSURE, REACTOR AT HIGH OR LOW PRESSURE.  
SUCTION FROM SUPPRESSION POOL, SUPPRESSION POOL AT HIGH PRESSURE, REACTOR AT HIGH OR LOW PRESSURE.  
THESE POTENTIAL OPERATING MODES DO NOT CONTROL PIPE OR VALVE SIZING OR SPECIFICATION, AND NO DATA IS SHOWN.
  5. THE CONTROLLING MODES FOR LINE SIZING AND ARRANGEMENT ARE:  
SUCTION FROM COND. STORAGE ———— MODE A  
SUCTION FROM SUPPRESSION POOL ———— MODE C  
PUMP DISCHARGE ———— MODE C  
STEAM SUPPLY ———— MODE B  
TURBINE EXHAUST ———— MODE A, C & D  
TEST LINE ———— MODE E  
COOLING SYSTEM ———— MODE A
  6. THE PRESSURE AT LOCATION (3) IS ESTIMATED FROM PRELIMINARY PUMP DATA.
  7. PUMP MINIMUM FLOW REQUIREMENT MAY OCCUR DURING ANY OPERATING MODE. FLOW REQUIREMENT IS 450 GPM MINIMUM.
  8. THE PRESSURE DROPS ACROSS THE GLAND SEAL CONDENSER AND LUBE OIL COOLER WILL BE 3 PSI EACH.
  9. THIS DRAWING REFLECTS THE AS-BUILT CONFIGURATION PER BURNS & ROE HPCI P & ID, DRAWING #2044, REV 16.

TABLE OF ELEVATION (FEET)

GRADE	903
VESSEL N.W.L.	963
POOL L.W.L.	875
PUMP C.L.	862

MODE A ACCIDENT MODE, SUCTION FROM CONDENSATE STORAGE, REACTOR AT HIGH PRESSURE, SUPPRESSION POOL AT HIGH PRESSURE.

LOCATION	1	2	3	4	5	6	7	8	9	10	11	12	13	14	15	16	17	18	19	20	21
FLOW - SEE NOTE 2	—	4250	4320	4250	4250	—	0	—	159.0	158.5	158.5	—	D	0.5	0.05	1	70	70	50	20	—
PRESSURE - PSIA	14.7	*	280	*	1140	—	—	1135	*	*	51.9	*	—	14.5	14.9	*	75	*	*	*	50
TEMPERATURE °F	100	100	100	100	100	—	—	560	SAT.	SAT.	283	100	—	240	200	200	100	130	130	130	140

MODE B ACCIDENT MODE, SUCTION FROM CONDENSATE STORAGE, REACTOR AT LOW PRESSURE, SUPPRESSION POOL AT HIGH PRESSURE.

LOCATION	1	2	3	4	5	6	7	8	9	10	11	12	13	14	15	16	17	18	19	20	21
FLOW - SEE NOTE 2	—	4250	4320	4250	4250	—	0	—	109.5	109.0	109.0	—	D	0.5	0.05	1	70	70	50	20	—
PRESSURE - PSIA	14.7	*	8.5	*	170	—	—	165	*	*	51.8	*	—	14.5	14.9	*	75	*	*	*	50
TEMPERATURE °F	100	100	100	100	100	—	—	366	SAT.	SAT.	283	100	—	240	200	200	100	130	130	130	140

MODE C ACCIDENT MODE, SUCTION FROM SUPPRESSION POOL, REACTOR AT HIGH PRESSURE, SUPPRESSION POOL AT LOW PRESSURE.

LOCATION	1	2	3	4	5	6	7	8	9	10	11	12	13	14	15	16	17	18	19	20	21
FLOW - SEE NOTE 2	—	4250	4320	4250	4250	—	4250	—	149.0	148.5	148.5	—	0	0.5	0.05	1	70	70	50	20	—
PRESSURE - PSIA	—	*	280	*	1140	17.7	16.5	1135	*	*	16.7	*	—	14.5	14.9	*	75	*	*	*	14.7
TEMPERATURE °F	—	140	140	140	140	140	140	560	SAT.	SAT.	218	140	—	240	200	200	140	170	170	170	140

MODE D ACCIDENT MODE, SUCTION FROM SUPPRESSION POOL, REACTOR AT LOW PRESSURE, SUPPRESSION POOL AT LOW PRESSURE.

LOCATION	1	2	3	4	5	6	7	8	9	10	11	12	13	14	15	16	17	18	19	20	21
FLOW - SEE NOTE 2	—	4250	4320	4250	4250	—	4250	—	71.0	70.5	70.5	—	0	0.5	0.05	1	70	70	50	20	—
PRESSURE - PSIA	—	*	8.5	*	170	17.7	16.5	165	*	*	16.6	*	—	14.5	14.9	*	75	*	*	*	14.7
TEMPERATURE °F	—	140	140	140	140	140	140	366	SAT.	SAT.	218	140	—	240	200	200	140	170	170	170	140


MODE E TEST MODE, SUCTION FROM CONDENSATE STORAGE, REACTOR AT HIGH PRESSURE, SUPPRESSION POOL AT LOW PRESSURE.

LOCATION	1	2	3	4	5	6	7	8	9	10	11	12	13	14	15	16	17	18	19	20	21
FLOW - SEE NOTE 2	—	4250	4320	4250	—	—	0	—	158.0	157.5	157.5	—	4250	0.5	0.05	1	70	70	50	20	—
PRESSURE - PSIA	14.7	*	255	*	—	—	—	1000	*	*	25.3	*	*	14.5	14.9	*	75	*	*	*	14.7
TEMPERATURE °F	100	100	100	100	—	—	—	545	SAT.	SAT.	218	100	100	240	200	200	100	130	130	130	140

- \* THE PRESSURE AT THIS LOCATION DEPENDS UPON PIPING ARRANGEMENTS, AND MAY BE VARIED WITHIN THE FOLLOWING LIMITS:
- LOCATION
- (2) MINIMUM NPSH AT PUMP SUCTION = 21 FEET
- (2) TO (1) MAXIMUM PRESSURE RISE = 2800 FEET @ HIGH PRESS MODE
- = 525 FEET @ LOW PRESS MODE
- (8) MAXIMUM PRESSURE DROP BETWEEN LOCATIONS (2) AND (8) = 15 PSI.
- (10) MAXIMUM PRESSURE = 65 PSIA
- (12) SUFFICIENT PRESSURE TO RETURN TO SUPPRESSION POOL
- (13) SUFFICIENT PRESSURE TO RETURN TO COND. STORAGE
- (16) MAXIMUM PRESSURE AVAILABLE = 65 PSIA
- (16)(19)(20) SUFFICIENT PRESSURE TO RETURN TO PUMP SUCTION DURING OPERATION

FOR PREVIOUS REVISIONS, SEE SUPERSEDED CARDS.

REVISIONS BY N.P.P.D.				
NO.	REVISIONS	DFT	CHKD	APP
NO. 1	02-035 (OCT 02-0719)	RAC	RHG	KG
NO. 2				
NO. 3				
NO. 4				
NO. 5				
NO. 6				
NO. 7				
NO. 8				
NO. 9				
NO. 10				
NO. 11				
NO. 12				
NO. 13				
NO. 14				
NO. 15				
NO. 16				
NO. 17				
NO. 18				
NO. 19				
NO. 20				
NO. 21				

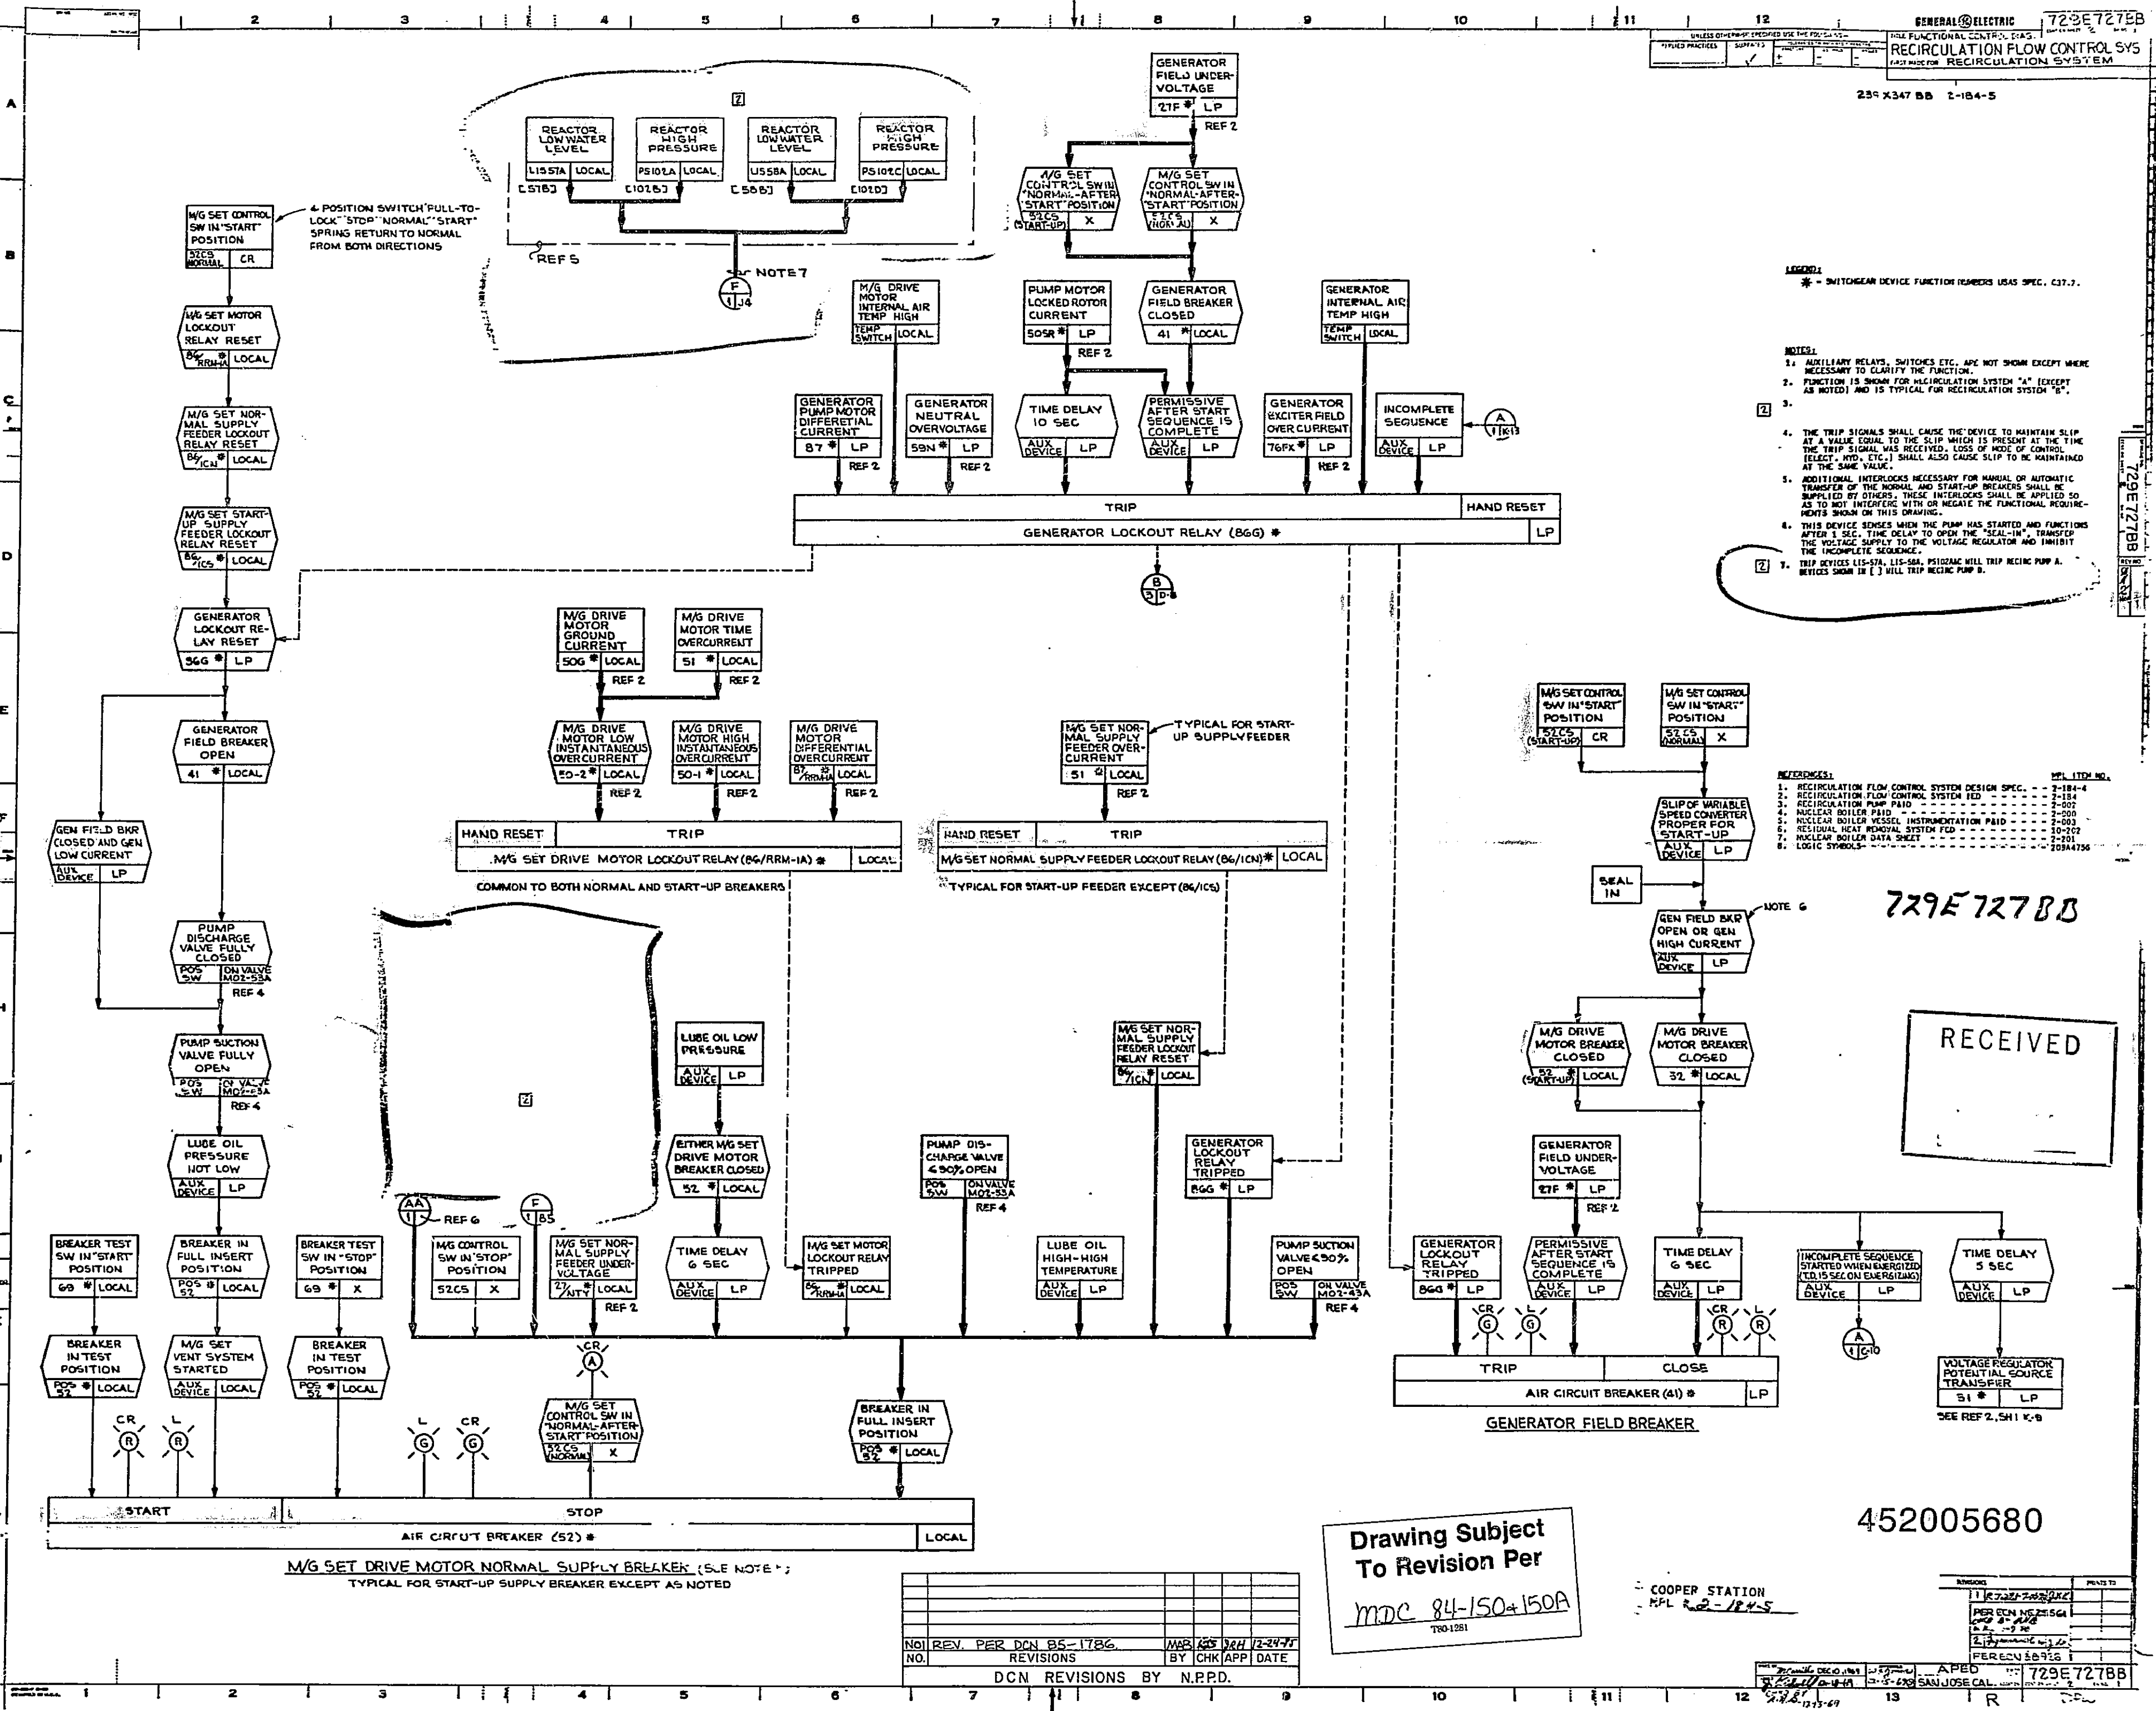

LEGEND:  
\* - SWITCHING DEVICE FUNCTION REMBERS USAS SPEC. 437.7.

- NOTES:
1. AUXILIARY RELAYS, SWITCHES ETC. ARE NOT SHOWN EXCEPT WHERE NECESSARY TO CLARIFY THE FUNCTION.
  2. FUNCTION IS SHOWN FOR RECIRCULATION SYSTEM "A" (EXCEPT AS NOTED) AND IS TYPICAL FOR RECIRCULATION SYSTEM "B".
  - 3.
  4. THE TRIP SIGNALS SHALL CAUSE THE DEVICE TO MAINTAIN SLIP AT A VALUE EQUAL TO THE SLIP WHICH IS PRESENT AT THE TIME THE TRIP SIGNAL WAS RECEIVED. LOSS OF MODE OF CONTROL (SELECT, HYD, ETC.) SHALL ALSO CAUSE SLIP TO BE MAINTAINED AT THE SAME VALUE.
  5. ADDITIONAL INTERLOCKS NECESSARY FOR MANUAL OR AUTOMATIC TRANSFER OF THE NORMAL AND START-UP BREAKERS SHALL BE SUPPLIED BY OTHERS. THESE INTERLOCKS SHALL BE APPLIED SO AS TO NOT INTERFERE WITH OR NEGATE THE FUNCTIONAL REQUIREMENTS SHOWN ON THIS DRAWING.
  6. THIS DEVICE SENSES WHEN THE PUMP HAS STARTED AND FUNCTIONS AFTER 1 SEC. TIME DELAY TO OPEN THE "SEAL-IN" TRANSFER THE VOLTAGE SUPPLY TO THE VOLTAGE REGULATOR AND INHIBIT THE INCOMPLETE SEQUENCE.
  7. TRIP DEVICES L15-57A, L15-58A, PS102AC WILL TRIP RECIRC PUMP A. DEVICES SHOWN IN [ ] WILL TRIP RECIRC PUMP B.

- REFERENCES:
- |   |          |
|---|----------|
| 1. RECIRCULATION FLOW CONTROL SYSTEM DESIGN SPEC. | 2-184-4  |
| 2. RECIRCULATION FLOW CONTROL SYSTEM FED          | 2-184    |
| 3. RECIRCULATION PUMP PAID                        | 2-002    |
| 4. NUCLEAR BOILER PAID                            | 2-003    |
| 5. NUCLEAR BOILER VESSEL INSTRUMENTATION PAID     | 2-003    |
| 6. RESIDUAL HEAT REMOVAL SYSTEM FED               | 10-207   |
| 7. NUCLEAR BOILER DATA SHEET                      | 2-201    |
| 8. LOGIC SYMBOLS                                  | 209A4756 |

729E7278B

RECEIVED


452005680

Drawing Subject To Revision Per  
MDC 84-150-150A  
780-1281

COOPER STATION  
MPL 2-2-184-5

NOI REV. PER DCN 85-1786	MAR 1985	2-24-77
NO.	REVISIONS	BY CHK APP DATE
DCN REVISIONS BY N.P.D.		




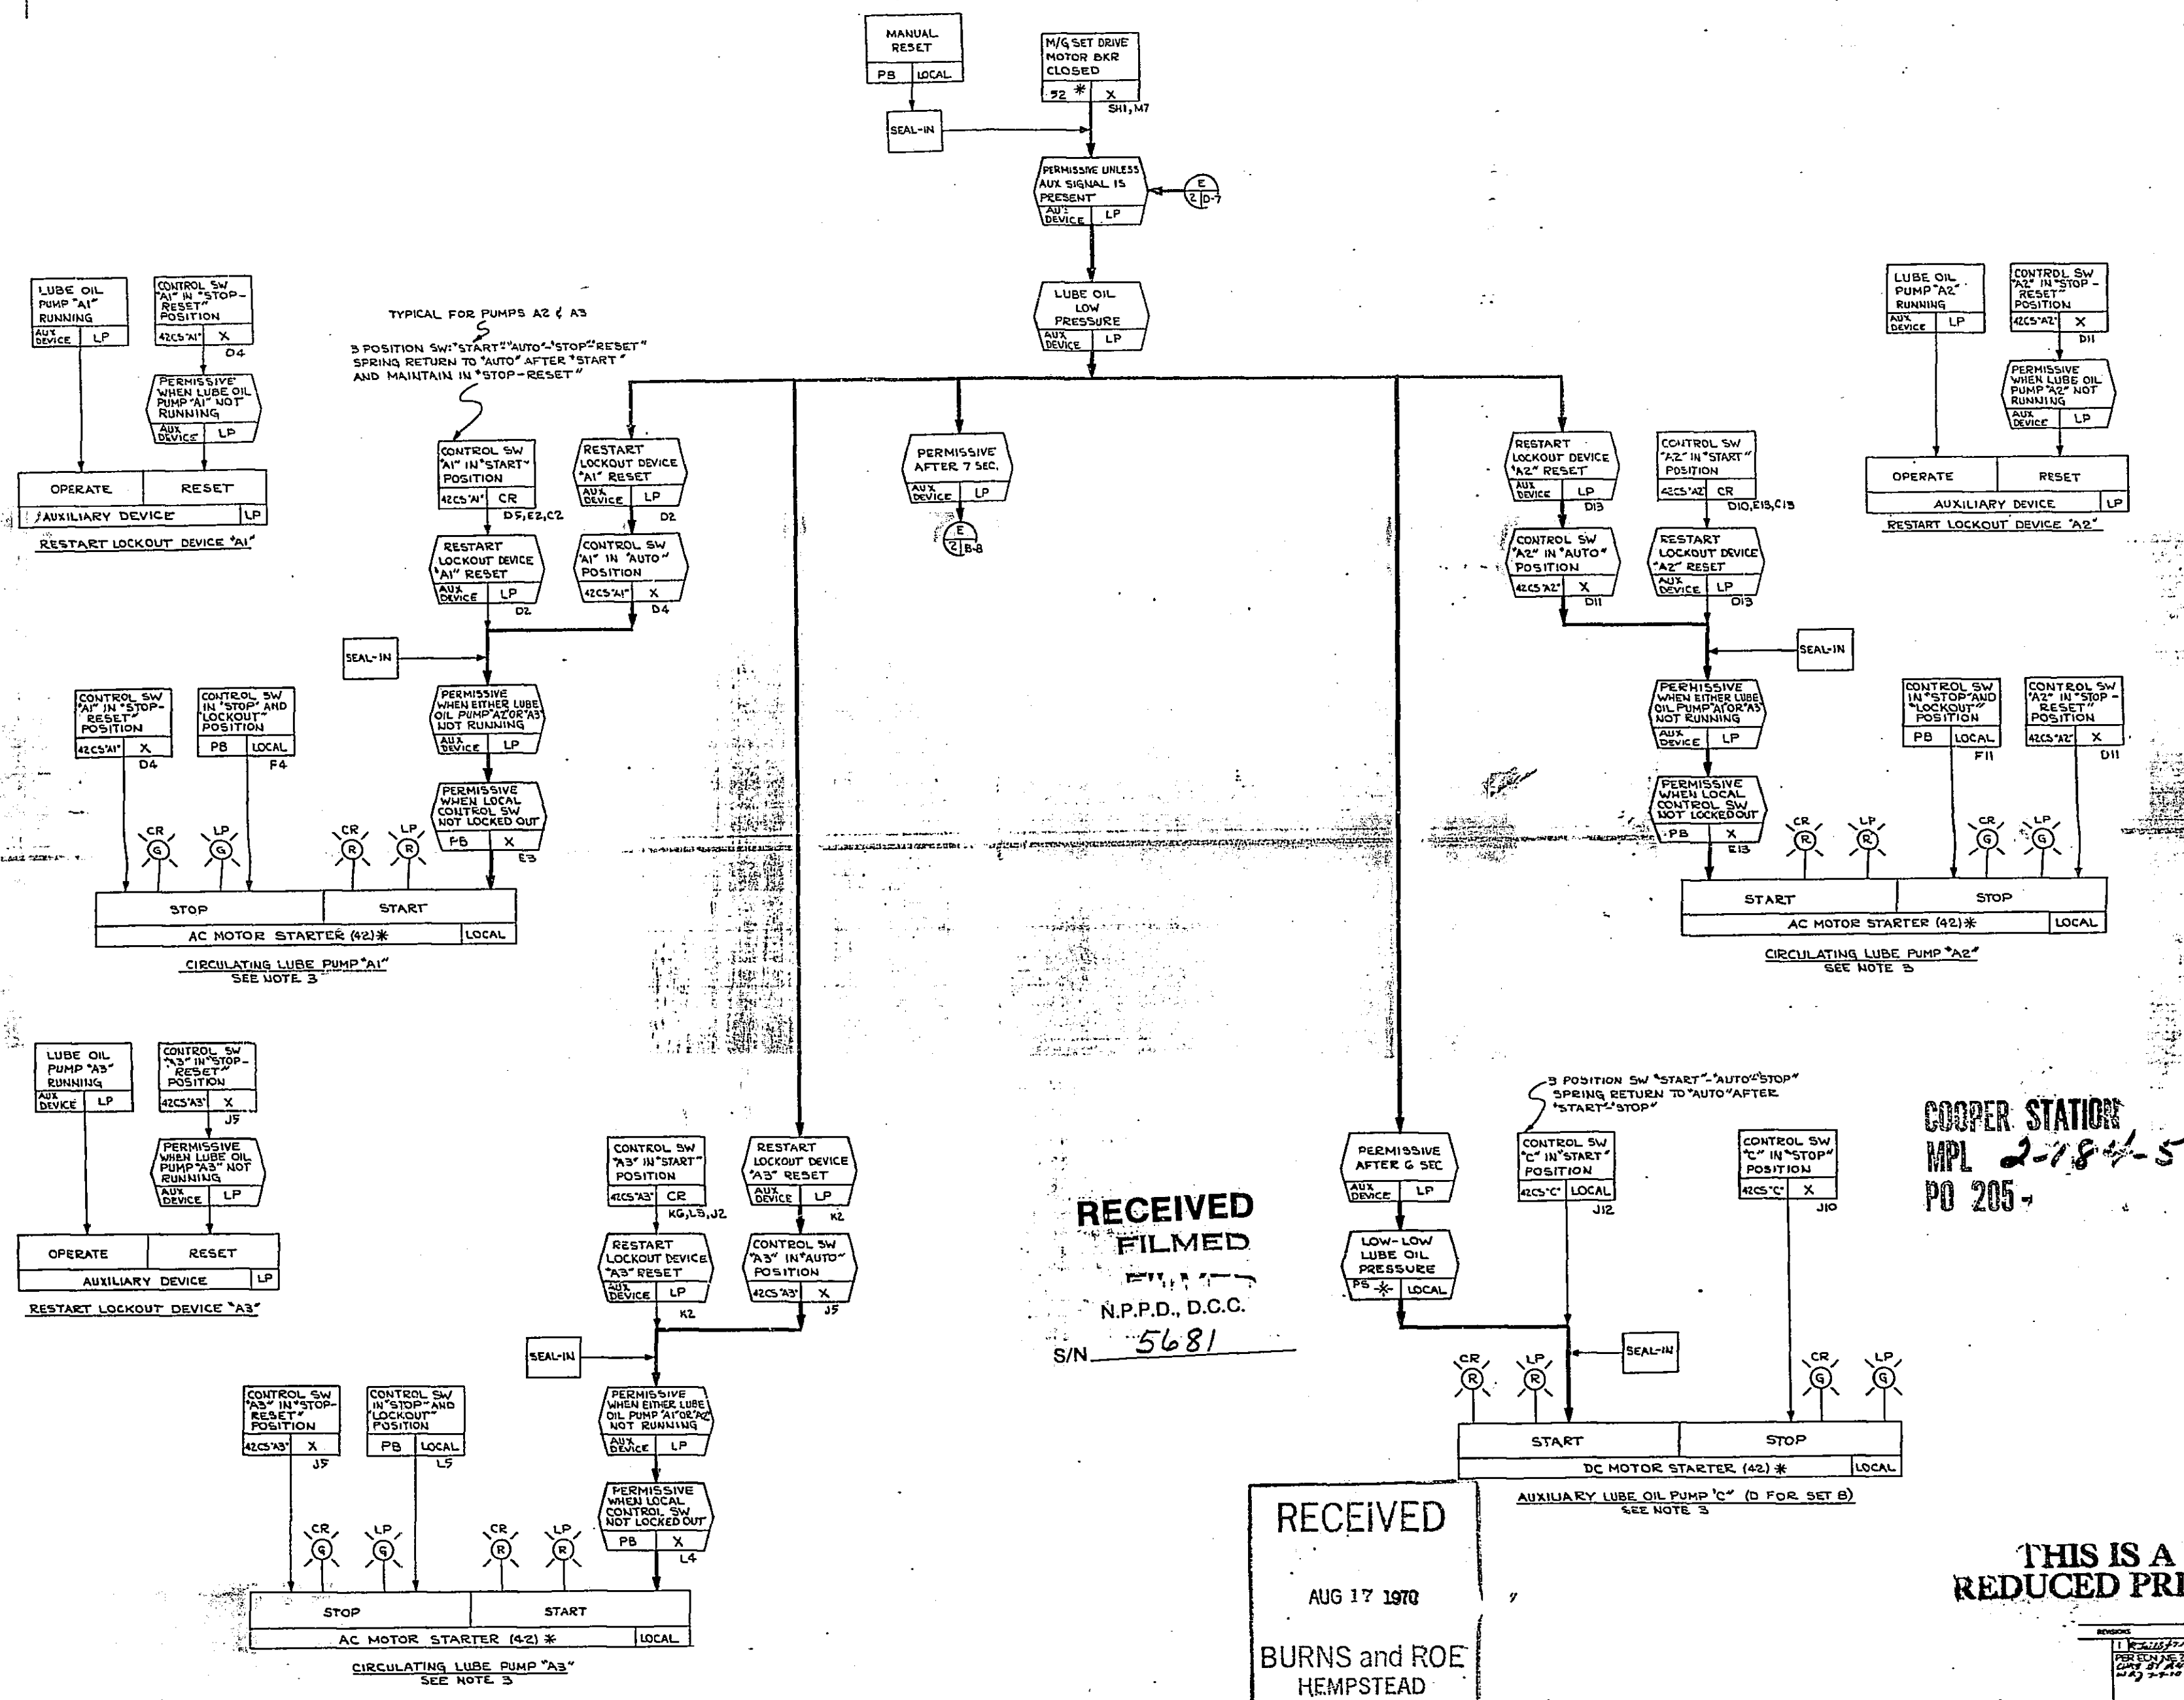


RECEIVED  
FILMED  
N.P.P.D., D.C.C.  
S/N 5681


RECEIVED  
AUG 17 1970  
BURNS and ROE  
HEMPSTEAD

COOPER STATION  
MPL 2-18-5  
PO 205

THIS IS A  
REDUCED PRINT

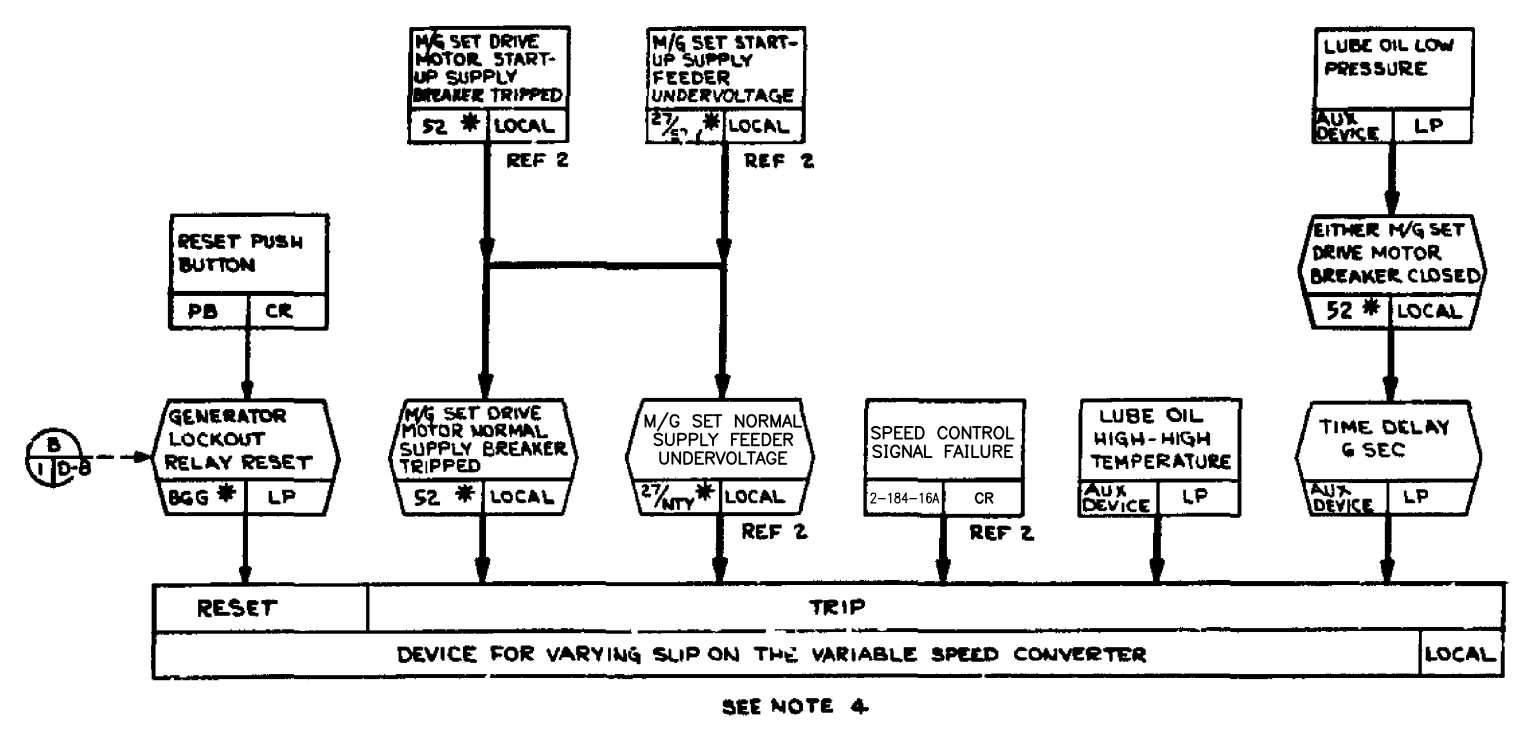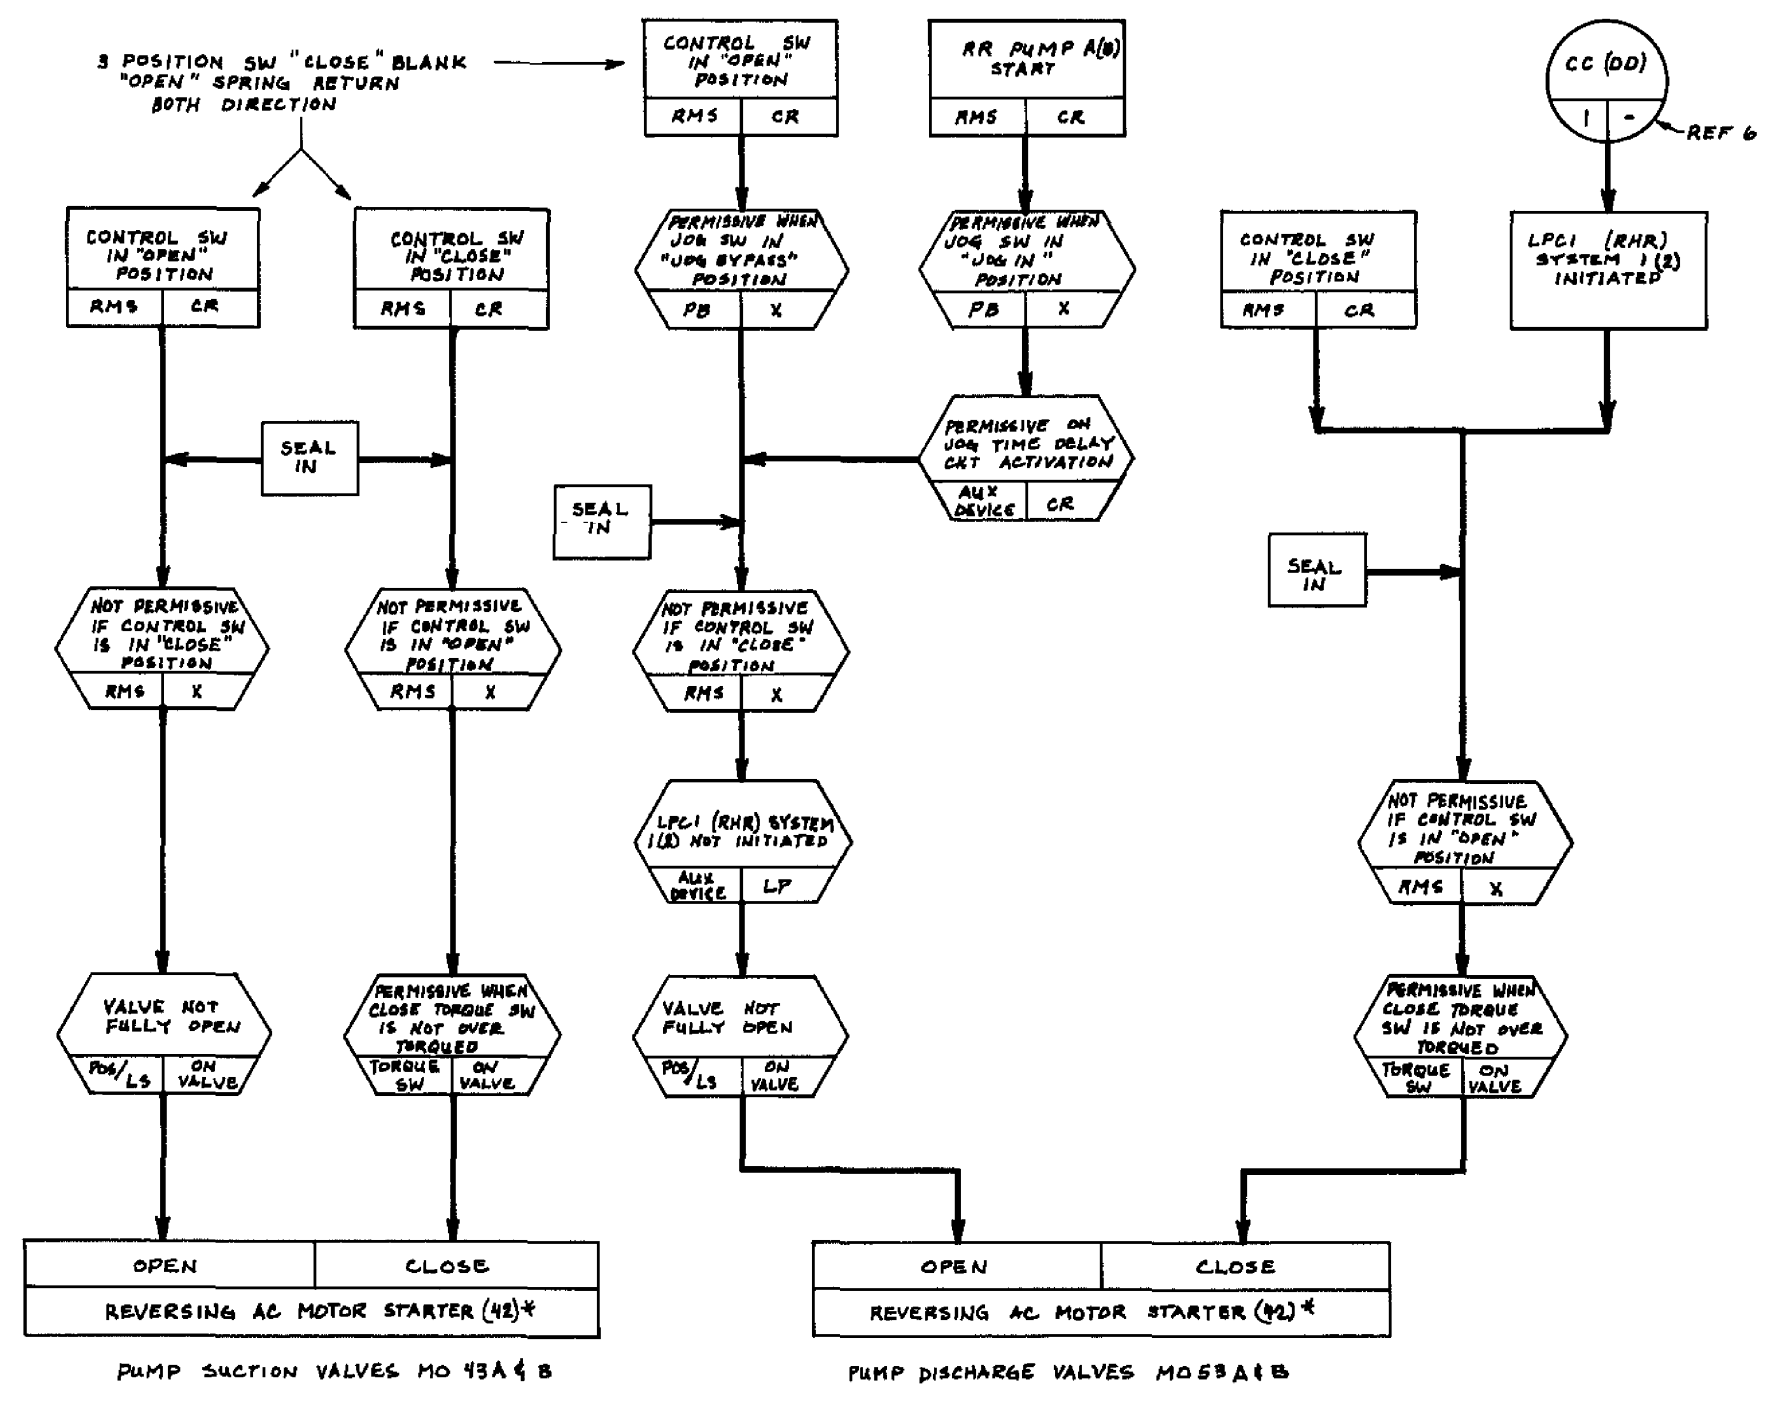

VALVES ARE SHOWN FOR BOTH RECIRCULATION LOOPS  
(FUNCTION IS TYPICAL FOR EACH VALVE AS INDICATED)

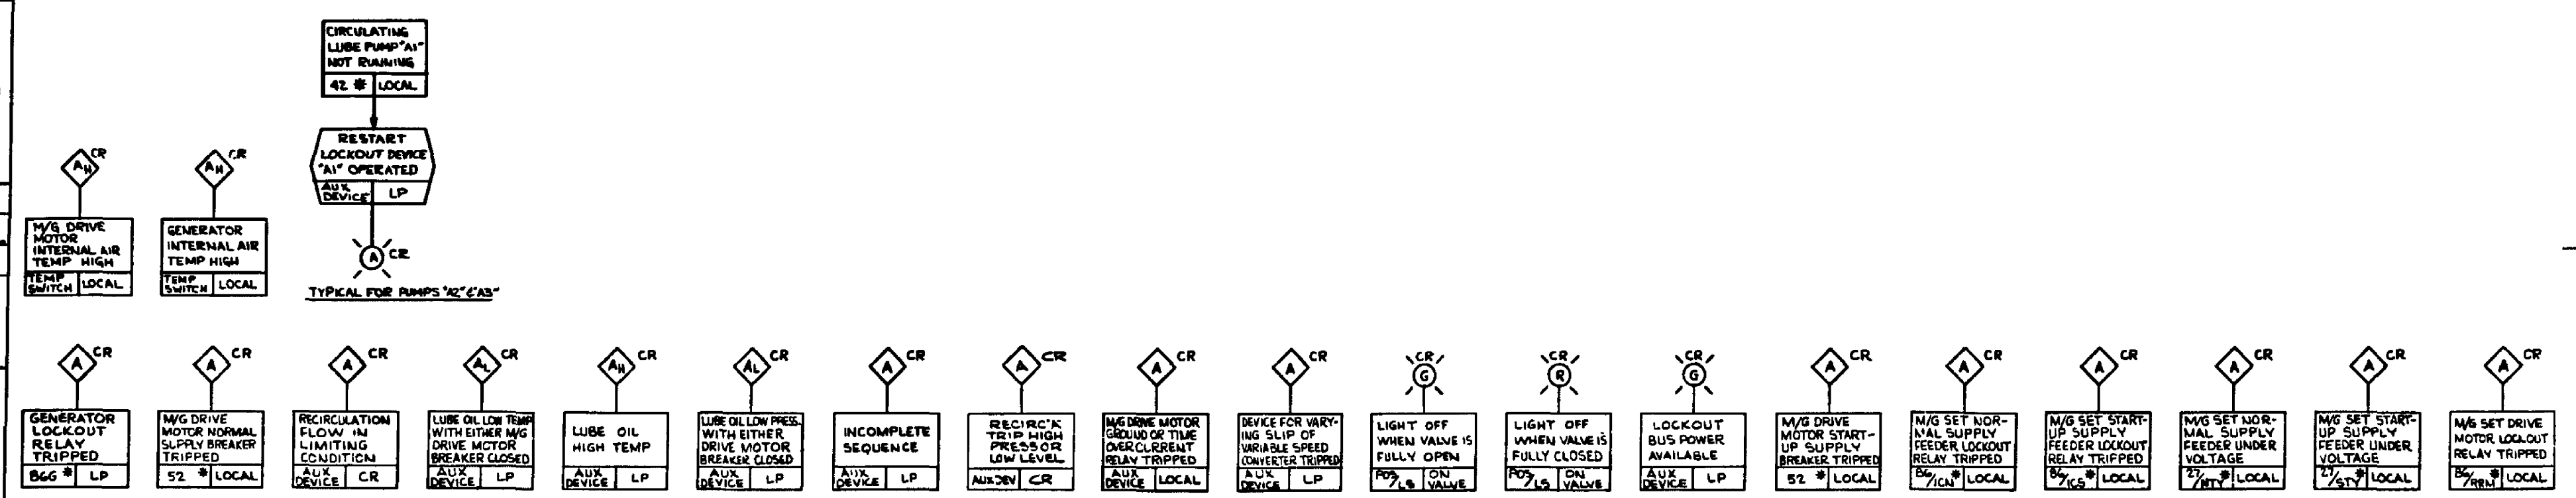

TYPICAL FOR EACH VALVE


452005682

FOR PREVIOUS REVISIONS, SEE SUPERSEDED CARDS.

REVISIONS BY N.P.P.D.

NO.	REVISIONS	DFT	CKD	APP	DATE
N02	CED 2001-0017 (DCN 02-0176)	RAC	RHG	KG	4-27-05

SCAN/CADD DWG  
DO NOT REVISE MANUALLY  
CADD FILE: C0052840  
729E727BB  
CONT. ON SHEET F SHEET 3  
REV N02

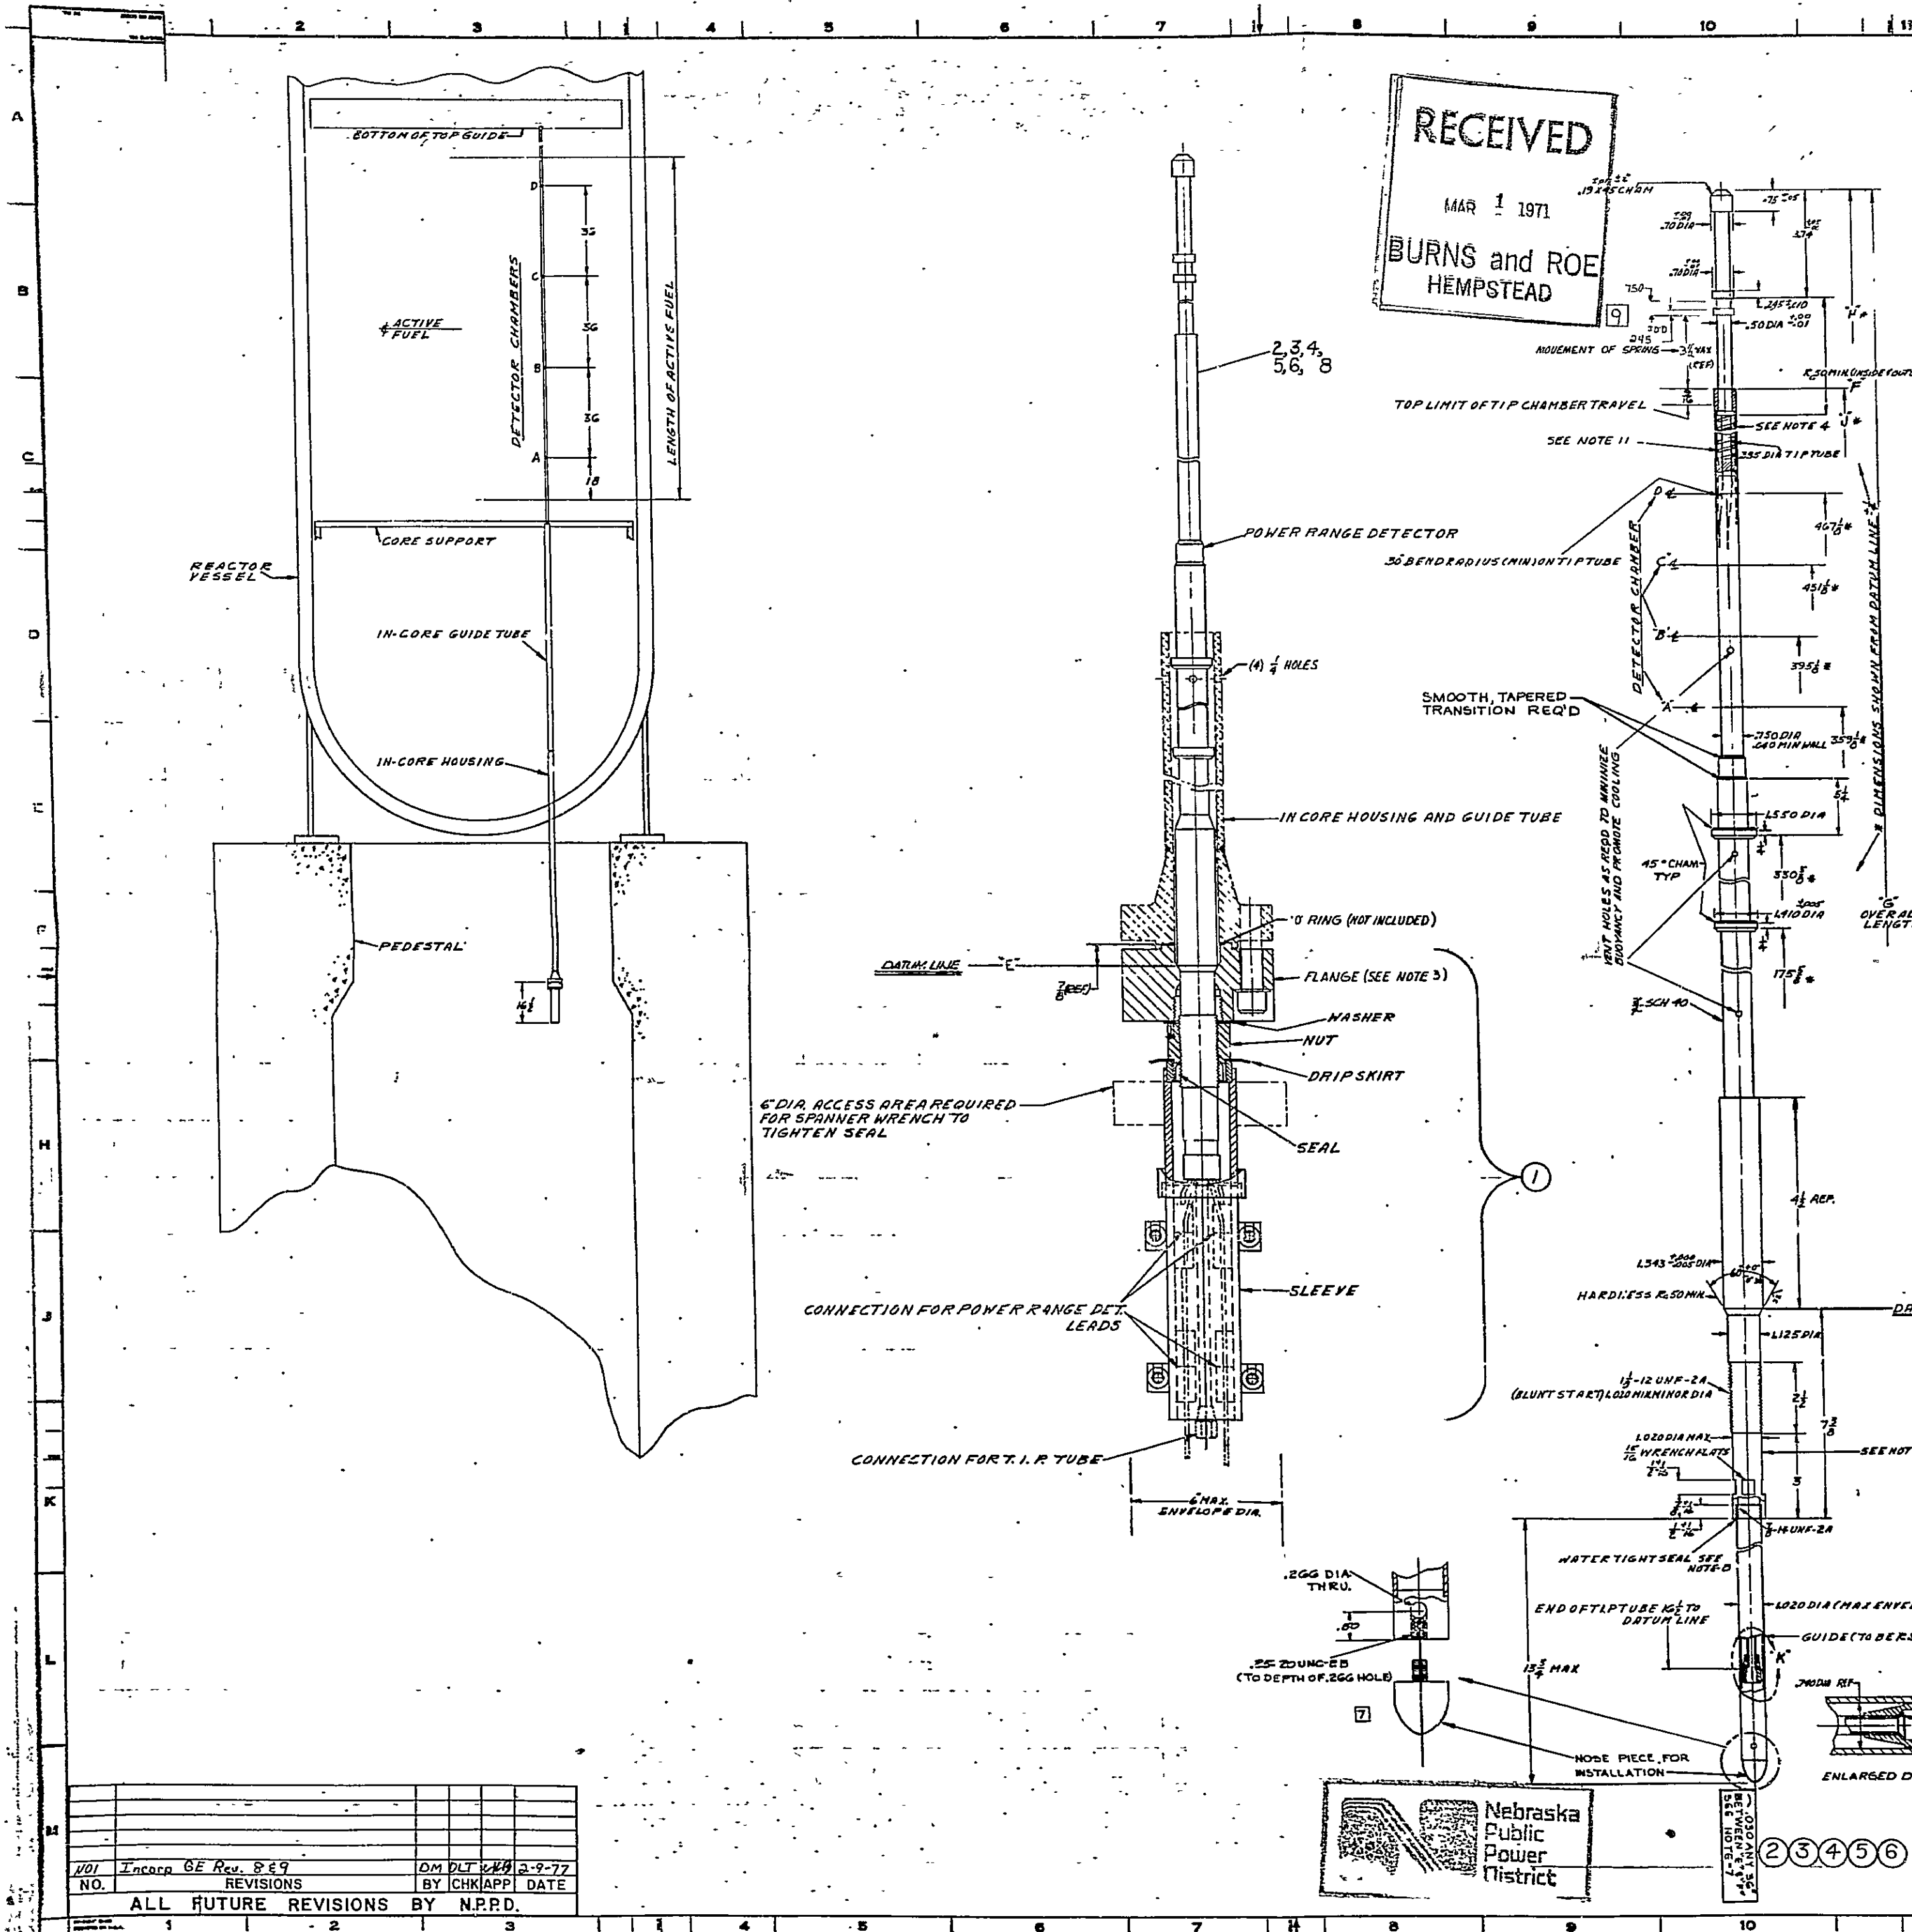

GENERAL ELECTRIC 729E989			
POWER RANGE MONITORING UNIT			
PURCHASED PART			
PT. NO.	NAME	VENDOR	VENDOR IDENT. NO.
1	P.R.M. INSTALL. HARDWARE	1110	237K 65761
2	POWER RANGE DETECTOR	129B3620G3	719
3	POWER RANGE DETECTOR	129B3620G4	719
4	POWER RANGE DETECTOR	129B3620G5	719
5	POWER RANGE DETECTOR	129B3620G6	719
6	POWER RANGE DETECTOR	129B3620G7	719
7	POWER RANGE DETECTOR	129B3620G8	719
8	POWER RANGE DETECTOR	129B3620G9	719
9	POWER RANGE DETECTOR	129B3620G10	719
10	POWER RANGE DETECTOR	129B3620G11	719

POWER RANGE DETECTORS		
PROJECT	PART NO.	SPEC. NO.
DYKESMAN 2-1	729E989P2	21A1491
MILLSTONE	729E989P2	21A1497
AVONPORT	729E989P2	21A1498
TEANUKA	729E989P2	21A1499
QUAD CITIES 1-2	729E989P2	21A1492
MONTHLIELO	729E989P2	21A1493
FUKUSHIMA 1	729E989P2	21A1494
TVA 1-2-3	729E989P2	21A1495
VERMONT YANKEE	729E989P2	21A1496
ARM	729E989P2	21A1497
LEAH BOTTOM 2-3	729E989P2	21A1498
PLAIDM	729E989P2	21A1499
LEAH BOTTOM 2-3	729E989P2	21A1492
WILCO	729E989P2	21A1493
COOPER	729E989P2	21A1494
BELL	729E989P2	21A1495
FUKUSHIMA 2	729E989P2	21A1496
WATSON 1-2	729E989P2	21A1497
SAHOLINA 1-2	729E989P2	21A1498
WATSON 1-2	729E989P2	21A1499
LEAH BOTTOM 2-3	729E989P2	21A1492
CHINSHAN 1-2	729E989P2	21A1493

For Deleted Projects See Dwg 761E983

NOTES:

- MATERIAL (EXCEPT SPRING) SHALL BE TP 304, F304 OR TP 316 STAINLESS STEEL. SPRING SHALL BE INCONEL X-750. MATERIAL FOR PARTS REQUIRING DESIGN PER ASME CODE SECTION III, SHALL BE SPECIFIED PER THE FOLLOWING G.E. SPECIFICATIONS:  
B50YP21A2 PIPE, SEAMLESS TP 316, ASME SA 312  
B50YP22A2 PIPE, SEAMLESS TP 304, ASME SA 312  
B50YP23A2 TUBING, WELDED TP 304, ASME SA 249  
B50YP23B2 TUBING, SEAMLESS TP 304, ASME SA 213  
B50YP24A2 ASME SA 249  
B50YP25B2 ASME SA 213  
B50YP25C2 FORGED AND ROLLED PARTS F304, ASME SA 182  
B50YP25D2 FORGED AND ROLLED PARTS F316, ASME SA 182
- UNIT SHALL BE DESIGNED, FABRICATED, TESTED AND STAMPED AS A PRIMARY VESSEL PER SECTION III, CLASS 1 OF ASME BOILER AND PRESSURE VESSEL CODE (STAMP ON CODE PLATE) AND PER SPECIFICATION AS SHOWN IN TABLE ABOVE.
- FLANGE OF PT-1 SHALL BE DESIGNED TO MATE WITH G.E. DWG. # 117C1684 AND SHALL BE FABRICATED AND EXAMINED IN ACCORDANCE WITH USAS B16.5 AND ASME BOILER AND PRESSURE VESSEL CODE, SEC. III.
- MARK WITH VIBRA-TOOL OR LOW STRESS DIE STAMP ON AREA INDICATED APPLICABLE PT. NO. OR OTHER PRODUCT IDENTIFICATION.
- ALL PARTS SHALL BE VAPOR DEGREASED PRIOR TO ASSEMBLY PER G.E. #P50YP110 OR CLEANED BY OTHER SUITABLE APPROVED METHODS WITH NON-HALOGENATED COMPOUNDS.
- CLEAN WITH ACETONE AFTER ASSEMBLY AND WRAP TIGHTLY IN CLEAN CLEAR POLYETHYLENE TO PREVENT CONTAMINATION DURING STORAGE AND SHIPMENT. CAUTION: DO NOT USE ANY ADHESIVE TAPES ON BASIC METAL.
- MAY BE STRAIGHTENED ON HORIZONTAL FLAT SURFACE TO MEET THIS REQUIREMENT.
- DETACHABLE JOINT TO BE WATER-TIGHT UNDER 110 FT. OF WATER.
- THERE SHALL BE NO LEAKAGE BETWEEN THE POWER RANGE DETECTOR AND THE FLANGE OF PT-1 AFTER ASSEMBLY IN THE REACTOR AT MAX. REACTOR PRESSURE.
- THE ENVIRONMENT BELOW THE FLANGE SHALL BE:  
A. NORMAL OPERATION: 135°F AVERAGE - 508 R.H.  
185°F MAX - 90% R.H. UP TO 30 MINUTES  
B. ABNORMAL OPERATION: 300°F FOR 10 MINUTES 100% R.H.  
320°F FOR 6 HRS. 100% R.H.  
11. SPRING TO BE DESIGNED FOR A MINIMUM 100 SPRING UNLOADINGS FROM 20 TO 10 LBS AT 573°F.  
5 LBS. PRE-LOAD  
5 LBS./IN. GRADIENT  
21 LBS. MAX. LOAD

PT. NO.	G	H	J
2	513 1/8	492 1/8	494 1/8
3	513 1/8	492 1/8	494 1/8
4	512 1/8	491 1/8	493 1/8
5	518 1/8	497 1/8	499 1/8
6	517 1/8	496 1/8	498 1/8
7			
8	514 1/8	493 1/8	495 1/8
9	509 1/8	488 1/8	480 1/8
10	512 1/8	491 1/8	493 1/8

RECEIVED  
FILMED  
N.P.P.D., D.C.C.  
S/N 5599  
COOPER STATION  
MPL. # 2-1-104

REVISIONS

NO.	DATE	DESCRIPTION
1	12/1/77	REVISED TO ACCOMMODATE MINIMUM ENVELOPE ROUNDCORNER AS SHOWN
2	12/1/77	REVISED TO ACCOMMODATE MINIMUM ENVELOPE ROUNDCORNER AS SHOWN
3	12/1/77	REVISED TO ACCOMMODATE MINIMUM ENVELOPE ROUNDCORNER AS SHOWN
4	12/1/77	REVISED TO ACCOMMODATE MINIMUM ENVELOPE ROUNDCORNER AS SHOWN
5	12/1/77	REVISED TO ACCOMMODATE MINIMUM ENVELOPE ROUNDCORNER AS SHOWN
6	12/1/77	REVISED TO ACCOMMODATE MINIMUM ENVELOPE ROUNDCORNER AS SHOWN
7	12/1/77	REVISED TO ACCOMMODATE MINIMUM ENVELOPE ROUNDCORNER AS SHOWN
8	12/1/77	REVISED TO ACCOMMODATE MINIMUM ENVELOPE ROUNDCORNER AS SHOWN
9	12/1/77	REVISED TO ACCOMMODATE MINIMUM ENVELOPE ROUNDCORNER AS SHOWN
10	12/1/77	REVISED TO ACCOMMODATE MINIMUM ENVELOPE ROUNDCORNER AS SHOWN


ALL FUTURE REVISIONS BY N.P.P.D.




# TUBE ROUTING SCHEDULE

05	06	07	08	09	10
13	D1	C8	C6	C5	C1
21	D2	D9	C5	B9	B1
29	D3	D8	C4	B8	B6
37	D4	D7	A9	A8	B4
45	A7	A6	A8	A3	A1
44	36	28	20	12	04


NOTE: THE TUBE ROUTING SCHEDULE INDICATES THE TUBE LINE THAT COMES FROM EACH INDEXING MECHANISM. THE INDEXING MECH ARE DESIGNATED LETTERS (A,B,C,D) AS SHOWN IN THE PLAN VIEW. FOR TUBE ROUTING NUMBERING SEE VIEW G-G, SHEET 2. ROUTE ALL NO 10 TUBES FROM INDEXING MECH. TO THE 4-WAY CONN. AS SHOWN IN THE 4-WAY CONNECTION DIAGRAM ON SHEET 2.

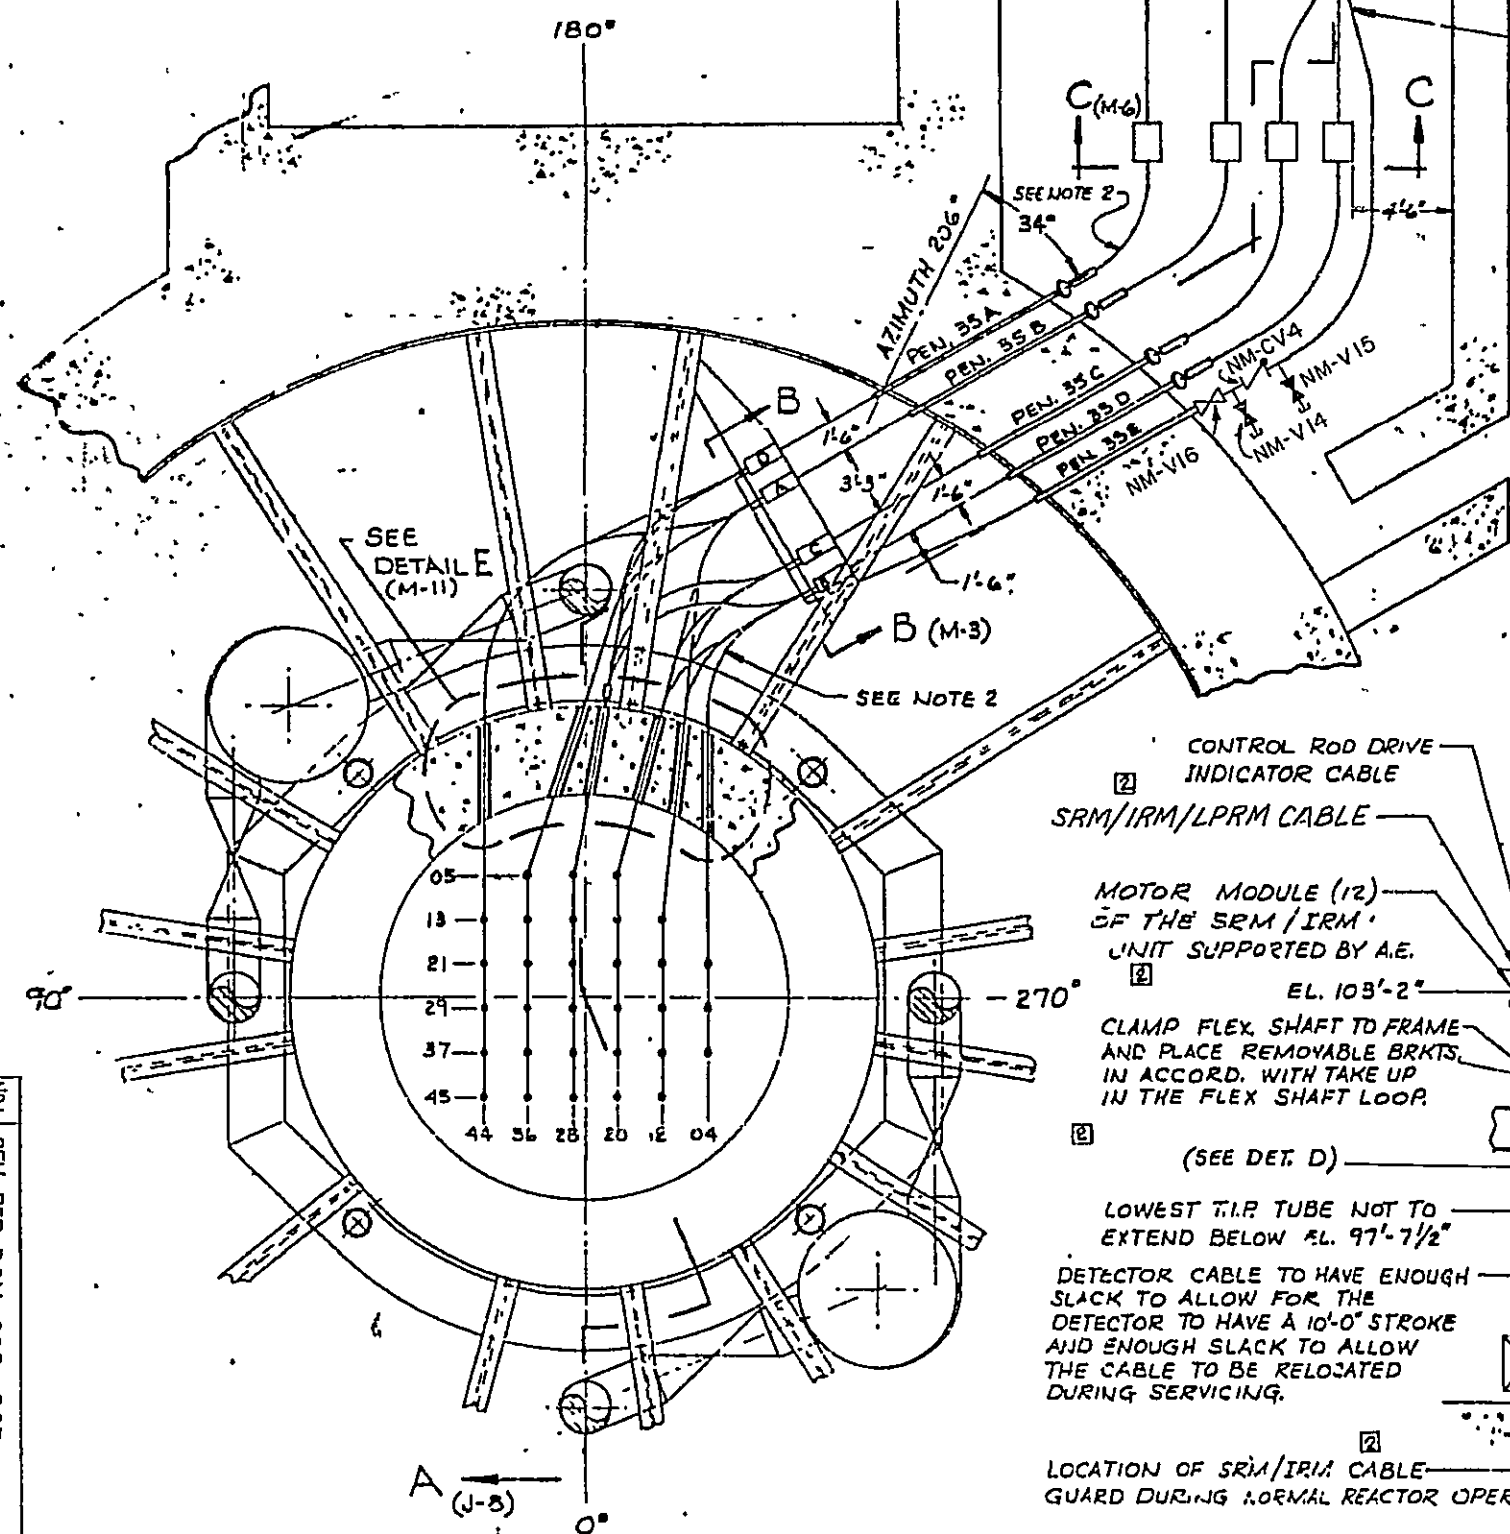


PLAN VIEW AT EL. 101'-6"

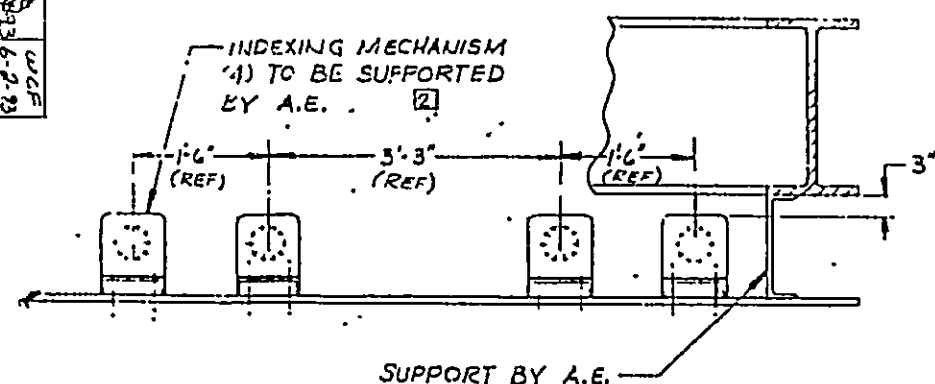


SECTION B-B (E-4)

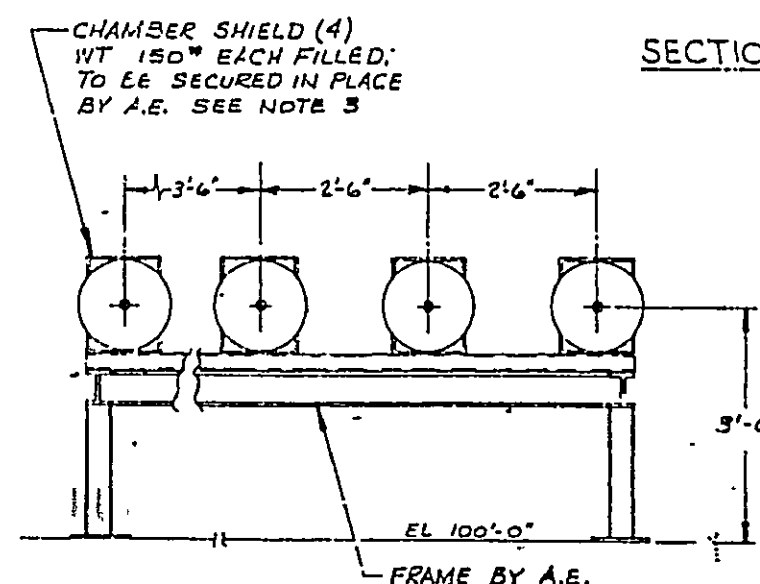

SECTION C-C (C-6)

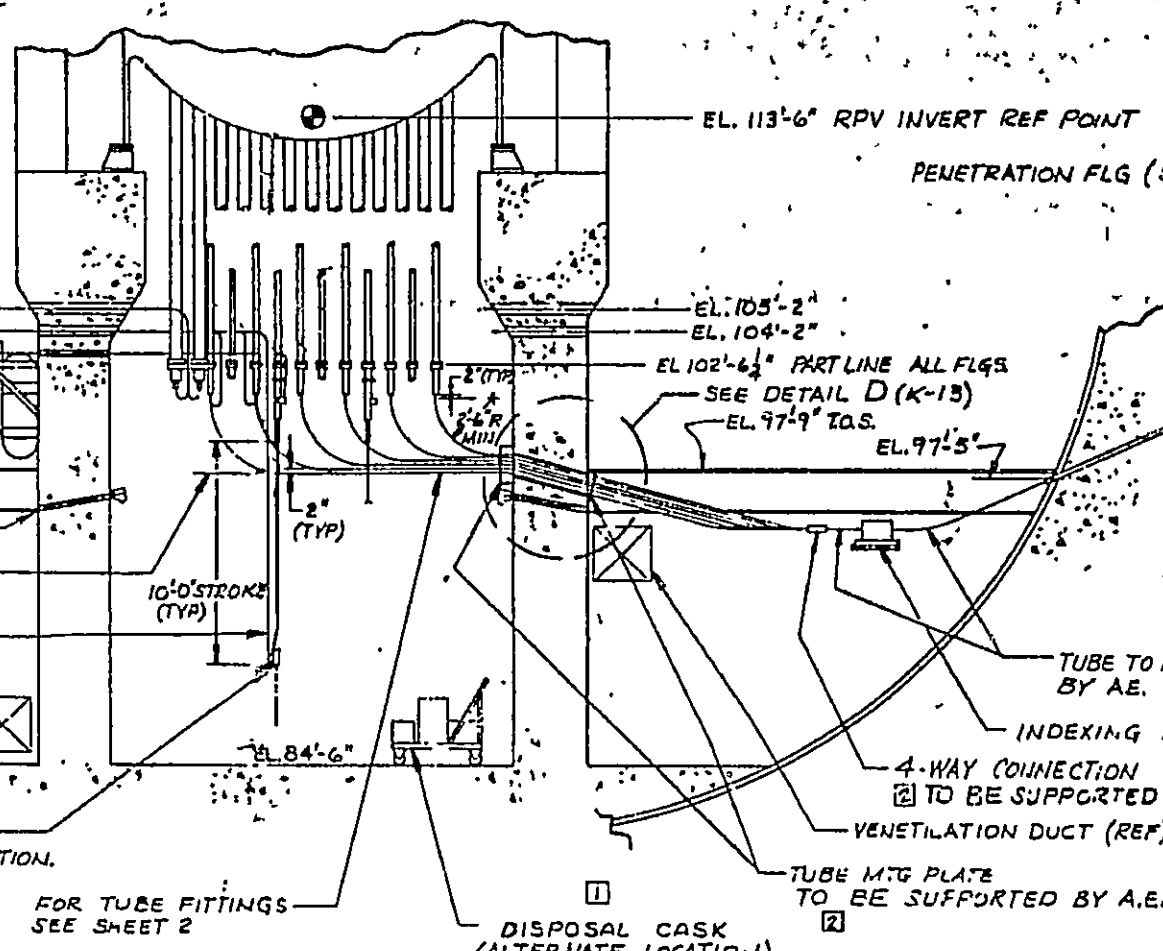


SECTION A-A (J-3)

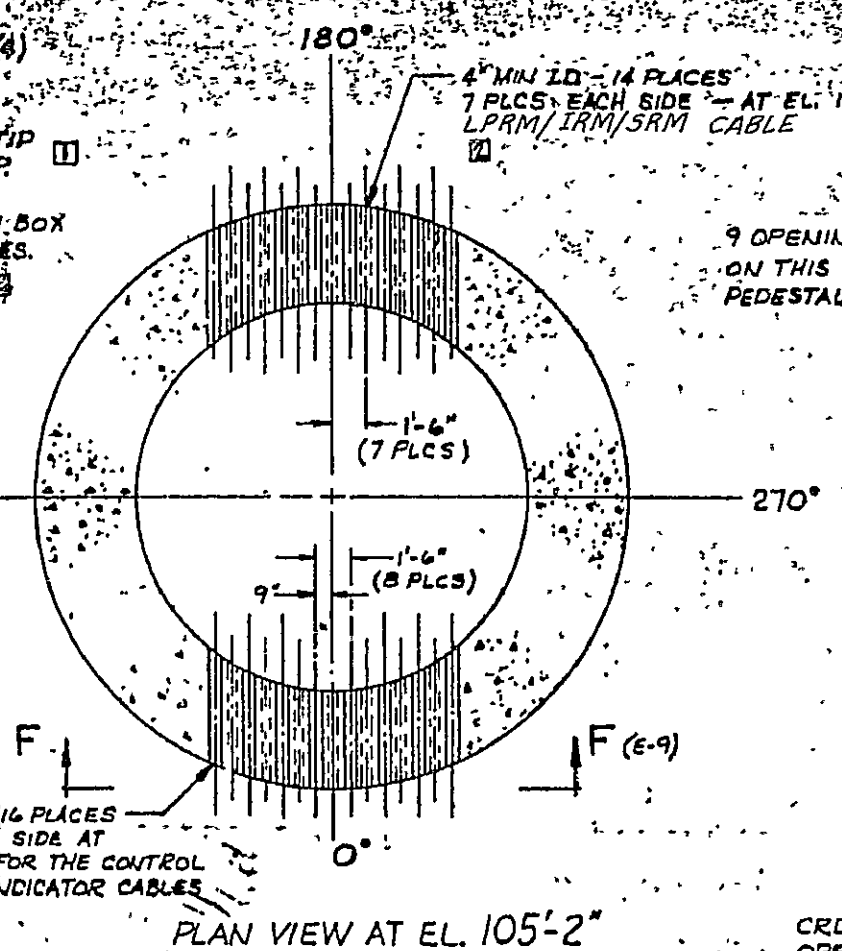


PLAN VIEW AT EL. 105'-2"


SECTION F-F (D-9)

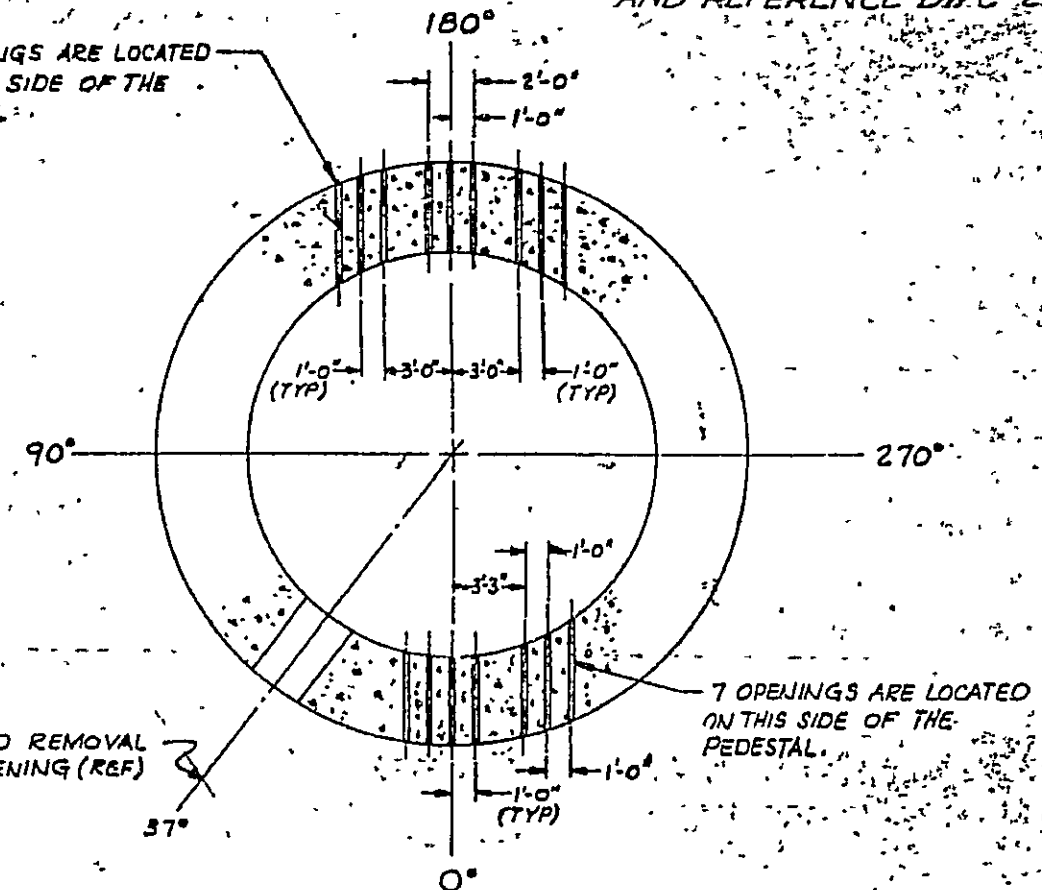

PLAN VIEW AT EL. 96'-6"

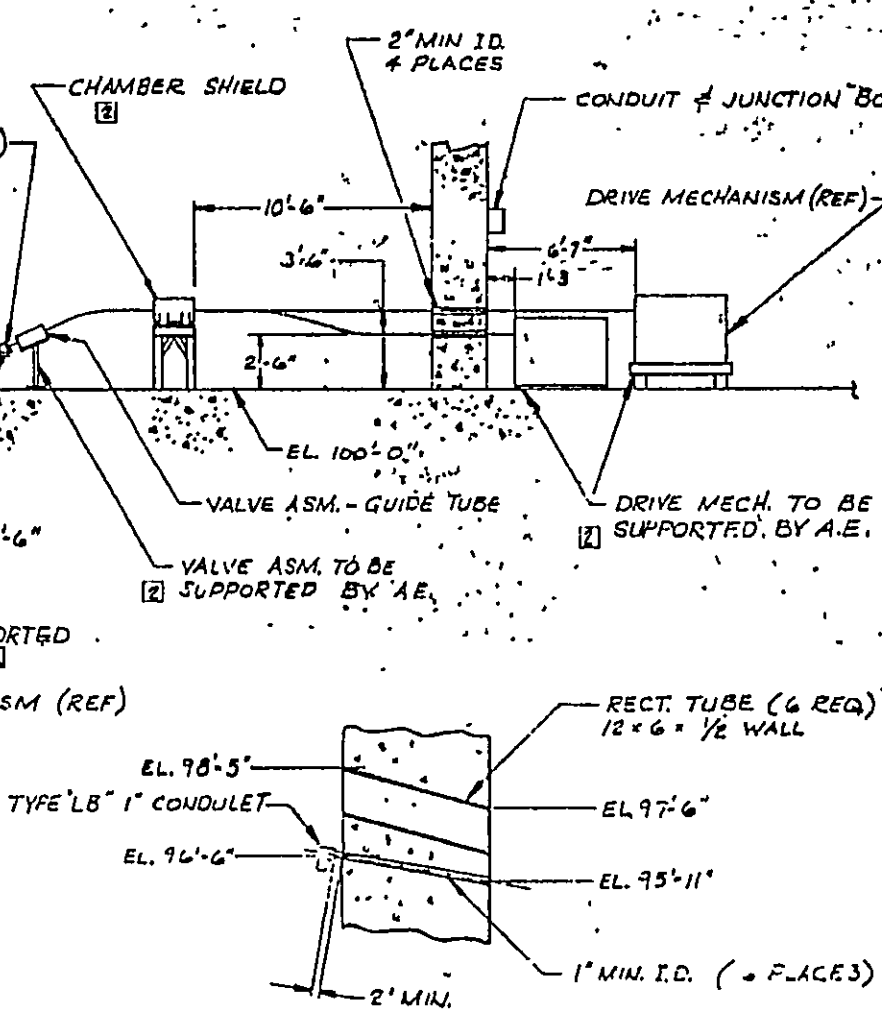

DETAIL D (H-9)

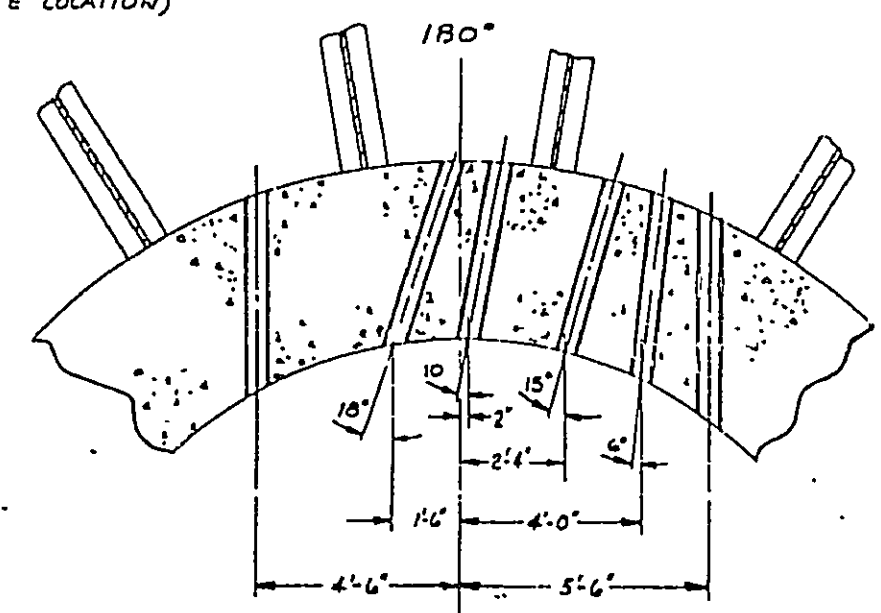

DETAIL E (E-3)

FOR CONSTRUCTION

452005355

NO.	REV.	PER.	DCN	C93-1207
1	1	1	1	1
2	2	2	2	2
3	3	3	3	3
50	50	50	50	50

NO.	REV.	PER.	DCN	C93-1207
1	1	1	1	1
2	2	2	2	2
3	3	3	3	3
50	50	50	50	50


NO.	REV.	PER.	DCN	C94-1122
1	1	1	1	1
2	2	2	2	2
3	3	3	3	3
50	50	50	50	50

FITTING DWG. NO. 129-3151

NUT CAT. NO. 5127XG  
THE WEATHERHEAD CO. \*

SEE DETAIL K (K-9)




TYPE 1

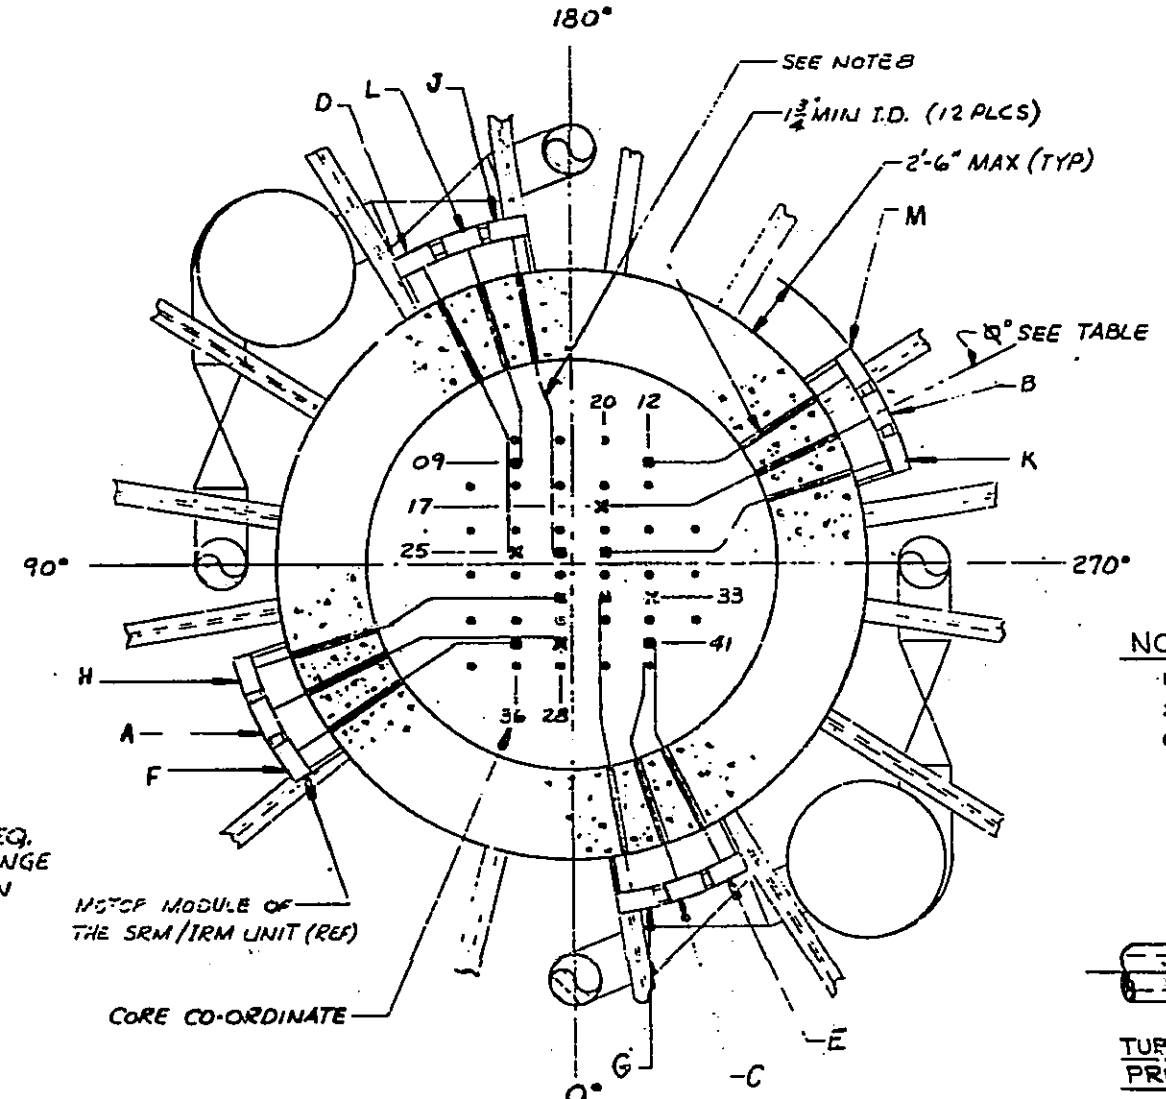

MOTOR MODULE NO	AZIMUTH °	CORE CO-ORDINATE	MIN. LENGTH OF FLEX SHAFT
IRM F	56°	36-41	18'-0"
IRM A	64°	28-41	21'-0"
IRM H	72°	28-33	22'-0"
SRM D	154°	36-25	21'-0"
IRM L	162°	36-09	18'-0"
IRM J	170°	28-25	22'-0"
IRM M	236°	12-09	18'-0"
SRM B	244°	20-17	22'-0"
IRM K	252°	20-25	21'-0"
IRM E	334°	12-41	18'-0"
SRM C	342°	12-33	21'-0"
IRM G	350°	20-33	21'-0"

NOTE:

- INTERMEDIATE RANGE MONITORING SYSTEM (IRM)
- x SOURCE RANGE MONITORING SYSTEM (SRM)
- TRAVERSING IN-CORE PROBE SYSTEM (TIP)

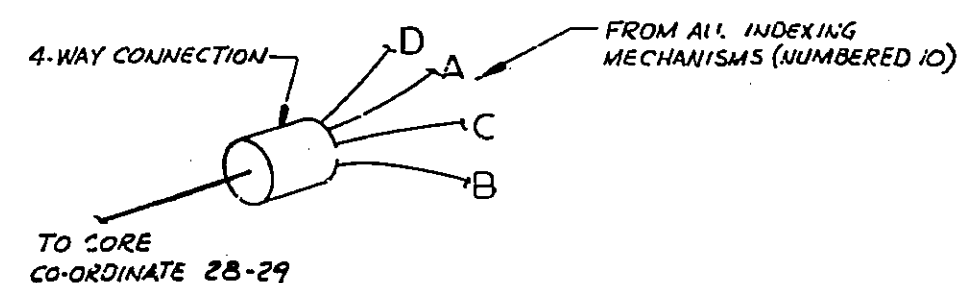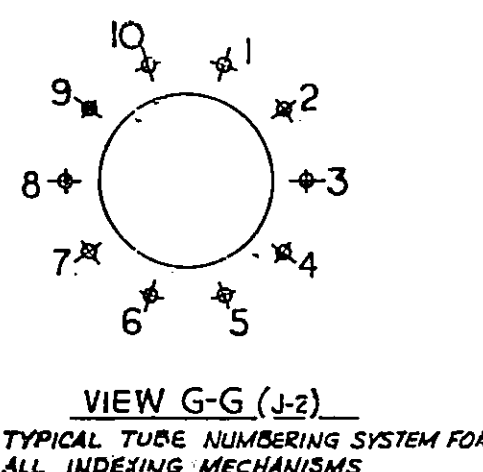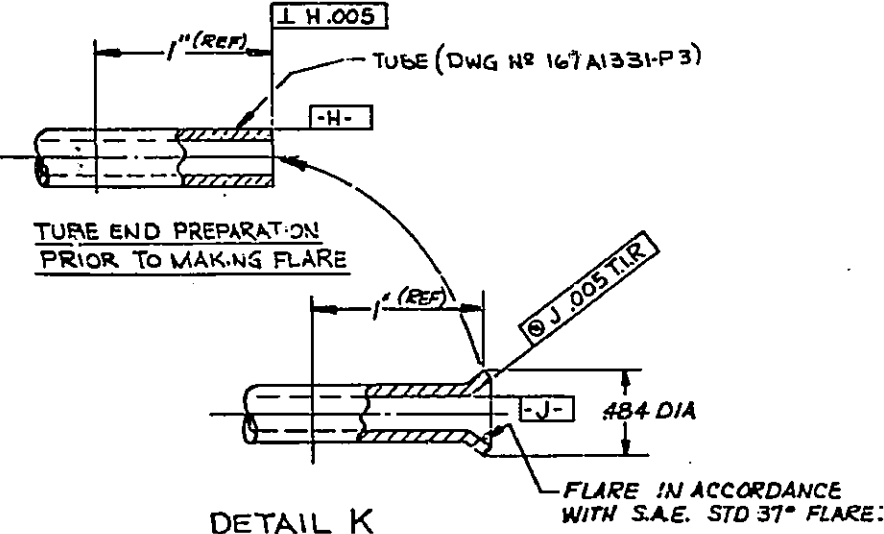

1. THE UNIONS MAY BE LOCATED AS REQUIRED BETWEEN CONCRETE CYLINDER C.O.D. AND SHEATH PENETRATION.
2. THE NUMBER OF T.I.P.'s, GUIDE TUBE BENDS SHALL BE HELD TO A MINIMUM.
  - A. THE TOTAL DEGREES OF BEND SHALL NOT EXCEED 450°. THE MINIMUM BEND RADIUS SHALL BE 2'-6" INSIDE PEDESTAL - 5'-0" RADIUS OUTSIDE PEDESTAL.
  - B. BENDS MUST BE SMOOTH AND MADE BY BENDING OVER FORM OF PROPER RADIUS. THE BENDS MUST BE UNIFORM, NOT A SERIES OF SMALLER BENDS, & FREE FROM INTERNAL DEFORMATIONS.
  - C. TUBE FLANGES TO BE FORMED WITH PROPER FLAMING TOOLS AND CAREFULLY ASSEMBLED INTO FITTINGS FOR GOOD ALIGNMENT.
  - D. CORRECT FIT OF ALL ATTACHMENTS TO BE CHECKED BY INVERTING DUMBY TRANSDUCING DETECTOR AND ASSURING SMOOTH MOVEMENT.
  - E. MAXIMUM "L" LENGTH OF T.I.P. RUN FROM IN-CORE HOLDING FLANGE TO DRIVE MECHANISM TO BE 40'-0". ACTUAL LENGTH TO BE SPECIFIED BY A.E.
  - F. THE T.I.P.'s, GUIDE TUBES SHALL BE HELD AT 1'-0" MAXIMUM INTERVALS BY CHAMFER SUPPORT (FURNISHED BY A.E.).
3. GUIDE SHIELDS TO BE FILLED WITH 1/8" MAXIMUM DIAMETER FREE FLOWING COMPRESSING LEAD SHOT APPROXIMATELY 4500' TOTAL.
4. SIGNAL CABLE CONDUIT AND POWER CABLE CONDUIT SHALL BE SEPARATED BY A MINIMUM OF 12".
5. THE FOLLOWING EQUIPMENT WILL BE SUPPLIED AS PART OF THE NEUTRON MONITORING EQUIPMENT: THE DUMBY TRANSDUCER, SHEATH PENETRATION FLANGE, IN-UTRY CONNECTION, GUIDE SHIELD, VALVE ASSEMBLY (GUIDE TUBE), SENSING UNIT, POWER RANGE NEUTRON MONITOR UNIT, DISPOSAL CASP, T.I.P. GUIDE TUBES, ALL TUBE FITTING CONNECTIONS AS SHOWN AND TIP FLANGE EQUIP.
6. ALL TURNING AND FITTINGS ARE TO BE SHIPPED TO FIELD FOR CUTTING, FLAMING, BENDING, AND INSTALLATION.
7. ALL TUBE BENDS, FROM PENETRATION FLANGE TO VALVE ASSEMBLY, TO BE TESTED AND BE EQUITABLE TIGHT AT 80 PSI INTERNAL AIR PRESSURE.
8. SUPPORT FLEXIBLE SHAFT AT 4'-0" MAX. INTERVALS TO PREVENT CASKING ROTATION. CASK MUST BE TAPPED TO PREVENT JAMMING THE INDECKMAN.
9. THE MIN. BEND RADIUS SHALL BE 9'-0".
10. OR ENGINEERING APPROVED EQUIVALENT.
11. ALL GAS AND AIR LINES SUPPLIED BY A.E. FOR 100 PSI SERVICE; REFERENCE ALSO DCG-2124

Information Only


Correct status  
on microfilm

REFERENCE DRAWINGS	NPS ITEM NO.
1. DRIVE MECHANISM	7-101
2. CHAMBER SHIELD	7-106
3. TIP PURGE EQUIP.	7-113
4. FOKLIZATION FLANGE	7-103
5. INDEXING MECHANISM	7-107
6. 4-WAY CONNECTION	7-108
7. VALVE ASM (SIDE TUBE)	7-104
8. SW/IRON UNIT	2-1-102
9. REACTOR ASM (CORE CONFIGURATION)	2-1
10. TIP	7-121
11. DUMMY T/P	7-122
12. GUIDE TUBES	7-112
13. POWER RANGE NEUTRON MONITOR INST.	7-81
14. DISPOSAL CASK	7-110


452007202


**RECEIVED**  
APR 18 1975  
**BURNS and ROE**  
**HEMPSTEAD**


[illegible]

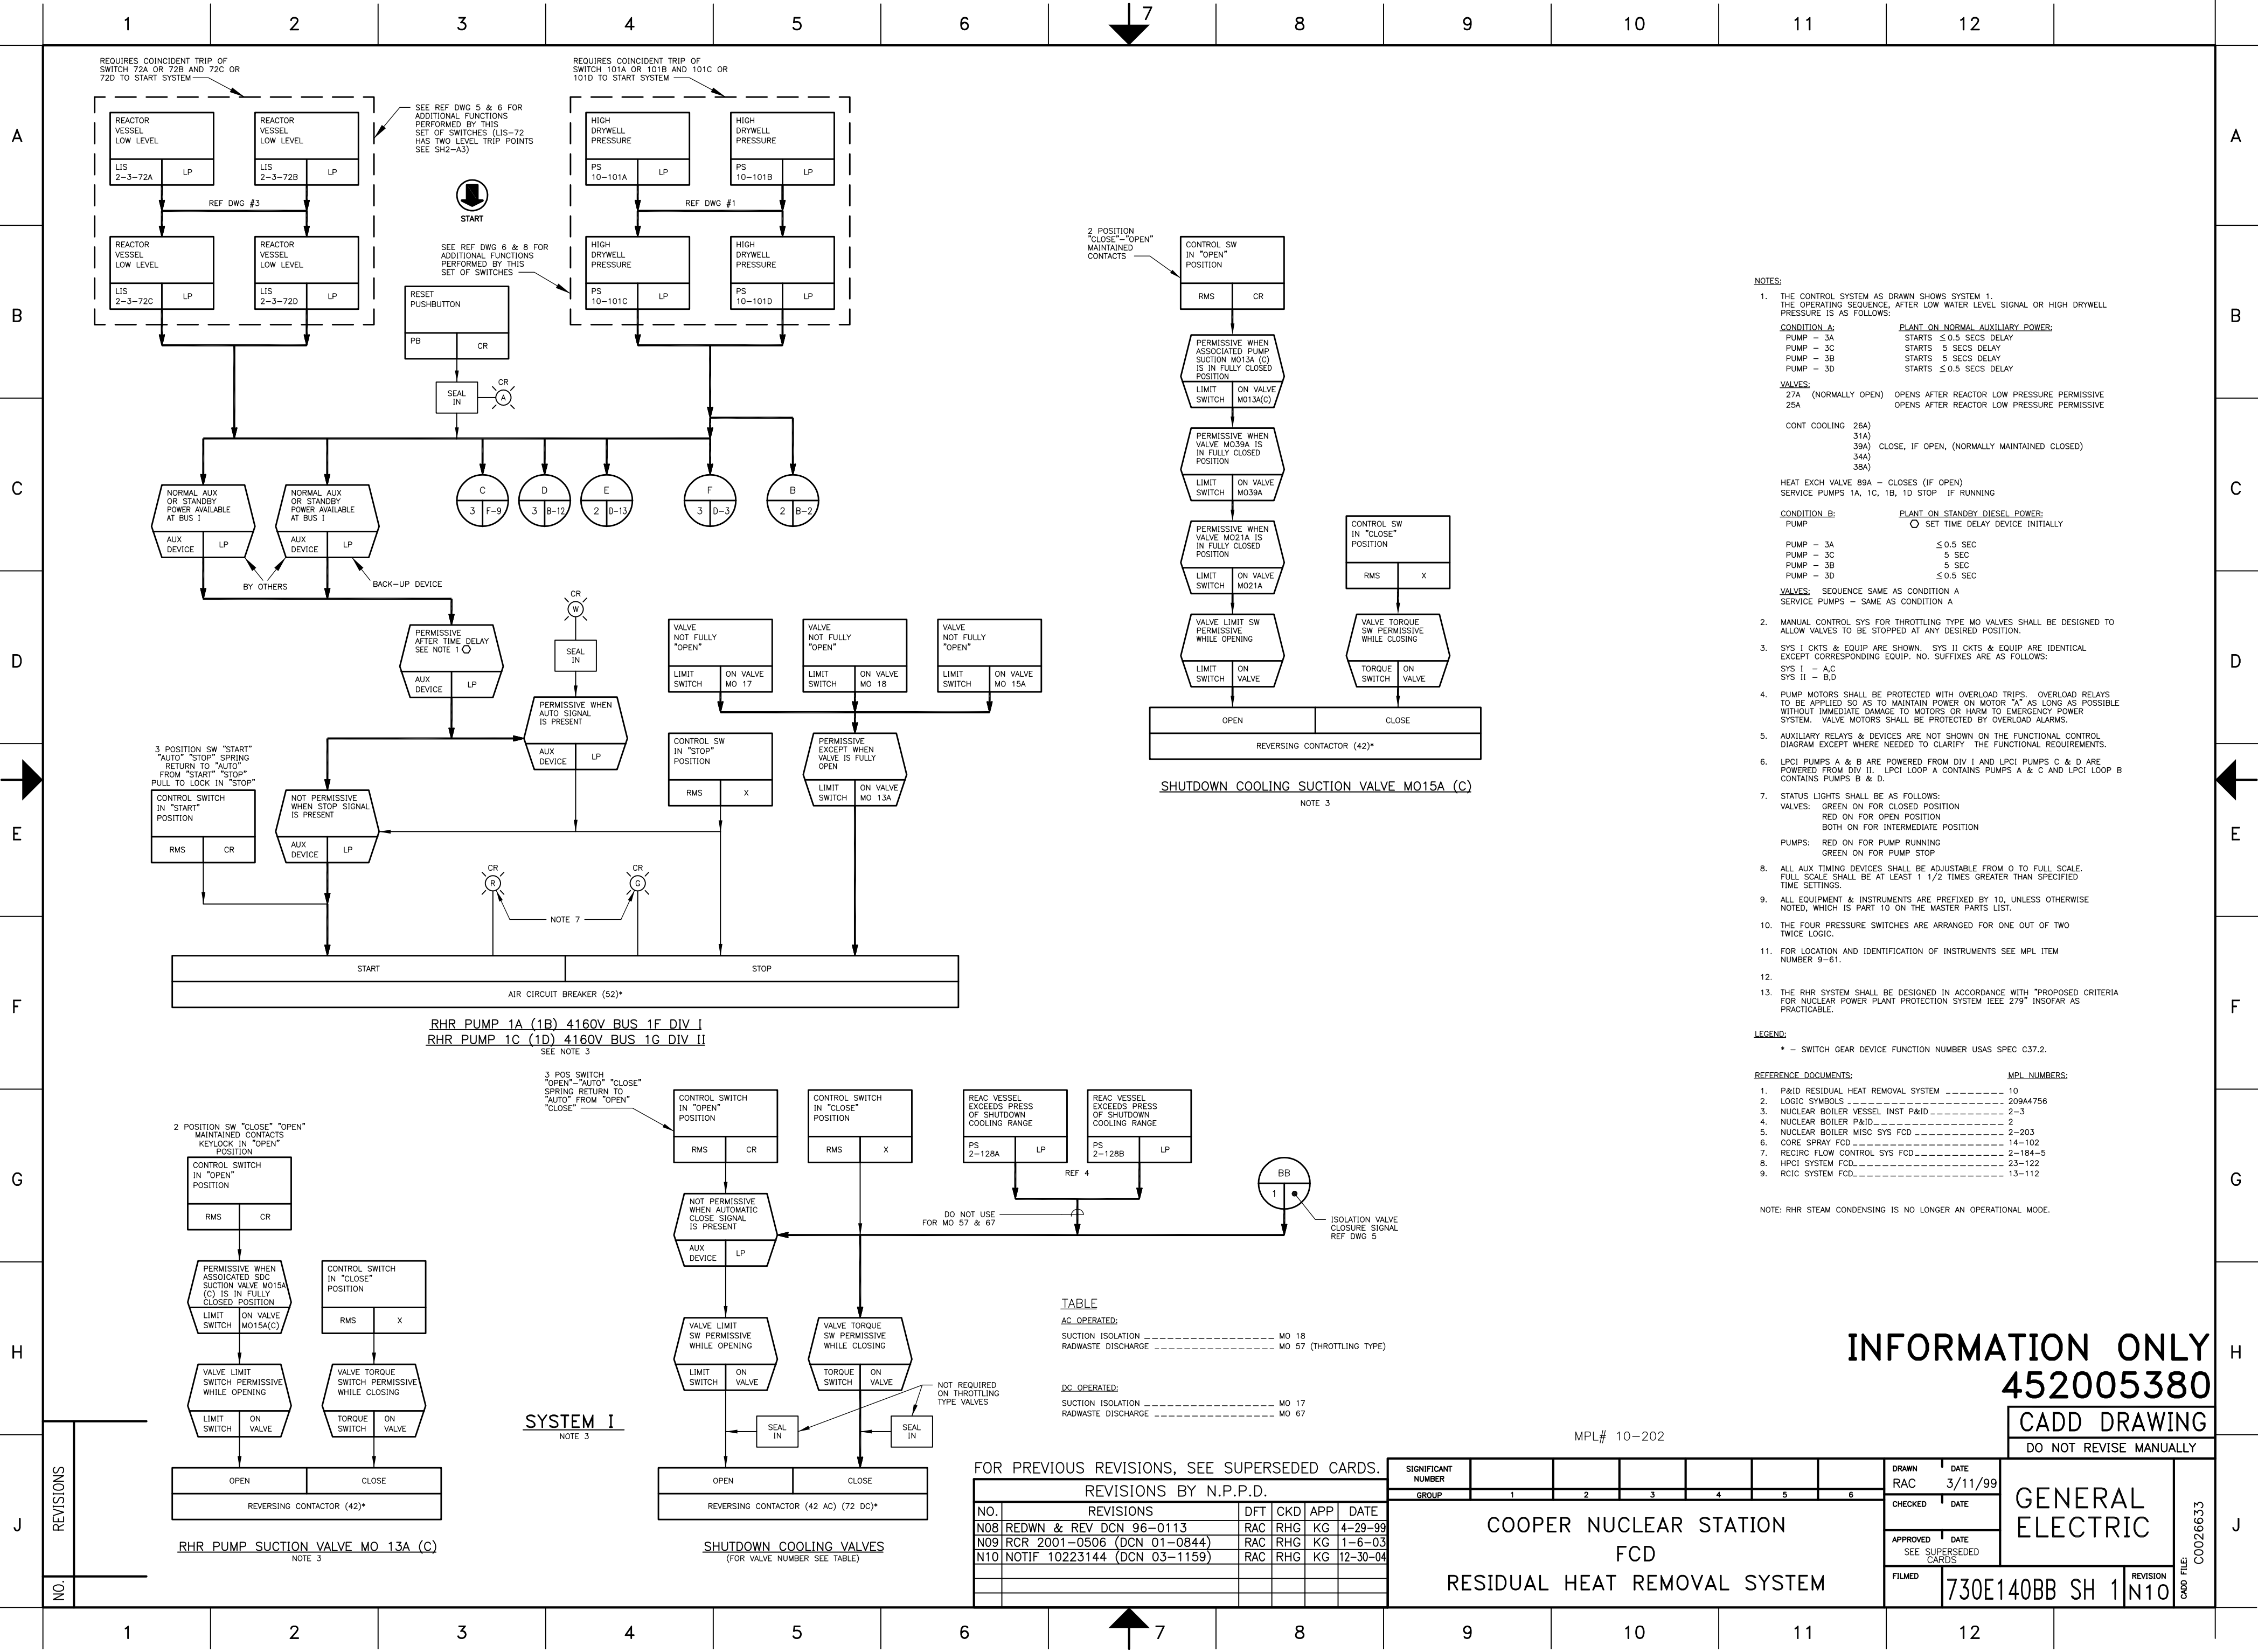



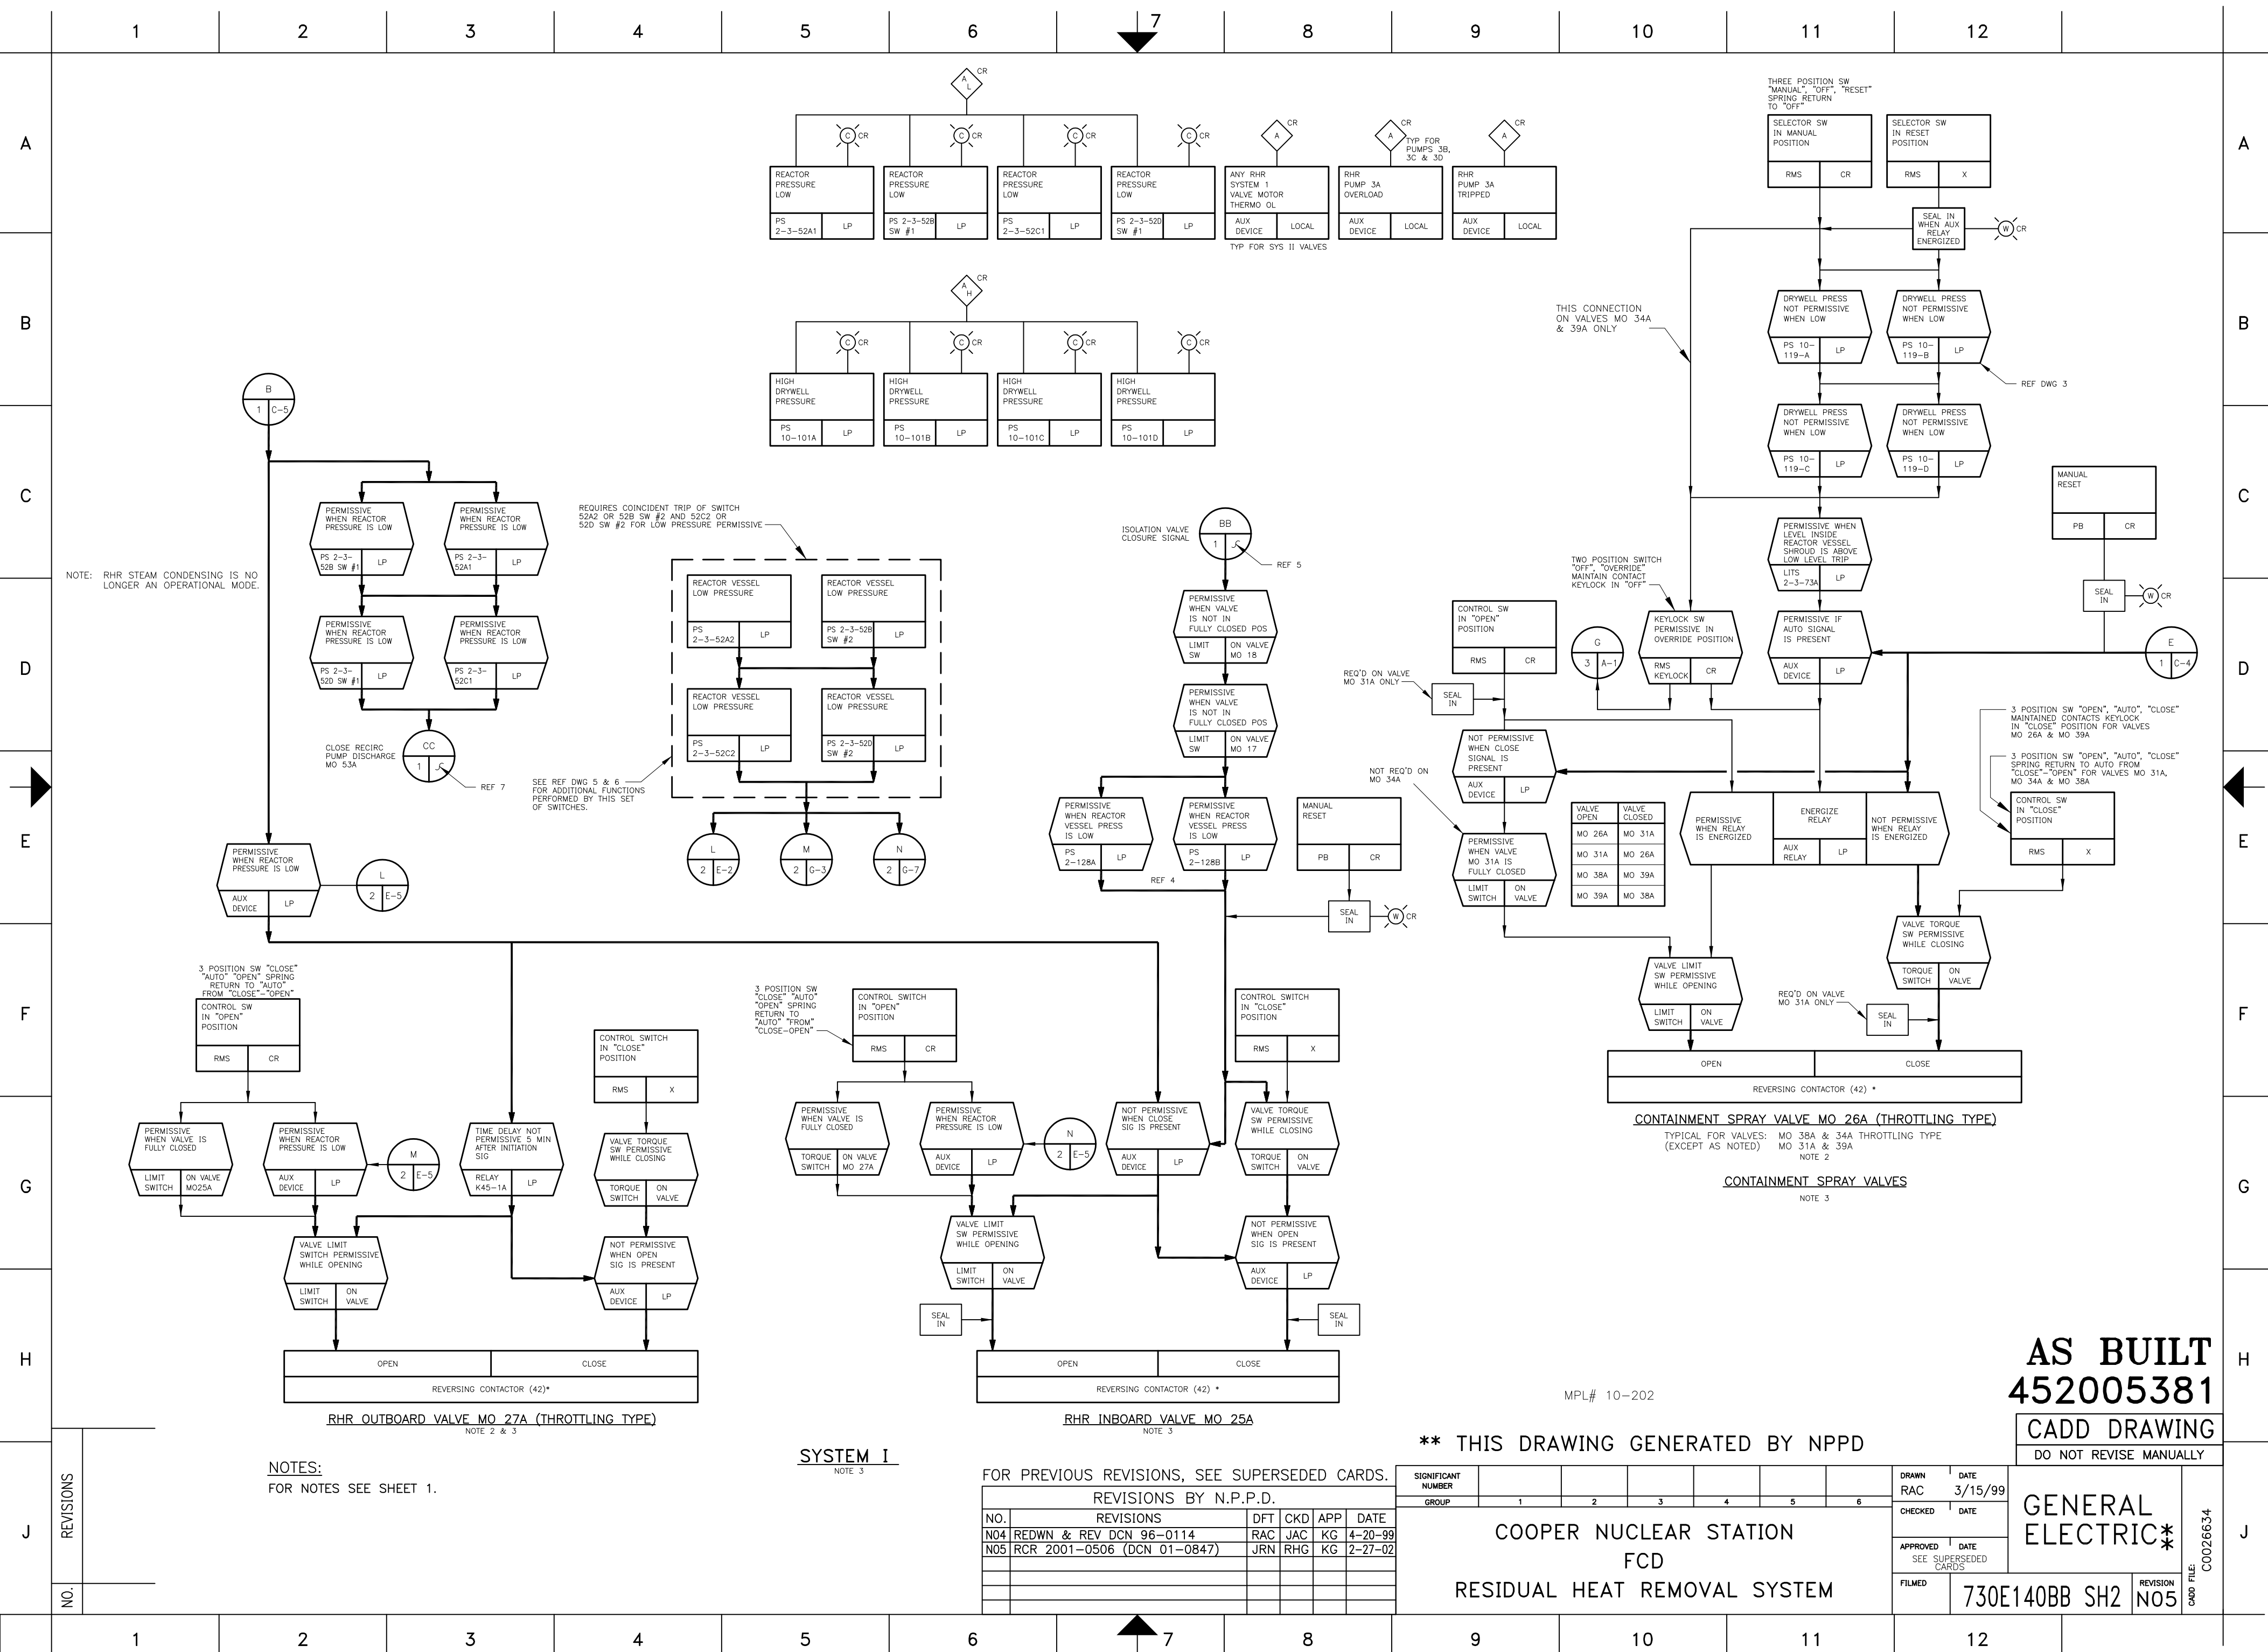

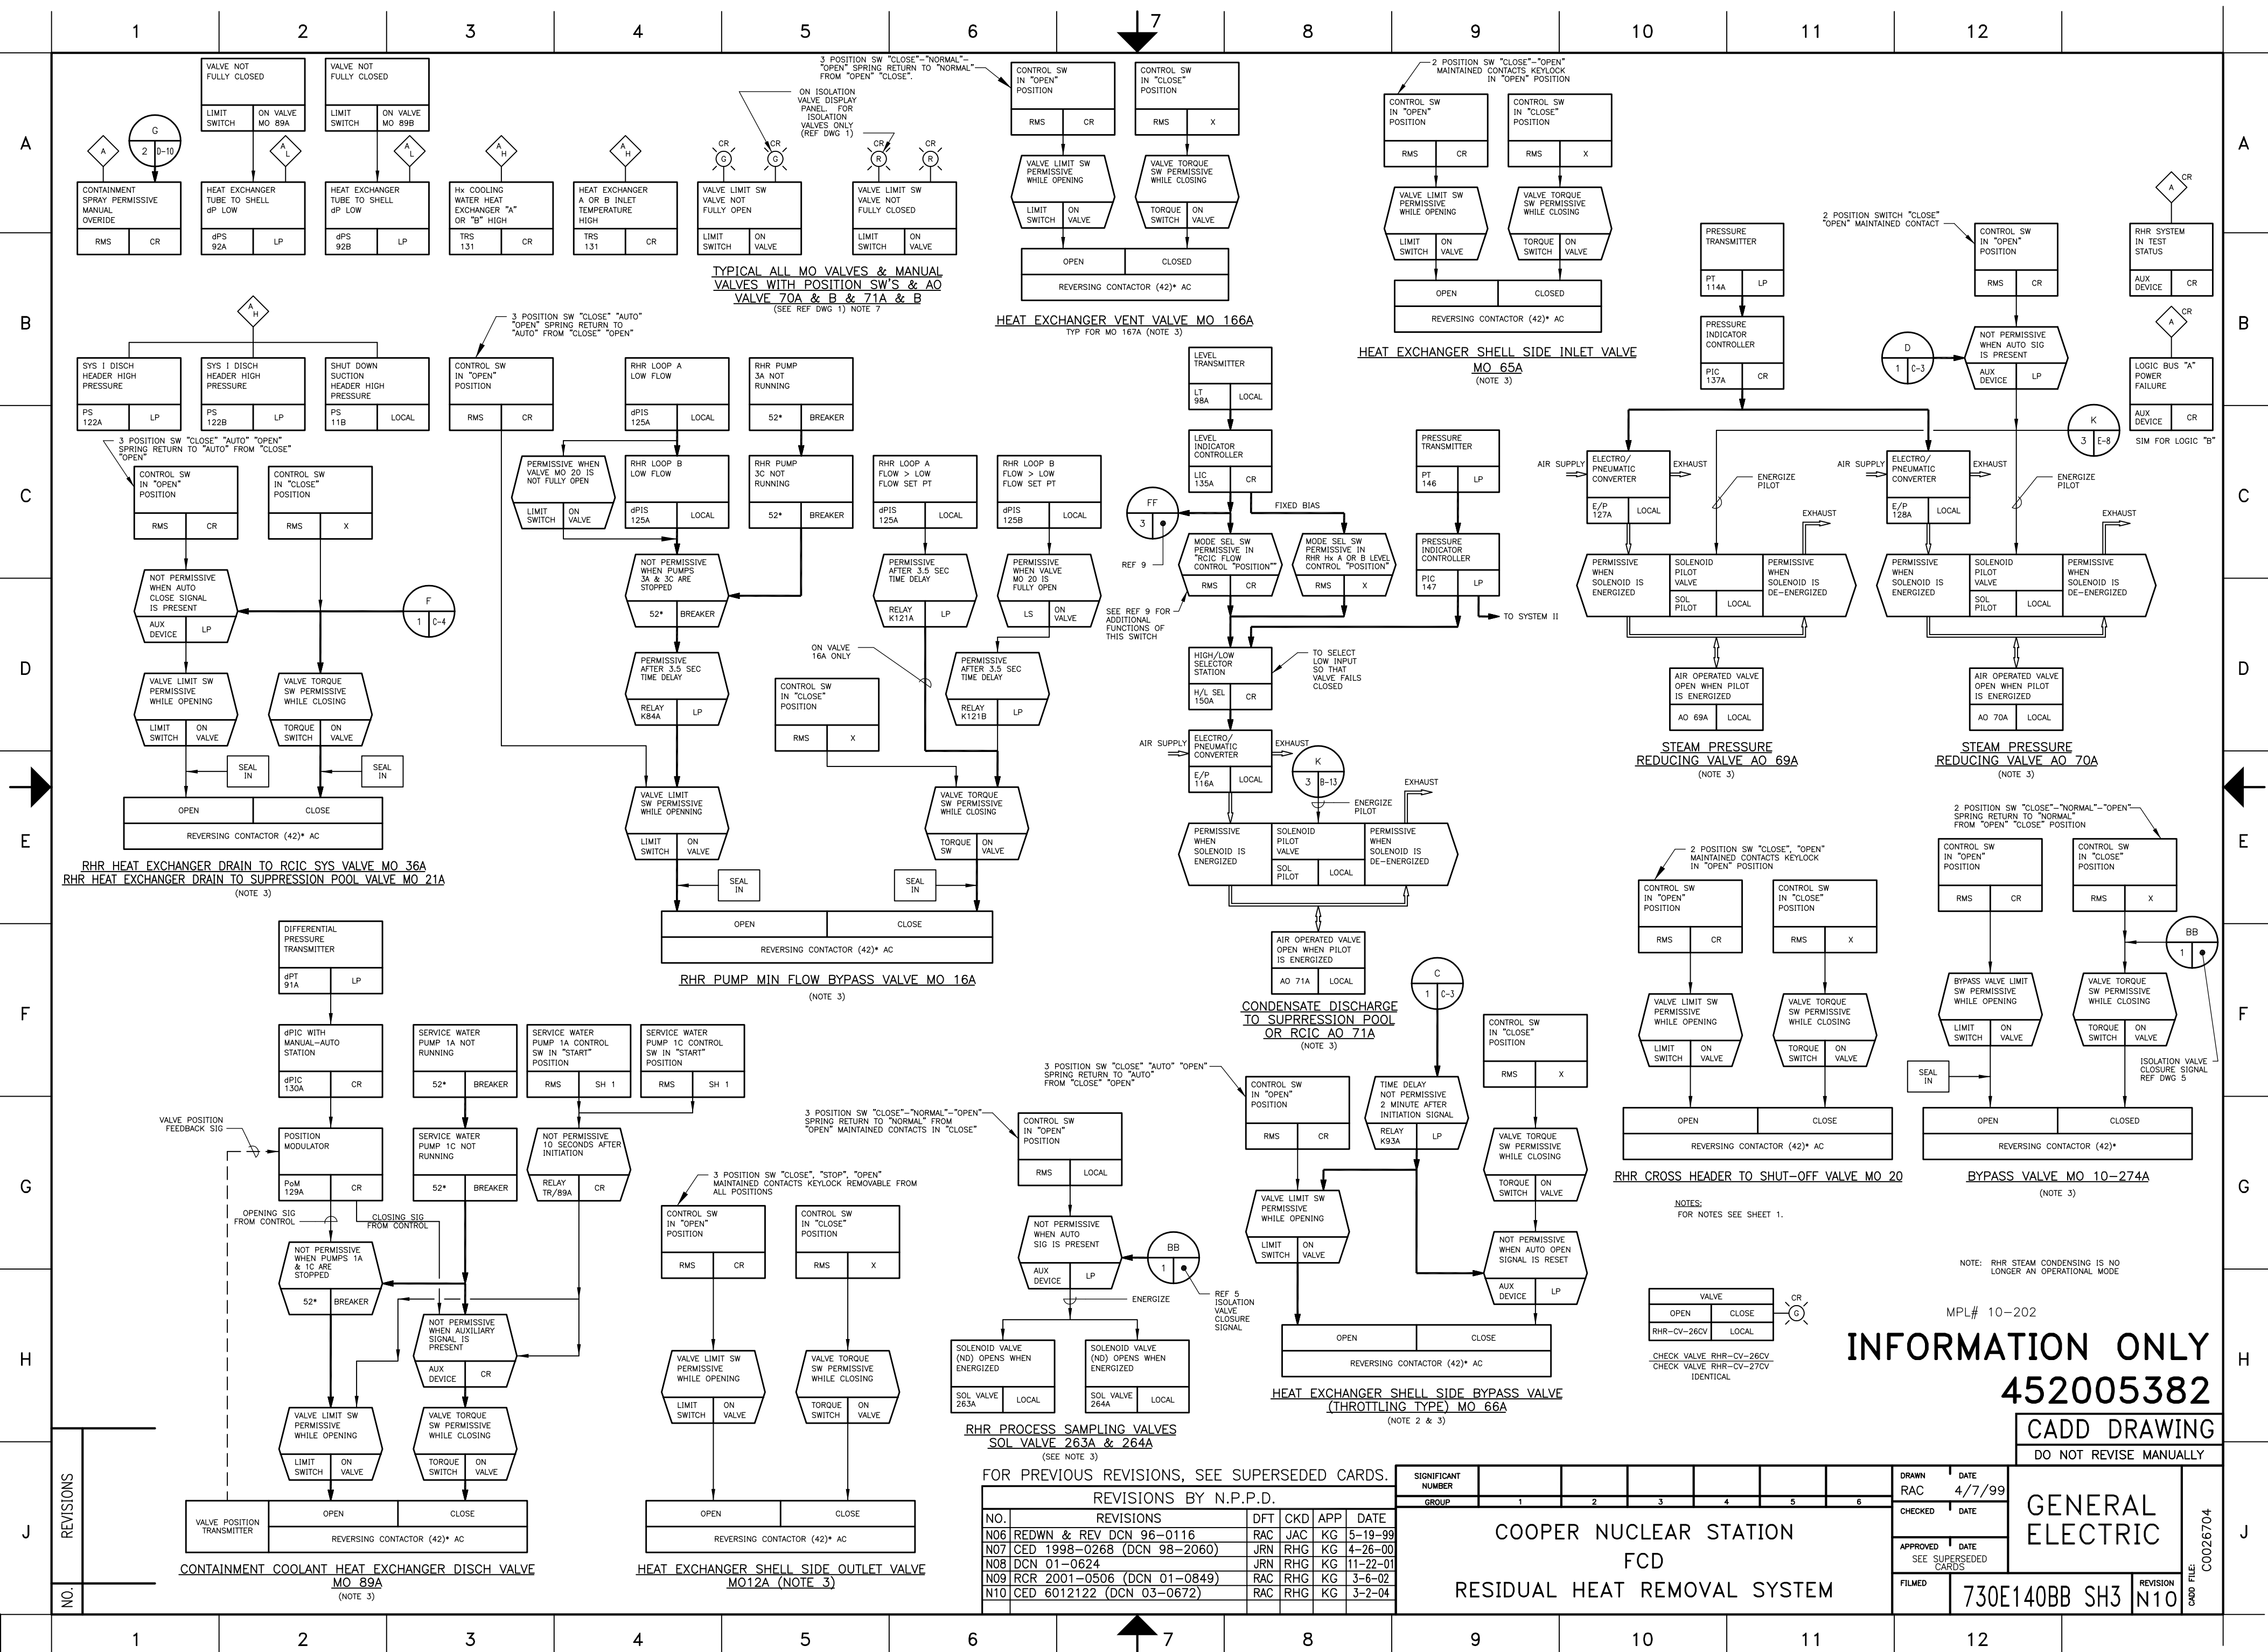

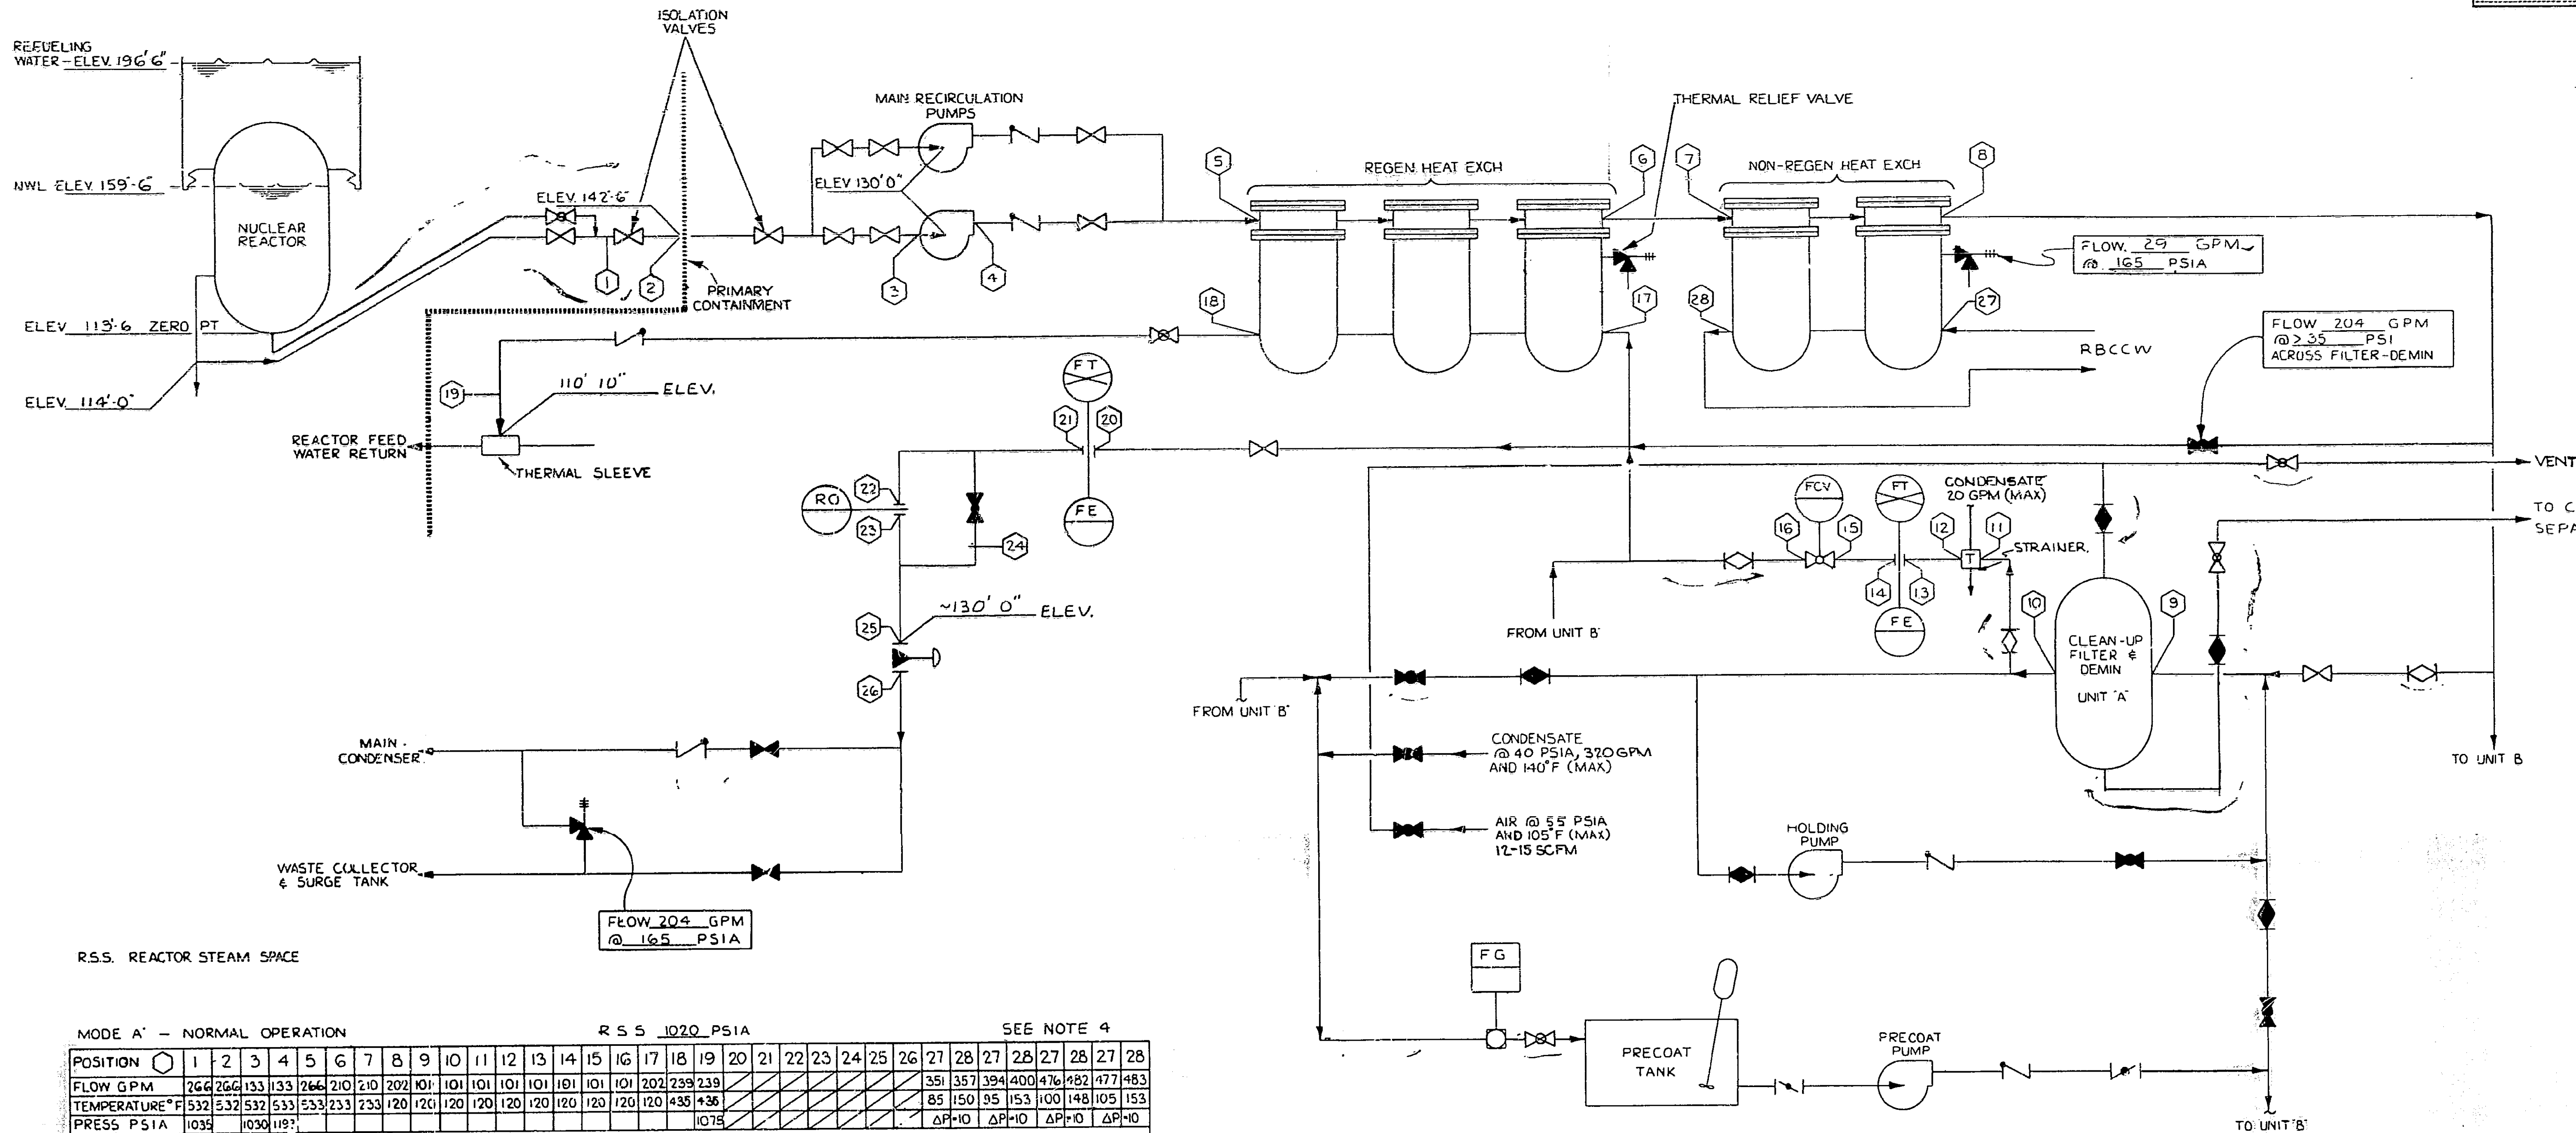

MODE A' - NORMAL OPERATION															R S S 1020 PSIA															SEE NOTE 4																																																																																																																																																																																																																																																																																																																																																																																																																																																																																																																																																																																																																																																																																																																																																																																																																																																																																																																																																																																																																																																																																																																																																																																																																																																																																																																																																																																																																																																																																																																	
POSITION	1	2	3	1486	1



FCP: 236X100 BD (2-205)



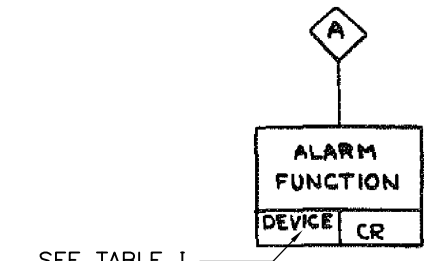


TABLE I

ALARM FUNCTION	INITIATING DEVICE(S)
BLOWDOWN SYSTEM TIMER INITIATED	TIMING DEVICE (A <sub>1</sub> ) AND (B <sub>1</sub> ) TO ONE COMMON ANNUNCIATOR
RELIEF VALVE POSITION	PSH ON TAILPIPE (B TOTAL) TO ONE COMMON ANN.
BLOWDOWN CIRCUIT POWER FAILURE	AUX. POWER FAILURE RELAY FOR EACH LOGIC CHANNEL TO ONE COMMON ANNUNCIATOR
BLOWDOWN SYS AUX. RELAY ENERGIZED	AUX. RELAY (C) / TO ONE COMMON ANNUNCIATOR

BLOWDOWN SYSTEM SPECIAL ALARMS (NOTE 8)

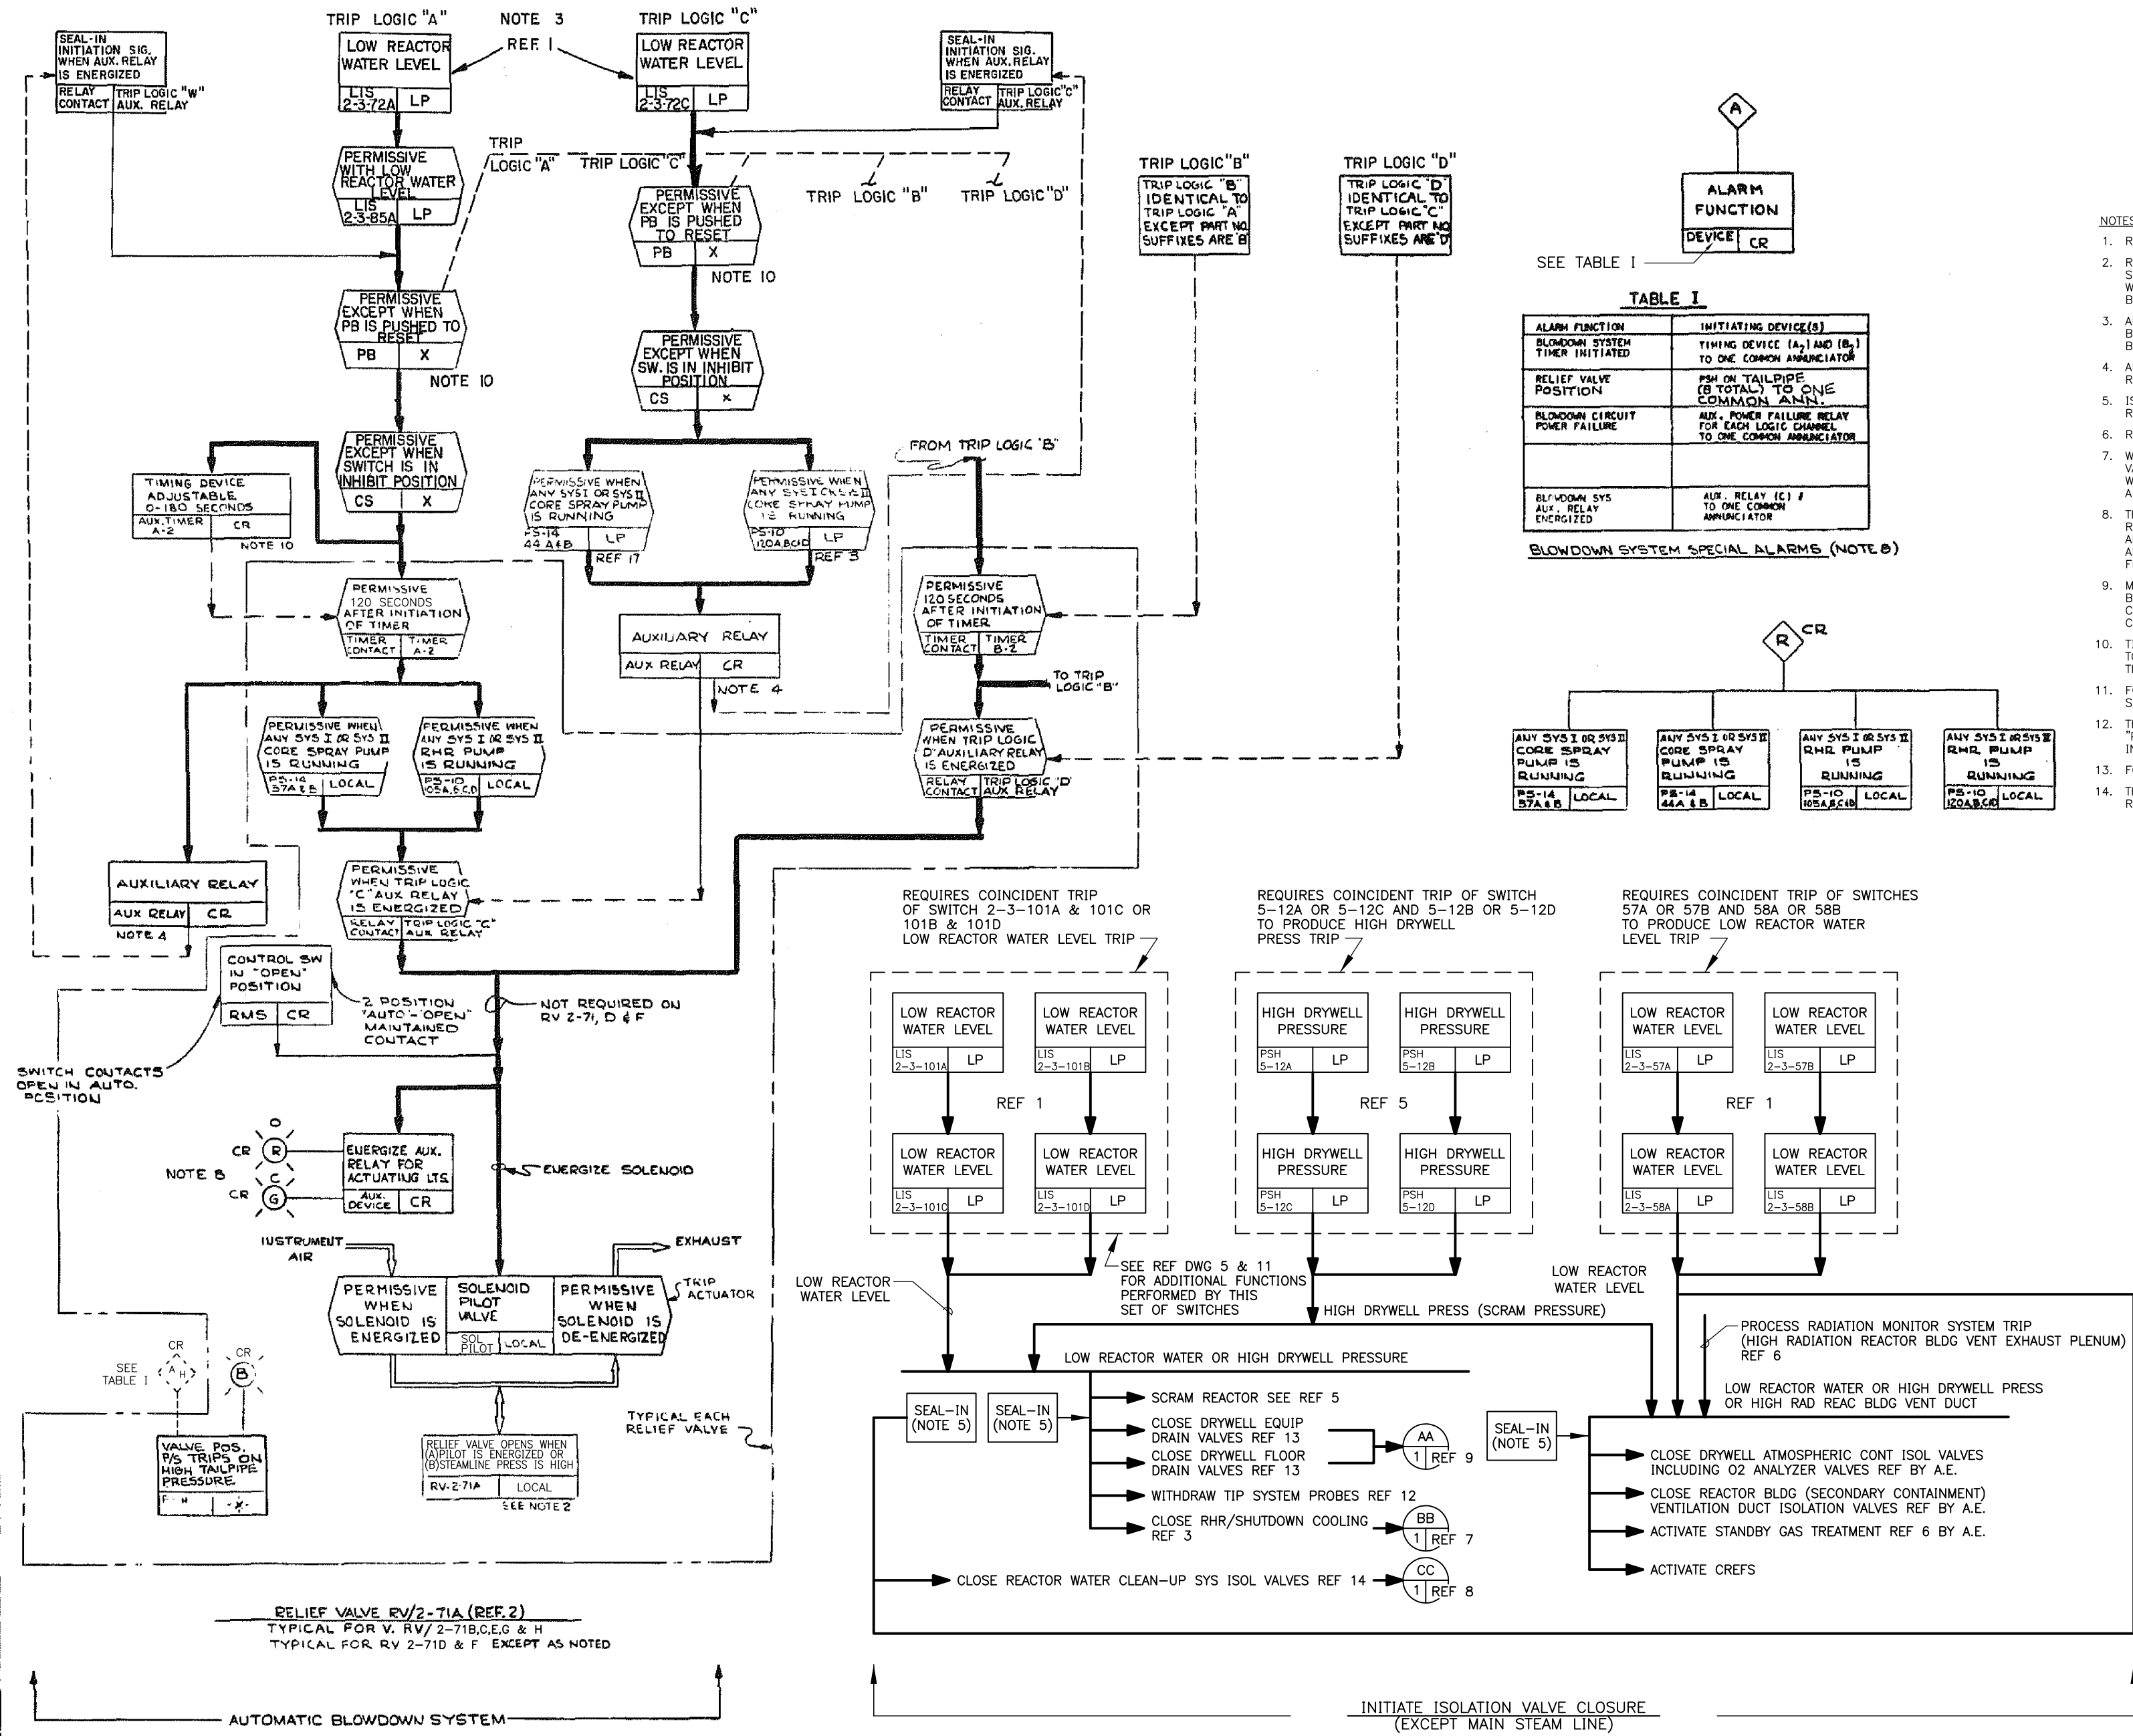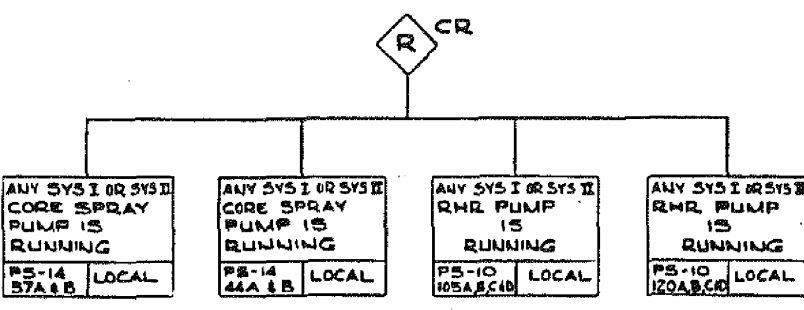

- NOTES:
1. REMOVED
  2. RELIEF VALVE MAY BE MANUALLY OPENED AT ANY TIME BY CONTROL SWITCH OR AUTOMATICALLY BY REACTOR HIGH PRESS VALVES CLOSE WHEN SWITCH IS IN AUTO POSITION EXCEPT WHEN AUTOMATIC BLOW DOWN OR REACTOR HIGH PRESSURE SIGNALS ARE PRESENT.
  3. AUTOMATIC BLOWDOWN TRIP LOGIC CIRCUITS A&C SHALL BE POWERED FROM STATION BATTERIES "A". TRIP LOGIC CIRCUITS B&D SHALL BE POWERED FROM STATION BATTERIES "B" WITH AUTOMATIC TRANSFER TO BATTERY "A" ON LOSS OF POWER.
  4. AUXILIARY RELAYS AND DEVICES ARE NOT SHOWN ON FCD EXCEPT WHERE REQUIRED TO CLARIFY FUNCTION.
  5. ISOLATION VALVE CLOSURE SIGNALS SHALL BE SEALED IN UNTIL MANUALLY RESET FROM THE CONTROL ROOM PANEL.
  6. REMOVED
  7. WHEN TEST SOLENOID PILOT IS ENERGIZED, THE MAIN STEAM ISOLATION VALVE OPERATOR IS SLOWLY EXHAUSTED (60 SEC CLOSURE TIME) WHILE VALVE IS CLOSED BY ACTION OF THE VALVE SPRING WITHOUT AID OF THE AIR PRESSURE.
  8. THE ALARMS AND VALVE INDICATING LIGHTS SHOWN ON THE FCD ARE SYSTEM REQUIREMENTS IN ADDITION TO THOSE SHOWN ON THE SYSTEM P&ID'S. ADDITIONAL INFORMATION ON ALARMS, VALVE POSITION INDICATING LIGHTS, AND PROCESS INSTRUMENTATION NOT SHOWN ON THIS FCD MAY BE OBTAINED FROM REF 1, 2, 3, 4, 5, 6, 13 AND 14.
  9. MAIN STEAM LINE ISOLATION VALVE TRIP LOGIC CIRCUITS A, B, C, & D SHALL BE POWERED FROM REACTOR PROTECTION SYS M-G SETS. TRIP ACTUATOR CIRCUIT I SHALL BE POWERED FROM ANY RELIABLE AC SOURCE. TRIP ACTUATOR CIRCUIT II SHALL BE POWERED FROM STATION BATTERIES.
  10. TIMING DEVICES SHALL BE OF THE TYPE THAT AUTO. MECHANICALLY RESET TO ZERO, UPON LOSS OF POWER TO THE TIMING DEVICE OR UPON LOSS OF THE INITIATION SIGNAL, OR UPON PUSHING THE PB TO RESET.
  11. FOR LOCATION AND IDENTIFICATION OF INSTRUMENTS SEE INSTRUMENT DATA SHEET LISTED IN MPL FOR EACH INSTRUMENT.
  12. THE NUCLEAR BOILER SYSTEM SHALL BE DESIGNED IN ACCORDANCE WITH PROPOSED CRITERIA FOR NUCLEAR POWER PLANT PROTECTION SYSTEM IEEE 279" IN SO FAR AS PRACTICABLE.
  13. FOR TRIP SETTINGS SEE REF 18.
  14. THE DEVICES IN THIS LOGIC ARE ESSENTIAL AND MUST MEET THE REQUIREMENTS OF IEEE 279.

REF. DOCUMENTS

	MPL #
1. P&ID NUCLEAR BOILER VESSEL INSTRUMENTATION	2 - 3
2. P&ID NUCLEAR BOILER	2
3. P&ID RHR SYSTEM	10
4. FCD HPCI SYSTEM	23
5. IED REACTOR PROTECTION SYSTEM	5
6. IED PROCESS RADIATION MONITOR	17
7. FUNCTIONAL CONTROL DIAGRAM RHR SYSTEM	10 - 202
8. FCD REACTOR WATER CLEAN-UP SYSTEM	12 - 202
9. FCD RADWASTE SYSTEM	20 - 703
10. DESIGN SPEC FOR CONTAINMENT ISOLATION SYSTEM	1 - 157
11. FCD RECIRC FLOW CONTROL SYSTEM	2 - 184 - 5
12. FCD NEUTRON MONITOR SYSTEM	7 - 2
13. P&ID RADWASTE SYSTEM	20
14. P&ID REACTOR WATER CLEANUP SYSTEM	12
15. SCHEMATIC CONTROL DIAGRAM	175A9560
16. LOGIC SYMBOLS	209A4756
17. P&ID CORE SPRAY SYSTEM	14
18. TURB GEN STEAM BYPASS SYS	1 - 139

LEGEND  
\* = SWITCH GEAR DEVICE FUNCTION NO'S USAS SPEC C-37.2  
\* = FURNISHED AS PART OF VALVE OR DEVICE ASSEMBLY.

INFORMATION ONLY

452005040

SCAN/CADD DWG

DO NOT REVISE MANUALLY



CADD FILE: C0054654

730E149BB

REV N05

FOR PREVIOUS REVISIONS, SEE SUPERSEDED CARDS.

NO.	REVISIONS	DFT	CKD	APP	DATE
N05	CED 6014280 (DCN 04-1263)	RAC	RHG	KG	8-18-05

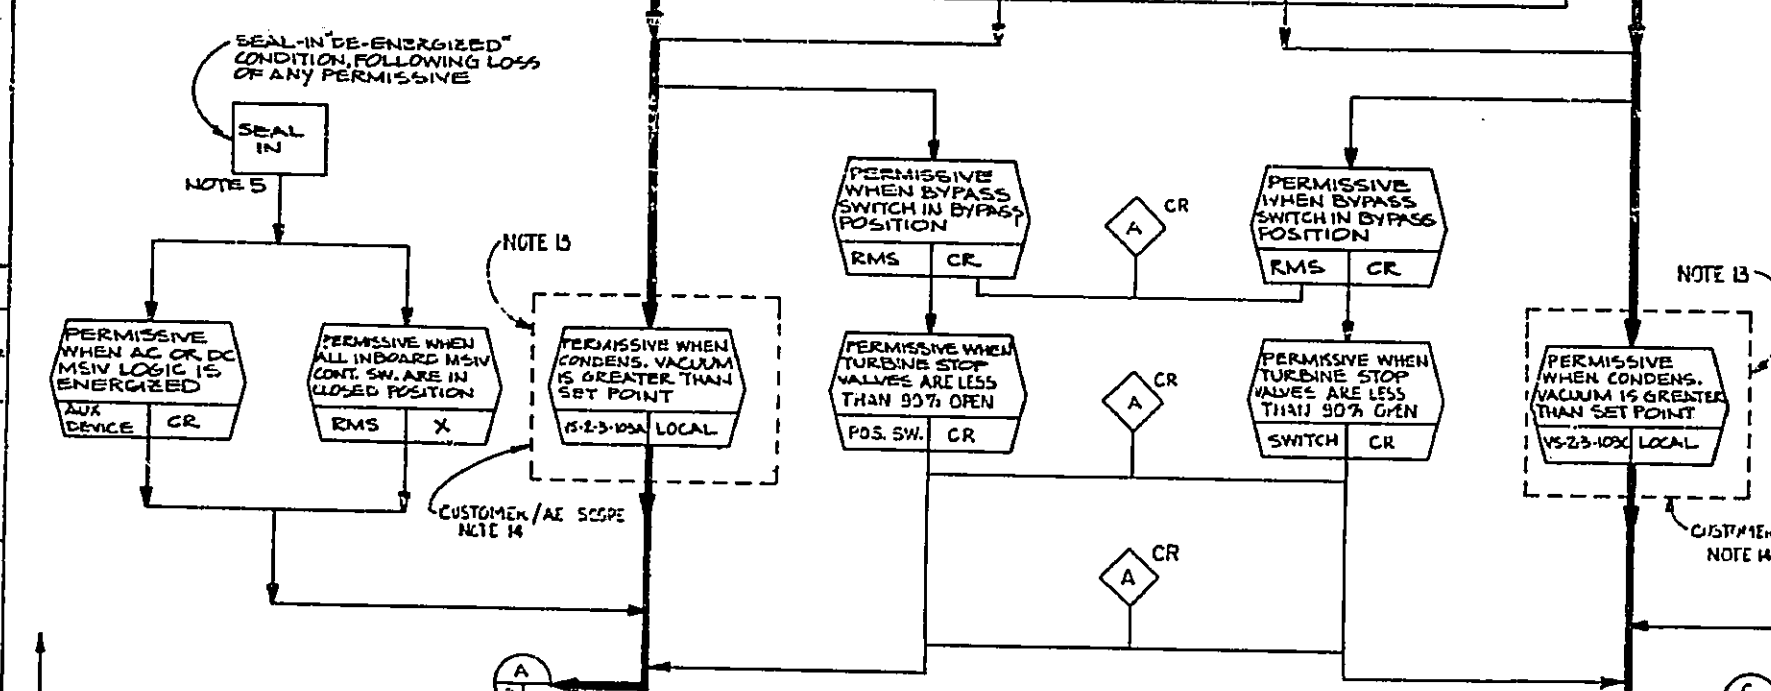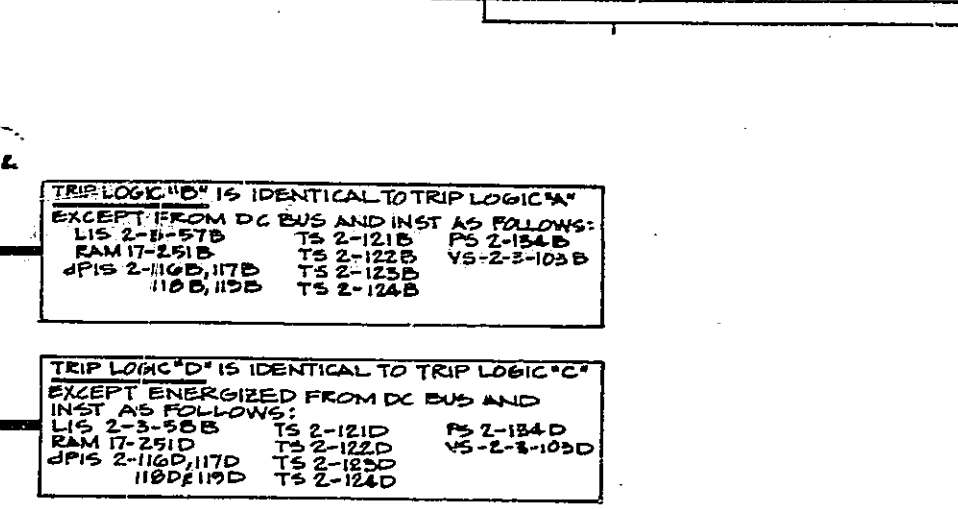


**INFORMATION  
ONLY**

MAIN STEAMLINE DRAIN VALVE MO 2-74 (REF 2)  
 (TYPICAL FOR DRAIN VALVE MO 2-77 EXCEPT DC TYPE & CONTACTOR (72) & LOGIC CTD)  
 (TYPICAL FOR DRAIN VALVE MO 2-78, MO 2-79 & MO 2-265 EXCEPT AS NOTED)

		REVISIONS		PRINTS TO	
<p>611 1-7-4-2-10-1</p> <p>ADDED M02-263 PER ECA-30319-1 7/11/4, 7/1/3</p> <p>7/11/4, 7/1/3</p> <p>PER ECA-30627-1 7/11/4, 7/1/3</p>	<p>5/1/4, 7/1/3, 7/1/4</p> <p>REV MAIN-11/11</p> <p>USE 1501 VIAL</p> <p>CONTROL SYS 10/11C</p> <p>ECA 20809-10</p> <p>7/11/4, 7/1/3</p>	<p>ECA 20809-7</p> <p>ECA 20809-10</p> <p>ADDED 513 PER</p> <p>ECA 20809-9</p> <p>7/11/4</p>	<p>1/1/4, 7/1/3</p> <p>REDRAWN WITH GEN. CHG'S</p> <p>ENCIRCLED AREAS</p> <p>A-ECA 20315-2</p> <p>ECA 20809-10</p> <p>ECA 20211-1</p>		
<p>DOUGHERT, THOMAS</p> <p>7/11/4, 7/1/3</p> <p>7/11/4, 7/1/3</p>		<p>ECA 20809-10</p> <p>7/11/4</p> <p>7/11/4</p>	<p>BWRS</p> <p>730E49BB</p> <p>SAN JOSE</p> <p>7/11/4</p>		

REACTOR RECIRCULATION PUMP A/B SPEED CONTROLLER CONFIGURATION  
FUNCTION BLOCKS TYPICAL FOR CONTROLLERS RRFC-SIC-16A/B

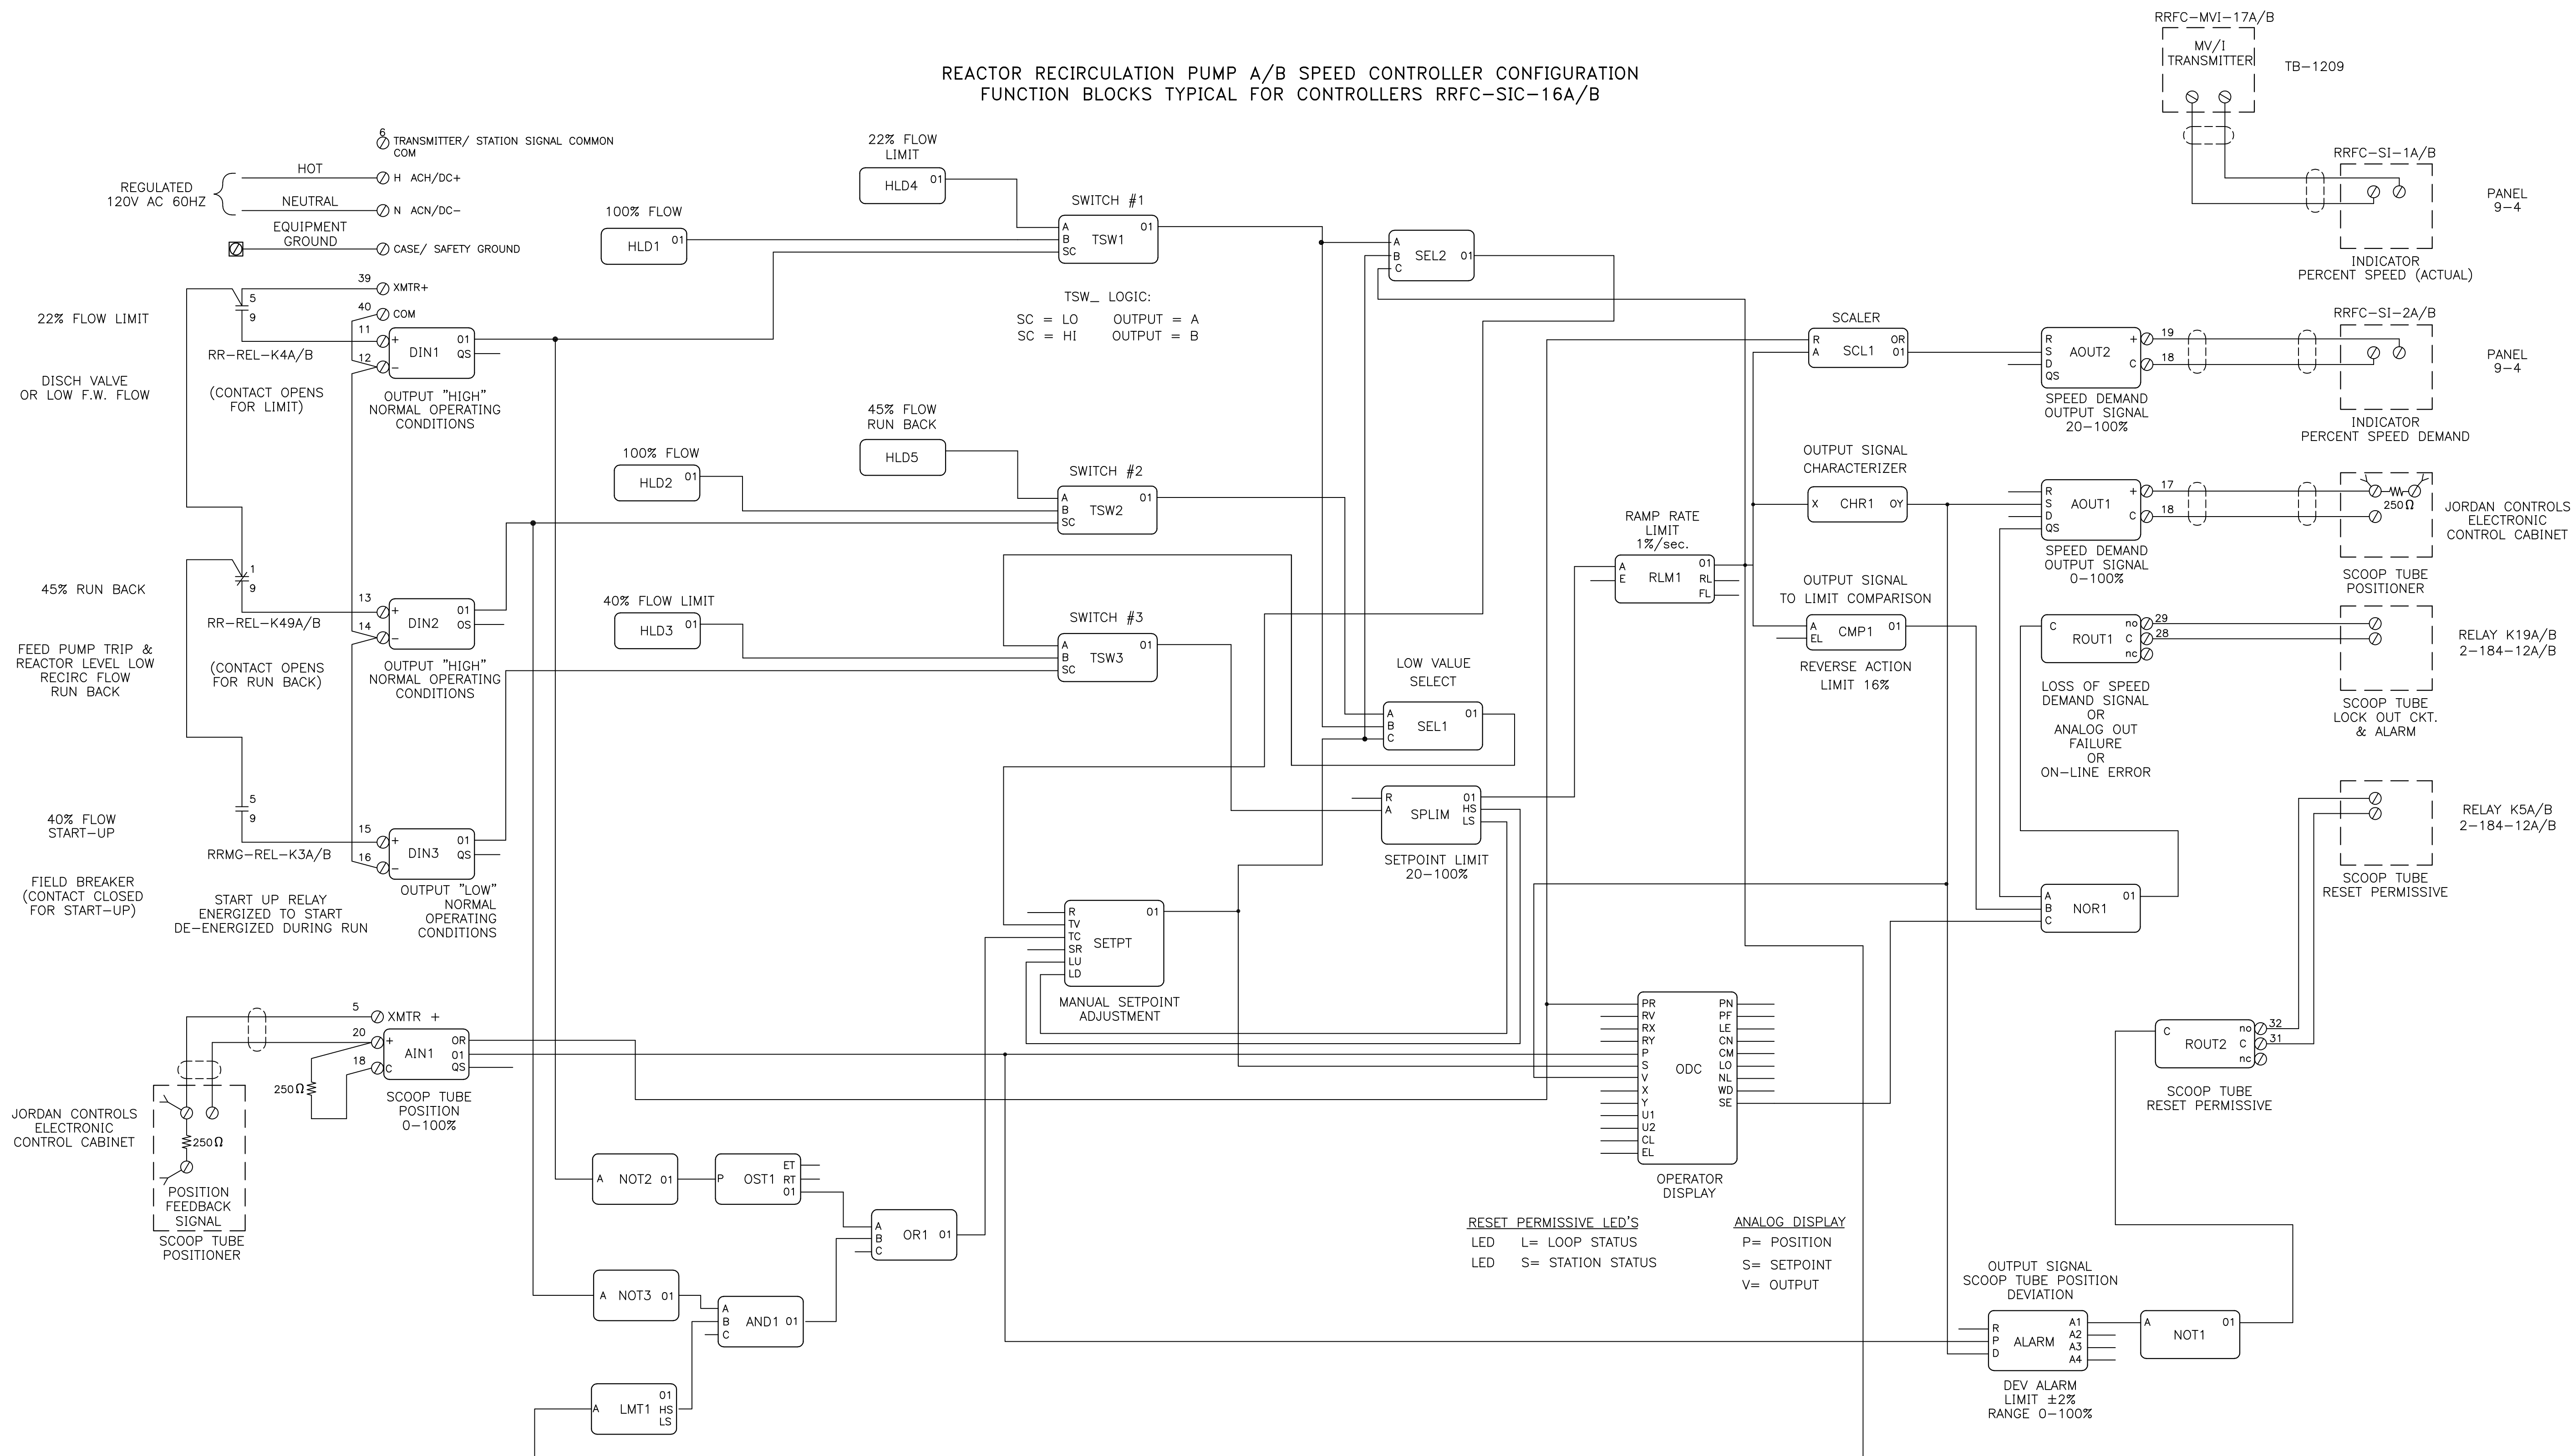

QUALITY STATUS:

BLOCK TYPE	QS TRANSITION	CONDITION
AOUT_	LO → HI	HI Z OR OPEN CKT

MPU CONTROLLER BOARD JUMPERS

JUMPER (SHUNT) ID	DESCRIPTION	JUMPER INSTALLED
W2	ETHERNET//LIL/ MOD BUS	YES
W4	LONWORKS I/O BUS	YES
W8	REAL TIME CLOCK BATTERY	YES

CONTROLLER BOARD VERSION DEPENDENT (NOTE 2)

- NOTE:
- RRFC PUMP SPEED CONTROLLER REQUIREMENTS AND CONFIGURATION DESCRIPTION, CED 2001-0017 ATTACHMENT: F
  - SHUNT INSTALLED ON N/C OF W8 DURING STORAGE, INSTALLED ON CLK WHEN CONTROLLER INSTALLED IN THE FIELD.


AS BUILT  
454244494  
CADD DRAWING

FOR PREVIOUS REVISIONS, SEE SUPERSEDED CARDS


NO.	REVISIONS	DFT	CKD	APP	DATE
N05	CR-CNS-2007-004110CN 07-0045	DLR	DLR	DLR	11/17/07
N06	CEP 6010820 (DCN 08-1765)	DLR	DLR	DLR	04/09/08
N07	CEP 6010820 (DCN 08-0517)	KG	KG	KG	10/15/08

SIGNIFICANT NUMBER								DRAWN	DATE	GENERAL ELECTRIC	C0042095
GROUP	1	2	3	4	5	6	DLR	8/21/01			
COOPER NUCLEAR STATION REACTOR RECIRCULATION CONTROLLER CONFIGURATION								CHECKED	DATE		
								JDN	3/19/02		
								APPROVED	DATE		
								KMD	3/19/02		
								FILMED	730E197BB SH 6B	REVISION NO7	QACD FILE:




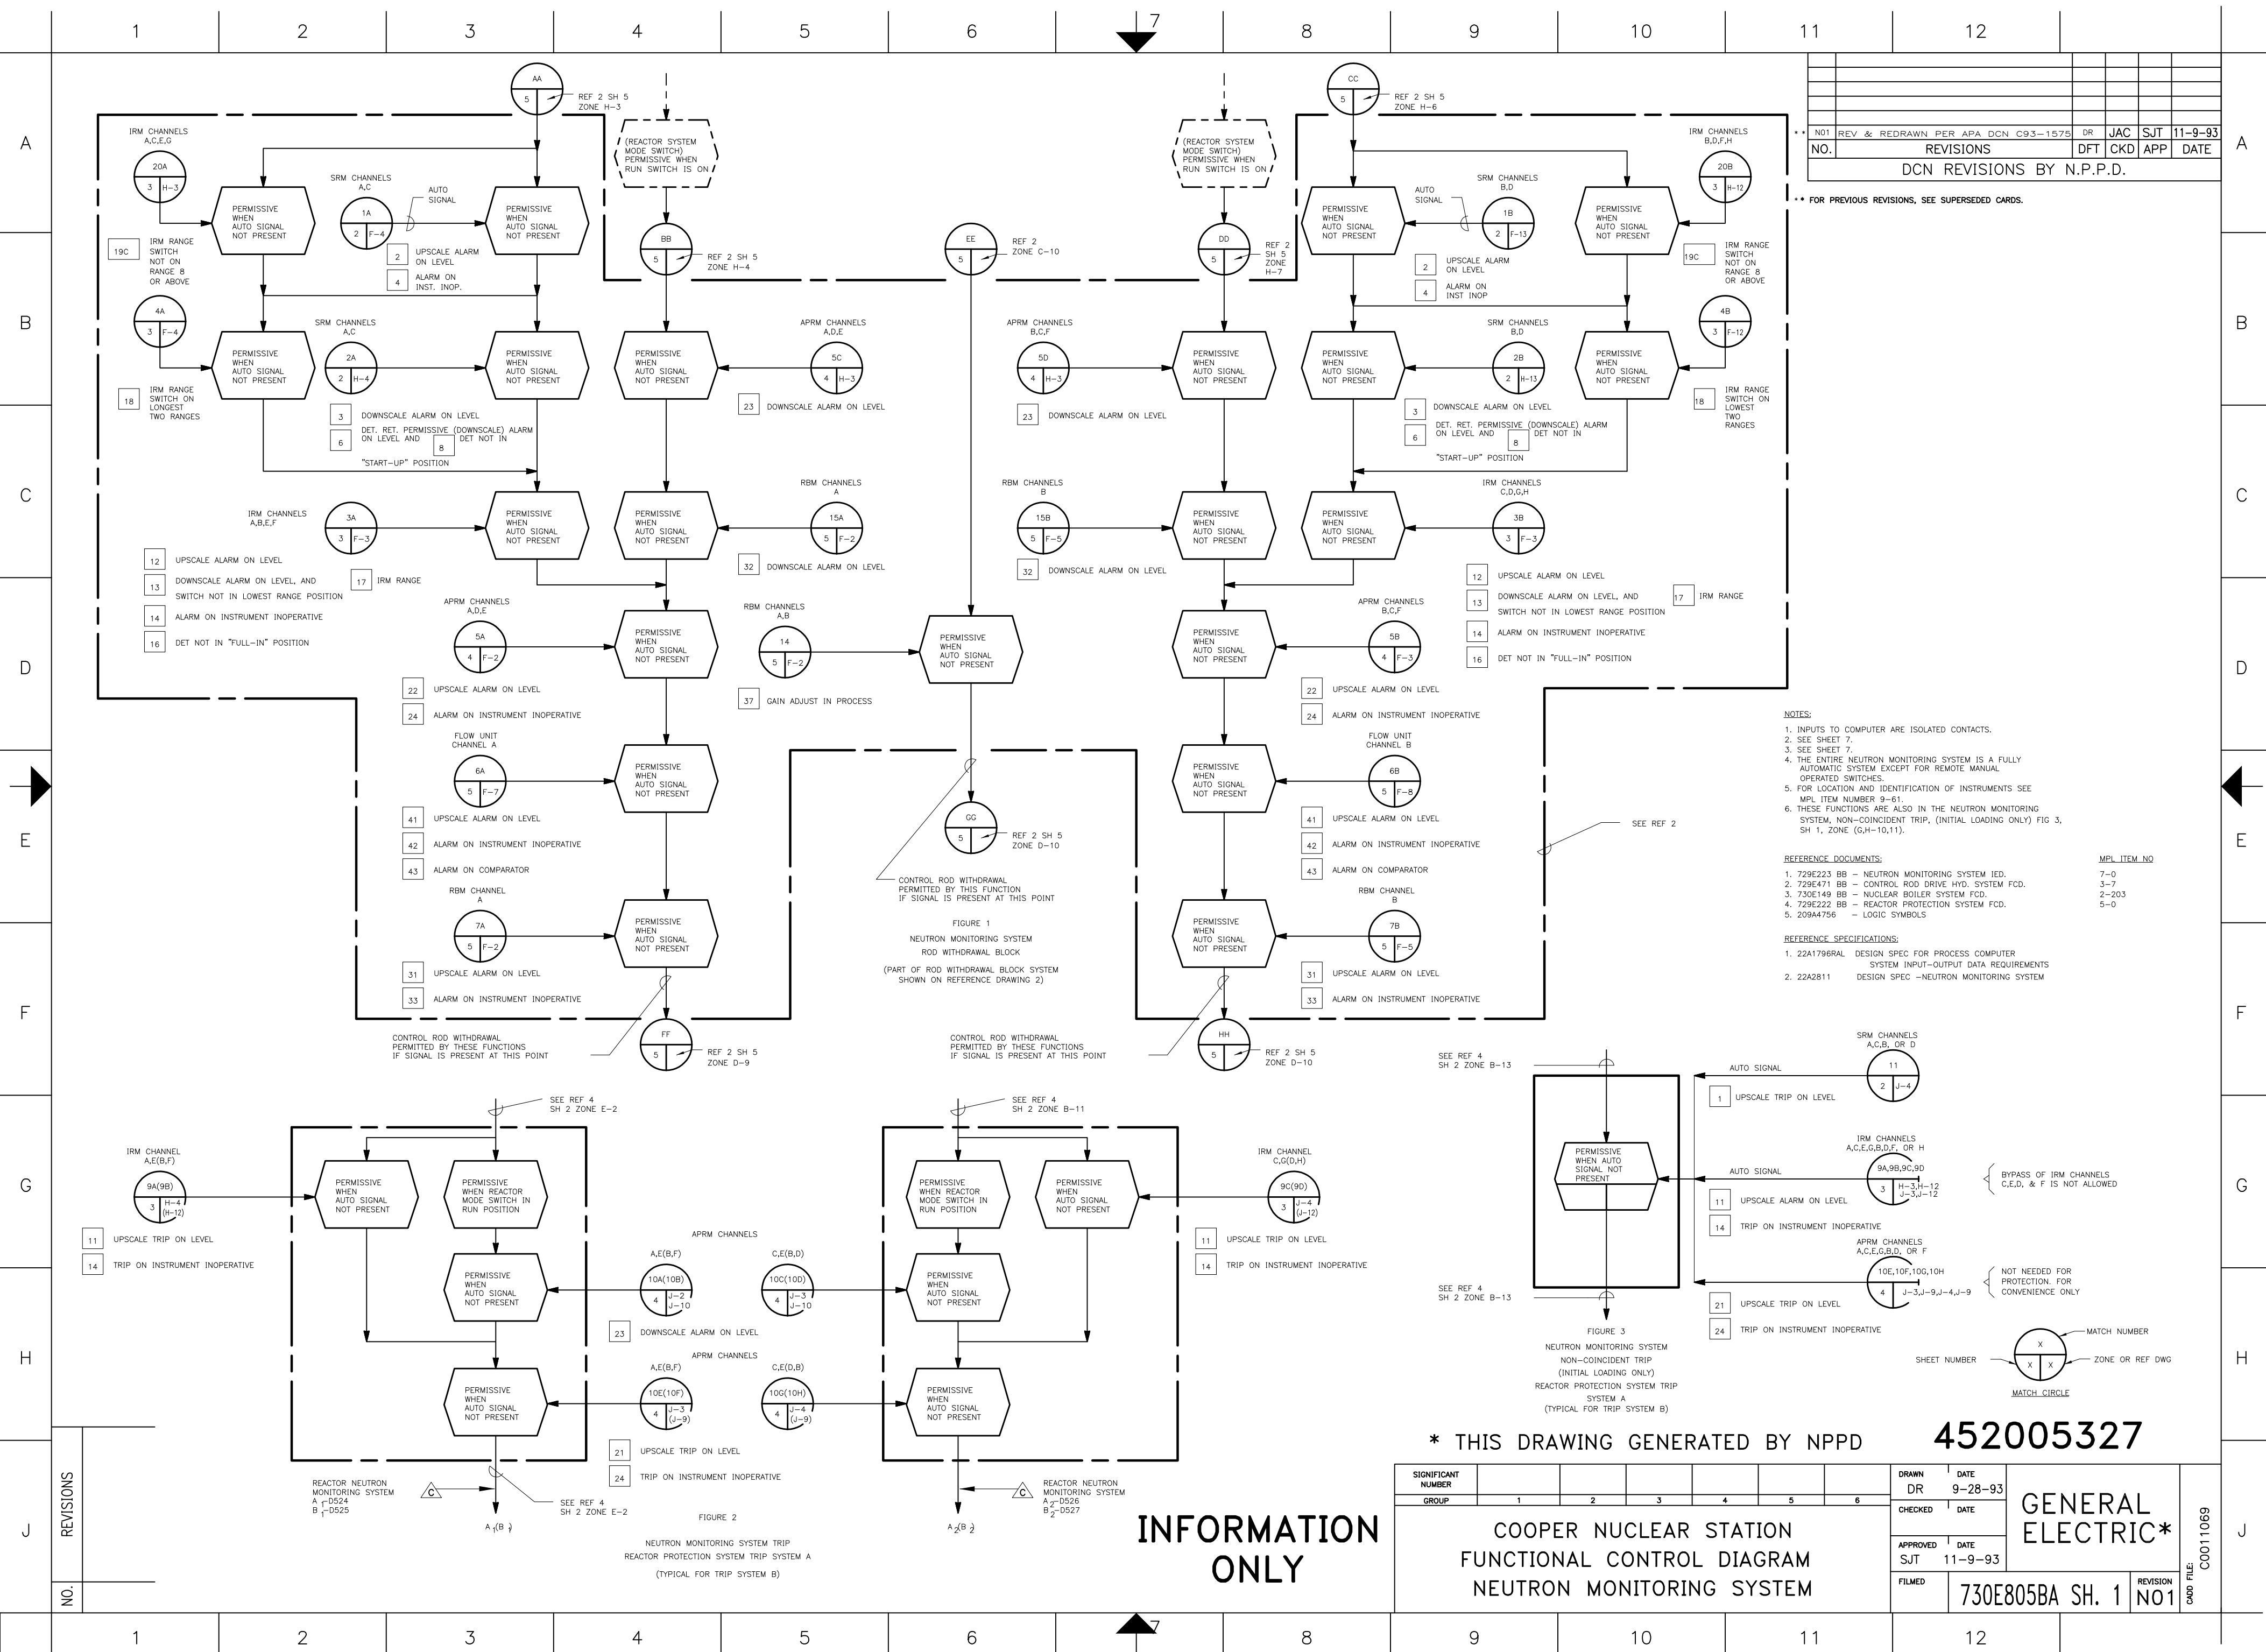



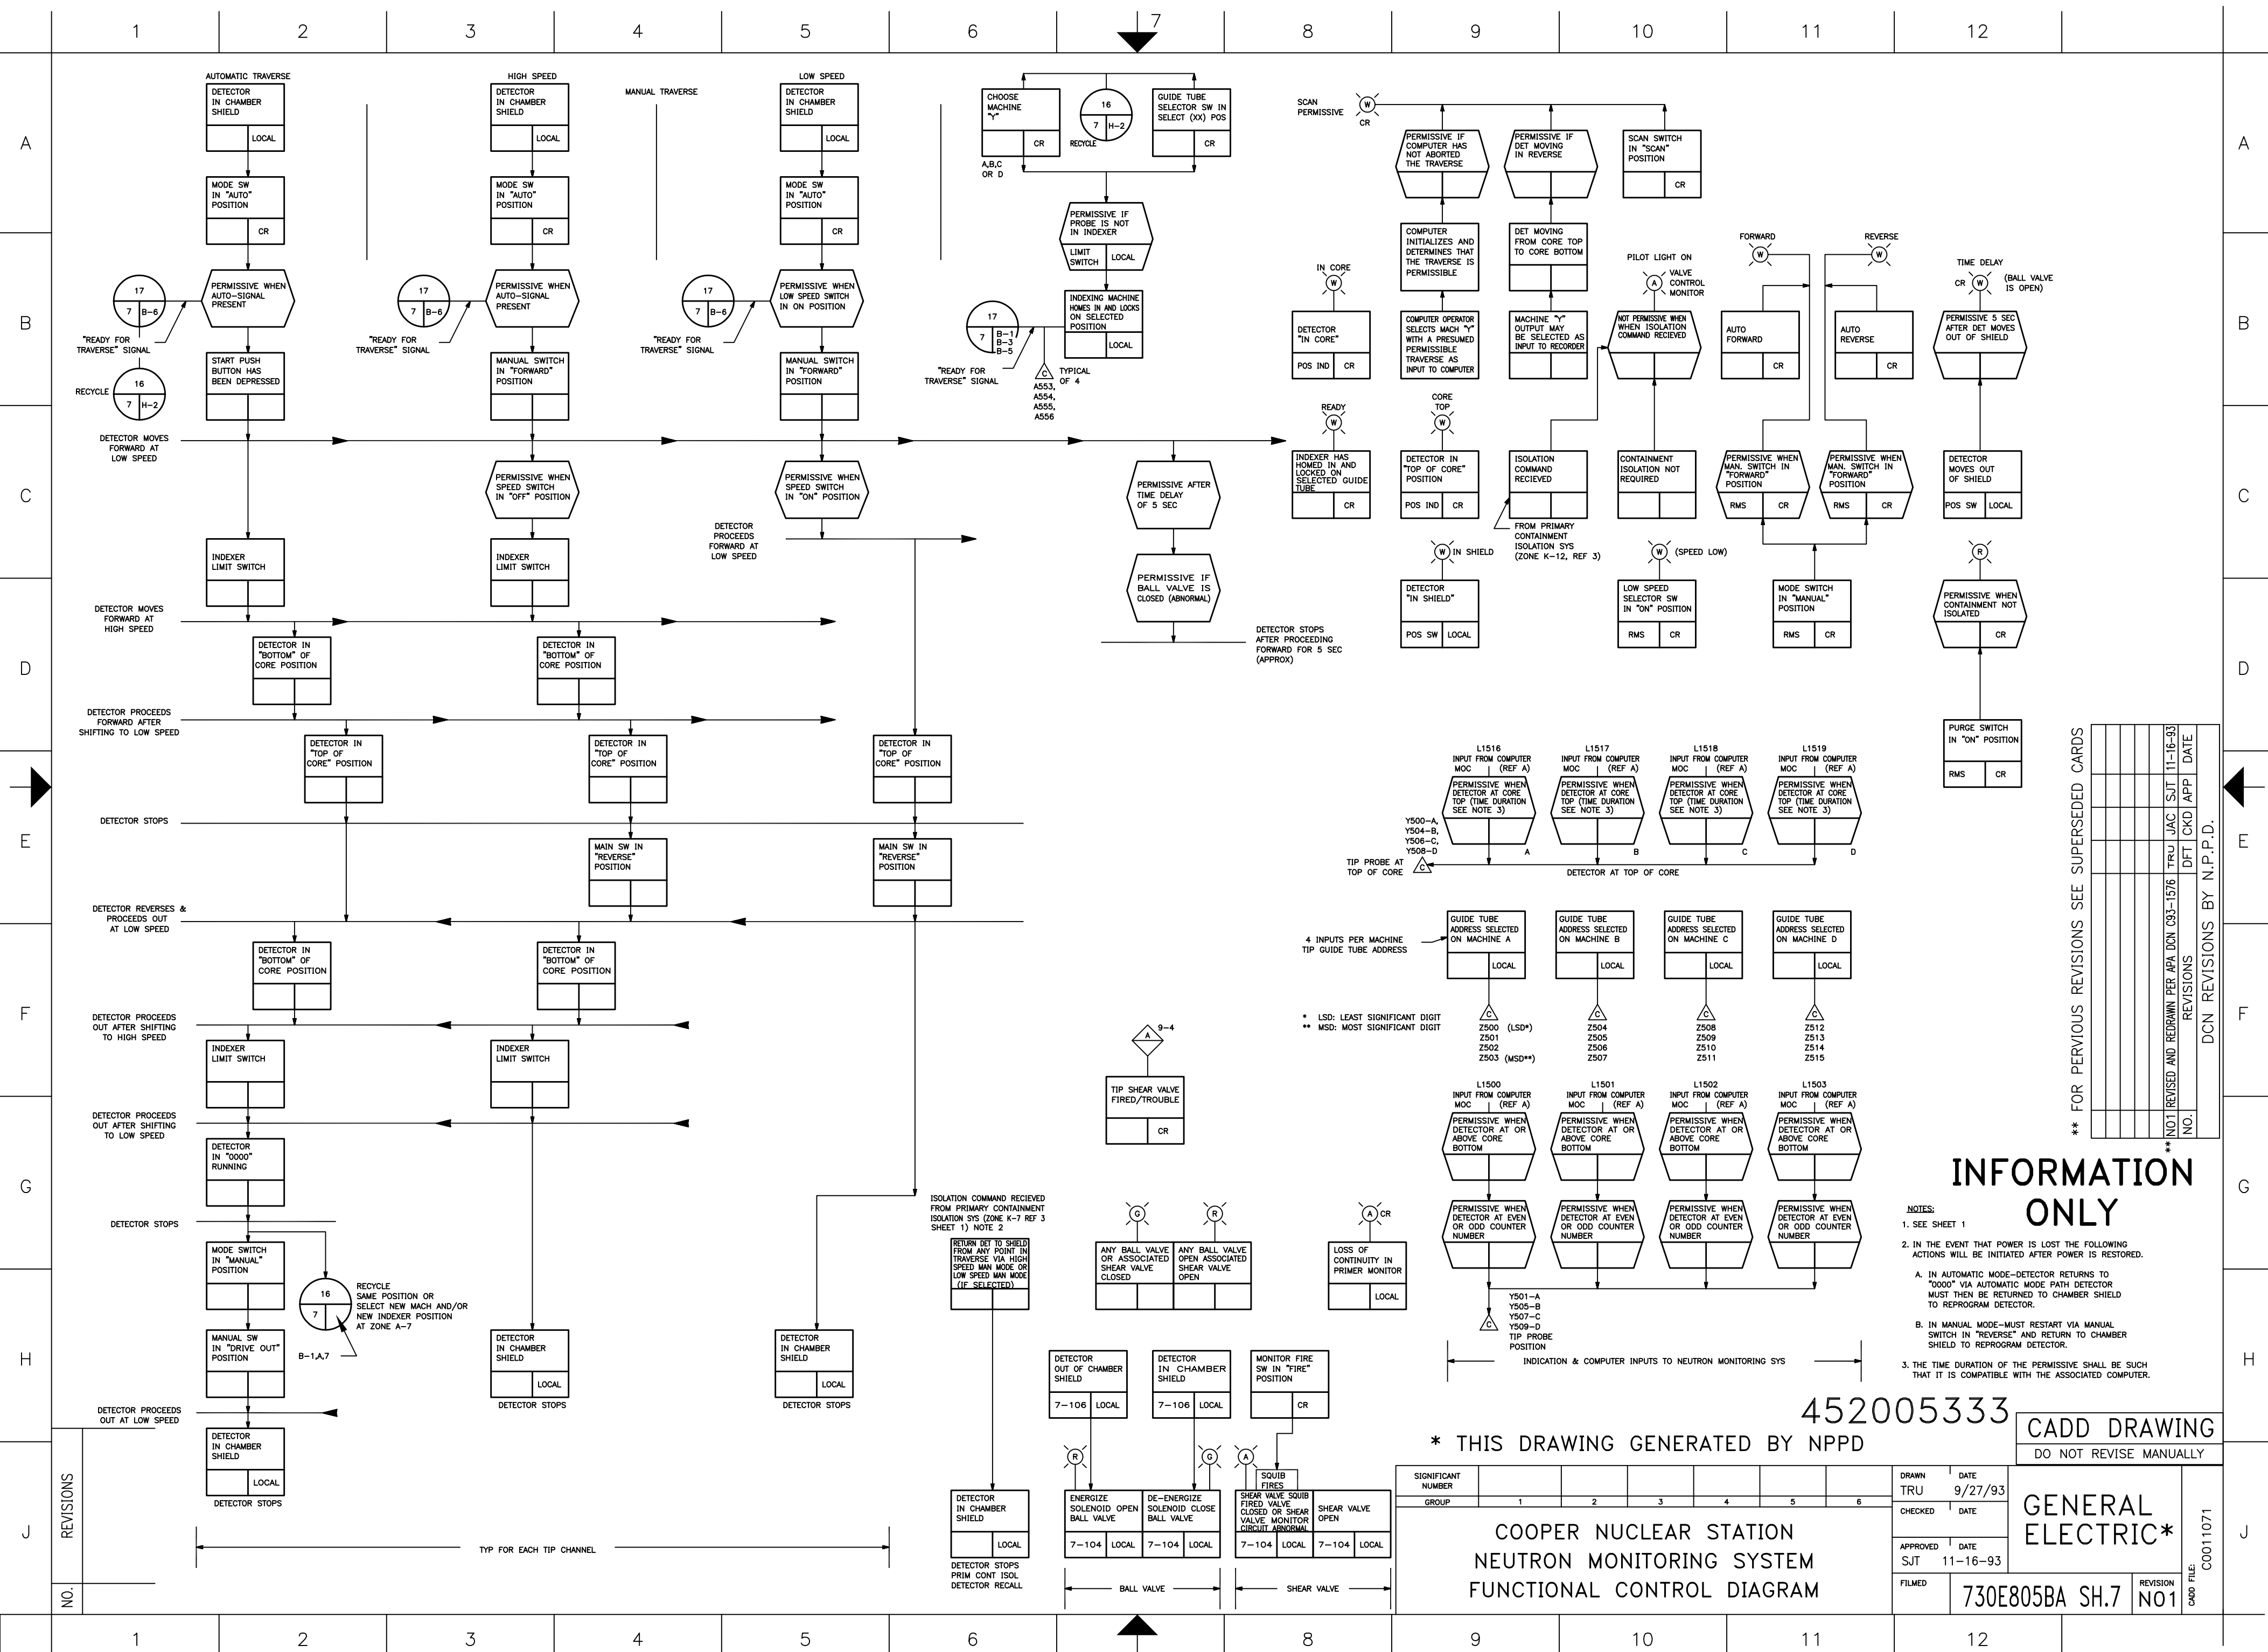



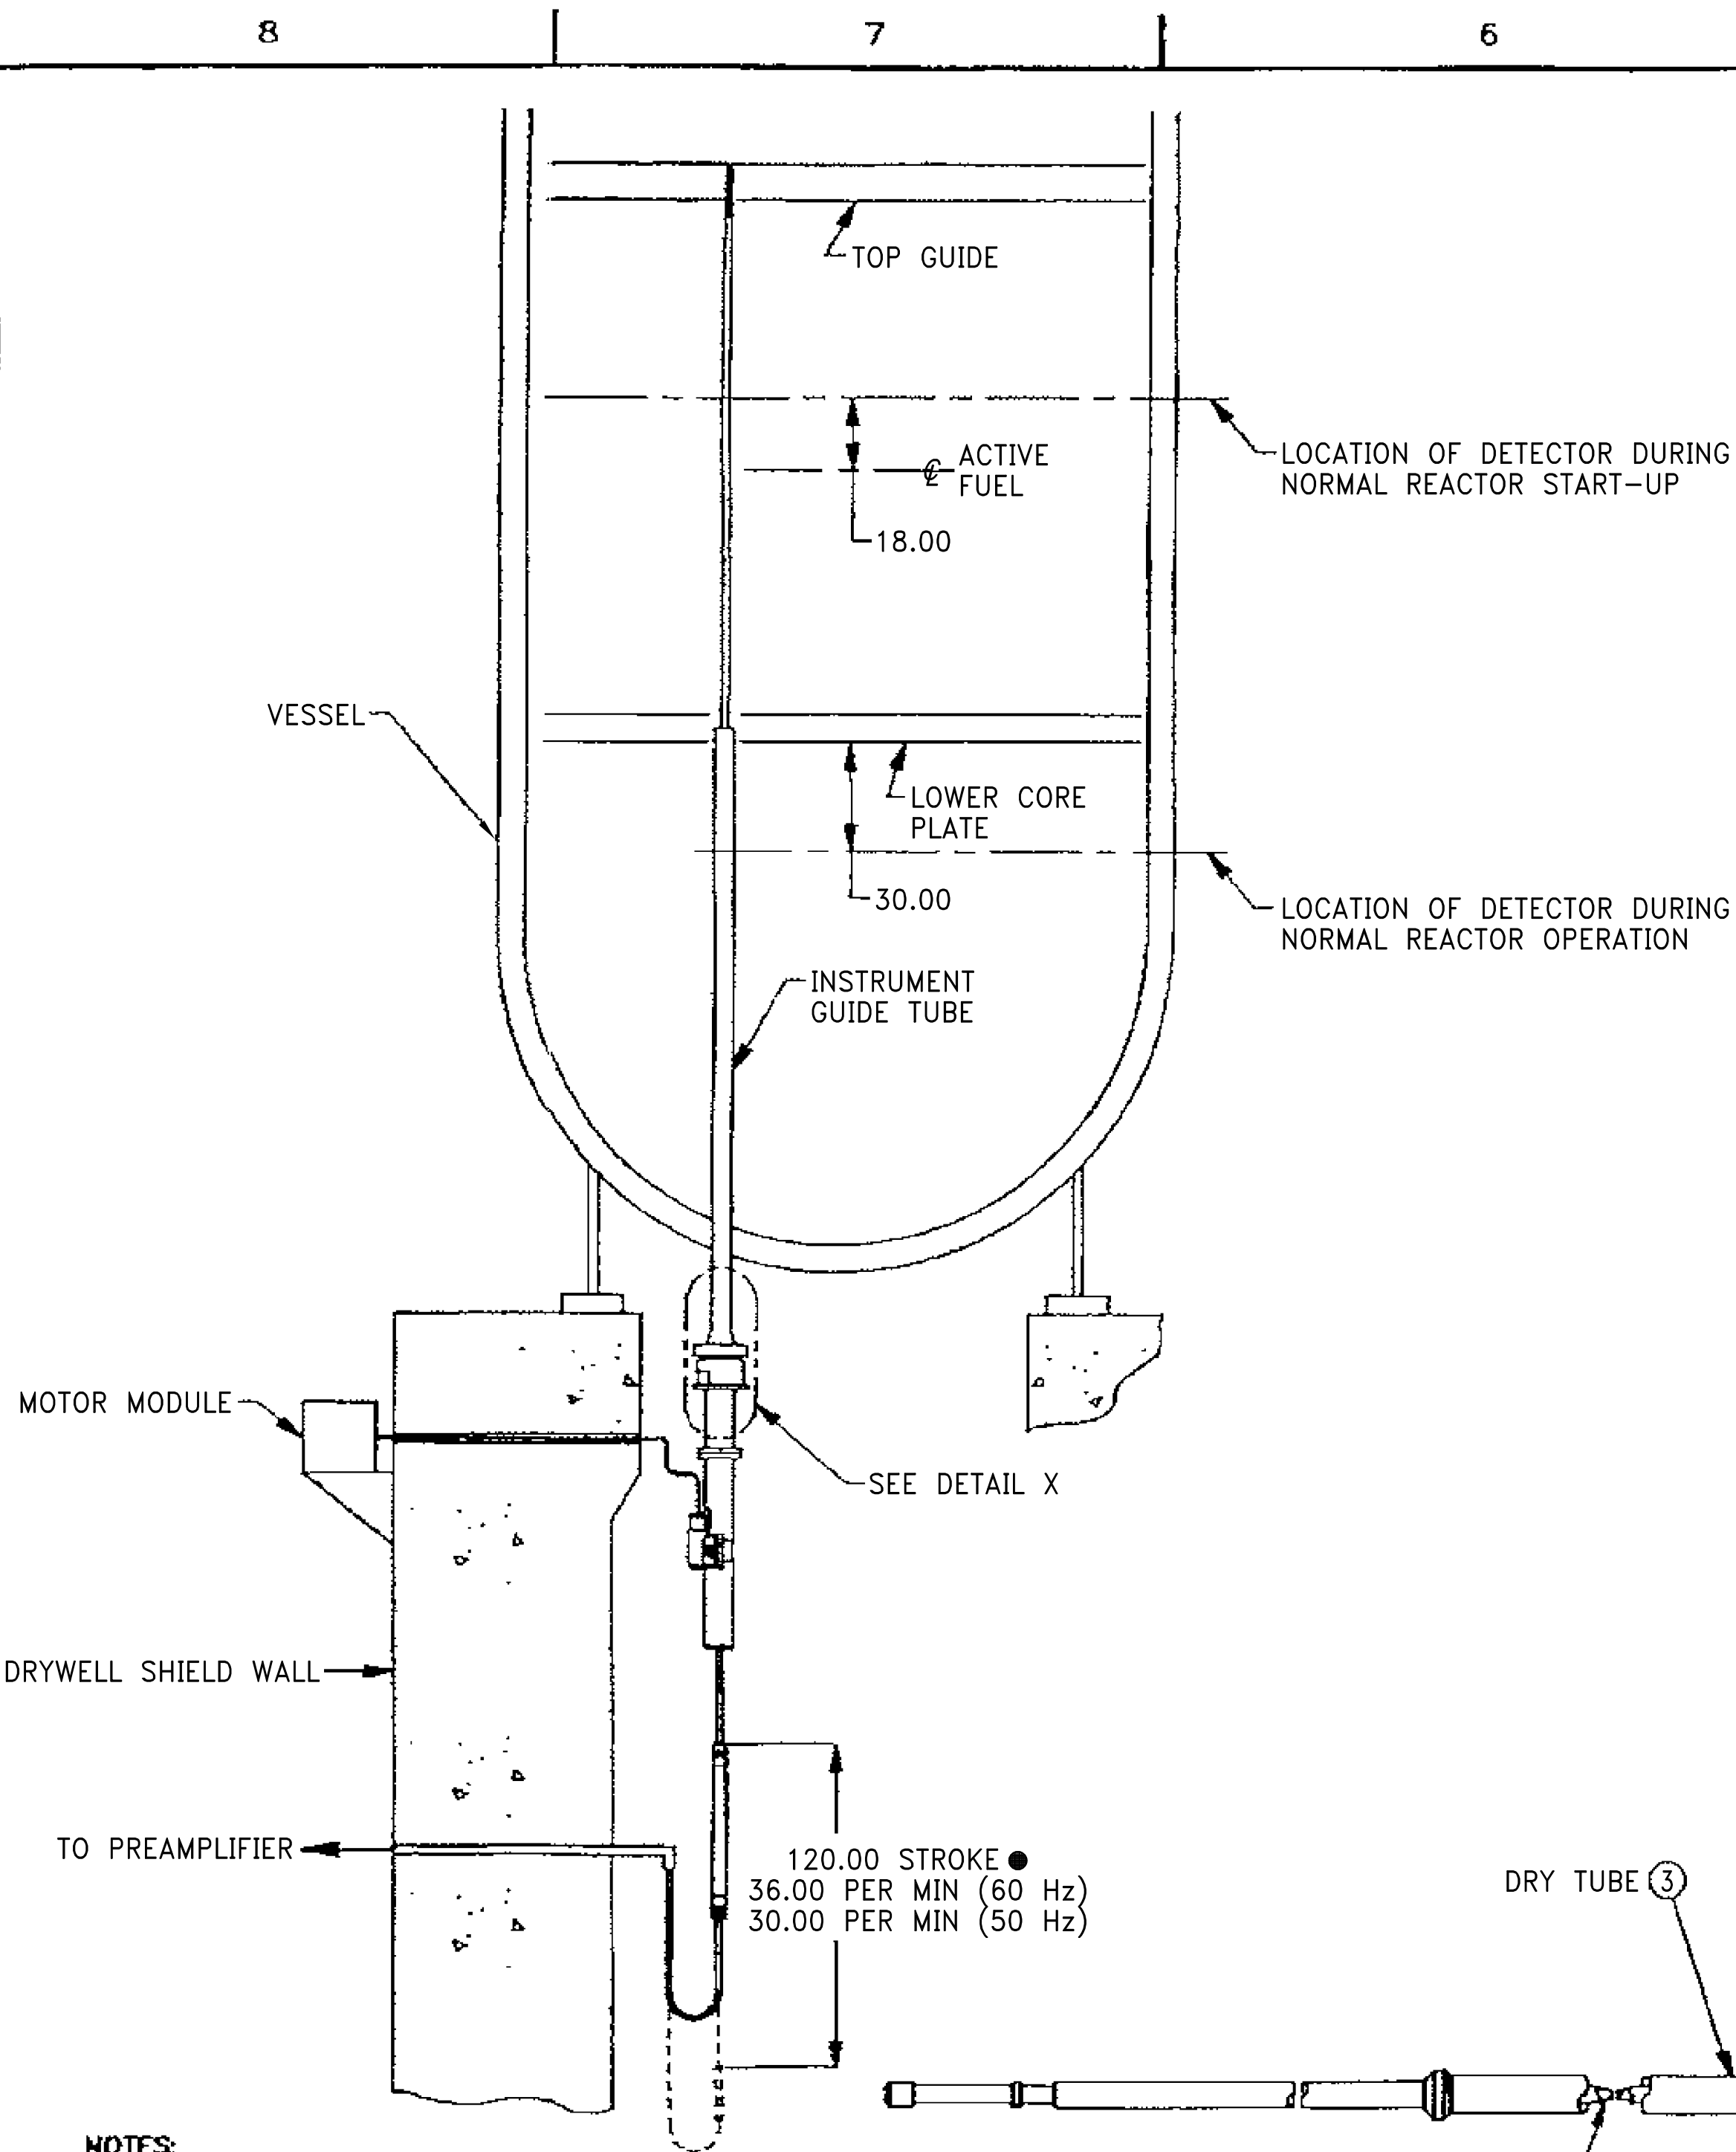

- NOTES:**
- 1- DISASSEMBLY POINTS:
    - JOINT D - TO DISCONNECT ITEM 16
    - JOINT E - TO REPLACE ITEM 15
    - JOINT F - TO ALLOW DRIVE TUBE TO PASS THROUGH ITEM 1
    - JOINT G - TO DISENGAGE GEAR BOX FROM ITEM 1
    - JOINT H - TO REMOVE ITEM 1 OR DRIVE TUBE. (NOSE PIECE MUST BE REASSEMBLED TO ITEM 3 FOR PROTECTION IF ITEM 1 IS REMOVED. SEE 8860-424)
    - JOINT J - TO REMOVE ADAPTER. (SEE NOTE ON "H" ABOVE).
  - 2- TO DISCONNECT ELECTRICAL CABLE (ITEM 16) FROM DETECTOR DRIVE (ITEM 1):
    - 2.1- LOOSEN CORD GRIP AT LOWER END OF CABLE GUARD.
    - 2.2- UNSCREW CABLE GUARD AT JOINT D.
    - 2.3- SEPARATE THE TWO ELECTRICAL CONNECTORS, KEEPING THE CABLE GUARD WITH THE ELECTRICAL CABLE.





USE 10482918P002 OR 193B1550P002. IF 193B1550P002 IS USED LUBRICANT MUST BE APPLIED BEFORE INSTALLATION.

THESE COMPONENTS MUST BE CONFIGURED TOGETHER FOR PROPER ASSEMBLY USE.

ITEM	ALT	DESCRIPTION	REF. IDENTIFICATION	QTY.	EP NUMBER
1		DETECTOR DRIVE	112C2345G001	1	B11/B13-D192
2		SHUTTLE TUBE ***	RS-E5-0800-20X	1	PART OF B11/B13-D192
2A		SHUTTLE TUBE	RS-E5-0810-401	X	PART OF B11/B13-D192
3		DRY TUBE ***	RS-E5-1200-206	1	B11/B13-D191
3A		DRY TUBE	RS-E5-1500-201	X	B11/B13-D191
4		FLANGE	107C5053G002	1	
5		ADAPTER	112C2528G001	1	
6		THREAD SEAL	159A2501P001	1	PART OF B11/B13-D192
7		HEX NUT	SEE NOTE 4	1	
8		FLAT WASHER	167A1628P001	1	
9		FLAT WASHER	SEE PLANT MPL	-	B11/B13-D052
10		BOLT	SEE PLANT MPL	-	B11/B13-D056
11		SOC HEAD SCREW	117C1007P23016	8	
12		FLAT WASHER	175A8011P012	8	PART OF B11/B13-D192
13		FLEX SHAFT	112C2546P002 OR ME-0801-084B	1	PART OF B11/B13-D192
14		MOTOR MODULE	135B9892	1	C51-S001
15		DETECTOR	112C3144	1	C51-N001 OR C51-N002
16		CABLE	SUPPLIED BY AE	-	-
17A		EQI PLUG	RS-E3-0026	X	PART OF B11/B13-D192
17A		EQI RECEPTACLE	RS-E3-0021	X	PART OF B11/B13-D192
18		ACCESS PARTS	237X614G001	1	PART OF C51-S001
19					
20					
21		O RING	SEE PLANT MPL	-	B11/B13-D050
22		O RING	209A4117P003	1	
23		SEALANT	213A6931P001	1	PART OF B11/B13-D192
24			DELETED		

\*\*\* USED FOR JOINING ITEM 15 TO ITEM 16.

\*\*\* FOR ITEM WITH - X- IN PART No. REPLACE -X- WITH MODEL No. APPLYING TO SITE SPECIFIC APPLICATION.

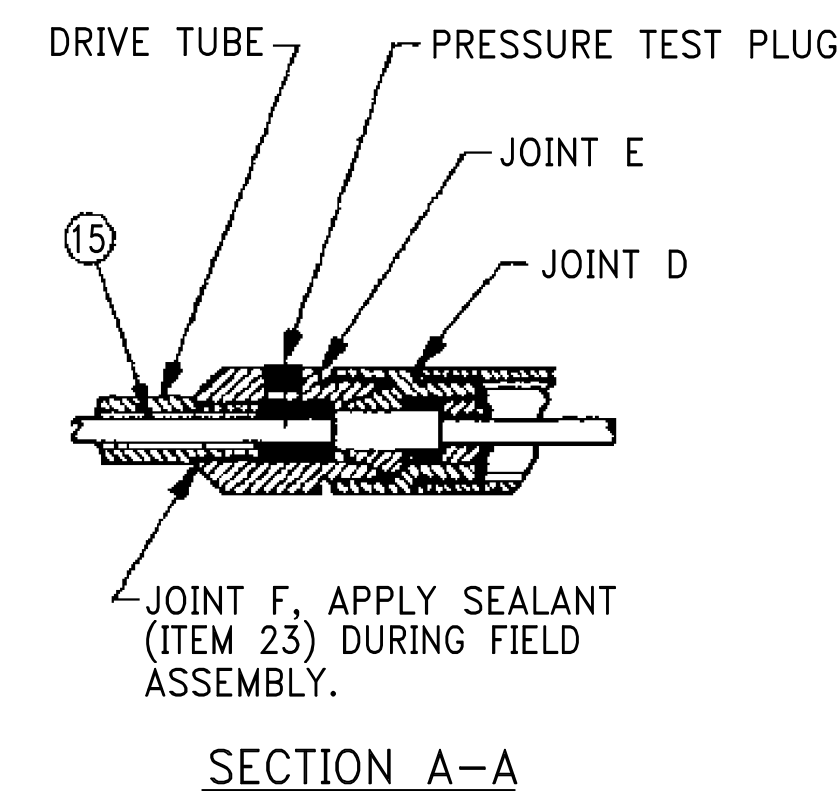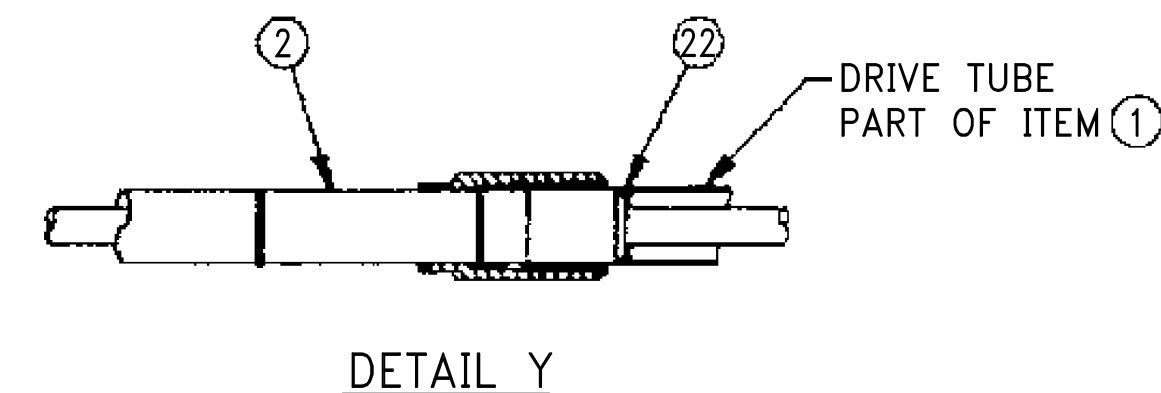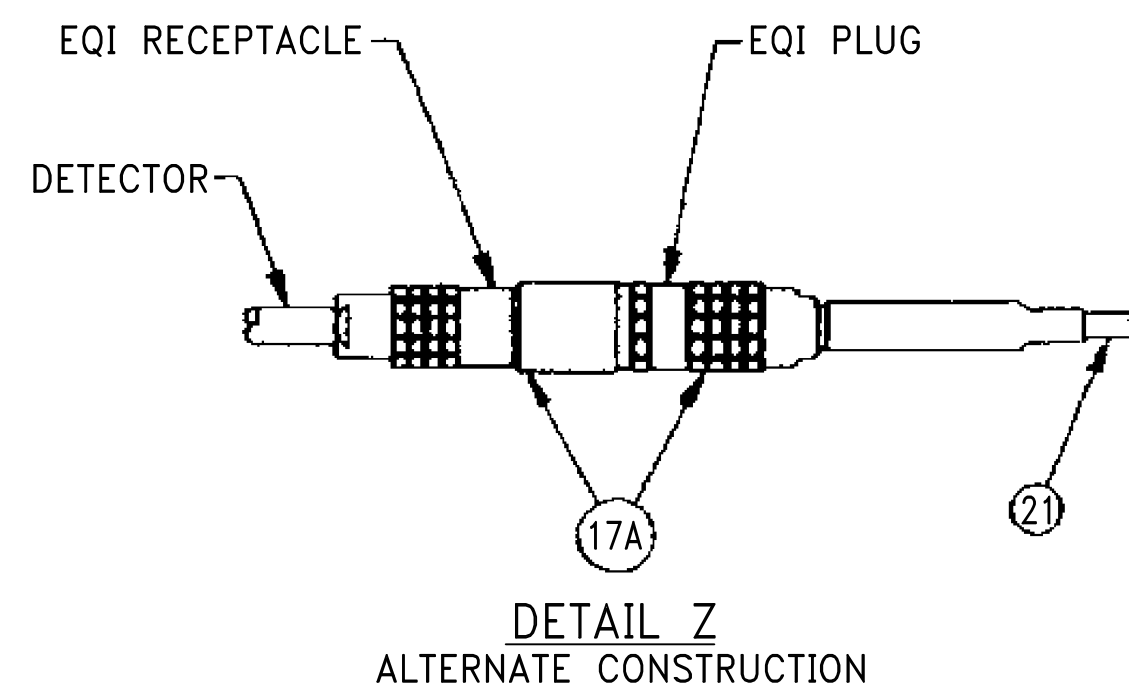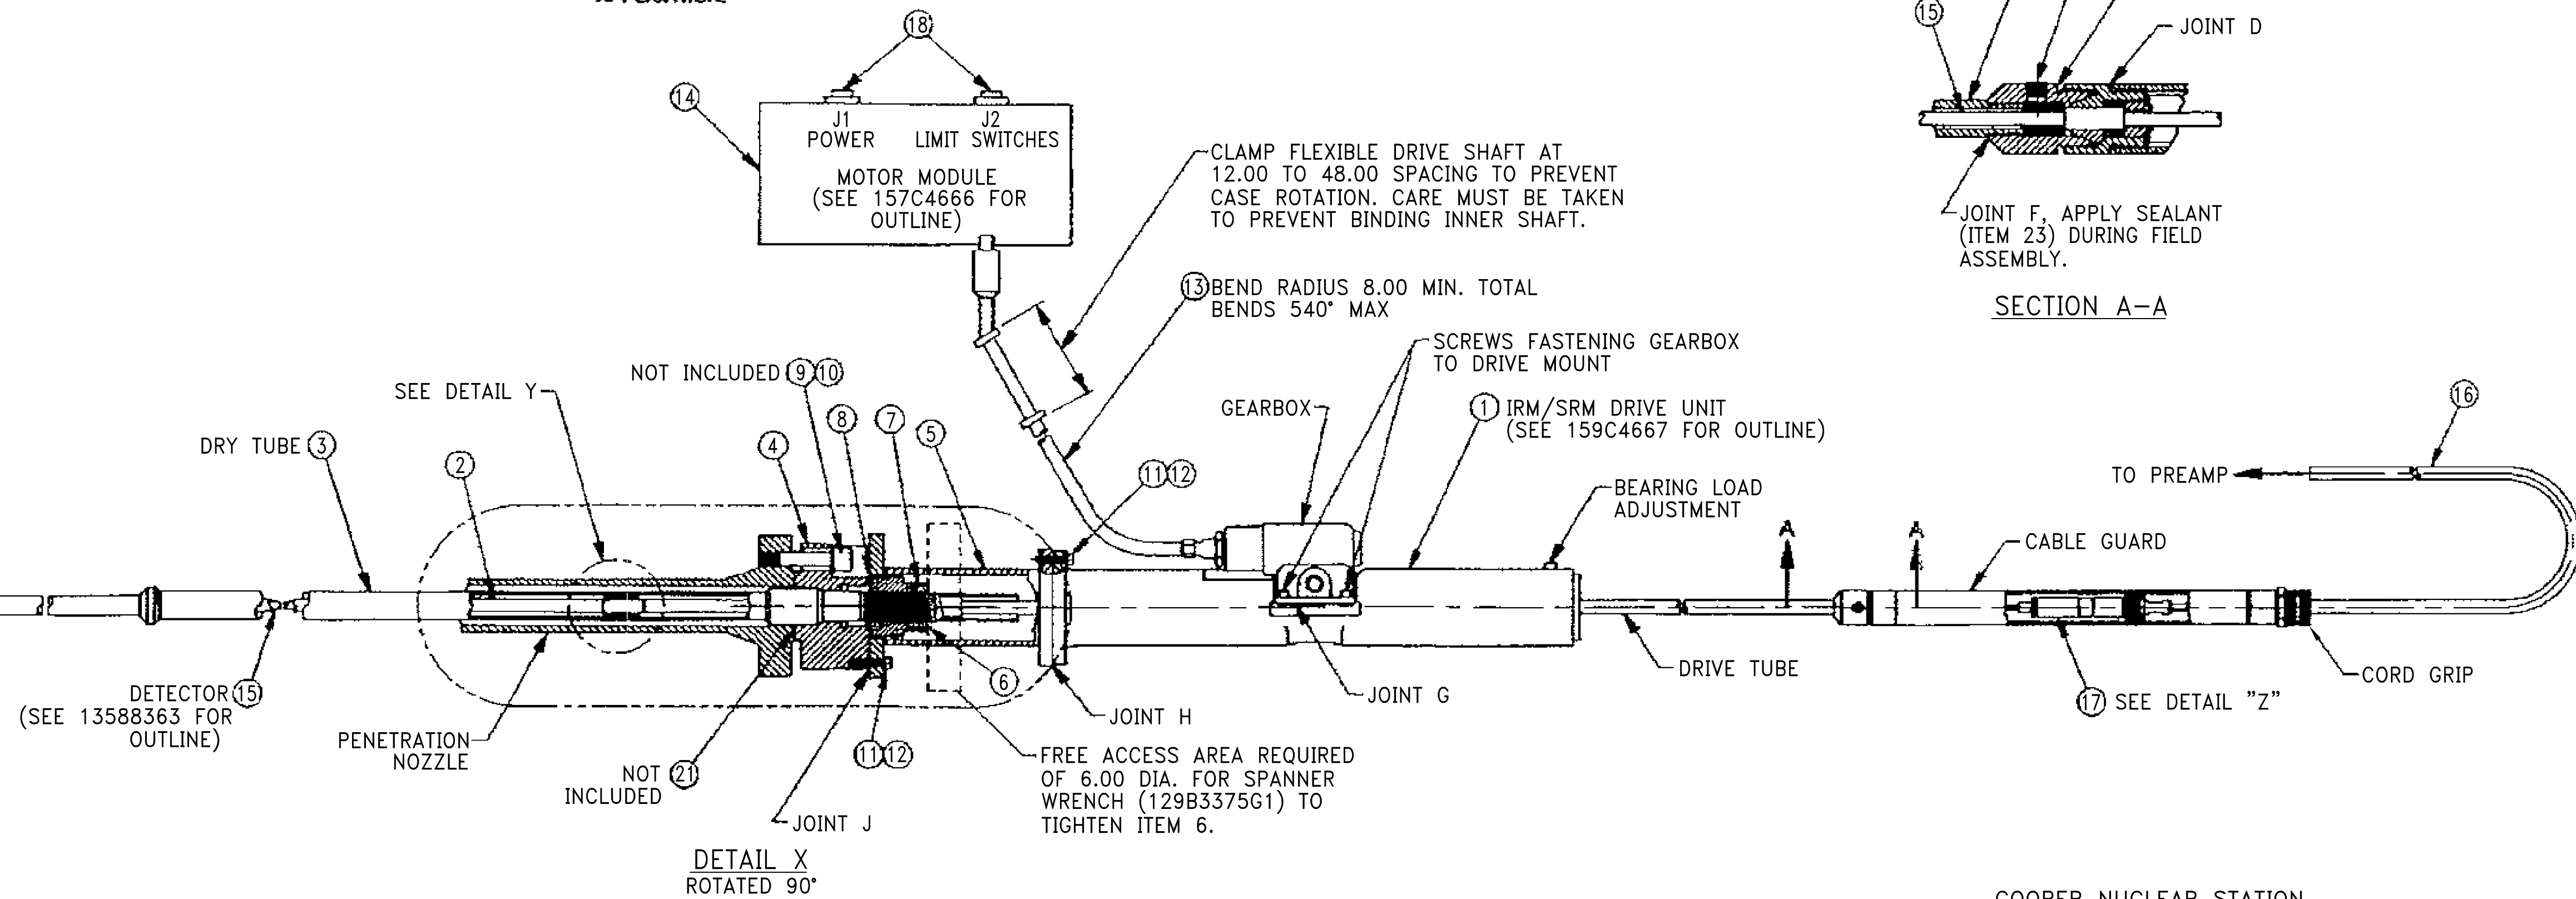

COOPER NUCLEAR STATION

453007347

SCAN/CADD DWG


DO NOT REVISE MANUALLY

CADD FILE: C0047197


INFORMATION ONLY


ITEM NO.	QTY REQD	PART OR IDENT NO	NOMENCLATURE OR DESCRIPTION
LIST OF MATERIAL OR PARTS			
<div> <div>           UNLESS OTHERWISE SPECIFIED            DIMENSIONS ARE IN INCHES AND            DECIMALS ARE AS FOLLOWS:            SURFACE FINISH: 30 INCHES            TOLERANCES: XXX            ANGULAR: 300K         </div> <div>           DATE: 6-13-68            BY: M. TAYLOR            CHECKED: M. TAYLOR            APPROVED: R. C. RYAN            APPROVED: N/A         </div> </div>			
INCORE STARTUP CHAMBER RETRACT MECHANISM (FIELD INSTALLATION) SIZE: D SCALE: D.N.S.			SHEET: 1 REV: NO.3

NO.	REVISIONS	DFT	CKD	APP	DATE
NO.1	VENDOR MANUAL REVIEW (DCN 02-0023)	RR	DUF	KG	2-13-68
NO.3	TE-10645114 (DCN 09-0253)	RC	DUF	KZ	11-4-10

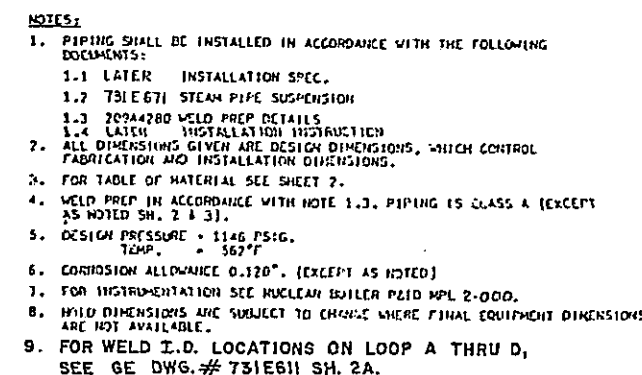


LEGEND:

 INDICATES PIPE SPOOL HANGER


 INDICATES FIELD WELD DESIGNATIONS ARE TO BE USED FOR NON-DESTRUCTIVE EXAMINATION RECORDS).

T.L. INDICATES TANGENT LINE.

 INDICATES FIELD WELD THAT DOES NOT REQUIRE NON-DESTRUCTIVE EXAMINATION RECORDS.

W.P. INDICATES WORK POINT.

PLAN VIEW  
PRIMARY STEAM PIPING  
24" O.D. (NOM.)

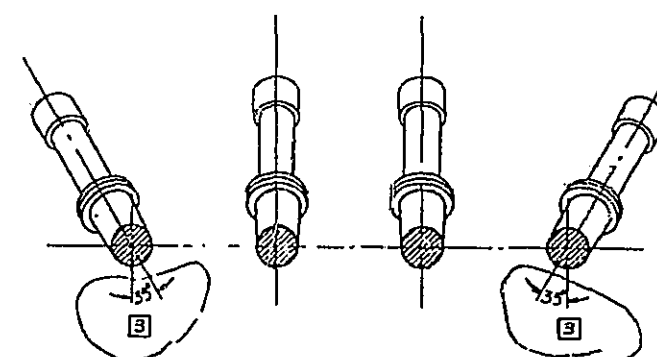

SECTION D-D  
WOLFE ORIENTATION  
INTERIOR ONLY

COOPER STATION  
MPL 2-190  
JAN 25 1964

**THIS IS A  
REDUCED PRICE**


452005404

NO4	REV. PER. DCN 89-4017	RAC	SW	MAH	11-10-89
NO3	REV. PER. DCN 86-331	WAB	BS	MAH	7/25/86
NO2	REV. PER. DCN 79-338	SGH	DES	MAH	6/28/79
	FOR INFO. ONLY				
NO1	DCN 79-351 AS B/LT M/G	RH	ALT	MAH	4/25/77
NO.	REVISIONS	BY	CHK	APP	DATE
ALL FUTURE REVISIONS BY NPDD					

[illegible]





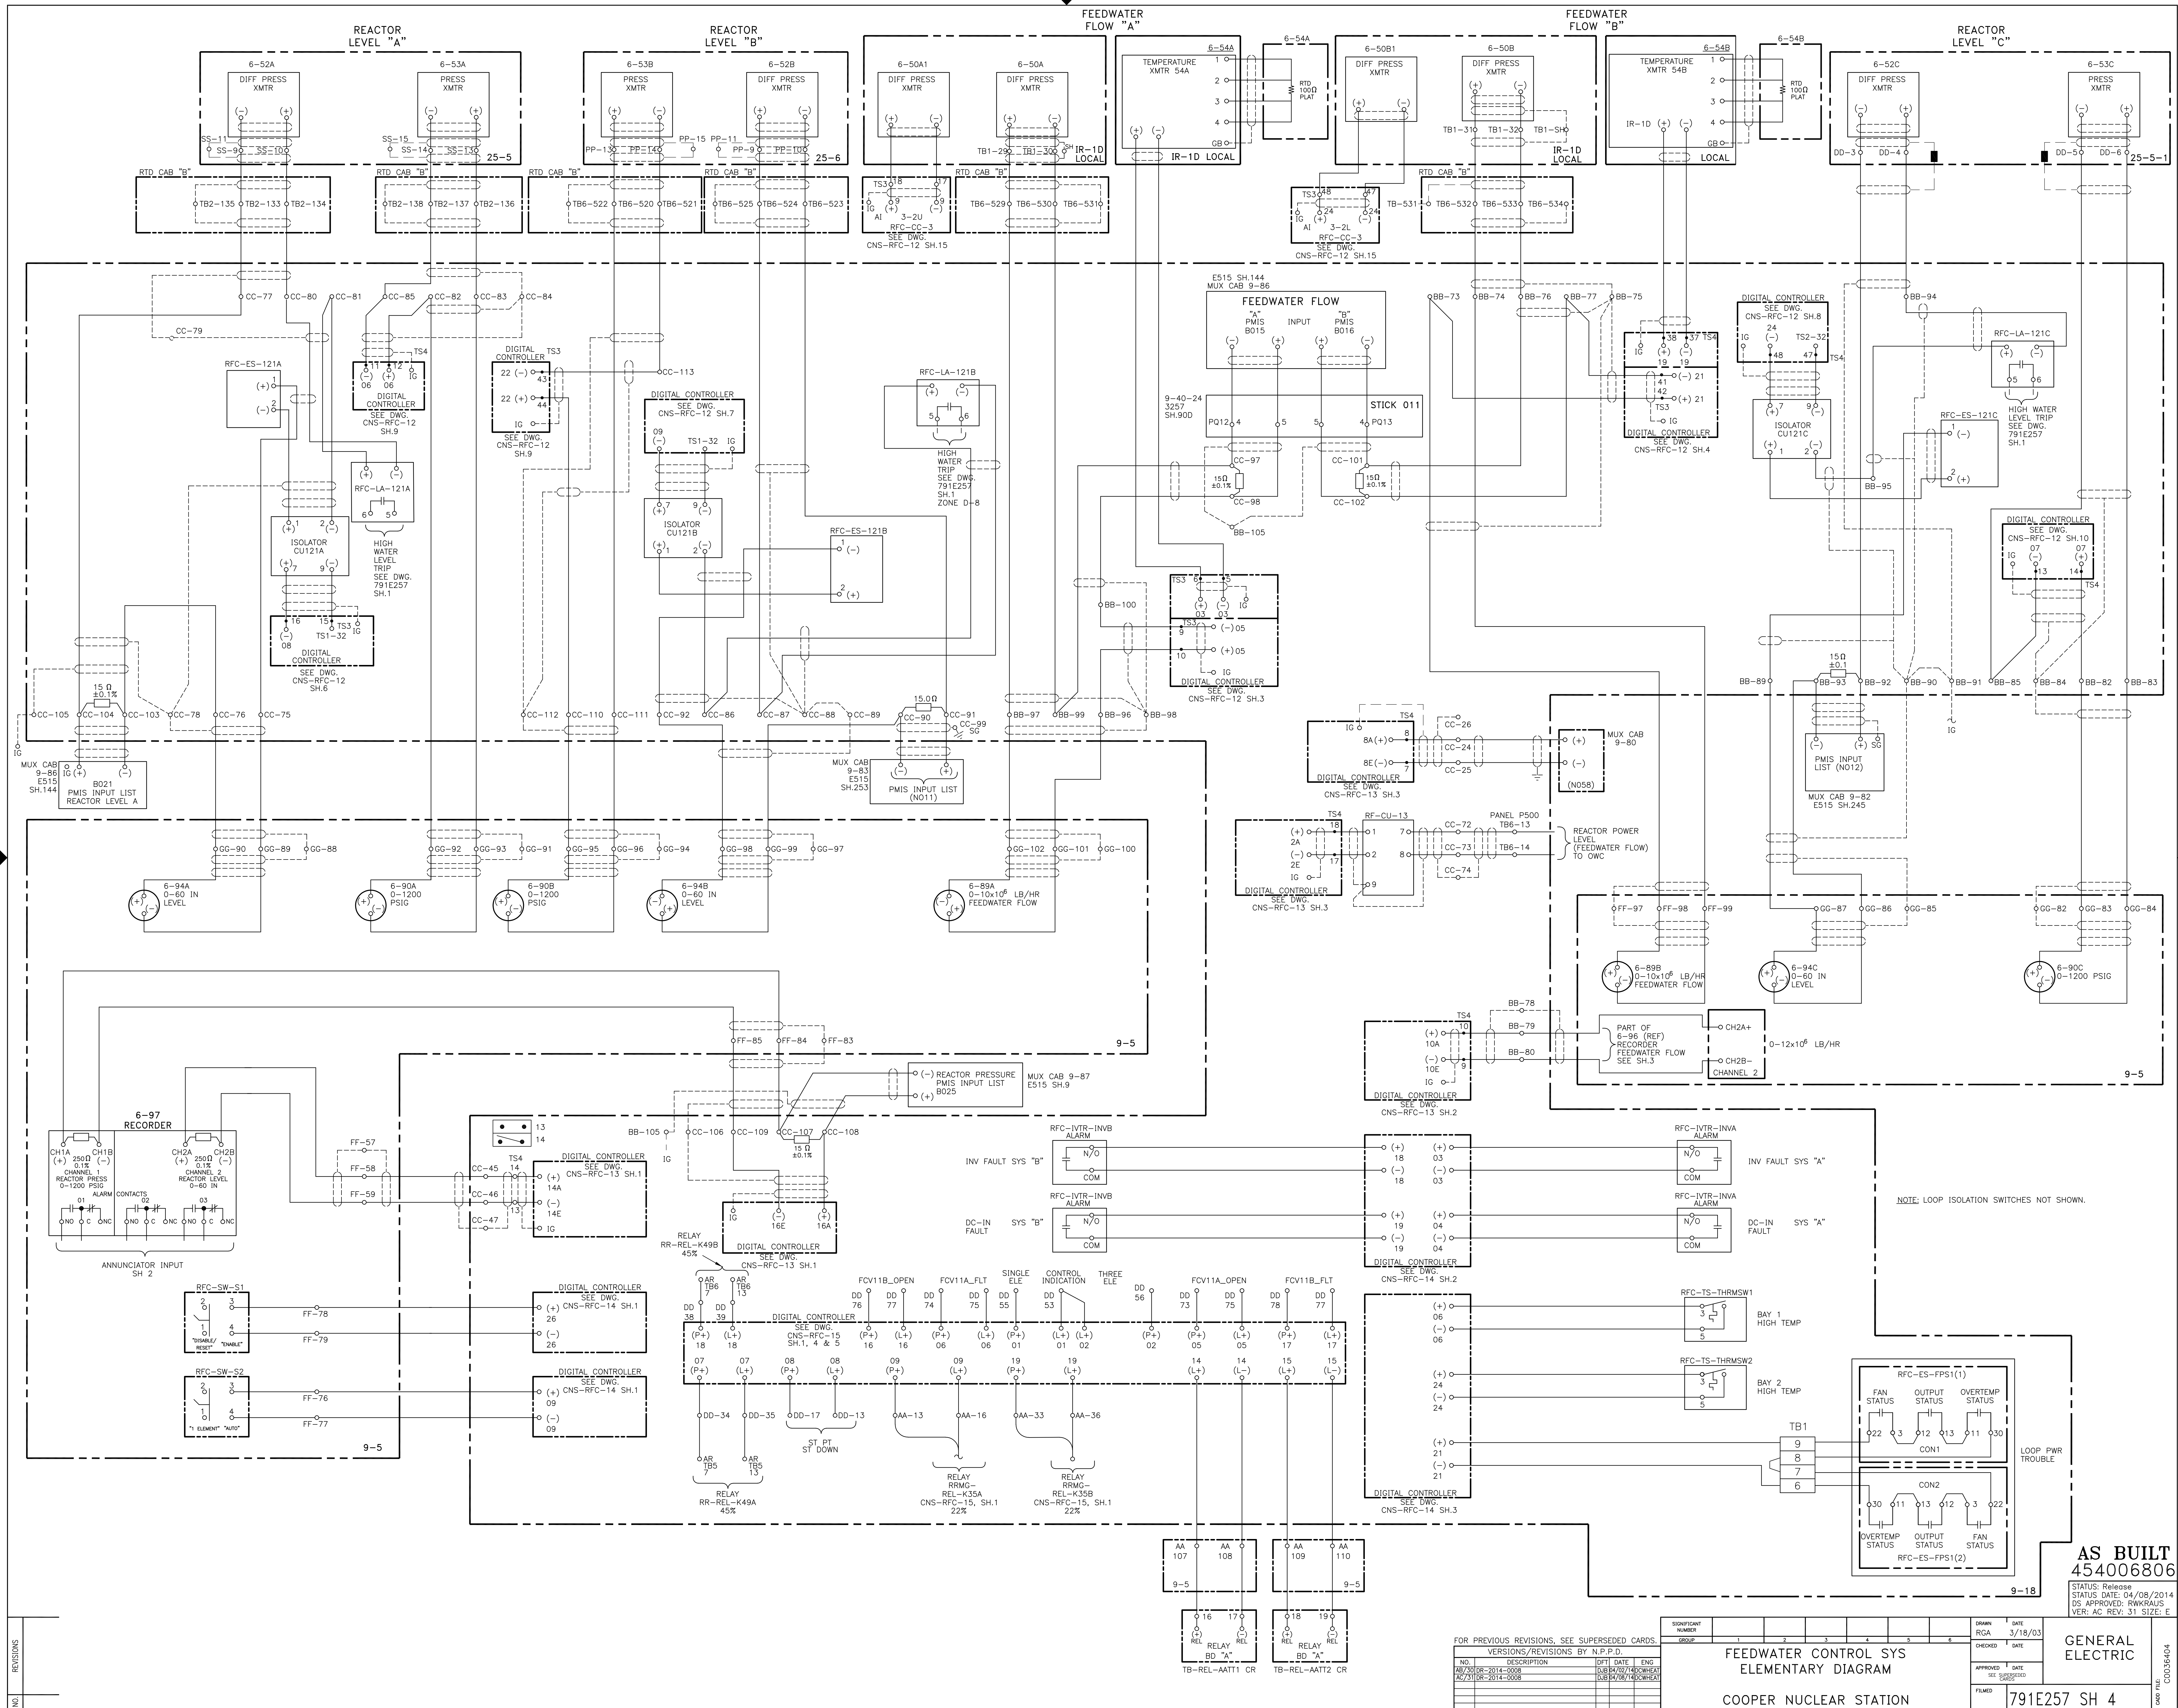




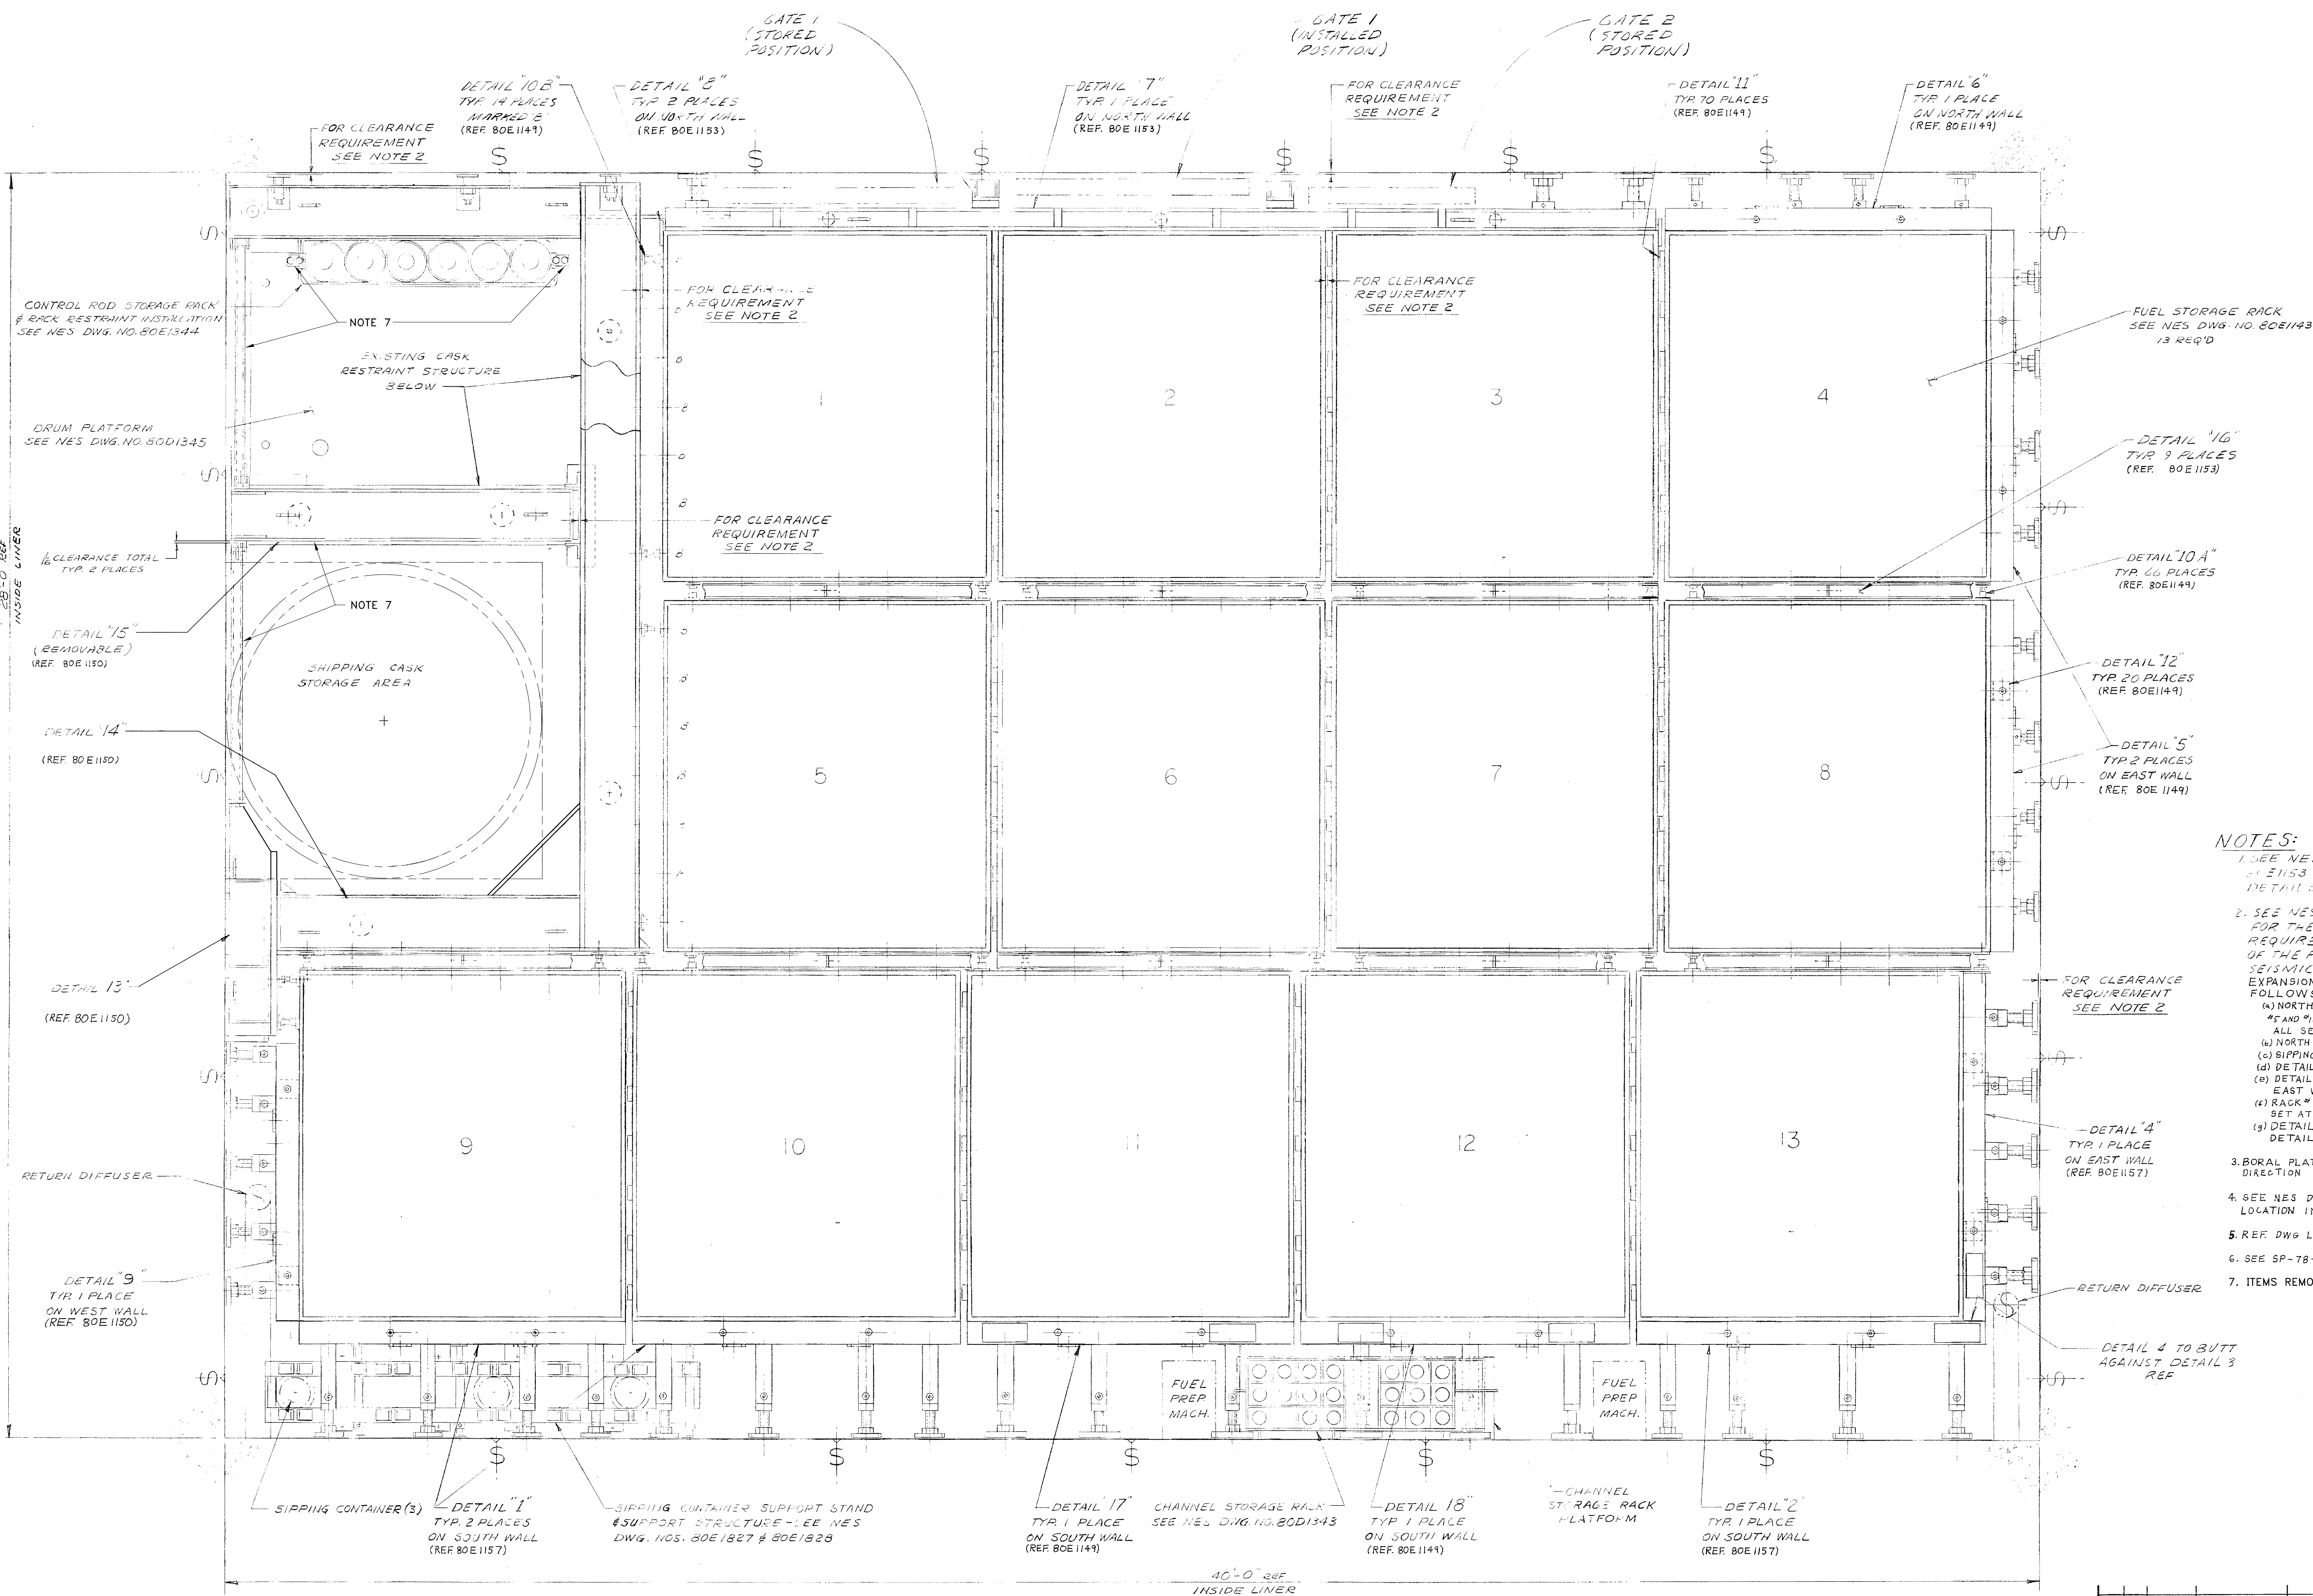


27	13	NOTE 11	BOE1144-27	PCISON CURTAIN-TYPE 2	2
26	13	NOTE 11	BOE1144-26	PCISON CURTAIN-TYPE 1	1
15	18		BOE1144-25	STORAGE CELL	
24	18		BOE1144-24	SUPPORT COLLAR	
23	8			RECT BAR, 1/2"x6"x20" LG	
22	8			RECT BAR, 1/2"x5"x51 3/4" (REF) LG	
21	9			RECT BAR, 1/2"x5"x54 1/4" (REF) LG	
20	4			RECT BAR, 1/2"x5"x76 1/8" (REF) LG	
19	4			RECT BAR, 1/2"x5"x82 1/8" (REF) LG	
18	2			RECT BAR, 1/2"x5"x85 1/8" LG	
17	2			RECT BAR, 1/2"x5"x91 3/4" LG	
16	4			RECT BAR, 1/2"x5"x111 1/8" (REF) LG	
15	4			RECT BAR, 1/2"x5"x116 1/8" (REF) LG	
14	4			C, 5"x5"x1/2"x150 1" (REF) LG	
13	12		-13	SUPPORT CHANNEL	
12	1		-12	SUPPORT PLATE-TYPE 2	
11	6		-11	SUPPORT PLATE-TYPE 1	
10	6		-10	BOTTOM RIB-TYPE 3	
9	13		-9	BOTTOM RIB-TYPE 2	
8	6		-8	BOTTOM RIB-TYPE 1	
7	2		-7	BOTTOM SIDE PLATE-TYPE 2	
6	2		-6	BOTTOM SIDE PLATE-TYPE 1	
5	13		-5	TOP RIB-TYPE 2	
4	12		-4	TOP RIB-TYPE 1	
3	2		-3	TOP SIDE PLATE-TYPE 2	
2	2	NOTE 3	BOE1144-2	TOP SIDE PLATE-TYPE 1	
				FUEL STORAGE RACK	
ITEM	QTY	MAT'L	PART NUMBER	DESCRIPTION	4504043166
PARTS LIST					
SIGNATURES		DATE		AUTOMATION INDUSTRIES, INC. NUCLEAR ENERGY SERVICES	
DRAWN LOU ZEEZA		6-30-76			
CHECKED		9-15-76			
MECH DESG. <i>Handwritten initials</i>		9-16-76			
STRUCT ENG. <i>Handwritten initials</i>		10-1-76			
DESIGN HYD. <i>Handwritten initials</i>		5-1-76			
NUC. ENG. <i>Handwritten initials</i>		5-1-76			
PROC HIGH <i>Handwritten initials</i>		10-1-76			
V.P. ENG. <i>Handwritten initials</i>		10-5-76			
C.A. MGR. <i>Handwritten initials</i>		10-5-76			
N.P.P.D. <i>Handwritten initials</i>		10-7-76			
TITLE		SIZE		REV	
E		78446		BOE1143	
SCALE		NOTED		PROJ: 5110-200	
SHEET				J01	



THIS DRAWING CONTAINS CONFIDENTIAL INFORMATION AND IS SUPPLIED BY AUTOMATION INDUSTRIES INC. THE OWNER OF SUCH INFORMATION, IN ACCEPTING THE DRAWING, AGREES THAT IT IS FOR THE USER'S SOLE USE, THAT IT WILL NOT BE REPRODUCED OR DISTRIBUTED TO OTHERS, AND THAT THE DRAWING OR THE INFORMATION CONTAINED THEREIN WILL NOT BE USED IN ANY MANNER DETRIMENTAL TO AUTOMATION INDUSTRIES INC.

REVISIONS					
ZONE	NO.	DESCRIPTION	DWN	CHKD	DATE
ALL	1	CRA NO. 218	JDH	10/17/77	2-4-77
ALL	2	CRA NO. 226	JDH	10/17/77	3-10-77
ALL	3	CRA NO. 300	JDH	10/17/77	9-8-77
57	4	CRA NO. 493	JDH	10/17/77	7-26-77



- NOTES:**
- SEE NES DRAWINGS NO. 80E1149, 80E1150, 80E1153 AND 80E1157 FOR SEISMIC BRACING DETAILS "1" THRU "13"
  - SEE NES SPECIFICATION NO. 80A1279 FOR THE PROCEDURE AND ADDITIONAL REQUIREMENTS FOR THE INSTALLATION OF THE FUEL STORAGE RACKS AND SEISMIC BRACING DETAILS. THERMAL EXPANSION GAPS SET PER SP-78-13 ARE AS FOLLOWS:  
(a) NORTH WALL & RACKS 1, 2, 3, 4; RACK #4 AND #8; RACK #5 AND #10; RACK #6 AND #11; RACK #7 AND #13; RACK #9; ALL SET AT .140"  
(b) NORTH WALL AND DETAIL 14 SET AT .080"  
(c) SHIPPING STAND AND RACK #9, #10 SET AT 1/16"  
(d) DETAIL 14 AND RACK #4, #10, SET AT .180"  
(e) DETAIL 14 AND RACK #10, #11, #5; RACK #8 AND EAST WALL; ALL SET AT 7/32"  
(f) RACK #9 AND WEST WALL; RACK #13 AND EAST WALL; SET AT 9/32"  
(g) DETAIL 14 AND DETAIL 15, DETAIL 7 AND DETAIL 8 SET AT 1/4"
  - BORAL PLATES ARE ALIGNED IN THE EAST-WEST DIRECTION
  - SEE NES DWG. 80E1158 FOR SPENT FUEL CELL LOCATION INDEXING
  - REF. DWG. LECK #10
  - SEE SP-78-13 FOR INSTALLATION DETAIL
  - ITEMS REMOVED PER CED 6016920.

INFORMATION ONLY  
454043171


SCAN/CADD DWG  
DO NOT REVISE MANUALLY  
CADD FILE: C0070954

FOR PREVIOUS REVISIONS, SEE SUPERSEDED CARDS.					
NO.	REVISIONS	DATE	CHKD	APP	DATE
NO. 1	6016920 (DCN 06-0568)	01/11/78	JDH	JDH	01/11-5-78

SIGNATURES		DATE	
DRAWN	JOE HORNAK	6-11-75	
CHECKED	W. HATCH, JR.	10-1-76	
MECH. DES.	10-1-76		
STRUCT. ENG.	10-1-76		
THERM. HYD.	10-1-76		
NUC. ENG.	10-1-76		
PROJ. MGR.	10-1-76		
V.P. ENG.	10-1-76		
G.A. MGR.	10-1-76		
N.P.P.D.	10-1-76		

ITEM	QTY	CODE IDENT	PART NUMBER	DESCRIPTION
PARTS LIST				
AUTOMATION INDUSTRIES, INC. NUCLEAR ENERGY SERVICES				
TITLE: FUEL STORAGE RACK(13) AND SEISMIC BRACING INSTALLATION IN POOL				
SIZE	CODE IDENT NO.	CRAWLING NO.	REV	
E	78446	80E1148	N03	
SCALE: 3/4"=1'-0" PROJ: 5110-200 SHEET				



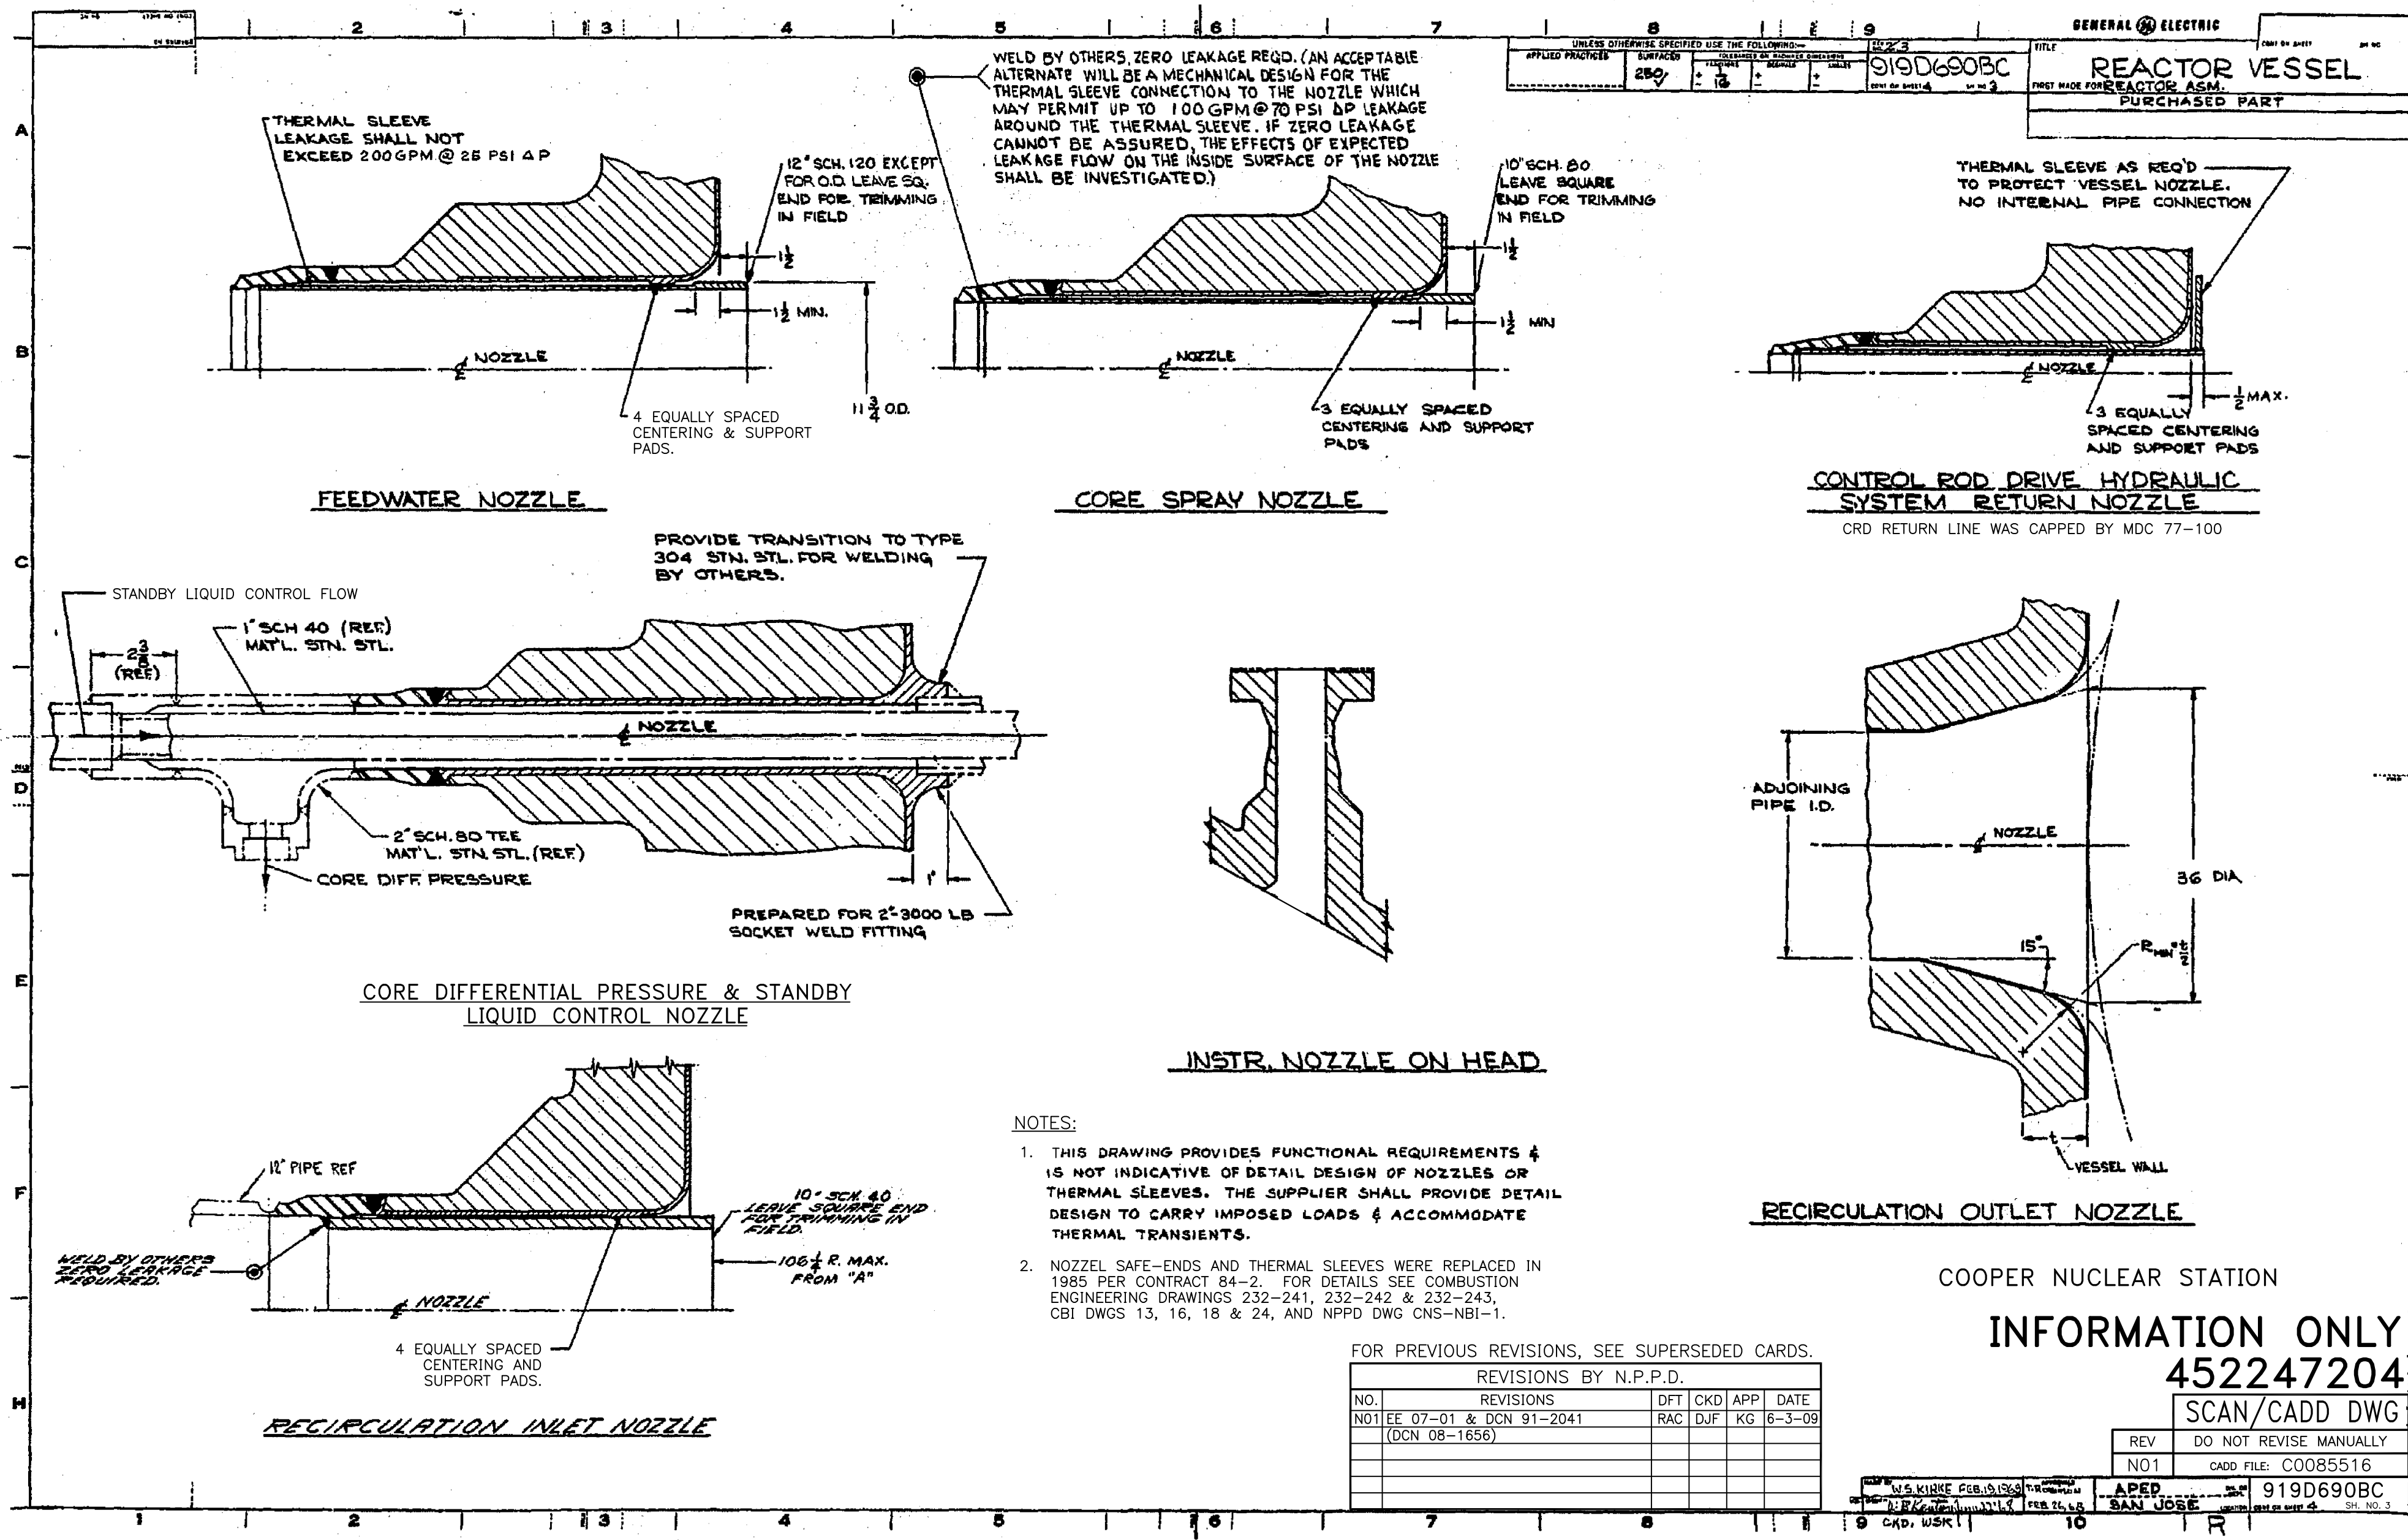

WELD BY OTHERS, ZERO LEAKAGE REQ'D. (AN ACCEPTABLE ALTERNATE WILL BE A MECHANICAL DESIGN FOR THE THERMAL SLEEVE CONNECTION TO THE NOZZLE WHICH MAY PERMIT UP TO 100 GPM @ 70 PSI ΔP LEAKAGE AROUND THE THERMAL SLEEVE. IF ZERO LEAKAGE CANNOT BE ASSURED, THE EFFECTS OF EXPECTED LEAKAGE FLOW ON THE INSIDE SURFACE OF THE NOZZLE SHALL BE INVESTIGATED.)

THERMAL SLEEVE AS REQ'D TO PROTECT VESSEL NOZZLE. NO INTERNAL PIPE CONNECTION

FEEDWATER NOZZLE

CORE SPRAY NOZZLE

CONTROL ROD DRIVE HYDRAULIC SYSTEM RETURN NOZZLE

CRD RETURN LINE WAS CAPPED BY MDC 77-100

CORE DIFFERENTIAL PRESSURE & STANDBY LIQUID CONTROL NOZZLE

INSTR. NOZZLE ON HEAD

RECIRCULATION OUTLET NOZZLE

RECIRCULATION INLET NOZZLE

NOTES:

1. THIS DRAWING PROVIDES FUNCTIONAL REQUIREMENTS & IS NOT INDICATIVE OF DETAIL DESIGN OF NOZZLES OR THERMAL SLEEVES. THE SUPPLIER SHALL PROVIDE DETAIL DESIGN TO CARRY IMPOSED LOADS & ACCOMMODATE THERMAL TRANSIENTS.
2. NOZZLE SAFE-ENDS AND THERMAL SLEEVES WERE REPLACED IN 1985 PER CONTRACT 84-2. FOR DETAILS SEE COMBUSTION ENGINEERING DRAWINGS 232-241, 232-242 & 232-243, CBI DWGS 13, 16, 18 & 24, AND NPPD DWG CNS-NBI-1.

FOR PREVIOUS REVISIONS, SEE SUPERSEDED CARDS.


REVISIONS BY N.P.D.					
NO.	REVISIONS	DFT	CKD	APP	DATE
N01	EE 07-01 & DCN 91-2041 (DCN 08-1656)	RAC	DJF	KG	6-3-09


COOPER NUCLEAR STATION  
INFORMATION ONLY  
452247204

SCAN/CADD DWG

REV DO NOT REVISE MANUALLY  
N01 CADD FILE: C0085516

W.S. KIRKE FEB. 19. 1968  
APED SAN JOSE 919D690BC  
CADD, WSK 10 R

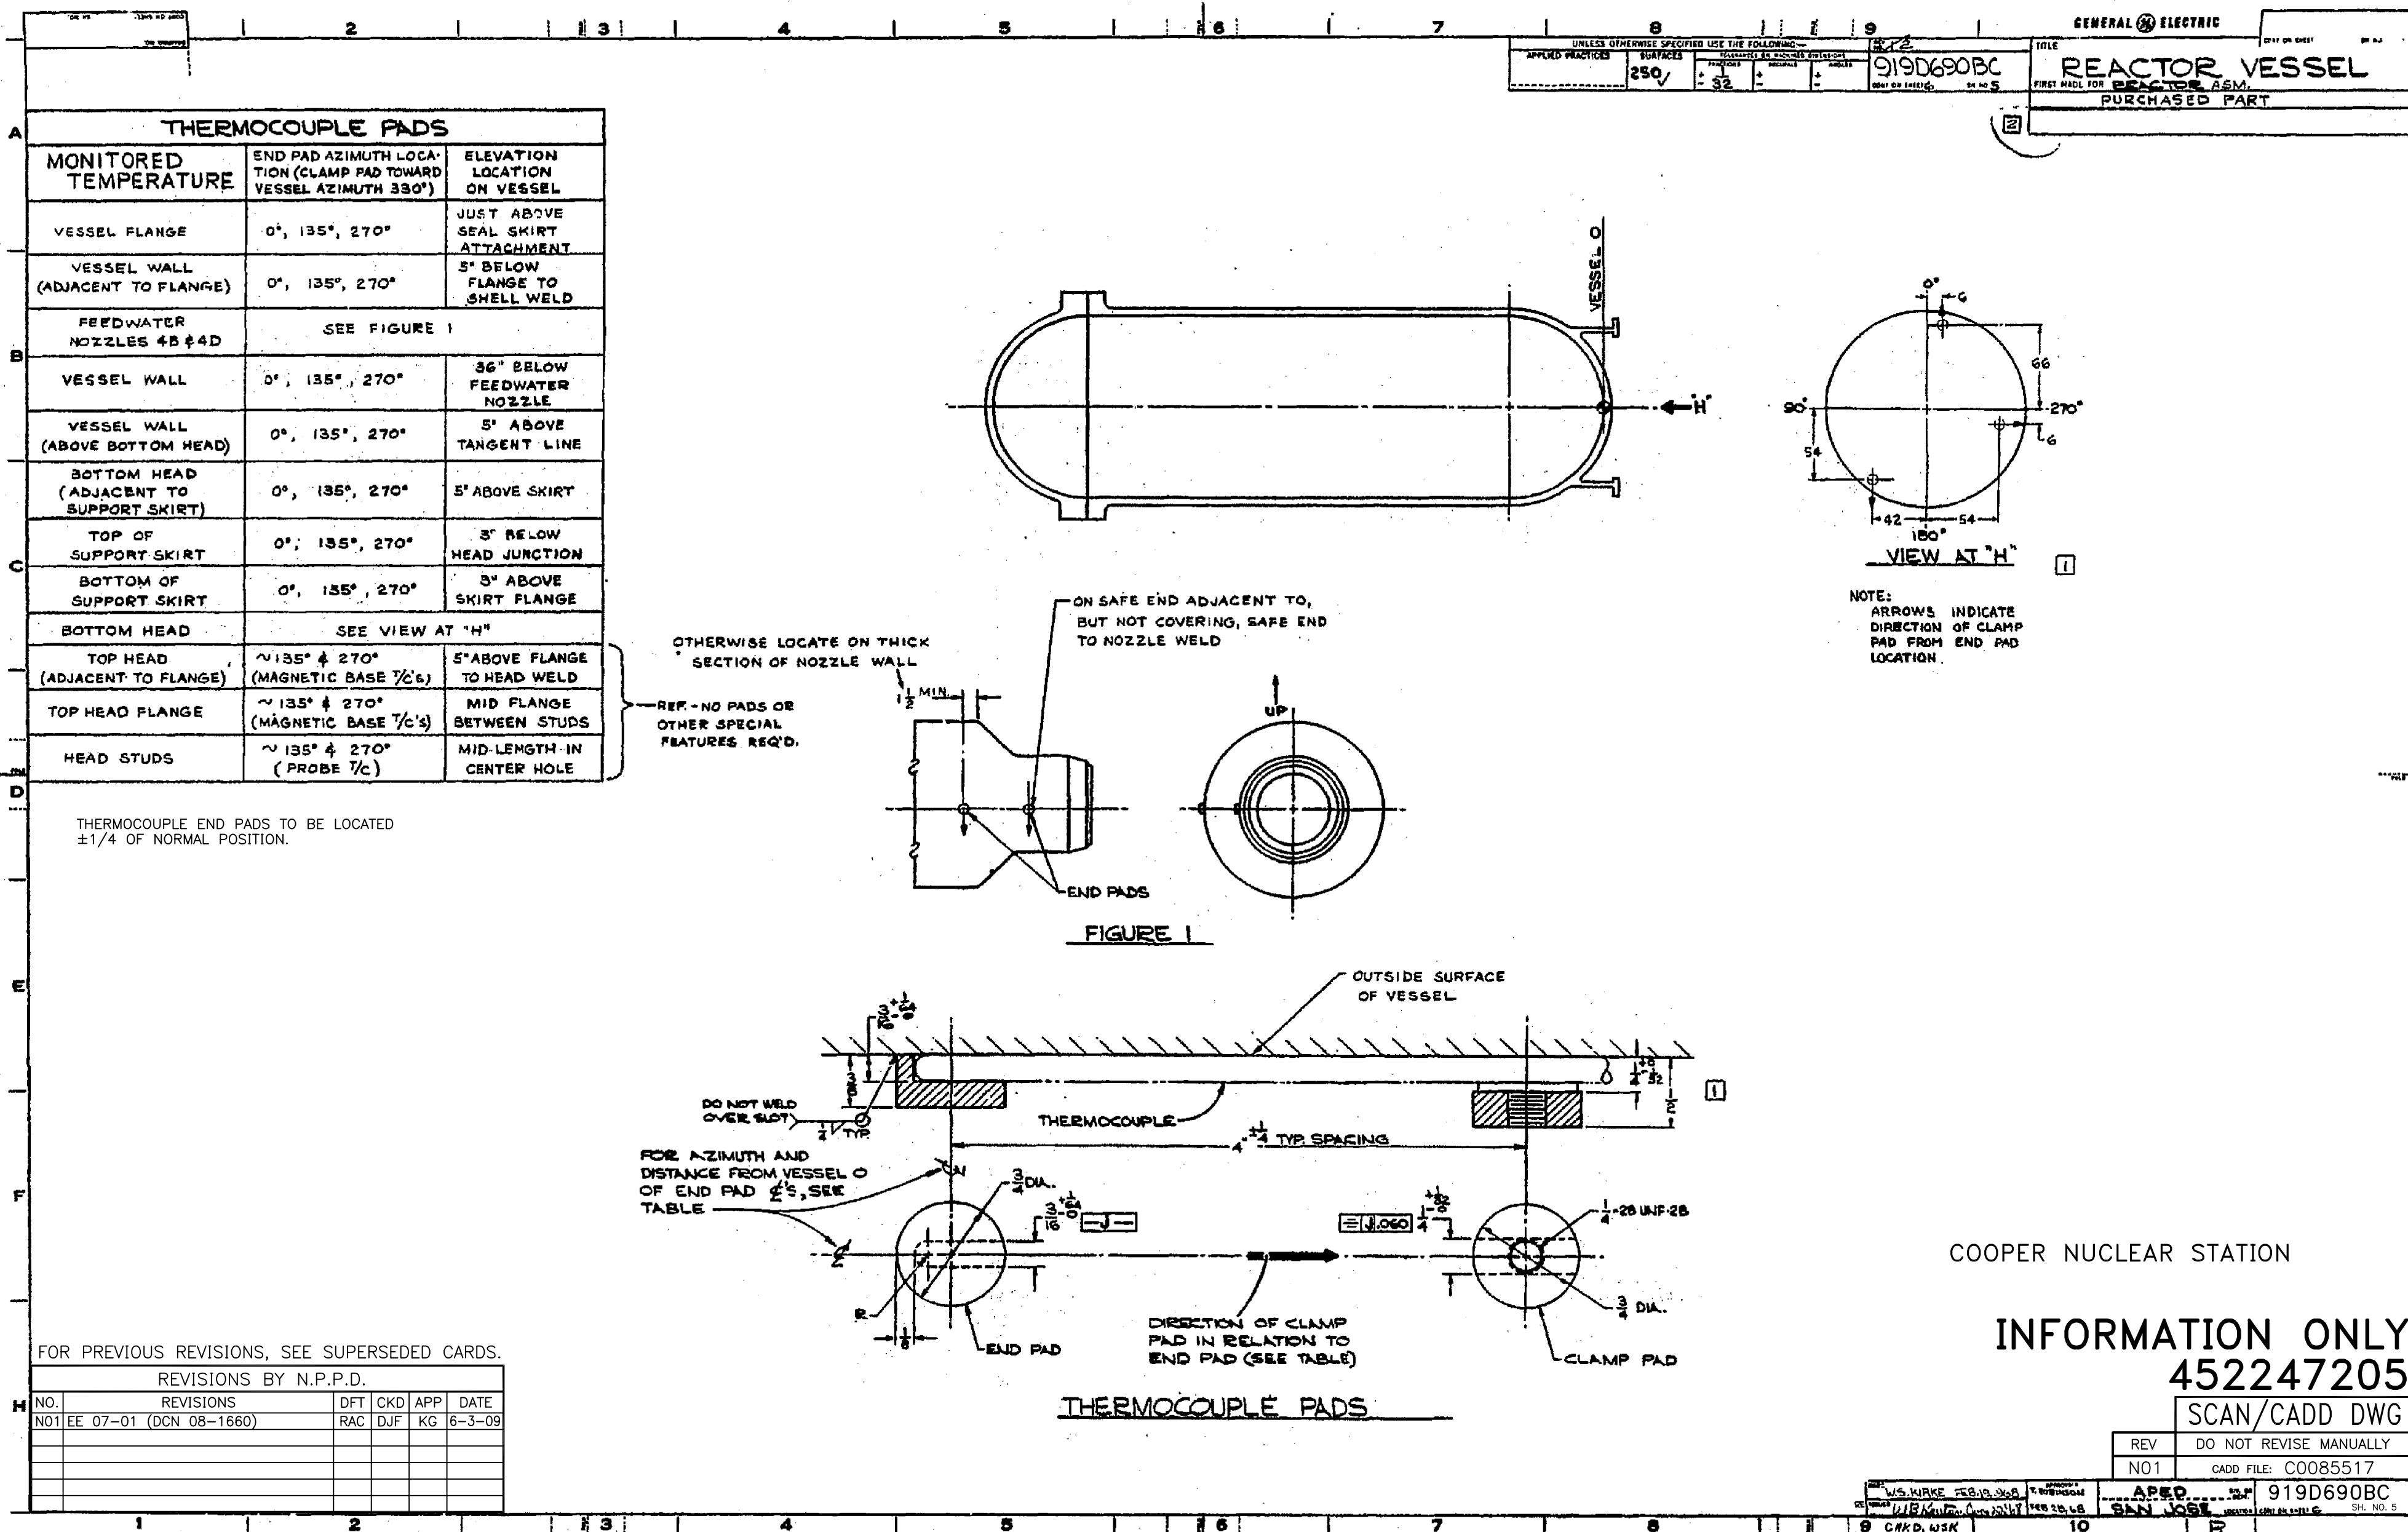


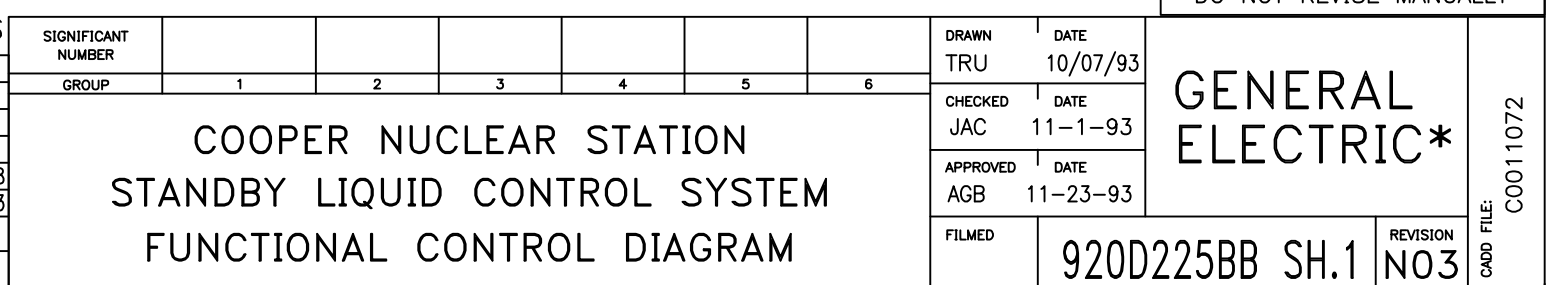







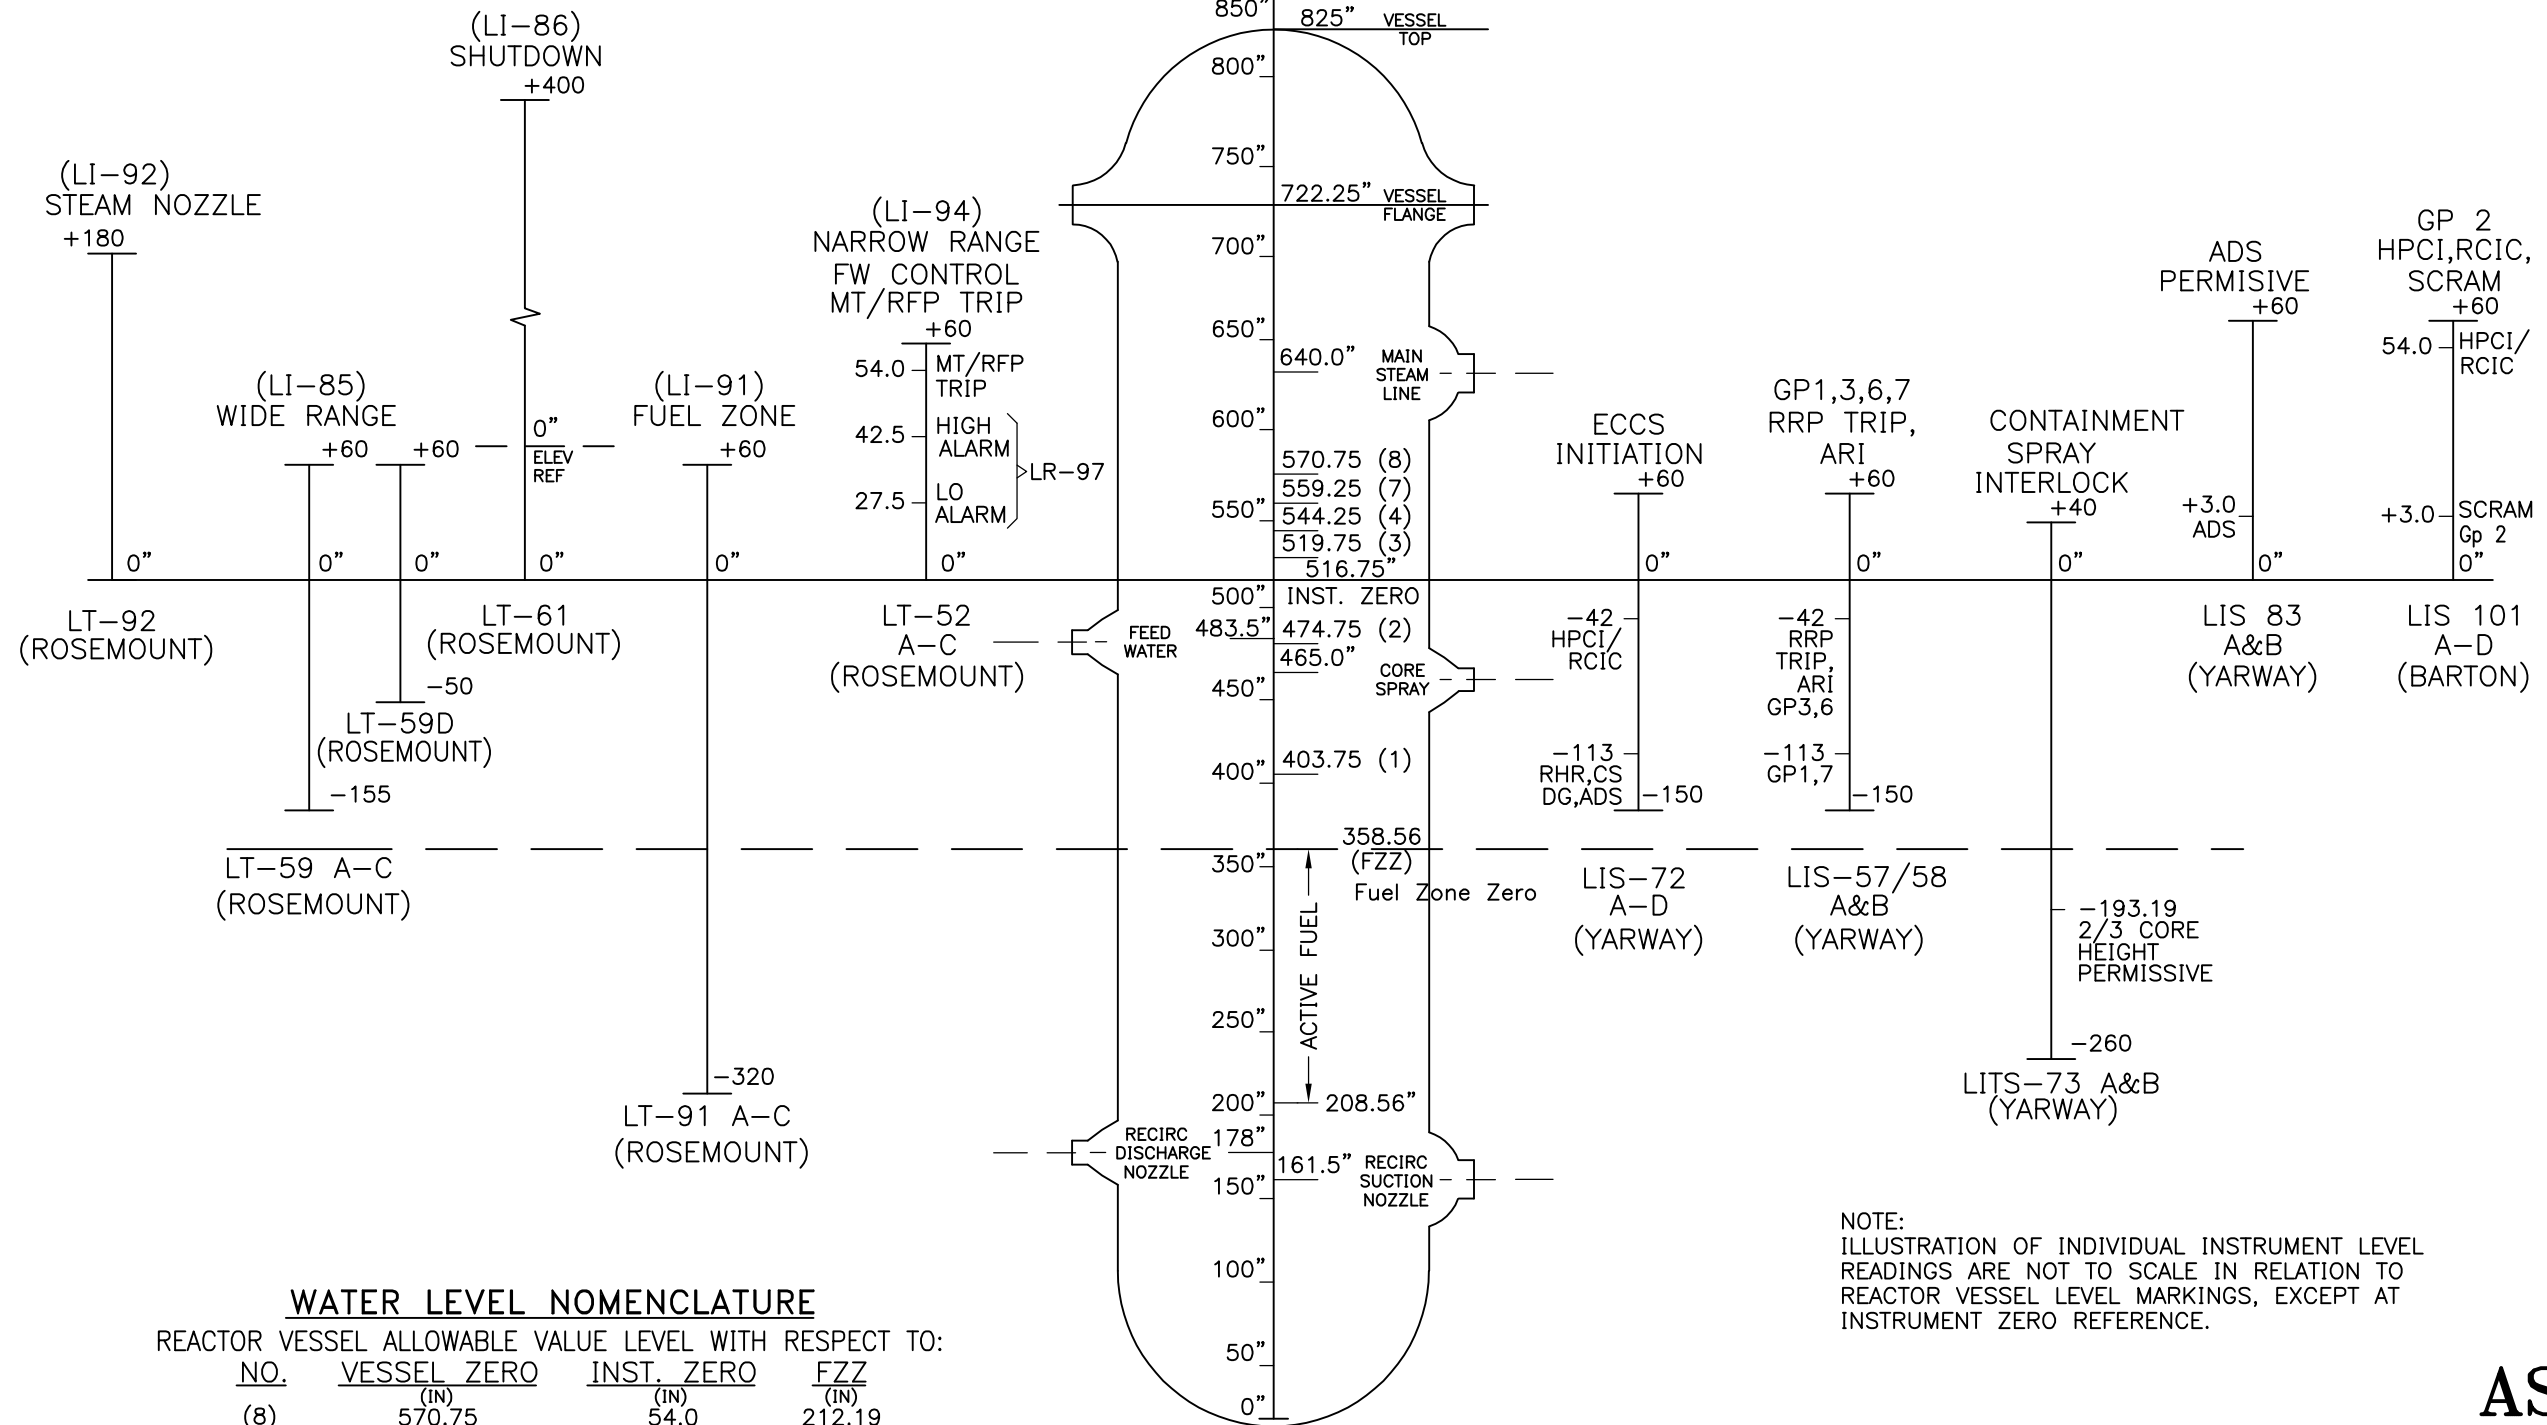


WATER LEVEL NOMENCLATURE			
REACTOR VESSEL ALLOWABLE VALUE LEVEL WITH RESPECT TO:			
NO.	VESSEL ZERO (IN)	INST. ZERO (IN)	FZZ (IN)
(8)	570.75	54.0	212.19
(7)	559.25	42.5	200.69
(4)	544.25	27.5	185.69
(3)	519.75	3.0	161.19
(2)	474.75	-42.0	116.19
(1)	403.75	-113.0	45.19

ELEVATION 917'-0"  
VESSEL BOTTOM

FOR PREVIOUS REVISIONS, SEE SUPERSEDED CARDS.

REVISIONS BY N.P.P.D.					
NO.	REVISIONS	DFT	CKD	APP	DATE
N03	N/A (DCN 05-1259)	RAC	JAC	KG	1-10-06
N04	CR 2006-06944 (DCN 06-1570)	KG	DJB	DLR	2-7-07
N05	CED 6010820 (DCN 04-0608)	RAC	DLR	KG	5-19-08
N06	CED 6024445 (DCN 08-0030)	MTK	DLR	KG	8-11-08

SIGNIFICANT NUMBER						
GROUP	1	2	3	4	5	6
COOPER NUCLEAR STATION REACTOR WATER LEVEL INDICATION CORRELATION						

DRAWN PAM	DATE 9/24/98	 Nebraska Public Power District	CADD FILE: C0026002
CHECKED AJH	DATE 2-9-99		
APPROVED PS	DATE 2-9-99		
FILMED			
CNS-NBI-10		REVISION N06	


AS BUILT  
451243784

CADD DRAWING

DO NOT REVISE MANUALLY

NO.	REVISIONS
N00	RDC 2-17-99 PS 2-17-99



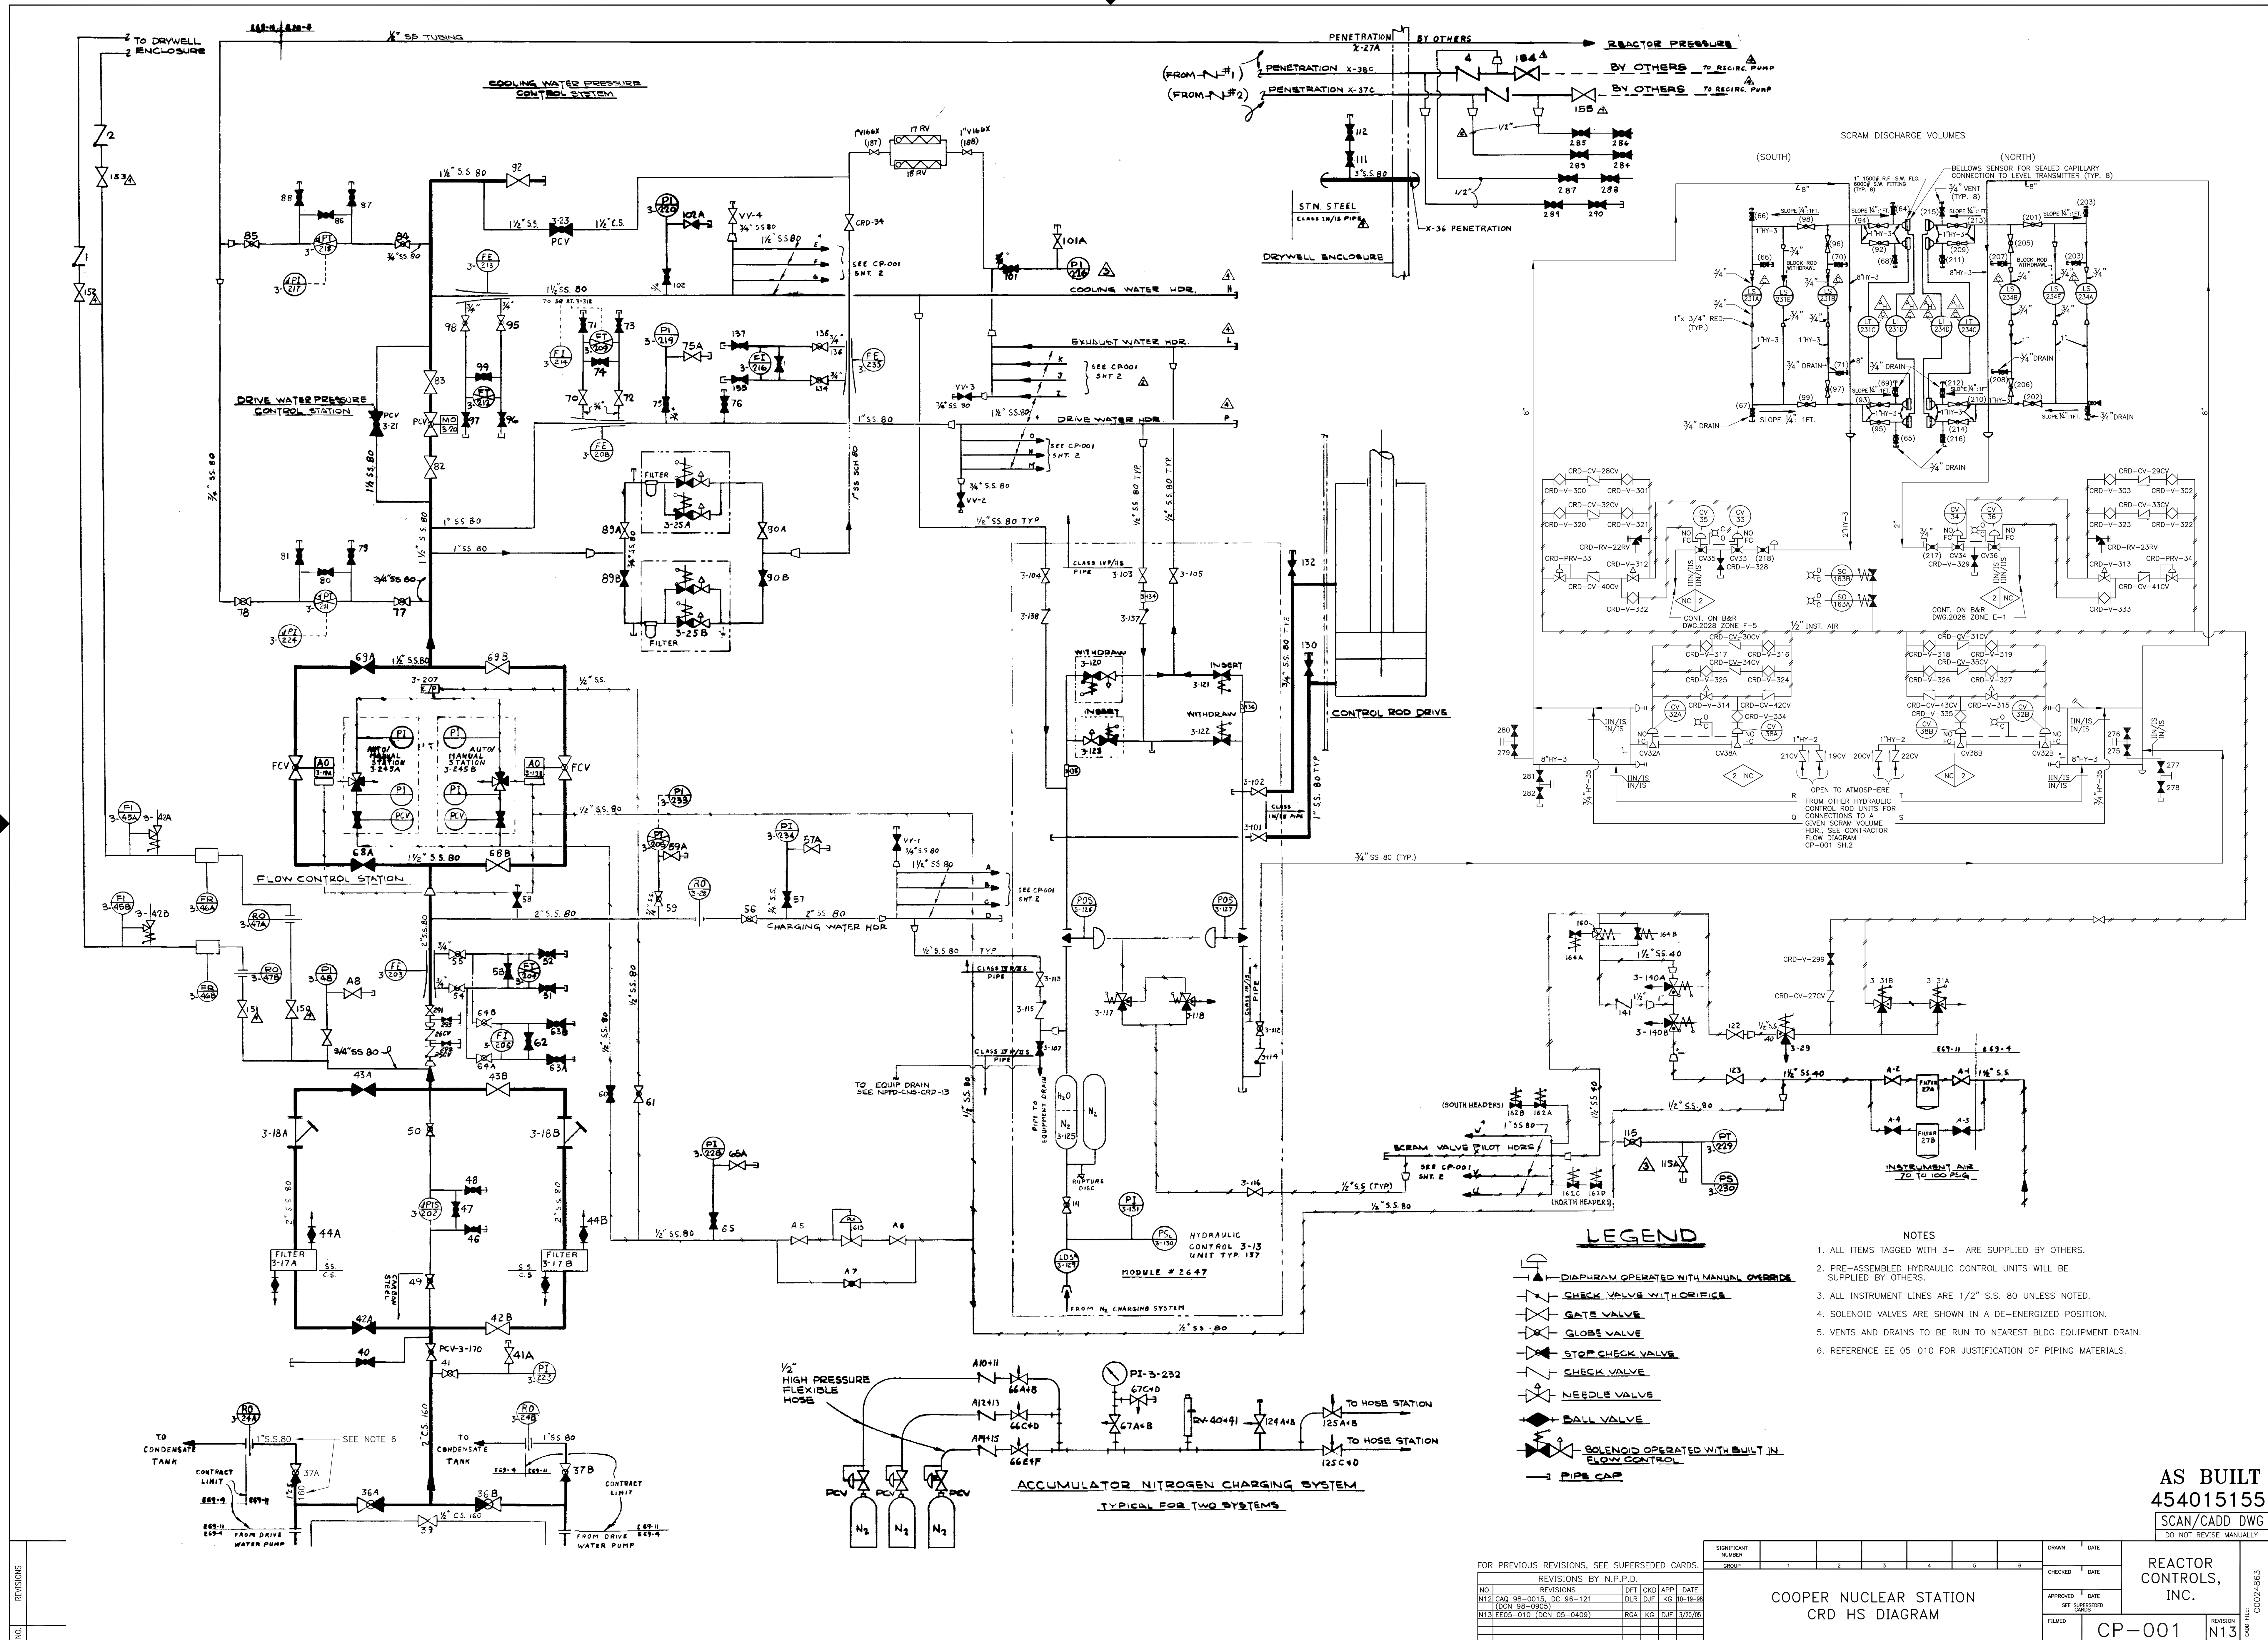

LEGEND

- DIAPHRAM OPERATED WITH MANUAL OVERRIDE
- CHECK VALVE WITH ORIFICE
- GATE VALVE
- GLOBE VALVE
- STOP CHECK VALVE
- CHECK VALVE
- NEEDLE VALVE
- BALL VALVE
- SOLENOID OPERATED WITH BUILT IN FLOW CONTROL
- PIPE CAP

NOTES

- ALL ITEMS TAGGED WITH 3- ARE SUPPLIED BY OTHERS.
- PRE-ASSEMBLED HYDRAULIC CONTROL UNITS WILL BE SUPPLIED BY OTHERS.
- ALL INSTRUMENT LINES ARE 1/2" S.S. 80 UNLESS NOTED.
- SOLENOID VALVES ARE SHOWN IN A DE-ENERGIZED POSITION.
- VENTS AND DRAINS TO BE RUN TO NEAREST BLDG EQUIPMENT DRAIN.
- REFERENCE EE 05-010 FOR JUSTIFICATION OF PIPING MATERIALS.

AS BUILT  
454015155  
SCAN/CADD DWG

REACTOR  
CONTROLS,  
INC.

CP-001  
N13

COOPER NUCLEAR STATION  
CRD HS DIAGRAM


FOR PREVIOUS REVISIONS, SEE SUPERSEDED CARDS.			
REVISIONS BY N.P.D.			
NO.	REVISIONS	DATE	DATE
N12	CAD 98-0015, DC 98-121	DLR	10-19-98
N13	EE05-010 (DCN 05-0499)	RGA	3/20/03

SIGNIFICANT NUMBER		DRAWN		DATE	
1	2	3	4	5	6
CHECKED		DATE		APPROVED	
DATE		DATE		DATE	
FILMED		DATE		DATE	

NOTE:

2424 MWh BASED ON LICENSED CORE THERMAL POWER; ACCOUNTING FOR SYSTEM THERMAL LOSSES, HEAT REJECTION TO THE REACTOR WATER CLEANUP, AND HEAT ADDITION OF REACTOR RECIRCULATION PUMPS.

This document contains information that is proprietary to Siemens Power Corporation and may not be reproduced or disclosed to any third party or other entity, in whole or in part, without the express prior written permission of Siemens Power Corporation.

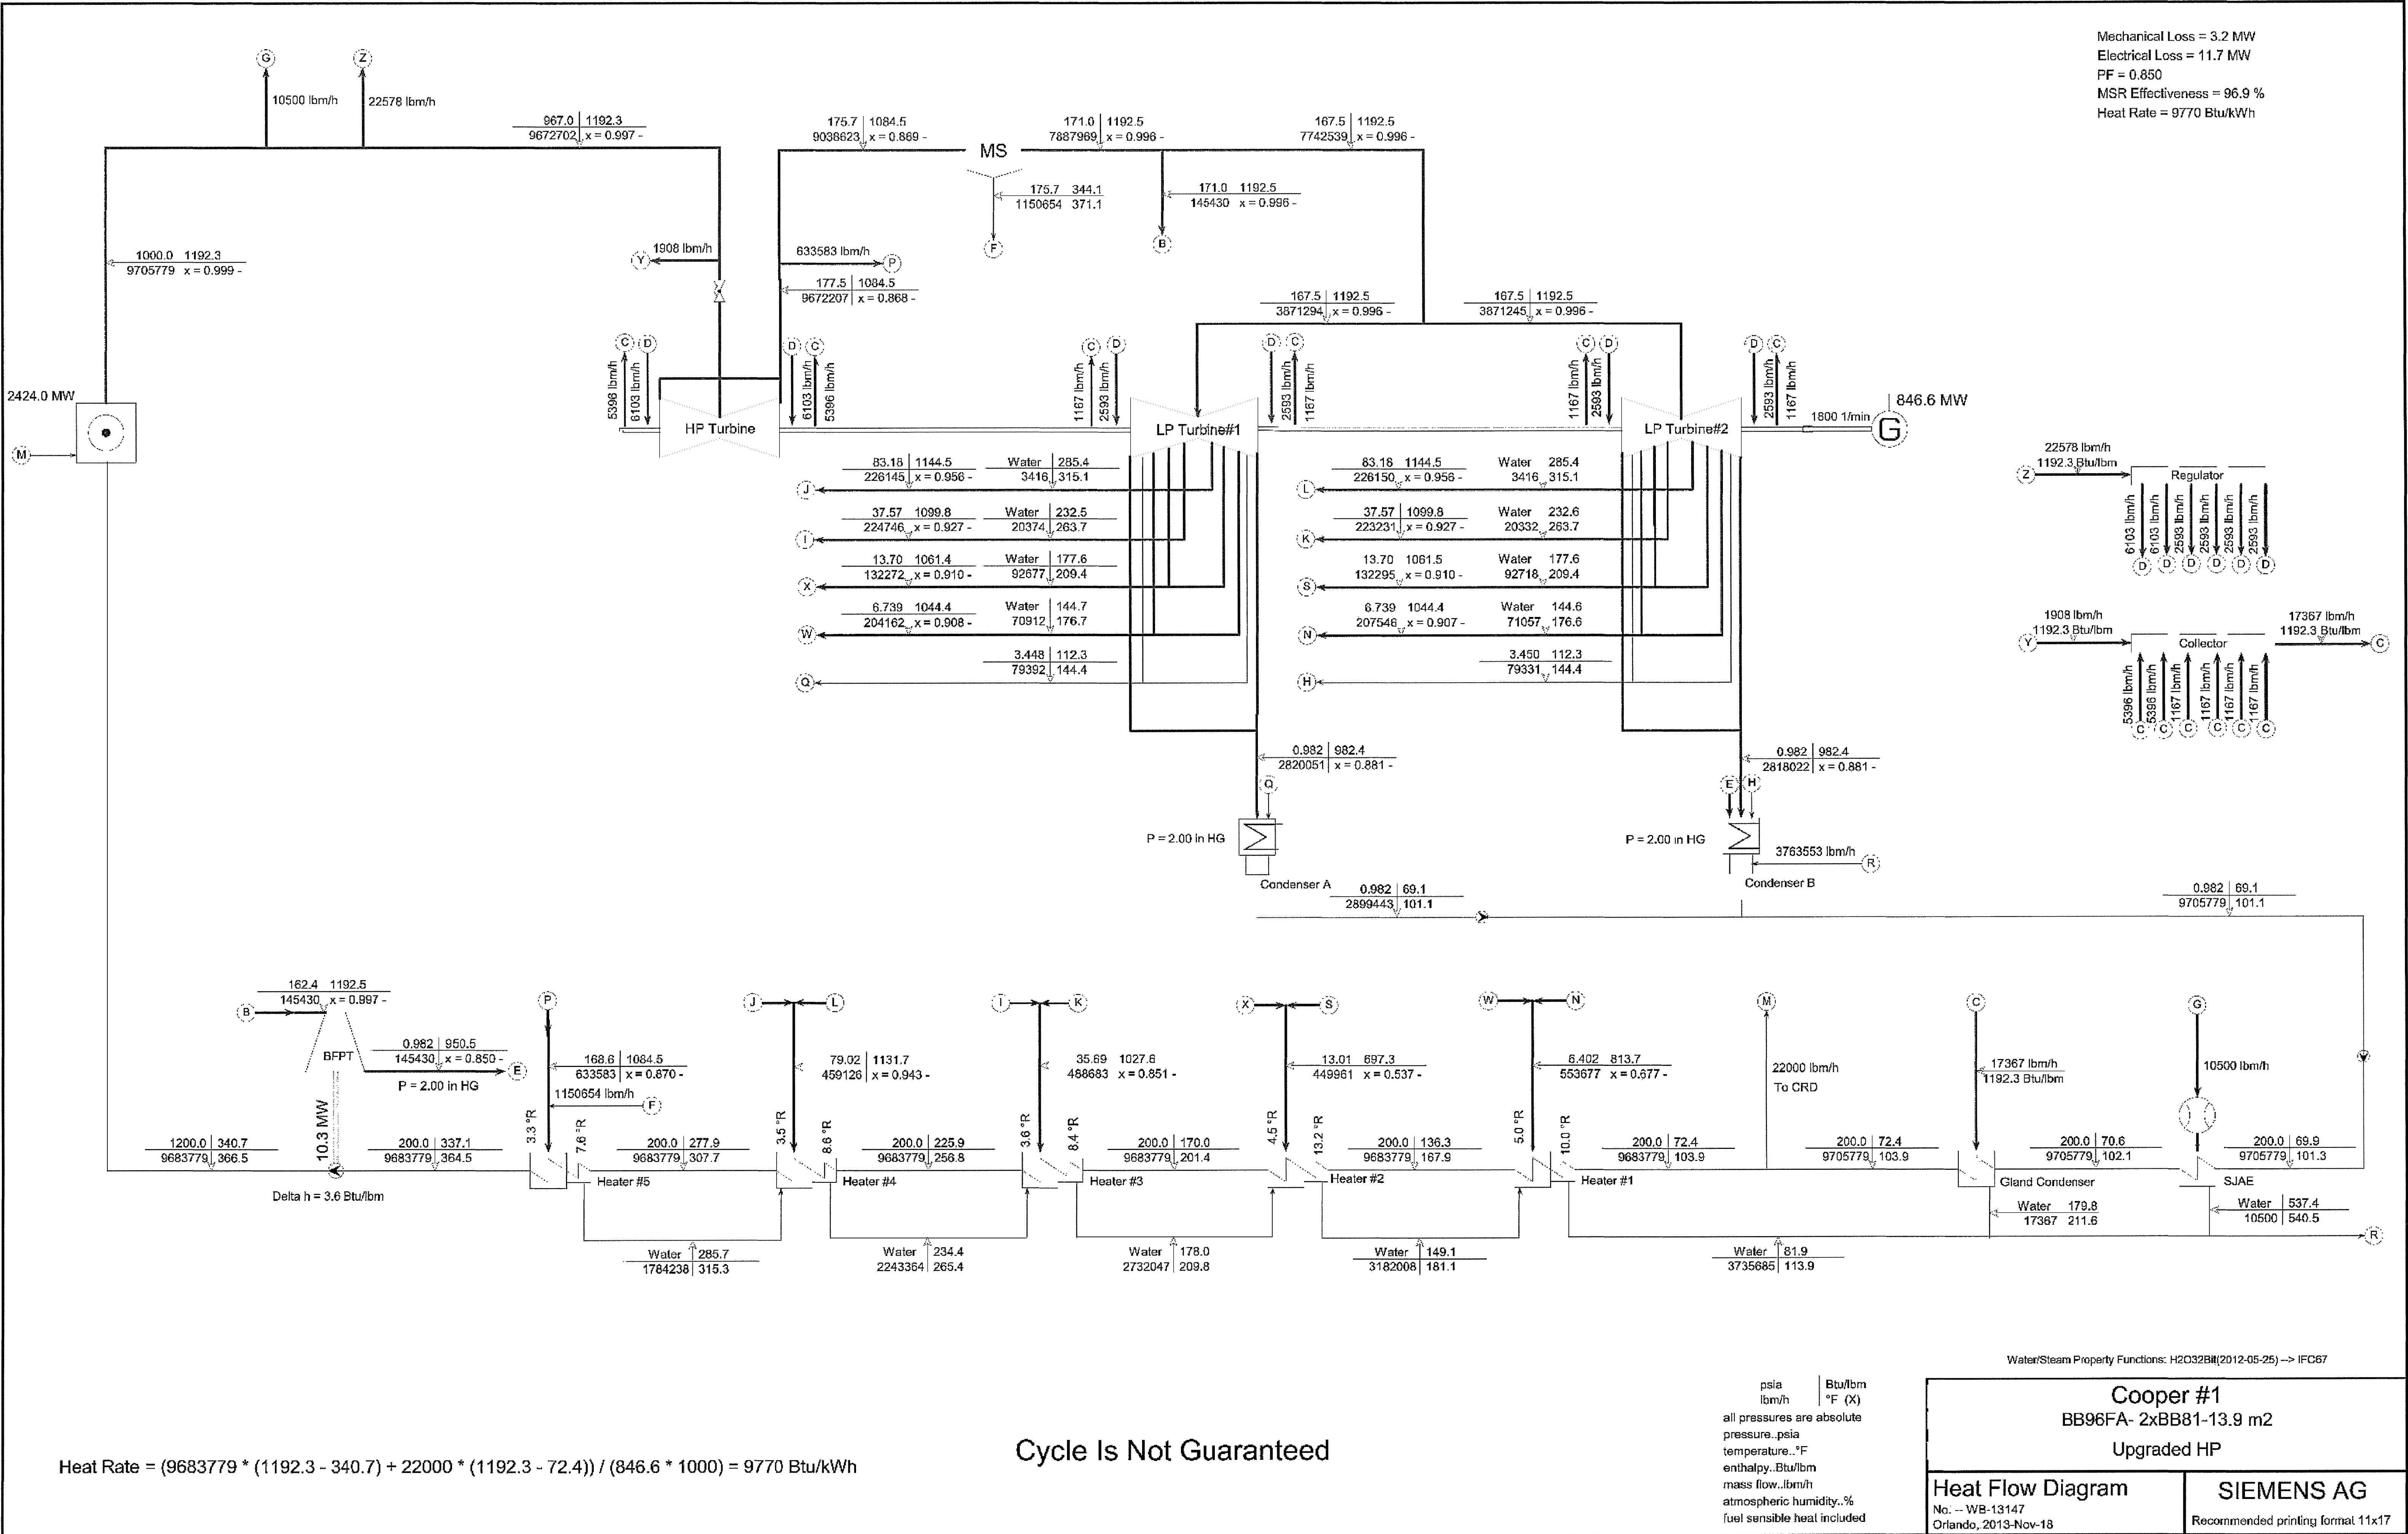

JOB IDENTIFICATION : Cooper\_1\_BB96FA\_Upgrade\_BB81-13.9m2\_09.28.13\_1\_g1; Lp.002; GrlnshME 2013-Nov-18 18:32:44 UTC; v 2.21.2


460008478

BY A.C. DATE \_\_\_\_\_  
CHKD. BY \_\_\_\_\_ DATE \_\_\_\_\_

SUBJECT NEBRASKA PUBLIC POWER DISTRICT SHEET NO. \_\_\_\_\_ OF \_\_\_\_\_  
COOPER NUCLEAR STATION JOB NO. 2520-02  
AREA TEMP. MONITORING SYSTEM FOR NUCLEAR BOILER SYSTEMS LEAK DETECTIONS

REV. NO. 7

IL-E-70-3 SHT. NO. 107 B  
DWG. NO. ID-105 SH. 3 A

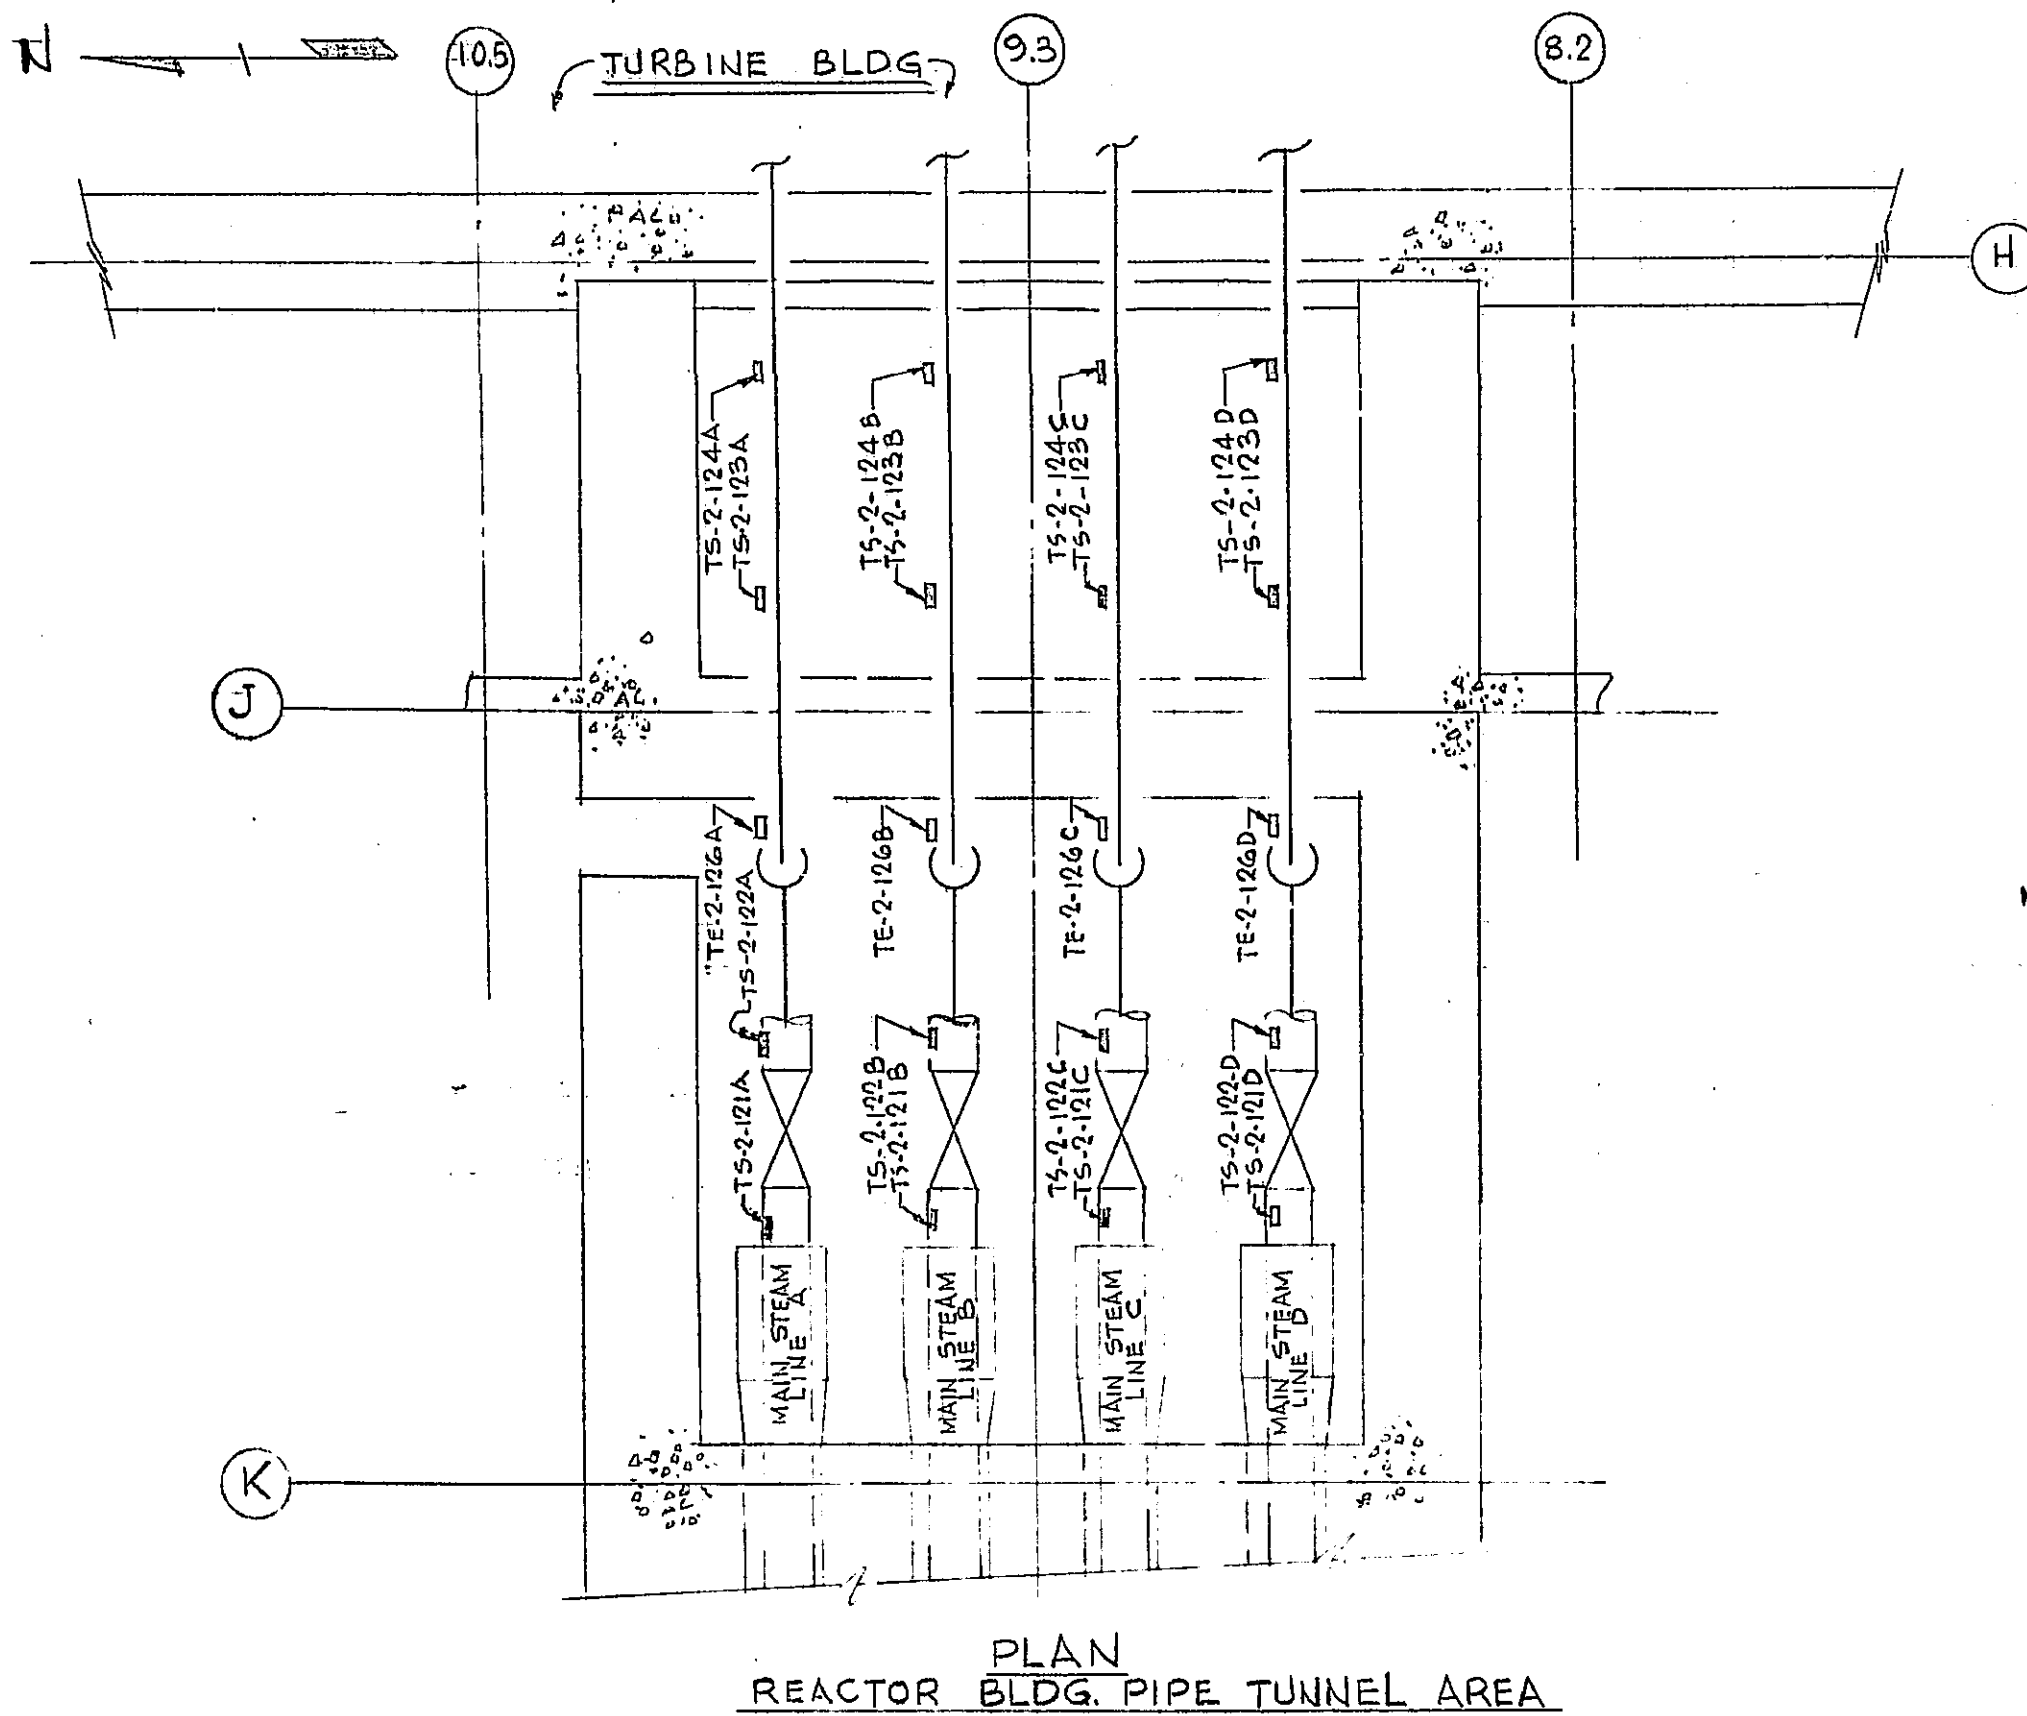

### MAIN STEAM SYSTEM LEAK DETECTION

#### NOTE:

FIELD TO LOCATE TEMP. ELEMENTS AND SWITCHES ABOVE  
PIPING APPROX. AS SHOWN AND TO CLEAR ALL  
OBSTRUCTIONS.  
FOR MOUNTING DETAILS OF TE-2-126 SEE G.E. DWG.  
145C3018  
FOR MOUNTING DETAILS OF TS-2-121 THRU-124 SEE  
DWG. NO. ID-105 SH. 2

T30-0877

**RECEIVED**  
**FILMED**

N.P.D., D.C.C

S/N 1800




FOR PREVIOUS REVISIONS, SEE SUPERSEDED CARDS.

REVISIONS BY N.P.P.D.									
REVISIONS		DFT	CKD	APP	DATE				
NO.	REVISIONS	RRT	RHG	RGA	7-11-03				
N02	CNS PROCEDURE 2.2.61A & NOTIFI-								
	CATION RCR 2003-0241 (DCN 03-0070)	RAC	JAC	KG	8-26-05				
N03	ICED 6016540 (DCN 04-2886)	RAC	JAC	KG	8-7-07				
N04	W.O. 4433895 (DCN 07-1342)								

BY: KML DATE: \_\_\_\_\_ SUBJECT: NEBRASKA PUBLIC POWER DISTRICT SHEET NO. \_\_\_\_\_ OF \_\_\_\_\_  
CHKD. BY: \_\_\_\_\_ DATE: \_\_\_\_\_ COOPER NUCLEAR STATION JOB NO. 2520-02  
INSTALLATION DETAILS-TEMPERATURE DETECTORS FOR NUCLEAR BOILER SYSTEMS LEAK DETECTION

REV. NO. NO4 IL-E-70-3 SHT. NO. 107 C  
DWG. NO. I.D.-105 SHEET-4

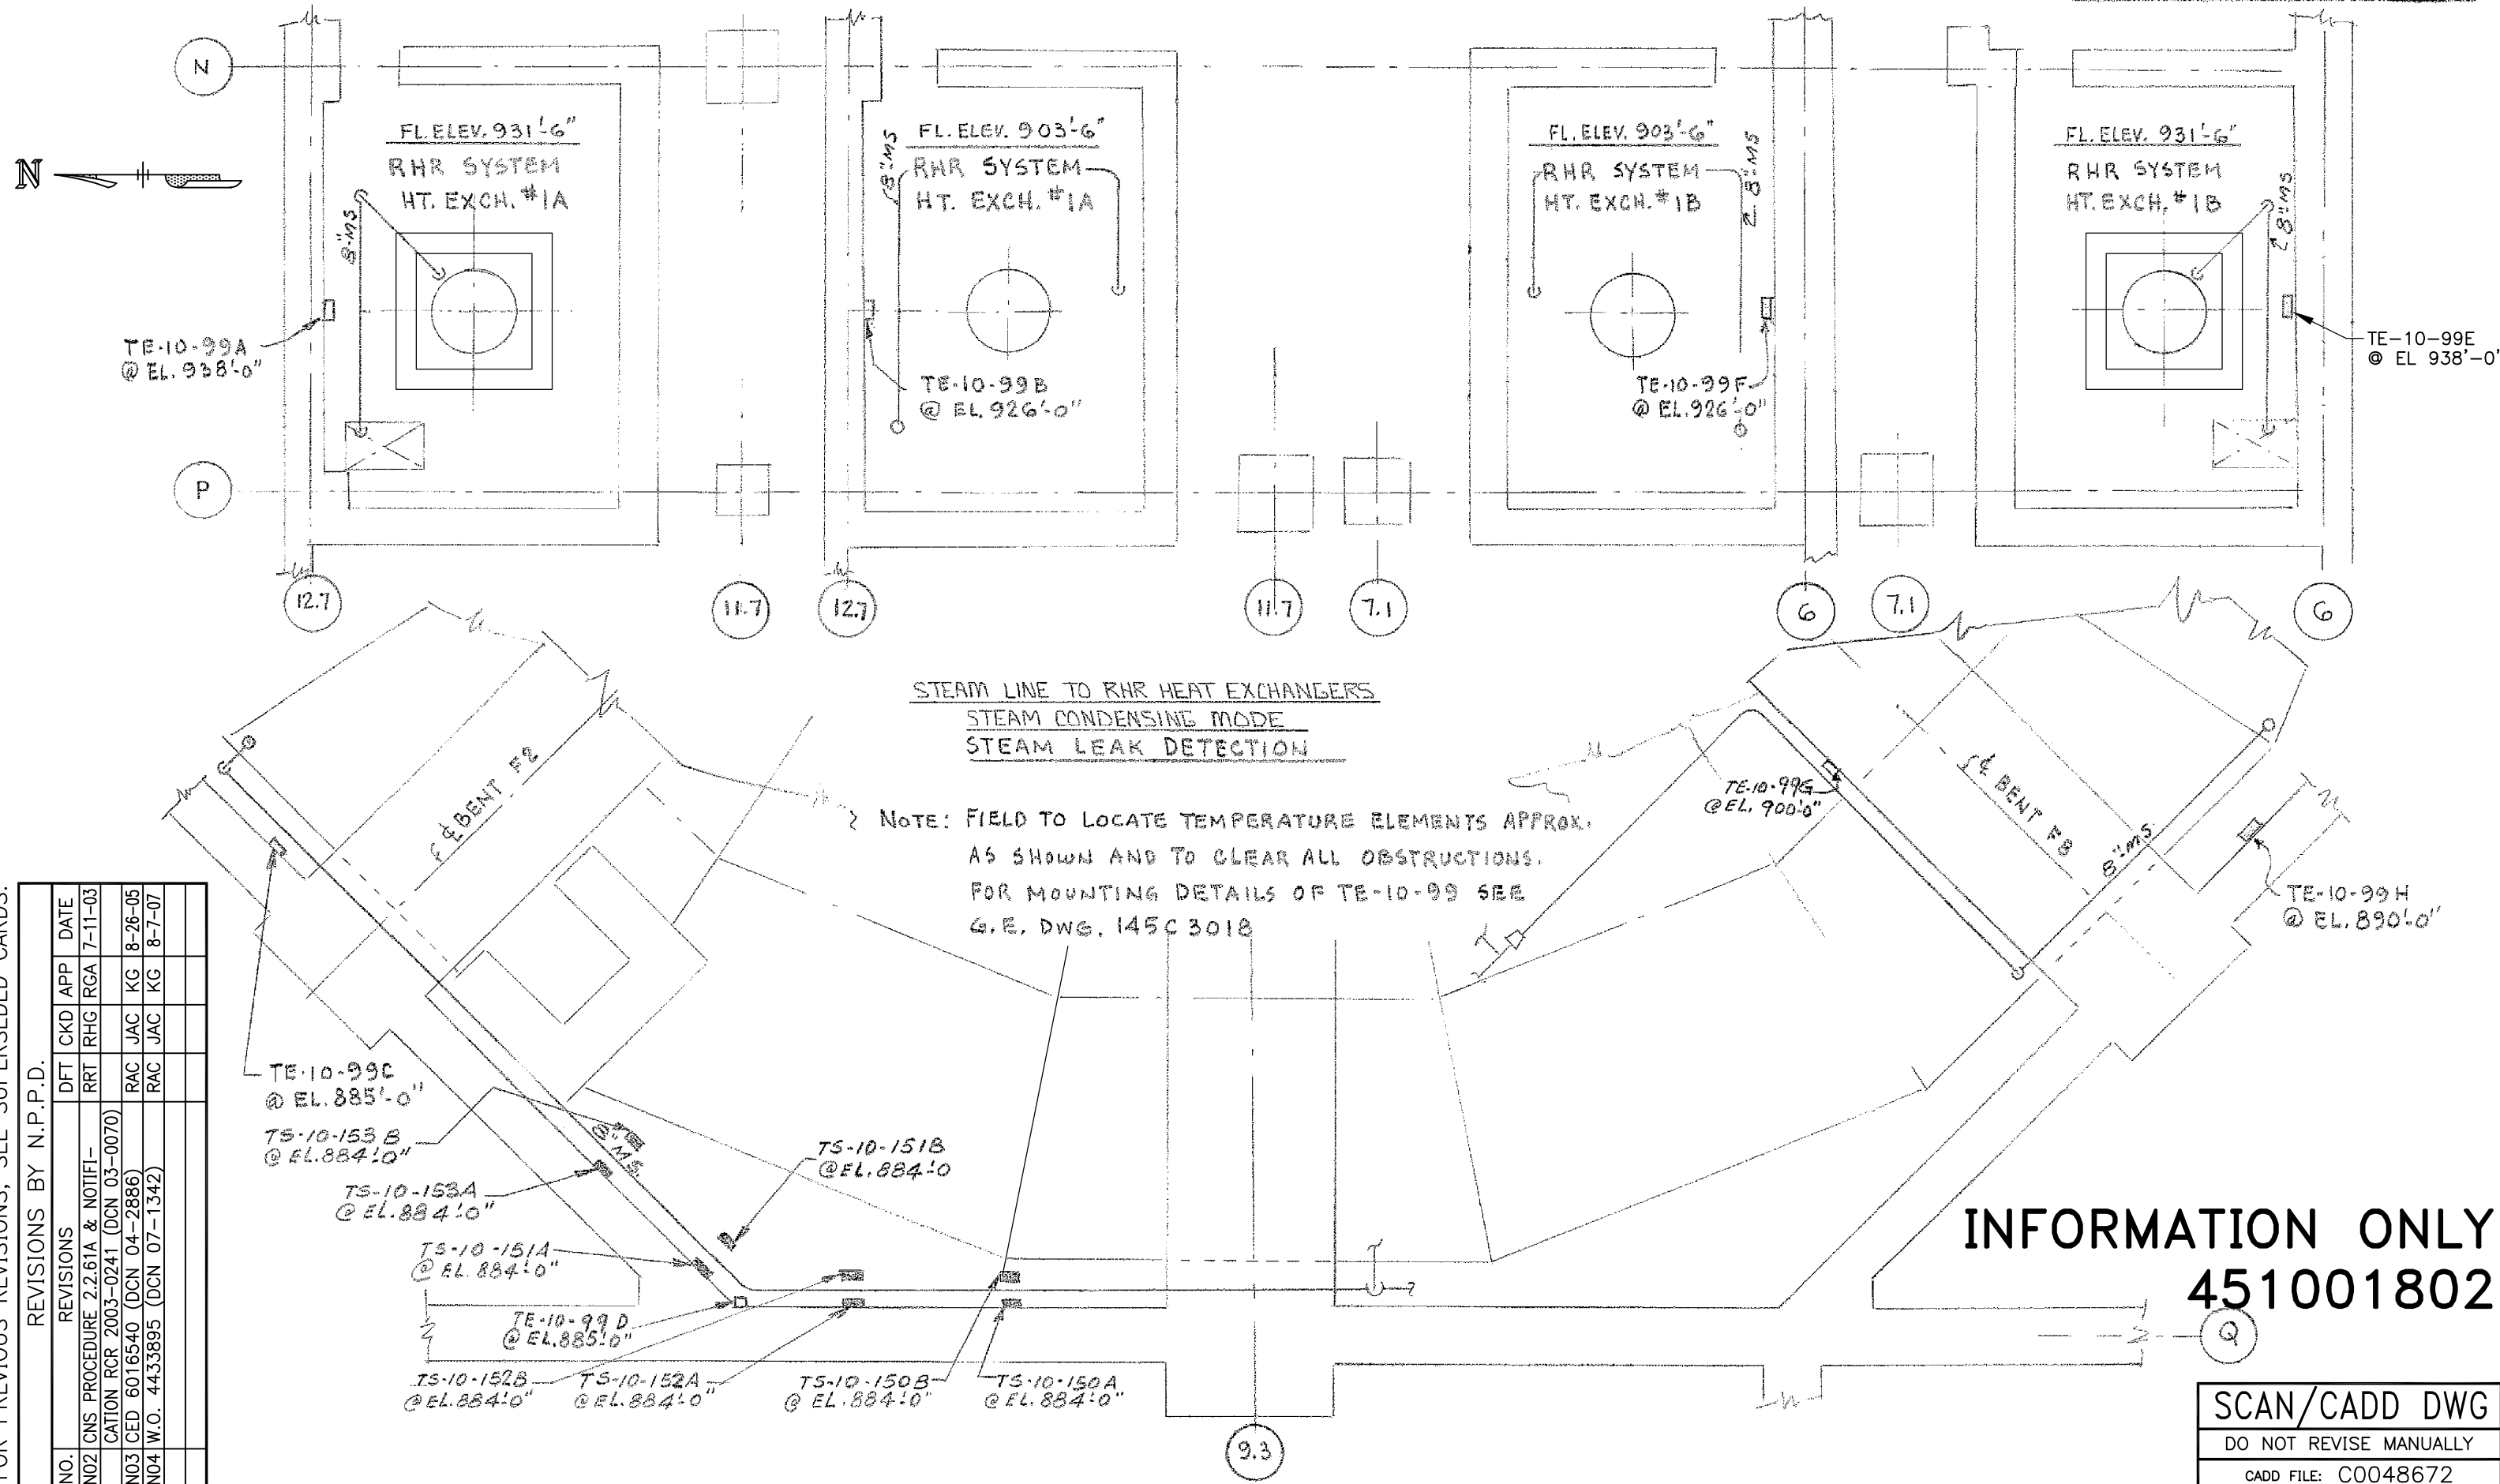


SCAN/CADD DWG  
DO NOT REVISE MANUALLY  
CADD FILE: C0048672

BY K.M.L. DATE \_\_\_\_\_  
CHKD. BY: DATE \_\_\_\_\_

SUBJECT NEBRASKA PUBLIC POWER DISTRICT SHEET NO. 6 OF 7  
COOPER NUCLEAR STATION JOB NO. 2520-02  
INSTALLATION DETAILS - TEMPERATURE DETECTORS FOR NUCLEAR BOILER SYSTEMS LEAK DETECTION

REV. No. 7

IL-E-70-3 SHT. NO. 107 E  
DWG. NO. I.D. -105 SHEET-G

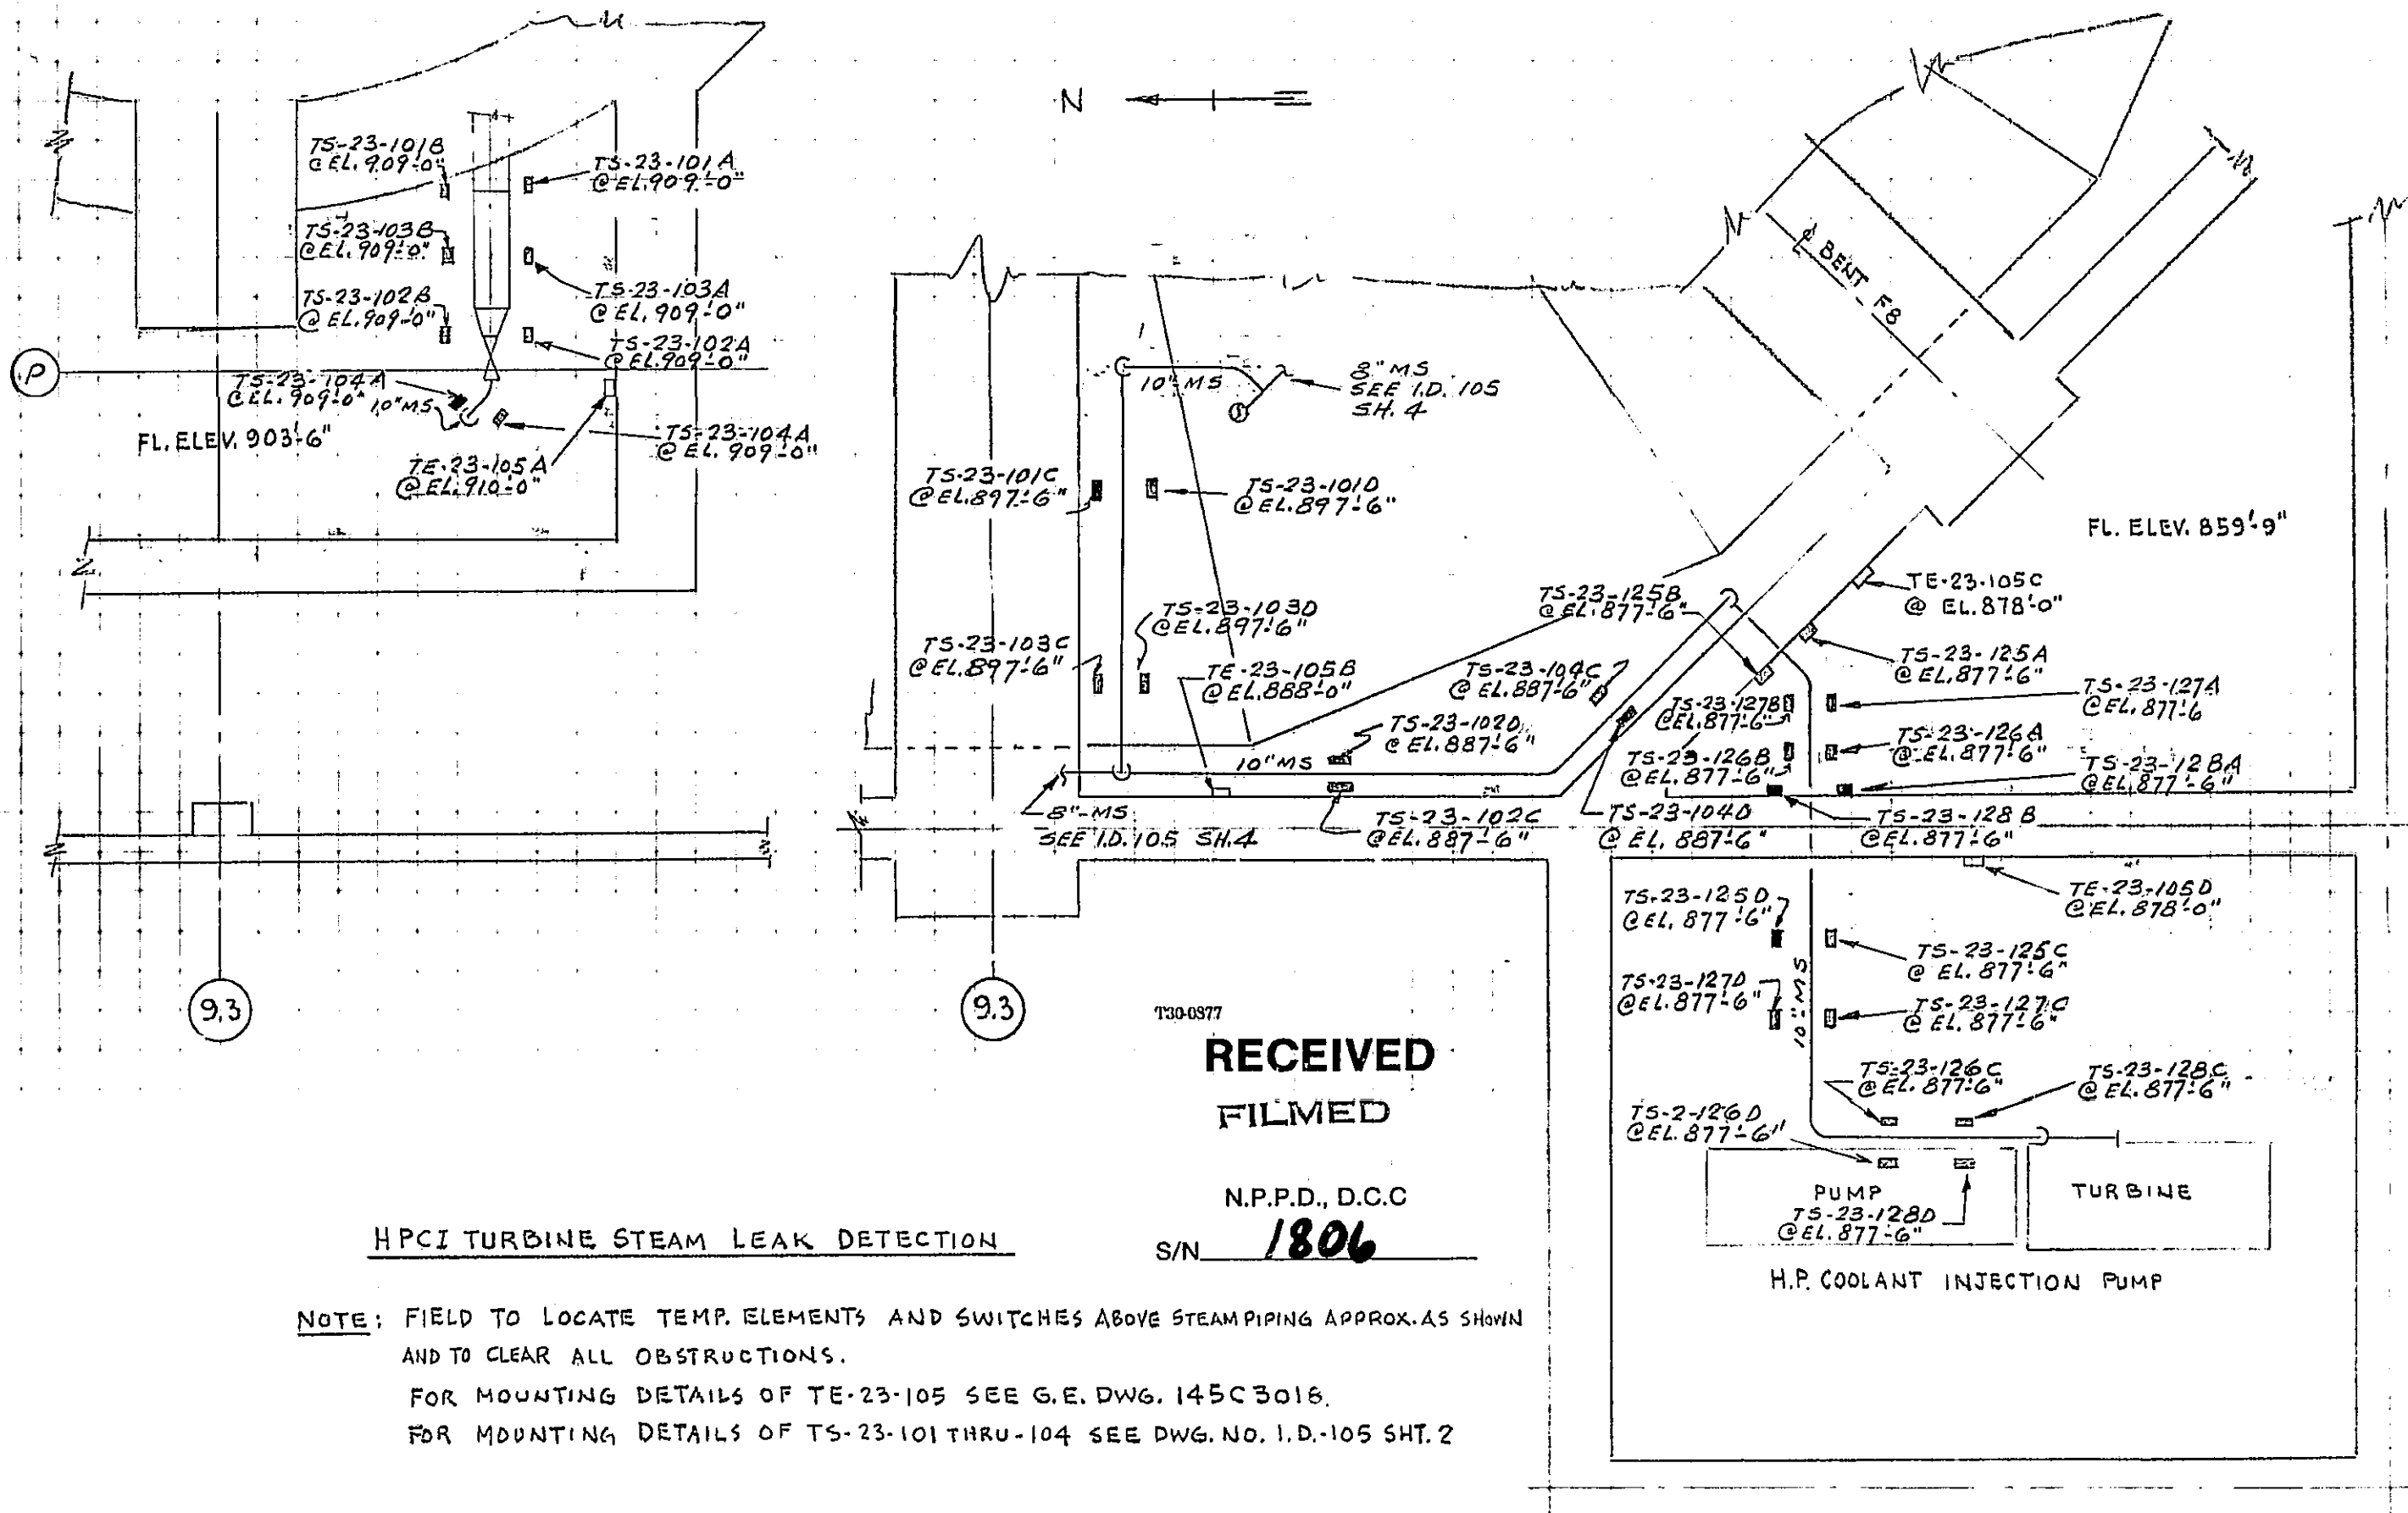

RECEIVED  
FILMED

N.P.P.D., D.C.C.

S/N 1806

HPCI TURBINE STEAM LEAK DETECTION

NOTE: FIELD TO LOCATE TEMP. ELEMENTS AND SWITCHES ABOVE STEAM PIPING APPROX. AS SHOWN  
AND TO CLEAR ALL OBSTRUCTIONS.

FOR MOUNTING DETAILS OF TE-23-105 SEE G.E. DWG. 145C3016.

FOR MOUNTING DETAILS OF TS-23-101 THRU-104 SEE DWG. NO. I.D.-105 SHT. 2

BY KML DATE  
CHKD. BY DATE

SUBJECT NEBRASKA PUBLIC POWER DISTRICT  
COOPER NUCLEAR STATION



SHEET NO. OF  
JOB NO. 2520-02

INSTALLATION DETAILS - TEMPERATURE DETECTORS FOR NUCLEAR BOILER SYSTEMS LEAK DETECTION

REV. NO. 7

IL-E-70-3 SHT. NO. 107 F

DWG. NO. I.D. - 105 SHEET-7

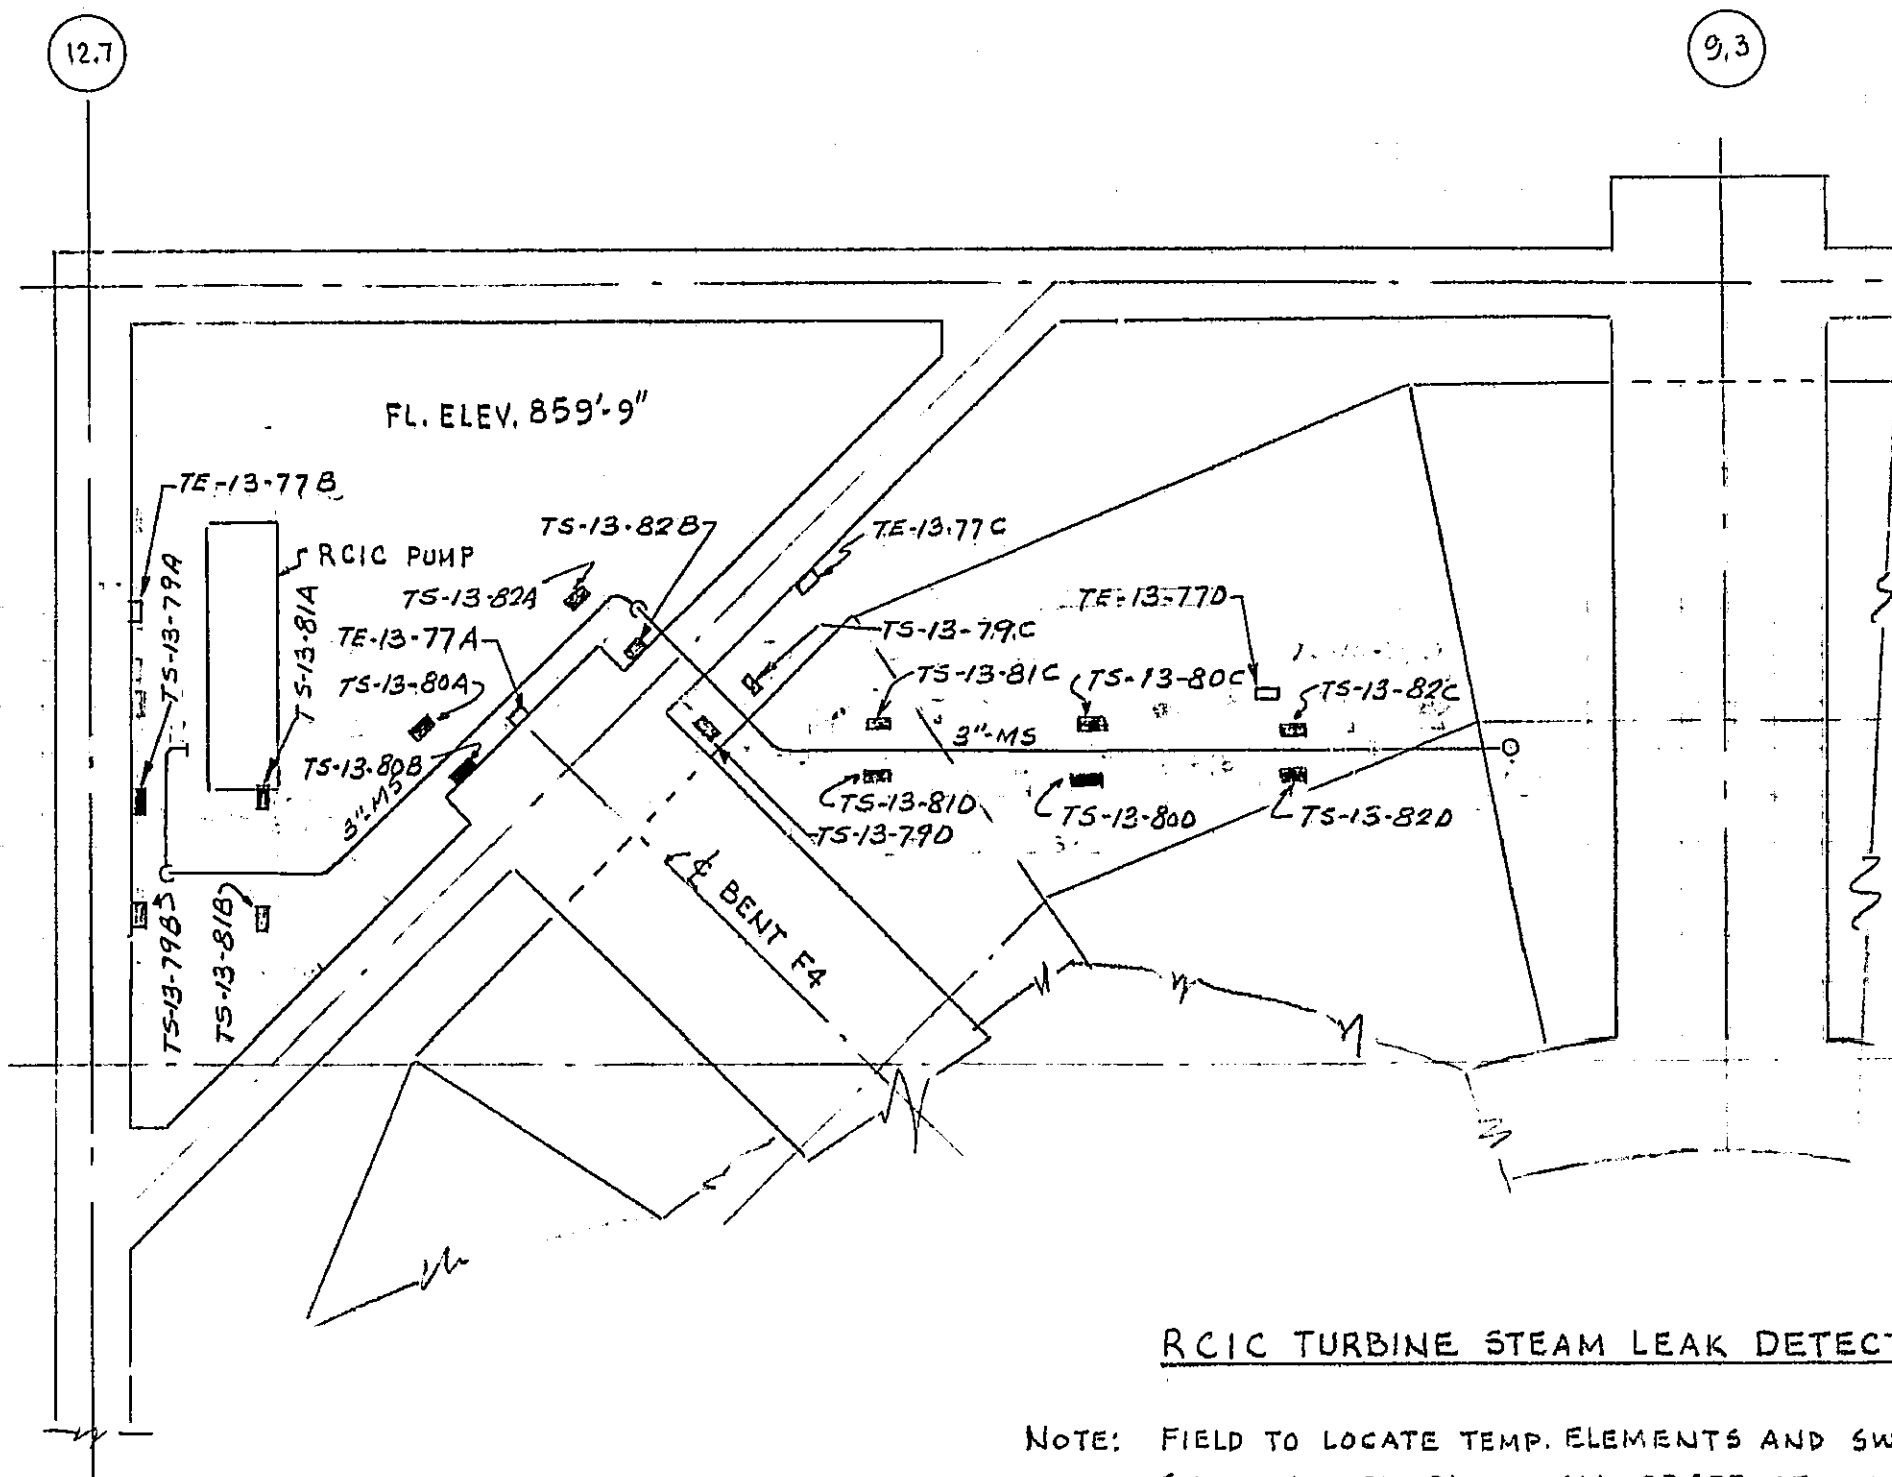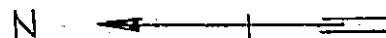

### RCIC TURBINE STEAM LEAK DETECTION

NOTE: FIELD TO LOCATE TEMP. ELEMENTS AND SWITCHES ABOVE STEAM PIPING APPROX. AS SHOWN, AND TO CLEAR ALL OBSTRUCTIONS.

FOR MOUNTING DETAILS OF TE-13-77 SEE G.E. DWG. 145C3018

FOR MOUNTING DETAILS OF TS-13-79 THRU 82 SEE DWG. NO. I.D. - 105 SHT. 2

T30-0877

**RECEIVED**


**FILMED**

N.P.P.D.; D.C.C

S/N **1807**





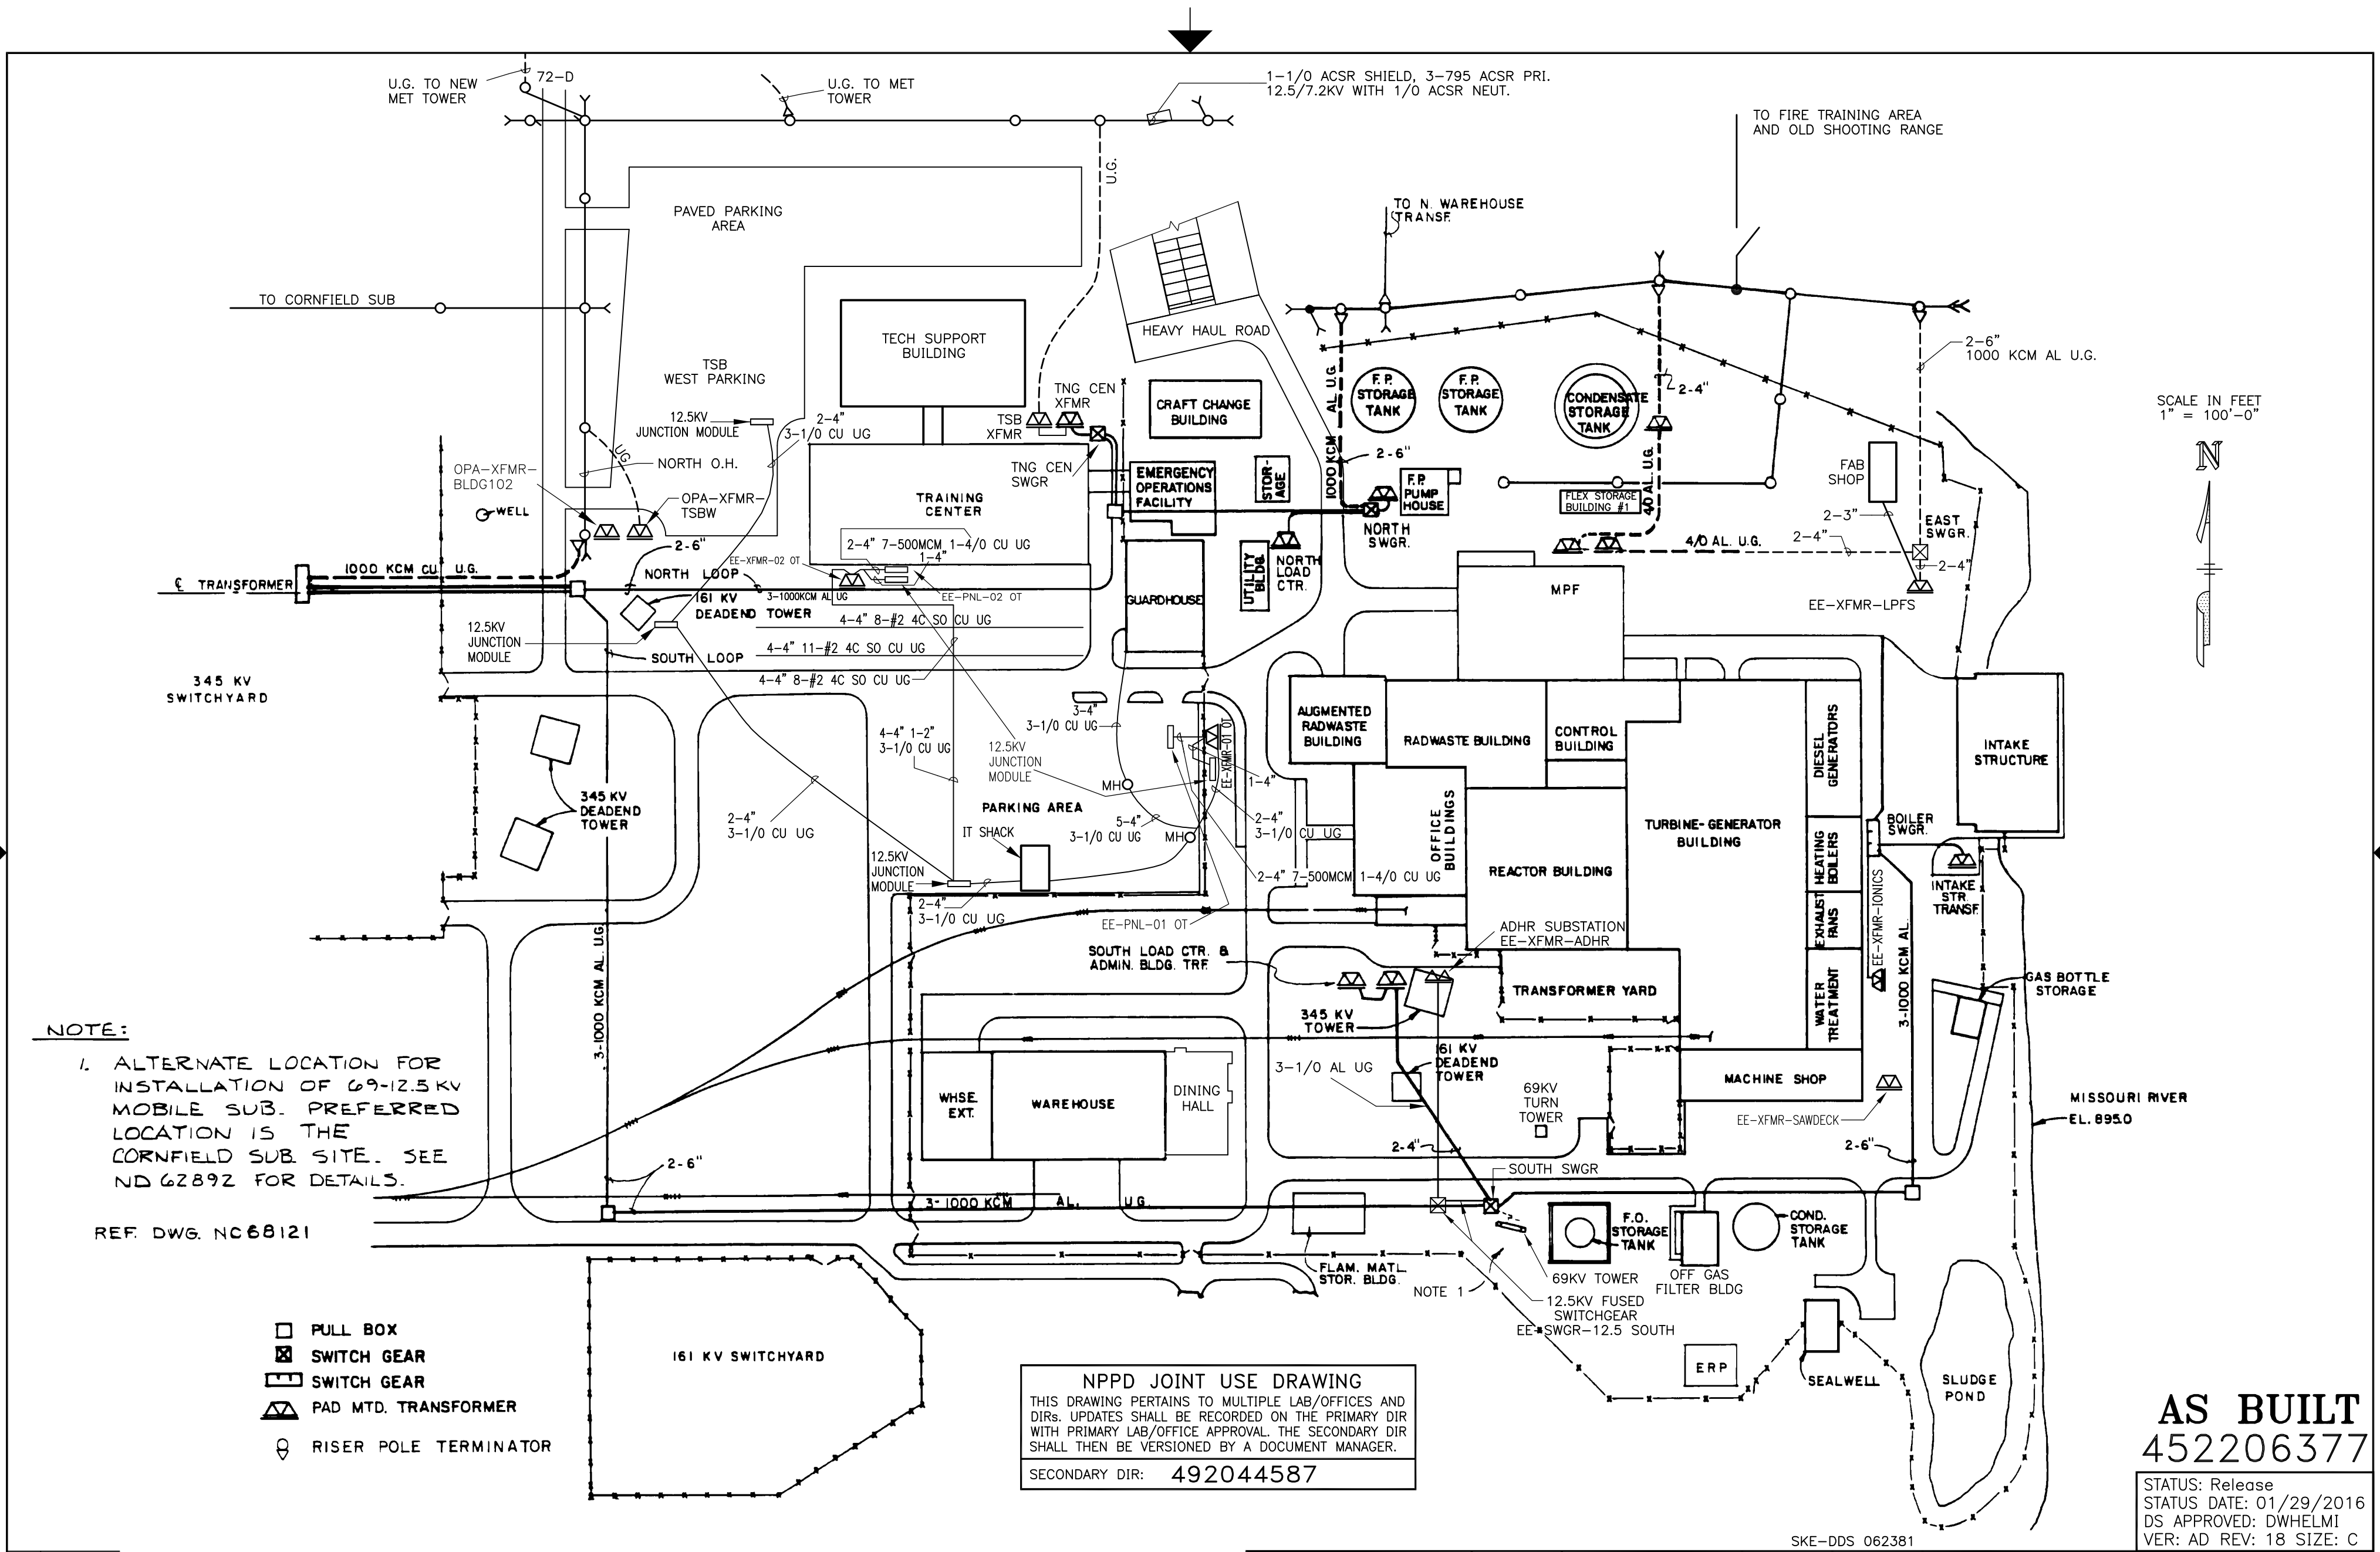

NOTE:  
1. ALTERNATE LOCATION FOR  
INSTALLATION OF 69-12.5 KV  
MOBILE SUB. PREFERRED  
LOCATION IS THE  
CORNFIELD SUB SITE. SEE  
ND 62892 FOR DETAILS.

REF. DWG. NC68121

- PULL BOX
- SWITCH GEAR
- SWITCH GEAR
- PAD MTD. TRANSFORMER
- RISER POLE TERMINATOR

NPPD JOINT USE DRAWING  
THIS DRAWING PERTAINS TO MULTIPLE LAB/OFFICES AND  
DIRS. UPDATES SHALL BE RECORDED ON THE PRIMARY DIR  
WITH PRIMARY LAB/OFFICE APPROVAL. THE SECONDARY DIR  
SHALL THEN BE VERSIONED BY A DOCUMENT MANAGER.  
SECONDARY DIR: 492044587

**AS BUILT**  
**452206377**  
STATUS: Release  
STATUS DATE: 01/29/2016  
DS APPROVED: DWHELM  
VER: AD REV: 18 SIZE: C

NO. VERSIONS/REVISIONS

FOR PREVIOUS REVISIONS, SEE SUPERSEDED CARDS.				
VERSIONS/REVISIONS BY N.P.P.D.				
NO.	DESCRIPTION	DFT	DATE	ENG
AC/16	DR-2014-0008	DLR	10/11/14	DJBUTLE
AE/17	DR-2014-0008	RLR	3/16/15	REJENSE
AD/18	DR-2013-0985	RLR	12/29/15	DWHELM


SIGNIFICANT NUMBER	930096				2590	
GROUP	1	2	3	4	5	6

COOPER NUCLEAR STATION  
ROUTING OF  
12.5 KV UNDERGROUND SYSTEM




DRAWN DJF	DATE 6-23-81	 Nebraska Public Power District	CADD FILE: E0023024
CHECKED WWW	DATE 8-28-81		
APPROVED GRK	DATE 8/28/81		
FILMED 9/10/81	NC44587		

REV	CHANGE DETAIL	DATE
1	ITEM #40 WAS 102-218	1/20/89
2	REDRAWN-MOVED PARTS LIST	4/11/90
3	ADDED SECTION "B-B"	8/9/91
4	ADD TORQUE CHART (ECR# 94)	11/25/92
5	NO CHANGE TO THIS DRAWING	3/27/97
6	REDRAWN PER ECR 231	8/14/98
7	CHANGE PER ECR 234	10/12/98
8	CHANGE PER ECR 502	4/15/08

ITEM No.	TORQUE
16, 28 29, 30 31, 33, 46	25 FT.-LBS
32	15 FT.-LBS
42	20 FT.-LBS
35 36, 59	30 IN.-LBS

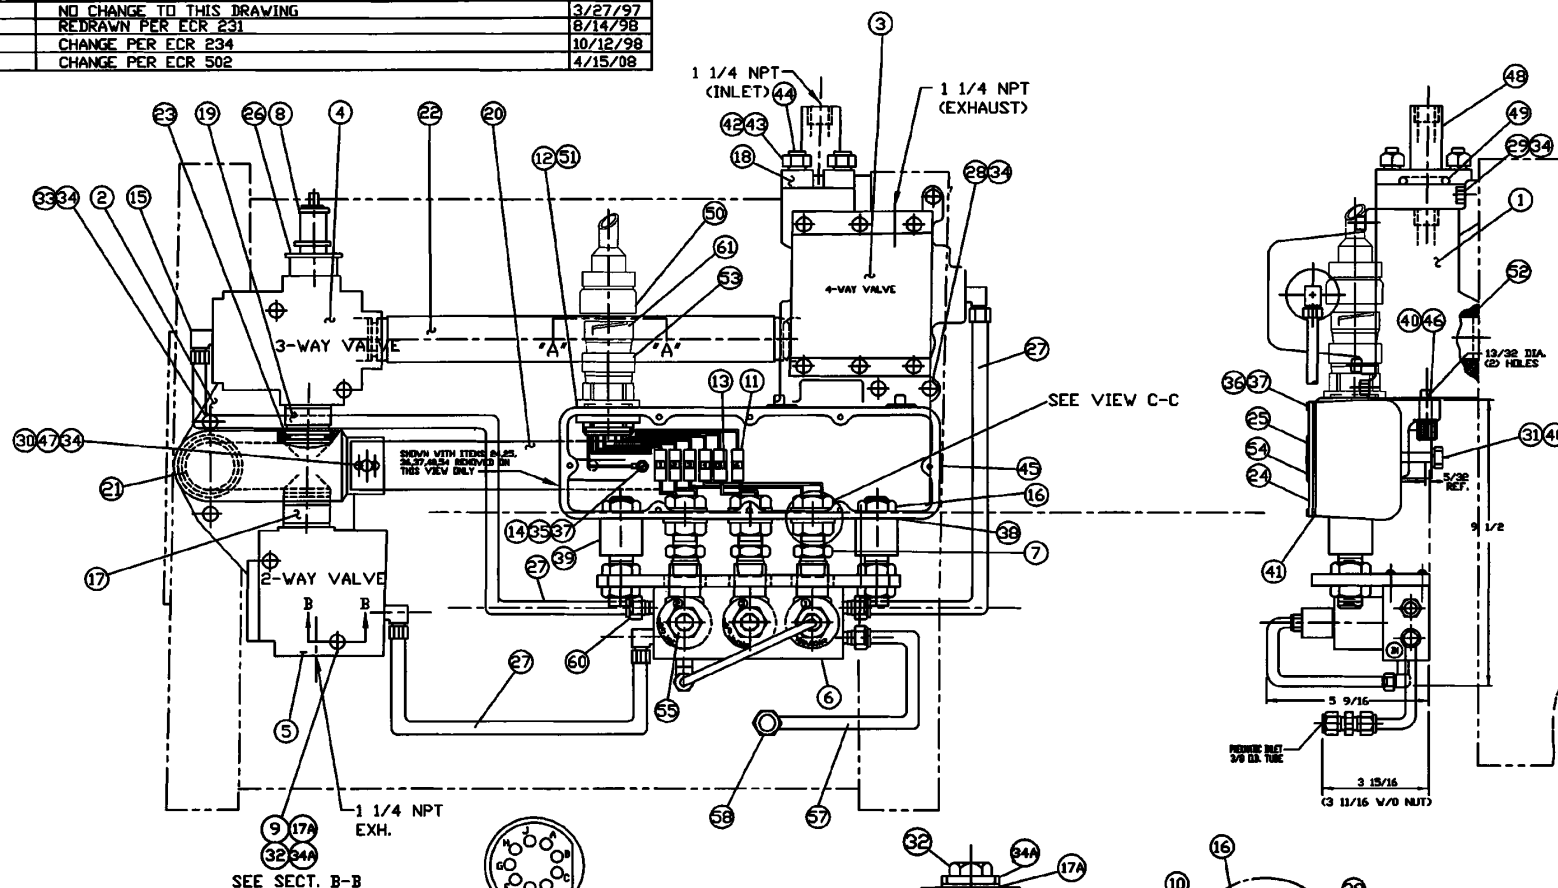

FUNCTION	SOL.	PIN	WIRE	VOLTS
MAIN AC VALVE	1	C	3	180V 60Hz
EXERCISE VALVE	3	E	5	180V 60Hz
MAIN DC VALVE	2	A	1	125VDC
		G	NOT USED	
		H		
		J		

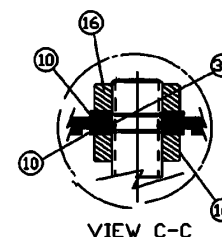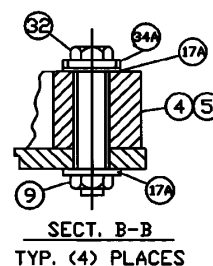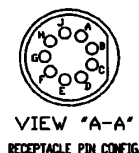


**AS BUILT**  
**450249440**

STATUS: Release  
STATUS DATE: 10/21/2014  
DS APPROVED: KASCHIZ  
VER: AB REV: 01 SIZE: A

NOTES:

1. ALLOWABLE FASTENER TENSION TOL.  $\pm 5\%$ .
2. TORQUE FASTENERS TO NORMAL VALUES LISTED.
3. TORQUE 4-WAY VALVE RETAINER SCREWS TO 10 FT.-LBS.

VERSIONS/REVISIONS BY N.P.P.D.				
NO.	DESCRIPTION	DFT	DATE	ENG
AB/01	DR-2014-0255	DLR	4/8/14	KASCHIZ

9	941	1-12-12	-	MoB	1-11-12
8	502	BJS 4/15/08	-	JFM	4/15/08
7	234	RAC 10/15/98	MAC10/15/98	NJK10/15/98	
6	231	DB 8/25/98	MAC8/24/98	NJKB/24/98	
REV.	ECR	APPROVED	CHECKED	DRAWN	
 RALPH A. HILLER COMPANY 6005 ENTERPRISE DRIVE EXPORT PA. 15632					
SHEET 4 OF 6			SCALE: N. T. S.		
TITLE: 20 X 5 MSIV ACTUATOR					
DRAWING NUMBER: SA-A085					



BY DATE

SUBJECT NPPD CNS

SHEET NO. 1 OF 1

CHKD. BY DATE

CONTAINMENT PENETRATION ASS'Y

SK 101670R

FOR DETAILS OF PENETRATION X714, SEE IMPELL  
DWGS NO RWCU-1, RWCU-2, RWCU-8 AND-OB1  
DWGS. NO. 61, 62, 63 & 64.

EXTERNAL PENETRATION CONTROLS

SK 101670R

5" MIN. LATERAL RESTRAINT ASSEMBLY

(REF) 1/2" W.T. SLEEVE EXTENSION-

(I.D. TO MATCH EXIST. SLEEVE I.D.)

TUBE-TURN, TAYLOR FORGE OR EQUAL  
FLANGE "D" BORE TO SUIT

MAT'L: SA 516 GR.70 FBK

MAT'L: SA 105 G+T  
OR SA 181 G+T

EXIST. CONT'T.  
VESSEL

EXIST. BIOLOGICAL  
SHIELD WALL

PROCESS PIPE "B" & CONT'T PENETRATION

EXIST. SLEEVE I.D. = "A" + 4" (REF)

MAT'L SAME AS EXIST. NOZZLE

GUARD PIPE O.D. = "C"  
(WHERE REQUIRED)

CONTAINMENT NOZZLE EXTENSION -  
(O.D. & W.T. TO MATCH EXIST. NOZZLE)

SUPPT SHOE @  
BOTTOM - SHIP  
LOOSE-ATTACH  
TO F.H.F. W/ MAX  
1/2" FILLET WELD

FLUED HEAD  
FITTING

CONTAINMENT PENETR. EXT'N ASSY

DETERMINE TO SUIT

EXIST. EMBEDDED SLEEVE - 1/2" W.T.

EXIST. CONTAINMENT PENETR. NOZZLE

(REF. CB&I DWGS)

SEE GUARD PIPE GUIDE DETAIL

451200306

REFERENCE:

I. APPENDIX ENCL. VII Pg 3006  
OF SPEC. E 69-4

NOTE: THIS SKETCH PROVIDES INFORMATION  
REFERENCED IN REF. 1 - NOTE 2

# CONTAINMENT PENETRATION ASSEMBLY

PENETR. No.	A	PROCESS PIPE B	GUARD PIPE C	FLANGE D	REMARKS
X 8	18	3" SCH.	12	LAT RESTR ASSY NOT REQ.	ATTACH F.H.F. @ CUT LINE
X 10	18	3" SCH.	12	" " " " "	ATTACH F.H.F. @ CUT LINE
X 11	26	10" SCH.	20	32" CL 350 SLIP ON	
X 12	36	20" O.D.	NONE	48" CL 350 SLIP ON	
X 13A&B	42	24" O.D.	NONE	60" CL 350 SLIP ON	
X 14	22	6" SCH.	16	28" CL 175 SLIP ON	SEE NOTE 1
X 16A&B	26	10" SCH.	NONE	32" CL 350 SLIP ON	
X 17	22	6" SCH.	NONE	28" CL 175 SLIP ON	
X 23	12 SCH.	8" SCH.	NONE		
X 24	12 SCH.	8" SCH.	NONE		
X 7A-D	42	24	SEE SKETCH M 200 FOR SPECIAL DETAILS		

PENETR. No.	A	PROCESS PIPE B	GUARD PIPE C	FLANGE D	REMARKS
X 18	6 SCH.	3" SCH.	NONE	LAT. RESTR. ASSY NOT REQ.	ATTACH F.H.F. @ CUT LINE
X 19	6 SCH.	3" SCH.	NONE	LAT. RESTR. ASSY NOT REQ.	ATTACH F.H.F. @ CUT LINE
X 20	8 SCH.	4" SCH.	NONE		
X 21	3 SCH.	1" SCH.	NONE		
X 22	3 SCH.	1" SCH.	NONE		
X 36	6 SCH.	3" SCH.	NONE	LAT. RESTR ASSY NOT REQ.	ATTACH F.H.F. @ CUT LINE
X 41	6 SCH.	1" SCH.	NONE	LAT. RESTRAINT ASSY NOT REQ.	ATTACH F.H.F. @ CUT LINE
X 42	4 SCH.	1 1/2" SCH.	NONE	LAT. RESTR. ASSY NOT REQ.	ATTACH F.H.F. @ CUT LINE
X 43	18	4 SCH.	NONE	LAT. RESTR ASSY NOT REQ.	ATTACH F.H.F. @ CUT LINE
X 44	18	4 SCH.	NONE	LAT. RESTR ASSY NOT REQ.	ATTACH F.H.F. @ CUT LINE
X 45	34	18	SEE SKETCH M 200 FOR SPECIAL DETAILS		

SK 101670R

NPPD - CNS

CONT'T PENETR.

ASS'Y & EXT.

PENETRATION

CONTROLS

ISSUE/DATE

1 OCT 16, 1970

2 NOV 23, 1970

REV NO2

EXIST. NOZZLE W.T.

3" 6" (B) 4" SHIMS -  
EQUALLY SPACED


EXIST. NOZZLE

GUARD PIPE

"C" - I.D. CONTINUOUS SLEEVE

NOTE: THIS DETAIL NOT REQ'D  
FOR X 7A-D & 9A&B

## GUARD PIPE GUIDE DETAIL

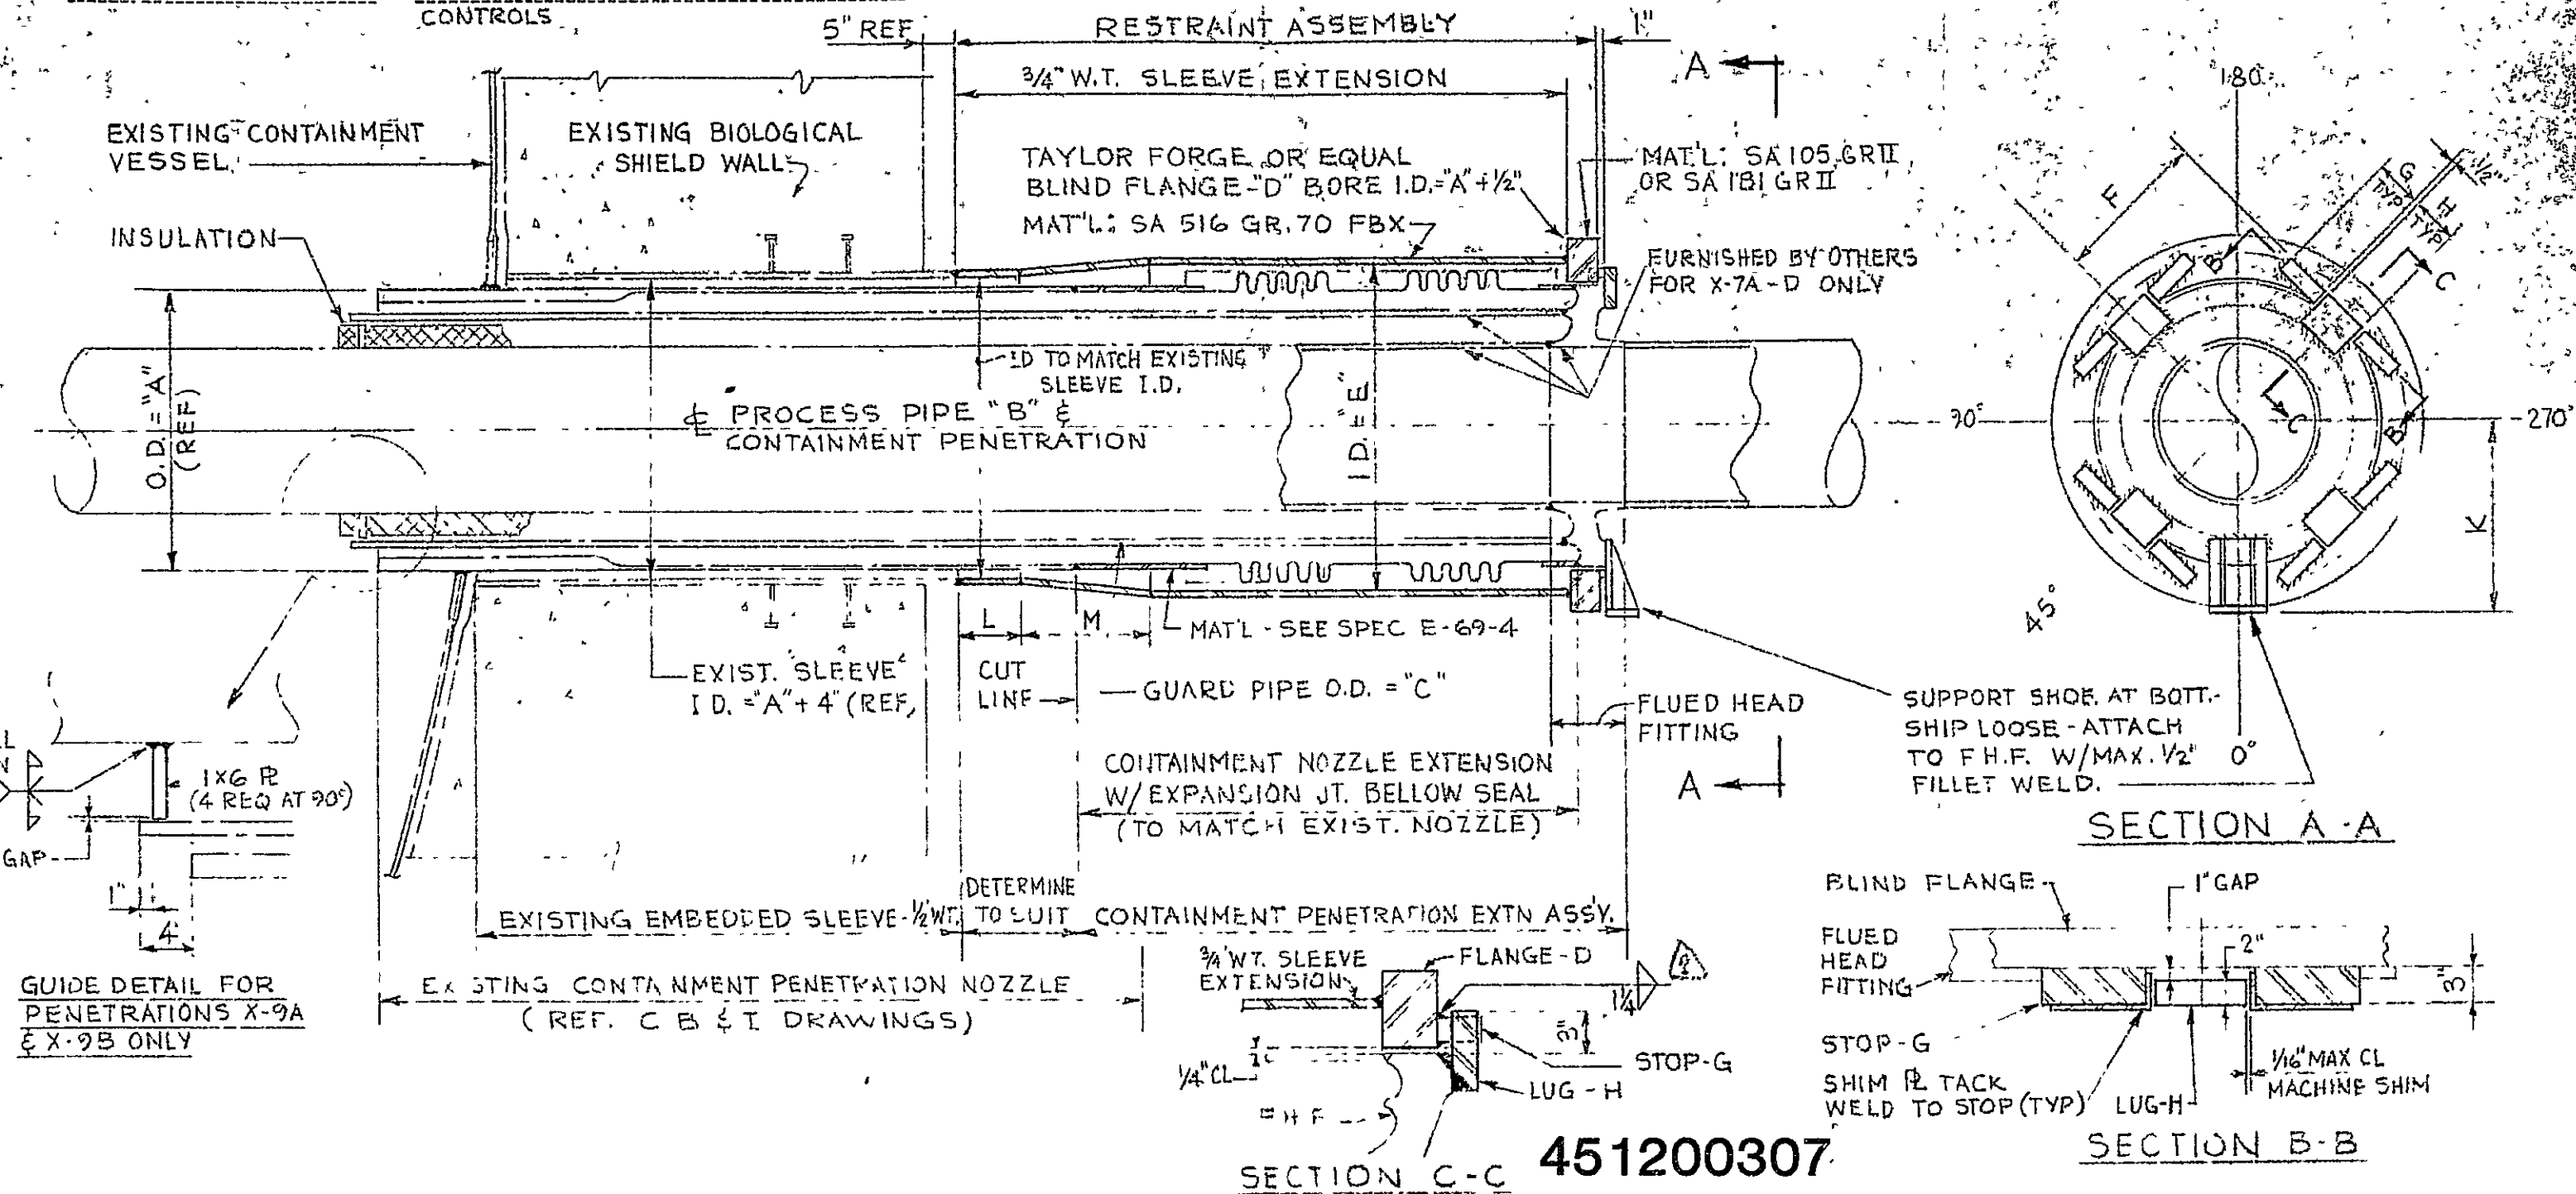

GUIDE DETAIL FOR PENETRATIONS X-9A & X-9B ONLY

PENE R NO	A	PROCESS PIPE - B	GUARD PIPE C	FLANGE - D	RESTRAINT P PL - E	F	STOP G	LUG H	K	L	M	REMARKS
X-7A	42	24 OD	36 OD	40" CLASS 350	52	24	2x3x8	2x6x7	20	10	20	
X-7B	42	24	36	48" CLASS 350	52	24	2x3x8	2x6x7	20	10	20	
X-7C	42	24	36	48" CLASS 350	52	24	2x3x8	2x6x7	20	10	20	
X-7D	42	24	36	48" CLASS 350	52	24	2x3x8	2x6x7	29	10	20	
X-9A	34	18	23	42" CLASS 350	44	20	2x3x8	2x6x7	26	10	20	
X-9B	34	18	23	42" CLASS 350	44	20	2x3x8	2x6x7	26	10	20	

SKETCH M-200  
 NPPD - CNS  
 CONTAINMENT  
 PENETRATION  
 X-7A THRU X-7D,  
 X-9A & X-9B  
 ASSY & EXTERIOR  
 PENETR CONTROLS

ISSUE	DATE
1	10-20-70
2	11-20-70