

- REFERENCES:
- PROCESS FLOW DIAGRAM @ DWG. 541-F-424
  - DEFINITION OF SYMBOLS
    - E. SPEC. G-675176 REV. 3
    - E. SPEC. G-675164 REV. 0
  - INSTALLATION OF INSTRUMENTATION
    - PROC. SPEC. CAP. 294367 REV. 1
  - MATERIAL SPEC. PIPE AND FITTINGS
    - NYPA SPEC. TS-MS-024
    - E. SPEC. G-676398 REV. 3
- LEGEND:
- TEMPORARY STRAINER
  - ELECTRICAL HEAT TRACING
  - TRIP ON LOW LEVEL IN BORON INJECTION TANK
  - CONTAINMENT PENETRATION
  - SEISMIC CLASSIFICATION
  - QUICK DISCONNECT FOR TEST
  - L.O. LOCKED OPEN
  - L.C. LOCKED CLOSED
  - F.O. FAIL OPEN
  - F.C. FAIL CLOSED
  - V. LOCAL VENT
  - D. LOCAL DRAIN
  - SENSOR W/ CAPILLARY

- NOTES:
- PIPING IS SCHEDULE 140
  - LOCATED IN HIGH SIDE OF PIPE IN LOCAL HIGH POINT
  - ORIFICE IS SUPPLIED WITH PUMP PACKAGE
  - MOUNTED WITH STEM HORIZONTAL
  - PROVISION FOR A SECOND SUMP LINE
  - BALANCE PISTON FLOW LINE FOR S.I. PUMP 32 IS INSIDE VALVES 887A AND 887B
  - LOCATED AT LOW POINT OF PIPE WORK
  - VALVES INSTALLED FOR VERTICAL DISCHARGE
  - FLUSH LINE IS INSTALLED AS CLOSE TO VALVE INLET AS POSSIBLE
  - VALVES ARE DIRECTED TO THIRD SECTION OF THE SUMP (SECTION CONTAINING RECIRC. PUMPS)
  - IVSWS OR LEAKOFF CONNECTIONS ON THE FOLLOWING VALVES: 850A, 850B, 850C, 885A, 886A & B ARE PLUGGED OR CAPPED
  - ALL VALVE NO.'S. ARE PRECEDED BY "SI" AS THE SYSTEM DESIGNATION EXCEPT AS NOTED
  - NORMAL POSITION OF VALVES SI-2165, -2166, -2168, -2169, -2170, -2171, -2172 IS LOCK-THROTTLED, AS DETERMINED BY A SYSTEM FLOW BALANCE. VALVE MIN. STOP POSITION SET AT 0.25" TO ALLOW VALVE 855 TO PROTECT DOWNSTREAM PIPING.

- REFERENCE DRAWINGS:
- 9321-F-27503 SIS SAFETY INJECTION SYSTEM SHEET 2
  - 27193 WDS WASTE DISPOSAL SYSTEM SHEET 1 - CONTAINMENT
  - 27203 ACS AUXILIARY COOLANT SYSTEM - INSIDE CONTAINMENT
  - 27513 ACS AUXILIARY COOLANT SYSTEM IN PAB & FSB - SHEET 2
  - 27363 CVCS CHEMICAL & VOLUME CONTROL SYSTEM SHEET 1
  - 27373 CVCS CHEMICAL & VOLUME CONTROL SYSTEM SHEET 2
  - 27383 RCS REACTOR COOLANT SYSTEM SHEET 1
  - 27473 RCS REACTOR COOLANT SYSTEM SHEET 2
  - 27233 N NITROGEN TO NUCLEAR EQUIPMENT
  - 27243 PW PRIMARY MAKE-UP WATER SYSTEM
  - 27453 SS SAMPLING SYSTEM
  - 27463 IVSWS ISOLATION VALVE SEAL WATER SYSTEM
  - 27273 AS AUXILIARY STEAM & COND FOR PRIMARY AUX. BLDG.
  - 9321-C-27413 NUCLEAR LINE SCHEDULE

WORK THIS DWG. WITH DWG. 9321-F-27503

NOTE:  
ALL PIPING ON THIS DWG. IS SEISMIC CLASS I EXCEPT AS NOTED

REDRAWN FROM (W) DWG. 685J427 & 110E364

DATE	BY	CHK'D	APP'D
05/10/17	SM	44	INCORPORATED EC-71098

INDIAN POINT NO. 3 NUCLEAR POWER PLANT


FLOW DIAGRAM  
SAFETY INJECTION SYSTEM  
SHEET NO. 1

SCALE: NONE

DWG NO. 9321-F-27353

SHEET 44

TYPE A/ISI/FSAR

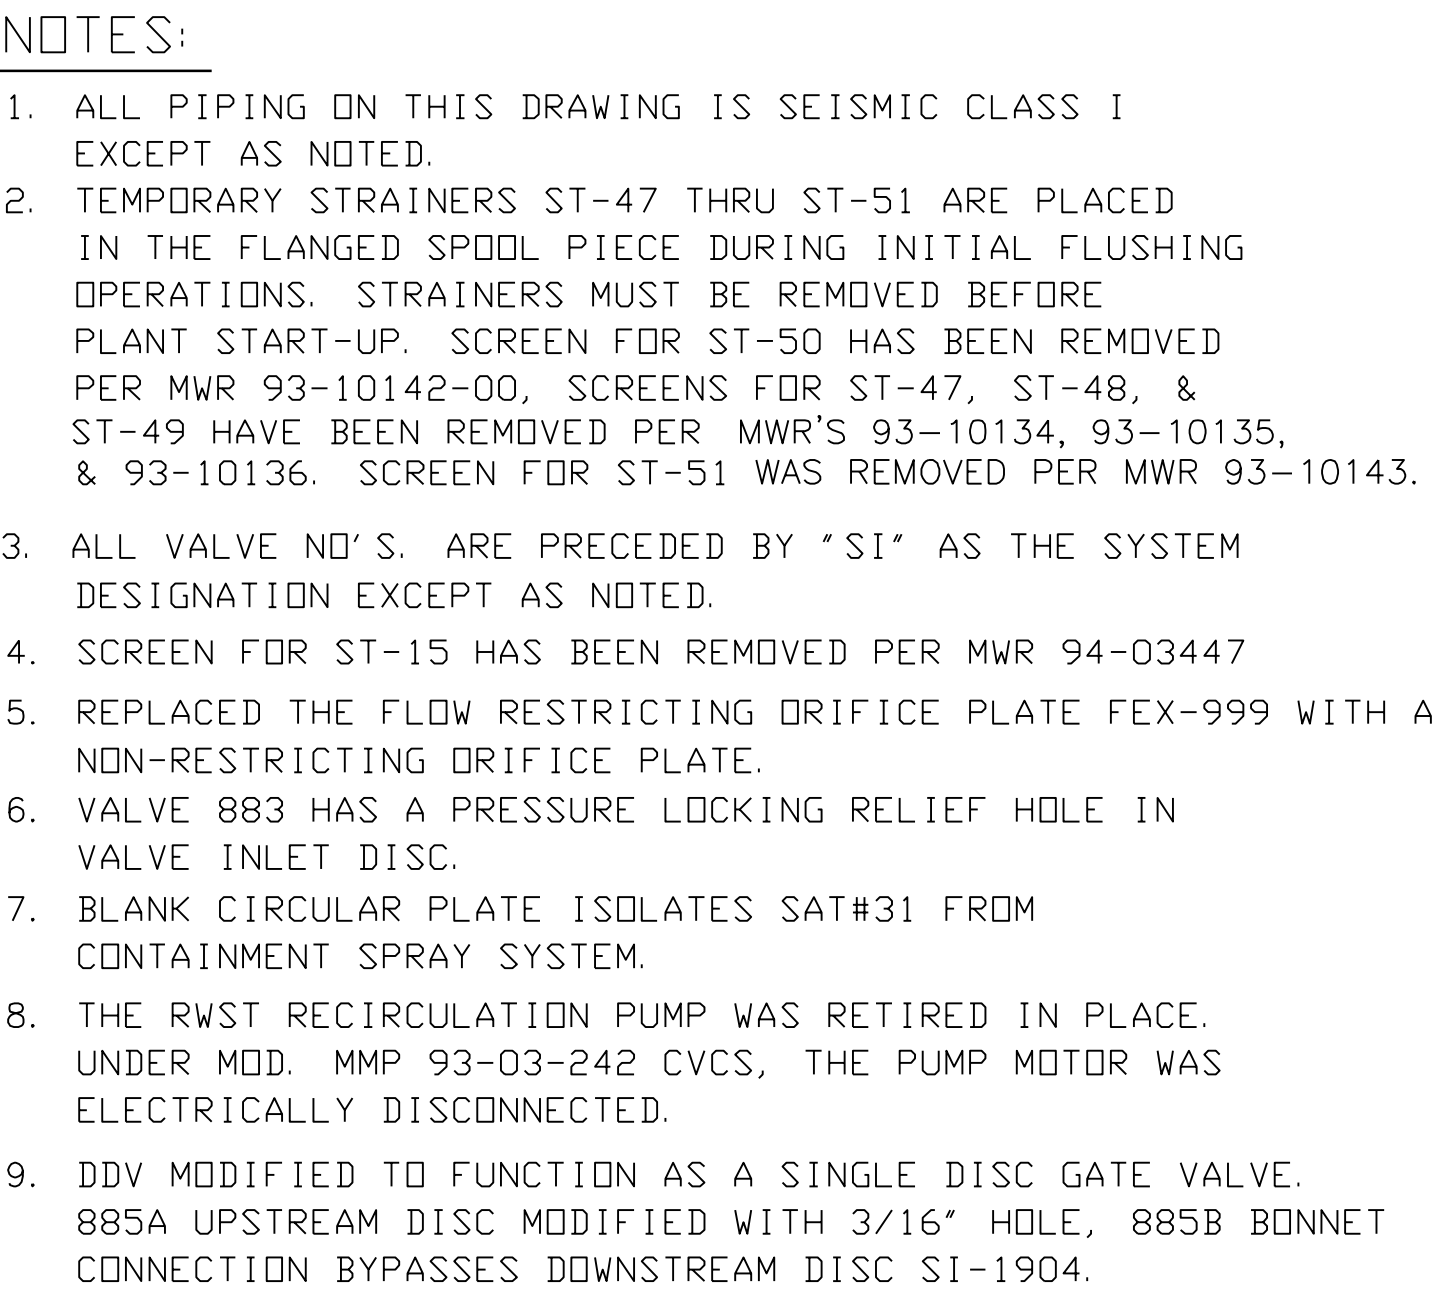

WORK THIS DWG. WITH DWG. 9321-F-27353.  
FOR ADDITIONAL NOTES AND REFERENCE DWGS  
SEE 9321-F-27353

THIS IS A COMPUTER AIDED DESIGN DRAWING. A RECORD OF THE REVISIONS OF THIS DOCUMENT WITH APPROVAL INITIALS/SIGNATURES, IS MAINTAINED

DWN	CHR'D	INDIAN POINT NO. 3 NUCLEAR POWER PLANT
DES' SUPV		
DISCIPLINE ENG		
DISCIPLINE MGR.		
PROJ APPROVAL		
DATE		<p>FLOW DIAGRAM SAFETY INJECTION SYSTEM SHEET NO. 2</p>

59	INCORPORATED EC-79305	9/14/18	OG	APPROVAL SIGNATURE ON FILE	
REV	DESCRIPTION	DATE	BY	CHK'D	APP.





**Entergy**  
Energy. It's what we do.

SCALE	NONE	
DWG NO		REV
9321-F-27503		59






W

636F269 APH  
1903M  
0686

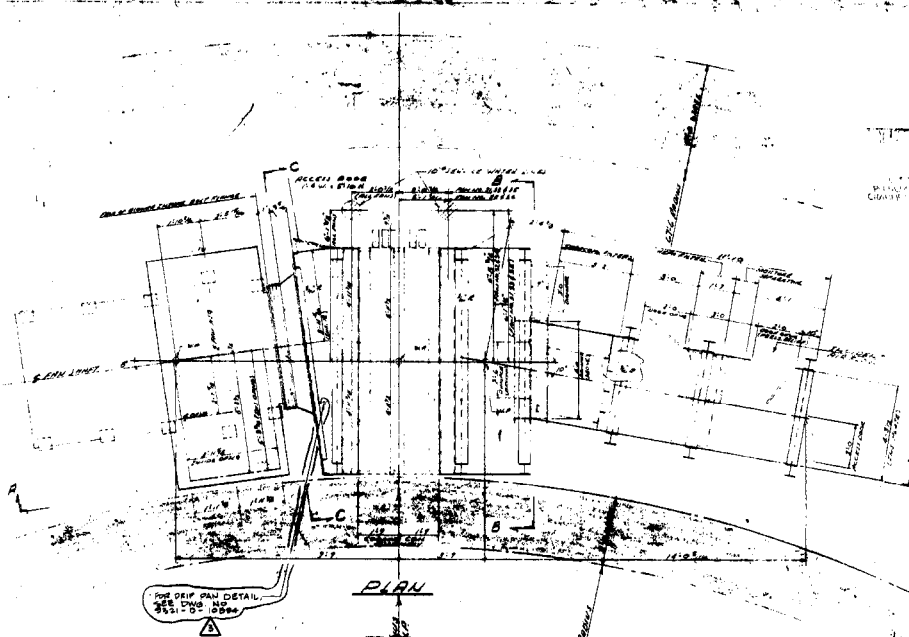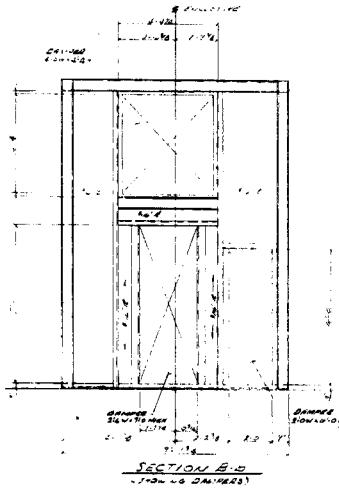

DETAIL OF BANK ASSEMBLY

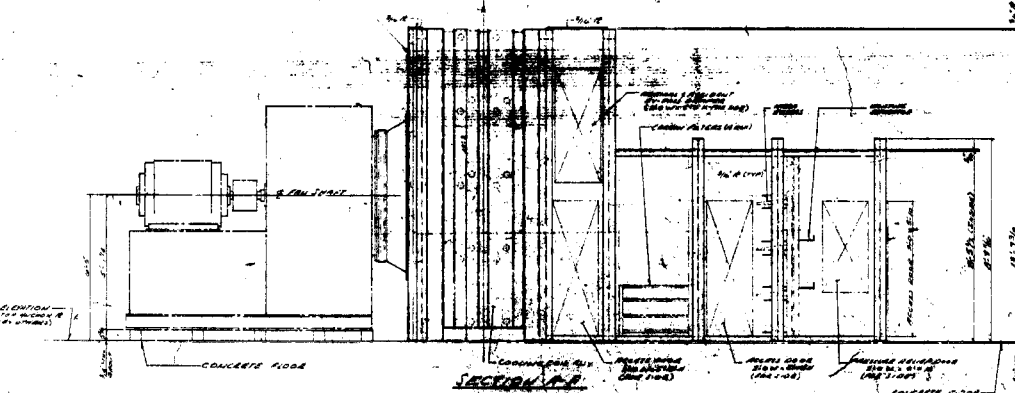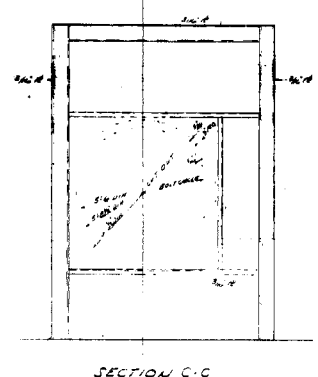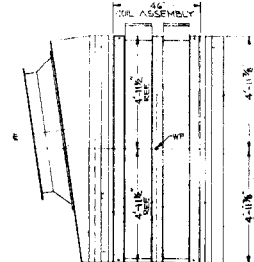

- 1. GROUT TO FLOOR FOR WATERPROOFING.
- 2. INSTALL JUNCTION BOXES LOCATING COILS AND ASSEMBLY BY LOCATING BATH LINE & COILS.
- 3. ASSEMBLY COILS TO FLOOR.
- 4. ASSEMBLY COILS TO FLOOR.
- 5. ASSEMBLY COILS TO FLOOR.
- 6. ASSEMBLY COILS TO FLOOR.
- 7. ASSEMBLY COILS TO FLOOR.
- 8. ASSEMBLY COILS TO FLOOR.
- 9. ASSEMBLY COILS TO FLOOR.
- 10. ASSEMBLY COILS TO FLOOR.

Approved for Construction  
7/13/72  
FASNY, MODIFICATION NO. 1 B-03-055 FOU  
WESTINGHOUSE ELECTRIC CORP.  
ST. LOUIS, MISSOURI  
INDIAN POINT UNIT #43  
SPRING BRIDGE, MISSOURI




microfilm

636F269

636F269

USE DIA 20 FOR PRINT



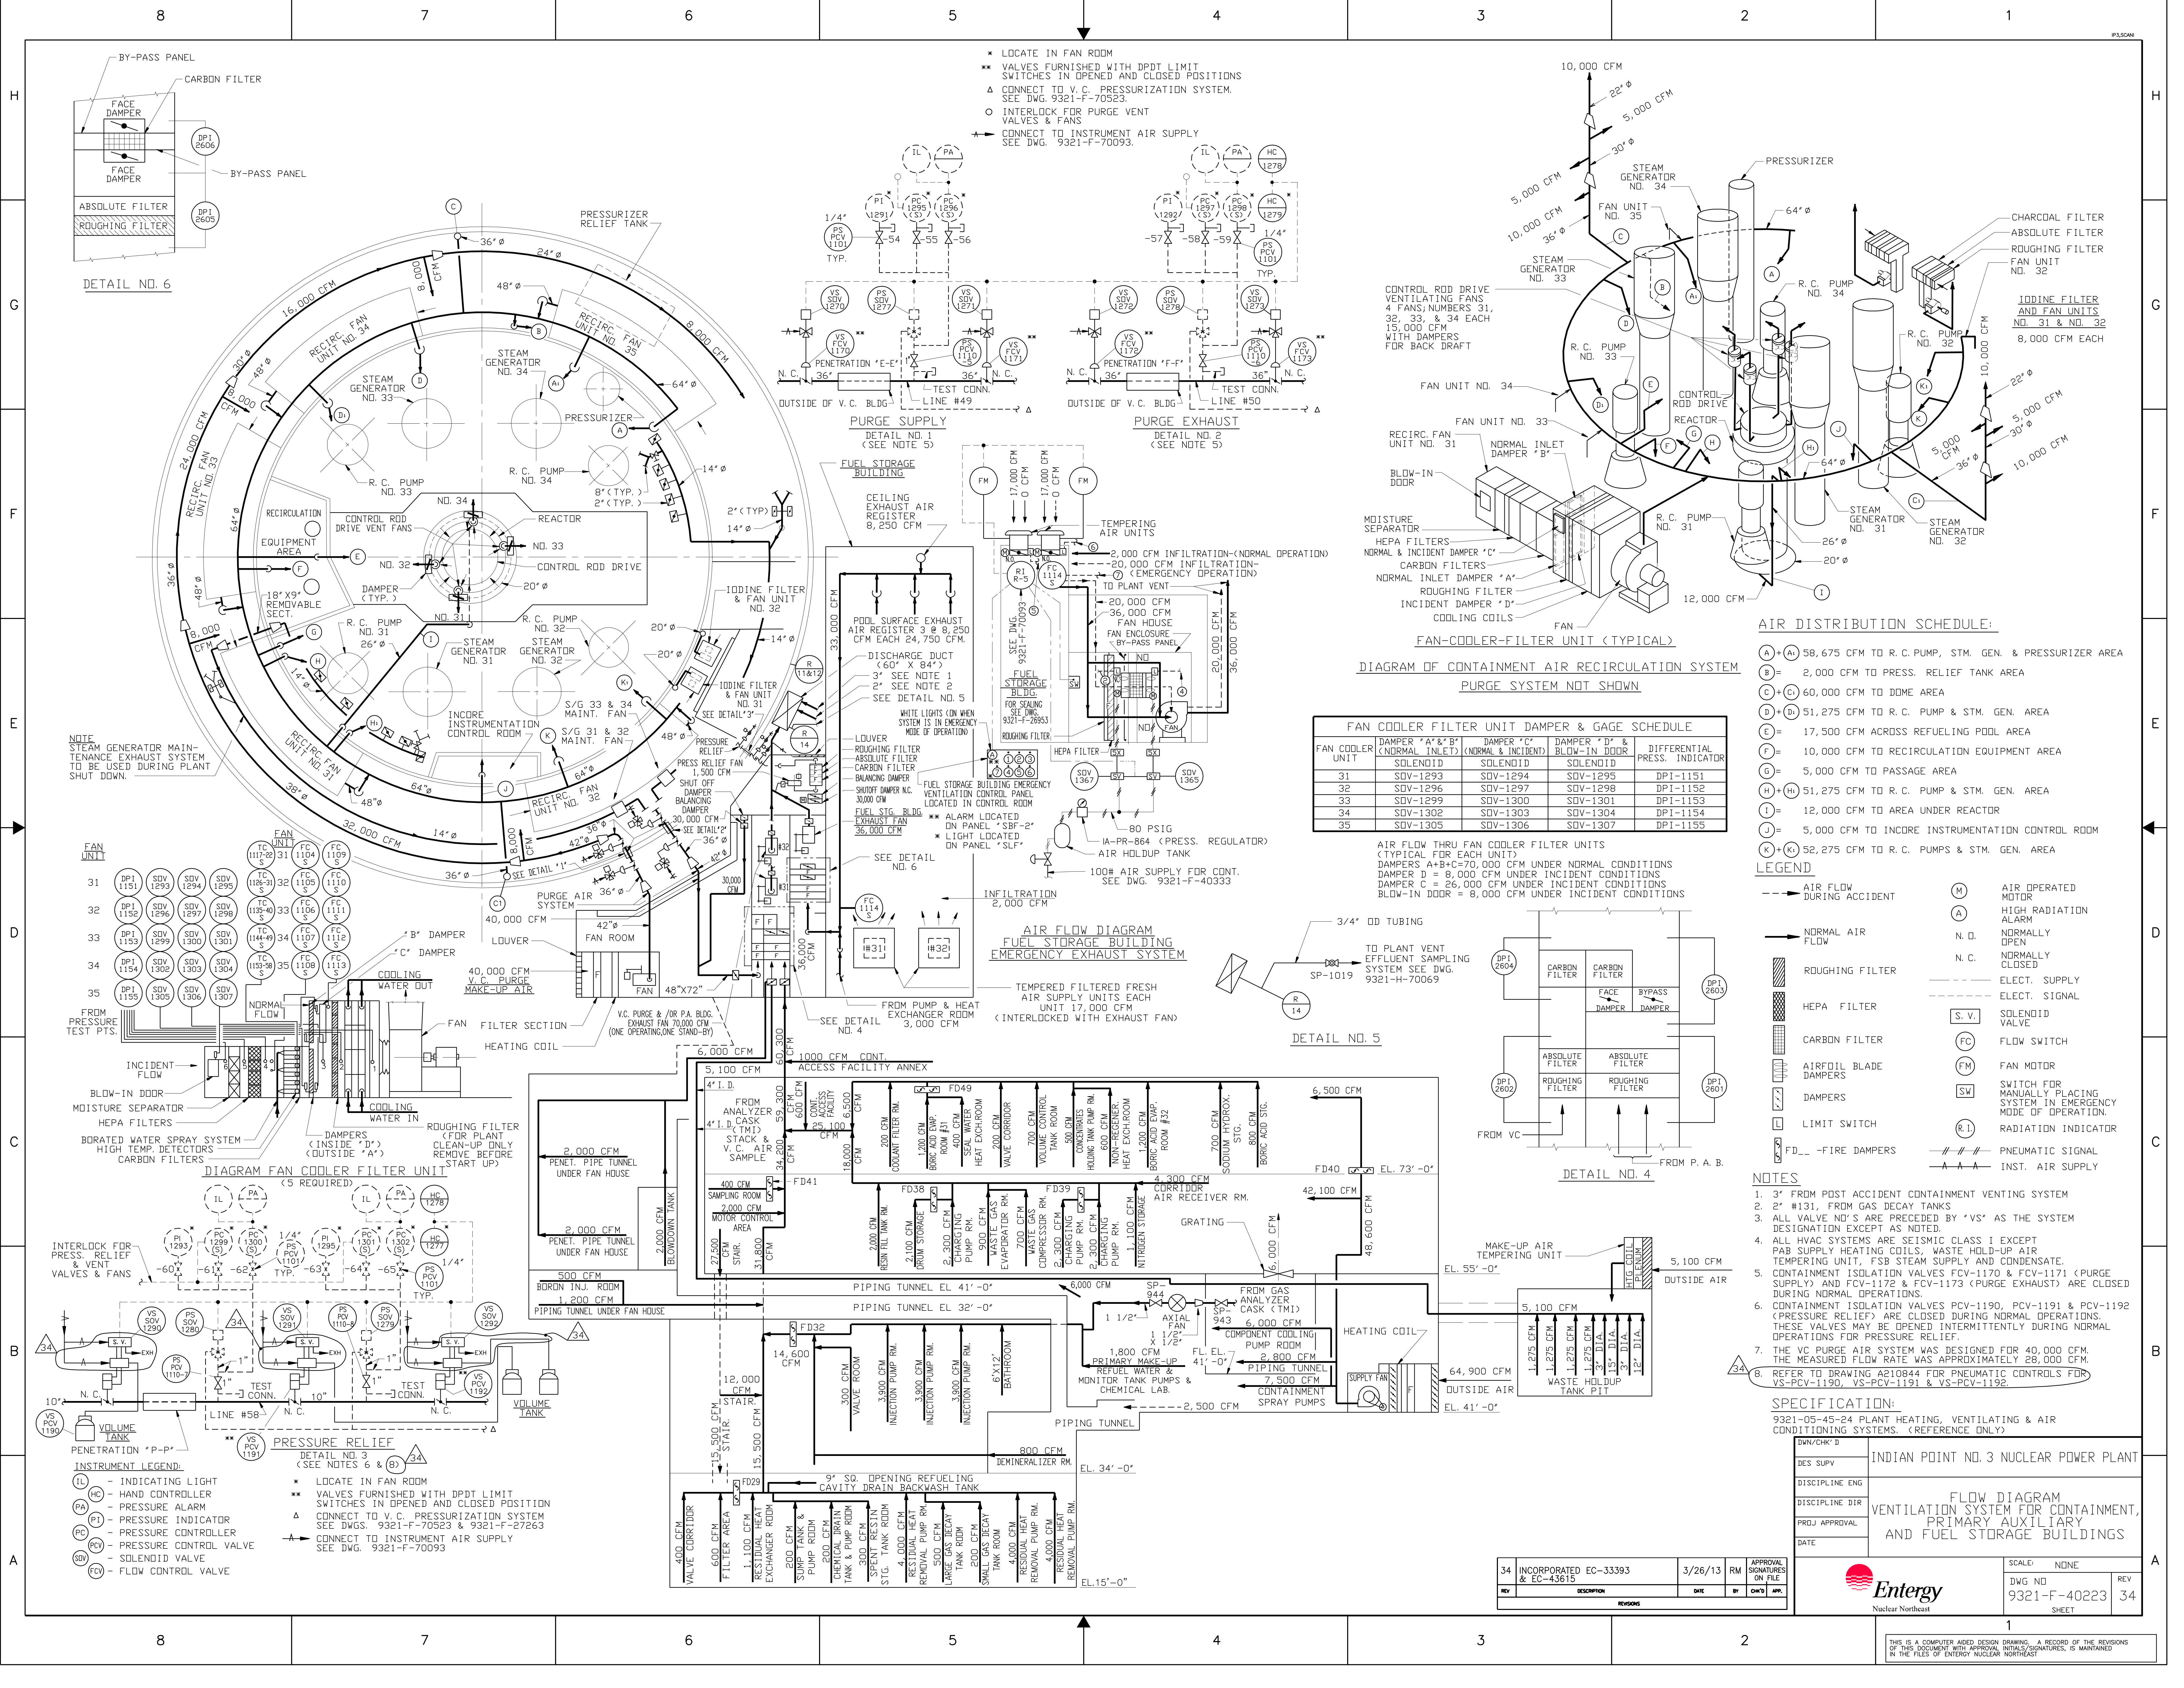

AIR DISTRIBUTION SCHEDULE:	
(A)+(A)	58,675 CFM TO R.C. PUMP, STM. GEN. & PRESSURIZER AREA
(B)	2,000 CFM TO PRESS. RELIEF TANK AREA
(C)+(C)	60,000 CFM TO DOME AREA
(D)+(D)	51,275 CFM TO R.C. PUMP & STM. GEN. AREA
(E)	17,500 CFM ACROSS REFUELING POOL AREA
(F)	10,000 CFM TO RECIRCULATION EQUIPMENT AREA
(G)	5,000 CFM TO PASSAGE AREA
(H)+(H)	51,275 CFM TO R.C. PUMP & STM. GEN. AREA
(I)	12,000 CFM TO AREA UNDER REACTOR
(J)	5,000 CFM TO INCORE INSTRUMENTATION CONTROL ROOM
(K)+(K)	52,275 CFM TO R.C. PUMPS & STM. GEN. AREA
LEGEND	
--- AIR FLOW DURING ACCIDENT	(M) AIR OPERATED MOTOR
--- NORMAL AIR FLOW	(A) HIGH RADIATION ALARM
--- ROUGHING FILTER	N.D. NORMALLY OPEN
--- HEPA FILTER	N.C. NORMALLY CLOSED
--- CARBON FILTER	(S.V.) SOLENOID VALVE
--- AIRFOIL BLADE DAMPERS	(FC) FLOW SWITCH
--- LIMIT SWITCH	(FM) FAN MOTOR
--- FD... - FIRE DAMPERS	(SW) SWITCH FOR MANUALLY PLACING SYSTEM IN EMERGENCY MODE OF OPERATION
--- PNEUMATIC SIGNAL	(R.I.) RADIATION INDICATOR
--- INST. AIR SUPPLY	

- NOTES
- 3" FROM POST ACCIDENT CONTAINMENT VENTING SYSTEM
  - 2" #131, FROM GAS DECAY TANKS
  - ALL VALVE NO.'S ARE PRECEDED BY 'VS' AS THE SYSTEM DESIGNATION EXCEPT AS NOTED
  - ALL HVAC SYSTEMS ARE SEISMIC CLASS 1 EXCEPT PAB SUPPLY HEATING COILS, WASTE HOLD-UP AIR TEMPERING UNIT, FSB STEAM SUPPLY AND CONDENSATE
  - CONTAINMENT ISOLATION VALVES FCV-1170 & FCV-1171 (PURGE SUPPLY) AND FCV-1172 & FCV-1173 (PURGE EXHAUST) ARE CLOSED DURING NORMAL OPERATIONS
  - CONTAINMENT ISOLATION VALVES PCV-1190, PCV-1191 & PCV-1192 (PRESSURE RELIEF) ARE CLOSED DURING NORMAL OPERATIONS. THESE VALVES MAY BE OPENED INTERMITTENTLY DURING NORMAL OPERATIONS FOR PRESSURE RELIEF
  - THE VC PURGE AIR SYSTEM WAS DESIGNED FOR 40,000 CFM. THE MEASURED FLOW RATE WAS APPROXIMATELY 28,000 CFM
  - REFER TO DRAWING A210844 FOR PNEUMATIC CONTROLS FOR VS-PCV-1190, VS-PCV-1191 & VS-PCV-1192

SPECIFICATION:

9321-05-45-24 PLANT HEATING, VENTILATING & AIR CONDITIONING SYSTEMS. (REFERENCE ONLY)

DESIGN/CHK'D	INDIAN POINT NO. 3 NUCLEAR POWER PLANT
DES. SUPV	
DISCIPLINE ENG	
DISCIPLINE DIR	
PROJ. APPROVAL	
DATE	

FLOW DIAGRAM VENTILATION SYSTEM FOR CONTAINMENT, PRIMARY AUXILIARY AND FUEL STORAGE BUILDINGS


34	INCORPORATED EC-33393 & EC-43615	3/26/13	RM	APPROVAL SIGNATURES ON FILE	
REV	DESCRIPTION	DATE	BY	CHK'D	APP.


SCALE: NONE	REV
DWG NO. 9321-F-40223	34
SHEET	

Entergy Nuclear Northeast






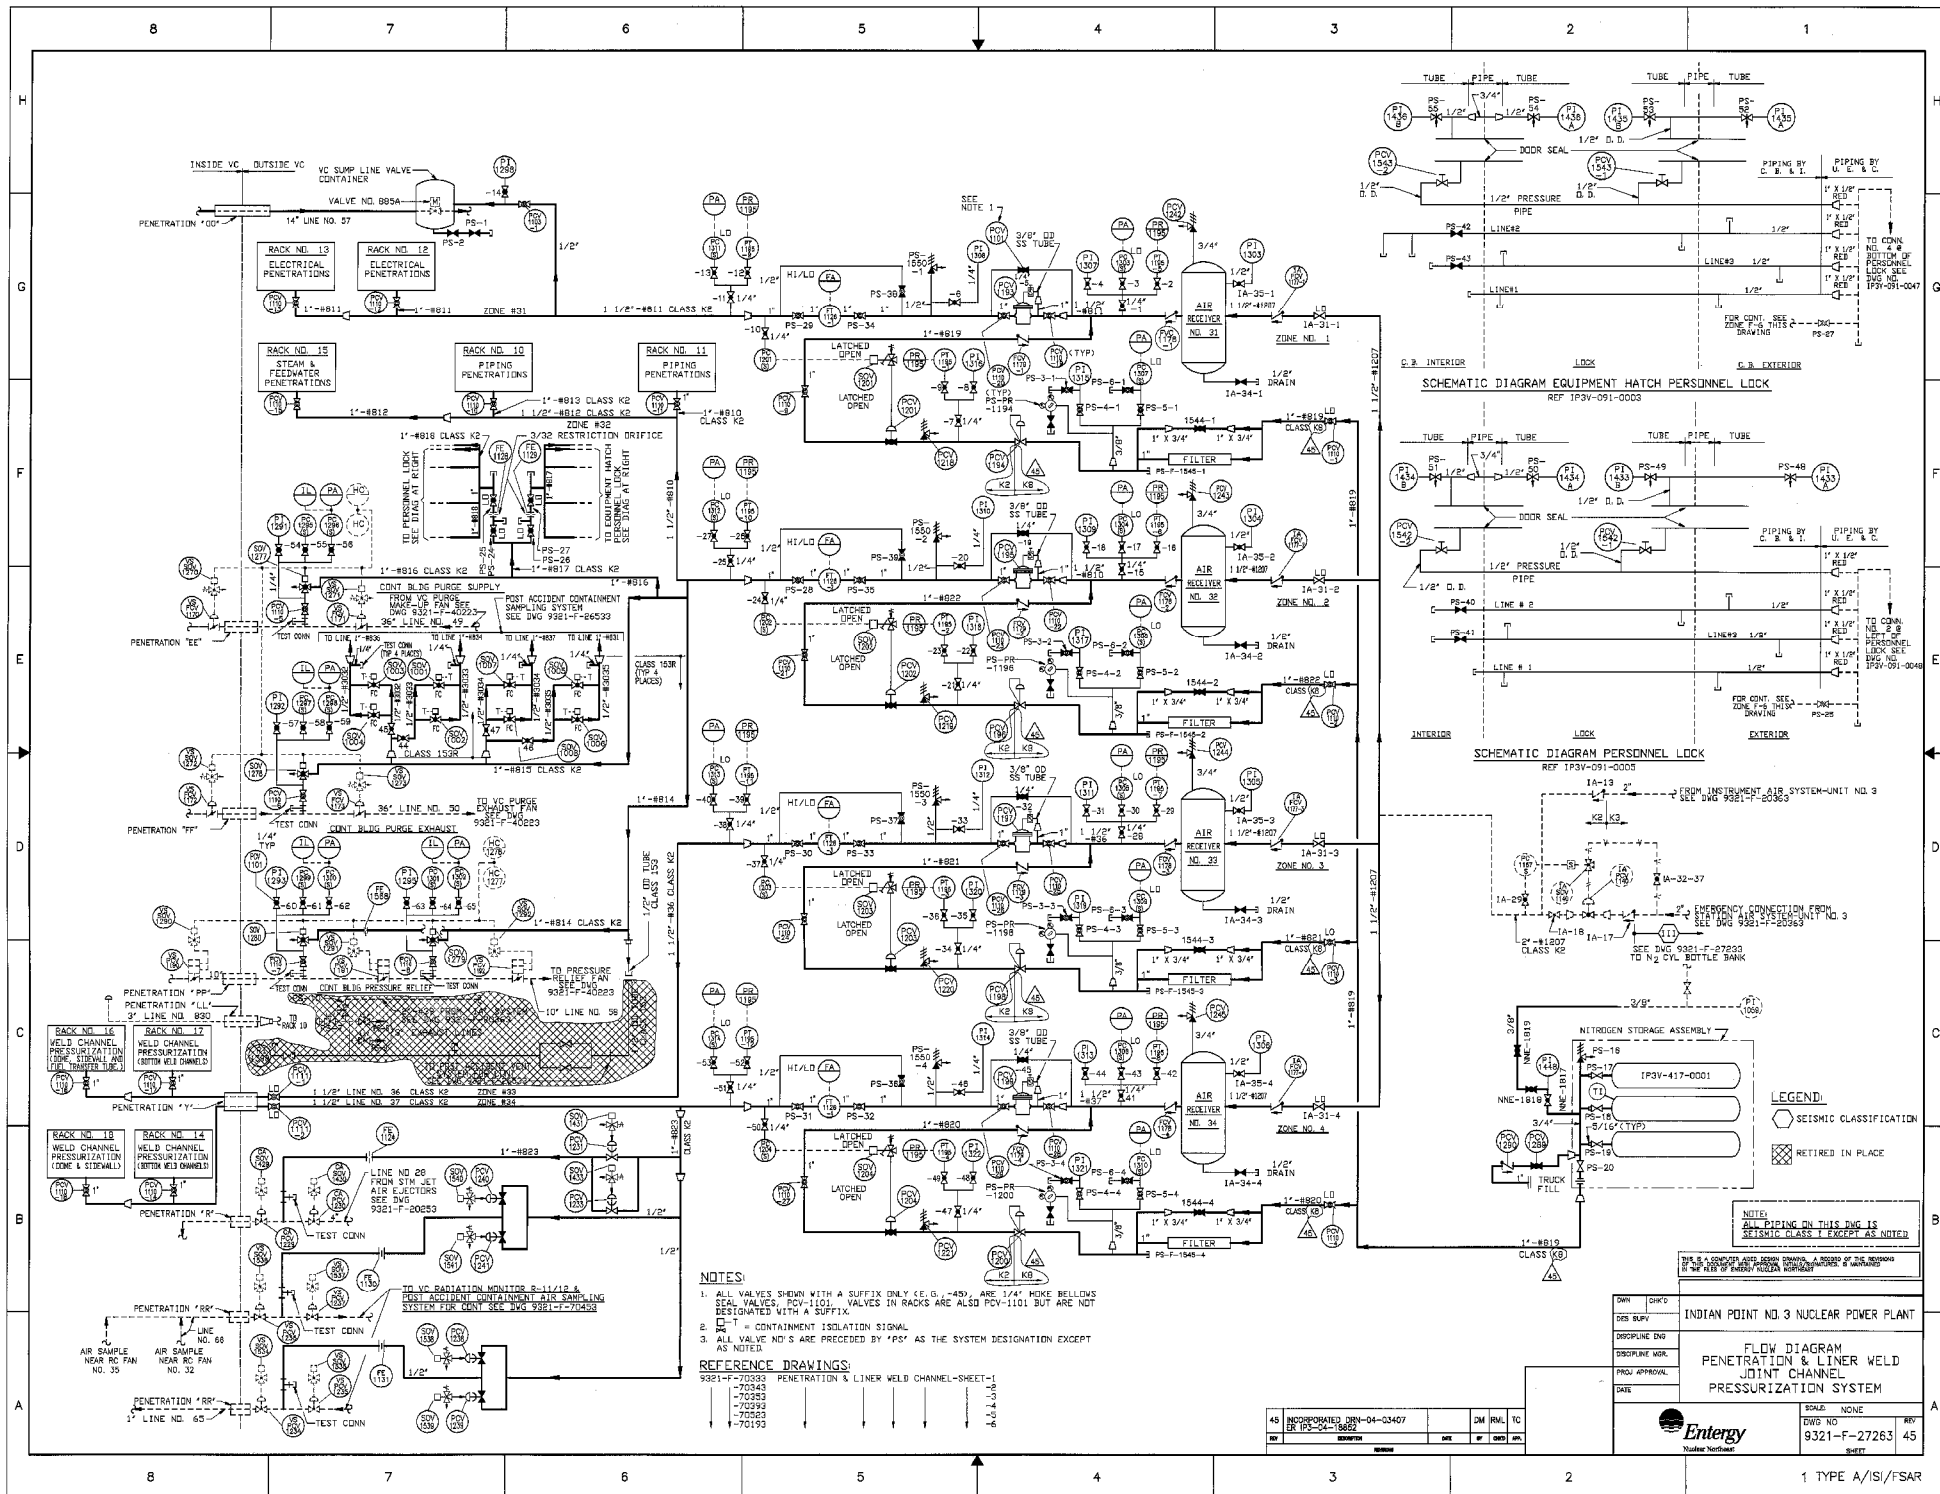

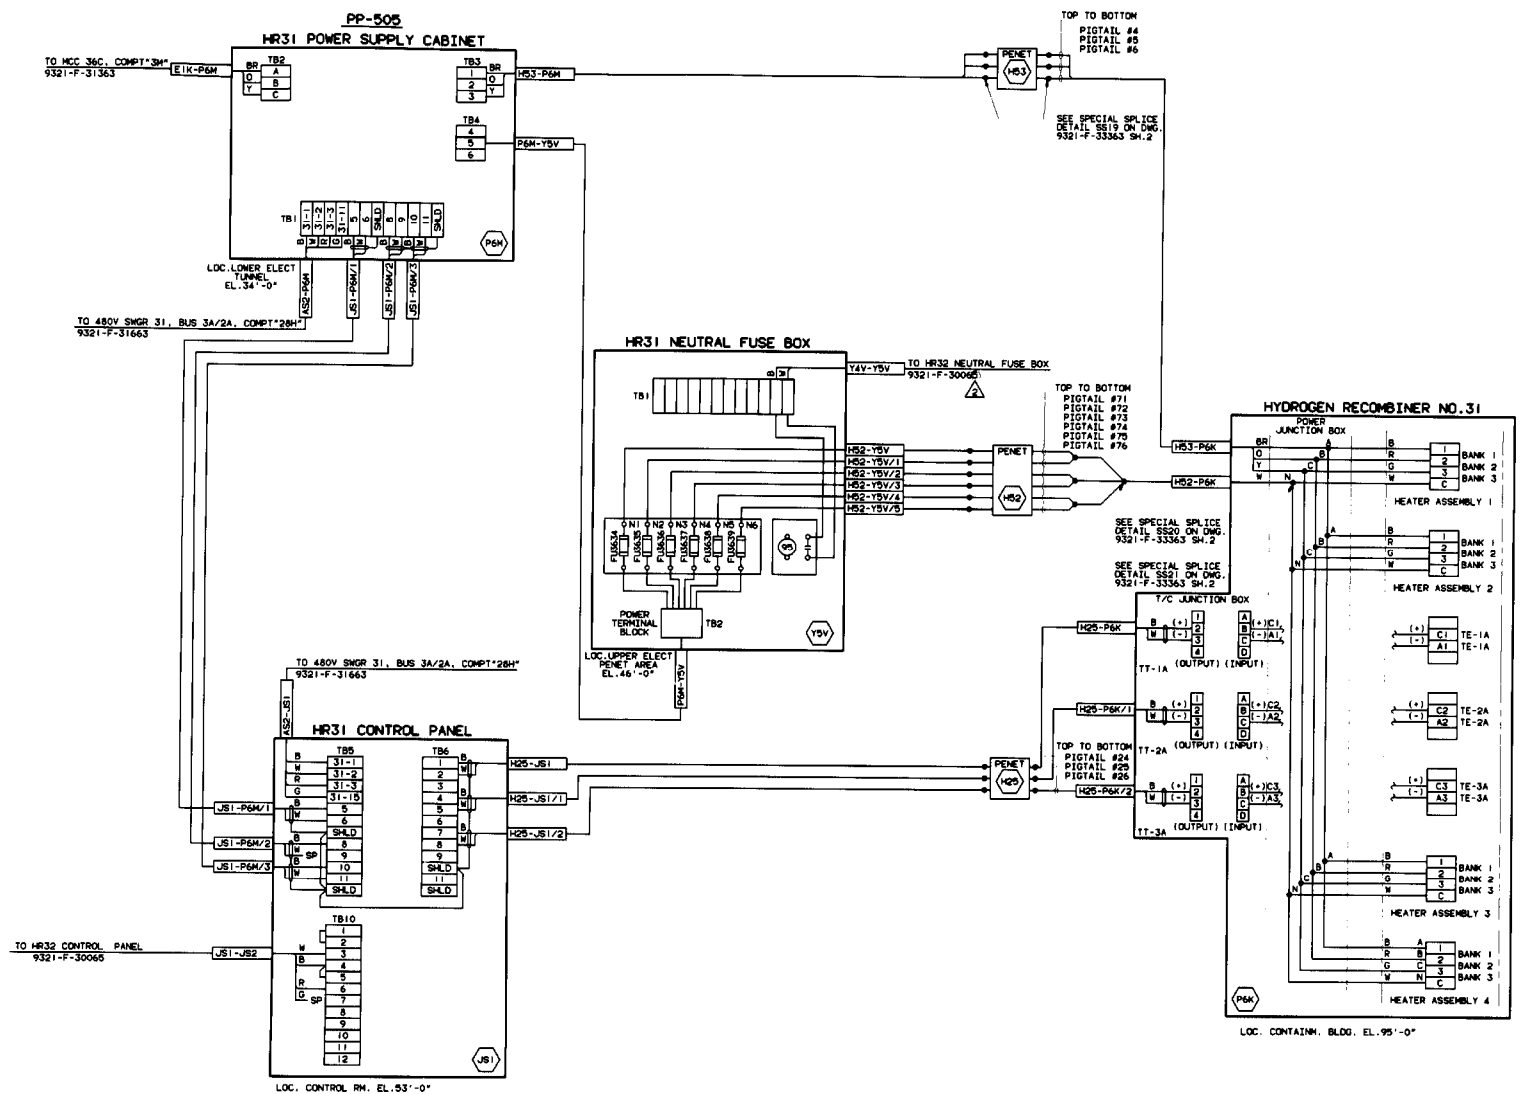

REV	DATE	DESCRIPTION	BY	CHK	APP
1		AS BUILT PER DCR100146280			
2		ORIGINAL ISSUE - AS BUILT PER			
3		REVISED			

DESIGN	DESIGN	INDIAN POINT NO. 3 NUCLEAR POWER PLANT
DESIGN	DESIGN	
DISCIPLINE	DISCIPLINE	HYDROGEN RECOMBINER NO. 31
DISCIPLINE	DISCIPLINE	WIRING DIAGRAM
DATE	DATE	
		SCALE: NONE DWG NO: 9321-F-30064 SHEET: 2 (FSAR)

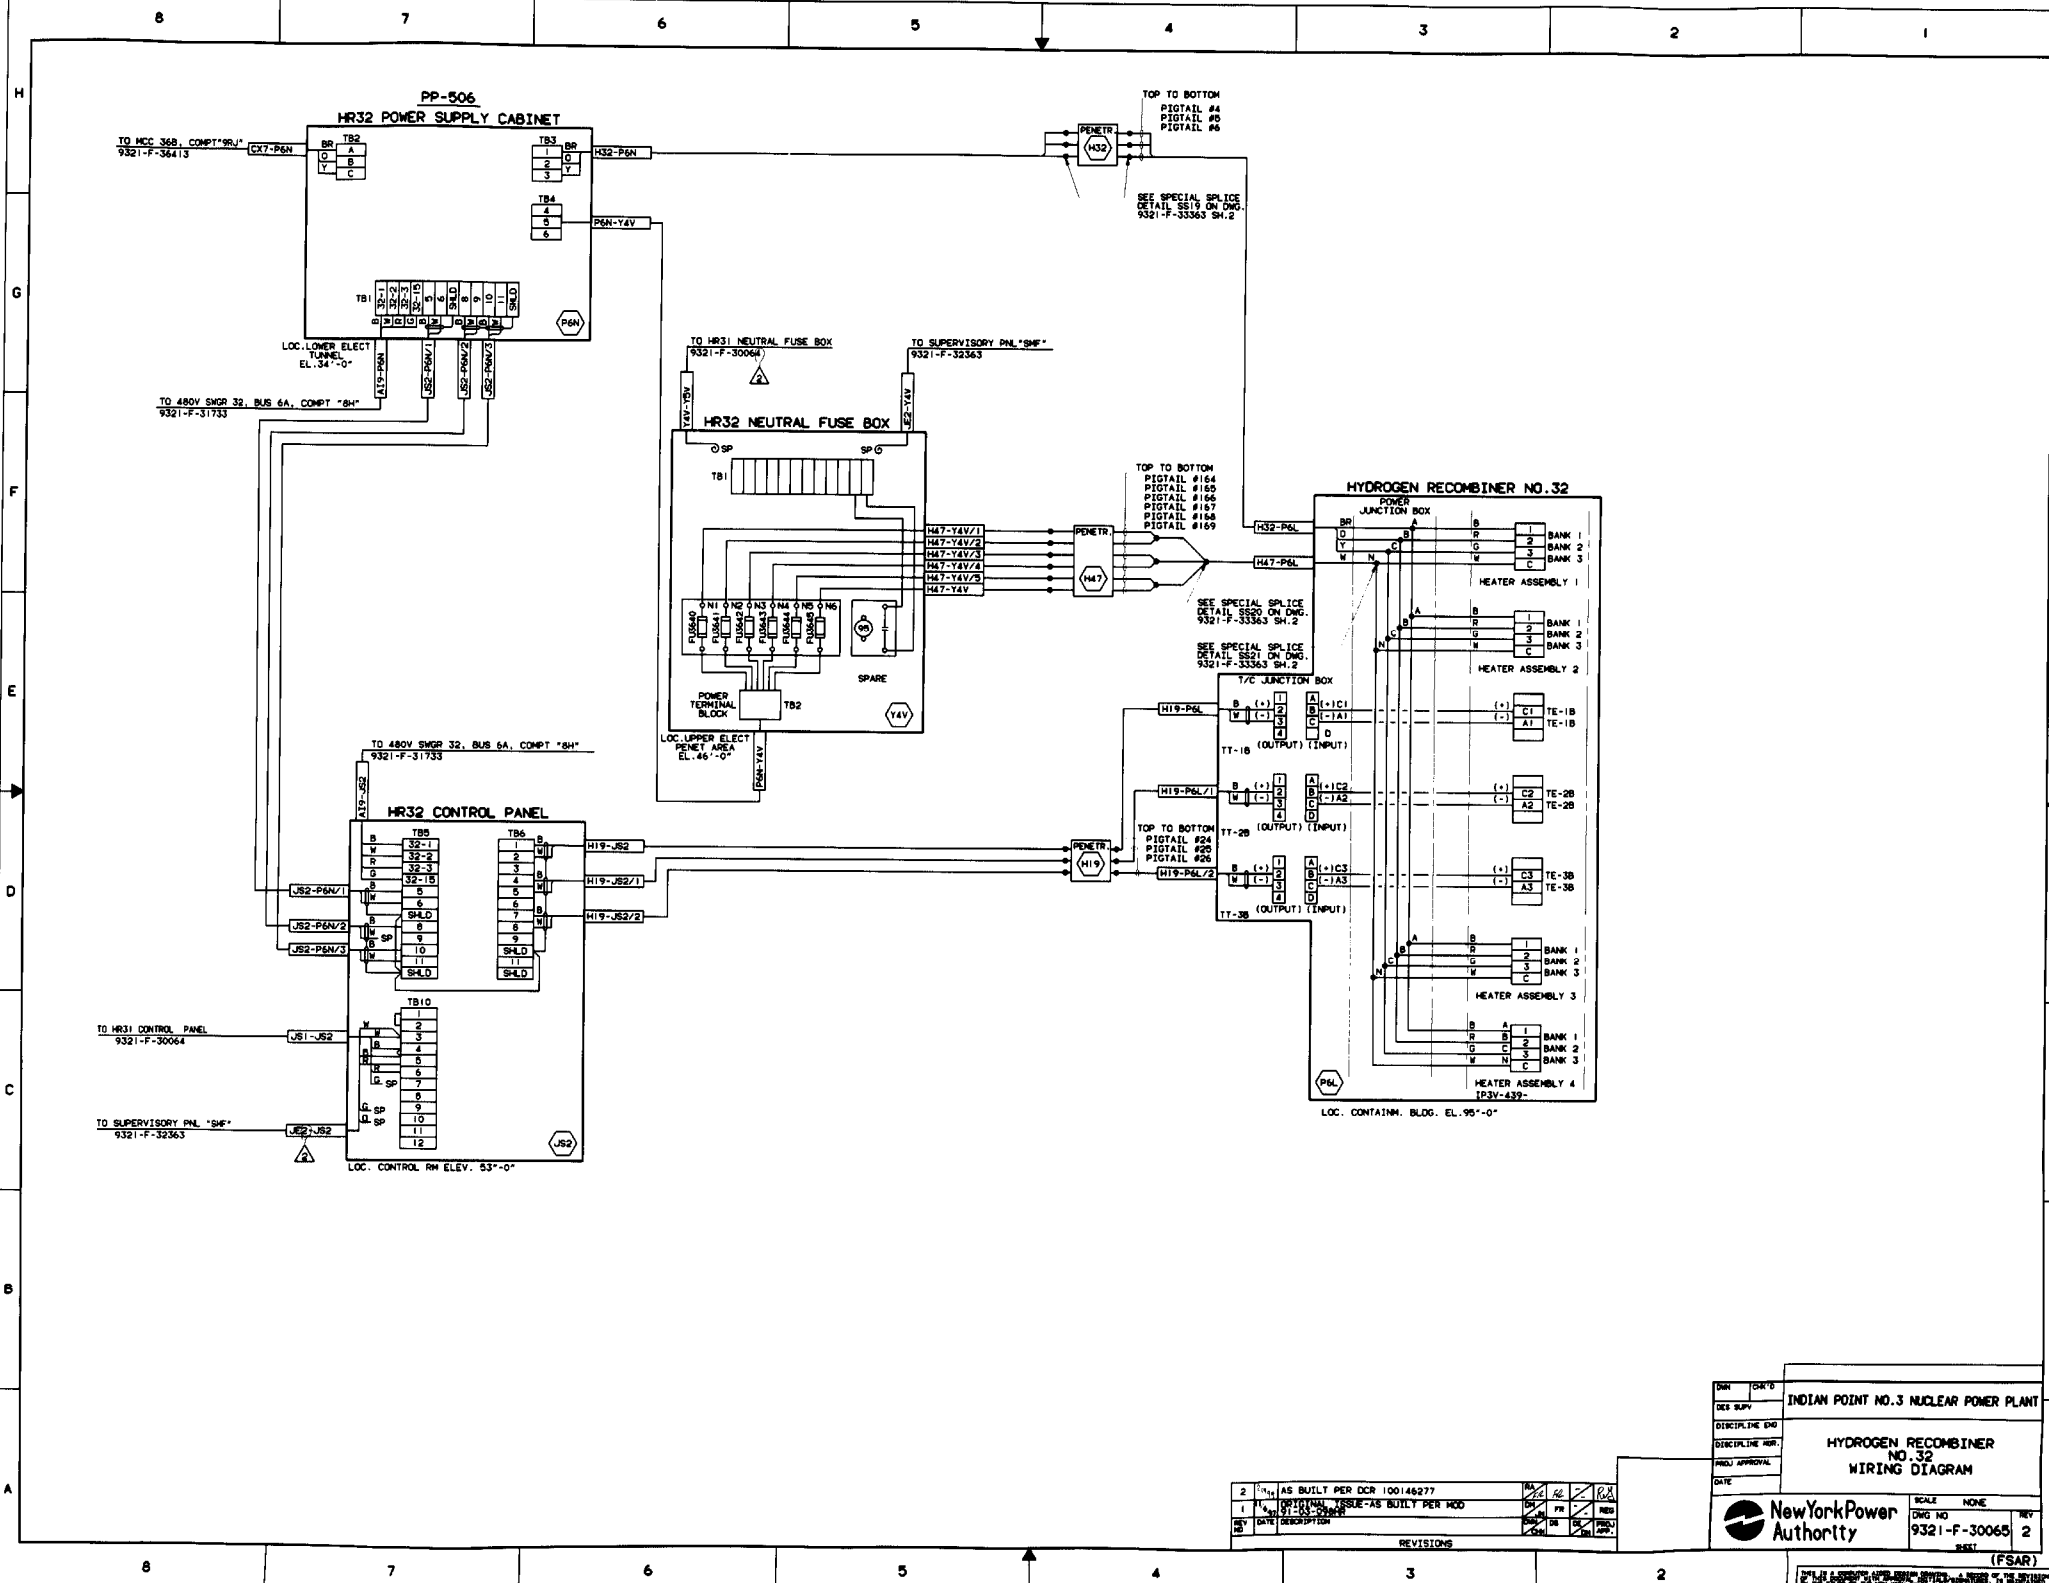

REV	DATE	DESCRIPTION	BY	CHKD	APP'D
1		AS BUILT PER DCR 100146277			
2		ISSUED AS BUILT PER HOD			
3					
4					
5					
6					
7					
8					
9					
10					
11					
12					

INDIAN POINT NO.3 NUCLEAR POWER PLANT	
HYDROGEN RECOMBINER NO. 32 WIRING DIAGRAM	
SCALE: NONE	REV: 2
New York Power Authority	
(FSAR)	