

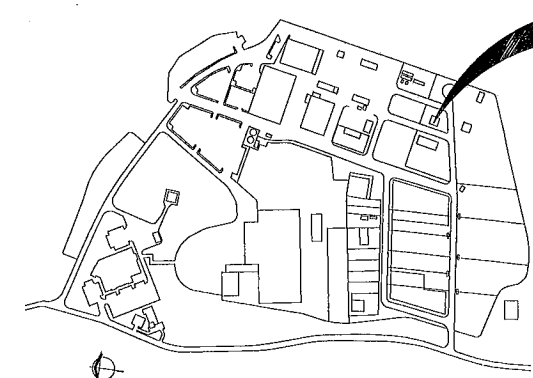


**G-21**  
WELDING/RIGGING  
5530 SF

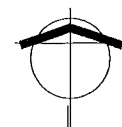


MESA VICINITY MAP

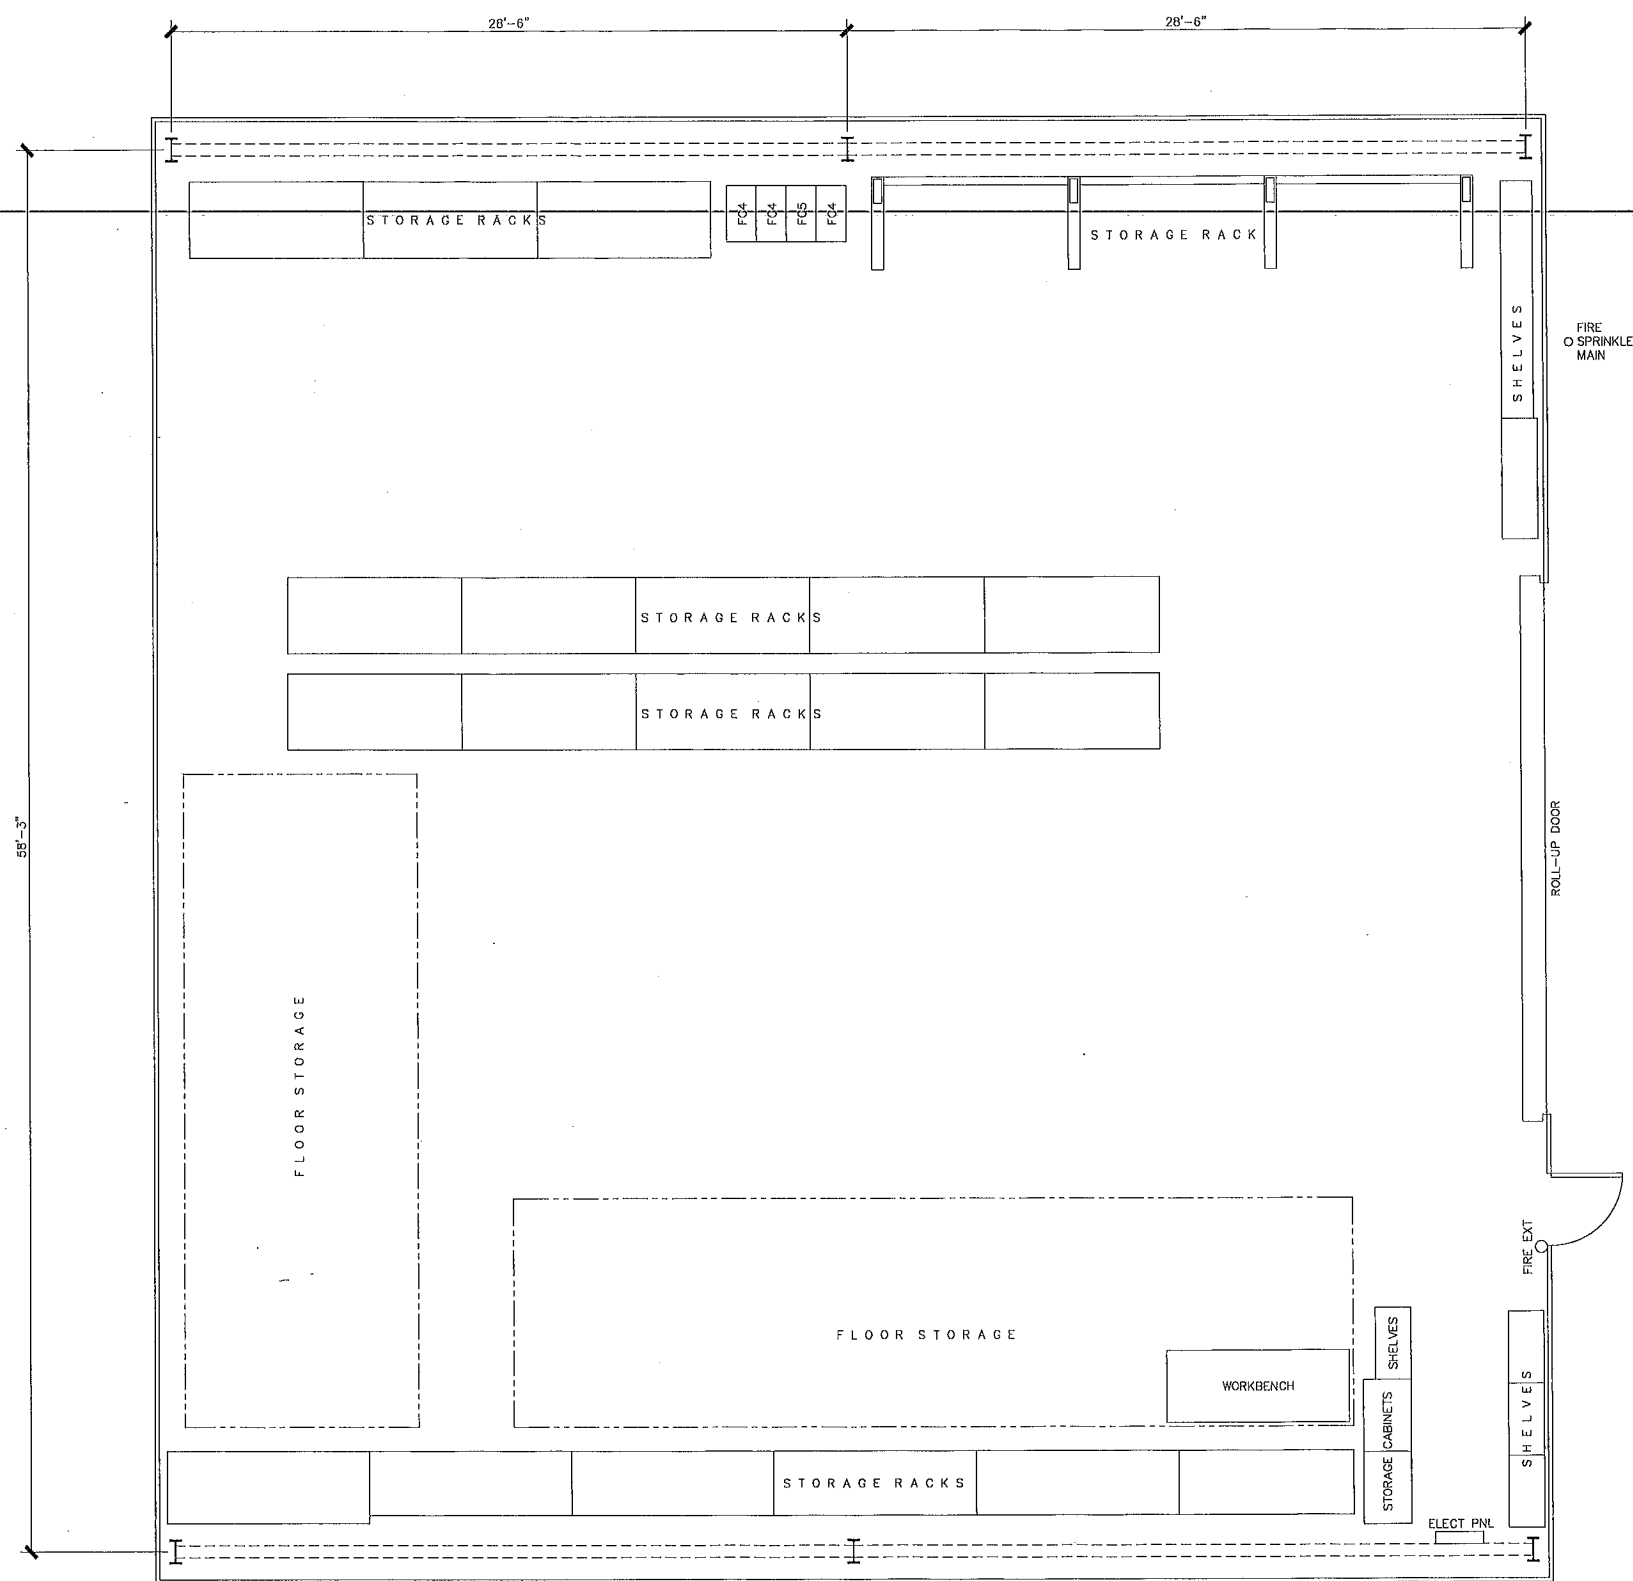

0'1' 5' 10'

**G-22**  
STARYARD WAREHOUSE  
3574 SF

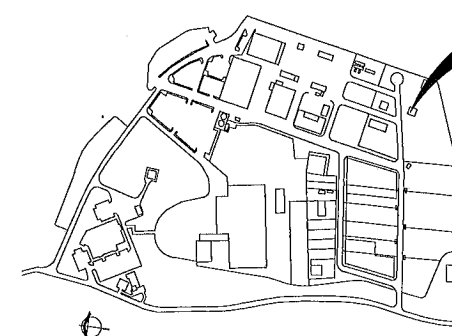

MESA VICINITY MAP

**G-22**  
**ASBUILT**

Southern California Edison SITE FACILITIES PLANNING 10/23/89	ABL TG22		1/4"=1'-0"	SCALE
	M. SMITH	DRAWN BY		
	DATE	DATE		

REVISION	DATE	BY

