

A-135
50-348/364-CIVP
5/21/92

APCO EX. 135

CONNECTRON INC. NSS3 TERMINAL BLOCK ASSEMBLY


AS-BUILT DIMENSIONS

SCALE 1"=1"


JUN -2 12:13

BASED ON EXAMINATION OF EXISTING SAMPLE


OFFICE OF SECRETARY
DOCKETING & SERVICE
BRANCH

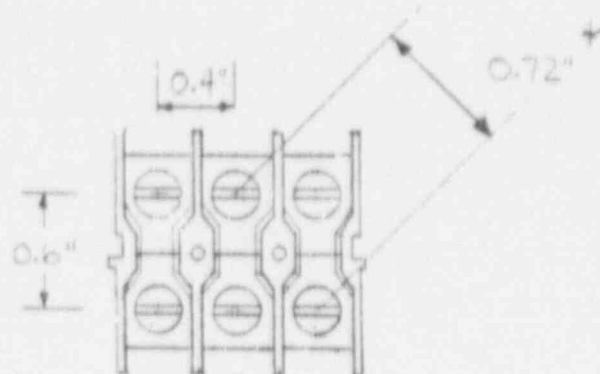

PLAN VIEW

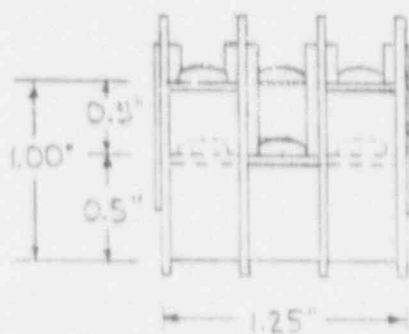

FRONT VIEW

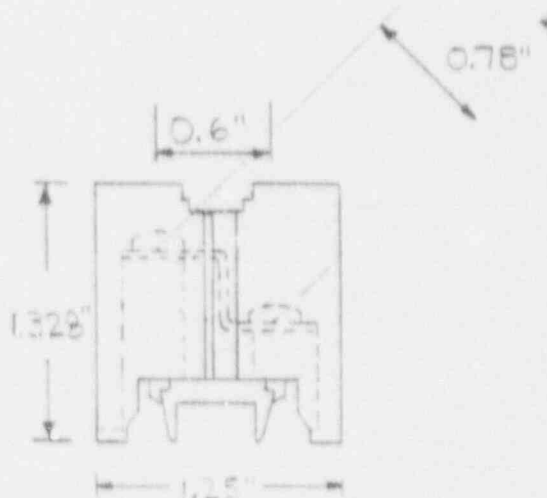

END VIEW

* THESE ARE CALCULATED DIMENSIONS

$$1.72 = \sqrt{(0.6)^2 + (0.4)^2} \quad \text{and} \quad 0.78 = \sqrt{(0.6)^2 + (0.5)^2}$$

9207310226 920521
PDR ADOCK 05000348
G PDR

DRAWN BY J. L. HAYES/ALR

CHECKED BY: R. P. Pelt