



**MacDermid**

INCORPORATED

...right to the Finish!®

50 BROOKSIDE ROAD - WATERBURY, CONNECTICUT 06720 - TELEPHONE (203) 575-5700 - TELEX 4436011

May 15, 1985

MS 16  
P9

Nuclear Regulatory Commission  
Region I  
Nuclear Materials Safety, Section B  
631 Park Avenue  
King-of-Prussia, PA 19406

Dear Dr. Wurtz:

Enclosed please find a facilities diagram with the new location of our gas chromatograph/electron capture detector (marked with a red "X"). The laboratory in which this equipment is located is a limited access area which remains locked when not in use. Further, the building in which the laboratory is located is secured via an electronic/magnetic coded-card system.

If any additional information is required for amendment 170.31 (3P) of 10CFR170, please contact me at (203)-575-5936. Refer to Control Number 03498.

Sincerely,

Jenifer Marchesi  
Supervisor, Analytical Services

JM/cjw


8506190097 850530  
REG1 LIC30  
06-18322-02 PDR

**"OFFICIAL RECORD COPY"**


**ML10**

03498


MAY 20 1985

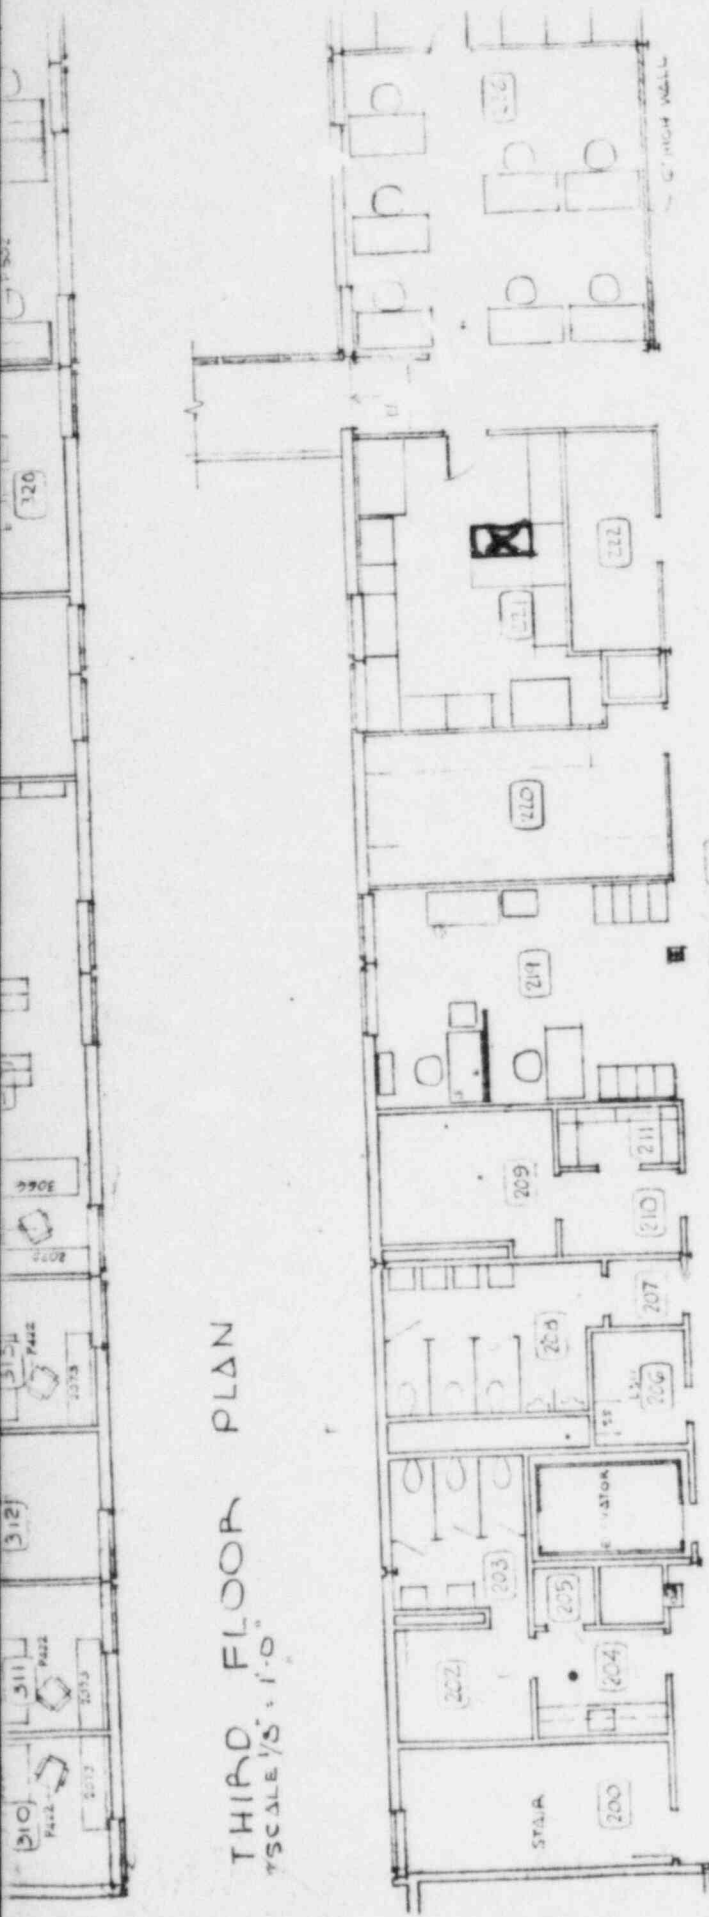

THIRD FLOOR PLAN  
SCALE 1/8" = 1'-0"

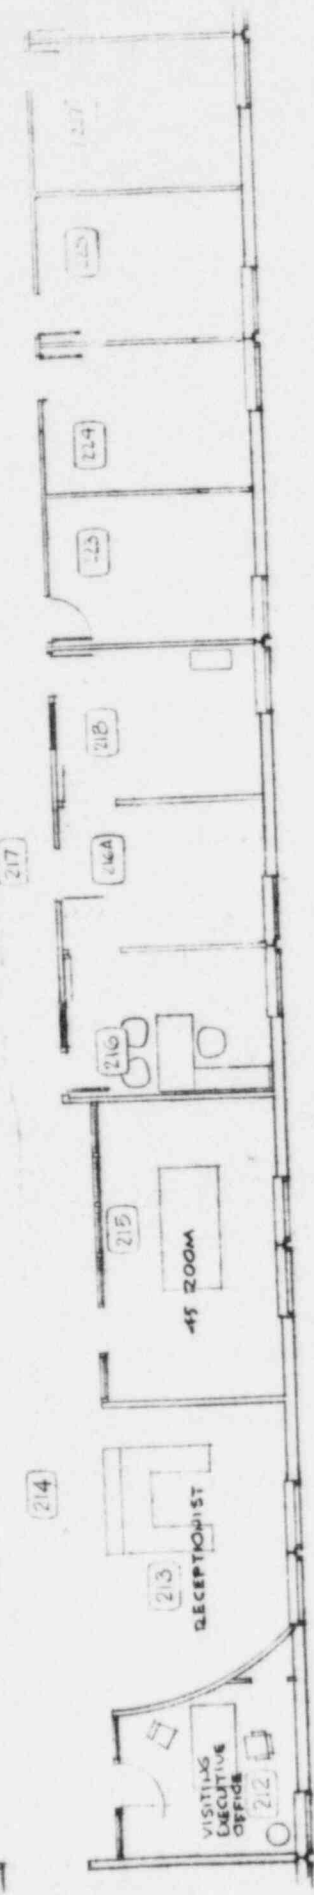

SECOND FLOOR PLAN  
SCALE 1/8" = 1'-0"

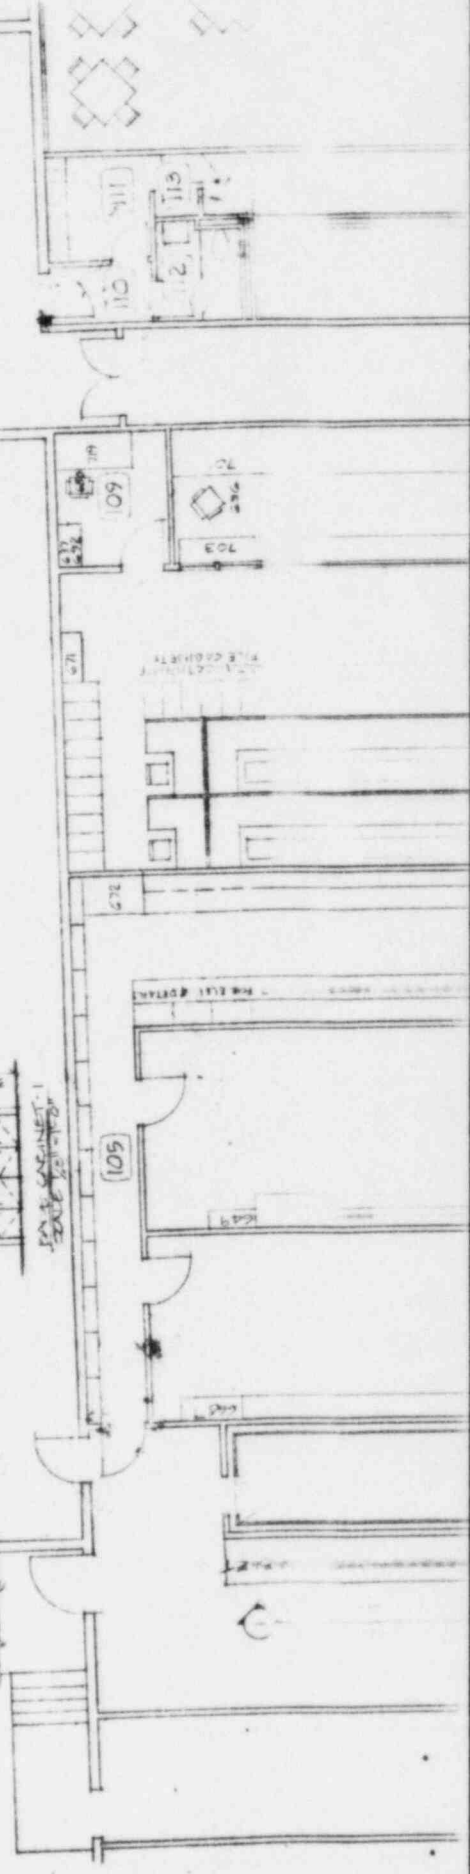

# DOCUMENT/ PAGE PULLED

ANO. 8506190097

NO. OF PAGES 1

## REASON

☐ PAGE ILLEGIBLE:

☐ HARD COPY FILED AT: PDR CF  
OTHER \_\_\_\_\_

☐ BETTER COPY REQUESTED ON \_\_\_\_/\_\_\_\_/\_\_\_\_

☐ PAGE TOO LARGE TO FILM.

☒ HARD COPY FILED AT: PDR CF  
☒ OTHER Region I

☒ FILMED ON APERTURE CARD NO. 8506190097-01

5/6/85

## TELEPHONE OR VERBAL CONVERSATION RECORD

TIME

11:00

☒ A.M.  
☐ P.M.☒ INCOMING CALL☐ OUTGOING CALL☐ VISIT

PERSON CALLING

Jennifer Marchese

OFFICE/ADDRESS

Mac Dermid, Inc.

PHONE NUMBER

EXTENSION

(203) 575-5936

PERSON CALLED

E. Wurtz

OFFICE/ADDRESS

RI

PHONE NUMBER

EXTENSION

337-5168

## CONVERSATION

SUBJECT

Telephone Def. of L.C. Amendment

SUMMARY

- ① MacDermid will send a facilities diagram indicating the location of the GC.
- ② Will include how the GC will be secured to prevent removal of the GC.

"OFFICIAL RECORD COPY"

ML10

REFERRED TO:

ACTION REQUESTED

ACTION TAKEN

☐ ADVISE ME OF  
ACTION TAKEN.

INITIALS

DATE

INITIALS

DATE