

## MEMO

### Hochiki America Corporate Planning




telephone (714) 898-0795



fax (714) 892-2809



e-mail: us009760@interramp.com

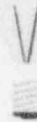

**DATE:** June 7, 1996 **CC:** LL, DH- HA

**TO:** Chris Brown- USNRC **# of pages:** 1

**FROM:** Gyo Shinozaki *GS*

**RE:** Reply to June 3, 1996 letter

The following are Hochiki America's response to your letter dated June 3, 1996.

- 1) The QA/QC program descriptions have been revised in our AI\_ SERIES submittal of June 7, 1996. The procedures follow Appendix C of Regulatory Guide 6.9. Additionally you will find attached a marked up copy of material drawings. These drawings indicate the areas that are dimensionally checked by our incoming inspection personnel. By verifying that the indicated areas on each part conform to specification we can guarantee that the chamber assembly will also conform to design specifications. The drawings are QC versions of enclosures A7, A8, A10, A11, A12, B5, B7, B9 and B11 included in our AI\_ SERIES submittal.
- 2) Drop tests were inexplicably performed at 6 ½ feet. We repeated the test at 12 feet. This represents a height similar to what our detectors are installed at in a ceiling. The results are included in AI\_ SERIES submittal enclosures A18 and B28. The second issue regarding removable contamination is still an open issue. We have been told that Wipe Tests were performed on the test equipment before and after the vibration tests and that a passing evaluation for the entire test means that the Wipe Test was also sufficient. We are currently looking for the ISO or ANSI version of the JIS standard used for this test.
- 3) As stated above we are currently attempting to locate a copy of ISO 1677 and 2919 or ANSI N542 which are the JIS equivalent of the Sealed Radioactive Source Standard. Please allow us 1 more week to provide this for you. As for the issue of the holder, please note that XM-11781 is a Hochiki part number and AZ-93-063 is the Hochiki drawing number for the same part. The testing organization simply noted the part number instead of the drawing number.
- 4) A new drawing of the name label with the correct safety statements is included in AI\_ SERIES submittal enclosure A13.
- 5) The thickness of both AIE and AIC type detectors is 0.031 inches. The process in which the holder and inner electrode are secured is outlined in AI\_ SERIES submittal- "Details of Construction".
- 6) Upon further review of the calculations in our original submittal it was found that all the calculated doses were higher than measured except for the 25cm distance. Thus in the AI\_ SERIES submittal the calculations involving the 25cm distance were recalculated using the higher of the 2 actual measurements, the AIE value of 1.24 uR/hr. In this way we can insure calculations based on worst case scenarios.

Please let me know if you should have any questions on our responses. Thank you for your cooperation in advance.

9610210056 960607

PDR RC \*

SSD

PDR



DRAWN Y. Kawabata	DATE 20. OCT. '95	TITLE OUTER ELECTRODE
CHECKED F. Suganuma	UNIT MM	DWG NO. A2-95-0248
APPROVED J. Masuno	SCALE 1:1	HOSHIMI CORPORATION

NO. 918

NO. 918

HOCHIKI AMERICA CORP

10:22AM

JUN. 6.1996




NO. 918

NO. 918

HOCHIKI AMERICA CORP

10:22AM





JUN. 6.1996

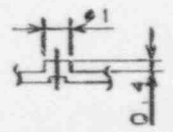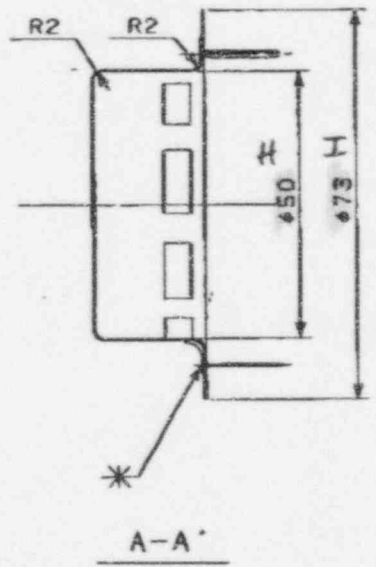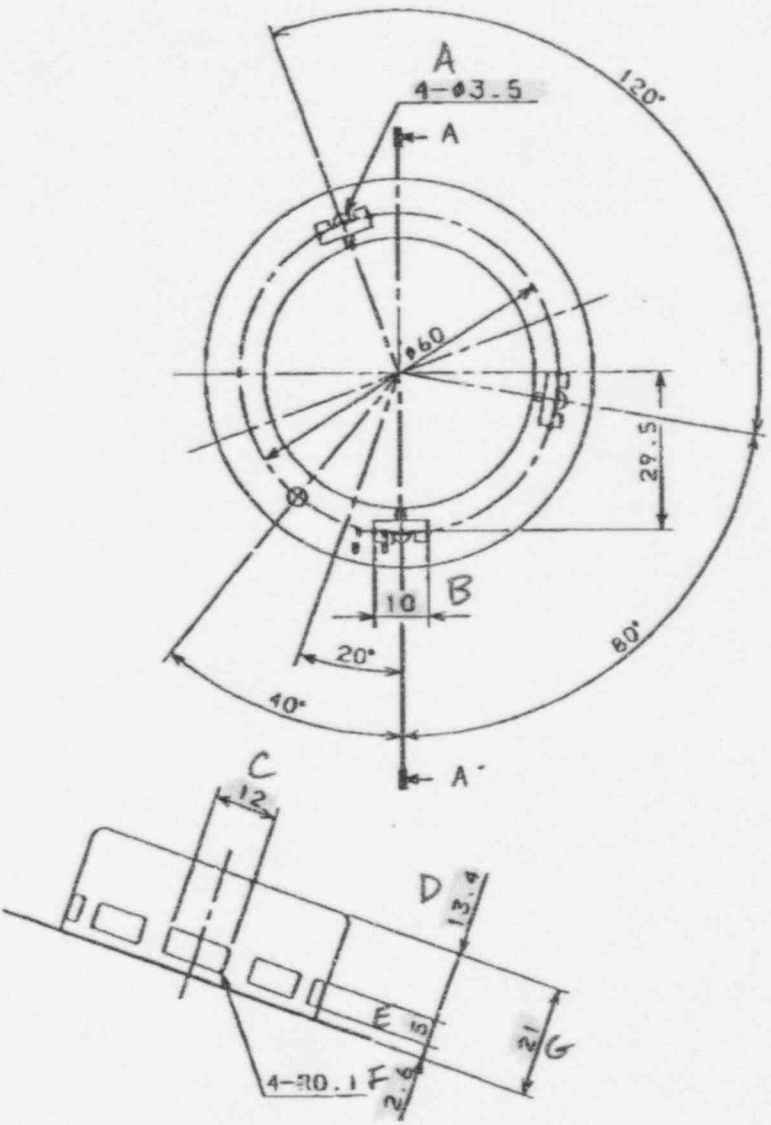

B-B' (S=5:1)

AIC

DRAWN <i>H. Shibuya</i>	DATE 6-SEP-'93	TITLE OUTER ELECTRODE
CHECKED <i>T. Iwata</i>	UNIT mm	DWG NO. A2-93-0161
APPROVED <i>O. Kinoshita</i>	SCALE	HOCHIKI CORPORATION

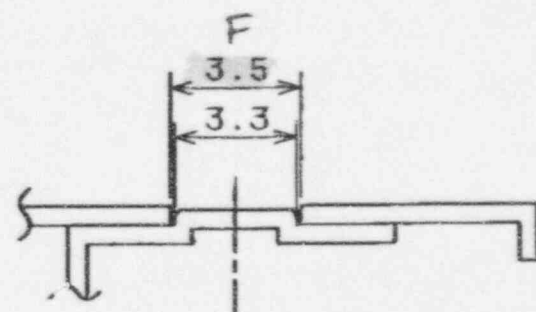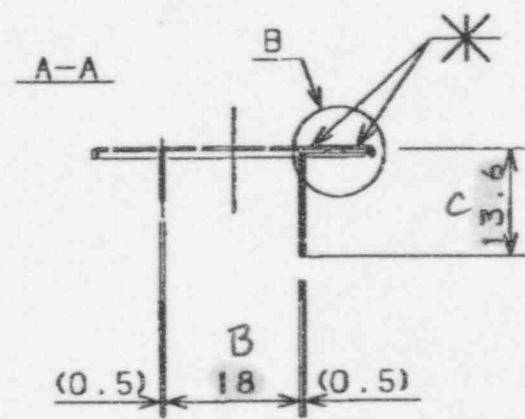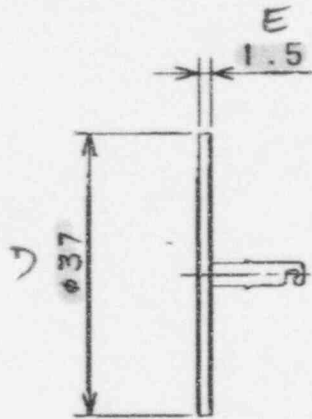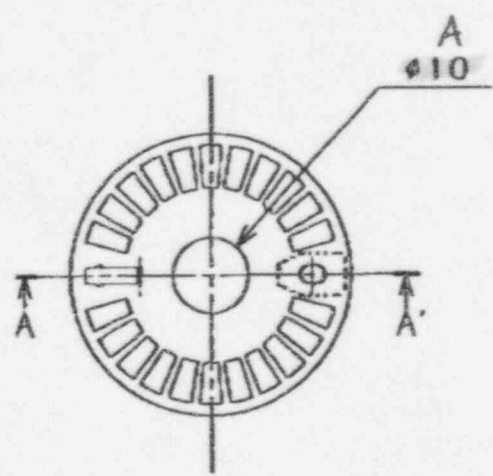

DRAWN: Y. Kanabata	DATE 20.OCT.'95	TITLE INTERMEDIATE ELECTRODE
CHECKED P. Sugawara	UNIT mm	DWG NO. A2-95-0249
APPROVED Miyawaka	SCALE 1:1	HOCHIKI CORPORATION

A1E



NO. 918 760 P. 7/8

HOCHIKI AMERICA CORP


10:22AM

JUN. 6. 1996


RECEIVED

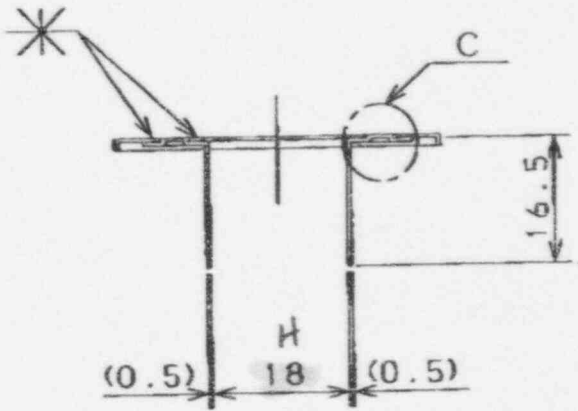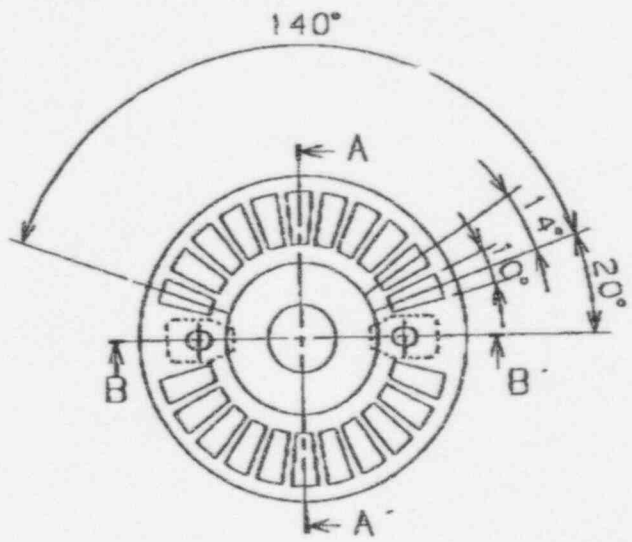

B-B'



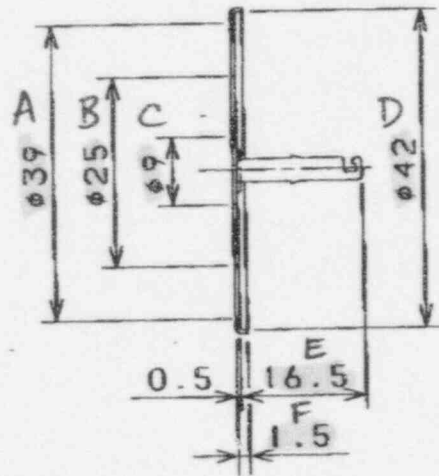


A-A'

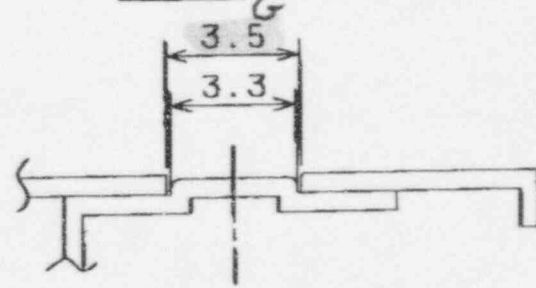


C (5:1)

DRAWN H. Shibuya	DATE 6. SEP. '93	TITLE INTERMEDIATE ELECTRODE
CHECKED T. Sumita	UP. F M M	DWG NO. A2-93-0162
APPROVED O. Kinowa	SCALE	HOCHIKI CORPORATION

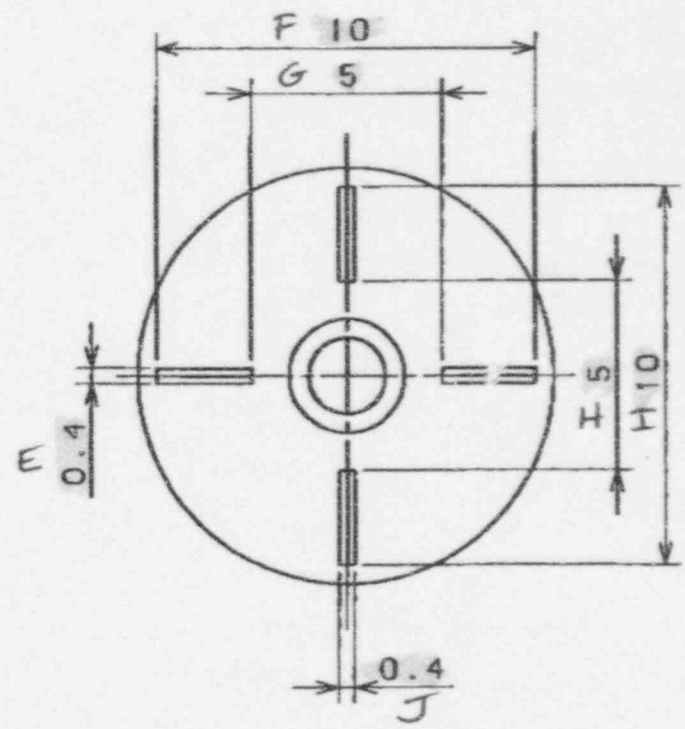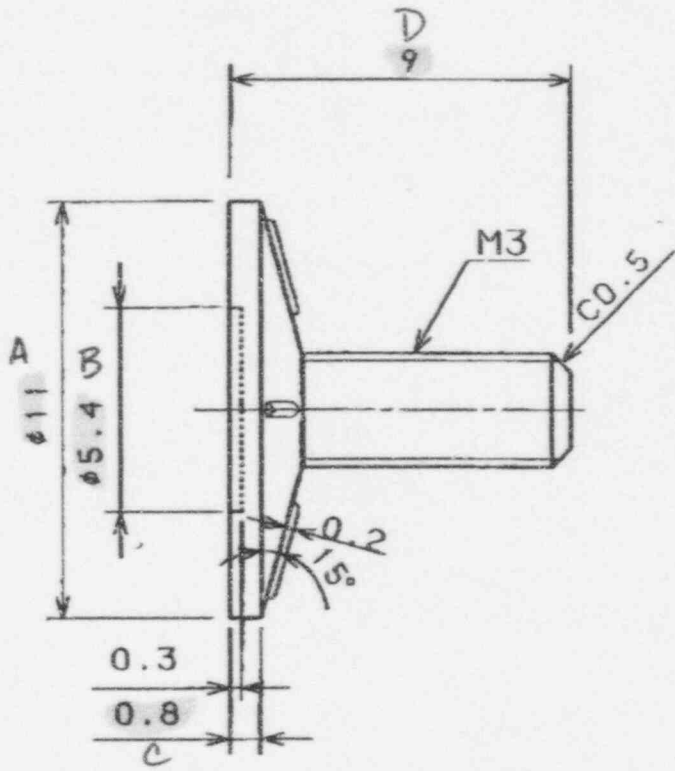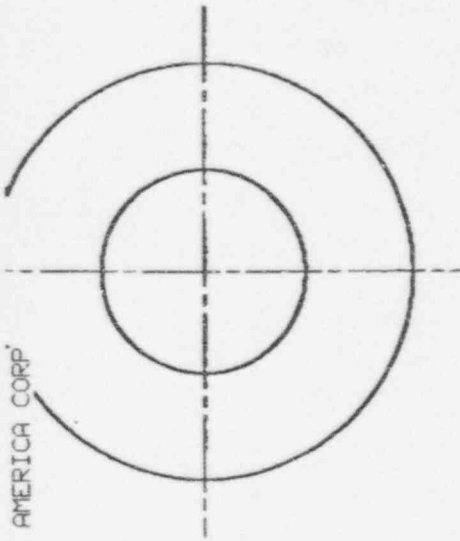

DRAWN <i>Y. Kawabata</i>	DATE 20.OCT.'95	TITLE INNER ELECTRODE
CHECKED <i>P. Nopachan</i>	UNIT mm	DWG NO. A2-95-0250
APPROVED <i>J. Kawan</i>	SCALE 5:1	HOCHIKI CORPORATION











AIE

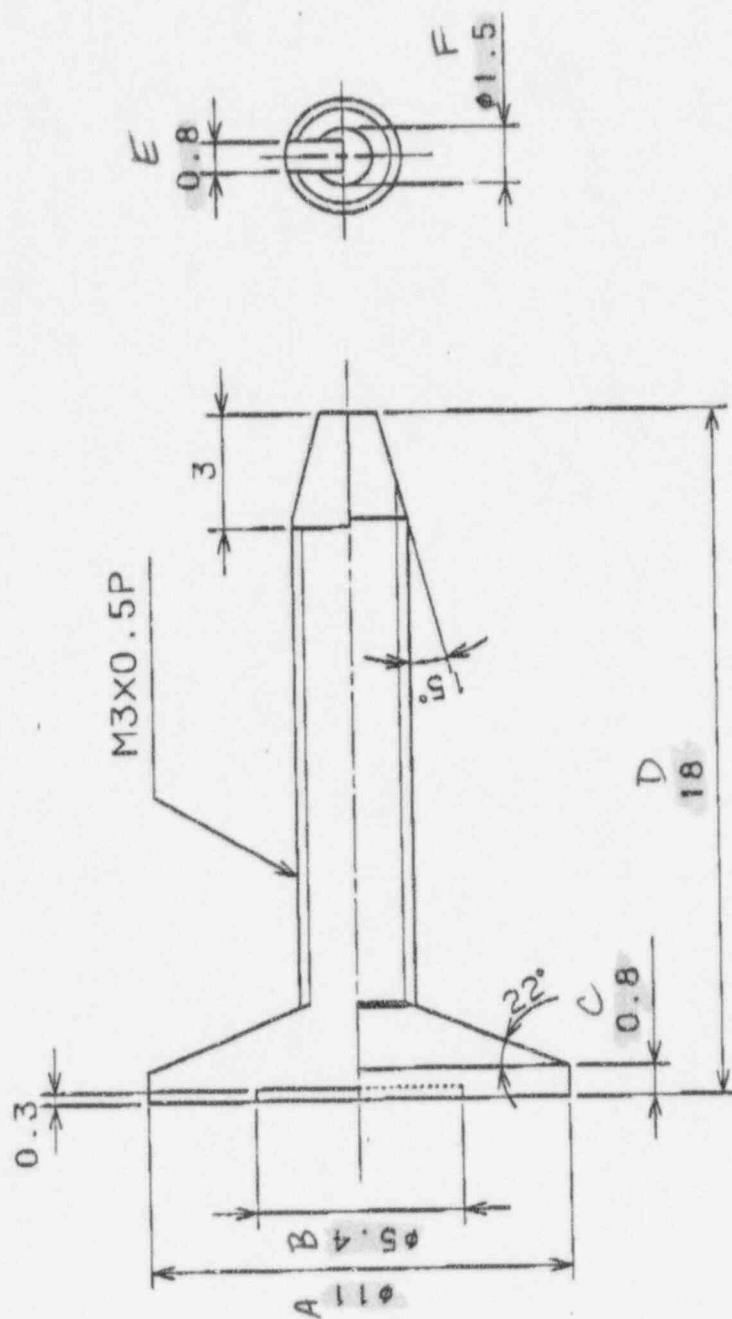

DRAWN	DATE	TITLE
H. Shibuya	6. SEP. '93	INNER ELECTRODE
CHECKED	UNIT	DWG NO.
T. Arita	mm	A2-93-0163
APPROVED	SCALE	HOCHIKI CORPORATION
O. Kuroawa		

SUED



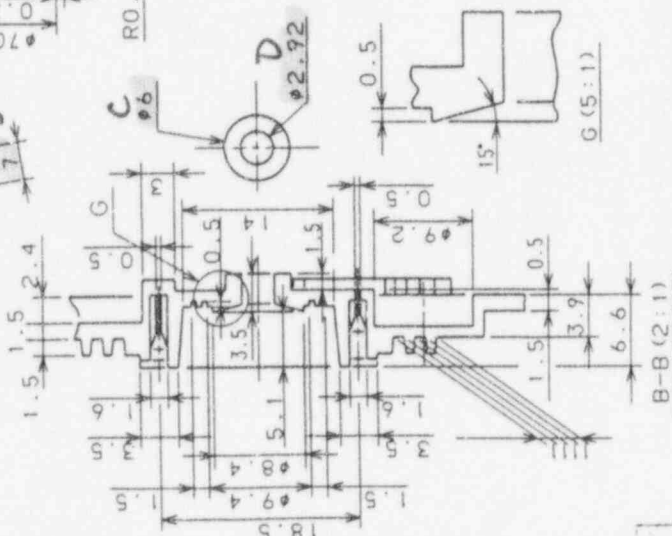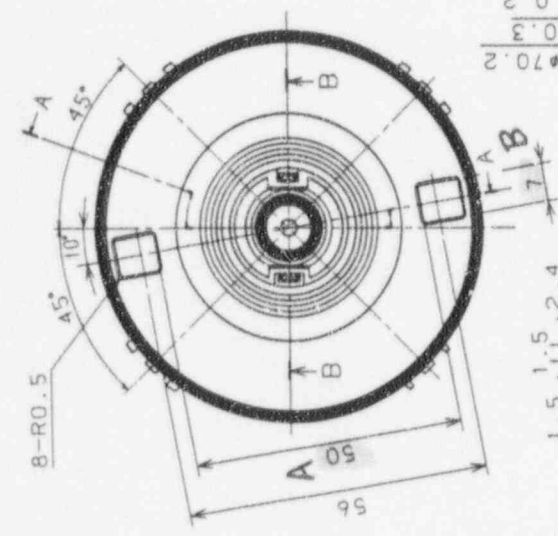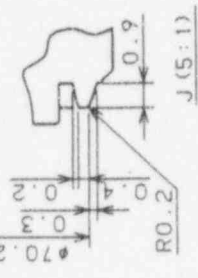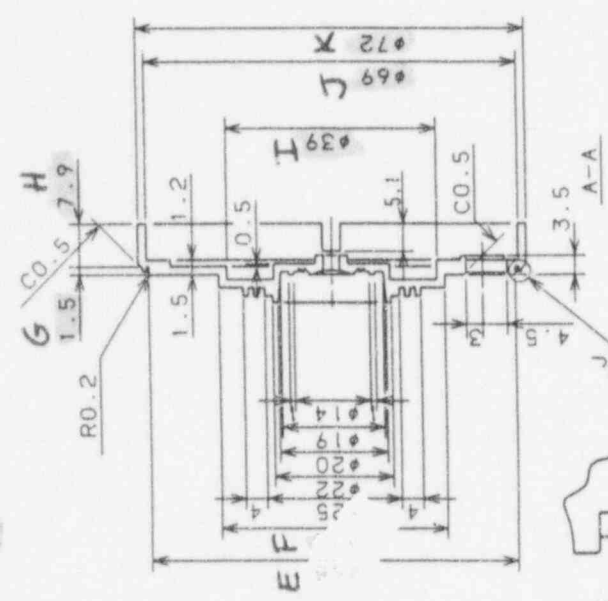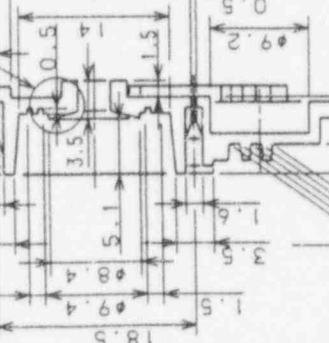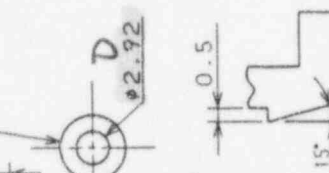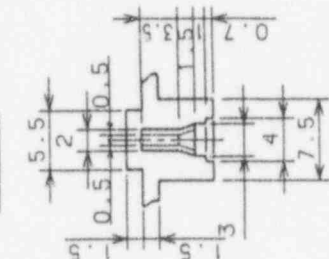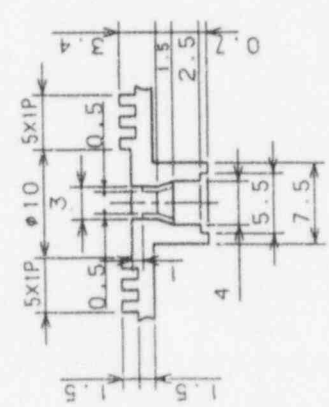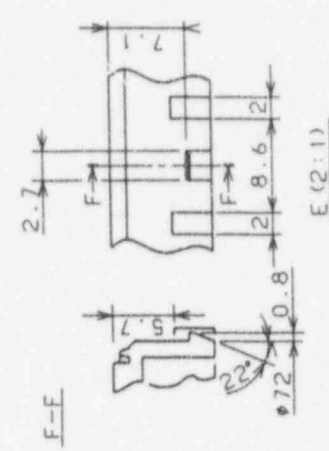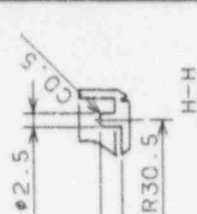

0-0 (2:1)


C-C (2:1)

AIE


DRAWN Y. Kawabata		DATE 20.OCT.'95	TITLE INSULATION PLATE	
CHECKED P. Asakura		UNIT mm	DWG NO. A2-95-0251	
APPROVED Minawa		SCALE 1:1	HOCHIKI CORPORATION	

HOCHIKI CORPORATION



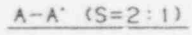

DRAWN <i>H. Shibuya</i>	DATE 6. SEP. '93	TITLE INSULATION PLATE
CHECKED <i>T. Iwata</i>	UNIT M <sup>2</sup>	DWG NO. A2-93-0167
APPROVED <i>O. Komiya</i>	SCALE	HOCHIKI CORPORATION

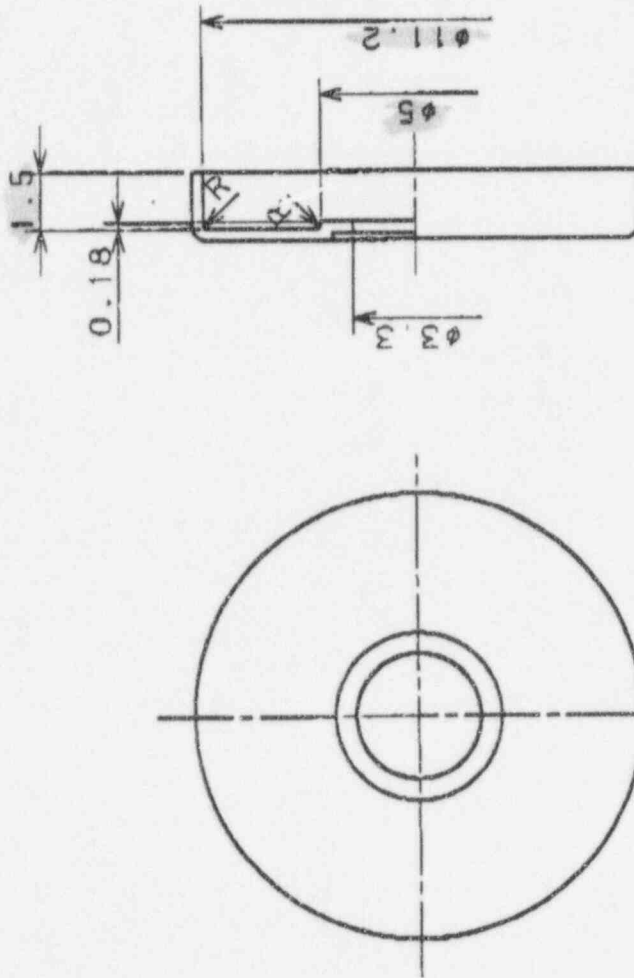

AIE

DATE	7. SEP. '93	TITLE	RI HOLDER
DRAWN	<i>Y. Kawabata</i>	DWG NO.	A2-93-0172
CHECKED	<i>P. Sigelua</i>	SCALE	
APPROVED	<i>J. Kimura</i>	HOCHIKI CORPORATION	