



Passaic General Hospital

350 Boulevard, P.O. Box 959, Passaic, N.J. 07055 • (201) 365-4300

Charles B. Vanderberg
Chairman, Board of Governors

Michael T. Kornett
President and
Chief Executive Officer

U.S. Nuclear Regulatory Commission
Region 1
Nuclear Materials, Section B
631 Park Ave.
King of Prussia, PA 19406


May 31, 1985

Gentlemen,

Passaic General Hospital, license# 29-01040-03, wishes to amend its byproduct license to include another temporary location for the Nuclear Medicine Department hotlab which has to be moved once more due to the construction in the immediate area adjacent to it. This area shall be temporarily used until the permanent new area is finished during sometime in October 1985. Enclosed are copies of the new area and the decommission radiation survey as required. Also, enclosed is a check payable to the NRC for the sum of \$120.00 as required as per 10 CFR 170.

If you have any questions regarding this amendment request, please contact me.

Sincerely,

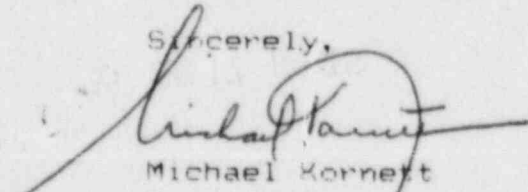

Michael Kornett
President and
Chief Executive Officer

RECEIVED BY LFMS	
Date	6/17/85
Leg	Time Pg. 12-1
By	Jacques
Orig. To	
Action Compl.	

8512040072 850815
REG1 LIC30
29-01040-03 PDR

Check 12721 (\$120) - 7C
received 7/1/85


"OFFICIAL RECORD COPY"

ML10

03947


JUN 07 1985

ASSIAC GENERAL HOSPITAL
NUCLEAR MEDICINE DEPARTMENT

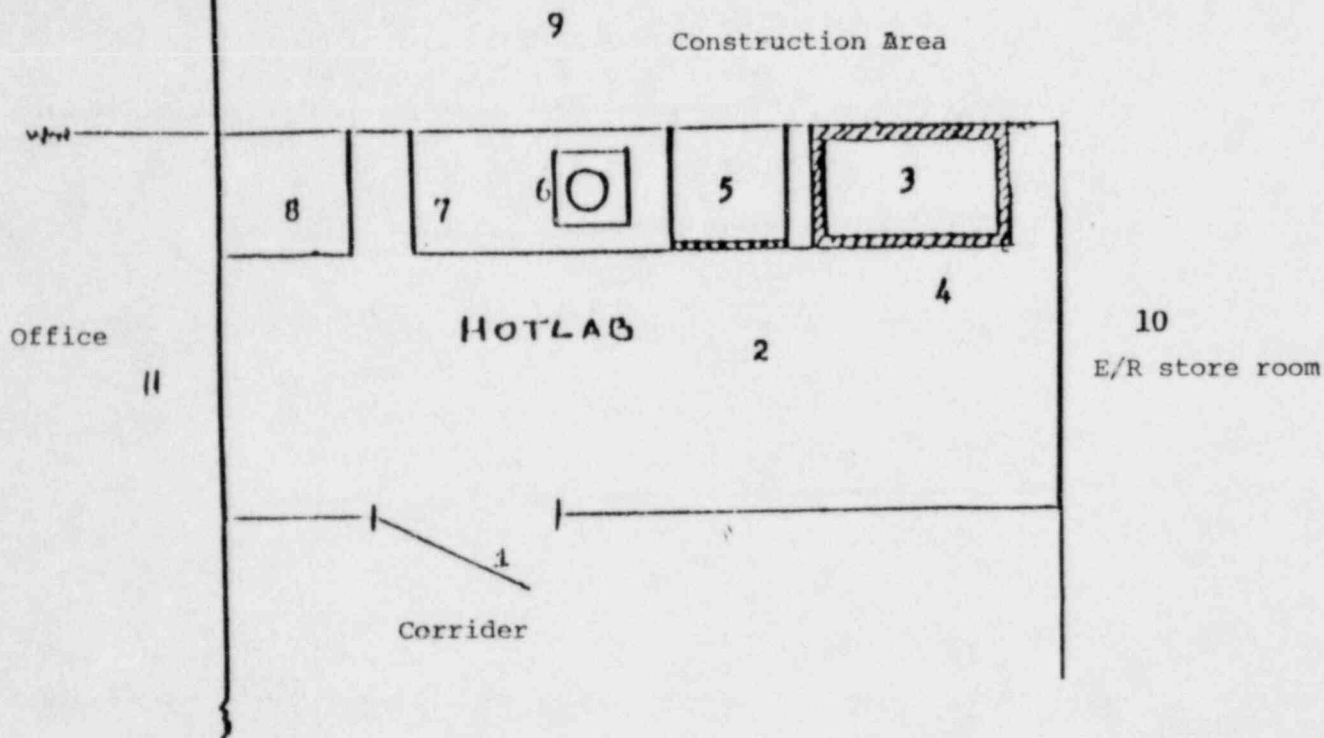

Scale; $\frac{1}{4}" = 1'$

DATE:	#	LOCATION	mR/hr	CPM/100.
SURVEYED BY:	1	Door/ Floor		
INSTRUMENTATION:	2	Floor		
	3	Lead Fort		
	4	R/A Waste		
	5	L Shield		
	6	Dose Calibrator		
	7	Prep. Area		
Co 57. cpm/ dpm : eff.	8	Refridgerator		
220 dpm. cpm	9	CONSTRUCTION		
	10	Waiting Area		
	11	OFFICE		

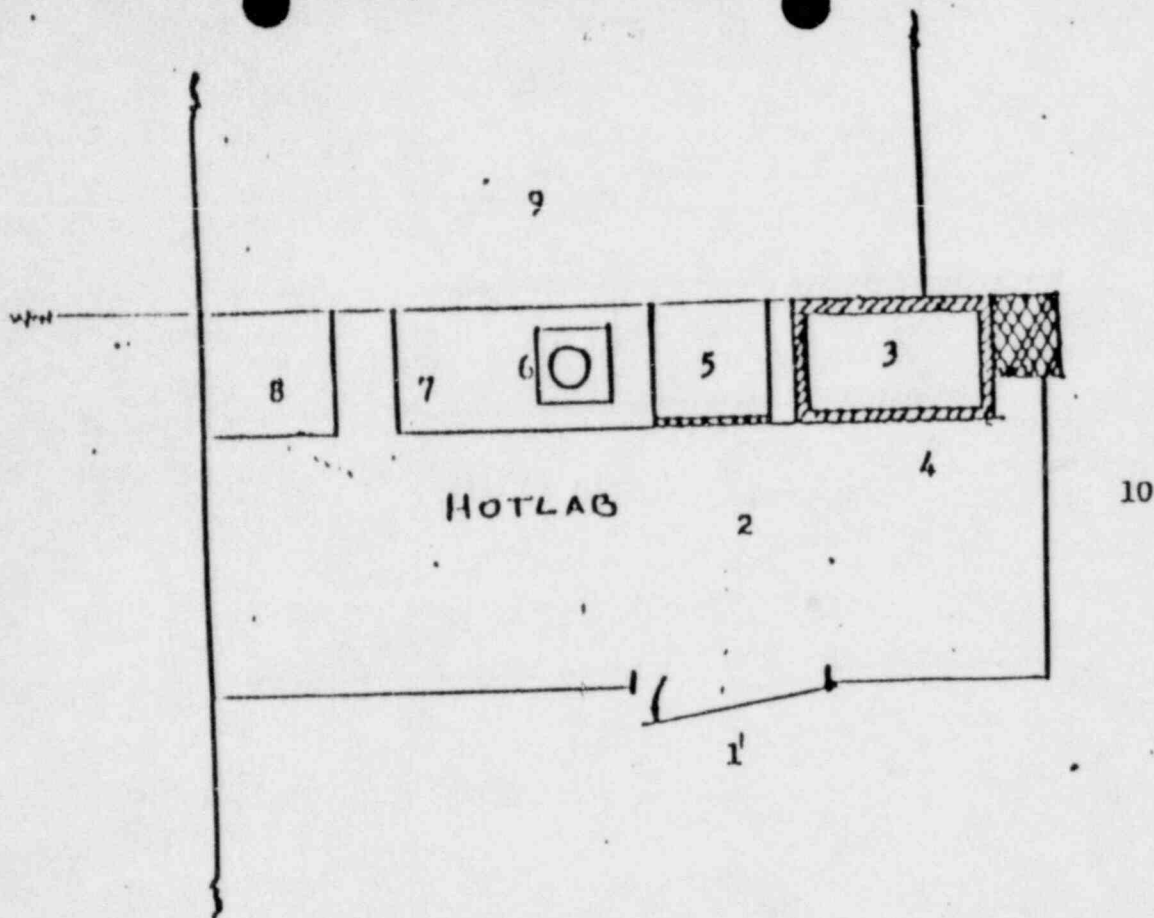

Scale; 1" = 1'

DATE: 5/8/85	#	LOCATION	mR/hr	CPM/100.
SURVEYED BY: Eric Cheatham	1	Door/ Floor	.05	345
INSTRUMENTATION: Eon GM, Schwart-Mann	2	Floor	.05	329
Well Counter, Tc99m Setting	3	Lead Fort	.05	315
	4	R/A Waste	.05	315
	5	L Shield	.05	293
	6	Dose Calibrator	.05	329
	7	Prep. Area	.05	321
Co 57: 2638 cpm/ 3565 dpm : eff. .53	8	Refridgerator	.05	323
220 dpm. 163 cpm net	9	E/R Stock Rm	.05	333
= 508 cpm gross	10	Waiting Area	.05	345
	11	Background	.05	345

BETWEEN: William O. Miller, Chief
License Fee Management Branch
Office of Administration -

John E. Glenn, Chief
Nuclear Materials Section B
Division of Engineering and
Technical Programs

LICENSE FEE TRANSMITTAL

Fee Needed

A. REGION

1. APPLICATION ATTACHED

Applicant/Licensee: Passaic General Hospital

Application Dated: 5/31/85

Control No.: 03947

License No.: 29-01040-03

2. FEE ATTACHED

Amount: 0

Check No.: 0

3. COMMENTS

Signed Brenda Platchek

Date 6/12/85

02/20

B. LICENSE FEE MANAGEMENT BRANCH

1. Fee Category and Amount: 7C

2. Correct Fee Paid. Application may be processed for:

Amendment ✓

Renewal

License

Signed Allen S. Cabell

Date 7-3-85

6/88