

NOTES:
SEE M-22BB01(Q) FOR NOTES.

AS-BUILT CLASS 1

DRAWING INFORMATION				PROJECT INFORMATION			
DRAWN	N/A	DATE		PROJECT	CALLAWAY PLANT	CLASS	
CHKD.	N/A	DATE		DESCRIPTION	REACTOR COOLANT SYSTEM		
SUPV.	N/A	DATE		FIGURE	FSAR FIGURE 5.1-1 SHEET 2		
APPD.	N/A	DATE		LOCATION	CALLAWAY PLANT		
UNION ELECTRIC COMPANY				M-22BB02 (Q)			
ST. LOUIS, MO				REV. 33			


- | | |
|--|--------------------------------|
| 1. DELETED. | DRAWN (CRO.) BY
MIL. R/W 17 |
| 2. SINGLE ALARM POINT FOR ALL FOUR (4) PUMPS. | INCORP.
RFR 22941A |
| 3. RESTRICTION ORIFICE $\frac{3}{4}$ " DIAMETER. POINT AT WHICH
QUALITY GROUP CLASSIFICATION IS CHANGED FROM "A"
TO "B". | |
| 4. DELETED | |
| 5. REFERENCE WESTINGHOUSE DRAWING: 1145E02 S001. | |
| 6. DELETED. | |
| 7. DELETED. | |
| 8. THERMAL BARRIER COOLING COIL HAS INTERNAL PRESSURE
DESIGN RATING OF 150 PSIA. | |
| 9. DELETED. | |
| 10. DELETED. | |
| 11. DELETED. | |
| 12. DELETED. | |
| 13. DELETED. | |
| 14. LIGHT INDICATING ADEQUATE OIL PRESSURE IS AN
INTEGRAL PART OF HIS. | |
| 15. DELETED. | |
| 16. ALTERNATE PRESSURE SWITCH BBPS0491A. | |
| 17. ALTERNATE PRESSURE SWITCH BBPS0492A. | |
| 18. ALTERNATE PRESSURE SWITCH BBPS0493A. | |
| 19. ALTERNATE PRESSURE SWITCH BBPS0494A. | |

A SEPERATE RCP DRAWING
EXISTS FOR EACH LOOP-
SEE THE FOLLOWING DRAWING
FOR THE APPLICABLE LOOP:

LOOP	DRAWING
A	M-22BB03A(Q)
B	M-22BB03B(Q)
C	M-22BB03C(Q)
D	M-22BB03D(Q)

AS-BUILT CLASS 1

DESIGN	(DATE)	PIPING AND INSTRUMENTATION DIAGRAM REACTOR COOLANT SYSTEM 14 FSAR FIGURE 5.1-1 SHEET 3		
CHKD.	(DATE)			
SUPV.	(DATE)			
APPR.	(DATE)			
N/A		LOCATION	CALLAWAY PLANT	CLASS
UNION ELECTRIC COMPANY ST. LOUIS, MO			M-22BB03(Q)	REV. 14

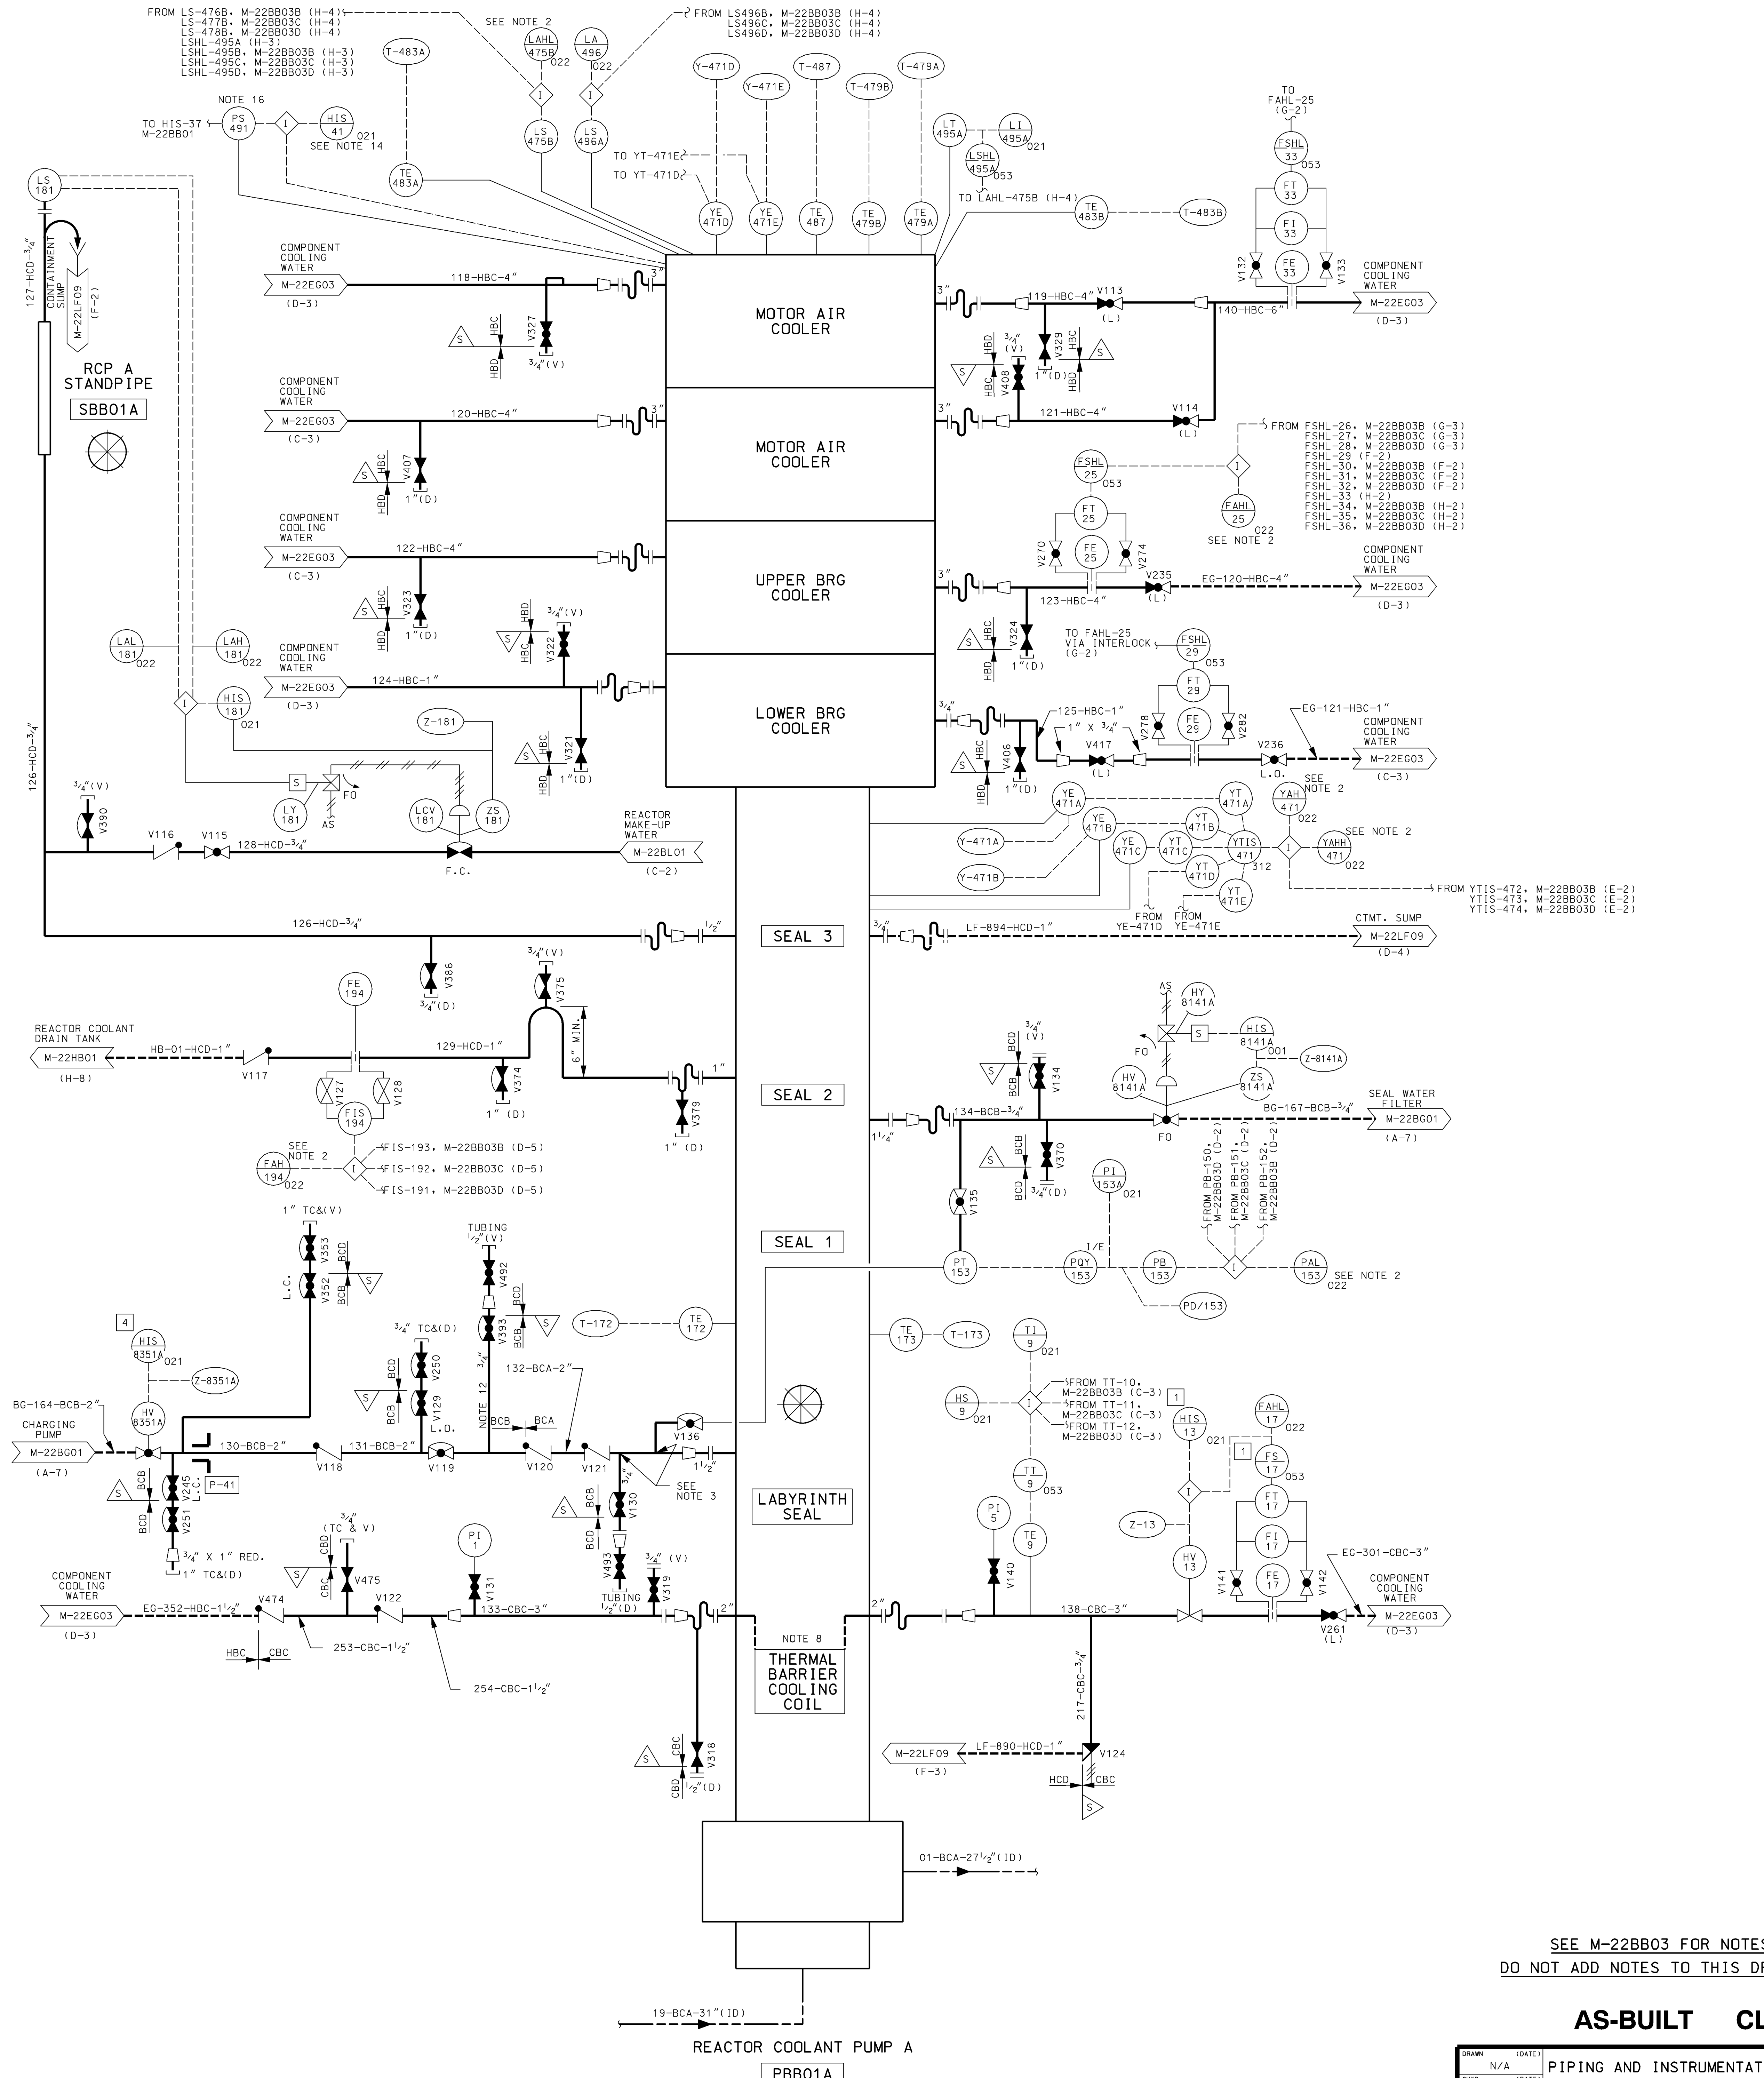

SEE M-22BB03 FOR NOTES.
DO NOT ADD NOTES TO THIS DRAWING.

AS-BUILT CLASS 1

DATE	01/23/97	REV.	1
DRAWN	N/A	DATE	01/23/97
CHKD.	N/A	DATE	01/23/97
SUPV.	N/A	DATE	01/23/97
APPD.	N/A	DATE	01/23/97
LOCATION	CALLAWAY PLANT	CLASS	CLASS 1
UNION ELECTRIC COMPANY	ST. LOUIS, MO	M-22BB03A(Q)	REV. 9

PIPING AND INSTRUMENTATION DIAGRAM
REACTOR COOLANT SYSTEM
ESAR FIGURE 5.1-1 SHEET 3A

REV.	DATE	DRAWN	CHKD.	SUPV.	APPD.	LOCATION	CLASS
1	01/23/97	RLW	N/A	N/A	N/A	N/A	N/A
2	01/23/97	RLW	N/A	N/A	N/A	N/A	N/A
3	01/23/97	RLW	N/A	N/A	N/A	N/A	N/A
DATE	01/23/97	REV.	1
DRAWN	N/A	DATE	01/23/97
CHKD.	N/A	DATE	01/23/97
SUPV.	N/A	DATE	01/23/97
APPD.	N/A	DATE	01/23/97
LOCATION	CALLAWAY PLANT	CLASS	CLASS 1
UNION ELECTRIC COMPANY	ST. LOUIS, MO	M-22BB03A(Q)	REV. 9

PIPING AND INSTRUMENTATION DIAGRAM
REACTOR COOLANT SYSTEM
ESAR FIGURE 5.1-1 SHEET 3A

SEE M-22BB03 FOR NOTES.
DO NOT ADD NOTES TO THIS DRAWING.

AS-BUILT CLASS 1

DRAWN	(DATE)							
N/A								
CHECKED	(DATE)							
N/A								
SUPV.	(DATE)							
N/A								
APPROD.	(DATE)	LOCATION	CALLAWAY ENERGY CENTER			1A	CLASS	
N/A								
UNION ELECTRIC COMPANY ST. LOUIS, MO							M-22BB03B(Q)	REV. 11

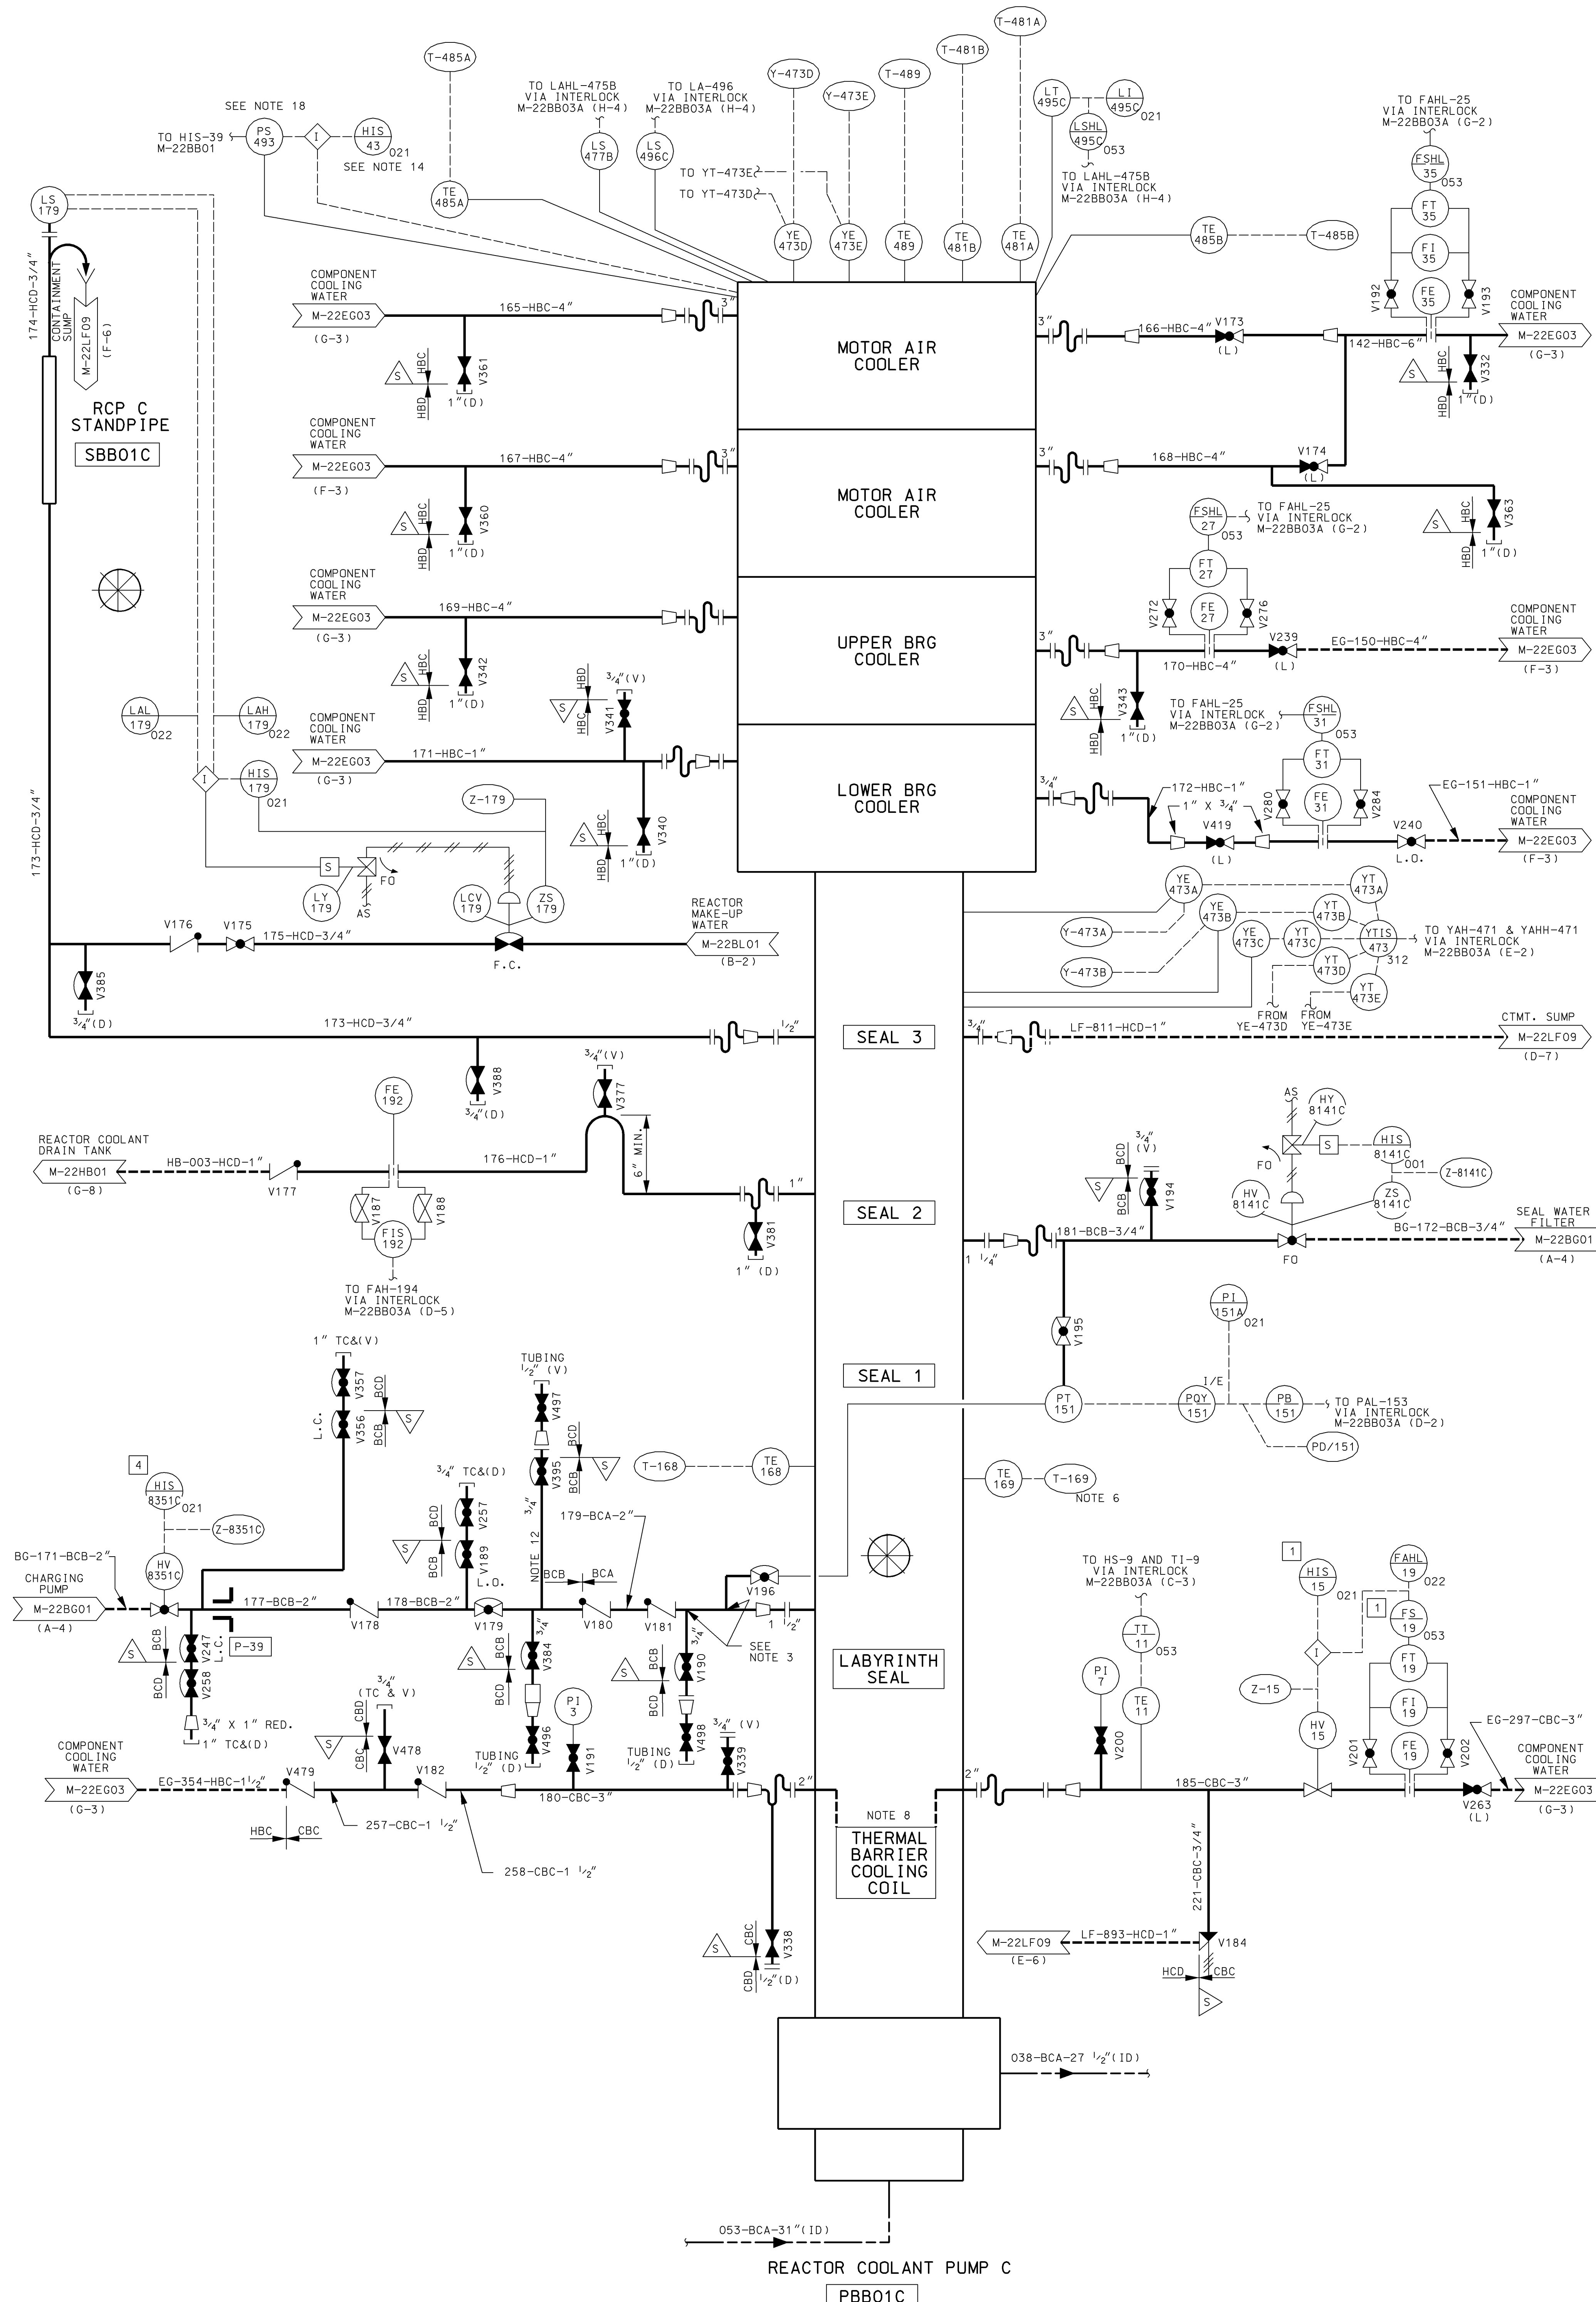

SEE M-22BB03 FOR NOTES.
DO NOT ADD NOTES TO THIS DRAWING.

AS-BUILT CLASS 1

DRWN	N/A	(DATE)	
CHKD	N/A	(DATE)	
SUPV	N/A	(DATE)	
APPR	N/A	(DATE)	
LOCATION	CALLAWAY PLANT		
CLASS			
UNION ELECTRIC COMPANY	M-22BB03C(Q)	REV.	7
ST. LOUIS, MO			

REV.	DATE	DRWN	012391	RLW
CHD.	SUPV.	PPRO.	DLB	AMR
PER	INITIAL	ISSUE		
REFR	17575A			
REV.	DATE	DRWN	033191	DLB
CHD.	SUPV.	PPRO.	RLW	AMR
INCORP	DEC-1402			
REV.	DATE	DRWN	040898	MAL
CHD.	SUPV.	PPRO.	EWM	JHK
INCORP	DEC-1501			
REV.	DATE	DRWN	062598	RAM
CHD.	SUPV.	PPRO.	JHK	AMR
INCORP	DEC-18922A			
REV.	DATE	DRWN	020199	DJB
CHD.	SUPV.	PPRO.	RAM	AMR
INCORP	DEC-19267A			
REV.	DATE	DRWN	100899	RLW
CHD.	SUPV.	PPRO.	DJB	AMR
INCORP	DEC-97-1008A			
REV.	DATE	DRWN	120503	TWS
CHD.	SUPV.	PPRO.	RLW	MAL
INCORP	DEC-200307724			
REV.	DATE	DRWN	110904	TWS
CHD.	SUPV.	PPRO.	RLW	MAL
INCORP	DEC-22341A			

MINOR CHANGE
CAR 200307724
DATE 11/09/04
DRAWN: JHK, SUPV: TWS
INCORP: 11/09/04

TO YAH-471 & YAH-471
VIA INTERLOCK
M-22BB03A (E-2)

TO FAHL-25
VIA INTERLOCK
M-22BB03A (G-2)

TO FAHL-194
VIA INTERLOCK
M-22BB03A (D-5)

TO H5-9 AND T1-9
VIA INTERLOCK
M-22BB03A (C-3)


TO FAHL-19
VIA INTERLOCK
M-22BB03A (G-2)

TO FAHL-25
VIA INTERLOCK
M-22BB03A (G-2)

TO FAHL-25
VIA INTERLOCK
M-22BB03A (G-2)

TO FAHL-25
VIA INTERLOCK
M-22BB03A (G-2)

TO FAHL-25
VIA INTERLOCK
M-22BB03A (G-2)

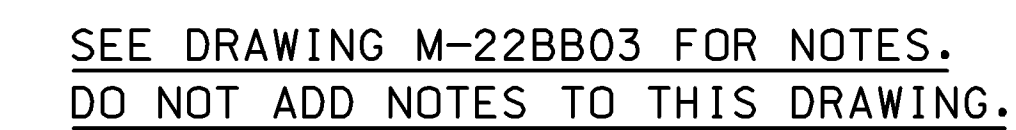

DESIGN	(DATE)							
N/A		PIPING AND INSTRUMENTATION DIAGRAM						
CAD.	(DATE)	REACTOR COOLANT SYSTEM						
N/A		FSAR FIGURE 5.1-1 SHEET 3D						
SUPV.	(DATE)							
N/A								
APP'D.	(DATE)	LOCATION	CALLAWAY PLANT				CLASS	
N/A								
UNION ELECTRIC COMPANY ST. LOUIS, MO			M-22BB03D(Q)				REV. 8	

(0)00822-Z-W


RV CORE SUBCOOLING MONITOR

TRAIN	SEP. GRP.	T/C JUNCT. BOX NO.	T/C NUMBER							PENE-TRATION NO.
A	1	BB04A	38	30	33	5	45	41 (NOTE 10)	SPR	75
			48	20	44	47	49	43	SPR	76
			42	39	15	35	13	46	7	77
			31	27	32	29 (NOTE 15)	4	1	SPR	78
B	4	BB04B	37	9	17	12 (NOTE 14)	36	11	SPR	75
			24	23	19	50	25	22	18	76
			40 (NOTE 11)	16 (NOTE 11)	14	34	10	21	SPR	77
			26	2	8	28	3	6 (NOTE 13)	SPR	78

RV CORE SUBCOOLING MONITOR

(NOTE 8)

THERMOCOUPLE/CORE COOLING MONITOR	
DISPLAY INSTRUMENTS FOR CONTROL BOARD SECTION AND/OR OTHER CABINETS	
INSTRUMENT TAG NO.	LOCATION
UU-1390A	RP081A
UU-1390B	RP081B
TR-1390A	RP081A
TR-1390B	RP081B
TJ-1390A	RL022
TJ-1390B	RL022
TAL-1390A	RK020
TALL-1390B	RK020

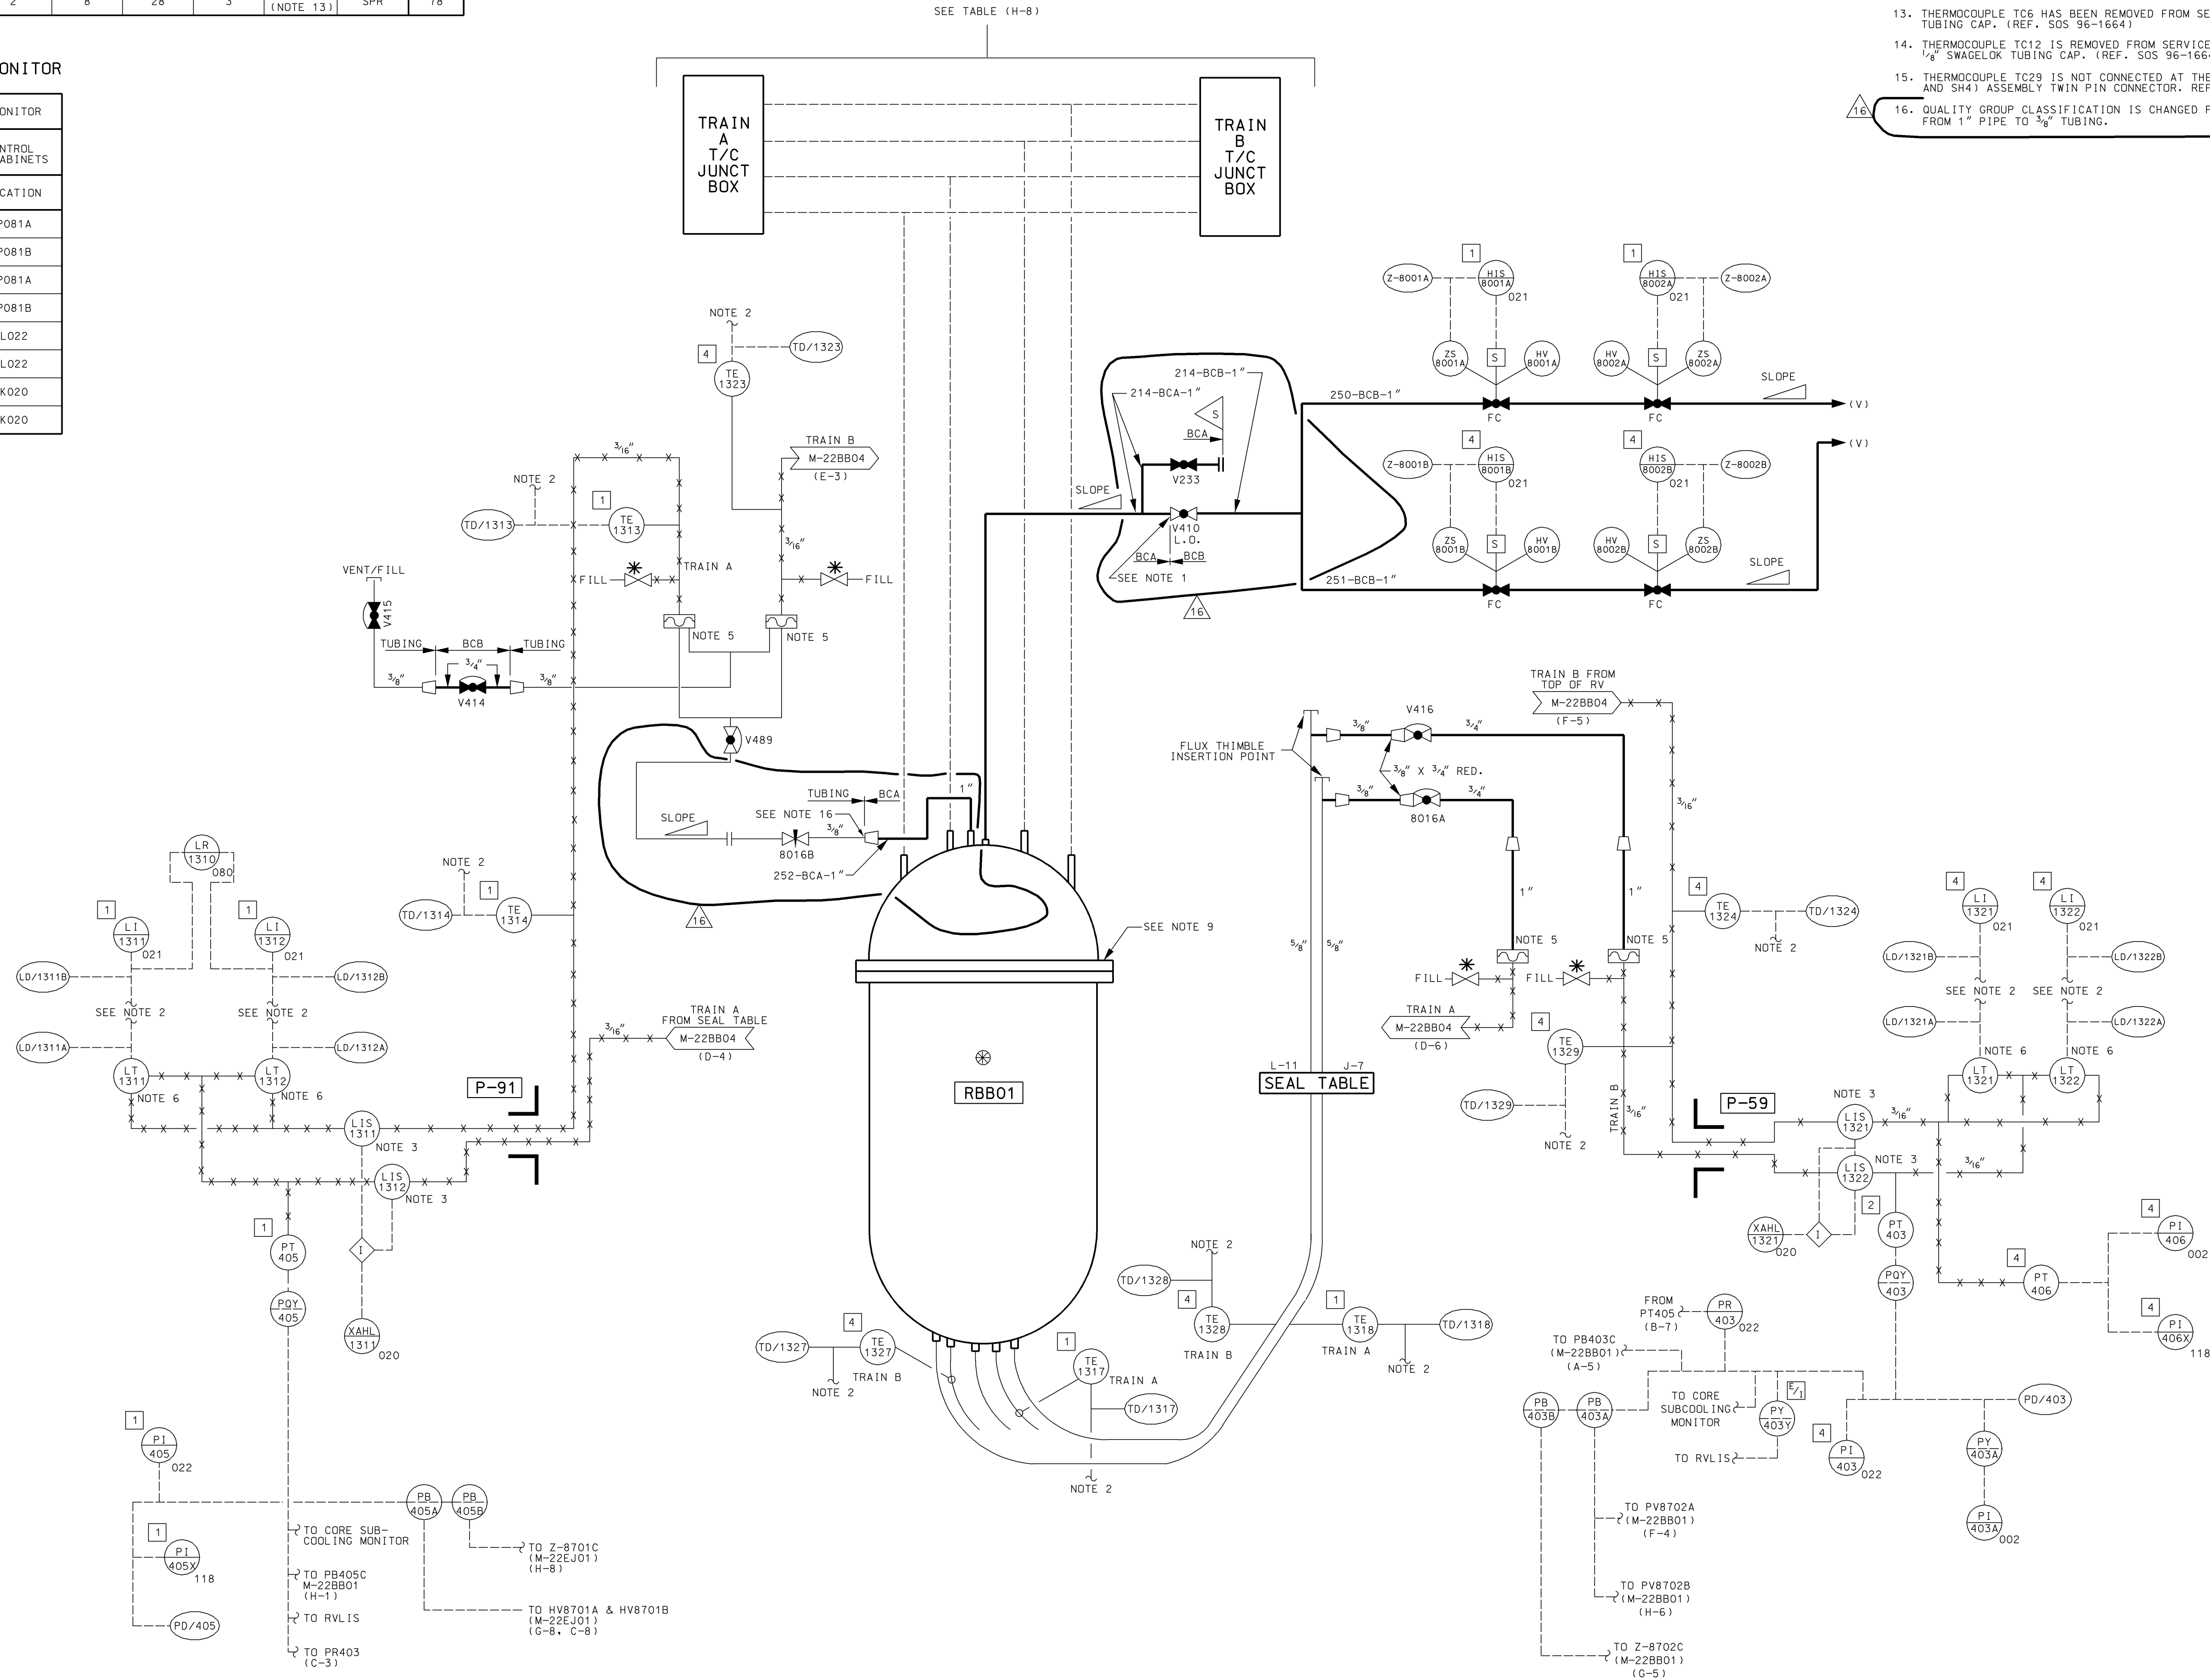

NOTES

1. REFER TO NOTE 1 ON M-22BB01(01).
2. SEE WESTINGHOUSE PROCESS BLOCK DIAGRAMS-W DWG. NO. 2326090 (4 SHEETS), AND WESTINGHOUSE INSTALLATION SCHEMATIC.
3. LIS-1311, 1312, 1321, AND 1322 ARE HYDRAULIC ISOLATORS WITH A MALFUNCTION INDICATION.
4. DELETED.
5. HYDRAULIC SENSORS.
6. LEVEL TRANSMITTER ELEVATION ABOVE HYDRAULIC ISOLATOR AND NEAR CONTAINMENT PENETRATION.
7. DELETED.
8. FOR THERMOCOUPLE/CORE COOLING MONITOR SEE WESTINGHOUSE DRAWING 2332078, (5 SHEETS).
9. ONLY 53 OF THE 54 STUDS ARE REQUIRED TO BE TENSIONED TO ENSURE O-RING SEATING AND COMPLIANCE WITH THE ASME CODE STRESS CONCENTRATION FACTORS.
10. BBTC0041 HAS BEEN ABANDONED IN PLACE.
11. THERMOCOUPLES TC16 AND TC40 HAVE BEEN REMOVED FROM SERVICE AND CAPPED WITH A 1/8" SWAGelok TUBING CAP (REF. CMP 92-1028).
12. DELETED.
13. THERMOCOUPLE TC6 HAS BEEN REMOVED FROM SERVICE AND CAPPED WITH A 1/8" SWAGelok TUBING CAP. (REF. SOS 96-1664)
14. THERMOCOUPLE TC12 IS REMOVED FROM SERVICE AND CAPPED WITH A 1/8" SWAGelok TUBING CAP. (REF. SOS 96-1664 AND RFR-17473B)
15. THERMOCOUPLE TC29 IS NOT CONNECTED AT THE TRANSITION CABLE (18BS33AX - P4, N4, AND 5H4) ASSEMBLY TWIN PIN CONNECTOR. REF.: SOS 99-2143 AND RFR-17473C.
16. QUALITY GROUP CLASSIFICATION IS CHANGED FROM "A" TO "B" AT THE 3/8" ADAPTOR FROM 1" PIPE TO 3/8" TUBING.

AS-BUILT CLASS 1

DRWN	DATE	N/A
CHKD	DATE	N/A
SUPV	DATE	N/A
APPD	DATE	N/A
UNION ELECTRIC COMPANY	ST. LOUIS, MO	M-22BB04(Q)

PIPING & INSTRUMENTATION DIAGRAM
REACTOR COOLANT SYSTEM

FSAR FIGURE 5.1-1 SHEET 4

CALLAWAY ENERGY CENTER

REV. 16

NOTES TO FIGURE 5.1-2

Mode A Steady State Full Power Operation

<u>Location</u>	<u>Fluid</u>	<u>Pressure</u>	<u>Temperature</u>	<u>Flow</u>		<u>Volume</u>
		<u>(psig)</u>	<u>(°F)</u>	<u>gpm</u> ⁽¹⁾	<u>lb/hr</u> ⁽²⁾	
1	Reactor coolant	2,235.0	618.8	108,781	36.2040	-
2	Reactor coolant	2,233.7	618.8	108,781	36.2040	-
3	Reactor coolant	2,189.7	557.7	97,452	36.2040	-
4	Reactor coolant	2,186.1	557.7	97,453	36.2040	-
5	Reactor coolant	2,282.3	558.0	97,368	36.2065	-
6	Reactor coolant	2,281.0	558.0	97,361	36.2040	-
10-15	Reactor coolant	See Loop #1 Specifications				-
19-24	Reactor coolant	See Loop #1 Specifications				-
28-33	Reactor coolant	See Loop #1 Specifications				-
37	Reactor coolant	2,282.3	558.0	1.0	0.00037	-
38	Reactor coolant	2,282.3	558.0	1.0	0.00037	-
39	Reactor coolant	2,282.3	558.0	2.0	0.00074	-


CALLAWAY - SP

NOTES TO FIGURE 5.1-2 (Sheet 2)

<u>Location</u>	<u>Fluid</u>	<u>Pressure</u>	<u>Temperature</u>	<u>Flow</u>		<u>Volume</u>
		<u>(psig)</u>	<u>(°F)</u>	<u>gpm</u> ⁽¹⁾	<u>lb/hr</u> ⁽²⁾	
40	Steam	2,235.0	652.7	-	-	720
41	Reactor coolant	2,235.0	652.7	-	-	1,080
42	Reactor coolant	2,235.0	652.7	2.5	0.0007	-
43	Reactor coolant	2,235.0	652.7	2.5	0.0007	-
44	Steam	2,235.0	652.7	0	0	-
45	Reactor coolant	2,235.0	≤300	0	0	Minimize
46	N ₂	3.0	120	0	0	-
47	Reactor coolant	2,235.0	≤300	0	0	Minimize
48	N ₂	3.0	120	0	0	-
49	N ₂	3.0	120	0	0	-
50	N ₂	3.0	120	-	-	450
51	Pressurizer relief tank water	3.0	120	-	-	1,350
52	Steam/H ₂	2,235.0	559	0	0	-
53	Reactor coolant	3.0	120	0	0	-
54	Reactor coolant	50	170	0	0	-

(1) At the conditions specified.

(2) X 10⁶.

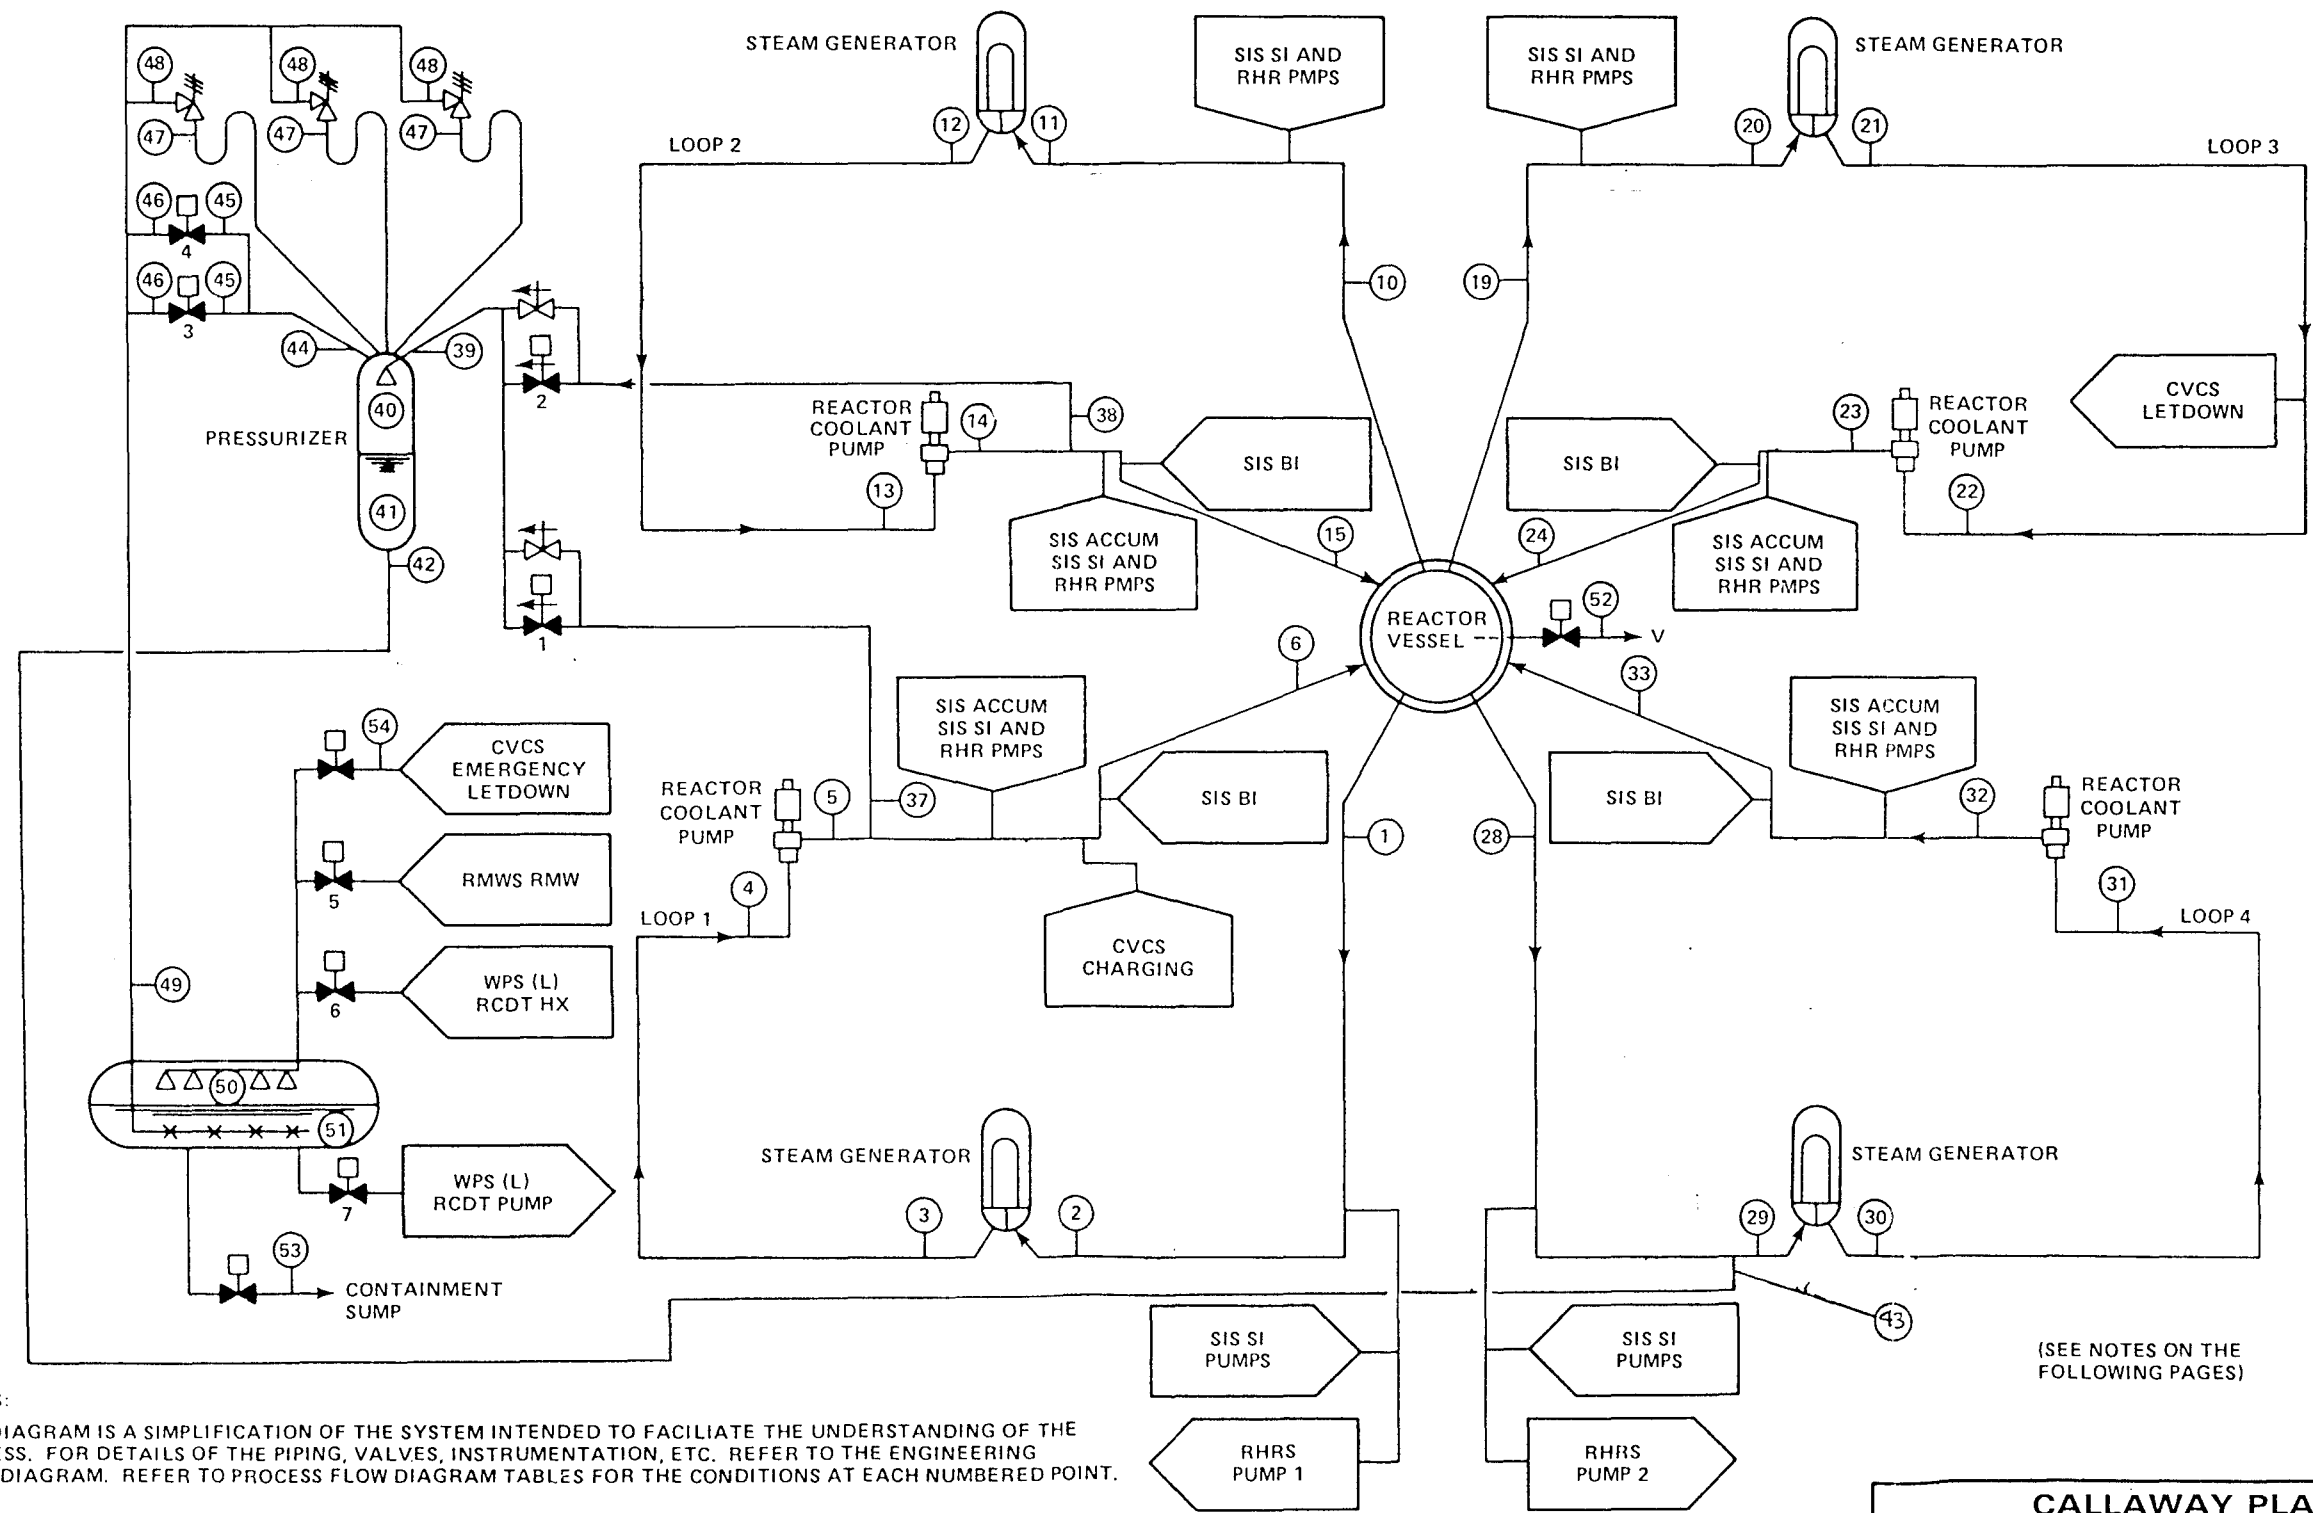

NOTES:


THIS DIAGRAM IS A SIMPLIFICATION OF THE SYSTEM INTENDED TO FACILITATE THE UNDERSTANDING OF THE PROCESS. FOR DETAILS OF THE PIPING, VALVES, INSTRUMENTATION, ETC. REFER TO THE ENGINEERING FLOW DIAGRAM. REFER TO PROCESS FLOW DIAGRAM TABLES FOR THE CONDITIONS AT EACH NUMBERED POINT.

(SEE NOTES ON THE FOLLOWING PAGES)

REV OL-8
11/95


CALLAWAY PLANT

FIGURE 5.1-2
REACTOR COOLANT SYSTEM
PROCESS FLOW DIAGRAM

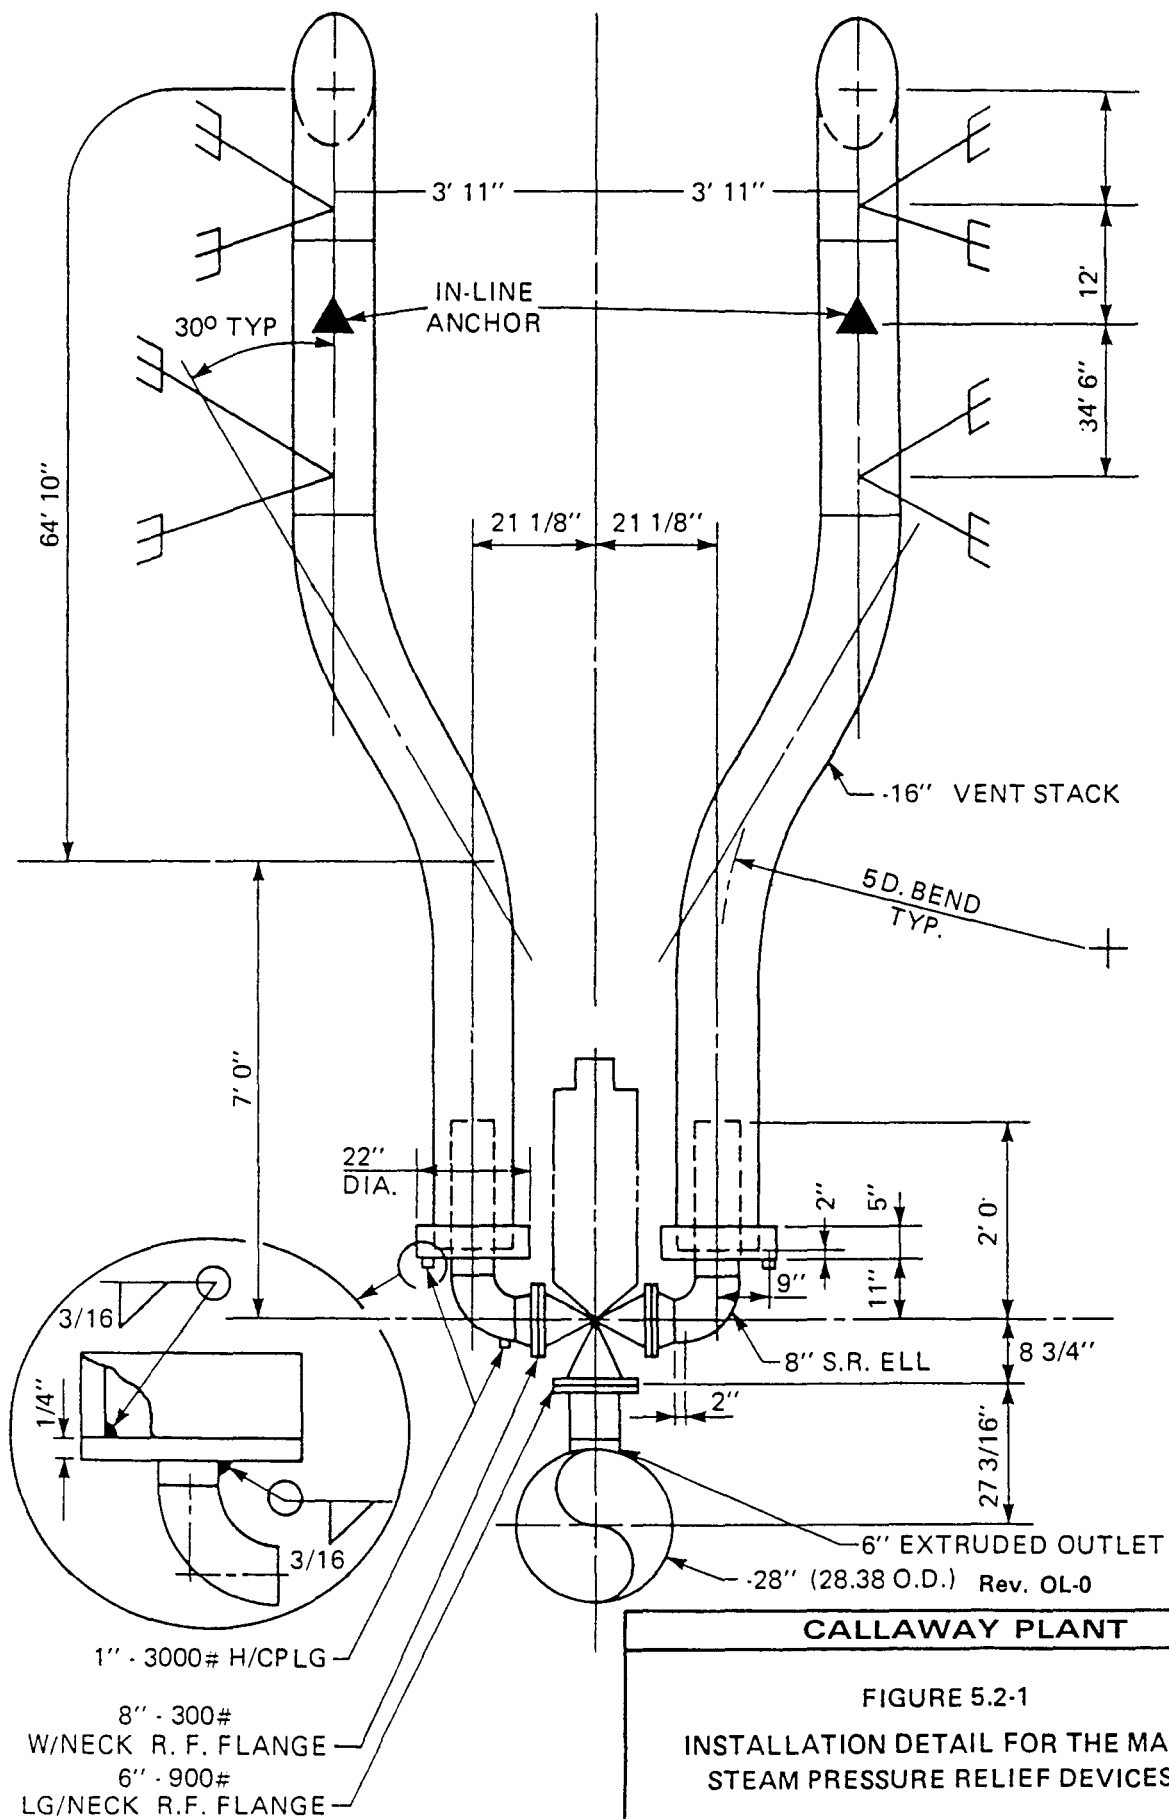

6/86

CALLAWAY PLANT
FIGURE 5.2-1
INSTALLATION DETAIL FOR THE MAIN STEAM PRESSURE RELIEF DEVICES

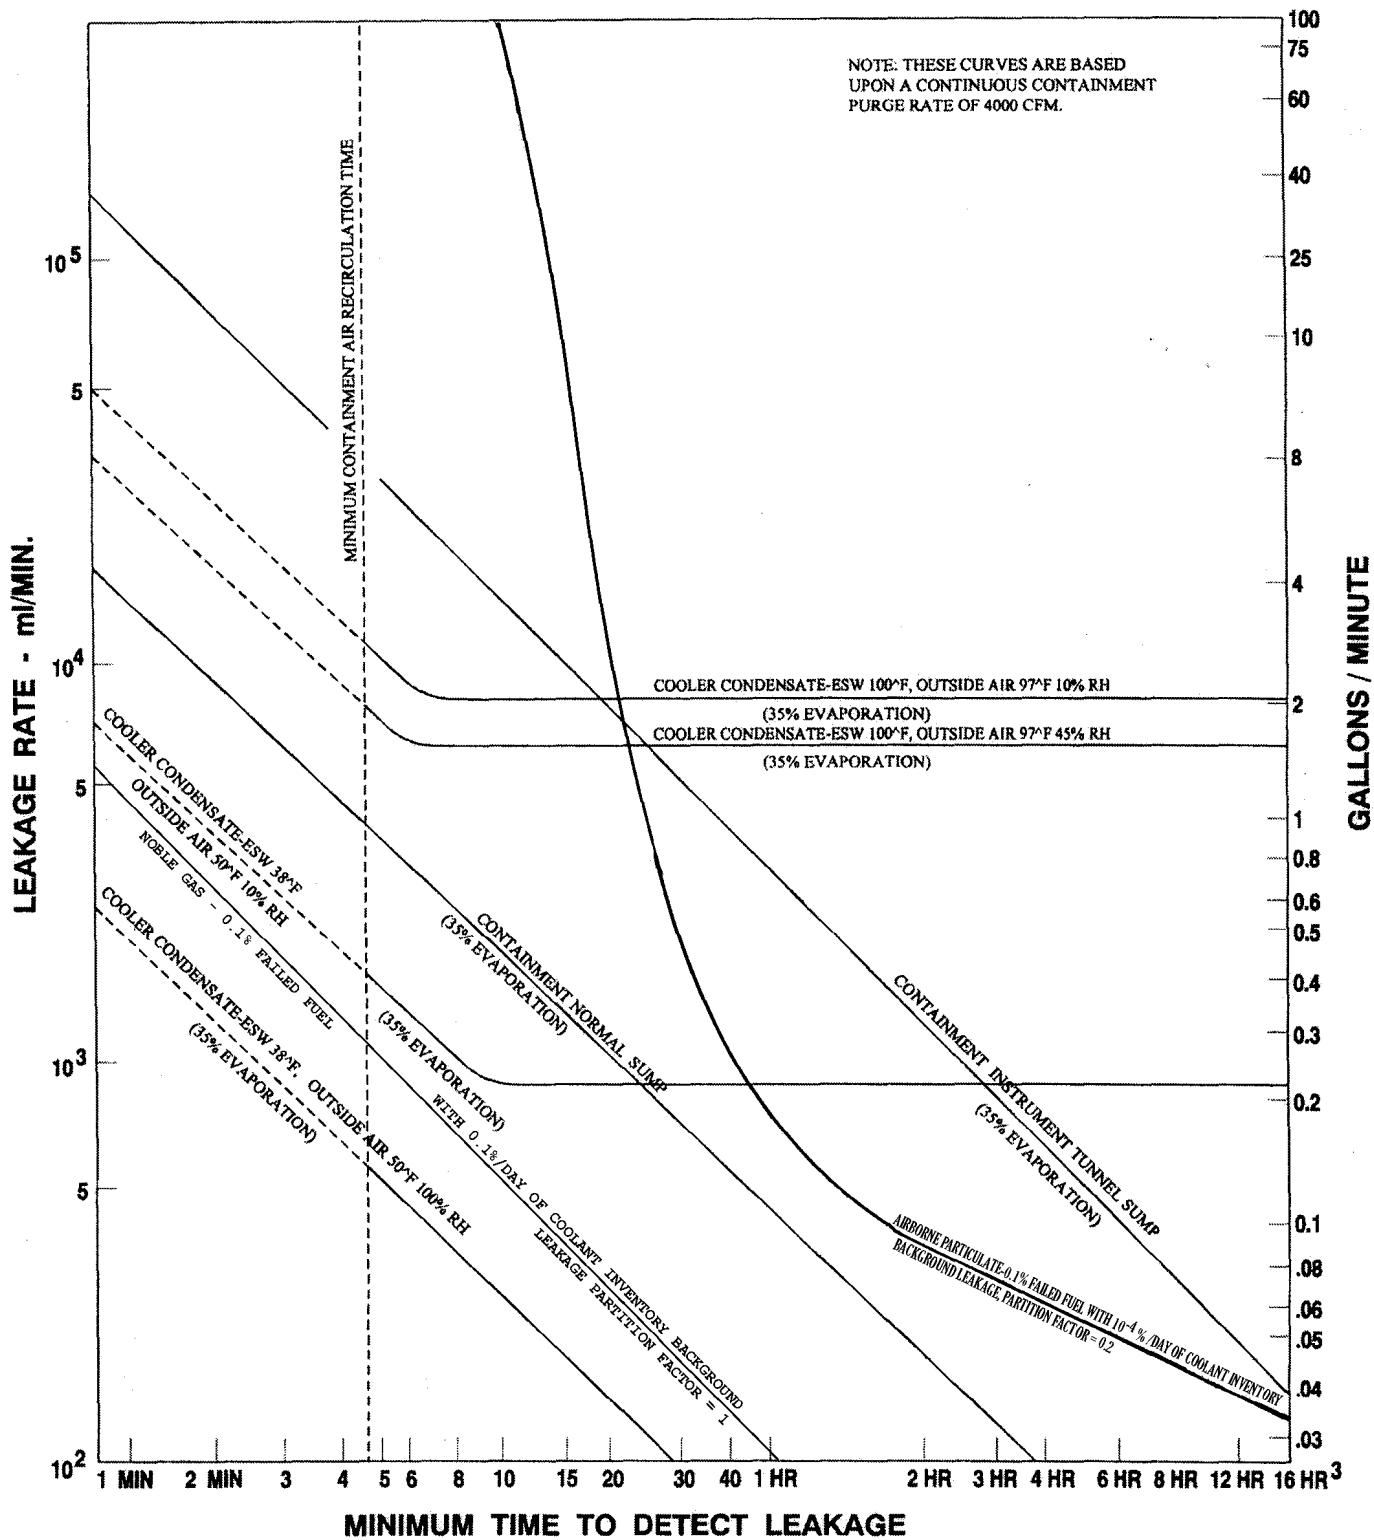


CALLAWAY PLANT

FIGURE 5.2 - 2

PRIMARY COOLANT LEAK
DETECTION RESPONSE TIME


REV. OL-14 12/04

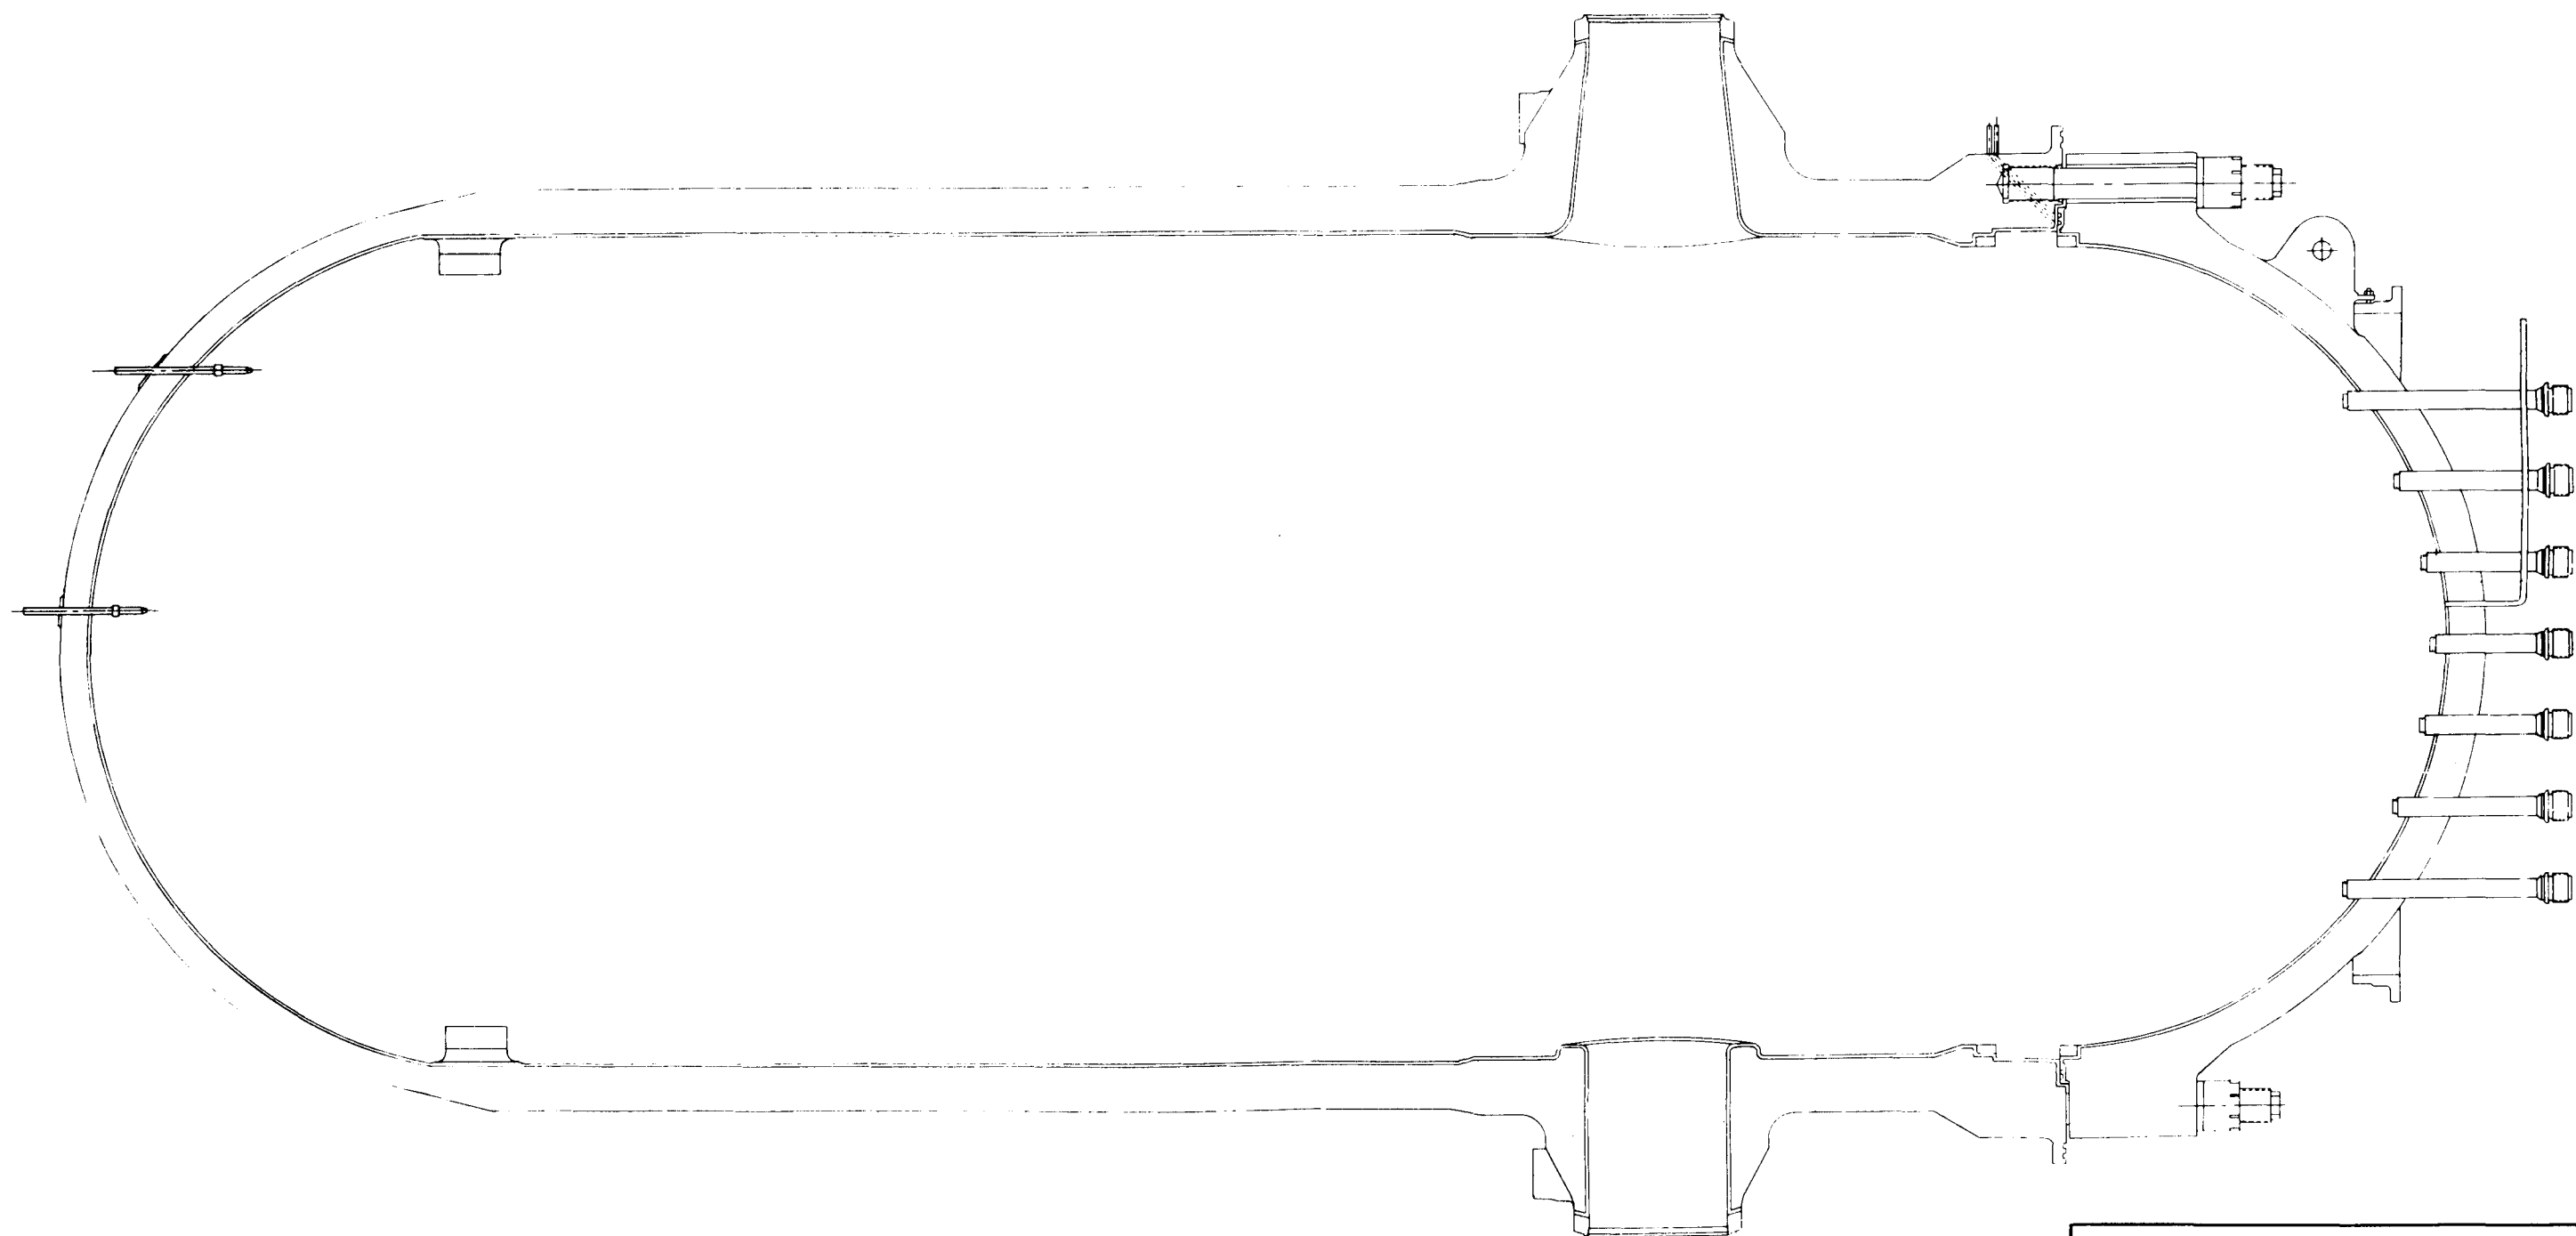

Rev. OL-0
6/86

CALLAWAY PLANT

FIGURE 5.3-1
REACTOR VESSEL

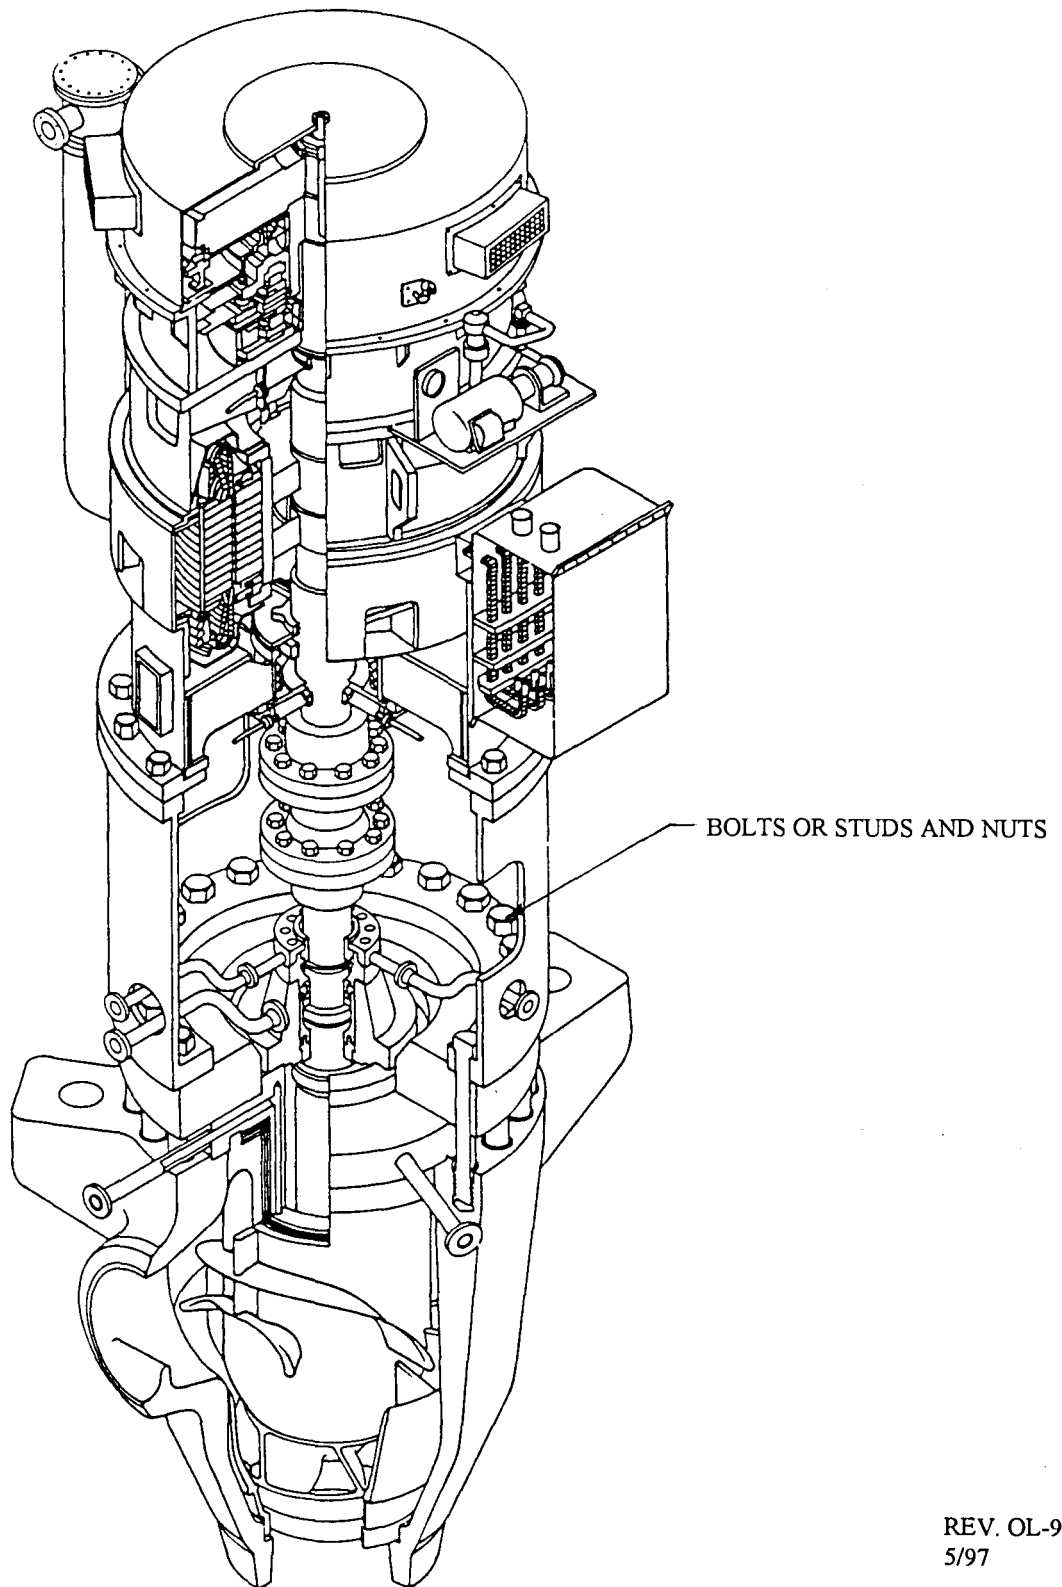


REV. OL-9
5/97

CALLAWAY PLANT

FIGURE 5.4-1

REACTOR COOLANT CONTROLLED
LEAKAGE PUMP

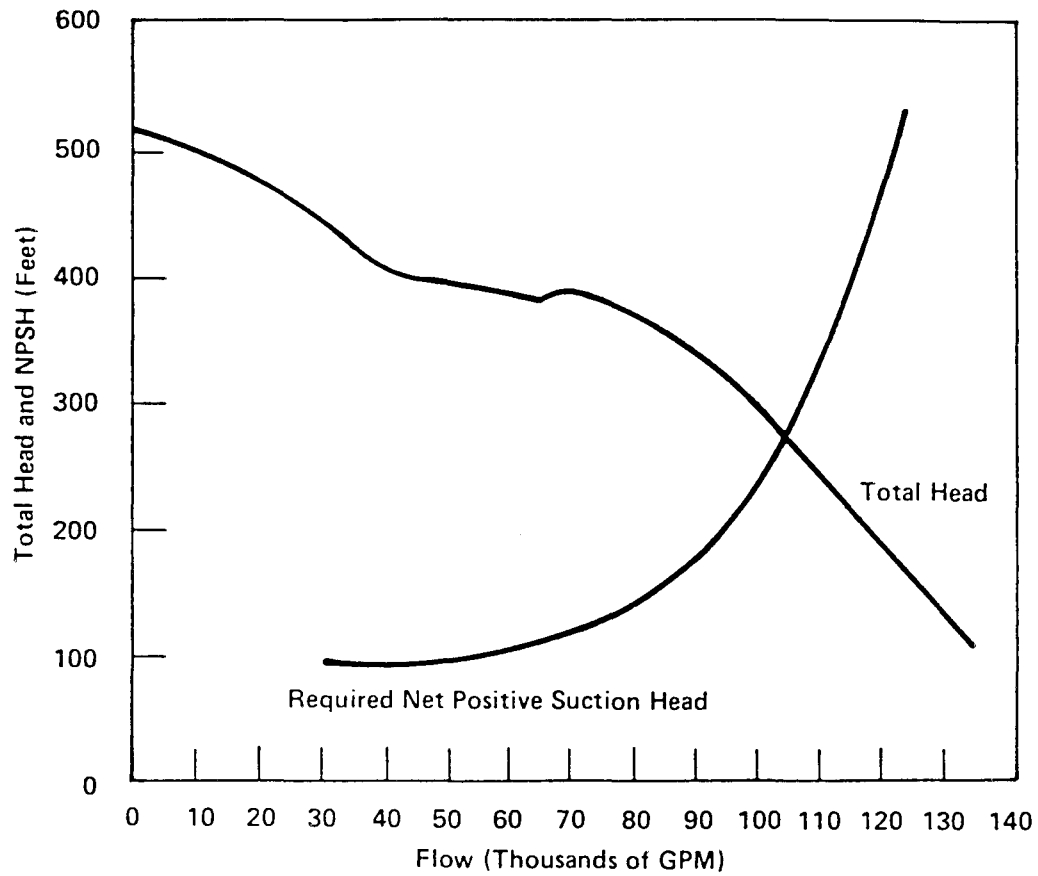


Rev. OL-0
6/86

CALLAWAY PLANT

FIGURE 5.4-2

REACTOR COOLANT PUMP ESTIMATED
PERFORMANCE CHARACTERISTIC

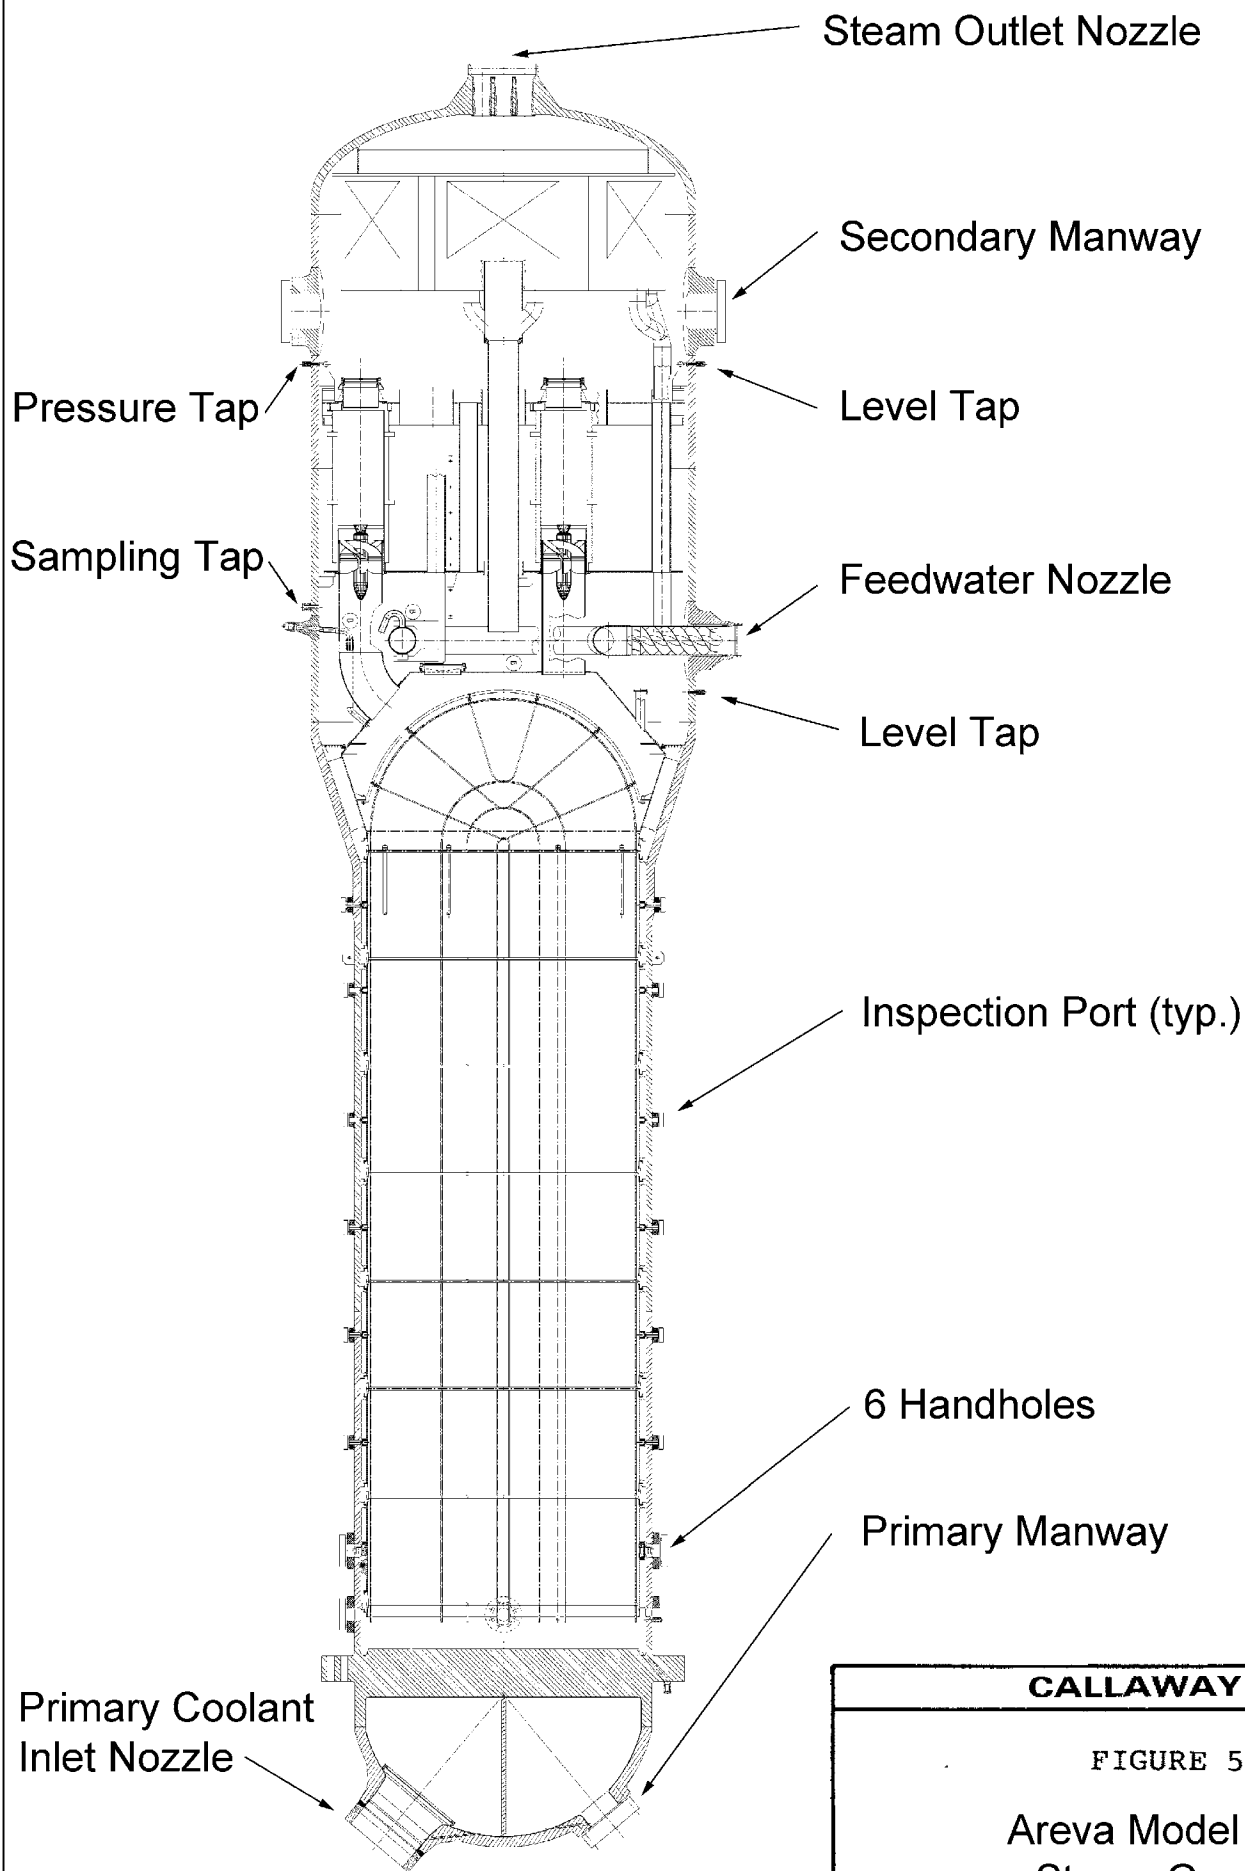

REV. OL-15
5/06

CALLAWAY PLANT


FIGURE 5.4-3

Areva Model 73/19T
Steam Generator

Figure 5.4-4 Deleted

Figure 5.4-5 Deleted

Figure 5.4-6 Deleted

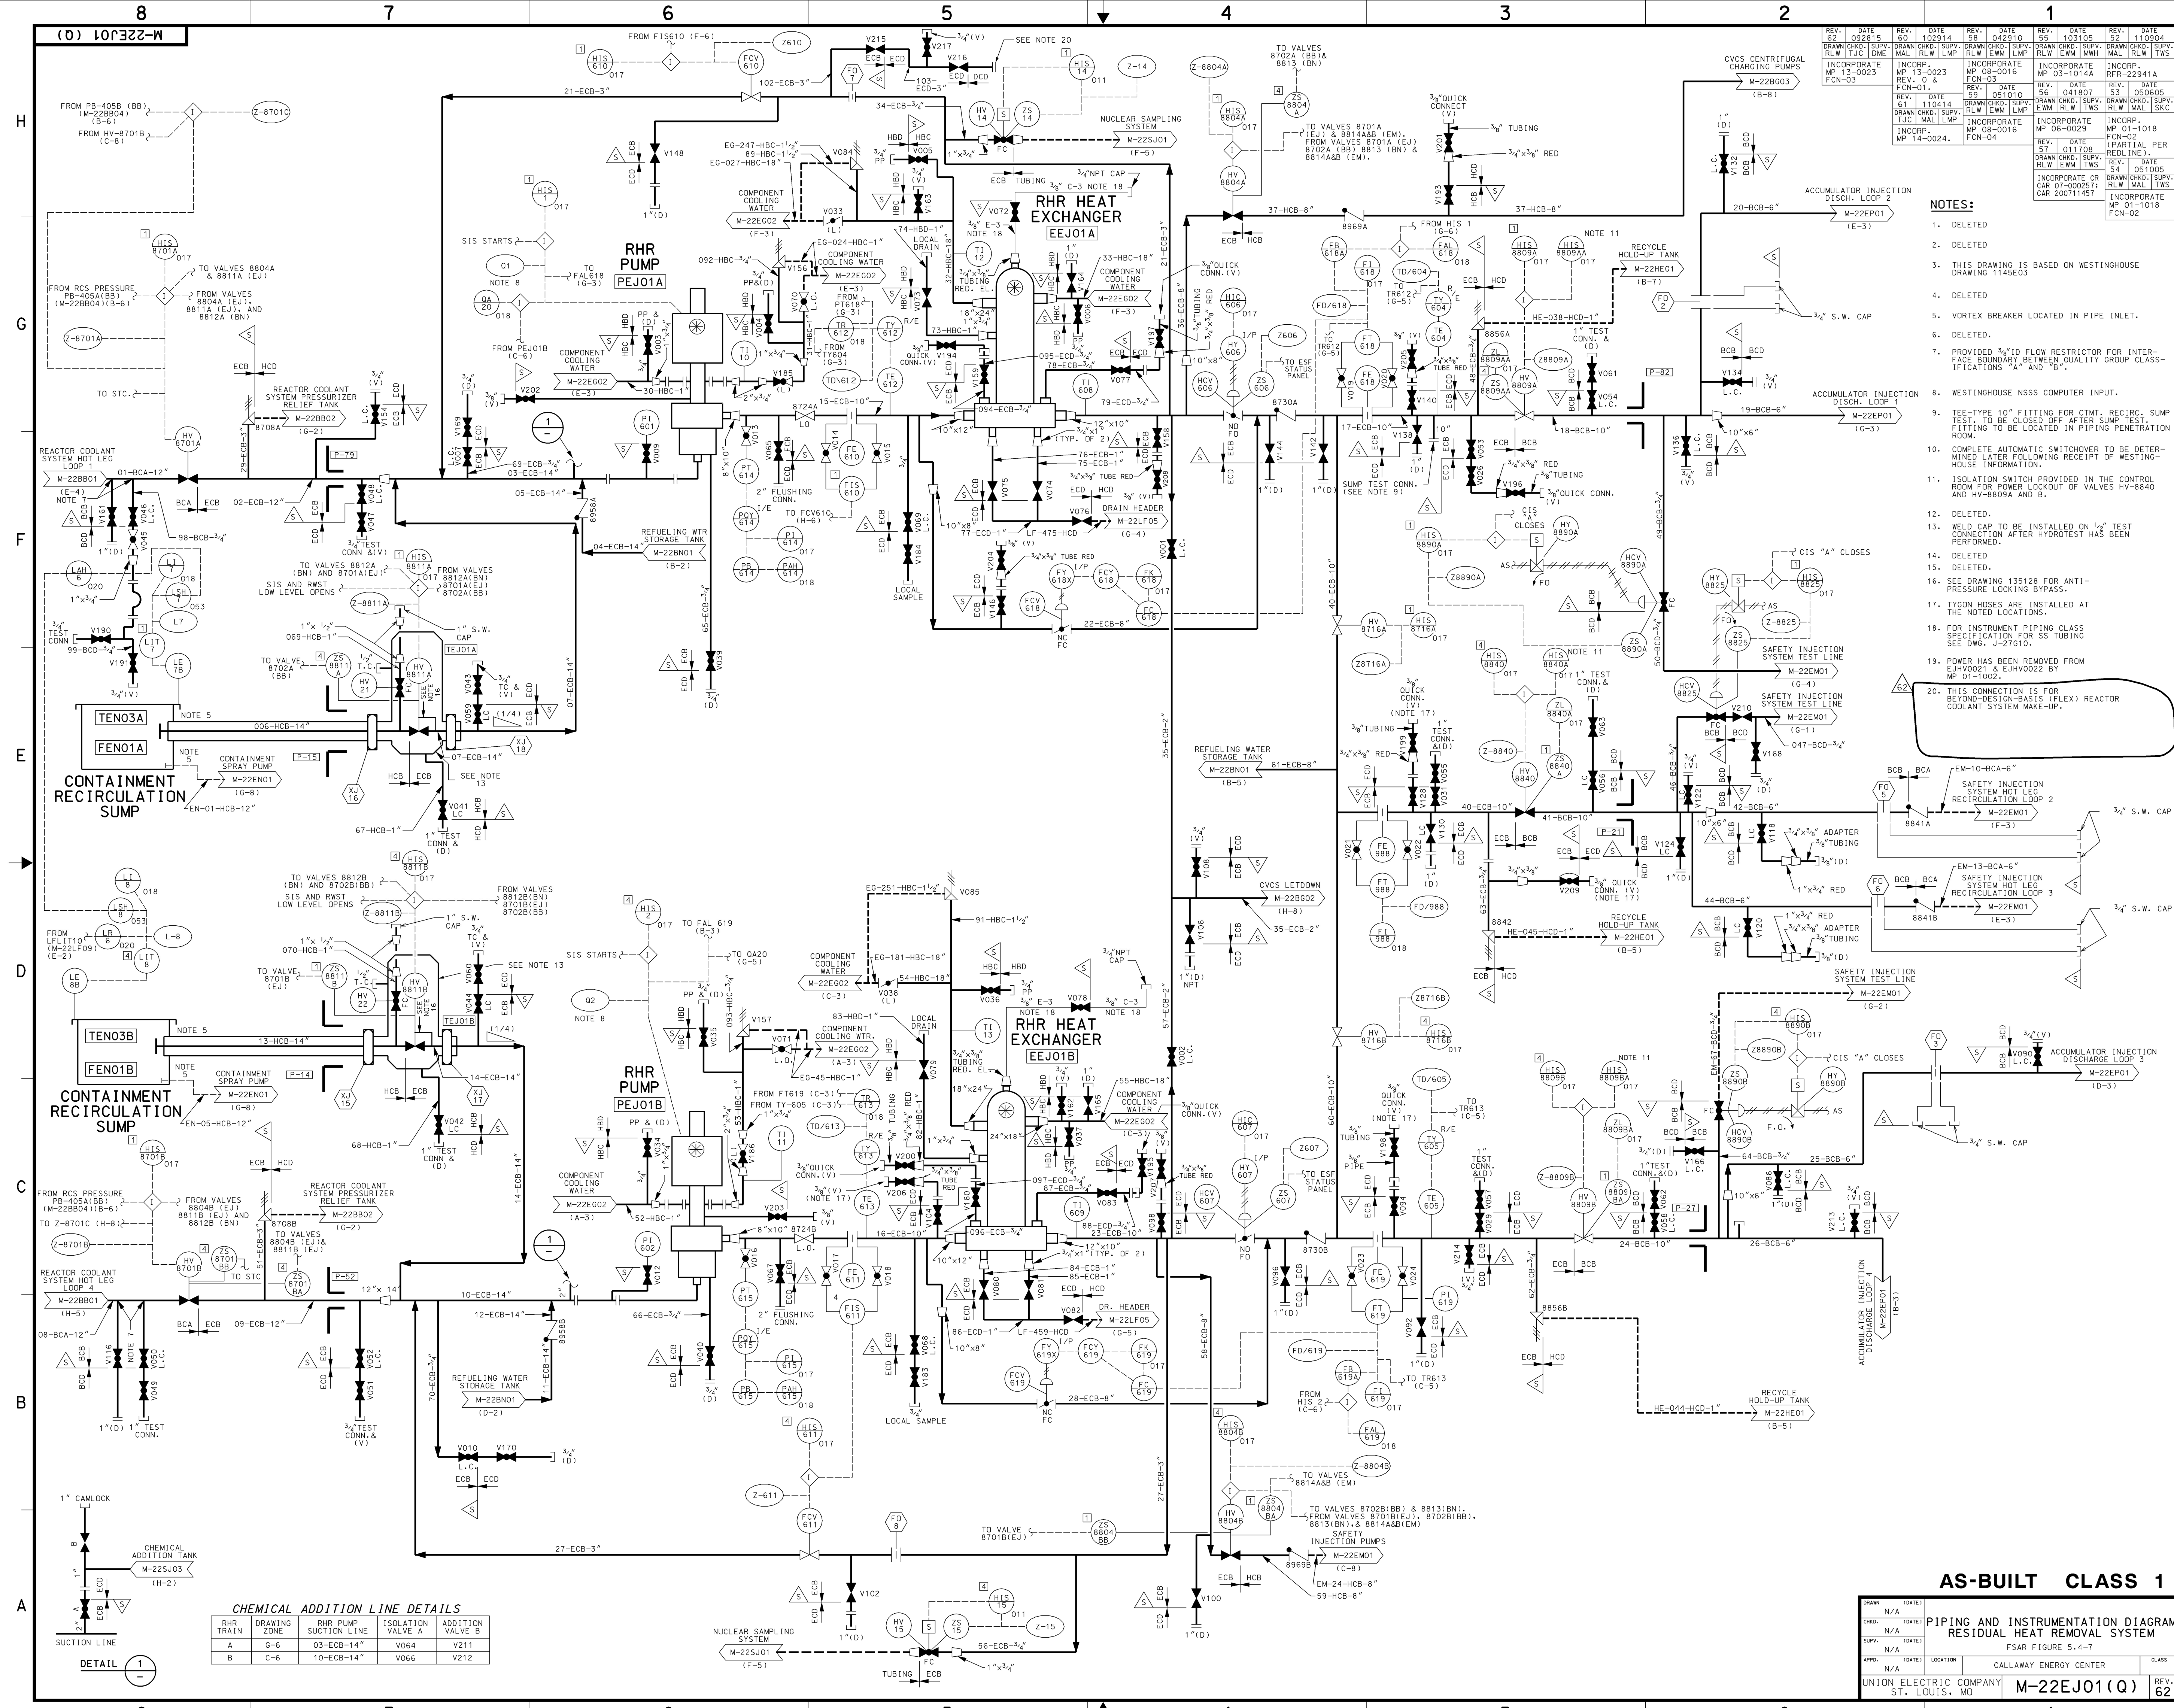

- NOTES:**
1. DELETED
 2. DELETED
 3. THIS DRAWING IS BASED ON WESTINGHOUSE DRAWING 1145E03
 4. DELETED
 5. VORTEX BREAKER LOCATED IN PIPE INLET.
 6. DELETED
 7. PROVIDED 3/4" ID FLOW RESTRICTOR FOR INTER-FACE BOUNDARY BETWEEN QUALITY GROUP CLASSIFICATIONS "A" AND "B".
 8. WESTINGHOUSE NSSS COMPUTER INPUT.
 9. TEE-TYPE 10" FITTING FOR CMT. RECIRC. SUMP TEST; TO BE CLOSED OFF AFTER SUMP TEST; FITTING TO BE LOCATED IN PIPING PENETRATION ROOM.
 10. COMPLETE AUTOMATIC SWITCHOVER TO BE DETERMINED LATER FOLLOWING RECEIPT OF WESTINGHOUSE INFORMATION.
 11. ISOLATION SWITCH PROVIDED IN THE CONTROL ROOM FOR POWER LOCKOUT OF VALVES HV-8840 AND HV-8809A AND B.
 12. DELETED
 13. INCORPORATE 135128 FOR ANTI-PRESSURE LOCKING BYPASS.
 14. DELETED
 15. DELETED
 16. SEE DRAWING 135128 FOR ANTI-PRESSURE LOCKING BYPASS.
 17. TYGON HOSES ARE INSTALLED AT THE NOTED LOCATIONS.
 18. FOR INSTRUMENT PIPING CLASS SPECIFICATION FOR SS TUBING SEE DWG. J-271010.
 19. POWER HAS BEEN REMOVED FROM EHV0021 & EHV0022 BY MP 01-1002.
 20. THIS CONNECTION IS FOR BEYOND-DESIGN-BASIS (FLEX) REACTOR COOLANT SYSTEM MAKE-UP.


AS-BUILT CLASS 1

DATE	BY	DATE	BY	DATE	BY	DATE	BY
09/28/15	N/A	09/28/15	N/A	09/28/15	N/A	09/28/15	N/A
09/28/15	N/A	09/28/15	N/A	09/28/15	N/A	09/28/15	N/A
09/28/15	N/A	09/28/15	N/A	09/28/15	N/A	09/28/15	N/A
09/28/15	N/A	09/28/15	N/A	09/28/15	N/A	09/28/15	N/A

UNION ELECTRIC COMPANY
ST. LOUIS, MO

M-22EJ01(Q)

REV. 62

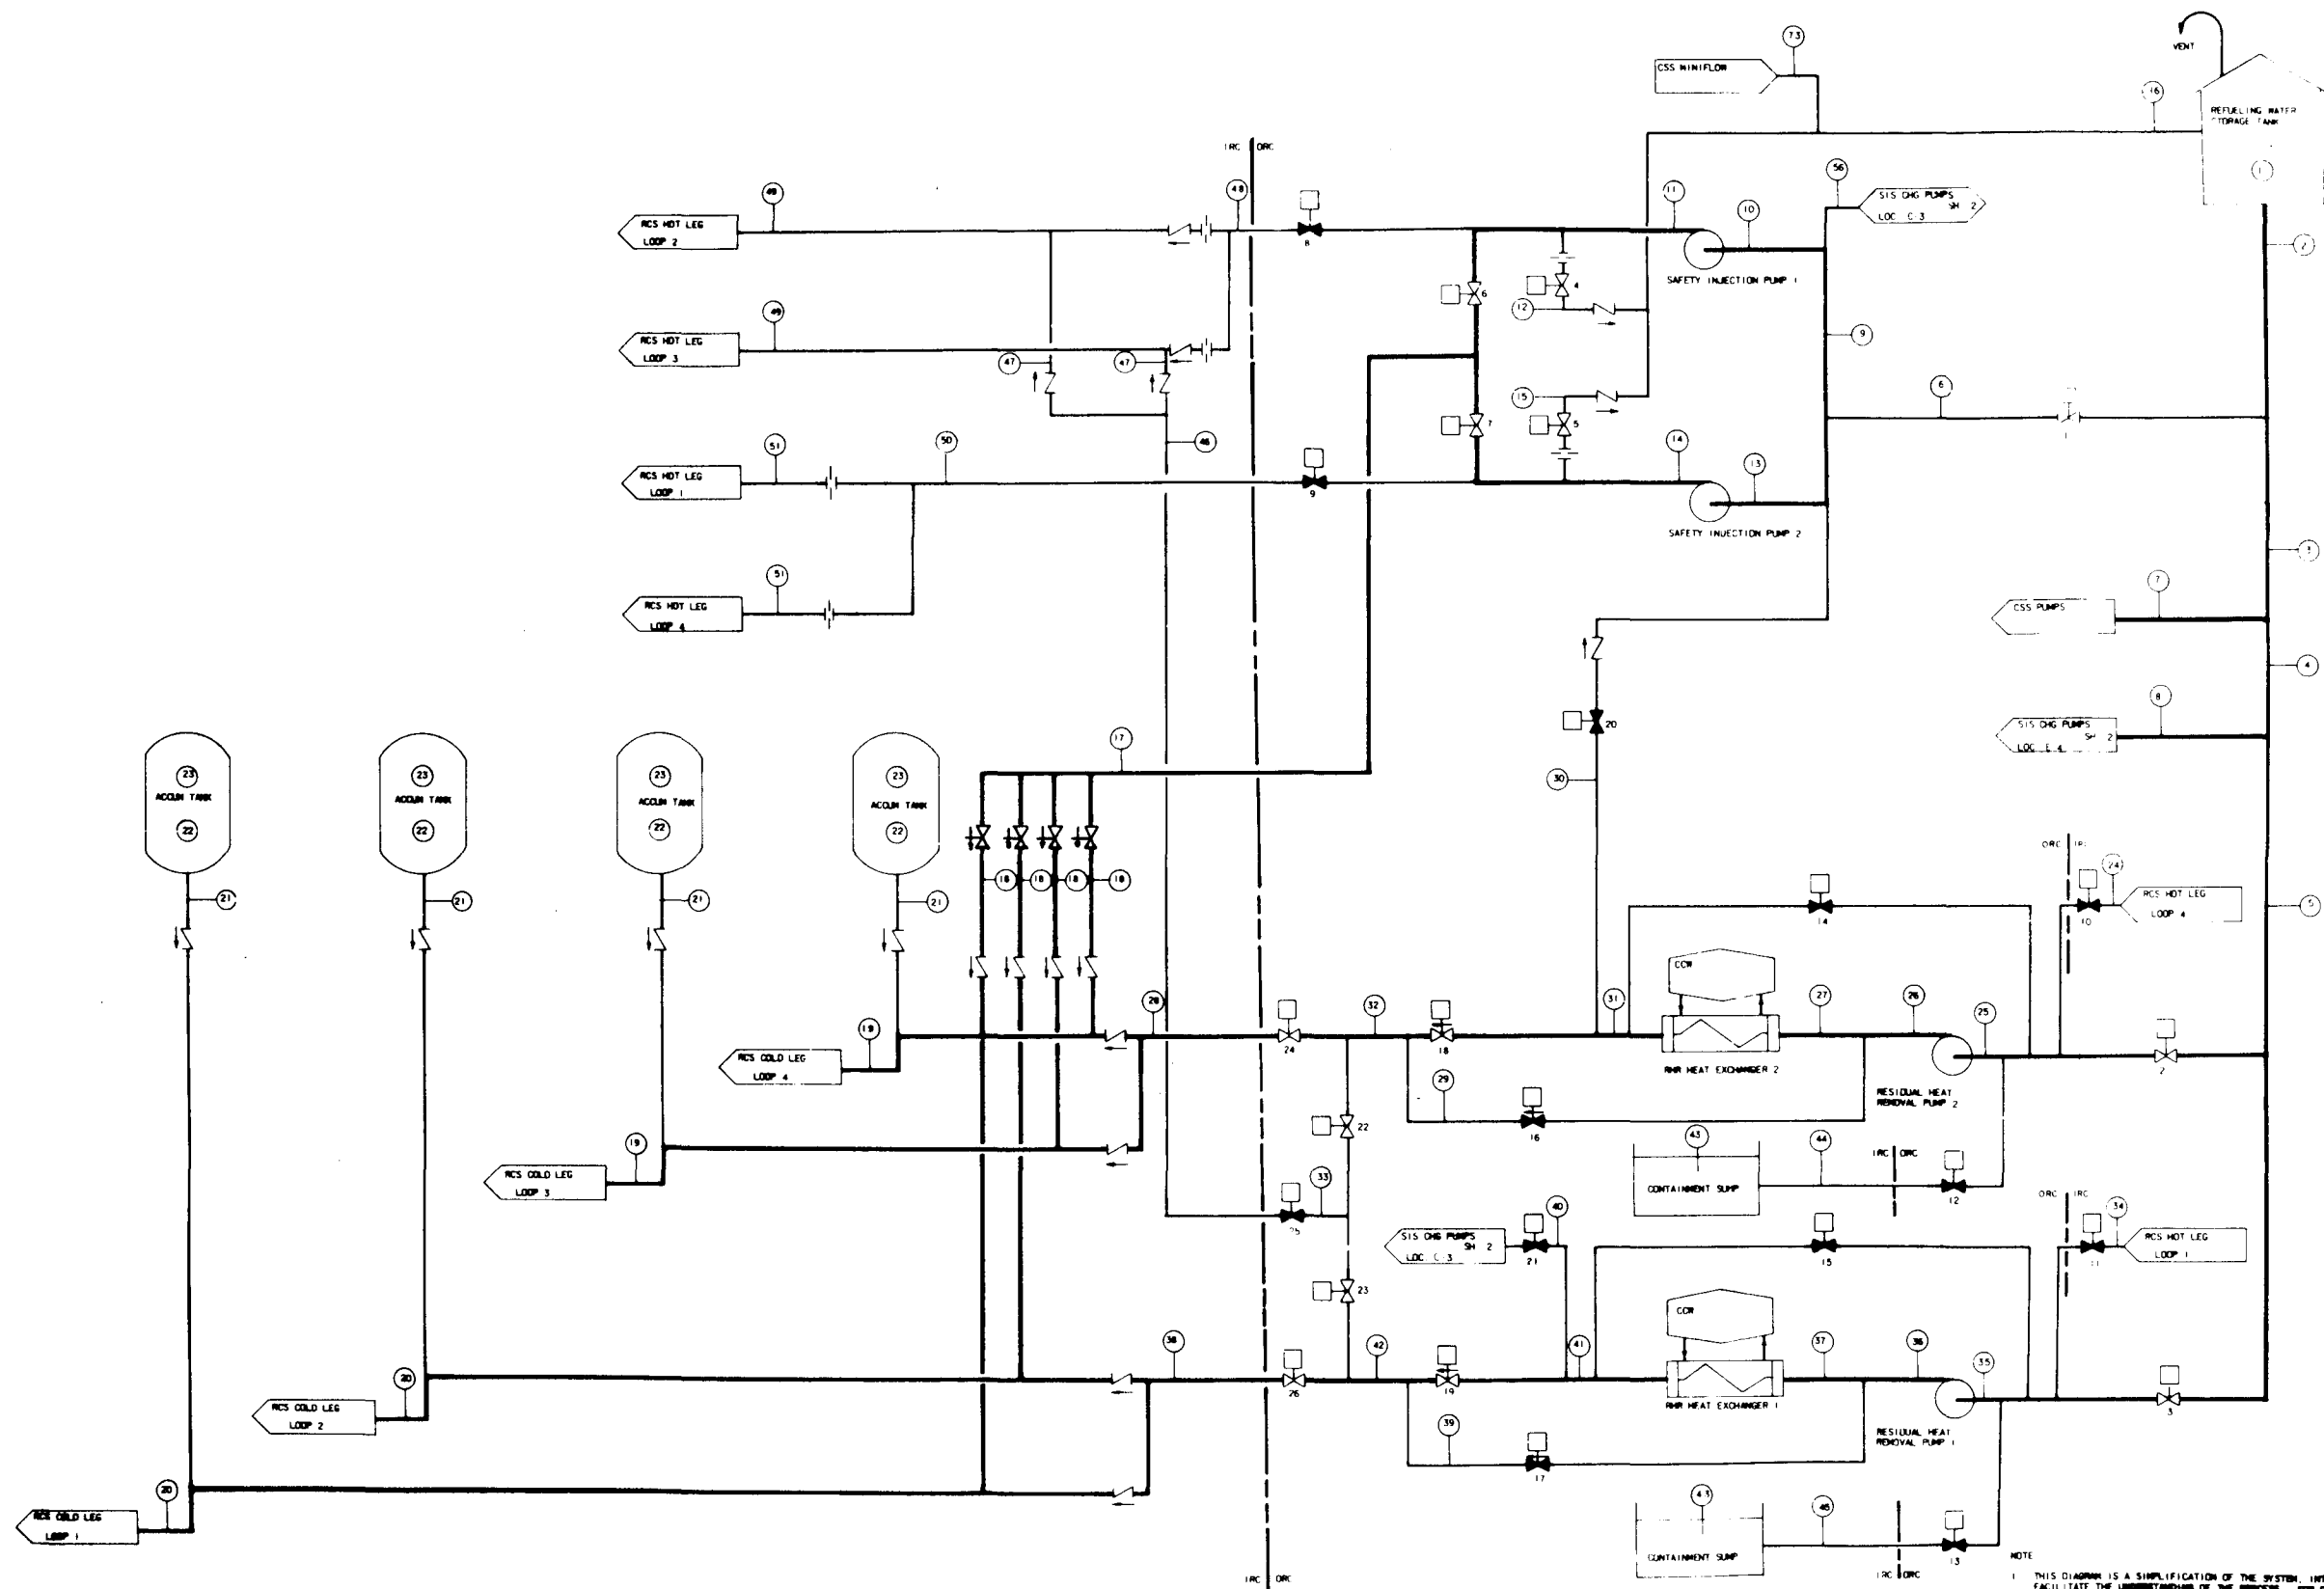

NOTE
1. THIS DIAGRAM IS A SIMPLIFICATION OF THE SYSTEM, INTENDED TO FACILITATE THE UNDERSTANDING OF THE PROCESS. FOR DETAILS OF THE PIPING, VALVES, INSTRUMENTATION, ETC. REFER TO THE ENGINEERING FLOW DIAGRAM. REFER TO PROCESS PLAN DIAGRAM TABLES FOR THE CONDITION AT EACH INSTRUMENT POINT.

(SEE NOTES ON THE FOLLOWING PAGES)

CALLAWAY PLANT

FIGURE 5.4-8

RESIDUAL HEAT REMOVAL SYSTEM
PROCESS FLOW DIAGRAM

NOTES TO FIGURE 5.4-8

MODES OF OPERATION

MODE A - INITIATION OF RHR OPERATION

When the reactor coolant temperature and pressure are reduced below approximately 350°F and 400 psig, approximately 4 hours after reactor shutdown, the second phase of plant cooldown starts with the RHRS being placed in operation. Before starting the pumps, the inlet isolation valves are opened, the heat exchanger flow control valves are set at minimum flow, and the outlet valves are verified open. The automatic miniflow valves are open and remain so until the pump flow exceeds approximately 1,650 gpm (at 300°F) at which time they close. Should the pump flow drop below approximately 816 gpm (at 300°F), the miniflow valves open automatically.

Startup of the RHRS includes a warmup period during which time reactor coolant flow through the heat exchangers is limited to minimize thermal shock on the RCS. The rate of heat removal from the reactor coolant is controlled manually by regulating the reactor coolant flow through the residual heat exchangers. The total flow is regulated automatically by control valves in the heat exchanger bypass line to maintain a constant total flow. The cooldown rate is limited to 100°F/hr, based on equipment stress limits and a 120°F maximum component cooling water temperature at the RHR heat exchanger inlet.

MODE B - END CONDITIONS OF A NORMAL COOLDOWN

This situation characterizes most of the RHRS operation. As the reactor coolant temperature decreases, the flow through the residual heat exchanger is increased until all of the flow is directed through the heat exchanger to obtain maximum cooling.

Note:

For the safeguards functions performed by the RHRS, refer to Section 6.3, ECCS.

NOTES TO FIGURE 5.4-8 (Sheet 2)**VALVE ALIGNMENT CHART**

<u>Valve No.</u>	<u>Operational Mode</u>	
	<u>A</u>	<u>B</u>
2	C	C
3	C	C
10	O	O
11	O	O
12	C	C
13	C	C
14	C	C
15	C	C
16	P	C
17	P	C
18	P	O
19	P	O
20	C	C
21	C	C
22	O	O
23	O	O
24	O	O
26	O	O

O = Open

C = Closed

P = Partially Open

NOTES TO FIGURE 5.4-8 (Sheet 3)
MODE A - INITIATION OF RHR OPERATION


<u>Location</u>	<u>Fluid</u>	<u>Pressure</u> <u>(psig)</u>	<u>Temperature</u> <u>(F)</u>	<u>Flow</u> <u>(gpm)^(a)</u>	<u>(lb/hr)</u>
24	Reactor coolant	400	350	3,800	1.60×10^6
25	"	407	350	3,800	1.60×10^6
26	"	542	350	3,800	1.60×10^6
27	"	541	350	1,259	0.56×10^6
31	"	539	140	1,259	0.56×10^6
29	"	496	350	2,541	1.13×10^6
32	"	496	280	3,800	1.69×10^6
28	"	480	280	3,690	1.64×10^6
19 Loop 4	"	404	280	1,992	0.885×10^6
19 Loop 3	"	419	280	1,698	0.755×10^6
34	"	400	350	3,800	1.69×10^6
35	"	407	350	3,800	1.69×10^6
36	"	542	350	3,800	1.69×10^6
37	"	541	350	1,259	0.56×10^6
41	"	539	140	1,259	0.56×10^6
39	"	496	350	2,541	1.13×10^6
42	"	496	280	3,800	1.69×10^6
38	"	479	280	3,910	1.74×10^6
20 Loop 1	"	404	280	1,955	0.87×10^6
20 Loop 2	"	404	280	1,955	0.87×10^6

(a) At reference conditions 350°F and 400 psig

NOTES TO FIGURE 5.4-8 (Sheet 4)**MODE B - END CONDITIONS OF A NORMAL COOLDOWN**

<u>Location</u>	<u>Fluid</u>	<u>Pressure</u> <u>(psig)</u>	<u>Temperature</u> <u>(F)</u>	<u>Flow</u> <u>(gpm) ^(a)</u>	<u>(lb/hr)</u>
24	Reactor coolant	0	140	3,800	1.87×10^6
25	"	7	140	3,800	1.87×10^6
26	"	156	140	3,800	1.87×10^6
27	"	149	140	3,800	1.87×10^6
31	"	129	120	3,800	1.87×10^6
29	"	93	120	0	0
32	"	93	120	3,800	1.87×10^6
28	"	75	120	3,800	1.87×10^6
19	"	2	120	1,900	0.935×10^6
34	"	0	140	3,800	1.87×10^6
35	"	7	140	3,800	1.87×10^6
36	"	156	140	3,800	1.87×10^6
37	"	149	140	3,800	1.87×10^6
41	"	129	120	3,800	1.87×10^6
39	"	93	120	0	0
42	"	93	120	3,800	1.87×10^6
38	"	75	120	3,800	1.87×10^6
20	"	2	120	1,900	0.935×10^6

(a) At reference conditions 140°F and 0 psig.

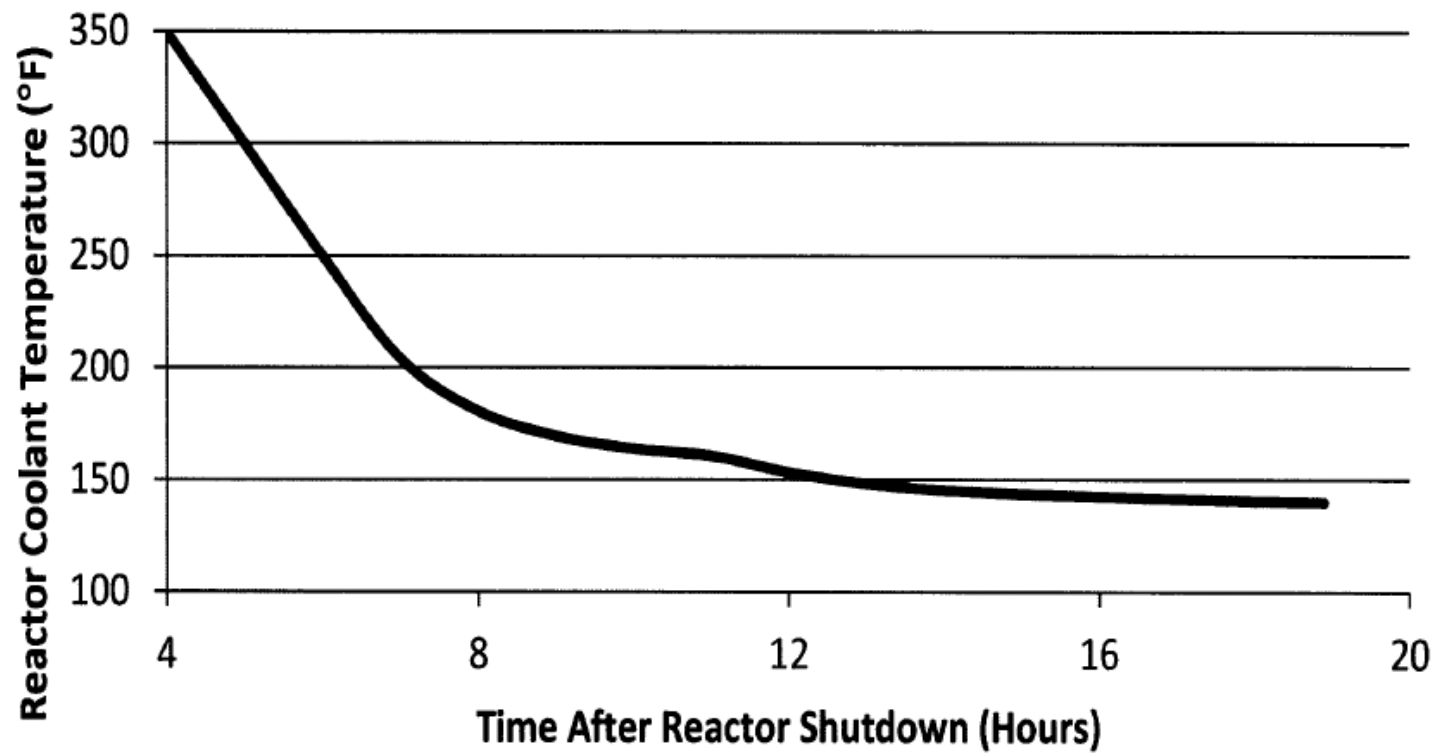


CALLAWAY PLANT

FIGURE 5.4-9

NORMAL RESIDUAL HEAT
REMOVAL COOLDOWN

REV. 16 9/14

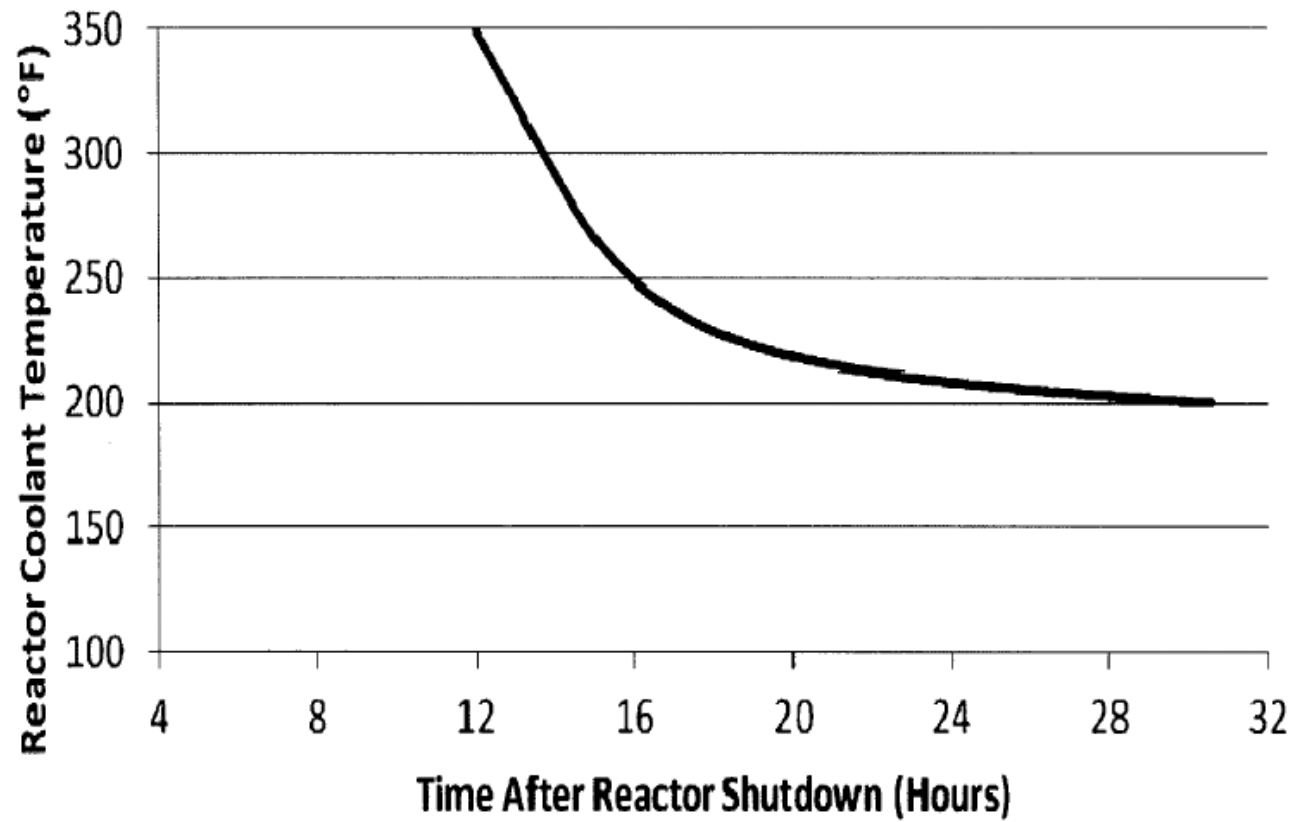


CALLAWAY PLANT

FIGURE 5.4-10

**SINGLE RESIDUAL HEAT REMOVAL
TRAIN COOLDOWN**

REV. 16 9/14

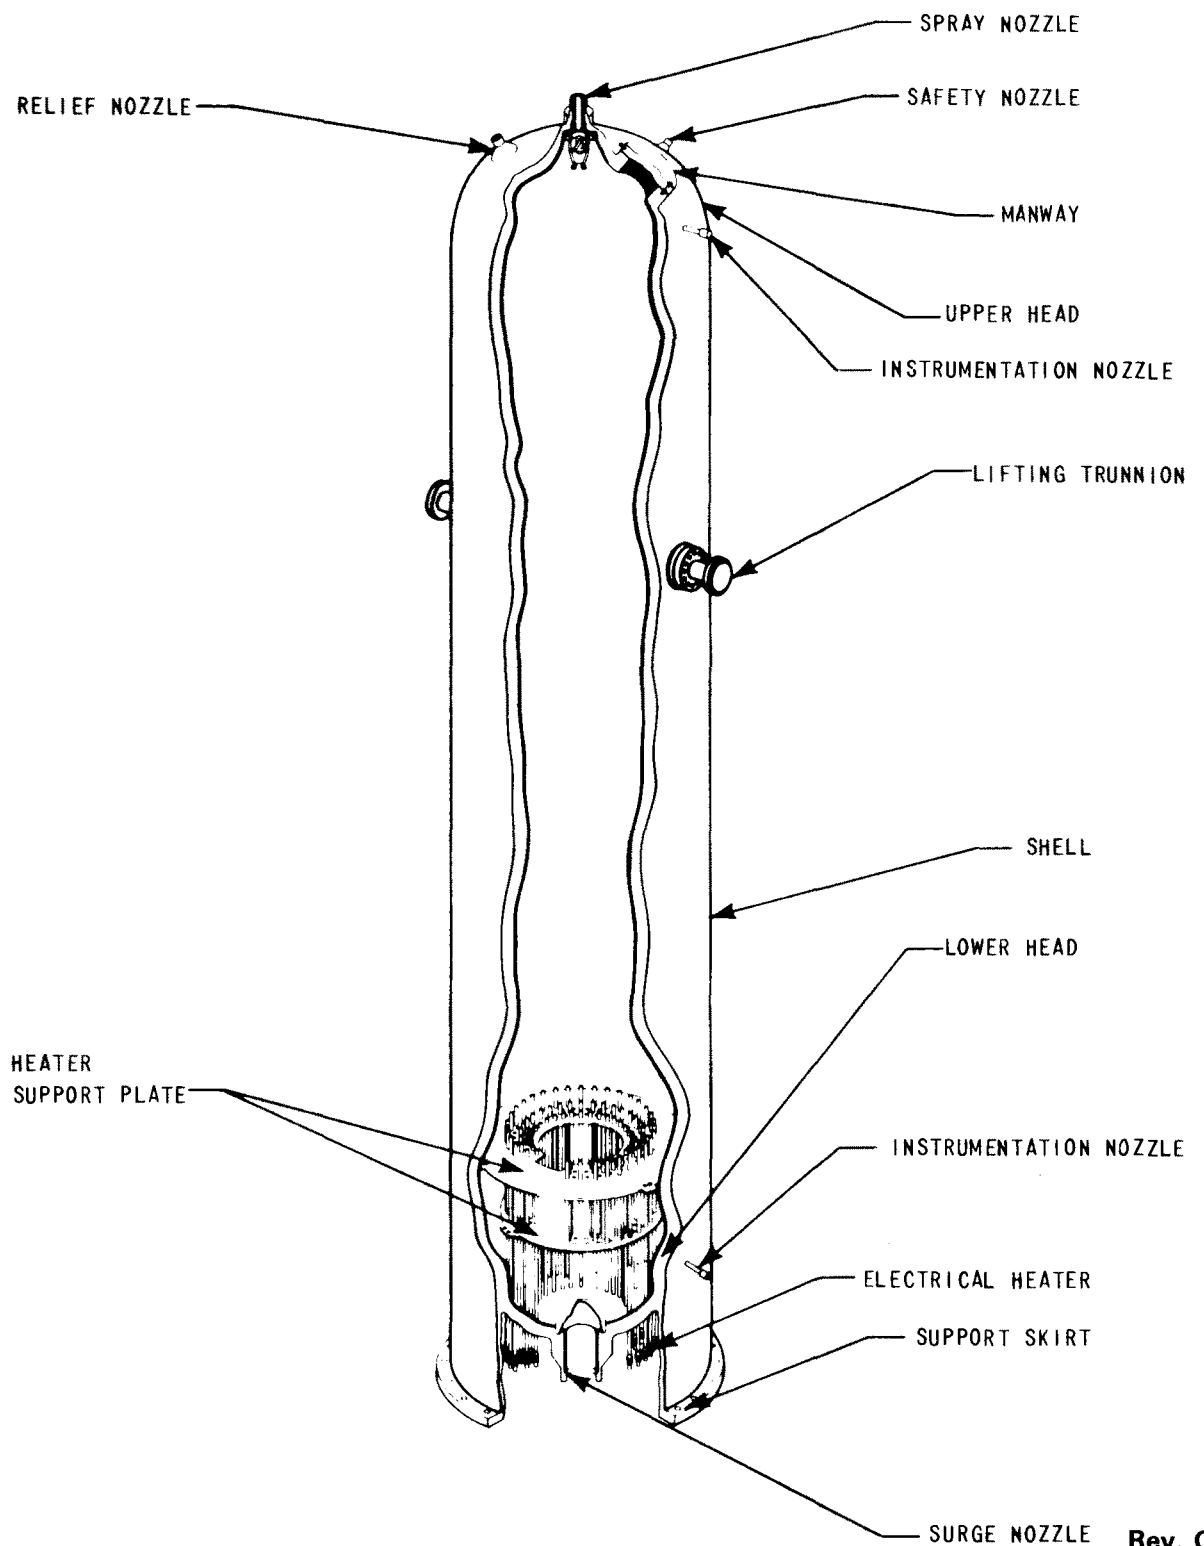


Rev. OL-0
6/86

CALLAWAY PLANT

FIGURE 5.4-11

PRESSURIZER

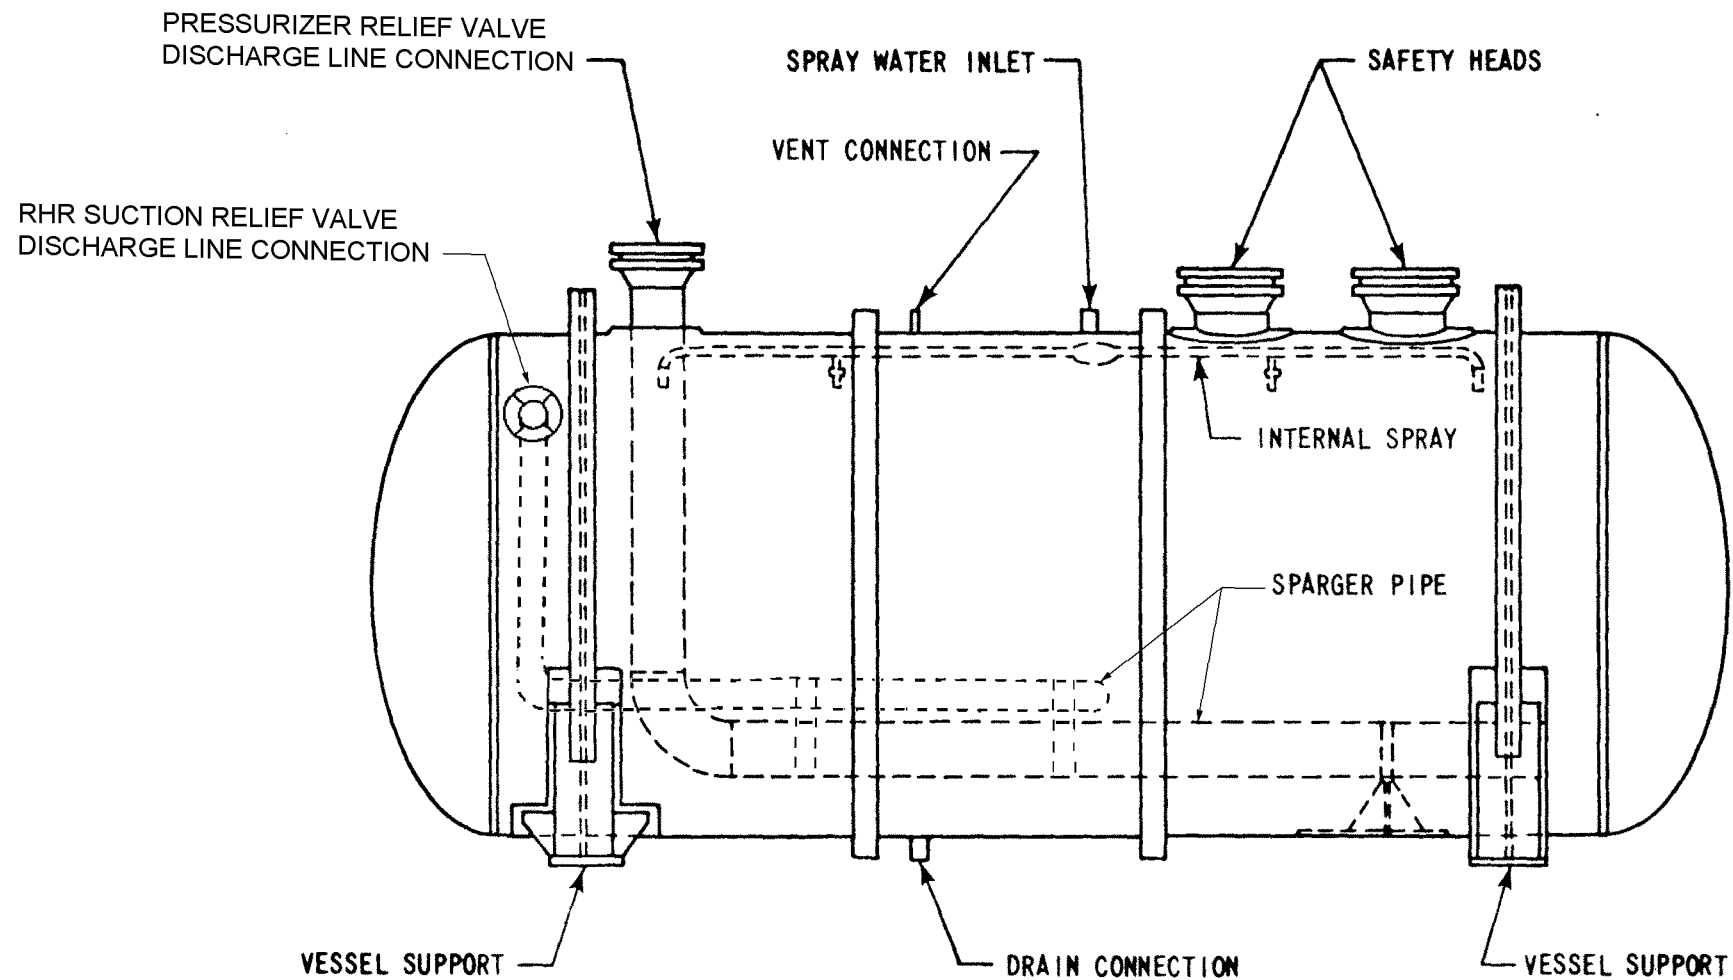


CALLAWAY PLANT

FIGURE 5.4-12


PRESSURIZER RELIEF TANK

REV. 1 3/09

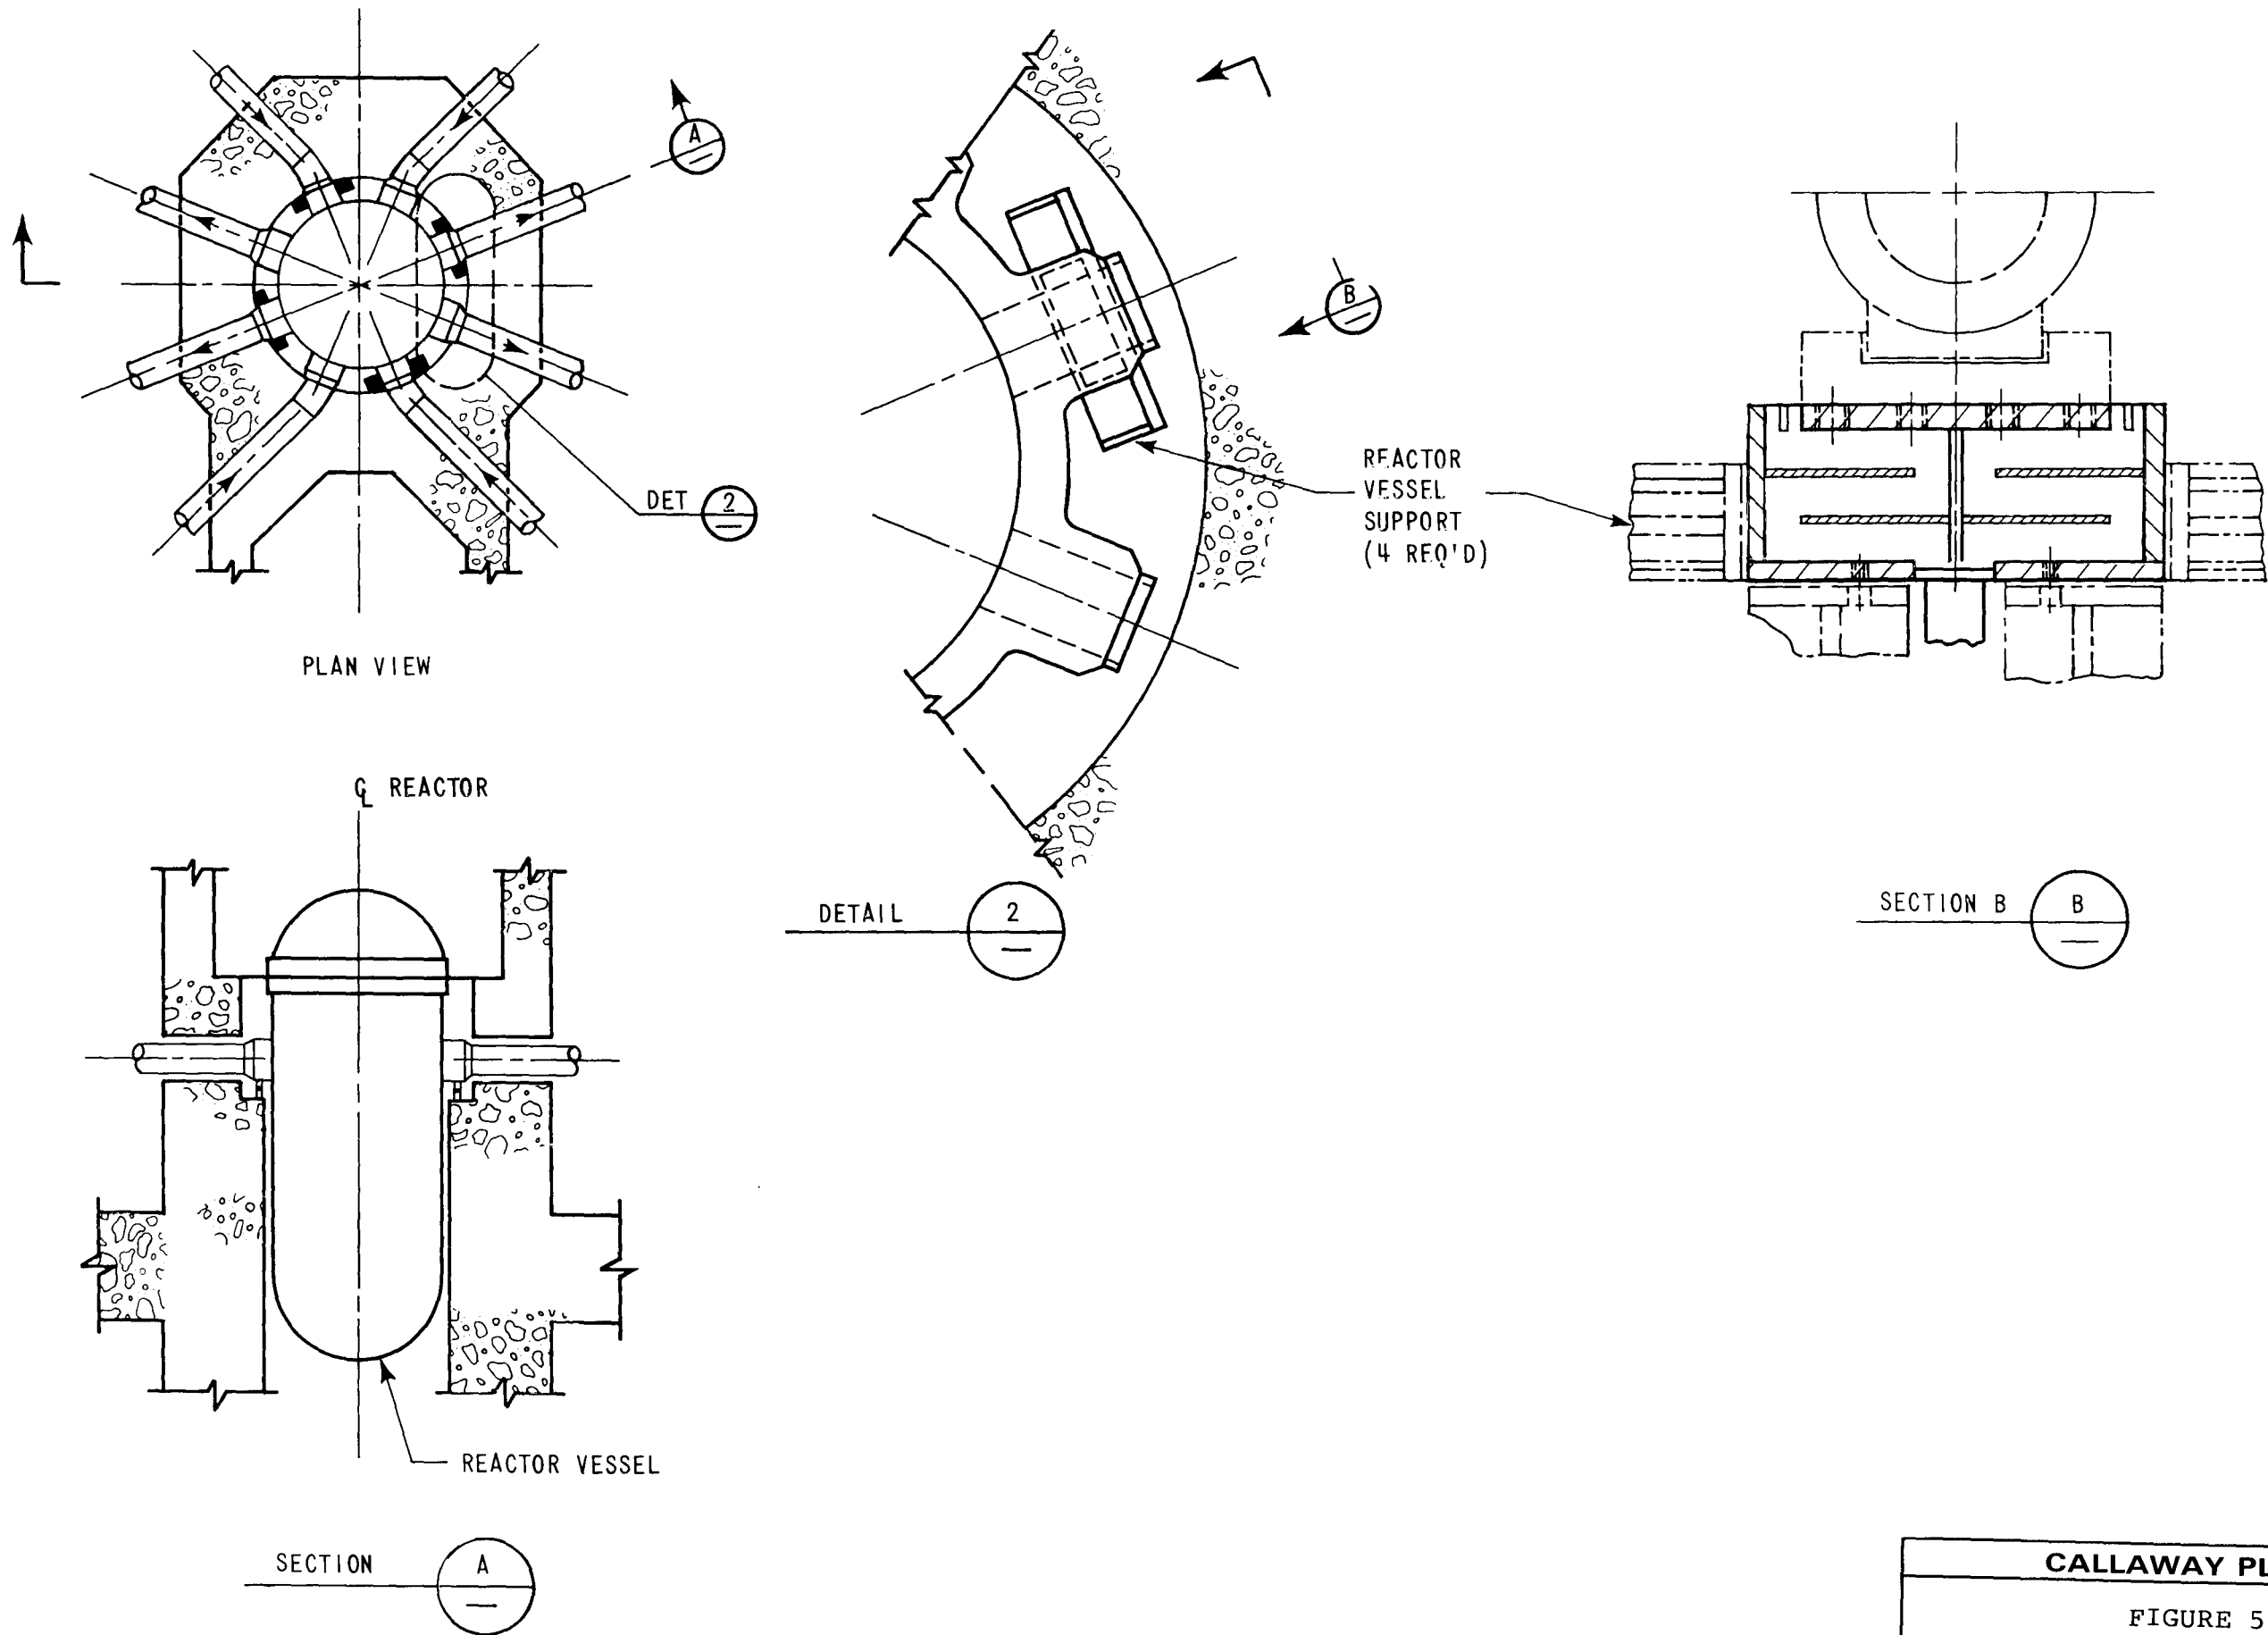

Rev. OL-0
6/86


CALLAWAY PLANT
FIGURE 5.4-13
REACTOR VESSEL SUPPORTS

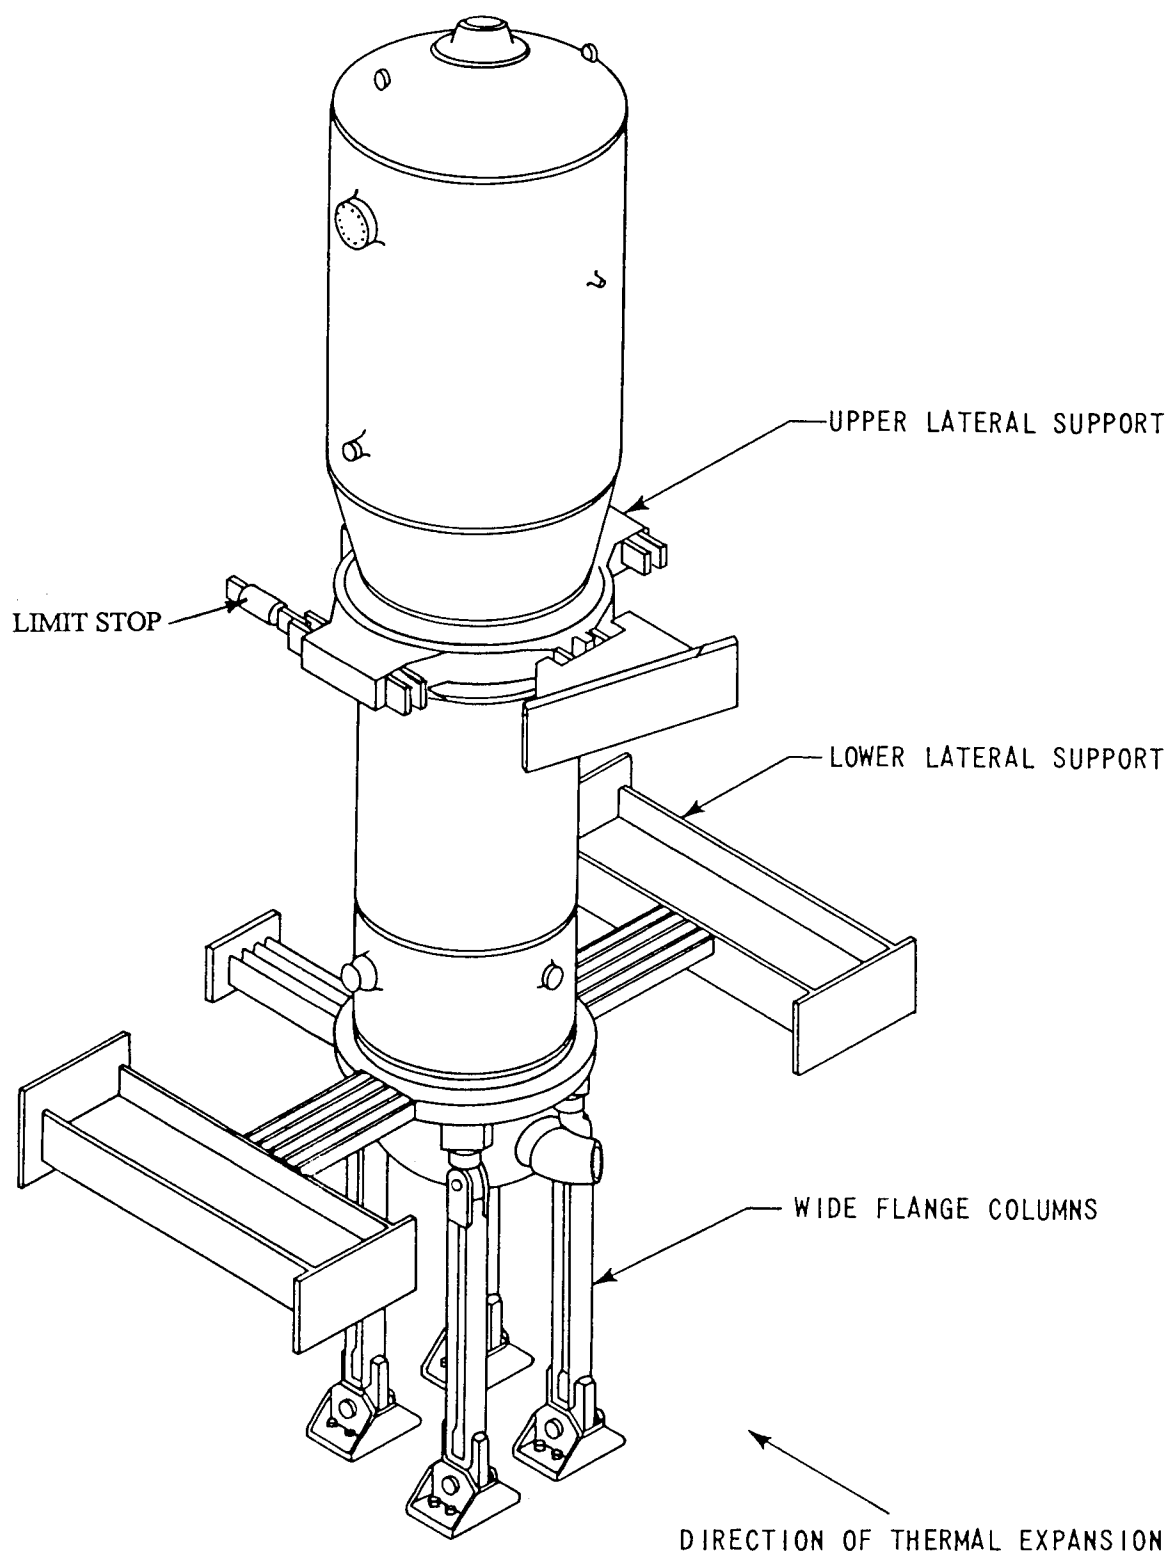

REV. OL-15
5/06

CALLAWAY PLANT

FIGURE 5.4-14
STEAM GENERATOR SUPPORTS


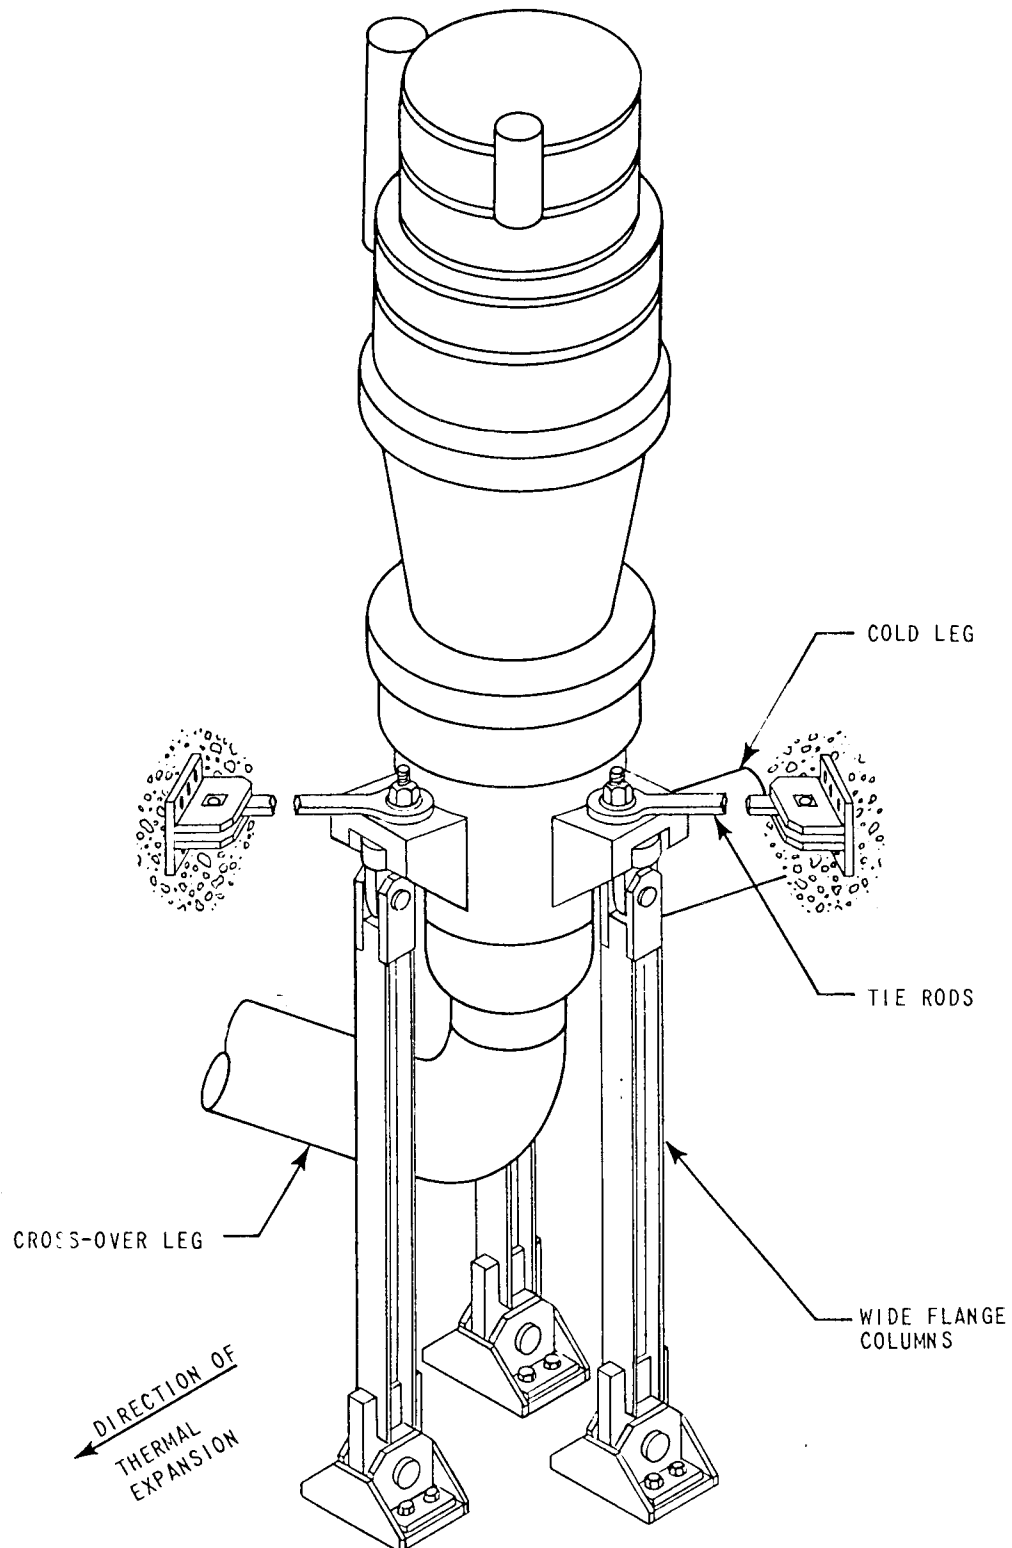


Rev. OL-0
6/86

CALLAWAY PLANT


FIGURE 5.4-15

REACTOR COOLANT PUMP SUPPORT

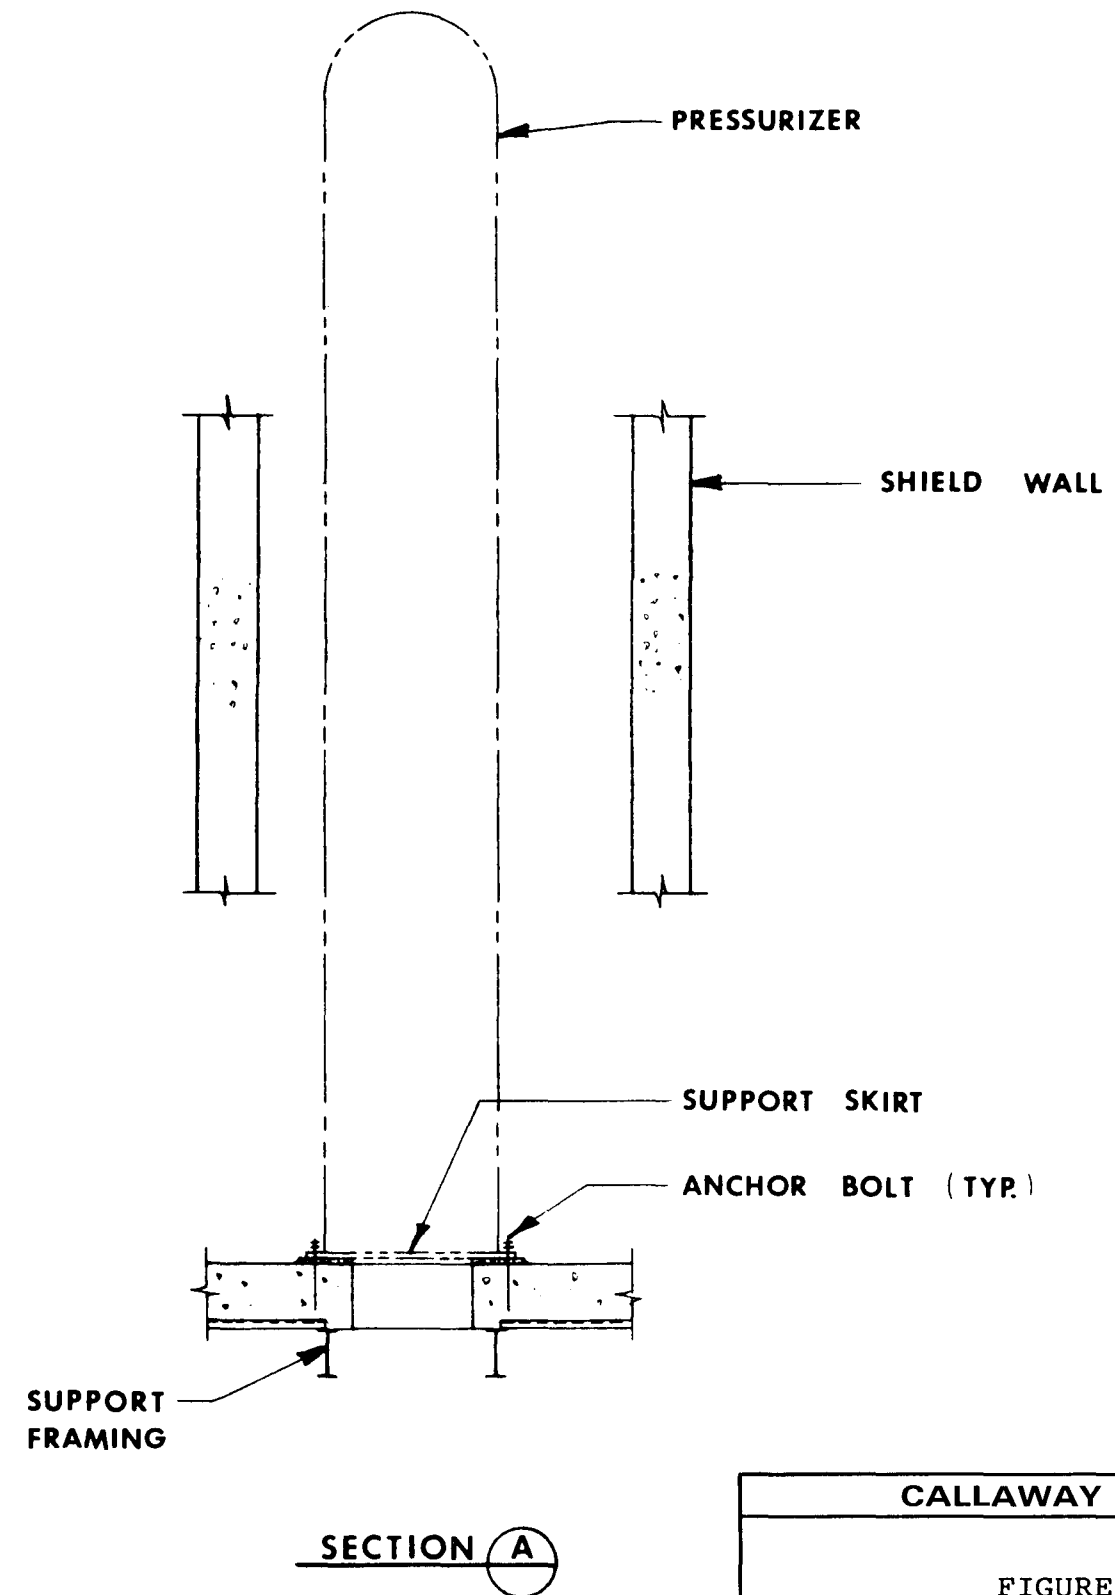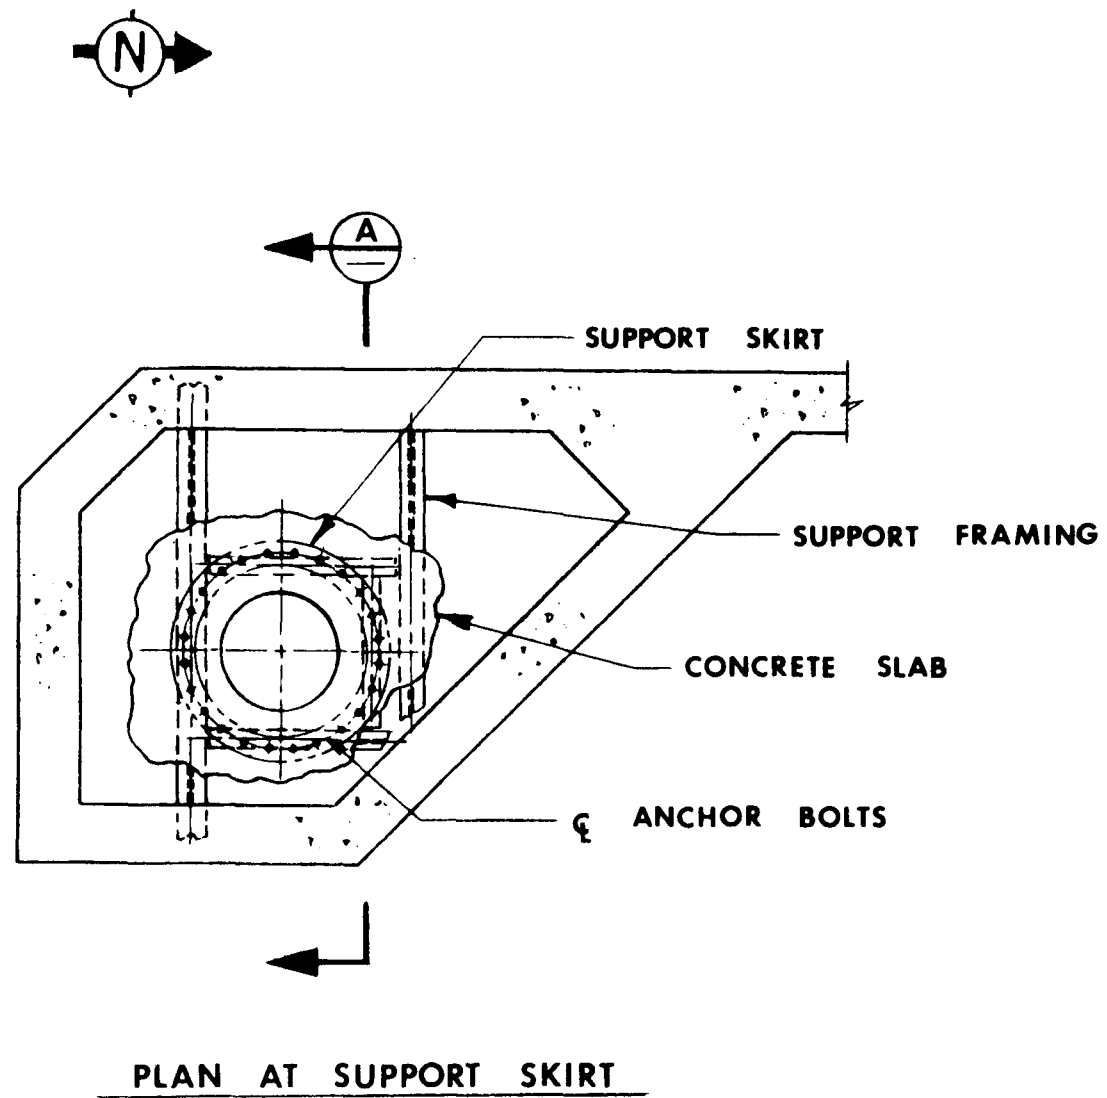

Rev. OL-0
6/86

CALLAWAY PLANT
FIGURE 5.4-16
REACTOR BUILDING INTERNALS PRESSURIZER SUPPORTS

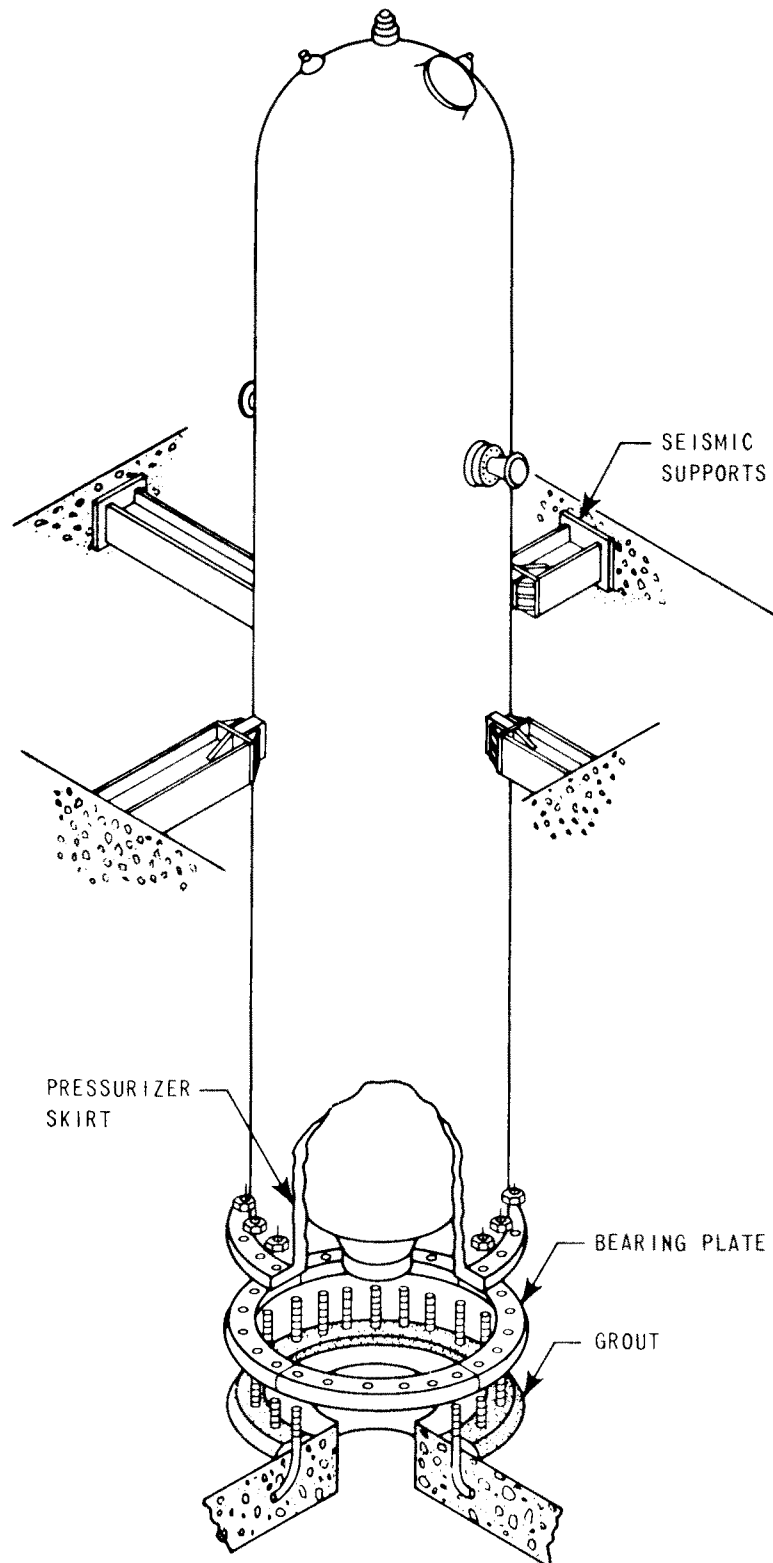


Rev. OL-0
6/86

CALLAWAY PLANT

FIGURE 5.4-17

PRESSURIZER SUPPORTS

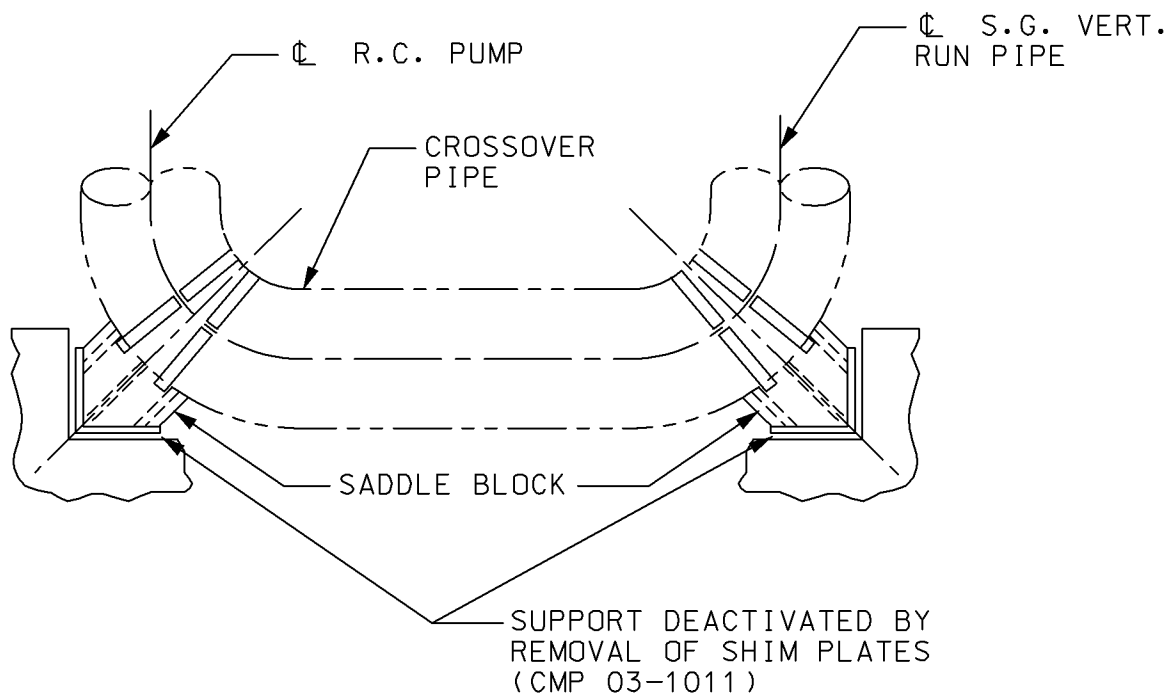


CALLAWAY PLANT

FIGURE 5.4 - 18
CROSSOVER LEG RESTRAINT

REV. OL-15 5/06


Figure 5.4-19 Deleted

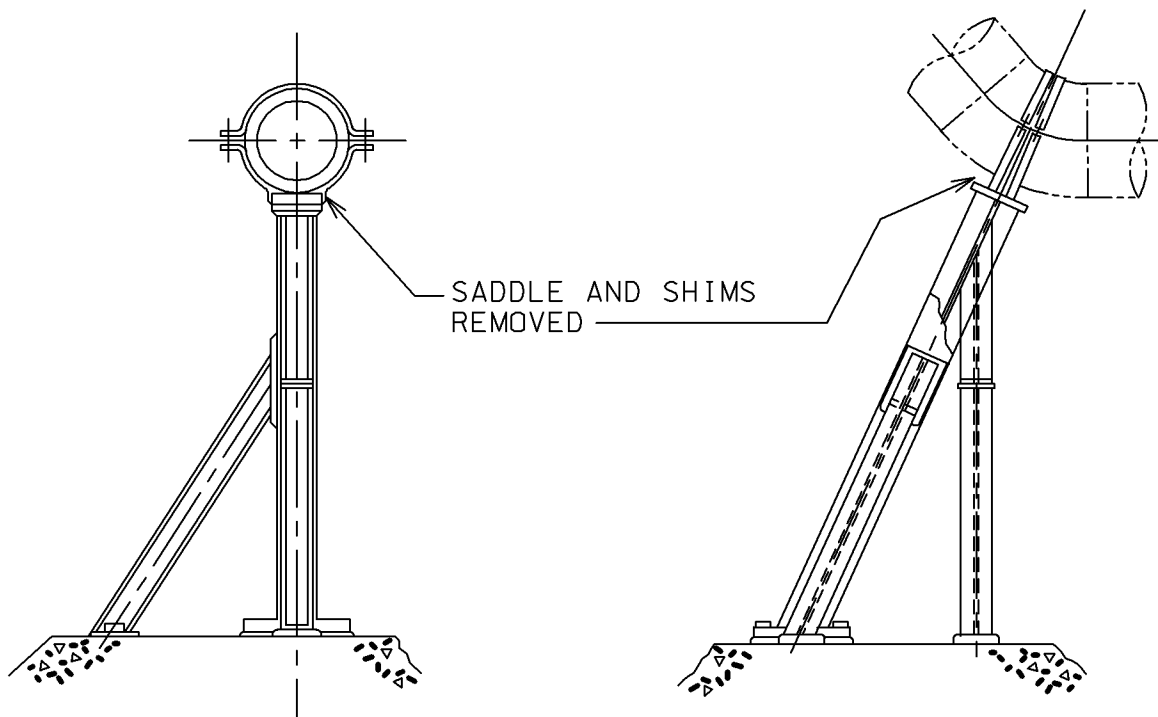


CALLAWAY PLANT

FIGURE 5.4 - 20
HOT LEG RESTRAINT


REV. OL-15 5/06

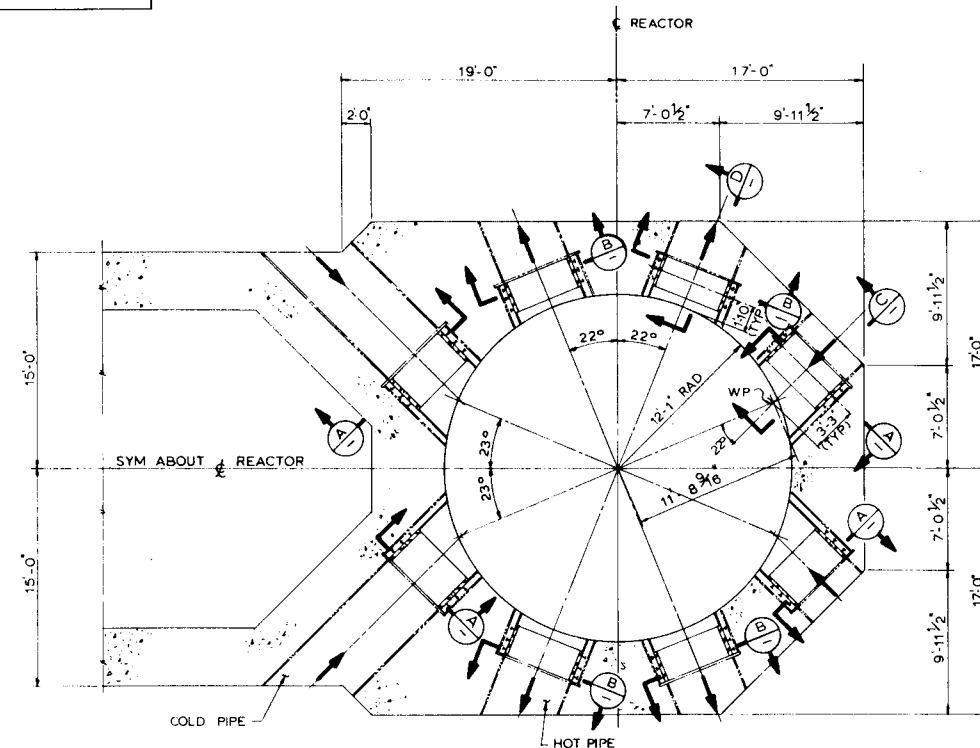


PLAN AT EL 2014'-6"

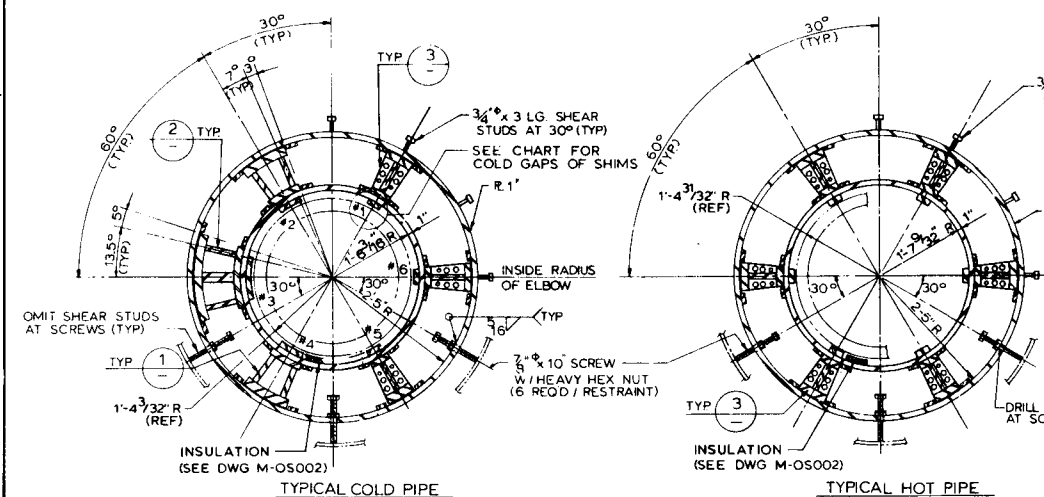


SECTION A
SCALE 1"=1'-0"

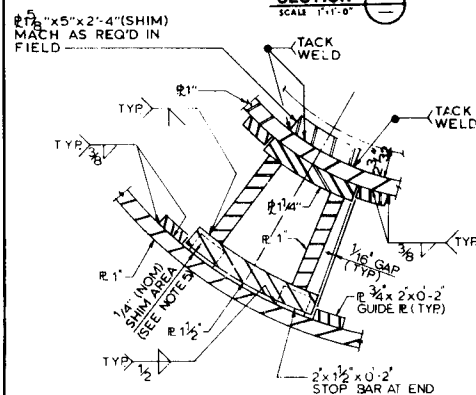



DETAIL 1
SCALE 3/16"=0"

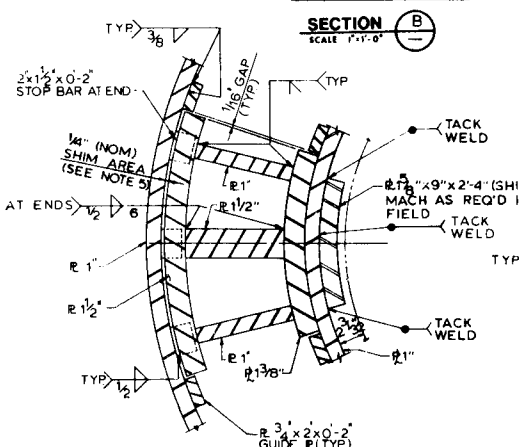

SECTION B
SCALE 1" = 1'-0"

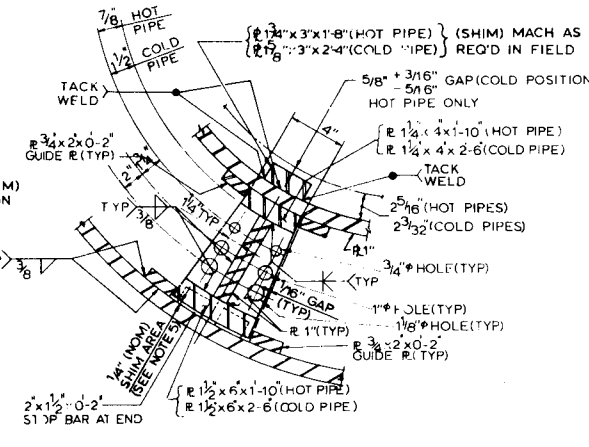

DETAIL 3
SCALE 3"=1'-0"

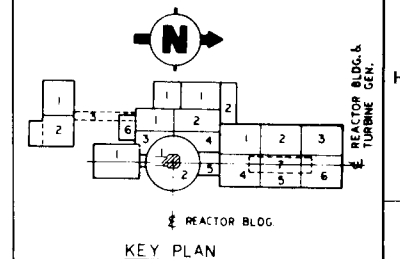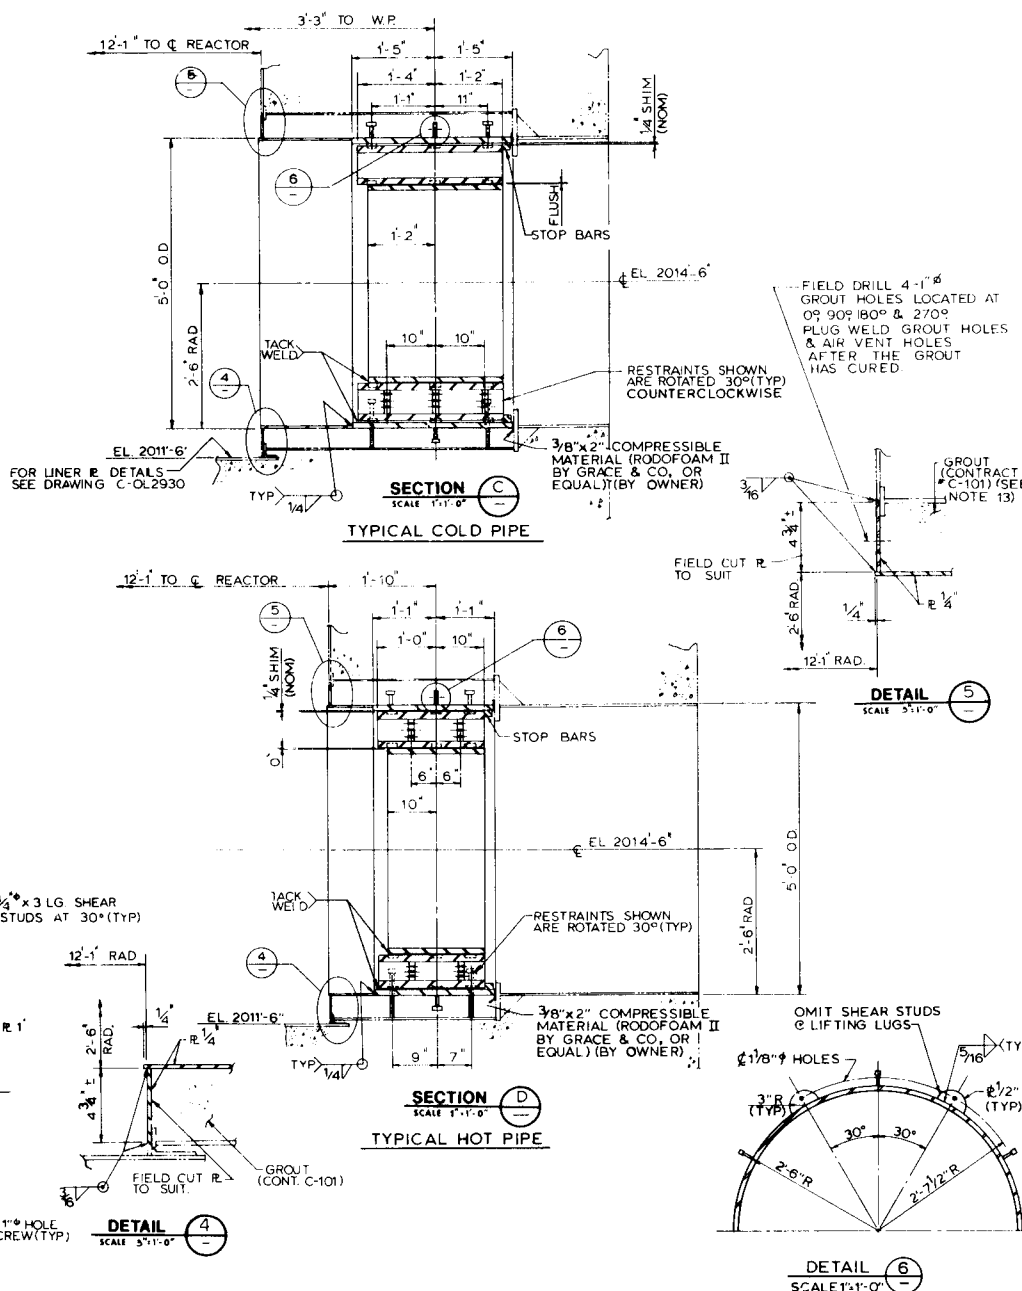

NOTES

1. ALL DIMENSIONS GIVEN ARE IN COLD POSITION UNLESS NOTED OTHERWISE.
2. MATERIAL FOR THE 1" THICK COLLAR RING SHALL BE ASTM A516 GR 70.
3. THE 1" THICK COLLAR RING AND BUILT UP FILLER MEMBERS SHALL BE SET WELD HEAT TREATED.
4. SURFACES WHICH RECEIVE SHIMS AND/OR BEARING SHALL BE MACHINED TO THE DESIGN CONTOUR.
5. SHIM AREA AS INDICATED ON THE DRAWING SHALL BE PROVIDED WITH NOT LESS THAN 50% OF THE BEARING AREA.
6. SHIM PLATES SHALL BE SHOP TACK WELDED TO THE BUILT UP FILLER MEMBER AFTER PROPERLY ALIGNED.
7. THE RADIAL LOCATION (R) INSIDE RADIUS AT ANY POINT OF THE 1" THICK COLLAR RING SHALL NOT VARY FROM THE DESIGN RADIUS BY MORE THAN 1/8".
8. RESTRAINT ASSEMBLIES SHALL BE SHOP PRE ASSEMBLED TO INSURE PROPER ALIGNMENT AND DELIVER TO SITE AS ONE UNIT FOR EACH RESTRAINT.
9. THE MAXIMUM ALLOWABLE GAP AT THE SHIM OR BEARING SURFACES SHALL BE 1/16" SHIMS MAY BE ADDED BETWEEN THE OUTSIDE FACE OF THE INNER RING AND THE INSIDE FACE OF THE SPOKE TO MEET THIS REQUIREMENT.
10. THE FIELD MACHINED SHIMS SHALL ACCOUNT FOR THE AS BUILT DIMENSIONS OF THE RESTRAINT RING, THE INSIDE FACE OF THE INNER RING, AND THE OUTSIDE DIAMETER OF THE HOT AND COLD PIPES AT EACH LOCATION.
11. DELETED
12. THE OUTER RING SHALL BE PRESSURE AGAINST THE COMPRESSIBLE MATERIAL AS MUCH AS POSSIBLE TO PREVENT LEAKAGE OF GROUT.
13. DELETED
14. THE AS-BUILT COLD GAP AT SHIMS MUST BE:
 - A) SMALLER THAN (OR EQUAL TO) THE AS-BUILT COLD GAP AT SHIM #2.
 - B) SMALLER THAN (OR EQUAL TO) THE AS-BUILT COLD GAP AT SHIM #1.

REFERENCE DRAWINGS

C-OL2930	REACTOR BUILDING LINER PLATE REACTOR CAVITY WALL
----------	---

MATERIAL RESPONSIBILITY

1. STEEL TO BE FURNISHED UNDER SPEC
10466-C202

Rev. OL-0
6 / 86

CALLAWAY PLANT

FIGURE 5.4-21
HOT AND COLD LEG
LATERAL RESTRAINTS
(C-03BB53(Q)-4)