

SYSTEM DESIGNATOR

|                                  |   | NO. OF SHEETS |   |
|----------------------------------|---|---------------|---|
| MAIN POWER CYCLE AND AUXILIARIES |   | P & ID        |   |
| AB                               | MAIN STEAM                                  |               | 7 |
| AC                               | MAIN TURBINE                                |               | 4 |
| AD                               | CONDENSATE                                  |               | 8 |
| AE                               | FEEDWATER                                   |               | 2 |
| AF                               | FEEDWATER HEATER EXTRACTION, DRAINS & VENTS |               | 4 |
| AK                               | CONDENSATE DEMINERALIZER                    |               | 4 |
| AL                               | AUXILIARY FEEDWATER                         |               | 1 |
| AN                               | DEMINERALIZED WATER STORAGE & TRANSFER      |               | 1 |
| AP                               | CONDENSATE STORAGE AND TRANSFER             |               | 1 |
| AQ                               | CONDENSATE AND FEEDWATER CHEMICAL ADDITION  |               | 2 |

|  |                                 | NO. OF SHEETS |   |
|--|---------------------------------|---------------|---|
| REACTOR AND STEAM GENERATOR CONTROLS AND AUXILIARIES |                                 | P & ID        |   |
| BB   | REACTOR COOLANT                 |               | 4 |
| BG   | CHEMICAL AND VOLUME CONTROL     |               | 5 |
| BL   | REACTOR MAKEUP WATER            |               | 1 |
| BM   | STEAM GENERATOR BLOWDOWN        |               | 5 |
| BN   | BORATED REFUELING WATER STORAGE |               | 1 |

|  |   | NO. OF SHEETS |   |
|--|---|---------------|---|
| TURBINE GENERATOR CONTROLS AND AUXILIARIES |   | P & ID        |   |
| CA   | STEAM SEAL                                |               | 1 |
| CB   | MAIN TURBINE LUBE OIL                     |               | 1 |
| CC   | GENERATOR HYDROGEN AND CO <sub>2</sub>    |               | 1 |
| CD   | GENERATOR SEAL OIL                        |               | 1 |
| CE   | STATOR COOLING WATER                      |               | 1 |
| CF   | LUBE OIL STORAGE, TRANSFER & PURIFICATION |               | 2 |
| CG   | CONDENSER AIR REMOVAL                     |               | 1 |
| CH   | MAIN TURBINE CONTROL OIL                  |               | 1 |

|                   |                   | NO. OF SHEETS |   |
|-------------------|-------------------|---------------|---|
| CIRCULATING WATER |                   | P & ID        |   |
| DA                | CIRCULATING WATER |               | 2 |

|  |  | NO. OF SHEETS |   |
|--|--|---------------|---|
| EQUIPMENT & EMERGENCY CORE COOLING WATER |  | P & ID        |   |
| EA                                       | SERVICE WATER  |               | 2 |
| EB                                       | CLOSED COOLING WATER   |               | 1 |
| EC                                       | FUEL POOL COOLING & CLEANUP                                  |               | 2 |
| EF                                       | ESSENTIAL SERVICE WATER (P & ID'S-2 M-22 DWGS., 1 M-U2 DWG.) |               | 3 |
| EG                                       | COMPONENT COOLING WATER                                      |               | 3 |
| EJ                                       | RESIDUAL HEAT REMOVAL  |               | 1 |
| EM                                       | HIGH PRESSURE COOLANT INJECTION                              |               | 2 |
| EN                                       | CONTAINMENT SPRAY  |               | 1 |
| EP                                       | ACCUMULATOR SAFETY INJECTION                                 |               | 1 |

|                 |  | NO. OF SHEETS |   |
|-----------------|--|---------------|---|
| AUXILIARY STEAM |  | P & ID        |   |
| FA              | AUXILIARY STEAM GENERATOR                |               | 1 |
| FB              | AUXILIARY STEAM                          |               | 2 |
| FC              | AUXILIARY TURBINES                       |               | 3 |
| FE              | AUXILIARY STEAM CHEMICAL ADDITION SYSTEM |               | 1 |

|      |   | NO. OF SHEETS |   |
|------|---|---------------|---|
| HVAC |   | P & ID        |   |
| GA   | PLANT HEATING   |               | 2 |
| GB   | CENTRAL CHILLED WATER   |               | 1 |
| GD   | ESSENTIAL SERVICE WATER PUMP HOUSE BUILDING HVAC (P & ID-1 M-U2 DWG.) |               | 1 |
| GE   | TURBINE BUILDING HVAC   |               | 5 |
| GG   | FUEL BUILDING HVAC  |               | 2 |
| GH   | RADWASTE BUILDING HVAC  |               | 2 |
| GK   | CONTROL BUILDING HVAC   |               | 4 |
| GL   | AUXILIARY BUILDING HVAC   |               | 3 |
| GM   | DIESEL GENERATORS BUILDING HVAC                                       |               | 1 |
| GN   | CONTAINMENT COOLING   |               | 2 |
| GS   | CONTAINMENT HYDROGEN CONTROL  |               | 1 |
| GR   | CONTAINMENT ATMOSPHERIC CONTROL                                       |               | 1 |
| GT   | CONTAINMENT PURGE HVAC  |               | 1 |
| GF   | MISCELLANEOUS BUILDING HVAC   |               | 2 |
| GP   | CONTAINMENT INTEGRATED LEAK RATE TEST                                 |               | 1 |

|          |                               | NO. OF SHEETS |   |
|----------|-------------------------------|---------------|---|
| RADWASTE |                               | P & ID        |   |
| HA       | GASEOUS RADWASTE              |               | 3 |
| HB       | LIQUID RADWASTE               |               | 5 |
| HC       | SOLID RADWASTE                |               | 4 |
| HD       | DECONTAMINATION               |               | 1 |
| HE       | BORON RECYCLE                 |               | 3 |
| HF       | SECONDARY LIQUID WASTE SYSTEM |               | 5 |

|      |                    | NO. OF SHEETS |   |
|------|--------------------|---------------|---|
| FUEL |                    | P & ID        |   |
| JE   | EMERGENCY FUEL OIL |               | 1 |

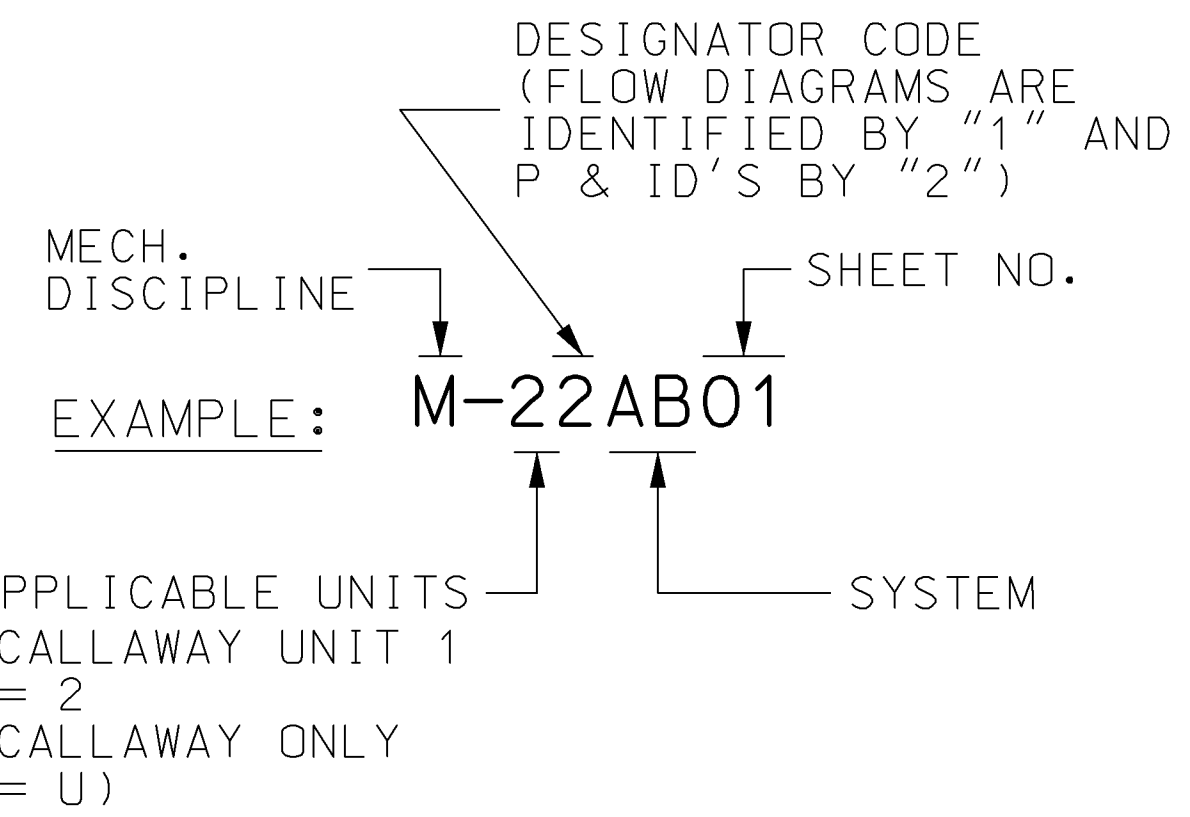
|          |   | NO. OF SHEETS |      |
|----------|---|---------------|------|
| SERVICES |   | P & ID        |      |
| KA       | COMPRESSED AIR  |               | 7    |
| KB       | BREATHING AIR SYSTEM  |               | 3    |
| KC       | FIRE PROTECTION   |               | 7    |
| KD       | DOMESTIC WATER  |               | 2    |
| KE       | FUEL HANDLING, FUEL STORAGE & REACTOR VESSEL SERVICE                                |               | NONE |
| KH       | SERVICE GAS (CO <sub>2</sub> , N <sub>2</sub> , H <sub>2</sub> , & O <sub>2</sub> ) |               | 2    |
| KJ       | STANDBY DIESEL ENGINE   |               | 6    |
| KS       | BULK CHEMICAL STORAGE (P & ID-1 M-U2 DWG.)  |               | 1    |

|        |                              | NO. OF SHEETS |    |
|--------|------------------------------|---------------|----|
| DRAINS |                              | P & ID        |    |
| LA     | SANITARY DRAINS              |               | 2  |
| LD     | CHEMICAL AND DETERGENT WASTE |               | 1  |
| LE     | OILY WASTE                   |               | 4  |
| LF     | FLOOR & EQUIPMENT DRAINS     |               | 10 |

|                  |                               | NO. OF SHEETS |   |
|------------------|-------------------------------|---------------|---|
| SAMPLING SYSTEMS |                               | P & ID        |   |
| RM               | PROCESS SAMPLING AND ANALYSIS |               | 3 |
| SJ               | NUCLEAR SAMPLING              |               | 4 |

NOTES:

1. THIS DRAWING PROVIDES THE SYSTEM DESIGNATORS USED IN THE P & ID AND FLOW DIAGRAM DRAWING NUMBERS. DRAWINGS M-220102, M-220103, AND M-220104 PROVIDE THE APPLICABLE SYMBOLS AND LEGEND.
2. DRAWING NUMBERING SYSTEM IS AS FOLLOWS:



3. SEE DRAWING 8600-X-89846 FOR S & P P & ID INDEX.

AS-BUILT

| DRAWING INDEX FOR SYSTEM FLOW AND PIPING AND INSTRUMENT DIAGRAMS |     | CALLAWAY PLANT |          | GLASS    |        |
|--|-----|----------------|----------|----------|--------|
| DRAWN  | N/A | (DATE)         |          |          |        |
| CHKD.  | N/A | (DATE)         |          |          |        |
| SURV.  | N/A | (DATE)         |          |          |        |
| APPR.  | N/A | (DATE)         | LOCATION |          |        |
| UNION ELECTRIC COMPANY ST. LOUIS, MO                             |     |                |          | M-220101 | REV. 7 |













M-26001

**FSAR Figure 1.2-1 is withheld per RIS 2015-17**

|       |           |   |          |       |             |               |      |
|-------|-----------|---|----------|-------|-------------|---------------|------|
|       | 062707    | INCRP. MP 06-0005.  | MAL      | TJC   | N/A         | MWH           |      |
| 6     | 042005    | INCRP. RFR 22941A   | TJC      | MAL   | N/A         | TWS           |      |
| 4     | 071301    | INCRP. MP 99-1038 FCN-16  | SKC      | JHK   | N/A         | AMR           |      |
| 4     | 121796    | INCRP. CMP 89-1045 AND DEC-1384                                       | RLW      | DLBr  | N/A         | AMR           |      |
| 4     | 3191      | INCRP. RMP 94-2006A.  | MAL      | —     | —           | —             |      |
| 4     | 1878      | INCRP DEC-587   | SKC      | —     | —           | —             |      |
| 1     | 878       | INCRP. CMP. 85-0363   | JAN      | —     | N/A         | N/A           |      |
| 4     | 7380      | REFLECTS TURNAROUND TO U.E. SUPERSEDES M-06001 R-1 F INCRP RFR 22941A | 4LD      | —     | N/A         | N/A           |      |
| NO.   | DATE      | REVISIONS   | BY       | CHK   | DES<br>SUPV | PROJ<br>ENGR  | APPR |
| SCALE | 1"=50'-0" | DATE 2-7-84   | DESIGNED | DRAWN | CB          | CHIEF<br>ENGR |      |


# BECHTEL

GAITHERSBURG, MARYLAND

## SNUPPS

### PENINSULAR PLANT ARRANGMENT STANDARD POWER SYSTEMS & STRUCTURE INTERFACE

FSAR FIGURE 1.2-1

|   |                     |     |
|---|---------------------|-----|
|  | UTILITY DRAWING NO. | REV |
|   | AS-BUILT            |     |
| JOB NO  | BECHTEL DRAWING NO  | REV |
| 10466   | M-2G001             | 7   |

DRAWING QUALITY TO UNITS

|   |   |   |   |   |   |   |   |   |    |    |    |    |    |    |    |    |    |    |    |    |    |    |    |    |    |    |    |    |    |
|---|---|---|---|---|---|---|---|---|----|----|----|----|----|----|----|----|----|----|----|----|----|----|----|----|----|----|----|----|----|
| 1 | 2 | 3 | 4 | 5 | 6 | 7 | 8 | 9 | 10 | 11 | 12 | 13 | 14 | 15 | 16 | 17 | 18 | 19 | 20 | 21 | 22 | 23 | 24 | 25 | 26 | 27 | 28 | 29 | 30 |
|---|---|---|---|---|---|---|---|---|----|----|----|----|----|----|----|----|----|----|----|----|----|----|----|----|----|----|----|----|----|

1 34x44 "E" SIZE

**FSAR Figure 1.2-1 is withheld per RIS 2015-17**



FSAR Figure 1.2-2 is withheld per RIS 2015-17

H  
G  
F  
E  
D  
C  
B  
A

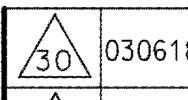
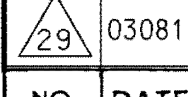

|                             |                            |           |       |      |       |
|-----------------------------|----------------------------|-----------|-------|------|-------|
| 110904                      | INCORP. RFR 22941A.        | MAL       | RLW   | N/A  | TWS   |
| 1031004                     | INCORPORATE RFR 22733A.    | BMM       | RLW   | N/A  | TWS   |
| 1022699                     | INCORP. 1000 RFR 2009A AND | EWM       | RAM   | N/A  | JHC   |
| 1022699                     | INCORP. 1000 RFR 2009A AND | JHK       | MAL   | N/A  | JHC   |
| 1022699                     | INCORP. 1000 RFR 2009A AND | K         | N/A   | N/A  | JHC   |
| NO                          | DATE                       | REVISIONS | BY    | CHK  | APP   |
| SCALE 1/8"=1'-0"            | DATE 10-25-75              | DESIGNED  | DRAWN | ED.S | CHIEF |
| BECHTEL                     |                            |           |       |      |       |
| GAITHERSBURG, MARYLAND      |                            |           |       |      |       |
| SNUPPS                      |                            |           |       |      |       |
| EQUIPMENT LOCATION          |                            |           |       |      |       |
| RADWASTE BUILDING           |                            |           |       |      |       |
| PLAN BASEMENT EL. 1976'-0"  |                            |           |       |      |       |
| FSAR FIGURE 1.2-2           |                            |           |       |      |       |
| AS-BUILT                    |                            |           |       |      |       |
| UTILITY DRAWING NO.         |                            |           |       |      |       |
| REV                         |                            |           |       |      |       |
| JOB NO.                     |                            |           |       |      |       |
| BECHTEL DRAWING NO.         |                            |           |       |      |       |
| REV                         |                            |           |       |      |       |
| 10466                       |                            |           |       |      |       |
| M-2G010                     |                            |           |       |      |       |
| 22                          |                            |           |       |      |       |
| DRAWING APPLICABLE TO UNITS |                            |           |       |      |       |
| 1 3x44 'E' SIZE             |                            |           |       |      |       |

FSAR Figure 1.2-2 is withheld per RIS 2015-17



FSAR Figure 1.2-3 is withheld per RIS 2015-17

H  
G  
F  
E  
D  
C  
B  
A

|   |        |                        |                     |           |                     |
|---|--------|------------------------|---------------------|-----------|---------------------|
|  | 030618 | INCORP. RFR 160558.    | MAL                 | RLW       | DME                 |
|  | 030811 | INCORPORATE MP 09-0042 | EWM                 | RLW       | SKC                 |
| NO  | DATE   | REVISIONS              | BY                  | CHK       | APPN                |
| SCALE 1"=1'-0"  |        | DATE 10-20-75          | DESIGNED            | DRAWNED.S | CHIEF ENGR          |
| BECHTEL<br>GAITHERSBURG, MARYLAND   |        |                        |                     |           |                     |
| SNUPPS  |        |                        |                     |           |                     |
| EQUIPMENT LOCATION<br>RADWASTE BUILDING<br>EL. 2000'-0"<br>FSAR FIGURE 1.2-3          |        |                        |                     |           |                     |
| AS-BUILT  |        |                        | UTILITY DRAWING NO. |           | REV                 |
|   |        |                        |                     |           |                     |
|  |        |                        | JOB NO.             |           | BECHTEL DRAWING NO. |
|   |        |                        | 10466               |           | M-2G011             |
| DRAWING APPLICABLE TO UNITS   |        |                        | 2                   |           | 34x44               |
|   |        |                        | 1                   |           | 30                  |

FSAR Figure 1.2-3 is withheld per RIS 2015-17



FSAR Figure 1.2-4 is withheld per RIS 2015-17

FSAR Figure 1.2-4 is withheld per RIS 2015-17

|  |  |  |                     |     |          |         |            |      |
|--|--|--|---------------------|-----|----------|---------|------------|------|
| 8  | 042005   | INCORP. RFR 22941A                         | TJC                 | MAL | N/A      | TWS     |            |      |
| 7  | 041698   | INCORP. RFR 16086D.                        | MAL                 | EMW | N/A      | JHK     |            |      |
| 6  | 112897   | INCORPORATES MP 93-2031                    | RAM                 | HLP | N/A      | AMR     |            |      |
| 5  | 072897   | ISSUE PER EDP-ZZ-04024                     | RAM                 | JHK | N/A      | AMR     |            |      |
| 4  | 060297   | INCORP. RFR-16406A.<br>INCORP. RFR-17916B. | JHK                 | EMW | N/A      | AMR     |            |      |
| 3  | 051596   | INCORP. RFR-13399J.                        | JHK                 | EMW | N/A      | AMR     |            |      |
| 2  | 7-1-19<br>RFR-16428A.  | K  | EMW                 | N/A | AMR      |         |            |      |
| 1  | 7-1-19<br>RFR-16086A.  | K  | EMW                 | N/A | AMR      |         |            |      |
| 0  | INITIAL ISSUE<br>SUPERSEDES M-09012<br>REV 6 REFLECTS TUE NOV 93<br>US UC RFR-13399A | MAL  | EMW                 | N/A | AMR      |         |            |      |
| NO. DATE REVISIONS   |  |  | BY                  | CHK | DES      | ENGR    | PROJ       | APPR |
| SCALE 1/8"=1'-0"   |  |  | DATE 10-23-75       |     | DESIGNED |         | DRAWN E.S. |      |
| BECHTEL<br>GAITHERSBURG, MARYLAND                                    |  |  |                     |     |          |         |            |      |
| EQUIPMENT LOCATION<br>RADWASTE BUILDING<br>PARTIAL PLAN EL. 2022'-0" |  |  |                     |     |          |         |            |      |
| AS-BUILT   |  |  |                     |     |          |         |            |      |
| UTILITY DRAWING NO.  |  |  | REV                 |     |          |         |            |      |
| JOB NO.  |  |  | BECHTEL DRAWING NO. |     |          | REV     |            |      |
| 10466  |  |  | M-2G012             |     |          | 8       |            |      |
| DRAWING APPLICABLE TO UNITS  |  |  | 2                   |     |          | 34x44   |            |      |
|  |  |  | 1                   |     |          | E" SIZE |            |      |



FSAR Figure 1.2-5 is withheld per RIS 2015-17

M-2G013

H

G

F

E

D

C


B

A

|   |        |                     |                     |             |             |              |      |
|---|--------|---------------------|---------------------|-------------|-------------|--------------|------|
| 19  | 060408 | INCORP. MP 07-0091. | MAL                 | TJC         | N/A         | LMR          |      |
| 18  | 110904 | INCORP. RFR-22941A. | MAL                 | RLW         | N/A         | TWS          |      |
| 17  | 123002 | INCORP. RFR-22041A  | DJB                 | SKC         | N/A         | TWS          |      |
| NO.   | DATE   | REVISIONS           | BY                  | CHK<br>SUPV | DES<br>ENGR | PROJ<br>ENGR | APPR |
| SCALE 1/8"=1'-0"  |        | DATE 10-16-75       |                     | DESIGNED    |             | DRAWN        | GLP  |
| BECHTEL   |        |                     |                     |             |             |              |      |
| GAITHERSBURG, MARYLAND  |        |                     |                     |             |             |              |      |
| EQUIPMENT LOCATIONS<br>RADWASTE BUILDING<br>EL. 2031'-6" & ROOF PLAN<br>FSAR FIGURE 1.2-5 |        |                     |                     |             |             |              |      |
| AS-BUILT  |        |                     | UTILITY DRAWING NO. |             |             | REV          |      |
|   |        |                     | BECHTEL DRAWING NO. |             |             | REV          |      |
| 10466   |        |                     | M-2G013             |             |             | 19           |      |
| DRAWING APPLICABLE TO UNITS   |        |                     | 2                   |             |             |              |      |

FSAR Figure 1.2-5 is withheld per RIS 2015-17

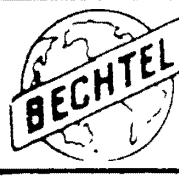
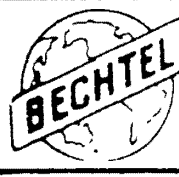
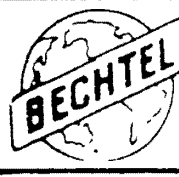
**FSAR Figure 1.2-6 is withheld per RIS 2015-17**

|   |            |   |          |                     |             |                   |              |              |
|---|------------|---|----------|---------------------|-------------|-------------------|--------------|--------------|
| 4   | 060408     | INCORP. MP 07-0091.   | MAL      | TJC                 | N/A         | N/A               | LMR          |              |
| 3   | 042005     | INCORPORATES RFR 22341A   | TJC      | MAL                 | N/A         | N/A               | TWS          |              |
| 2   | 112897     | INCORPORATES MP 93-2031   | RAM      | HLP                 | N/A         | N/A               | AMR          |              |
| 1   | 072897     | ISSUE PER EDP-ZZ-04024  | RAM      | JHK                 | N/A         | N/A               | AMR          |              |
| 0   | 011497     | INITIAL ISSUE. SUPERCEDES<br>DWG. M-06014 REV. 7. RE-<br>FLECTS TURNOVER TO UE. | JHK      | EMW                 | N/A         | N/A               | AMR          |              |
| NO.   | DATE       | REVISIONS   | BY       | CHK                 | DES<br>SURV | ENGR<br>ENGR      | PROJ<br>ENGR | APPR<br>ENGR |
| SCALE   | 1/8"=1'-0" | DATE 10-21-75   | DESIGNED | DRAWN               | GLP         | CHIEF<br>ENGINEER |              |              |
| BECHTEL<br>GAITHERSBURG, MARYLAND   |            |   |          |                     |             |                   |              |              |
| SNUPPS  |            |   |          |                     |             |                   |              |              |
| EQUIPMENT LOCATION<br>RADWASTE BUILDING<br>SECTIONS A & B<br>FSAR FIGURE 1.2-6        |            |   |          |                     |             |                   |              |              |
| AS-BUILT  |            |   |          | UTILITY DRAWING NO. |             |                   |              | REV          |
|  |            |   |          | JOB NO.             |             |                   |              | REV          |
|   |            |   |          | BECHTEL DRAWING NO. |             |                   |              | REV          |
| 10466   |            |   |          | M-2G014             |             |                   |              | 4            |
| DRAWING APPLICABLE TO UNITS   |            |   |          | 2                   | X           | X                 | X            | X            |



**FSAR Figure 1.2-7 is withheld per RIS 2015-17**

**FSAR Figure 1.2-7 is withheld per RIS 2015-17**

|   |          |                           |                    |           |                  |
|---|----------|---------------------------|--------------------|-----------|------------------|
| 8   | 030861   | [INCORP. MP 09-0042]      | EWM                | RLW       | TWS              |
| A   | 060908   | [INCORP. MP 07-0091.]     | MAL                | TJC       | TWS              |
|   | 042005   | [INCORP. RFR 22941A]      | TJC                | MAL       | TWS              |
| 5   | 050102   | [INCORP. MP 99-2003A]     | RAM                | DJB       | AMR              |
| 4   | 070698   | [INCORP. MP 97-2005]      | RAM                | EWB       | AMR              |
| 3   | 112891   | [INCORP. MP 93-2031]      | RAM                | HLP       | AMR              |
| 2   | 072891   | [ISSUE PER EDP--ZZ-0402A] | RAM                | JHK       | AMR              |
| 1   | 123198   | [INCORP. CMP 89-1045]     | RLW                | DLB*      | AMR              |
| INITIAL ISSUE, REFLECTS<br>TURNOVER TO U.E. SUPERSEDES<br>M-00015 REV. 6.             |          |                           | JGH                | PLL       | TJG              |
| 0   | 0917     | [INCORP. CMP 84-03-016.   | BY                 | CHK       | APPR             |
| NO  | DATE     | REVISIONS                 |                    |           |                  |
| SCALE:  | AS-BUILT | DATE 10-24-75             | DESIGNED           | DRAWN G.N | CHECKED<br>EAGER |
| BECHTEL   |          |                           |                    |           |                  |
| GAITHERSBURG, MARYLAND  |          |                           |                    |           |                  |
| SNUPPS  |          |                           |                    |           |                  |
| EQUIPMENT LOCATION<br>RADWASTE BUILDING<br>SECTIONS C & E<br>FSAR FIGURE 1.2-7        |          |                           |                    |           |                  |
| AS-BUILT  |          |                           | UTILITY DRAWING NO |           | REV              |
|   |          |                           |                    |           |                  |
|  |          |                           | JOB NO             |           | REV              |
|   |          |                           |                    |           |                  |
|  |          |                           | BECHTEL DRAWING NO |           | REV              |
|   |          |                           |                    |           |                  |
|  |          |                           | M-2G015            |           | 8                |
|   |          |                           |                    |           |                  |
| DRAWING APPLICABLE TO UNITS   |          |                           |                    |           |                  |
| [X] [ ] [Z] [X] [X] [X] [X] [X] [X] [X]   |          |                           |                    |           |                  |

FSAR Figure 1.2-8 is withheld per RIS 2015-17

FSAR Figure 1.2-8 is withheld per RIS 2015-17

3

042005

INCORP. RFR 22941A

TJC

MAL

N/A

TWS

2

030805

INCORPORATE MP 01-1001B

RLW

MAL

N/A

TWS

1

121796

INCORP. CMP 89-1045B

RLW

DLB

N/A

AMR

12

24

INITIAL ISSUE. SUPERSEDES  
W-06016, R. 6. REFLECTS  
TURNOVER TO U.S. ISSUE  
32 PER EDP-22-04024.

MAL

ERM

N/A

TJM

0

NO

DATE

REVISIONS

BY

CHK

DES

ENG

PROJ

APPR

SCALE 1/8"=1'-0"

DATE 10-27-75

DESIGNED

DRAWN SBF

CHKD

ENGR

BECHTEL

GAITHERSBURG, MARYLAND

SNUPPS

3

EQUIPMENT LOCATION  
RADWASTE BUILDING  
SECTION D & F  
FSAR FIGURE 1.2-8

AS-BUILT

UTILITY DRAWING NO

REV

BECHTEL

JOB NO

BECHTEL DRAWING NO

REV

10466

M-2G016

3

DRAWING APPLICABLE TO UNITS

2

1

H

G

F

E

D

C

B

A



FSAR Figure 1.2-9 is withheld per RIS 2015-17

FSAR Figure 1.2-9 is withheld per RIS 2015-17

| |
|---|
| 1 | 2 | 3 | 1479 |
|---|

FSAR Figure 1.2-10 is withheld per RIS 2015-17

H

G

F

E

D

C

B

A

|                 |         |  |              |           |            |      |
|-----------------|---------|--|--------------|-----------|------------|------|
| 13              | 012918  | INCORP. RFR 160459.  | MAL          | TJC       | N/A        | DME  |
| 12              | 071416  | INCORP. RFR 201506614.   | TJC          | MAL       | N/A        | DME  |
| 11              | 061313  | INCORP. MP 12-0002.<br>FCN-01.   | MAL          | RLW       | N/A        | LMP  |
| 10              | 110904  | INCORP. RFR-22941A.  | MAL          | RLW       | N/A        | TWS  |
| 9               | 091804  | INCORP. MP 02-1018<br>FCN-1B.  | JHK          | MAL       | N/A        | TWS  |
| 8               | 032002  | INCORP. RFR-21562A.  | JHK          | MAL       | N/A        | AMR  |
| 7               | 082898  | INCORP. RFR-18812A.  | RLW          | DJB       | N/A        | AMR  |
| 6               | 080196  | INCORP. RFR-16916B.  | JHK          | EWB       | N/A        | AMR  |
| 5               | 042896  | INCORP. RFR-13528G.  | JHK          | EWB       | N/A        | AMR  |
| 4               | 1/1/15  | INCORP. RFR-13528G.  | SER          | DA        | —          | —    |
| 3               | 1/1/15  | INCORP. RFR-13528G.  | K            | SW        | N/A        | —    |
| 2               | 8/1/14  | INCORP. RFE-14770A.  | MAL          | DA        | —          | —    |
| 1               | 8/1/14  | INCORP. RFR-13528  | MAL          | DA        | —          | —    |
| 0               | 1/12/11 | INITIAL ISSUE SUPERCEDES<br>DWG. M-06021 REV. 5<br>REFLECTS TURNOVER TO<br>U.E. INCORP. RFR-09335B | SER          | SW        | —          | —    |
| NO. DATE        |         | REVISIONS  | BY           | CHK       | DES        | PROJ |
| SCALE: 1"=1'-0" |         | DATE 3-4-74  | DESIGNED DWM | DRAWN DJS | CHIEF ENGR | APPR |

|   |  |                     |
|---|--|---------------------|
| BECHTEL<br>GAITHERSBURG, MARYLAND   |  |                     |
| SNUPPS  |  |                     |
| EQUIPMENT LOCATIONS<br>AUXILIARY BUILDING<br>PARTIAL PLAN EL. 1988'-0" & EL. 2013'-6"<br>FSAR FIGURE 1.2-10 |  |                     |
| AS-BUILT  |  | UTILITY DRAWING NO. |
| JOB NO.   |  | REV                 |
| 10466   |  | 13                  |
| BECHTEL DRAWING NO.   |  | REV                 |
| M-2G021   |  | 13                  |
| DRAWING APPLICABLE TO UNITS   |  |                     |
| 2 1 34x44 1/2" SIZE   |  |                     |

FSAR Figure 1.2-10 is withheld per RIS 2015-17

8

7

6

5

4

3

2

1



FSAR Figure 1.2-11 withheld per RIS 2015-17

FSAR Figure 1.2-11 withheld per RIS 2015-17

|   |   |                      |      |      |
|---|---|----------------------|------|------|
| D0891   | ENCORP. RFP 16057-91, REACTOR LOCATION COLUMN IN TABLE REFORMATTED FOR CONSISTENCY AND CLARITY. | SUN                  | ASB  | CMS  |
| D0891   | ENCORP. RFP 16055-91.   | MAY                  | PLN  | CMS  |
| D0891   | ENCORP. RFP 201604-93.  | MAY                  | PLN  | CMS  |
| DATE  | DATE  | DATE                 | DATE | DATE |
| SCALE   | DATE  | DATE                 | DATE | DATE |
| <b>BCHT</b>   |   |                      |      |      |
| GATHERSBURG, MARYLAND   |   |                      |      |      |
| EQUIPMENT LOCATIONS<br>REACTOR AND AUXILIARY BUILDINGS<br>PLAN GROUND FLOOR EL. 2'000 - "0" |   |                      |      |      |
| <b>AS-BUILT</b>   |   | UTILITY DRAWING NO.  |      | REV  |
| JOB NO.   |   | AS-BUILT DRAWING NO. |      | REV  |
|   |   | M-26022              |      | 70   |
| DRAWING APPROVED BY DATE  |   |                      |      |      |

FSAR Figure 1.2-12 is withheld per RIS 2015-17

FSAR Figure 1.2-12 is withheld per RIS 2015-17

|   |                                      |                       |                      |
|---|--------------------------------------|-----------------------|----------------------|
| 0151  | INCORP. MP 17-0004, REV. 0.          | SLK                   | AWH/ONE              |
| 0211  | INCORP. MP 16004, REV. 0 & REV. 1.   | SLK                   | AWH/ONE              |
| 0211  | LOCATION COLUMN IN TABLE REFORMATTED | SLK                   | AWH/ONE              |
| 0724  | INCORP. MP 10-000 FEN-01             | FLW                   | TJC/SAC              |
| 0727  | INCORP. MP 20201854                  | NAL                   | HLW/ONE              |
| NO.   | DATE                                 | REVISIONS             | BY                   |
| SCALE: 1"=10'   | DATE: 11-19-2018                     | DESIGNED BY: CHEN/PAW | CHECKED BY: CHEN/PAW |
| <b>BECHTEL</b><br>BETHESDA, MARYLAND  |                                      |                       |                      |
| <b>SNUPPS</b>   |                                      |                       |                      |
| EQUIPMENT LOCATIONS<br>REACTOR AND AUXILIARY BUILDINGS<br>PLAN: EL-2026'-0"<br>FSAR FIGURE 1.2-12 |                                      |                       |                      |
| <b>AS-BUILT</b>   |                                      | UTILITY DRAWING NO.   | REV.                 |
| JOB NO.   |                                      | BECHTEL DRAWING NO.   | REV.                 |
| M-26023   |                                      | 53                    |                      |
| DRAWING APPLICABLE TO UNIT: 2   |                                      |                       |                      |
| 1 3444 1" SIZE  |                                      |                       |                      |



FSAR Figure 1.2-13 is withheld per RIS 2015-17

FSAR Figure 1.2-13 is withheld per RIS 2015-17

|   |  |                     |      |       |
|---|--|---------------------|------|-------|
| Q2119   | INCORP. MP 17-0006, REV. G.                                      | SJK                 | AHR  | DME   |
| Q4119   | INCORP. CH 20190215  | EDH                 | AHR  | DME   |
| Q2119   | INCORP. RFR 160587, REV. 1                                       |                     |      |       |
| Q2119   | LOCATION COLUMN IN TABLE REFORMATTED FOR CONSISTENCY AND CLARITY | SJK                 | AHR  | DME   |
| Q30618  | INCORP. RFR 160558   | MGL                 | RLW  | DME   |
| Q30811  | INCORPORATE MP 12-0007   | JJC                 | MAL  | DMS   |
| REV. DATE   | REVISIONS  | DMM                 | CHK  | DAPPV |
| SCALE 1/8"=1'-0" DATE 12-1-78 (DESIGNED BY M. G. HANN, U.S. NRC)  |  |                     |      |       |
| <b>BECHTEL</b><br>BATHESBURG, MARYLAND  |  |                     |      |       |
| EQUIPMENT LOCATION<br>REACTOR AND AUXILIARY BUILDINGS<br>PLAN OPERATING FLOOR EL. 2047'-6"<br>FSAR FIGURE 1.2-13  |  |                     |      |       |
| <b>AS-BUILT</b>   |  | UTILITY DRAWING NO. | REV. |       |
| JOB NO.   |  | BECHTEL DRAWING NO. | REV. |       |
|   |  | M-2G024             | 68   |       |
| DRAWING APPLICABLE TO VIEWS 1 2 3 100 |  |                     |      |       |

FSAR Figure 1.2-14 is withheld per RIS 2015-17

H

G

F

E

D

C

B

A


|     |        |                                       |       |      |      |
|-----|--------|---------------------------------------|-------|------|------|
| 34  | 072315 | INCORPORATE MP 10-0001 FCN-01.        | RLW   | TJC  | DME  |
| 33  | 110410 | INCORP. MP 07-0092 FCN-01.            | TJC   | MAL  | SKC  |
| 32  | 020810 | INCORP. MP 07-0092.                   | MAL   | TJC  | TWS  |
| 31  | 112508 | INCORPORATE MP 08-0033                | RLW   | EWM  | TWS  |
| 30  | 041708 | INCORP. RFR-200604320 (AC 08-000016). | TJC   | MAL  | TWS  |
| 29  | 041206 | INCORPORATE MP 03-1009                | RLW   | EWM  | TWS  |
| 28  | 011706 | INCORP. AC 05-000110.                 | MAL   | JHK  | TWS  |
| 27  | 110904 | INCORP. RFR-22941A.                   | MAL   | RLW  | TWS  |
| 26  | 032604 | INCORPORATE RFR 22513A.               | EWM   | RLW  | TWS  |
| 25  | 031003 | INCORP. CMP 00-1006A                  | DJB   | SKC  | TWS  |
| 24  | 072502 | INCORP. RFR-19054A.                   | JHK   | EWM  | TWS  |
| 23  | 062402 | INCORP. DEC-1829 & RFR-09330K         | RLW   | EWM  | AMR  |
| REV | DATE   | REVISIONS                             | DRAFT | CHKD | APPR |

SCALE 1/8"=1'-0" DATE 2-25-14 DESIGNED BY [signature] DRAWN BY [signature] CHECKED BY [signature]

BECHTEL  
GAITHERSBURG, MARYLAND

SNUPPS


EQUIPMENT LOCATIONS  
REACTOR AND AUXILIARY BUILDINGS  
PLAN EL. 2068'-8"  
FSAR FIGURE 1.2-14

|   |                     |     |
|---|---------------------|-----|
| AS-BUILT  | UTILITY DRAWING NO. | REV |
|   | BECHTEL DRAWING NO. | REV |
|  | M-2G025             | 34  |

DRAWING APPLICABLE TO UNIT 2

FSAR Figure 1.2-14 is withheld per RIS 2015-17

**FSAR Figure 1.2-15 is withheld per RIS 2015-17**

|  |         |                           |                     |      |                       |                |
|--|---------|---------------------------|---------------------|------|-----------------------|----------------|
| 10   | 072415  | INCORP. MP 10-0001 FCN-01 | RLW                 | TJC  | N/A                   | SKC            |
| 10   | 042005  | INCORP. RFR 22341A        | TJC                 | MAL  | N/A                   | TWS            |
| 9  | 031003  | INCORP. CWP 00-1006A      | DJB                 | SKC  | N/A                   | TWS            |
| 8  | 071301  | INCORP. MP 98-100406.     | JHK                 | MAL  | N/A                   | AMR            |
| 7  | 041510  | INCORP. RFR 15963B.       | JK                  | surv | N/A                   | QMS            |
| 6  | 082608  | INCORP. CMP 89-0103       | MAL                 | surv | —                     | QMS            |
| NO   | DATE    | REVISIONS                 | BY                  | CHK  | Q'S SUPV              | PROJ ENGR APPR |
| SCALE 1/4"=1'-0"   |         |                           | DATE 1-16-79        |      | DESIGNED BY DRAWN JEH |                |
| <h2 style="text-align: center;">BECHTEL</h2> <p style="text-align: center;">GATHERSBURG, MARYLAND</p>  |         |                           |                     |      |                       |                |
| <h2 style="text-align: center;">SNUPPS</h2>  |         |                           |                     |      |                       |                |
| <h3 style="text-align: center;">EQUIPMENT LOCATIONS</h3> <h3 style="text-align: center;">REACTOR AND AUXILIARY BUILDINGS</h3> <h3 style="text-align: center;">SECTION A</h3> <p style="text-align: center;">FSAR FIGURE 1.2-15</p> |         |                           |                     |      |                       |                |
| <h1 style="text-align: center;">AS-BUILT</h1>  |         |                           | UTILITY DRAWING NO. |      | REV                   |                |
|  |         |                           |                     |      |                       |                |
|   | JOB NO. |                           | BECHTEL DRAWING NO. |      | REV                   |                |
|  | 10466   |                           | M-2G026             |      | 11                    |                |
| DRAWING APPLICABLE TO UNITS  |         |                           | 2                   | 3    | 4                     | 5              |
|  |         |                           | 1                   | 2    | 3                     | 4              |



FSAR Figure 1.2-16 is withheld per RIS 2015-17

FSAR Figure 1.2-16 is withheld per RIS 2015-17

|   |          |   |     |     |                     |      |
|---|----------|---|-----|-----|---------------------|------|
|   | 072415   | INCCORP. MP 10-0001 FCN-01  | RLW | TJC | N/A                 | SKC  |
|   | 042005   | INCCORP. RFR 22941A.  | TJC | MAL | N/A                 | TWS  |
|   | 071301   | INCCORP. MP 98-1004D.   | JHK | MAL | N/A                 | AMR  |
|   | 12-5-90  | INCCORP. CHMP-BA-1026   | GER | RLW | -                   | -    |
|   | 10-9-90  | ISSUE PER EDP-EE-04024  | MAL | RLW | -                   | -    |
|   | 11-16-81 | INITIAL ISSUE REFLECTS<br>TRANSFER TO U.E. SUPERSEDES<br>M-24027 REV. B. INCCORP<br>CHMP-BA-09410 | GER | RLW | -                   | -    |
| NO.   | DATE     | REVISIONS   | BY  | CHK | DES                 | PROJ |
|   |          |   |     | CHK | ENGR                | ENGR |
| SCALE: 1/4"=1'-0" (DATE 3-14-74) DESIGNED DMM DRAWN RWV                                   |          |   |     |     |                     |      |
| BECHTEL   |          |   |     |     |                     |      |
| GAITHERSBURG, MARYLAND  |          |   |     |     |                     |      |
| SNUPPS  |          |   |     |     |                     |      |
| EQUIPMENT LOCATIONS<br>REACTOR AND AUXILIARY BUILDINGS<br>SECTION B<br>FSAR FIGURE 1.2-16 |          |   |     |     |                     |      |
| AS-BUILT  |          |   |     |     | UTILITY DRAWING NO. | REV. |
|   |          |   |     |     |                     |      |
| JOB NO.   |          |   |     |     | BECHTEL DRAWING NO. | REV. |
| 10466   |          |   |     |     | M-2G027             | 5    |
| DRAWINGS APPLICABLE TO SHEET  |          |   |     |     |                     |      |

FSAR Figure 1.2-17 is withheld per RIS 2015-17

FSAR Figure 1.2-17 is withheld per RIS 2015-17

9

072415

INCORP. MP 10-0001 FCN-01

RLW

TJC

---

SKC

8

052207

INCORP. MP 06-0003.

MAL

TJC

---

TWS

7

042005

INCORP. RFR 22941A

TJC

MAL

---

TWS

6

022898

INCORP. CMP 96-1012A

DJB

RBF

---

AMR

5

0201

INCORP CMP 93-1010

RLW

RLW

N/A

---

4

0405

INCORP CMP 92-1055A

K

ENR

N/A

---

3

2400

1991E PER EDP 82-04024

MAL

RLW

---

---

2

1200

INCORP CMP 89-1025

SBR

RLW

---

---

1

0400

1991E PER EDP 82-04024

MAL

RLW

---

---

0

0101

REFLECTS TURNOVER TO UE ;  
SUPERSEDES M-05028 R-Y &  
INC. CMP 84-0400

RLW

RLW

N/A

N/A

---

NO

DATE

REVISIONS

BY

CHK

DES

PROJ

APPV

SCALE: 1/8" = 1'-0"

DATE: 12-28-78

DESIGNED: DWM

DRAWN: HJB

CHKD: RLW

ENGR: RLW

PROJ: RLW

APPV: RLW

BECHTEL

GAITHERSBURG, MARYLAND

SNUPPS

EQUIPMENT LOCATIONS  
REACTOR AND AUXILIARY BUILDINGS  
SECTION C  
FSAR FIGURE 1.2-17

AS-BUILT

UTILITY DRAWING NO.

REV

BECHTEL

JOB NO.

BECHTEL DRAWING NO.

REV

10466

M-2G028

9

DRAWING APPLICABLE TO UNITS

2

1

2

3

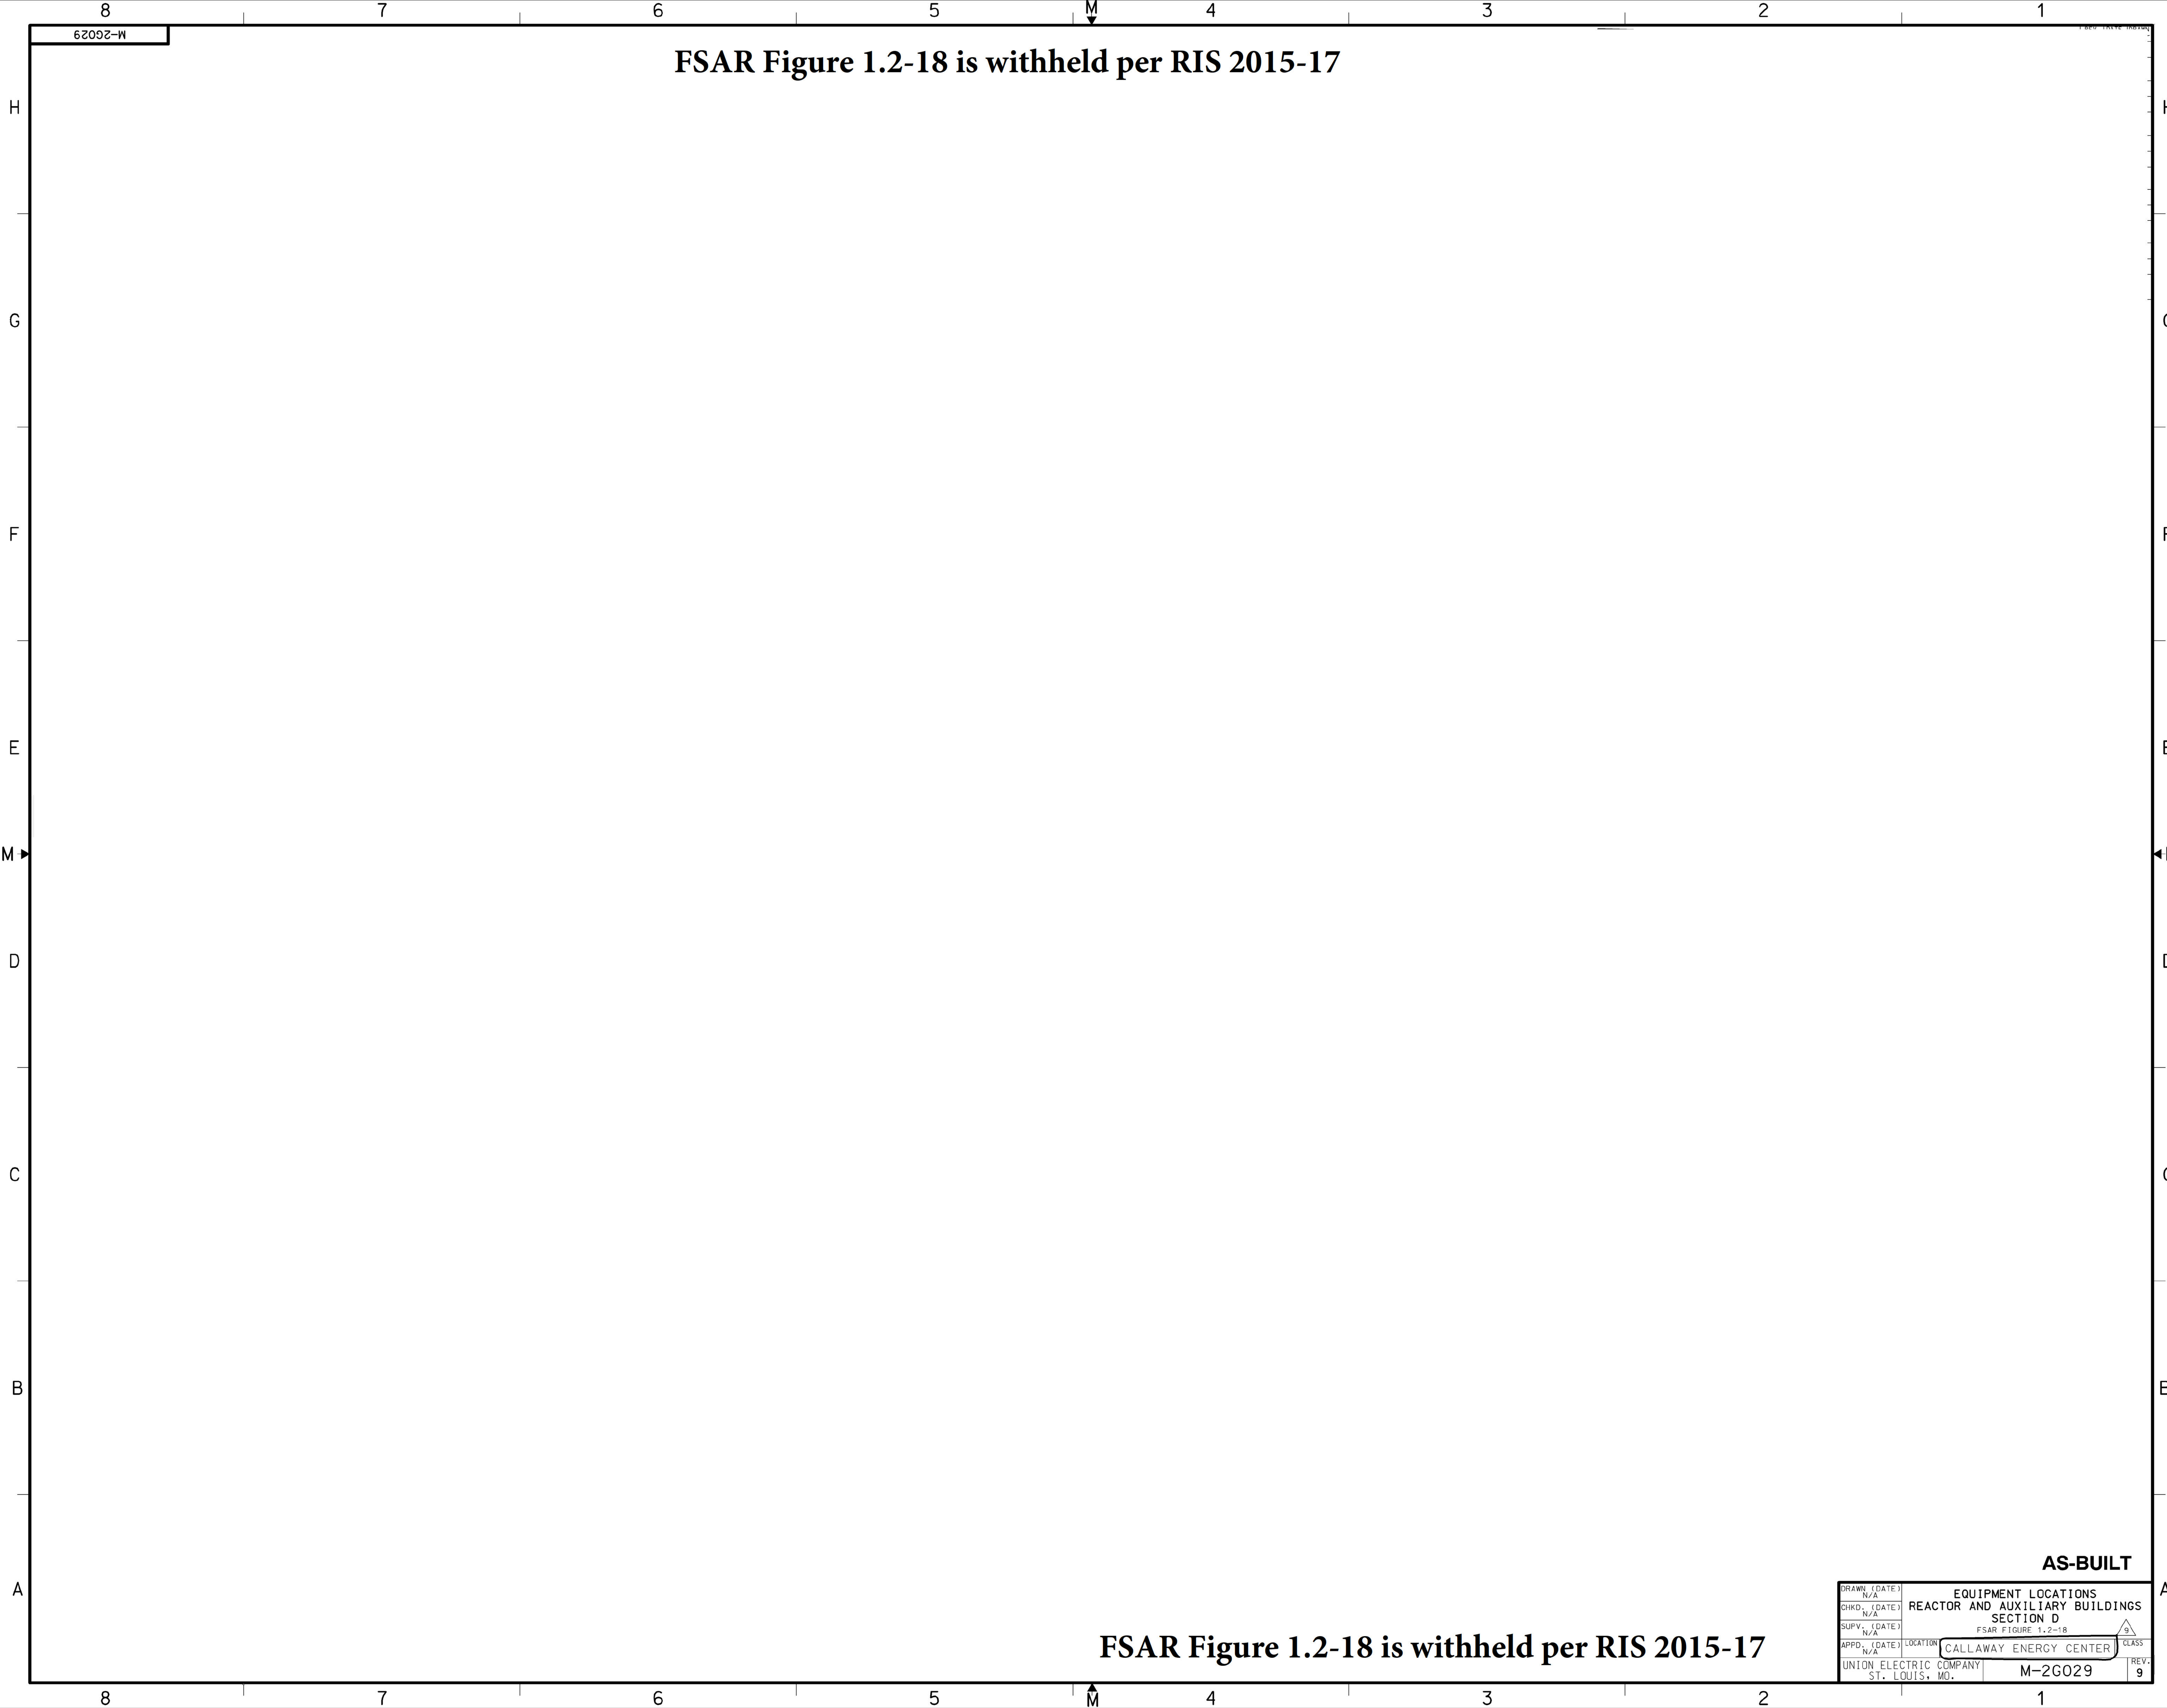
99

100

1

34x44

E" SIZE



FSAR Figure 1.2-18 is withheld per RIS 2015-17


FSAR Figure 1.2-18 is withheld per RIS 2015-17

M-2G029

|   |  |  |
|---|--|--|
| AS-BUILT  |  |  |
| EQUIPMENT LOCATIONS<br>REACTOR AND AUXILIARY BUILDINGS<br>SECTION D |  |  |
| FSAR FIGURE 1.2-18  |  |  |
| CALLAWAY ENERGY CENTER  |  |  |
| M-2G029   |  |  |



**FSAR Figure 1.2-19 is withheld per RIS 2015-17**

|   |        |   |                     |           |           |           |
|---|--------|---|---------------------|-----------|-----------|-----------|
| 8   | 060210 | INCORP. MP 03-0056<br>FCN-02, FCN-08.   | MAL                 | TJC       | N/A       | LMP       |
| 7   | 042005 | INCORP. RFR 22941A.   | TJC                 | MAL       | N/A       | TWS       |
| 6   | 082201 | INCORP. RFR 21270A.   | MAL                 | SKC       | N/A       | AMR       |
| 5   | 060701 | INCORP. RFR-20198B.   | JHK                 | MAL       | N/A       | AMR       |
| 4   | 042398 | INCORP. CMP 96-1012A  | DJB                 | RLW       | ---       | JHK       |
| 3   | 144400 | INCORP CMP 92-1010  | MAL                 | RLW       | ---       | Q-20      |
| 2   | 144400 | 144400 PER EDP 23-04024<br>REFLECTS TURNOVER TO UE<br>INCORP CMP 85-0395A   | 602                 | JB        | N/A       | CCC       |
| 1   | 921205 | DRAFTED CMP 84-049A, 4 CMP<br>84-05-01A PER LEB-539.<br>EXCEPTIONS PER CNCLP-0051.<br>THIS DWG. SUPERSEDES<br>DWG. M-0G030, REV. 7. | WYN                 | EL        | FS        | JKL       |
| NO. DATE  |        | REVISIONS   | BY CHK DESU         |           | CHKD ENGR | PROJ ENGR |
| SCALE 1"=10'  |        | DATE 3-16-74  | DESIGNED DWM        | DRAWN DJS |           | CHKD ENGR |
| <h1 style="text-align: center;">BECTHEL</h1> <p style="text-align: center;">GAITHERSBURG, MARYLAND</p>                          |        |   |                     |           |           |           |
| <h2 style="text-align: center;">SNUPPS</h2>   |        |   |                     |           |           |           |
| <p style="text-align: center;">EQUIPMENT LOCATIONS<br/>AUXILIARY BUILDING<br/>SECTIONS E, F, &amp; G<br/>FSAR FIGURE 1-2-19</p> |        |   |                     |           |           |           |
| <h1 style="text-align: center;">AS-BUILT</h1>   |        |   | UTILITY DRAWING NO. |           | REV       |           |
|    |        |   | BECTHEL DRAWING NO. |           | REV       |           |
| 10466   |        |   | M-2G030             |           | 8         |           |
| DRAWING APPLICABLE TO UNIT  |        |   | 2                   |           | 34-44     |           |

FSAR Figure 1.2-20 is withheld per RIS 2015-17

M-2G040

H

G

F

E

D

C

B

A

FSAR Figure 1.2-20 is withheld per RIS 2015-17

|  |        |                         |                     |           |                |
|--|--------|-------------------------|---------------------|-----------|----------------|
|  | 072017 | INCCORP. RFR 170008.    | MAL                 | RLW       | DME            |
|  | 071516 | INCCORP. RFR 201506791. | TJC                 | MAL       | DME            |
| NO.  | DATE   | REVISIONS               | BY                  | CHK       | APPR           |
| SCALE 1/8"=1'-0"   |        | DATE 3-7-78             | DESIGNED            | DRAWN JTB | CHIEF ENGINEER |
| <b>BECHTEL</b><br>GAITHERSBURG, MARYLAND   |        |                         |                     |           |                |
| EQUIPMENT LOCATIONS<br>FUEL BLDG. PLANS EL.2000'-0"<br>EL.2026'-0" & EL.2047'-6"<br>FSAR FIGURE 1.2-20 |        |                         |                     |           |                |
| <b>AS-BUILT</b>  |        |                         | UTILITY DRAWING NO. |           | REV            |
|  |        |                         | JOB NO.             |           | REV            |
|  |        |                         | BECHTEL DRAWING NO. |           | REV            |
|  |        |                         | M-2G040             |           | 36             |
| DRAWING APPLICABLE TO UNITS  |        |                         | 2                   |           |                |

This drawing and the design it covers is the property of the Utilities which are participating in the SNUPPS Project. It is loaned on the borrower's express agreement that it will not be reproduced, copied, loaned, exhibited, or used except in the limited way and private use permitted by written consent given by the SNUPPS Utilities to the borrower.

M-2G041

FSAR Figure 1.2-21 is withheld per RIS 2015-17

FSAR Figure 1.2-21 is withheld per RIS 2015-17

|  |               |  |          |                     |          |      |
|--|---------------|--|----------|---------------------|----------|------|
| 6  | 011717        | INCORP. MP 14-0014, FCN-01.  | MAL      | RLW                 | N/A      | DME  |
| 5  | 020216        | INCORPORATE MP 13-0038 FCN-07.   | CNS      | RLW                 | N/A      | DME  |
| 4  | 011115        | INCORPORATE CAR 201405515.   | CNS      | RLW                 | N/A      | DME  |
| 3  | 080515        | INCORPORATE MP 13-0038 FCN-01 & FCN-04.  | RLW      | TJC                 | N/A      | DME  |
| 2  | 042005        | INCORP. RFR 22941A.  | TJC      | MAL                 | N/A      | TWS  |
| 1  | 101399        | INCORP. MP 97-1016A.   | MAL      | EWM                 | N/A      | AMR  |
| 0  | 10/26/88      | INITIAL ISSUE SUPERCEDES M-06041 REV 4 REFLECTS TURNOVER TO U.E. INCORP CMP-85-0025A, & CMP-84-0570-FCN-01 | SBR      |                     |          |      |
| NO.  | DATE          | REVISIONS  | BY       | CHK                 | DES SUPV | ENGR |
| SCALE 1/8"=1'-0"   | DATE 10-17-18 | DESIGNED   | DRAWN JT | CHKD                | ENGR     | APPR |
| BECHTEL  |               |  |          |                     |          |      |
| GAITHERSBURG, MARYLAND   |               |  |          |                     |          |      |
| SNUPPS   |               |  |          |                     |          |      |
| EQUIPMENT LOCATIONS<br>FUEL BUILDING<br>SECTIONS A, B, & C<br>FSAR FIGURE 1.2-21 |               |  |          |                     |          |      |
| AS-BUILT   |               |  |          | UTILITY DRAWING NO. |          | REV  |
| JOB NO.  |               |  |          | BECHTEL DRAWING NO. |          | REV  |
| 10466  |               |  |          | M-2G041             |          | 6    |
| DRAWING APPLICABLE TO UNITS  |               |  |          |                     |          |      |



This drawing and the design it covers is the property of the Utilities which are participating in the SNUPPS Project. It is loaned on the borrower's express agreement that it will not be reproduced, copied, loaned, exhibited, or used except in the limited way and private use permitted by written consent given by the SNUPPS Utilities to the borrower.

M-26042

FSAR Figure 1.2-22 is withheld per RIS 2015-17

FSAR Figure 1.2-22 is withheld per RIS 2015-17

|  |            |   |                     |       |      |      |
|--|------------|---|---------------------|-------|------|------|
| 6  | 011117     | INCORP. MP 14-0014, FCN-01.   | MAL                 | RLW   | N/A  | DME  |
| 5  | 020216     | INCORPORATE MP 13-0038 FCN-07.  | CNS                 | RLW   | N/A  | DME  |
| 4  | 011116     | INCORPORATE CAR 201505515.  | CNS                 | RLW   | N/A  | DME  |
| 3  | 080515     | INCORPORATE MP 13-0038 FCN-01 & FCN-04.   | RLW                 | TJC   | N/A  | DME  |
| 2  | 042005     | INCORP. RFR 22941A.   | TJC                 | MAL   | N/A  | TWS  |
| 1  | 102099     | INCORP. MP 97-1016A.  | MAL                 | EWM   | N/A  | AMR  |
| 0  | 102600     | INITIAL ISSUE SUPERCEDES M-06042 R.A. REFLECTS TURN-OVER TO DE INCORP CMP 84-0570-FCN-01. | MAL                 | RLW   | N/A  | BY   |
| NO.  | DATE       | REVISIONS   | BY                  | CHK   | DES  | PROJ |
| SCALE  | 1/8"=1'-0" | DATE 11-2-78  | DESIGNED            | DRAWN | CHKD | APPR |
| BECHTEL  |            |   |                     |       |      |      |
| GAITHERSBURG, MARYLAND   |            |   |                     |       |      |      |
| SNUPPS   |            |   |                     |       |      |      |
| EQUIPMENT LOCATIONS<br>FUEL BUILDING<br>SECTIONS D, E, & F<br>FSAR FIGURE 1.2-22 |            |   |                     |       |      |      |
| AS-BUILT   |            |   | UTILITY DRAWING NO. |       | REV  |      |
| JOB NO.  |            |   | BECHTEL DRAWING NO. |       | REV  |      |
| 10466  |            |   | M-26042             |       | 6    |      |
| DRAWING APPLICABLE TO UNITS  |            |   | 2                   |       |      |      |



FSAR Figure 1.2-23 is withheld per RIS 2015-17

|                                     |                |  |                     |     |          |           |
|-------------------------------------|----------------|--|---------------------|-----|----------|-----------|
| 30                                  | 021110         | INCORP. MP 07-0066, FCN-24.  | MAL                 | TJC | N/A      | TWS       |
| 29                                  | 110904         | INCORP. RFR-22941A.  | MAL                 | RLW | N/A      | TWS       |
| 28                                  | 091804         | INCORPORATE RFR 17704B   | EWM                 | JHK | N/A      | TWS       |
| 27                                  | 041604         | INCORP. RFR 22782B.  | MAL                 | RLW | N/A      | TWS       |
| 26                                  | 112103         | INCORPORATE RFR 22782A   | EWM                 | RLW | N/A      | TWS       |
| 25                                  | 082003         | INCORPORATE RFR 20282E   | EWM                 | RLW | N/A      | TWS       |
| 24                                  | 032603         | INCORP. MP 01-1002A  | RLW                 | EWM | N/A      | TWS       |
| 23                                  | 082201         | INCORP. RFR-17126B.  | JHK                 | MAL | N/A      | AMR       |
| 22                                  | 050501         | INCORP. MP 00-1007 FCN-07 AND RFR 20282C.                                      | RLW                 | EWM | N/A      | AMR       |
| 21                                  | 021501         | INCORP. RFR-20493B.  | JHK                 | MAL | N/A      | AMR       |
| 20                                  | 062699         | INCORP. MP 97-1006 FCN-1B.   | JHK                 | MAL | N/A      | JHC       |
| 19                                  | 012299         | INC. RFR-19223A & RFR-19228A   | JHK                 | MAL | N/A      | AMR       |
| 18                                  | 090998         | INCORP. MP 97-1034C.   | MAL                 | JHK | N/A      | AMR       |
| 17                                  | 011498         | INCORP. RFR-17704A.  | JHK                 | EWM | N/A      | AMR       |
| 16                                  | 031497         | INCORP. RFR-17572A.  | JHK                 | EWM | N/A      | AMR       |
| 15                                  | 020697         | INCORP. CMP 96-1009A FCN-01.   | JHK                 | EWM | N/A      | AMR       |
| 14                                  | 121796         | INCORP. RFR-13528F.  | JHK                 | MAL | N/A      | AMR       |
| 13                                  | 071296         | INCORP. RMP 94-2005 FCN-02   | RLW                 | DLB | N/A      | AMR       |
| 12                                  | 11-14-93       | INCORP. RFR-16518A.  | K                   | EWM | N/A      | Q-2       |
| 11                                  | 7/31/94        | INCORP. RFR-16112A   | SEE H/P             | —   | —        | Q-2       |
| 10                                  | 10/11/94       | INCORP. RFR-14770C.  | MAL                 | SEE | —        | Q-2       |
| 9                                   | 8/6/94         | INCORP. RFR-14770A.  | MAL                 | SEE | —        | Q-2       |
| 8                                   | 3/24/93        | INCORP. RFR-10429 (MINOR MOD)  | SEE                 | SEE | —        | Q-2       |
| 7                                   | 6/19/92        | INCORP. CMP 91-1020  | SEE                 | SEE | —        | Q-2       |
| 6                                   | 3/3/92         | INCORP. RMP 90-2017.   | MAL                 | NR  | —        | Q-2       |
| 5                                   | 1/15/91        | ISSUED PER EDP-22-0A024.   | K                   | SEE | N/A      | Q-2       |
| 4                                   | 3/14/91        | INCORP. CMP-87-10B9.   | MAL                 | NR  | —        | Q-2       |
| 3                                   | 1/30/91        | INCORP. RFR-08400A.  | MAL                 | NR  | —        | Q-2       |
| 2                                   | 1/13/91        | ISSUE PER EDP-22-0A024   | MAL                 | NR  | —        | Q-2       |
| 1                                   | 1/14/89        | INCORP. CMP-87-10B9.   | MAL                 | NR  | N/A      | Q-2       |
| 0                                   | 3/2/86         | INITIAL ISSUE (RFR-1641A); REFLECTS TURNOVER TO UE 1 SUPERSEDES M-00050 REV. B | NR                  | NR  | N/A      | Q-2       |
| NO.                                 | DATE           | REVISIONS  | BY                  | CHK | DES SUPV | PROJ ENGR |
| SCALE: 1/8"=1'-0"                   | DATE: 11-22-78 | DESIGNED   | DRAWN               | CAI | CHIEF    | ENGR      |
| BECHTEL                             |                |  |                     |     |          |           |
| GAITHERSBURG, MARYLAND              |                |  |                     |     |          |           |
| SNUPPS                              |                |  |                     |     |          |           |
| EQUIPMENT LOCATIONS                 |                |  |                     |     |          |           |
| CONTROL BLDG. & COMM. CORRIDOR PLAN |                |  |                     |     |          |           |
| EL. 1974'-0" & EL. 1984'-0"         |                |  |                     |     |          |           |
| FSAR FIGURE 1.2-23                  |                |  |                     |     |          |           |
| AS-BUILT                            |                |  | UTILITY DRAWING NO. |     | REV      |           |
| JOM NO.                             |                |  | BECHTEL DRAWING NO. |     | REV      |           |
| M-2G050                             |                |  | 30                  |     |          |           |
| DRAWING APPLICABLE TO UNITS         |                |  | 2                   |     |          |           |
|                                     |                |  | 34x44               |     | E" SIZE  |           |

FSAR Figure 1.2-23 is withheld per RIS 2015-17


FSAR Figure 1.2-24 is withheld per RIS 2015-17

FSAR Figure 1.2-24 is withheld per RIS 2015-17

|  |  |                      |          |      |
|--|--|----------------------|----------|------|
| 00211  | INCORP. MP 16-0024, REV. 0.  | AWR                  | SJK      | DNE  |
| 00211  | INCORP. MP 16-0024, REV. 0. REV. 1. SMALL LEGACY ERROR, & PER ENG. MARKUP. | SJK                  | AWR      | DNE  |
| 11241  | INCORP. MP 11-0020, REV. 0. AND FON-01.                                    | NAAL                 | RLW      | DNE  |
| 03291  | INCORPORATE MP 12-0020 REL. 0.   | RLW                  | TJC      | DNE  |
| 00211  | INCORPORATE FC 15-00040. MP 20110189.                                      | CNS                  | RLW      | DNE  |
| NO.  | DATE   | REVISIONS            | DRWN     | CHKD |
| SCALE: 1/8" = 1'-0"  |  | DATE: 01/1/00        | DESIGNED | CHKD |
| <b>BECHTEL</b><br>SAN FRANCISCO, CALIFORNIA  |  |                      |          |      |
| <b>SNUPPS</b>  |  |                      |          |      |
| EQUIPMENT LOCATIONS<br>CONTROL & DIESEL GEN. BLDGS. AND COMM.<br>CORRIDOR PLAN EL. 2000'-0" & EL. 2016'-0"<br>FSAR FIGURE 1.2-24 |  |                      |          |      |
| <b>AS-BUILT</b>  |  | UTILITY BRIDGING NO. | REV.     |      |
| JOB NO.  |  | BECHTEL DRAWING NO.  | REV.     |      |
|  |  | M-26051              | 45       |      |
| REVISIONS APPLICABLE TO SHEET  |  | 1 3444 1" 50'        |          |      |

FSAR Figure 1.2-25 is withheld per RIS 2015-17

FSAR Figure 1.2-25 is withheld per RIS 2015-17

|  |                            |                     |                     |          |
|--|----------------------------|---------------------|---------------------|----------|
| 011619   | INCRP. MP 08-0027, FCN-04. | CBH                 | SLK                 | DNE      |
| 010211   | INCRP. MP 13-0002, FCN-01. | MAL                 | PLW                 | DNE      |
| REV. 1   | 01/13/2015                 | DATE 11-13-15       | DESIGNED            | DRAWN ON |
| <b>BECHTEL</b><br>BATHESBURG, MARYLAND   |                            |                     |                     |          |
| <b>SNUPPS</b><br>EQUIPMENT LOCATIONS<br>CONTROL & DIESEL GENS. BLDGS. AND COMM.<br>CORRIDOR PLAN EL.2032' -0" & EL.2047' -6"<br>FSAR FIGURE 1.2-25 |                            |                     |                     |          |
| <b>AS-BUILT</b>  |                            | UTILITY DRAWING NO. | REV.                |          |
|   |                            | JOB NO.             | BECHTEL DRAWING NO. | REV.     |
|  |                            |                     | M-26052             | 34       |
| DRAWING APPLICABLE TO UNIT: 1 3404 1" 502  |                            |                     |                     |          |

FSAR Figure 1.2-26 is withheld per RIS 2015-17

H

G

F

E

D

C

B

A

|    |        |                                    |     |     |     |     |
|----|--------|------------------------------------|-----|-----|-----|-----|
| 17 | 060613 | INCORP. MP 11-0022 FCN-01.         | TJC | MAL | N/A | LMP |
| 16 | 110107 | INCORP. CARS 20070996T.            | MAL | TJC | N/A | TWS |
| 15 | 042009 | INCORP. RFR 22941A.                | TJC | MAL | N/A | TWS |
| 14 | 103100 | INCORP. RFR-19484B.                | JHK | MAL | N/A | AMR |
| 13 | 032700 | INCORP. RFR-20282A AND RFR-20357A. | JHK | MAL | N/A | AMR |
| 12 | 080699 | INCORP. RFR-19484A.                | DLB | SKC | N/A | AMR |
| 11 | 041698 | INCORP. RFR-18540A.                | MAL | EXM | N/A | JHK |
| 10 | 011498 | INCORP. RFR-18299A.                | JHK | EXM | N/A | AMR |
| 9  | 041697 | INCORP. RFR-17674A.                | JHK | EXM | N/A | AMR |
| 8  | 031497 | INCORP. RFR-10753C.                | JHK | EXM | N/A | AMR |

| NO. | DATE | REVISIONS | BY | CHK | DES  | PROJ | APP  |
|-----|------|-----------|----|-----|------|------|------|
|     |      |           |    |     | SUPV | ENGR | ENGR |

SCALE 1/8"=1'-0" DATE 12-1-18 DESIGNED DRAWN CAI

BECHTEL  
GAITHERSBURG, MARYLAND

EQUIPMENT LOCATIONS  
CONTROL, DIESEL, GENS., & COMM. CDRR, BLDGS.  
PLAN ELS. 2061'-6", 2066'-0" & 2073'-6" & SEC. "D"  
FSAR FIGURE 1.2-26

| AS-BUILT | UTILITY DRAWING NO. | REV |
|----------|---------------------|-----|
|          |                     |     |

|                             |         |    |
|-----------------------------|---------|----|
| 10466                       | M-2G053 | 17 |
| DRAWING APPLICABLE TO UNITS |         |    |

FSAR Figure 1.2-26 is withheld per RIS 2015-17



FSAR Figure 1.2-27 is withheld per RIS 2015-17

H

G

F

E

D

C

B

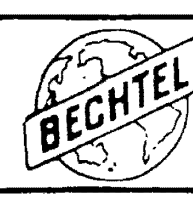
A

|                    |          |   |              |     |     |                                |
|--------------------|----------|---|--------------|-----|-----|--------------------------------|
| △                  | 030217   | INCORP. MP 13-0002, FCN-01.   | MAL          | RLW | N/A | DME                            |
| △                  | 042005   | INCORP. RFR 22941A.   | TJC          | MAL | N/A | TWS                            |
| △                  | 021501   | INCORP. MP 00-1007A.  | JHK          | MAL | N/A | AMR                            |
| △                  | 051698   | INCORP. DEC-1609.   | JHK          | MAL | N/A | JHC                            |
| △                  | 6-22-91  | INCORP. CMP 91-1020.  | MAL          | RLW | —   | RLW                            |
| △                  | 11/15/91 | ISSUED PER EDP-ZZ-0402A.  | K            | RLW | N/A | RLW                            |
| △                  | 11/14/91 | INCORP. CMP 87-1059.  | MAL          | RLW | N/A | RLW                            |
| △                  | 8-8-91   | INCORP. CMP. 85-0290.   | 4DC          | RLW | N/A | RLW                            |
| △                  | 7-23-96  | INC. CMP 85-0113 ; REFLECTS TURNOVER TO UE ; SUPERSEDES M-06054 R-5 | 8            | RLW | N/A | RLW                            |
| NO. DATE           |          |   | REVISIONS    |     |     | BY CHK DES ENGR PROJ APPR      |
| SCALE 1/8" = 1'-0" |          |   | DATE 2-28-74 |     |     | DESIGNED DRAWN C.B. CHIEF ENGR |

BECHTEL

GAITHERSBURG, MARYLAND

|   |                     |                     |
|---|---------------------|---------------------|
| SNUPPS                                  |                     |                     |
| EQUIPMENT LOCATIONS                     |                     |                     |
| CONTROL & DIESEL GENS. BLDGS. AND COMM. |                     |                     |
| CORRIDOR SECTION "A"                    |                     |                     |
| FSAR FIGURE 1.2-27                      |                     |                     |
| AS-BUILT                                | UTILITY DRAWING NO. | REV                 |
|   | JOB NO.             | BECHTEL DRAWING NO. |
|   | 10466               | M-2G054             |
|   |                     | 8                   |



DRAWING APPLICABLE TO UNITS

2

34x44 "E" SIZE

FSAR Figure 1.2-27 is withheld per RIS 2015-17

**FSAR Figure 1.2-28 is withheld per RIS 2015-17**



Figure withheld in accordance with 10 CFR 2.390


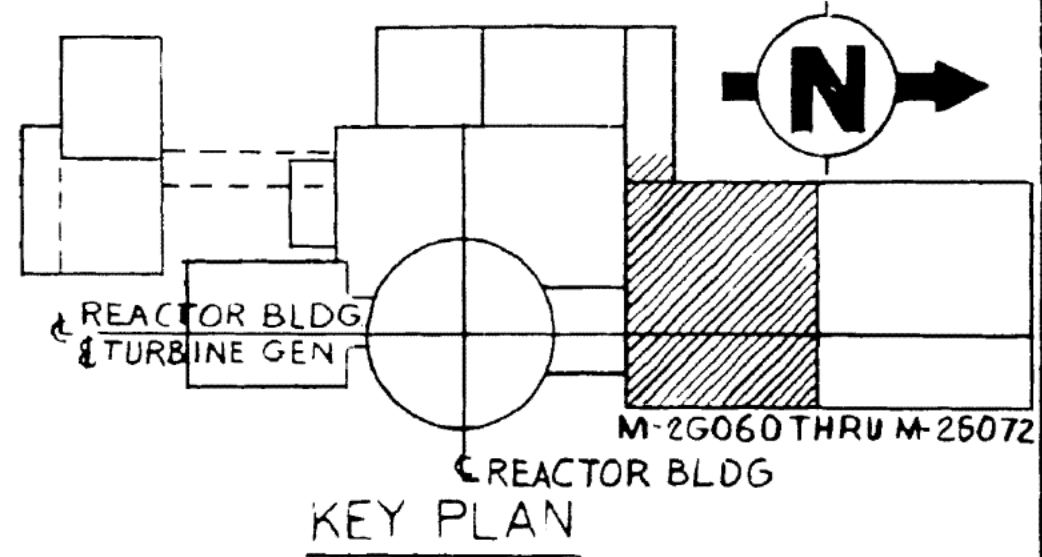
|   |         |   |          |                     |       |       |                     |       |  |
|---|---------|---|----------|---------------------|-------|-------|---------------------|-------|--|
| △ <sub>12</sub>   | 060711  | INCORP. RFR 201100321.  | MAL      | TJC                 | N/A   | TWS   |                     |       |  |
| △ <sub>11</sub>   | 090310  | INCORP. MP 10-0032.   | MAL      | EWB                 | N/A   | LMP   |                     |       |  |
| △ <sub>10</sub>   | 120906  | INCORP. RFR 200707619.<br>CHANGE SCAFFOLD AREA'S<br>AREAFILL.   | MAL      | TJC                 | N/A   | TWS   |                     |       |  |
| △ <sub>9</sub>  | 042005  | INCORP. RFR-222941A.  | TJC      | MAL                 | N/A   | TWS   |                     |       |  |
| △ <sub>8</sub>  | 032700  | INCORP. RFR-20282A.   | JHK      | MAL                 | N/A   | AMR   |                     |       |  |
| △ <sub>7</sub>  | 052896  | INC'D RWP 91-2014 FCN-02  | RBF      | DJB                 | N/A   | AMR   |                     |       |  |
| △ <sub>6</sub>  | 032898  | INCORP.<br>RFR-16778A.  | JHK      | EWB                 | N/A   | AMR   |                     |       |  |
| △ <sub>5</sub>  | 3/27/71 | INCORP.<br>RFR-07718A.  | K        | JC                  | N/A   | AMR   |                     |       |  |
| △ <sub>4</sub>  | 6/22/71 | INCORP. CPM 91-1020.  | MAL      | 7/2                 | —     | AMR   |                     |       |  |
| △ <sub>3</sub>  | 11/2/71 | ISSUED PER<br>EDP-22-04024.   | K        | 7/2                 | N/A   | AMR   |                     |       |  |
| △ <sub>2</sub>  | 5/16/80 | REFLECTS TURNOVER TO UE<br>INCORP. CPM 84-0088B.  | K        | 1/24                | N/A   | AMR   |                     |       |  |
| △ <sub>1</sub>  | 3/24/80 | DRAFTED TO INCORPORATE<br>CPM 81-03-013B.   | 1/24     | 7/2                 | N/A   | AMR   |                     |       |  |
| △ <sub>0</sub>  | 1/2/81  | DRAFTED CPM 84-05-97A<br>PER ELB-SIO CPM 80-003-<br>33A PER ELB-S22. THIS DWG.<br>SUPERSEDES M-03060 REV.5. | EDP      | 1/1/81              | 7/2   | AMR   |                     |       |  |
| NO.   | DATE    | REVISIONS   | BY       | CHK                 | DR    | ENGR  | PROJ                | APPR  |  |
| SCALE 1/8"=1'-0"  |         | DATE 1-15-74  | DESIGNED | D.L.W               | DRAWN | R.J.C | ENGR                | J.P.C |  |
| <b>BECHTEL</b>  |         |   |          |                     |       |       |                     |       |  |
| GAITHERSBURG, MARYLAND  |         |   |          |                     |       |       |                     |       |  |
| <b>SNUPPS</b>   |         |   |          |                     |       |       |                     |       |  |
| EQUIPMENT LOCATION<br>TURBINE BUILDING<br>CONDENSER PIT - PLAN EL. 1983'-0"           |         |   |          |                     |       |       |                     |       |  |
| FSAR FIGURE 1.2-29  |         |   |          |                     |       |       |                     |       |  |
| <b>AS-BUILT</b>   |         |   |          | UTILITY DRAWING NO. |       |       | REV                 |       |  |
|  |         |   |          | JOB NO.             |       |       | BECHTEL DRAWING NO. |       |  |
|   |         |   |          | 10466               |       |       | M-2G060             |       |  |
| DRAWING APPLICABLE TO UNITS   |         |   |          | 7                   |       |       | 12                  |       |  |







Figure withheld in accordance with 10 CFR 2.390



- NOTES:
- 1. DELETED.
  - 2. THE FOLLOWING NON-PLANT EQUIPMENT ITEMS HAVE BEEN APPROVED FOR STORAGE AT THE GENERAL LOCATIONS SHOWN.

| APPROVED NON-PLANT EQUIPMENT STORAGE |                         |                      |           |                |
|--------------------------------------|-------------------------|----------------------|-----------|----------------|
| ITEM                                 | DESCRIPTION             | APPROVAL DOCUMENT(S) | RESP DEPT | LOCATION       |
| 1                                    | 10' PROTECTION BARRIERS | RFR-160587           | OPS       | (2)TB-TD/T8-T9 |

|   |          |  |                |                     |     |      |      |      |
|---|----------|--|----------------|---------------------|-----|------|------|------|
| 9   | 020819   | INCORP RFR-160587, REV. 1.   | SJK/AHR        | N/A                 | DME |      |      |      |
| 8   | 051011   | INCORP. MP 10-0038 FCN-15.   | MAL/TJC        | N/A                 | TWS |      |      |      |
| 7   | 090310   | INCORP. MP 10-0032.  | MAL/EWM        | N/A                 | LMP |      |      |      |
| 6   | 042005   | INCORP RFR-22941A  | TJC/MAL        | N/A                 | TWS |      |      |      |
| 5   | 100298   | INCORP RFR-19394B  | SKC/MAL        | N/A                 | AMR |      |      |      |
| 4   | 102398   | INCORP DEC-1360  | DLB/EWM        | N/A                 | AMR |      |      |      |
| 3   | 7/4/15   | INCORP RFR-16056A.   | K/EHL          | N/A                 | DME |      |      |      |
| 2   | 11/11/15 | INCORP RFR-15704A  | HLp/SK         | N/A                 | DME |      |      |      |
| 1   | 11/23/15 | INCORP RFR-08942B.   | MAL/SK         | —                   | AMR |      |      |      |
| 1   | 12/30/15 | INITIAL ISSUE SUPERSEDES M-08062 REV 4. REFLECTS TURNOVER TO UE# INCORP CMP-04-0754A | SK/SJK         | N/A                 | AMR |      |      |      |
| NO  | DATE     | REVISIONS  | BY             | CHK                 | DES | ENGR | PROJ | APP  |
| SCALE 1/8"=1'-0"  |          | DATE 1/22/74   | DESIGNED BY LW | DRAWN AE Z          | CHK | DES  | ENGR | PROJ |
| BECHTEL<br>GAITHERSBURG, MARYLAND   |          |  |                |                     |     |      |      |      |
| SNUPPS  |          |  |                |                     |     |      |      |      |
| EQUIPMENT LOCATION<br>TURBINE BUILDING<br>PARTIAL PLAN EL. 2015'-0"<br>FSAR FIGURE 1.2-31 |          |  |                |                     |     |      |      |      |
| AS-BUILT  |          |  |                | UTILITY DRAWING NO. |     | REV  |      |      |
| JOB NO.   |          |  |                | BECHTEL DRAWING NO. |     | REV  |      |      |
| 10466   |          |  |                | M-2G062             |     | 9    |      |      |
| DRAWING APPLICABLE TO UNITS   |          |  |                | 2                   |     |      |      |      |

Figure withheld in accordance with 10 CFR 2.390

Figure withheld in accordance with 10 CFR 2.390

NOTES:

1. THE FOLLOWING NON-PLANT EQUIPMENT HAS BEEN APPROVED FOR STORAGE AT THE GENERAL LOCATIONS SHOWN.

| APPROVED NON-PLANT EQUIPMENT STORAGE |                             |                      |           |                |                               |
|--------------------------------------|-----------------------------|----------------------|-----------|----------------|-------------------------------|
| ITEM                                 | DESCRIPTION                 | APPROVAL DOCUMENT(S) | RESP DEPT | ROOM NO.       | LOCATION(S)                   |
| 5                                    | BREAKER MAINT TOOLS/CABINET | RFR-18001A           | MAINT     | 4401 GEN. FLR. | TE/T3                         |
| 6                                    | HOSE RACK AND HOSES         | RFR-18317A           | OPS       | 4401 GEN. FLR. | TD-TE/T10-T11                 |
| 7                                    | AIR WRENCH CART & TOOLS     | RFR-18317A           | OPS       | 4401 GEN. FLR. | TB/T10-T11                    |
| 8                                    | SECURITY CHESTS             | RFR-19923A           | SEC       | 4401           | TB/T1, TG/T7-T8, TG/T4        |
| 9                                    | OFFICE FURNITURE            | RFR-201405347        | I&C       | 4401           | TE/T2-T3                      |
| 10                                   | REMOTE RACKING MECHANISM    | RFR-201101991        | OPS       | 4401           | TF/T3                         |
| 11                                   | BREAKER LIFTING RIGS        | RFR-160509           | ME        | 4401 GEN. FLR. | TF/T2-T3                      |
| 12                                   | SPARE BREAKERS              | RFR-160509           | ME        | 4401 GEN. FLR. | TE/T1-T2                      |
| 13                                   | 65' PROTECTION BARRIERS     | RFR-160587           | OPS       |                | (2) TB/T3-T4, (3) TE-TG/T5-T6 |
| 14                                   | 10' PROTECTION BARRIERS     | RFR-160587           | OPS       |                | (2) TE/T1-T2, (6) TD-TG/T3-T4 |
| 15                                   | PLANT STATUS CABINET        | RFR-160587           | OPS       |                | TF/T3                         |

Figure withheld in accordance with 10 CFR 2.390

|  |              |  |       |               |       |
|--|--------------|--|-------|---------------|-------|
| 32   | 052919       | INCCORP. MP 18-0039, REV. 0.             | SJK   | AHR           | DME   |
| 31   | 020819       | INCCORP. RFR 160587, REV. 0 & REV. 1.    | SJK   | AHR           | DME   |
| 30   | 022718       | INCCORP. RFR 160509.                     | MAL   | RLW           | DME   |
| 29   | 020918       | INCCORP. MP 08-0056, REV. 0.             | MAL   | RLW           | DME   |
| 28   | 022116       | INCORPORATE AC 15-000040, RFR 201101991. | CNS   | RLW           | DME   |
| 27   | 101515       | INCCORP. RFR 201405347.                  | MAL   | RLW           | DME   |
| NO.  | DATE         | REVISIONS                                | BY    | CHK           | APPR  |
| SCALE 1/8"=1'-0"   | DATE 4-11-75 | DESIGNED                                 | DRAWN | CHIEF         | ENGR. |
| BECHTEL<br>GAITHERSBURG, MARYLAND  |              |  |       |               |       |
| SNUPPS   |              |  |       |               |       |
| EQUIPMENT LOCATION<br>TURBINE BUILDING<br>MEZZANINE FLOOR PLAN EL.2033'-0"<br>FSAR FIGURE 1.2-32 |              |  |       |               |       |
| AS-BUILT   |              | UTILITY DRAWING NO.                      |       | REV           |       |
| JOB NO.  |              | BECHTEL DRAWING NO.                      |       | REV           |       |
| 10466  |              | M-2G063                                  |       | 32            |       |
| DRAWING APPLICABLE TO UNITS  |              | 2  |       | 34x44 1" SIZE |       |

FSAR Figure 1.2-33 is withheld per RIS 2015-17

FSAR Figure 1.2-33 is withheld per RIS 2015-17

|                                   |                                       |                     |      |          |
|-----------------------------------|---------------------------------------|---------------------|------|----------|
| 002819                            | INCORP. MP 18-0039, REV. 0.           | SLK                 | AWD  | 04/04/04 |
| 002819                            | INCORP. RFR 160430, REV. 0.           | UHS                 | MAJ  | 04/04/04 |
| 002819                            | INCORPORATE MP 16-0039, REV. 0.       | UHS                 | MAJ  | 04/04/04 |
| 002819                            | INCORPORATE MP 18-0035, REV. 13       | SLW                 | TJC  | 04/04/04 |
| 002819                            | INCORP. MP 01-1002 FCN-10             | SLW                 | MAJ  | 04/04/04 |
| 002819                            | INCORP. MP 11-0022 FCN-01             | TJC                 | MAJ  | 04/04/04 |
| 002819                            | CORRECTED TYPE IN REV. 16 REV. BLOCK. |                     |      |          |
| NO.                               | DATE                                  | REVISIONS           | BY   | CHKD     |
| 002819                            | 04/04/04                              | 01                  | SLK  | UHS      |
| BECHTEL                           |                                       |                     |      |          |
| EQUIPMENT LOCATION                |                                       |                     |      |          |
| TURBINE BUILDING                  |                                       |                     |      |          |
| OPERATING FLOOR-PLAN EL. 2065'-0" |                                       |                     |      |          |
| FSAR FIGURE 1.2-33                |                                       |                     |      |          |
| AS-BUILT                          |                                       | UTILITY DRAWING NO. | REV. |          |
| JOB NO.                           |                                       | BECHTEL DRAWING NO. | REV. |          |
| 10466                             |                                       | M-2G064             | 22   |          |
| DRAWING APPROVED TO PRINT         |                                       |                     |      |          |

Figure withheld in accordance with 10 CFR 2.390

Figure withheld in accordance with 10 CFR 2.390


|   |  |                     |            |            |
|---|--|---------------------|------------|------------|
| 090310  | INCORP. MP 10-0032.  | MAL                 | EWI        | LMP        |
| 081805  | INCORPORATE MP 03-1017C  | EWI                 | JHK        | TWS        |
| 042007  | INITIAL ISSUE. REFLECTS TURNOVER TO UE. THIS DWG. SUPERCEDES M-00065 REV. 7. INC. CMP 85-0265 & RFR 01127. | JGH                 | DLB        | DHZ        |
| REV. DATE   | REVISIONS  | BY                  | CHK        | APPR       |
| SCALE 1/8"=1'-0"  | DATE 12-5-73   | DESIGNED D/W        | DRAWN C/JM | CHIEF KGBR |
| <b>BECHTEL</b><br>GAITHERSBURG, MARYLAND  |  |                     |            |            |
| <b>SNUPPS</b>   |  |                     |            |            |
| EQUIPMENT LOCATION<br>TURBINE BUILDING<br>SECTION "A"<br>FSAR FIGURE 1.2-34           |  |                     |            |            |
| <b>AS-BUILT</b>   |  | UTILITY DRAWING NO. |            | REV        |
|  |  | BECHTEL DRAWING NO. |            | REV        |
| 10466   |  | M-2G065             |            | 6          |
| DRAWING APPLICABLE TO UNITS 2 1   |  |                     |            |            |



Figure withheld in accordance with 10 CFR 2.390

Figure withheld in accordance with 10 CFR 2.390

|   |   |           |       |     |      |
|---|---|-----------|-------|-----|------|
| 042005  | INCORP. RFR-22941A.   | TJC       | MAL   | N/A | TWS  |
| 022502  | INCORP. MP 99-2016A.  | JHK       | MAL   | N/A | AMR  |
| 1/3   | INITIAL ISSUE SUPERSEDES M-06066 REVS, REFLECTS TURNOVER TO U E, INCORP CMP 86-Q2-50A | W         | 3/27  | N/A | N/A  |
| NO  | DATE  | REVISIONS | BY    | CHK | ENGR |
| SCALE 1/8"=1'-0"                                      | DATE 4/23/75  | DESIGNED  | DRAWN | CHK | ENGR |
| <b>BECHTEL</b>  |   |           |       |     |      |
| GAITHERSBURG, MARYLAND                                |   |           |       |     |      |
| <b>SNUPPS</b>   |   |           |       |     |      |
| EQUIPMENT LOCATION<br>TURBINE BUILDING<br>SECTION "B" |   |           |       |     |      |
| FSAR FIGURE 1.2-35                                    |   |           |       |     |      |
| <b>AS-BUILT</b>                                       |   |           |       |     |      |
| UTILITY DRAWING NO.                                   |   |           |       |     |      |
| REV   |   |           |       |     |      |
| JOB NO.   |   |           |       |     |      |
| BECHTEL DRAWING NO.                                   |   |           |       |     |      |
| 10466   |   |           |       |     |      |
| M-2G066   |   |           |       |     |      |
| 2   |   |           |       |     |      |
| DRAWING APPLICABLE TO UNITS                           |   |           |       |     |      |

Figure withheld in accordance with 10 CFR 2.390

Figure withheld in accordance with 10 CFR 2.390

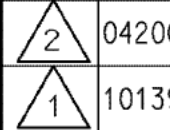
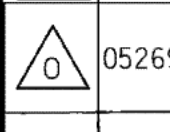
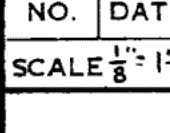
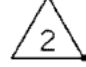


|   |        |   |                     |     |                     |       |
|---|--------|---|---------------------|-----|---------------------|-------|
|    | 042000 | INCORP.<br>RFR-22941A.  | TJC                 | MAL | N/A                 | TWS   |
|    | 101398 | INCORP.<br>RMP-98-2004A.  | RLW                 | DJB | N/A                 | AMR   |
|    | 052698 | INITIAL ISSUE. SUPERCEDES<br>DWG. M-06067 REV. 6. RE-<br>FLECTS TURNOVER TO UE. | JHK                 | MAL | N/A                 | AMR   |
| NO.   | DATE   | REVISIONS   | BY                  | CHK | DRS                 | ENGR  |
|   |        |   |                     |     | SUPV                | CHIEF |
|   |        |   |                     |     | ENGR                | ENGR  |
| SCALE 1"=1'-0" DATE 3-15-74 DESIGNED RHM DRAWN <i>Spencer</i>   |        |   |                     |     |                     |       |
| <b>BECHTEL</b><br>GAITHERSBURG, MARYLAND  |        |   |                     |     |                     |       |
| <b>SNUPPS</b>   |        |   |                     |     |                     |       |
| EQUIPMENT LOCATION<br>TURBINE BUILDING<br>SECTION "C"<br> PSAR FIGURE 1.2-36 |        |   |                     |     |                     |       |
| <b>AS-BUILT</b>   |        |   | UTILITY DRAWING NO. |     | REV                 |       |
|    |        |   | JOB NO.             |     | BECHTEL DRAWING NO. |       |
|   |        |   | 10466               |     | M-2G067             |       |
|   |        |   |                     |     | 2                   |       |
| DRAWING APPLICABLE TO UNITS   |        |   |                     |     |                     |       |

Figure withheld in accordance with 10 CFR 2.390

Figure withheld in accordance with 10 CFR 2.390

|   |              |   |                     |               |                     |                      |
|---|--------------|---|---------------------|---------------|---------------------|----------------------|
| 3   | 032009       | INCORP. CHANGE REQUEST<br>RFR 022395A P01<br>(RFR CAR 200503454).                   | MAL                 | TJC           | N/A                 | TWS                  |
| 2   | 042005       | INCORP. RFR 22941A  | TJC                 | MAL           | N/A                 | TWS                  |
| 1   | 042005       | REFLECTS TURNOVER TO UE &<br>INCORP. CMP 04-02-50P                                  | WLS                 | WLS           | N/A                 | N/A                  |
| 0   | 042005       | DRAFTED CMP 04-03-33A<br>PER ELB-532. THIS<br>DRAWING SUPERSEDES<br>M-09068 REV. 5. | WLS                 | WLS           | N/A                 | N/A                  |
| NO.   | DATE         | REVISIONS   | BY                  | CHK           | DES<br>SUPV         | PROJ<br>ENGR         |
| SCALE 1/8" = 1'-0"  | DATE 4-12-74 | DESIGNED RMP  | DRAWN T. J. C.      | CHKD J. W. L. | DES. SUPV. J. W. L. | PROJ. ENGR. J. W. L. |
| <b>BECHTEL</b><br>GAITHERSBURG, MARYLAND                                    |              |   |                     |               |                     |                      |
| <b>SNUPPS</b>   |              |   |                     |               |                     |                      |
| EQUIPMENT LOCATION<br>TURBINE BUILDING<br>SECTION "D"<br>FSAR FIGURE 1.2-37 |              |   |                     |               |                     |                      |
| <b>AS-BUILT</b>   |              |   | UTILITY DRAWING NO. |               | REV                 |                      |
| JOB NO.   |              |   | BECHTEL DRAWING NO. |               | REV                 |                      |
| 10466   |              |   | M-2G068             |               | 3                   |                      |
| DRAWING APPLICABLE TO UNITS   |              |   | 2                   |               | 1                   |                      |

Figure withheld in accordance with 10 CFR 2.390

- NOTES:
- 1. \* PROVISION FOR FUTURE CONDENSER TUBE CLEANING EQUIPMENT
  - 2.  DENOTES EQUIPMENT PERMANENTLY REMOVED FROM SERVICE AND MAY NOT BE LOCATED AS SHOWN.

|   |   |                     |          |            |             |
|---|---|---------------------|----------|------------|-------------|
| 042005  | INCCORP. RFR 22941A.  | TJC                 | MAL      | ----       | TWS         |
| 01992   | INCCORP. CMP 91-1020  | MAL                 | ---      | ---        | ---         |
| 11591   | ISSUE PER EDPF ZZ-04024   | ESR                 | ---      | ---        | ---         |
| 3-7-86  | INITIAL ISSUE, REFLECTS TURN-OVER TO UC. THIS DWG SUPERSEDES M-06049 REV 4, INCCORP. CMP 84-03-138. | SK                  | 2-13     | N/A        | N/A         |
| NO.   | DATE  | REVISIONS           | BY       | CHK        | DES         |
| SCALE   | 1"=0'   | DATE 7-7-75         | DESIGNED | DRAWN B.S. | PROJ. ENGR. |
| <b>BECHTEL</b><br>GAITHERSBURG, MARYLAND                                    |   |                     |          |            |             |
| <b>SNUPPS</b>   |   |                     |          |            |             |
| EQUIPMENT LOCATION<br>TURBINE BUILDING<br>SECTION "E"<br>FSAR FIGURE 1.2-35 |   |                     |          |            |             |
| <b>AS-BUILT</b>   |   | UTILITY DRAWING NO. |          | REV        |             |
| JOB NO.   |   | BECHTEL DRAWING NO. |          | REV        |             |
| 10466   |   | M-2G069             |          | 3          |             |
| DRAWING APPLICABLE TO UNITS   |   |                     |          |            |             |

Figure withheld in accordance with 10 CFR 2.390



Figure withheld in accordance with 10 CFR 2.390

Figure withheld in accordance with 10 CFR 2.390

|  |          |  |         |      |      |
|--|----------|--|---------|------|------|
|  | 042005   | INCORP. RFR 22941A.  | TJC     | MAL  | TWS  |
|  | 060804   | INITIAL ISSUE, REFLECTS TURNOVER TO UE. SUPERCEDES M-06070 REV 4.        | EMM     | JHK  | TWS  |
| NO.                                      | DATE     | REVISION   | BY      | CHKD | APPR |
| DRAWN                                    | N/A      | <div>EQUIPMENT LOCATION<br/>TURBINE BUILDING<br/>SECTION "F".<br/></div> |         |      |      |
| CHKD.                                    | N/A      |  |         |      |      |
| SUPV.                                    | N/A      |  |         |      |      |
| APPD.                                    | N/A      |  |         |      |      |
| N/A                                      | LOCATION | CALLAWAY PLANT UNIT 1  | CLASS   | REV  |      |
| UNION ELECTRIC COMPANY<br>ST. LOUIS, MO. |          |  | M-2G070 |      | 1    |

Figure withheld in accordance with 10 CFR 2.390

Figure withheld in accordance with 10 CFR 2.390

|   |  |             |                     |            |           |
|---|--|-------------|---------------------|------------|-----------|
| 042005  | INCORP. RFR 22941A   | TJC         | MAL                 | N/A        | TWS       |
| 0   | INITIAL ISSUE REFLECTS TURN-OVER TO UE. INCORP RMP 93-2035A. SUPERSEDES M-06071 REV. 5 | SKC         | DLB                 | N/A        | AMR       |
| NO.   | DATE   | REVISIONS   | BY                  | CHK        | DES       |
| SCALE 8 1/4" = 1'-0"  | DATE 12-17-73  | DESIGNED RM | DRAWN C/JM          | CHIEF ENGR | PROJ ENGR |
| BECHTEL<br>GAITHERSBURG, MARYLAND   |  |             |                     |            |           |
| SNUPPS  |  |             |                     |            |           |
| EQUIPMENT LOCATION<br>TURBINE BUILDING<br>SECTION "G"<br>FSAR FIGURE 1.2-40 |  |             |                     |            |           |
| AS-BUILT  |  |             | UTILITY DRAWING NO. |            | REV       |
| JOB NO.   |  |             | BECHTEL DRAWING NO. |            | REV       |
| 10466   |  |             | M-2G071             |            | 1         |
| DRAWING APPLICABLE TO UNITS 1 2 XXXXXXXX                                    |  |             |                     |            |           |

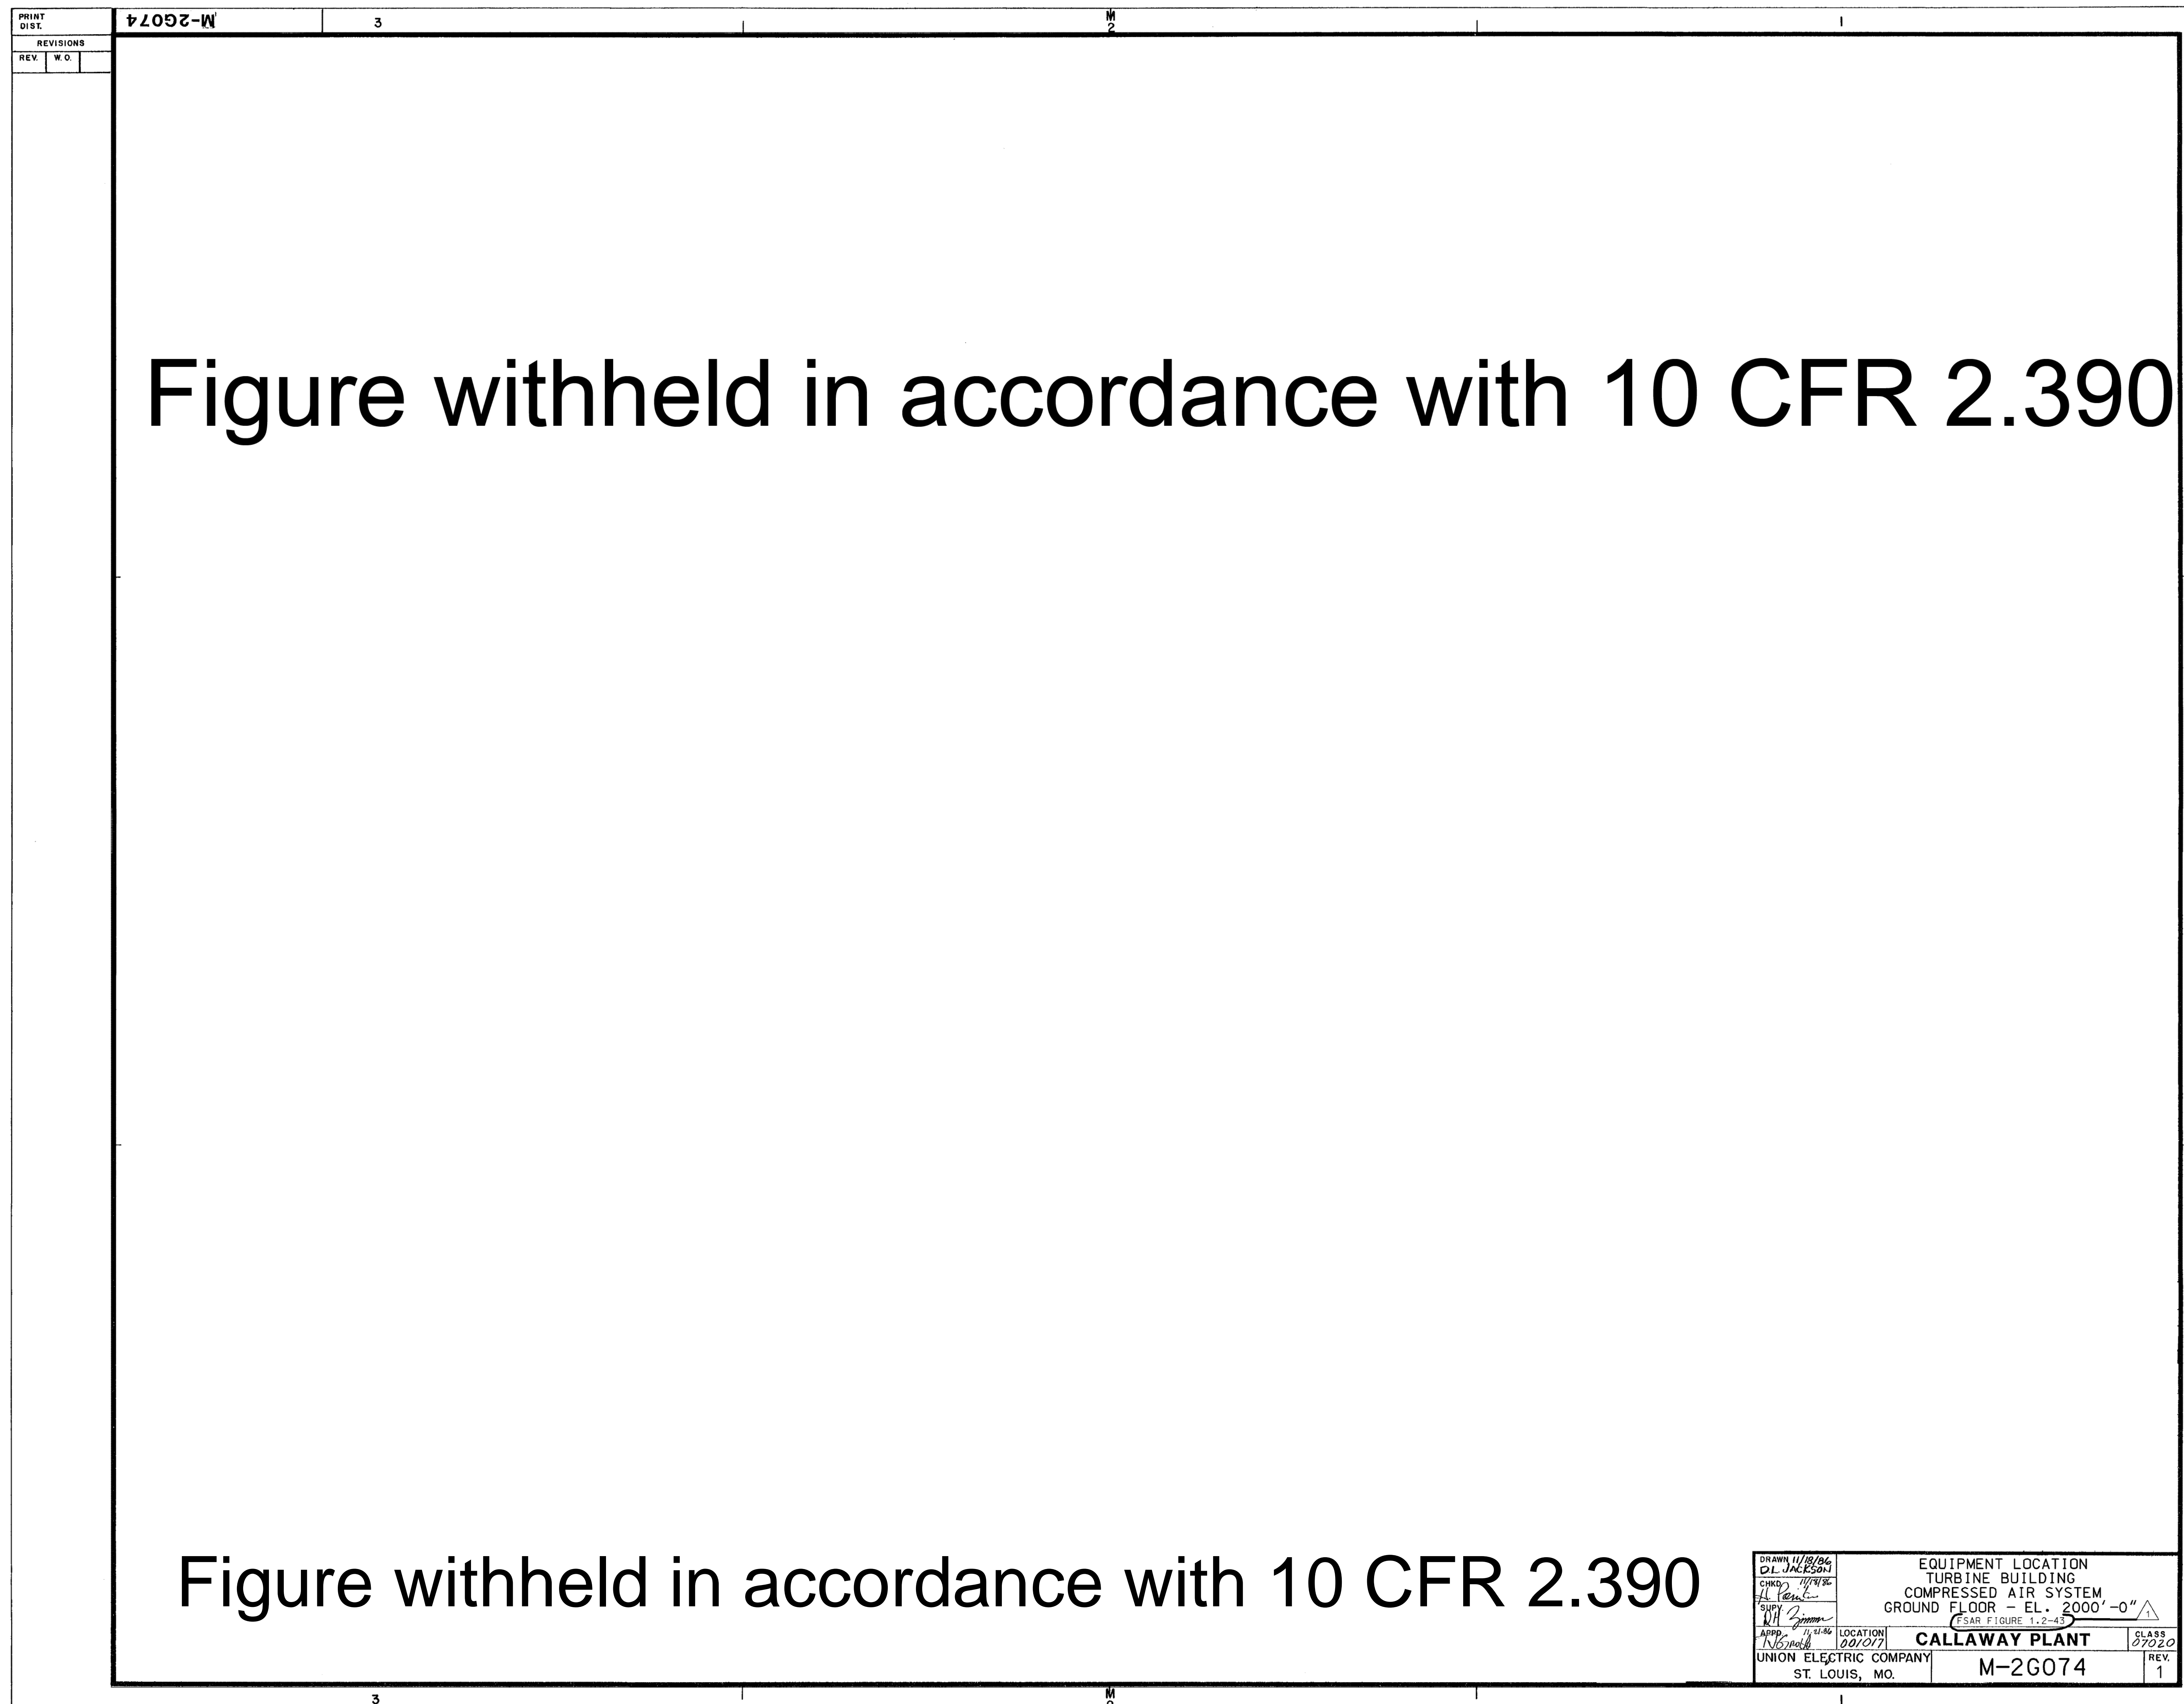


FSAR Figure 1.2-42 is withheld per RIS 2015-17

FSAR Figure 1.2-42 is withheld per RIS 2015-17

|  |  |                     |             |      |
|--|--|---------------------|-------------|------|
| 010819   | INCORP. RFR 100420+ REV. D.  | ASH                 | MAI         | DNE  |
| 011116   | INCORP. RFR 201501412.   | MAI                 | RLW         | DNE  |
| 010913   | INCORP. MP 10-0035, REV. D. AND<br>CORRECTED DOOR TO AS-BUILT.                                 | MAI                 | RLW         | DNE  |
| 011105   | INCORPORATE MP 03-105 TC   | EMW                 | JHX         | TWS  |
| 042005   | INCORP. RFR 22041A   | TJC                 | MAI         | TWS  |
| 043090   | INITIAL ISSUE+ REFLECTS TURNOVER<br>TO S.U.C.; INCORP. MP 110034+<br>SUPERSEDES M-6073 REV. D. | RLW                 | DLB         | JHX  |
| REV  | DATE   | DESCRIPTION         | DESIGNED BY | DATE |
| SCALE: 1/4"=1'-0" DATA: S.T.T.G. (DESIGNED BY) DRAWN: S.V.T. DATE: 0000  |  |                     |             |      |
| <b>BECHTEL</b><br>GATHERBURG, MARYLAND   |  |                     |             |      |
| <b>SNUPPS</b>  |  |                     |             |      |
| EQUIPMENT LOCATION<br>TURBINE COMPONENTS LAYDOWN<br>OPERATION FLOOR EL. 2065'-0"<br>FSAR FIGURE 1.2-42   |  |                     |             |      |
| <b>AS-BUILT</b>  |  | UTILITY DRAWING NO. | REV.        |      |
| JOB NO.  |  | BECHTEL DRAWING NO. | REV.        |      |
| 10466  |  | M-2G073             | 5           |      |
| DRAWING APPLICABLE TO UNITS: 1 2 3 100 |  |                     |             |      |





4

3

M

2

1

00188-X-0098

FSAR Figure 1.2-44 is withheld per RIS 2015-17

D

D

C

C

B

B

A

A

FSAR Figure 1.2-44 is withheld per RIS 2015-17

|   |        |   |                   |                        |            |
|---|--------|---|-------------------|------------------------|------------|
| DESIGN                                  | (DATE) | PROPERTY-SITE LAYOUT<br>OWNER CONTROLLED AREA<br>AND SURROUNDING AREA<br>FSAR FIGURE 1.2-44 |                   |                        |            |
| CHKD.                                   | (DATE) |   |                   |                        |            |
| SUPV.                                   | (DATE) |   |                   |                        |            |
| APPR.                                   | (DATE) | LOCATION  | CALLAWAY LOCATION | CALLAWAY ENERGY CENTER | CLASS      |
| N/A                                     |        | 001017  | 982               |                        |            |
| UNION ELECTRIC COMPANY<br>ST. LOUIS, MO |        |   |                   | 8600-X-88100           | REV.<br>74 |

4

3

M

2

1

FSAR Figure 1.2-45 is withheld per RIS 2015-17

FSAR Figure 1.2-45 is withheld per RIS 2015-17

UNION ELECTRIC COMPANY  
CALLAWAY PLANT  
FINAL SAFETY ANALYSIS REPORT

FIGURE 1.2-45  
COOLING WATER  
YARD PIPING SYSTEMS

REV. 18 11/16

FSAR Figure 1.2-46 is withheld per RIS 2015-17

H

G

F

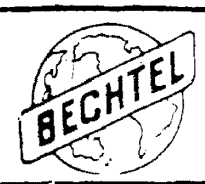
E

D

C

B

A

|   |         |   |                     |     |             |               |
|---|---------|---|---------------------|-----|-------------|---------------|
| <div>15</div>   | 121608  | INCORP. CHANGE REQUEST<br>(CAR 08-000389<br>(CAR 200808332)). | MAL                 | TJC | N/A         | TWS           |
| <div>14</div>   | 042005  | INCORP. RFR 22941A.   | TJC                 | MAL | N/A         | TWS           |
| <div>13</div>   | 030103  | INCORP. MP 98-1040A.  | JHK                 | MAL | N/A         | TWS           |
| <div>12</div>   | 082201  | INCORP. RFR-20356A.   | JHK                 | MAL | N/A         | AMR           |
| <div>11</div>   | 050501  | INCORP. RFR 19923A.   | MAL                 | RLW | N/A         | AMR           |
| <div>10</div>   | 072299  | INCORP. RFR-19694A.   | JHK                 | MAL | N/A         | AMR           |
| <div>9</div>  | 112498  | INCORP. RFR-17296C  | DLB                 | SKC | N/A         | AMR           |
| <div>8</div>  | 060898  | INCORP. RFR-15830B  | DLB                 | SKC | N/A         | AMR           |
| <div>7</div>  | 041691  | INCORP. RFR-17296A AND<br>RFR-17719A.                         | JHK                 | EMW | N/A         | AMR           |
| NO. DATE  |         | REVISIONS   | BY                  | CHK | DES<br>SUPP | ENGR<br>ENGR  |
| SCALE 6"=1'-0"  |         | DATE 8-23-74  | DESIGNED BY         | DRN | SDP         | CHIEF<br>ENGR |
| BECHTEL   |         |   |                     |     |             |               |
| GAITHERSBURG, MARYLAND  |         |   |                     |     |             |               |
| SNUPPS  |         |   |                     |     |             |               |
| ESSENTIAL SERVICE WATER SYS.<br>PUMPHOUSE<br>EQUIPMENT LOCATIONS-PLAN<br>FSAR FIGURE 1.2-46 |         |   |                     |     |             |               |
| UNION ELECTRIC CO.<br>CALLAWAY PLANT<br>UNIT 1  |         |   | UTILITY DRAWING NO. |     |             | REV           |
|   |         |   | AS-BUILT            |     |             |               |
|        | JOB NO. |   | BECHTEL DRAWING NO. |     |             | REV           |
|   | 10884   |   | M-UG080             |     |             | 15            |
| DRAWING APPLICABLE TO UNITS   |         |   |                     |     |             |               |
|   |         | 2   | X                   | X   | X           | X             |

FSAR Figure 1.2-46 is withheld per RIS 2015-17



FSAR Figure 1.2-47 is withheld per RIS 2015-17

|  |   |      |        |          |      |
|--|---|------|--------|----------|------|
| 042005                                 | INCORP. RFR 22941A  | TJC  | MAL    | N/A      | TWS  |
| 121197                                 | REFLECTS TURNOVER TO U.E.<br>INCORP DEC-1462  | DLBH | RLW    | N/A      | AMR  |
| 5/12/13                                | (F-6) DELETED ESW LOCAL CONTROL PANEL.<br>GEN. UPDATE OF CONCRETE C-7, F-6 ADDED SEISMIC RESTRAINTS TO PUMP SECTIONS;<br>F-7 REVISED UNIT HEATER;<br>A-2 ADDED PROFESSIONAL SEAL;<br>C-7, F-6 REVISED MONORAIL; A-1 DELETED REFERENCE TO CALLAWAY UNIT 2.   | OB   | FMA    | FA       | JAC  |
| 10/2/11                                | B-5 EL 1995'-10" WAS EL 1995'-0"<br>F-6, C-7 ADDED MONORAIL.<br>F-7 ADDED INSUL. FLGS.<br>C-7 RELEASED HOLD ON PRE-LUBE STORAGE TANKS.  | DS   | DS     | DS       | MM   |
| 5/11/11                                | B-4 MOD. SECTION "C"<br>F-6 VERTICAL LADDER WAS EMBEDDED RUNGS, 1985'-0"<br>PLATFORM ELEV WAS 1983'-6"<br>DELETED RIGGING BEAM,<br>RELEASED HOLD & MOD.<br>PIPING ARR@ PLATFORM@ 2008'-0"<br>C-6 RELEASED HOLD ON PUMPS.<br>REVISED ALL ROOF ELEVATIONS<br>C-7 ADDED HOLD TO ESW PUMP<br>PRE-LUBE STORAGE TANKS<br>F-6 RELOCATED ESW LOCAL CONTROL PANEL, TRANS & MCC 1 ADDED PLATFORM,<br>WALL LADDER & UNIT HEATERS.<br>E-6 7'-6" DIM. WAS 10'-0" | DS   | DS     | DS       | MM   |
| 7/5/74                                 | ISSUED FOR CONSTRUCTION   | BY   | CHK    | ENGR     | PROJ |
| NO. DATE                               | REVISIONS   | BY   | CHK    | ENGR     | PROJ |
| SCALE                                  | NOTED   | DATE | 7-5-74 | DESIGNED | GEN  |
| DRAWN S.B.F.                           |   |      |        |          |      |
| BECHTEL                                |   |      |        |          |      |
| GAITHERSBURG, MARYLAND                 |   |      |        |          |      |
| SNUPPS                                 |   |      |        |          |      |
| ESSENTIAL SERVICE WATER SYS. PUMPHOUSE |   |      |        |          |      |
| EQUIPMENT LOCATIONS 5 SECTIONS         |   |      |        |          |      |
| UNION ELECTRIC CO                      |   |      |        |          |      |
| CALLAWAY PLANT                         |   |      |        |          |      |
| UNIT 1                                 |   |      |        |          |      |
| AS-BUILT                               |   |      |        |          |      |
| JOB NO.                                |   |      |        |          |      |
| BECHTEL DRAWING NO.                    |   |      |        |          |      |
| M-UG081                                |   |      |        |          |      |
| 5                                      |   |      |        |          |      |
| DRAWING APPLICABLE TO UNITS            |   |      |        |          |      |

FSAR Figure 1.2-47 is withheld per RIS 2015-17

**FSAR Figure 1.2-48 is withheld per RIS 2015-17**

|   |            |  |              |           |            |           |
|---|------------|--|--------------|-----------|------------|-----------|
| Q   | 021110     | INCORP. MP 07-0066, FCN-24.  | MAL          | TJC       | N/A        | TWS       |
| B   | 042005     | INCORP. RFR 22941A.  | TJC          | MAL       | N/A        | TWS       |
| Q   | 042899     | INCORP. MP 90-1009 FCN-03.   | JHK          | MAL       | N/A        | JHC       |
| A   | 11/14/92   | REFLECTS TURNOVER TO U.E. INCORP RFR-098358 (MIN. MOD)   | ESR          | LOC       | ---        | Jfm       |
|   |            | (D-5) ADDED HANDRAIL GEN. UPDATE OF CONCRETE, A-1, F-1 DELETE REFERENCE TO CALLAWAY UNIT 2; F-6, G-6 ADDED EQUIP. NOIS FOR FAN MOTORS.   | 10/8         | PNA       | 1/2        | 1/2       |
| A   | 5/1/79     | ADDED PROFESSIONAL SEAL NOT CIRCLED GENERAL REVISION TO DWG PRESENTATION OF COOLING TOWER INCLUDING ROOF, FAN SHIELDING, AND AREA UNDER FANS.                                  | 10/8         | 1/2       | 1/2        | 1/2       |
| A   | 5/1/79     | F-3 ADDED PARTIAL PLAN. F1-F4 ADDED PLATFORMS & LADDERS  | 10/8         | 1/2       | 1/2        | 1/2       |
|   |            | G-6 RELOCATED FAN MOTORS. F-7, F-4. MOD. ELECT. EQUIP. ROOM OUTLINE & EQUIP. LOC. MOD. 20 SUPPLY LINE ARRGT.   | 10/8         | 1/2       | 1/2        | 1/2       |
| A   | 5/1/79     | F-6 RELOCATED PERSONNEL HATCHES  | 10/8         | 1/2       | 1/2        | 1/2       |
|   |            | E-1 REVISED NOTE 3.  | 10/8         | 1/2       | 1/2        | 1/2       |
|   | 9/1/74     | REVISED THE 20" SUPPLY PIPING, ARRG. & GENERAL DESIGN CHANGE, REVISED ENTRANCE TO ELECTRICAL ROOM. LOWERED 36" DRAIN PIPES. ADDED WALL BETWEEN PIPING AND ELECTRICAL EQUIPMENT | 10/8         | 1/2       | 1/2        | 1/2       |
| A   | 7/8/76     | ISSUED FOR CONSTRUCTION  | 10/8         | 1/2       | 1/2        | 1/2       |
| NO  | DATE       | REVISIONS  | BY           | CHK       | DES ENGR   | PROJ ENGR |
| SCALE   | 1/8"=1'-0" | DATE 6-3-76  | DESIGNED GLP | DRAWN GLP | CHECK ENGR | PROJ ENGR |
| <h2 style="text-align: center;">BECHTEL</h2> <p style="text-align: center;">GATHERSBURG, MARYLAND</p> <h3 style="text-align: center;">SNUPPS</h3> <p style="text-align: center;">UHS COOLING TOWER<br/>ARRANGEMENT<br/>FSAR FIGURE 1.2-48</p> <p style="text-align: center;">UTILITY DRAWING NO.      REV</p> <h2 style="text-align: center;">AS-BUILT</h2> <p style="text-align: center;">JOB NO.      BECHTEL DRAWING NO.      REV</p> <p style="text-align: center;">10884      M-UG082      8</p> <p style="text-align: center;">DRAWING APPLIED TO UNITS      2      34-64      T-11</p> |            |  |              |           |            |           |