SIZE E

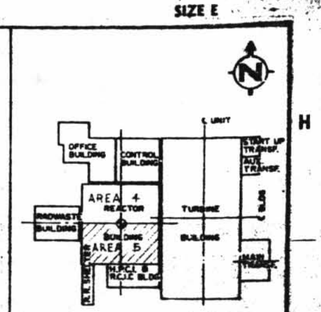

KEY PLAN

REVISION NOTES ⚠2

ISSUED FOR CONSTRUCTION OF:
SERVICE CONDENSATE SYS. HBC-14.
REVISED & REROUTED OF 4"-HBC-118
PER FCN № 368.
REVISED EMBEDDED PIPING FROM
SCH. 40 TO SCH. 80.

REVISION NOTES ⚠3

ISSUED FOR CONSTRUCTION OF:
REACTOR WELL DIFFUSER 6"-HCC-1 &
3"-HCC-1.

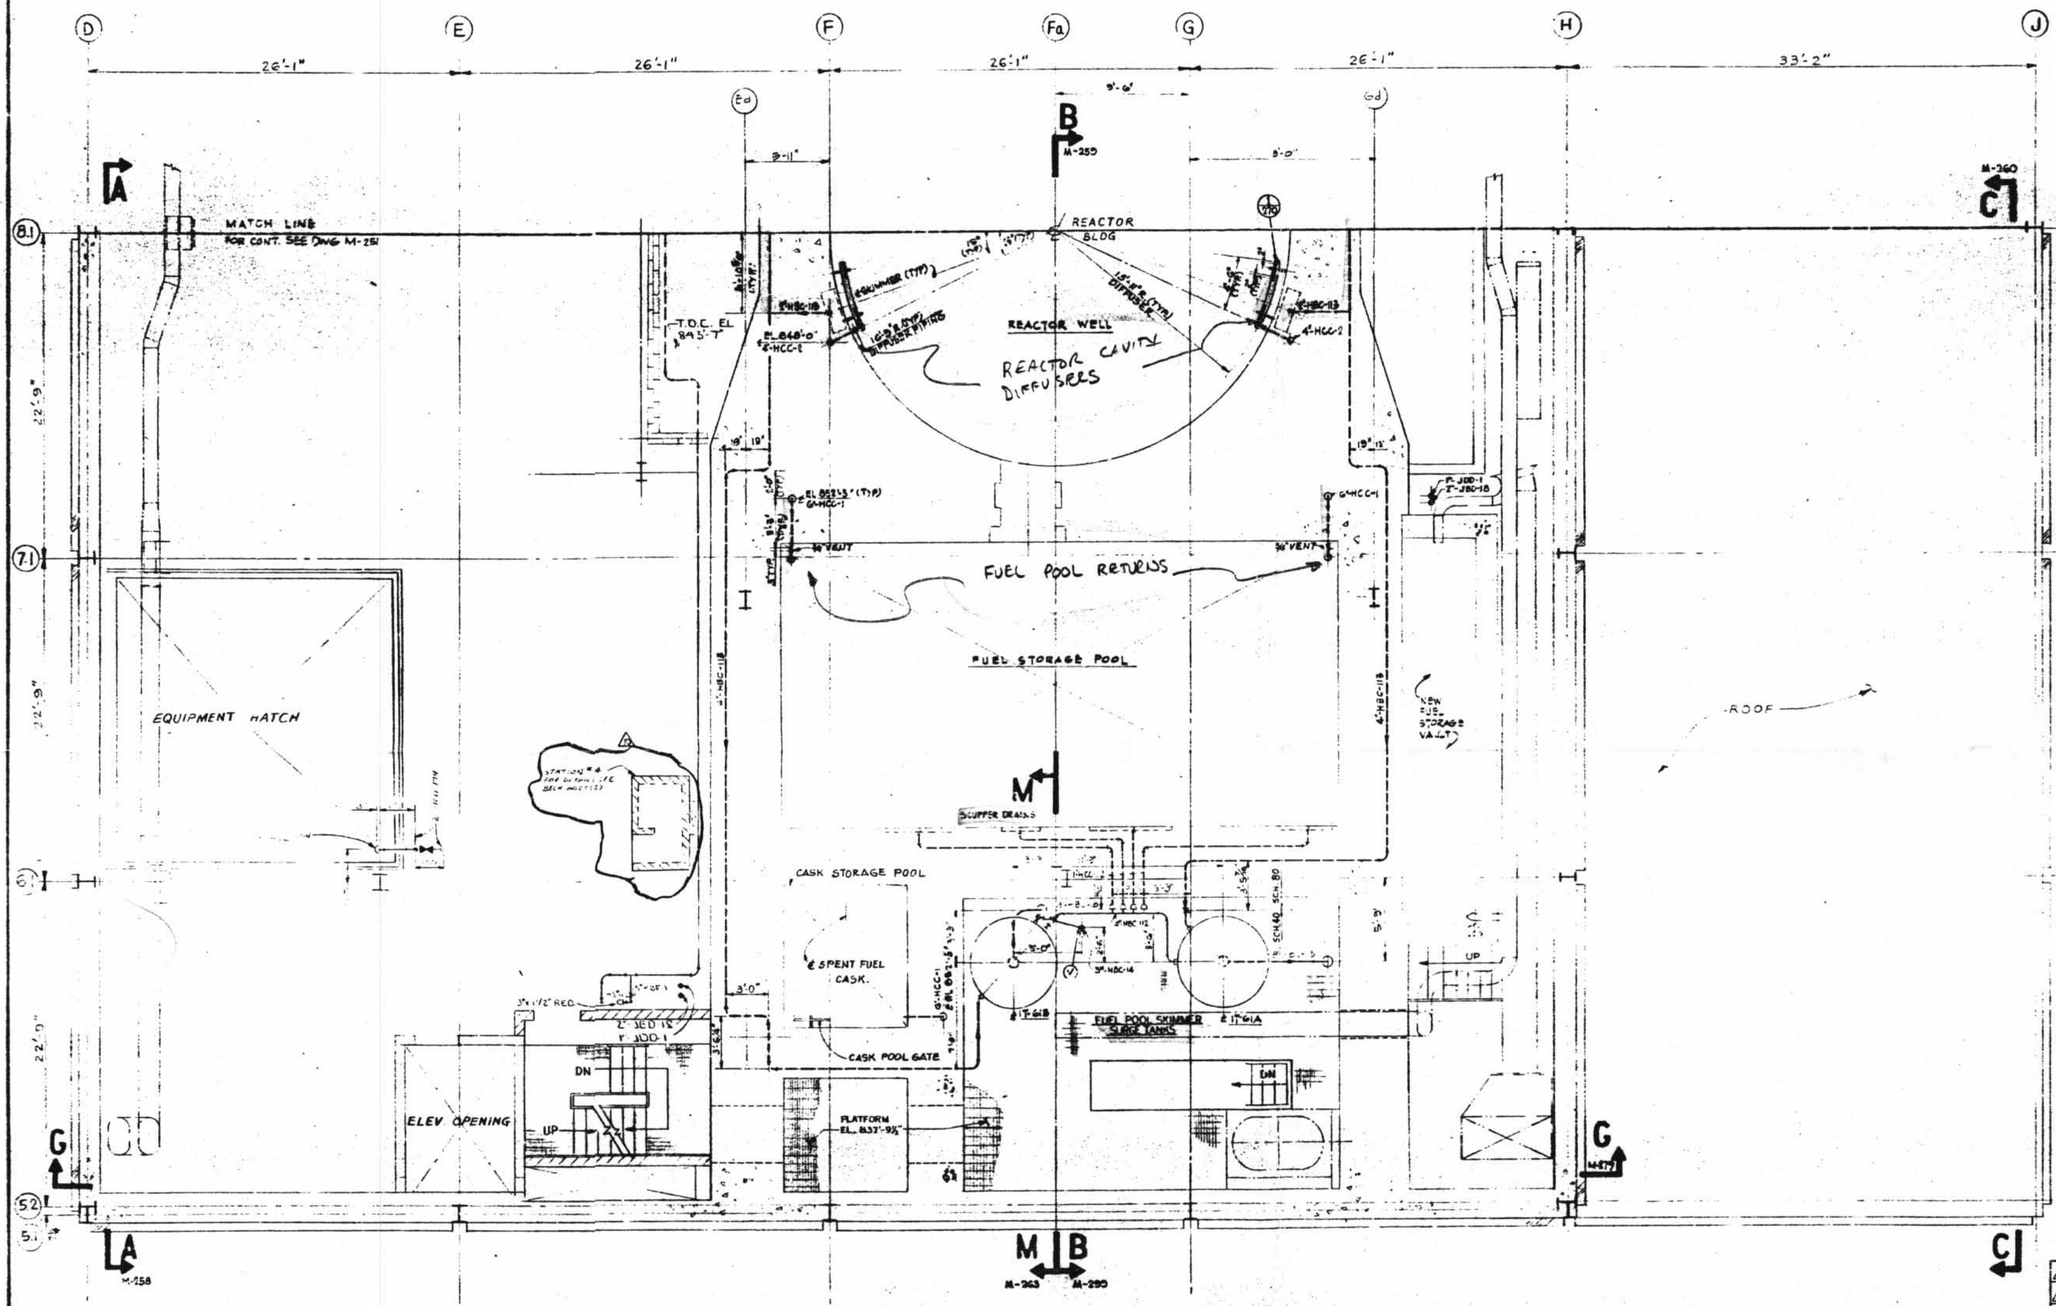

FOR INFORMATION
ONLY

⚠12 & 8	REV PER DCR 845	HB	[illegible]	[illegible]	[illegible]	
⚠8	REV PER DCR-920	SB	AP	[illegible]	[illegible]	
⚠3	CHANGED 3"-HBC-118 TO 1" SPEC. HCC (CO-ORD D-8	[illegible]	AP	[illegible]	[illegible]	
⚠2	REVISED LOCATION OF 3"-HCC-1 SYSTEM SPRAY NOZZLES & DRAIN PIPE, GATE	PL	AP	[illegible]	[illegible]	
⚠1	REVISION PER DCP-1163(D.B.)	DB	[illegible]		[illegible]	
⚠	REVD PER ADMIN - [illegible]	[illegible]	[illegible]		[illegible]	
⚠	REVISED PER DCR N-554	[illegible]	[illegible]		[illegible]	
⚠	ISSUED FOR CONST'N OF FUEL POOL DRY-AS-BUILT-HCC-1, HBC-14, HBC-118	HL	[illegible]	[illegible]	[illegible]	
NO.	REMARKS	BY	CHK'D	APP'D	DATE	

1/4"=1'-0" W.O. JC

BECHTEL
SAN FRANCISCO

DUANE ARNOLD ENERGY CENTER—UNIT NO 1
IOWA ELECTRIC LIGHT AND POWER COMPANY
CEDAR RAPIDS, IOWA

AREA-5 PIPING
PLAN BELOW ELEV 855'-0"

JOB NO. 7884 DRAWING NO. BECH-M-271 REV. 10

D2