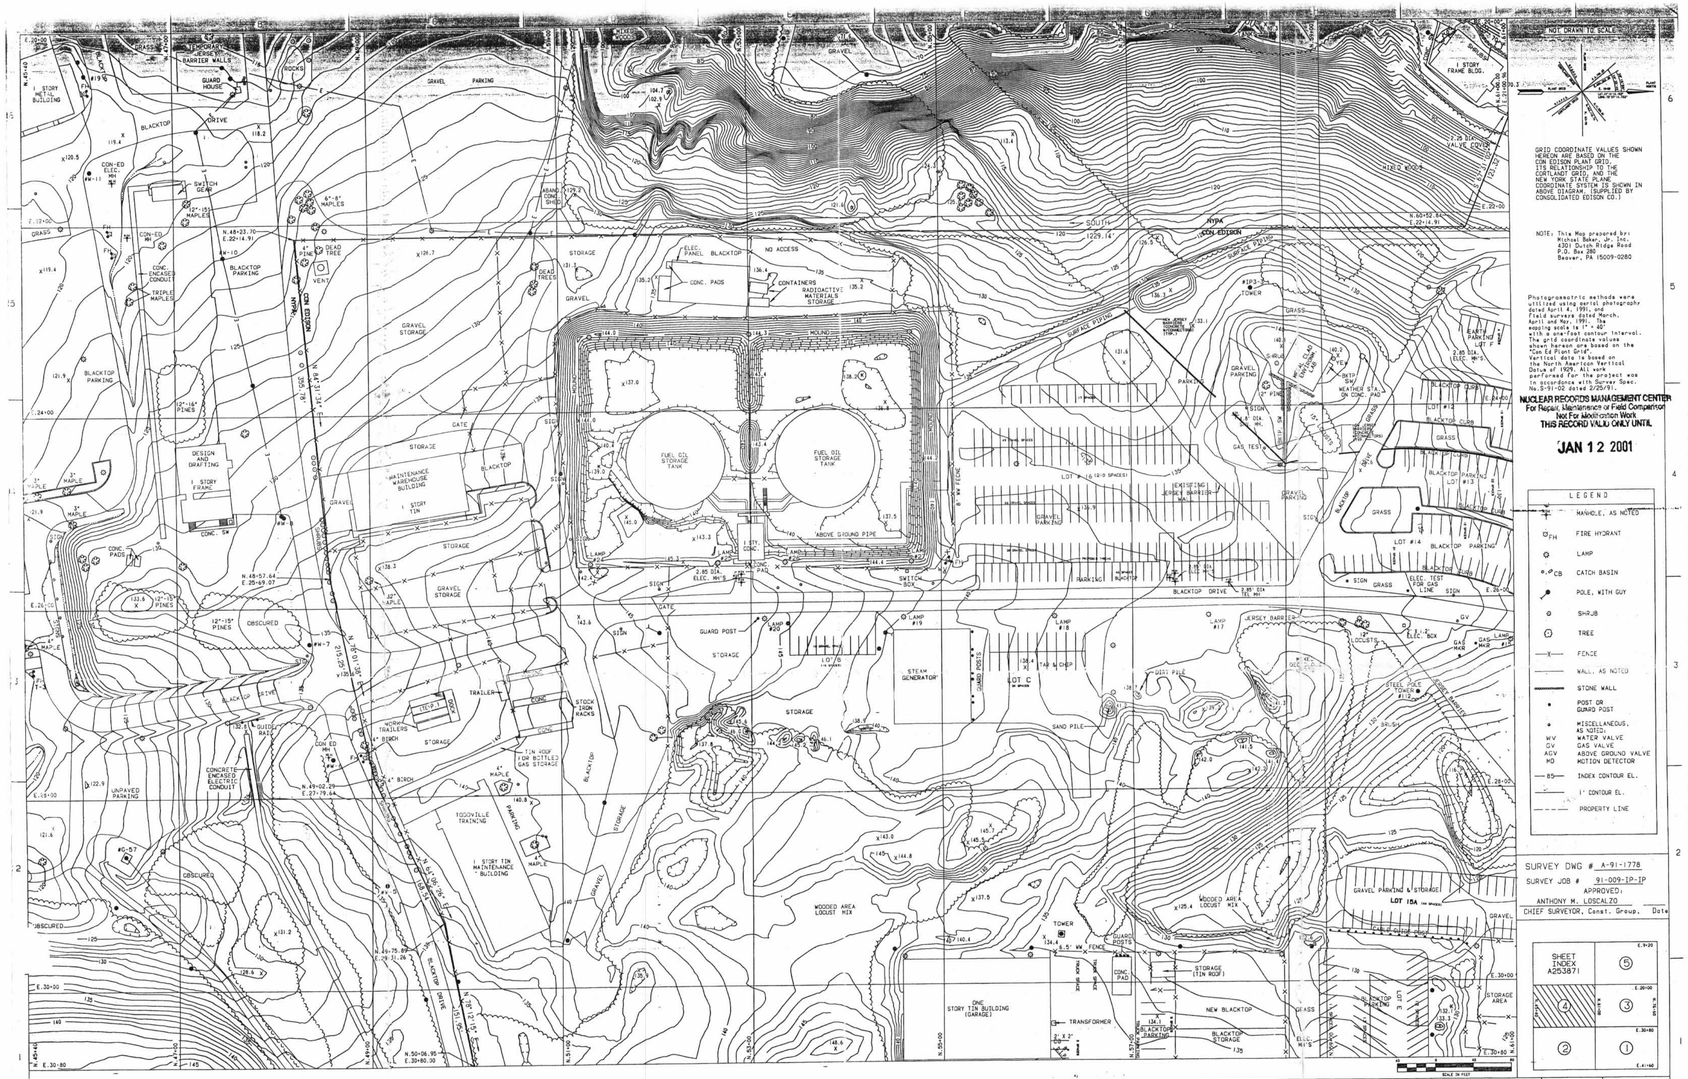
NOT DRAWN TO SCALE
GRID COORDINATE VALUES SHOWN HEREON ARE BASED ON THE CON EDISON PLANT GRID. ITS RELATIONSHIP TO THE CORTLANDT GRID, AND THE NEW YORK STATE PLANE COORDINATE SYSTEM IS SHOWN IN ABOVE DIAGRAM. (SUPPLIED BY CONSOLIDATED EDISON CO.)
NOTE: This Map prepared by: Michael Baker, Jr. Inc. 4301 Dutch Ridge Road P.O. Box 280 Beaver, PA 15009-0280
Photogrammetric methods were utilized using aerial photography dated April 4, 1991, and Field surveys dated March, April and May, 1991. The mapping scale is 1" = 40' with a one-foot contour interval. The grid coordinate values shown hereon are based on the "Con Ed Plant Grid". Vertical data is based on the North American Vertical Datum of 1929. All work performed for the project was in accordance with Survey Spec. No.S-91-02 dated 2/25/91.
NUCLEAR RECORDS MANAGEMENT CENTER
For Repair, Maintenance or Field Comparison
Not For Modification Work
THIS RECORD VALID ONLY UNTIL
JAN 12 2001
LEGEND
MANHOLE, AS NOTED
FIRE HYDRANT
LAMP
CATCH BASIN
POLE, WITH GUY
SHRUB
TREE
FENCE
WALL, AS NOTED
STONE WALL
POST OR GUARD POST
MISCELLANEOUS, AS NOTED
WV WATER VALVE
GV GAS VALVE
AGV ABOVE GROUND VALVE
MD MOTION DETECTOR
85 INDEX CONTOUR EL.
1' CONTOUR EL.
PROPERTY LINE
SURVEY DWG # A-91-1778
SURVEY JOB # 91-009-IP-IP
APPROVED:
ANTHONY M. LOSCALZO
CHIEF SURVEYOR, Const. Group. Date
SHEET INDEX A253871
THIS REVISION IS CLASS "A" PER CI-240-1 TO SHOW WORK DONE ON MOD. PROC. CPG-90-03550-C PKG. NO.8547 RELEASE AS CONSTRUCTED P.N.03550-89 L.H./ 10-20-93
L.J.SMITH 6-11-92
DON BUTEL 6-11-92
J. CURLY 6-11-92
E. KENT 6-12-92
TITLE: INDIAN POINT GEN STATION
SITE DEVELOPMENT PLAN
SHEET 4 OF 5
Con Edison
STATION INDIAN POINT
A253875-01
SCALE 1" = 40'
REVIEW
APPROVALS

D-2